

Memo to: El Paso County PCD

From: Core Engineering Group

Date: March 14, 2018

RE: Jimmy Camp Creek Main Channel Lorson Blvd Bridge (CDR -17-7)- Review1
Response to Comments

Design/H&H Report

1. Note: Provide P.E. signed and stamped report with the final submittal. **RE: noted**
2. Address interim and permanent runoff conveyance from the bridge and temporary and permanent water quality facilities for the area to be paved. Reference ECM Section I.7. **RE: ultimate runoff treated in Ponds C1, C3, G1/G2 which are existing. Interim WQ will be provided in the sediment basin until Lorson is built to the east which will happen within a year or two.**
3. See redlines regarding riprap thicknesses (typos?) on "Layout Recommendations" sheets (pages 63, 66, and 69 of the report pdf). **RE: thicknesses updated**

Construction Plans / Geotechnical Issues

1. Note: Provide P.E. signature and stamp on all pages with the final submittal. **RE: noted**
2. Provide a plan showing all maintenance roads/trails meeting county criteria on both sides of the channel providing access to the bridge structure, including extension to a public road or designated access easement from a road. **RE: access was dedicated in CM South in Tract F and G. The access is from Fontaine Boulevard.**
3. Show and label all existing and proposed easements, including drainage and utilities. **RE: tracts labeled.**
4. Show and label bridge clearances to the pedestrian/maintenance trails on the appropriate plan sheets. Ensure that clearances will be adequate for both maintenance and regional trail purposes. **RE: labeled**
5. See electronic redlines for additional minor comments/questions.

Grading and Erosion Control Plan / SWMP

1. If the water line crossing Jimmy Camp Creek is included with bridge construction, include it in the limits of construction. **RE: limits updated for watermain**

2. Include all construction access and haul roads, staging and storage areas on the GEC Plan. If roads for equipment access need to be built to the channel bottom, include description of the locations, design and restoration in the SWMP narrative and show on the GEC Plan. **RE: access shown on plan. Narrative added to indicated contractor to provide haul road and access to bottom of channel in their swmp.**
3. Include all relevant GEC and SWMP checklist items; missing, incomplete, and unclear items are highlighted on the checklists. A short notation/explanation must be provided for items that are not applicable. **RE: SWMP updated**
4. Note: some SWMP checklist items (including items 5, 6, 10, 16 and 24) may be deferred to the contractor. If certain items are deferred, provide a note on the GEC Plan specifying that they will be required on the contractor's SWMP at the time construction begins. **RE: note placed on plan.**

Forms/FAE/SIA

1. Provide a separate breakdown of the bridge line item costs. Attach to the FAE for reference. **RE: attached to egf.**
2. See FAE electronic redlines. **RE: electric conduit not needed. Barricades provided with CM South. Ultimate Wq facilities are Pond C1, Pond G1/G2, and Pond C3. All WQ ponds are existing. Will use sediment pond in interim for WQ. When Lorson is constructed to the east flow will flow east in curb to inlets draining to Pond C1.**
3. Note: Per development agreement requirements, the bridge improvements need to be completed prior to any additional lots being platted to the east. If the improvements are not complete and accepted prior to an additional subdivision being platted, the Subdivision Improvements Agreement (SIA) for that subdivision will need to include the remaining improvements and/or warranty period, as allowed by the Board of County Commissioners. **RE: noted**
4. See redline on Letter of Intent (typo). **RE: length changed**

COLORADO DEPARTMENT OF TRANSPORTATION

I am in receipt of a referral request for comment of the subject development. CDOT understands the Lorson Boulevard Bridge over Jimmy Camp Creek Main Channel construction is situated at Lorson Boulevard, generally located east of State Highway 21 and Fontaine Boulevard. CDOT's comments are as follows;

- The Region 2 Hydraulics Unit has reviewed the "Final Bridge Hydrology and Hydraulics Report" from Loris and Associates Inc. dated September 25, 2017 and has no comments.

Furthermore, the subject development will not have a significant impact on the State Highway system, therefore no further comments from CDOT will be necessary.

Please contact me in Pueblo at (719) 562-5537 with any questions.

Sincerely,

Andrew Lewis
Asst. Access Manager

ELPASO COUNTY COMMUNITY SERVICES DEPARTMENT ENVIRONMENTAL

The El Paso County Environmental Division has completed its review of the Jimmy Camp Creek Main Channel Lorson Blvd Bridge CDR17007. Our review consisted of the following items: wetlands, federal and state listed threatened or endangered species, general wildlife resources and noxious weeds.

1. A completed U.S. Army Corps of Engineers (USCOE) permit shall be provided to the Planning and Community Development Department prior to project commencement if ground-disturbing activities will occur in wetland areas. Alternatively, a letter from a qualified wetland scientist indicating why such a permit is not required for this project will be acceptable. The applicant is hereby on notice that the USCOE has regulatory jurisdiction over wetlands. It is the applicant's responsibility, and not El Paso County's, to ensure compliance with all applicable laws and regulations, including, but not limited to, the Clean Water Act. **RE: no wetlands are present. Letter will be provided in CLOMR**

2. Documentation from the U.S. Fish and Wildlife Service (USFWS) shall be provided to the Planning and Community Development Department prior to project commencement where the project will result in ground disturbing activity in habitat occupied or potentially occupied by threatened or endangered species and/or where development will occur within 300 feet of the centerline of a stream or within 300 feet of the 100 year floodplain, whichever is greater. The applicant is hereby on notice that the USFWS has regulatory jurisdiction over threatened and endangered species and migratory birds, respectively. It is the applicant's responsibility, and not El Paso County's, to ensure compliance with all applicable laws and regulations, including but not limited to, the Endangered Species Act and the Migratory Bird Treaty Act. **RE: noted**

It is strongly recommended that the applicant obtain the necessary approvals from all federal, state and county agencies as a part of their planning process.

CONSTRUCTION PLANS
FOR


LORSON BLVD BRIDGE OVER JIMMY CAMP CREEK MAIN CHANNEL

FINAL GRADING/EROSION CONTROL PLAN



Know what's below.
Call before you dig.

CALL 2-BUSINESS DAYS IN ADVANCE
BEFORE YOU DIG, GRADE OR
EXCAVATE FOR THE MARKING OF
UNDERGROUND MEMBER UTILITIES

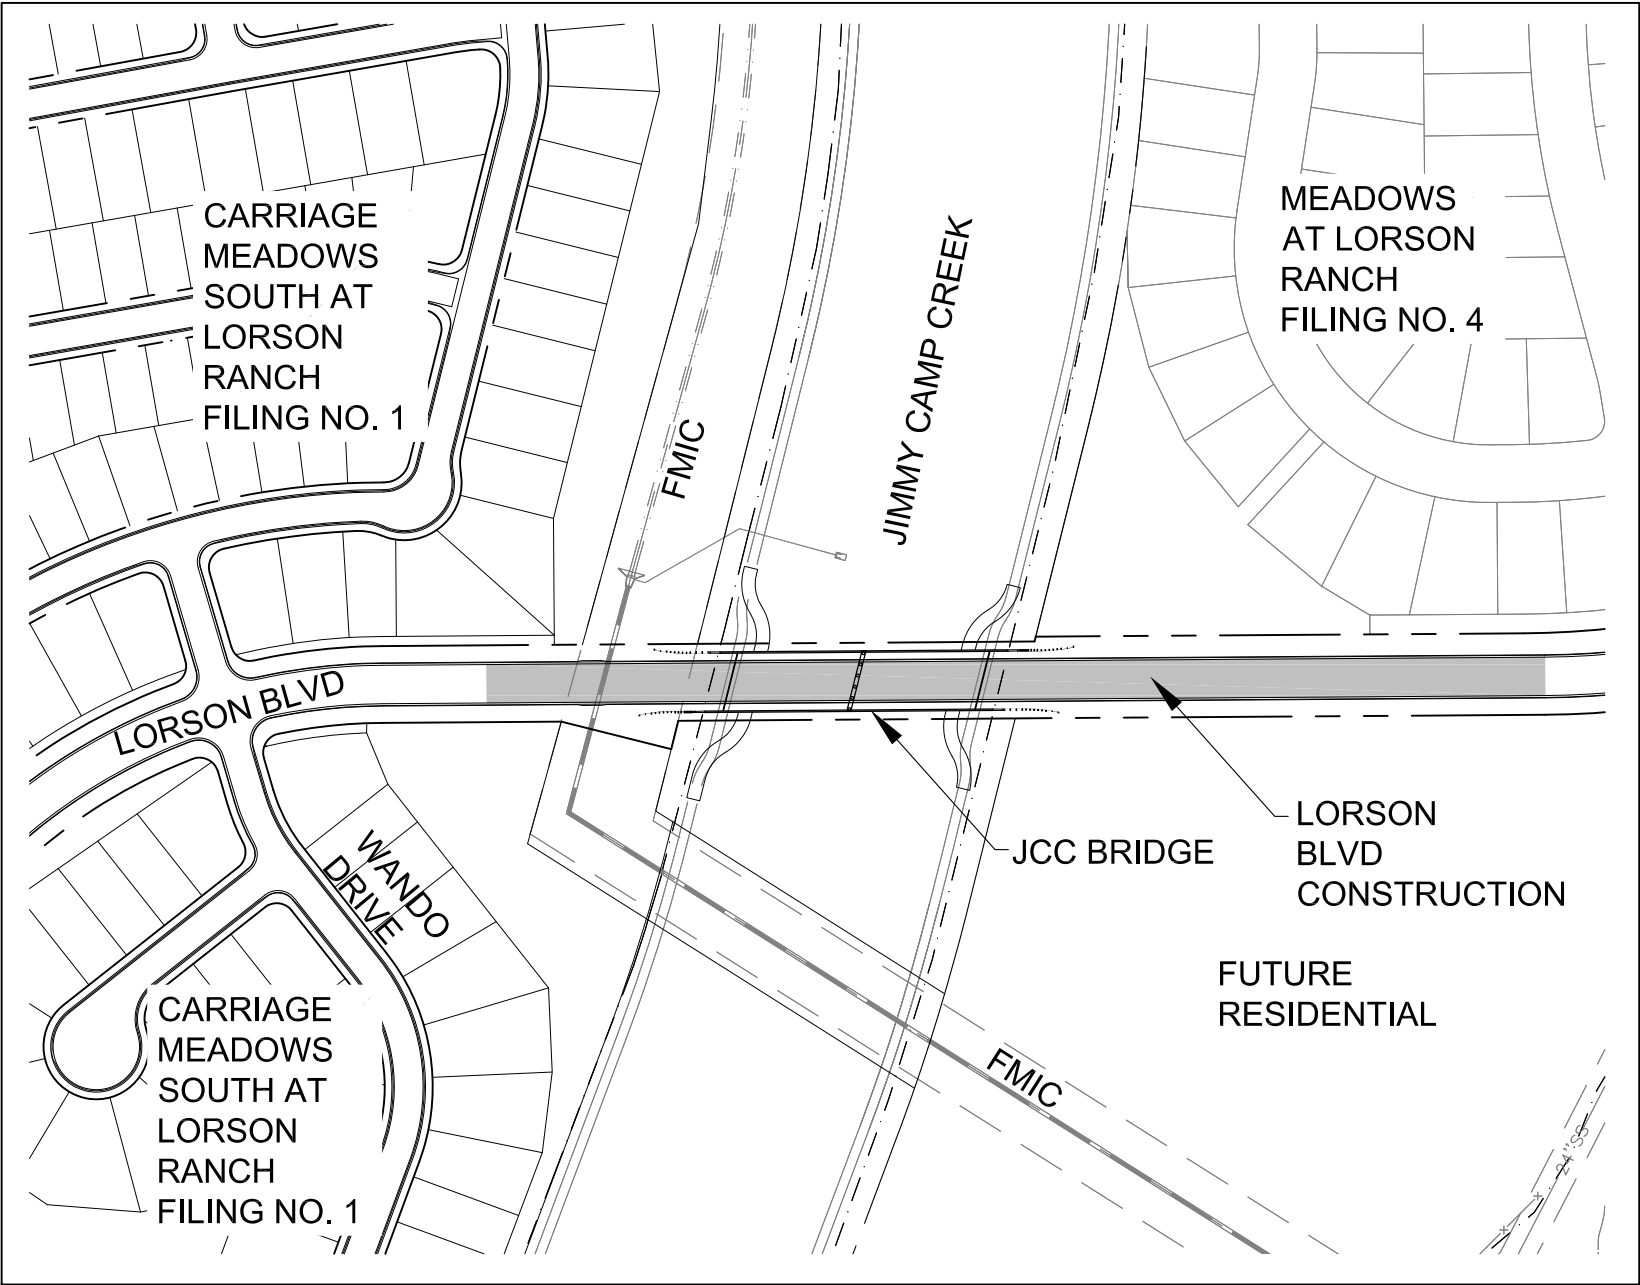

KEY MAP
SCALE: 1"=200'



VICINITY MAP
NO SCALE

SHEET INDEX	
SHEET NO.	SHEET DESCRIPTION
1	COVER SHEET
2	NOTES - GRADING/EROSION CONTROL PLAN
3	GRADING & EROSION CONTROL PLAN
4	GRADING/EROSION CONTROL DETAILS

DEVELOPER'S STATEMENT

THE UNDERSIGNED OWNER/DEVELOPER HAS READ AND WILL COMPLY WITH ALL THE REQUIREMENTS SPECIFIED IN THESE CONSTRUCTION PLANS AND THE ACCOMPANYING DRAINAGE REPORT.

BUSINESS NAME LORSON, LLC

BY _____ DATE _____

TITLE _____

ADDRESS 212 N. WAHSATCH AVE., SUITE 301
COLORADO SPRINGS, CO 80903

WATER / SANITARY
WIDEFIELD WATER AND SANITATION DISTRICT
37 WIDEFIELD BLVD.
SECURITY, CO 80911
719-390-7111

CABLE
COMCAST
P.O. BOX 173838
DENVER, CO 80217
970-641-4774

ELECTRIC
MOUNTAIN VIEW ELECTRIC
11140 E. WOODMEN RD.
COLORADO SPRINGS, CO 80831
719-495-2283

SECURITY FIRE PROTECTION DISTRICT
400 SECURITY BOULEVARD
SECURITY, CO 80911
719-392-7121

TELEPHONE
CENTURYLINK
7925 INDUSTRY ROAD
COLORADO SPRINGS, CO 80939
719-278-4651

GAS
BLACK HILLS ENGERGY
7060 ALLEGRE ST.
FOUNTAIN, CO 80817
719-393-6639

EL PASO COUNTY
PLANNING AND COMMUNITY DEVELOPMENT
2880 INTERNATIONAL CIRCLE
COLORADO SPRINGS, CO 80910
719-520-6300

BASIS OF BEARING

BEARINGS ARE BASED ON THE SOUTH LINE OF THE NORTH HALF OF SECTION 23, TOWNSHIP 15 SOUTH, RANGE 65 WEST OF THE 6TH PRINCIPAL MERIDIAN AS BEING SOUTH 89°41'52" WEST. THE EAST QUARTER CORNER OF SAID SECTION 23 IS A FOUND 3-1/2" ALUMINUM CAP MONUMENT AND THE WEST QUARTER CORNER OF SAID SECTION 23 IS A FOUND 2-1/2" ALUMINUM CAP MONUMENT

BENCHMARK

FIMS MONUMENT F204 LOCATED AT THE NORTHWEST CORNER OF FONTAINE BLVD AND COTTONWOOD GROVE DR. ELEVATION 5724.072 (N.G.V.D. 29)

TRAFFIC CONTROL NOTE

THE CONTRACTOR SHALL PROVIDE ALL TRAFFIC CONTROL DEVICES AND MONITORING NECESSARY TO SAFELY COMPLETE THE WORK SHOWN IN THESE CONSTRUCTION DOCUMENTS IN CONFORMANCE WITH M.U.T.C.D. GUIDELINES. THE CONTRACTOR SHALL COMPLETE ALL NECESSARY WORK FOR PLAN REVIEW, PERMITS AND PROCESSING. TRAFFIC CONTROL WILL NOT BE PAID SEPARATELY BUT IS INCLUDED IN THE COST OF THE PROJECT.

PREPARED FOR:
LORSON, LLC
212 N. WAHSATCH AVE., SUITE 301
COLORADO SPRINGS, CO 80903
719-635-3200
CONTACT: JEFF MARK

PREPARED BY:
CORE ENGINEERING GROUP
15004 1ST AVENUE S.
BURNSVILLE, MN 55306
719-570-1100
CONTACT: RICHARD L. SCHINDLER P.E.

LORIS & ASSOCIATES
100 SUPERIOR PLAZA WAY, SUITE 220
SUPERIOR, CO, 80027
303-444-2073
CONTACT: DAN BELTZER P.E.

Use standard GEC Plan signature blocks.

CONSTRUCTION APPROVAL

COUNTY PLAN REVIEW IS PROVIDED ONLY FOR GENERAL CONFORMANCE WITH COUNTY DESIGN CRITERIA. THE COUNTY IS NOT RESPONSIBLE FOR THE ACCURACY AND ADEQUACY OF THE DESIGN, DIMENSIONS, AND/OR ELEVATIONS WHICH SHALL BE CONFIRMED AT THE JOB SITE. THE COUNTY THROUGH THE APPROVAL OF THIS DOCUMENT ASSUMES NO RESPONSIBILITY FOR COMPLETENESS AND/OR ACCURACY OF THIS DOCUMENT.

FILED IN ACCORDANCE WITH THE REQUIREMENTS OF THE EL PASO COUNTY LAND DEVELOPMENT CODE, DRAINAGE CRITERIA MANUALS VOLUME 1 AND 2, AND ENGINEERING CRITERIA MANUAL AS AMENDED. CONSTRUCTION DOCUMENTS WILL BE VALID FOR A PERIOD OF 2 YEARS FROM THE DATE SIGNED BY THE EL PASO COUNTY ENGINEER.

JENNIFER IRVINE, COUNTY ENGINEER/ECM ADMINISTRATOR DATE
CONDITIONS:

ENGINEER'S APPROVAL

THESE DETAILED PLANS AND SPECIFICATIONS WERE PREPARED UNDER MY DIRECTION AND SUPERVISION. SAID PLANS AND SPECIFICATIONS HAVE BEEN PREPARED ACCORDING TO THE CRITERIA ESTABLISHED BY THE COUNTY FOR DETAILED ROADWAY, DRAINAGE, GRADING AND EROSION CONTROL PLANS AND SPECIFICATIONS, AND SAID PLANS AND SPECIFICATIONS ARE IN CONFORMITY WITH APPLICABLE MASTER DRAINAGE PLANS AND MASTER TRANSPORTATION PLANS. SAID PLANS AND SPECIFICATIONS MEET THE PURPOSES FOR WHICH THE PARTICULAR ROADWAY AND DRAINAGE FACILITIES ARE DESIGNED AND ARE CORRECT TO THE BEST OF MY KNOWLEDGE AND BELIEF. I ACCEPT RESPONSIBILITY FOR ANY LIABILITY CAUSED BY ANY NEGLIGENT ACTS, ERRORS OR OMISSIONS ON MY PART IN PREPARATION OF THESE DETAILED PLANS AND SPECIFICATIONS.

RICHARD L. SCHINDLER, P.E. # 33997
FOR AND ON BEHALF OF CORE ENGINEERING GROUP

CORE ENGINEERING GROUP

15004 1ST AVENUE S.
BURNSVILLE, MN 55306
PH: 719-570-1100
CONTACT: RICHARD L. SCHINDLER, P.E.
EMAIL: Rich@ceg1.com

DATE

X

DESCRIPTION

NO.

1.

PROJECT:

LORSON, LLC
212 N. WAHSATCH AVE., SUITE 301
COLORADO SPRINGS, COLORADO 80903
(719) 635-3200
CONTACT: JEFF MARK

PREPARED FOR:

JCC BRIDGE
JCC MAIN CHANNEL - LORSON BLVD.
EL PASO COUNTY, COLORADO

DRAWN: LIA
DESIGNED: RLS
CHECKED: RLS

COVER SHEET

BRIDGE AT JCC MAIN CHANNEL

GRADING AND EROSION CONTROL PLANS

DATE

SEPT 15, 2017

PROJECT NO.

100.030

SHEET NUMBER

1

TOTAL SHEETS:

4

CONSTRUCTION NOTES

1. ALL WORK SHALL COMPLY WITH THE CODES AND POLICIES FOR EL PASO COUNTY.
2. EXISTING TOPOGRAPHIC INFORMATION SHOWN ON THIS GRADING PLAN WAS OBTAINED FROM DREXEL, BARRELL & CO., JULY, 2005. THE CONTRACTOR SHALL BE RESPONSIBLE TO EXAMINE THE SITE AND BE FAMILIAR WITH THE EXISTING CONDITIONS.
3. DEPTH OF MOISTURE-DENSITY CONTROL FOR THIS PROJECT SHALL BE AS FOLLOWS:
BASE OF ALL CUTS AND FILLS - 12 INCHES,
FULL DEPTH OF ALL EMBANKMENTS
4. THE CONTRACTOR IS RESPONSIBLE FOR THE RE-ESTABLISHMENT OF ALL SURVEY MONUMENTS DISTURBED WITHIN THE PROJECT LIMITS.
5. THE CONTRACTOR SHALL PROTECT ALL WORK AREAS AND FACILITIES FROM FLOODING AT ALL TIMES. AREAS AND FACILITIES SUBJECTED TO FLOODING, REGARDLESS OF THE SOURCE OF WATER, SHALL BE PROMPTLY DEWATERED AND RESTORED.
6. PRIOR TO PAVING OPERATIONS, THE ENTIRE SUBGRADE SHALL BE PROOF-ROLLED WITH A LOADED 988 FRONT-END LOADER OR SIMILAR HEAVY RUBBER TIRED VEHICLE (GVW OF 50,000 POUNDS WITH 18 KIP PER AXLE AT TIRE PRESSURES OF 90 PSI) TO DETECT ANY SOFT OR LOOSE AREAS. IN AREAS WHERE SOFT OR LOOSE SOILS, PUMPING OR EXCESSIVE MOVEMENT IS OBSERVED, THE EXPOSED MATERIALS SHALL BE OVER-EXCAVATED TO A MINIMUM DEPTH OF TWO FEET BELOW PROPOSED FINAL GRADE OR TO A DEPTH AT WHICH SOILS ARE STABLE. AFTER THIS HAS BEEN COMPLETED, THE EXPOSED MATERIALS SHALL BE SCARIFIED TO A DEPTH OF 12 INCHES AND MOISTURE CONDITIONED. THE SUBGRADE SHALL THEN BE UNIFORMLY COMPACTED TO A MINIMUM OF 95% OF STANDARD PROCTOR DENSITY (ASTM D-698) AT 0 TO +4.0% OF OPTIMUM MOISTURE CONTENT FOR A-6 AND A-7-6 SOILS ENCOUNTERED. OTHER SUBGRADE TYPES SHALL BE UNIFORMLY COMPACTED TO A MINIMUM OF 95% OF MODIFIED PROCTOR DENSITY (ASTM D-1557) AT PLUS OR MINUS 2.0% OF OPTIMUM MOISTURE CONTENT. AREAS WHERE STABLE NATURAL SOILS ARE ENCOUNTERED AT PROPOSED SUBGRADE ELEVATION SHALL ALSO BE SCARIFIED (18 INCHES FOR A-7-6 SOILS BELOW FULL-DEPTH ASPHALT CONCRETE) AND COMPACTED AS OUTLINED ABOVE PRIOR TO PAVING OPERATIONS. SUBGRADE FILL SHALL BE PLACED IN SIX-INCH LIFTS AND UNIFORMLY COMPACTED, MEETING THE REQUIREMENTS AS PREVIOUSLY DESCRIBED.
7. SUBGRADE MATERIALS DEEMED UNSUITABLE BY THE ENGINEER SHALL BE EXCAVATED, DISPOSED OF AND REPLACED WITH APPROVED MATERIALS.
8. FILL SHALL BE PLACED IN 8-INCH MAXIMUM LOOSE LIFTS AND SHALL BE COMPACTED PRIOR TO SUCCESSIVE LIFTS.
9. THE CONTRACTOR IS RESPONSIBLE FOR PREVENTING AND CONTROLLING EROSION DURING CONSTRUCTION ACTIVITIES AT ALL TIMES DURING GRADING AND CONSTRUCTION. THE CONTRACTOR SHALL PROVIDE THE FOLLOWING EROSION AND SEDIMENT CONTROL MEASURES:
 - HAY BALE BARRIERS WHERE NEEDED AND/OR AS DIRECTED BY THE ENGINEER.
 - SILT FENCE WHERE NEEDED AND/OR AS DIRECTED BY THE ENGINEER.
 - TEMPORARY SEDIMENTATION BASINS WHERE NEEDED AND/OR AS DIRECTED BY THE ENGINEER.
 - MULCHING AND SEEDING OF EXCESSIVE SLOPED AREAS AS NEEDED OR AS DIRECTED BY THE ENGINEER.
 - TEMPORARY VEHICLE TRACKING CONTROL AS NEEDED AND/OR DIRECTED BY THE ENGINEER.
 - CONCRETE WASH AREAS.
 - INLET PROTECTION.
- THESE AND ALL EROSION CONTROL BEST MANAGEMENT PRACTICES AS SHOWN IN THE GRADING AND EROSION CONTROL PLANS SHALL BE STRICTLY ADHERED TO.
10. FINISHED CONTOURS/SPOT ELEVATIONS SHOWN HEREON REPRESENT FINISHED GRADES. ALL PAVEMENT SUBGRADES ARE BASED ON THE COMPOSITE ASPHALT PAVEMENT RECOMMENDATIONS MADE IN THE "GEOTECHNICAL STUDY" FOR LORSON RANCH.



EL PASO COUNTY STANDARD CONSTRUCTION NOTES:

1. ALL DRAINAGE AND ROADWAY CONSTRUCTION SHALL MEET THE STANDARDS AND SPECIFICATIONS OF THE CITY OF COLORADO SPRINGS/EL PASO COUNTY DRAINAGE CRITERIA MANUAL, VOLUMES 1 AND 2, AND THE EL PASO COUNTY ENGINEERING CRITERIA MANUAL.
2. CONTRACTOR SHALL BE RESPONSIBLE FOR THE NOTIFICATION AND FIELD NOTIFICATION OF ALL EXISTING UTILITIES, WHETHER SHOWN ON THE PLANS OR NOT, BEFORE BEGINNING CONSTRUCTION. LOCATION OF EXISTING UTILITIES SHALL BE VERIFIED BY THE CONTRACTOR PRIOR TO CONSTRUCTION. CALL 811 TO CONTACT THE UTILITY NOTIFICATION CENTER OF COLORADO (UNCC).
3. CONTRACTOR SHALL KEEP A COPY OF THESE APPROVED PLANS, THE GRADING AND EROSION CONTROL PLAN, THE STORMWATER MANAGEMENT PLAN (SWMP), THE SOILS AND GEOTECHNICAL REPORT, AND THE APPROPRIATE DESIGN AND CONSTRUCTION STANDARDS AND SPECIFICATIONS AT THE JOB SITE AT ALL TIMES, INCLUDING THE FOLLOWING:
 - a. EL PASO COUNTY ENGINEERING CRITERIA MANUAL (ECM)
 - b. CITY OF COLORADO SPRINGS/EL PASO COUNTY DRAINAGE CRITERIA MANUAL, VOLUMES 1 AND 2
 - c. COLORADO DEPARTMENT OF TRANSPORTATION (CDOT) STANDARD SPECIFICATIONS FOR ROAD AND BRIDGE CONSTRUCTION
 - d. CDOT M & S STANDARDS
4. NOTWITHSTANDING ANYTHING DEPICTED IN THESE PLANS IN WORDS OR GRAPHIC REPRESENTATION, ALL DESIGN AND CONSTRUCTION RELATED TO ROADS, STORM DRAINAGE AND EROSION CONTROL SHALL CONFORM TO THE STANDARDS AND REQUIREMENTS OF THE MOST RECENT VERSION OF THE RELEVANT ADOPTED EL PASO COUNTY STANDARDS, INCLUDING THE LAND DEVELOPMENT CODE, THE ENGINEERING CRITERIA MANUAL, THE DRAINAGE CRITERIA MANUAL, AND THE DRAINAGE CRITERIA MANUAL VOLUME 2. ANY DEVIATIONS FROM REGULATIONS AND STANDARDS MUST BE REQUESTED, AND APPROVED, IN WRITING. ANY MODIFICATIONS NECESSARY TO MEET CRITERIA AFTER-THE-FACT WILL BE ENTIRELY THE DEVELOPER'S RESPONSIBILITY TO RECTIFY.
5. IT IS THE DESIGN ENGINEER'S RESPONSIBILITY TO ACCURATELY SHOW EXISTING CONDITIONS, BOTH ONSITE AND OFFSITE, ON THE CONSTRUCTION PLANS. ANY MODIFICATIONS NECESSARY DUE TO CONFLICTS, OMISSIONS, OR CHANGED CONDITIONS WILL BE ENTIRELY THE DEVELOPER'S RESPONSIBILITY TO RECTIFY.
6. CONTRACTOR SHALL SCHEDULE A PRE-CONSTRUCTION MEETING WITH EL PASO COUNTY PLANNING AND COMMUNITY DEVELOPMENT (PCD) – INSPECTIONS, PRIOR TO STARTING CONSTRUCTION.
7. IT IS THE CONTRACTOR'S RESPONSIBILITY TO UNDERSTAND THE REQUIREMENTS OF ALL JURISDICTIONAL AGENCIES AND TO OBTAIN ALL REQUIRED PERMITS, INCLUDING BUT NOT LIMITED TO EL PASO COUNTY EROSION AND STORMWATER QUALITY CONTROL PERMIT (ESQCP), REGIONAL BUILDING FLOODPLAIN DEVELOPMENT PERMIT, U.S. ARMY CORPS OF ENGINEERS—ISSUED 401 AND/OR 404 PERMITS, AND COUNTY AND STATE FUGITIVE DUST PERMITS.
8. CONTRACTOR SHALL NOT DEVIATE FROM THE PLANS WITHOUT FIRST OBTAINING WRITTEN APPROVAL FROM THE DESIGN ENGINEER AND PCD. CONTRACTOR SHALL NOTIFY THE DESIGN ENGINEER IMMEDIATELY UPON DISCOVERY OF ANY ERRORS OR INCONSISTENCIES.
9. ALL STORM DRAIN PIPE SHALL BE CLASS III RCP UNLESS OTHERWISE NOTED AND APPROVED BY PCD.
10. CONTRACTOR SHALL COORDINATE GEOTECHNICAL TESTING PER ECM STANDARDS. PAVEMENT DESIGN SHALL BE APPROVED BY EL PASO COUNTY PCD PRIOR TO PLACEMENT OF CURB AND GUTTER AND PAVEMENT.
11. ALL CONSTRUCTION TRAFFIC MUST ENTER/EXIT THE SITE AT APPROVED CONSTRUCTION ACCESS POINTS.
12. SIGHT VISIBILITY TRIANGLES AS IDENTIFIED IN THE PLANS SHALL BE PROVIDED AT ALL INTERSECTIONS. OBSTRUCTIONS GREATER THAN 18 INCHES ABOVE FLOWLINE ARE NOT ALLOWED WITHIN SIGHT TRIANGLES.
13. SIGNING AND STRIPING SHALL COMPLY WITH EL PASO COUNTY PUBLIC WORK DEPARTMENT AND MUTCD CRITERIA.
14. CONTRACTOR SHALL OBTAIN ANY PERMITS REQUIRED BY EL PASO COUNTY PWD, INCLUDING WORK WITHIN THE RIGHT-OF-WAY AND SPECIAL TRANSPORT PERMITS.
15. THE LIMITS OF CONSTRUCTION SHALL REMAIN WITHIN THE PROPERTY LINE UNLESS OTHERWISE NOTED. THE OWNER/DEVELOPER SHALL OBTAIN WRITTEN PERMISSION AND EASEMENTS, WHERE REQUIRED, FROM ADJOINING PROPERTY OWNER(S) PRIOR TO ANY OFF-SITE DISTURBANCE, GRADING, OR CONSTRUCTION.

STANDARD NOTES FOR EL PASO COUNTY GRADING AND EROSION CONTROL PLANS

- CONSTRUCTION MAY NOT COMMENCE UNTIL A CONSTRUCTION PERMIT IS OBTAINED FROM PCD AND A PRECONSTRUCTION CONFERENCE IS HELD WITH PCD INSPECTIONS.
2. STORMWATER DISCHARGES FROM CONSTRUCTION SITES SHALL NOT CAUSE OR THREATEN TO CAUSE POLLUTION, CONTAMINATION, OR DEGRADATION OF STATE WATERS. ALL WORK AND EARTH DISTURBANCE SHALL BE DONE IN A MANNER THAT MINIMIZES POLLUTION OF ANY ON-SITE OR OFF SITE WATERS, INCLUDING WETLANDS.
3. NOTWITHSTANDING ANYTHING DEPICTED IN THESE PLANS IN WORDS OR GRAPHIC REPRESENTATION, ALL DESIGN AND CONSTRUCTION RELATED TO ROADS, STORM DRAINAGE AND EROSION CONTROL SHALL CONFORM TO THE STANDARDS AND REQUIREMENTS OF THE MOST RECENT VERSION OF THE RELEVANT ADOPTED EL PASO COUNTY STANDARDS, INCLUDING THE LAND DEVELOPMENT CODE, THE ENGINEERING CRITERIA MANUAL, THE DRAINAGE CRITERIA MANUAL, AND THE DRAINAGE CRITERIA MANUAL VOLUME 2. ANY DEVIATIONS FROM REGULATIONS AND STANDARDS MUST BE REQUESTED, AND APPROVED, IN WRITING.
4. A SEPARATE STORMWATER MANAGEMENT PLAN (SWMP) FOR THIS PROJECT SHALL BE COMPLETED AND AN EROSION AND STORMWATER QUALITY CONTROL PERMIT (ESQCP) ISSUED PRIOR TO COMMENCING CONSTRUCTION. DURING CONSTRUCTION THE SWMP IS THE RESPONSIBILITY OF THE DESIGNATED STORMWATER MANAGER, SHALL BE LOCATED ON SITE AT ALL TIMES AND SHALL BE KEPT UP TO DATE WITH WORK PROGRESS AND CHANGES IN THE FIELD.
5. ONCE THE ESQCP HAS BEEN ISSUED, THE CONTRACTOR MAY INSTALL THE INITIAL STAGE EROSION AND SEDIMENT CONTROL BMPs AS INDICATED ON THE GEC. A PRECONSTRUCTION MEETING BETWEEN THE CONTRACTOR, ENGINEER, AND EL PASO COUNTY WILL BE HELD PRIOR TO ANY CONSTRUCTION. IT IS THE RESPONSIBILITY OF THE APPLICANT TO COORDINATE THE MEETING TIME AND PLACE WITH COUNTY PCD INSPECTIONS STAFF.
6. SOIL EROSION CONTROL MEASURES FOR ALL SLOPES, CHANNELS, DITCHES, OR ANY DISTURBED LAND AREA SHALL BE COMPLETED WITHIN 21 CALENDAR DAYS AFTER FINAL GRADING, OR FINAL EARTH DISTURBANCE, HAS BEEN COMPLETED. DISTURBED AREAS AND STOCKPILES WHICH ARE NOT AT FINAL GRADE BUT WILL REMAIN DORMANT FOR LONGER THAN 30 DAYS SHALL ALSO BE MULCHED WITHIN 21 DAYS AFTER INTERIM GRADING. AN AREA THAT IS GOING TO REMAIN IN AN INTERIM STATE FOR MORE THAN 60 DAYS SHALL ALSO BE SEEDED. ALL TEMPORARY SOIL EROSION CONTROL MEASURES AND BMPs SHALL BE MAINTAINED UNTIL PERMANENT SOIL EROSION CONTROL MEASURES ARE IMPLEMENTED AND ESTABLISHED.
7. TEMPORARY SOIL EROSION CONTROL FACILITIES SHALL BE REMOVED AND EARTH DISTURBANCE AREAS GRADED AND STABILIZED WITH PERMANENT SOIL EROSION CONTROL MEASURES PURSUANT TO STANDARDS AND SPECIFICATION PRESCRIBED IN THE DCM VOLUME II AND THE ENGINEERING CRITERIA MANUAL (ECM) APPENDIX I.
8. ALL PERSONS ENGAGED IN EARTH DISTURBANCE SHALL IMPLEMENT AND MAINTAIN ACCEPTABLE SOIL EROSION AND SEDIMENT CONTROL MEASURES INCLUDING BMPs IN CONFORMANCE WITH THE EROSION CONTROL TECHNICAL STANDARDS OF THE DRAINAGE CRITERIA MANUAL (DCM) VOLUME II AND IN ACCORDANCE WITH THE STORMWATER MANAGEMENT PLAN (SWMP).
9. ALL TEMPORARY EROSION CONTROL FACILITIES INCLUDING BMPs AND ALL PERMANENT FACILITIES INTENDED TO CONTROL EROSION OF ANY EARTH DISTURBANCE OPERATIONS, SHALL BE INSTALLED AS DEFINED IN THE APPROVED PLANS, THE SWMP AND THE DCM VOLUME II AND MAINTAINED THROUGHOUT THE DURATION OF THE EARTH DISTURBANCE OPERATION.
10. ANY EARTH DISTURBANCE SHALL BE CONDUCTED IN SUCH A MANNER SO AS TO EFFECTIVELY REDUCE ACCELERATED SOIL EROSION AND RESULTING SEDIMENTATION. ALL DISTURBANCES SHALL BE DESIGNED, CONSTRUCTED, AND COMPLETED SO THAT THE EXPOSED AREA OF ANY DISTURBED LAND SHALL BE LIMITED TO THE SHORTEST PRACTICAL PERIOD OF TIME.
11. ANY TEMPORARY OR PERMANENT FACILITY DESIGNED AND CONSTRUCTED FOR THE CONVEYANCE OF STORMWATER AROUND, THROUGH, OR FROM THE EARTH DISTURBANCE AREA SHALL BE DESIGNED TO LIMIT THE DISCHARGE TO A NON-EROSIVE VELOCITY.
12. CONCRETE WASH WATER SHALL BE CONTAINED AND DISPOSED OF IN ACCORDANCE WITH THE SWMP. NO WASH WATER SHALL BE DISCHARGED TO OR ALLOWED TO RUNOFF TO STATE WATERS, INCLUDING ANY SURFACE OR SUBSURFACE STORM DRAINAGE SYSTEM OR FACILITIES.
13. EROSION CONTROL BLANKETING SHALL BE USED ON SLOPES STEEPER THAN 3:1.
14. BUILDING, CONSTRUCTION, EXCAVATION, OR OTHER WASTE MATERIALS SHALL NOT BE TEMPORARILY PLACED OR STORED IN THE STREET, ALLEY, OR OTHER PUBLIC WAY, UNLESS IN ACCORDANCE WITH AN APPROVED TRAFFIC CONTROL PLAN. BMPs MAY BE REQUIRED BY EL PASO COUNTY PCD IF DEEMED NECESSARY, BASED ON SPECIFIC CONDITIONS AND CIRCUMSTANCES.
15. VEHICLE TRACKING OF SOILS AND CONSTRUCTION DEBRIS OFF-SITE SHALL BE MINIMIZED. MATERIALS TRACKED OFFSITE SHALL BE CLEANED UP AND PROPERLY DISPOSED OF IMMEDIATELY.
16. CONTRACTOR SHALL BE RESPONSIBLE FOR THE REMOVAL OF ALL WASTES FROM THE CONSTRUCTION SITE FOR DISPOSAL IN ACCORDANCE WITH LOCAL AND STATE REGULATORY REQUIREMENTS. NO CONSTRUCTION DEBRIS, TREE SLASH, BUILDING MATERIAL WASTES OR UNUSED BUILDING MATERIALS SHALL BE BURIED, DUMPED, OR DISCHARGED AT THE SITE.
17. THE OWNER, SITE DEVELOPER, CONTRACTOR, AND/OR THEIR AUTHORIZED AGENTS SHALL BE RESPONSIBLE FOR THE REMOVAL OF ALL CONSTRUCTION DEBRIS, DIRT, TRASH, ROCK, SEDIMENT, AND SAND THAT MAY ACCUMULATE IN THE STORM SEWER OR OTHER DRAINAGE CONVEYANCE SYSTEM AND STORMWATER APPURTENANCES AS A RESULT OF SITE DEVELOPMENT.
18. THE QUANTITY OF MATERIALS STORED ON THE PROJECT SITE SHALL BE LIMITED, AS MUCH AS PRACTICAL, TO THAT QUANTITY REQUIRED TO PERFORM THE WORK IN AN ORDERLY SEQUENCE. ALL MATERIALS STORED ON-SITE SHALL BE STORED IN A NEAT, ORDERLY MANNER, IN THEIR ORIGINAL CONTAINERS, WITH ORIGINAL MANUFACTURER'S LABELS.
19. NO CHEMICALS ARE TO BE USED BY THE CONTRACTOR, WHICH HAVE THE POTENTIAL TO BE RELEASED IN STORMWATER UNLESS PERMISSION FOR THE USE OF A SPECIFIC CHEMICAL IS GRANTED IN WRITING BY THE ECM ADMINISTRATOR. IN GRANTING THE USE OF SUCH CHEMICALS, SPECIAL CONDITIONS AND MONITORING MAY BE REQUIRED.
20. BULK STORAGE STRUCTURES FOR PETROLEUM PRODUCTS AND OTHER CHEMICALS SHALL HAVE ADEQUATE PROTECTION SO AS TO CONTAIN ALL SPILLS AND PREVENT ANY SPILLED MATERIAL FROM ENTERING STATE WATERS, INCLUDING ANY SURFACE OR SUBSURFACE STORM DRAINAGE SYSTEM OR FACILITIES.
21. NO PERSON SHALL CAUSE THE IMPEDIMENT OF STORMWATER FLOW IN THE FLOW LINE OF THE CURB AND GUTTER OR IN THE DITCHLINE.
22. INDIVIDUALS SHALL COMPLY WITH THE "COLORADO WATER QUALITY CONTROL ACT" (TITLE 25, ARTICLE 8, CRS), AND THE "CLEAN WATER ACT" (33 USC 1344), IN ADDITION TO THE REQUIREMENTS INCLUDED IN THE DCM VOLUME II AND THE ECM APPENDIX I. ALL APPROPRIATE PERMITS MUST BE OBTAINED BY THE CONTRACTOR PRIOR TO CONSTRUCTION (NPDES, FLOODPLAIN, 404, FUGITIVE DUST, ETC.). IN THE EVENT OF CONFLICTS BETWEEN THESE REQUIREMENTS AND LAWS, RULES, OR REGULATIONS OF OTHER FEDERAL, STATE, OR COUNTY AGENCIES, THE MORE RESTRICTIVE LAWS, RULES, OR REGULATIONS SHALL APPLY.
23. ALL CONSTRUCTION TRAFFIC MUST ENTER/EXIT THE SITE AT APPROVED CONSTRUCTION ACCESS POINTS.
24. PRIOR TO ACTUAL CONSTRUCTION THE PERMITTEE SHALL VERIFY THE LOCATION OF EXISTING UTILITIES.
25. A WATER SOURCE SHALL BE AVAILABLE ON SITE DURING EARTHWORK OPERATIONS AND UTILIZED AS REQUIRED TO MINIMIZE DUST FROM EARTHWORK EQUIPMENT AND WIND.
26. THE SOILS REPORT FOR THIS SITE HAS BEEN PREPARED BY RMG AND SHALL BE CONSIDERED A PART OF THESE PLANS.
27. AT LEAST TEN DAYS PRIOR TO THE ANTICIPATED START OF CONSTRUCTION, FOR PROJECTS THAT WILL DISTURB 1 ACRE OR MORE, THE OWNER OR OPERATOR OF CONSTRUCTION ACTIVITY SHALL SUBMIT A PERMIT APPLICATION FOR STORMWATER DISCHARGE TO THE COLORADO DEPARTMENT OF PUBLIC HEALTH AND ENVIRONMENT, WATER QUALITY DIVISION. THE APPLICATION CONTAINS CERTIFICATION OF COMPLETION OF A STORMWATER MANAGEMENT PLAN (SWMP), OF WHICH THIS GRADING AND EROSION CONTROL PLAN MAY BE A PART. FOR INFORMATION OR APPLICATION MATERIALS CONTACT:

COLORADO DEPARTMENT OF PUBLIC HEALTH AND ENVIRONMENT
WATER QUALITY CONTROL DIVISION
WQCD - PERMITS
4300 CHERRY CREEK DRIVE SOUTH
DENVER, CO 80246-1530
ATTN: PERMITS UNIT

<div><div><div><div>CORE</div><div>ENGINEERING GROUP</div></div></div><div><div>15004 1ST AVENUE S.</div><div>BURNSVILLE, MN 55306</div><div>PH: 719.570.1100</div><div>CONTACT: RICHARD L. SCHINDLER, P.E.</div><div>EMAIL: Rich@cegl.com</div></div></div>			
<div><div></div><div><div>DATE</div><div>X</div></div></div>			
<div><div><div>NO.</div><div>1.</div></div><div><div>X</div></div></div>			
<div><div><div>DESCRIPTION</div><div></div></div></div>			
<div><div><div>DRAWN:</div><div>RLS</div></div><div><div>DESIGNED:</div><div>RLS</div></div><div><div>CHECKED:</div><div>RLS</div></div></div>		<div><div>PROJECT:</div><div>JCC BRIDGE</div><div>JCC MAIN CHANNEL – LORSON BLVD.</div><div>EL PASO COUNTY, COLORADO</div></div>	
<div><div><div>PREPARED FOR:</div><div>LORSON, LLC</div><div>212 N. WAHSATCH AVE., SUITE 301</div><div>COLORADO SPRINGS, COLORADO 80903</div><div>(719) 635-3200</div><div>CONTACT: JEFF MARK</div></div></div>			
<div><div>NOTES - WATERMAIN, STREET, GRADING AND EROSION CONTROL</div><div>JCC BRIGE AT MAIN CHANNEL</div></div>			
<div>DATE</div> <div>SEPT 15, 2017</div>			
<div>PROJECT NO.</div> <div>100.030</div>			
<div>SHEET NUMBER</div> <div>2</div>			
TOTAL SHEETS:		4	

Markup Summary

dsdrice (10)




Subject: Text Box
Page Label: 1
Lock: Unlocked
Status:
Checkmark: Unchecked
Author: dsdrice
Date: 11/28/2017 9:27:20 AM
Color: ■

Use standard GEC Plan signature blocks.




Subject: Callout
Page Label: 2
Lock: Unlocked
Status:
Checkmark: Unchecked
Author: dsdrice
Date: 11/28/2017 1:39:37 PM
Color: ■

Include date.

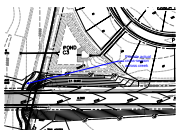


Subject: Callout
Page Label: 3
Lock: Unlocked
Status:
Checkmark: Unchecked
Author: dsdrice
Date: 11/28/2017 10:07:31 AM
Color: ■

Provide actual cross-section across creek

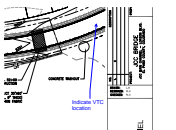


Subject: Callout
Page Label: 3
Lock: Unlocked
Status:
Checkmark: Unchecked
Author: dsdrice
Date: 11/28/2017 10:08:13 AM
Color: ■

Indicate VTC location

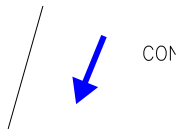


Subject: Arrow
Page Label: 3
Lock: Unlocked
Status:
Checkmark: Unchecked
Author: dsdrice
Date: 11/13/2017 4:20:08 PM
Color: ■

flow direction (?)

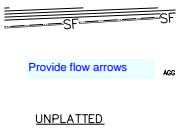


Subject: Text Box
Page Label: 3
Lock: Unlocked
Status:
Checkmark: Unchecked
Author: dsdrice
Date: 11/13/2017 4:15:58 PM
Color: ■

Provide flow arrows

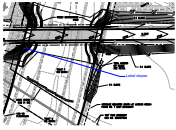


Subject: Callout
Page Label: 3
Lock: Unlocked
Status:
Checkmark: Unchecked
Author: dsdrice
Date: 11/13/2017 4:18:40 PM
Color: ■

Label slopes

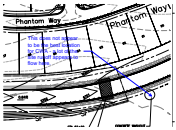

Subject: Callout
Page Label: 3
Lock: Unlocked
Status:
Checkmark: Unchecked
Author: dsdrice
Date: 11/28/2017 10:10:21 AM
Color: ■

This does not appear to be the best location for CWA - a lot of the site runoff appears to flow here.

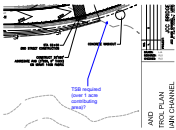

Subject: Callout
Page Label: 3
Lock: Unlocked
Status:
Checkmark: Unchecked
Author: dsdrice
Date: 11/27/2017 11:42:34 AM
Color: ■

TSB required (over 1 acre contributing area)?

Provide Temporary Sediment Basin

Subject: Text Box
Page Label: 4
Lock: Unlocked
Status:
Checkmark: Unchecked
Author: dsdrice
Date: 11/13/2017 4:22:15 PM
Color: ■

Provide Temporary Sediment Basin


CONSTRUCTION PLANS
FOR
LORSON BLVD BRIDGE OVER JIMMY CAMP CREEK MAIN CHANNEL

FINAL GRADING/EROSION CONTROL PLAN
WATERMAIN AND STREET CONSTRUCTION PLANS



Know what's below.
Call before you dig.

CALL 2-BUSINESS DAYS IN ADVANCE
BEFORE YOU DIG, GRADE OR
EXCAVATE FOR THE MARKING OF
UNDERGROUND MEMBER UTILITIES

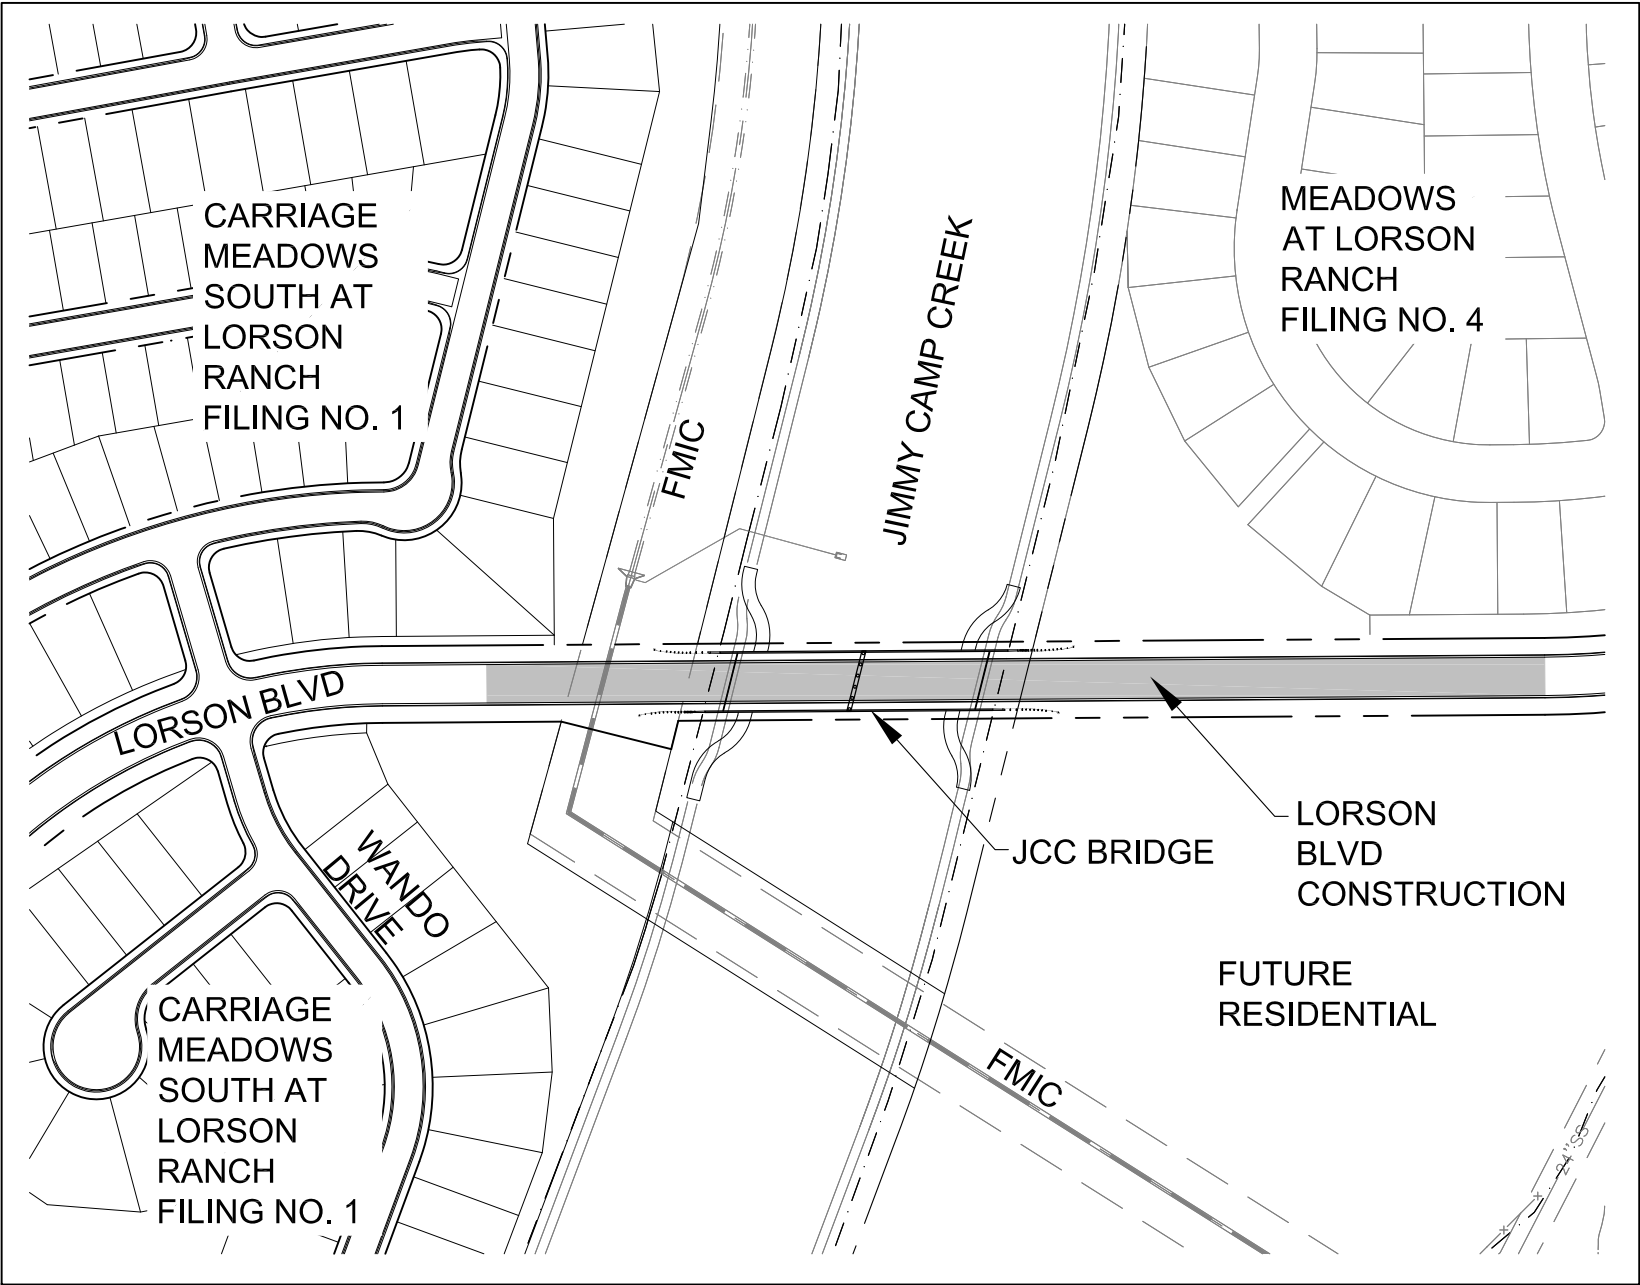

KEY MAP
SCALE: 1"=200'



VICINITY MAP
NO SCALE

SHEET INDEX	
SHEET NO.	SHEET DESCRIPTION
C1.1	COVER SHEET
C1.2	NOTES - GRADING/E.C., STREET, WATERMAIN
C1.3	WATERMAIN DETAILS & STREET TYPICAL SECTION
C4.1	GRADING & EROSION CONTROL PLAN
C6.1-C6.2	STREET PLAN AND PROFILE
C8.1-C8.2	WATERMAIN PLAN AND PROFILE
C12.1	GRADING/EROSION CONTROL DETAILS
B01-B27	JCC BRIDGE PLANS - LORIS & ASSOCIATES

DEVELOPER'S STATEMENT

THE UNDERSIGNED OWNER/DEVELOPER HAS READ AND WILL COMPLY WITH ALL THE REQUIREMENTS SPECIFIED IN THESE CONSTRUCTION PLANS AND THE ACCOMPANYING DRAINAGE REPORT.

BUSINESS NAME LORSON, LLC

BY _____ DATE _____

TITLE _____

ADDRESS 212 N. WAHSATCH AVE., SUITE 301
 COLORADO SPRINGS, CO 80903

WATER / SANITARY
WIDEFIELD WATER AND SANITATION DISTRICT
37 WIDEFIELD BLVD.
SECURITY, CO 80911
719-390-7111

CABLE
COMCAST
P.O. BOX 173838
DENVER, CO 80217
970-641-4774

ELECTRIC
MOUNTAIN VIEW ELECTRIC
11140 E. WOODMEN RD.
COLORADO SPRINGS, CO 80831
719-495-2283

SECURITY FIRE PROTECTION DISTRICT
400 SECURITY BOULEVARD
SECURITY, CO 80911
719-392-7121

PREPARED FOR:
LORSON, LLC
212 N. WAHSATCH AVE., SUITE 301
COLORADO SPRINGS, CO 80903
719-635-3200
CONTACT: JEFF MARK

PREPARED BY:
CORE ENGINEERING GROUP
15004 1ST AVENUE S.
BURNSVILLE, MN 55306
719-570-1100
CONTACT: RICHARD L. SCHINDLER P.E.

LORIS & ASSOCIATES
100 SUPERIOR PLAZA WAY, SUITE 220
SUPERIOR, CO, 80027
303-444-2073
CONTACT: DAN BELTZER P.E.

TELEPHONE
CENTURYLINK
7925 INDUSTRY ROAD
COLORADO SPRINGS, CO 80939
719-278-4651

GAS
BLACK HILLS ENGERGY
7060 ALLEGRE ST.
FOUNTAIN, CO 80817
719-393-6639

EL PASO COUNTY
PLANNING AND COMMUNITY DEVELOPMENT
2880 INTERNATIONAL CIRCLE
COLORADO SPRINGS, CO 80910
719-520-6300

BASIS OF BEARING

BEARINGS ARE BASED ON THE SOUTH LINE OF THE NORTH HALF OF SECTION 23, TOWNSHIP 15 SOUTH, RANGE 65 WEST OF THE 6TH PRINCIPAL MERIDIAN AS BEING SOUTH 89°41'52" WEST. THE EAST QUARTER CORNER OF SAID SECTION 23 IS A FOUND 3-1/2" ALUMINUM CAP MONUMENT AND THE WEST QUARTER CORNER OF SAID SECTION 23 IS A FOUND 2-1/2" ALUMINUM CAP MONUMENT

BENCHMARK

FIMS MONUMENT F204 LOCATED AT THE NORTHWEST CORNER OF FONTAINE BLVD AND COTTONWOOD GROVE DR. ELEVATION 5724.072 (N.G.V.D. 29)

TRAFFIC CONTROL NOTE

THE CONTRACTOR SHALL PROVIDE ALL TRAFFIC CONTROL DEVICES AND MONITORING NECESSARY TO SAFELY COMPLETE THE WORK SHOWN IN THESE CONSTRUCTION DOCUMENTS IN CONFORMANCE WITH M.U.T.C.D. GUIDELINES. THE CONTRACTOR SHALL COMPLETE ALL NECESSARY WORK FOR PLAN REVIEW, PERMITS AND PROCESSING. TRAFFIC CONTROL WILL NOT BE PAID SEPARATELY BUT IS INCLUDED IN THE COST OF THE PROJECT.

CONSTRUCTION APPROVAL

FOUNTAIN MUTUAL IRRIGATION COMPANY FOR CONSTRUCTION WITHIN THE FMIC EASEMENT

FMIC REPRESENTATIVE _____ DATE _____

DISTRICT APPROVAL (WATER)

THE WIDEFIELD WATER AND SANITATION DISTRICT RECOGNIZES THE DESIGN ENGINEER AS HAVING RESPONSIBILITY FOR THE DESIGN. THE WIDEFIELD WATER AND SANITATION DISTRICT HAS LIMITED ITS SCOPE OF REVIEW ACCORDINGLY.

WIDEFIELD WATER AND SANITATION DISTRICT
WATER DESIGN APPROVAL

DATE _____ BY _____

PROJECT NO. _____

IN CASE OF ERRORS OR OMISSIONS WITH THE WATER DESIGN AS SHOWN ON THIS DOCUMENT THE STANDARDS AS DEFINED IN THE "RULES AND REGULATIONS FOR INSTALLATION OF WATER MAINS AND SERVICES" SHALL RULE.

APPROVAL EXPIRES 180 DAYS FROM DESIGN APPROVAL

CONSTRUCTION APPROVAL

COUNTY PLAN REVIEW IS PROVIDED ONLY FOR GENERAL CONFORMANCE WITH COUNTY DESIGN CRITERIA. THE COUNTY IS NOT RESPONSIBLE FOR THE ACCURACY AND ADEQUACY OF THE DESIGN, DIMENSIONS, AND/OR ELEVATIONS WHICH SHALL BE CONFIRMED AT THE JOB SITE. THE COUNTY THROUGH THE APPROVAL OF THIS DOCUMENT ASSUMES NO RESPONSIBILITY FOR COMPLETENESS AND/OR ACCURACY OF THIS DOCUMENT.

FILED IN ACCORDANCE WITH THE REQUIREMENTS OF THE EL PASO COUNTY LAND DEVELOPMENT CODE, DRAINAGE CRITERIA MANUALS VOLUME 1 AND 2, AND ENGINEERING CRITERIA MANUAL AS AMENDED. CONSTRUCTION DOCUMENTS WILL BE VALID FOR A PERIOD OF 2 YEARS FROM THE DATE SIGNED BY THE EL PASO COUNTY ENGINEER.

JENNIFER IRVINE, COUNTY ENGINEER/ECM ADMINISTRATOR _____ DATE _____
CONDITIONS:

ENGINEER'S APPROVAL

THESE DETAILED PLANS AND SPECIFICATIONS WERE PREPARED UNDER MY DIRECTION AND SUPERVISION. SAID PLANS AND SPECIFICATIONS HAVE BEEN PREPARED ACCORDING TO THE CRITERIA ESTABLISHED BY THE COUNTY FOR DETAILED ROADWAY, DRAINAGE, GRADING AND EROSION CONTROL PLANS AND SPECIFICATIONS, AND SAID PLANS AND SPECIFICATIONS ARE IN CONFORMITY WITH APPLICABLE MASTER DRAINAGE PLANS AND MASTER TRANSPORTATION PLANS. SAID PLANS AND SPECIFICATIONS MEET THE PURPOSES FOR WHICH THE PARTICULAR ROADWAY AND DRAINAGE FACILITIES ARE DESIGNED AND ARE CORRECT TO THE BEST OF MY KNOWLEDGE AND BELIEF. I ACCEPT RESPONSIBILITY FOR ANY LIABILITY CAUSED BY ANY NEGLIGENT ACTS, ERRORS OR OMISSIONS ON MY PART IN PREPARATION OF THESE DETAILED PLANS AND SPECIFICATIONS.

RICHARD L. SCHINDLER, P.E. # 33997
FOR AND ON BEHALF OF CORE ENGINEERING GROUP

CORE ENGINEERING GROUP

15004 1ST AVENUE S.
BURNSVILLE, MN 55306
PH: 719-570-1100
CONTACT: RICHARD L. SCHINDLER, P.E.
EMAIL: Rich@ceg1.com

DATE

X

DESCRIPTION

NO.

1.

PREPARED FOR:

LORSON, LLC
212 N. WAHSATCH AVE., SUITE 301
COLORADO SPRINGS, COLORADO 80903
CONTACT: JEFF MARK

PROJECT:

JCC BRIDGE
JCC MAIN CHANNEL - LORSON BLVD.
EL PASO COUNTY, COLORADO

DRAWN: LIA
DESIGNED: RLS
CHECKED: RLS

COVER SHEET

BRIDGE AT JCC MAIN CHANNEL

CONSTRUCTION PLANS

DATE

SEPT 15, 2017

PROJECT NO.

100.030

SHEET NUMBER

C1.1

TOTAL SHEETS:

36

CONSTRUCTION NOTES

1. ALL WORK SHALL COMPLY WITH THE CODES AND POLICIES FOR EL PASO COUNTY.

2. EXISTING TOPOGRAPHIC INFORMATION SHOWN ON THIS GRADING PLAN WAS OBTAINED FROM DREXEL, BARRELL & CO., JULY, 2005. THE CONTRACTOR SHALL BE RESPONSIBLE TO EXAMINE THE SITE AND BE FAMILIAR WITH THE EXISTING CONDITIONS.

3. DEPTH OF MOISTURE–DENSITY CONTROL FOR THIS PROJECT SHALL BE AS FOLLOWS:
BASE OF ALL CUTS AND FILLS – 12 INCHES,
FULL DEPTH OF ALL EMBANKMENTS

4. THE CONTRACTOR IS RESPONSIBLE FOR THE RE–ESTABLISHMENT OF ALL SURVEY MONUMENTS DISTURBED WITHIN THE PROJECT LIMITS.

5. THE CONTRACTOR SHALL PROTECT ALL WORK AREAS AND FACILITIES FROM FLOODING AT ALL TIMES. AREAS AND FACILITIES SUBJECTED TO FLOODING, REGARDLESS OF THE SOURCE OF WATER, SHALL BE PROMPTLY DEWATERED AND RESTORED.

6. PRIOR TO PAVING OPERATIONS, THE ENTIRE SUBGRADE SHALL BE PROOF–ROLLED WITH A LOADED 988 FRONT–END LOADER OR SIMILAR HEAVY RUBBER TIRED VEHICLE (GVW OF 50,000 POUNDS WITH 18 KIP PER AXLE AT TIRE PRESSURES OF 90 PSI) TO DETECT ANY SOFT OR LOOSE AREAS. IN AREAS WHERE SOFT OR LOOSE SOILS, PUMPING OR EXCESSIVE MOVEMENT IS OBSERVED, THE EXPOSED MATERIALS SHALL BE OVER–EXCAVATED TO A MINIMUM DEPTH OF TWO FEET BELOW PROPOSED FINAL GRADE OR TO A DEPTH AT WHICH SOILS ARE STABLE. AFTER THIS HAS BEEN COMPLETED, THE EXPOSED MATERIALS SHALL BE SCARIFIED TO A DEPTH OF 12 INCHES AND MOISTURE CONDITIONED. THE SUBGRADE SHALL THEN BE UNIFORMLY COMPACTED TO A MINIMUM OF 95% OF STANDARD PROCTOR DENSITY (ASTM D–698) AT 0 TO +4.0% OF OPTIMUM MOISTURE CONTENT FOR A–6 AND A–7–6 SOILS ENCOUNTERED. OTHER SUBGRADE TYPES SHALL BE UNIFORMLY COMPACTED TO A MINIMUM OF 95% OF MODIFIED PROCTOR DENSITY (ASTM D–1557) AT PLUS OR MINUS 2.0% OF OPTIMUM MOISTURE CONTENT. AREAS WHERE STABLE NATURAL SOILS ARE ENCOUNTERED AT PROPOSED SUBGRADE ELEVATION SHALL ALSO BE SCARIFIED (18 INCHES FOR A–7–6 SOILS BELOW FULL–DEPTH ASPHALT CONCRETE) AND COMPACTED AS OUTLINED ABOVE PRIOR TO PAVING OPERATIONS. SUBGRADE FILL SHALL BE PLACED IN SIX–INCH LIFTS AND UNIFORMLY COMPACTED, MEETING THE REQUIREMENTS AS PREVIOUSLY DESCRIBED.

7. SUBGRADE MATERIALS DEEMED UNSUITABLE BY THE ENGINEER SHALL BE EXCAVATED, DISPOSED OF AND REPLACED WITH APPROVED MATERIALS.

8. FILL SHALL BE PLACED IN 8–INCH MAXIMUM LOOSE LIFTS AND SHALL BE COMPACTED PRIOR TO SUCCESSIVE LIFTS.

9. THE CONTRACTOR IS RESPONSIBLE FOR PREVENTING AND CONTROLLING EROSION DURING CONSTRUCTION ACTIVITIES AT ALL TIMES DURING GRADING AND CONSTRUCTION. THE CONTRACTOR SHALL PROVIDE THE FOLLOWING EROSION AND SEDIMENT CONTROL MEASURES:

- HAY BALE BARRIERS WHERE NEEDED AND/OR AS DIRECTED BY THE ENGINEER.
- SILT FENCE WHERE NEEDED AND/OR AS DIRECTED BY THE ENGINEER.
- TEMPORARY SEDIMENTATION BASINS WHERE NEEDED AND/OR AS DIRECTED BY THE ENGINEER.
- MULCHING AND SEEDING OF EXCESSIVE SLOPED AREAS AS NEEDED OR AS DIRECTED BY THE ENGINEER.
- TEMPORARY VEHICLE TRACKING CONTROL AS NEEDED AND/OR DIRECTED BY THE ENGINEER.
- CONCRETE WASH AREAS.
- INLET PROTECTION.

THESE AND ALL EROSION CONTROL BEST MANAGEMENT PRACTICES AS SHOWN IN THE GRADING AND EROSION CONTROL PLANS SHALL BE STRICTLY ADHERED TO.

10. FINISHED CONTOURS/SPOT ELEVATIONS SHOWN HEREON REPRESENT FINISHED GRADES. ALL PAVEMENT SUBGRADES ARE BASED ON THE COMPOSITE ASPHALT PAVEMENT RECOMMENDATIONS MADE IN THE "GEOTECHNICAL STUDY" FOR LORSON RANCH.

EL PASO COUNTY STANDARD CONSTRUCTION NOTES:

1. ALL DRAINAGE AND ROADWAY CONSTRUCTION SHALL MEET THE STANDARDS AND SPECIFICATIONS OF THE CITY OF COLORADO SPRINGS/EL PASO COUNTY DRAINAGE CRITERIA MANUAL, VOLUMES 1 AND 2, AND THE EL PASO COUNTY ENGINEERING CRITERIA MANUAL.

2. CONTRACTOR SHALL BE RESPONSIBLE FOR THE NOTIFICATION AND FIELD NOTIFICATION OF ALL EXISTING UTILITIES, WHETHER SHOWN ON THE PLANS OR NOT, BEFORE BEGINNING CONSTRUCTION. LOCATION OF EXISTING UTILITIES SHALL BE VERIFIED BY THE CONTRACTOR PRIOR TO CONSTRUCTION. CALL 811 TO CONTACT THE UTILITY NOTIFICATION CENTER OF COLORADO (UNCC).

3. CONTRACTOR SHALL KEEP A COPY OF THESE APPROVED PLANS, THE GRADING AND EROSION CONTROL PLAN, THE STORMWATER MANAGEMENT PLAN (SWMP), THE SOILS AND GEOTECHNICAL REPORT, AND THE APPROPRIATE DESIGN AND CONSTRUCTION STANDARDS AND SPECIFICATIONS AT THE JOB SITE AT ALL TIMES, INCLUDING THE FOLLOWING:

- a. EL PASO COUNTY ENGINEERING CRITERIA MANUAL (ECM)
- b. CITY OF COLORADO SPRINGS/EL PASO COUNTY DRAINAGE CRITERIA MANUAL VOLUMES 1 AND 2
- c. COLORADO DEPARTMENT OF TRANSPORTATION (CDOT) STANDARD SPECIFICATIONS FOR CONSTRUCTION
- d. CDOT M & S STANDARDS

4. NOTWITHSTANDING ANYTHING DEPICTED IN THESE PLANS IN WORDS OR GRAPHIC REPRESENTATION, ALL DESIGN AND CONSTRUCTION RELATED TO ROADS, STORM DRAINAGE AND EROSION CONTROL SHALL CONFORM TO THE STANDARDS AND REQUIREMENTS OF THE MOST RECENT VERSION OF THE RELEVANT ADOPTED EL PASO COUNTY STANDARDS, INCLUDING THE LAND DEVELOPMENT CODE, THE ENGINEERING CRITERIA MANUAL, THE DRAINAGE CRITERIA MANUAL, AND THE DRAINAGE CRITERIA MANUAL VOLUME 2. ANY DEVIATIONS FROM REGULATIONS AND STANDARDS MUST BE REQUESTED, AND APPROVED, IN WRITING. ANY MODIFICATIONS NECESSARY TO MEET THE REQUIREMENTS OF THE MOST RECENT VERSION OF THE RELEVANT ADOPTED EL PASO COUNTY STANDARDS, INCLUDING THE LAND DEVELOPMENT CODE, THE ENGINEERING CRITERIA MANUAL, THE DRAINAGE CRITERIA MANUAL, AND THE DRAINAGE CRITERIA MANUAL VOLUME 2. ANY DEVIATIONS FROM REGULATIONS AND STANDARDS MUST BE REQUESTED, AND APPROVED, IN WRITING.

5. IT IS THE DESIGN ENGINEER'S RESPONSIBILITY TO ACCURATELY SHOW EXISTING CONDITIONS AND CHANGED CONDITIONS WILL BE ENTIRELY THE DEVELOPER'S RESPONSIBILITY TO RECTIFY.

6. CONTRACTOR SHALL SCHEDULE A PRE–CONSTRUCTION MEETING WITH EL PASO COUNTY PLANNING AND COMMUNITY DEVELOPMENT (PCD) – INSPECTIONS, PRIOR TO STARTING CONSTRUCTION.

7. IT IS THE CONTRACTOR'S RESPONSIBILITY TO UNDERSTAND THE REQUIREMENTS OF ALL JURISDICTIONAL AGENCIES AND TO OBTAIN ALL REQUIRED PERMITS, INCLUDING BUT NOT LIMITED TO EL PASO COUNTY EROSION AND STORMWATER QUALITY CONTROL PERMIT (ESQCP), REGIONAL BUILDING FLOODPLAIN DEVELOPMENT PERMIT, U.S. ARMY CORPS OF ENGINEERS–ISSUED 401 AND/OR 404 PERMITS, AND COUNTY AND STATE FUGITIVE DUST PERMITS.

8. CONTRACTOR SHALL NOT DEVIATE FROM THE PLANS WITHOUT FIRST OBTAINING WRITTEN APPROVAL FROM THE DESIGN ENGINEER AND PCD. CONTRACTOR SHALL NOTIFY THE DESIGN ENGINEER IMMEDIATELY UPON DISCOVERY OF ANY ERRORS OR INCONSISTENCIES.

9. ALL STORM DRAIN PIPE SHALL BE CLASS III RCP UNLESS OTHERWISE NOTED AND APPROVED BY PCD.

10. CONTRACTOR SHALL COORDINATE GEOTECHNICAL TESTING PER ECM STANDARDS. PAVEMENT DESIGN SHALL BE APPROVED BY EL PASO COUNTY PCD PRIOR TO PLACEMENT OF CURB AND GUTTER AND PAVEMENT.

11. ALL CONSTRUCTION TRAFFIC MUST ENTER/EXIT THE SITE AT APPROVED CONSTRUCTION ACCESS POINTS.

12. SIGHT VISIBILITY TRIANGLES AS IDENTIFIED IN THE PLANS SHALL BE PROVIDED AT ALL INTERSECTIONS. OBSTRUCTIONS GREATER THAN 18 INCHES ABOVE FLOWLINE ARE NOT ALLOWED WITHIN SIGHT TRIANGLES.

13. SIGNING AND STRIPING SHALL COMPLY WITH EL PASO COUNTY PUBLIC WORK DEPARTMENT AND MUTCD CRITERIA.

14. CONTRACTOR SHALL OBTAIN ANY PERMITS REQUIRED BY EL PASO COUNTY PWD, INCLUDING WORK WITHIN THE RIGHT–OF–WAY AND SPECIAL TRANSPORT PERMITS.

15. THE LIMITS OF CONSTRUCTION SHALL REMAIN WITHIN THE PROPERTY LINE UNLESS OTHERWISE NOTED. THE OWNER/DEVELOPER SHALL OBTAIN WRITTEN PERMISSION AND EASEMENTS, WHERE REQUIRED, FROM ADJOINING PROPERTY OWNER(S) PRIOR TO ANY OFF–SITE DISTURBANCE, GRADING, OR CONSTRUCTION.

WIDEFIELD WATER AND SANITATION DISTRICT GENERAL NOTES

1. ALL UTILITY CONSTRUCTION TO BE CONDUCTED IN CONFORMANCE WITH THE CURRENT WIDEFIELD WATER AND SANITATION DISTRICT SPECIFICATIONS. COMPACTION REQUIREMENTS SHALL BE 95% STANDARD PROCTOR AS DETERMINED BY ASTM D698, UNLESS OTHERWISE APPROVED BY THE WIDEFIELD WATER AND SANITATION DISTRICT OR A HIGHER STANDARD IS IMPOSED BY ANOTHER AGENCY HAVING RIGHT–OF–WAY JURISDICTION.

2. ALL MATERIALS AND WORKMANSHIP SHALL BE SUBJECT TO INSPECTION BY THE WIDEFIELD WATER AND SANITATION DISTRICT. THE WIDEFIELD WATER AND SANITATION DISTRICT RESERVES THE RIGHT TO ACCEPT OR REJECT ANY SUCH MATERIALS AND WORKMANSHIP THAT DOES NOT CONFORM TO ITS STANDARDS AND SPECIFICATIONS.

3. THE DEVELOPER OR HIS ENGINEER HAS LOCATED ALL FIRE HYDRANTS AND FUTURE SERVICE STUBS. ANY REQUIRED REALIGNMENT, EITHER HORIZONTAL OR VERTICAL, SHALL BE AT THE EXPENSE OF THE DEVELOPER.

4. ALL DUCTILE IRON PIPE, TO INCLUDE FITTINGS, VALVES AND FIRE HYDRANTS WILL BE WRAPPED WITH POLYETHYLENE TUBING, BONDED AT EACH JOINT AND ELECTRICALLY ISOLATED.

5. ALL DUCTILE IRON PIPE SHALL BE DOUBLE BONDED. DIP SHALL HAVE CATHODIC PROTECTION USING NO. 6 WIRE WITH 17 LB. MAGNESIUM ANODES EVERY 400 FEET.

6. PVC MAIN LINES SHALL BE INSTALLED WITH COATED NO. 12 TRACER WIRE.

7. ALL FITTINGS SHALL BE DUCTILE IRON –MECHANICAL JOINT AND HAVE 1 LB. MAGNESIUM ANODES AT EVERY FITTING.

8. THE CONTRACTOR IS REQUIRED TO NOTIFY THE WIDEFIELD WATER AND SANITATION DISTRICT (390–7111) A MINIMUM OF 48 HOURS AND A MAXIMUM OF 96 HOURS PRIOR TO THE START OF CONSTRUCTION. THE CONTRACTOR SHALL ALSO NOTIFY AFFECTED UTILITY COMPANIES 48 HOURS PRIOR TO CONSTRUCTION ADJACENT TO THE KNOWN UTILITY LINES.

9. THE LOCATION OF ALL UTILITIES AS SHOWN ON THESE DRAWINGS ARE APPROXIMATE ONLY. THE LOCATION OF ALL UTILITIES SHALL BE VERIFIED PRIOR TO CONSTRUCTION BY THE CONTRACTOR.

10. THE CONTRACTOR SHALL FIELD EXCAVATE AND VERIFY THE VERTICAL AND HORIZONTAL LOCATION OF ALL TIE–INS. CONTRACTOR SHALL NOTIFY THE WIDEFIELD WATER AND SANITATION DISTRICT AND THE ENGINEER OF THE FIELD VERIFIED INFORMATION PRIOR TO CONSTRUCTION.

11. ALL BENDS SHALL BE FIELD STAKED PRIOR TO CONSTRUCTION.

12. ANY WATER UTILITY MATERIAL REMOVED AND NOT REUSED SHALL BE RETURNED TO THE WIDEFIELD WATER AND SANITATION DISTRICT IF THE DISTRICT SO REQUESTS.

13. THE CONTRACTOR SHALL AT HIS EXPENSE SUPPORT AND PROTECT ALL UTILITY MAINS SO THAT THEY WILL FUNCTION CONTINUOUSLY DURING CONSTRUCTION. SHOULD A UTILITY MAIN FAIL AS A RESULT OF THE CONTRACTOR'S OPERATION, IT WILL BE REPLACED IMMEDIATELY BY EITHER THE CONTRACTOR OR THE WIDEFIELD WATER AND SANITATION DISTRICT AT FULL COST OF LABOR AND MATERIALS TO THE CONTRACTOR.

14. ANY PUMPING OR BYPASS OPERATIONS MUST BE REVIEWED AND APPROVED PRIOR TO EXECUTION BY BOTH THE WIDEFIELD WATER AND SANITATION DISTRICT AND THE ENGINEER.

15. DISINFECTION SHALL BE ACCOMPLISHED BY GLUING TABLETS TO THE TOP OF THE LINE. POWDER OR GRANULER HTH SHALL NOT BE USED. SEE WIDEFIELD SPECS FOR FURTHER DEFINITION OF DISINFECTION TECHNIQUES.

16. CONTRACTOR MUST REPLACE OR REPAIR ANY DAMAGE TO ALL SURFACE IMPROVEMENTS, INCLUDING BUT NOT LIMITED TO FENCES, CURB AND GUTTER AND/OR ASPHALT THAT MAY BE CAUSED DURING CONSTRUCTION.

17. ALL WATER LINES 6" AND LARGER, AND ALL SEWER LINES 8" AND LARGER, SHALL HAVE AS "AS–BUILT" PLANS PREPARED AND APPROVED PRIOR TO FINAL ACCEPTANCE BY THE WIDEFIELD WATER AND SANITATION DISTRICT.

18. PRIOR TO CONSTRUCTION, A PRE–CONSTRUCTION CONFERENCE IS REQUIRED A MINIMUM OF 72 HOURS IN ADVANCE OF COMMENCEMENT OF WORK. TO SET THE PRE–CONSTRUCTION CONFERENCE, CONTACT BRANDON BERNARD–WATER SUPERINTENDENT (464–2051) AND/OR MARK MCCORMICK, WASTEWATER SUPERINTENDENT OF THE WIDEFIELD WATER AND SANITATION DISTRICT FOR A TIME. NO PRE–CONSTRUCTION CONFERENCE TIMES WILL BE SET UNTIL 4 SETS OF SIGNED DRAWINGS ARE RECEIVED BY THE WIDEFIELD W & S DISTRICT. PRE–CONSTRUCTION DATE /INITIALS_____.

WIDEFIELD WATER AND SANITATION DISTRICT UTILITY CONSTRUCTION NOTES

1. ALL DUCTILE IRON PIPE AND FITTINGS SHALL HAVE CATHODIC PROTECTION AND 1 LB MAGNESIUM ANODES AT EVERY FITTING.

2. ALL FIRE HYDRANTS SHALL BE MEULLER SUPER CENTURION 200 OR AMERICAN AVK SERIES 2700, (MODERN)

STANDARD NOTES FOR EL PASO COUNTY GRADING AND EROSION CONTROL PLANS

1. CONSTRUCTION MAY NOT COMMENCE UNTIL A CONSTRUCTION PERMIT IS OBTAINED FROM PCD AND A PRECONSTRUCTION CONFERENCE IS HELD WITH PCD INSPECTIONS.

2. STORMWATER DISCHARGES FROM CONSTRUCTION SITES SHALL NOT CAUSE OR THREATEN TO CAUSE POLLUTION, CONTAMINATION, OR DEGRADATION OF STATE WATERS. ALL WORK AND EARTH DISTURBANCE SHALL BE DONE IN A MANNER THAT MINIMIZES POLLUTION OF ANY ON–SITE OR OFF SITE WATERS, INCLUDING WETLANDS.

3. NOTWITHSTANDING ANYTHING DEPICTED IN THESE PLANS IN WORDS OR GRAPHIC REPRESENTATION, ALL DESIGN AND CONSTRUCTION RELATED TO ROADS, STORM DRAINAGE AND EROSION CONTROL SHALL CONFORM TO THE STANDARDS AND REQUIREMENTS OF THE MOST RECENT VERSION OF THE RELEVANT ADOPTED EL PASO COUNTY STANDARDS, INCLUDING THE LAND DEVELOPMENT CODE, THE ENGINEERING CRITERIA MANUAL, THE DRAINAGE CRITERIA MANUAL, AND THE DRAINAGE CRITERIA MANUAL VOLUME 2. ANY DEVIATIONS FROM REGULATIONS AND STANDARDS MUST BE REQUESTED, AND APPROVED, IN WRITING.

4. A SEPARATE STORMWATER MANAGEMENT PLAN (SWMP) FOR THIS PROJECT SHALL BE COMPLETED AND AN EROSION AND STORMWATER QUALITY CONTROL PERMIT (ESQCP) ISSUED PRIOR TO COMMENCING CONSTRUCTION. DURING CONSTRUCTION THE SWMP IS THE RESPONSIBILITY OF THE DESIGNATED STORMWATER MANAGER, SHALL BE LOCATED ON SITE AT ALL TIMES AND SHALL BE KEPT UP TO DATE WITH WORK PROGRESS AND CHANGES IN THE FIELD.

5. ONCE THE ESQCP HAS BEEN ISSUED, THE CONTRACTOR MAY INSTALL THE INITIAL STAGE EROSION AND SEDIMENT CONTROL BMPS AS INDICATED ON THE GEC. A PRECONSTRUCTION MEETING BETWEEN THE CONTRACTOR, ENGINEER, AND EL PASO COUNTY WILL BE HELD PRIOR TO ANY CONSTRUCTION. IT IS THE RESPONSIBILITY OF THE APPLICANT TO COORDINATE THE MEETING TIME AND PLACE WITH COUNTY PCD INSPECTIONS STAFF.

6. SOIL EROSION CONTROL MEASURES FOR ALL SLOPES, CHANNELS, DITCHES, OR ANY DISTURBED LAND AREA SHALL BE COMPLETED WITHIN 21 CALENDAR DAYS AFTER FINAL GRADING, OR FINAL EARTH DISTURBANCE, HAS BEEN COMPLETED. DISTURBED AREAS AND STOCKPILES WHICH ARE NOT AT FINAL GRADE BUT WILL REMAIN DORMANT FOR LONGER THAN 30 DAYS SHALL ALSO BE MULCHED WITHIN 21 DAYS AFTER INTERIM GRADING. AN AREA THAT IS GOING TO REMAIN IN AN INTERIM STATE FOR MORE THAN 60 DAYS SHALL ALSO BE SEEDED. ALL TEMPORARY SOIL EROSION CONTROL MEASURES AND BMPS SHALL BE MAINTAINED UNTIL PERMANENT SOIL EROSION CONTROL MEASURES ARE IMPLEMENTED AND ESTABLISHED.

7. TEMPORARY SOIL EROSION CONTROL FACILITIES SHALL BE REMOVED AND EARTH DISTURBANCE AREAS GRADED AND STABILIZED WITH PERMANENT SOIL EROSION CONTROL MEASURES PURSUANT TO STANDARDS AND SPECIFICATION PRESCRIBED IN THE DCM VOLUME II AND THE ENGINEERING CRITERIA MANUAL (ECM) APPENDIX I.

8. ALL PERSONS ENGAGED IN EARTH DISTURBANCE SHALL IMPLEMENT AND MAINTAIN ACCEPTABLE SOIL EROSION AND SEDIMENT CONTROL MEASURES INCLUDING BMPS IN CONFORMANCE WITH THE EROSION CONTROL TECHNICAL STANDARDS OF THE DRAINAGE CRITERIA MANUAL (DCM) VOLUME II AND IN ACCORDANCE WITH THE STORMWATER MANAGEMENT PLAN (SWMP).

9. ALL TEMPORARY EROSION CONTROL FACILITIES INCLUDING BMPS AND ALL PERMANENT FACILITIES INTENDED TO CONTROL EROSION OF ANY EARTH DISTURBANCE OPERATIONS, SHALL BE INSTALLED AS DEFINED IN THE APPROVED PLANS, THE SWMP AND THE DCM VOLUME II AND MAINTAINED THROUGHOUT THE DURATION OF THE EARTH DISTURBANCE OPERATION.

10. ANY EARTH DISTURBANCE SHALL BE CONDUCTED IN SUCH A MANNER SO AS TO EFFECTIVELY REDUCE ACCELERATED SOIL EROSION AND RESULTING SEDIMENTATION. ALL DISTURBANCES SHALL BE DESIGNED, CONSTRUCTED, AND COMPLETED SO THAT THE EXPOSED AREA OF ANY DISTURBED LAND SHALL BE LIMITED TO THE SHORTEST PRACTICAL PERIOD OF TIME.

11. ANY TEMPORARY OR PERMANENT FACILITY DESIGNED AND CONSTRUCTED FOR THE CONVEYANCE OF STORMWATER AROUND, THROUGH, OR FROM THE EARTH DISTURBANCE AREA SHALL BE DESIGNED TO LIMIT THE DISCHARGE TO A NON–EROSIVE VELOCITY.

12. CONCRETE WASH WATER SHALL BE CONTAINED AND DISPOSED OF IN ACCORDANCE WITH THE SWMP. NO WASH WATER SHALL BE DISCHARGED TO OR ALLOWED TO RUNOFF TO STATE WATERS, INCLUDING ANY SURFACE OR SUBSURFACE STORM DRAINAGE SYSTEM OR FACILITIES.

13. EROSION CONTROL BLANKETING SHALL BE USED ON SLOPES STEEPER THAN 3:1.

14. BUILDING, CONSTRUCTION, EXCAVATION, OR OTHER WASTE MATERIALS SHALL NOT BE TEMPORARILY PLACED OR STORED IN THE STREET, ALLEY, OR OTHER PUBLIC WAY, UNLESS IN ACCORDANCE WITH AN APPROVED TRAFFIC CONTROL PLAN. BMP'S MAY BE REQUIRED BY EL PASO COUNTY PCD IF DEEMED NECESSARY, BASED ON SPECIFIC CONDITIONS AND CIRCUMSTANCES.

15. VEHICLE TRACKING OF SOILS AND CONSTRUCTION DEBRIS OFF–SITE SHALL BE MINIMIZED. MATERIALS TRACKED OFFSITE SHALL BE CLEANED UP AND PROPERLY DISPOSED OF IMMEDIATELY.

16. CONTRACTOR SHALL BE RESPONSIBLE FOR THE REMOVAL OF ALL WASTES FROM THE CONSTRUCTION SITE FOR DISPOSAL IN ACCORDANCE WITH LOCAL AND STATE REGULATORY REQUIREMENTS. NO CONSTRUCTION DEBRIS, TREE SLASH, BUILDING MATERIAL WASTES OR UNUSED BUILDING MATERIALS SHALL BE BURIED, DUMPED, OR DISCHARGED AT THE SITE.

17. THE OWNER, SITE DEVELOPER, CONTRACTOR, AND/OR THEIR AUTHORIZED AGENTS SHALL BE RESPONSIBLE FOR THE REMOVAL OF ALL CONSTRUCTION DEBRIS, DIRT, TRASH, ROCK, SEDIMENT, AND SAND THAT MAY ACCUMULATE IN THE STORM SEWER OR OTHER DRAINAGE CONVEYANCE SYSTEM AND STORMWATER APPURTENANCES AS A RESULT OF SITE DEVELOPMENT.

18. THE QUANTITY OF MATERIALS STORED ON THE PROJECT SITE SHALL BE LIMITED, AS MUCH AS PRACTICAL, TO THAT QUANTITY REQUIRED TO PERFORM THE WORK IN AN ORDERLY SEQUENCE. ALL MATERIALS STORED ON–SITE SHALL BE STORED IN A NEAT, ORDERLY MANNER, IN THEIR ORIGINAL CONTAINERS, WITH ORIGINAL MANUFACTURER'S LABELS.

19. NO CHEMICALS ARE TO BE USED BY THE CONTRACTOR, WHICH HAVE THE POTENTIAL TO BE RELEASED IN STORMWATER UNLESS PERMISSION FOR THE USE OF A SPECIFIC CHEMICAL IS GRANTED IN WRITING BY THE ECM ADMINISTRATOR. IN GRANTING THE USE OF SUCH CHEMICALS, SPECIAL CONDITIONS AND MONITORING MAY BE REQUIRED.

20. BULK STORAGE STRUCTURES FOR PETROLEUM PRODUCTS AND OTHER CHEMICALS SHALL HAVE ADEQUATE PROTECTION SO AS TO CONTAIN ALL SPILLS AND PREVENT ANY SPILLED MATERIAL FROM ENTERING STATE WATERS, INCLUDING ANY SURFACE OR SUBSURFACE STORM DRAINAGE SYSTEM OR FACILITIES.

21. NO PERSON SHALL CAUSE THE IMPEDIMENT OF STORMWATER FLOW IN THE FLOW LINE OF THE CURB AND GUTTER OR IN THE DITCHLINE.

22. INDIVIDUALS SHALL COMPLY WITH THE "COLORADO WATER QUALITY CONTROL ACT" (TITLE 25, ARTICLE 8, CRS), AND THE "CLEAN WATER ACT" (33 USC 1344), IN ADDITION TO THE REQUIREMENTS INCLUDED IN THE DCM VOLUME II AND THE ECM APPENDIX I. ALL APPROPRIATE PERMITS MUST BE OBTAINED BY THE CONTRACTOR PRIOR TO CONSTRUCTION (NPDES, FLOODPLAIN, 404, FUGITIVE DUST, ETC.). IN THE EVENT OF CONFLICTS BETWEEN THESE REQUIREMENTS AND LAWS, RULES, OR REGULATIONS OF OTHER FEDERAL, STATE, OR COUNTY AGENCIES, THE MORE RESTRICTIVE LAWS, RULES, OR REGULATIONS SHALL APPLY.

23. ALL CONSTRUCTION TRAFFIC MUST ENTER/EXIT THE SITE AT APPROVED CONSTRUCTION ACCESS POINTS.

24. PRIOR TO ACTUAL CONSTRUCTION THE PERMITTEE SHALL VERIFY THE LOCATION OF EXISTING UTILITIES.

25. A WATER SOURCE SHALL BE AVAILABLE ON SITE DURING EARTHWORK OPERATIONS AND UTILIZED AS REQUIRED TO MINIMIZE DUST FROM EARTHWORK EQUIPMENT AND WIND.

26. THE SOILS REPORT FOR THIS SITE HAS BEEN PREPARED BY RMG AND SHALL BE CONSIDERED A PART OF THESE PLANS.

27. AT LEAST TEN DAYS PRIOR TO THE ANTICIPATED START OF CONSTRUCTION, FOR PROJECTS THAT WILL DISTURB 1 ACRE OR MORE, THE OWNER OR OPERATOR OF CONSTRUCTION ACTIVITY SHALL SUBMIT A PERMIT APPLICATION FOR STORMWATER DISCHARGE TO THE COLORADO DEPARTMENT OF PUBLIC HEALTH AND ENVIRONMENT, WATER QUALITY DIVISION. THE APPLICATION CONTAINS CERTIFICATION OF COMPLETION OF A STORMWATER MANAGEMENT PLAN (SWMP), OF WHICH THIS GRADING AND EROSION CONTROL PLAN MAY BE A PART. FOR INFORMATION OR APPLICATION MATERIALS CONTACT:

COLORADO DEPARTMENT OF PUBLIC HEALTH AND ENVIRONMENT
WATER QUALITY CONTROL DIVISION
WQCD – PERMITS
4300 CHERRY CREEK DRIVE SOUTH
DENVER, CO 80246–1530
ATTN: PERMITS UNIT

CORE
ENGINEERING GROUP

15004 1ST AVENUE S.
DENVER, CO 80202
PHONE: 719.570.1100
CONTACT: RICHARD L. SCHINDLER, P.E.
EMAIL: Rich@ceg1.com

DATE: X

DESCRIPTION: X

NO.: 1.

PROJECT: JCC BRIDGE
JCC MAIN CHANNEL – LORSON BLVD.
EL PASO COUNTY, COLORADO

PREPARED FOR: LORSON, LLC
212 N. WAHSATCH AVE., SUITE 301
COLORADO SPRINGS, COLORADO 80903
(719) 635–3200
CONTACT: JEFF MARK


DRAWN: RLS
DESIGNED: RLS
CHECKED: RLS

DATE: SEPT 15, 2017

PROJECT NO. 100.030

SHEET NUMBER C1.2

TOTAL SHEETS: 36

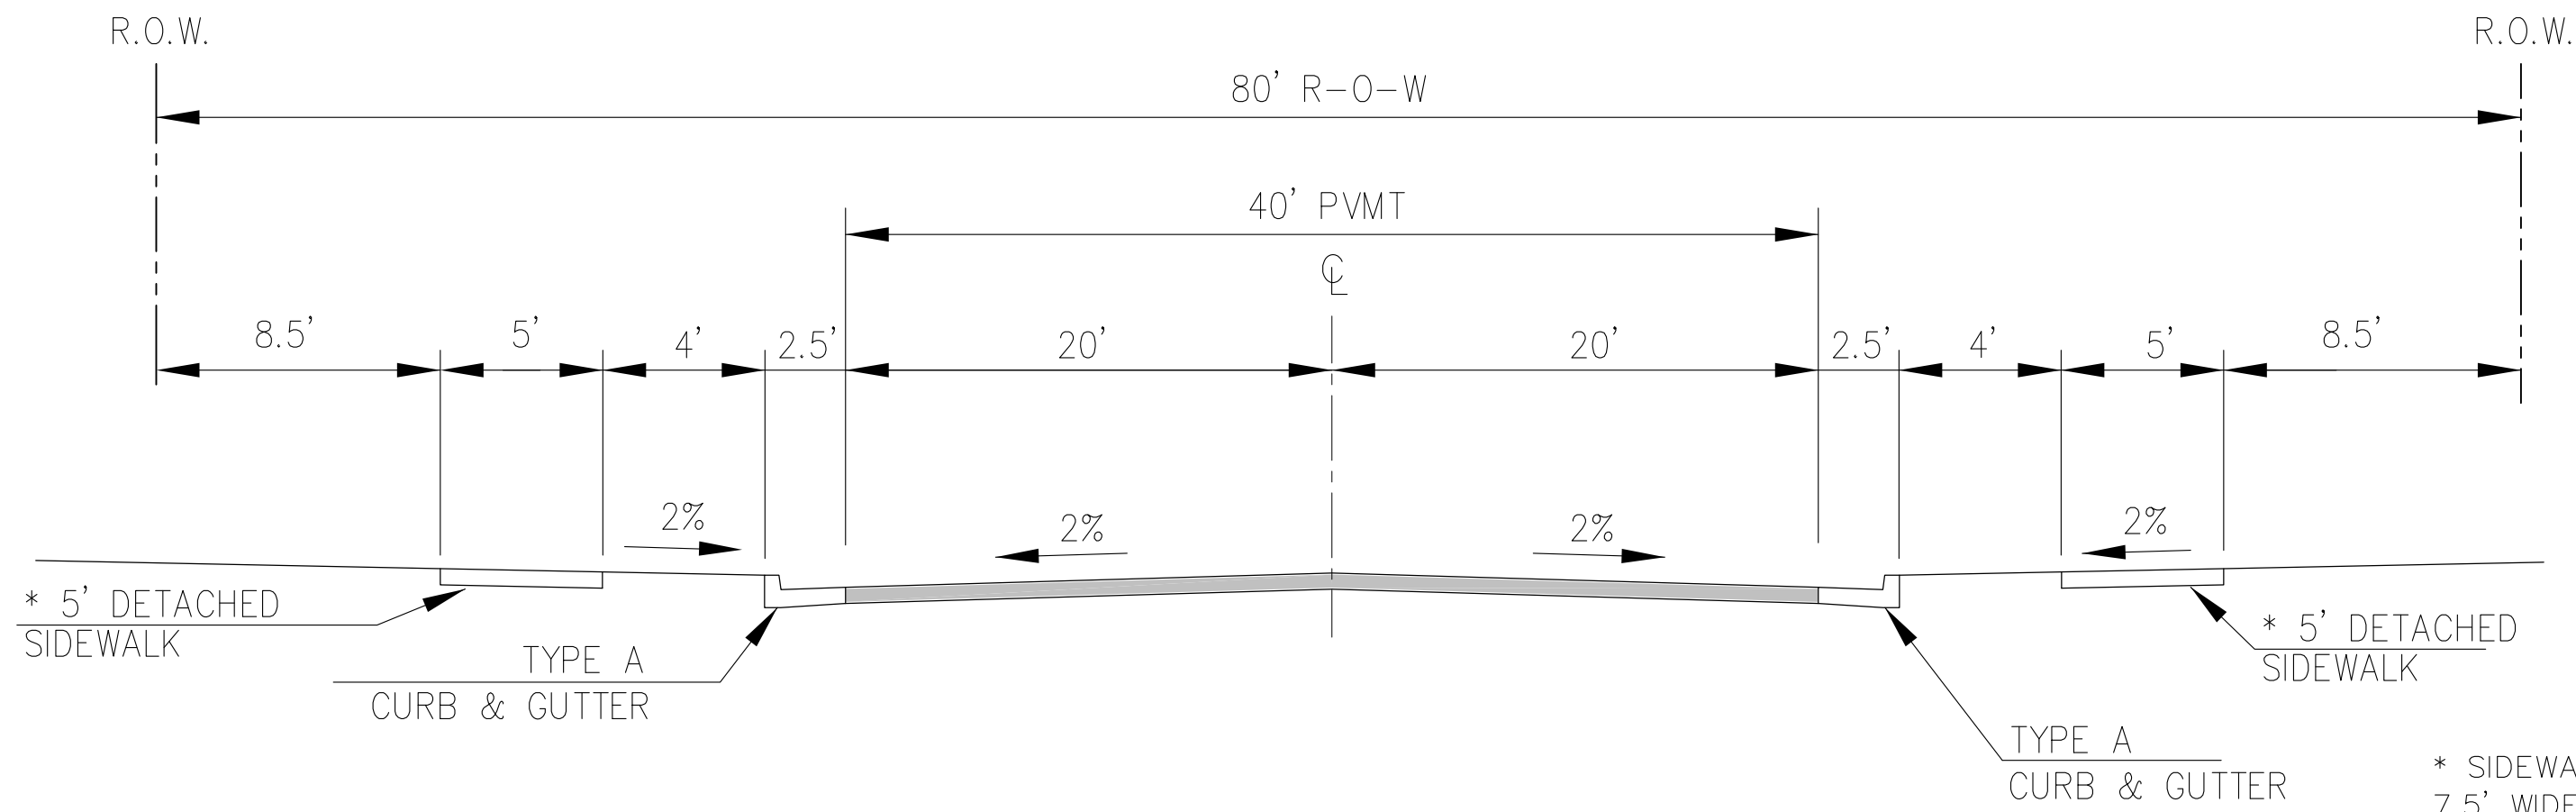

* SIDEWALK CHANGES TO 7.5' WIDE ATTACHED SIDEWALK OVER BRIDGE

TYPICAL SECTION 80' R.O.W.
RESIDENTIAL URBAN COLLECTOR
NOT TO SCALE



LORSON BOULEVARD

NOTE:
Pavement section to be determined by Hveem analysis and design. Design to be approved by El Paso County PCD Engineering


NOTE
ALL HYDRANTS SHALL BE MEULLER SUPER CENTURION 200.

NOTES

1. HYDRANT NOZZLE SHALL BE POSITIONED AT RIGHT ANGLES TO CURB. IF NO CURB OR SIDEWALK EXIST, NOZZLE SHALL BE PLACED AT RIGHT ANGLE TO STREET OR ALLEY.
2. HYDRANTS WILL BE PLACED A MINIMUM OF 5.0 FEET FROM ANY UTILITY OR DRAINAGE STRUCTURE (TO BE CO-ORDINATED WITH JOINT TRENCH INSTALLATION)
3. ANY HYDRANT BEING INSTALLED WITH CONDITIONS OTHER THAN THOSE MENTIONED AND/OR DETAILED BELOW WILL REQUIRE SIGNED APPROVAL FROM SECURITY FIRE PROTECTION DISTRICT.

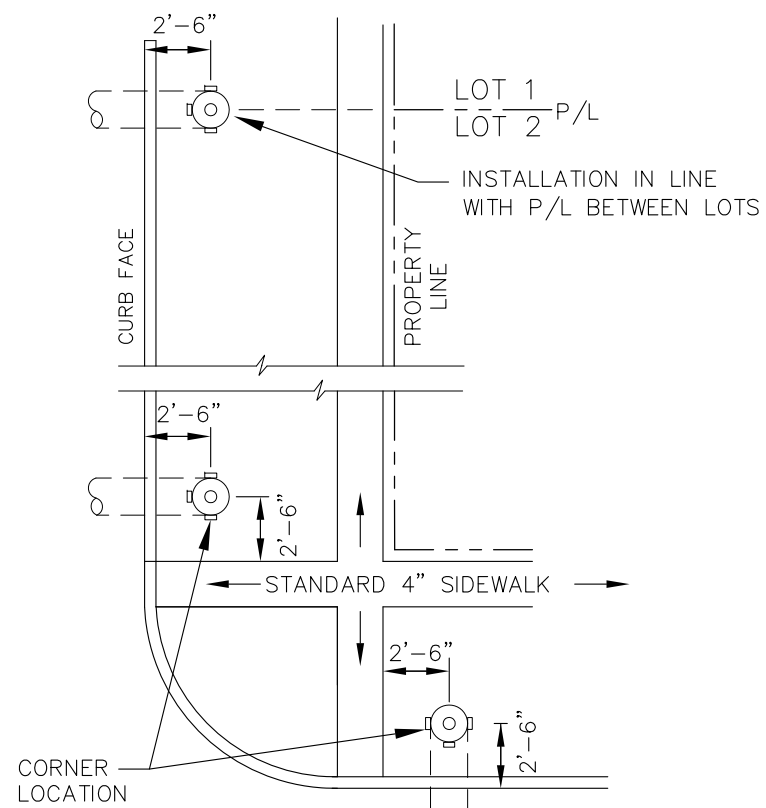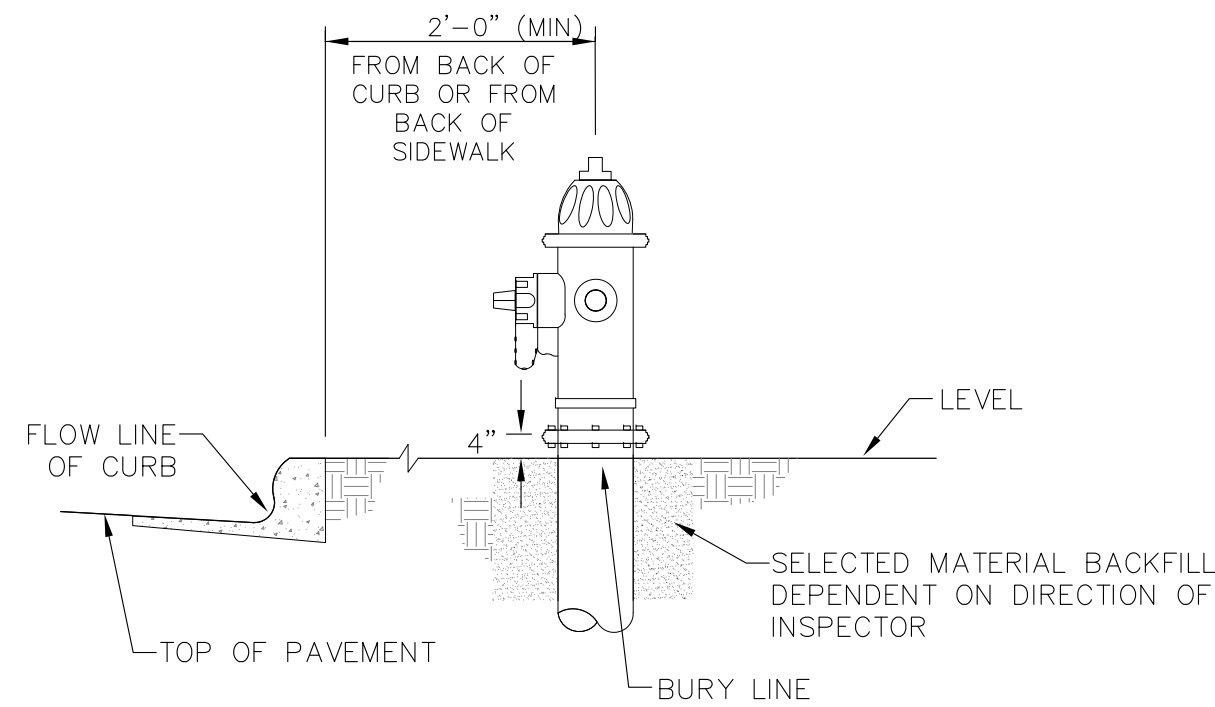


DETACHED SIDEWALK LOCATION
NO SCALE

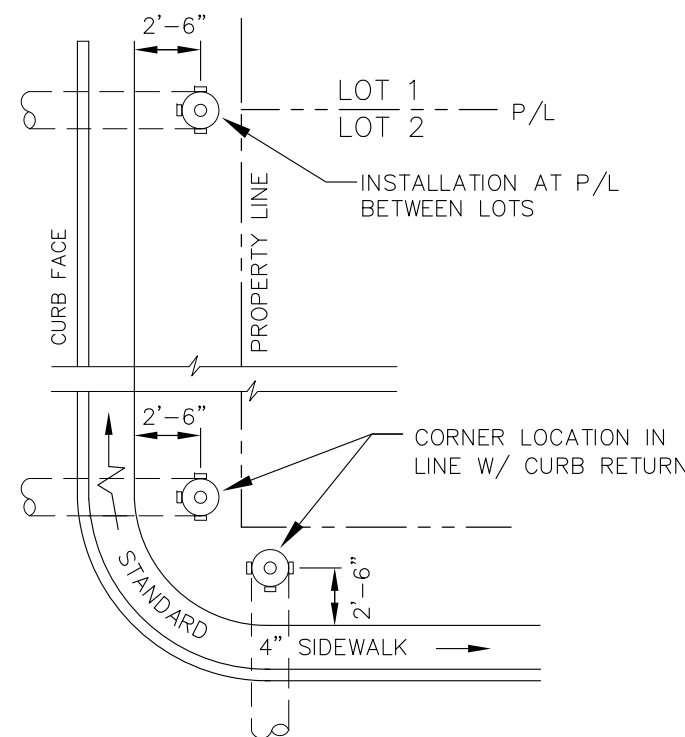


ATTACHED SIDEWALK LOCATION
NO SCALE

FIRE HYDRANT LOCATIONS
NO SCALE

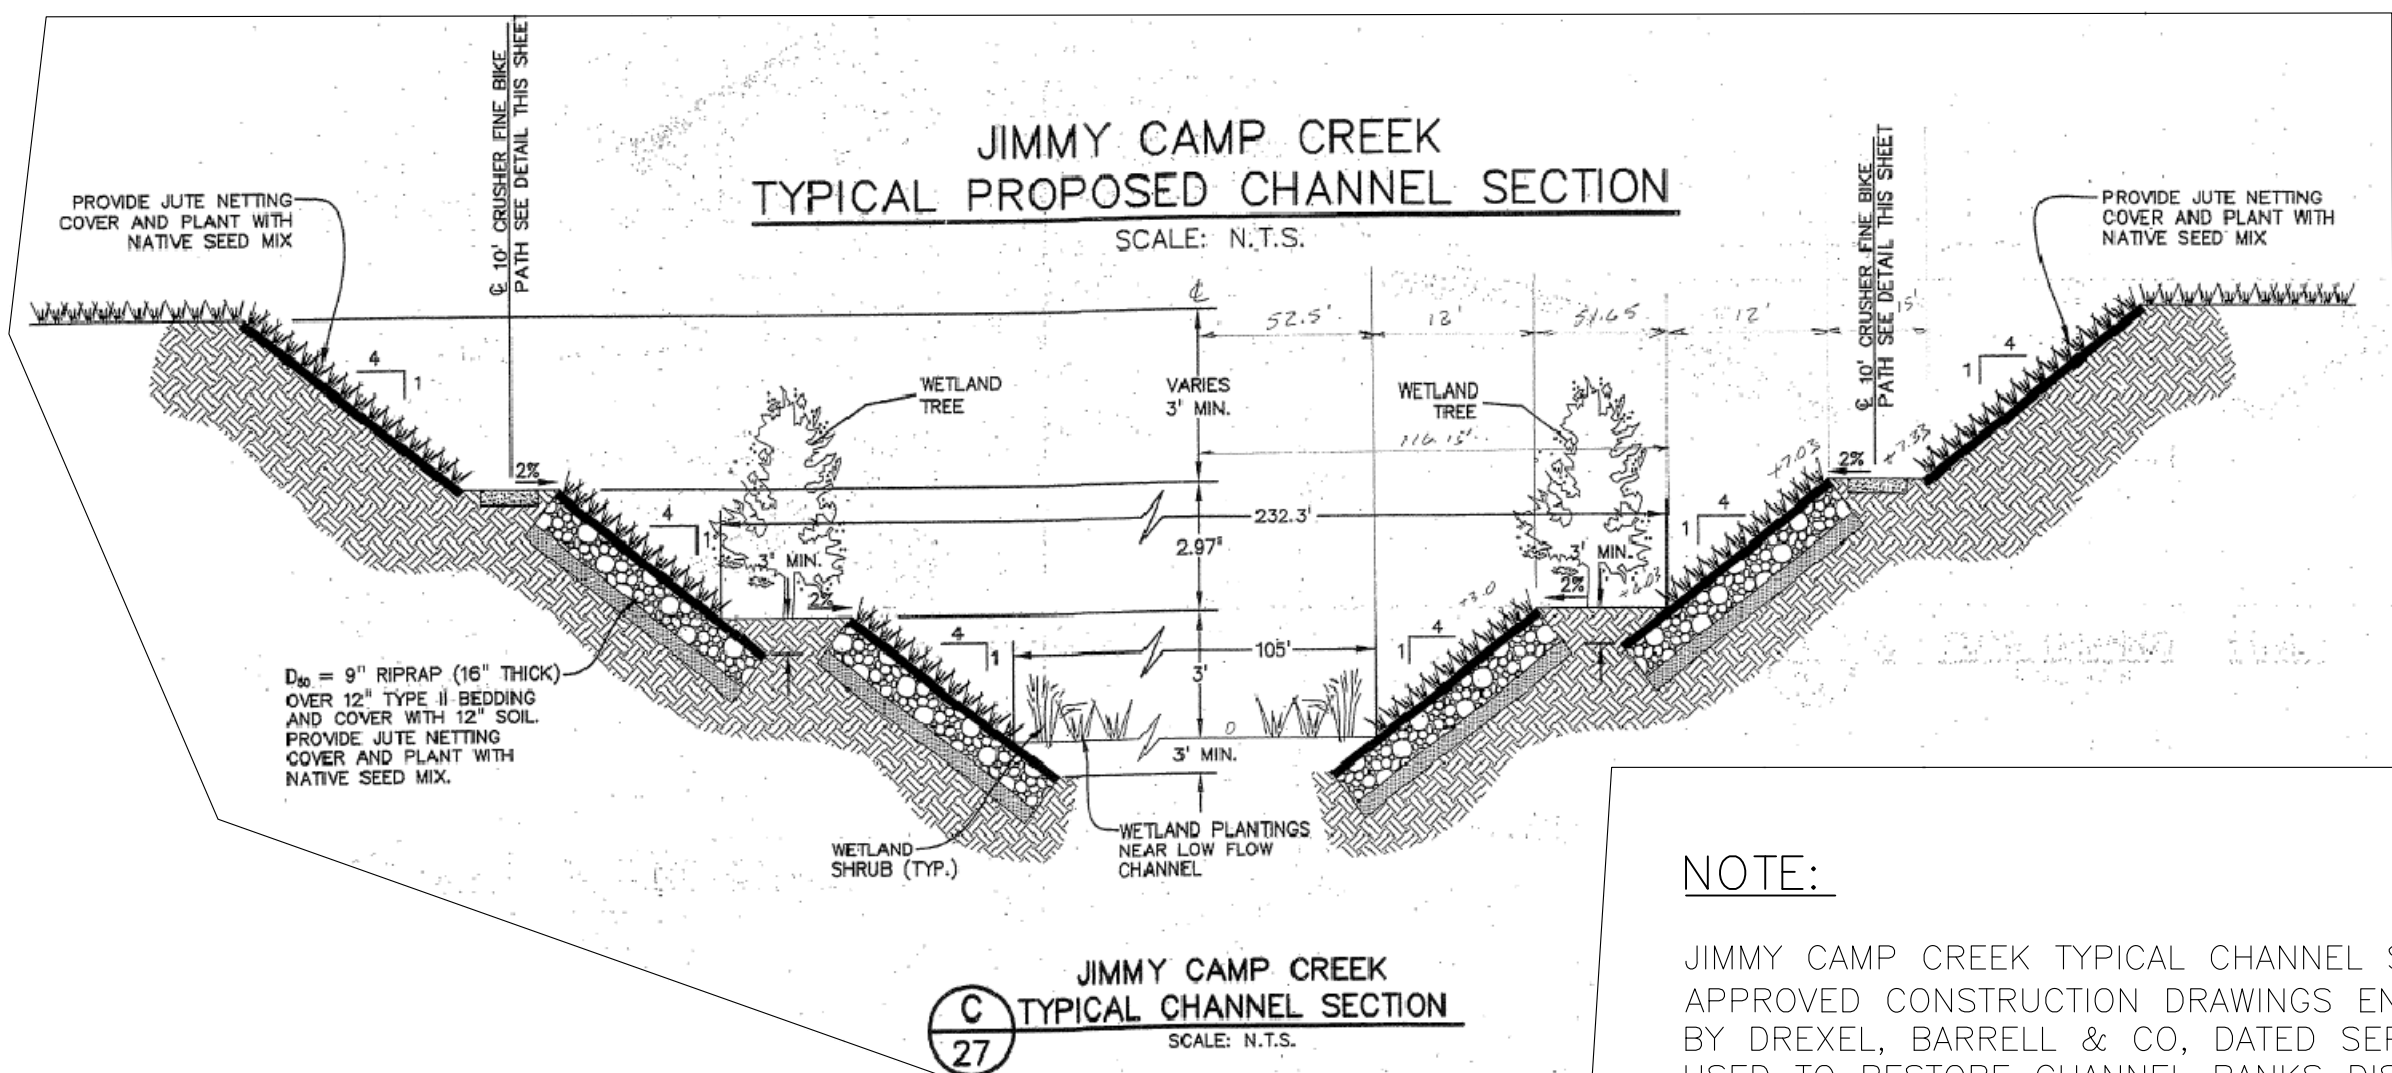

NOTE:

JIMMY CAMP CREEK TYPICAL CHANNEL SECTION IS TAKEN FROM APPROVED CONSTRUCTION DRAWINGS ENTITLED "JIMMY CAMP CREEK REALIGNMENT" BY DREXEL, BARRELL & CO, DATED SEPTEMBER 6, 2005. THIS SECTION IS TO BE USED TO RESTORE CHANNEL BANKS DISTURBED BY WATERMAIN CONSTRUCTION SHOWN ON SHEET C8.1 TO THE ARMORED CONDITION.

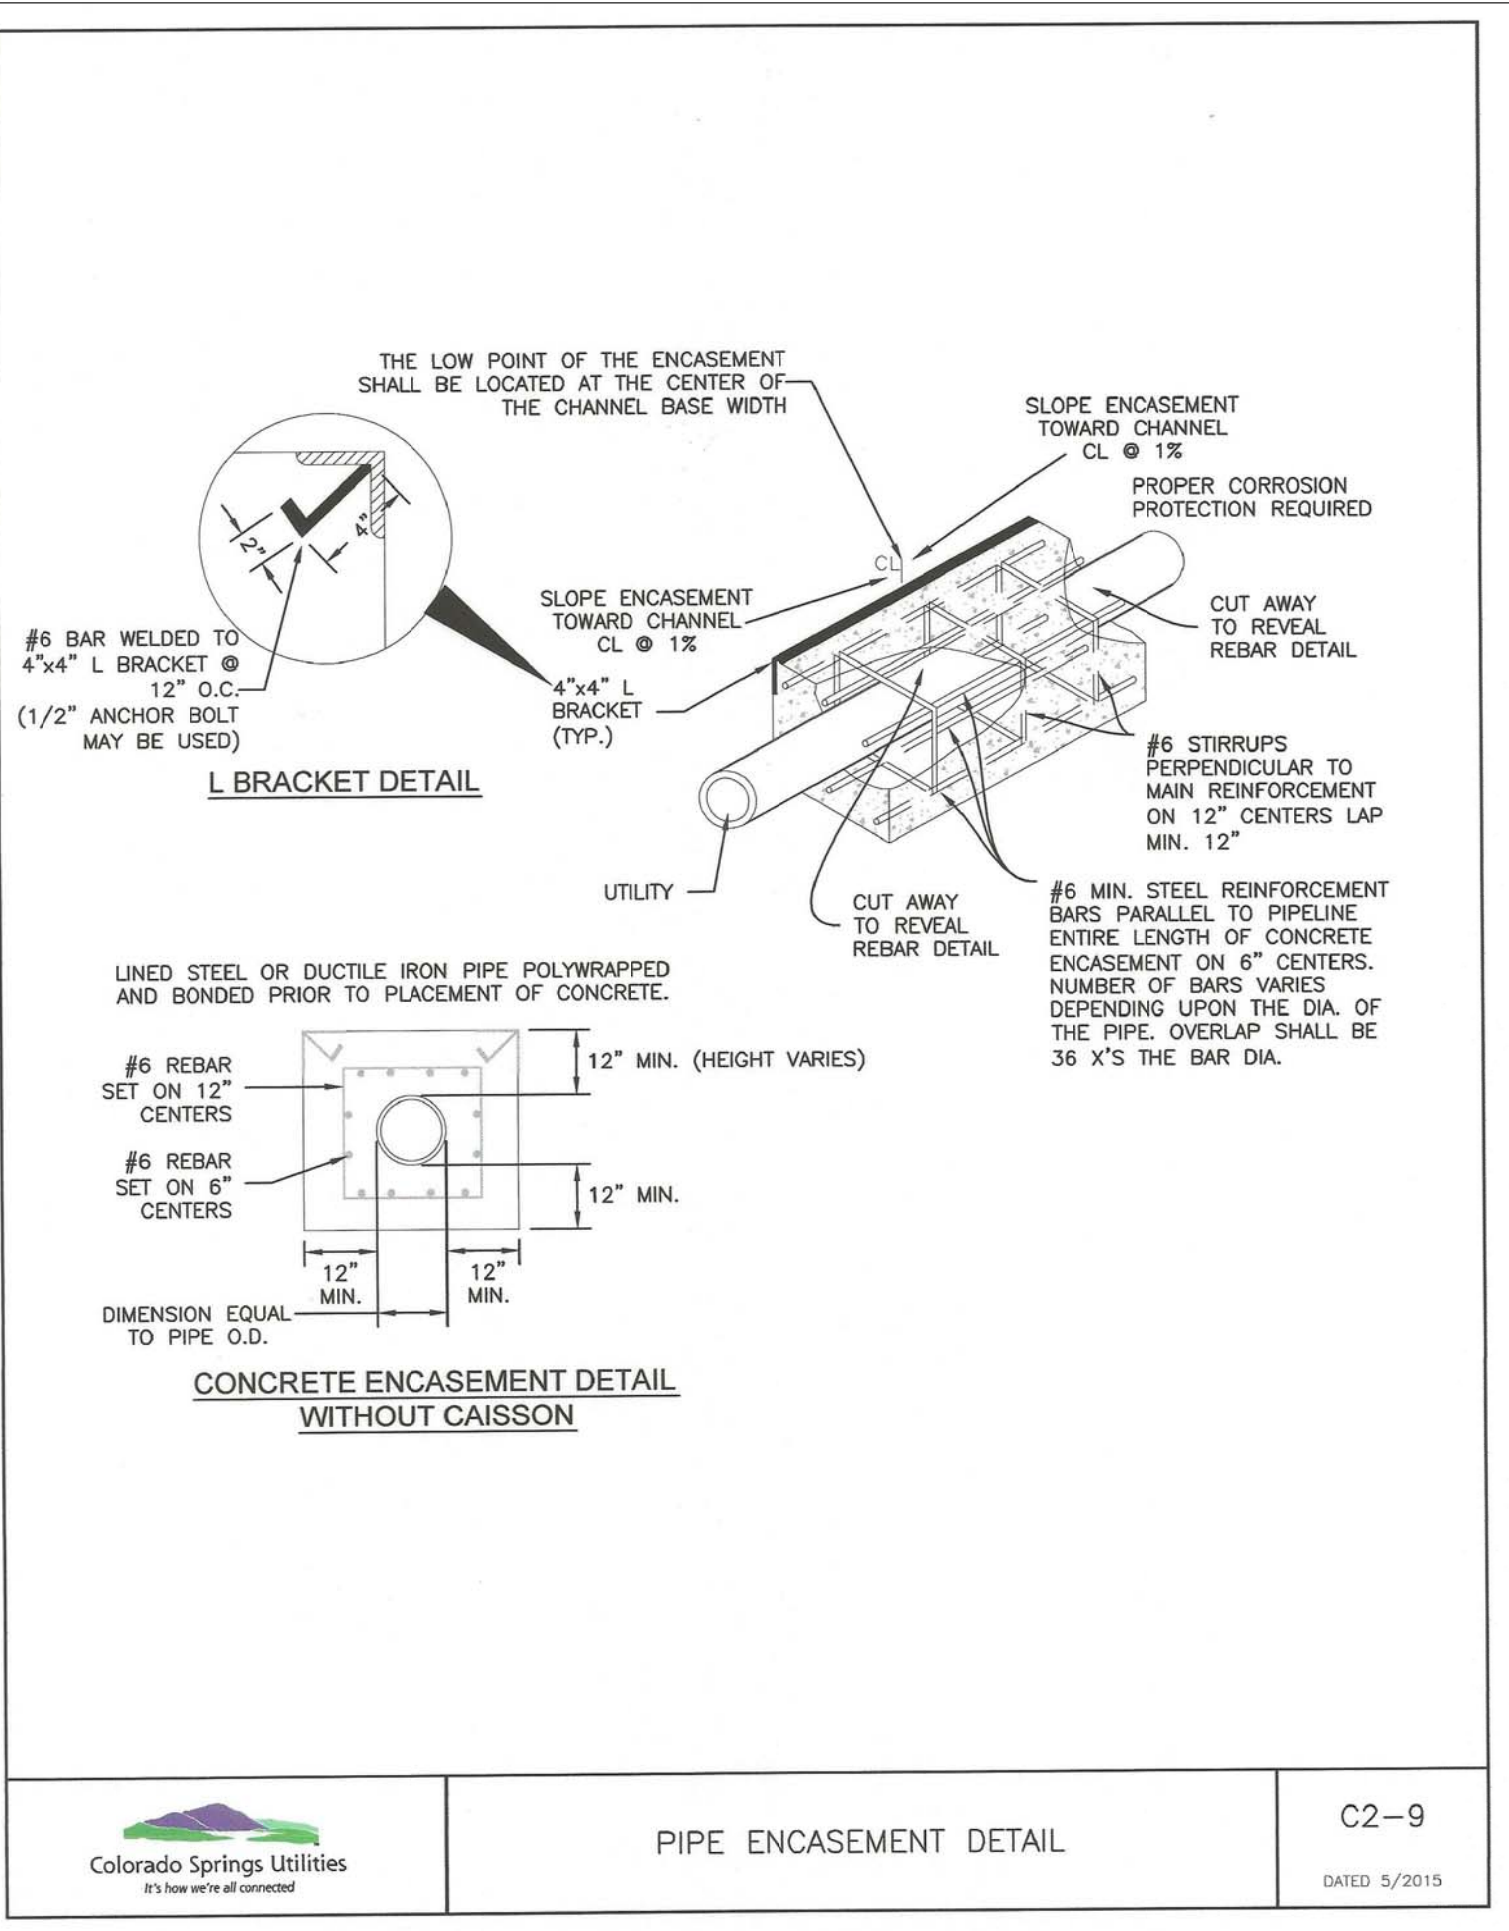

CORE
ENGINEERING GROUP
15004 1ST AVENUE S.
DENVER, CO 80202
PHONE: 719.570.1100
CONTACT: RICHARD L. SCHINDLER, P.E.
EMAIL: Rich@ceg1.com



NO.	DESCRIPTION	DATE
1.	X	X

PREPARED FOR:
LORSON, LLC
212 N. WAHSATCH AVE., SUITE 301
COLORADO SPRINGS, COLORADO 80903
(719) 635-3200
CONTACT: JEFF MARK

PROJECT:
JCC BRIDGE
JCC MAIN CHANNEL - LORSON BLVD.
EL PASO COUNTY, COLORADO

DRAWN: LJA
DESIGNED: RLS
CHECKED: RLS

WATERMAIN DETAILS AND
STREET TYPICAL SECTION
JCC BRIDGE AT MAIN CHANNEL

DATE
SEPT 15, 2017



PROJECT NO.
100.030

SHEET NUMBER

C1.3

TOTAL SHEETS: 36

Striping Notes:
1. All pavement markings shall be in compliance with the current Manual on Uniform Traffic Control Devices (MUTCD).
2. Any deviation from the striping plan shall be approved by El Paso County Planning and Community Development.
3. All longitudinal lines shall be a minimum 15mil thickness epoxy paint.
4. The contractor shall notify El Paso County Planning and Community Development (719) 520-6819 prior to and upon completion of signing and striping.

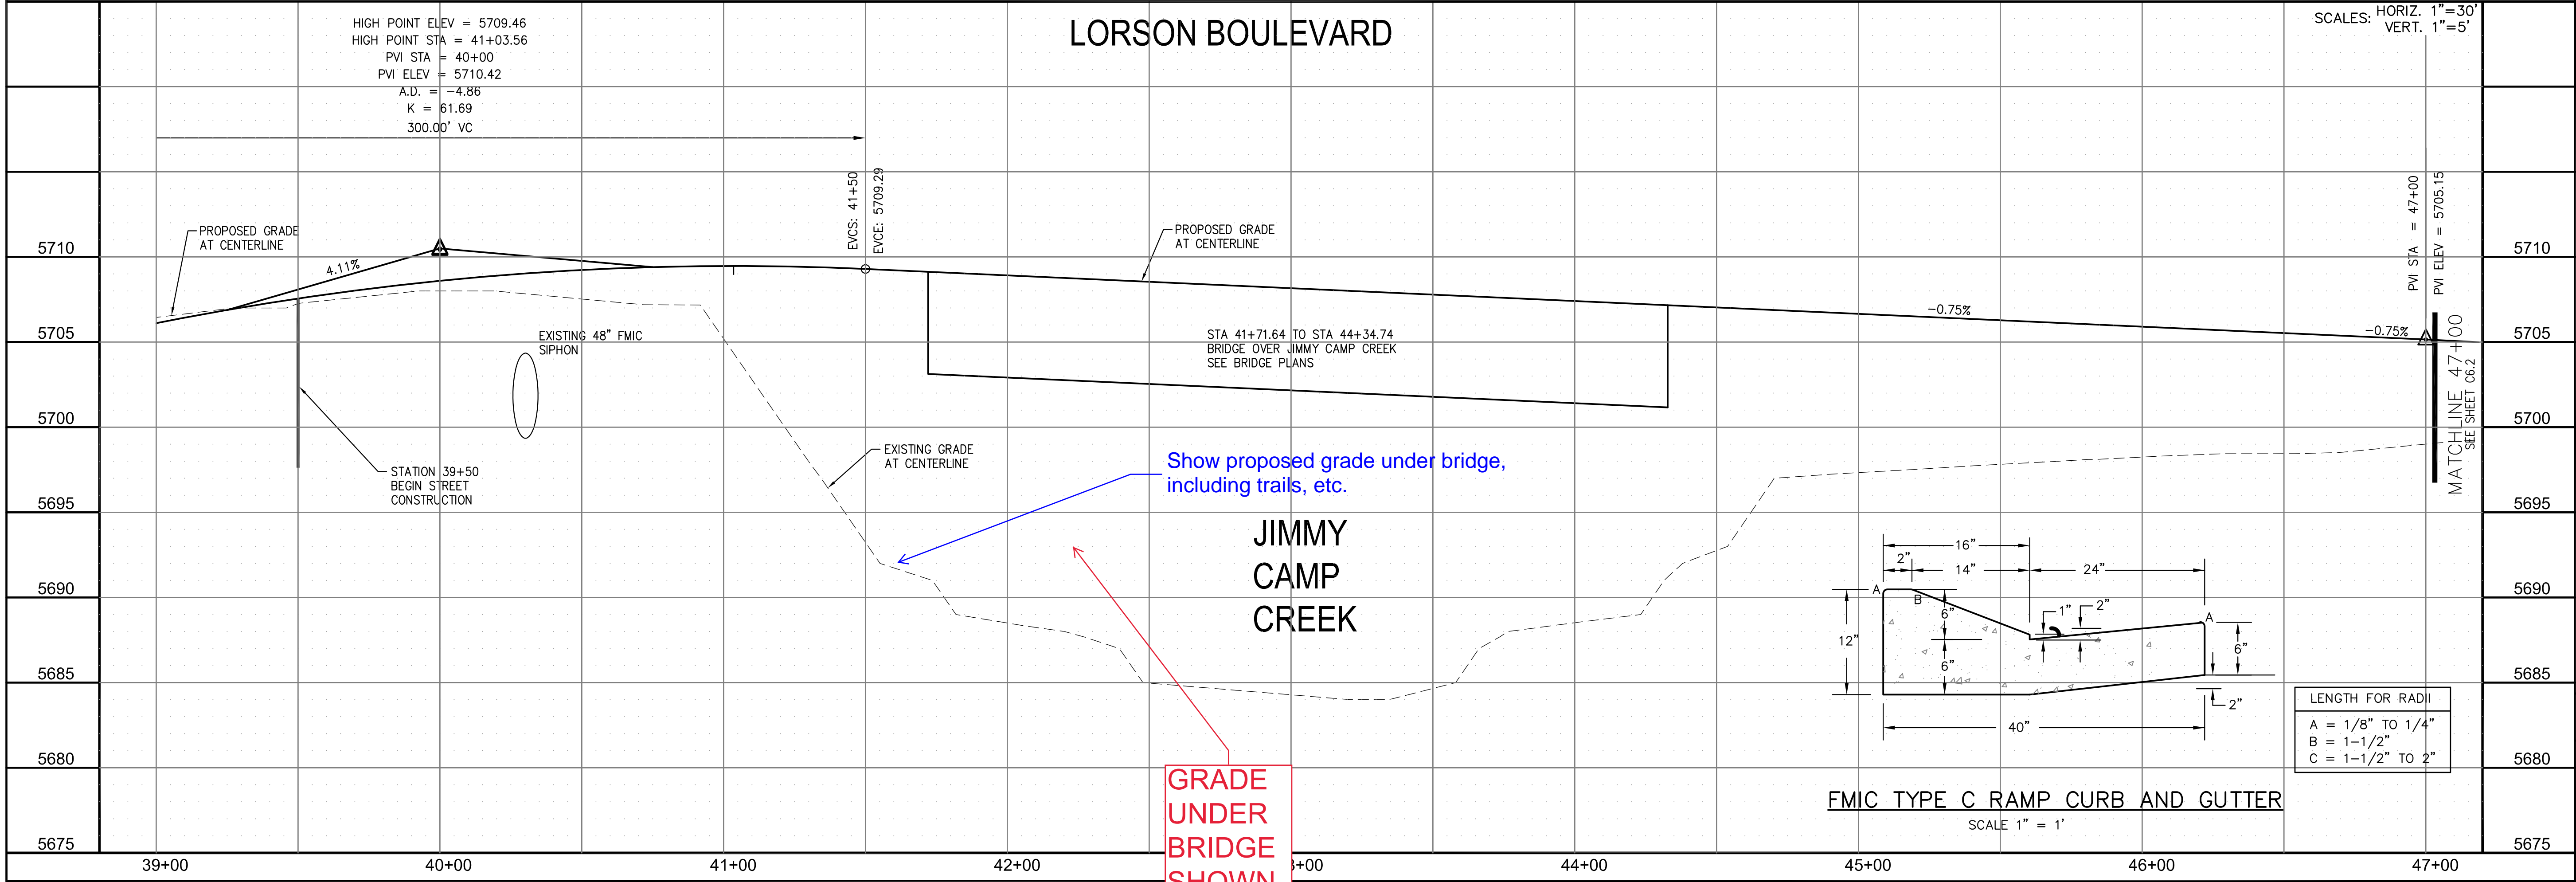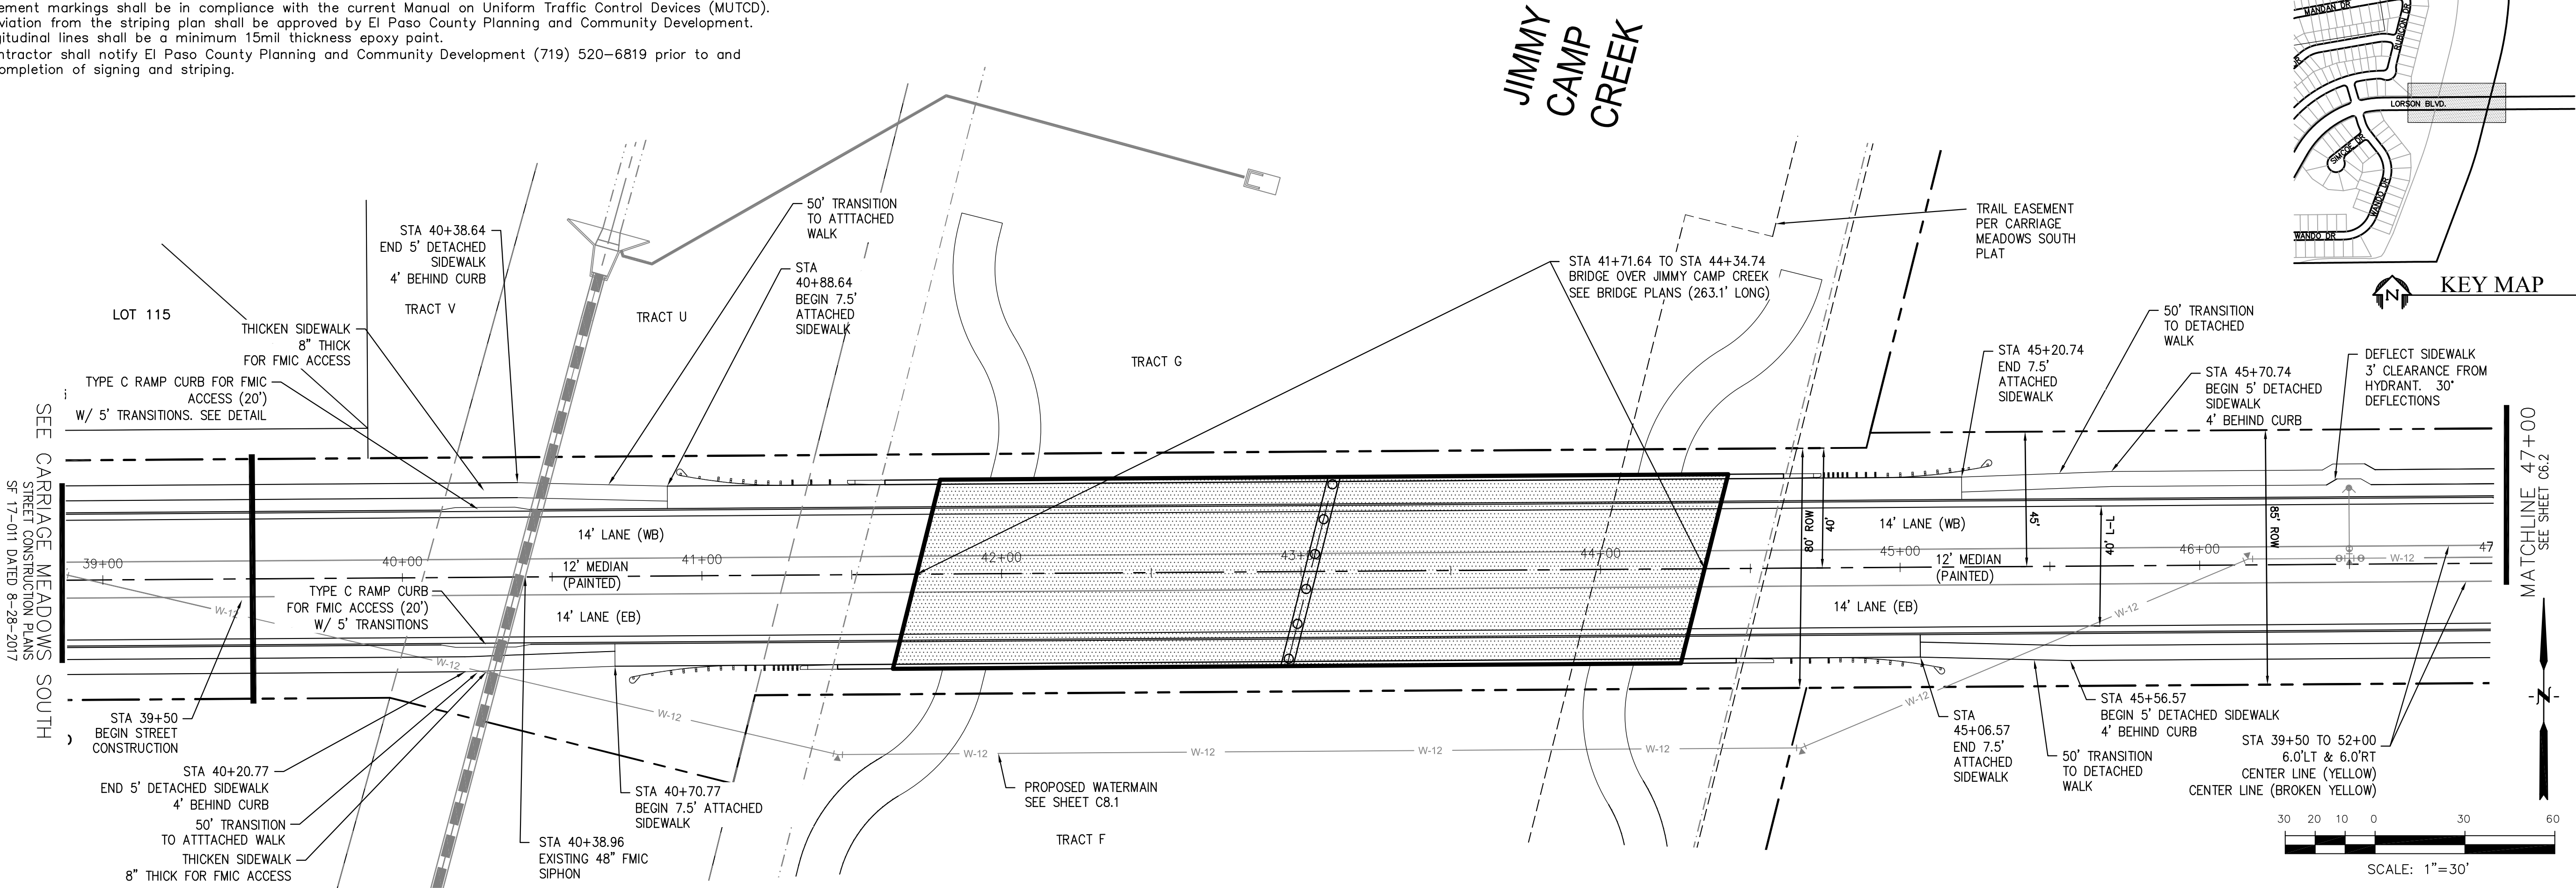

CORE

ENGINEERING GROUP

15004 1ST AVENUE S.
BURNESVILLE, CO 81615
CONTACT: RICHARD L. SCHINDLER, P.E.
EMAIL: Rich@ceg1.com

DATE

NO.

1.

DESCRIPTION

NO.

1.

PREPARED FOR:

JCC BRIDGE

JCC MAIN CHANNEL - LORSON BLVD.
EL PASO COUNTY, COLORADO

PROJECT NO.

100.030

DATE

SEPT 15, 2017

PROJECT NO.

100.030

SHEET NUMBER

C6.1



TOTAL SHEETS:

36


STREET

STA 39+50 TO STA 47+00


LORSON BOULEVARD

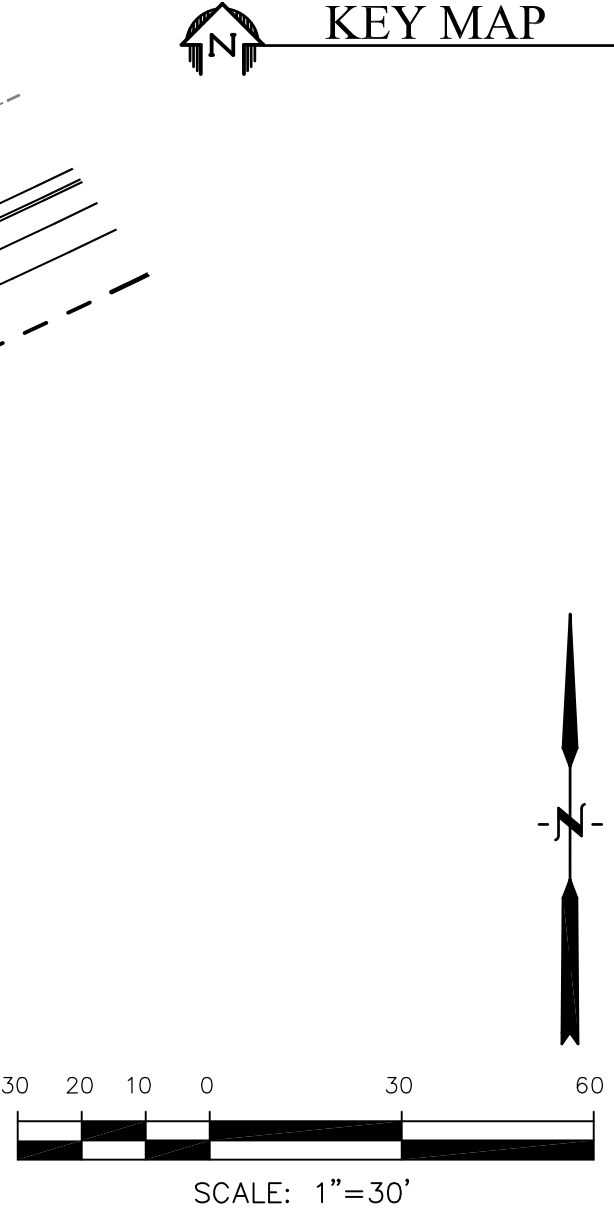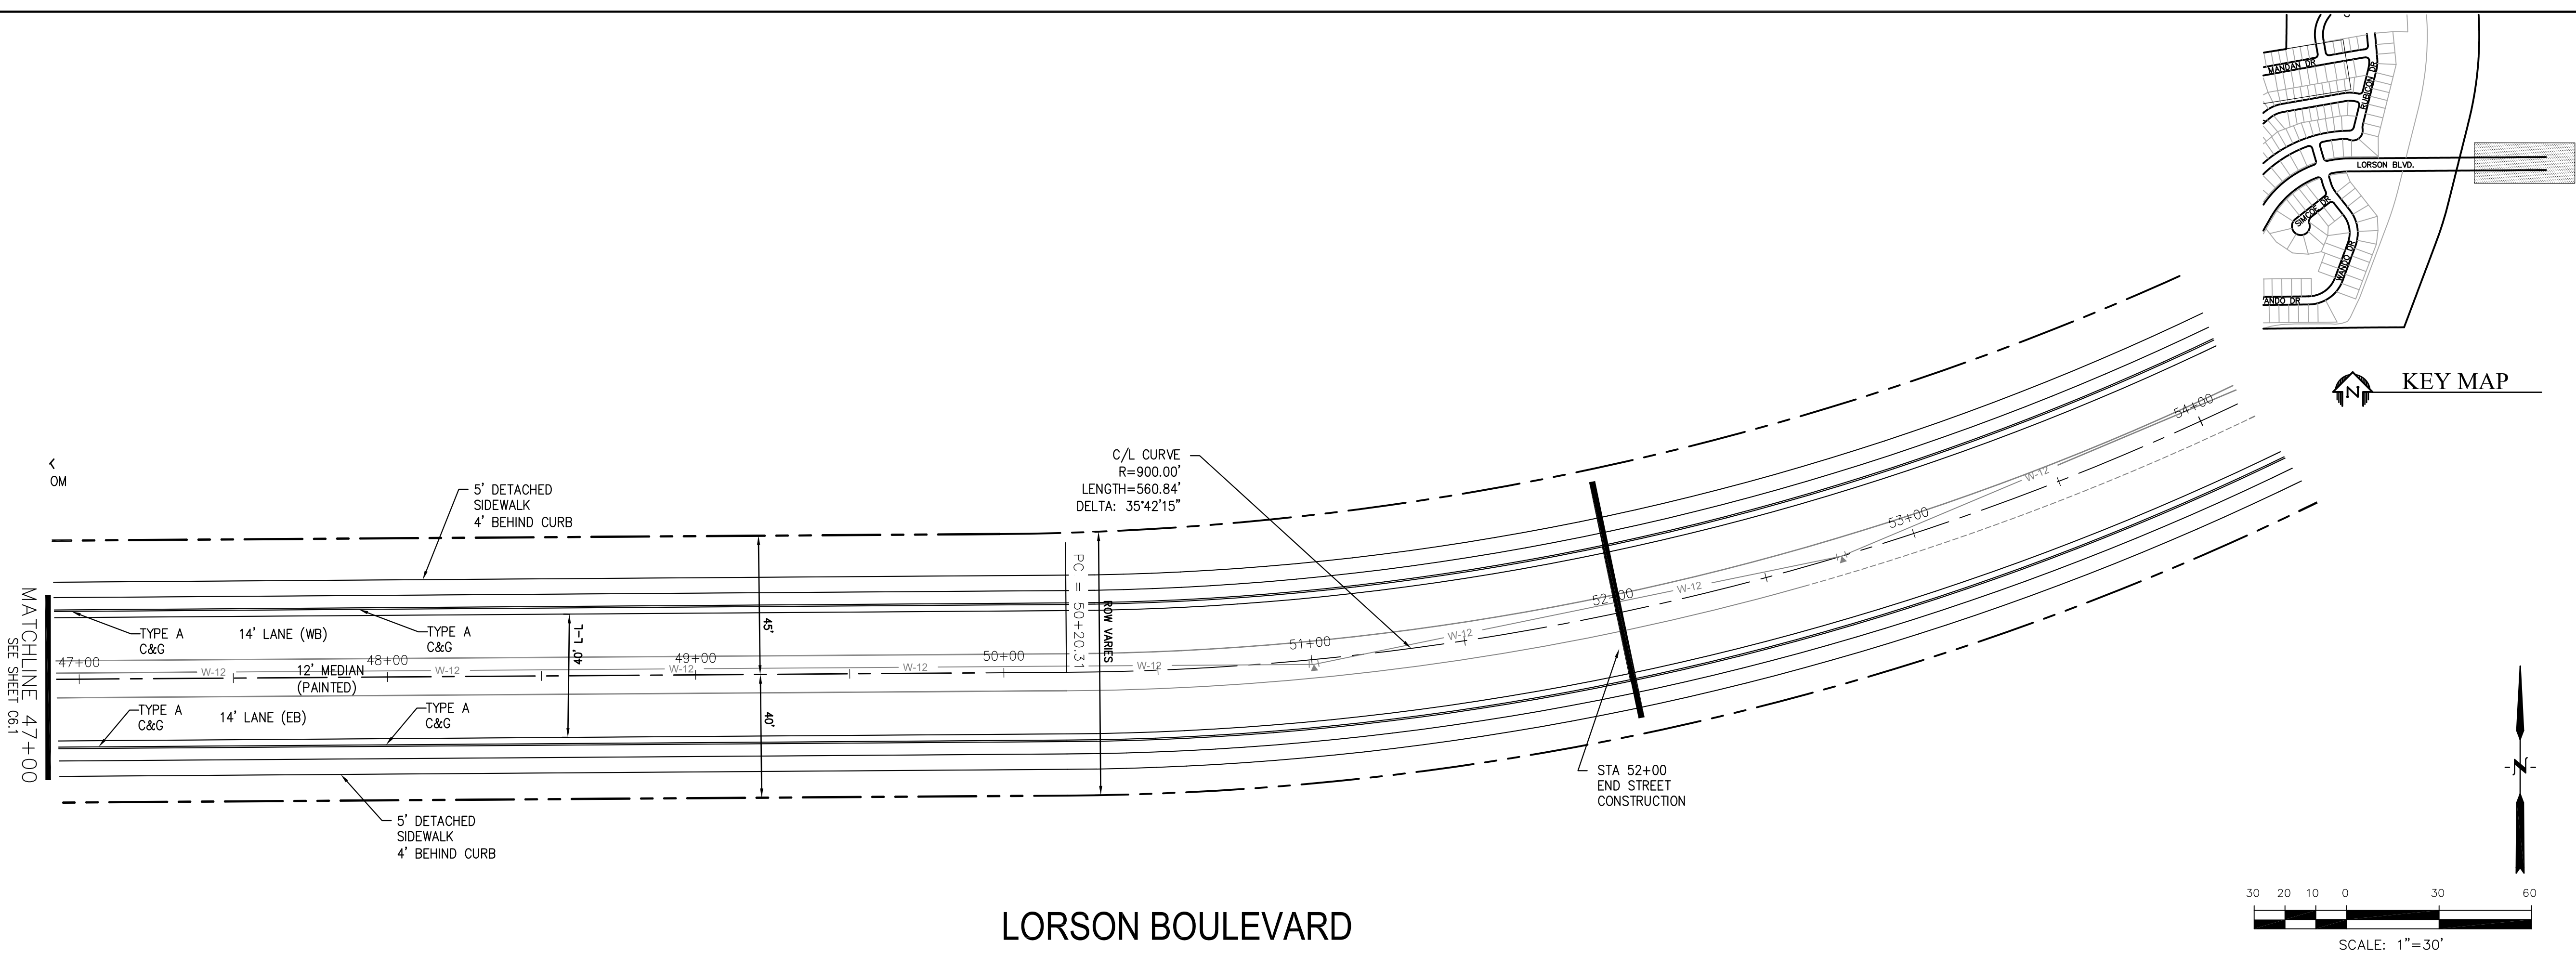

LORSON BOULEVARD



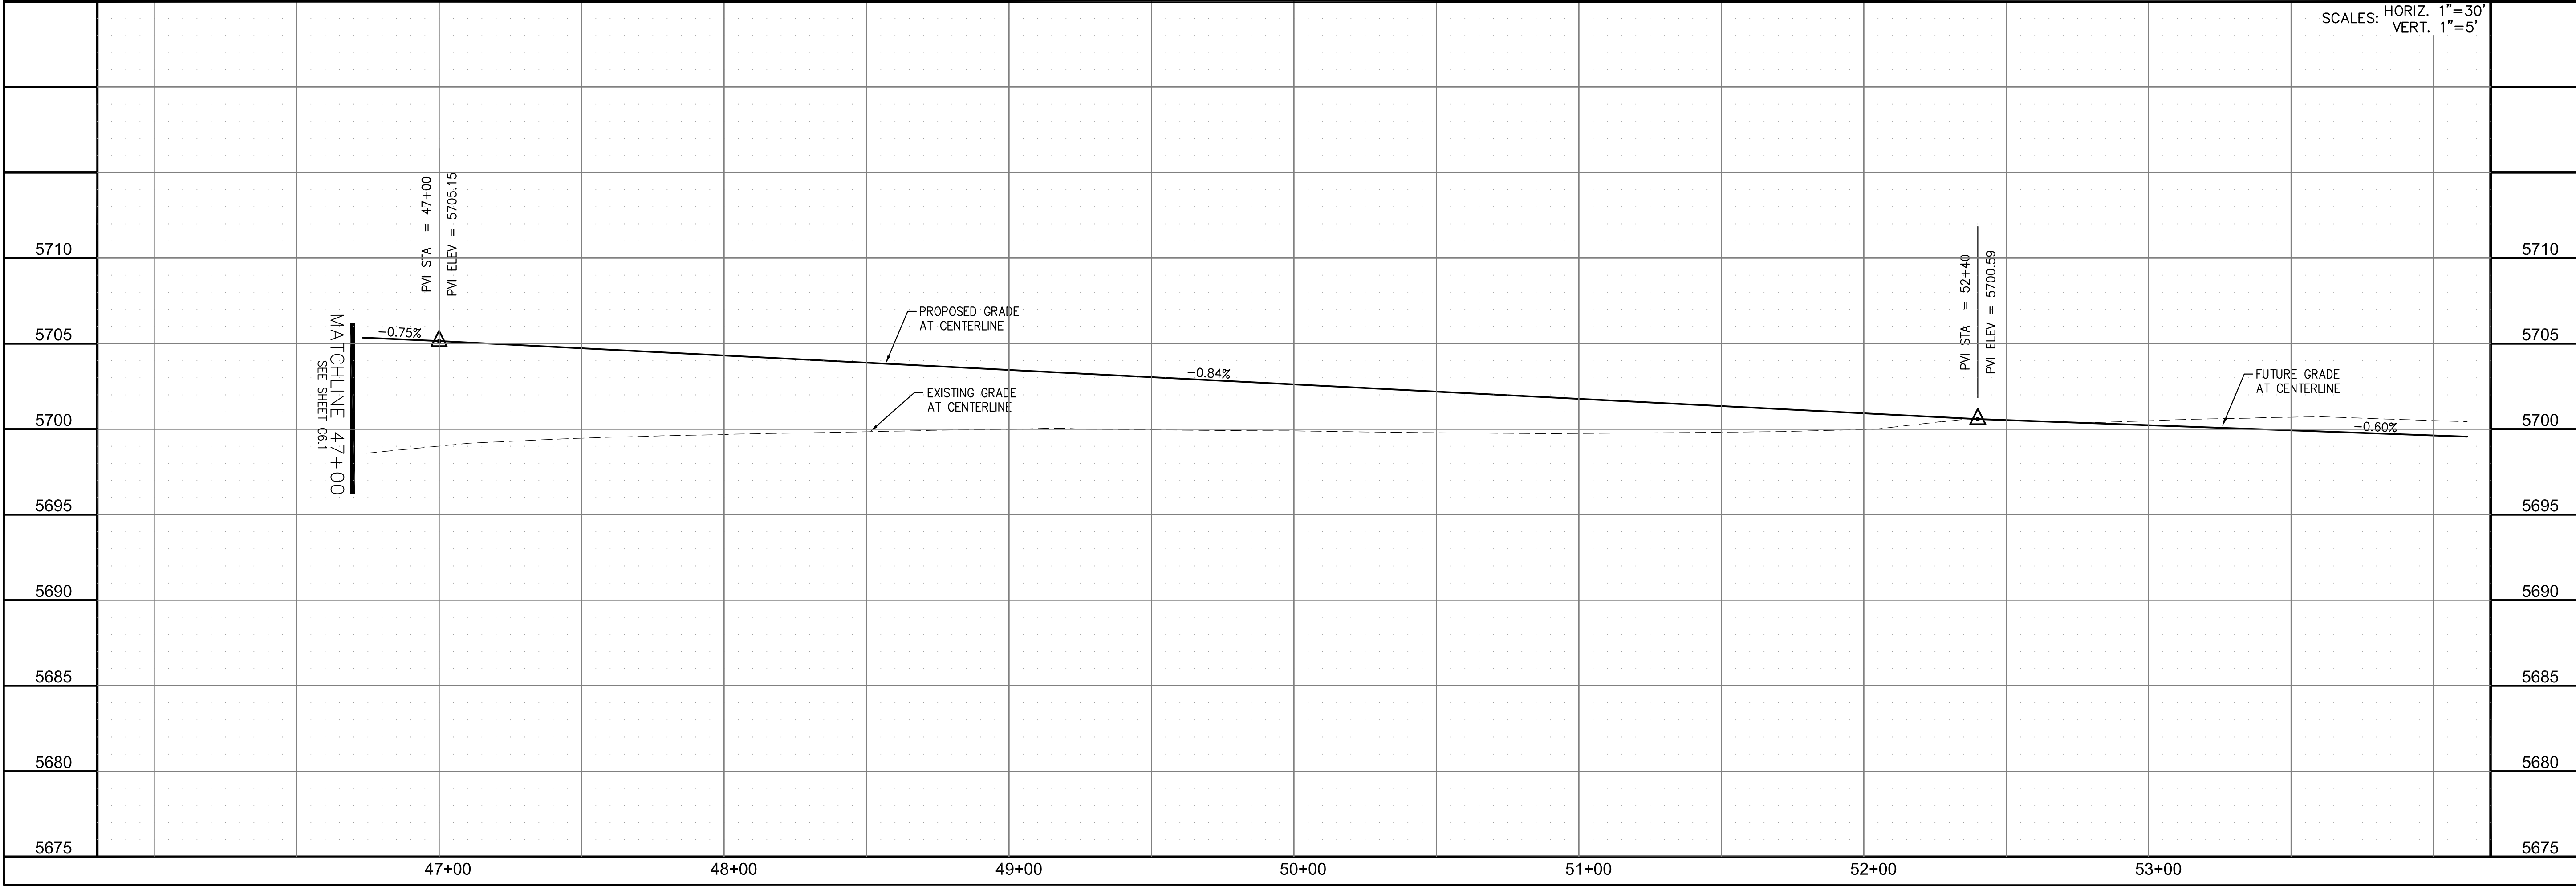


DATE		DESCRIPTION		NO.	
	X			1.	
PROJECT:		JCC BRIDGE		JCC MAIN CHANNEL - LORSON BLVD.	
PREPARED FOR:		LORSON, LLC		212 N. WAHSATCH AVE., SUITE 301	
		COLORADO SPRINGS, COLORADO 80903		(719) 635-3200	
		CONTACT: RICHARD L. SCHINDLER, P.E.		EMAIL: Rich@ceg1.com	
		CONTACT: JEFF MARK			
DATE		SEPT 15, 2017		PROJECT NO.	
				100.030	
				SHEET NUMBER	
				C6.2	
TOTAL SHEETS:		36			

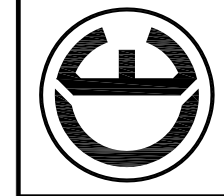

CORE
ENGINEERING GROUP
15004 1ST AVENUE S.
BURNING WOOD, MO 63306
CONTACT: RICHARD L. SCHINDLER, P.E.
EMAIL: Rich@ceg1.com



- NOTES
1. STATIONING REFERS TO ROADWAY CENTERLINE.
 2. TOP OF WATERMAIN 10' OFF ROADWAY C/L IS 5.0' MIN FROM FINISHED GRADE.
 3. WATERMAIN ELEVATIONS ARE TO TOP UNLESS NOTED OTHERWISE.
 4. ALL WATERMAIN IS PVC, C900. ALL SANITARY SEWER IS PVC, SDR35.

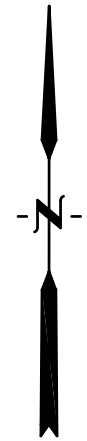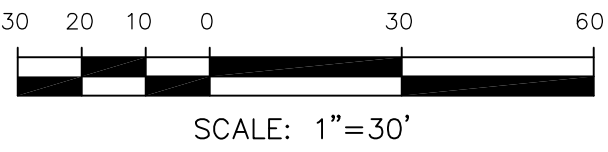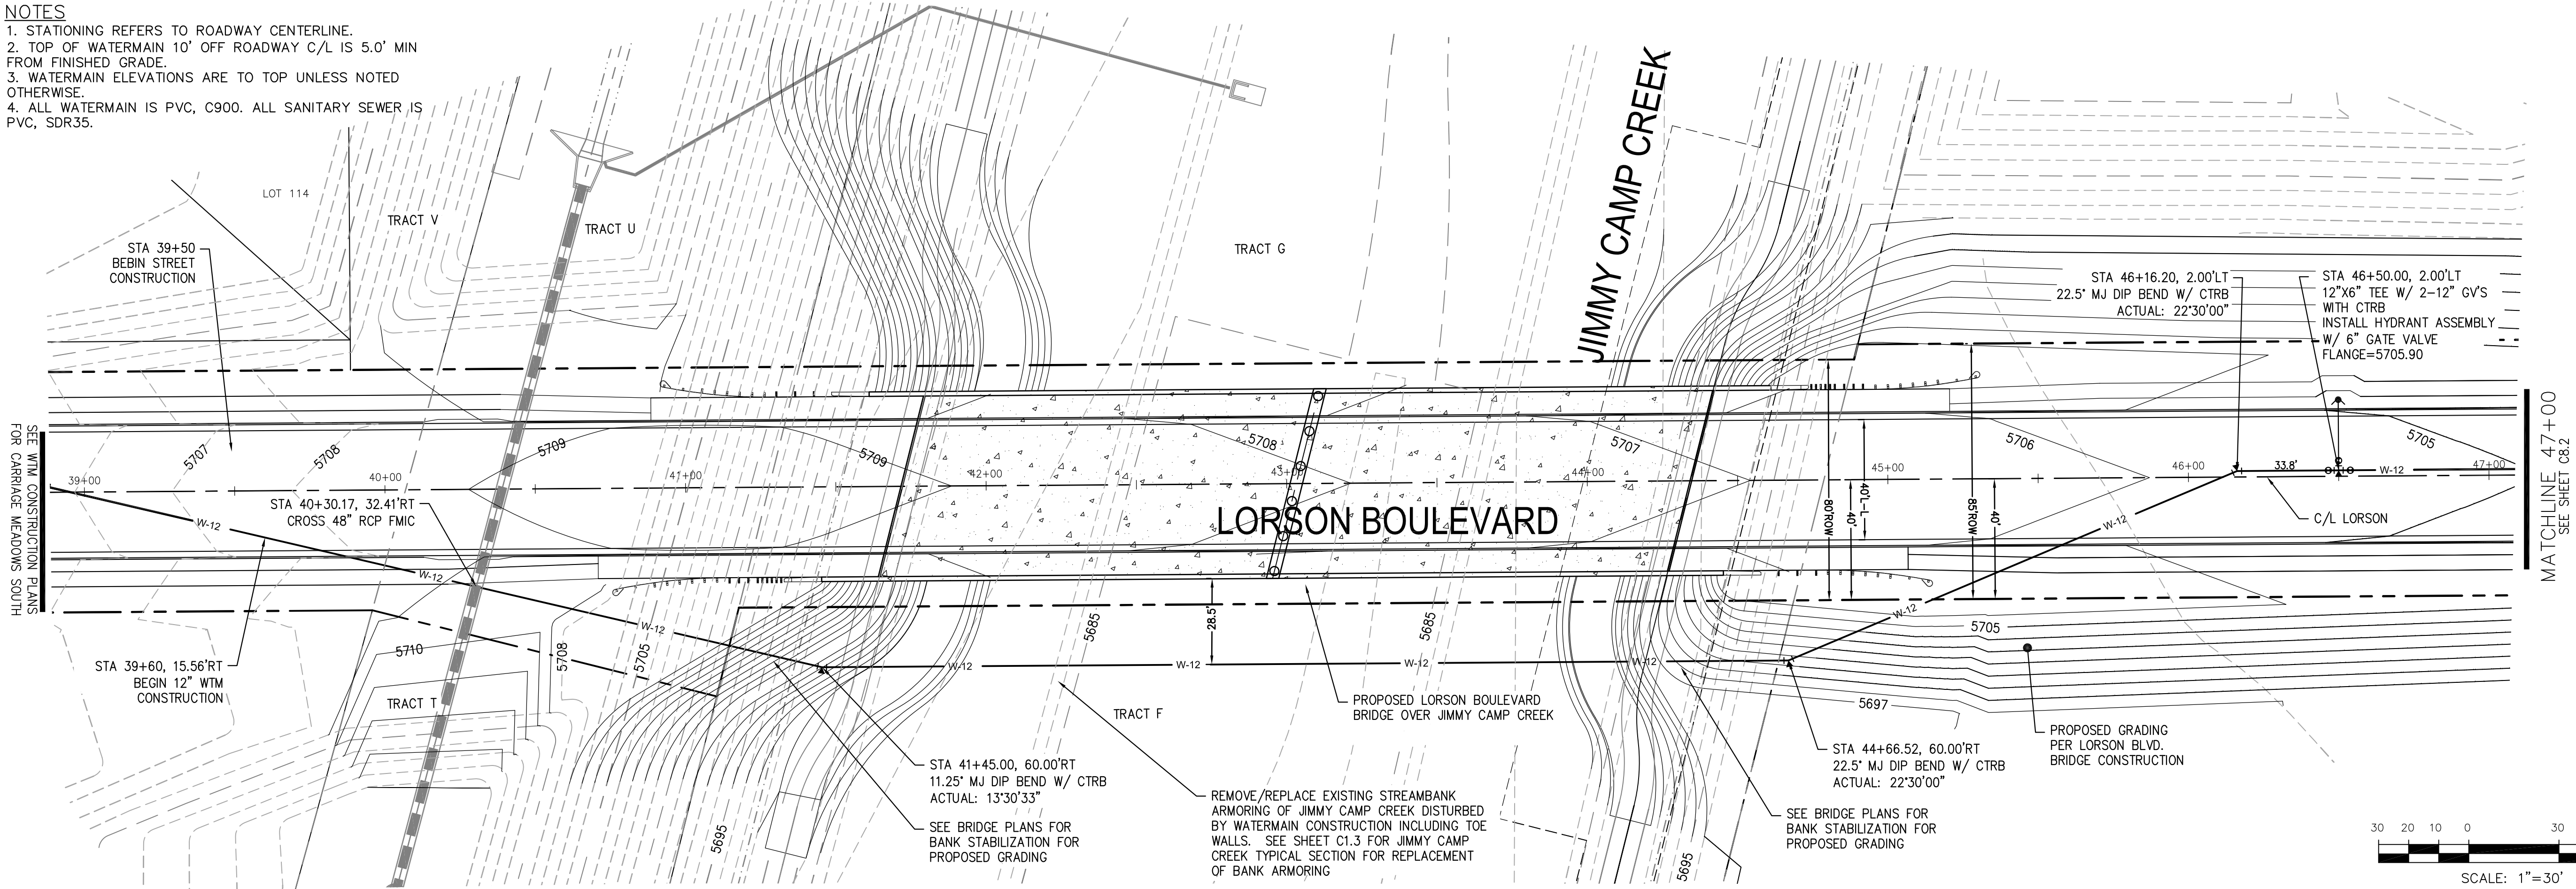

HIGH POINT ELEV = 5709.46
HIGH POINT STA = 41+03.56
PVI STA = 40+00
PVI ELEV = 5710.42
A.D. = -4.86
K = 61.69
300.00' VC

SCALES: HORIZ. 1"=30'
VERT. 1"=5'

FOR WTM CONSTRUCTION PLANS
SEE CARRIAGE MEADOW SOUTH

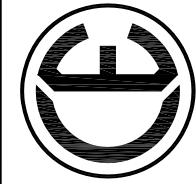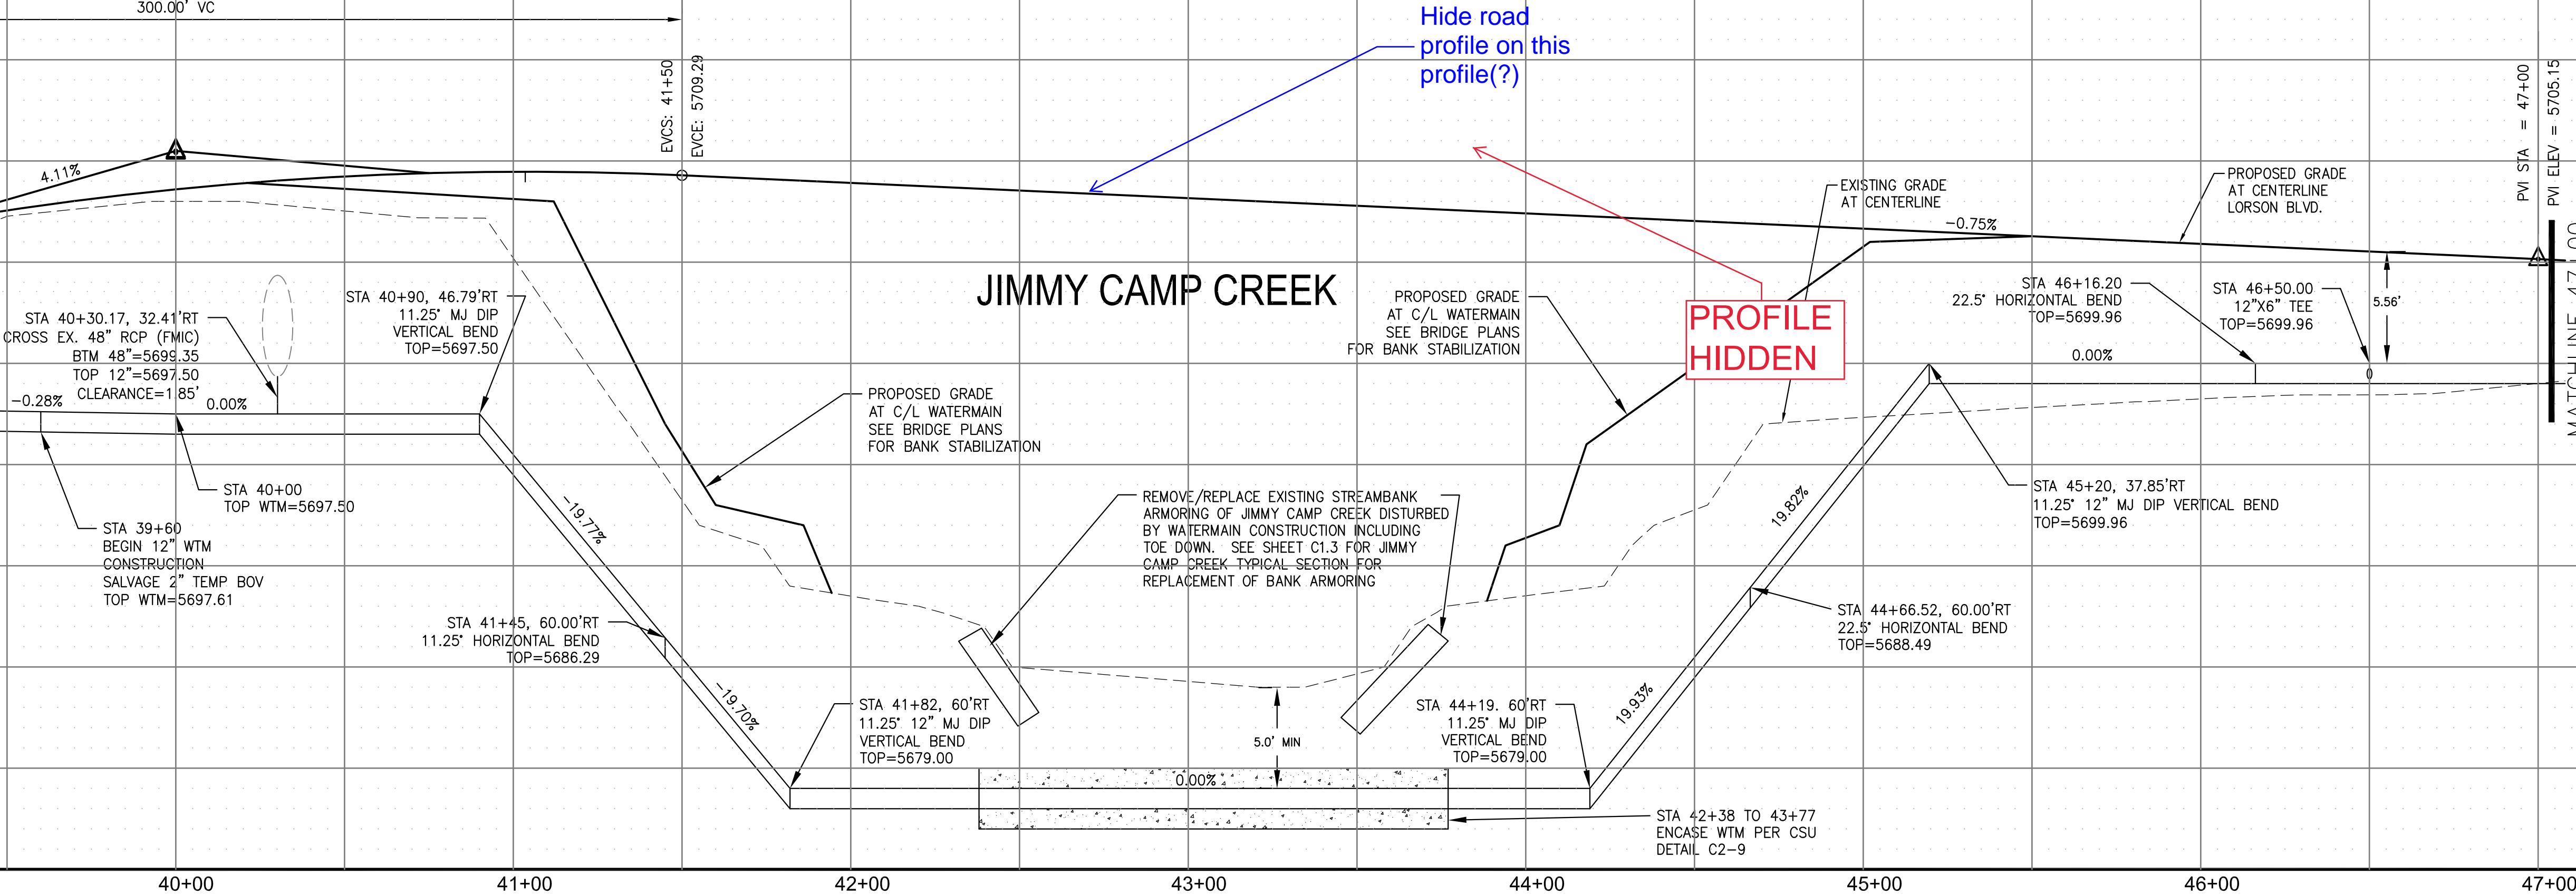


DATE	DESCRIPTION
SEP 15, 2017	STA 39+50 TO STA 47+00
NO.	1.
PROJECT:	JCC BRIDGE JCC MAIN CHANNEL - LORSON BLVD. EL PASO COUNTY, COLORADO
PREPARED FOR:	LORSON, LLC 212 N. WAHSATCH AVE., SUITE 301 COLORADO SPRINGS, COLORADO 80903 (719) 635-3200 CONTACT: JEFF MARK

DRAWN: RLS
DESIGNED: RLS
CHECKED: RLS

WATERMAIN
STA 39+50 TO STA 47+00
LORSON BOULEVARD

1. STATIONING REFERS TO ROADWAY CENTERLINE.
2. TOP OF WATERMAIN 10' OFF ROADWAY C/L IS 5.0' MIN FROM FINISHED GRADE.
3. WATERMAIN ELEVATIONS ARE TO TOP UNLESS NOTED OTHERWISE.
4. ALL WATERMAIN IS PVC, C900. ALL SANITARY SEWER IS PVC, SDR35.

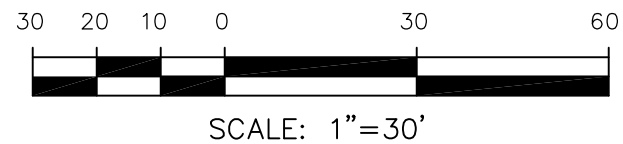[illegible]

BRIDGE DESCRIPTION:

2--SPAN, 263'-1 1/16" LONG (BACK FACE ABUTMENT -- BACK FACE ABUTMENT) BY 63'-0" WIDE PRESTRESSED CONCRETE BULB--TEE GIRDER SUPERSTRUCTURE OVER JIMMY CAMP CREEK. SPAN LENGTHS ARE 130'-0" & ABUTMENT #1 BEARINGS TO & PIER; 130'-0" & PIER TO & ABUTMENT #3 BEARINGS. ROADWAY ON TANGENT ALIGNMENT. 75'33'38" SKEW.

GENERAL NOTES:

- A. ALL WORK SHALL BE IN ACCORDANCE WITH THE COLORADO DEPARTMENT OF TRANSPORTATION 2011 STANDARD SPECIFICATIONS FOR ROAD AND BRIDGE CONSTRUCTION.
- B. EXCEPT AS SHOWN ON THE PLANS, STRUCTURE EXCAVATION AND BACKFILL SHALL BE IN ACCORDANCE WITH M-206-2 FOR BRIDGES.
- C. EXPANSION JOINT MATERIAL SHALL MEET AASHTO SPECIFICATION M213.
- D. THE FINAL FINISH FOR THE SURFACES OF THE TYPE 7 BRIDGE RAIL AND CURBS SHALL BE CLASS 2. ALL OTHER EXPOSED CONCRETE SURFACES SHALL RECEIVE A CLASS 1 FINISH TO ONE FOOT BELOW FINISHED GRADE.
- E. LEVELING PADS ARE UNLAMINATED BEARINGS. THEY SHALL BE CUT OR MOLDED FROM AASHTO ELASTOMER GRADE 3, 4, OR 5 AS DESCRIBED IN TABLES 705-1 AND 705-2 WITH A DUROMETER (SHORE "A") HARDNESS OF 60.
- F. GRADE 60 REINFORCING STEEL IS REQUIRED.
- G. ALL REINFORCING STEEL SHALL BE EPOXY COATED UNLESS OTHERWISE NOTED. (N) DENOTES NON-EPOXY COATED REINFORCING STEEL.
- H. ALL STRUCTURAL STEEL NOT OTHERWISE NOTED SHALL BE A588 WEATHERING STEEL IN ACCORDANCE WITH SECTION 509 OF THE STANDARD SPECIFICATIONS.
- I. THE FOLLOWING STRUCTURAL STEEL SHALL BE AASHTO M270 GRADE 50 (ASTM A-572): BEARING PLATES AND PILING. THE FOLLOWING STRUCTURAL STEEL SHALL BE ASTM A-53, GRADE B: PEDESTRIAN HANDRAIL ON BRIDGE RAIL TYPE 7 (SPECIAL).
- J. ALL RAILING STEEL SHALL BE PAINTED AFTER FABRICATION IN ACCORDANCE WITH SECTION 509 OF THE STANDARD SPECIFICATIONS. COLOR SHALL BE SELECTED BY THE OWNER.
- K. ALL BOLTS SHALL BE 3/8" DIAMETER, HIGH STRENGTH, UNLESS NOTED OTHERWISE.
- L. AN EMERGENCY DECK CONSTRUCTION JOINT MAY BE LOCATED AT THE ONE QUARTER SPAN POINT BACK FROM AN ABUTMENT WITH RESPECT TO THE DIRECTION OF THE DECK PLACEMENT.
- M. ALL LONGITUDINAL AND TRANSVERSE DIMENSIONS ARE MEASURED HORIZONTALLY AND INCLUDE NO CORRECTION FOR GRADE.
- N. THE CONTRACTOR SHALL BE RESPONSIBLE FOR THE STABILITY OF THE STRUCTURE DURING CONSTRUCTION.
- O. PERMANENT DECK FORMS ARE OPTIONAL.
- P. FOR STRUCTURE NUMBER INSTALLATION, SEE STANDARD S-614-12.
- Q. STATIONS, ELEVATIONS, AND DIMENSIONS CONTAINED IN THESE PLANS ARE CALCULATED FROM A RECENT FIELD SURVEY. THE CONTRACTOR SHALL VERIFY ALL DEPENDENT DIMENSIONS IN THE FIELD BEFORE ORDERING OR FABRICATING ANY MATERIAL.
- R. THE INFORMATION SHOWN ON THESE PLANS CONCERNING THE TYPE AND LOCATION OF UNDERGROUND UTILITIES IS NOT GUARANTEED TO BE ACCURATE OR ALL INCLUSIVE. THE CONTRACTOR IS RESPONSIBLE FOR MAKING HIS OWN DETERMINATION AS TO THE TYPE AND LOCATION OF UNDERGROUND UTILITIES AS MAY BE NECESSARY TO AVOID DAMAGE THERETO. THE CONTRACTOR SHALL CONTACT THE UTILITY NOTIFICATION CENTER OF COLORADO AT 1-800-922-1987 AT LEAST 2 DAYS (NOT INCLUDING THE DAY OF NOTIFICATION) PRIOR TO ANY EXCAVATION OR OTHER EARTHWORK.
- S. CONCENTRATIONS OF WATER-SOLUBLE SULFATES WERE MEASURED TO BE 0.08 PERCENT. THE CONCRETE SULFATE EXPOSURE FOR THIS PROJECT IS CLASS 0.
- T. THE FOLLOWING TABLE GIVES THE MINIMUM LAP SPLICE LENGTH FOR EPOXY COATED REINFORCING BARS PLACED IN ACCORDANCE WITH SUBSECTION 602.06. THESE SPLICE LENGTHS SHALL BE INCREASED BY 25% FOR BARS SPACED AT LESS THAN 6" ON CENTER OR LESS THAN 3" OF LATERAL COVER.
- | | | | | | | | | |
|---|-------|-------|-------|--------|-------|-------|--------|-------|
| BAR SIZE | #4 | #5 | #6 | #7 | #8 | #9 | #10 | #11 |
| SPLICE LENGTH FOR CLASS B OR D CONCRETE | 1'-3" | 1'-7" | 2'-5" | 2'-10" | 3'-8" | 4'-8" | 5'-11" | 7'-3" |
- WHEN THE CONTRACTOR ELECTS TO SUBSTITUTE EPOXY COATED REINFORCEMENT FOR BLACK REINFORCING BARS, THE MINIMUM LAP SPLICE SHALL BE AS DESCRIBED ABOVE.
- U. THE FOLLOWING TABLE GIVES THE MINIMUM LAP SPLICE LENGTH FOR BLACK REINFORCING BARS PLACED IN ACCORDANCE WITH SUBSECTION 602.06. THESE SPLICE LENGTHS SHALL BE INCREASED BY 25% FOR BARS SPACED AT LESS THAN 6" ON CENTER OR LESS THAN 3" OF LATERAL COVER.
- | | | | | | | | | |
|---|-------|-------|-------|--------|-------|-------|--------|--------|
| BAR SIZE | #4 | #5 | #6 | #7 | #8 | #9 | #10 | #11 |
| SPLICE LENGTH FOR CLASS B OR D CONCRETE | 1'-1" | 1'-4" | 1'-7" | 1'-11" | 2'-6" | 3'-1" | 3'-11" | 4'-10" |
- V. THE ABOVE SPLICE LENGTHS SHALL BE INCREASED BY 20% FOR 3 BAR BUNDLES AND 33% FOR 4 BAR BUNDLES.

DESIGN DATA:

- G. AASHTO, SIXTH EDITION LRFD WITH CURRENT INTERIMS.
- H. DESIGN METHOD: LOAD AND RESISTANCE FACTOR DESIGN.
- LIVE LOAD: HL-93 (DESIGN TRUCK OR TANDEM, AND DESIGN LANE LOAD)
- DEAD LOAD: ASSUMES 36 POUNDS PER SQUARE FOOT FOR BRIDGE DECK OVERLAY
ASSUMES 5 POUNDS PER SQUARE FOOT FOR PERMANENT STEEL DECK FORMS
ASSUMES 5 POUNDS PER SQUARE FOOT FOR UTILITIES

I. REINFORCED CONCRETE:

CLASS B CONCRETE: f'c = 4,500 PSI
CLASS D CONCRETE: f'c = 4,500 PSI
CLASS BZ CONCRETE: f'c = 4,000 PSI

REINFORCING STEEL: fy = 60,000 PSI

PRECAST PRESTRESSED CONCRETE:

CLASS PS CONCRETE: f'c = (SEE DETAILS)
f's = 270,000 PSI

SECTION OR DETAIL IDENTIFICATION

CROSS REFERENCE DRAWING NUMBER
(IF BLANK, REFERENCE IS TO SAME SHEET)

STRUCTURAL STEEL:


AASHTO M270 (ASTM A709) GRADE 36; fy = 36,000 PSI
AASHTO M270 (ASTM A709) GRADE 50; fy = 50,000 PSI



PRELIMINARY
NOT FOR CONSTRUCTION

FOUNDATION NOTES:

- A. **GEOTECHNICAL REPORT:** STRUCTURAL FOUNDATION DESIGN FOR THIS PROJECT IS BASED ON THE RECOMMENDATIONS OF A GEOTECHNICAL INVESTIGATION BY RMG -- ROCKY MOUNTAIN GROUP, DATED APRIL 3, 2017 (RMG REPORT 155271).
- B. **DRIVEN PILES:** A REPRESENTATIVE FROM RMG, (719) 548-0060, SHALL BE PRESENT TO OBSERVE FOUNDATION INSTALLATION OPERATIONS. COST TO BE INCLUDED IN ITEM 502. PILES SHALL BE INSTALLED TO PRACTICAL REFUSAL AS DEFINED IN THE STANDARD SPECIFICATIONS.
- C. **PILE DRIVING ANALYZER (PDA):** ONE PILE PER SUBSTRUCTURE SHALL BE MONITORED USING A PDA PER THE STANDARD SPECIFICATIONS. THE CONTRACTOR'S ENGINEER SHALL BE RESPONSIBLE FOR MONITORING AND REPORTING RESULTS TO THE CONTRACTOR AND ENGINEER.
- D. **MINIMUM TIP PENETRATION:** THE MINIMUM PILE PENETRATION SHALL BE 15 FEET BELOW THE BOTTOM OF THE BOTTOM OF ABUTMENT AT EACH SUBSTRUCTURE.
- E. **DRILLING HOLES TO FACILITATE PILE DRIVING (PRE-DRILLING):** SEE PROJECT SPECIAL PROVISIONS

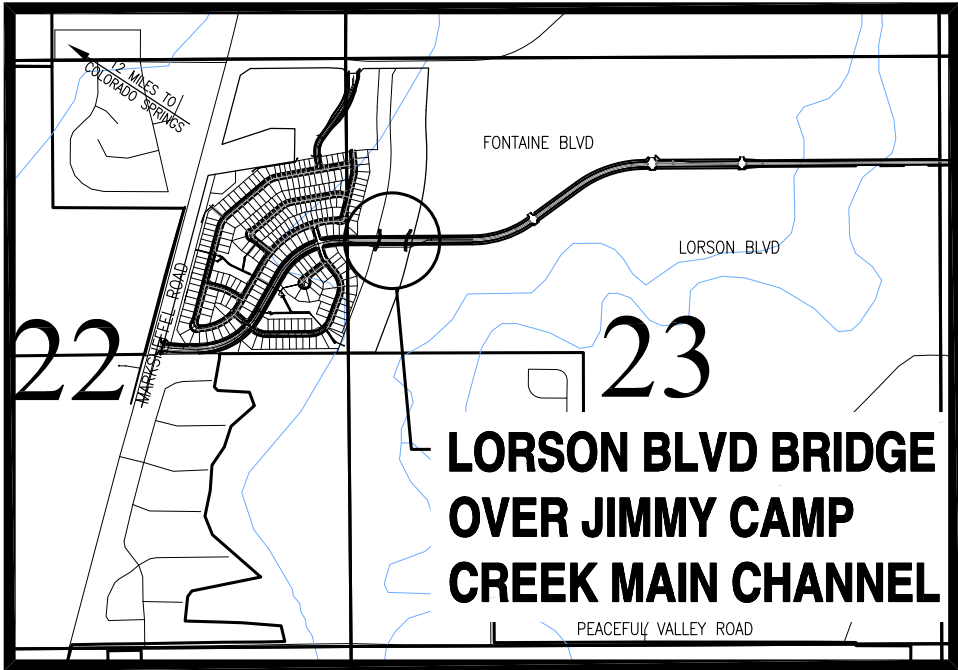

VICINITY MAP

N.T.S.
SECTION 23
TOWNSHIP 15 SOUTH
RANGE 65 WEST

BRIDGE & ROADWAY ABBREVIATIONS

● = AT/AT EACH	E = EPOXY COATED	MIN = MINIMUM	Σ = SURVEY LINE
ABC = AGGREGATE BASE COURSE	EF = EACH FACE	MK = MARK	SCJ = SAW CUT JOINT
ABUT = ABUTMENT	EL/ELEV = ELEVATION	NF = NEAR FACE	SHF = SHEET
ALT = ALTERNATE	EOP = EDGE OF PAVEMENT	NTS = NOT TO SCALE	SIM = SIMILAR
ARCH = ARCHITECTURAL	ETW = EDGE OF TRAVELED WAY	OC = ON CENTER	SPA = SPACING/SPACES
BF = BACK FACE	EST = ESTIMATED	OF = OUTSIDE FACE	SPEC = SPECIFICATIONS
BM = BEAM	EW = EACH WAY	OH = OVERHEAD	SQ = SQUARE
BOF = BOTTOM OF FOOTING	EQUIP = EQUIPMENT	OPNG = OPENING	STA = STATION
BOW = BOTTOM OF WALL	EXIST = EXISTING	OPP = OPPOSITE	STD = STANDARD
BRG = BEARING	EXP = EXPANSION	P = PLATE	SYM = SYMMETRICAL
BTM = BOTTOM	FT = FAR FACE	PC = POINT OF CURVATURE	T & B = TOP & BOTTOM
CL = CENTERLINE	FTG = FOOTING	PEJF = PREFORMED EXPANSION JOINT FILLER	TAN = TANGENT
(CIP) = (COMPLETE IN PLACE)	GAVL = GALVANIZED	PGL = PROFILE GRADE LINE	TH = TEST HOLE
CJ = CONTROL JOINT	GEOTECH = GEOGRAPHICAL	PI = POINT OF INTERSECTION	TOC = TOP OF CONCRETE
CLR = CLEARANCE	GRD BW = GRADE BEAM	PK = KNOWN POINT	TOF = TOP OF FOOTING
CONJ = CONSTRUCTION JOINT	HORIZ = HORIZONTAL	PP = POWER POLE	TOW = TOP OF WALL
COL = COLUMN	HCL = HORIZONTAL CONTROL LINE	PROJ = PROJECTION	TYP = TYPICAL
CONC = CONCRETE	IF = INSIDE FACE	PROP = PROPOSED	UNO = UNLESS NOTED OTHERWISE
CONT = CONTINUOUS	INV EL = INVERT ELEVATION	PT = POINT OF TANGENCY	VERT = VERTICAL
CP = CONTROL POINT	LP = LIGHT POLE	QTY = QUANTITY	VC = VERTICAL CURVE
D = DIAMETER	MAS = MASONRY	R/RAD = RADIUS	VPC = VERTICAL POINT OF CURVATURE
DET = DETAIL	MATL = MATERIAL	REIN = REINFORCING	VPI = VERTICAL POINT OF INTERSECTION
DIAG = DIAGONAL	MAX = MAXIMUM	REF = REFERENCE	VPT = VERTICAL POINT OF TANGENCY
DWG = DRAWING	MB = MAIL BOX	REQD = REQUIRED	WL = WORKING LINE
DWLS = DOWELS	MFR = MANUFACTURER	ROW = RIGHT OF WAY	WP = WORKING POINT
		± = EXISTING FEATURE DIMENSION	WWF = WELDED WIRE FABRIC

DESIGN ENGINEER'S STATEMENT:

THESE DETAILED PLANS AND SPECIFICATIONS WERE PREPARED UNDER MY DIRECTION AND SUPERVISION. SAID PLANS AND SPECIFICATIONS HAVE BEEN PREPARED ACCORDING TO THE CRITERIA ESTABLISHED BY THE COUNTY FOR DETAILED ROADWAY, DRAINAGE, GRADING AND EROSION CONTROL PLANS AND SPECIFICATIONS, AND SAID PLANS AND SPECIFICATIONS ARE IN CONFORMITY WITH APPLICABLE MASTER DRAINAGE PLANS AND MASTER TRANSPORTATION PLANS. SAID PLANS AND SPECIFICATIONS MEET THE PURPOSES FOR WHICH THE PARTICULAR ROADWAY AND DRAINAGE FACILITIES ARE DESIGNED AND ARE CORRECT TO THE BEST OF MY KNOWLEDGE AND BELIEF. I ACCEPT RESPONSIBILITY FOR ANY LIABILITY CAUSED BY ANY NEGLIGENT ACTS, ERRORS OR OMISSIONS ON MY PART IN PREPARATION OF THESE DETAILED PLANS AND SPECIFICATIONS.

PETER J. LORIS, P.E. LICENSE #

DATE

OWNER/DEVELOPER'S STATEMENT:

I, THE OWNER/DEVELOPER HAVE READ AND WILL COMPLY WITH ALL OF THE REQUIREMENTS SPECIFIED IN THESE DETAILED PLANS AND SPECIFICATIONS.

JEFF MARK, PRESIDENT
LORSON, LLC
212 N. WASATCH AVE, SUITE 301
COLORADO SPRINGS, CO 80903

DATE

INDEX OF SHEETS





SHEET NO.	DESCRIPTION	SHEET NO.	DESCRIPTION
B01	BRIDGE GENERAL INFORMATION	B13	PIER #2 PLAN & ELEVATION
B02	BRIDGE GENERAL LAYOUT	B14	PIER #2 DETAILS
B03	ENGINEERING GEOLOGY	B15	PIER DIAPHRAGM DETAILS
B04-B05	HYDRAULIC INFORMATION	B16	SUPERSTRUCTURE DETAILS
B06	CONSTRUCTION LAYOUT	B17	DECK REINFORCING PLAN
B07	FOUNDATION LAYOUT	B18-B19	PRESTRESSED CONCRETE I
B08-B09	ABUTMENTS 1 & 3 PLAN & ELEVATION	B20-B21	PRECAST CONCRETE DECK FORMS
B10-B11	ABUTMENT & WINGWALL DETAILS	B22-B23	BRIDGE RAIL TYPE 7 (SPECIAL)
B12	EXCAVATION AND BACKFILL DETAILS	B24-B27	DECK ELEVATIONS

SUMMARY OF QUANTITIES

CONTRACT ITEM NO.	CONTRACT ITEM DESCRIPTION	UNIT	ABUT #1	PIER #2	ABUT #3	SUPERSTRUCTURE	TOTAL
206	FILTER MATERIAL (CLASS A)	CY	24	30	120	-	265
206	STRUCTURE EXCAVATION	CY	204	712	120	-	1,362
206	STRUCTURE BACKFILL (CLASS 1)	CY	504	-	503	-	1,322
206	MECHANICAL REINFORCEMENT OF SOIL	CY	441	-	480	-	922
420	GEOTEXTILE (DRAINAGE) (CLASS 1)	SY	510	136	539	-	1,185
502	PILING (HP 14x89)	LF	625	-	504	-	1,129
503	DRILLED CAISSON (36 INCH)	LF	-	324	-	-	324
506	RIPRAP (24 INCH)	CY	680	-	718	-	1,399
506	RIPRAP (30 INCH)	CY	-	339	-	-	339
601	CONCRETE CLASS D (BRIDGE)	CY	49	65	49	832	997
602	REINFORCING STEEL	LB	7,003	19,124	7,003	-	224,830
602	REINFORCING STEEL (EPOXY COATED)	LB	13,004	1,986	13,004	117,100	145,093
606	BRIDGE RAIL TYPE 10M (SPECIAL)	LF	-	-	-	596	596
606	TRANSITION TYPE 3G	EA	-	-	-	-	2
606	TRANSITION TYPE 3H	EA	-	-	-	-	2
606	END ANCHORAGE (FLARED)	EA	-	-	-	-	4
613	4" DIAMETER SCH 80 PVC	LF	-	-	-	263	263
613	2" DIAMETER SCH 80 PVC	LF	-	-	-	526	526
613	12.5" CARRIER PIPE ASSEMBLY	LF	-	-	-	714	714
618	PRESTRESSED CONCRETE I (BT 72)	LF	-	-	-	1,820	1,820

C:\72 Clients\369 - Lorson\16136 - Lorson Bridge\50 DWG\16136 (B02) Bridge General Layout.dwg Sep 26, 2017 4:14pm

PRELIMINARY
NOT FOR CONSTRUCTION

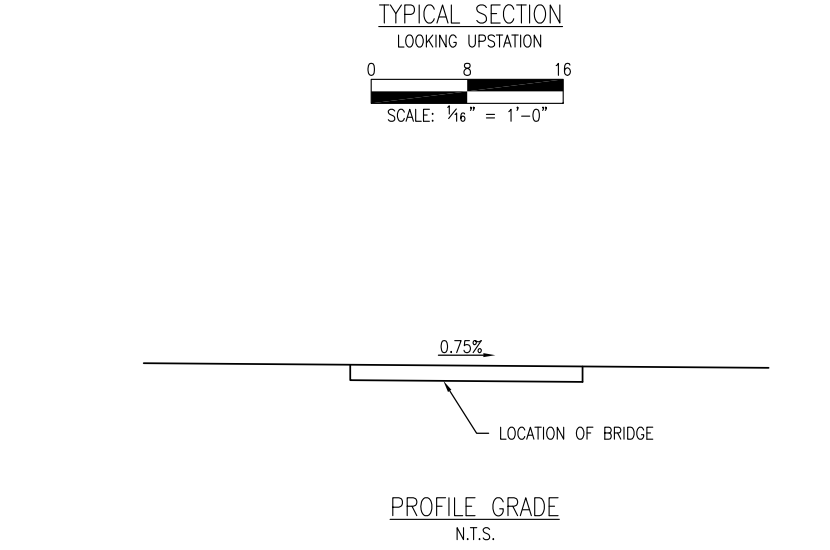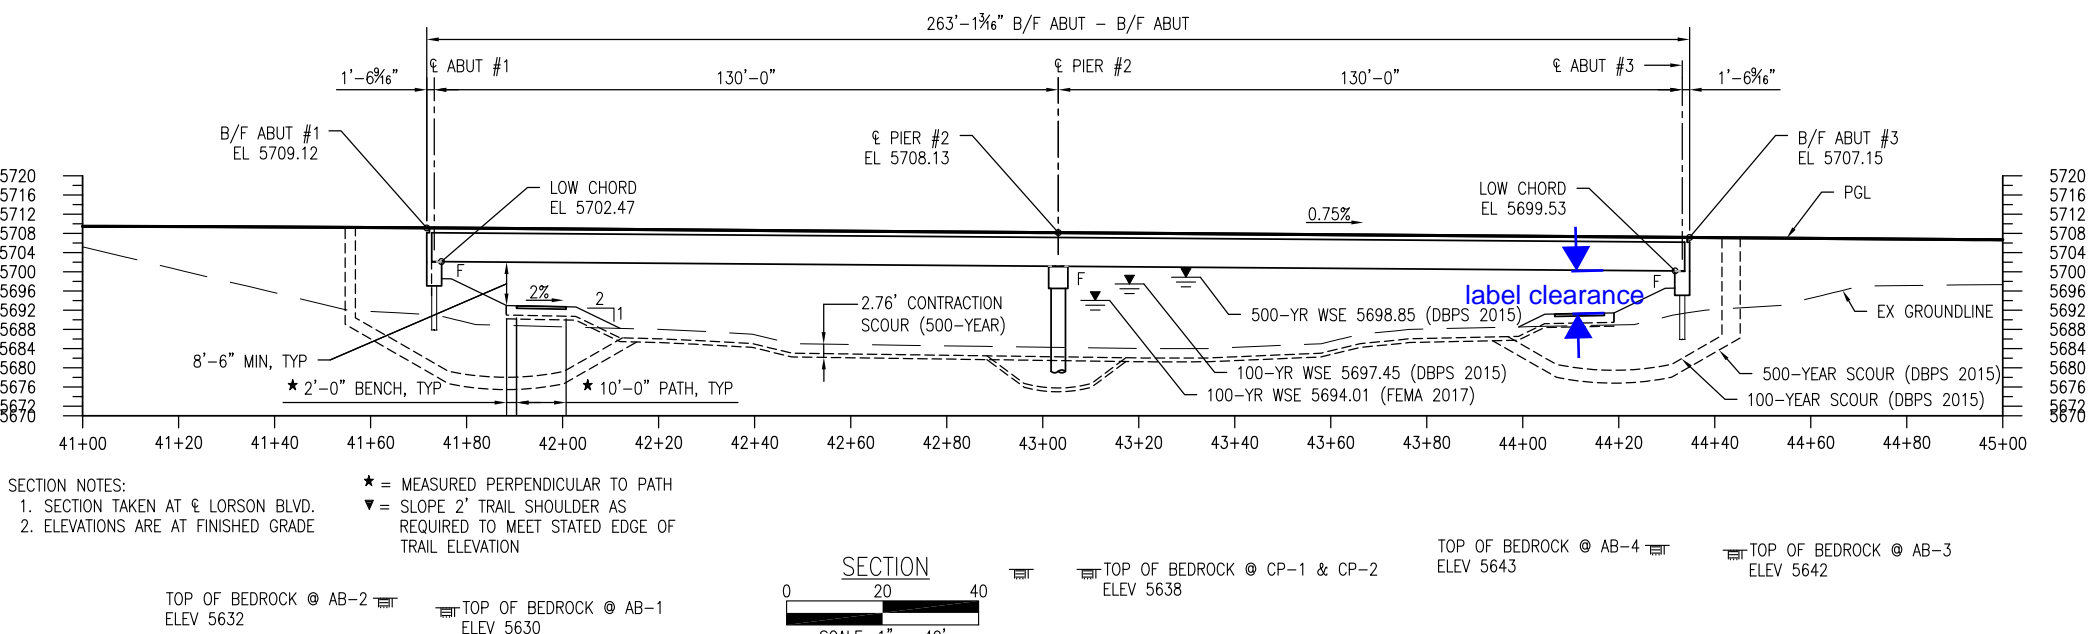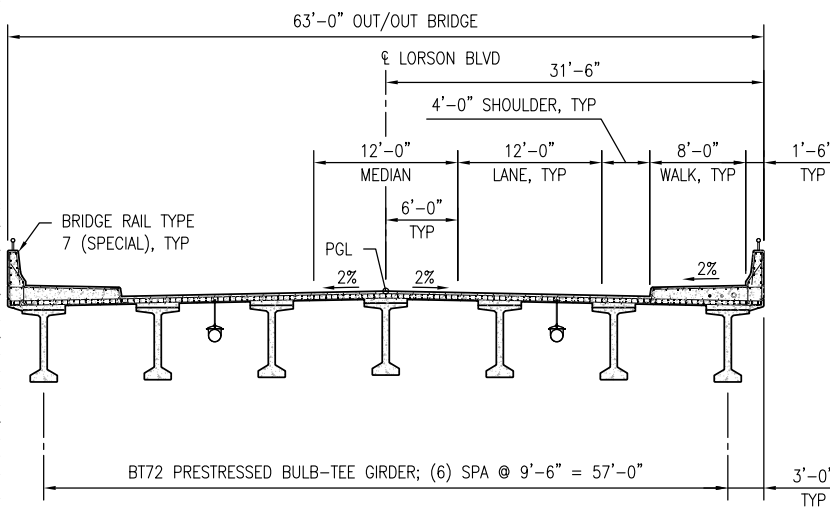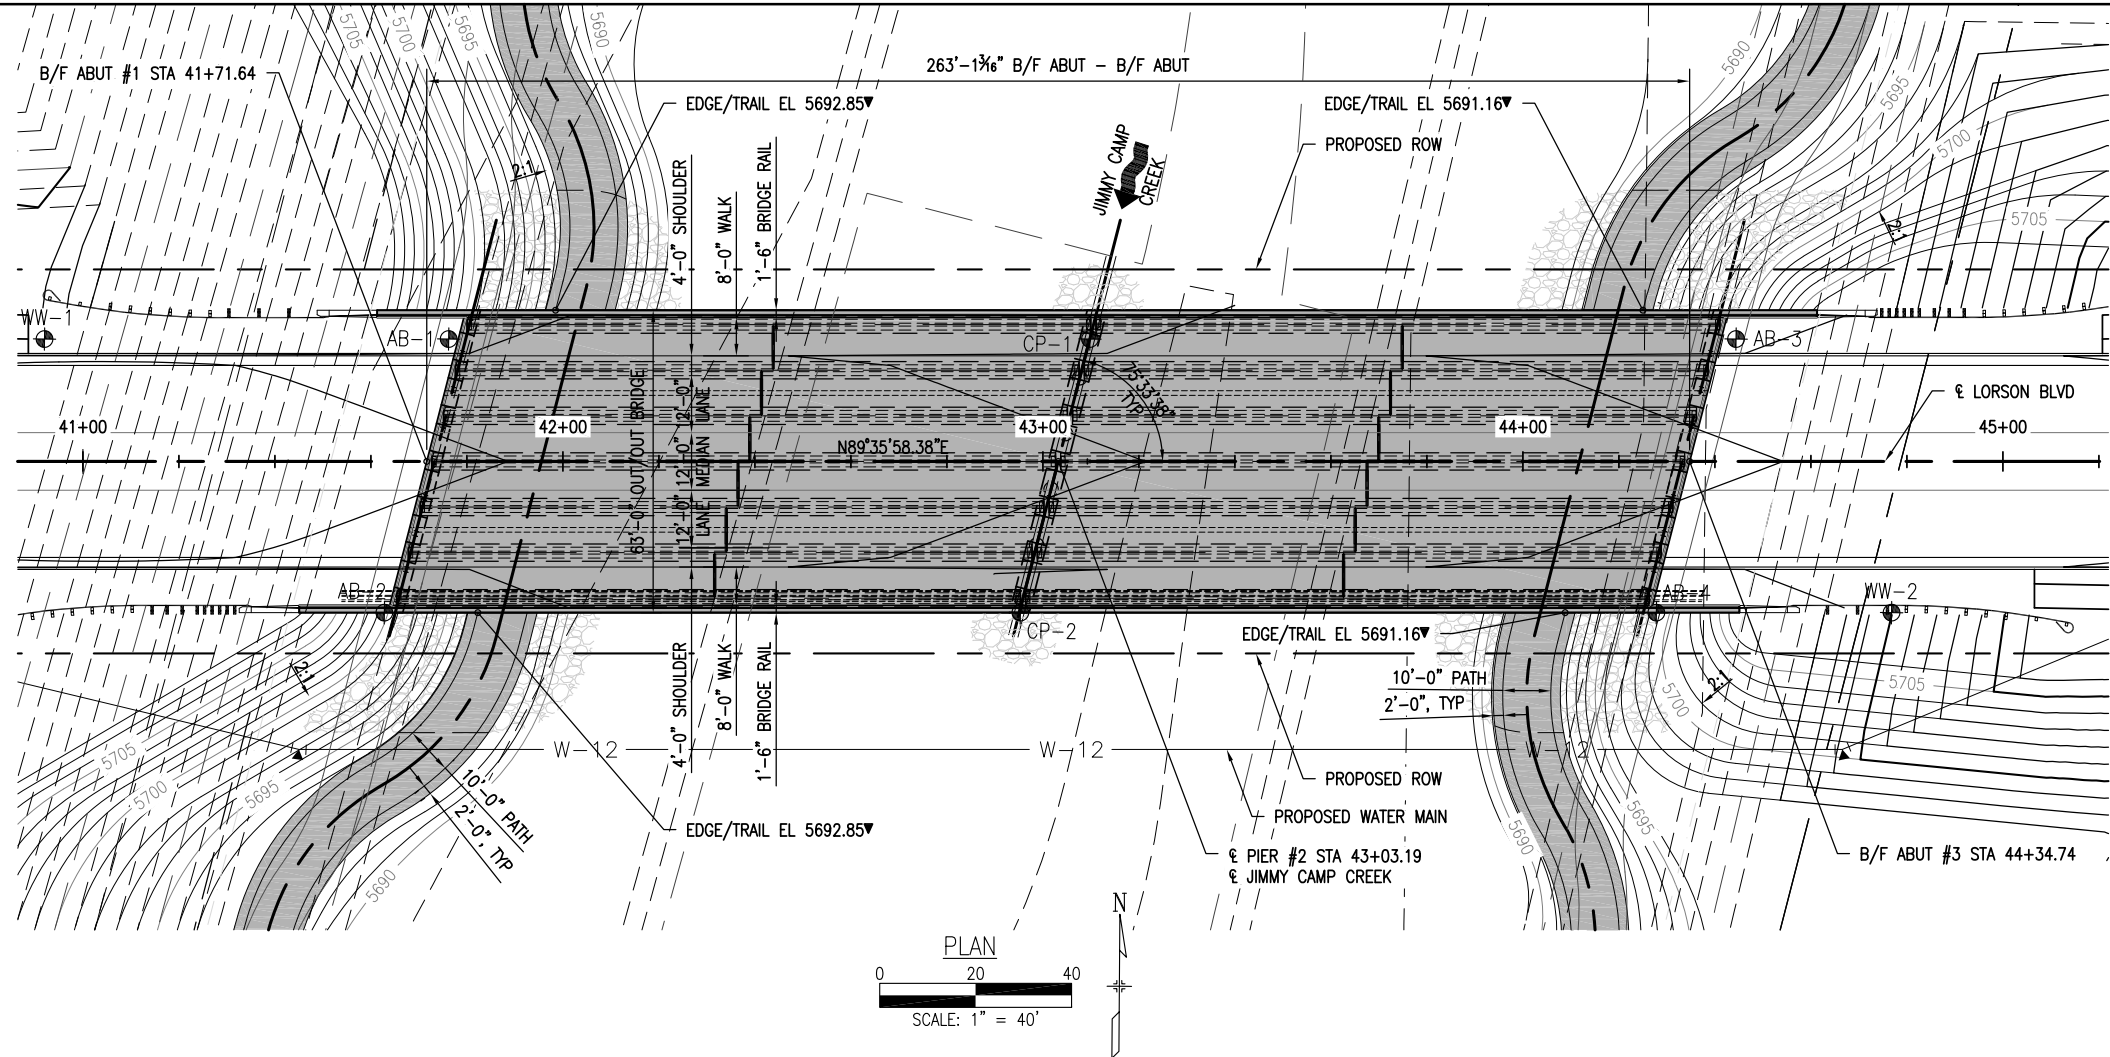

SECTION NOTES:
1. SECTION TAKEN AT E LORSON BLVD.
2. ELEVATIONS ARE AT FINISHED GRADE
★ = MEASURED PERPENDICULAR TO PATH
▼ = SLOPE 2' TRAIL SHOULDER AS REQUIRED TO MEET STATED EDGE OF TRAIL ELEVATION

Print Date:	
File Name:	
Horiz. Scale:	Vert. Scale: As Noted
Unit Information	Unit Leader Initials

Sheet Revisions		
Date:	Comments	Init.

Lorson and Associates, Inc.
100 Superior Plaza Way,
Suite 220
Superior, Colorado 80027
303.444.2073
www.LorsonAssociates.com

THE LANDHUIS COMPANY
212 N. WASATCH, SUITE 201
COLORADO SPRINGS, CO 80903
PHONE: 719.635.3200

CORE
ENGINEERING GROUP
212 N. WASATCH AVE., SUITE 206
COLORADO SPRINGS, CO 80903
PH: 719.570.1100
FAX: 719.570.1106
CONTACT: RICHARD L. SCHINDLER, P.E.
EMAIL: RichS@ceg1.com

As Constructed

No Revisions:

Revised:

Void:

LORSON BRIDGE
BRIDGE GENERAL LAYOUT

Designer: TDB

Detailer: TDB

Sheet Subset:

Structure Numbers

Subset Sheets:

Project No./Code

Sheet Number B02



- | | |
|--|--|
| | Sand, Silty, light brown to brown, loose to medium dense, moist to wet |
| | Clay, Sandy, brown, soft, moist to wet |
| | Sand, Silty to Clayey, brown, moist to wet, loose to medium dense |
| | Shale, Sandy, blue to gray, moist to wet, very hard |
| | Depth to water level encountered at the time of drilling |
| | Drive sample, Standard Penetration Test, 2-inch OD split barrel sample. The symbol 9/12 indicates that 9 blows hammer were required to drive the sampler 12 inches |
| | Drive sample, 2 1/2-inch OD modified California sample. The symbol 9/12 indicates that 9 blows hammer were required to drive the sampler 12 inches |

- 1) Borings were advanced with a power-driven, continuous-flight auger rig on April 3, 2017.
- 2) Elevations of the Borings were provided by M&S Civil Group.
- 3) Samples were obtained in general accordance with ASTM D-1586 utilizing a 2-inch OD split barrel sampler.
- 4) The lines between materials shown on the logs represent the approximate boundaries between material types. In-situ transitions may actually be gradual.
- 5) Water level readings shown on the logs were made while drilling. Fluctuations in the water level may occur with time.



NOTE: 1. TEST HOLE DRILLING FIELD EXPLORATION WAS PERFORMED BY ROCKY MOUNTAIN GROUP (RMG). ALL WORK SHALL CONFORM TO RECOMMENDATIONS, AS APPLICABLE, DISCUSSED IN THE GEOTECHNICAL REPORT TITLED "SUBSURFACE SOIL INVESTIGATION" - LORSON BLVD. BRIDGE OVER JIMMY CAMP CREEK, DATED APRIL 3, 2017.

3. ALL INFORMATION ON THIS SHEET WAS TAKEN DIRECTLY FROM THE GEOTECHNICAL REPORT. REFER TO EXPLORATORY BORING LOGS SUBSET FOR COMPLETE BORING LOGS WITH TEST RESULTS.

**PRELIMINARY
NOT FOR CONSTRUCTION**

Print Date:	<div><div></div><div></div><div></div><div></div><div></div></div>	Sheet Revisions			<div><div></div><div>Loris and Associates, Inc. 100 Superior Plaza Way, Suite 220 Superior, Colorado 80027 303.444.2073 www.LorisandAssociates.com</div></div>	<div><div>LORSON RANCH</div><div>THE LANDHUIS COMPANY 212 N. WASATCH, SUITE 201 COLORADO SPRINGS, CO 80903 CONTACT: RICHARD L. SCHINDLER, P.E. PHONE: 719-636-3200 richs@cegi.com</div></div>	<div><div>CORE ENGINEERING GROUP</div><div>212 N. WAHSATCH AVE., SUITE 206 COLORADO SPRINGS, CO 80903 PH: 719-570-1105 FAX: 719-570-1106 CONTACT: RICHARD L. SCHINDLER, P.E. EMAIL: RichS@cegi.com</div></div>	As Constructed		LORSON BRIDGE ENGINEERING GEOLOGY			Project No./Code	
File Name:		Date:	Comments	Init.				No Revisions:					-	
Horiz. Scale: Vert. Scale: As Noted									Revised:	Designer: TDB	Structure		-	
Unit Information Unit Leader Initials										Detailer: JWJ	Numbers			
									Void:	Sheet Subset:		Subset Sheets:		Sheet Number B03

PRELIMINARY
NOT FOR CONSTRUCTION

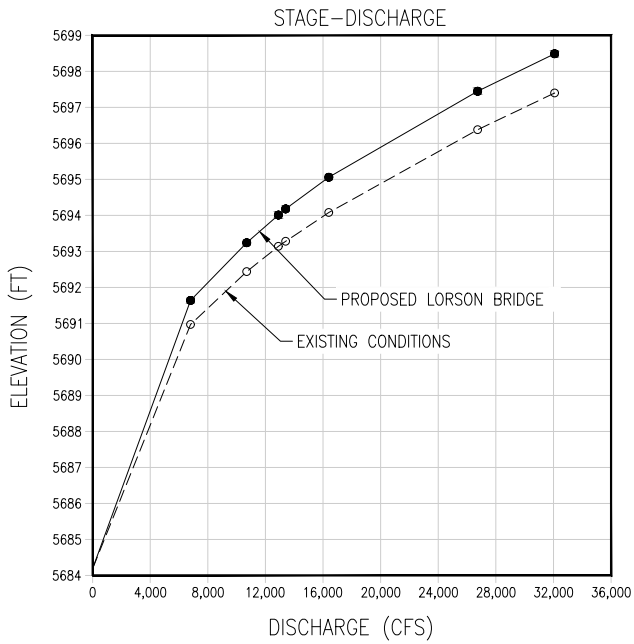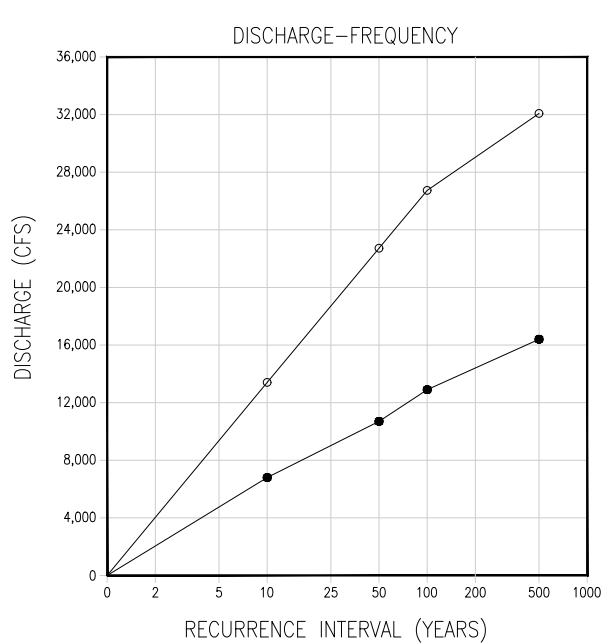

RECURRENCE INTERVAL (YEARS)	DISCHARGE AT BRIDGE (CFS)	DISCHARGE OVER ROAD (CFS)	VELOCITY AT BRIDGE (FT/SEC)	WSEL (FT-NGVD)	ABUTMENT SCOUR ELEV (FT-NGVD)	PIER SCOUR ELEV (FT-NGVD)
10	6,800	0.0	7.40	5691.64	-	-
50	10,700	0.0	9.00	5693.24	-	-
100	12,900	0.0	9.64	5694.01	-	-
500	16,400	0.0	10.57	5695.06	-	-
10	13,402	0.0	9.76	5694.18	-	-
100	26,734	0.0	13.14	5697.45	5678.40	5675.75
500	32,081	0.0	14.32	5698.49	5675.90	5674.85

- NOTES
- STAGE-DISCHARGE CURVE AT UPSTREAM OF FACE OF BRIDGE.
 - WSEL SHOWN IN STAGE-DISCHARGE CURVE ARE TAKE AT THE UPSTREAM FACE OF BRIDGE.
 - VELOCITY AT BRIDGE ARE AVERAGE VELOCITY.
 - BRIDGE DESIGN RECURRENCE INTERVAL IS 100-YEAR STORM.
 - ABUTMENT AND PIER SCOUR ELEVATIONS INCLUDE CONTRACTION SCOUR.

HYDRAULIC DATA:

DRAINAGE AREA: 44.16 SQUARE MILES
AVERAGE CHANNEL SLOPE: 0.0061 FT/FT
MANNING'S n FOR DESIGN: OVERBANK: 0.040 CHANNEL: 0.040 (EXISTING)
OVERBANK: 0.040 CHANNEL: 0.040, 0.090, 0.067 (PROPOSED)


DEBRIS: ☐ BRUSH ☐ TREES/LOGS ☐ ICE ☒ NONE

HYDROLOGY DATA:
TWO SETS OF FLOOD FREQUENCY DATA WERE USE FOR THE ANALYSIS OF THE PROPOSED LORSON BRIDGE. THE FIRST SET OF DISCHARGES WERE TAKEN FROM THE LOMR PREPARED FOR THE CHANNEL REALIGNMENT AND CONSTRUCTION OF FONTAINE BOULEVARD BRIDGE OVER JIMMY CAMP CREEK, SUBMITTED TO FEMA AND EFFECTIVE AUGUST 29, 2007. THE SECOND SET OF PEAK DISCHARGES ARE TAKEN FROM THE DRAINAGE BASIN PLANNING STUDY (DBPS) OF JIMMY CAMP CREEK, PREPARED BY KIOWA ENGINEERING CORPORATION, DATED MARCH OF 2015.

GEOTECHNICAL DATA:

BOTTOM MATERIAL: ☐ COHESIVE ☒ NON-COHESIVE
BOTTOM MATERIAL SIZE: ☐ CLAY ☒ SILT ☐ COBBLES ☐ SAND ☐ OTHER
STREAM PLANFORM: ☒ STRAIGHT ☐ MEANDERING ☐ BRAIDED
CHANNEL STABILITY: ☒ STABLE ☐ AGGRADING ☐ DEGRADED
ICE: ☐ YES ☒ NO ☐ UNKNOWN


BRIDGE SECTION

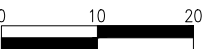

SCALE: 1" = 20'

1" = 20' HORIZ

1" = 10' VERT

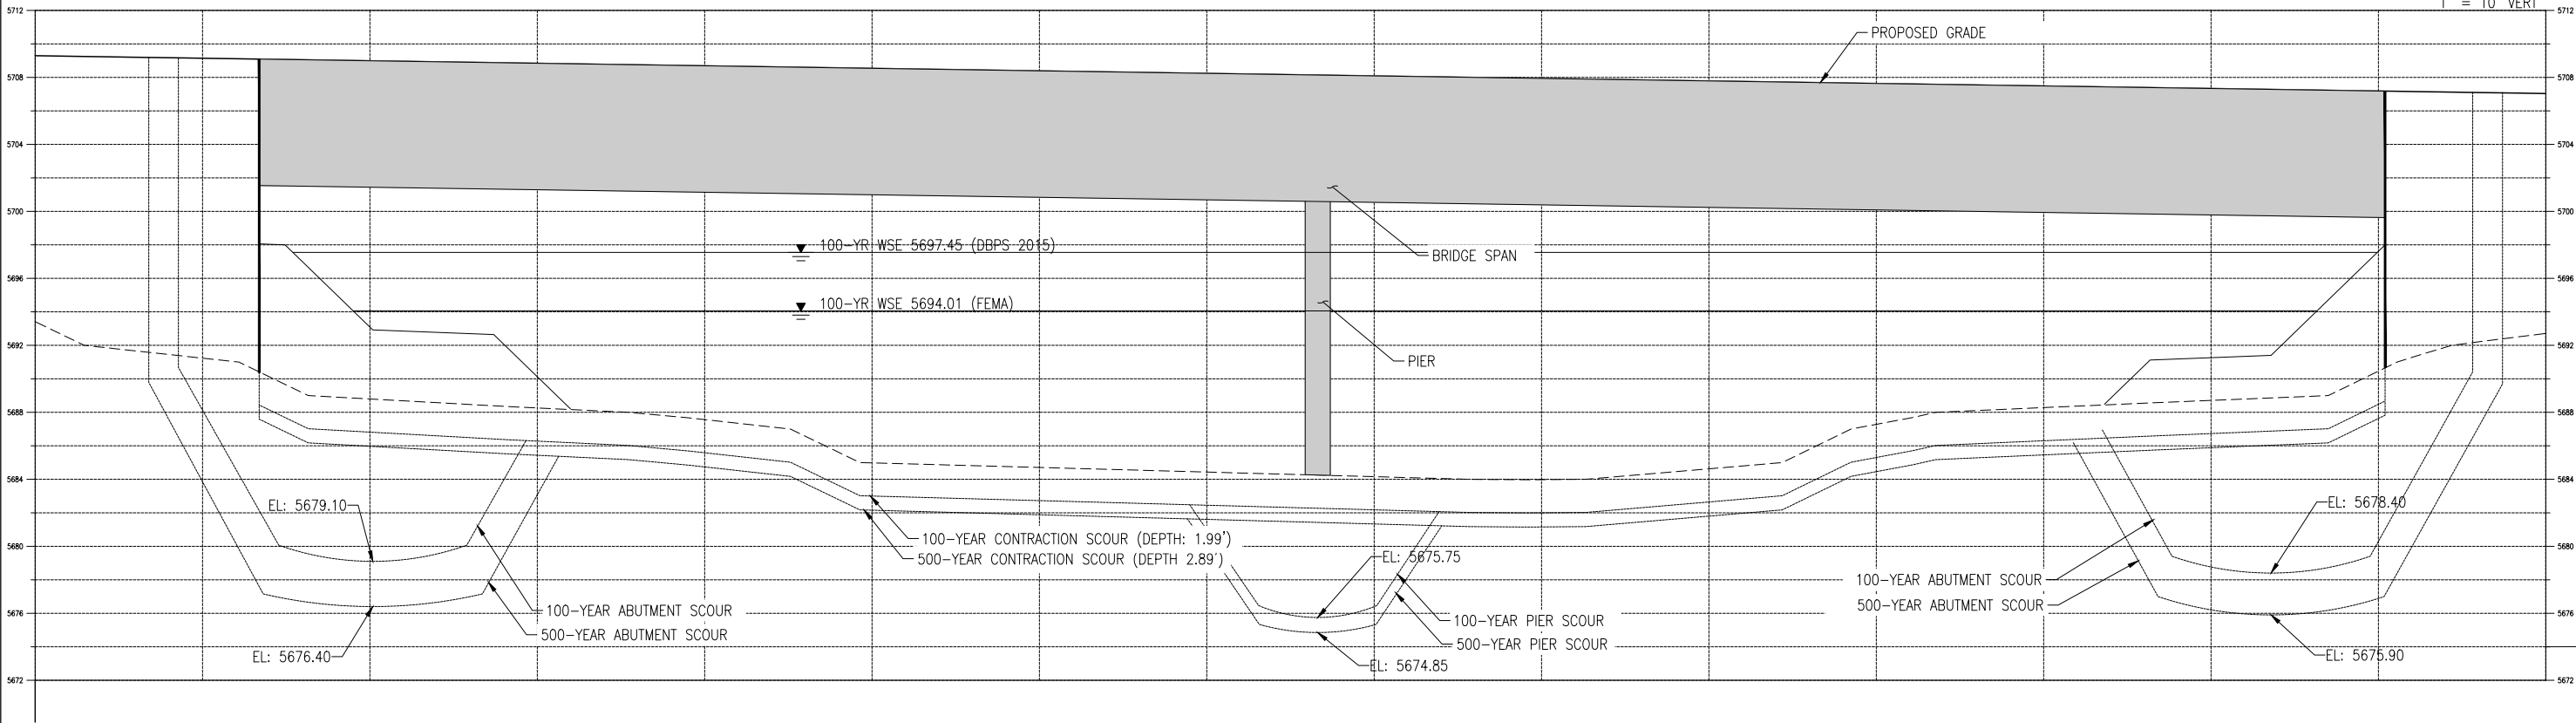

Print Date:
File Name:
Horiz. Scale: Vert. Scale: As Noted
Unit Information Unit Leader Initials

0000

Sheet Revisions

Date:	Comments	Init.



Loris and Associates, Inc.
100 Superior Plaza Way,
Suite 220
Superior, Colorado 80027
303.444.2073
www.LorisandAssociates.com



THE LANDHAUS COMPANY
212 N. WASATCH, SUITE 501
COLORADO SPRINGS, CO 80903
PHONE: 719-685-3200



212 N. WASATCH AVE., SUITE 206
COLORADO SPRINGS, CO 80903
PH: 719.570.1100
FAX: 719.570.1106
CONTACT: RICHARD L. SCHINDLER, P.E.
EMAIL: RichS@ceg1.com

As Constructed

No Revisions:

Revised:

Void:

LORSON BRIDGE
HYDRAULIC DATA
(SHEET 1)

Designer:

CJB

Detailer:

CJB

Sheet Subset:

Structure

Numbers

Subset Sheets:

Project No./Code


-

-



Sheet Number

B04

PRELIMINARY
NOT FOR CONSTRUCTION

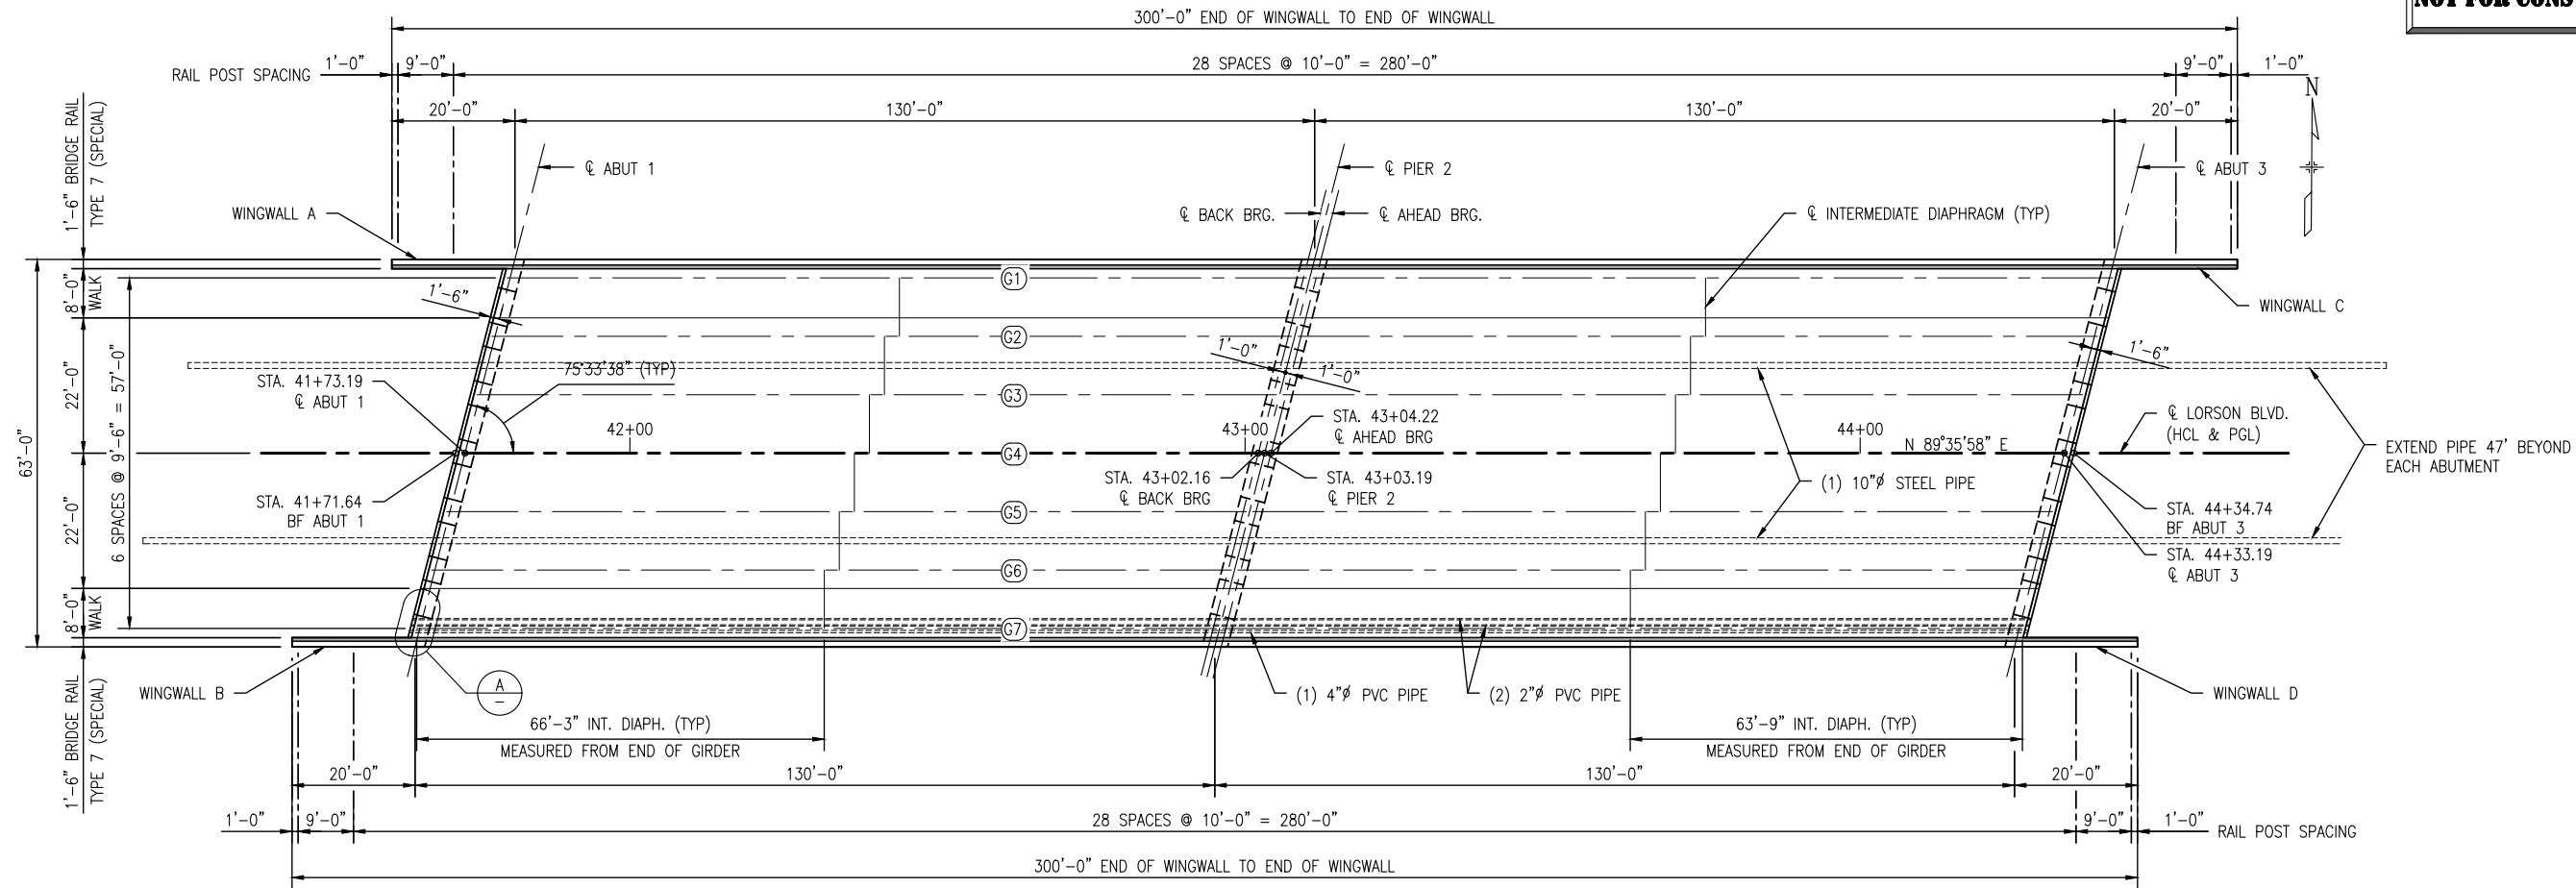

CONSTRUCTION LAYOUT

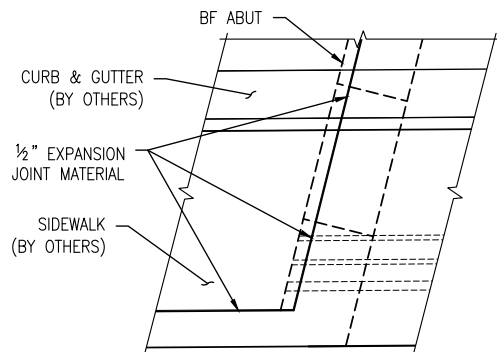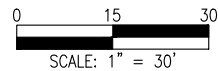


A
DETAIL
NTS

NOTES



- INTERMEDIATE DIAPHRAGMS MEASURED FROM GIRDER END.
- SEE SHEET B16 FOR UTILITY DETAILS.

Print Date:	<div><div></div><div></div><div></div><div></div></div>	Sheet Revisions			<div><div></div><div></div><div></div><div></div></div>	LORSON BRIDGE CONSTRUCTION LAYOUT		Project No./Code	
File Name:		Date:	Comments	Init.		As Constructed		-	
Horiz. Scale:						No Revisions:		-	
Unit Information						Revised:	Designer: TDB	Structure Numbers	
	Unit Leader Initials					Void:	Detailer: JWJ	Subset Sheets:	Sheet Number B06

PRELIMINARY
NOT FOR CONSTRUCTION

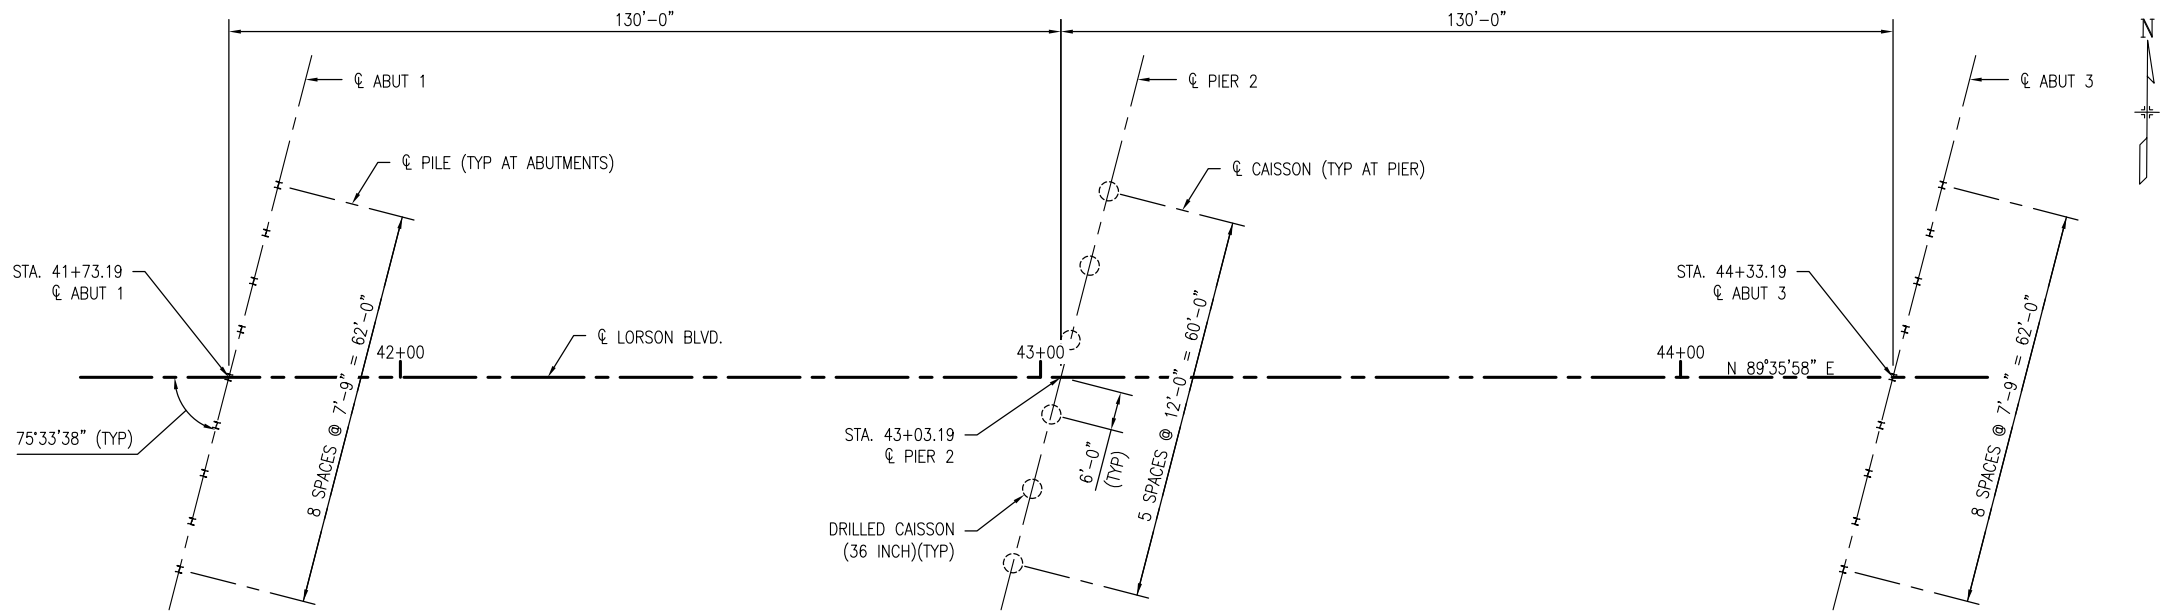

FOUNDATION LAYOUT

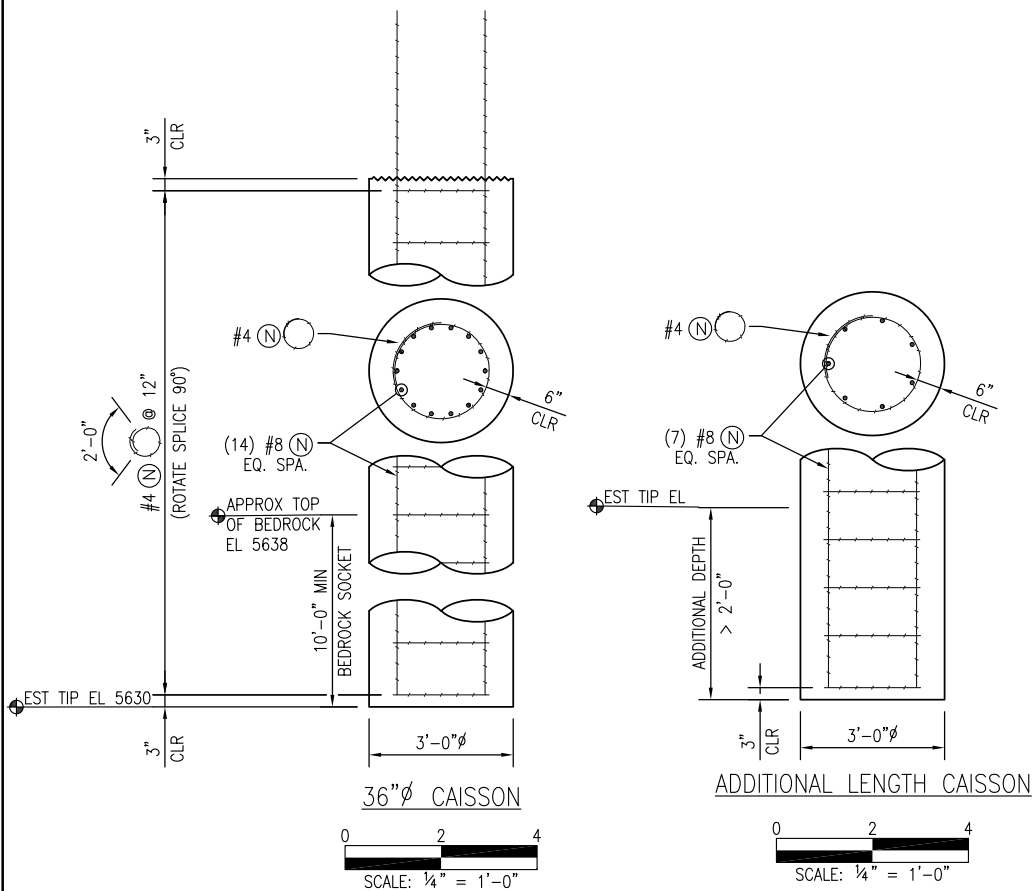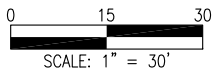

CAISSON DATA

LOCATION	CAISSON SIZE	TOP OF CAISSON ELEV.	EST. BEDROCK ELEV.	MINIMUM PENETRATION INTO BEDROCK (FT)	EST TIP ELEV.	FACTORED MAXIMUM LOADS (TONS)
PIER 2	36"Ø	5682.0	5638.0	10.0	5628.0	390

PILING DATA

LOCATION	PILE SIZE	PILE CUTOFF ELEV.	EST. BEDROCK ELEV.	EST PENETRATION INTO BEDROCK (FT)	EST TIP ELEV.	FACTORED MAXIMUM LOADS (TONS)
ABUTMENT 1	HP 14x89	5697.42	5631.0	3.0	5628.0	178
ABUTMENT 3	HP 14x89	5695.47	5642.5	3.0	5639.5	178

NOTES:

- ALL PILING SHALL BE DRIVEN TO REFUSAL.
- PILE TIPS ARE NOT REQUIRED. IF HOWEVER, UNEXPECTED HARD DRIVING CONDITIONS ARE ENCOUNTERED, PILE TIPS SHALL BE INSTALLED. PILE TIPS SHALL BE COMMERCIAL TIP APF HARD BITE 77600, 77750, DFP H-776, VERSA-STEEL VS-300, CONSTRUCTION SUPPLY HT-3300, OR APPROVED ALTERNATE.
- CAISSON CONCRETE SHALL BE CONCRETE CLASS BZ AND REINFORCING STEEL SHALL BE GRADE 60.
- BARS PROJECTING FROM TOP OF CAISSON SHALL BE PLACED TO FIT INSIDE THE REINFORCING CAGE OF THE PIER COLUMN.
- PILING SHALL BE ASTM A709 GR 50.
- THE CONTRACTOR SHALL VERIFY THE LOCATION OF ALL UTILITIES PRIOR TO CONSTRUCTION.
- THE BOTTOM OF THE CAISSON SHALL EXTEND THE MINIMUM PENETRATION SHOWN IN THE "CAISSON DATA", OR TO THE ESTIMATED TIP ELEVATION, WHICHEVER PRODUCES THE LOWER ELEVATION.
- IF ADDITIONAL DEPTH IS REQUIRED FOR BEDROCK EMBEDMENT, THE CAISSON SHALL BE EXTENDED AS SHOWN IN ADDITIONAL LENGTH DETAIL.
- THE FOUNDATION DESIGN IS BASED ON THE GEOTECHNICAL ENGINEERING STUDY PREPARED BY ROCKY MOUNTAIN GROUP, JOB NO. 155271, DATED APRIL, 2017.
- THE CAISSONS ARE DESIGNED USING AASHTO LRFD METHODOLOGY WITH THE FOLLOWING PARAMETERS:

ULTIMATE BEARING CAPACITY	=	150.5 KSF
RESISTANCE FACTOR FOR END BEARING	=	0.50
ULTIMATE SIDE SHEAR RESISTANCE	=	17.4 KSF
RESISTANCE FACTOR FOR SIDE SHEAR	=	0.45
- THE DRIVEN PILES ARE DESIGNED USING AASHTO LRFD METHODOLOGY WITH THE FOLLOWING PARAMETERS:

ULTIMATE PILE STRESS	=	40 KSI
RESISTANCE FACTOR	=	0.65
- THIS RESISTANCE FACTOR IS BASED ON A MINIMUM OF ONE PILE PER ABUTMENT BEING TESTED BY PDA TO THE MAXIMUM FACTORED LOAD SHOWN FOR THAT LOCATION.

Print Date:
File Name:
Horiz. Scale: Vert. Scale: As Noted
Unit Information Unit Leader Initials

Sheet Revisions		
Date:	Comments	Init.

Loris and Associates, Inc.
100 Superior Plaza Way,
Suite 220
Superior, Colorado 80027
303.444.2073
www.LorisandAssociates.com

LORSON RANCH
THE LANDHUIS COMPANY
212 N. WASATCH, SUITE 801
COLORADO SPRINGS, CO 80903
PHONE: 719.636.3200

CORE ENGINEERING GROUP
212 N. WASATCH AVE., SUITE 206
COLORADO SPRINGS, CO 80903
PH: 719.570.1100
FAX: 719.570.1106
CONTACT: RICHARD L. SCHINDLER, P.E.
EMAIL: RichS@ceg1.com

As Constructed
No Revisions:
Revised:
Void:



LORSON BRIDGE
FOUNDATION LAYOUT

Designer: TDB
Detailer: JWJ
Sheet Subset:
Structure Numbers
Subset Sheets:

Project No./Code
-
-
Sheet Number B07



Now what's below.
Call before you dig.

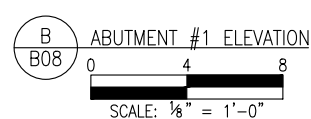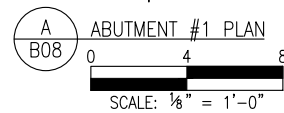

GIRDER	ELEVATION
G1	5701.43
G2	5701.63
G3	5701.84
G4	5702.05
G5	5701.87
G6	5701.70
G7	5701.52

1. ABUTMENT SHALL BE CONCRETE CLASS D.
2. DECK AND DIAPHRAGM SHALL BE PLACED MONOLITHICALLY.
3. SEAT ELEVATIONS SHOWN ARE AT ϕ ABUTMENT AND ϕ GIRDER.
4. FOR WINGWALL REINFORCING PROJECTING INTO ABUTMENT SEE SHEET B11.
5. FOR SIDEWALK REINFORCING PROJECTING INTO ABUTMENT SEE SHEET B16.
6. FOR BRIDGE RAIL REINFORCING PROJECTING INTO ABUTMENT SEE SHEET B22.
7. THREADED ROD SHALL BE PLACED IN $\frac{7}{8}" \phi$ INSERTS PROVIDED IN GIRDERS.
8. PLACE STIRRUP REINFORCING PARALLEL TO ϕ GIRDER.
9. AFTER INSTALLATION OF CONDUIT, SEAL GAP BETWEEN THE CONDUIT AND THE BLOCKOUT WITH MASTIC.

Print Date:	
File Name:	
Horiz. Scale:	Vert. Scale: As Noted
Unit Information	Unit Leader Initials

	Sheet Revisions		
	Date:	Comments	Init.
<input type="text"/>			
<input type="text"/>			
<input type="text"/>			
<input type="text"/>			



LORSON
RANCH




CORE
ENGINEERING GROUP

Void:


Subset Sheets:

Sheet Number B08

PRELIMINARY
NOT FOR CONSTRUCTION

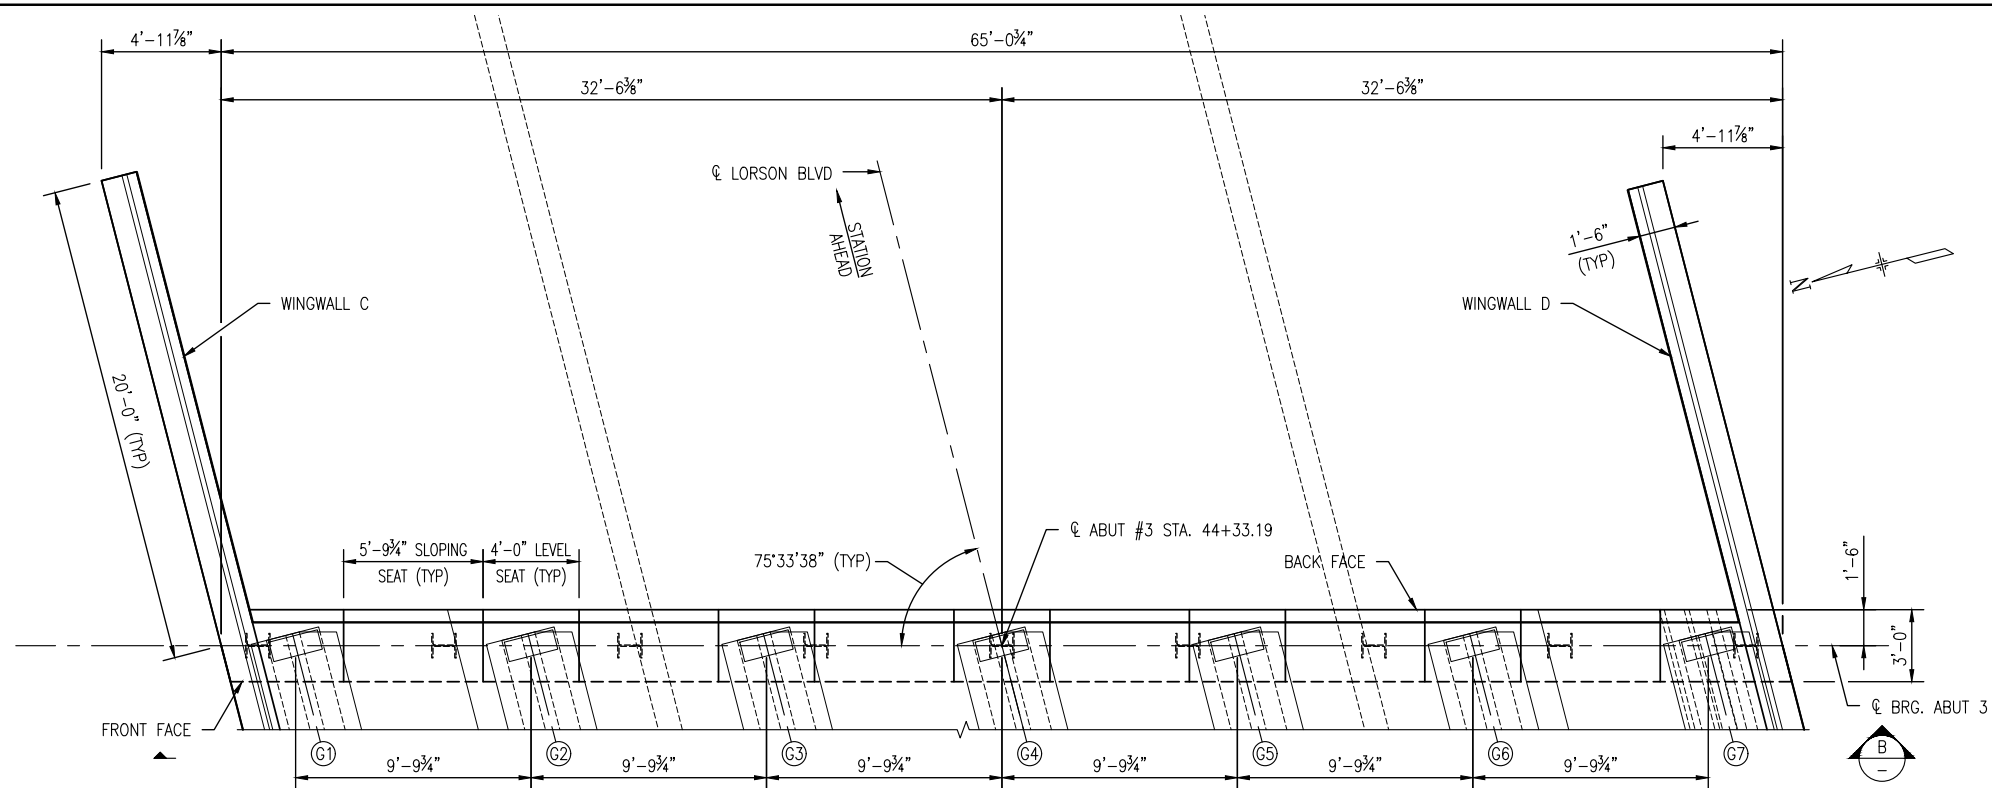

A
B09
ABUTMENT #3 PLAN
0 4 8
SCALE: 1/8" = 1'-0"

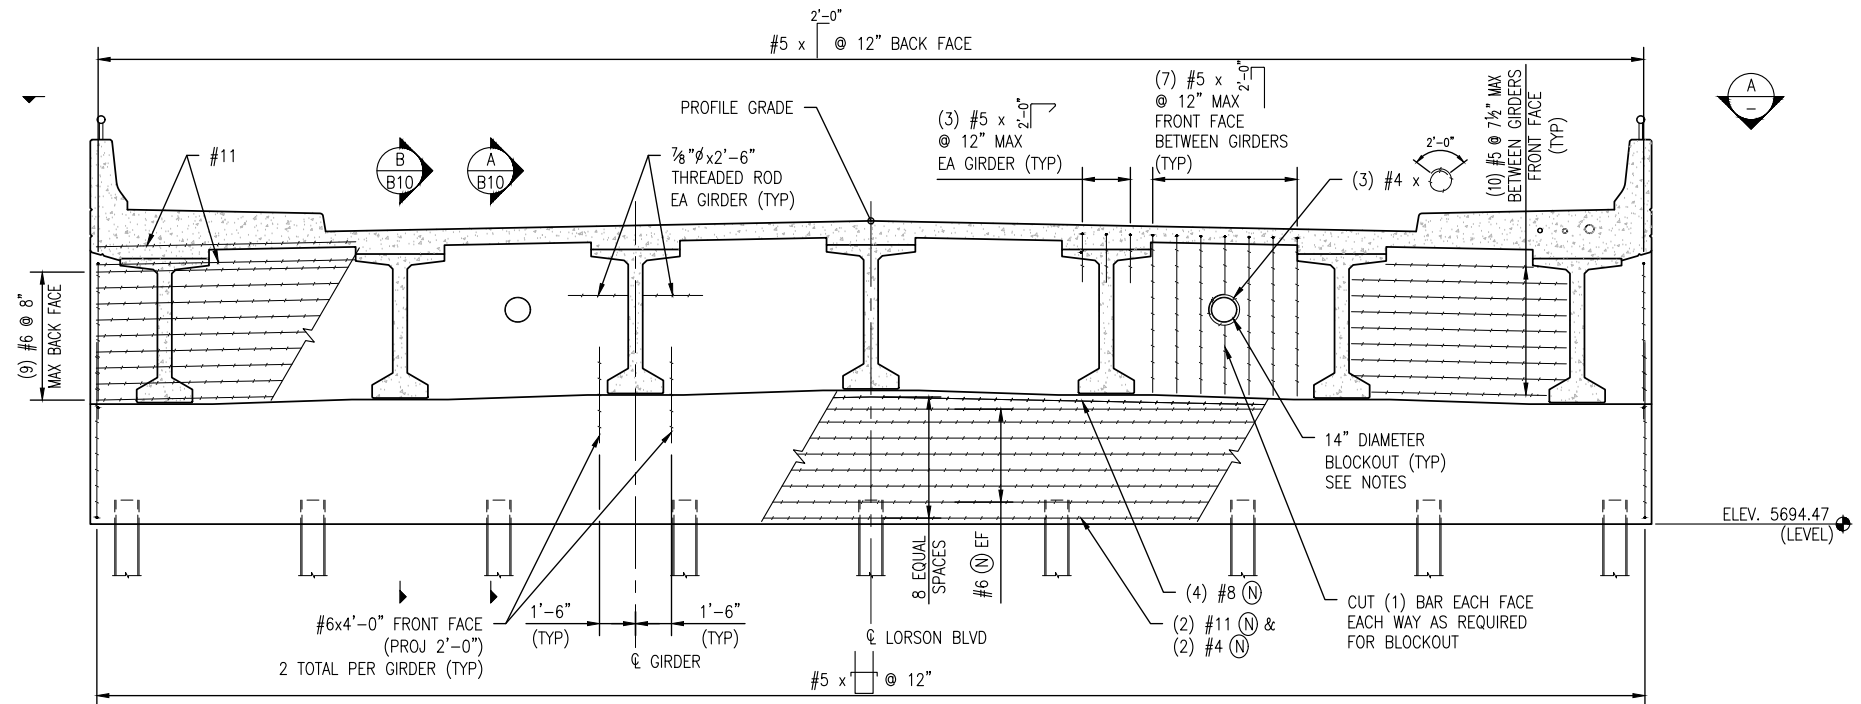

B
B09
ABUTMENT #3 ELEVATION
0 4 8
SCALE: 1/8" = 1'-0"

SEAT ELEVATIONS

GIRDER	ELEVATION
G1	5699.48
G2	5699.68
G3	5699.89
G4	5700.10
G5	5699.92
G6	5699.75
G7	5699.57

NOTES

1. ABUTMENT SHALL BE CONCRETE CLASS D.
2. DECK AND DIAPHRAGM SHALL BE PLACED MONOLITHICALLY.
3. SEAT ELEVATIONS SHOWN ARE AT ϕ ABUTMENT AND ϕ GIRDER.
4. FOR WINGWALL REINFORCING PROJECTING INTO ABUTMENT SEE SHEET B11.
5. FOR SIDEWALK REINFORCING PROJECTING INTO ABUTMENT SEE SHEET B16.
6. FOR BRIDGE RAIL REINFORCING PROJECTING INTO ABUTMENT SEE SHEET B22.
7. THREADED ROD SHALL BE PLACED IN 3/8" ϕ INSERTS PROVIDED IN GIRDERS.
8. PLACE STIRRUP REINFORCING PARALLEL TO ϕ GIRDER.
9. AFTER INSTALLATION OF CONDUIT, SEAL GAP BETWEEN THE CONDUIT AND THE BLOCKOUT WITH MASTIC.

Print Date:
File Name:
Horiz. Scale: Vert. Scale: As Noted
Unit Information Unit Leader Initials

Sheet Revisions

Date:	Comments	Init.

Loris and Associates, Inc.
100 Superior Plaza Way,
Suite 220
Superior, Colorado 80027
303.444.2073
www.LorisandAssociates.com

LORSON RANCH
THE LANDLUS COMPANY
212 N. WASATCH, SUITE 501
COLORADO SPRINGS, CO 80903
PHONE: 719.685.3200

CORE
ENGINEERING GROUP

212 N. WASATCH AVE., SUITE 206
COLORADO SPRINGS, CO 80903
PH: 719.570.1100
FAX: 719.570.1106
CONTACT: RICHARD L. SCHINDLER, P.E.
EMAIL: RichS@ceeg1.com

As Constructed

No Revisions:

Revised:

Void:

LORSON BRIDGE
ABUTMENT #3 PLAN & ELEVATION

Designer: TDB
Detailer: JWJ
Sheet Subset:
Structure Numbers
Subset Sheets:

Project No./Code

-

-




Sheet Number B09

C:\7.2 Clients\369 - Lorson Bridge\50 DWG\16136 (B08-B11) Abutment & Wingwall Details.dwg Sep 26, 2017 - 4:15pm

PRELIMINARY
NOT FOR CONSTRUCTION



NOTE: UNLESS NOTED OTHERWISE, ALL
INFORMATION SHOWN ON SECTION A/-
APPLIES TO THIS SECTION.

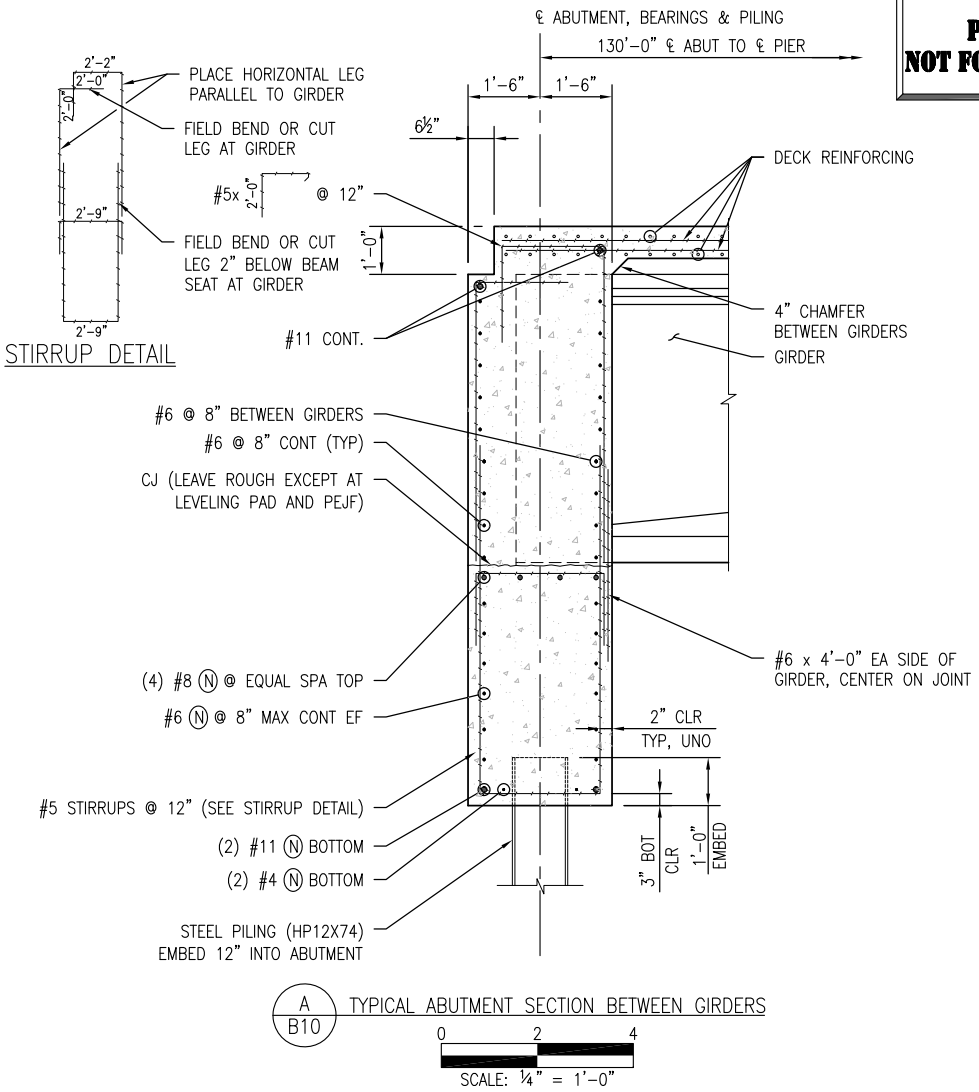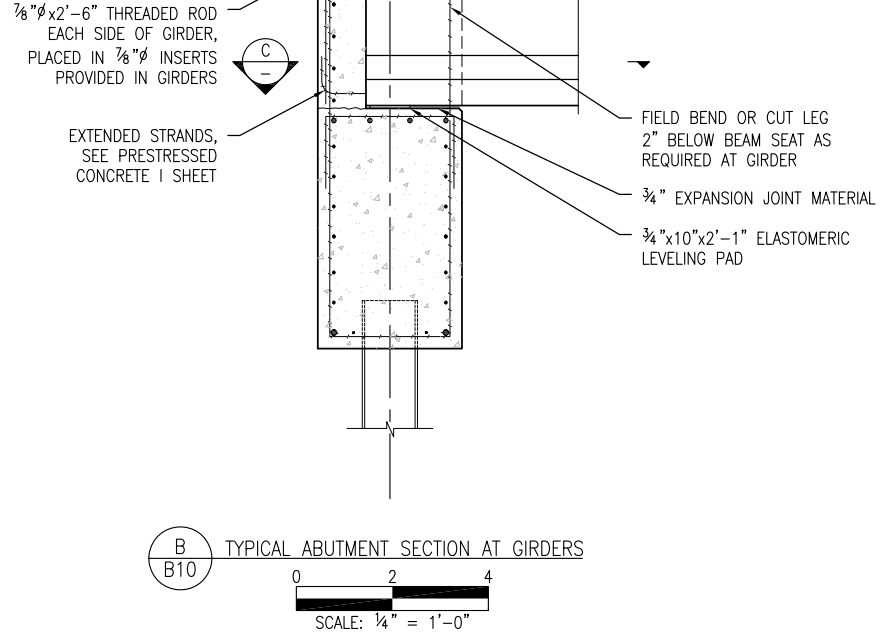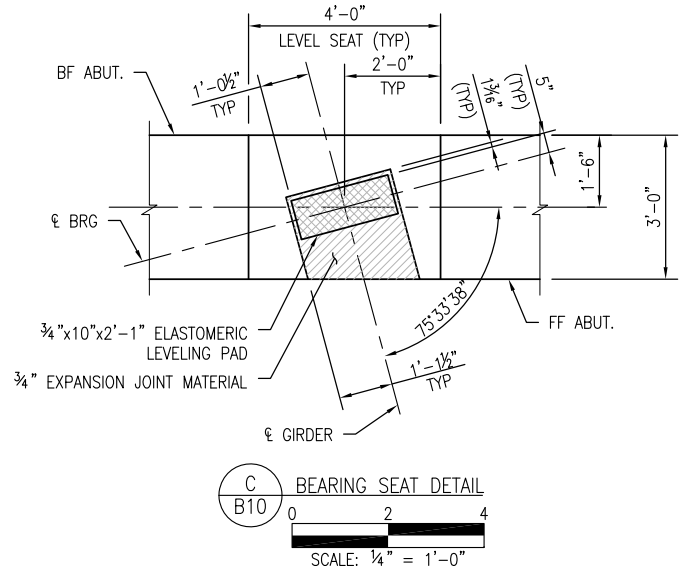

STIRRUP DETAIL


Print Date:		Sheet Revisions			 <div>Loris and Associates, Inc. 100 Superior Plaza Way, Suite 220 Superior, Colorado 80027 303.444.2078 www.LorisandAssociates.com</div>	 <div>THE LANDHUB COMPANY 212 N. WABASATCH, SUITE 301 COLORADO SPRINGS, CO 80903 CONTACT: RICHARD L. SCHWENDER, P.E. EMAIL: RichS@coeg1.com PHONE: 719-635-9200</div>	 <div>212 N. WAHSATCH AVE., SUITE 206 COLORADO SPRINGS, CO 80903 PH: 719.573.1100 FAX: 719.570.1106 CONTACT: RICHARD L. SCHWENDER, P.E. EMAIL: RichS@coeg1.com PHONE: 719-635-9200</div>	As Constructed		LORSON BRIDGE ABUTMENT DETAILS			Project No./Code	
File Name:		Date:	Comments	Init.				No Revisions:		-				
Horiz. Scale:	Vert. Scale: As Noted							Revised:	Designer:	TDB	Structure Numbers	-		
Unit Information	Unit Leader Initials								Detailer:	TDB				
									Void:	Sheet Subset:	Subset Sheets:		Sheet Number	B10

Loris and Associates, Inc.
100 Superior Plaza Way,
Suite 220
Superior, Colorado 80027
303.444.2073
www.LorisandAssociates.com



LORSON RANCH
THE LANDHUIS COMPANY
212 N. WASATCH, SUITE 206
COLORADO SPRINGS, CO 80903
PHONE: 719.636.3200

CORE ENGINEERING GROUP
212 N. WASATCH AVE., SUITE 206
COLORADO SPRINGS, CO 80903
PH: 719.570.1100
FAX: 719.570.1106
CONTACT: RICHARD L. SCHINDLER, P.E.
EMAIL: RichS@ceg1.com

PRELIMINARY
NOT FOR CONSTRUCTION

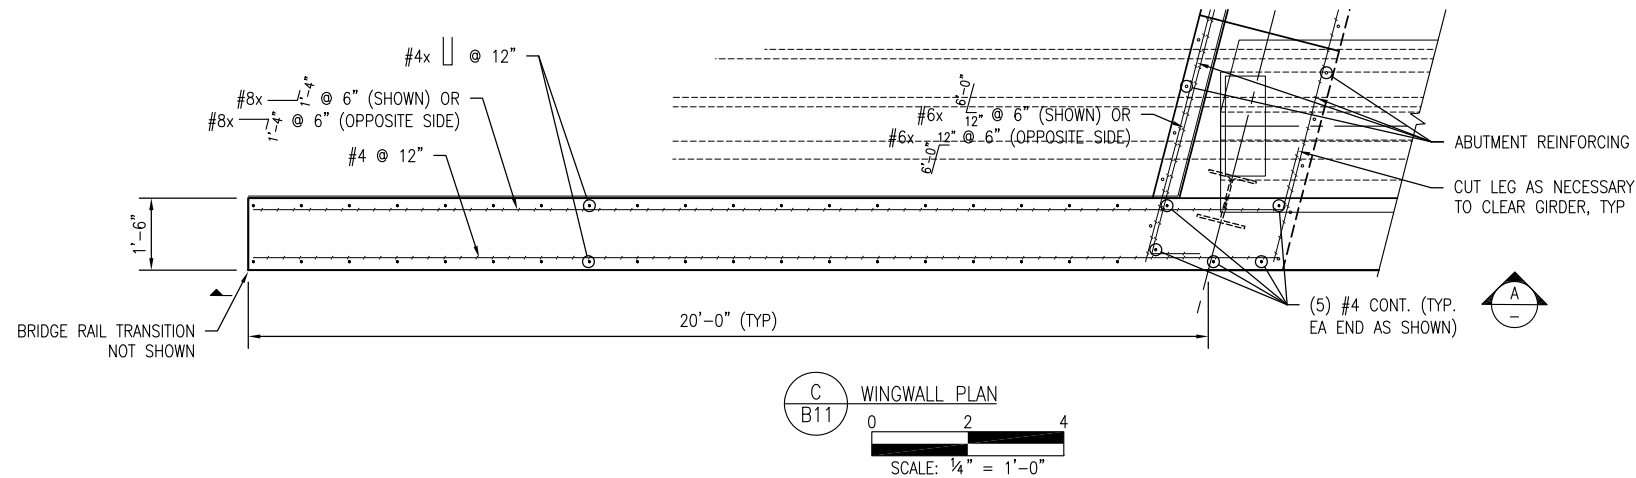

WINGWALL ELEVATIONS			
WINGWALL	ELEV. A	ELEV. B	ELEV. C
A	5709.55	5709.70	5696.43
B	5709.67	5709.82	5696.43
C	5707.60	5707.45	5694.48
D	5707.72	5707.57	5694.48

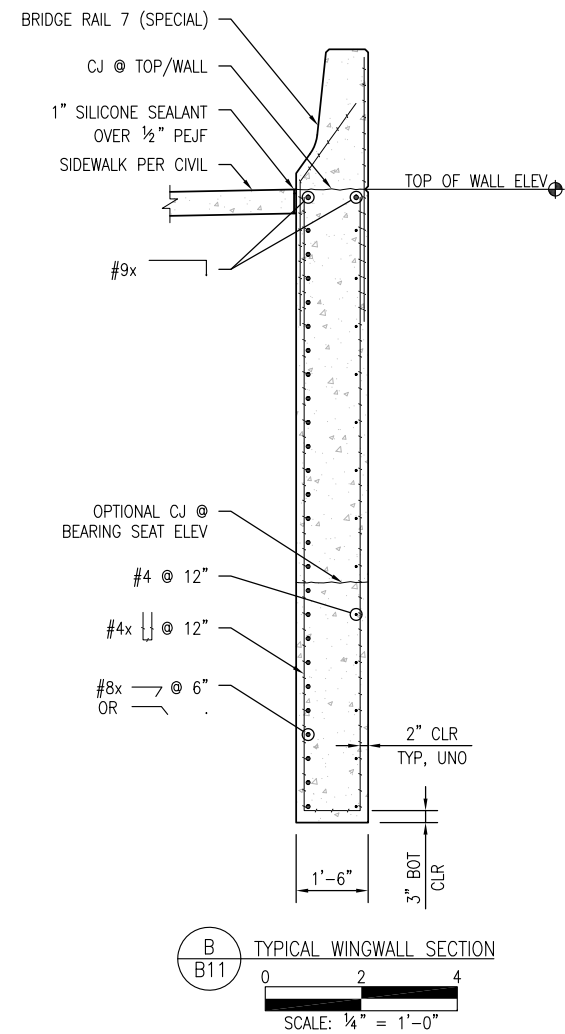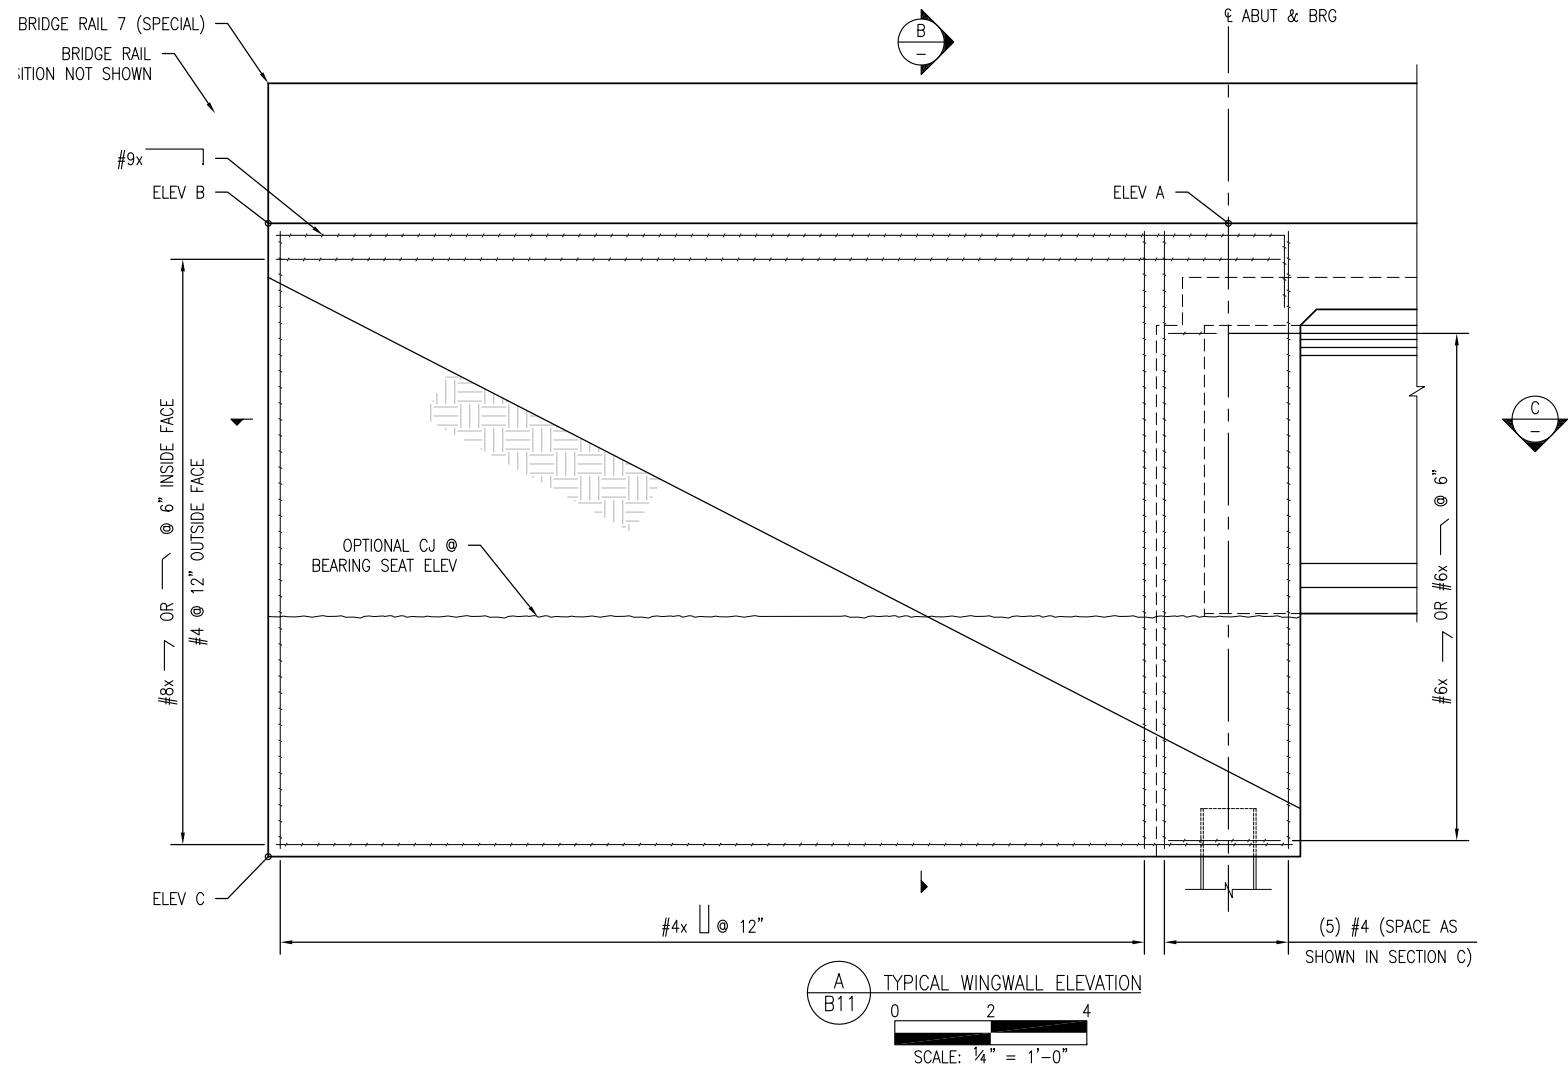



Print Date:	<div><div></div><div></div><div></div><div></div><div></div></div>	Sheet Revisions			<div><div></div><div>Loris and Associates, Inc. 100 Superior Plaza Way, Suite 220 Superior, Colorado 80027 303.444.2073 www.LoriseandAssociates.com</div></div>	<div><div>LORSON RANCH</div><div>THE LANDHUB COMPANY 212 N. WASATCH, SUITE 301 COLORADO SPRINGS, CO 80903 PHONE: 719-636-3200</div></div>	<div><div>CORE ENGINEERING GROUP</div><div>212 N. WAHSATCH AVE., SUITE 206 COLORADO SPRINGS, CO 80903 PH: 719.570.1100 FAX: 719.570.1108 CONTACT: RICHARD L. SCHINDLER, P.E. EMAIL: Rich@core1.com</div></div>	As Constructed		LORSON BRIDGE WINGWALL DETAILS			Project No./Code	
File Name:								No Revisions:		-				
Horiz. Scale: Vert. Scale: As Noted								Revised:		Designer: TDB	Structure	-		
Unit Information Unit Leader Initials								Void:		Detailer: TDB	Numbers	-		
										Sheet Subset:		Subset Sheets:	Sheet Number B11	

Loris and Associates, Inc.
100 Superior Plaza Way,
Suite 220
Superior, Colorado 80027
303.444.2073
www.LorisandAssociates.com

LORSON RANCH
THE LANDLUS COMPANY
212 N. WASATCH, SUITE 201
COLORADO SPRINGS, CO 80903
PHONE: 719.636.3200


CORE ENGINEERING GROUP
212 N. WASATCH AVE., SUITE 206
COLORADO SPRINGS, CO 80903
PH: 719.570.1100
FAX: 719.570.1106
CONTACT: RICHARD L. SCHINDLER, P.E.
EMAIL: RichS@ceg1.com

**PRELIMINARY
NOT FOR CONSTRUCTION**

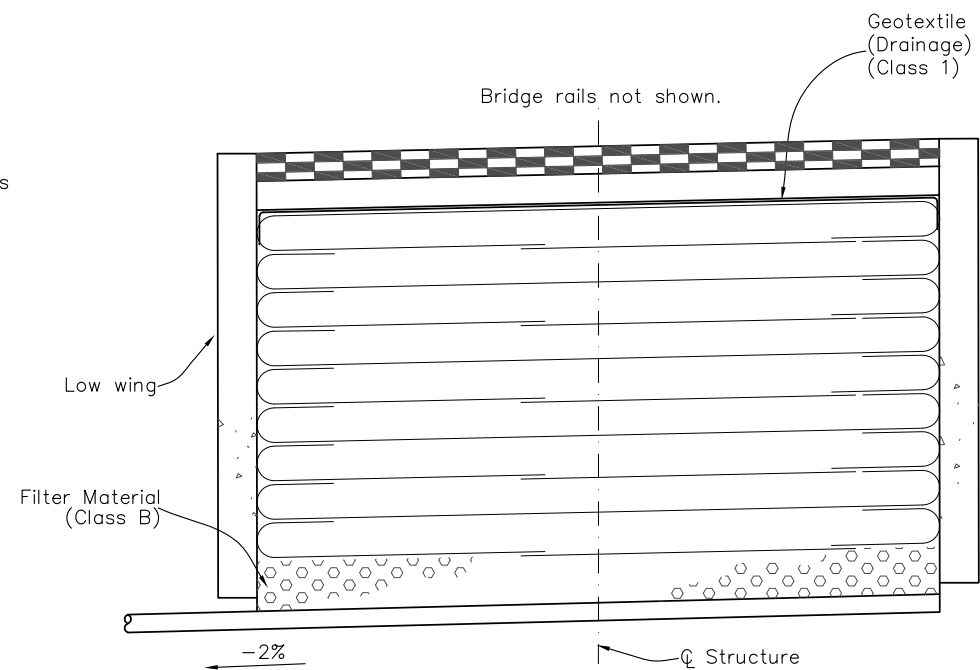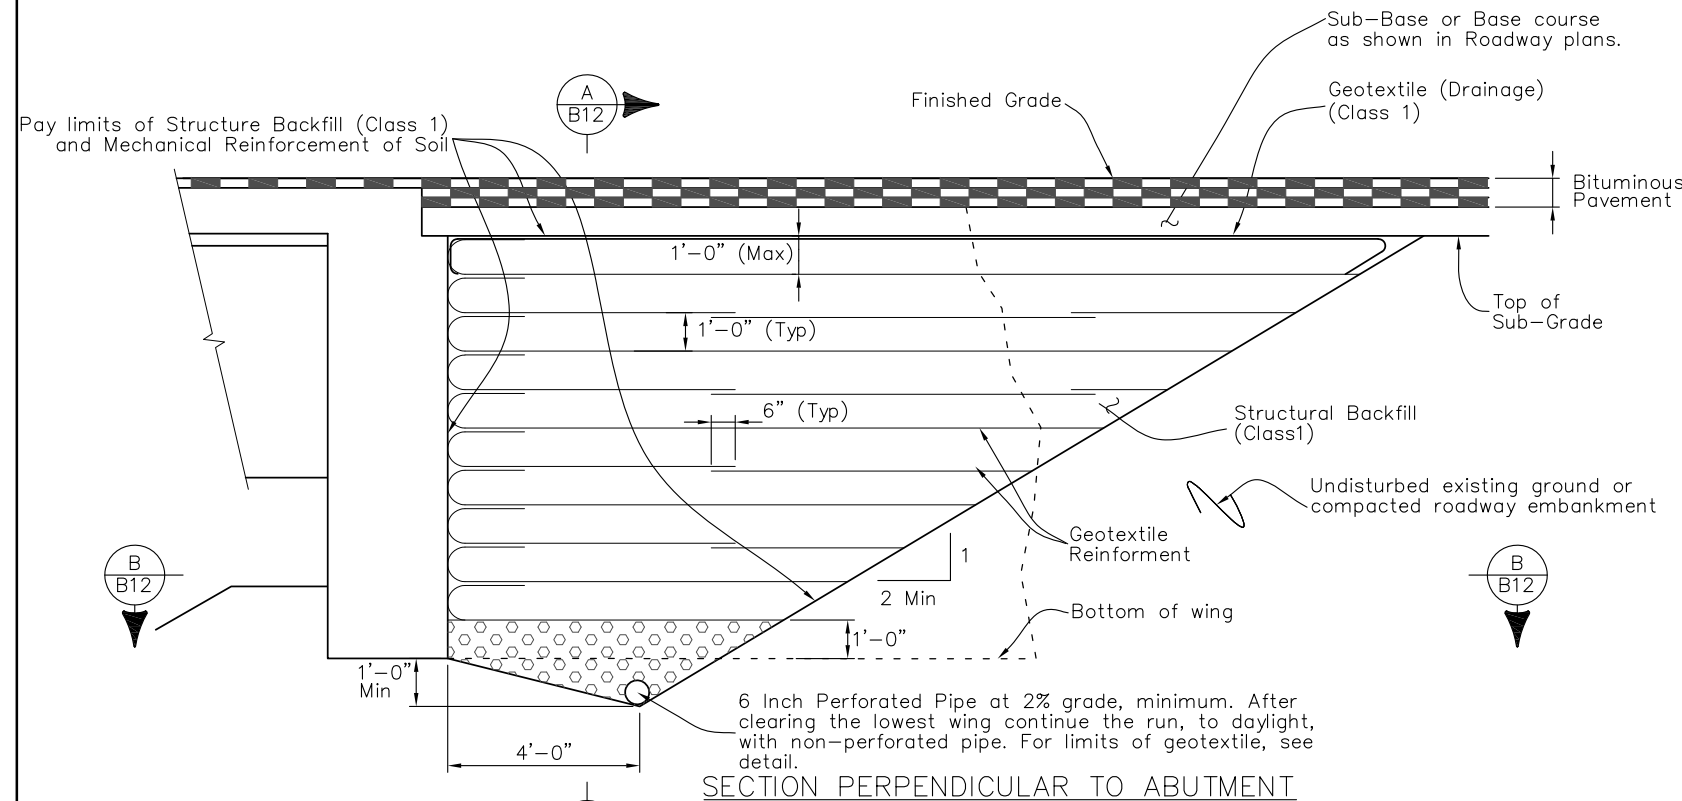

SECTION

A
B12

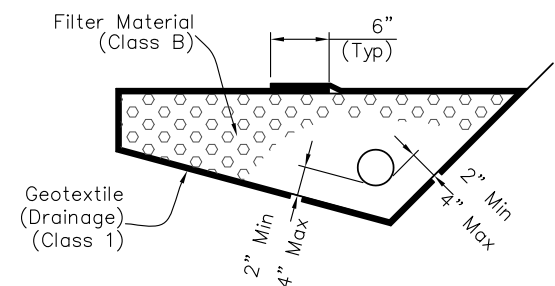

6 INCH PERFORATED PIPE UNDERDRAIN

6 Inch Perforated Pipe Underdrain includes all Filter Material (Class B) and Geotextile (Drainage) (Class 1) surrounding the Filter Material (Class B).

NOTES:

Geotextile Reinforcement shall be woven fabric with a Minimum Average Roll Value of 2400 lb/ft based on ASTM D4595.


Geotextile Reinforcement shall be placed by alternating Machine Direction (MD) with Cross Machine Direction (XD) from layer to layer.

The Geotextile Reinforcement wrap at Back Face of Abutment shall be pulled back slack free with its end anchored to soil underneath with staples or pins.


Minimum splice of all Geofabric shall consist of 6" of overlap.

Payment for all work items shown will be made under item 206 Mechanical Reinforcement of Soil (CY) and item 206 Structure Backfill (Class 1) (CY) and shall include the cost for 6 Inch Perforated Pipe Underdrain and Subsurface Drain Outlet (6"Ø Non-Perforated Pipe).

Installation of Pipe Underdrain and Subsurface Drain Outlet will Conform to the Construction requirements of Section 605.03 and 605.06, respectively.

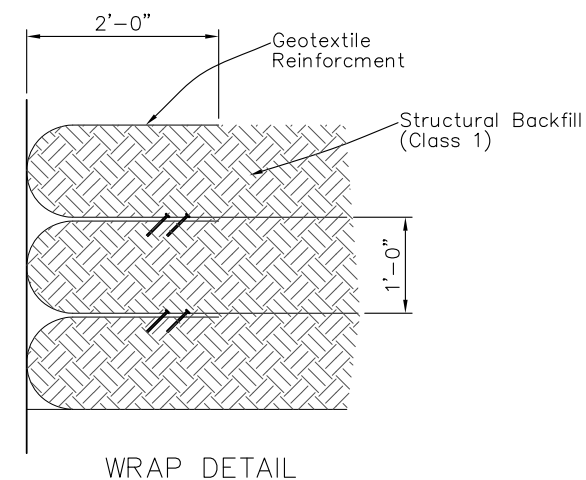

WRAP DETAIL


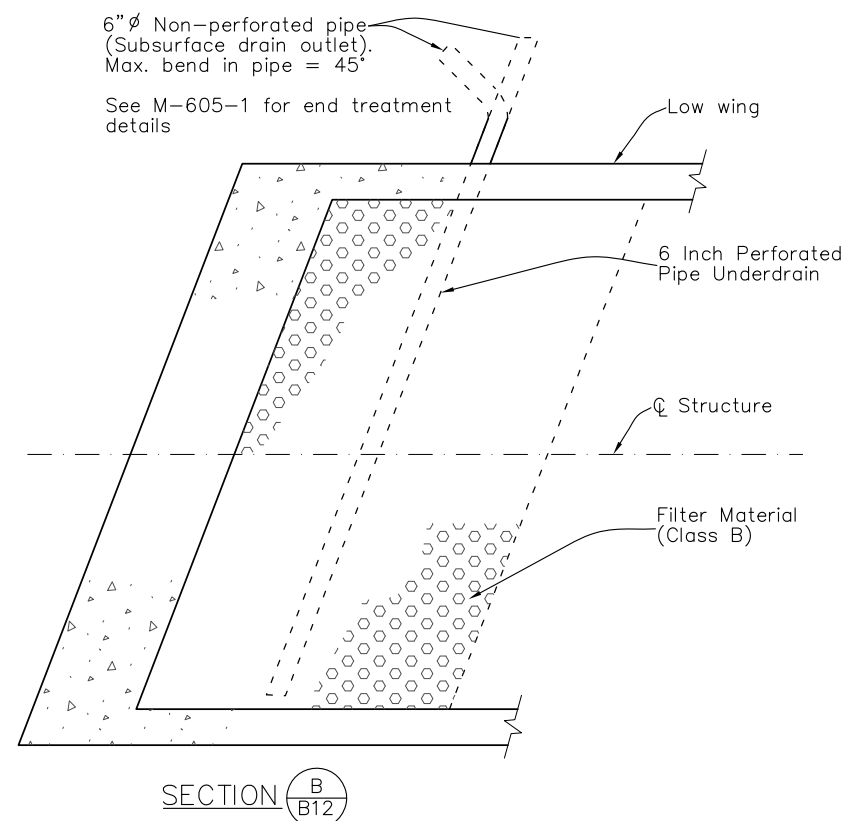


SECTION

B
B12

Print Date:	<div><div></div><div></div><div></div><div></div><div></div></div>	Sheet Revisions			<div><div></div><div>Loris and Associates, Inc. 100 Superior Plaza Way, Suite 220 Superior, Colorado 80027 303.444.2073 www.LorisandAssociates.com</div></div>	<div><div>LORSON RANCH</div><div>THE LANDHUIS COMPANY 212 N. WABATCHI, SUITE 301 COLORADO SPRINGS, CO 80903 CONTACT: RICHARD L. SCHINDLER, P.E. EMAIL: RichS@cecg1.com PHONE: 719-636-8200</div></div>	<div><div>CORE ENGINEERING GROUP</div><div>212 N. WAHSATCH AVE., SUITE 206 COLORADO SPRINGS, CO 80903 PH: 719.570.1100 FAX: 719.570.1106 CONTACT: RICHARD L. SCHINDLER, P.E. EMAIL: RichS@cecg1.com</div></div>	As Constructed		LORSON BRIDGE EXCAVATION AND BACKFILL DETAILS			Project No./Code	
File Name:		Date:	Comments	Init.				No Revisions:			-			
Horiz. Scale: Vert. Scale: As Noted								Revised:	Designer:	TDB	Structure Numbers	-		
Unit Information Unit Leader Initials									Detailer:	JWJ				
								Void:	Sheet Subset:		Subset Sheets:		Sheet Number	B12

PRELIMINARY
NOT FOR CONSTRUCTION

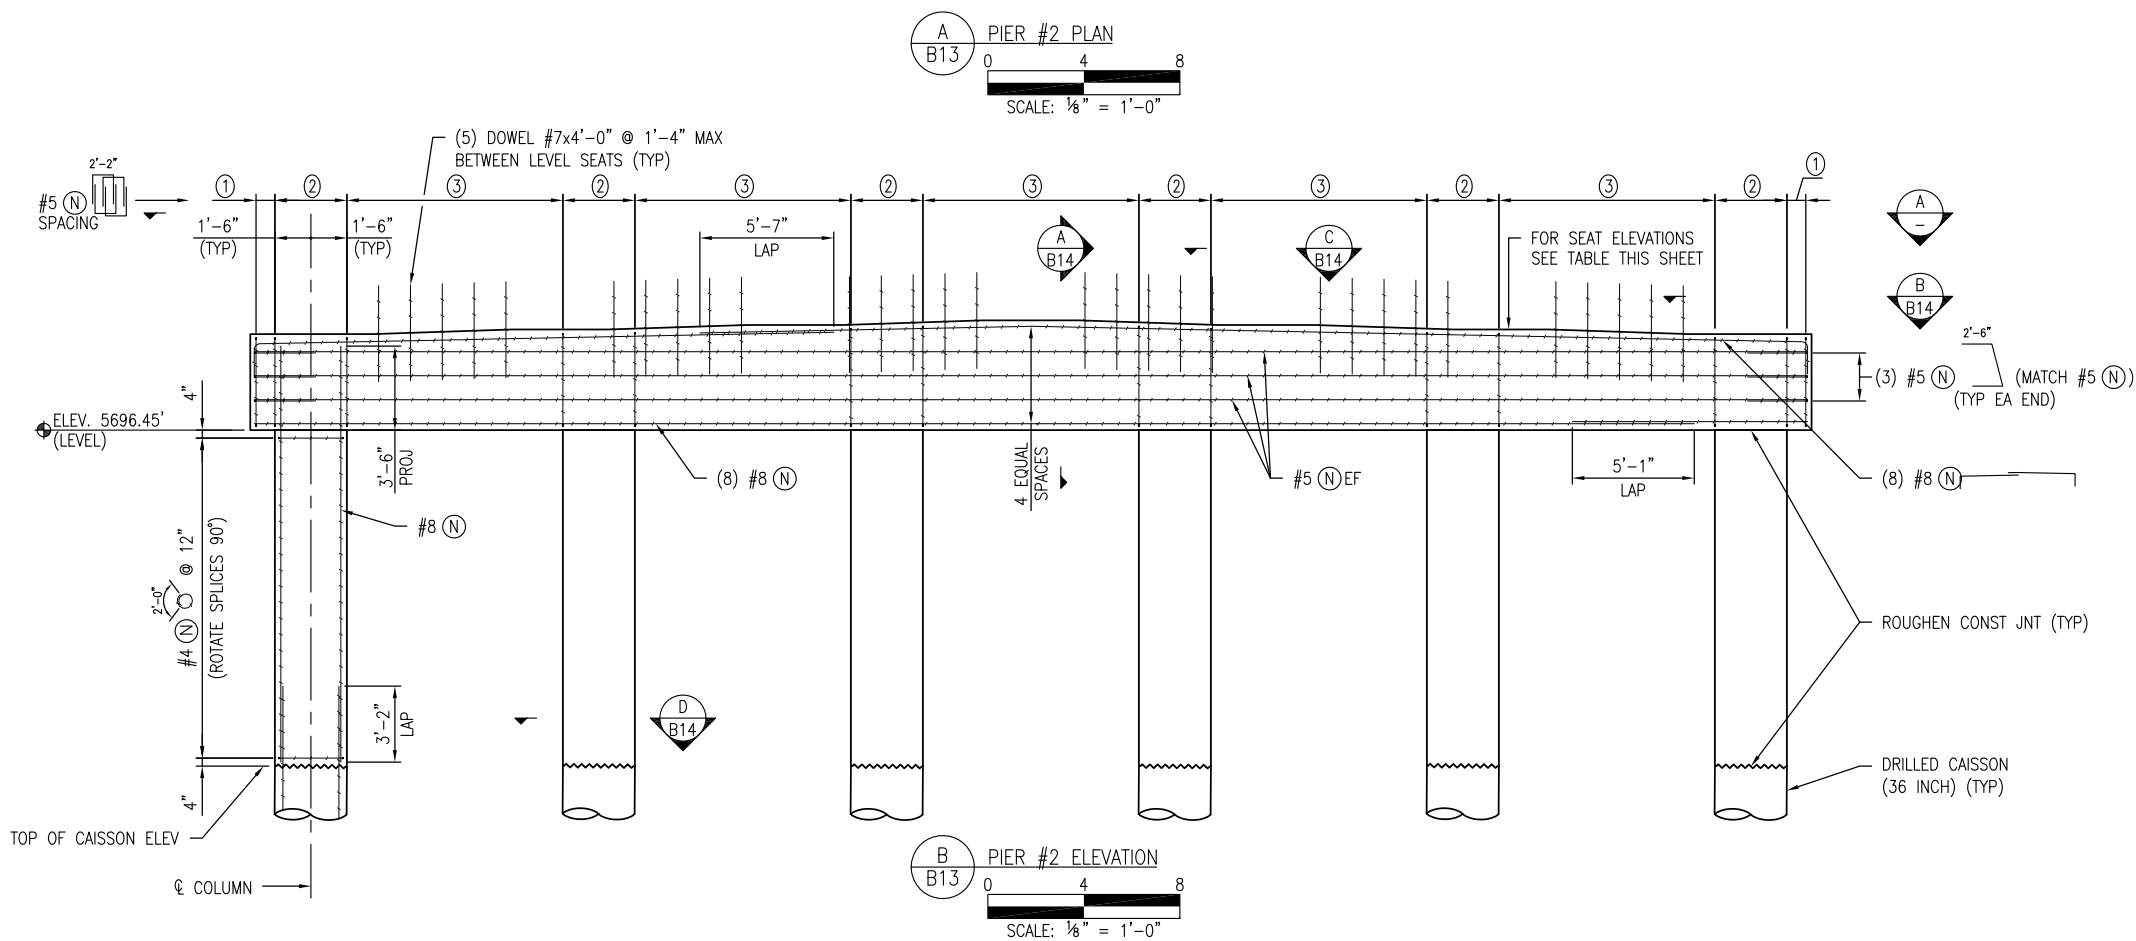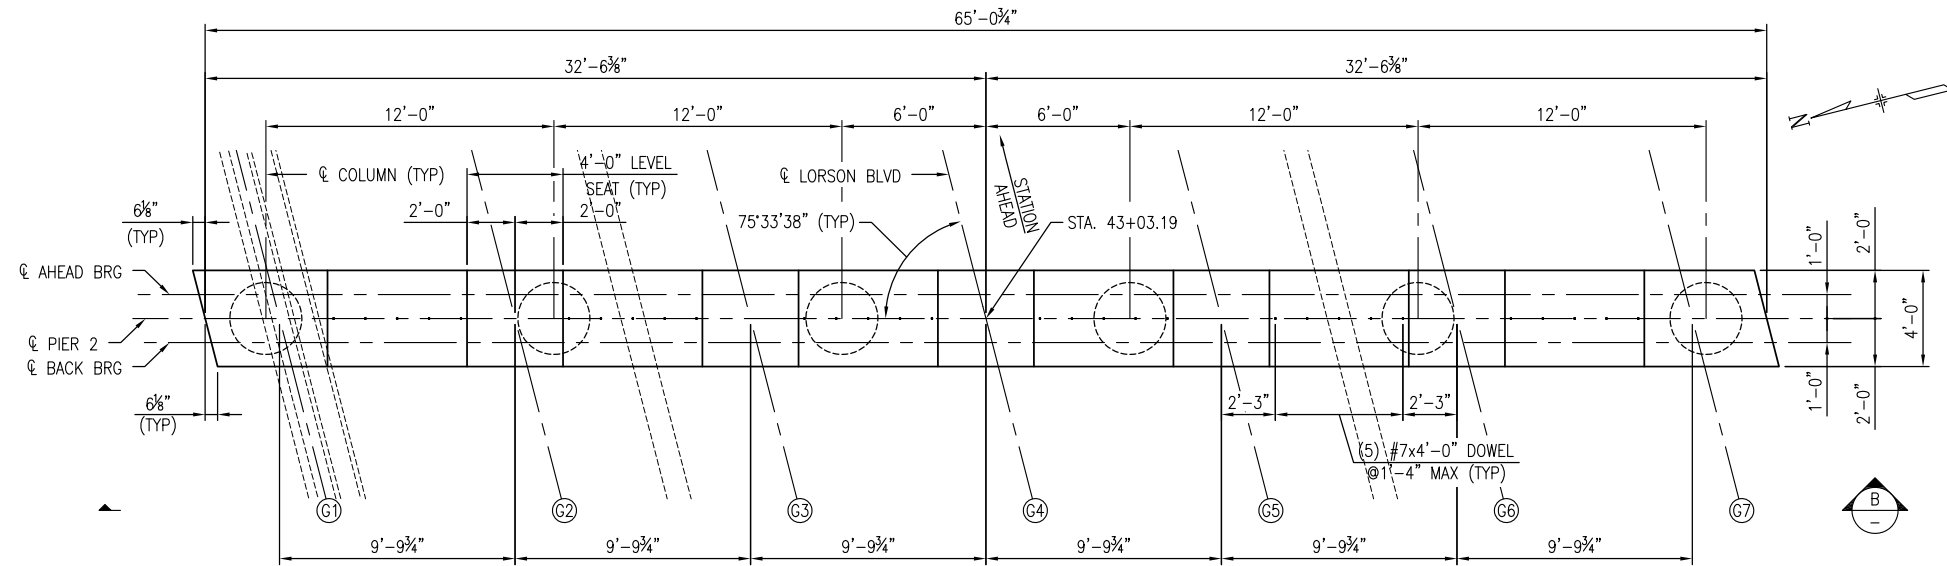

- ① (2) SPACES @ 9" MAX
② (3) SPACES @ 1'-0" = 3'-0"
③ (12) SPACES @ 9" = 9'-0"

SEAT ELEVATIONS	
GIRDER	ELEVATION
G1	5700.46
G2	5700.65
G3	5700.86
G4	5701.07
G5	5700.90
G6	5700.73
G7	5700.54

- NOTES
- PIER SHALL BE CONCRETE CLASS D.
 - ALTERNATE LAP SPLICES AS SHOW.
 - SEAT ELEVATIONS SHOWN ARE AT ϕ PIER AND ϕ GIRDER
 - FOR TOP OF CAISSON ELEVATIONS SEE SHEET B07
 - FOR BEARING SEAT DETAIL SEE SHEET B13




C:\72 Clients\369 - Lorson Bridge\50 DWG\16136 (B13-B14) Pier Details.dwg Sep 26, 2017 - 4:15pm

Print Date:		<div><div></div><div></div><div></div><div></div></div>	Sheet Revisions			<div><div></div><div></div></div> <div>Loris and Associates, Inc. 100 Superior Plaza Way, Suite 220 Superior, Colorado 80027 303.444.2073 www.LorisandAssociates.com</div>	<div><div></div><div></div></div> <div>THE LANDHUS COMPANY 212 N. WASATCH, SUITE 301 COLORADO SPRINGS, CO 80903 PHONE: 719.636.3200</div>	<div><div></div><div></div></div> <div>CORE ENGINEERING GROUP 212 N. WAHSATCH AVE., SUITE 206 COLORADO SPRINGS, CO 80903 PH: 719.570.1100 FAX: 719.570.1106 CONTACT: RICHARD L. SCHINDLER, P.E. EMAIL: RichS@ceg1.com</div>	As Constructed		LORSON BRIDGE PIER#2 PLAN & ELEVATION			Project No./Code	
File Name:			Date:	Comments	Init.				No Revisions:		-				
Horiz. Scale: Vert. Scale: As Noted									Revised:		Designer: TDB	Structure	-		
Unit Information Unit Leader Initials									Void:		Detailer: JWJ	Numbers			
											Sheet Subset:	Subset Sheets:	Sheet Number B13		



Print Date:		<div><div></div><div></div><div></div><div></div><div></div></div>	Sheet Revisions			<div><div></div><div>Loris and Associates, Inc. 100 Superior Plaza Way, Suite 220 Superior, Colorado 80027 303.444.2073 www.LorisandAssociates.com</div></div>	<div><div>LORSON RANCH</div><div>THE LANDHUS COMPANY 212 N. WASATCH, SUITE 301 COLORADO SPRINGS, CO 80903 PHONE: 719-635-3200</div></div>	<div><div>CORE ENGINEERING GROUP</div><div>212 N. WAHSATCH AVE., SUITE 206 COLORADO SPRINGS, CO 80903 PH: 719.570.1100 FAX: 719.570.1106 CONTACT: RICHARD L. SCHINDLER, P.E. EMAIL: RichS@ceg1.com</div></div>	As Constructed		LORSON BRIDGE PIER#2 DETAILS			Project No./Code	
File Name:			Date:	Comments	Init.				No Revisions:					-	
Horiz. Scale: Vert. Scale: As Noted									Revised:		Designer: TDB	Structure		-	
Unit Information Unit Leader Initials									Void:		Detailer: JWJ	Numbers			
											Sheet Subset:	Subset Sheets:		Sheet Number	B14

PRELIMINARY
NOT FOR CONSTRUCTION

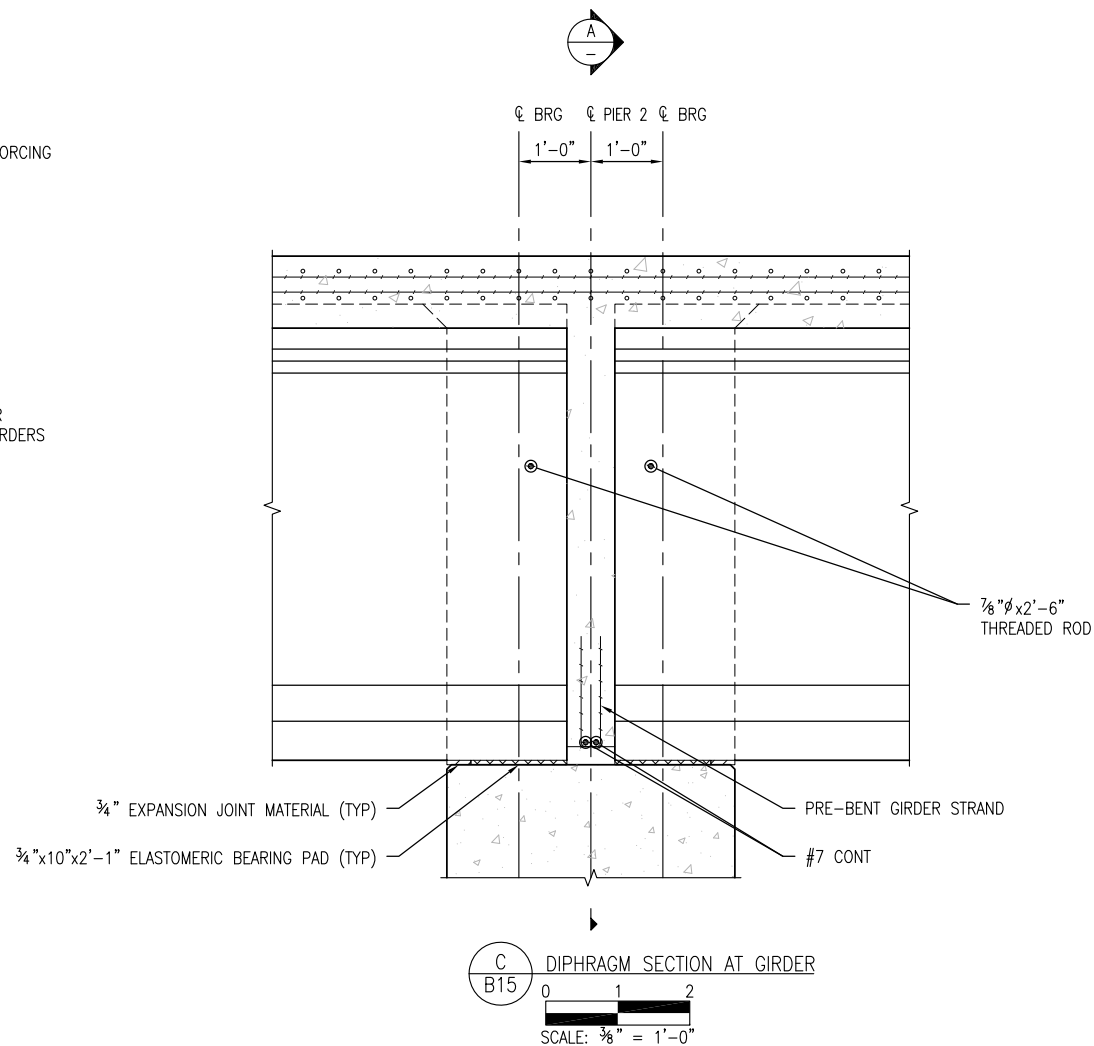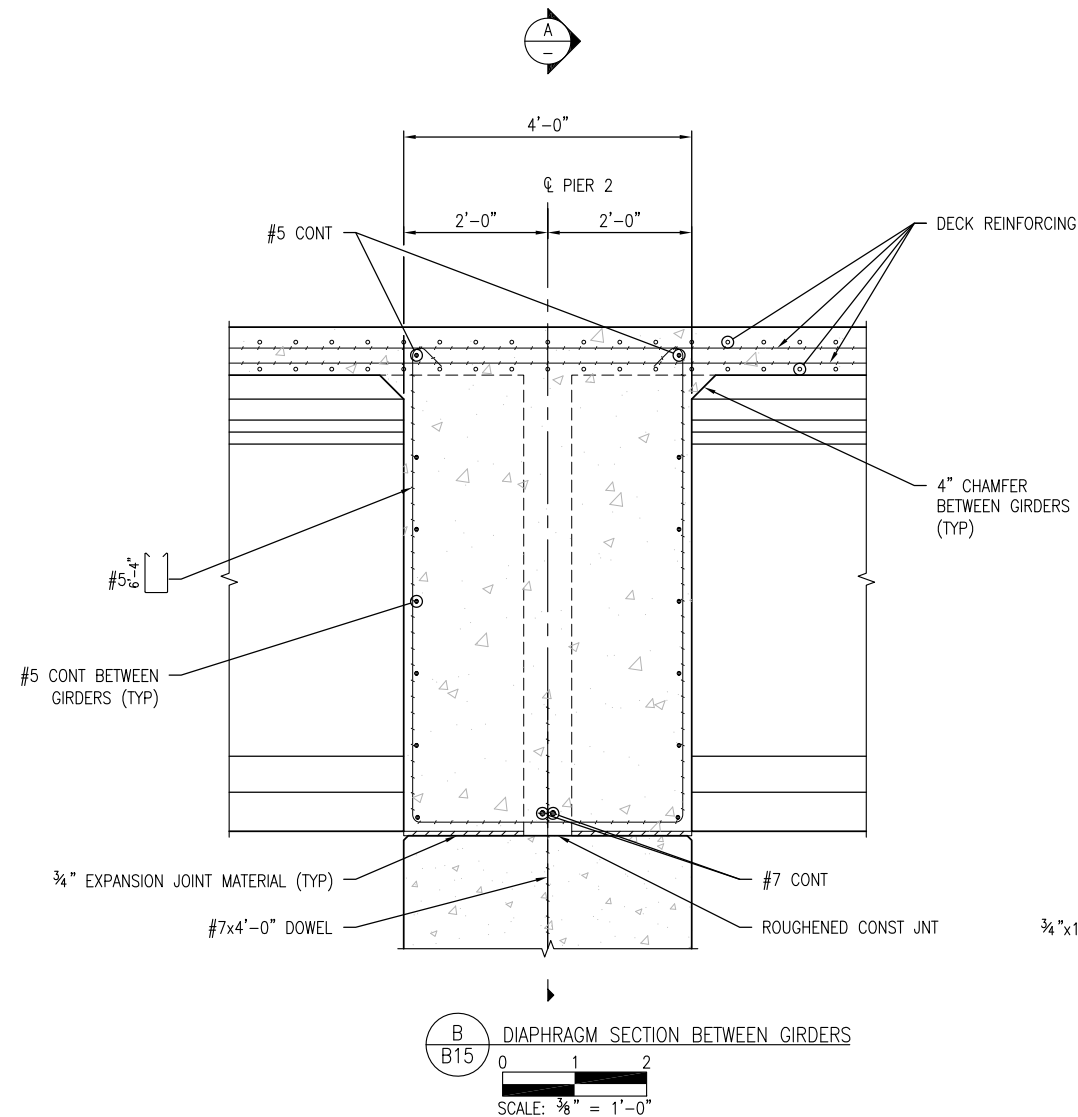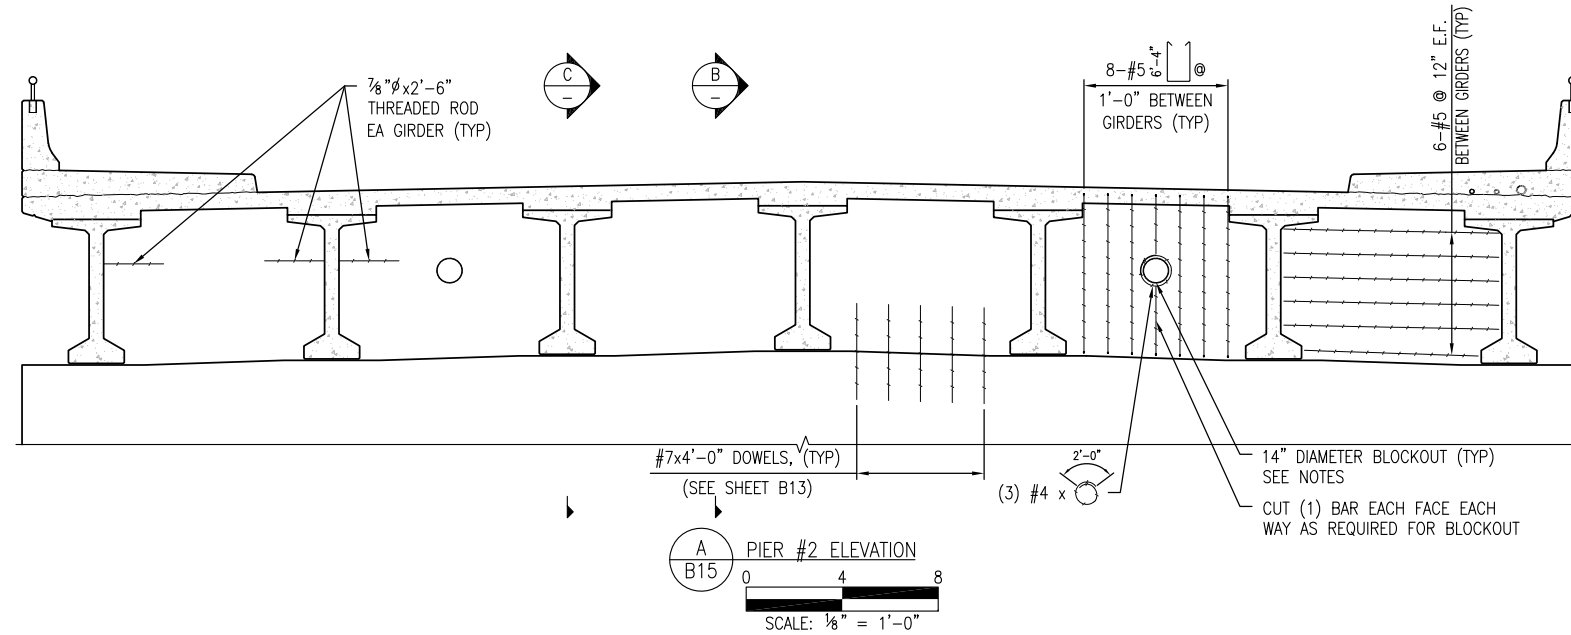

NOTES


- PIER DIAPHRAGM SHALL BE CONCRETE CLASS D.
- DECK AND PIER DIAPHRAGM SHALL BE PLACED MONOLITHICALLY.
- THREADED ROD SHALL BE PLACED IN 7/8" INSERTS PROVIDED IN GIRDERS. PROVIDE TWO BARS PER GIRDER END AT INTERIOR GIRDERS AND ONE BAR PER END AT EXTERIOR GIRDERS AS SHOWN.
- PLACE STIRRUP REINFORCING PARALLEL TO G GIRDER.
- AFTER INSTALLATION OF CONDUIT, SEAL GAP BETWEEN THE CONDUIT AND THE BLOCKOUT WITH MASTIC.

Print Date:
File Name:
Horiz. Scale: Vert. Scale: As Noted
Unit Information Unit Leader Initials

<input type="text"/>
<input type="text"/>
<input type="text"/>
<input type="text"/>

Sheet Revisions

Date:	Comments	Init.

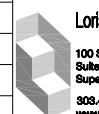

Loris and Associates, Inc.
100 Superior Plaza Way,
Suite 220
Superior, Colorado 80027
303.444.2073
www.LorisandAssociates.com



THE LANDHUS COMPANY
212 N. WASATCH, SUITE 901
COLORADO SPRINGS, CO 80903
PHONE: 719.636.3200



212 N. WASATCH AVE., SUITE 206
COLORADO SPRINGS, CO 80903
PH: 719.570.1100
FAX: 719.570.1106
CONTACT: RICHARD L. SCHINDLER, P.E.
EMAIL: RichS@ceg1.com

As Constructed

No Revisions:

Revised:

Void:

LORSON BRIDGE
PIER#2 DIAPHRAGM DETAILS

Designer:	TDB	Structure	
Detailer:	JWJ	Numbers	
Sheet Subset:		Subset Sheets:	




Project No./Code

-

-

Sheet Number B15


PRELIMINARY
NOT FOR CONSTRUCTION

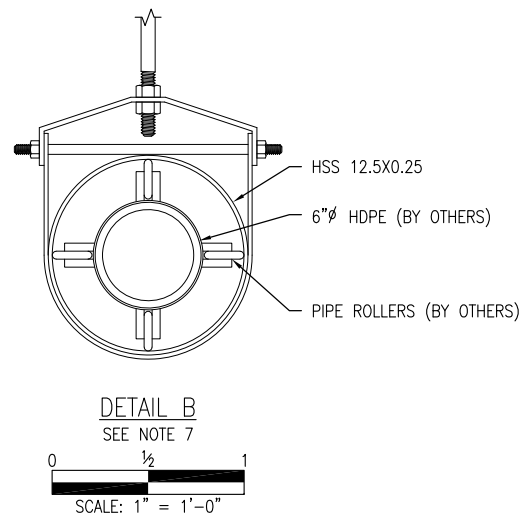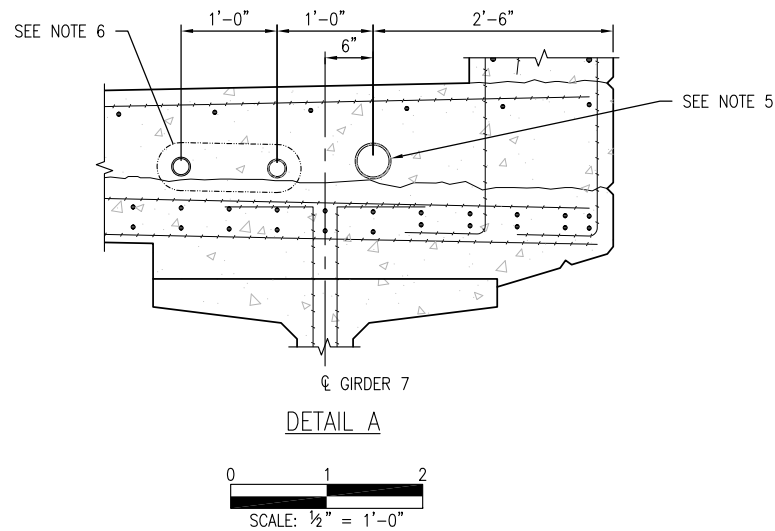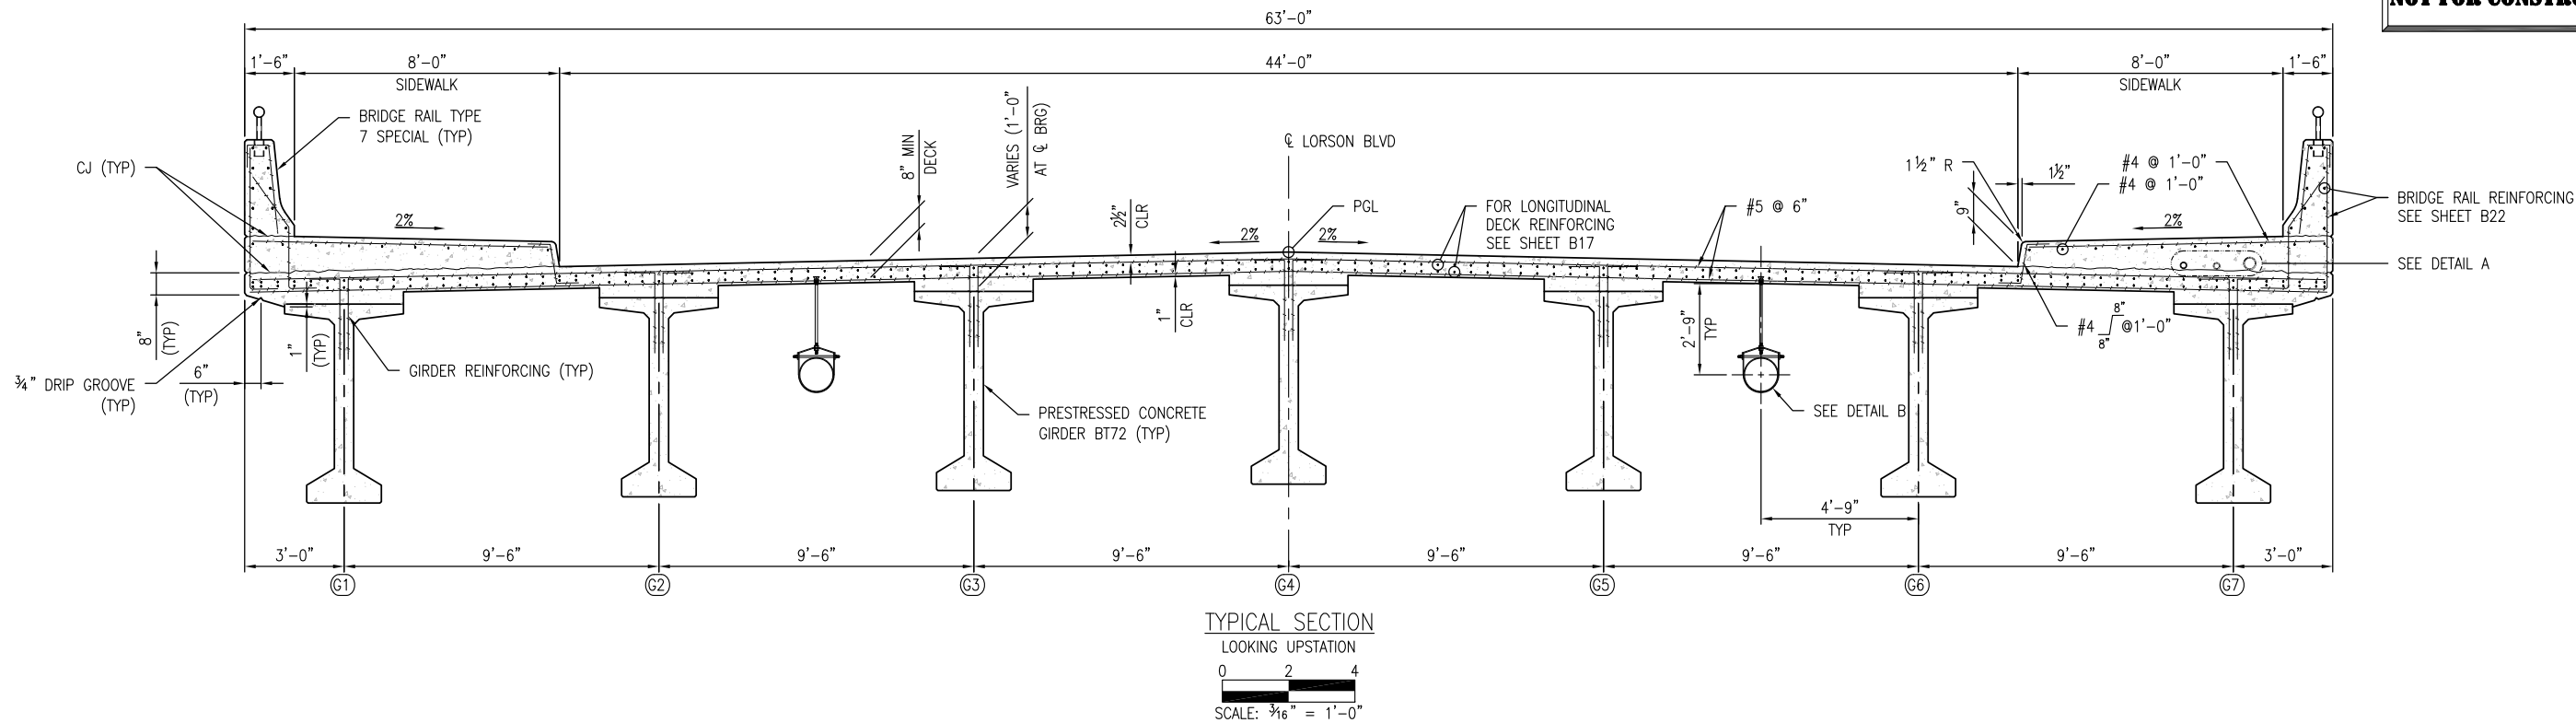

NOTES

- DECK SHALL BE CONCRETE CLASS D.
- SIDEWALK SURFACE SHALL BE BROOM-FINISHED IN ACCORDANCE WITH SECTION 608.
- FOR BRIDGE RAIL REINFORCING PROJECTING FROM DECK, SEE SHEET B17.
- PLACE TRANSVERSE BARS PARALLEL TO CL BRG.
- FOR CENTURY LINK, PROVIDE (1) 4"Ø SCHEDULE 80 PVC.
- FOR COMCAST, PROVIDE (2) 2"Ø SCHEDULE 80 PVC.
- FOR MOUNTAIN VIEW ELECTRIC ASSOCIATION, INC. (MVEA), PROVIDE TWO (2); CARRIER PIPES, AND HANGER ASSEMBLY. CARRIER PIPE SHALL BE ASTM A847; Fy=50 KSI. HANGER ASSEMBLY SHALL BE GALVANIZED ADJUSTABLE CLEVIS HANGER WITH 7/8" ALL-THREAD RODS, HEX NUTS AND SCREW CONCRETE INSERT AS MANUFACTURED BY ANVIL INTERNATIONAL, INC. OR APPROVED EQUIVALENT. LONGITUDINAL SPACING SHALL BE 16'-0" MAX. SUBMIT SHOP DRAWINGS TO MVEA FOR APPROVAL PRIOR TO CONSTRUCTION.




Print Date:		<div></div> <div></div> <div></div> <div></div> <div></div>	Sheet Revisions			<div><div></div><div>Loris and Associates, Inc. 100 Superior Plaza Way, Suite 220 Superior, Colorado 80027 303.444.2073 www.LorisandAssociates.com</div></div>	<div><div>LORSON RANCH</div><div>THE LANDHUIS COMPANY 212 N. WASATCH, SUITE 901 COLORADO SPRINGS, CO 80903 PHONE: 719-636-3200</div></div>	<div><div>CORE ENGINEERING GROUP</div><div>212 N. WASATCH AVE., SUITE 206 COLORADO SPRINGS, CO 80903 PH: 719.570.1100 FAX: 719.570.1106 CONTACT: RICHARD L. SCHINDLER, P.E. EMAIL: RichS@ceg1.com</div></div>	As Constructed		LORSON BRIDGE SUPERSTRUCTURE DETAILS			Project No./Code	
File Name:			Date:	Comments	Init.				No Revisions:		-				
Horiz. Scale: Vert. Scale: As Noted									Revised:		Designer: TDB	Structure	-		
Unit Information Unit Leader Initials									Void:		Detailer: JWJ	Numbers	-		
											Sheet Subset:	Subset Sheets:	Sheet Number B16		

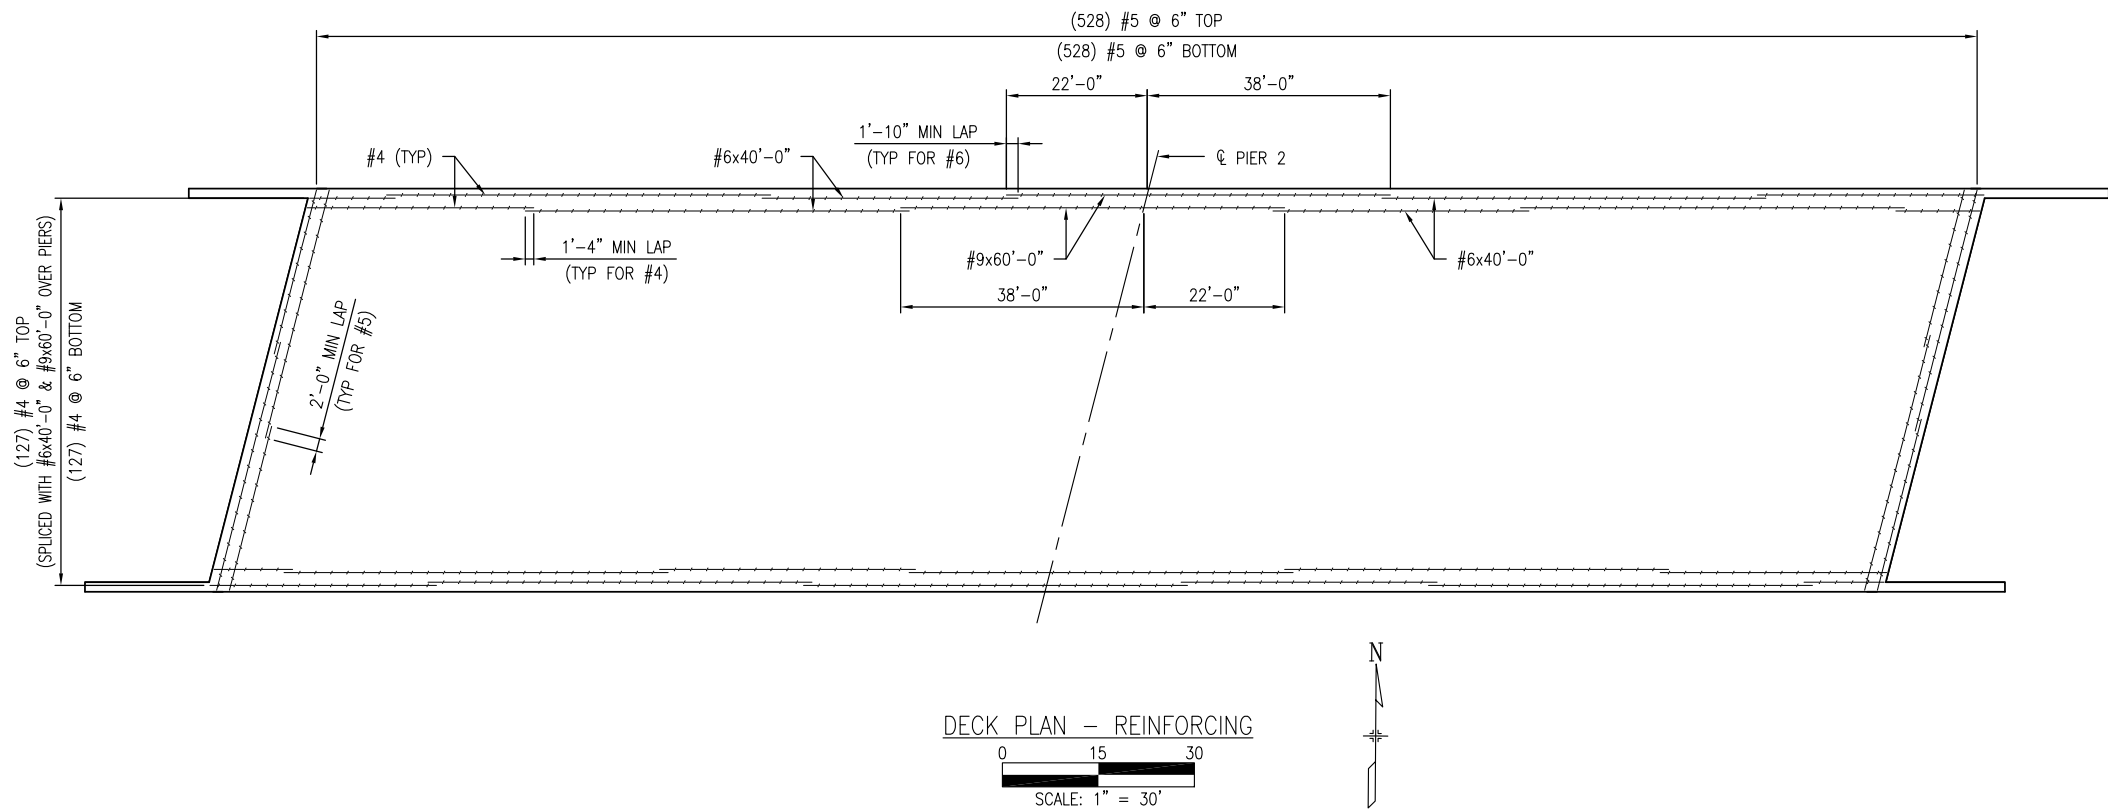


- NOTES
1. ALTERNATE LAP SPLICES AS SHOWN.
 2. FOR TOP REINFORCING IN ABUTMENT DIAPHRAGMS SEE SHEET B10.
 3. FOR REINFORCING IN SIDEWALK SEE SHEET B16.
 4. FOR TOP REINFORCING IN PIER DIAPHRAGMS SEE SHEET B14.
 5. FOR BRIDGE RAIL REINFORCING PROJECTIONG FROM DECK SEE SHEET B22.

Print Date:	<div><div></div><div></div><div></div><div></div><div></div></div>	Sheet Revisions			<div><div></div><div>Loris and Associates, Inc.</div><div>100 Superior Plaza Way, Suite 220 Superior, Colorado 80027 303.444.2073 www.LorisandAssociates.com</div></div>	<div><div></div><div>LORSON RANCH</div><div>THE LANDHUIS COMPANY 212 N. WASATCH, SUITE 501 COLORADO SPRINGS, CO 80903 PHONE: 719-570-3200</div></div>	<div><div></div><div>CORE ENGINEERING GROUP</div><div>212 N. WAHSATCH AVE., SUITE 206 COLORADO SPRINGS, CO 80903 PH: 719.570.1100 FAX: 719.570.1106 CONTACT: RICHARD L. SCHINDLER, P.E. EMAIL: RichS@ceg1.com</div></div>	As Constructed		LORSON BRIDGE DECK REINFORCING PLAN			Project No./Code			
File Name:		Date:	Comments	Init.				No Revisions:					-			
Horiz. Scale:		Vert. Scale: As Noted										-				
Unit Information		Unit Leader Initials														
												Sheet Number				
							Revised:	Designer:	TDB	Structure Numbers	-					
							Void:	Detailer:	JWJ		Sheet Number					
								Sheet Subset:	Subset Sheets:		B17					

C:\7.2 Clients\369 - Lorson Bridge\50 DWG\16136 (B18) Prestressed Concrete I - BT72.dwg Sep 26, 2017 - 4:16pm

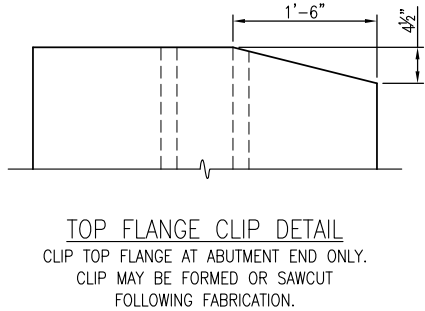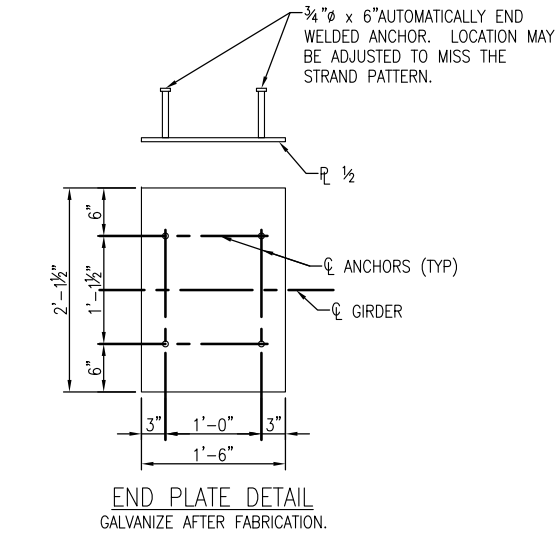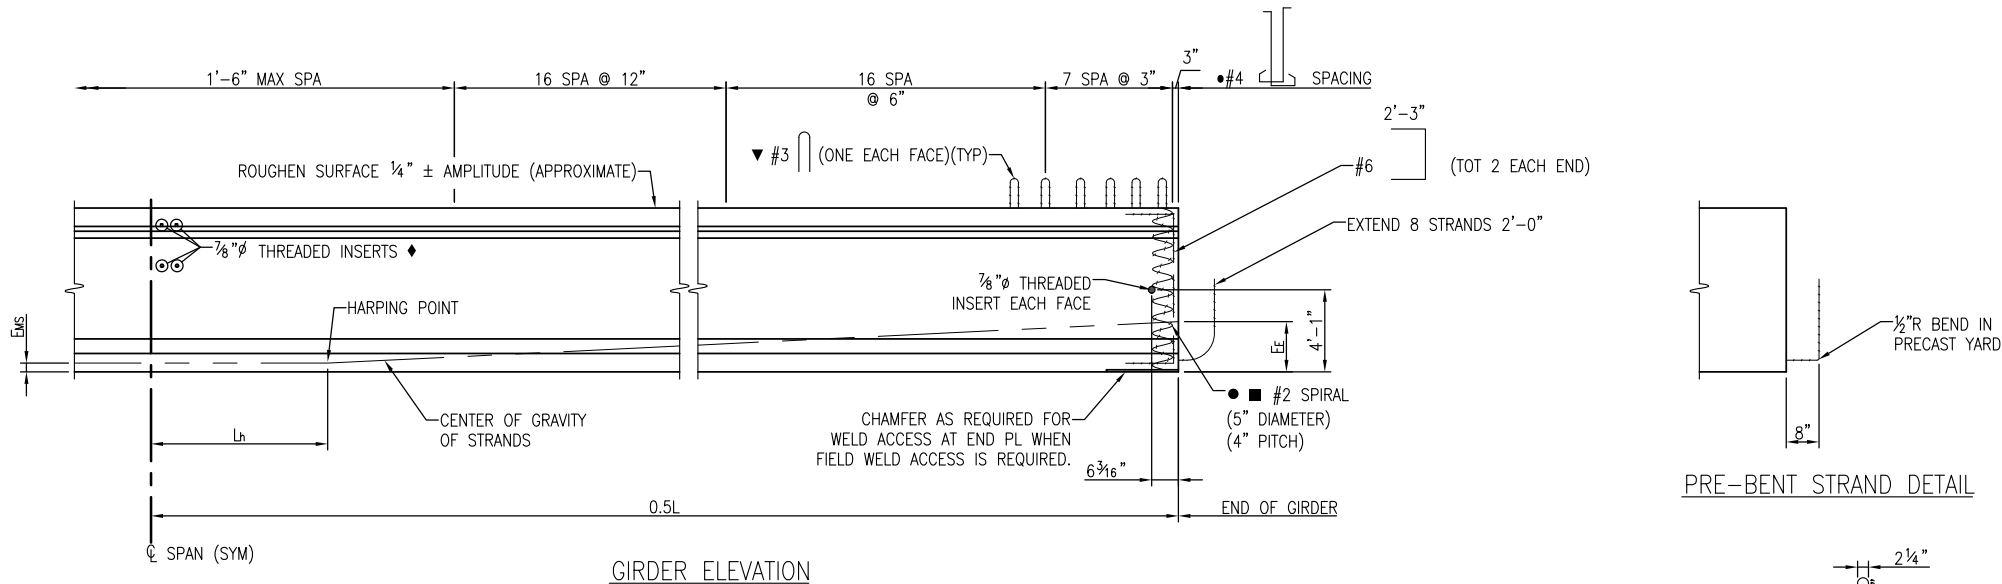

THESE LEGS REQUIRED ONLY ON THE END 20 STIRRUPS OF GIRDER (EACH FACE).

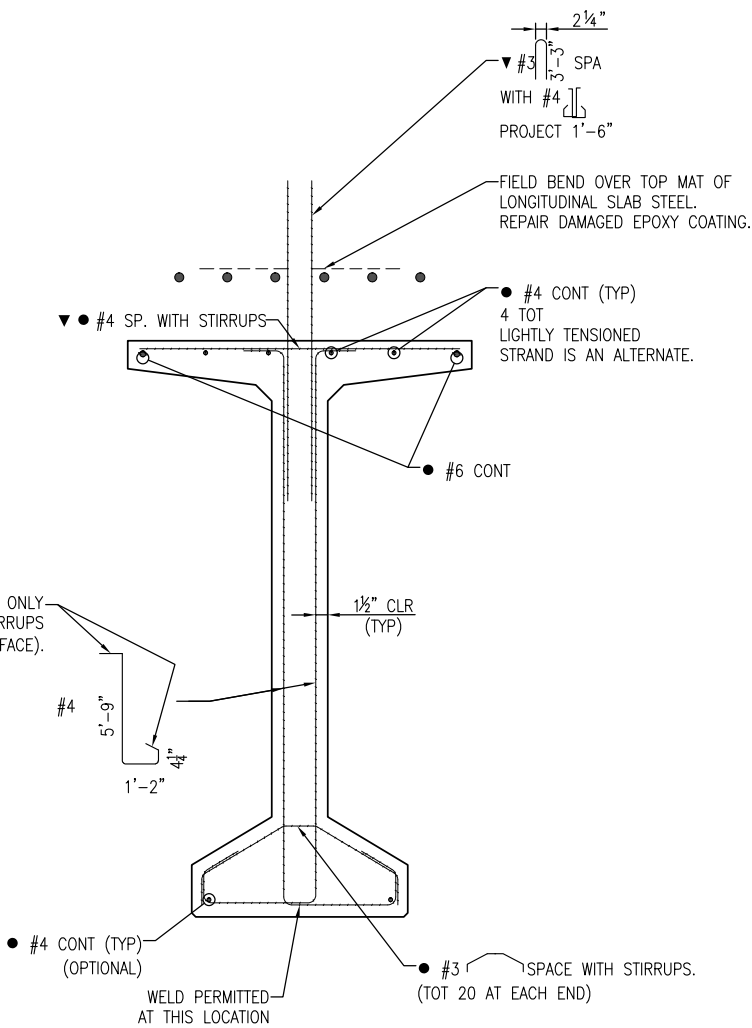

NOTES:

ALL WORK NECESSARY TO FABRICATE AND INSTALL THE INTEGRAL PARTS OF THE GIRDER (INCLUDING THE INTERMEDIATE DIAPHRAGMS, $\frac{7}{8}$ " ϕ THREADED RODS, AND LEVELING PADS), AS SHOWN ON THE PLANS, SHALL BE INCLUDED IN THE BID PRICE FOR ITEM NO. 618, PRESTRESSED CONCRETE I (BT72), WITH A PAY UNIT OF LF WHICH SHALL BE MEASURED BY DIMENSION L.

WHEN APPROVED BY THE ENGINEER, A MINIMUM OF TACK WELDING WILL BE PERMITTED ON ASTM A706 UNCOATED REINFORCING STEEL.

REINFORCING PROJECTING FROM THE TOP OF THE GIRDER AND REINFORCING WITHIN EIGHT FEET OF AN EXPANSION DEVICE IN THE BRIDGE DECK SHALL BE EPOXY COATED. DAMAGED COATING ON GIRDER REINFORCING NEED NOT BE REPAIRED. THE MINIMUM COVER FOR REINFORCING STEEL IS 1".

AT GIRDER ENDS NOT EMBEDDED IN CONCRETE DIAPHRAGMS, CUT STRANDS OFF 1" BELOW THE SURFACE OF THE CONCRETE AND FINISH WITH AN APPROVED EPOXY GROUT. AT GIRDER ENDS EMBEDDED IN CONCRETE DIAPHRAGMS, CUT STRANDS TO PROJECT 3", EXCEPT AS SHOWN. DO NOT MAKE COSMETIC REPAIRS (DAMAGE LESS THAN $\frac{1}{2}$ " DEEP) TO THE PARTS OF THE GIRDERS EMBEDDED IN CONCRETE.

USE LOW RELAXATION STRANDS MEETING THE REQUIREMENTS OF ASTM A-416 GRADE 270. THE MINIMUM CLEAR DISTANCE BETWEEN GROUPS OR INDIVIDUAL STRANDS SHALL BE $2.3(d_s)$ BUT NOT LESS THAN $\frac{1}{4}$ ". THE MINIMUM COVER FOR PRESTRESSING STEEL IS $\frac{1}{2}$ ".

A MINIMUM OF TWO HARPING POINTS SHALL BE USED PER GIRDER. HARPED STRANDS SHALL BE WELL DISTRIBUTED AT THE GIRDER ENDS, STARTING WITHIN 4" OF THE TOP OF THE GIRDER AND DISTRIBUTED SUCH THAT THERE IS NO SPACE BETWEEN STRANDS GREATER THAN 1'-0" AT THE END OF THE GIRDER. AS AN ALTERNATE THE CONTRACTOR MAY PLACE #4 \bullet X 10'-0" IN THE SIDES OF THE END OF THE WEB PARALLEL TO THE HARPED STRANDS SUCH THAT THERE IS NO SPACE GREATER THAN 1'-0".

A_s^* = MINIMUM AREA OF THE PRESTRESSING STEEL.
 d_s = NOMINAL STRAND DIAMETER.
 f'_s = ULTIMATE STRENGTH OF PRESTRESSING STEEL.
 F_j = JACKING FORCE PER GIRDER.
 F_f = FINAL FORCE PER GIRDER AFTER ALL LOSSES.
 f'_{ci} = REQUIRED CONCRETE STRENGTH AT RELEASE OF PRESTRESS FORCE.
 f'_c = REQUIRED CONCRETE STRENGTH AT 28 DAYS OF AGE.
L = LENGTH OF GIRDER ALONG THE GRADE OF THE GIRDER.
 Δ = DEFLECTION AT CENTERLINE OF SPAN DUE TO CAST-IN-PLACE SLAB, DIAPHRAGMS, ASPHALT, CURBS, RAILS, AND WALKS.

CONCRETE SHALL BE CLASS PS.

ENTRAINED AIR IS NOT REQUIRED FOR GIRDER CONCRETE.

USE $\frac{1}{2}$ " CHAMFER ON ALL CORNERS, EXCEPT AS NOTED.

PREDICTED CAMBER IS THE CAMBER FOR THE GIRDER ALONE AT 60 DAYS. ACCEPTABLE CAMBER VARIABILITY IS LIMITED TO 20% OVER THE PREDICTED CAMBER AND 50% UNDER THE PREDICTED CAMBER OR 1 INCH, WHICHEVER IS GREATER. THE CONTRACTOR SHALL REPORT TO THE ENGINEER VALUES OF CAMBER WHICH REQUIRE REMEDIAL MEASURES. THE REMEDIAL MEASURES SHALL BE REVIEWED AND APPROVED BY THE ENGINEER. THE COSTS ASSOCIATED WITH ALL REMEDIAL MEASURES SHALL BE BORNE BY THE CONTRACTOR.

∇ SPACE WITH #4 \llcorner FOR STIRRUP SPACINGS OF 9" OR MORE. SPACE AT 1'-0" FOR STIRRUP SPACINGS LESS THAN 9".

\bullet D20 WIRES MAY BE USED IN LIEU OF #4.
2 - D20 WIRES MAY BE USED IN LIEU OF #6.
D11 OR W10.9 WIRES MAY BE USED IN LIEU OF #3.
W5 WIRES MAY BE USED IN LIEU OF #2.

\blacksquare THE CONTRACTOR MAY SUBMIT AN ALTERNATE CROSS TIE ARRANGEMENT, AT THE END OF THE WEB, FOR APPROVAL BY THE ENGINEER.

\blacklozenge SEE CONSTRUCTION LAYOUT FOR INTERMEDIATE DIAPHRAGM LOCATIONS.

GIRDER SCHEDULE													
GIRDER TYPE	SPAN NO.	GIRDER NO.	L (FEET)	L _h (FEET)	A _g * (SQUARE INCH)	E _{MS} (INCH)	E _E (INCH)	F (KIPS)	F _f (KIPS)	CONCRETE STRENGTH		Δ (INCH)	PREDICTED CAMBER (INCH)
										f' _{ci} (PSI)	f' _c (PSI)		
BT72	1 & 2	G1-G7	130'-0"	13'-0"	8.680	5.05	15.45	1757.7	1369.0	7500	9000	2.34	4.72

**PRELIMINARY
NOT FOR CONSTRUCTION**

Print Date:
File Name:
Horiz. Scale: Vert. Scale: As Noted
Unit Information Unit Leader Initials

Sheet Revisions		
Date:	Comments	Init.




Lorson and Associates, Inc.
100 Superior Plaza Way,
Suite 220
Superior, Colorado 80027
303.444.2073
www.LorsonandAssociates.com

LORSON RANCH
THE LANDHUIS COMPANY
212 N. WASATCH, SUITE 901
COLORADO SPRINGS, CO 80903
PHONE: 719.636.3200

CORE ENGINEERING GROUP
212 N. WASATCH AVE., SUITE 206
COLORADO SPRINGS, CO 80903
PH: 719.570.1100
FAX: 719.570.1106
CONTACT: RICHARD L. SCHINDLER, P.E.
EMAIL: RichS@ceg1.com

As Constructed	LORSON BRIDGE PRESTRESSED CONCRETE I (SHEET 1)			Project No./Code
No Revisions:				—
Revised:	Designer:	TDB	Structure	—
	Detailer:	JWJ	Numbers	
Void:	Sheet Subset:		Subset Sheets:	Sheet Number B18

PRELIMINARY
NOT FOR CONSTRUCTION

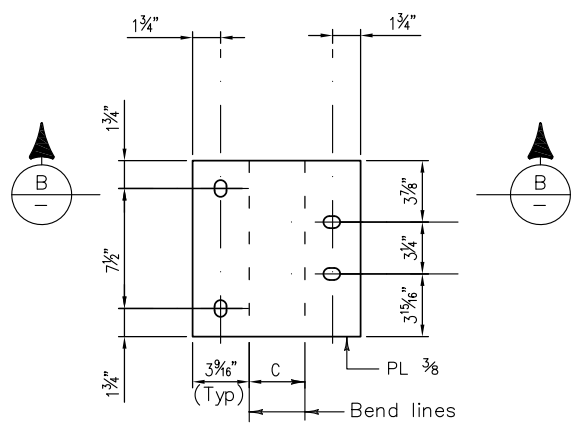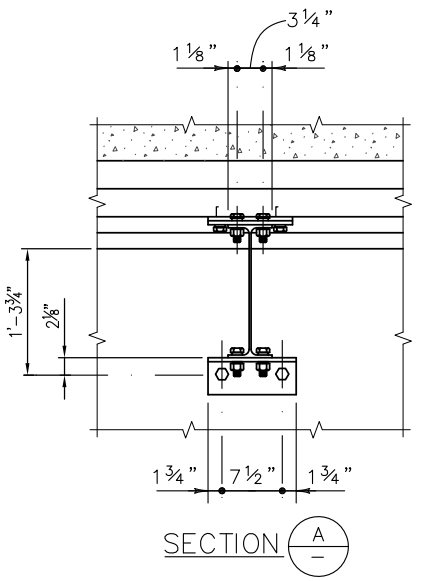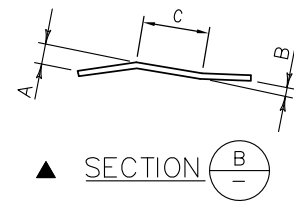

PLAN
(Before bending)
PLATE DETAIL

NOTES

All diaphragm materials, including bolts, nuts, and washers shall be galvanized. Galvanize after fabrication.

★ If the construction layout does not specify diaphragms, there shall be at least one diaphragm at mid span.

Bolts, nuts and lock washers may be zinc plated in lieu of being galvanized.



▲ Dimensions A, B and C shall be shown on the shop drawings.

The diaphragms may be placed on a skew such that they are between 80° and 100° to the girders. Additionally, all diaphragms shall be installed level.


The Contractor is responsible for determining necessary bracing requirements and for providing adequate bracing for the specific wind and weather conditions to be encountered for each specific project.

When bracing or diaphragms are required, no girders shall be erected and left unbraced. The intermediate diaphragms (when used) shall be connected to the adjacent girders simultaneously with the erection of the girders.

Use and installation of the intermediate diaphragms shall not relieve the Contractor of full responsibility to construct the Work in a manner which provides all necessary rigidity, supports all loads imposed, and provides in the finished structure the lines and grades indicated on the plans.




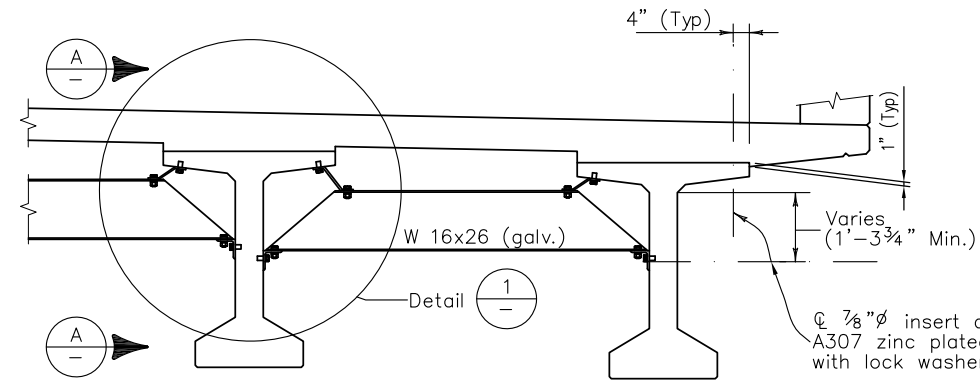
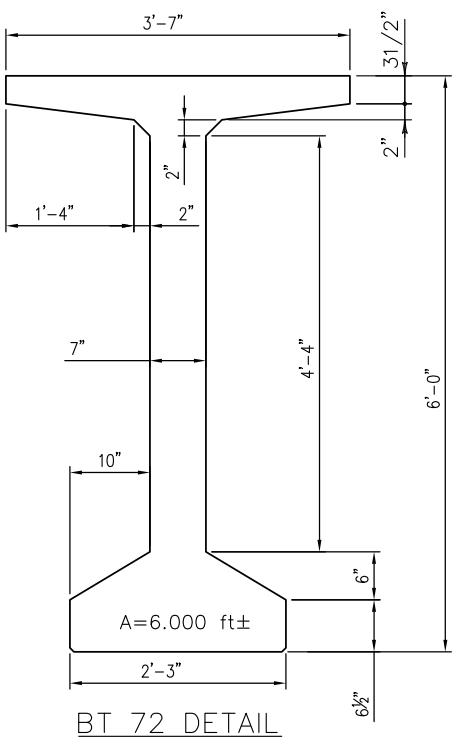


INTERMEDIATE DIAPHRAGM DETAILS
★ For location of diaphragms, see Construction Layout.

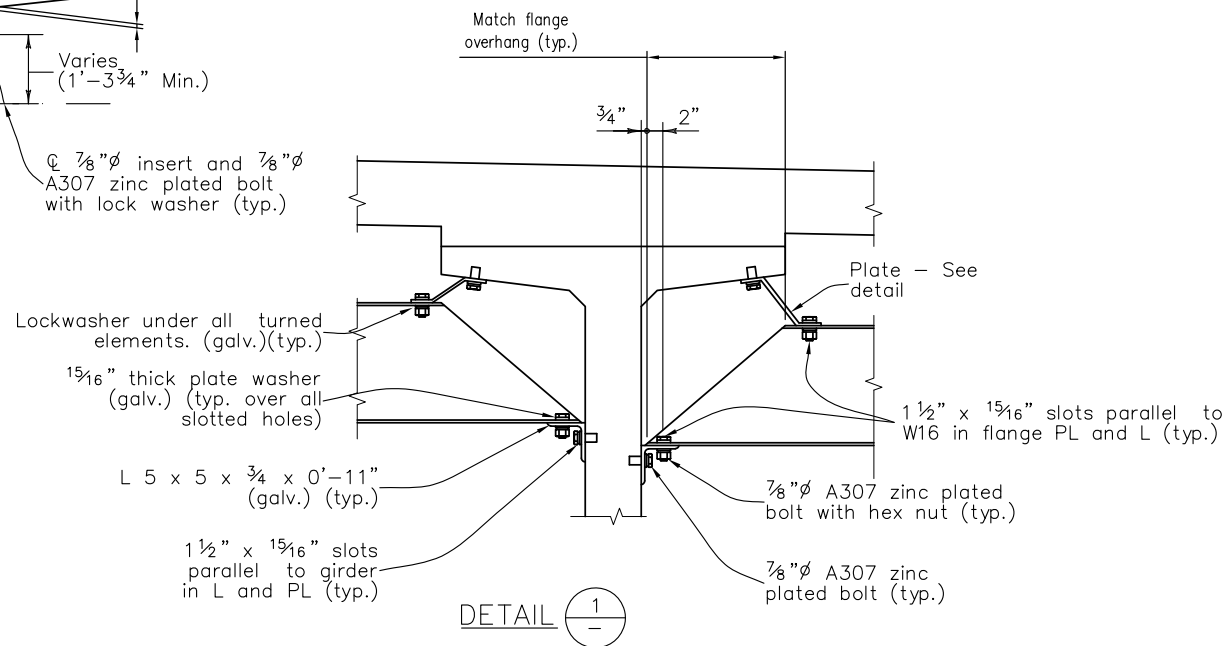


C:\72 Clients\369 - Lorson Bridge\50 DWG\16136 (B19) Intermediate Diaphragm Details.dwg Sep 26, 2017 - 4:16pm

Print Date:	<div><div></div><div></div><div></div><div></div></div>	Sheet Revisions			<div><div></div><div>Loris and Associates, Inc. 100 Superior Plaza Way, Suite 220 Superior, Colorado 80027 303.444.2073 www.LorisandAssociates.com</div></div>	<div><div>LORSON RANCH</div><div>THE LANDHUIS COMPANY 212 N. WASATCH, SUITE 301 COLORADO SPRINGS, CO 80903 PHONE: 719-636-3200</div></div>	<div><div><div>CORE</div>ENGINEERING GROUP</div><div>212 N. WAHSATCH AVE., SUITE 206 COLORADO SPRINGS, CO 80903 PH: 719.570.1100 FAX: 719.570.1106 CONTACT: RICHARD L. SCHINDLER, P.E. EMAIL: RichS@ceg1.com</div></div>	As Constructed		LORSON BRIDGE PRESTRESSED CONCRETE I (SHEET 2)			Project No./Code	
File Name:		Date:	Comments	Init.				No Revisions:		-			-	
Horiz. Scale: Vert. Scale: As Noted								Revised:		Designer:	TDB	Structure	-	
Unit Information Unit Leader Initials								Void:		Detailler:	JWJ	Numbers	-	
										Sheet Subset:		Subset Sheets:		

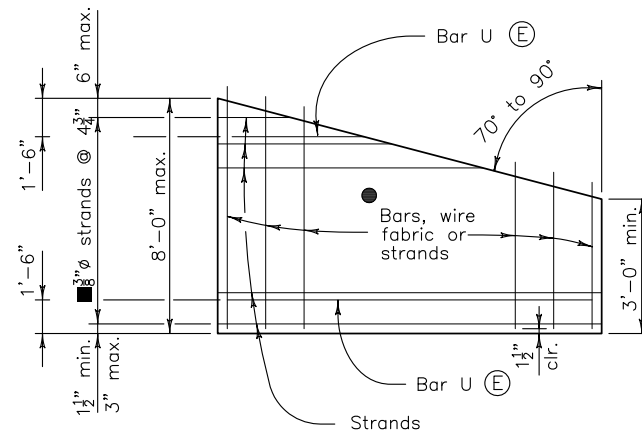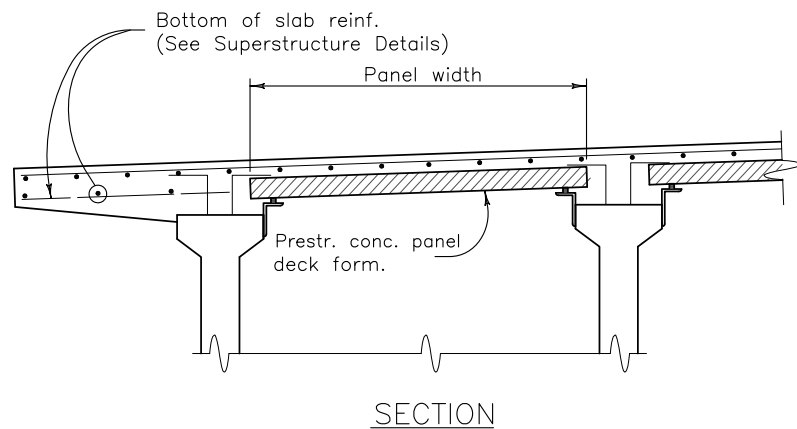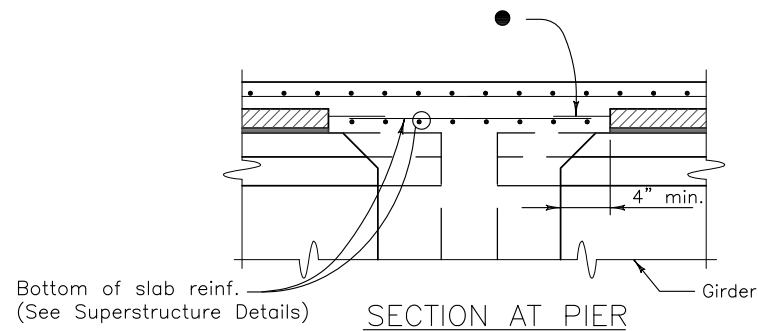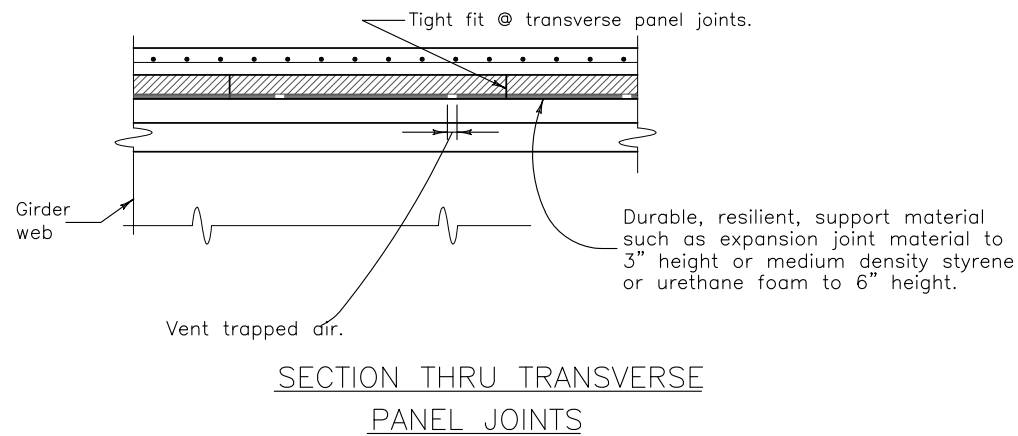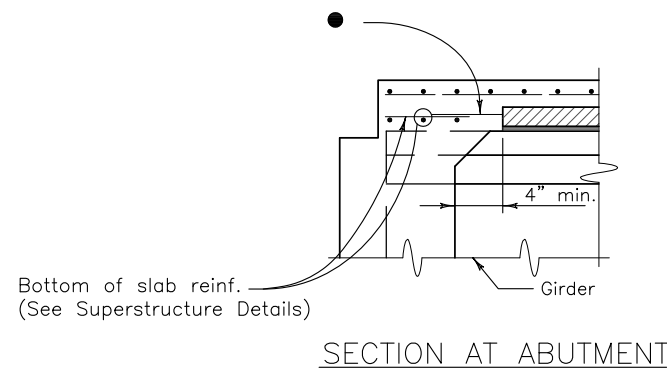

PLAN - SKEWS 70° TO 90°
OPTIONAL END PANEL

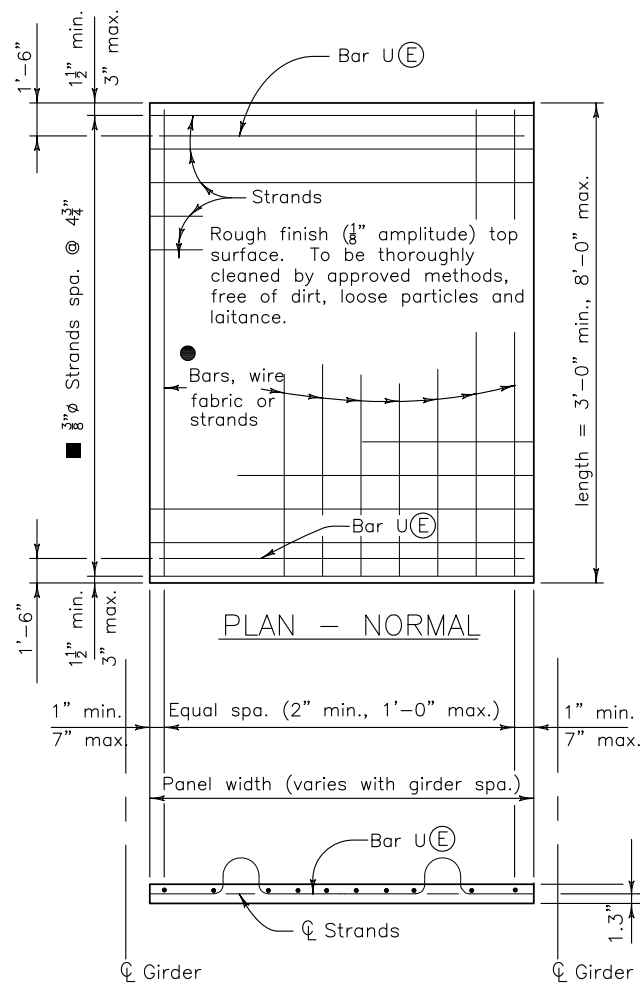

PRESTRESSED PANEL DETAILS

Notes:

Sawing of panels is acceptable in areas where projecting reinforcement is not required. It is desirable to have the prestressing strands project from the panels as long as the projecting strands do not interfere with other bridge components.

- Reinforcing perpendicular to strands may be deformed reinf. bars, welded wire fabric, or welded deformed bar mats, and shall be placed directly above the strands. Minimum area of reinforcing perpendicular to strands shall be 0.11 sq. in. per ft. Tensioned or untensioned strands may also be used. These individual bars or wires shall be no larger than .375" diameter. For location of longitudinal bar extensions, see sheet 2 of 2.

- May be reduced to 3/8" strands at 9 1/2" when the panel width is less than 5'-7" and the design span is less than 7'-7".

The longitudinal reinforcing steel in the cast-in-place portion of the deck may rest directly on the panels as necessary to obtain clearances at the top of deck, unless otherwise noted.

(E) denotes epoxy coated reinforcing.


The tolerance on strand placement shall not exceed $\pm 1/4$ ".

The tolerance on panel thickness shall not exceed $\pm 1/4$ ".

Concentrated construction loads shall not exceed 500 lb for 3" panels, 700 lb for 3.5" panels, nor 1100 lb for 4" panels unless the load is distributed to less than 117 psf.


Total loads applied to any panel during construction shall not exceed 117 psf.

Bottom flexural cracks, sags greater than .5", or cambers greater than .5" will be considered evidence of mishandling, overloading, or exceeding allowable tolerances, and may be cause for rejecting panels at the Engineer's discretion.

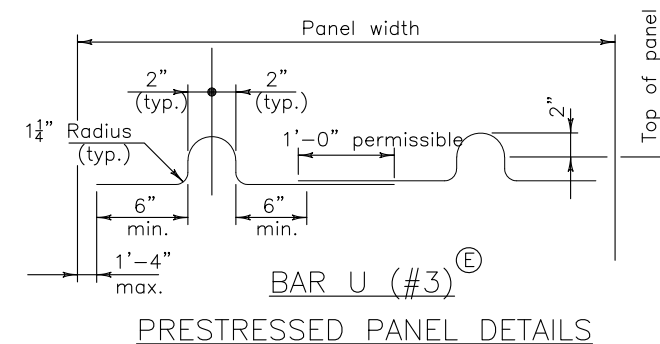

Print Date:		<div><div></div><div></div><div></div><div></div><div></div></div>	Sheet Revisions			<div><div></div><div>Loris and Associates, Inc. 100 Superior Plaza Way, Suite 220 Superior, Colorado 80027 303.444.2073 www.LorisandAssociates.com</div></div>	<div><div>LORSON RANCH</div><div>THE LANDLUB COMPANY 212 N. WASATCH, SUITE 301 COLORADO SPRINGS, CO 80903 PHONE: 719-635-8200</div></div>	<div><div>CORE ENGINEERING GROUP</div><div>212 N. WAHSATCH AVE., SUITE 206 COLORADO SPRINGS, CO 80903 PH: 719.570.1100 FAX: 719.570.1106 CONTACT: RICHARD L. SCHINDLER, P.E. EMAIL: RichS@ceg1.com</div></div>	As Constructed		LORSON BRIDGE PRECAST PANEL DECK FORM (SHEET 1)			Project No./Code	
File Name:			Date:	Comments	Init.				No Revisions:		-				
Horiz. Scale: Vert. Scale: As Noted									Revised:		Designer:	TDB	Structure		-
Unit Information Unit Leader Initials									Void:		Detailer:	JWJ	Numbers		
											Sheet Subset:		Subset Sheets:		Sheet Number B20

C:\7.2 Clients\369 - Lorson Bridge\50 DWG\16136 (B20-B21) Pre-cast Deck Form.dwg Sep 26, 2017 - 4:16pm

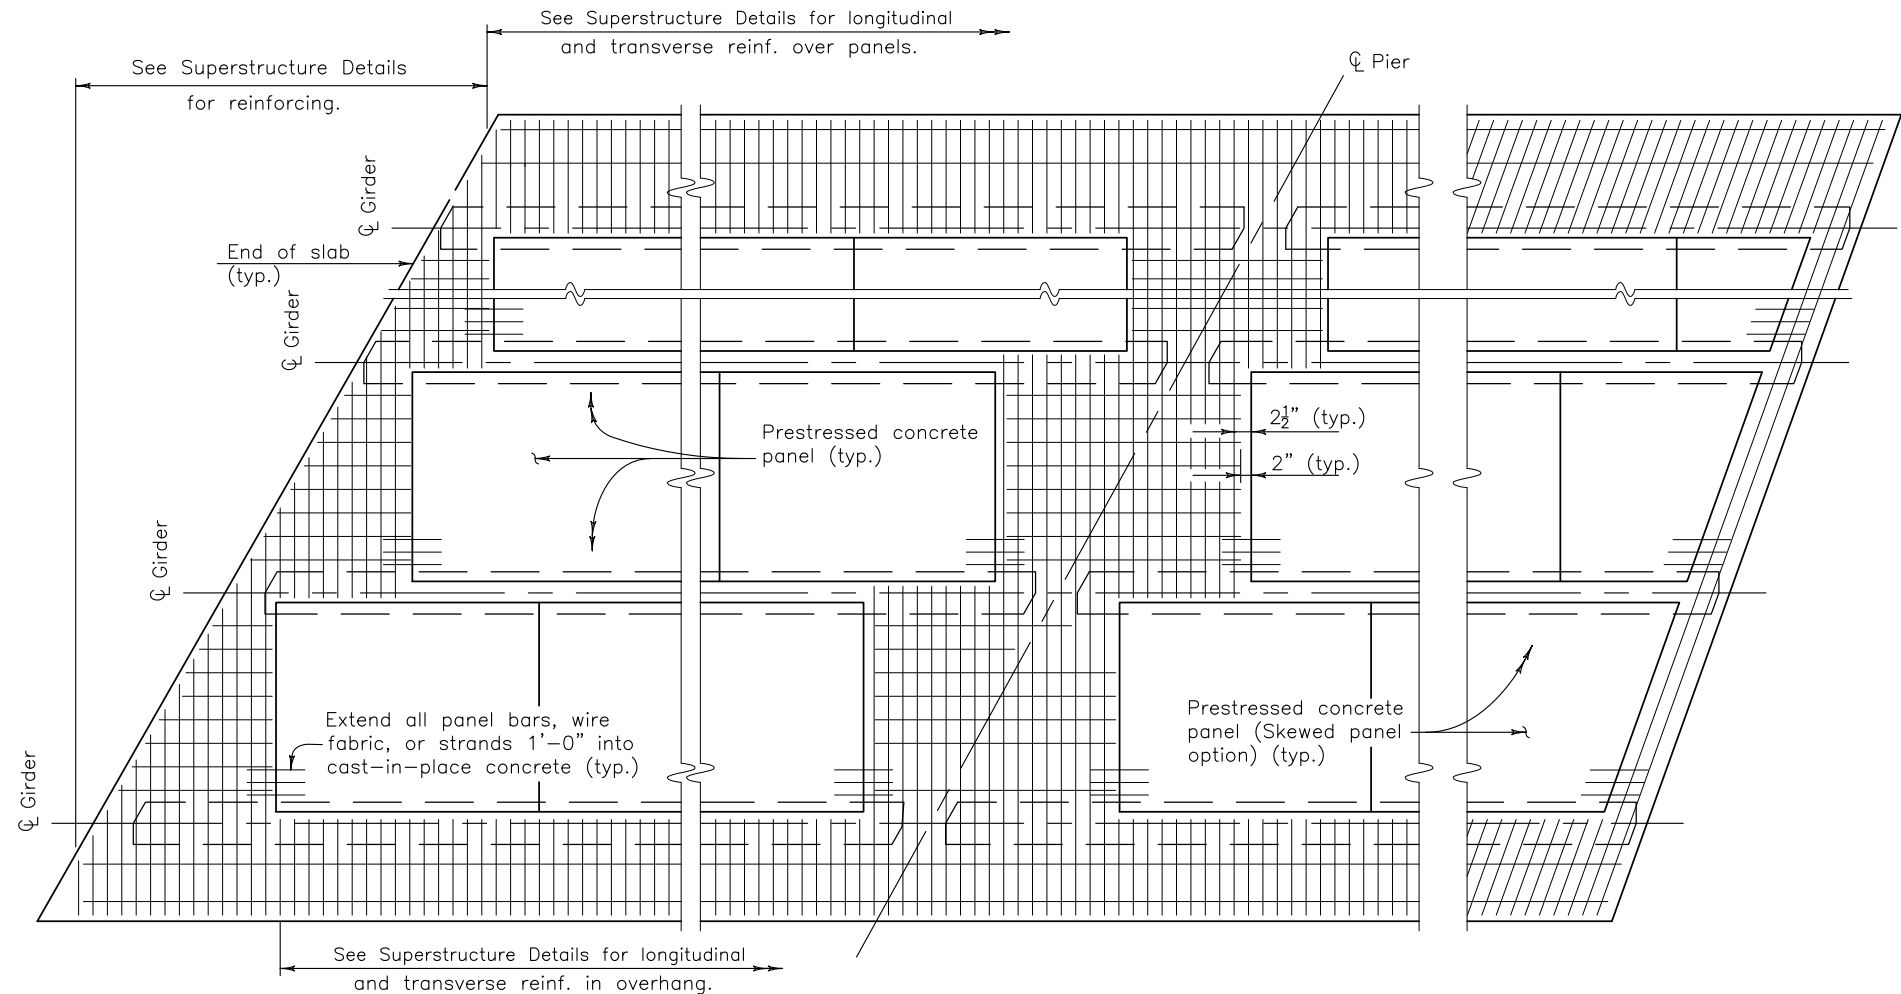


END OF SLAB
RECTANGULAR PANEL OPTION AND
SKEWS LESS THAN 70°

CONTINUOUS SLAB
OVER PIER

END OF SLAB
SKEWED PANEL OPTION FOR
SKEWS 70° TO 90°


Rectangular panel option shall be used for skews less than 70°.

PART PLAN

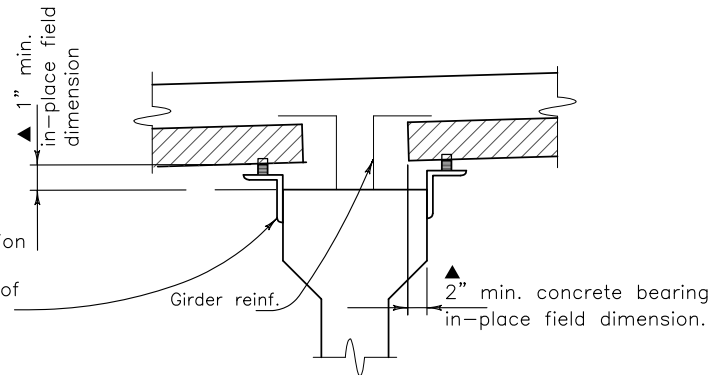

The angle and resilient material are shown for illustration and show only one potential method of support. The Contractor is responsible for the selection and design of the panel support and attachment to the girder. Support details shall be shown on the shop plans. Alternate methods for support may be used, provided they are shown on the shop plans and approved by the Engineer.

SUPPORT DETAIL

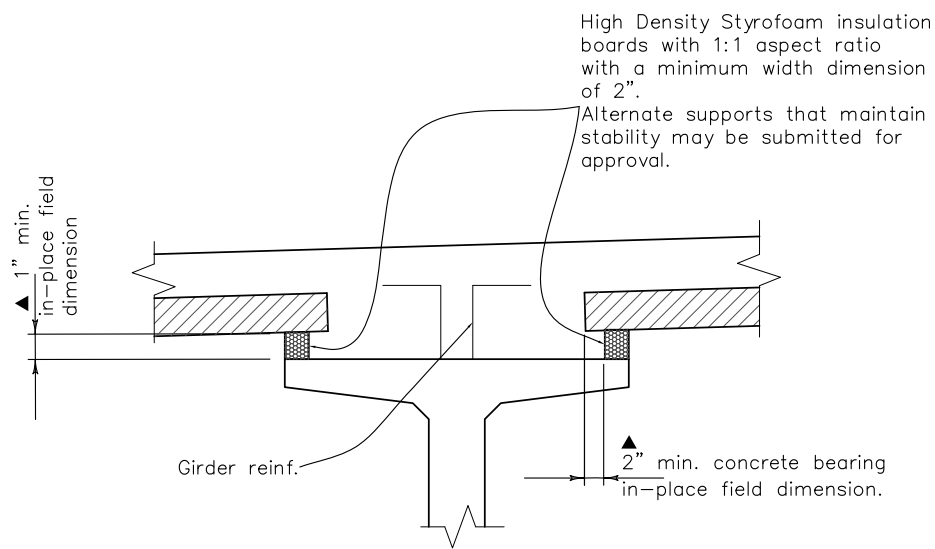

ALTERNATE SUPPORT DETAIL

NOTES:
Composite total slab designed for HS 25-44 and Alternate Military Loading.

All concrete shall be Class PS with release strength $f'_{ci} = 4500$ psi and minimum 28 day strength $f'_c = 6000$ psi. The strength shall be at least 5000 psi at the time of the deck pour.

Use $\frac{3}{8}$ " \emptyset low relaxation strands meeting the requirements of ASTM A416 grade 270. Jacking force per strand (F_j) shall be at least 17.2 kips. Final force per strand (F_f) is estimated to be 14.2 kips.

Installation of Bar U (#3) is mandatory. All four Bar U (#3) loops shall be used simultaneously for lifting the panels. Alternate methods may be used, for lifting, provided they are shown on the shop plans and approved by the Engineer.

Care must be taken to ensure proper cleaning of construction debris and consolidation of concrete mortar under the edges of the panels. It is also important that adequate space (Δ min. 1" x 2") is provided for the concrete to fill the space under the panel as the slab concrete is placed. Panel lengths and width shall be determined by the Contractor and shown on the shop plans.

The Contractor is responsible for the stability of the panels on the girders. Erected panels shall be uniformly supported along the length of the panel. The Contractor is responsible for meeting the total slab thickness shown on the Superstructure Details.





All planes of reinforcing steel shown in the superstructure details are required for areas not formed with precast panels.

**PRELIMINARY
NOT FOR CONSTRUCTION**

Print Date:		<div><div></div><div></div><div></div><div></div></div>	Sheet Revisions			<div><div></div><div>Loris and Associates, Inc.</div><div>100 Superior Plaza Way, Suite 220 Superior, Colorado 80027</div><div>303.444.2073</div><div>www.LorisandAssociates.com</div></div>	<div><div></div><div>LORSON RANCH</div><div>THE LANDHUIS COMPANY 212 N. WASATCH, SUITE 201 COLORADO SPRINGS, CO 80903 PHONE: 719-636-3200</div></div>	<div><div></div><div>CORE ENGINEERING GROUP</div><div>212 N. WASATCH AVE., SUITE 206 COLORADO SPRINGS, CO 80903 PH: 719.570.1100 FAX: 719.570.1106 CONTACT: RICHARD L. SCHINDLER, P.E. EMAIL: RichS@ceg1.com</div></div>	As Constructed		LORSON BRIDGE PRECAST PANEL DECK FORM (SHEET 2)				Project No./Code		
File Name:			Date:	Comments	Init.				No Revisions:		-				-		
Horiz. Scale:			Vert. Scale:	As Noted						Revised:		Designer:	TDB	Structure		-	
Unit Information			Unit Leader Initials							Void:		Detailer:	JWJ	Numbers		Sheet Number B21	
												Sheet Subset:		Subset Sheets:			



**PRELIMINARY
NOT FOR CONSTRUCTION**

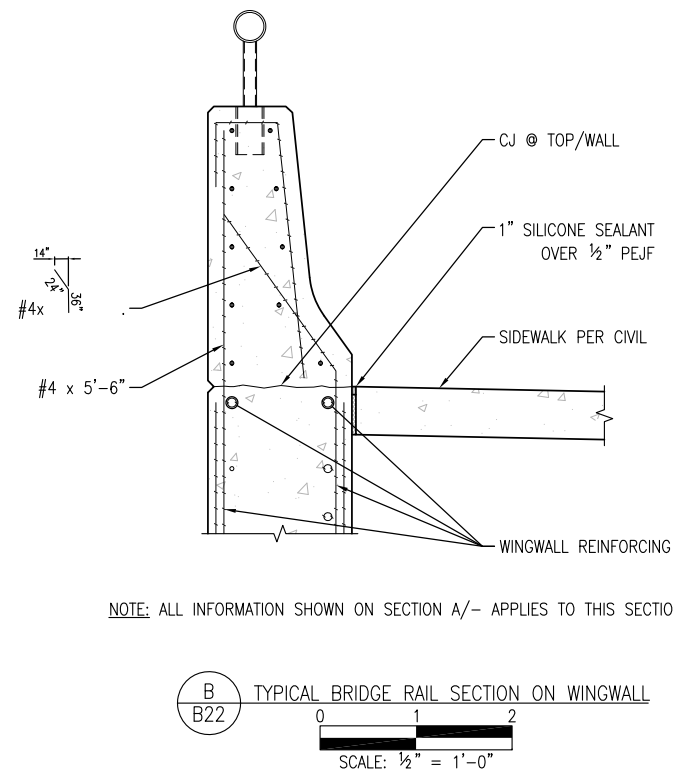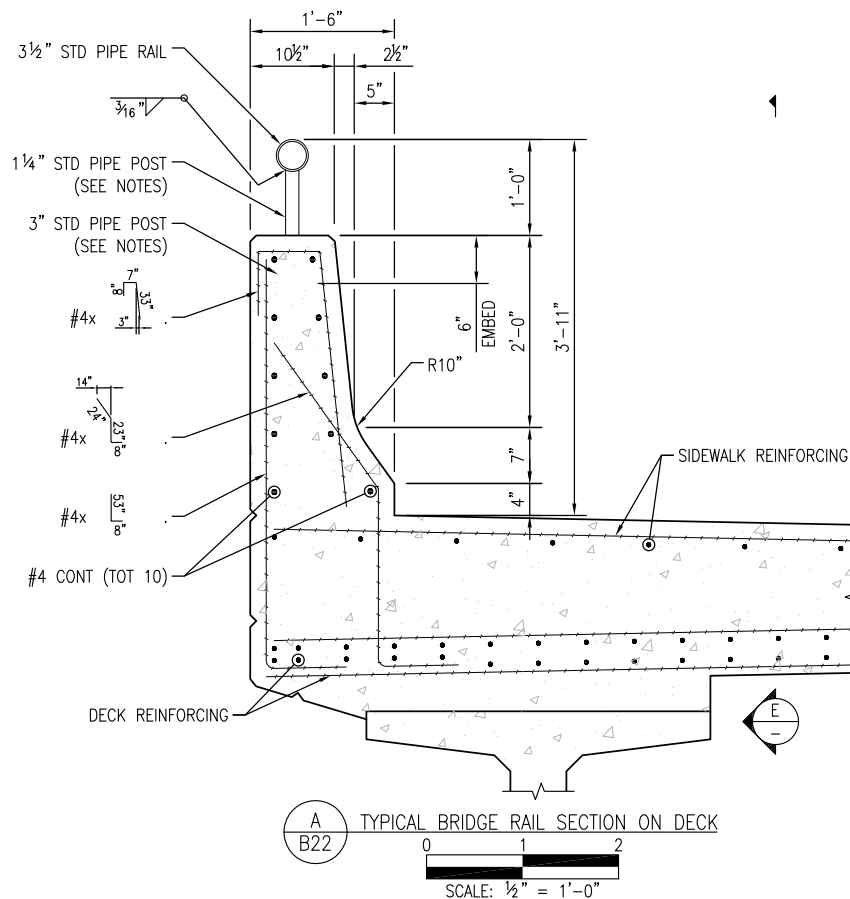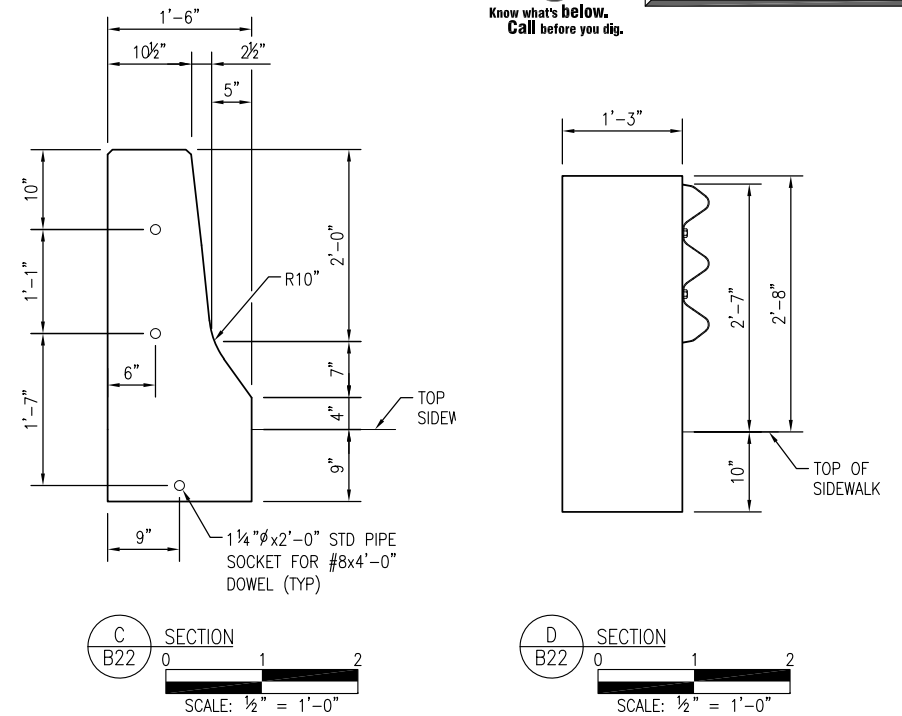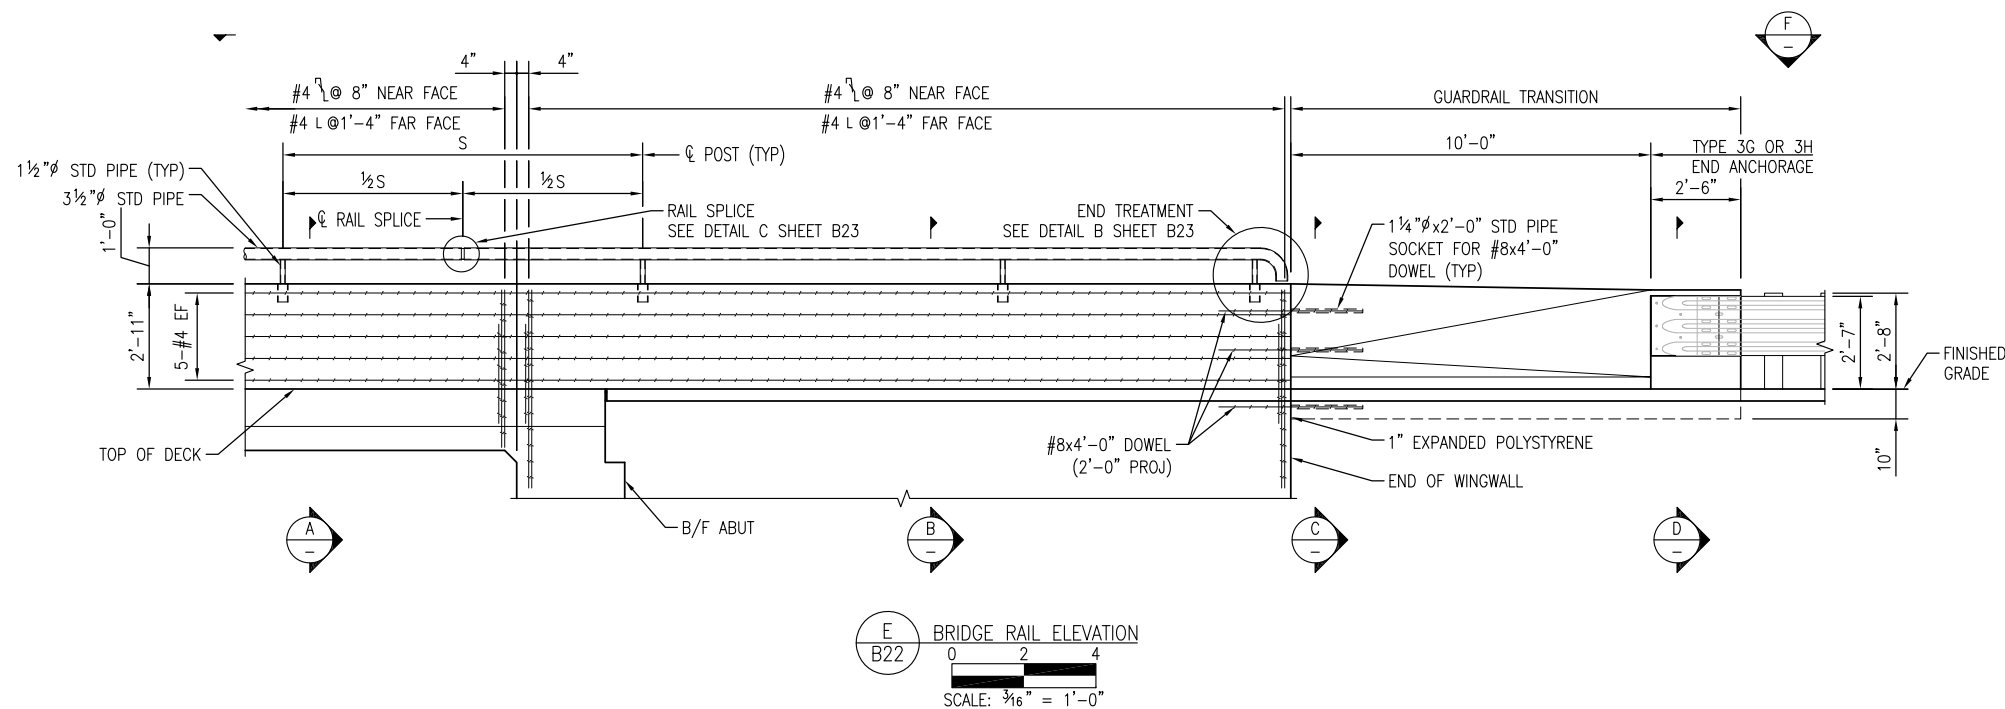

NOTE: ALL INFORMATION SHOWN ON SECTION A/- APPLIES TO THIS SECTION, UNO.


- NOTES:

1. FOR DETAILS OF GUARDRAIL TYPE 3 AND END ANCHORAGE, SEE CDOT STD PLAN NOS. M-606-1 AND M-606-13. SEE DRAWING B23 FOR LOCATIONS.
2. RAIL SHALL BE CONTINUOUS OVER NOT LESS THAN TWO POSTS. MAXIMUM SPLICE SPACING SHALL BE 20'-0". NO WELD BUTT SPLICES WILL BE ALLOWED IN THE RAIL LOCATIONS.
3. FOR POST SPACING, SEE DRAWING B3.
4. GROUT POSTS INTO SLEEVES WITH APPROVED NON-SHRINK GROUT.
5. BACKFILL ABUTMENT AND WINGWALLS BEFORE BARRIER IS PLACED.
6. ALL BRIDGE RAIL CONCRETE SHALL BE CLASS D
7. LONGITUDINAL REINFORCEMENT SHALL STOP AT ALL EXPANSION JOINTS.
8. BRIDGE RAIL SHALL BE CONSTRUCTED PLUMB
9. CONCRETE AND REINFORCING STEEL SHALL CONFORM TO THE REQUIREMENTS OF SECTIONS 601 AND 602, RESPECTIVELY.
10. THE SURFACE OF THE RAIL SHALL BE TESTED WITH A 10 FOOT STRAIGHT EDGE LAID ALONG THE SURFACE IN THE LONGITUDINAL DIRECTION. DEVIATION OF THE CONCRETE SURFACE FROM THE STRAIGHT EDGE SHALL BE LESS THAN $\frac{1}{4}$ " PLUS ALLOWANCE FOR THE ROADWAY HORIZONTAL AND VERTICAL CLEARANCE, IF ANY.
11. STEEL ELEMENTS SHALL CONFORM TO THE REQUIREMENTS OF 509.
12. WELDING SHALL BE IN ACCORDANCE WITH AWS D1.1
13. ALL PIPE SHALL BE ASTM A-53, GRADE B.
14. ALL RAILING STEEL SHALL BE PAINTED AFTER FABRICATION IN ACCORDANCE WITH SECTION 509 OF THE STANDARD SPECIFICATIONS. COLOR SHALL BE SELECTED BY THE OWNER.
15. PIPE SLEEVES SHALL BE GALVANIZED IN ACCORDANCE WITH SECTION 509.
16. POSTS SHALL BE PERPENDICULAR TO THE LONGITUDINAL ROADWAY GRADE.
17. PRIOR TO FABRICATION OF THIS ITEM, THREE SETS OF WORKING DRAWINGS WHICH COMPLY WITH THE REQUIREMENTS OF SECTION 105, SHALL BE SUBMITTED TO THE ENGINEER, FOR INFORMATION ONLY.
18. FOR END TREATMENT AND RAIL SPLICE DETAILS, SEE DRAWING B23.


Print Date:		<div><div></div><div></div><div></div><div></div><div></div></div>	Sheet Revisions			<div><div></div><div></div><div></div></div> <div>Loris and Associates, Inc. 100 Superior Plaza Way, Suite 220 Superior, Colorado 80027 303.444.2073 www.LorisandAssociates.com</div>	<div><div></div><div></div><div></div></div> <div>LORSON RANCH</div> <div>THE LANDHUB COMPANY 212 N. WASATCH, SUITE 301 COLORADO SPRINGS, CO 80903 PHONE: 719-635-3200</div>	<div><div></div><div></div><div></div></div> <div>CORE ENGINEERING GROUP</div> <div>212 N. WAHSATCH AVE., SUITE 206 COLORADO SPRINGS, CO 80903 PH: 719-570-1100 FAX: 719-570-1106 CONTACT: RICHARD L. SCHINDLER, P.E. EMAIL: RichS@ceg1.com</div>	As Constructed		LORSON BRIDGE BRIDGE RAIL TYPE 7 (SPECIAL) (SHEET 1)				Project No./Code	
File Name:			No Revisions:						-							
Horiz. Scale: Vert. Scale: As Noted			Revised:		Designer: TDB				Structure		-					
Unit Information Unit Leader Initials			Void:		Detailer: TDB				Numbers							
					Sheet Subset:				Subset Sheets:		Sheet Number B22					

C:\7.2 Clients\369 - Lorson Bridge\50 DWG\16136 (B22-B23) Bridge Rail Type 7 (Special).dwg Sep 26, 2017 - 4:16pm


PRELIMINARY
NOT FOR CONSTRUCTION

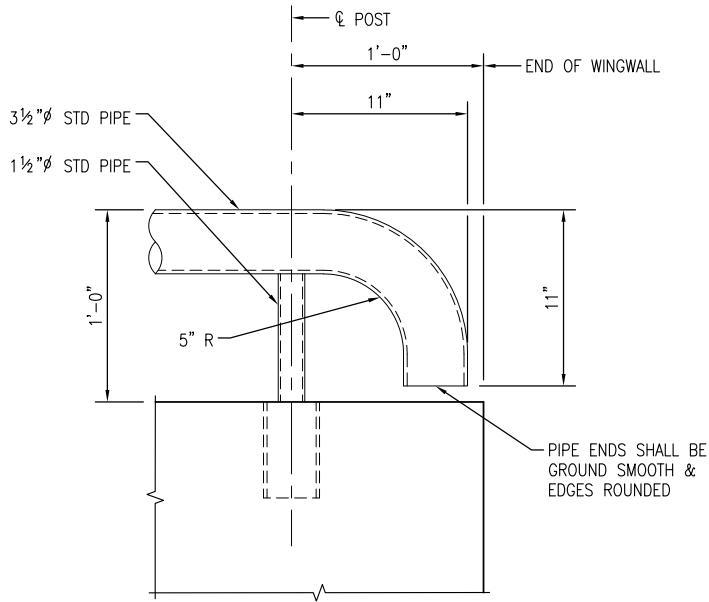

A
B22 TYPICAL END TREATMENT ON DECK
0 1/2 1
SCALE: 1" = 1'-0"

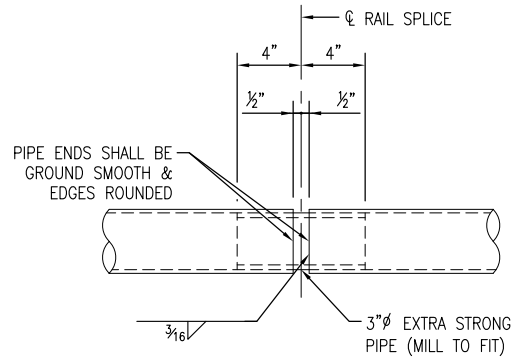

B
B22 RAIL SPLICE
0 1/2 1
SCALE: 1" = 1'-0"

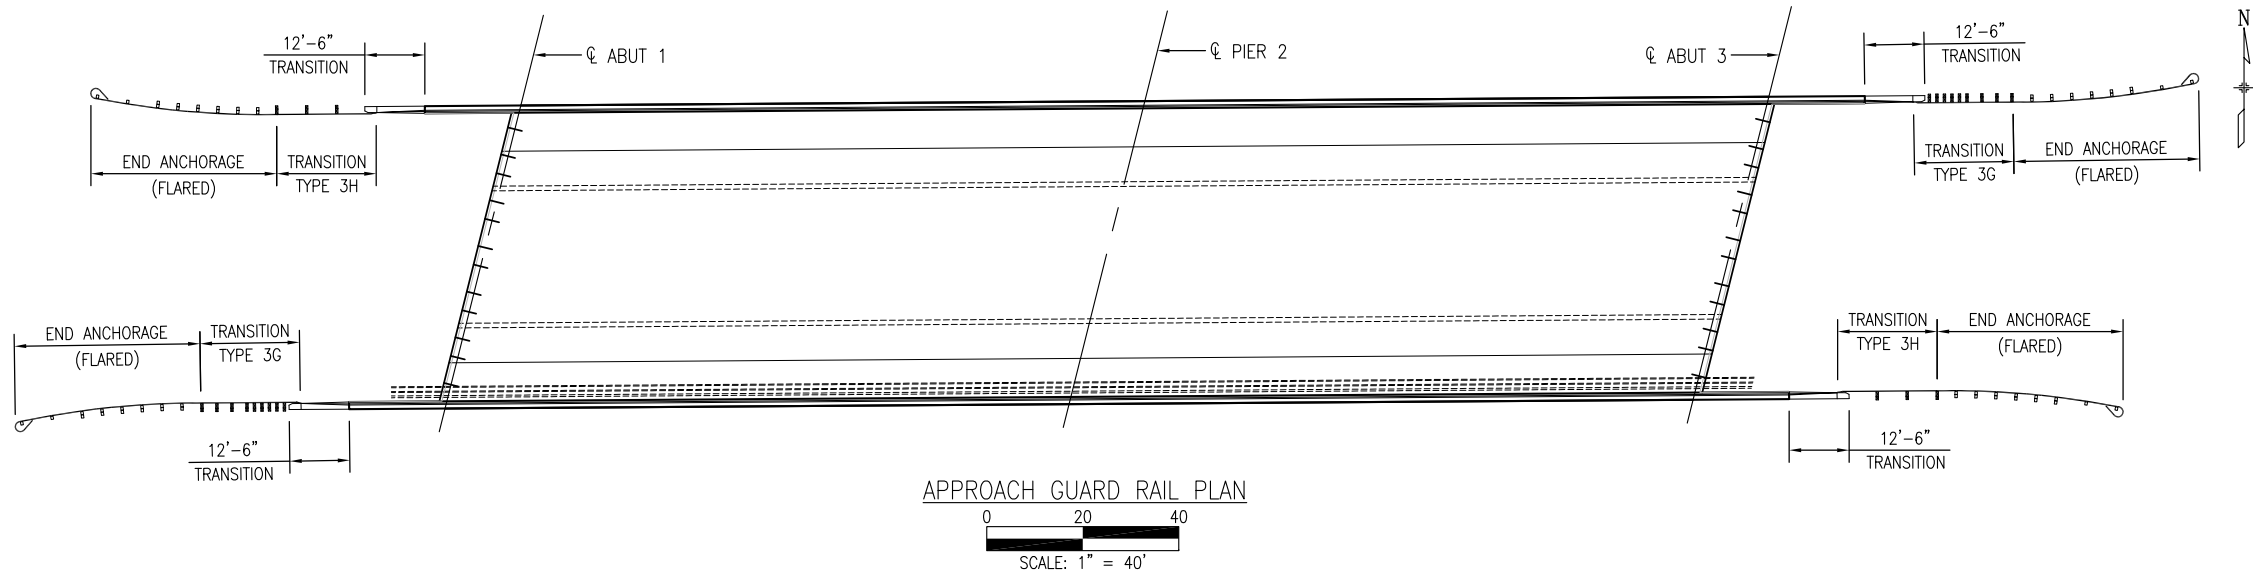

APPROACH GUARD RAIL PLAN
0 20 40
SCALE: 1" = 40'

Print Date:	
File Name:	
Horiz. Scale:	Vert. Scale: As Noted
Unit Information	Unit Leader Initials

Sheet Revisions		
Date:	Comments	Init.

Loris and Associates, Inc.
100 Superior Plaza Way,
Suite 220
Superior, Colorado 80027
303.444.2073
www.LorisandAssociates.com

LORSON RANCH
THE LANDHUIS COMPANY
212 N. WASATCH, SUITE 501
COLORADO SPRINGS, CO 80903
PHONE: 719-635-3200

CORE ENGINEERING GROUP
212 N. WASATCH AVE., SUITE 206
COLORADO SPRINGS, CO 80903
PH: 719-570-1100
FAX: 719-570-1106
CONTACT: RICHARD L. SCHINDLER, P.E.
EMAIL: RichS@ceg1.com

As Constructed
No Revisions:
Revised:
Void:

LORSON BRIDGE BRIDGE RAIL TYPE 7 (SPECIAL) (SHEET 2)			
Designer:	TDB	Structure	
Detailer:	TDB	Numbers	
Sheet Subset:		Subset Sheets:	

Project No./Code
-
-
Sheet Number B23

C:\72 Clients\369 - Lorson Bridge\50 DWG\16136 (B24) Deck Elevations.dwg Sep 26, 2017 - 4:16pm

<table><tr><td>CDOT</td><td>CDOT</td><td>CDOT</td><td>CCDOTT</td><td>State of Colorado</td><td>CDOT</td><td>CDOT</td><td>CDOT</td><td>CCDOTT</td><td colspan="3"></td></tr><tr><td>C</td><td>C T</td><td>CD OT</td><td>DO</td><td>Department of Transportation</td><td>C</td><td>C T</td><td>CD OT</td><td>DO</td><td colspan="3"></td></tr><tr><td>C</td><td>C T</td><td>CD OT</td><td>DO</td><td>Staff Bridge Design</td><td>C</td><td>C T</td><td>CD OT</td><td>DO</td><td colspan="3"></td></tr><tr><td>CDOT</td><td>CDOT</td><td>CDOT</td><td>DO</td><td>English Output</td><td>CDOT</td><td>CDOT</td><td>CDOT</td><td>DO</td><td colspan="3"></td></tr></table>												CDOT	CDOT	CDOT	CCDOTT	State of Colorado	CDOT	CDOT	CDOT	CCDOTT				C	C T	CD OT	DO	Department of Transportation	C	C T	CD OT	DO				C	C T	CD OT	DO	Staff Bridge Design	C	C T	CD OT	DO				CDOT	CDOT	CDOT	DO	English Output	CDOT	CDOT	CDOT	DO				<table><tr><td>BENT LINE :</td><td colspan="3">INTERSECTION POINT</td><td>:</td><td colspan="2">FROM LAYOUT LINE :</td><td colspan="2">BENT LINE</td><td>:</td><td colspan="2">GIRDER LINE</td><td>ROADWAY</td></tr><tr><td>DESCRIPTION :</td><td colspan="3"></td><td>:</td><td>OFFSET</td><td>ORDINATE</td><td>:</td><td>LENGTH FROM</td><td>:</td><td>SKREW</td><td>:</td><td>LENGTH FROM</td><td>CROSS-</td></tr><tr><td>:</td><td>STATION</td><td>OFFSET</td><td>ELEVATION</td><td>:</td><td>X</td><td>Y</td><td>:</td><td>Y-AXIS</td><td>:</td><td>D M S</td><td>:</td><td>REF LINE</td><td>SLOPE</td></tr></table>												BENT LINE :	INTERSECTION POINT			:	FROM LAYOUT LINE :		BENT LINE		:	GIRDER LINE		ROADWAY	DESCRIPTION :				:	OFFSET	ORDINATE	:	LENGTH FROM	:	SKREW	:	LENGTH FROM	CROSS-	:	STATION	OFFSET	ELEVATION	:	X	Y	:	Y-AXIS	:	D M S	:	REF LINE	SLOPE
CDOT	CDOT	CDOT	CCDOTT	State of Colorado	CDOT	CDOT	CDOT	CCDOTT																																																																																																								
C	C T	CD OT	DO	Department of Transportation	C	C T	CD OT	DO																																																																																																								
C	C T	CD OT	DO	Staff Bridge Design	C	C T	CD OT	DO																																																																																																								
CDOT	CDOT	CDOT	DO	English Output	CDOT	CDOT	CDOT	DO																																																																																																								
BENT LINE :	INTERSECTION POINT			:	FROM LAYOUT LINE :		BENT LINE		:	GIRDER LINE		ROADWAY																																																																																																				
DESCRIPTION :				:	OFFSET	ORDINATE	:	LENGTH FROM	:	SKREW	:	LENGTH FROM	CROSS-																																																																																																			
:	STATION	OFFSET	ELEVATION	:	X	Y	:	Y-AXIS	:	D M S	:	REF LINE	SLOPE																																																																																																			
STRUCTURE ID: Lorson				BRIDGE GEOMETRY (WIN2.1.0e)				17/09/05 13:13				PAGE 1																																																																																																				
DESCRIPTION				Units: feet; Project: ; Subaccount: ; Designer: J. Johnson; Detailer: J. Johnson; Location: Colo. Springs; Lorson Blvd. over Jimmy Camp Creek Lorson Ranch Colorado Springs, CO																																																																																																												
HORIZONTAL ALIGNMENT DATA																																																																																																																
HORIZONTAL TANGENT																																																																																																																
VERTICAL ALIGNMENT DATA																																																																																																																
ELEVATION		ELEVATION		STATION		ELEVATION		ELEVATION		PERCENT																																																																																																						
AT PI		AT GRADE				AT GRADE		AT PI		GRADE																																																																																																						
5709.1200		5709.1200		PI		41+71.6400				-0.750000																																																																																																						
										-0.750000																																																																																																						
TABLE OF ROADWAY CROSS-SLOPES (SUPERELEVATION: E= -NC-)																																																																																																																
STATION		SLOPE LEFT		SLOPE RIGHT		VC LENGTH																																																																																																										
(ON TANGENT)		-0.0200		-0.0200		75.00 (MAX)																																																																																																										
OFFSET PROFILE CONTROL TO PIVOT POINT = 0.0200 FEET RIGHT																																																																																																																
LIMITS OF VALID ELEVATION AND CROSS-SLOPE DATA																																																																																																																
* UNLIMITED *				* UNLIMITED *				BEGIN		END																																																																																																						
LAYOUT LINE DATA																																																																																																																
LAYOUT LINE DEFINED TO BE COINCIDENT WITH HORIZONTAL CONTROL																																																																																																																
LAYOUT LINE INTERSECTS REF LINE AT				HCL STA		OFFSET		X		Y																																																																																																						
				41+73.1900		0.00000000		0.0000		0.0000																																																																																																						
DEAD LOAD DEFLECTION DATA																																																																																																																
DEFLECTIONS AT TENTH POINTS FROM FITTED CURVE																																																																																																																
0.0		0.1		0.2		0.3		0.4		0.5		0.6		0.7																																																																																																		

C:\72 Clients\369 - Lorson\ Bridge\50 DWG\16136 (B24) Deck Elevations.dwg Sep 26, 2017 - 4:16pm

GIRDER 1											GIRDER 3										
PARALLEL TO HORIZONTAL CONTROL											PARALLEL TO HORIZONTAL CONTROL										
BENT LINE	STATION	OFFSET	ELEVATION	ELEV+DL	X	Y	BENT LNTH	SKEW	GIRDER LNTH	CRS-SLP	BENT LINE	STATION	OFFSET	ELEVATION	ELEV+DL	X	Y	BENT LNTH	SKEW	GIRDER LNTH	CRS-SLP
BF ABUT 1	41+78.9795	-28.5000	5708.4950		-28.5000	5.7895	-29.4296	14 26 22.00	-1.5489	-0.020000	BF ABUT 1	41+74.0872	-9.5000	5708.9116		-9.5000	0.8972	-9.8099	14 26 22.00	-1.5489	-0.020000
CL ABUT 1	41+80.5285	-28.5000	5708.4833	708.4833	-28.5000	7.3385	-29.4296	14 26 22.00	0.0000	-0.020000	CL ABUT 1	41+75.6362	-9.5000	5708.9000	708.9000	-9.5000	2.4462	-9.8099	14 26 22.00	0.0000	-0.020000
F-1	41+93.6317	-28.5000	5708.3851	708.4459	-28.5000	20.4417			13.1033	-0.020000	F-1	41+88.7394	-9.5000	5708.8018	708.8626	-9.5000	15.5494			13.1033	-0.020000
F-2	42+06.7350	-28.5000	5708.2868	708.4017	-28.5000	33.5450			26.2065	-0.020000	F-2	42+01.8427	-9.5000	5708.7035	708.8184	-9.5000	28.6527			26.2065	-0.020000
F-3	42+19.8383	-28.5000	5708.1885	708.3462	-28.5000	46.6483			39.3098	-0.020000	F-3	42+14.9459	-9.5000	5708.6052	708.7629	-9.5000	41.7559			39.3098	-0.020000
F-4	42+32.9415	-28.5000	5708.0902	708.2754	-28.5000	59.7515			52.4130	-0.020000	F-4	42+28.0492	-9.5000	5708.5069	708.6921	-9.5000	54.8592			52.4130	-0.020000
F-5	42+46.0448	-28.5000	5707.9920	708.1866	-28.5000	72.8548			65.5163	-0.020000	F-5	42+41.1525	-9.5000	5708.4087	708.6033	-9.5000	67.9625			65.5163	-0.020000
F-6	42+59.1480	-28.5000	5707.8937	708.0788	-28.5000	85.9580			78.6196	-0.020000	F-6	42+54.2557	-9.5000	5708.3104	708.4955	-9.5000	81.0657			78.6196	-0.020000
F-7	42+72.2513	-28.5000	5707.7954	707.9531	-28.5000	99.0613			91.7228	-0.020000	F-7	42+67.3590	-9.5000	5708.2121	708.3698	-9.5000	94.1690			91.7228	-0.020000
F-8	42+85.3546	-28.5000	5707.6971	707.8120	-28.5000	112.1646			104.8261	-0.020000	F-8	42+80.4623	-9.5000	5708.1138	708.2287	-9.5000	107.2723			104.8261	-0.020000
F-9	42+98.4578	-28.5000	5707.5989	707.6597	-28.5000	125.2678			117.9294	-0.020000	F-9	42+93.5655	-9.5000	5708.0156	708.0764	-9.5000	120.3755			117.9294	-0.020000
BK BRG P2	43+09.4959	-28.5000	5707.5161	707.5260	-28.5000	136.3059	-29.4296	14 26 22.00	128.9674	-0.020000	BK BRG P2	43+04.6035	-9.5000	5707.9328	707.9426	-9.5000	131.4135	-9.8099	14 26 22.00	128.9674	-0.020000
CL PIER 2	43+10.5285	-28.5000	5707.5083	707.5133	-28.5000	137.3385	-29.4296	14 26 22.00	130.0000	-0.020000	CL PIER 2	43+05.6362	-9.5000	5707.9250	707.9300	-9.5000	132.4462	-9.8099	14 26 22.00	130.0000	-0.020000
AH BRG P2	43+11.5611	-28.5000	5707.5006	707.5006	-28.5000	138.3711	-29.4296	14 26 22.00	131.0326	-0.020000	AH BRG P2	43+06.6688	-9.5000	5707.9173	707.9173	-9.5000	133.4788	-9.8099	14 26 22.00	131.0326	-0.020000
F-1	43+24.6127	-28.5000	5707.4027	707.4636	-28.5000	151.4227			144.0842	-0.020000	F-1	43+19.7204	-9.5000	5707.8194	707.8802	-9.5000	146.5304			144.0842	-0.020000
F-2	43+37.6644	-28.5000	5707.3048	707.4197	-28.5000	164.4744			157.1359	-0.020000	F-2	43+32.7720	-9.5000	5707.7215	707.8364	-9.5000	159.5820			157.1359	-0.020000
F-3	43+50.7160	-28.5000	5707.2069	707.3646	-28.5000	177.5260			170.1875	-0.020000	F-3	43+45.8237	-9.5000	5707.6236	707.7813	-9.5000	172.6337			170.1875	-0.020000
F-4	43+63.7676	-28.5000	5707.1090	707.2942	-28.5000	190.5776			183.2391	-0.020000	F-4	43+58.8753	-9.5000	5707.5257	707.7109	-9.5000	185.6853			183.2391	-0.020000
F-5	43+76.8192	-28.5000	5707.0112	707.2058	-28.5000	203.6292			196.2908	-0.020000	F-5	43+71.9269	-9.5000	5707.4278	707.6225	-9.5000	198.7369			196.2908	-0.020000
F-6	43+89.8709	-28.5000	5706.9133	707.0984	-28.5000	216.6809			209.3424	-0.020000	F-6	43+84.9786	-9.5000	5707.3300	707.5151	-9.5000	211.7886			209.3424	-0.020000
F-7	44+02.9225	-28.5000	5706.8154	706.9730	-28.5000	229.7325			222.3940	-0.020000	F-7	43+98.0302	-9.5000	5707.2321	707.3897	-9.5000	224.8402			222.3940	-0.020000
F-8	44+15.9741	-28.5000	5706.7175	706.8324	-28.5000	242.7841			235.4457	-0.020000	F-8	44+11.0818	-9.5000	5707.1342	707.2491	-9.5000	237.8918			235.4457	-0.020000
F-9	44+29.0258	-28.5000	5706.6196	706.6805	-28.5000	255.8358			248.4973	-0.020000	F-9	44+24.1335	-9.5000	5707.0363	707.0971	-9.5000	250.9435			248.4973	-0.020000
CL ABUT 3	44+40.5285	-28.5000	5706.5333	706.5408	-28.5000	267.3385	-29.4296	14 26 22.00	260.0000	-0.020000	CL ABUT 3	44+35.6362	-9.5000	5706.9500	706.9575	-9.5000	262.4462	-9.8099	14 26 22.00	260.0000	-0.020000
BF ABUT 3	44+42.0774	-28.5000	5706.5217	706.5217	-28.5000	268.8874	-29.4296	14 26 22.00	261.5489	-0.020000	BF ABUT 3	44+37.1851	-9.5000	5706.9384	706.9384	-9.5000	263.9951	-9.8099	14 26 22.00	261.5489	-0.020000
GIRDER 2											GIRDER 4										
PARALLEL TO HORIZONTAL CONTROL											PARALLEL TO HORIZONTAL CONTROL										
BENT LINE	STATION	OFFSET	ELEVATION	ELEV+DL	X	Y	BENT LNTH	SKEW	GIRDER LNTH	CRS-SLP	BENT LINE	STATION	OFFSET	ELEVATION	ELEV+DL	X	Y	BENT LNTH	SKEW	GIRDER LNTH	CRS-SLP
BF ABUT 1	41+76.5334	-19.0000	5708.7033		-19.0000	3.3434	-19.6198	14 26 22.00	-1.5489	-0.020000	BF ABUT 1	41+71.6411	0.0000	5709.1200		0.0000	-1.5489	0.0000	14 26 22.00	-1.5489	
CL ABUT 1	41+78.0823	-19.0000	5708.6917	708.6917	-19.0000	4.8923	-19.6198	14 26 22.00	0.0000	-0.020000	CL ABUT 1	41+73.1900	0.0000	5709.1084	709.1084	0.0000	0.0000	0.0000	14 26 22.00	0.0000	
F-1	41+91.1856	-19.0000	5708.5934	708.6543	-19.0000	17.9956			13.1033	-0.020000	F-1	41+86.2933	0.0000	5709.0101	709.0709	0.0000	13.1033			13.1033	
F-2	42+04.2888	-19.0000	5708.4951	708.6100	-19.0000	31.0988			26.2065	-0.020000	F-2	41+99.3965	0.0000	5708.9118	709.0267	0.0000	26.2065			26.	

C:\72 Clients\369 - Lorson\16136 - Lorson Bridge\50 DWG\16136 (B24) Deck Elevations.dwg Sep 26, 2017 - 4:16pm

GIRDER 5										GIRDER 7											
PARALLEL TO HORIZONTAL CONTROL										PARALLEL TO HORIZONTAL CONTROL											
BENT LINE	STATION	OFFSET	ELEVATION	ELEV+DL	X	Y	BENT LNTH	SKEW	GIRDER LNTH	CRS-SLP	BENT LINE	STATION	OFFSET	ELEVATION	ELEV+DL	X	Y	BENT LNTH	SKEW	GIRDER LNTH	CRS-SLP
BF ABUT 1	41+69.1949	9.5000	5708.9483		9.5000	-3.9951	9.8099	14 26 22.00	-1.5489	-0.020000	BF ABUT 1	41+64.3026	28.5000	5708.6050		28.5000	-8.8874	29.4296	14 26 22.00	-1.5489	-0.020000
CL ABUT 1	41+70.7438	9.5000	5708.9367	708.9367	9.5000	-2.4462	9.8099	14 26 22.00	0.0000	-0.020000	CL ABUT 1	41+65.8515	28.5000	5708.5934	708.5934	28.5000	-7.3385	29.4296	14 26 22.00	0.0000	-0.020000
F-1	41+83.8471	9.5000	5708.8384	708.8993	9.5000	10.6571			13.1033	-0.020000	F-1	41+78.9548	28.5000	5708.4951	708.5560	28.5000	5.7648			13.1033	-0.020000
F-2	41+96.9504	9.5000	5708.7402	708.8551	9.5000	23.7604			26.2065	-0.020000	F-2	41+92.0580	28.5000	5708.3969	708.5118	28.5000	18.8680			26.2065	-0.020000
F-3	42+10.0536	9.5000	5708.6419	708.7995	9.5000	36.8636			39.3098	-0.020000	F-3	42+05.1613	28.5000	5708.2986	708.4562	28.5000	31.9713			39.3098	-0.020000
F-4	42+23.1569	9.5000	5708.5436	708.7288	9.5000	49.9669			52.4130	-0.020000	F-4	42+18.2646	28.5000	5708.2003	708.3855	28.5000	45.0746			52.4130	-0.020000
F-5	42+36.2602	9.5000	5708.4453	708.6400	9.5000	63.0702			65.5163	-0.020000	F-5	42+31.3678	28.5000	5708.1020	708.2967	28.5000	58.1778			65.5163	-0.020000
F-6	42+49.3634	9.5000	5708.3471	708.5322	9.5000	76.1734			78.6196	-0.020000	F-6	42+44.4711	28.5000	5708.0038	708.1889	28.5000	71.2811			78.6196	-0.020000
F-7	42+62.4667	9.5000	5708.2488	708.4065	9.5000	89.2767			91.7228	-0.020000	F-7	42+57.5744	28.5000	5707.9055	708.0631	28.5000	84.3844			91.7228	-0.020000
F-8	42+75.5699	9.5000	5708.1505	708.2654	9.5000	102.3799			104.8261	-0.020000	F-8	42+70.6776	28.5000	5707.8072	707.9221	28.5000	97.4876			104.8261	-0.020000
F-9	42+88.6732	9.5000	5708.0523	708.1131	9.5000	115.4832			117.9294	-0.020000	F-9	42+83.7809	28.5000	5707.7089	707.7698	28.5000	110.5909			117.9294	-0.020000
BK BRG P2	42+99.7112	9.5000	5707.9695	707.9793	9.5000	126.5212	9.8099	14 26 22.00	128.9674	-0.020000	BK BRG P2	42+94.8189	28.5000	5707.6262	707.6360	28.5000	121.6289	29.4296	14 26 22.00	128.9674	-0.020000
CL PIER 2	43+00.7438	9.5000	5707.9617	707.9667	9.5000	127.5538	9.8099	14 26 22.00	130.0000	-0.020000	CL PIER 2	42+95.8515	28.5000	5707.6184	707.6234	28.5000	122.6615	29.4296	14 26 22.00	130.0000	-0.020000
AH BRG P2	43+01.7765	9.5000	5707.9540	707.9540	9.5000	128.5865	9.8099	14 26 22.00	131.0326	-0.020000	AH BRG P2	42+96.8841	28.5000	5707.6107	707.6107	28.5000	123.6941	29.4296	14 26 22.00	131.0326	-0.020000
F-1	43+14.8281	9.5000	5707.8561	707.9169	9.5000	141.6381			144.0842	-0.020000	F-1	43+09.9358	28.5000	5707.5128	707.5736	28.5000	136.7458			144.0842	-0.020000
F-2	43+27.8797	9.5000	5707.7582	707.8731	9.5000	154.6897			157.1359	-0.020000	F-2	43+22.9874	28.5000	5707.4149	707.5298	28.5000	149.7974			157.1359	-0.020000
F-3	43+40.9314	9.5000	5707.6603	707.8180	9.5000	167.7414			170.1875	-0.020000	F-3	43+36.0390	28.5000	5707.3170	707.4747	28.5000	162.8490			170.1875	-0.020000
F-4	43+53.9830	9.5000	5707.5624	707.7476	9.5000	180.7930			183.2391	-0.020000	F-4	43+49.0907	28.5000	5707.2191	707.4043	28.5000	175.9007			183.2391	-0.020000
F-5	43+67.0346	9.5000	5707.4645	707.6592	9.5000	193.8446			196.2908	-0.020000	F-5	43+62.1423	28.5000	5707.1212	707.3158	28.5000	188.9523			196.2908	-0.020000
F-6	43+80.0862	9.5000	5707.3667	707.5518	9.5000	206.8962			209.3424	-0.020000	F-6	43+75.1939	28.5000	5707.0233	707.2085	28.5000	202.0039			209.3424	-0.020000
F-7	43+93.1379	9.5000	5707.2688	707.4264	9.5000	219.9479			222.3940	-0.020000	F-7	43+88.2456	28.5000	5706.9255	707.0831	28.5000	215.0556			222.3940	-0.020000
F-8	44+06.1895	9.5000	5707.1709	707.2858	9.5000	232.9995			235.4457	-0.020000	F-8	44+01.2972	28.5000	5706.8276	706.9425	28.5000	228.1072			235.4457	-0.020000
F-9	44+19.2411	9.5000	5707.0730	707.1338	9.5000	246.0511			248.4973	-0.020000	F-9	44+14.3488	28.5000	5706.7297	706.7905	28.5000	241.1588			248.4973	-0.020000
CL ABUT 3	44+30.7438	9.5000	5706.9867	706.9942	9.5000	257.5538	9.8099	14 26 22.00	260.0000	-0.020000	CL ABUT 3	44+25.8515	28.5000	5706.6434	706.6509	28.5000	252.6615	29.4296	14 26 22.00	260.0000	-0.020000
BF ABUT 3	44+32.2928	9.5000	5706.9751	706.9751	9.5000	259.1028	9.8099	14 26 22.00	261.5489	-0.020000	BF ABUT 3	44+27.4005	28.5000	5706.6318	706.6318	28.5000	254.2105	29.4296	14 26 22.00	261.5489	-0.020000
GIRDER 6										RIGHT GUTTER											
PARALLEL TO HORIZONTAL CONTROL										PARALLEL TO HORIZONTAL CONTROL											
BENT LINE	STATION	OFFSET	ELEVATION	ELEV+DL	X	Y	BENT LNTH	SKEW	GIRDER LNTH	CRS-SLP	BENT LINE	STATION	OFFSET	ELEVATION	ELEV+DL	X	Y	BENT LNTH	SKEW	GIRDER LNTH	CRS-SLP
BF ABUT 1	41+66.7488	19.0000	5708.7767		19.0000	-6.4412	19.6198	14 26 22.00	-1.5489	-0.020000	BF ABUT 1	41+65.9763	22.0000	5708.7225		22.0000	-7.2137	22.7176	14 26 22.00	-1.5489	-0.020000
CL ABUT 1	41+68.2977	19.0000	5708.7651	708.7651	19.0000	-4.8923	19.6198	14 26 22.00	0.0000	-0.020000	CL ABUT 1	41+67.5252	22.0000	5708.7109	708.7109	22.0000	-5.6648	22.7176	14 26 22.00	0.0000	-0.020000
F-1	41+81.4009	19.0000	5708.6668	708.7276	19.0000	8.2109			13.1033	-0.020000	F-1	41+80.6285	22.0000	5708.6126	708.6734	22.0000	7.4385			13.1033	-0.020000
F-2	41+94.5042	19.0000	5708.5685	708.6834	19.0000	21.3142			26.2065	-0.020000	F-2	41+93.7317	22.0000	5708.5143	708.6292	22.0000	20.5417			26.2065	-0.020000
F-3	42+07.6075	19.0000	57																		

C:\7.2 Clients\369 - Lorson\ Bridge\50 DWG\16136 (B24) Deck Elevations.dwg Sep 26, 2017 - 4:16pm

RIGHT EDGE OF DECK			PARALLEL TO HORIZONTAL CONTROL				AT FINISHED GRADE				
BENT LINE	STATION	OFFSET	ELEVATION	ELEV+DL	X	Y	BENT LNTH	SKEW	GIRDER LNTH	CRS-SLP	
BF ABUT 1	41+63.5301	31.5000	5708.5508		31.5000	-9.6599	32.5275	14 26 22.00	-1.5489	-0.020000	
CL ABUT 1	41+65.0791	31.5000	5708.5392	708.5392	31.5000	-8.1109	32.5275	14 26 22.00	0.0000	-0.020000	
F-1	41+78.1823	31.5000	5708.4409	708.5018	31.5000	4.9923			13.1033	-0.020000	
F-2	41+91.2856	31.5000	5708.3427	708.4575	31.5000	18.0956			26.2065	-0.020000	
F-3	42+04.3888	31.5000	5708.2444	708.4020	31.5000	31.1988			39.3098	-0.020000	
F-4	42+17.4921	31.5000	5708.1461	708.3312	31.5000	44.3021			52.4130	-0.020000	
F-5	42+30.5954	31.5000	5708.0478	708.2425	31.5000	57.4054			65.5163	-0.020000	
F-6	42+43.6986	31.5000	5707.9496	708.1347	31.5000	70.5086			78.6196	-0.020000	
F-7	42+56.8019	31.5000	5707.8513	708.0089	31.5000	83.6119			91.7228	-0.020000	
F-8	42+69.9052	31.5000	5707.7530	707.8679	31.5000	96.7152			104.8261	-0.020000	
F-9	42+83.0084	31.5000	5707.6547	707.7156	31.5000	109.8184			117.9294	-0.020000	
BK BRG P2	42+94.0464	31.5000	5707.5720	707.5818	31.5000	120.8564	32.5275	14 26 22.00	128.9674	-0.020000	
CL PIER 2	42+95.0791	31.5000	5707.5642	707.5692	31.5000	121.8891	32.5275	14 26 22.00	130.0000	-0.020000	
AH BRG P2	42+96.1117	31.5000	5707.5565	707.5565	31.5000	122.9217	32.5275	14 26 22.00	131.0326	-0.020000	
F-1	43+09.1633	31.5000	5707.4586	707.5194	31.5000	135.9733			144.0842	-0.020000	
F-2	43+22.2149	31.5000	5707.3607	707.4756	31.5000	149.0249			157.1359	-0.020000	
F-3	43+35.2666	31.5000	5707.2628	707.4205	31.5000	162.0766			170.1875	-0.020000	
F-4	43+48.3182	31.5000	5707.1649	707.3500	31.5000	175.1282			183.2391	-0.020000	
F-5	43+61.3698	31.5000	5707.0670	707.2616	31.5000	188.1798			196.2908	-0.020000	
F-6	43+74.4215	31.5000	5706.9691	707.1543	31.5000	201.2315			209.3424	-0.020000	
F-7	43+87.4731	31.5000	5706.8713	707.0289	31.5000	214.2831			222.3940	-0.020000	
F-8	44+00.5247	31.5000	5706.7734	706.8883	31.5000	227.3347			235.4457	-0.020000	
F-9	44+13.5764	31.5000	5706.6755	706.7363	31.5000	240.3864			248.4973	-0.020000	
CL ABUT 3	44+25.0791	31.5000	5706.5892	706.5966	31.5000	251.8891	32.5275	14 26 22.00	260.0000	-0.020000	
BF ABUT 3	44+26.6280	31.5000	5706.5776	706.5776	31.5000	253.4380	32.5275	14 26 22.00	261.5489	-0.020000	

Print Date:

File Name:

Horiz. Scale:Vert. Scale: As Noted

Unit InformationUnit Leader Initials

Sheet Revisions

Date:

Comments

Init.

Loris and Associates, Inc.

100 Superior Plaza Way,
Suite 220
Superior, Colorado 80027

303.444.2073
www.LorisandAssociates.com

LORSON RANCH

THE LANDHUIS COMPANY
212 N. WASATCH, SUITE 201
COLORADO SPRINGS, CO 80903
PHONE: 719.570.3200

CORE

ENGINEERING GROUP

212 N. WASATCH AVE., SUITE 206
COLORADO SPRINGS, CO 80903
PH: 719.570.1100
FAX: 719.570.1106
CONTACT: RICHARD L. SCHINDLER, P.E.
EMAIL: RichS@ceg1.com

As Constructed

No Revisions:

Revised:

Void:

LORSON BRIDGE
DECK ELEVATIONS
(SHEET 4)

Designer: TDB

Detailer: JWJ

Sheet Subset:

Structure Numbers

Subset Sheets:

Project No./Code

-

-

Sheet NumberB27

PRELIMINARY



NOT FOR CONSTRUCTION

dsdrice (6)

Provide date

Provide date

See separate GEC plan redlines.

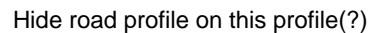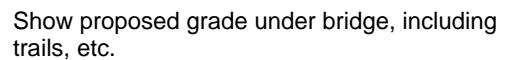




Subject: ^cC^L BACK BRG.
Page Label: 15
Lock: Unlocked
Status:
Checkmark: Unchecked
Author: AutoCAD SHX Text
Date:
Color: ☐

As Constructed
No Revisions:
Revised:


Subject: As Constructed
Page Label: 15
Lock: Unlocked
Status:
Checkmark: Unchecked
Author: AutoCAD SHX Text
Date:
Color: ☐



Subject: -
Page Label: 15
Lock: Unlocked
Status:
Checkmark: Unchecked
Author: AutoCAD SHX Text
Date:
Color: ☐

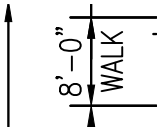

Subject: 8'-0"
Page Label: 15
Lock: Unlocked
Status:
Checkmark: Unchecked
Author: AutoCAD SHX Text
Date:
Color: ☐

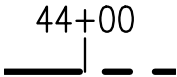

Subject: 44+00
Page Label: 15
Lock: Unlocked
Status:
Checkmark: Unchecked
Author: AutoCAD SHX Text
Date:
Color: ☐


Vert. Scale: As Noted	C
Unit Leader Initials	C
	C
	C

Subject: Unit Leader Initials
Page Label: 15
Lock: Unlocked
Status:
Checkmark: Unchecked
Author: AutoCAD SHX Text
Date:
Color: ☐

et Revisor
Comments

Subject:
Page Label: 15
Lock: Unlocked
Status:
Checkmark: Unchecked
Author: AutoCAD SHX Text
Date:
Color: ☐

Comments

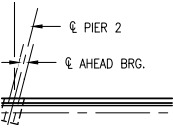


Subject:
Page Label: 15
Lock: Unlocked
Status:
Checkmark: Unchecked
Author: AutoCAD SHX Text
Date:
Color: ☐

^cC^L AHEAD BRG.

As Constr
No Revisions:
Revised:

Subject:
Page Label: 15
Lock: Unlocked
Status:
Checkmark: Unchecked
Author: AutoCAD SHX Text
Date:
Color: ☐

No Revisions:

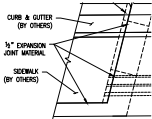

Subject:
Page Label: 15
Lock: Unlocked
Status:
Checkmark: Unchecked
Author: AutoCAD SHX Text
Date:
Color: ☐

|D" EXPANSION JOINT MATERIAL

Subject:
Page Label: 15
Lock: Unlocked
Status:
Checkmark: Unchecked
Author: AutoCAD SHX Text
Date:
Color: ☐

-

'P)


Subject:
Page Label: 15
Lock: Unlocked
Status:
Checkmark: Unchecked
Author: AutoCAD SHX Text
Date:
Color: ☐

63'-9" INT. DIAPH. (TYP)




Subject:
Page Label: 15
Lock: Unlocked
Status:
Checkmark: Unchecked
Author: AutoCAD SHX Text
Date:
Color: ☐

THE LANDHUIS COMPANY 212 N. WASATCH,
SUITE 301 COLORADO SPRINGS, CO 80903
PHONE: 719-635-3200

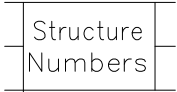

Subject:
Page Label: 15
Lock: Unlocked
Status:
Checkmark: Unchecked
Author: AutoCAD SHX Text
Date:
Color: ☐

Structure

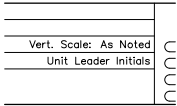


Subject:
Page Label: 15
Lock: Unlocked
Status:
Checkmark: Unchecked
Author: AutoCAD SHX Text
Date:
Color: ☐

Vert. Scale: As Noted




Subject:
Page Label: 15
Lock: Unlocked
Status:
Checkmark: Unchecked
Author: AutoCAD SHX Text
Date:
Color: ☐

A

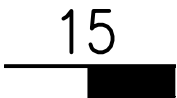


Subject:
Page Label: 15
Lock: Unlocked
Status:
Checkmark: Unchecked
Author: AutoCAD SHX Text
Date:
Color: ☐

15

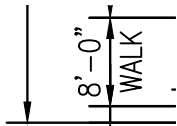


Subject:
Page Label: 15
Lock: Unlocked
Status:
Checkmark: Unchecked
Author: AutoCAD SHX Text
Date:
Color: ☐

8'-0"

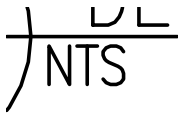


Subject: NTS
Page Label: 15
Lock: Unlocked
Status:
Checkmark: Unchecked
Author: AutoCAD SHX Text
Date:
Color: ☐

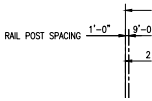


Subject: RAIL POST SPACING
Page Label: 15
Lock: Unlocked
Status:
Checkmark: Unchecked
Author: AutoCAD SHX Text
Date:
Color: ☐



Subject: ~2G3
Page Label: 15
Lock: Unlocked
Status:
Checkmark: Unchecked
Author: AutoCAD SHX Text
Date:
Color: ☐

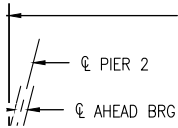


Subject: ^cC^L PIER 2
Page Label: 15
Lock: Unlocked
Status:
Checkmark: Unchecked
Author: AutoCAD SHX Text
Date:
Color: ☐

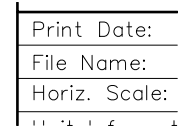

Subject: File Name:
Page Label: 15
Lock: Unlocked
Status:
Checkmark: Unchecked
Author: AutoCAD SHX Text
Date:
Color: ☐




Subject: ~2G5
Page Label: 15
Lock: Unlocked
Status:
Checkmark: Unchecked
Author: AutoCAD SHX Text
Date:
Color: ☐

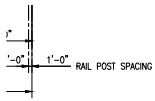

Subject:
Page Label: 15
Lock: Unlocked
Status:
Checkmark: Unchecked
Author: AutoCAD SHX Text
Date:
Color: ☐

RAIL POST SPACING

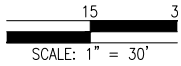


Subject:
Page Label: 15
Lock: Unlocked
Status:
Checkmark: Unchecked
Author: AutoCAD SHX Text
Date:
Color: ☐

SCALE: 1" = 30'



Subject:
Page Label: 15
Lock: Unlocked
Status:
Checkmark: Unchecked
Author: AutoCAD SHX Text
Date:
Color: ☐

~2G1

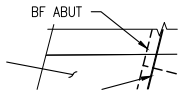

Subject:
Page Label: 15
Lock: Unlocked
Status:
Checkmark: Unchecked
Author: AutoCAD SHX Text
Date:
Color: ☐

BF ABUT




Subject:
Page Label: 15
Lock: Unlocked
Status:
Checkmark: Unchecked
Author: AutoCAD SHX Text
Date:
Color: ☐

30



Subject:
Page Label: 15
Lock: Unlocked
Status:
Checkmark: Unchecked
Author: AutoCAD SHX Text
Date:
Color: ☐


1'-6" BRIDGE RAIL

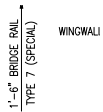


Subject: 1'-6" BRIDGE RAIL
Page Label: 15
Lock: Unlocked
Status:
Checkmark: Unchecked
Author: AutoCAD SHX Text
Date:
Color: ☐

P)

Subject: 66'-3" INT. DIAPH. (TYP)
Page Label: 15
Lock: Unlocked
Status:
Checkmark: Unchecked
Author: AutoCAD SHX Text
Date:
Color: ☐

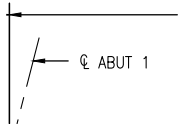

Subject: ^cC^L ABUT 1
Page Label: 15
Lock: Unlocked
Status:
Checkmark: Unchecked
Author: AutoCAD SHX Text
Date:
Color: ☐

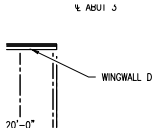


Subject: WINGWALL D
Page Label: 15
Lock: Unlocked
Status:
Checkmark: Unchecked
Author: AutoCAD SHX Text
Date:
Color: ☐

Project No./Code
-
-

Subject: Project No./Code
Page Label: 15
Lock: Unlocked
Status:
Checkmark: Unchecked
Author: AutoCAD SHX Text
Date:
Color: ☐

File Name:
Horiz. Scale:
Unit Information

Subject: Unit Information
Page Label: 15
Lock: Unlocked
Status:
Checkmark: Unchecked
Author: AutoCAD SHX Text
Date:
Color: ☐

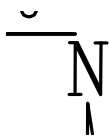

Subject:
Page Label: 15
Lock: Unlocked
Status:
Checkmark: Unchecked
Author: AutoCAD SHX Text
Date:
Color: ☐

N

0


Subject:
Page Label: 15
Lock: Unlocked
Status:
Checkmark: Unchecked
Author: AutoCAD SHX Text
Date:
Color: ☐

0



Subject:
Page Label: 15
Lock: Unlocked
Status:
Checkmark: Unchecked
Author: AutoCAD SHX Text
Date:
Color: ☐

212 N. WAHSATCH AVE., SUITE 206
COLORADO SPRINGS, CO 80903 PH:
719.570.1100 FAX: 719.570.1106 CONTACT:
RICHARD L. SCHINDLER, P.E. EMAIL:
RichS@ceg1.com

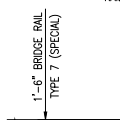

Subject:
Page Label: 15
Lock: Unlocked
Status:
Checkmark: Unchecked
Author: AutoCAD SHX Text
Date:
Color: ☐

1'-6" BRIDGE RAIL

TDB

Subject:
Page Label: 15
Lock: Unlocked
Status:
Checkmark: Unchecked
Author: AutoCAD SHX Text
Date:
Color: ☐

TDB



Subject:
Page Label: 15
Lock: Unlocked
Status:
Checkmark: Unchecked
Author: AutoCAD SHX Text
Date:
Color: ☐

~2G7

INTERMEDIATE DIMENSIONS MEASURED FROM ORDER
SEE SHEET B16 FOR UTILITY DETAILS.

LORSON BRIDGE		
CONSTRUCTION LAYOUT		
12	TDB	Structure
:	JWJ	Numbers
Subset:	Subset Sheets:	

Subject:
Page Label: 15
Lock: Unlocked
Status:
Checkmark: Unchecked
Author: AutoCAD SHX Text
Date:
Color: ☐

CONSTRUCTION LAYOUT

JWJ		
-----	--	--


Subject:
Page Label: 15
Lock: Unlocked
Status:
Checkmark: Unchecked
Author: AutoCAD SHX Text
Date:
Color: ☐

JWJ

Sheet Revisions	
:	Comments

Subject:
Page Label: 15
Lock: Unlocked
Status:
Checkmark: Unchecked
Author: AutoCAD SHX Text
Date:
Color: ☐

Sheet Revisions

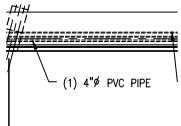

Subject:
Page Label: 15
Lock: Unlocked
Status:
Checkmark: Unchecked
Author: AutoCAD SHX Text
Date:
Color: ☐

(1) 4"~O PVC PIPE

Designer:
Detailer:
Sheet Sub

Subject:
Page Label: 15
Lock: Unlocked
Status:
Checkmark: Unchecked
Author: AutoCAD SHX Text
Date:
Color: ☐


Detailer:

B16 FOR UTILITY DETAILS.

LORSON BRIDGE
CONSTRUCTION LAYOUT

Subject:
Page Label: 15
Lock: Unlocked
Status:
Checkmark: Unchecked
Author: AutoCAD SHX Text
Date:
Color: ☐

LORSON BRIDGE

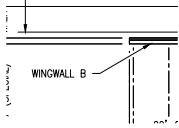


Subject:
Page Label: 15
Lock: Unlocked
Status:
Checkmark: Unchecked
Author: AutoCAD SHX Text
Date:
Color: ☐

WINGWALL B



Subject:
Page Label: 15
Lock: Unlocked
Status:
Checkmark: Unchecked
Author: AutoCAD SHX Text
Date:
Color: ☐

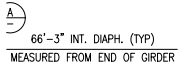


Subject:
Page Label: 15
Lock: Unlocked
Status:
Checkmark: Unchecked
Author: AutoCAD SHX Text
Date:
Color: ☐

66'-3" INT. DIAPH. (TYP)

B06

Subject:
Page Label: 15
Lock: Unlocked
Status:
Checkmark: Unchecked
Author: AutoCAD SHX Text
Date:
Color: ☐

B06

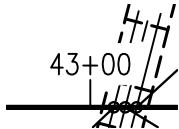


Subject:
Page Label: 15
Lock: Unlocked
Status:
Checkmark: Unchecked
Author: AutoCAD SHX Text
Date:
Color: ☐

43+00



Subject:
Page Label: 15
Lock: Unlocked
Status:
Checkmark: Unchecked
Author: AutoCAD SHX Text
Date:
Color: ☐

8'-0"

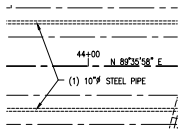


Subject:
Page Label: 15
Lock: Unlocked
Status:
Checkmark: Unchecked
Author: AutoCAD SHX Text
Date:
Color: ☐

(1) 10"~O STEEL PIPE




Subject:
Page Label: 15
Lock: Unlocked
Status:
Checkmark: Unchecked
Author: AutoCAD SHX Text
Date:
Color: ☐

www.LorisandAssociates.com

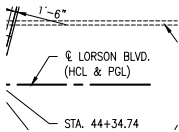

Subject:
Page Label: 15
Lock: Unlocked
Status:
Checkmark: Unchecked
Author: AutoCAD SHX Text
Date:
Color: ☐

^c^L LORSON BLVD. (HCL & PGL)

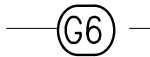

Subject:
Page Label: 15
Lock: Unlocked
Status:
Checkmark: Unchecked
Author: AutoCAD SHX Text
Date:
Color: ☐

~2G6



Subject:
Page Label: 15
Lock: Unlocked
Status:
Checkmark: Unchecked
Author: AutoCAD SHX Text
Date:
Color: ☐

Date:



Subject:
Page Label: 15
Lock: Unlocked
Status:
Checkmark: Unchecked
Author: AutoCAD SHX Text
Date:
Color: ☐

Loris and Associates, Inc.



Subject: 8'-0"
Page Label: 15
Lock: Unlocked
Status:
Checkmark: Unchecked
Author: AutoCAD SHX Text
Date:
Color: ☐

42+00

Subject: 42+00
Page Label: 15
Lock: Unlocked
Status:
Checkmark: Unchecked
Author: AutoCAD SHX Text
Date:
Color: ☐

Revised:

Subject: Revised:
Page Label: 15
Lock: Unlocked
Status:
Checkmark: Unchecked
Author: AutoCAD SHX Text
Date:
Color: ☐




Subject: PRELIMINARY NOT FOR CONSTRUCTION
Page Label: 15
Lock: Unlocked
Status:
Checkmark: Unchecked
Author: AutoCAD SHX Text
Date:
Color: ☐

Print Date:
File Name:
Horizontal Scale:

Subject: Print Date:
Page Label: 15
Lock: Unlocked
Status:
Checkmark: Unchecked
Author: AutoCAD SHX Text
Date:
Color: ☐


Structure
Numbers
Subset Sheets:

Subject: Subset Sheets:
Page Label: 15
Lock: Unlocked
Status:
Checkmark: Unchecked
Author: AutoCAD SHX Text
Date:
Color: ☐

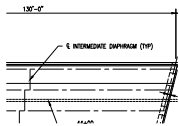

Subject:
Page Label: 15
Lock: Unlocked
Status:
Checkmark: Unchecked
Author: AutoCAD SHX Text
Date:
Color: ☐

^C^L INTERMEDIATE DIAPHRAGM (TYP)

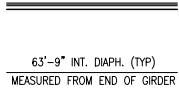

Subject:
Page Label: 15
Lock: Unlocked
Status:
Checkmark: Unchecked
Author: AutoCAD SHX Text
Date:
Color: ☐

63'-9" INT. DIAPH. (TYP)




Subject:
Page Label: 15
Lock: Unlocked
Status:
Checkmark: Unchecked
Author: AutoCAD SHX Text
Date:
Color: ☐

A




Subject:
Page Label: 15
Lock: Unlocked
Status:
Checkmark: Unchecked
Author: AutoCAD SHX Text
Date:
Color: ☐

1'-6" BRIDGE RAIL

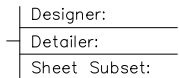


Subject:
Page Label: 15
Lock: Unlocked
Status:
Checkmark: Unchecked
Author: AutoCAD SHX Text
Date:
Color: ☐

Sheet Subset:

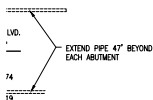


Subject:
Page Label: 15
Lock: Unlocked
Status:
Checkmark: Unchecked
Author: AutoCAD SHX Text
Date:
Color: ☐


EXTEND PIPE 47' BEYOND EACH ABUTMENT

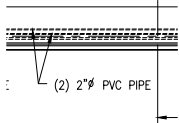


Subject: (2) 2"~O PVC PIPE
Page Label: 15
Lock: Unlocked
Status:
Checkmark: Unchecked
Author: AutoCAD SHX Text
Date:
Color: ☐

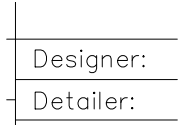


Subject: Designer:
Page Label: 15
Lock: Unlocked
Status:
Checkmark: Unchecked
Author: AutoCAD SHX Text
Date:
Color: ☐

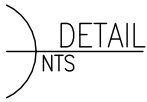

Subject: %%%u DETAIL
Page Label: 15
Lock: Unlocked
Status:
Checkmark: Unchecked
Author: AutoCAD SHX Text
Date:
Color: ☐

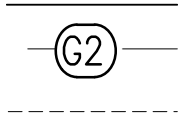


Subject: ~2G2
Page Label: 15
Lock: Unlocked
Status:
Checkmark: Unchecked
Author: AutoCAD SHX Text
Date:
Color: ☐

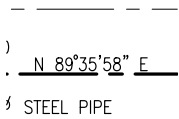

Subject: N 89~o35'58" E
Page Label: 15
Lock: Unlocked
Status:
Checkmark: Unchecked
Author: AutoCAD SHX Text
Date:
Color: ☐



Subject: ~2G4
Page Label: 15
Lock: Unlocked
Status:
Checkmark: Unchecked
Author: AutoCAD SHX Text
Date:
Color: ☐

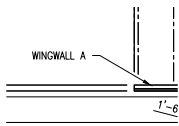


Subject:
Page Label: 15
Lock: Unlocked
Status:
Checkmark: Unchecked
Author: AutoCAD SHX Text
Date:
Color: ☐

WINGWALL A



Subject:
Page Label: 15
Lock: Unlocked
Status:
Checkmark: Unchecked
Author: AutoCAD SHX Text
Date:
Color: ☐

100 Superior Plaza Way, Suite 220 Superior, Colorado 80027

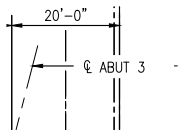


Subject:
Page Label: 15
Lock: Unlocked
Status:
Checkmark: Unchecked
Author: AutoCAD SHX Text
Date:
Color: ☐

^cC^L ABUT 3




Subject:
Page Label: 15
Lock: Unlocked
Status:
Checkmark: Unchecked
Author: AutoCAD SHX Text
Date:
Color: ☐

Void:

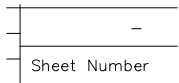

Subject:
Page Label: 15
Lock: Unlocked
Status:
Checkmark: Unchecked
Author: AutoCAD SHX Text
Date:
Color: ☐

Sheet Number

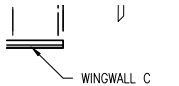


Subject:
Page Label: 15
Lock: Unlocked
Status:
Checkmark: Unchecked
Author: AutoCAD SHX Text
Date:
Color: ☐

WINGWALL C

3	Structure
J	Numbers
	Subset Sheet

Subject:
Page Label: 15
Lock: Unlocked
Status:
Checkmark: Unchecked
Author: AutoCAD SHX Text
Date:
Color: ☐

Numbers

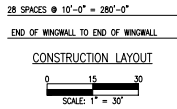

Subject:
Page Label: 15
Lock: Unlocked
Status:
Checkmark: Unchecked
Author: AutoCAD SHX Text
Date:
Color: ☐

CONSTRUCTION LAYOUT

Print Date:
File Name:
Horiz. Scale:
Unit Information:

Subject:
Page Label: 15
Lock: Unlocked
Status:
Checkmark: Unchecked
Author: AutoCAD SHX Text
Date:
Color: ☐

Horiz. Scale:

Init.

Subject:
Page Label: 15
Lock: Unlocked
Status:
Checkmark: Unchecked
Author: AutoCAD SHX Text
Date:
Color: ☐

Init.




Subject:
Page Label: 15
Lock: Unlocked
Status:
Checkmark: Unchecked
Author: AutoCAD SHX Text
Date:
Color: ☐



100 Superior Plaza Way,
Suite 220
Superior, Colorado 80027
303.444.2073
www.LorissendAssociates.co

Subject:
Page Label: 15
Lock: Unlocked
Status:
Checkmark: Unchecked
Author: AutoCAD SHX Text
Date:
Color: ☐

303.444.2073

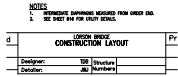


Subject:
Page Label: 15
Lock: Unlocked
Status:
Checkmark: Unchecked
Author: AutoCAD SHX Text
Date:
Color: ☐

NOTES 1. INTERMEDIATE DIAPHRAGMS
MEASURED FROM GIRDER END.
INTERMEDIATE DIAPHRAGMS MEASURED
FROM GIRDER END. 2. SEE SHEET B16 FOR
UTILITY DETAILS.SEE SHEET B16 FOR UTILITY
DETAILS.




Subject:
Page Label: 17
Lock: Unlocked
Status:
Checkmark: Unchecked
Author: AutoCAD SHX Text
Date:
Color: ☐

PRELIMINARY NOT FOR CONSTRUCTION

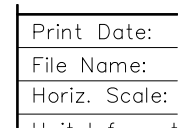


Subject:
Page Label: 17
Lock: Unlocked
Status:
Checkmark: Unchecked
Author: AutoCAD SHX Text
Date:
Color: ☐

File Name:

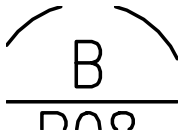


Subject:
Page Label: 17
Lock: Unlocked
Status:
Checkmark: Unchecked
Author: AutoCAD SHX Text
Date:
Color: ☐

B

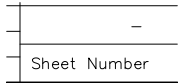


Subject:
Page Label: 17
Lock: Unlocked
Status:
Checkmark: Unchecked
Author: AutoCAD SHX Text
Date:
Color: ☐

Sheet Number

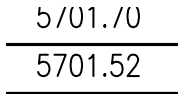

Subject:
Page Label: 17
Lock: Unlocked
Status:
Checkmark: Unchecked
Author: AutoCAD SHX Text
Date:
Color: ☐

5701.52

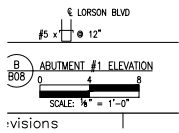

Subject:
Page Label: 17
Lock: Unlocked
Status:
Checkmark: Unchecked
Author: AutoCAD SHX Text
Date:
Color: ☐

%%u ABUTMENT #1 ELEVATION

G7

Subject:
Page Label: 17
Lock: Unlocked
Status:
Checkmark: Unchecked
Author: AutoCAD SHX Text
Date:
Color: ☐

G7




Subject:
Page Label: 17
Lock: Unlocked
Status:
Checkmark: Unchecked
Author: AutoCAD SHX Text
Date:
Color: ☐

NOTES 1. ABUTMENT SHALL BE CONCRETE CLASS D. ABUTMENT SHALL BE CONCRETE CLASS D. 2. DECK AND DIAPHRAGM SHALL BE PLACED MONOLITHICALLY. DECK AND DIAPHRAGM SHALL BE PLACED MONOLITHICALLY. 3. SEAT ELEVATIONS SHOWN ARE A^cT C^L ABUTMENT AND^c C^L GIRDER. SEAT ELEVATIONS SHOWN ARE A^cT C^L ABUTMENT AND^c C^L GIRDER. 4. FOR WINGWALL REINFORCING PROJECTING INTO ABUTMENT SEE SHEET B11. FOR WINGWALL REINFORCING PROJECTING INTO ABUTMENT SEE SHEET B11. 5. FOR SIDEWALK REINFORCING PROJECTING INTO ABUTMENT SEE SHEET B16. FOR SIDEWALK REINFORCING PROJECTING INTO ABUTMENT SEE SHEET B16. 6. FOR BRIDGE RAIL REINFORCING PROJECTING INTO ABUTMENT SEE SHEET B22. FOR BRIDGE RAIL REINFORCING PROJECTING INTO ABUTMENT SEE SHEET B22. 7. THREADED ROD SHALL BE PLACED IN |G"~O INSERTS PROVIDED IN GIRDERS. THREADED ROD SHALL BE PLACED IN |G"~O INSERTS PROVIDED IN GIRDERS. 8. PLACE STIRRUP REINFORCING PARALLEL TO^c C^L GIRDER. PLACE STIRRUP REINFORCING PARALLEL TO^c C^L GIRDER. 9. AFTER INSTALLATION OF CONDUIT, SEAL GAP BETWEEN THE CONDUIT AND THE AFTER INSTALLATION OF CONDUIT, SEAL GAP BETWEEN THE CONDUIT AND THE BLOCKOUT WITH MASTIC.

Designer:
Detailer:
Sheet Subset:

Subject:
Page Label: 17
Lock: Unlocked
Status:
Checkmark: Unchecked
Author: AutoCAD SHX Text
Date:
Color: ☐

Sheet Subset:

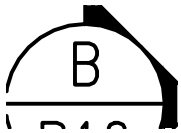

Subject:
Page Label: 17
Lock: Unlocked
Status:
Checkmark: Unchecked
Author: AutoCAD SHX Text
Date:
Color: ☐

B

As Constr
No Revisions:
Revised:

P


Subject:
Page Label: 17
Lock: Unlocked
Status:
Checkmark: Unchecked
Author: AutoCAD SHX Text
Date:
Color: ☐

No Revisions:



Subject:
Page Label: 17
Lock: Unlocked
Status:
Checkmark: Unchecked
Author: AutoCAD SHX Text
Date:
Color: ☐

A

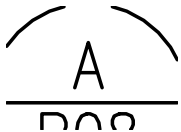

Subject:
Page Label: 17
Lock: Unlocked
Status:
Checkmark: Unchecked
Author: AutoCAD SHX Text
Date:
Color: ☐

A




Subject:
Page Label: 17
Lock: Unlocked
Status:
Checkmark: Unchecked
Author: AutoCAD SHX Text
Date:
Color: ☐

5'-9 " SLOPING34" SLOPING




Subject:
Page Label: 17
Lock: Unlocked
Status:
Checkmark: Unchecked
Author: AutoCAD SHX Text
Date:
Color: ☐

G3

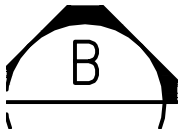

Subject:
Page Label: 17
Lock: Unlocked
Status:
Checkmark: Unchecked
Author: AutoCAD SHX Text
Date:
Color: ☐

B

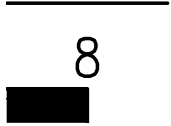


Subject:
Page Label: 17
Lock: Unlocked
Status:
Checkmark: Unchecked
Author: AutoCAD SHX Text
Date:
Color: ☐

8




Subject:
Page Label: 17
Lock: Unlocked
Status:
Checkmark: Unchecked
Author: AutoCAD SHX Text
Date:
Color: ☐

100 Superior Plaza Way, Suite 220 Superior,
Colorado 80027

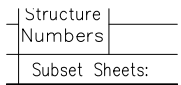

Subject:
Page Label: 17
Lock: Unlocked
Status:
Checkmark: Unchecked
Author: AutoCAD SHX Text
Date:
Color: ☐

Subset Sheets:

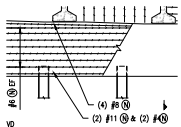


Subject:
Page Label: 17
Lock: Unlocked
Status:
Checkmark: Unchecked
Author: AutoCAD SHX Text
Date:
Color: ☐


(4) #8 ~1N



Subject:
Page Label: 17
Lock: Unlocked
Status:
Checkmark: Unchecked
Author: AutoCAD SHX Text
Date:
Color: ☐

G7

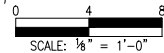Init.	Subject: Page Label: 17 Lock: Unlocked Status: Checkmark: Unchecked Author: AutoCAD SHX Text Date: Color: <input type="checkbox"/>	Init.
5/01.84 5702.05 5701.87	Subject: Page Label: 17 Lock: Unlocked Status: Checkmark: Unchecked Author: AutoCAD SHX Text Date: Color: <input type="checkbox"/>	5702.05
B08	Subject: Page Label: 17 Lock: Unlocked Status: Checkmark: Unchecked Author: AutoCAD SHX Text Date: Color: <input type="checkbox"/>	B08
Designer: Detailer: Sheet Sub	Subject: Page Label: 17 Lock: Unlocked Status: Checkmark: Unchecked Author: AutoCAD SHX Text Date: Color: <input type="checkbox"/>	Detailer:
ABUTMENT #1 PLAN  2'-0" x 12" BACK FACE	Subject: Page Label: 17 Lock: Unlocked Status: Checkmark: Unchecked Author: AutoCAD SHX Text Date: Color: <input type="checkbox"/>	SCALE: 1/8" = 1'-0"
Date:	Subject: Page Label: 17 Lock: Unlocked Status: Checkmark: Unchecked Author: AutoCAD SHX Text Date: Color: <input type="checkbox"/>	Date:

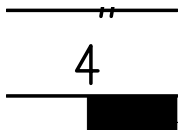

Subject: 4
Page Label: 17
Lock: Unlocked
Status:
Checkmark: Unchecked
Author: AutoCAD SHX Text
Date:
Color: ☐




Subject: 1'-6"
Page Label: 17
Lock: Unlocked
Status:
Checkmark: Unchecked
Author: AutoCAD SHX Text
Date:
Color: ☐




Subject: -
Page Label: 17
Lock: Unlocked
Status:
Checkmark: Unchecked
Author: AutoCAD SHX Text
Date:
Color: ☐



Subject: N
Page Label: 17
Lock: Unlocked
Status:
Checkmark: Unchecked
Author: AutoCAD SHX Text
Date:
Color: ☐

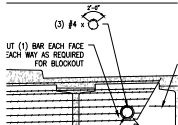

Subject: (3) #4 x
Page Label: 17
Lock: Unlocked
Status:
Checkmark: Unchecked
Author: AutoCAD SHX Text
Date:
Color: ☐

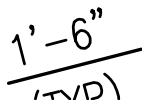


Subject: 1'-6"
Page Label: 17
Lock: Unlocked
Status:
Checkmark: Unchecked
Author: AutoCAD SHX Text
Date:
Color: ☐

G1

Subject:
Page Label: 17
Lock: Unlocked
Status:
Checkmark: Unchecked
Author: AutoCAD SHX Text
Date:
Color: ☐

G1

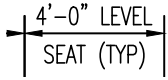

Subject:
Page Label: 17
Lock: Unlocked
Status:
Checkmark: Unchecked
Author: AutoCAD SHX Text
Date:
Color: ☐

4'-0" LEVEL


5701.43

5701.63

5701.84


Subject:
Page Label: 17
Lock: Unlocked
Status:
Checkmark: Unchecked
Author: AutoCAD SHX Text
Date:
Color: ☐

5701.63

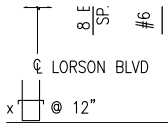

Subject:
Page Label: 17
Lock: Unlocked
Status:
Checkmark: Unchecked
Author: AutoCAD SHX Text
Date:
Color: ☐

^cC^L LORSON BLVD

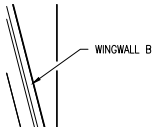


Subject:
Page Label: 17
Lock: Unlocked
Status:
Checkmark: Unchecked
Author: AutoCAD SHX Text
Date:
Color: ☐

WINGWALL B

G2

Subject:
Page Label: 17
Lock: Unlocked
Status:
Checkmark: Unchecked
Author: AutoCAD SHX Text
Date:
Color: ☐

G2

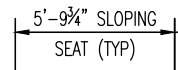

Subject:
Page Label: 17
Lock: Unlocked
Status:
Checkmark: Unchecked
Author: AutoCAD SHX Text
Date:
Color: ☐

5'-9 " SLOPING34" SLOPING

LAI LLL
GIRDER
G1

Subject:
Page Label: 17
Lock: Unlocked
Status:
Checkmark: Unchecked
Author: AutoCAD SHX Text
Date:
Color: ☐

GIRDER

G6

Subject:
Page Label: 17
Lock: Unlocked
Status:
Checkmark: Unchecked
Author: AutoCAD SHX Text
Date:
Color: ☐

G6

JWJ

Subject:
Page Label: 17
Lock: Unlocked
Status:
Checkmark: Unchecked
Author: AutoCAD SHX Text
Date:
Color: ☐

JWJ

5702.05
5701.87
5701.70

Subject:
Page Label: 17
Lock: Unlocked
Status:
Checkmark: Unchecked
Author: AutoCAD SHX Text
Date:
Color: ☐

5701.87

—

Subject:
Page Label: 17
Lock: Unlocked
Status:
Checkmark: Unchecked
Author: AutoCAD SHX Text
Date:
Color: ☐

-



Subject:
Page Label: 17
Lock: Unlocked
Status:
Checkmark: Unchecked
Author: AutoCAD SHX Text
Date:
Color: ☐

THE LANDHUIS COMPANY 212 N. WASATCH,
SUITE 301 COLORADO SPRINGS, CO 80903
PHONE: 719-635-3200

2'-0"

Subject:
Page Label: 17
Lock: Unlocked
Status:
Checkmark: Unchecked
Author: AutoCAD SHX Text
Date:
Color: ☐

2'-0"

Sheet Revisions	
	Comments

Subject:
Page Label: 17
Lock: Unlocked
Status:
Checkmark: Unchecked
Author: AutoCAD SHX Text
Date:
Color: ☐

Sheet Revisions

5 X 2'-0"

MAY

Subject:
Page Label: 17
Lock: Unlocked
Status:
Checkmark: Unchecked
Author: AutoCAD SHX Text
Date:
Color: ☐

2'-0"

G1

Subject:
Page Label: 17
Lock: Unlocked
Status:
Checkmark: Unchecked
Author: AutoCAD SHX Text
Date:
Color: ☐

G1

5/01.63

5701.84


5702.05

Subject:
Page Label: 17
Lock: Unlocked
Status:
Checkmark: Unchecked
Author: AutoCAD SHX Text
Date:
Color: ☐

5701.84



Subject:
Page Label: 17
Lock: Unlocked
Status:
Checkmark: Unchecked
Author: AutoCAD SHX Text
Date:
Color: ☐

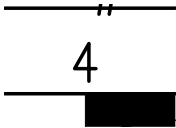

Subject:
Page Label: 17
Lock: Unlocked
Status:
Checkmark: Unchecked
Author: AutoCAD SHX Text
Date:
Color: ☐


Vert. Scale: As Noted	U
Unit Leader Initials	

Subject:
Page Label: 17
Lock: Unlocked
Status:
Checkmark: Unchecked
Author: AutoCAD SHX Text
Date:
Color: ☐


SEAT ELEVATIONS

GIRDER	ELEVATION
G1	5701.43
G2	5701.63

Subject:
Page Label: 17
Lock: Unlocked
Status:
Checkmark: Unchecked
Author: AutoCAD SHX Text
Date:
Color: ☐

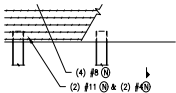

Subject:
Page Label: 17
Lock: Unlocked
Status:
Checkmark: Unchecked
Author: AutoCAD SHX Text
Date:
Color: ☐

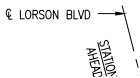

Subject:
Page Label: 17
Lock: Unlocked
Status:
Checkmark: Unchecked
Author: AutoCAD SHX Text
Date:
Color: ☐

WITH MASTIC.

LORSON BRIDGE
#1 PLAN & EL


Subject:
Page Label: 17
Lock: Unlocked
Status:
Checkmark: Unchecked
Author: AutoCAD SHX Text
Date:
Color: ☐

LORSON BRIDGE




Subject:
Page Label: 17
Lock: Unlocked
Status:
Checkmark: Unchecked
Author: AutoCAD SHX Text
Date:
Color: ☐

^cC^L GIRDER

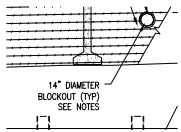


Subject:
Page Label: 17
Lock: Unlocked
Status:
Checkmark: Unchecked
Author: AutoCAD SHX Text
Date:
Color: ☐

14" DIAMETER BLOCKOUT (TYP) SEE NOTES

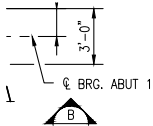


Subject:
Page Label: 17
Lock: Unlocked
Status:
Checkmark: Unchecked
Author: AutoCAD SHX Text
Date:
Color: ☐

^cC^L BRG. ABUT 1

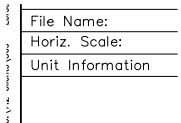

Subject:
Page Label: 17
Lock: Unlocked
Status:
Checkmark: Unchecked
Author: AutoCAD SHX Text
Date:
Color: ☐

Unit Information

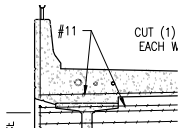


Subject:
Page Label: 17
Lock: Unlocked
Status:
Checkmark: Unchecked
Author: AutoCAD SHX Text
Date:
Color: ☐


#11

3	Structure
J	Numbers
	Subset Sheet


Subject: Numbers
Page Label: 17
Lock: Unlocked
Status:
Checkmark: Unchecked
Author: AutoCAD SHX Text
Date:
Color: ☐

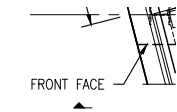

Subject: FRONT FACE
Page Label: 17
Lock: Unlocked
Status:
Checkmark: Unchecked
Author: AutoCAD SHX Text
Date:
Color: ☐

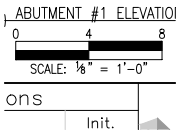


Subject: SCALE: 1/8" = 1'-0"
Page Label: 17
Lock: Unlocked
Status:
Checkmark: Unchecked
Author: AutoCAD SHX Text
Date:
Color: ☐

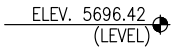


Subject: ELEV. 5696.42
Page Label: 17
Lock: Unlocked
Status:
Checkmark: Unchecked
Author: AutoCAD SHX Text
Date:
Color: ☐

G5


Subject: G5
Page Label: 17
Lock: Unlocked
Status:
Checkmark: Unchecked
Author: AutoCAD SHX Text
Date:
Color: ☐

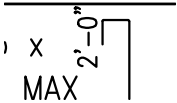


Subject: 2'-0"
Page Label: 17
Lock: Unlocked
Status:
Checkmark: Unchecked
Author: AutoCAD SHX Text
Date:
Color: ☐

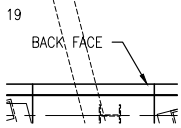


Subject:
Page Label: 17
Lock: Unlocked
Status:
Checkmark: Unchecked
Author: AutoCAD SHX Text
Date:
Color: ☐

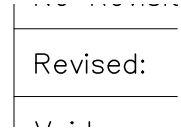


Subject:
Page Label: 17
Lock: Unlocked
Status:
Checkmark: Unchecked
Author: AutoCAD SHX Text
Date:
Color: ☐

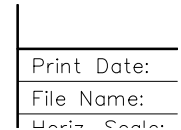


Subject:
Page Label: 17
Lock: Unlocked
Status:
Checkmark: Unchecked
Author: AutoCAD SHX Text
Date:
Color: ☐

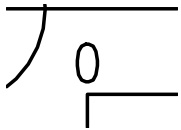

Subject:
Page Label: 17
Lock: Unlocked
Status:
Checkmark: Unchecked
Author: AutoCAD SHX Text
Date:
Color: ☐

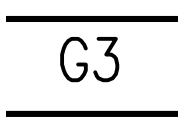

Subject:
Page Label: 17
Lock: Unlocked
Status:
Checkmark: Unchecked
Author: AutoCAD SHX Text
Date:
Color: ☐

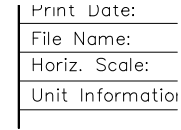

Subject:
Page Label: 17
Lock: Unlocked
Status:
Checkmark: Unchecked
Author: AutoCAD SHX Text
Date:
Color: ☐




Subject: Loris and Associates, Inc.
Page Label: 17
Lock: Unlocked
Status:
Checkmark: Unchecked
Author: AutoCAD SHX Text
Date:
Color: ☐



Subject: 1'-6"
Page Label: 17
Lock: Unlocked
Status:
Checkmark: Unchecked
Author: AutoCAD SHX Text
Date:
Color: ☐



Subject: 303.444.2073
Page Label: 17
Lock: Unlocked
Status:
Checkmark: Unchecked
Author: AutoCAD SHX Text
Date:
Color: ☐

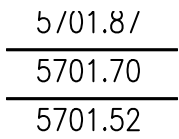

Subject: 5701.70
Page Label: 17
Lock: Unlocked
Status:
Checkmark: Unchecked
Author: AutoCAD SHX Text
Date:
Color: ☐



Subject: G6
Page Label: 17
Lock: Unlocked
Status:
Checkmark: Unchecked
Author: AutoCAD SHX Text
Date:
Color: ☐




Subject: -
Page Label: 17
Lock: Unlocked
Status:
Checkmark: Unchecked
Author: AutoCAD SHX Text
Date:
Color: ☐

Designer:
Detailer:

Subject:
Page Label: 17
Lock: Unlocked
Status:
Checkmark: Unchecked
Author: AutoCAD SHX Text
Date:
Color: ☐

Designer:

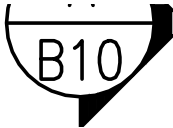

Subject:
Page Label: 17
Lock: Unlocked
Status:
Checkmark: Unchecked
Author: AutoCAD SHX Text
Date:
Color: ☐

B10

et Revision
Comments


Subject:
Page Label: 17
Lock: Unlocked
Status:
Checkmark: Unchecked
Author: AutoCAD SHX Text
Date:
Color: ☐

Comments

Void:

Subject:
Page Label: 17
Lock: Unlocked
Status:
Checkmark: Unchecked
Author: AutoCAD SHX Text
Date:
Color: ☐

Void:

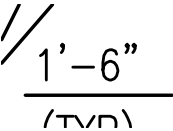

Subject:
Page Label: 17
Lock: Unlocked
Status:
Checkmark: Unchecked
Author: AutoCAD SHX Text
Date:
Color: ☐

1'-6"



Subject:
Page Label: 17
Lock: Unlocked
Status:
Checkmark: Unchecked
Author: AutoCAD SHX Text
Date:
Color: ☐

A

6. FOR BRIDGE AND RETAINING PROJECTS INTO RETAINMENT 5
7. THICKNESS SHOULD BE PLACED IN 4" P. HAVING PROVED
8. PLACE STRIP REINFORCING PARALLEL TO 1. CHECK
9. AFTER INSTALLATION OF CONCRETE, DO NOT REMOVE THE CO
BLOODOUT WITH MASTIC.


LONDON BRIDGE	
ABUTMENT #1 PLAN & ELEVATION	
Designer:	TOR Structure
Checker:	JBU (Reviewed)
Sheet:	Submittal

Subject:
Page Label: 17
Lock: Unlocked
Status:
Checkmark: Unchecked
Author: AutoCAD SHX Text
Date:
Color: ☐

ABUTMENT#1 PLAN & ELEVATION



Subject:
Page Label: 17
Lock: Unlocked
Status:
Checkmark: Unchecked
Author: AutoCAD SHX Text
Date:
Color: ☐

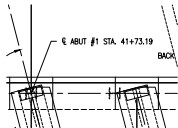


Subject:
Page Label: 17
Lock: Unlocked
Status:
Checkmark: Unchecked
Author: AutoCAD SHX Text
Date:
Color: ☐

^cC^L ABUT #1 STA. 41+73.19



Subject:
Page Label: 17
Lock: Unlocked
Status:
Checkmark: Unchecked
Author: AutoCAD SHX Text
Date:
Color: ☐

G5

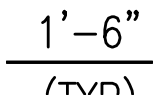


Subject:
Page Label: 17
Lock: Unlocked
Status:
Checkmark: Unchecked
Author: AutoCAD SHX Text
Date:
Color: ☐

1'-6"

CONDUIT AND THE	
Project No./Code	
-	
-	

Subject:
Page Label: 17
Lock: Unlocked
Status:
Checkmark: Unchecked
Author: AutoCAD SHX Text
Date:
Color: ☐

Project No./Code

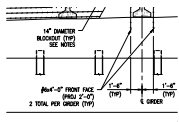


Subject:
Page Label: 17
Lock: Unlocked
Status:
Checkmark: Unchecked
Author: AutoCAD SHX Text
Date:
Color: ☐

#6x4'-0" FRONT FACE (PROJ 2'-0") 2 TOTAL
PER GIRDER (TYP)

TDB


Subject:
Page Label: 17
Lock: Unlocked
Status:
Checkmark: Unchecked
Author: AutoCAD SHX Text
Date:
Color: ☐

TDB

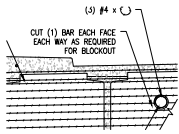

Subject:
Page Label: 17
Lock: Unlocked
Status:
Checkmark: Unchecked
Author: AutoCAD SHX Text
Date:
Color: ☐

CUT (1) BAR EACH FACE EACH WAY AS
REQUIRED FOR BLOCKOUT

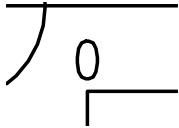


Subject:
Page Label: 17
Lock: Unlocked
Status:
Checkmark: Unchecked
Author: AutoCAD SHX Text
Date:
Color: ☐

0



Subject:
Page Label: 17
Lock: Unlocked
Status:
Checkmark: Unchecked
Author: AutoCAD SHX Text
Date:
Color: ☐

B10

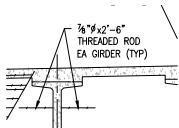

Subject:
Page Label: 17
Lock: Unlocked
Status:
Checkmark: Unchecked
Author: AutoCAD SHX Text
Date:
Color: ☐

|G"~0x2'-6" THREADED ROD EA GIRDER (TYP)

As Constructed
No Revisions:
Revised:

Subject:
Page Label: 17
Lock: Unlocked
Status:
Checkmark: Unchecked
Author: AutoCAD SHX Text
Date:
Color: ☐

As Constructed



Subject:
Page Label: 17
Lock: Unlocked
Status:
Checkmark: Unchecked
Author: AutoCAD SHX Text
Date:
Color: ☐

8

Vert. Scale: As Noted	C C C C
Unit Leader Initials	

Subject:
Page Label: 17
Lock: Unlocked
Status:
Checkmark: Unchecked
Author: AutoCAD SHX Text
Date:
Color: ☐

Unit Leader Initials




Subject:
Page Label: 17
Lock: Unlocked
Status:
Checkmark: Unchecked
Author: AutoCAD SHX Text
Date:
Color: ☐

STATION AHEAD



Subject:
Page Label: 17
Lock: Unlocked
Status:
Checkmark: Unchecked
Author: AutoCAD SHX Text
Date:
Color: ☐

G2

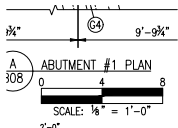

Subject:
Page Label: 17
Lock: Unlocked
Status:
Checkmark: Unchecked
Author: AutoCAD SHX Text
Date:
Color: ☐

%%u ABUTMENT #1 PLAN




Subject:
Page Label: 17
Lock: Unlocked
Status:
Checkmark: Unchecked
Author: AutoCAD SHX Text
Date:
Color: ☐

www.LorisandAssociates.com




Subject:
Page Label: 17
Lock: Unlocked
Status:
Checkmark: Unchecked
Author: AutoCAD SHX Text
Date:
Color: ☐

212 N. WAHSATCH AVE., SUITE 206
COLORADO SPRINGS, CO 80903 PH:
719.570.1100 FAX: 719.570.1106 CONTACT:
RICHARD L. SCHINDLER, P.E. EMAIL:
RichS@ceg1.com

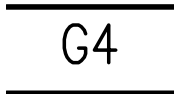


Subject:
Page Label: 17
Lock: Unlocked
Status:
Checkmark: Unchecked
Author: AutoCAD SHX Text
Date:
Color: ☐

G4

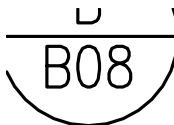

Subject:
Page Label: 17
Lock: Unlocked
Status:
Checkmark: Unchecked
Author: AutoCAD SHX Text
Date:
Color: ☐

B08

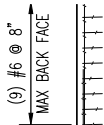

Subject:
Page Label: 17
Lock: Unlocked
Status:
Checkmark: Unchecked
Author: AutoCAD SHX Text
Date:
Color: ☐

(9) #6 @ 8"



Subject:
Page Label: 17
Lock: Unlocked
Status:
Checkmark: Unchecked
Author: AutoCAD SHX Text
Date:
Color: ☐


4'-0" LEVEL

ELEVATION
5701.43
5701.63

Subject:
Page Label: 17 5701.43
Lock: Unlocked
Status:
Checkmark: Unchecked
Author: AutoCAD SHX Text
Date:
Color: ☐

5696.42
(LEVEL)

Subject:
Page Label: 17 (LEVEL)
Lock: Unlocked
Status:
Checkmark: Unchecked
Author: AutoCAD SHX Text
Date:
Color: ☐

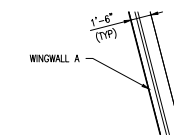


Subject:
Page Label: 17 WINGWALL A
Lock: Unlocked
Status:
Checkmark: Unchecked
Author: AutoCAD SHX Text
Date:
Color: ☐

Structure
Numbers

Subject:
Page Label: 17 Structure
Lock: Unlocked
Status:
Checkmark: Unchecked
Author: AutoCAD SHX Text
Date:
Color: ☐

ATIONS
ELEVATION
5701.43

Subject:
Page Label: 17 ELEVATION
Lock: Unlocked
Status:
Checkmark: Unchecked
Author: AutoCAD SHX Text
Date:
Color: ☐

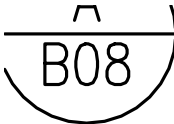

Subject:
Page Label: 17 B08
Lock: Unlocked
Status:
Checkmark: Unchecked
Author: AutoCAD SHX Text
Date:
Color: ☐



Subject:
Page Label: 17 1'-6"
Lock: Unlocked
Status:
Checkmark: Unchecked
Author: AutoCAD SHX Text
Date:
Color: ☐



Subject:
Page Label: 17 (9) #6 @ 8"
Lock: Unlocked
Status:
Checkmark: Unchecked
Author: AutoCAD SHX Text
Date:
Color: ☐