

KEYMAP

<u>LEGAL DESCRIPTION:</u> KNOWN ALL BY THESE PRESENTS:

THAT COLA LLC. AND ROS EQUITY HOLDINGS—INDEPENDANCE LLC, BEING THE OWNERS OF THE FOLLOWING DESCRIBED PARCEL OF LAND:

ALL OF TRACT F, THE TRAILS AT ASPEN RIDGE FILING NO.2, RECORDED AT RECEPTION NO. 221714795 OF THE RECORDS OF THE EL PASO COUNTY CLERK AND RECORDERS OFFICE, LOCATED IN A PORTION OF THE WEST 1/2 OF SECTION 9, TOWNSHIP 15 SOUTH, RANGE 65 WEST OF THE 6TH P.M., EL PASO COUNTY, COLORADO.

TOGETHER WITH:

PARCEL A

A TRACT OF LAND LOCATED IN A PORTION OF SECTION 9, TOWNSHIP 15 SOUTH, RANGE 65 WEST OF THE 6TH P.M., EL PASO COUNTY, COLORADO, MORE PARTICULARLY DESCRIBED AS FOLLOWS:

COMMENCING AT THE NORTH 1/4 CORNER OF SAID SECTION 9;

THENCE S00°19'32"E ALONG THE NORTH-SOUTH CENTERLINE OF SAID SECTION 9, A DISTANCE OF 1613.80 FEET TO A POINT ON THE SOUTHERLY RIGHT-OF-WAY LINE OF BRADLEY ROAD AS RECORDED IN BOOK 5307 AT PAGE 1472 OF THE RECORDS OF EL PASO COUNTY;

THE FOLLOWING THREE (3) COURSES ARE ON SAID SOUTHERLY RIGHT—OF—WAY LINE OF SAID BRADLEY ROAD;

- 1) THENCE S89'30'29W A DISTANCE OF 3.77 FEET TO A POINT OF CURVE TO THE LEFT;
- 2) THENCE ON SAID CURVE, HAVING A RADIUS OF 2759.79 FEET, AN ARC LENGTH OF 730.29 FEET, A DELTA ANGLE OF 15°09'41", WHOSE LONG CHORD BEARS S81°55'38"W A DISTANCE OF 728.16 FEET;
- 3) THENCE S74'20'48"W A DISTANCE OF 385.14 FEET TO POINT ON THE WESTERLY LINE OF TRACT F, OF THE TRAILS AT ASPEN RIDGE FILING NO.2, RECORDED AT RECEPTION NO. 221714795 OF THE RECORDS OF SAID EL PASO COUNTY;

THE FOLLOWING THREE (3) COURSES ARE ON SAID TRACT F LINE;

1) THENCE S15'39'12"E A DISTANCE OF 429.99 FEET TO THE POINT OF BEGINNING;

2) THENCE S15'39'12"E A DISTANCE OF 40.00 FEET;

3) THENCE S74°20'48"W A DISTANCE OF 160.21 FEET;

THENCE N15°39'12"W A DISTANCE OF 40.00 FEET;

THENCE N74'20'48"E A DISTANCE OF 160.21 FEET TO THE **POINT OF BEGINNING**.

TOTAL AREA OF FILING NO.4 PLAT CONTAINS 35.509 ACRES.

BASIS OF BEARINGS

BEARINGS ARE BASED ON THE NORTH LINE OF THE NORTHWEST QUARTER OF SECTION 9, TOWNSHIP 15 SOUTH, RANGE 65 WEST OF THE 6TH P.M. SAID LINE BEARS S89'51'23"E FROM THE NORTHWEST CORNER OF SAID SECTION 9 (2 ½" ALUM. CAP PLS 17664) TO THE N ¼ CORNER OF SAID SECTION 9 (3 ¼" ALUM. CAP PLS 10377).

FLOOD PLAIN STATEMENT

ALL OF THE PROPERTY LIES IN ZONE X, PER FLOOD INSURANCE RATE MAP NO. 08041C0768 G DATED DECEMBER 7, 2018. FIELD SURVEYING WAS NOT PERFORMED TO DETERMINE THESE ZONES.

NOTICE: ACCORDING TO COLORADO LAW, YOU MUST COMMENCE ANY LEGAL ACTION BASED UPON ANY DEFECT IN THIS SURVEY WITHIN THREE YEARS AFTER YOU FIRST DISCOVER SUCH DEFECT. IN NO EVENT, MAY ANY ACTION BASED UPON ANY DEFECT IN THIS SURVEY BE COMMENCED MORE THAN TEN YEARS FROM THE DATE OF CERTIFICATION SHOWN HEREON.

THE TRAILS AT ASPEN RIDGE FILING NO.4

A SUBDIVISION OF TRACT F OF THE TRAILS AT ASPEN RIDGE FILING NO.1 LOCATED IN THE WEST 1/2 OF SECTION 9, TOWNSHIP 15 SOUTH, RANGE 65 WEST OF THE 6TH P.M. EL PASO COUNTY, COLORADO
SHEET 1 OF 3

DEDICATION:

THE UNDERSIGNED, BEING ALL THE OWNERS, MORTGAGEES, BENEFICIARIES OF DEEDS OF TRUST AND HOLDERS OF OTHER INTERESTS IN THE LAND DESCRIBED HEREIN, HAVE LAID OUT, SUBDIVIDED, AND PLATTED SAID LANDS INTO LOTS, TRACTS, STREETS, AND EASEMENTS AS SHOWN HEREON UNDER THE NAME AND SUBDIVISION OF "THE TRAILS AT ASPEN RIDGE FILING NO.4". ALL PUBLIC IMPROVEMENTS SO PLATTED ARE HEREBY DEDICATED TO PUBLIC USE AND SAID OWNER DOES HEREBY COVENANT AND AGREE THAT THE PUBLIC IMPROVEMENTS WILL BE CONSTRUCTED TO EL PASO COUNTY STANDARDS AND THAT PROPER DRAINAGE AND EROSION CONTROL FOR SAME WILL BE PROVIDED AT SAID OWNER'S EXPENSE, ALL TO THE SATISFACTION OF THE BOARD OF COUNTY COMMISSIONERS OF EL PASO COUNTY, COLORADO. UPON ACCEPTANCE BY RESOLUTION, ALL PUBLIC IMPROVEMENTS SO DEDICATED WILL BECOME MATTERS OF MAINTENANCE BY EL PASO COUNTY, COLORADO. THE UTILITY EASEMENTS SHOWN HEREON ARE HEREBY DEDICATED FOR PUBLIC UTILITIES AND COMMUNICATION SYSTEMS AND OTHER PURPOSES AS SHOWN HEREON. THE ENTITIES RESPONSIBLE FOR PROVIDING THE SERVICES FOR WHICH THE EASEMENTS ARE ESTABLISHED ARE HEREBY GRANTED THE PERPETUAL RIGHT OF INGRESS AND EGRESS FROM AND TO ADJACENT PROPERTIES FOR INSTALLATION, MAINTENANCE, AND REPLACEMENT OF UTILITY LINES AND

RELATED FACILITIES.
<u>OWNER:</u>
THE AFOREMENTIONED COLA LLC. A LIMITED LIABILITY COMPANY, HAS EXECUTED THIS INSTRUMENT
THIS DAY OF, 20, A.D. BY
RANDY O'LEARY, PRESIDENT COLA LLC.
STATE OF COLORADO) SS
COUNTY OF EL PASO)
THIS INSTRUMENT WAS ACKNOWLEDGED BEFORE ME THIS DAY OF, 20 BY RANDY O'LEARY, PRESIDENT COLA LLC.
NOTARY PUBLIC
MY COMMISSION EXPIRES:
<u>OWNER:</u>
THE AFOREMENTIONED ROS EQUITY HOLDINGS—INDEPENDANCE LLC. A LIMITED LIABILITY COMPANY, HAS EXECUTED THIS INSTRUMENT
THIS DAY OF, 20, A.D. BY:
, PRESIDENT, ROS EQUITY HOLDINGS—INDEPENDANCE LLC.

STATE OF COLORADO)

COUNTY OF EL PASO)

THIS INSTRUMENT WAS ACKNOWLEDGED BEFORE ME THIS ____ DAY OF ____, 20__ BY _____, PRESIDENT, ROS EQUITY HOLDINGS—INDEPENDANCE LLC.

NOTARY PUBLIC

MY COMMISSION EXPIRES: ______

EASEMENTS:

UNLESS OTHERWISE INDICATED, ALL FRONT LOT LINES ARE HEREBY PLATTED WITH A TEN FOOT (15') PUBLIC UTILITY AND DRAINAGE EASEMENT AND A FIVE FEET PUBLIC IMPROVEMENT EASEMENT IN THE FIRST FIVE FEET ADJACENT TO ROAD RIGHT OF WAY. SIDE LOT LINES ARE HEREBY PLATTED WITH A FIVE FOOT (5') PUBLIC UTILITY AND DRAINAGE EASEMENT AND ALL REAR LOT LINES ARE HEREBY PLATTED WITH A TEN FOOT (10') PUBLIC UTILITY AND DRAINAGE EASEMENT, WITH THE SOLE RESPONSIBILITY FOR MAINTENANCE OF THEIR EASEMENTS VESTED WITH THE INDIVIDUAL PROPERTY OWNERS.

NO OBSTRUCTIONS ARE ALLOWED TO PENETRATE THE 40:1 APPROACH SURFACE.

ALL EXTERIOR LIGHTING PLANS MUST BE APPROVED BY THE DIRECTOR OF AVIATION TO PREVENT A HAZARD TO AIRCRAFT.

NO ELECTROMAGNETIC, LIGHT, OR ANY PHYSICAL EMISSIONS, WHICH MIGHT INTERFERE WITH AIRCRAFT, AVIATION, COMMUNICATIONS, OR NAVIGATIONAL AIDS ARE ALLOWED.

TRACTS:

TRACTS A, B, C, E AND F ARE TO BE OWNED AND MAINTAINED BY THE WATERVIEW II METROPOLITAN DISTRICT FOR THE PURPOSES OF OPEN SPACE, DRAINAGE, MAIL KIOSK, TRAILS, PARKS AND UTILITIES. OWNERSHIP BY WATERVIEW II METROPOLITAN DISTRICT WILL BE CONVEYED BY SEPARATE INSTRUMENT. EL PASO COUNTY PLANNING AND COMMUNITY DEVELOPMENT DEPARTMENT MAY AUTHORIZE BUILDING PERMITS FOR STRUCTURES TO BE UTILIZED FOR THE ALLOWED USES LISTED PREVIOUSLY.

TRACT B OF THIS PROPERTY IS SUBJECT TO A PRIVATE DETENTION BASIN/STORMWATER QUALITY BMP MAINTENANCE AGREEMENT AND EASEMENT AS RECORDED AT RECEPTION NO.______ OF THE RECORDS OF EL PASO COUNTY. WATERVIEW II METROPOLITAN DISTRICT IS RESPONSIBLE FOR MAINTENANCE OF THE SUBJECT DRAINAGE FACILITIES.

TRACT D IS TO BE OWNED AND MAINTAINED BY THE WATERVIEW II METROPOLITAN DISTRICT AND IS RESERVED FOR FUTURE RIGHT—OF—WAY, AT NO COST TO THE COUNTY, FOR POSSIBLE CONNECTION TO THE EAST. TRACT SHALL BE DEDICATED TO EL PASO COUNTY AT NO COST TO EL PASO COUNTY, AT THE TIME THE CONNECTION IS REQUIRED. IF NO CONNECTION TO THE EAST IS REQUIRED. THIS TRACT MAY BE CONVERTED TO A LOT FOR USE AS A SINGLE FAMILY RESIDENTIAL PER REVIEW AND APPROVAL OF AN AMENDED PLAT BY EL PASO COUNTY.

TRACT G IS TO BE OWNED AND MAINTAINED BY COLA LLC. FOR FUTURE DEVELOPMENT. NO BUILDING PERMITS MAY BE ISSUED WITHOUT A PLATTING ACTION AND THAT ALL IMPACT FEES ASSOCIATED WITH THESE TRACTS WILL BE PAID AT THE TIME OF REPLATTING.

Remove period

NOTES:


- 1. THIS SURVEY DOES NOT CONSTITUTE A TITLE SEARCH BY RIDGELINE LAND SURVEYING LLC., TO DETERMINE OWNERSHIP OR EASEMENTS OF RECORD. FOR ALL INFORMATION REGARDING EASEMENTS, RIGHTS—OF—WAY AND TITLE OF RECORD, RIDGELINE LAND SURVEYING LLC RELIED UPON A COMMITMENT FOR TITLE INSURANCE NO. ABN55074355.5, PREPARED BY LAND TITLE GUARANTEE, DATED 5/29/2021.
- 2. NO DRIVEWAY SHALL BE ESTABLISHED UNLESS, AN ACCESS PERMIT HAS BEEN GRANTED BY EL PASO COUNTY.
- 3. THE FOLLOWING REPORTS HAVE BEEN SUBMITTED IN ASSOCIATION WITH THE PRELIMINARY PLAN OR FINAL PLAT FOR THIS SUBDIVISION AND ARE ON FILE AT THE COUNTY PLANNING AND COMMUNITY DEVELOPMENT DEPARTMENT: SOILS AND GEOLOGICAL STUDY; WATER AVAILABILITY STUDY; DRAINAGE REPORT; WILDFIRE HAZARD REPORT; NATURAL FEATURES REPORT; EROSION CONTROL REPORT; TRAFFIC IMPACT STUDY.

THE SOILS, GEOLOGY AND GEOLOGIC HAZARD REPORT WAS PREPARED BY ENTECH ENGINEERING JOB NO.170039.

- 5. ALL STRUCTURAL FOUNDATIONS SHALL BE LOCATED AND DESIGNED BY A PROFESSIONAL ENGINEER CURRENTLY REGISTERED IN THE STATE OF COLORADO.
- 6. WIDEFIELD WATER AND SANITATION DISTRICT WILL PROVIDE POTABLE WATER SERVICE AND WASTEWATER SERVICES.
- 7. DEVELOPER SHALL COMPLY WITH FEDERAL AND STATE LAWS, REGULATIONS, ORDINANCES, REVIEW AND PERMIT REQUIREMENTS, AND OTHER REQUIREMENTS, IF ANY, OF APPLICABLE AGENCIES INCLUDING, BUT NOT LIMITED TO, THE COLORADO DEPARTMENT OF TRANSPORTATION, U.S. ARMY CORPS OF ENGINEERS, U.S. FISH AND WILDLIFE SERVICE AND/OR COLORADO DEPARTMENT OF WILDLIFE REGARDING THE ENDANGERED SPECIES ACT, PARTICULARLY AS IT RELATES TO THE PREBLE'S MEADOW JUMPING MOUSE AS A LISTED THREATENED SPECIES.
- 8. ALL PROPERTY WITHIN THIS SUBDIVISION IS SUBJECT TO CODES, COVENANTS AND RESTRICTIONS OF THE WATERVIEW II METROPOLITAN DISTRICT AS RECORDED AT RECEPTION NO. 220087532 OF THE RECORDS OF THE EL PASO COUNTY CLERK AND RECORDER.
- 9. THE ADDRESSES EXHIBITED ON THIS PLAT ARE FOR INFORMATIONAL PURPOSES ONLY. THEY ARE NOT THE LEGAL DESCRIPTION AND ARE SUBJECT TO CHANGE.
- 10. REGARDING AN UNDERSTANDING BETWEEN THE APPLICANT AND WIDEFIELD SCHOOL DISTRICT 3, THE APPLICANT IS REQUIRED BY SCHOOL DISTRICT 3 TO DISCLOSE THE SCHOOL DISTRICT'S LACK OF SCHOOLS AND CHANGING ATTENDANCE BOUNDARIES IN THIS AREA.
- 11. BURROWING OWLS INHABIT PRAIRIE DOG TOWNS FROM APRIL THRU OCTOBER. AS SUCH, A SURVEY SHOULD BE CONDUCTED PRIOR TO CONSTRUCTION. NOTE: THIS SPECIES IS PROTECTED BY THE FEDERAL MIGRATORY BIRD TREATY.
- 12. THERE WILL BE NO DIRECT LOT ACCESS TO BRADLEY ROAD FROM ANY LOT OR TRACT. VEHICULAR ACCESS TO LOTS ABUTTING ANY TRACT IS NOT PERMITTED.
- 13. THE CURRENT NOISE STUDY, "WATERVIEW PHASE II IMPACT STUDY", PERFORMED BY LSC, DATED OCTOBER 2011, AND THE NOISE STUDY ADDENDUM, DATED DECEMBER 19, 2012, INDICATES THAT A NOISE WALL IS NOT REQUIRED ALONG POWERS BOULEVARD AT THIS TIME. IN THE EVENT THAT A NOISE WALL BE REQUIRED IN THE FUTURE, CDOT WILL NOT BE RESPONSIBLE FOR CONSTRUCTING THE NOISE WALL.
- 14. ALL PROPERTY WITHIN THIS SUBDIVISION IS SUBJECT TO ROAD IMPACT FEES PRIOR TO THE ISSUANCE OF BUILDING PERMITS IN ACCORDANCE WITH EL PASO COUNTY RESOLUTION NO. 19-471. IN ADDITION, ALL PROPERTY WITHIN THIS SUBDIVISION IS INCLUDED WITHIN THE BOUNDARIES OF EL PASO COUNTY PUBLIC IMPROVEMENT DISTRICT NO.2, EL PASO COUNTY, COLORADO (PID 2) PURSUANT TO RESOLUTION NO. 20-130 OF THE PID 2 BOARD OF DIRECTORS, RECORDED IN THE RECORDS OF THE EL PASO COUNTY CLERK AND RECORDER AT RECEPTION NO. 220042582.
- 15. THIS SERVES AS NOTICE OF POTENTIAL AIRCRAFT OVERFLIGHT AND NOISE IMPACTS ON THIS PROPERTY DUE TO ITS CLOSE PROXIMITY TO AN AIRPORT, WHICH IS BEING DISCLOSED TO ALL PROSPECTIVE PURCHASERS CONSIDERING THE USE OF THIS PROPERTY FOR RESIDENTIAL AND OTHER PURPOSES. THIS PROPERTY IS SUBJECT TO THE OVERFLIGHT AND ASSOCIATED NOISE OF ARRIVING AND DEPARTING AIRCRAFT DURING THE COURSE OF NORMAL AIRPORT OPERATIONS.
- 16. ALL PROPERTY OWNERS ARE RESPONSIBLE FOR MAINTAINING PROPER STORM WATER DRAINAGE IN AND THROUGH THEIR PROPERTY. PUBLIC DRAINAGE EASEMENTS AS SPECIFICALLY NOTED ON THE PLAT SHALL BE MAINTAINED BY THE INDIVIDUAL LOT OWNERS UNLESS OTHERWISE INDICATED. HOME BUILDERS ARE RESPONSIBLE TO ENSURE PROPER DRAINAGE AROUND STRUCTURES, INCLUDING ELEVATIONS OF FOUNDATIONS AND WINDOW WELLS IN RELATION TO SIDE LOT DRAINAGE EASEMENTS AND SWALES. HOMEOWNERS SHALL NOT CHANGE THE GRADE OF THE LOT OR THE DRAINAGE SWALES WITHIN SAID EASEMENTS, AS CONSTRUCTED BY THE BUILDER, IN A MANNER THAT WOULD CAUSE ADVERSE DRAINAGE IMPACTS TO PROPERTIES. STRUCTURES, FENCES, MATERIALS OR LANDSCAPING THAT COULD IMPEDE THE FLOW OF RUNOFF SHALL NOT BE PLACED IN DRAINAGE EASEMENTS.
- 17. THE NON-REVOCABLE PUBLIC IMPROVEMENT EASEMENT SHOWN AT THE END OF BIG JOHNSON DRIVE CUL-DE-SAC IS INTENDED FOR TURN AROUND AND EMERGENCY RESPONSE PURPOSES. AT SUCH A TIME THAT BIG JOHNSON DRIVE IS EXTENDED BY THE ADJACENT PROPERTY OWNER/DEVELOPER AND ACCEPTED BY THE COUNTY, THE NON-REVOCABLE PUBLIC IMPROVEMENT EASEMENT FOR THE CUL-DE-SAC WILL BE VACATED, LEAVING A STANDARD STREET ROW AND THE CUL-DE-SAC IMPROVEMENTS WILL BE REMOVED AND REPLACED WITH A STANDARD STREET SECTION. THE EASEMENT VACATION, CUL-DE-SAC REMOVAL AND STANDARD STREET SECTION CONSTRUCTION AND SITE RESTORATION IS THE RESPONSIBILITY OF THE OWNER/DEVELOPER TO EXTENDING BIG JOHNSON DRIVE.
- 18. NOTICE: THIS PROPERTY WILL BE INCLUDED WITHIN A SPECIAL TAXING DISTRICT, FOUNTAIN MUTUAL METROPOLITAN DISTRICT, CREATED FOR THE PURPOSE OF CONSTRUCTING AND MAINTAINING CERTAIN DRAINAGE AND PARK AND RECREATION IMPROVEMENTS. SPECIAL TAXING DISTRICTS ARE SUBJECT TO A GENERAL OBLIGATION INDEBTEDNESS THAT IS PAID BY REVENUES PRODUCED FROM ANNUAL TAX LEVIES ON THE TAXABLE PROPERTY WITHIN SUCH DISTRICTS. THE BUYER SHOULD FAMILIARIZE HIMSELF/ HERSELF WITH THIS POTENTIALITY AND RAMIFICATIONS THEREOF.
- 19. MAILBOXES SHALL BE INSTALLED IN ACCORDANCE WITH ALL EL PASO COUNTY AND UNITED STATES POSTAL SERVICE REGULATIONS.
- 20. ALL DIMENSIONS SHOWN HEREON ARE EXPRESSED IN TERMS OF U.S. SURVEY FOOT.
- 21. THIS PLAT IS REGULATED BY THE TRAILS AT ASPEN RIDGE PUD (PUDSP—191) RECEPTION NO. 221135788 OF THE RECORDS OF EL PASO COUNTY.
- 22. PERIMETER DRAINS AND SUMP PUMPS SHALL NOT DIRECTLY DISCHARGE ONTO PUBLIC RIGHT-OF-WAYS.
- 23. ALL ROADWAYS SHOWN HEREON ARE PUBLIC, RIGHT-OF-WAY WIDTHS SHOWN HEREON.
 PUBLIC IMPROVEMENTS WITHIN SAID RIGHT-OF-WAY SO DEDICATED WILL BECOME MATTERS OF
 MAINTENANCE BY EL PASO COUNTY

 Unresolved: Did not add note referencing
- 24. LOTS 1-124 ACREAGE: 10.763
 TRACTS A-G ACREAGE: 19.842
 PUBLIC STREETS ACREAGE: 4.904
 TOTAL ACREAGE: 35.509

geotech report and list any of the lots/areas impacted by hazards noted in report

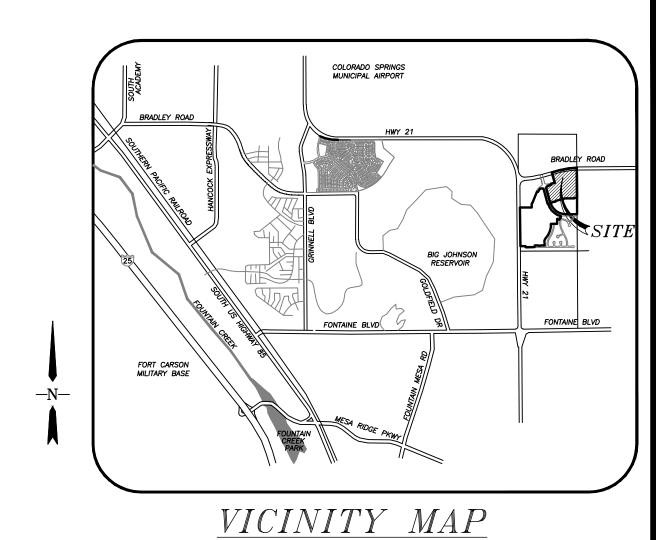

SURVEYOR'S CERTIFICATION:

I JAMES F. LENZ, A DULY REGISTERED PROFESSIONAL LAND SURVEYOR IN THE STATE OF COLORADO, DO HEREBY CERTIFY THAT THIS PLAT TRULY AND CORRECTLY REPRESENTS THE RESULTS OF A SURVEY MADE ON DATE OF SURVEY, BY ME OR UNDER MY DIRECT SUPERVISION AND THAT ALL MONUMENTS EXIST AS SHOWN HEREON; THAT MATHEMATICAL CLOSURE ERRORS ARE LESS THAN 1:10,000; AND THAT SAID PLAT HAS BEEN PREPARED IN FULL COMPLIANCE WITH ALL APPLICABLE LAWS OF THE STATE OF COLORADO DEALING WITH MONUMENTS, SUBDIVISION, OR SURVEYING OF LAND AND ALL APPLICABLE PROVISIONS OF THE EL PASO COUNTY LAND DEVELOPMENT CODE.

JAMES F. LENZ PROFESSIONAL LAND SURVEYOR IN THE STATE OF COLORADO, NO 34583 FOR AND ON BEHALF OF RIDGELINE LAND SURVEYING LLC.

COUNTY CERTIFICATION:

THIS PLAT FOR "THE TRAILS AT ASPEN RIDGE FILING NO.4" WAS APPROVED FOR FILING BY THE EXECUTIVE DIRECTOR OF THE EL PASO COUNTY PLANNING AND COMMUNITY DEVELOPMENT DEPARTMENT ON THIS ___ DAY OF _____, 20__, SUBJECT TO ANY NOTES SPECIFIED HEREON AND ANY CONDITIONS INCLUDED IN THE (COVENANTS). THE DEDICATIONS OF LAND TO THE PUBLIC STREETS AND EASEMENTS ARE ACCEPTED, BUT PUBLIC IMPROVEMENTS THEREON WILL NOT BECOME MAINTENANCE RESPONSIBILITY OF EL PASO COUNTY UNTIL PRELIMINARY ACCEPTANCE OF THE PUBLIC IMPROVEMENTS IN ACCORDANCE WITH THE REQUIREMENTS OF THE LAND DEVELOPMENT CODE AND ENGINEERING CRITERIA MANUAL AND THE SUBDIVISION IMPROVEMENTS AGREEMENT

DIRECTOR, PLANNING AND COMMUNI	TY DEVELOPMENT	DATE
STEVE SCHLEIKER, COUNTY ASSESS	 OR	 DATE

CLERK AND RECORDER CERTIFICATION:

I HEREBY CERTIFY THAT THIS PLAT WAS FILED IN MY OFFICE ON THIS ______ DAY OF ______ 2022, AT _____ O'CLOCK A.M./P.M. AND WAS RECORDED AT RECEPTION NUMBER ______ OF THE RECORDS OF EL PASO COUNTY.

EL PASO COUNTY CLERK AND RECORDER

BY:		FEE:
-----	--	------

<u>OWNER/DEVELOPER</u>

COLA LLC 7910 GATEWAY BLVD EAST #102 EL PASO, TX 79915—1801

$\underline{ENGINEER}$

MATRIX 2435 RESEARCH PARKWAY COLORADO SPRINGS, CO 80920

SURVEYED
DECEMBER 2018

DATE OF PREPARATION
JUNE 2021

FEES:		
DRAINAGE	BRIDGE	
SCHOOL	PARK	



DATE: 4/20/22 SHEET 1 OF 3 PCD# SF-21-024

