




645.0 E ELEVATION 2 STORY
 AVERAGE FINISH GRADE = (AFG)
 $AFG = \frac{51.1+50.7+50.6(2)+48.9+48.2+47.6}{7} = 49.7$
 BUILDING HEIGHT = 24.6 + (TF - AFG) =
 BUILDING HEIGHT = 24.6 + (51.6 - 49.7) = 26.5

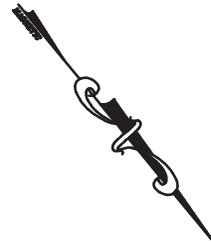

Released for Permit

06/23/2025 8:26:25 AM



SFD25624


APPROVED
 BESQCP
 06/23/2025 10:25:39 AM
 dsdyounger
 EPC Planning & Community
 Development Department

APPROVED
 Plan Review
 06/23/2025 10:25:46 AM
 dsdyounger
 EPC Planning & Community
 Development Department

It is the owner's responsibility to coordinate with easement holders to avoid impact to utilities that may be located in the easements.

ANY APPROVAL GIVEN BY EL PASO COUNTY DOES NOT OVERTAKE THE NEED TO COMPLY WITH APPLICABLE FEDERAL, STATE, OR LOCAL LAWS AND/OR REGULATION. Planning & Community Development Department approval is contingent upon compliance with all applicable notes on the recorded plat.
 An access permit must be granted by the Planning & Community Development Department prior to the establishment of any driveway onto a County road.
 Diversion of blockage of any drainage way is not permitted without approval of the Planning & Community Development Department.

LOT 48

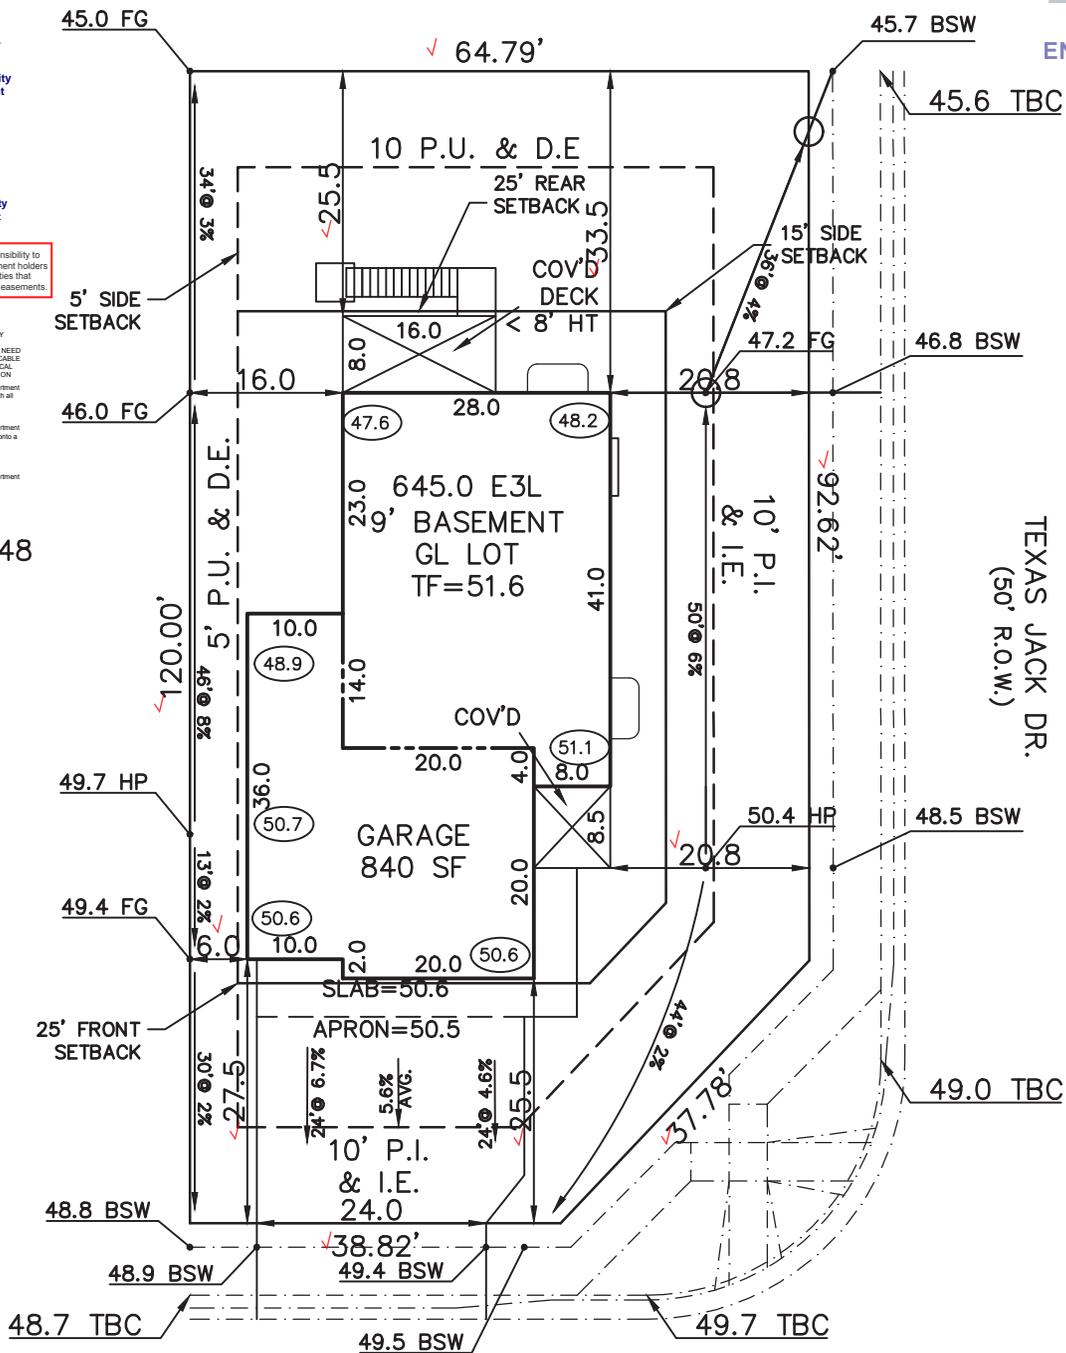

PUD
 PLAT 15150

SCHEDULE No. 5228405009 ✓

HARVEY LOGAN DR.
 (50' R.O.W.)

WARNING! 1. LOCATE UNDERGROUND UTILITIES PRIOR TO EXCAVATION. 2. THIS PLOT PLAN SHOWS IMPROVEMENTS AT GRADE ONLY. SEE FOUNDATION PLANS FOR STRUCTURAL INFORMATION.	SITE DATA LOT SQ. FT.= 7422 ✓ HOUSE SQ. FT.= 2109 ✓ COVERAGE = 28.4% ✓ BLDG. HEIGHT = 26.5 ✓	PLOT PLAN	
	LEGAL DESCRIPTION LOT 49 ✓ HOMESTEAD NORTH AT STERLING RANCH FILING NO. 1 ✓ EL PASO COUNTY, COLORADO		
NOTES: 1. ALL COVERED AREAS ARE INCLUDED IN LOT COVERAGE. 2. DECK 8'+ ABOVE GRADE ARE INCLUDED IN LOT COVERAGE. 3. DECK STAIRS SHOWN MAY NOT BE ACCURATE TO NUMBER OF STEPS NEEDED TO REACH GRADE. 4. RETAINING WALL(S) SHOWN ARE DESIGNED PER INFORMATION PROVIDED BY THE DEVELOPER. ACTUAL FIELD CONDITIONS ENCOUNTERED DURING CONSTRUCTION MAY REQUIRE MINOR MODIFICATION TO THE DESIGN. 5. DUE TO SITE CONDITIONS, ACTUAL RETAINING WALLS, GRADING AND SLOPES MAY VARY FROM THE APPROVED PLOT PLAN, VANTAGE HOMES RESERVES THE RIGHT TO MODIFY OR CHANGE THE PLOT PLAN WITHOUT PRIOR NOTICE. 6. 12" EAVES	ADDRESS 8215 HARVEY LOGAN DRIVE ✓		
	SCALE: ...1"=20'	DRAWING NAME HN1-49	DATE 06-19-25
	VANTAGE HOMES 9540 FEDERAL DRIVE, SUITE 100 COLORADO SPRINGS, COLORADO 80921 PHONE 719-534-0984 FAX 719-534-0998 1 inch = 20 ft.		



SITE



2023 PPRBC
2021 IECC Amended

Address: 8215 HARVEY LOGAN DR, COLORADO SPRINGS

Parcel: 5228405009

Plan Track #: 202960 

Received: 23-Jun-2025 (AMY)

Description:

RESIDENCE

Type of Unit:

Garage	838	
Lower Level 2	1071	
Main Level	1070	
Upper Level 1	1158	
	4137	Total Square Feet

Required PPRBD Departments (2)

Enumeration

APPROVED

AMY

6/23/2025 8:26:41 AM

Floodplain

(N/A) RBD GIS

Required Outside Departments (1)

County Zoning

APPROVED

Plan Review

06/23/2025 10:26:48 AM

dsdyounger

**EPC Planning & Community
Development Department**

Release of this plan does not preclude compliance with all applicable codes, ordinances and other pertinent regulations. This plan set must be present on the job site for every inspection.