


DRAWING INDEX

- 1 OF 14 - SITE PLAN, PROJECT INFORMATION, DRAWING INDEX
- 2 OF 14 - SITE DETAILS
- 3 OF 14 - UTILITY SERVICE PLAN
- 4 OF 14 - GRADING PLAN
- 5 OF 14 - EROSION CONTROL PLAN
- 6 OF 14 - LANDSCAPE PLAN
- 7 OF 14 - NOT USED
- 8 OF 14 - PHOTO METRIC PLAN
- 9 OF 14 - PHOTO METRIC DETAILS
- 10 OF 14 - BUILDING 'A' & 'B' ELEVATIONS PER EFC STANDARDS
- 11 OF 14 - BUILDING 'C' & 'D' ELEVATIONS
- 12 OF 14 - BUILDING 'E' & 'F' ELEVATIONS
- 13 OF 14 - BUILDING 'G' & 'H' ELEVATIONS
- 14 OF 14 - BUILDING 'I' & 'J' ELEVATIONS

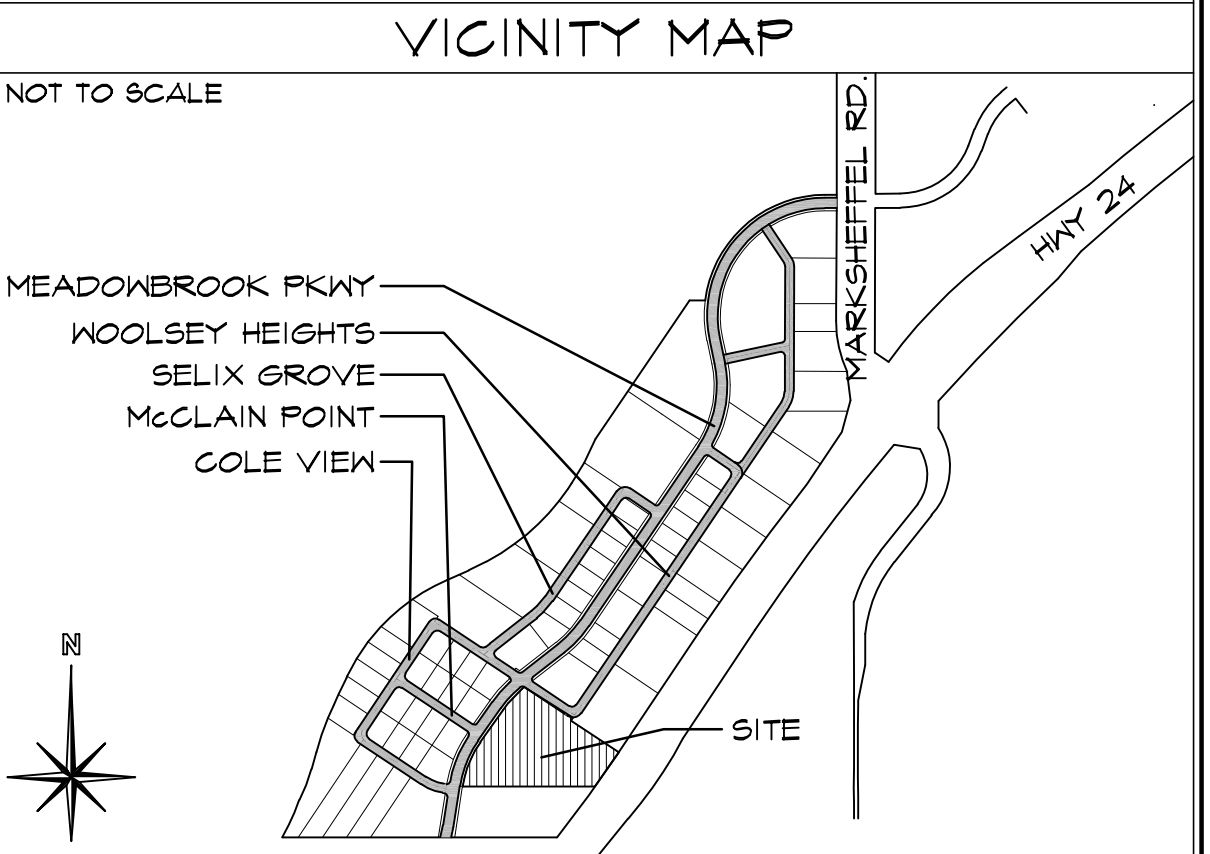

PROJECT INFORMATION

PROPERTY INFORMATION
 OWNER NAME: MEADOWBROOK STORAGE, LLC
 1403 WOOLSEY HTS.
 COLORADO SPRINGS, CO 80915

LEGAL DESCRIPTION: LOT 45A FILING 2A OF CLAREMONT BUSINESS PARK

PARCEL NUMBER: 54081-01-044
ZONING: CS
LOT SIZE: 231,734 SF (5.32 ACRES)
CURRENT USE: VACANT
FLOODPLAIN STATEMENT: ZONE X (MAP NO. 17-001-001 DATED MARCH 17, 1997)

BUILDING INFORMATION
 GROSS BUILDING AREA: 112,842 SF
 BUILDING OCCUPANCY: S-2, B
 TYPE OF CONSTRUCTION: I-B
 FIRE SYSTEMS: NONE
 AREA SEPARATION WALLS: NONE

ZONING CODE STUDY
 PROPOSED PRINCIPAL USE: MINI-STORAGE/RV STORAGE
 STRUCTURAL COVERAGE OF LOT: 44%
 PAVEMENT COVERAGE: 51%
 BUILDING STRUCTURAL HEIGHT: 25'-11" (45'-0" MAX)
 FRONT YARD SETBACK: 25'-0"
 SIDE YARD SETBACK: 0'-0"
 REAR YARD SETBACK: 25'-0"

REQUIRED PARKING SPACES:
 MINI-STORAGE-(1 SPACE/100 UNITS) (273 UNITS / 100 UNITS)..... 3
 MINI-STORAGE-(1 SPACE/EMPLOYEE) (1 EMPLOYEE)..... 1 (PROVIDED AS-A GARAGE UNIT)
 H.C-(1 SPACE/25 READ)..... 5
TOTAL PARKING SPACES REQUIRED: 9
 STANDARD SPACES PROVIDED: 2
 H.C. SPACES PROVIDED: 1
 LOADING SPACE PROVIDED: 14'x18' AREA PROVIDED (SEE DTL 1 ON PG 2 FOR DIMENSIONS)

DEVELOPMENT SCHEDULE
 CONSTRUCTION: SUMMER 2017
 LANDSCAPING: SUMMER 2017

DEVELOPMENT APPLICANT
 COMPANY: HAMMERS CONSTRUCTION, INC.
 1411 WOOLSEY HEIGHTS
 COLO. SPGS., CO 80915
 PHONE NUMBER: (719)-570-1549
 FAX NUMBER: (719)-570-1008
 APPLICANT NAME: LISA PETERSON
 APPLICANT E-MAIL: lpeterson@hammersconstruction.com


SITE LEGEND

- PROPERTY LINE
- RIGHT OF WAY
- BUILDING SETBACK
- LANDSCAPE SETBACK
- UTILITY/DRAINAGE EASEMENT
- ELECTRICAL EASEMENT
- ACCESS EASEMENT
- OPAQUE CHAINLINK FENCE
- 6' HIGH WROUGHT IRON FENCE
- GAS LINE
- WATER LINE
- ELECTRICAL LINE
- SANITARY SEWER LINE
- STORM SEWER LINE
- PHONE LINE
- OVERHEAD ELECTRIC LINE
- RETAINING WALL
- NEW SIDEWALK LOCATIONS
- W/ CONTROL JOINTS @ 5'-0" OC.

PROPERTY CORNER
 SIGN
 TRAFFIC FLOW
 WALL PACK LIGHTING
 EXISTING FIRE HYDRANT
 PROPOSED FIRE HYDRANT
 MANHOLE
 ELECTRICAL TRANSFORMER

MISC. UNITS

BUILDING	APPROX. UNIT SIZE	UNIT	SQ. FT.
A	30x20	600.00	
B	21x40	852.17	
	14x40	606.51	
C	14x42	1,152.00	
	14x40	1,255.90	
D	14x42	996.00	
	14x40	206.75	
E	20x15	346.41	
	10x27	270.00	
	10x10	388.05	
	10x25	267.65	
	10x30	549.11	
	18x15	237.56	
F	10x20	219.62	
	10x24	246.59	
	33x28	336.00	
TOTAL MISC. UNIT SF			9,666.32

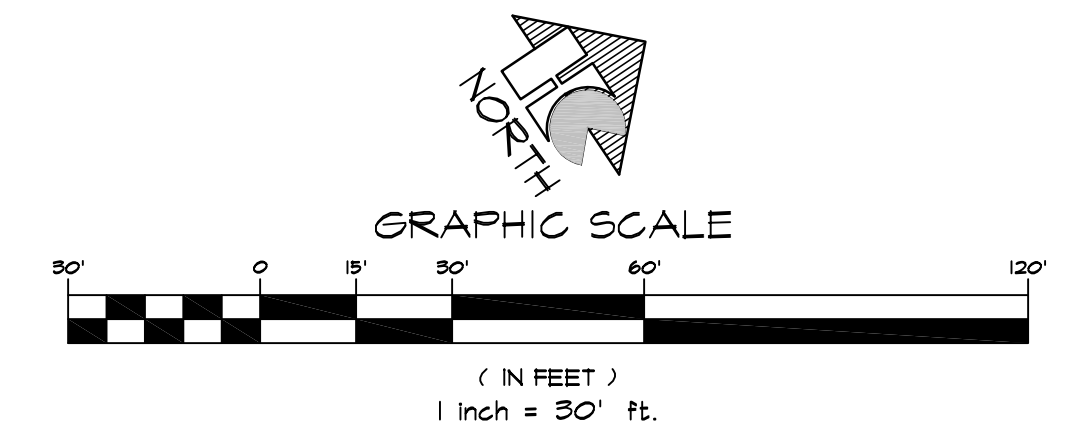

BUILDING TABULATION

UNIT SIZE	10 x 20	10 x 28	10 x 30	12 x 30	12 x 40	12 x 40 A	14 x 30	14 x 40	14 x 40 A	MISC.	TOTAL	TOTAL
UNIT SF	200	280	300	360	480	543	420	560	622		RENTABLE	BUILDING
A				14						3	5,040.00	5,640.00
B					2			1	20	3	16,578.28	17,846.00
C									34	4	24,648.82	26,818.00
D									13	2	4,587.05	10,319.00
E	23										4,600.00	6,000.00
F	27										5,400.00	4,200.00
G		5	75					1		11	26,484.58	11,036.00
H											0.00	17,725.00
I											2,100.00	2,100.00
J											3,300.00	3,000.00
				4	1						8,080.00	8,080.00
TOTAL UNITS	50	5	43	18	3	1	1	12	67	20	105,868.73	112,842.00
TOTALSF	10,000.00	1,400.00	21,900.00	6,480.00	1,440.00	542.95	420.00	6,720.00	41,649.46	9,666.32	106,268.73	

1 SITE PLAN
 SCALE: 1"=30'-0"

HAMMERS CONSTRUCTION INC.

COMMERCIAL GENERAL CONTRACTORS SPECIALIZING IN DESIGN/BUILD

PRESIDENT: STEVE R. HAMMERS
 VICE PRES: DAVID J. HAMMERS
 1411 WOOLSEY HEIGHTS
 COLORADO SPRINGS, CO 80915
 (719) 570-1599 FAX (719) 570-7008
 www.hammersconstruction.com

THIS DRAWING CONTAINS MATERIAL & INFORMATION WHICH MAY NOT BE REPRODUCED WITHOUT WRITTEN CONSENT OF HAMMERS CONSTRUCTION, INC. THESE DRAWINGS ARE INTENDED TO BE USED ONLY BY HAMMERS CONSTRUCTION & ITS REPRESENTATIVES. THESE DRAWINGS HAVE NOT BEEN PREPARED FOR ANY OTHER PURPOSE THAN TO INDICATE THE GENERAL FEATURES AND PLACEMENT OF THE PROPOSED PROJECT. COPYRIGHT © 2017 HAMMERS CONSTRUCTION

MEADOWBROOK STORAGE


LOT 45-2
 1403 WOOLSEY HTS.
 COLORADO SPRINGS, CO 80915
 EL PASO COUNTY, COLORADO

per your calculation, 4 spaces would be necessary including the 1 employee space.




DATE: APR 25, 2017
 DRAWN BY: D. AGUIÑO
 PROJ. MGR: R. DYACHENKO
 SCALE: SEE PLAN
 APPROVED BY:
 JOB NO: 1028


REVISIONS:
 5/3/17 - COMMENTS 5/18/17

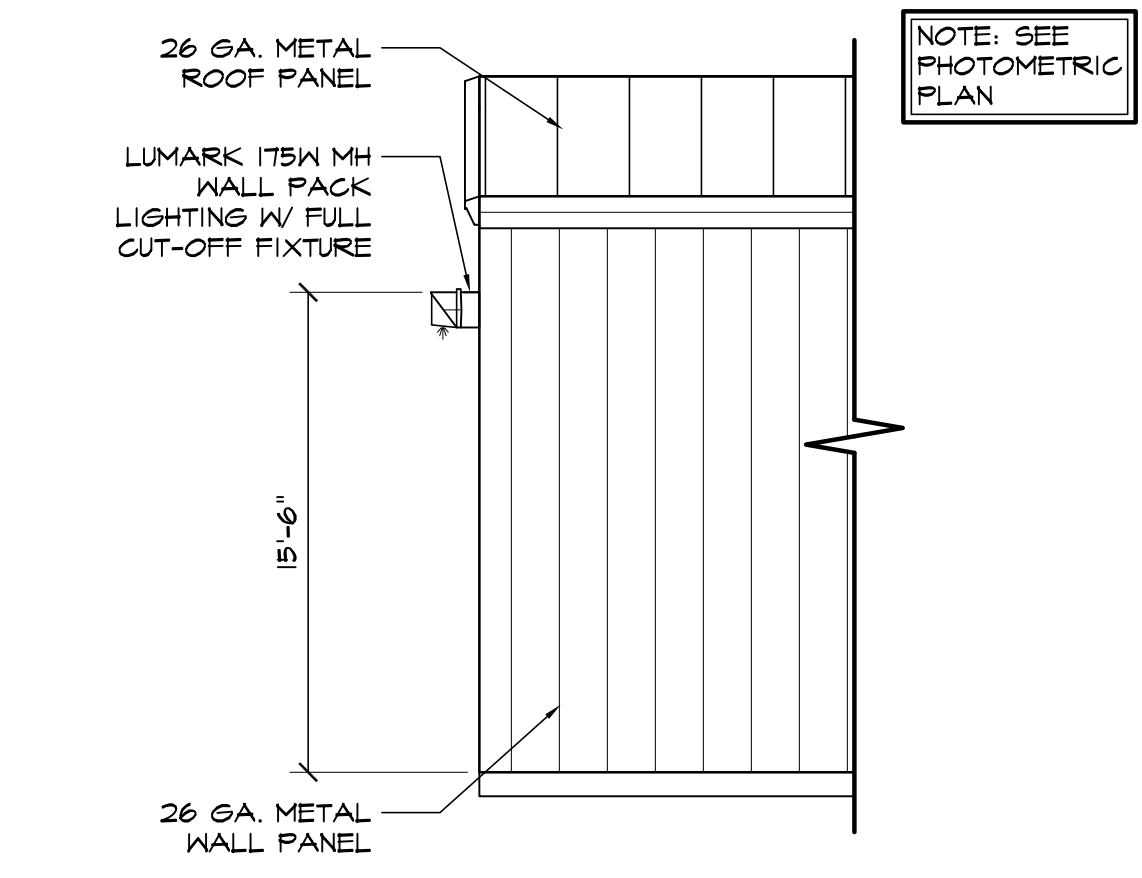


5 WALL PACK LIGHT DETAIL
SCALE: 1/4"=1'-0"

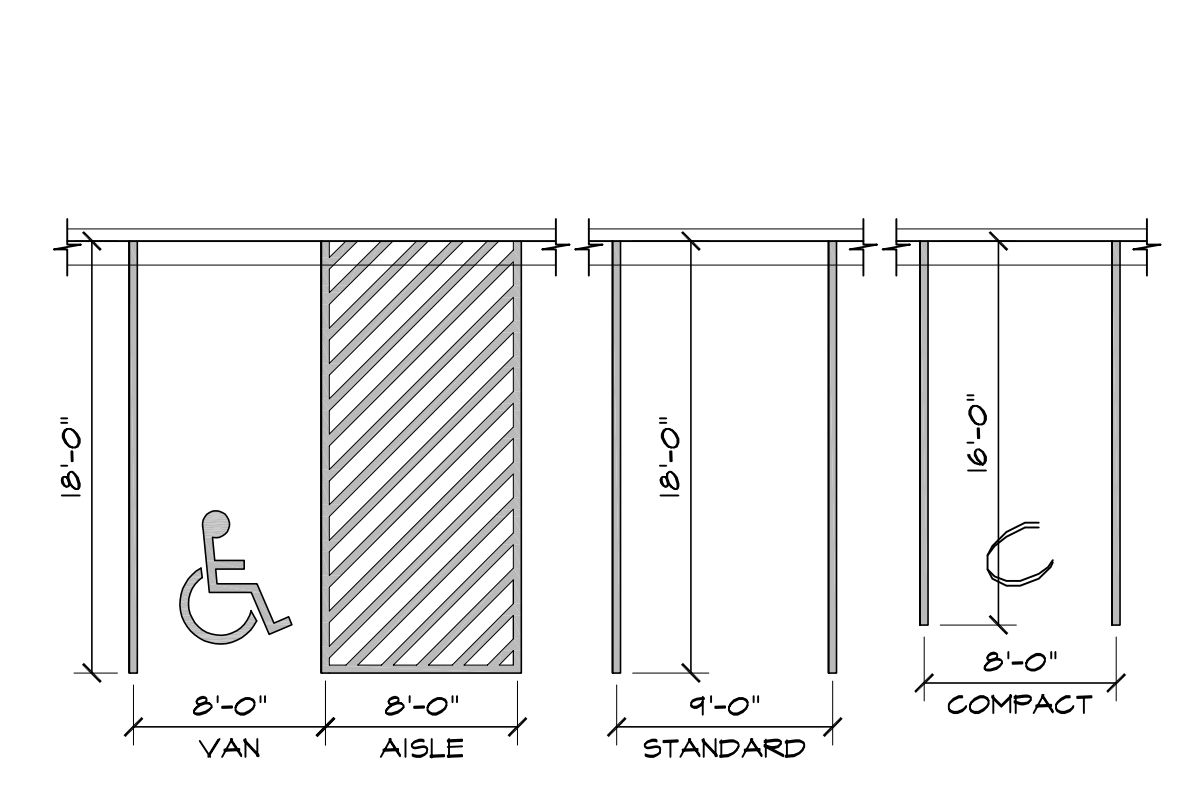


1 ADA / STANDARD PARKING
SCALE: 1/8"=1'-0"

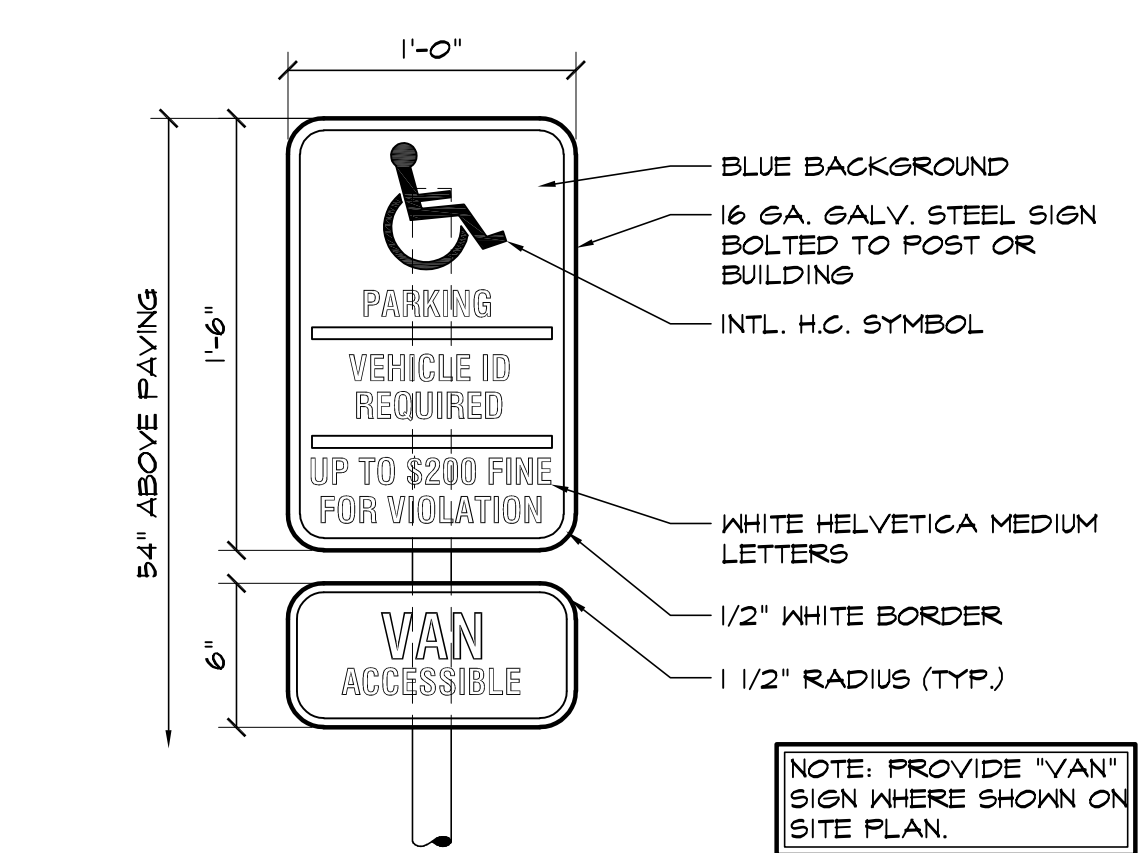


6 HANDICAPPED PARKING SIGN
SCALE: 1 1/2"=1'-0"

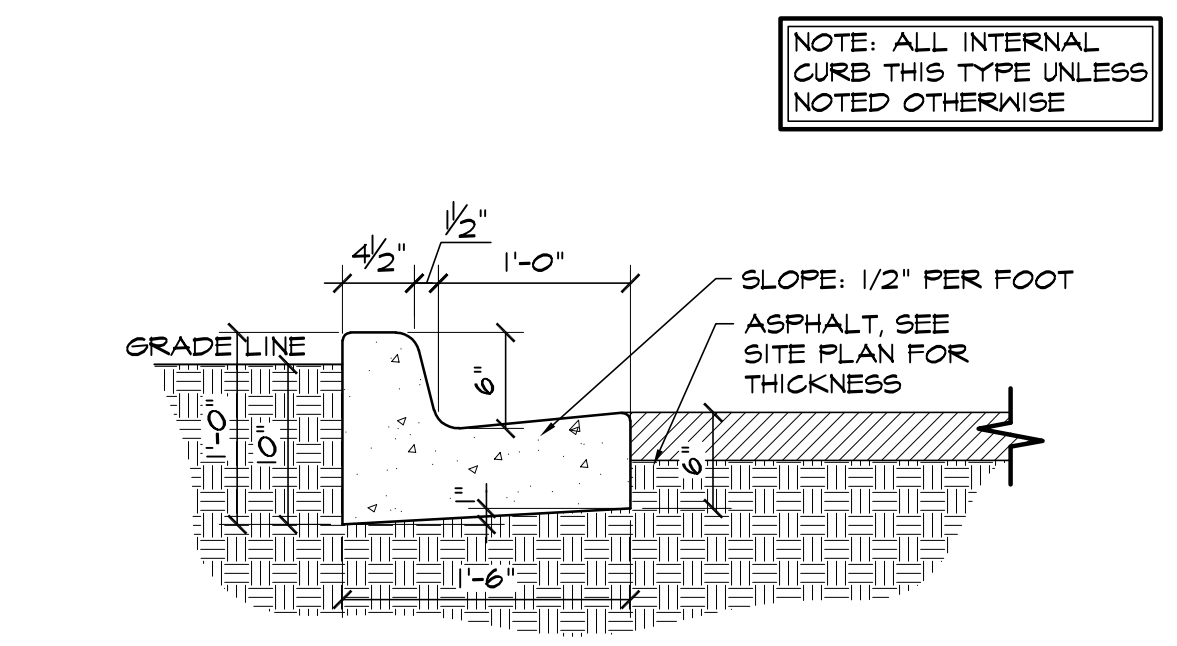


2 EPC TYPE B CURB
SCALE: 1"=1'-0"

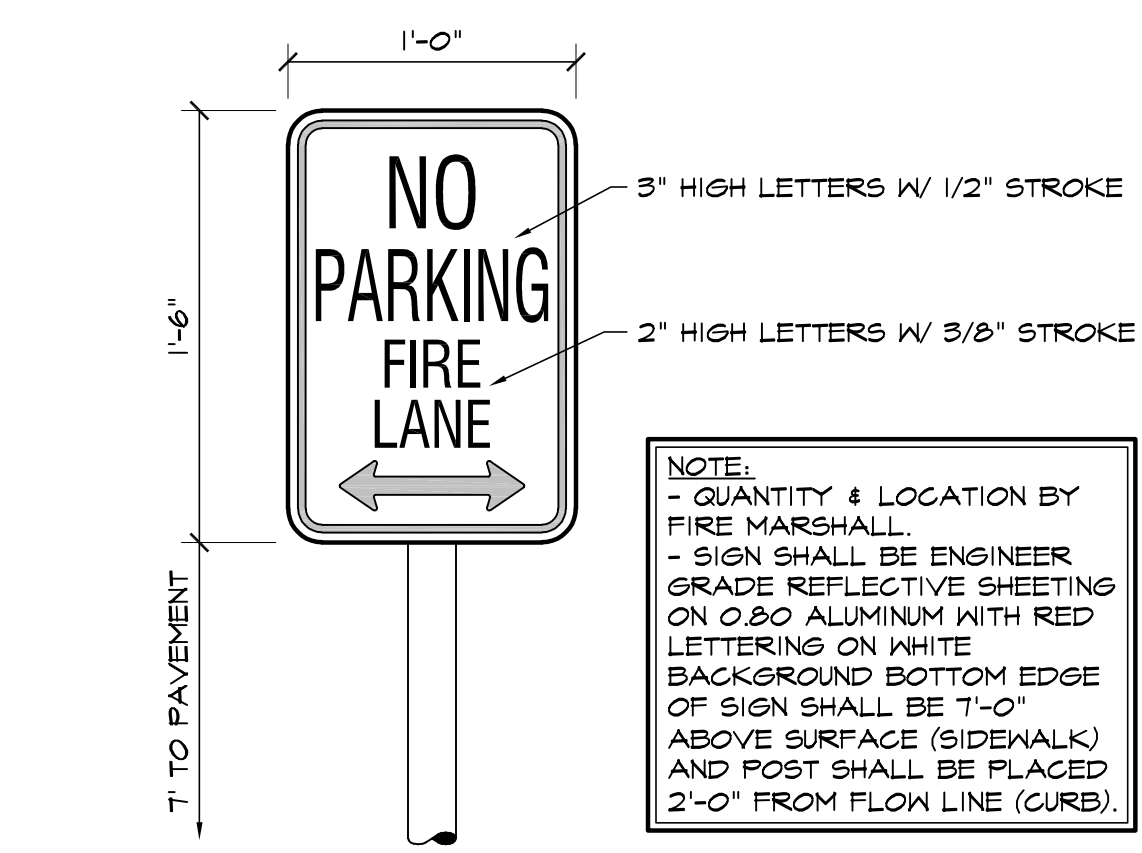


7 FIRE LANE SIGN
SCALE: 1 1/2"=1'-0"

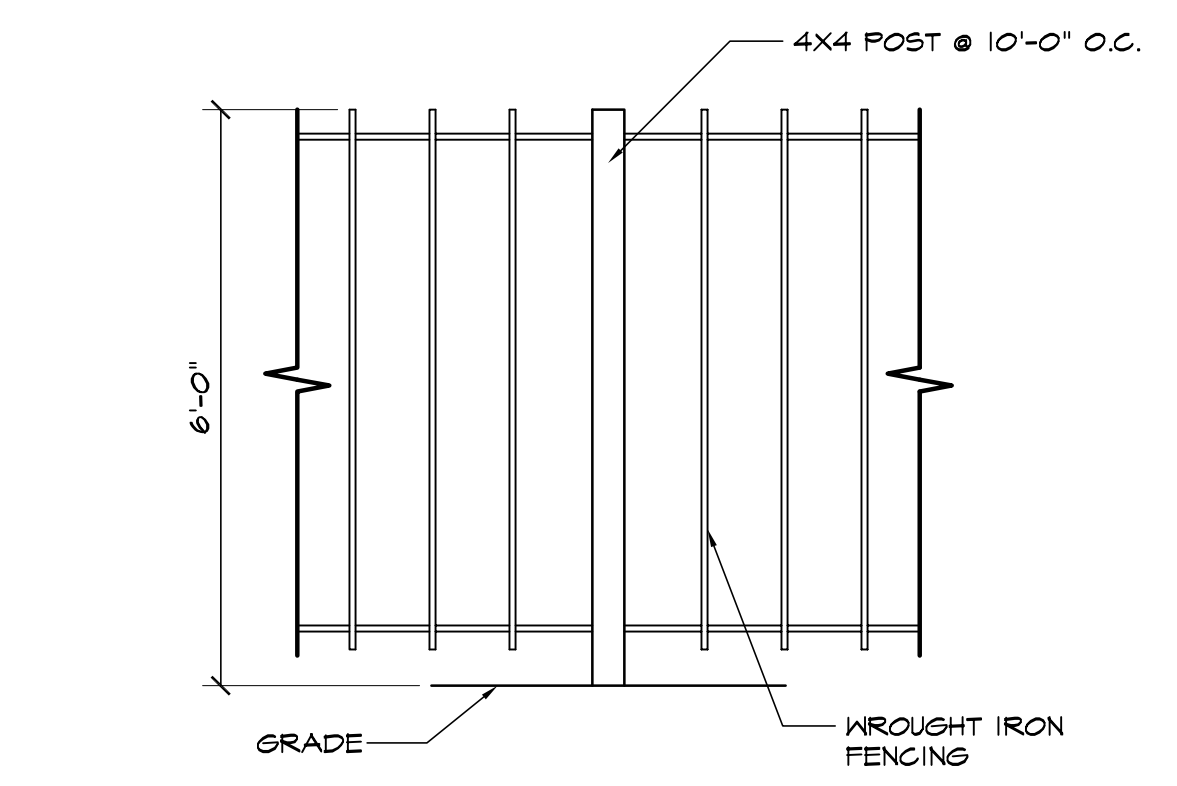

3 WROUGHT IRON FENCE DETAIL
SCALE: 1/2" = 1'-0"

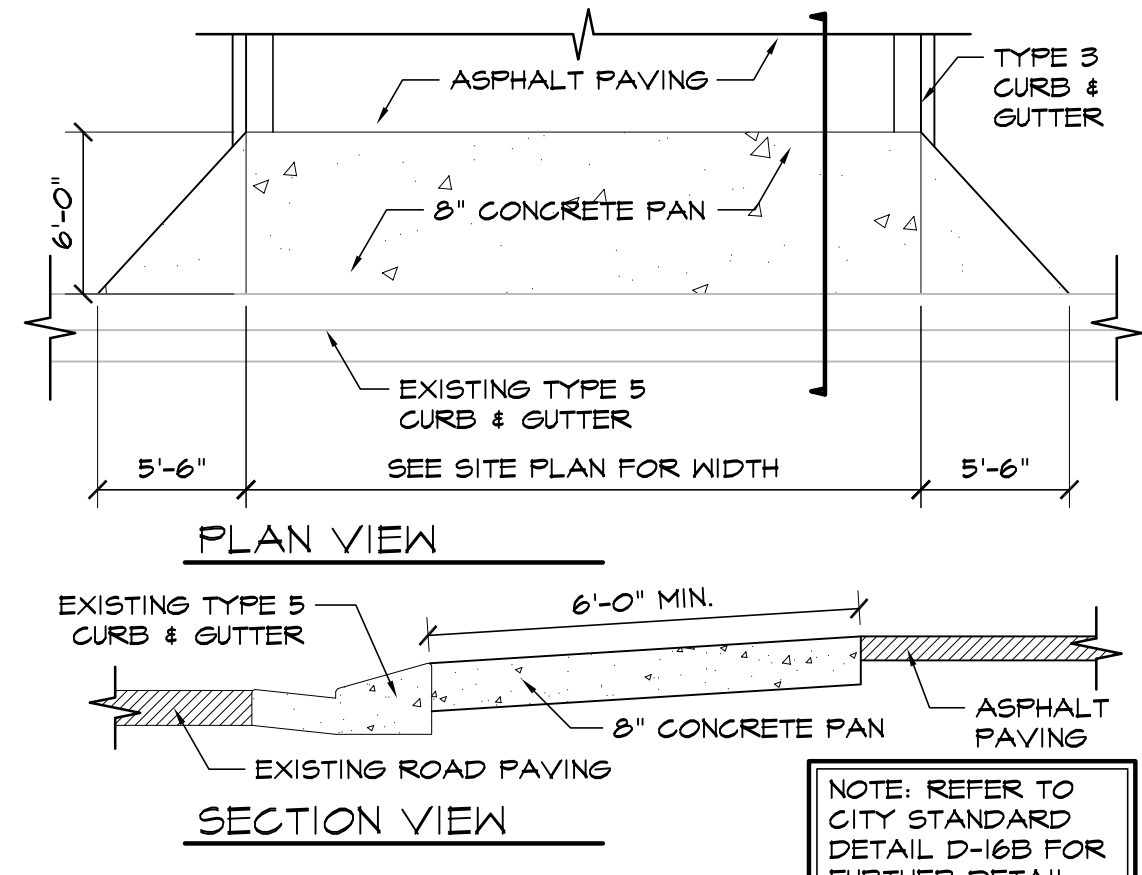

8 DRIVEWAY DETAIL
NOT TO SCALE

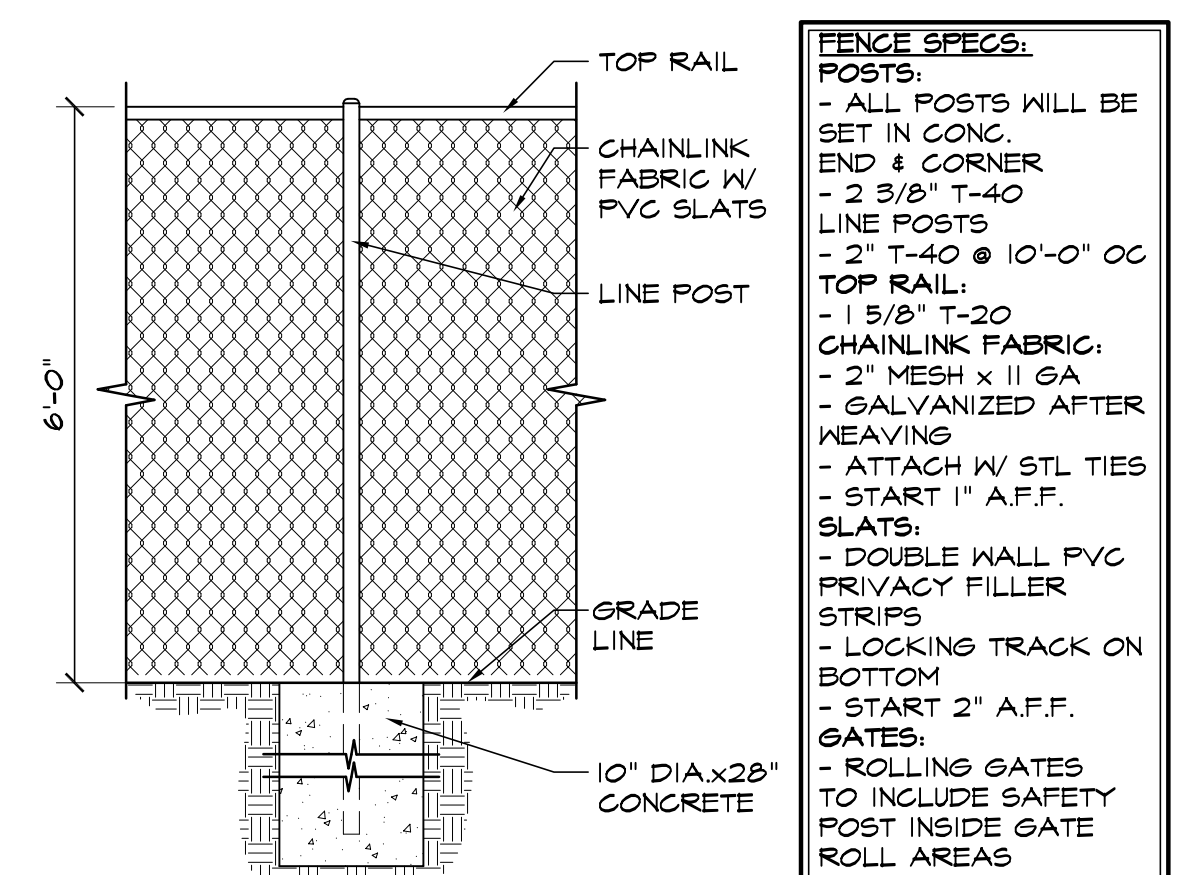

4 CHAINLINK FENCE DETAIL
SCALE: 1/2"=1'-0"

HAMMERS CONSTRUCTION INC.
COMMERCIAL GENERAL CONTRACTORS SPECIALIZING IN DESIGN/BUILD
PRESIDENT: STEVE R. HAMMERS
VICE PRES: DAVID J. HAMMERS
1411 WOOLSEY HEIGHTS
COLORADO SPRINGS, CO 80915
(719) 570-1589 FAX (719) 570-7008
www.hammersconstruction.com

THIS DRAWING CONTAINS MATERIAL & INFORMATION WHICH MAY NOT BE REPRODUCED WITHOUT WRITTEN CONSENT OF HAMMERS CONSTRUCTION INC. THESE DRAWINGS ARE INTENDED TO BE USED ONLY BY HAMMERS CONSTRUCTION & ITS REPRESENTATIVES. THESE DRAWINGS HAVE NOT BEEN PREPARED FOR ANY OTHER PURPOSE THAN TO INDICATE THE GENERAL FEATURES AND PLACEMENT OF THE PROPOSED PROJECT. COPYRIGHT © 2017 HAMMERS CONSTRUCTION

MEADOWBROOK STORAGE
LOT 45-2
1403 WOOLSEY HTS.
COLORADO SPRINGS, CO 80915
EL PASO COUNTY, COLORADO

DATE: APR 25, 2017
DRAWN BY: D. AQUINO
PROJ. MGR: Y. DYACHENKO
SCALE: SEE PLAN
APPROVED BY:
JOB NO: 1028

REVISIONS:

△	5/3/17 - COMMENTS 5/18/17
△	
△	
△	
△	


Markup Summary

1 (3)



Subject: Callout
Page Label: 1
Lock: Locked
Status:
Checkmark: Unchecked
Author: dsdkendall
Date: 6/19/2017 4:11:04 PM
Color: ■

per your calculation, 4 spaces would be necessary including the 1 employee space.

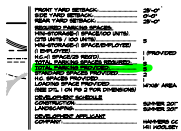

Subject: Highlight
Page Label: 1
Lock: Locked
Status:
Checkmark: Unchecked
Author: dsdkendall
Date: 6/19/2017 4:11:02 PM
Color: ■



Subject: Callout
Page Label: 1
Lock: Locked
Status:
Checkmark: Unchecked
Author: dsdkendall
Date: 6/19/2017 4:11:03 PM
Color: ■

There should be 6/ Alternative parking Ratio needs to be referenced.