


File Name: P:\2017\20170351\Drawings\3Sheet\51E100P.dwg Last Plotted: 2017/06/02 @ 1:42 PM By: dgh

The lighting exceeds 0 at the property line. Please place or lower the lighting to meet the Code Section 6.2.3 pg. 6-17.

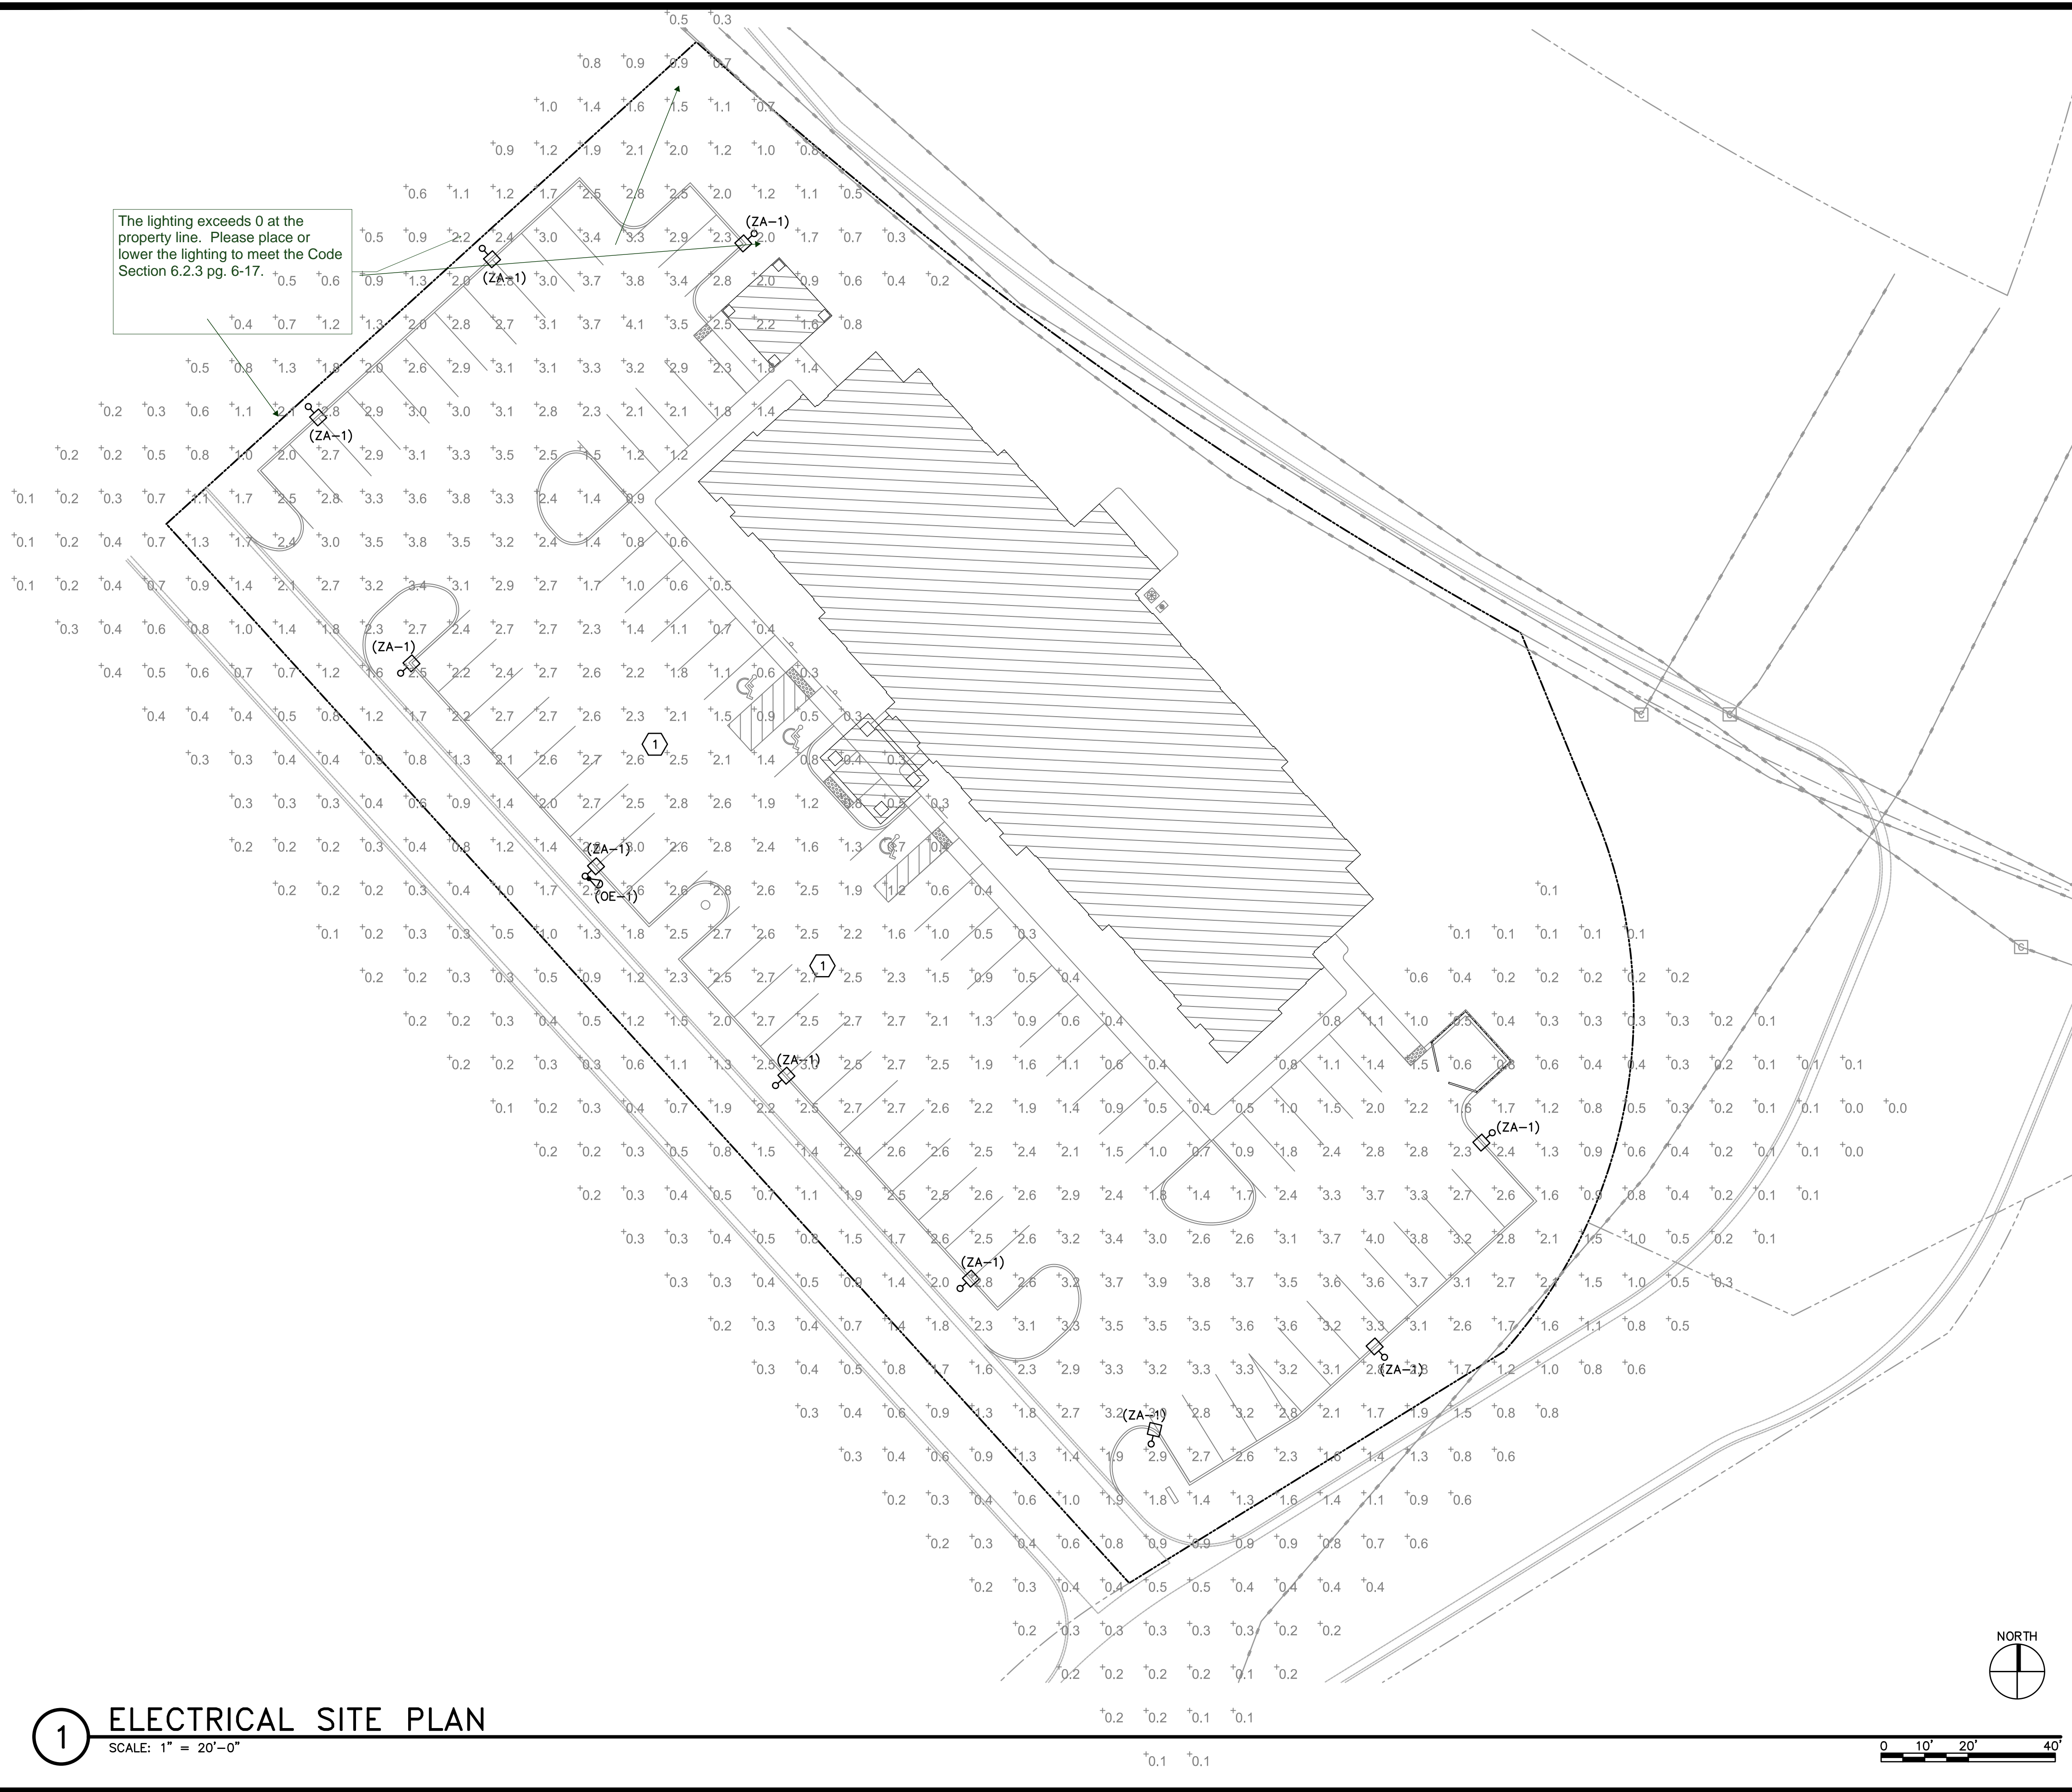


1 ELECTRICAL SITE PLAN


SCALE: 1" = 20'-0"

SHEET KEYNOTES

1. ROUTE CIRCUITS THROUGH EXTERIOR LIGHTING CONTROLLER. PROVIDE CONTROLLER.
2. CONTRACTOR SHALL VERIFY ALL REQUIREMENTS WITH LOCAL POWER AND TELEPHONE UTILITY COMPANIES AND PROVIDE THE REQUIRED INFRASTRUCTURE FOR THE BUILDING.
3. COORDINATE TERMINATION POINT WITH POWER UTILITY FOR CONNECTIONS TO TRANSFORMER AND WITH PHONE UTILITY FOR CONNECTIONS TO PHONE DEMARC IN DATA ROOM.

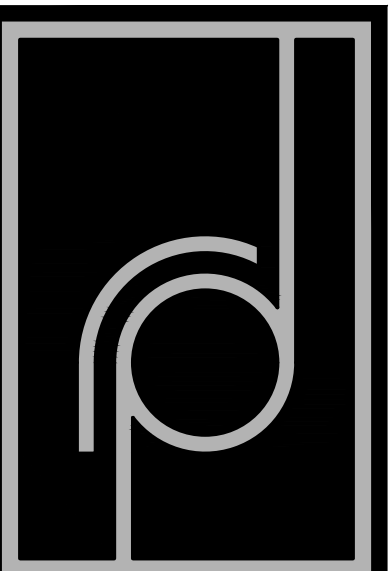

THE RICHARDSON DESIGN PARTNERSHIP, L.L.C.
 510 South 600 East
 Salt Lake City, Utah 84102
 P: 801.355.6868
 F: 801.355.6880

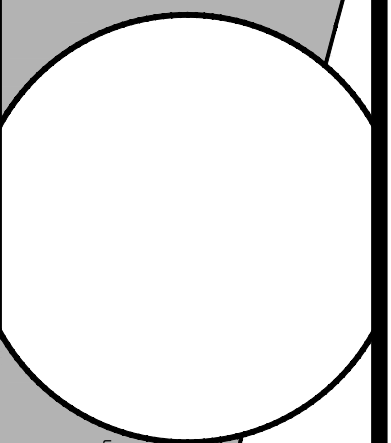

304 E. South St., Suite 400
 Salt Lake City, Utah 84102
 800.879.9707 / 801.355.6151
 www.spectrumengineers.com

SPECTRUM ENGINEERS

THE GRAPHIC MATERIAL AND DESIGN ON THIS SHEET ARE INSTRUMENTS OF SERVICE AND REMAIN AT ALL TIMES THE PROPERTY OF THE RICHARDSON AND DESIGN CONTAINED HEREIN IS PROHIBITED WITHOUT THE WRITTEN CONSENT OF THE RICHARDSON DESIGN PARTNERSHIP, L.L.C. ALL RIGHTS RESERVED.


MY PLACE EXTENDED STAY
 3 STORY - 64 GUESTROOM PROTOTYPE
 PROJECT:

DATE:	DESCRIPTION:


SITE PHOTOMETRICS
 PROJECT #
 E100P
 SHEET #

Markup Summary


dsdparsons (4)

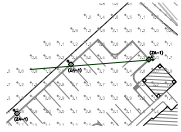


Subject: Arrow
Page Label: [1] 51E100P-PDF_22X34
Lock: Unlocked
Status:
Checkmark: Unchecked
Author: dsdparsons
Date: 8/29/2017 3:32:59 PM
Color: ■

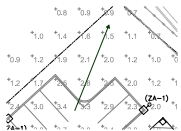

Subject: Arrow
Page Label: [1] 51E100P-PDF_22X34
Lock: Unlocked
Status:
Checkmark: Unchecked
Author: dsdparsons
Date: 8/29/2017 3:33:22 PM
Color: ■

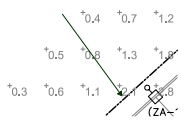

Subject: Arrow
Page Label: [1] 51E100P-PDF_22X34
Lock: Unlocked
Status:
Checkmark: Unchecked
Author: dsdparsons
Date: 8/29/2017 3:33:06 PM
Color: ■

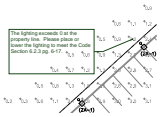

Subject: Callout
Page Label: [1] 51E100P-PDF_22X34
Lock: Unlocked
Status:
Checkmark: Unchecked
Author: dsdparsons
Date: 8/29/2017 3:32:48 PM
Color: ■


The lighting exceeds 0 at the property line. Please place or lower the lighting to meet the Code Section 6.2.3 pg. 6-17.

AutoCAD SHX Text (27)




Subject:
Page Label: [1] 51E100P-PDF_22X34
Lock: Unlocked
Status:
Checkmark: Unchecked
Author: AutoCAD SHX Text
Date:
Color: □

C

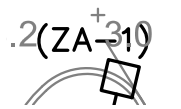


Subject:
Page Label: [1] 51E100P-PDF_22X34
Lock: Unlocked
Status:
Checkmark: Unchecked
Author: AutoCAD SHX Text
Date:
Color: □


(ZA-1)

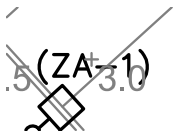


Subject:
Page Label: [1] 51E100P-PDF_22X34 (ZA-1)
Lock: Unlocked
Status:
Checkmark: Unchecked
Author: AutoCAD SHX Text
Date:
Color:

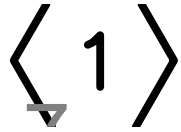


Subject:
Page Label: [1] 51E100P-PDF_22X34 1
Lock: Unlocked
Status:
Checkmark: Unchecked
Author: AutoCAD SHX Text
Date:
Color:

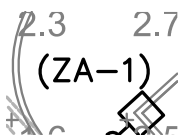


Subject:
Page Label: [1] 51E100P-PDF_22X34 (ZA-1)
Lock: Unlocked
Status:
Checkmark: Unchecked
Author: AutoCAD SHX Text
Date:
Color:

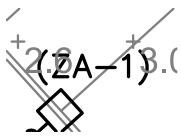

Subject:
Page Label: [1] 51E100P-PDF_22X34 (ZA-1)
Lock: Unlocked
Status:
Checkmark: Unchecked
Author: AutoCAD SHX Text
Date:
Color:

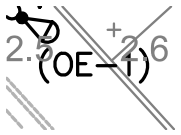

Subject:
Page Label: [1] 51E100P-PDF_22X34 (OE-1)
Lock: Unlocked
Status:
Checkmark: Unchecked
Author: AutoCAD SHX Text
Date:
Color:

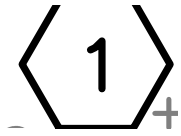

Subject:
Page Label: [1] 51E100P-PDF_22X34 1
Lock: Unlocked
Status:
Checkmark: Unchecked
Author: AutoCAD SHX Text
Date:
Color:

(ZA-1)
2.0

Subject: (ZA-1)
Page Label: [1] 51E100P-PDF_22X34
Lock: Unlocked
Status:
Checkmark: Unchecked
Author: AutoCAD SHX Text
Date:
Color:

20'

Subject: 20'
Page Label: [1] 51E100P-PDF_22X34
Lock: Unlocked
Status:
Checkmark: Unchecked
Author: AutoCAD SHX Text
Date:
Color:

10'

Subject: 10'
Page Label: [1] 51E100P-PDF_22X34
Lock: Unlocked
Status:
Checkmark: Unchecked
Author: AutoCAD SHX Text
Date:
Color:

ELECTRICAL SITE PLAN


Subject: ELECTRICAL SITE PLAN
Page Label: [1] 51E100P-PDF_22X34
Lock: Unlocked
Status:
Checkmark: Unchecked
Author: AutoCAD SHX Text
Date:
Color:

1. / 1.
(ZA-1)
2. 1 +1

Subject: (ZA-1)
Page Label: [1] 51E100P-PDF_22X34
Lock: Unlocked
Status:
Checkmark: Unchecked
Author: AutoCAD SHX Text
Date:
Color:

NORTH

Subject: NORTH
Page Label: [1] 51E100P-PDF_22X34
Lock: Unlocked
Status:
Checkmark: Unchecked
Author: AutoCAD SHX Text
Date:
Color:

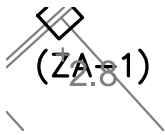


Subject:
Page Label: [1] 51E100P-PDF_22X34 (ZA-1)
Lock: Unlocked
Status:
Checkmark: Unchecked
Author: AutoCAD SHX Text
Date:
Color:



Subject:
Page Label: [1] 51E100P-PDF_22X34 SHEET KEYNOTES
Lock: Unlocked
Status:
Checkmark: Unchecked
Author: AutoCAD SHX Text
Date:
Color:



Subject:
Page Label: [1] 51E100P-PDF_22X34 SCALE: 1" = 20'-0"
Lock: Unlocked
Status:
Checkmark: Unchecked
Author: AutoCAD SHX Text
Date:
Color:

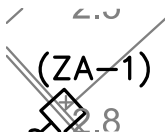

Subject:
Page Label: [1] 51E100P-PDF_22X34 (ZA-1)
Lock: Unlocked
Status:
Checkmark: Unchecked
Author: AutoCAD SHX Text
Date:
Color:



Subject:
Page Label: [1] 51E100P-PDF_22X34 C
Lock: Unlocked
Status:
Checkmark: Unchecked
Author: AutoCAD SHX Text
Date:
Color:



Subject:
Page Label: [1] 51E100P-PDF_22X34 0
Lock: Unlocked
Status:
Checkmark: Unchecked
Author: AutoCAD SHX Text
Date:
Color:




Subject:
Page Label: [1] 51E100P-PDF_22X34
Lock: Unlocked
Status:
Checkmark: Unchecked
Author: AutoCAD SHX Text
Date:
Color:

1. ROUTE CIRCUITS THROUGH EXTERIOR LIGHTING CONTROLLER. PROVIDE ROUTE CIRCUITS THROUGH EXTERIOR LIGHTING CONTROLLER. PROVIDE CONTROLLER.
 2. CONTRACTOR SHALL VERIFY ALL REQUIREMENTS WITH LOCAL POWER CONTRACTOR SHALL VERIFY ALL REQUIREMENTS WITH LOCAL POWER AND TELEPHONE UTILITY COMPANIES AND PROVIDE THE REQUIRED INFRASTRUCTURE FOR THE BUILDING. 3. COORDINATE TERMINATION POINT WITH POWER UTILITY FOR COORDINATE TERMINATION POINT WITH POWER UTILITY FOR CONNECTIONS TO TRANSFORMER AND WITH PHONE UTILITY FOR CONNECTIONS TO PHONE DEMARC IN DATA ROOM.




Subject:
Page Label: [1] 51E100P-PDF_22X34
Lock: Unlocked
Status:
Checkmark: Unchecked
Author: AutoCAD SHX Text
Date:
Color:

C

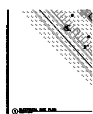

Subject:
Page Label: [1] 51E100P-PDF_22X34
Lock: Unlocked
Status:
Checkmark: Unchecked
Author: AutoCAD SHX Text
Date:
Color:

File Name:
 P:\2017\20170351\1Drawings\3Sheet\51E100P.dwg
 Last Plotted: 2017/06/02 @ 1:42 PM By: dgh

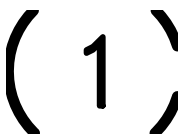


Subject:
Page Label: [1] 51E100P-PDF_22X34
Lock: Unlocked
Status:
Checkmark: Unchecked
Author: AutoCAD SHX Text
Date:
Color:

1



Subject:
Page Label: [1] 51E100P-PDF_22X34
Lock: Unlocked
Status:
Checkmark: Unchecked
Author: AutoCAD SHX Text
Date:
Color:

40'

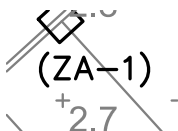

Subject:
Page Label: [1] 51E100P-PDF_22X34
Lock: Unlocked
Status:
Checkmark: Unchecked
Author: AutoCAD SHX Text
Date:
Color:

(ZA-1)

2.6 (ZA-2)8

Subject:
Page Label: [1] 51E100P-PDF_22X34 (ZA-1)
Lock: Unlocked
Status:
Checkmark: Unchecked
Author: AutoCAD SHX Text
Date:
Color: