



6/14/2018 6:53:42 PM

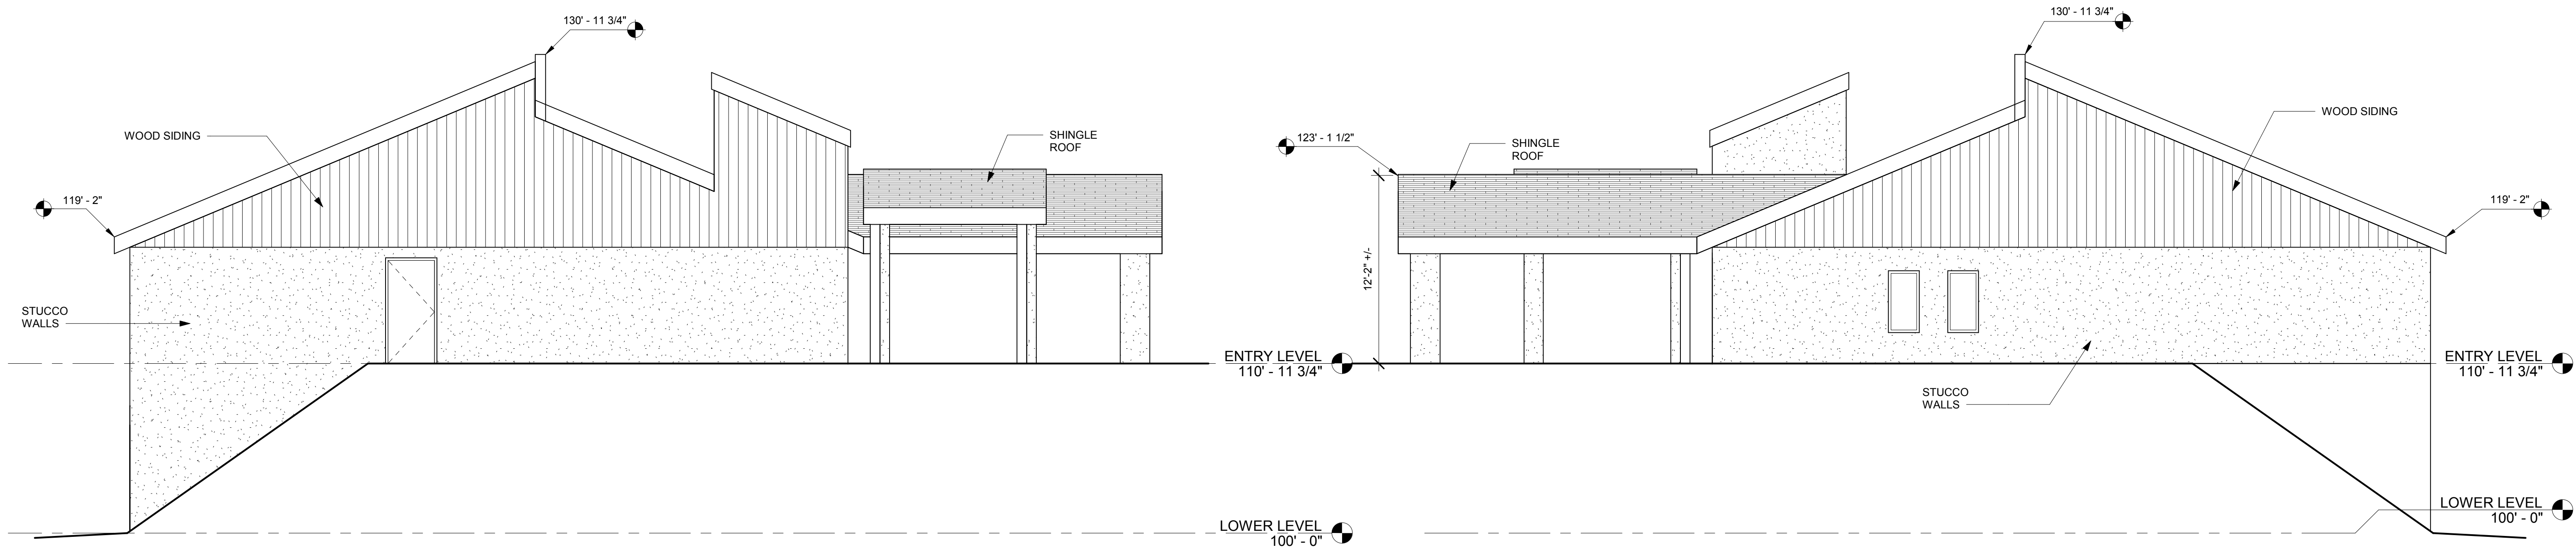


③ East
3/16" = 1'-0"

④ West
3/16" = 1'-0"

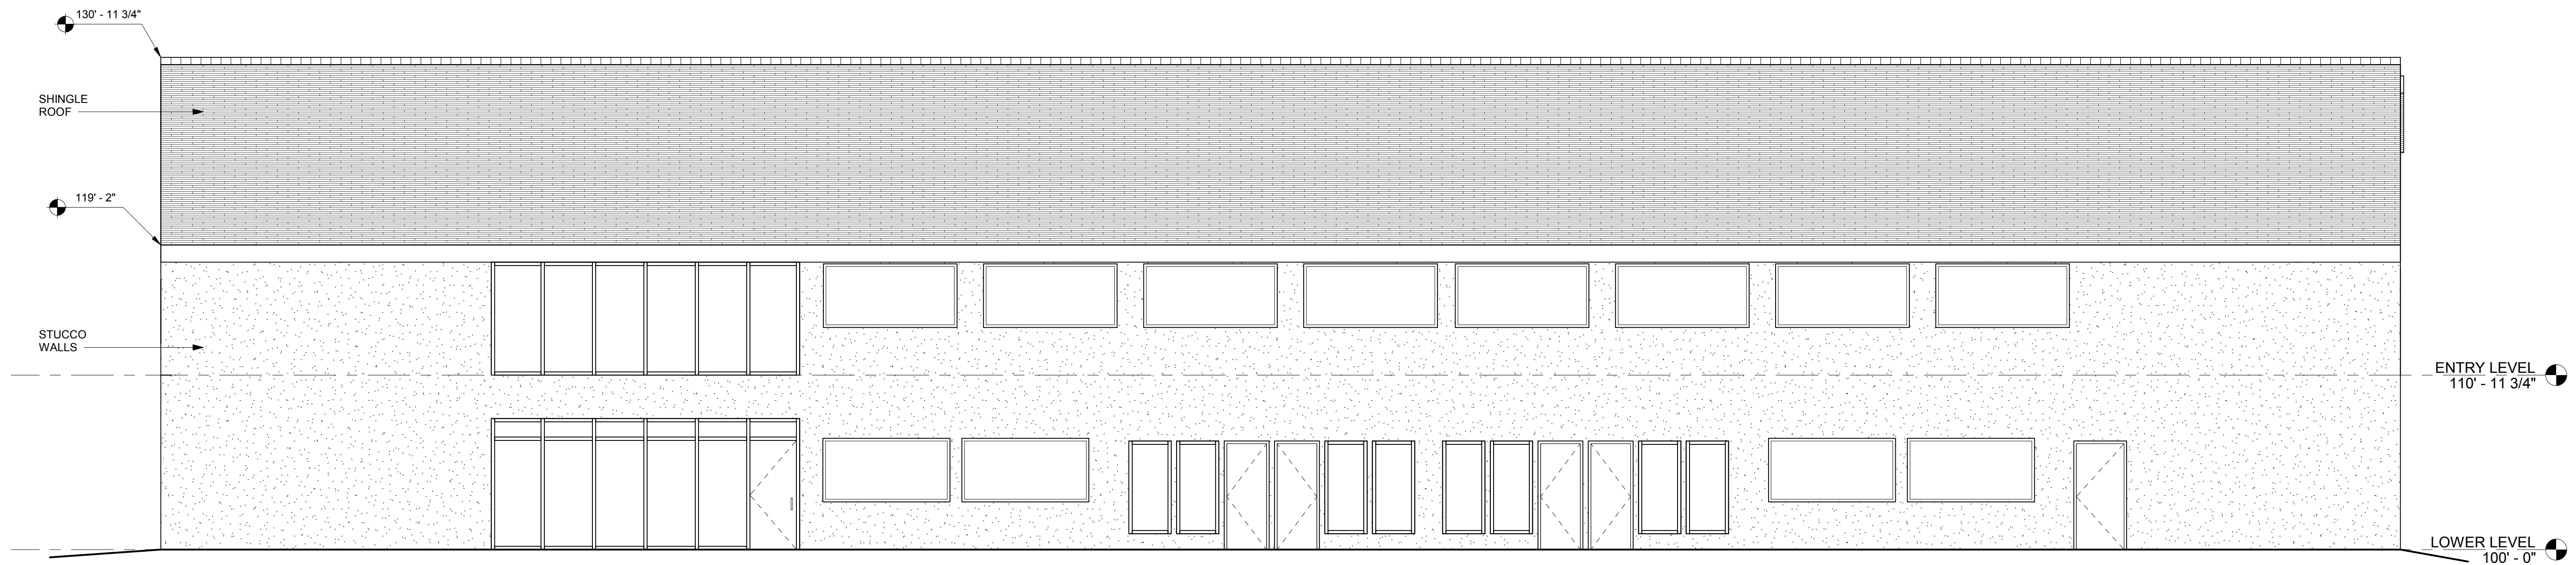

② South
3/16" = 1'-0"

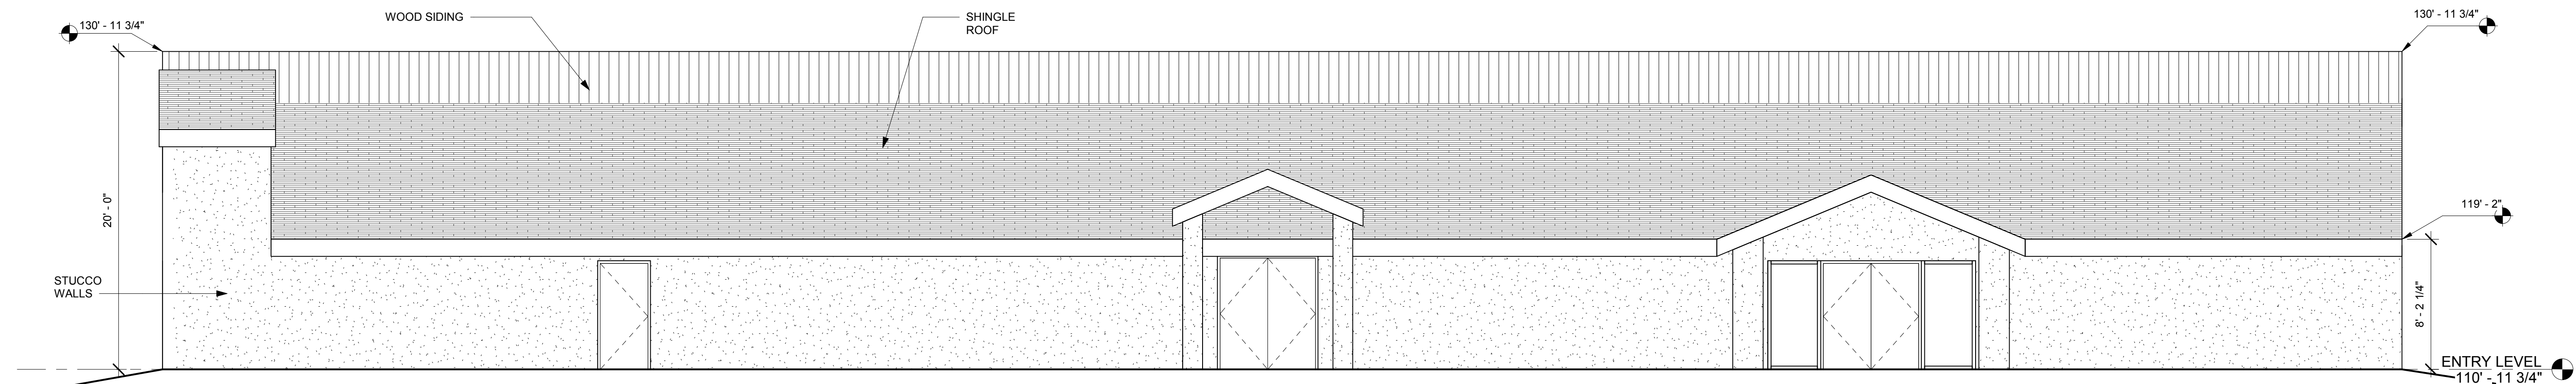

① North
3/16" = 1'-0"



YOW Architects PC

Architecture & Planning

115 S. Weber Colorado Springs, Colorado 719-475-8133

NOT FOR
CONSTRUCTION

1865 Woodmoor Dr - Clubhouse

1865 Woodmoor Dr
Monument, CO
AS BUILT

Project Number
18.195

Date
6.14.18

Revisions

Drawn By
ATT
Checked By
YOW

A1.2
Building Elevations

Scale
3/16" = 1'-0"



YOW Architects PC

Architecture & Planning

115 S. Weber Colorado Springs, Colorado 719-475-8133

NOT FOR
CONSTRUCTION

1865 Woodmoor Drive -
Building A - Aspen
1865 Woodmoor Dr
Monument, CO
AS BUILT

Project Number
18.195

Date
6.14.18
Revisions

Drawn By
ATT
Checked By
YOW

A5.1
Building Elevations


Scale
3/16" = 1'-0"



④ East
3/16" = 1'-0"



③ West
3/16" = 1'-0"

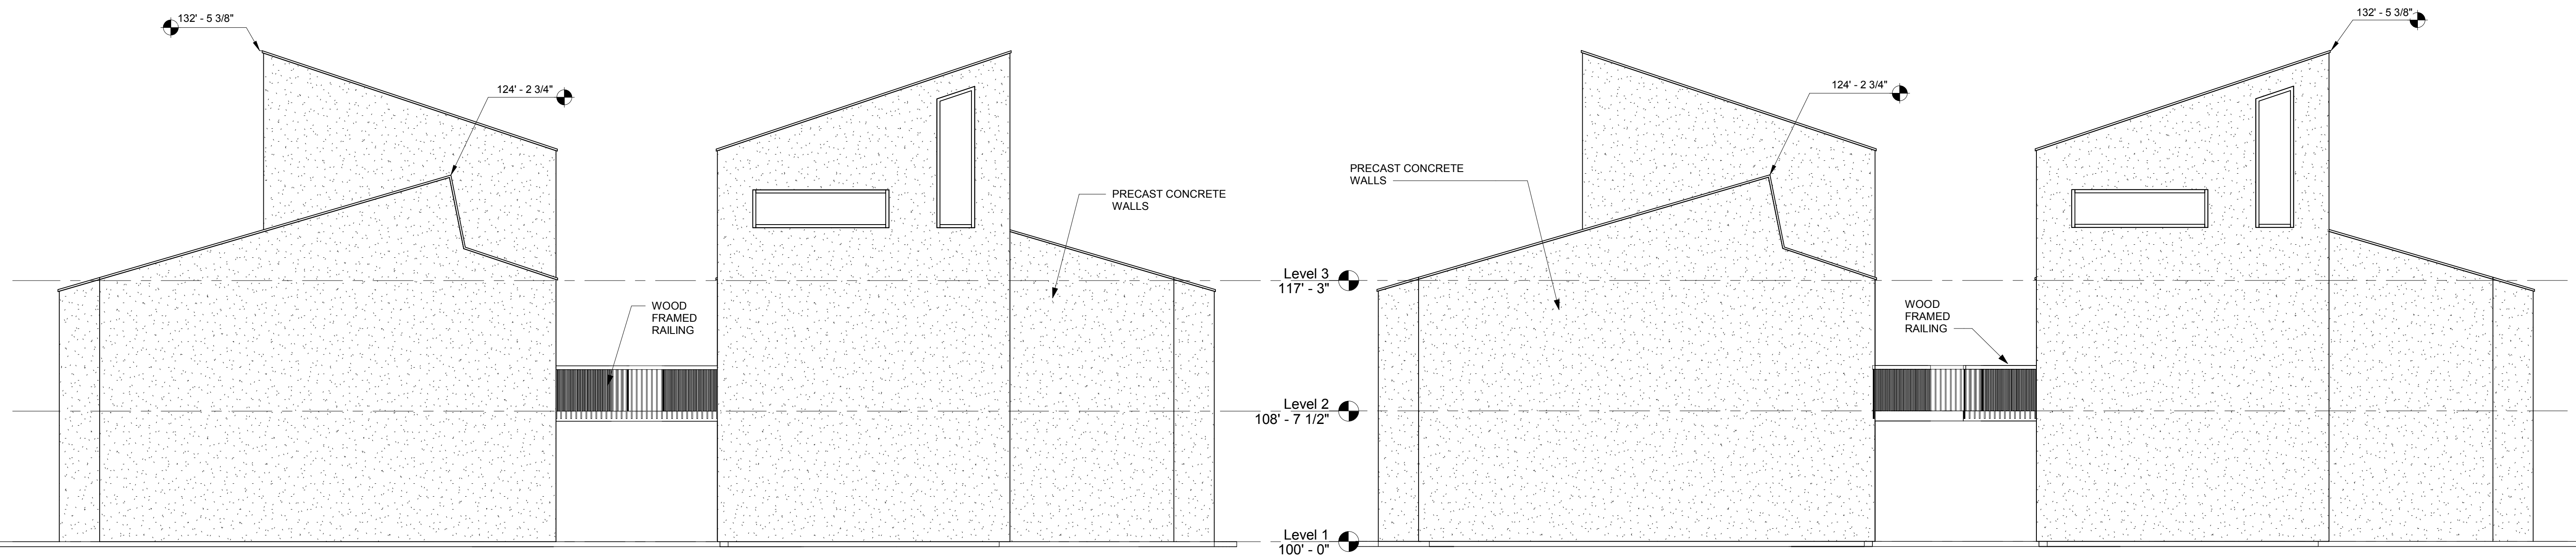

② South
3/16" = 1'-0"

① North
3/16" = 1'-0"

6/14/2018 10:33:17 PM