



2 ADA / STANDARD PARKING  
SCALE: 1/8"=1'-0"

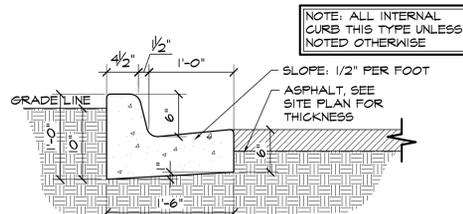


3 EPC TYPE B CURB  
SCALE: 1"=1'-0"

ADA Route to building entrance required to be shown on map from handicap parking spot.


Must have this note:  
The parties responsible for this plan have familiarized themselves with all current accessibility criteria and specifications and the proposed plan reflects all site elements required by the applicable ADA design standards and guidelines as published by the United States Department of Justice. Approval of this plan by El Paso County does not assure compliance with the ADA or any regulations or guidelines enacted or promulgated under or with respect to such laws.

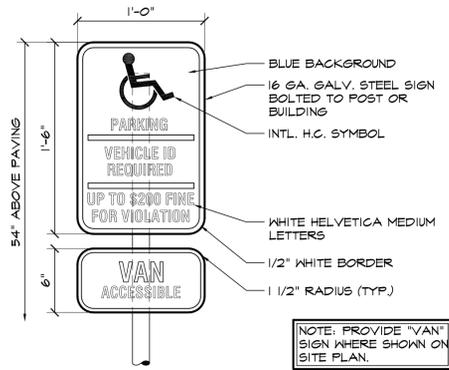



6 HANDICAPPED PARKING SIGN  
SCALE: 1 1/2"=1'-0"

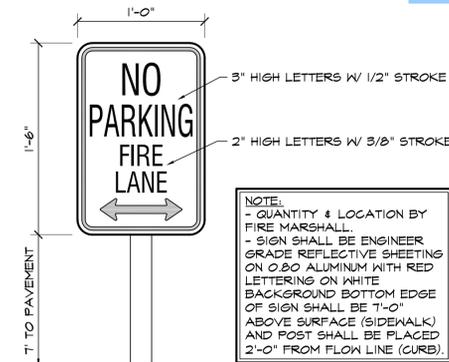


7 FIRE LANE SIGN  
SCALE: 1 1/2"=1'-0"

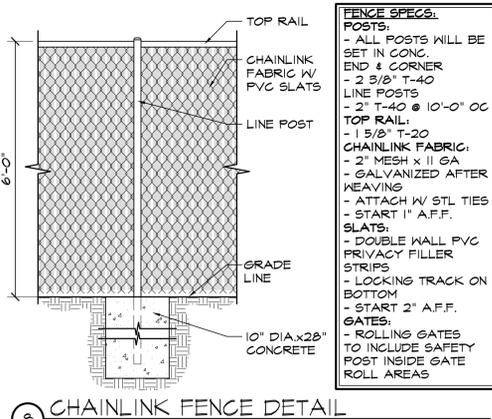


8 CHAINLINK FENCE DETAIL  
SCALE: 1/2"=1'-0"

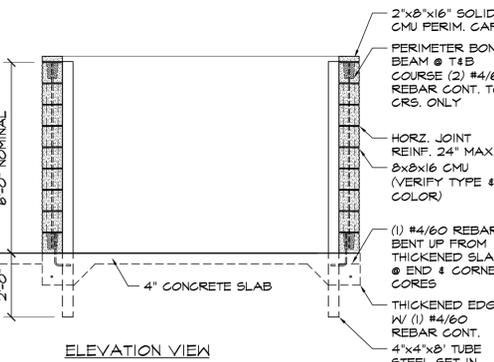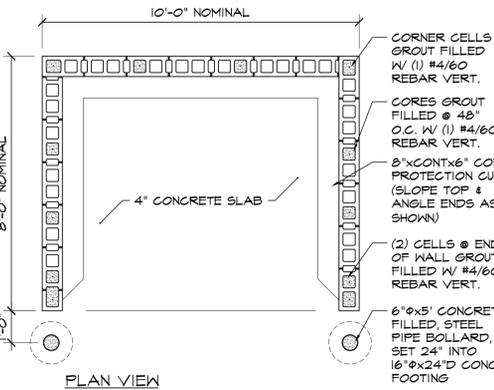

5 CMU TRASH ENCLOSURE DETAIL  
SCALE: 3/8"=1'-0"

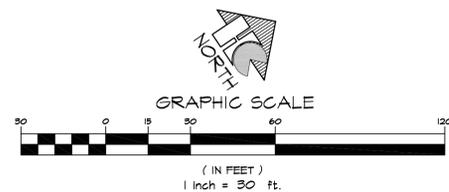

Show and label the easements

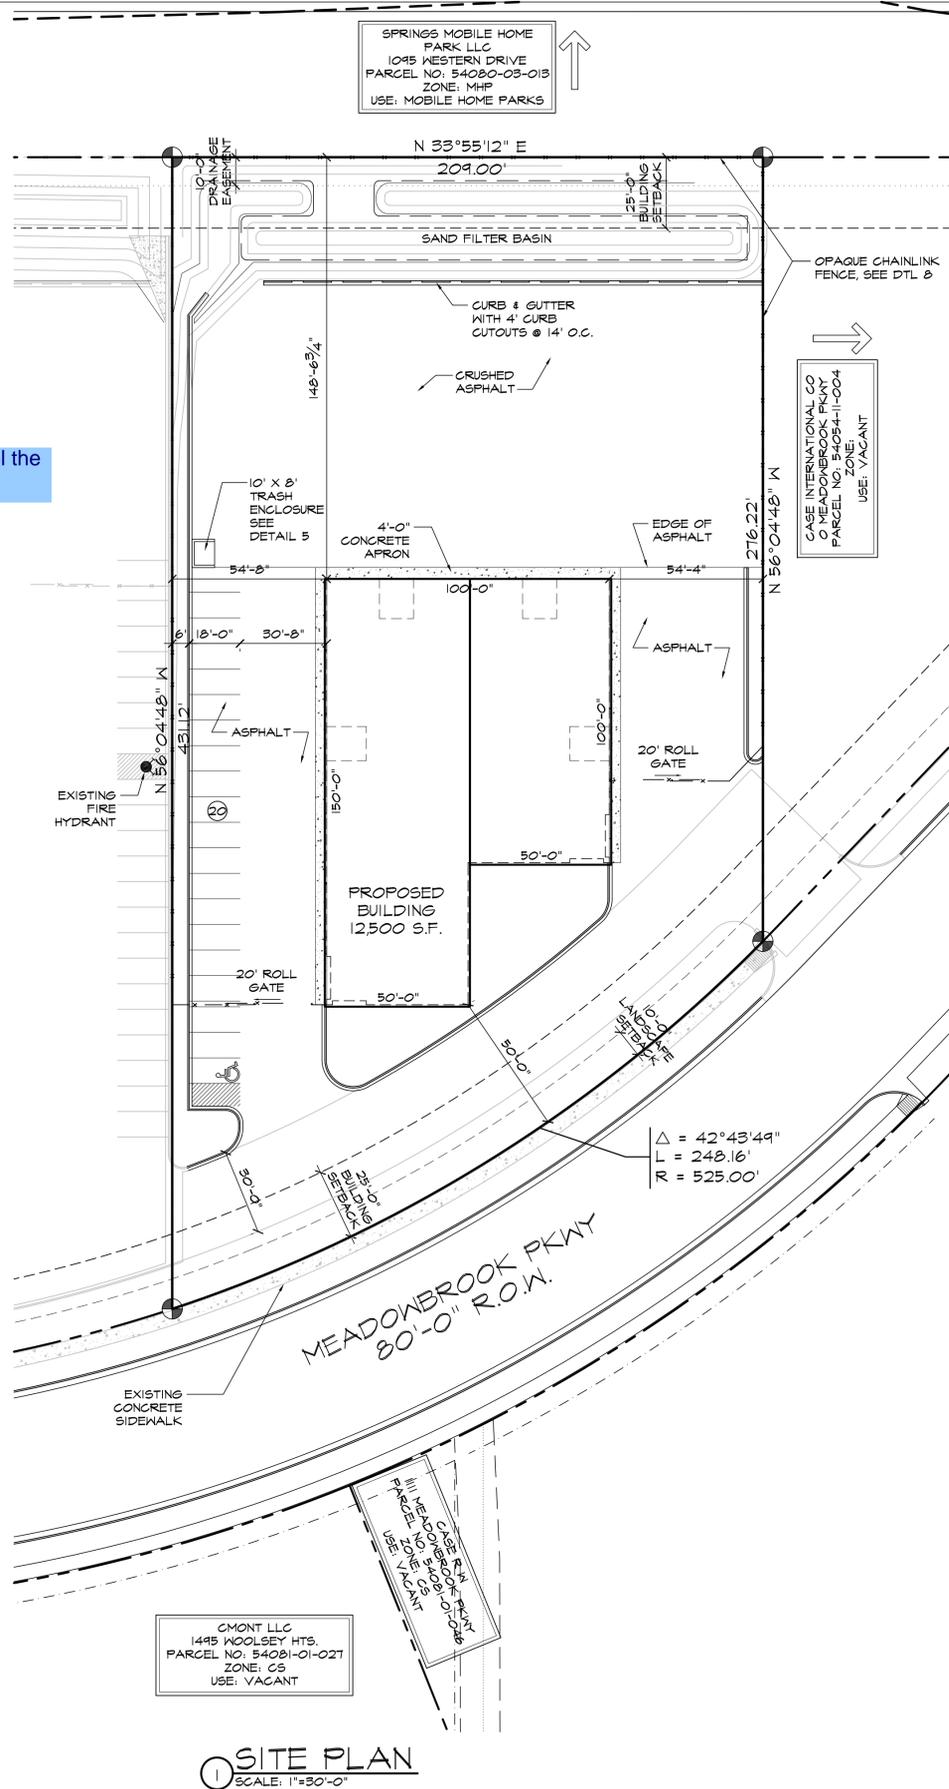


1 SITE PLAN  
SCALE: 1"=30'-0"

DRAWING INDEX

- 1 OF 10 - SITE PLAN & DETAILS, PROJECT INFORMATION, DRAWING INDEX
- UI: 2 OF 10 - UTILITY SERVICE PLAN
- CI: 3 OF 10 - GRADING & EROSION CONTROL PLAN
- C2: 4 OF 10 - EROSION CONTROL PLAN DETAILS
- C3: 5 OF 10 - EROSION CONTROL PLAN DETAILS
- LP-01: 6 OF 10 - LANDSCAPE PLAN
- LP-02: 7 OF 10 - LANDSCAPE DETAILS
- ES-1: 8 OF 10 - PHOTOMETRIC PLAN
- ES-2: 9 OF 10 - PHOTOMETRIC DETAILS
- 10 OF 10 - BUILDING ELEVATIONS

VICINITY MAP

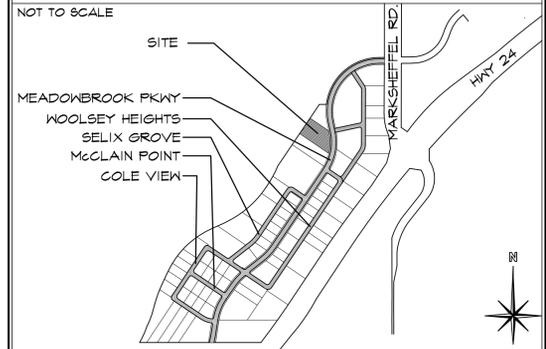

PROJECT INFORMATION

<b>PROPERTY INFORMATION</b>	
OWNER NAME:	HAMMERS CONSTRUCTION, INC 1411 WOOLSEY HEIGHTS COLORADO SPRINGS, CO 80915
LEGAL DESCRIPTION:	LOT 2 PADMARK BUSINESS PARK, FIL NO 1
PARCEL NUMBER:	54081-02-051
ZONING:	C5
LOT SIZE:	73,657 SF (1.69 ACRES)
CURRENT USE:	VACANT
FLOODPLAIN STATEMENT:	ZONE X (MAP NO: 0804COT56F, DATED MARCH 17, 1997)
<b>BUILDING INFORMATION</b>	
NEW BUILDING AREA:	12,500 SF
BUILDING OCCUPANCY:	B/S-2
TYPE OF CONSTRUCTION:	11-B
FIRE SYSTEMS:	NOT SPRINKLED
AREA SEPARATION WALLS:	NONE
<b>ZONING CODE STUDY</b>	
PROPOSED PRINCIPAL USE:	OFFICE WAREHOUSE
STRUCTURAL COVERAGE OF LOT:	17%
PAVEMENT COVERAGE:	12%
NEW BUILDING STRUCTURAL HEIGHT:	19'-0" 3/8"
FRONT YARD SETBACK:	25'-0"
SIDE YARD SETBACK:	0'-0"
REAR YARD SETBACK:	25'-0"
<b>REQUIRED PARKING SPACES</b>	
OFFICE-(1 SPACE/200 SF)	6
1,500 / 200 SF	8
WAREHOUSE-(1 SPACE/1,000 SF)	12
11,000 / 1,000 SF	11
H.C.-(1 SPACE/25 REOP)	1
TOTAL PARKING SPACES REQUIRED:	20
TOTAL PARKING PROVIDED:	20
NEW STANDARD SPACES PROVIDED:	19
H.C. SPACES PROVIDED:	1
LOADING SPACE PROVIDED:	14'x18' AREA PROVIDED
(SEE DETAIL 2 FOR DIMENSIONS)	
<b>DEVELOPMENT SCHEDULE</b>	
CONSTRUCTION:	SUMMER 2018
LANDSCAPING:	SUMMER 2018
<b>DEVELOPMENT APPLICANT</b>	
COMPANY:	HAMMERS CONSTRUCTION, INC. 1411 WOOLSEY HEIGHTS COLO. SPGS, CO 80915 (719)-510-1549
PHONE NUMBER:	(719)-510-1549
FAX NUMBER:	(719)-510-1008
APPLICANT NAME:	LISA PETERSON
APPLICANT E-MAIL:	lpeterson@hammersconstruction.com

SITE LEGEND

---	PROPERTY LINE
---	RIGHT OF WAY
---	BUILDING SETBACK
---	LANDSCAPE SETBACK
---	UTILITY EASEMENT
---	DRAINAGE EASEMENT
---	CONSTRUCTION LIMIT LINE
---	ACCESS EASEMENT
---	OPAQUE CHAINLINK FENCE
---	6' HIGH AROUGHT IRON FENCE
---	GAS LINE
---	WATER LINE
---	ELECTRICAL LINE
---	SANITARY SEWER LINE
---	STORM SEWER LINE
---	RETAINING WALL
---	NEW SIDEWALK LOCATIONS W/ CONTROL JOINTS @ 5'-0" O.C.
●	PROPERTY CORNER
→	TRAFFIC FLOW
□	WALL PACK LIGHTING
—	SIGN
○	MANHOLE
○	EXISTING FIRE HYDRANT
○	PROPOSED FIRE HYDRANT
□	ELECTRICAL TRANSFORMER

**HAMMERS CONSTRUCTION INC.**  
COMMERCIAL GENERAL CONTRACTORS SPECIALIZING IN DESIGN/BUILD  
PRESIDENT: STEVE R. HAMMERS  
VICE PRES: DAVID J. HAMMERS  
1411 WOOLSEY HEIGHTS  
COLORADO SPRINGS, CO 80915  
(719) 510-1599 FAX (719) 510-7008  
www.hammersconstruction.com

THIS DRAWING CONTAINS MATERIAL & INFORMATION WHICH MAY NOT BE REPRODUCED WITHOUT WRITTEN CONSENT OF HAMMERS CONSTRUCTION, INC. THESE DRAWINGS ARE INTENDED TO BE USED ONLY BY HAMMERS CONSTRUCTION & ITS REPRESENTATIVES. THESE DRAWINGS HAVE NOT BEEN PREPARED FOR ANY OTHER PURPOSE THAN TO INDICATE THE GENERAL FEATURES AND PLACEMENT OF THE PROPOSED PROJECT. COPYRIGHT © 2018 HAMMERS CONSTRUCTION

**PAD-2**  
PADMARK BUSINESS PARK-LOT 2-1  
1150 MEADOWBROOK PKWY  
COLORADO SPRINGS, CO 80915  
EL PASO COUNTY, COLORADO

DATE: MAY 8, 2018  
DRAWN BY: L. PETERSON  
PROJ. MGR: Z. GRABTREE  
SCALE: SEE PLAN  
APPROVED BY:  
JOB NO: 1059

RESUBMITTALS:  
▲  
▲  
1 of 10  
SITE PLAN

# Markup Summary

---

## dsdlaforce (1)

---

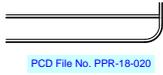

**Subject:** Text Box  
**Page Label:** 1  
**Author:** dsdlaforce  
**Date:** 6/5/2018 4:08:19 PM  
**Color:** ■

PCD File No. PPR-18-020

---

## dsdkendall (1)

---



**Subject:** Text Box  
**Page Label:** 1  
**Author:** dsdkendall  
**Date:** 6/1/2018 11:09:40 AM  
**Color:** ■

ADA Route to building entrance required to be shown on map from handicap parking spot,.

Must have this note :  
The parties responsible for this plan have familiarized themselves with all current accessibility criteria and specifications and the proposed plan reflects all site elements required by the applicable ADA design standards and guidelines as published by the United States Department of Justice. Approval of this plan by El Paso County does not assure compliance with the ADA or any regulations or guidelines enacted or promulgated under or with respect to such laws.

---

## dsdgrimm (1)

---



**Subject:** Engineer  
**Page Label:** 1  
**Author:** dsdgrimm  
**Date:** 6/5/2018 4:24:35 PM  
**Color:** ■

Show and label the easements