

KNOW ALL MEN BY THESE PRESENTS:

That Meadowbrook Development LLC, being the owner of the following described tract of land to wit: TRACTS J, K & L MEADOWBROOK CROSSING FILING NO. 1, EL PASO COUNTY, COLORADO Parcels total 4.095 acres.

OWNERS CERTIFICATE:

The undersigned, being all the owners, mortgagees, beneficiaries of deeds of trust and holders of other interests in the land described herein, have laid out, subdivided, and plotted said lands into lots, and easements as shown herein under the name and subdivision of MEADOWBROOK CROSSING FILING NO. 2. All public improvements so planned are hereby dedicated to public use and said owner does hereby covenant and agree that the public improvements will be constructed to El Paso County standards and that proper drainage and erosion control for same will be provided at said owner's expense, all to the satisfaction of the Board of County Commissioners of El Paso County, Colorado. Upon acceptance by resolution, all public improvements so dedicated will become matters of maintenance by El Paso County, Colorado. The utility easements shown hereon are hereby dedicated for public utilities and communication systems and other purposes as shown hereon. The entities responsible for providing the services for which the easements are established are hereby granted the perpetual right of ingress and egress from and to adjacent properties for installation, maintenance, and replacement of utility lines and related facilities.

Meadowbrook Development, LLC
By: \_\_\_\_\_
Title: \_\_\_\_\_

STATE OF \_\_\_\_\_ }
COUNTY OF \_\_\_\_\_ } SS
The above and aforementioned was acknowledged before me this \_\_\_\_\_ day of \_\_\_\_\_, 2018, by \_\_\_\_\_
Witness my hand and seal \_\_\_\_\_
Address \_\_\_\_\_
My Commission expires \_\_\_\_\_

EASEMENTS:

Unless otherwise indicated all side, front, and rear lot lines are hereby platted on either side with a five foot (5') public utility and drainage easement, unless otherwise indicated. All exterior subdivision boundaries are hereby platted with a seven foot (7') public utility and drainage easement. The sole responsibility for maintenance of these easements is hereby vested with the individual property owner.

FEES:

Drainage Fee: \_\_\_\_\_ School Fee: \_\_\_\_\_
Bridge Fee: \_\_\_\_\_ Urban Park Fee: \_\_\_\_\_
Regional Park Fee: \_\_\_\_\_

MEADOWBROOK CROSSING FILING NO. 2

A REPLAT OF TRACTS J, K, AND L, MEADOWBROOK OF CROSSING FILING NO. 1 BEING A PORTION OF THE SOUTH 1/2 OF SECTION 8, TOWNSHIP 14 SOUTH, RANGE 65 WEST OF THE 6TH P.M. EL PASO COUNTY, STATE OF COLORADO.

Note must be revised prior to plat recordation to reflect the approved LOMR

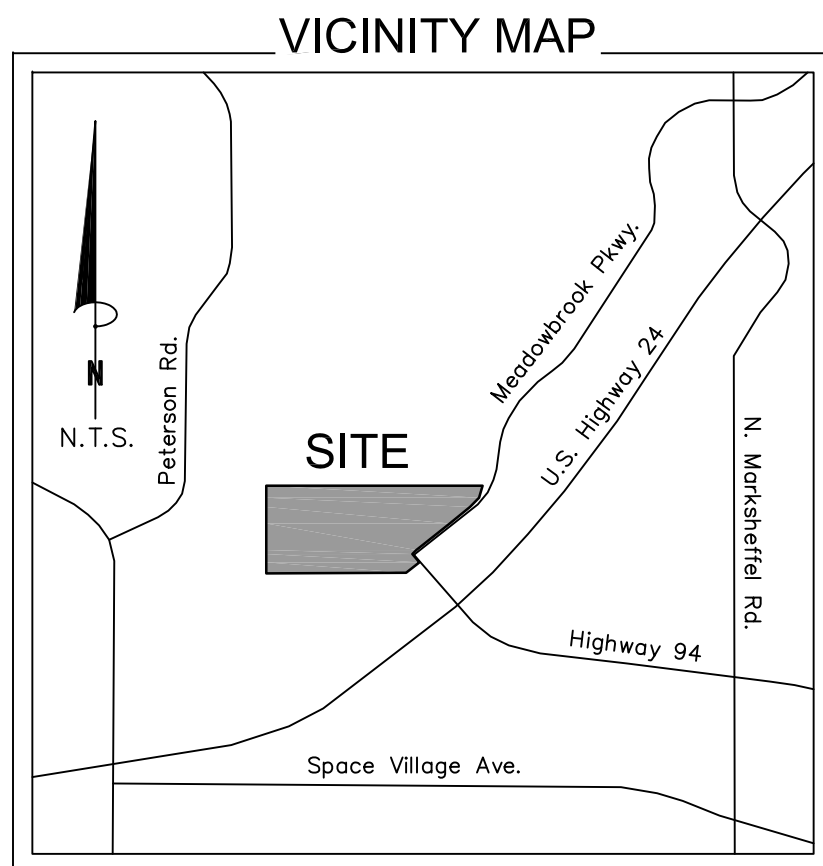


Table with 4 columns: Final total gross acreage, Total Number of lots, Net acreage of subdivision, Net acreage land to be dedicated for public streets. Values: 4.095, 35, 4.095, 0.

ASSESSOR'S CERTIFICATE:

The attached plat of MEADOWBROOK CROSSING FILING NO. 2 is approved by the Assessor's Office of El Paso County, Colorado the \_\_\_\_\_ day of \_\_\_\_\_, 2018. Steve Schleiker

PLANNING AND COMMUNITY DEVELOPMENT:

Approval is granted for this plat of MEADOWBROOK CROSSING FILING NO. 2 on this \_\_\_\_\_ day of \_\_\_\_\_, 2018. Director of Planning and Community Development

Replace "Development Services Department" with "Planning and Community Development Department"

BOARD OF COUNTY COMMISSIONERS CERTIFICATE:

The attached plat of MEADOWBROOK CROSSING FILING NO. 2 is approved by the Board of County Commissioners of El Paso County, Colorado the \_\_\_\_\_ day of \_\_\_\_\_, 2018. President

OWNER:

Meadowbrook Development LLC
90 S. Cascade Ave, Suite 1500
Colorado Springs, CO 80903

RECORDING:

STATE OF COLORADO }
COUNTY OF EL PASO } SS
I hereby certify that this instrument was filed for record in my office at \_\_\_\_\_ o'clock \_\_\_\_\_M., this \_\_\_\_\_ day of \_\_\_\_\_, 2018, A.D., and is duly recorded under Reception No. \_\_\_\_\_ of the records of El Paso County, Colorado. SURCHARGE: \_\_\_\_\_ CHUCK BROERMAN, RECORDER FEE: \_\_\_\_\_ BY: \_\_\_\_\_ Deputy

NOTES:

- 1. This survey does not constitute a title search by Clark Land Surveying, Inc. to determine ownership or easements of record. For all information regarding easements, rights-of-way and title of record, Clark Land Surveying, Inc. relied upon a Title Insurance Policy, prepared by OLD REPUBLIC NATIONAL TITLE INSURANCE COMPANY, Commitment No. SC55057698-2, effective date 05-31-2016 at 5:00 P.M.
2. Basis of bearings is north line of the south half of Sec. 8, T14S, R65W of the 6th P.M., monumented at both ends by a 3/4" Brass Cap in range box and assumed to bear N89°43'13"E.
3. FEDERAL EMERGENCY MANAGEMENT AGENCY, FEMA Flood Insurance Rate Map, Map Number 08041C752F with effective dates MARCH 17, 1997, indicates this parcel of land is located in Zone X (area determined to be out of the 500 year flood plain) & in Zone AE (special flood hazard area inundated by 100 year flood). A CLOMR has been reviewed and approved by FEMA issued May 12, 2017, Case No. 17-08-0333R to provide channel improvements and revise the floodplain limits. Portions of the channel and floodplain to the northeast of this site have been mitigated per an existing LOMR, Case No. 06-08-B137p, effective December 13, 2006. No structures or solid fences are permitted within the designated Floodplain area.
4. Easements and other record documents shown or noted on this survey were examined as to location and purpose and were not examined as to restrictions, exclusions, conditions, obligations, terms, or as to the right to grant the same.
5. The lined units used in this drawing are U.S. Survey Feet.
6. No driveway shall be established unless an access permit has been granted by El Paso County.
7. Mailboxes shall be installed in accordance with all El Paso County and United States Postal Service regulations.
8. Any person who knowingly removes, alters, or defaces any public land survey monument or land boundary monument or accessory commits a Class Two (2) misdemeanor pursuant to C.R.S. §16-4-508.
9. All property owners are responsible for maintaining proper storm water drainage in and through their property. Public drainage easements as specifically noted on the plat shall be maintained by the individual lot owners unless otherwise indicated. Structures, fences, materials or landscaping that could impede the flow of runoff shall not be placed in drainage easements.
10. Developer shall comply with federal and state laws, regulations, ordinances, review and permit requirements, and other agency requirements, if any, of applicable agencies including, but not limited to, the Colorado Division of Wildlife, Colorado Department of Transportation, U.S. Army Corps of Engineers and the U.S. Fish and Wildlife Service regarding the Endangered Species Act, particularly as it relates to the listed species (e.g., Preble's Meadow Jumping Mouse).
11. The addresses exhibited on this plat are for informational purposes only. They are not the legal description and are subject to change.
12. No lot or interest therein shall be sold, conveyed, or transferred whether by deed or by contract, nor shall building permits be issued, until and unless either the required public and common development improvements have been constructed and completed and preliminarily accepted in accordance with the Subdivision Improvements Agreement between the applicant/owner and El Paso County as recorded under Reception Number \_\_\_\_\_ in the Office of the Clerk and Recorder of El Paso County, Colorado or, in the alternative, other collateral is provided to make provision for the completion of said improvements in accordance with the El Paso County Land Development Code and Engineering Criteria Manual. Any such alternative collateral must be approved by the Board of County Commissioners or, if permitted by the Subdivision Improvements Agreement, by the Development Services Department Director and meet the policy and procedure requirements of El Paso County prior to the release by the County of any lots for sale, conveyance or transfer. This plat restriction may be removed or rescinded by the Board of County Commissioners or, if permitted by the Subdivision Improvements Agreement, by the Development Services Department Director upon either approval in alternate form of collateral or completion and preliminary acceptance by the El Paso Board of County Commissioners of all improvements required to be constructed and completed in accordance with said Subdivision Improvements Agreement. The partial release of lots for sale, conveyance or transfer may only be granted in accordance with any planned partial release of lots authorized by the Subdivision Improvements Agreement.
13. Meadowbrook Development LLC shall be responsible for final design, construction, and maintenance of private detention pond/water quality BMP(s) as described in the approved Preliminary/Final Drainage Report for this subdivision. Final design, construction drawings and drainage report updates for the detention pond/water quality BMP(s) serving each lot shall be provided with Site Development Plan submittals. The detention pond/water quality BMP(s) shall be constructed and completed prior to the issuance of any building permits for the subject lots. The subdivision developer is responsible for providing financial assurances as indicated in the Subdivision Improvements Agreement and Estimate of Guaranteed Funds for all detention ponds/water quality BMPs. All detention ponds/water quality BMPs shall be constructed prior to the release of said financial assurances.
14. Meadowbrook Development LLC shall enter into a Private Detention Basin/Stormwater Quality BMP Maintenance Agreement and Easement ("Agreement") prior to the issuance of any building permits for the subject lots. In the case that the developer constructs the detention pond(s), the developer shall enter into an Agreement for each pond constructed.
15. NOTICE OF POTENTIAL AIRCRAFT OVERFLIGHT AND NOISE IMPACT ASSOCIATED WITH AIRPORT: This serves as notice of potential aircraft overflight and noise impacts on this property due to its close proximity to an airport, which is being disclosed to all prospective purchasers considering the use of this property for residential and other purposes. This property is subject to the overflight and associated noise of arriving and departing aircraft during the course of normal airport operations. An easement will be provided at the final plat stage. All property within this subdivision is subject to a Notice of Potential Aircraft Overflight and Noise Impact recorded at Reception No. \_\_\_\_\_ of the records of the El Paso County Clerk and Recorder. All property within this subdivision is subject to an Aviation Easement as recorded at Reception No. 217030936 of the records of the El Paso County Clerk and Recorder.
16. There shall be no direct lot access to Meadowbrook Parkway and U.S. Highway 24.
17. The Subdivider(s) agrees on behalf of him/herself and any developer or builder successors and assigns that Subdivider and/or said successors and assigns shall be required to pay traffic impact fees in accordance with the El Paso County Road Impact Fee Program Resolution (Resolution No. 12-382), or any amendments thereto, at or prior to the time of building permit submittals. The fee obligation, if not paid at final plat recording, shall be documented on all sales documents and on plat notes to ensure that a title search would find the fee obligation before sale of the property.
18. Pursuant to Resolution 12-416, approved by the Board of Directors, El Paso County Public Improvements District 2 and recorded in the records of the El Paso County Clerk and Recorder at Reception Number \_\_\_\_\_, the parcels within the platted boundaries of MEADOWBROOK CROSSING are included with the boundaries of the El Paso County Public Improvements District 2 and as such is subject to applicable fees and mill levy.
19. The following reports have been submitted in association with the Preliminary Plan or Final Plat for this subdivision and are on file at the County Development Services Department: Transportation Impact Study; Drainage Report; Water Resources Report; Wastewater Disposal Report; Geology and Soils Report; Fire Protection Report; Wildfire Hazard Report; Natural Features Report.
20. All property within this subdivision is subject to a Declaration of Covenants as recorded at Reception No. \_\_\_\_\_ of the records of the El Paso County Clerk and Recorder.
21. The property is within the Service Area of the Central Marksheffel Metropolitan District and, as such, is subject to an assessment for the construction of Marksheffel Road.
22. There are 35 single-family residential lots platted within this subdivision served by Cherokee Metropolitan District, Colorado Springs Utilities, Century Link, Cimarron Hills Fire Department, El Paso County Sheriff's Department.
23. The following have been found to be impacted by geologic hazards: Tracts E, F, G, H, I, J, K, and L have been found to potentially be impacted by shallow groundwater. Mitigation measures and a map of the hazard area can be found in the report Geologic Hazards Evaluation and Preliminary Geotechnical Investigation by CTL Thompson, Inc., Project No. CS18620-105 dated December 9, 2016 in File No. AP-17-002 available at the El Paso County Planning and Community Development Department.

Add reception no from FIL 1 plat No new SIA will occur with this filing

Add reception no from FIL 1 plat

16-454

Add File Nos SP172 & SF172

This is a replat of J,K, & L no new tracts are being proposed. Identify specific constraints relative to the new lot numbers.

SURVEYOR'S CERTIFICATION:

I Stewart L. Mapes, Jr., a duly registered Professional Land Surveyor in the State of Colorado, do hereby certify that this plat truly and correctly represents the results of a survey made on August 12, 2016, by me or under my direct supervision and that all monuments exist as shown hereon; that mathematical closure errors are less than 1:10,000; and that said plat has been prepared in full compliance with all applicable laws of the State of Colorado dealing with monuments, subdivision, or surveying of land and all applicable provisions of the El Paso County Land Development Code.

This statement is neither a warranty nor guarantee, either expressed or implied.

I attest the above on this \_\_\_\_\_ day of \_\_\_\_\_, 2018.

Stewart L. Mapes, Jr.
Colorado Professional Land Surveyor No. 38245
For and on behalf of Clark Land Surveying, Inc.

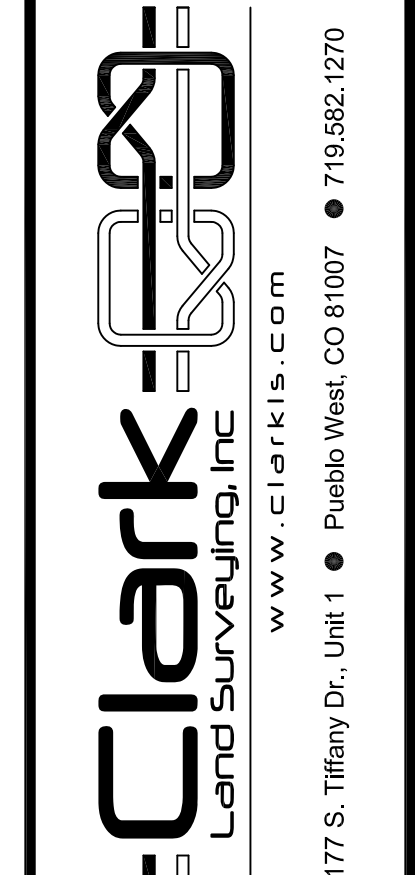


Table with 3 columns: Revisions, Description, No. Rows for Date, By, and No.

Notice: According to Colorado law you must commence legal action to correct any defect in this survey within three years after you first discover such defect. In no event may any action based upon any defect in this survey be commenced more than ten years from the date of the certification shown hereon.



MEADOWBROOK CROSSING FILING NO. 2
A REPLAT OF TRACTS J, K, & L, MEADOWBROOK CROSSING FILING NO. 1, EL PASO COUNTY, COLORADO
Project No. 170900
Date: 11/29/2017
Sheet 1 of 3
Drawn By: BCR
Checked By: SLM

# MEADOWBROOK CROSSING FILING NO. 2

A REPLAT OF TRACTS J, K, AND L,  
MEADOWBROOK OF CROSSING FILING NO. 1  
BEING A PORTION OF THE SOUTH 1/2 OF SECTION 8,  
TOWNSHIP 14 SOUTH, RANGE 65 WEST OF THE 6TH P.M.  
EL PASO COUNTY, STATE OF COLORADO.

AS PLATTED

- LEGEND
- FOUND PLSS MONUMENT, AS NOTED
  - FOUND BOUNDARY MONUMENT, AS NOTED
  - SET BOUNDARY MONUMENT, #5 REBAR W/ 1/4" PLASTIC CAP, "PLS 38245"
  - BOUNDARY LINE
  - - - ADJACENT LOT LINE
  - - - - EASEMENT LINE

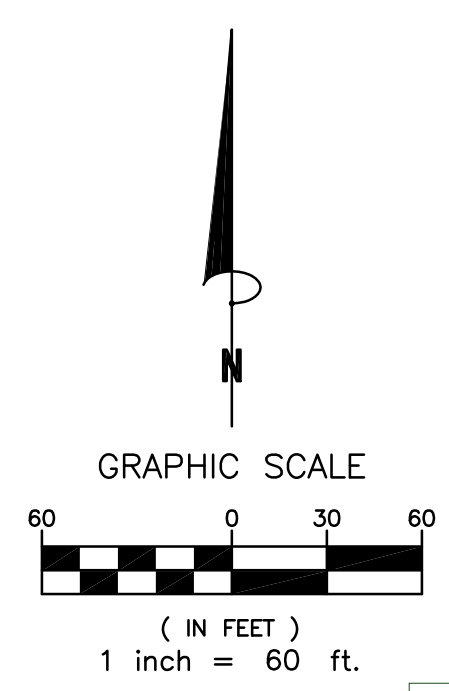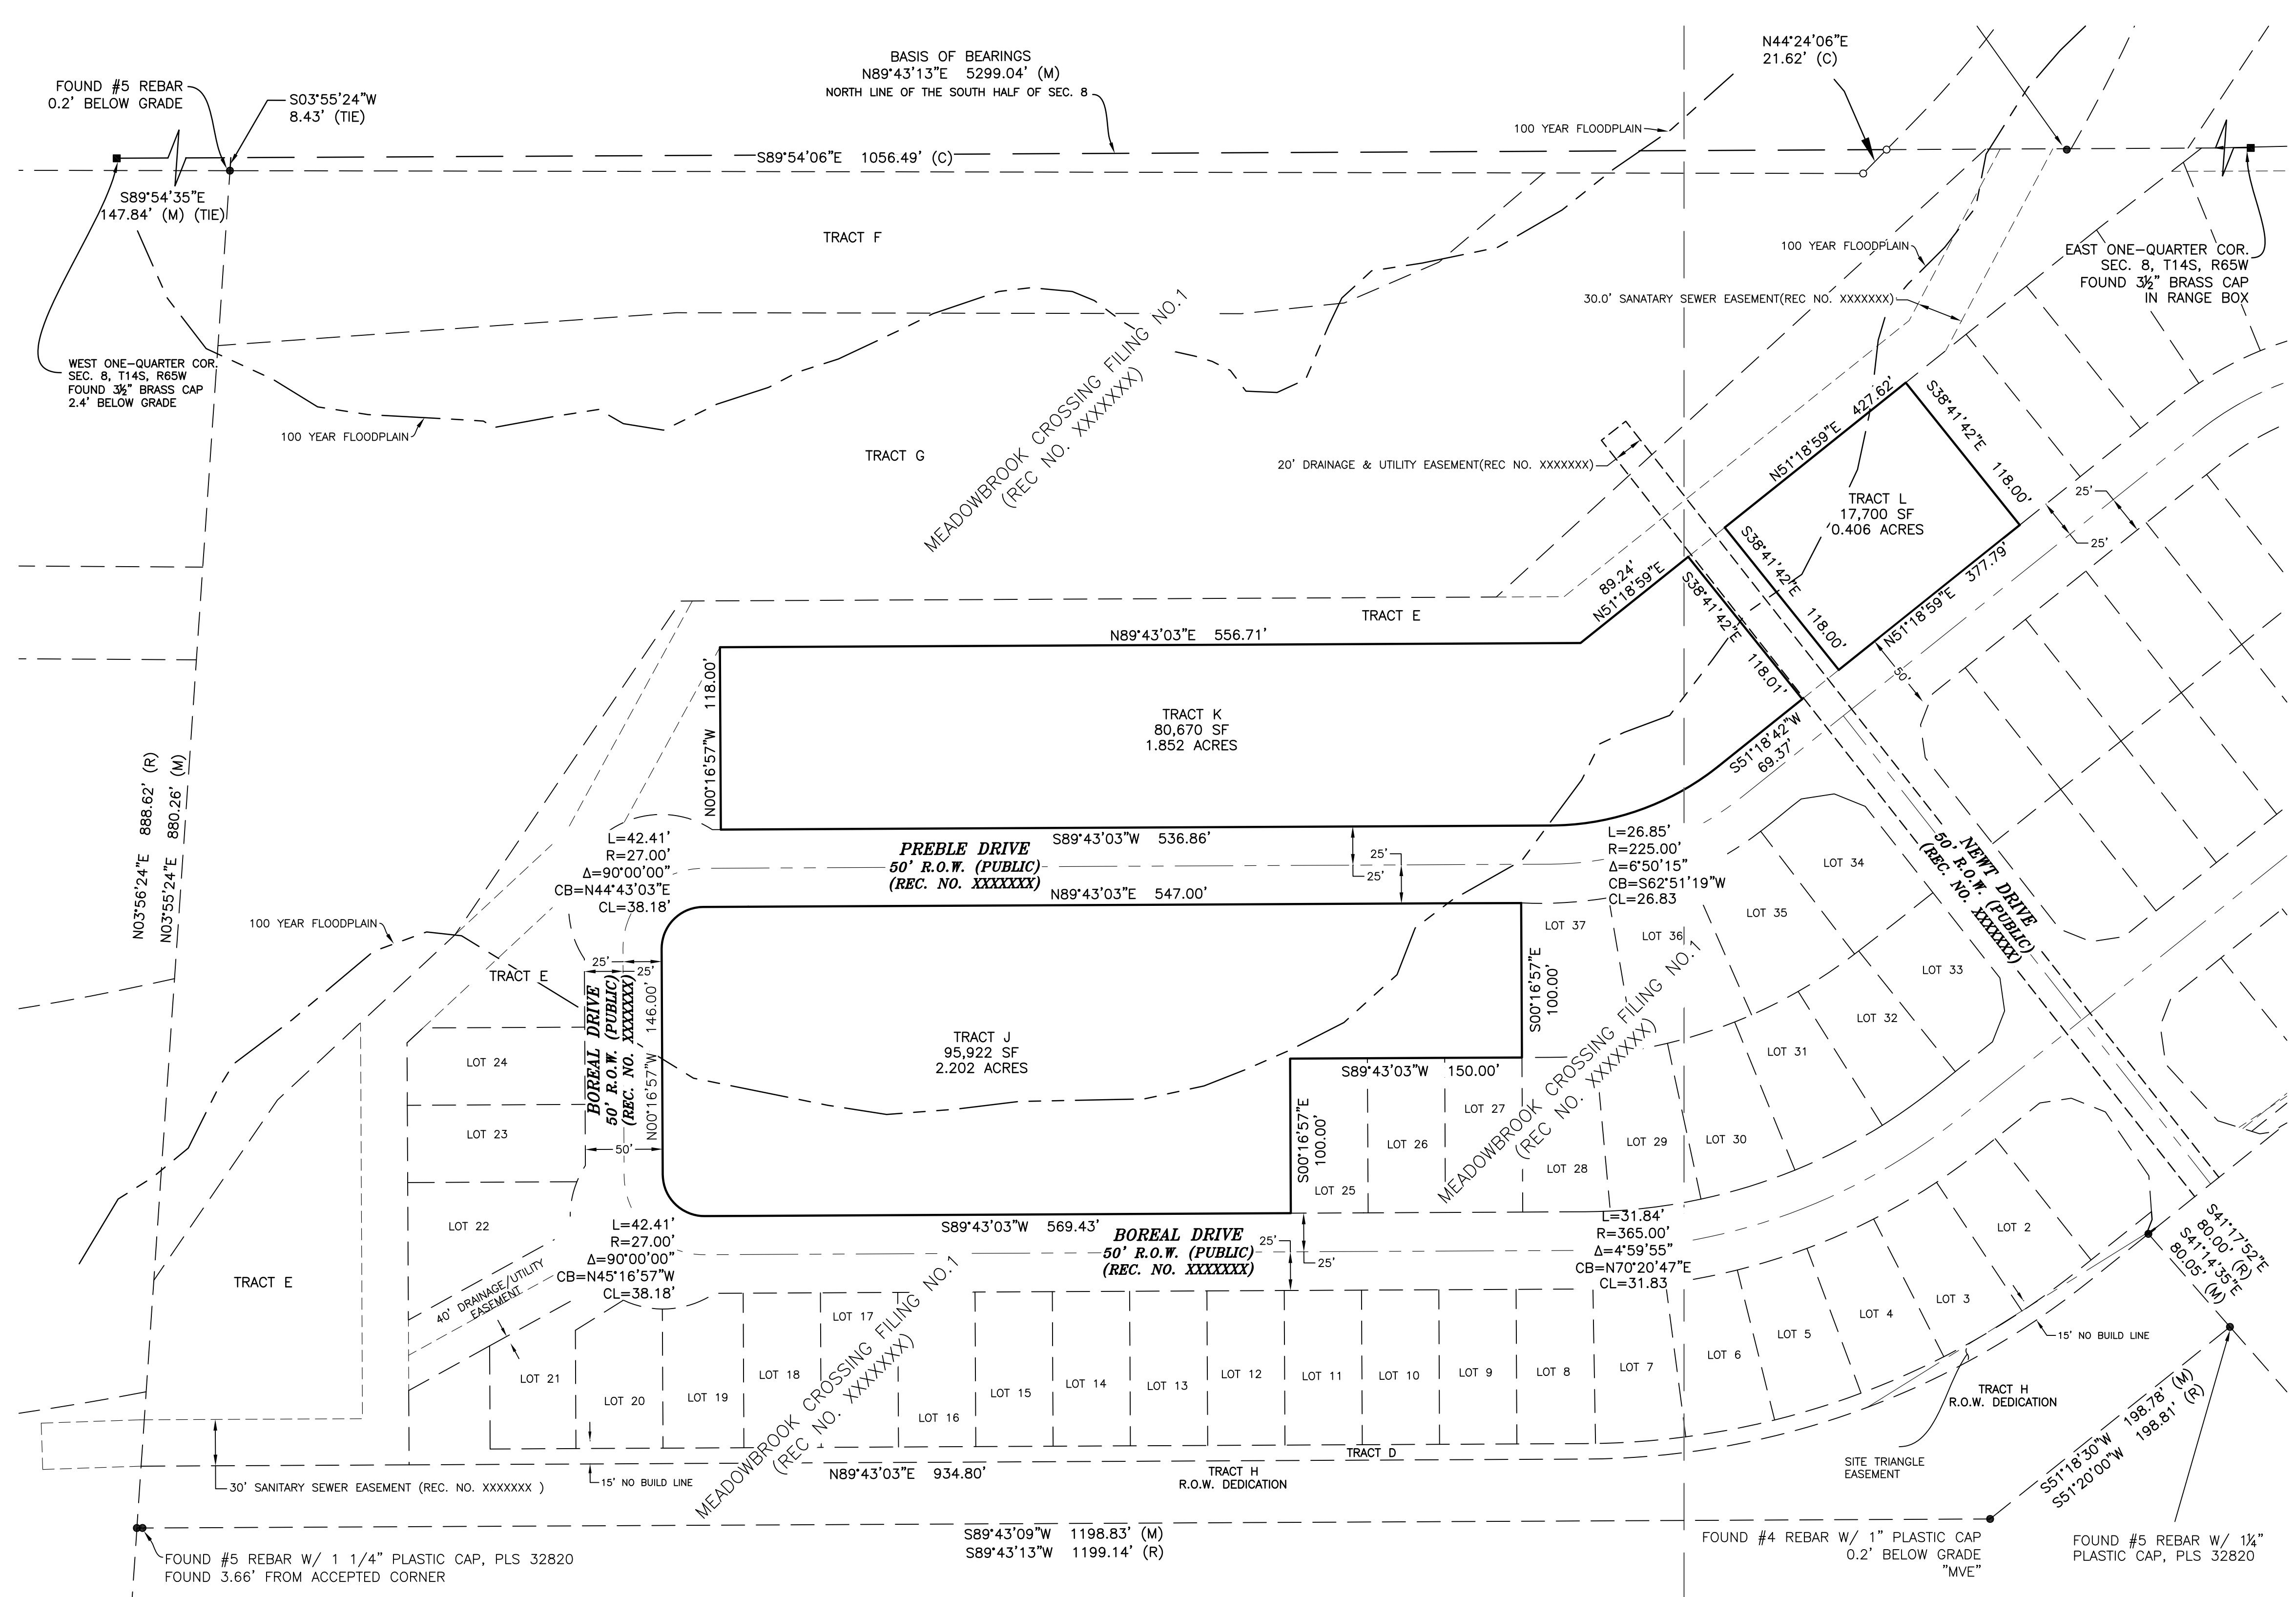


PCD File No. XX-XX-XXX

No.	Description	By	Date


Notice: According to Colorado law you must commence legal action to set aside or correct this survey within three years after you first discover such defect. In no event may any action based upon any defect in this survey be commenced more than ten years from the date of the certification shown hereon.

# MEADOWBROOK CROSSING FILING NO. 2

A REPLAT OF TRACTS J, K, AND L,  
MEADOWBROOK OF CROSSING FILING NO. 1  
BEING A PORTION OF THE SOUTH 1/2 OF SECTION 8,  
TOWNSHIP 14 SOUTH, RANGE 65 WEST OF THE 6TH P.M.  
EL PASO COUNTY, STATE OF COLORADO.

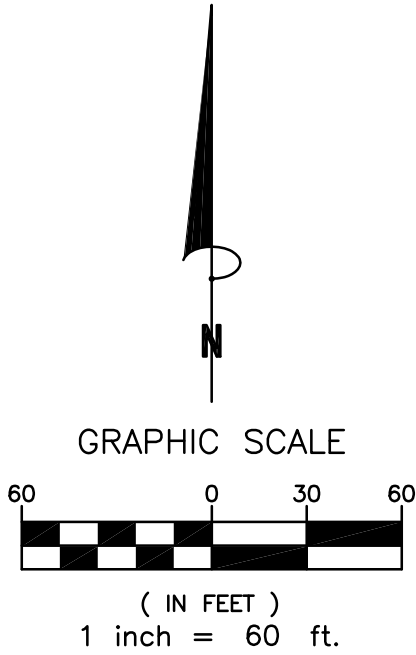

## AS REPLATTED

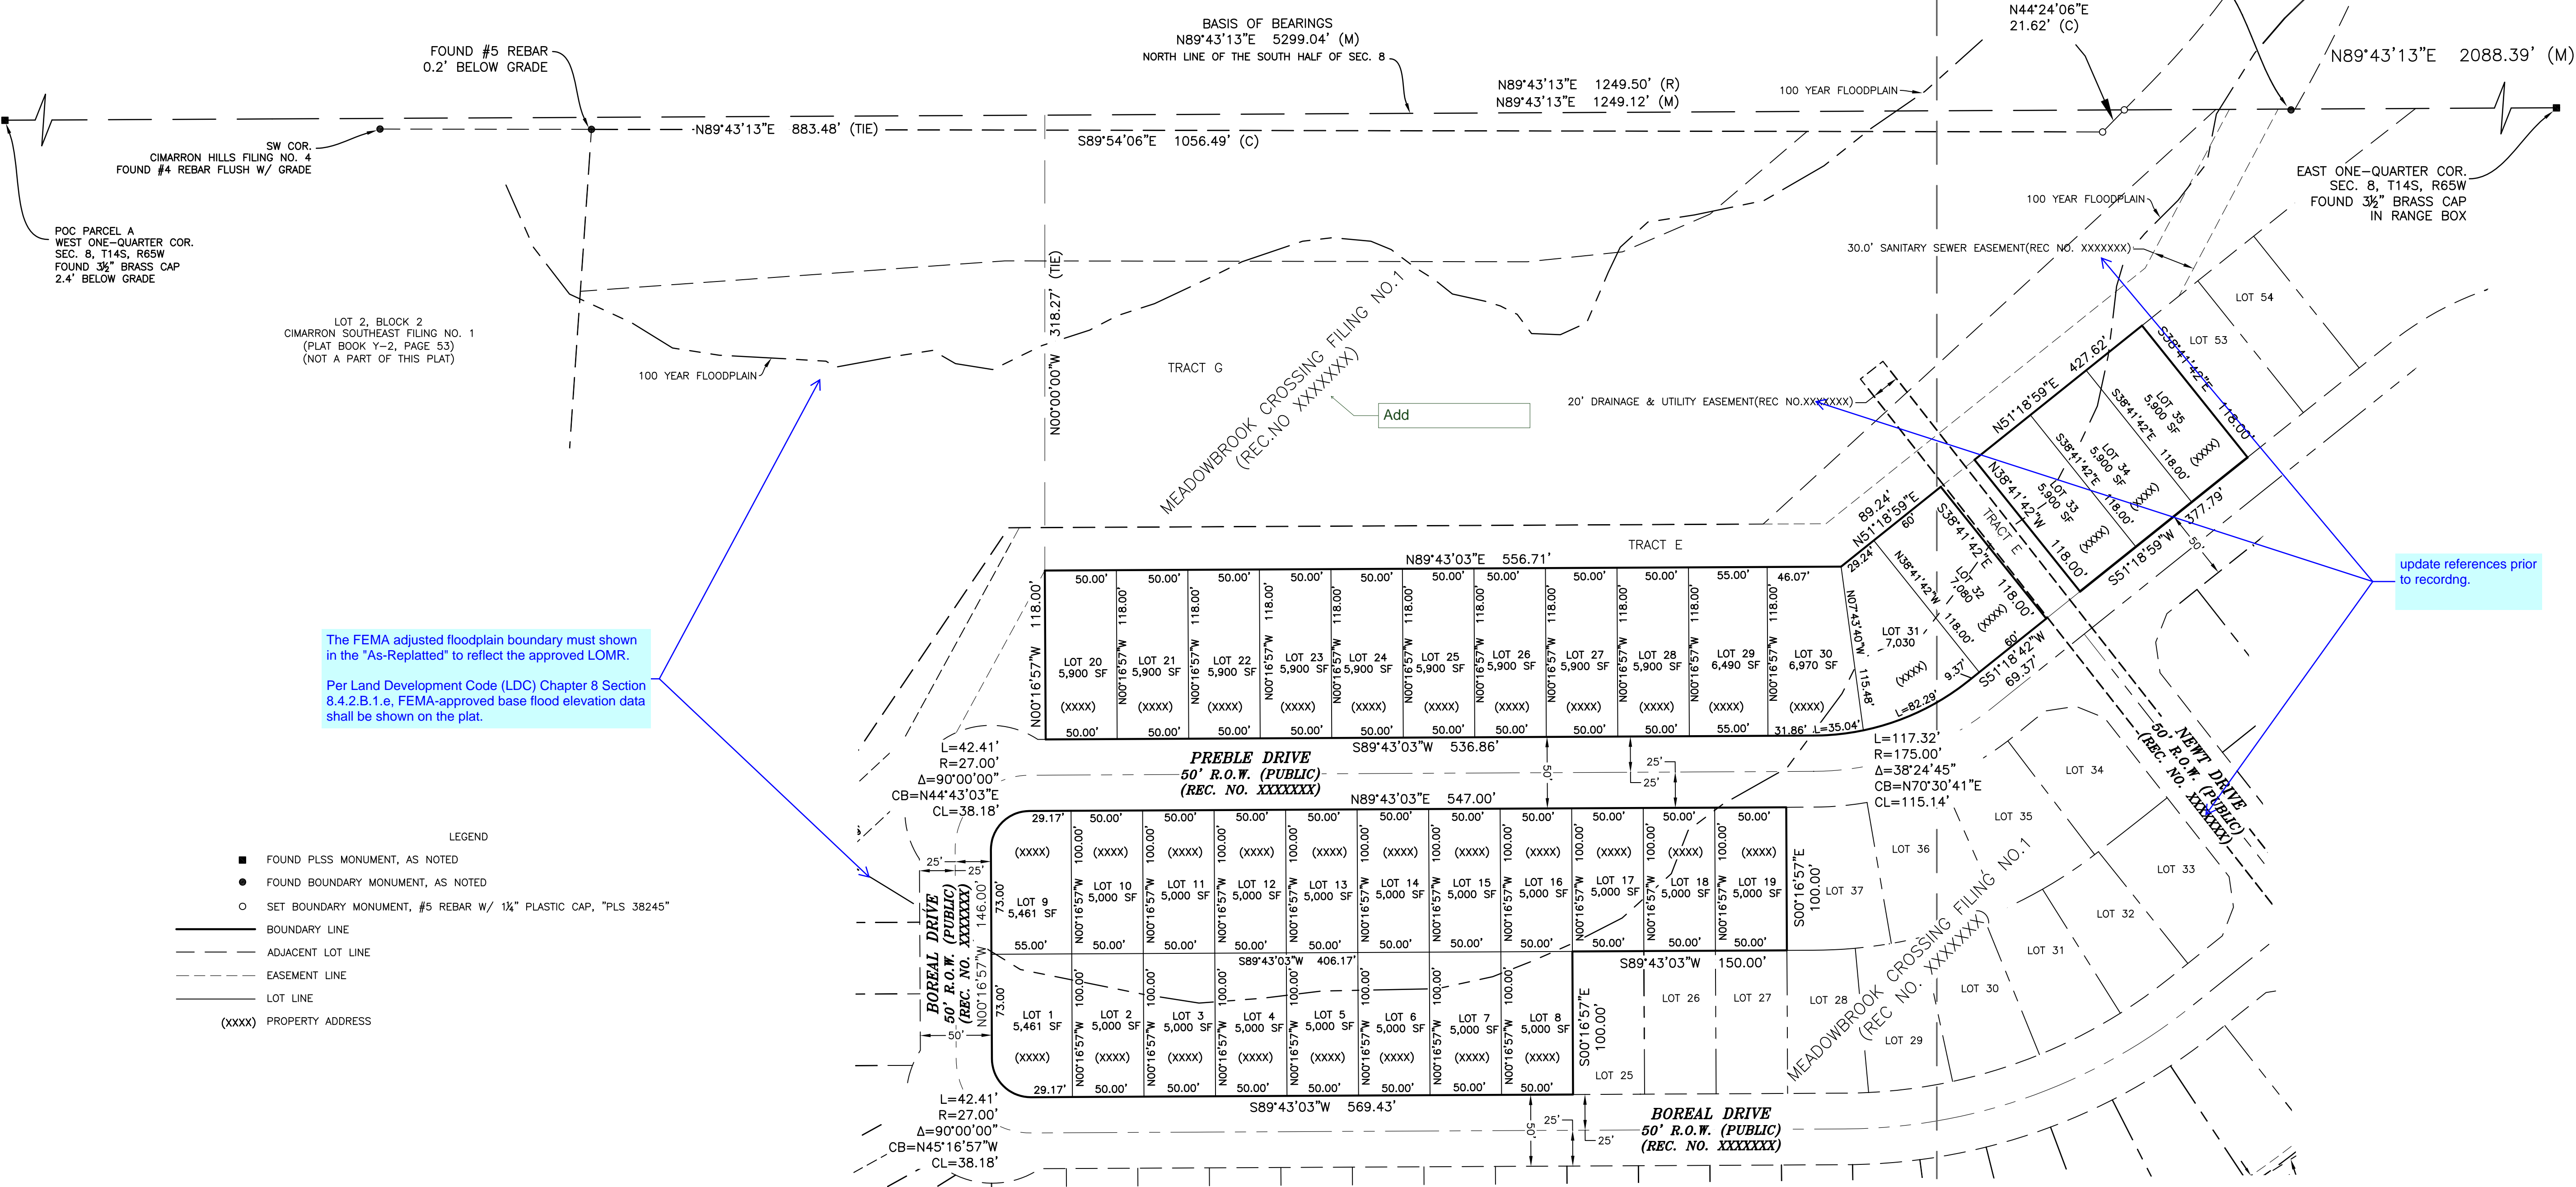

The FEMA adjusted floodplain boundary must shown in the "As-Replatted" to reflect the approved LOMR.  
Per Land Development Code (LDC) Chapter 8 Section 8.4.2.B.1.e. FEMA-approved base flood elevation data shall be shown on the plat.

- LEGEND**
- FOUND PLSS MONUMENT, AS NOTED
  - FOUND BOUNDARY MONUMENT, AS NOTED
  - SET BOUNDARY MONUMENT, #5 REBAR W/ 1/4" PLASTIC CAP, "PLS 38245"
  - BOUNDARY LINE
  - - - ADJACENT LOT LINE
  - EASEMENT LINE
  - - - LOT LINE
  - (XXXX) PROPERTY ADDRESS

**Clark**  
Land Surveying, Inc.  
www.clarkls.com  
177 S. Tiffany Dr., Unit 1 • Pueblo West, CO 81007 • 719.862.1270

Revisions	No.	Description	By	Date

Notice: According to Colorado law you must conduct a final action and record your plat in this survey within three years after you first discover such defect. In no event may any action based upon any defect in this survey be commenced more than ten years from the date of the certification shown herein.

**MEADOWBROOK CROSSING FILING NO. 2**  
A REPLAT OF TRACTS J, K, & L,  
MEADOWBROOK CROSSING FILING NO. 1,  
EL PASO COUNTY, COLORADO

Project No. **170900**  
Drawn By: BCR  
Checked By: SLM  
Date: 11/29/2017  
Sheet 3 of 3

# Markup Summary

---


## dsdlaforce (4)

---



**Subject:** Callout  
**Page Label:** 1  
**Lock:** Unlocked  
**Status:**  
**Checkmark:** Unchecked  
**Author:** dsdlaforce  
**Date:** 3/12/2018 3:51:41 PM  
**Color:** ■

Replace "Development Services Department" with "Planning and Community Development Department"

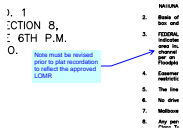

**Subject:** Callout  
**Page Label:** 1  
**Lock:** Unlocked  
**Status:**  
**Checkmark:** Unchecked  
**Author:** dsdlaforce  
**Date:** 3/12/2018 3:48:19 PM  
**Color:** ■

Note must be revised prior to plat recordation to reflect the approved LOMR



**Subject:** Callout  
**Page Label:** 3  
**Lock:** Unlocked  
**Status:**  
**Checkmark:** Unchecked  
**Author:** dsdlaforce  
**Date:** 3/12/2018 4:03:17 PM  
**Color:** ■

The FEMA adjusted floodplain boundary must shown in the "As-Replatted" to reflect the approved LOMR.

Per Land Development Code (LDC) Chapter 8 Section 8.4.2.B.1.e, FEMA-approved base flood elevation data shall be shown on the plat.



**Subject:** Callout  
**Page Label:** 3  
**Lock:** Unlocked  
**Status:**  
**Checkmark:** Unchecked  
**Author:** dsdlaforce  
**Date:** 3/12/2018 4:04:32 PM  
**Color:** ■

update references prior to recording.

---


## dsdparsons (9)

---



**Subject:** Callout  
**Page Label:** 1  
**Lock:** Unlocked  
**Status:**  
**Checkmark:** Unchecked  
**Author:** dsdparsons  
**Date:** 3/13/2018 9:45:35 AM  
**Color:** ■

Add reception no from FIL 1 plat  
No new SIA will occur with this filing

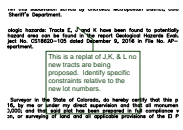

**Subject:** Callout  
**Page Label:** 1  
**Lock:** Unlocked  
**Status:**  
**Checkmark:** Unchecked  
**Author:** dsdparsons  
**Date:** 3/13/2018 9:48:30 AM  
**Color:** ■

This is a replat of J,K, & L no new tracts are being proposed. Identify specific constraints relative to the new lot numbers.



Using File  
XXXXXX

Add

**Subject:** Callout  
**Page Label:** 3  
**Lock:** Unlocked  
**Status:**  
**Checkmark:** Unchecked  
**Author:** dsdparsons  
**Date:** 3/13/2018 9:46:53 AM  
**Color:** ■

Add