

KNOW ALL MEN BY THESE PRESENTS:

THAT FEATHERGRASS INVESTMENTS, LLC A COLORADO LIMITED LIABILITY COMPANY BEING THE OWNER OF THE FOLLOWING DESCRIBED TRACT OF LAND TO WIT:

LEGAL DESCRIPTION:

TRACT KK AS PLATTED IN HANNAH RIDGE AT FEATHERGRASS FILING NO. 1 RECORDED UNDER RECEPTION NO. 214713468, RECORDS OF EL PASO COUNTY, COLORADO, AS CORRECTED BY AFFIDAVIT OF CORRECTION RECORDED AT RECEPTION NO. 214061663 AND CLARIFIED BY AFFIDAVIT OF CLARIFICATION RECORDED AT RECEPTION NO. 214081923 AND AFFIDAVIT OF CORRECTION RECORDED UNDER RECEPTION NO. 218057396 AND AFFIDAVIT OF CORRECTION RECORDED UNDER RECEPTION NO. 218091255 BEING A PORTION OF SECTION 32, TOWNSHIP 13 SOUTH, RANGE 65 WEST OF THE SIXTH PRINCIPAL MERIDIAN, EL PASO COUNTY, COLORADO.

CONTAINING A CALCULATED AREA OF 7.944 ACRES.

OWNERS CERTIFICATE:

THE UNDERSIGNED, BEING ALL THE OWNERS, MORTGAGEES, BENEFICIARIES OF DEEDS OF TRUST AND HOLDERS OF OTHER INTERESTS IN THE LAND DESCRIBED HEREIN, HAVE LAID OUT, SUBDIVIDED, AND PLATTED SAID LANDS INTO LOTS, TRACTS, STREETS, AND EASEMENTS AS SHOWN HEREON UNDER THE NAME AND SUBDIVISION OF HANNAH RIDGE AT FEATHERGRASS FILING NO. 6. ALL PUBLIC IMPROVEMENTS SO PLATTED ARE HEREBY DEDICATED TO PUBLIC USE AND SAID OWNER DOES HEREBY COVENANT AND AGREE THAT THE PUBLIC IMPROVEMENTS WILL BE CONSTRUCTED TO EL PASO COUNTY STANDARDS AND THAT PROPER DRAINAGE AND EROSION CONTROL FOR SAME WILL BE PROVIDED AT SAID OWNER'S EXPENSE, ALL TO THE SATISFACTION OF THE BOARD OF COUNTY COMMISSIONERS OF EL PASO COUNTY, COLORADO. UPON ACCEPTANCE BY RESOLUTION, ALL PUBLIC IMPROVEMENTS SO DEDICATED WILL BECOME MATTERS OF MAINTENANCE BY EL PASO COUNTY, COLORADO. THE UTILITY EASEMENTS SHOWN HEREON ARE HEREBY DEDICATED FOR PUBLIC UTILITIES AND COMMUNICATION SYSTEMS AND OTHER PURPOSES AS SHOWN HEREON. THE ENTITIES RESPONSIBLE FOR PROVIDING THE SERVICES FOR WHICH THE EASEMENTS ARE ESTABLISHED ARE HEREBY GRANTED THE PERPETUAL RIGHT OF INGRESS AND EGRESS FROM AND TO ADJACENT PROPERTIES FOR INSTALLATION, MAINTENANCE, AND REPLACEMENT OF UTILITY LINES AND RELATED FACILITIES.

OWNER:

THE AFOREMENTIONED, FEATHERGRASS INVESTMENTS, LLC A COLORADO LIMITED LIABILITY COMPANY HAS EXECUTED THIS INSTRUMENT THIS ___ DAY OF _____, 20__.

WITNESS MY HAND AND OFFICIAL SEAL.

AS _____ OF FEATHERGRASS INVESTMENTS, LLC A COLORADO LIMITED LIABILITY COMPANY

STATE OF COLORADO)
) ss
COUNTY OF EL PASO)

THE FOREGOING INSTRUMENT WAS ACKNOWLEDGED BEFORE ME THIS _____ DAY OF _____, 20__, A.D. BY _____ OF FEATHERGRASS INVESTMENTS, LLC A COLORADO LIMITED LIABILITY COMPANY

WITNESS MY HAND AND OFFICIAL SEAL.


MY COMMISSION EXPIRES: _____ NOTARY PUBLIC

GENERAL NOTES:

- 1. THE DATE OF PREPARATION IS OCTOBER 4, 2018.
2. THE TRACT OF LAND HEREIN PLATTED LIES WITHIN SECTION 32, TOWNSHIP 13 SOUTH, RANGE 65 WEST OF THE SIXTH PRINCIPAL MERIDIAN.
3. UNLESS SHOWN OTHERWISE, ALL FRONT LOT LINES ARE HEREBY PLATTED WITH A 5.00 FOOT WIDE PUBLIC IMPROVEMENT AND UTILITY EASEMENT, AND A 10.00 FOOT WIDE PUBLIC UTILITY EASEMENT. ALL SIDE LOT LINES ARE HEREBY PLATTED WITH A 5.00 FOOT WIDE PUBLIC UTILITY AND DRAINAGE EASEMENT AND ALL REAR LOT LINES ARE HEREBY PLATTED WITH A 10.00 FOOT WIDE PUBLIC UTILITY AND DRAINAGE EASEMENT, WITH THE SOLE RESPONSIBILITY FOR THE SURFACE MAINTENANCE OF EASEMENTS BEING VESTED WITH THE INDIVIDUAL PROPERTY OWNER.
4. THE FOLLOWING REPORTS HAVE BEEN SUBMITTED AND ARE ON FILE AT THE COUNTY PLANNING AND COMMUNITY DEVELOPMENT DEPARTMENT: WATER RESOURCE REPORT; WASTEWATER DISPOSAL REPORT; GEOLOGY AND SOILS REPORT; FIRE PROTECTION REPORT; WILDFIRE HAZARD REPORT; NATURAL FEATURES REPORT; TRANSPORTATION IMPACT STUDY.
5. THE TOTAL NUMBER OF LOTS BEING PLATTED IS 33. THE TOTAL NUMBER OF TRACTS BEING PLATTED IS 1.
6. THE ARTICLES OF INCORPORATION FOR HANNAH RIDGE HOMEOWNER'S ASSOCIATION, INC., WERE FILED WITH THE COLORADO SECRETARY OF STATE UNDER IDENTIFICATION NUMBER 20171203918. THIS PLAT IS SUBJECT TO THE TERMS AND CONDITIONS AS SET FORTH IN THE RESTRICTIONS AND COVENANTS AS RECORDED AT RECEPTION NO. 217032014 OF THE RECORDS OF EL PASO COUNTY, COLORADO, AS AMENDED.
7. DEVELOPER SHALL COMPLY WITH FEDERAL AND STATE LAWS, REGULATIONS, ORDINANCES, REVIEW AND PERMIT REQUIREMENTS, AND OTHER AGENCY REQUIREMENTS, IF ANY, OF A APPLICABLE AGENCIES INCLUDING, BUT NOT LIMITED TO, THE COLORADO DEPARTMENT OF WILDLIFE, COLORADO DEPARTMENT OF TRANSPORTATION, U.S. ARMY CORP. OF ENGINEERS, THE U.S. FISH & WILDLIFE SERVICE AND/OR COLORADO DEPARTMENT OF WILDLIFE REGARDING THE ENDANGERED SPECIES ACT.
8. THE ADDRESSES EXHIBED ON THIS PLAT ARE FOR INFORMATIONAL PURPOSES ONLY. THEY ARE NOT THE LEGAL DESCRIPTION AND ARE SUBJECT TO CHANGE.
9. FLOODPLAIN STATEMENT: THIS SITE, HANNAH RIDGE AT FEATHERGRASS FILING NO. 6, IS NOT WITHIN A DESIGNATED F.E.M.A. FLOODPLAIN AS DETERMINED BY THE FLOOD INSURANCE RATE MAP, MAP NUMBER 08041C0752F, DATED MARCH 17, 1997.
10. NO LOT OR INTEREST THEREIN, SHALL BE SOLD, CONVEYED, OR TRANSFERRED WHETHER BY DEED OR BY CONTRACT, NOR SHALL BUILDING PERMITS BE ISSUED, UNTIL AND UNLESS EITHER THE REQUIRED PUBLIC AND COMMON DEVELOPMENT IMPROVEMENTS HAVE BEEN CONSTRUCTED AND COMPLETED AND PRELIMINARILY ACCEPTED IN ACCORDANCE WITH THE SUBDIVISION IMPROVEMENTS AGREEMENT BETWEEN THE APPLICANT/OWNER AND EL PASO COUNTY AS RECORDED UNDER RECEPTION NO. _____ IN THE OFFICE OF THE CLERK AND RECORDER OF EL PASO COUNTY, COLORADO OR, IN THE ALTERNATIVE, OTHER COLLATERAL IS PROVIDED TO MAKE PROVISION FOR THE COMPLETION OF SAID IMPROVEMENTS IN ACCORDANCE WITH THE EL PASO COUNTY LAND DEVELOPMENT CODE AND ENGINEERING CRITERIA MANUAL. ANY SUCH ALTERNATIVE COLLATERAL MUST BE APPROVED BY THE BOARD OF COUNTY COMMISSIONERS OR, IF PERMITTED BY THE SUBDIVISION IMPROVEMENTS AGREEMENT, BY THE DEVELOPMENT SERVICES DEPARTMENT DIRECTOR AND MEET THE POLICY AND PROCEDURE REQUIREMENTS OF EL PASO COUNTY PRIOR TO THE RELEASE BY THE COUNTY OF ANY LOTS FOR SALE, CONVEYANCE OR TRANSFER. THIS PLAT RESTRICTION MAY BE REMOVED OR RESCINDED BY THE BOARD OF COUNTY COMMISSIONERS OR, IF PERMITTED BY THE SUBDIVISION IMPROVEMENTS AGREEMENT, BY THE PLANNING AND COMMUNITY DEVELOPMENT DEPARTMENT DIRECTOR UPON EITHER APPROVAL OF AN ALTERNATIVE FORM OF COLLATERAL OR COMPLETION AND PRELIMINARY ACCEPTANCE BY THE EL PASO BOARD OF COUNTY COMMISSIONERS OF ALL IMPROVEMENTS REQUIRED TO BE CONSTRUCTED AND COMPLETED IN ACCORDANCE WITH SAID SUBDIVISION IMPROVEMENTS AGREEMENT. THE PARTIAL RELEASE OF LOTS FOR SALE, CONVEYANCE OR TRANSFER MAY ONLY BE GRANTED IN ACCORDANCE WITH ANY PLANNED PARTIAL RELEASE OF LOTS AUTHORIZED BY THE SUBDIVISION IMPROVEMENTS AGREEMENT.

HANNAH RIDGE AT FEATHERGRASS FILING NO. 6

A REPLAT OF TRACT KK OF HANNAH RIDGE AT FEATHERGRASS FILING NO. 1, RECEPTION NO. 214713468, RECORDS OF EL PASO COUNTY, COLORADO SECTION 32, TOWNSHIP 13 SOUTH, RANGE 65 TY, COLORADO WEST OF THE SIXTH PRINCIPAL MERIDIAN, EL PASO COUNTY, COLORADO

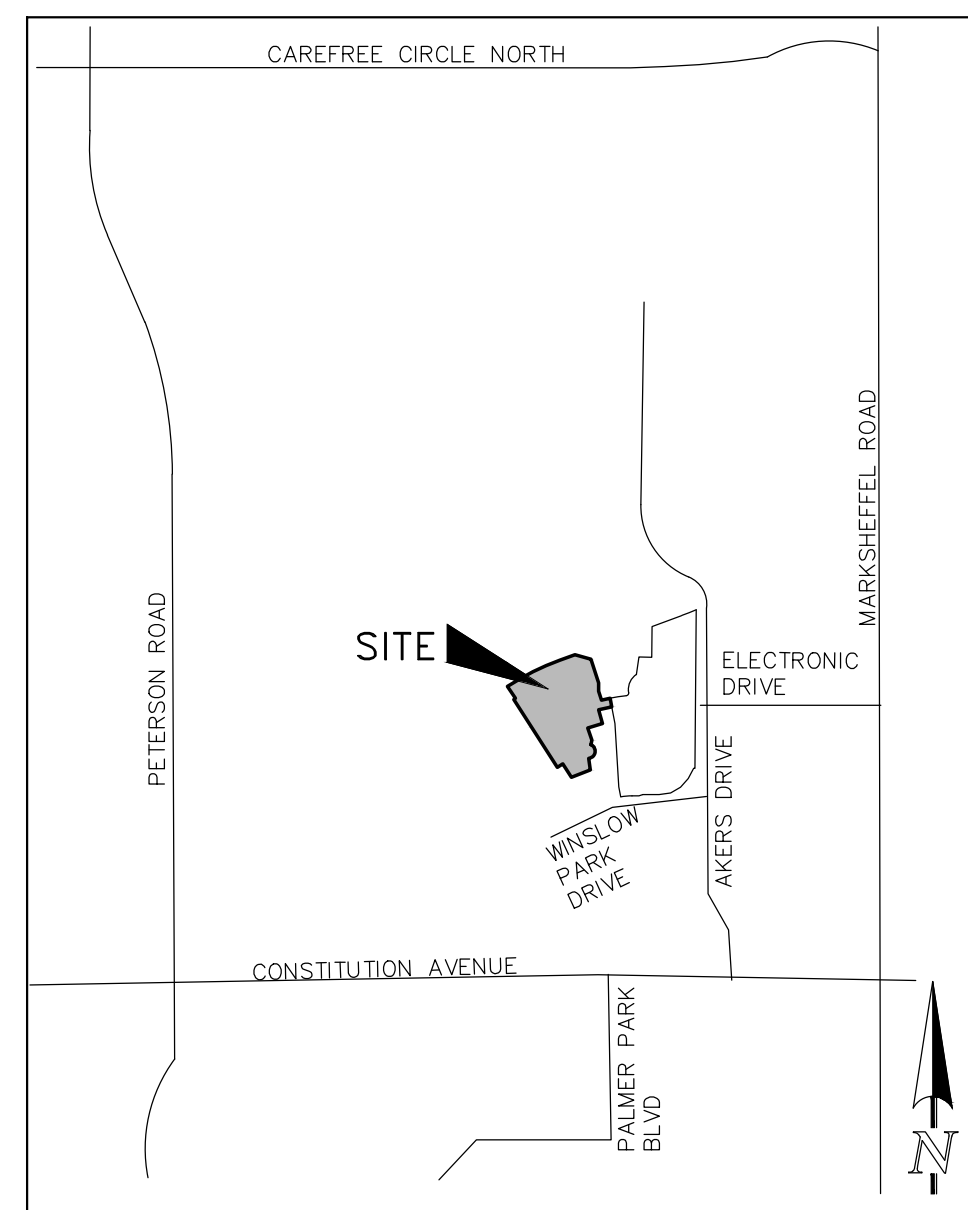

VICINITY MAP N.T.S.

TRACT TABLE with columns: TRACT, USE, OWNERSHIP/MAINTENANCE. Row 1: A, FUTURE DEVELOPMENT, OWNER OF RECORD current owner and not successors.

Please identify in the table, the acreage of future dev tract acreage of proposed ROW, acreage in Lots and then the total should add up to the legal. (This is broken out in the staff reports.)

SURVEYOR'S STATEMENT:

THE UNDERSIGNED PROFESSIONAL LAND SURVEYOR LICENSED IN THE STATE OF COLORADO, HEREBY STATES AND DECLARES THAT THE ACCOMPANYING PLAT WAS SURVEYED AND DRAWN UNDER HIS RESPONSIBLE CHARGE AND ACCURATELY SHOWS THE DESCRIBED TRACT OF LAND, AND SUBDIVISION THEREOF, AND THAT THE REQUIREMENTS OF TITLE 38 OF THE COLORADO REVISED STATUTES, 1973, AS AMENDED, HAVE BEEN MET TO THE BEST OF HIS KNOWLEDGE AND BELIEF.

DOUGLAS P. REINELT, PROFESSIONAL LAND SURVEYOR DATE
COLORADO P.L.S. NO. 50118
FOR AND ON BEHALF OF CLASSIC CONSULTING, ENGINEERS AND SURVEYORS, LLC.

NOTICE:

ACCORDING TO COLORADO LAW YOU MUST COMMENCE ANY LEGAL ACTION BASED UPON ANY DEFECT IN THIS SURVEY WITHIN THREE YEARS AFTER YOU FIRST DISCOVER SUCH DEFECT. IN NO EVENT, MAY ANY ACTION BASED UPON ANY DEFECT IN THIS SURVEY BE COMMENCED MORE THAN TEN YEARS FROM THE DATE OF THE CERTIFICATION SHOWN HEREON.

BOARD OF COUNTY COMMISSIONERS CERTIFICATE

THIS PLAT FOR HANNAH RIDGE AT FEATHERGRASS FILING NO. 6 WAS APPROVED FOR FILING BY THE EL PASO COUNTY, COLORADO BOARD OF COUNTY COMMISSIONERS ON THIS ___ DAY OF _____, 20__, SUBJECT TO ANY NOTES SPECIFIED HEREON AND ANY CONDITIONS INCLUDED IN THE RESOLUTION OF APPROVAL. THE DEDICATIONS OF LAND TO THE PUBLIC (STREETS AND EASEMENTS) ARE ACCEPTED, BUT PUBLIC IMPROVEMENTS THEREON WILL NOT BECOME MAINTENANCE RESPONSIBILITY OF EL PASO COUNTY UNTIL PRELIMINARY ACCEPTANCE OF THE PUBLIC IMPROVEMENTS IN ACCORDANCE WITH THE REQUIREMENTS OF THE LAND DEVELOPMENT CODE AND ENGINEERING CRITERIA MANUAL, AND THE SUBDIVISION IMPROVEMENTS AGREEMENT.

CHAIR, BOARD OF COUNTY COMMISSIONERS DATE

DIRECTOR OF PLANNING AND COMMUNITY DEVELOPMENT DEPARTMENT DATE

COUNTY ASSESSOR DATE

CLERK AND RECORDER:

STATE OF COLORADO)
) ss
COUNTY OF EL PASO)
I HEREBY CERTIFY THAT THIS INSTRUMENT WAS FILED FOR RECORD IN MY OFFICE AT O'CLOCK __M. THIS ___ DAY OF _____, 20__, A.D., AND IS DULY RECORDED AT RECEPTION NO. _____ OF THE RECORDS OF EL PASO COUNTY, COLORADO.

CHUCK BROERMAN, RECORDER

BY: _____ DEPUTY

DRAINAGE: Basin Names
BRIDGE FEES:
URBAN PARK:
REGIONAL PARK: District 11
SCHOOL FEE:
SURCHARGES: Delete
FEE: Delete

PRELIMINARY
THIS DOCUMENT HAS NOT BEEN PLAT CHECKED

OWNER: FEATHERGRASS INVESTMENTS, LLC
4715 NORTH CHESTNUT STREET, SUITE 200
COLORADO SPRINGS, CO 80907

Table with columns: NO., REVISION, DATE. Rows 1, 2.

GENERAL NOTES (CONT.):

- 11. THIS PLAT IS REGULATED BY A P.U.D. DEVELOPMENT PLAN AS RECORDED UNDER RECEPTION NO. 208091457 AND P.U.D. DEVELOPMENT GUIDELINES AS RECORDED UNDER RECEPTION NO. 208091456 OF THE RECORDS OF EL PASO COUNTY AND AS AMENDED.
12. MAILBOXES SHALL BE INSTALLED IN ACCORDANCE WITH ALL EL PASO COUNTY DEPARTMENT OF TRANSPORTATION AND UNITED STATES POSTAL SERVICE REGULATIONS.
13. FIRE PROTECTION IS BY FALCON FIRE PROTECTION DISTRICT.
14. THE HANNAH RIDGE HOMEOWNER'S ASSOCIATION, INC. SHALL MAINTAIN ALL IMPROVEMENTS LYING WITHIN MEDIANS, ISLANDS AND SIMILAR AREAS LYING WITHIN THE PLATTED RIGHT OF WAY.
15. ANY PERSON WHO KNOWINGLY REMOVES, ALTERS OR DEFACTS ANY PUBLIC LAND SURVEY MONUMENT OR LAND BOUNDARY MONUMENT OR ACCESSORY, COMMITS A CLASS TWO (2) MISDEMEANOR PURSUANT TO STATE STATUE 18-4-508, C.R.S.
16. THIS PLAT DOES NOT CONSTITUTE A TITLE SEARCH TO DETERMINE OWNERSHIP OR EASEMENTS OR RECORD. FOR ALL INFORMATION REGARDING EASEMENTS, RIGHT-OF-WAY AND TITLE OF RECORD, CLASSIC CONSULTING ENGINEERS AND SURVEYORS AND THE SURVEYOR OF RECORD RELIED UPON THE TITLE COMMITMENT ORDER NUMBER 181498-AMENDMENT NO. 1 PREPARED BY CAPSTONE TITLE AS AGENT FOR STEWART TITLE GUARANTY, WITH AN EFFECTIVE DATE OF AUGUST 20, 2018 AT 8:00 A.M.
17. PURSUANT TO RESOLUTION _____, APPROVED BY THE BOARD OF DIRECTORS, EL PASO COUNTY PUBLIC IMPROVEMENT DISTRICT AND RECORDED IN THE RECORDS OF THE EL PASO COUNTY CLERK AND RECORDED AT RECEPTION NO. _____, THE PARCELS WITHIN THE PLATTED BOUNDARIES OF HANNAH RIDGE AT FEATHERGRASS FILING NO. 6 ARE INCLUDED WITHIN THE BOUNDARIES OF THE EL PASO COUNTY PUBLIC IMPROVEMENT DISTRICT NO. 2 AND AS SUCH ARE SUBJECT TO APPLICABLE ROAD IMPACT FEES AND MILL LEVY.
18. A DRIVEWAY PERMIT IS REQUIRED TO BE APPLIED FOR AND APPROVED BY EL PASO COUNTY DEVELOPMENT SERVICES DEPARTMENT PRIOR TO THE ESTABLISHMENT OF ANY DRIVEWAY.
19. ALL PROPERTY OWNERS ARE RESPONSIBLE FOR MAINTAINING PROPER STORM WATER DRAINAGE IN AND THROUGH THEIR PROPERTY. PUBLIC DRAINAGE EASEMENTS AS SPECIFICALLY NOTED ON THE PLAT SHALL BE MAINTAINED BY THE INDIVIDUAL LOT OWNERS UNLESS OTHERWISE INDICATED. STRUCTURES, FENCES, MATERIALS OR LANDSCAPING THAT COULD IMPEDE THE FLOW OF RUNOFF SHALL NOT BE PLACED IN DRAINAGE EASEMENTS.
20. INDIVIDUAL LOT PURCHASERS ARE RESPONSIBLE FOR CONSTRUCTING DRIVEWAYS, INCLUDING NECESSARY DRAINAGE CULVERTS PER LAND DEVELOPMENT CODE SECTION 6.3.3.C.2 AND 6.3.3.C.3.
21. BASIS OF BEARINGS: A PORTION OF THE EASTERLY BOUNDARY OF HANNAH RIDGE AT FEATHERGRASS FILING NO. 1 BEING MONUMENTED AT THE BOTH ENDS BY A 1-1/2" ALUMINUM CAP STAMPED "PLS 27605", IS ASSUMED TO BEAR S00°21'33"W, A DISTANCE OF 1997.45 FEET.
22. TRACT A IS FOR FUTURE DEVELOPMENT TO BE OWNED AND MAINTAINED BY THE OWNER OF RECORD.

verify that you dont want to identify the title commitment exceptions on the face of the plat? It was platted as a tract previously. Is this subject to previous SIA, PID, BMP agreements, all metropolitan/special districts should be identified etc...

Where the Property is Located in the Airport Overlay Zone NOTICE OF POTENTIAL AIRCRAFT OVERFLIGHT AND NOISE IMPACT ASSOCIATED WITH AIRPORT: This serves as notice of potential aircraft overflight and noise impacts on this property due to its close proximity to an airport, which is being disclosed to all prospective purchasers considering the use of this property for residential and other purposes. This property is subject to the overflight and associated noise of arriving and departing aircraft during the course of normal airport operations. (Use when this plat is to provide the notice) All property within this subdivision is subject to a Notice of Potential Aircraft Overflight and Noise Impact recorded at Reception No. _____ of the records of the El Paso County Clerk and Recorder. (Use when the Notice has previously been recorded) All property within this subdivision is subject to an Avigation Easement as recorded at Reception No. _____ of the records of the El Paso County Clerk and Recorder. (Use only when the property is subject to an existing avigation easement as reflected in the title policy)

see title commitment and modify if necessary

water & wastewater provided by X electric and gas provided by X

Is this annexing completely into Falcon and not remaining in Cimmaron Fire? Note 13 above


complete when PID resolution is completed. You can work with Lori now since the tract was platted previously. This may already be in the PID per titlework. I do not know if it needs to go in again as lots

SF-18-039

HANNAH RIDGE AT FEATHERGRASS FILING NO. 6

A REPLAT OF TRACT KK OF HANNAH RIDGE AT FEATHERGRASS FILING NO. 1, RECEPTION NO. 214713468, RECORDS OF EL PASO COUNTY, COLORADO
SECTION 32, TOWNSHIP 13 SOUTH, RANGE 65 WEST OF THE SIXTH PRINCIPAL MERIDIAN, EL PASO COUNTY, COLORADO

AS PLATTED

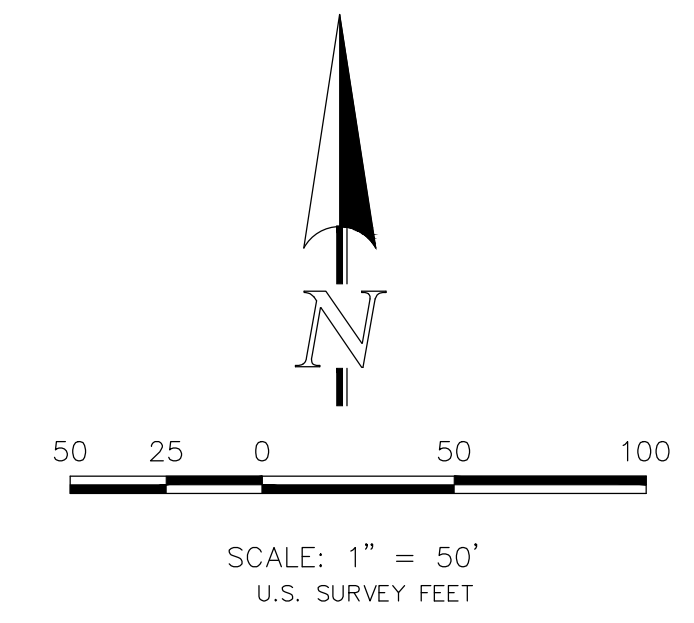

PRELIMINARY
THIS DOCUMENT HAS NOT BEEN PLAT CHECKED

HANNAH RIDGE AT FEATHERGRASS FILING NO. 6
JOB NO. 1116.06
OCTOBER 4, 2018
SHEET 2 OF 3




619 N. Cascade Avenue, Suite 200
Colorado Springs, Colorado 80903
(719)785-0790
(719)785-0799 (Fax)

LEGEND
* NOT PART OF THIS PLAT

HANNAH RIDGE AT FEATHERGRASS FILING NO. 6

A REPLAT OF TRACT KK OF HANNAH RIDGE AT FEATHERGRASS FILING NO. 1, RECEPTION NO. 214713468, RECORDS OF EL PASO COUNTY, COLORADO SECTION 32, TOWNSHIP 13 SOUTH, RANGE 65 WEST OF THE SIXTH PRINCIPAL MERIDIAN, EL PASO COUNTY, COLORADO

AS REPLATTED

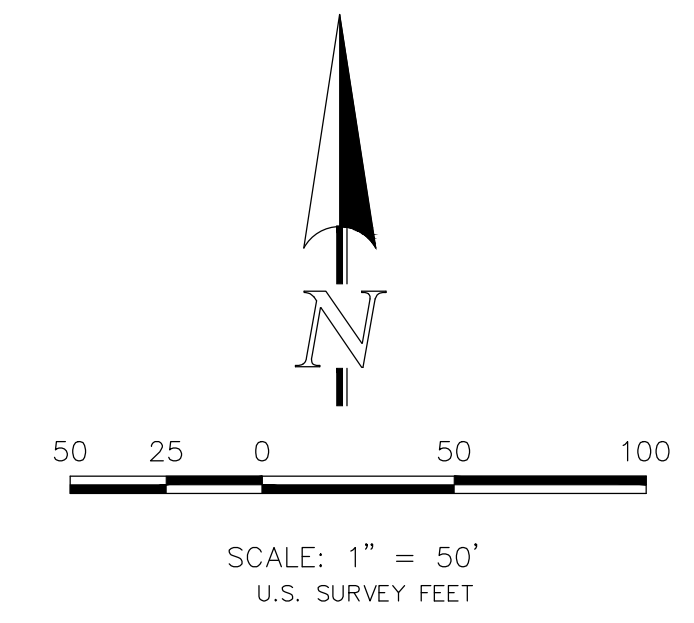

PRELIMINARY
THIS DOCUMENT HAS NOT BEEN
PLAT CHECKED

- LEGEND**
- NO. 5 REBAR WITH 1-1/2" ALUMINUM SURVEYORS CAP STAMPED "COES LLC PLS 30118" TO BE SET
 - RECOVERED MONUMENT AS NOTED
 - (XXXX) ADDRESS
 - * NOT PART OF THIS PLAT
 - (R) RADIAL BEARING

HANNAH RIDGE AT FEATHERGRASS
FILING NO. 6
JOB NO. 1116.06
OCTOBER 4, 2018
SHEET 3 OF 3



619 N. Cascade Avenue, Suite 200
Colorado Springs, Colorado 80903
(719)785-0790
(719)785-0799 (Fax)

N:\111606\DRAWINGS\SUBMIT\PLAT\111606_P3-REV.dwg, 10/17/2018, 8:20:35 AM, 1:1

Markup Summary

Steve Kuehster (1)

SF-18-039



Subject: text box
Page Label: 1
Author: Steve Kuehster
Date: 11/19/2018 3:43:55 PM
Color: ■


SF-18-039

dspdparsons (15)



Subject: Callout
Page Label: 3
Author: dsdparsons
Date: 11/20/2018 2:27:05 PM
Color: ■

PUBLIC

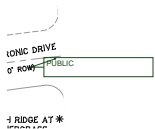

Subject: Callout
Page Label: 3
Author: dsdparsons
Date: 11/20/2018 2:27:15 PM
Color: ■

PUBLIC




Subject: Callout
Page Label: 3
Author: dsdparsons
Date: 11/20/2018 2:27:24 PM
Color: ■

PUBLIC



Subject: Callout
Page Label: 3
Author: dsdparsons
Date: 11/20/2018 2:28:07 PM
Color: ■


define the outer subdivision line boundary with a thicker or different line type. It is difficult to delineate from lot lines

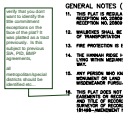

Subject: Callout
Page Label: 1
Author: dsdparsons
Date: 11/20/2018 2:28:47 PM
Color: ■


verify that you dont want to identify the title commitment exceptions on the face of the plat? It was platted as a tract previously. Is this subject to previous SIA, PID, BMP agreements,

all metropolitan/special districts should be identified etc...

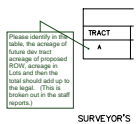

Subject: Callout
Page Label: 1
Author: dsdparsons
Date: 11/20/2018 2:29:30 PM
Color: ■

Please identify in the table, the acreage of future dev tract acreage of proposed ROW, acreage in Lots and then the total should add up to the legal. (This is broken out in the staff reports.)

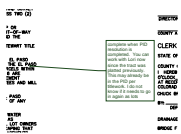

Subject: Callout
Page Label: 1
Author: dsdparsons
Date: 11/20/2018 2:30:36 PM
Color: ■

complete when PID resolution is completed. You can work with Lori now since the tract was platted previously. This may already be in the PID per titlework. I do not know if it needs to go in again as lots




Subject: Airport Overlay
Page Label: 1
Author: dsdparsons
Date: 11/20/2018 2:31:11 PM
Color: ■

Where the Property is Located in the Airport Overlay Zone
 NOTICE OF POTENTIAL AIRCRAFT OVERFLIGHT AND NOISE IMPACT ASSOCIATED WITH AIRPORT: This serves as notice of potential aircraft overflight and noise impacts on this property due to its close proximity to an airport, which is being disclosed to all prospective purchasers considering the use of this property for residential and other purposes. This property is subject to the overflight and associated noise of arriving and departing aircraft during the course of normal airport operations. (Use when this plat is to provide the notice)
 All property within this subdivision is subject to a Notice of Potential Aircraft Overflight and Noise Impact recorded at Reception No. _____, of the records of the El Paso County Clerk and Recorder. (Use when the Notice has previously been recorded)
 All property within this subdivision is subject to an Avigation Easement as recorded at Reception No. _____, of the records of the El Paso County Clerk and Recorder. (Use only when the property is subject to an existing avigation easement as reflected in the title policy)



Subject: Callout
Page Label: 1
Author: dsdparsons
Date: 11/20/2018 2:31:17 PM
Color: ■


see title commitment and modify if necessary

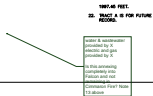

Subject: Callout
Page Label: 1
Author: dsdparsons
Date: 11/20/2018 2:32:46 PM
Color: ■


water & wastewater provided by X
 electric and gas provided by X

Is this annexing completely into Falcon and not remaining in Cimmaron Fire? Note 13 above

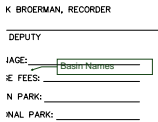


Subject: Callout
Page Label: 1
Author: dsdparsons
Date: 11/20/2018 2:33:13 PM
Color: ■

Basin Names

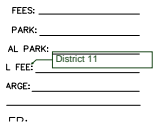

Subject: Callout
Page Label: 1
Author: dsdparsons
Date: 11/20/2018 2:33:22 PM
Color: ■

District 11

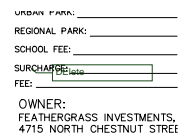

Subject: Callout
Page Label: 1
Author: dsdparsons
Date: 11/20/2018 2:33:29 PM
Color: ■

DElete

PL PARK: _____
FEE: _____
RGE: Delete
ER:
IERGRASS INVESTMENTS, LLC
NORTH CHESTNUT STREET,
200

Subject: Callout
Page Label: 1
Author: dsdparsons
Date: 11/20/2018 2:33:33 PM
Color: █

DElete

OWNERSHIP/MAINTENANCE
 OWNER OF RECORD
 current owner and not
successors

Subject: Callout
Page Label: 1
Author: dsdparsons
Date: 11/20/2018 2:34:55 PM
Color: █

current owner and not successors