


UTE PASS SUMMER HOMES COMPANY SUB. NO. 1A

A VACATION AND REPLAT OF LOTS 91 AND 92
 UTE PASS SUMMER HOMES COMPANY SUB. NO. 1
 A PORTION OF THE SOUTHEAST QUARTER OF THE SOUTHWEST QUARTER OF
 SECTION 15, TOWNSHIP 13 SOUTH, RANGE 68 WEST OF THE 6TH P.M.
 EL PASO COUNTY, COLORADO

Lots 92 and 93 as the previous comment states.

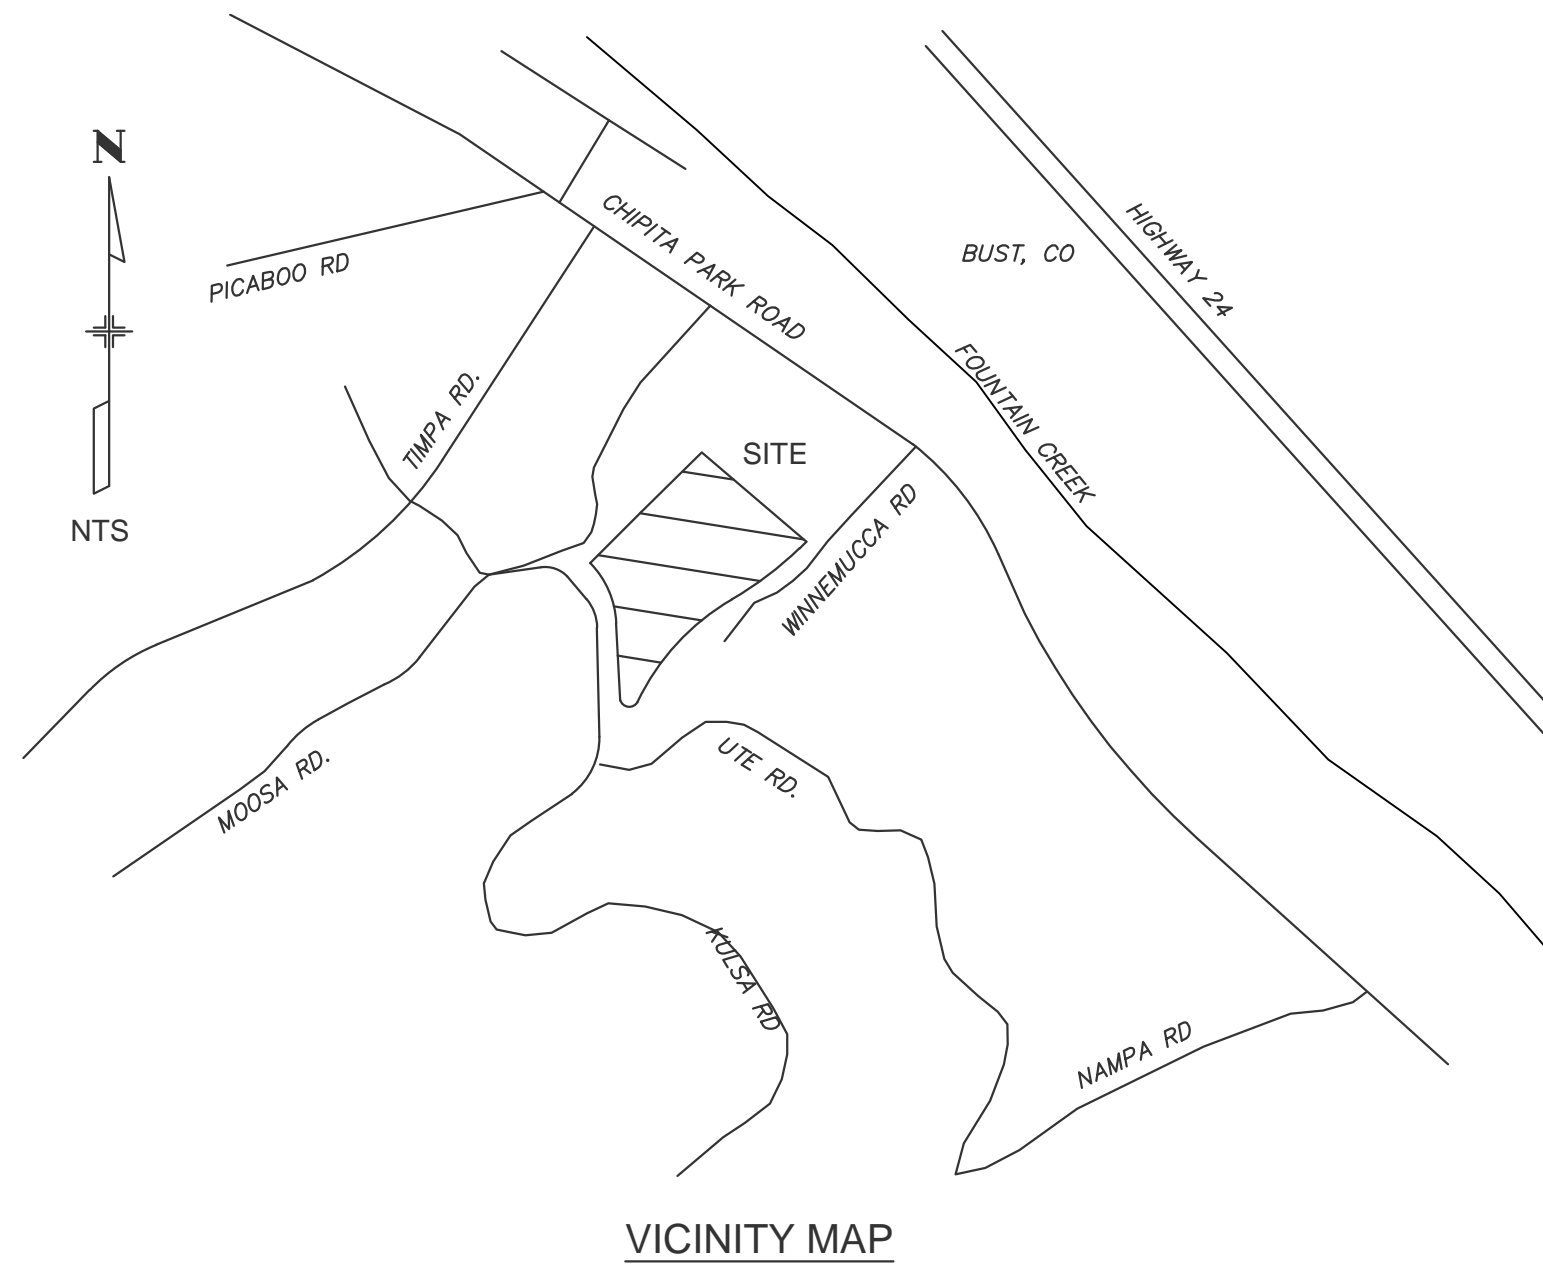

VICINITY MAP

BE IT KNOWN BY THESE PRESENTS:

THAT DONALD J. AND EILEEN F. ZYTKA; ERIC C. WINDESHEIM; AND COLLEEN L. STILES ARE THE OWNERS OF THE FOLLOWING DESCRIBED TRACT OF LAND, TO WIT:

LOTS 92 AND 93, UTE PASS SUMMER HOMES COMPANY SUBDIVISION FILING NO. 1, EL PASO COUNTY, COLORADO ACCORDING TO THE SUBDIVISION PLAT THEREOF RECORDED IN PLAT BOOK O AT PAGES 54 AND 55 OF THE EL PASO COUNTY RECORDS.

THE DESCRIBED TRACT CONTAINS 2.446 ACRES, MORE OR LESS.

OWNERS CERTIFICATE:

THE UNDERSIGNED, BEING ALL THE OWNERS, MORTGAGEES, BENEFICIARIES OF DEEDS OF TRUST AND HOLDERS OF OTHER INTERESTS IN THE LAND DESCRIBED HEREIN, HAVE LAID OUT AND REPLATTED SAID LANDS INTO LOTS AND EASEMENTS AS SHOWN HEREON UNDER THE NAME AND SUBDIVISION OF LOT 92 AND 93, UTE PASS SUMMER HOMES COMPANY SUB. NO. 1 AMENDED PLAT. ALL PUBLIC IMPROVEMENTS SO PLATTED ARE HEREBY DEDICATED TO PUBLIC USE AND SAID OWNER DOES HEREBY COVENANT AND AGREE THAT THE PUBLIC IMPROVEMENTS WILL BE CONSTRUCTED TO EL PASO COUNTY STANDARDS AND THAT PROPER DRAINAGE AND EROSION CONTROL FOR THE SAME WILL BE PROVIDED AT SAID OWNER'S EXPENSE, ALL TO THE SATISFACTION OF THE BOARD OF COUNTY COMMISSIONERS OF EL PASO COUNTY, COLORADO. UPON ACCEPTANCE BY RESOLUTION, ALL PUBLIC IMPROVEMENTS SO DEDICATED WILL BECOME MATTERS OF MAINTENANCE BY EL PASO COUNTY, COLORADO. THE UTILITY EASEMENTS SHOWN HEREON ARE HEREBY DEDICATED FOR PUBLIC UTILITIES, COMMUNICATION SYSTEMS AND OTHER PURPOSES AS SHOWN HEREON. THE ENTITIES RESPONSIBLE FOR PROVIDING THE SERVICES FOR WHICH THE EASEMENTS ARE ESTABLISHED ARE HEREBY GRANTED THE PERPETUAL RIGHT OF INGRESS AND EGRESS FROM AND TO ADJACENT PROPERTIES FOR INSTALLATION, MAINTENANCE AND REPLACEMENT OF UTILITY LINES AND RELATED FACILITIES.

BY: _____
 DONALD J. ZYTKA

BY: _____
 EILEEN F. ZYTKA

BY: _____
 ERIC C. WINDESHEIM

BY: _____
 COLLEEN L. STILES

NOTARIAL:

STATE OF COLORADO) SS
 COUNTY OF EL PASO)
 THE FOREGOING INSTRUMENT WAS ACKNOWLEDGED BEFORE ME THIS _____ DAY OF _____ 2018 BY DONALD J. ZYTKA AND EILEEN F. ZYTKA.

MY COMMISSION EXPIRES: _____
 NOTARY PUBLIC

NOTARIAL:

STATE OF COLORADO) SS
 COUNTY OF EL PASO)
 THE FOREGOING INSTRUMENT WAS ACKNOWLEDGED BEFORE ME THIS _____ DAY OF _____ 2018 BY ERIC C. WINDESHEIM AND COLLEEN L. STILES.

MY COMMISSION EXPIRES: _____
 NOTARY PUBLIC

COUNTY PLANNING AND COMMUNITY DEVELOPMENT DIRECTOR CERTIFICATE:

THIS PLAT FOR LOT 92 AND 93, UTE PASS SUMMER HOMES COMPANY SUB. NO. 1 AMENDED PLAT WAS APPROVED FOR FILING BY THE EL PASO COUNTY, COLORADO PLANNING AND COMMUNITY DEVELOPMENT DIRECTOR ON THIS _____ DAY OF _____ 2018, SUBJECT TO ANY NOTES OR CONDITIONS SPECIFIED HEREON. LOTS 92 AND 93, UTE PASS SUMMER HOMES COMPANY SUB. NO. 1 ARE HEREBY AMENDED FOR THE AREAS DESCRIBED BY THIS PLAT AND IS SUBJECT TO ALL COVENANTS, CONDITIONS AND RESTRICTIONS RECORDED AGAINST AND APPURTENANT TO THE ORIGINAL PLAT RECORDED IN THE OFFICE OF THE EL PASO COUNTY CLERK AND RECORDER, PLAT BOOK O, PAGES 54 AND 55.

 DIRECTOR, COUNTY PLANNING AND COMMUNITY DEVELOPMENT

RECORDING:

STATE OF COLORADO) SS
 COUNTY OF EL PASO)
 I HEREBY CERTIFY THAT THIS INSTRUMENT WAS FILED FOR RECORD AT MY OFFICE AT _____ O'CLOCK _____ M., THIS _____ DAY OF _____ 2018, AND IS DULY RECORDED AT RECEPTION NO. _____ OF THE RECORDS OF EL PASO COUNTY, COLORADO.

CHUCK BROERMAN

BY: _____
 COUNTY CLERK AND RECORDER

FEE: _____

SURCHARGE: _____

FEES:

DRAINAGE FEES: _____

BRIDGE FEES: _____

SCHOOL FEES: _____


PARK FEES: _____

VR 18-07

PREPARED BY
LWA LAND SURVEYING, INC.

953 E. FILLMORE STREET
 COLORADO SPRINGS, COLORADO 80907
 Phone (719) 636-5179

ZYTKA.dwg
 MAY 31, 2018
 PROJECT 16015
 SHEET 1 OF 1

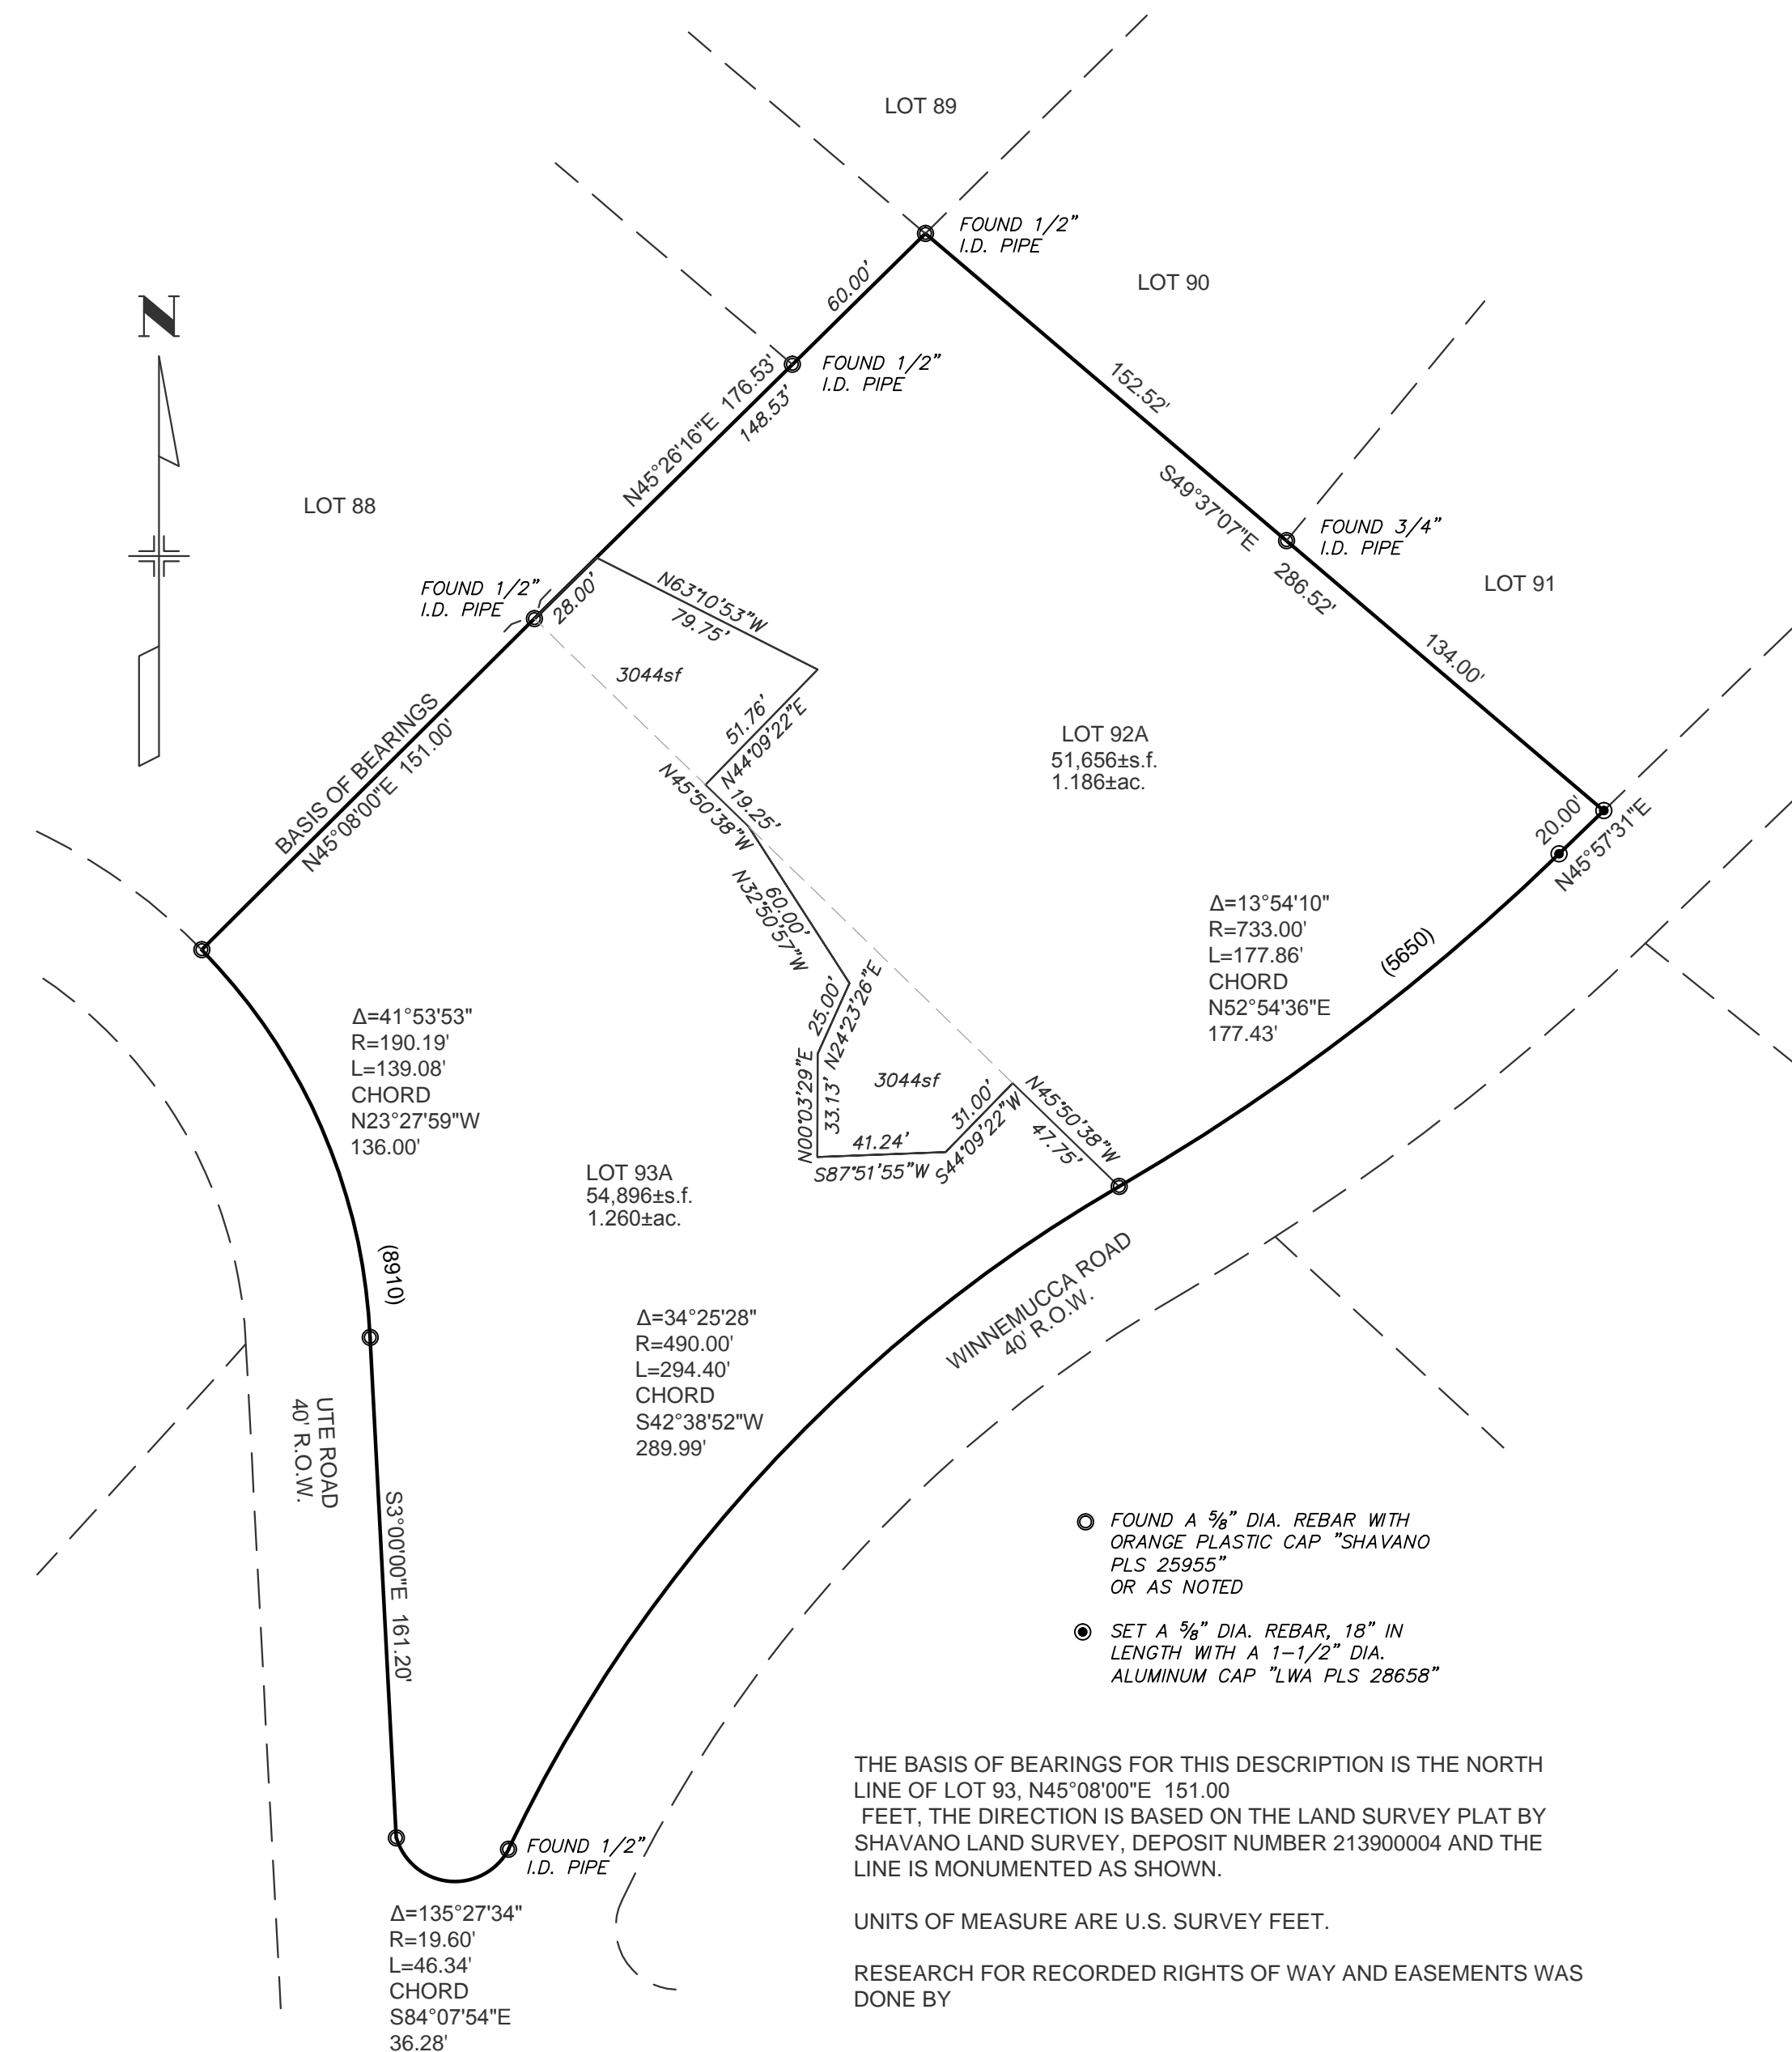

AS AMENDED

THE BASIS OF BEARINGS FOR THIS DESCRIPTION IS THE NORTH LINE OF LOT 93, N45°08'00"E 151.00 FEET. THE DIRECTION IS BASED ON THE LAND SURVEY PLAT BY SHAVANO LAND SURVEY, DEPOSIT NUMBER 213900004 AND THE LINE IS MONUMENTED AS SHOWN.

UNITS OF MEASURE ARE U.S. SURVEY FEET.

RESEARCH FOR RECORDED RIGHTS OF WAY AND EASEMENTS WAS DONE BY _____


SURVEYOR'S CERTIFICATION:

I, KEVIN M. O'LEARY, A DULY REGISTERED PROFESSIONAL LAND SURVEYOR IN THE STATE OF COLORADO, DO HEREBY CERTIFY THAT THIS PLAT TRULY AND CORRECTLY REPRESENTS THE RESULTS OF A SURVEY MADE ON THE DATE OF THE SURVEY, BY ME OR UNDER MY DIRECT SUPERVISION AND THAT ALL MONUMENTS EXIST AS SHOWN HEREON; THAT MATHEMATICAL CLOSURE ERRORS ARE LESS THAN 1:10,000; AND THAT SAID PLAT HAS BEEN PREPARED IN FULL COMPLIANCE WITH ALL APPLICABLE LAWS OF THE STATE OF COLORADO DEALING WITH MONUMENTS, SUBDIVISION, OR SURVEYING OF LAND AND ALL APPLICABLE PROVISIONS OF THE EL PASO COUNTY LAND DEVELOPMENT CODE.


I ATTEST THE ABOVE ON THIS _____ DAY OF _____, 2018.

 KEVIN M. O'LEARY
 COLORADO REGISTERED PLS #28658
 FOR AND ON BEHALF OF
 LWA LAND SURVEYING, INC.

DATE

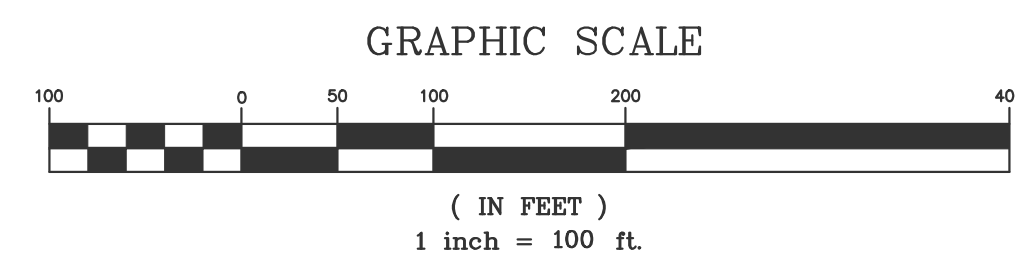

AS PLATTED

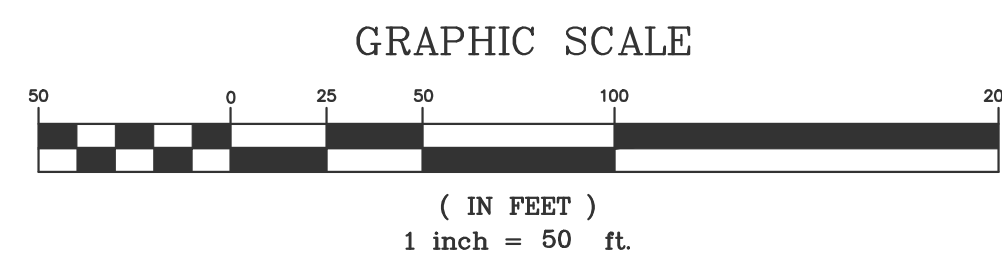

NOTES:

1. THE OWNERS WISH TO ADJUST THE LOT LINE TO BETTER FIT EXISTING IMPROVEMENTS
2. STRUCTURAL FOUNDATIONS ON THE LOTS IN THIS SUBDIVISION SHALL BE DESIGNED BY A COLORADO REGISTERED PROFESSIONAL ENGINEER.
3. THE ADDRESSES EXHIBITED ON THIS PLAT ARE FOR INFORMATIONAL PURPOSES ONLY. THEY ARE NOT THE LEGAL DESCRIPTION AND ARE SUBJECT TO CHANGE.
4. THE APPROVAL OF THIS REPLAT VACATES ALL PRIOR PLATS FOR THIS PROPERTY.
5. THE PROPERTY LIES WITHIN ZONE X, AREAS OUTSIDE OF THE 500 YEAR FLOODPLAIN, PER THE FEMA FLOOD INSURANCE RATE MAP 08041CO490F, DATED MARCH 17, 1997.
6. THIS SUBDIVISION CONTAINS 2 LOTS.
7. STORMWATER DRAINAGE - ALL PROPERTY OWNERS ARE RESPONSIBLE FOR MAINTAINING PROPER STORM WATER DRAINAGE IN AND THROUGH THEIR PROPERTY. PUBLIC DRAINAGE EASEMENTS AS SPECIFICALLY NOTED ON THE PLAT SHALL BE MAINTAINED BY THE INDIVIDUAL LOT OWNERS UNLESS OTHERWISE INDICATED. STRUCTURES, FENCES, MATERIALS OR LANDSCAPING THAT COULD IMPEDE THE FLOW OF RUNOFF SHALL NOT BE PLACED IN DRAINAGE EASEMENTS.
7. NO DRIVEWAY SHALL BE ESTABLISHED UNLESS AN ACCESS PERMIT HAS BEEN GRANTED BY EL PASO COUNTY.
8. EASEMENTS - AS SHOWN.

Markup Summary

dskendall (1)

COMPANY SUB. NO. 1
OF LOTS 91 AND 92
1 OF THE SOUTHWEST QUARTER OF
1/4 SEC 68 WEST OF THE 6TH P.M.
COLORADO

Lots 92 and 93 as the
previous comment
states.

Subject: Callout

Page Label: 1

Author: dskendall

Date: 6/20/2018 3:19:14 PM

Color: ■

Lots 92 and 93 as the previous comment states.