


This was the only sheet uploaded to EDARP under "Drainage Plans." Please send me the full set via email so we can eventually upload it to EDARP with all of the Final docs. Otherwise our inspectors will not have details for the riprap aprons, among other things (per my Review 1 comment in the GEC Plan). On 6/1 I was emailed a 11 page excerpt but it was incomplete and marked-up with internal markings/notations. So I'd still like to see the final full set.

LEGEND:

- BACK OF SCHOOL ACCESS ROAD PHASE 1
- FRONT OF SCHOOL ACCESS ROAD PHASE 2

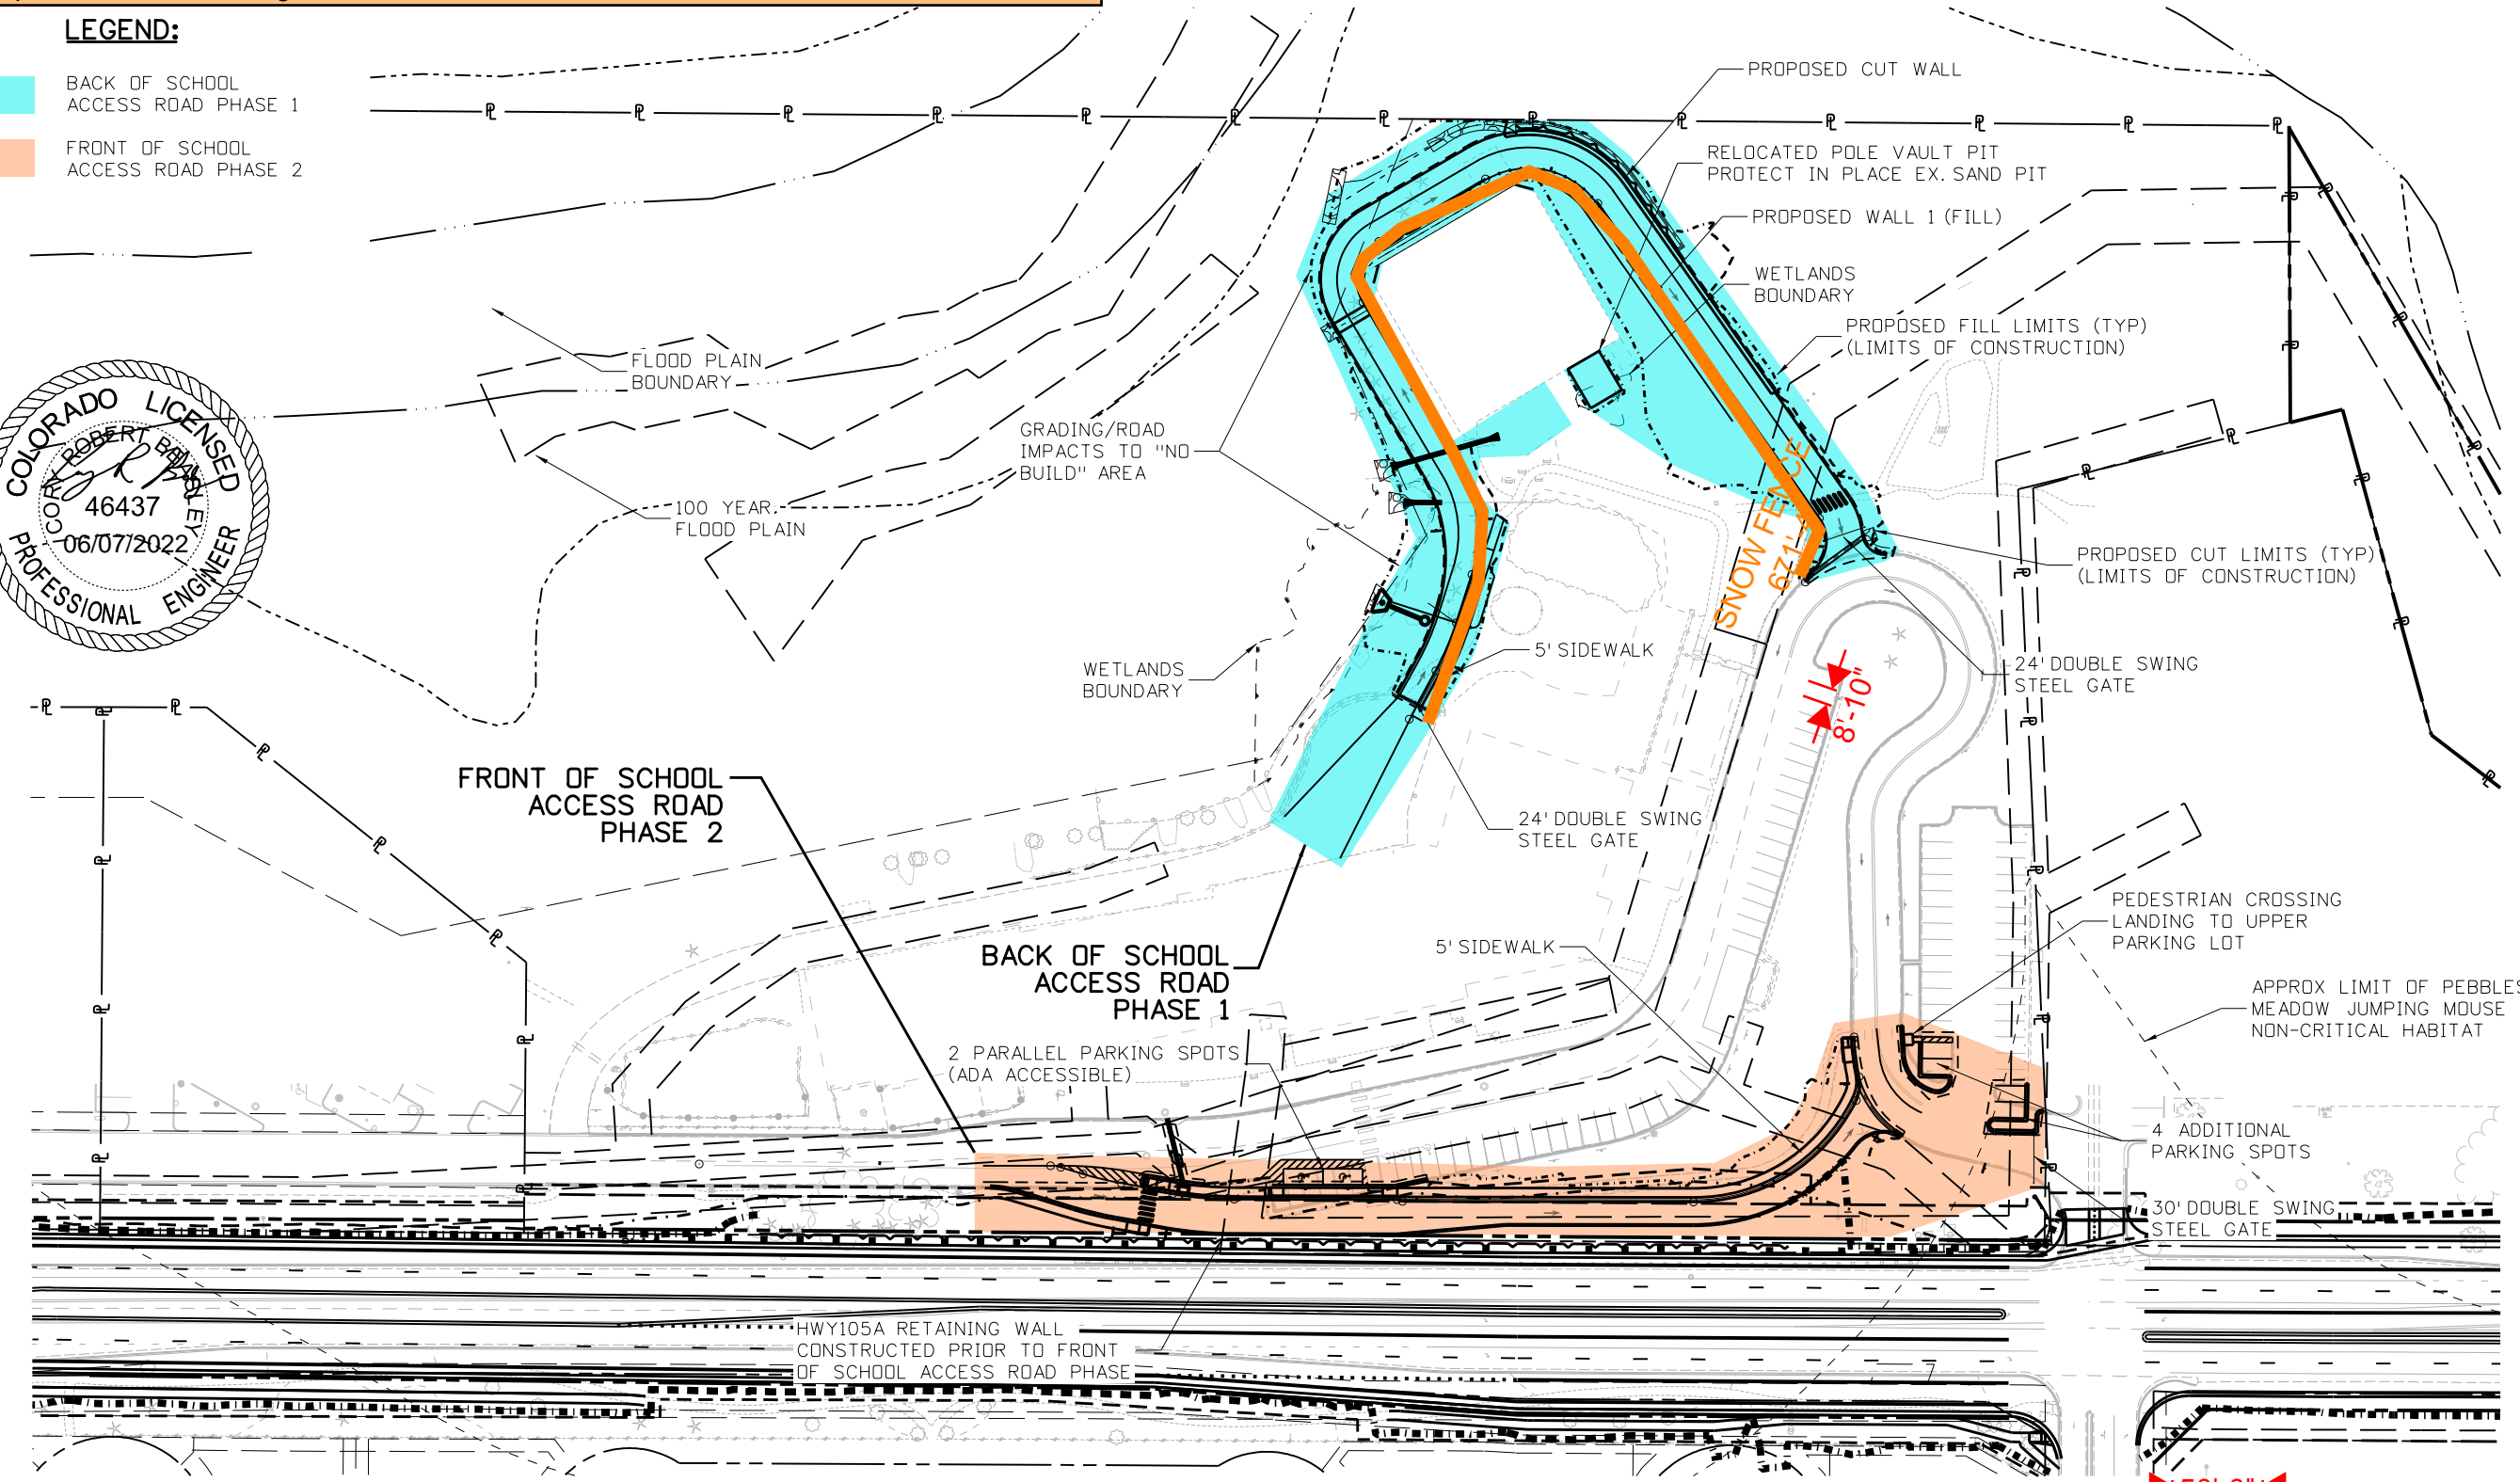

OVERALL MASTER PLANVIEW

Print Date: 6/7/2022
 File Name: SchoolGeneral-04 Overall Sheet.dgn
 Horiz. Scale: 1:100 Vert. Scale: None

Sheet Revisions		
Date:	Comments	Init.



As Constructed
 No Revisions:
 Revised:
 Void:

**MONUMENT ACADEMY
 OVERALL MASTER PLAN**

Designer: J. WILKERT
 Detailer: J. WILKERT
 Sheet Subset: GENERAL

Project No./Code
 19734
 STA 105A-014
 Sheet Number 4 of 82

CBEASLEY 5:18:53 PM p:\P\WAPP\DMA001\NorthCentral_Dmaha\Drawings\Monument Academy\SchoolGeneral-04_OverallSheet.dgn