# THE GLEN AT WIDEFIELD SUBDIVISION FILING NO. 12

A portion of the South One—half (S1/2) of Section 22 Township 15 South (T15S), Range 65 West (R65W) of the 6TH P.M. County of El Paso, State of Colorado

KNOW ALL MEN BY THESE PRESENTS:

That Glen Investment Group No. VIII, LLC, being the owner of the described tract of land, to wit:

LAND DESCRIPTION, THE GLEN AT WIDEFIELD SUBDIVISION FILING NO. 12:

A tract of land located in a Portion of the South One—half (S1/2) of Section 22, Township 15 South (T15S), Range 65 West (R65W) of the 6th P.M., County of El Paso, State of Colorado, being more particularly described as follows:

Beginning at the Northeast corner of Lot 89, Glen at Widefield Subdivision Filing No. 8 as recorded under Reception No. 218714205 in the records of the Clerk and Recorder's Office, County of El Paso, State of Colorado; Thence N89'59'54"W, a distance of 497.00 feet; Thence along the arc of a non-tangential curve to the left, having a central angle of 07'36'38", a radius of 1080.00 feet, an arc length of 143.46 feet, whose chord bears N36'10'01"W; Thence N07'21'14"W, a distance of 635.18 feet; Thence N09'31'38"W, a distance of 584.99 feet to a point on the North line of the South One-half (S1/2) of said Section 22; Thence N89'51'21"E along the North line of the South One-half (S1/2) of said Section 22, a distance of 1161.92 feet; Thence S00'18'38"E, a distance of 483.09 feet; Thence S89'41'22"W, a distance of 28.36 feet; Thence S00'18'38"E, a distance of 170.00 feet; Thence S81'14'24"W, a distance of 43.05 feet; Thence S41'26'03"W, a distance of 38.75 feet; Thence S18'59'59"W, a distance of 87.12 feet; Thence S24'56'29"W, a distance of 48.70 feet; Thence S67'16'30"W, a distance of 133.27 feet; Thence S68'48'W, a distance of 146.71 feet; Thence S00'04'54"W, a distance of 405.64 feet to the Point of Beginning.

Said tract contains 27.229± acres (1,186,077 S.F.) more or less.

#### OWNERS CERTIFICATE:

The undersigned, being all the owners, mortgagees, beneficiaries of deeds of trust and holders of other interests in the land described herein, have laid out, subdivided, and platted said lands into lots, streets, and easements as shown hereon under the name and subdivision of THE GLEN AT WIDEFIELD SUBDIVISION FILING NO. 12. All public improvements so platted are hereby dedicated to public use and said owner does hereby covenant and agree that the public improvements will be constructed to El Paso County standards and that proper drainage and erosion control for same will be provided at said owner's expense, all to the satisfaction of the Board of County Commissioners of El Paso County, Colorado. Upon acceptance by resolution, all public improvements so dedicated will become matters of maintenance by El Paso County, Colorado. The utility easements shown hereon are hereby dedicated for public utilities and communication systems and other purposes as shown hereon. The entities responsible for providing the services for which the easements are established are hereby granted the perpetual right of ingress and egress from and to adjacent properties for installation, maintenance, and replacement of utility lines and related facilities.

Glen Investment Group No. VIII. LLC

J. Mark Watson President Glen Investment Group No. VIII, LLC

# NOTARIAL:

STATE OF COLORADO ) ) S

COUNTY OF EL PASO

The foregoing instrument was acknowledged before me this \_\_\_\_ day

of \_\_\_\_\_, 20\_\_ A.D., by J. Mark Watson, President of Glen Investment Group No. VIII, LLC

# DEDICATION:

The above party in interest has caused said tract to be platted into Lots, Blocks, Streets, Easements and Tracts as shown on the plat, which is drawn to a fixed scale as indicated thereon, and accurately sets forth the boundaries and dimensions of said Lots, Blocks, Streets, Easements, and Tracts which shall be known as "THE GLEN AT WIDEFIELD SUBDIVISION FILING NO. 12" EI Paso County, Colorado. All streets as platted are hereby dedicated to public use and said owner does hereby personally covenant and agree that all platted streets will be graded, paved and that proper drainage for same will be provided at his own expense, all to the satisfaction of the Board of County Commissioners of El Paso County, Colorado, and upon acceptance by resolution, all streets so dedicated will become matters of maintenance by EL Paso County, Colorado.

## BASIS OF BEARINGS STATEMENT

The bearings of this plat are based upon a portion of the Easterly boundary of the Glen at Widefield Subdivision Filing No. 5B as recorded under Reception No. 206712326 in the records of the Clerk and Recorder's Office, County of El Paso, State of Colorado; Said line being also a portion of the Easterly Right—of—Way line of Autumn Glen Avenue as described in said subdivision, being monumented at the Point of Tangency of said boundary by a found cap and rebar marked "PLSC 25968" and at the Point of Curvature of said boundary by a found rebar and cap marked "PLSC 25968". Said line bears N29°46'44"W, a distance of

#### EASEMENTS:

Unless shown greater in width, both sides of all side lot lines will be platted with five (5') foot easements for drainage purposes and public utilities only, and both sides of all rear lot lines will be platted with a ten (10') foot easement for drainage purposes and public utilities only, and all lot lines adjoining a street which has a fifty (50') foot right-of-way width will be platted with a fifteen (15') foot easement, being a five (5') foot easement adjacent to that fifty (50') foot right-of-way for public improvements and a ten (10') foot easement adjacent to the five (5') foot easement for utility purposes, with sole responsibility for maintenance being vested with the adjoining property owners.

#### NOTES:

1. These tracts of land are subject to the following per the Commitment for Title Insurance, prepared by Unified Title Company, Order No. \_\_\_\_\_\_, effective date \_\_\_\_\_\_, 20\_\_ at 7:30 A.M.

9. Any rights of the Spring Lake Reservoir as shown on Map recorded under Reception No. 499772, File No. 836.

10. Terms, agreements, provisions, conditions and obligations as contained in Agreement between W. T. Gore and The League Land Company recorded December 9, 1922 in Book 606 at Page 543 at Reception No. 331050.

11. Right of Way recorded December 1, 1927 in Book 798 at Page 202, subject to the Special Warranty Deed recorded July 19, 1928 in Book 814 at Page 324, subject to the Agreement and Partial Release recorded November 15, 1982 in Book 3634 at Page 80, as modified by and subject to the Colorado Interstate Gas Company Right of Way and Easement Agreement to Pipeline Corridor recorded June 7, 2002 as Reception No. 202092771, and as modified by the Partial Release of Right of Way Agreement recorded February 21, 2008 as Reception No. 208020313.

12. Grant of Right of Way to the Mountain View Electric Association, Inc., recorded May 27, 1963 in Book 1959 at page 87.

13. Grant of Right of Way to the Mountain View Electric Association, Inc., recorded September 30, 1968 in Book 2256 at Page 64.

14. Terms, agreements, provisions, conditions, obligations and easements as contained in Water Line Easement Agreement, recorded May 1, 1997 at Reception No. 97048695.

15. Terms, agreements, provisions, conditions, obligations and easements as contained in Water Line Easement Agreement, recorded May 1, 1997 at Reception No. 97048696.

16. Deed recorded January 08, 1999 at Reception No. 99003604 and correction deed in connection therewith recorded December 02, 1999 at Reception No. 99181769, makes reference to the conveyance of appurtenant water rights.17. Right of Way and easement to Colorado Interstate Gas Company as contained in instrument recorded June 7, 2002 at Reception No.

202092771, and subject to the terms and conditions contained therein.

18. The effects of Order and Decree Organizing the Glen Metropolitan District No. 3 and issuance of Certificate of Election recorded June

24, 2004 at Reception No. 204105072.

19. Terms, agreements, provisions, conditions, obligations and easements as contained in Water and Sanitary Sewer Easement Agreement,

recorded November 18, 2005 at Reception No. 205185609 and recorded August 06, 2007 at Reception No. 207103032.

20. Inclusion within the Security Fire Protection District as evidenced by Order recorded December 9, 2005 as Reception No. 205196147.

21. Terms, agreements, provisions, conditions, obligations and easements as contained in Resolution No. 15—250 by and before the Board of County Commissioners, County of El Paso, State of Colorado, recorded June 18, 2015 at Reception No. 215063410.

22. Terms, agreements, provisions, conditions, obligations and easements as contained in Memorandum of Agreement, recorded June 18, 2015 at Reception No. 215063411.

23. Terms, agreements, provisions, conditions, obligations and easements as contained in Temporary Construction Easement Agreement recorded August 13, 2015 at Reception No. 215087837.

24. Terms, agreements, provisions, conditions, obligations and easements as contained in Grant of Right of Way, recorded December 07,

2015 at Reception No. 215131214.

25. Terms, agreements, provisions, conditions, obligations and easements as contained in Resolution No. 16—141,Approval of Early Grading

26. Terms, agreements, provisions, conditions and obligations as contained in Private Detention Basin/Stormwater Quality Best Management

Permit, by and before the Board of County Commissioners, County of El Paso, State of Colorado, recorded May 3, 2016 at Reception No.

Practice Maintenance Agreement and Easement recorded January 30, 2017 at Reception No. 217011405.

27. Right(s) of way, including its terms and conditions, whether in fee or easement only, as granted to Mountain View Electric Association,

Inc., as described in instrument recorded November 5, 2019 at Reception No. 219138555.

2. Water and sewer service is provided by Widefield Water and Sanitation District subject to the District's rules, regulations, and specifications.

3. The No driveway shall be established unless an access permit has been granted by El Paso County.
4. All structural foundations shall be located and designed by a Professional Engineer, currently registered in the State of Colorado.

5. The following reports have been submitted and are on file at the County Planning and Community Development: Soils and Geological, Water and

Wastewater Resources, Drainage Report, Natural Features Inventory Report, Erosion Control Report, Wetland Impact Report and Traffic Impact Study.

6. No man—made or non—man—made obstructions shall be allowed to penetrate the 40:1 approach surface of the Colorado Springs

7. All exterior lighting plans shall be approved by the Director of Aviation to prevent a hazard to aircraft.

8. No electromagnetic, light, or any other physical emissions which might interfere with aircraft, avigation, communications or navigational aids shall be allowed.

9. The Airport Advisory Commission suggests that residences constructed in this area should include F.A.A. approved sound mitigation construction techniques to obtain at least a 25db reduction in interior noise.

NOTICE: This property may be adversely impacted by noise caused by aircraft operating into and out of the Colorado Springs Municipal Airport. The buyer should familiarize himself/herself with this potentiality and the ramifications thereof.

10. All property owners are responsible for maintaining proper storm water drainage in and through their property. Public drainage easements as

specifically noted on the plat shall be maintained by the individual lot owners unless otherwise indicated. Structures, fences, materials or landscaping that could impede the flow of runoff shall not be placed in drainage easements.

11. No lot or interest therein, shall be sold, conveyed, or transferred whether by deed or by contract, nor shall building permits be issued, until

and unless either the required public and common development improvements have been constructed and completed and preliminary accepted in accordance with the Subdivision Improvements Agreement between the appleicant/owner and El Paso County as recorded under Reception Number \_\_\_\_\_\_\_ in the Office of the Clerk and Recorder of El Paso County, Colorado or, in the alternative, other collateral is provided to make provision for the completion of said improvements in accordance with the El Paso County Land Development Code and Engineering Criteria Manual. Any such alternative collateral must be approved by the Board of County Commissioners or, if permitted by the Subdivision Improvements Agreement, by the Planning and Community Development Director and meet the policy and procedure requirements of El Paso County prior to the release by the County of any lots for sale, conveyance or transfer.

prior to the release by the County of any lots for sale, conveyance or transfer.

This plat restriction may be removed or rescinded by the Board of County Commissioners or, if permitted by the Subdivision Improvements Agreement, by the Planning and Community Development Director upon either approval of an alternative form of collateral or completion and preliminary acceptance by the El Paso Board of County Commissioners of all improvements required to be constructed and completed in accordance with said Subdivision Improvements Agreement. The partial release of lots for sale, conveyance or transfer may only be granted in accordance with any planned partial release of lots authorized by the Subdivision Improvements Agreement.

12. All corner lots will be platted with a Sight Visibility and Public Improvements Easement as shown in the "Typical Public Improvement Easement" detail.

No obstructions greater than thirty (30") inches in height above flow line elevation of the adjacent roadway are allowed within this area. The sole responsibility for maintenance and ownership being vested with individual property owners.

13. The addresses (0000) exhibited on this plat are for informational purposes only. They are not the legal descriptions and are subject to change.

16. This property may be adversely impacted by possible radio towers installation on an adjacent parcel. The buyer should familiarize himself/herself

with this potentiality and ramification thereof.

17. This property is subject to the Protective Covenants, recorded at Reception No. \_\_\_\_\_\_, in the records of the El Paso County Clerk and Recorder.

18. This survey does not constitute a title search by Pinnade Land Surveying Company to determine ownership of easements of record. For all information regarding easement, rights-of-way and title of record, Pinnade Land Surveying Company relied upon a Commitment for Title Insurance, recording

prepared by Unified Title Company, Order No. 70583UTC, effective date January 20, 2020 at 7:30 A.M.

19. Developer shall comply with federal and state laws, regulations, ordinances, review and permit requirements, and other agency requirements, if any, of applicable agencies including, but not limited to, the Colorado Department of Wildlife, Colorado Department of Transportation, U.S. Army the Corps of Engineers, the U.S. Fish & Wildlife Service and/or Colorado Department of Wildlife regarding the Endangered Species Act, particularly as

it relates to the Preble's Meadow Jumping Mouse as a listed threatened species.

20. Mailboxes shall be installed in accordance with all El Paso County and United States Postal Service regulations.

#### NOTES CONTINUED:

- 21. The Subdivider(s) agrees on behalf of him/herself and any developer or builder successors and assignees that Subdivider and/or said successors and assigns shall be required to pay traffic impact fees in accordance with the El Paso County Road Impact Fee Program Resolution (Resolution No. 19-471), or any amendments thereto, at or prior to the time of building permit submittals. The fee obligation, if not paid at final plat recording, shall be documented on all sales documents and on plat notes to ensure that a title search would find the fee obligation before sale of the property.
- 22. The property in The Glen at Widefield Subdivision Filing No. 12 is located in Flood Zone X, determined to be outside the 500—year floodplain per FEMA Flood Insurance Rate Maps 08041C956 G and 08041C957 G, Effective dates December 07, 2018.
- 23. Pursuant to Resolution No.\_\_\_\_\_\_, approved by the Board of Directors, El Paso County Public Improvement District \_ and recorded in the records of the El Paso County Clerk and Recorder at Reception Number \_\_\_\_\_\_, the parcels within the platted boundaries of Glen at Widefield Subdivision Filing No. 12 are included within the boundaries of the El Paso County Public Improvement District #2 and as such is subject to applicable road impact fees and mill levy.
- 25. This plat has opted to be included in the 10-mil PID #2 for the road impact fee program. The fee is based on the established rate at the time of building permit application.
- 26. Tracts "A", "B", and "C" are to be used for open space, public and private utilities, drainage, trails, and signage. The tracts will be owned and maintained by The Glen Metropolitan District.
- 28. All distances shown hereon are in US Feet.
- 29. There are 79 lots and 3 tracts within this subdivision.

Please add the following notes (customize as necessary)

Soil and Geology Conditions:

Geologic Hazard Note-Final Plat: (to be customized based upon the individual circumstances)

The following lots have been found to be impacted by geologic hazards. Mitigation measures and a map of the hazard area can be found in the report (Title of Report, generally from the Preliminary Plan file) by (author of the report) (date of report) in file (name of file

and file number) available at the El Paso County Planning and Community Development Department:

\*Downslope Creep: (name lots or location of area)

Rockfall Source:(name lots or location of area)Rockfall Runout Zone:(name lots or location of area)

Potentially Seasonally High Groundwater:(name lots or location of area)

Other Hazard:
In Areas of High Groundwater:


Due to high groundwater in the area, all foundations shall incorporate an underground drainage system.

Where the Property is Located in the Airport Overlay Zone

NOTICE OF POTENTIAL AIRCRAFT OVERFLIGHT AND NOISE IMPACT ASSOCIATED WITH AIRPORT: This serves as notice of potential aircraft overflight and noise impacts on this property due to its close proximity to an airport, which is being disclosed to all prospective purchasers considering the use of this property for residential and other purposes. This property is subject to the overflight and associated noise of arriving and departing aircraft during the course of normal airport operations. (Use when this plat is to provide the notice)

All property within this subdivision is subject to a Notice of Potential Aircraft Overflight and Noise Impact recorded at Reception No.

\_\_\_\_\_\_, of the records of the EI Paso County Clerk and Recorder. (Use when the Notice has previously been recorded)
All property within this subdivision is subject to an Avigation Easement as recorded at Reception No. \_\_\_\_\_\_\_, of the records of the EI Paso County Clerk and Recorder. (Use only when the property is subject to an existing avigation easement as reflected in the title policy)

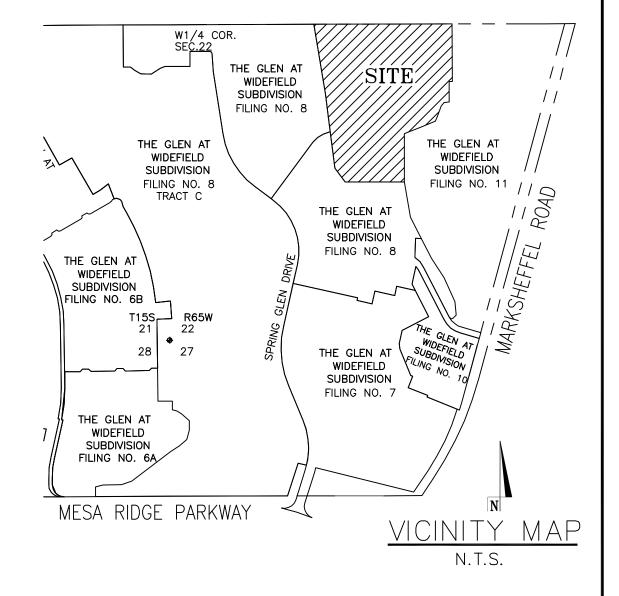

#### APPROVALS:

The accompanying please remove this signature block and add

Development this \_\_\_ the PCD Director signature line underneath the BoCC Chair signature line. You do not need to refer to the Director by name.

Community

BOARD OF COUNTY COMMISSIONERS CERTIFICATE:/

This plat for THE GLEN AT WIDEFIELD SUBDIVISION FILING No. 11 was approved for filing by the El Paso County, Colorado Board of County Commissioners on the \_\_\_\_\_ day of \_\_\_\_\_, 20\_\_, subject to any notes specified hereon and any conditions included in the resolution of approval. The dedications of land to the public streets, and easements are accepted, but public improvements thereon will not become the maintenance responsibility of El Paso County until preliminary acceptance of the public improvements in accordance with the requirements of the Land Development Code and Engineering Criteria Manual, and the Subdivision Improvements Agreement

					_
Chair,	Board	of	County	Commissioners	Ī

## ASSESSOR:

Steve Schleiker, El Paso County Assessor

# RECORDING:

I hereby certify that this instrument was filed for record in my office at \_\_\_\_ o'clock \_\_\_.M., this \_\_\_\_ day of \_\_\_\_\_, 20\_\_ A.D., and is duly recorded at Reception No. \_\_\_\_ of the records of El Paso County, Colorado.

SURCHARGE: \_\_\_\_\_ CHUCK BROERMAN, Recorder

FEE: \_\_\_\_\_ By: \_\_\_\_\_\_

Deputy

SCHOOL FEE - DISTRICT# \_\_\_\_: \_\_\_\_:

PARK FEES:

REGIONAL:

DRAINAGE BASIN:\_\_\_\_\_\_

DRAINAGE AND SURETY FEES: \_\_\_\_\_\_

BRIDGE FEE: \_\_\_\_\_\_

## SURVEYOR'S CERTIFICATION:

Add the following information:

Name, address and telephone

number of the owner of record

located in the lower right hand

Date of preparation, date of survey

Names, address, and telephone

preparing the plat (e.g., licensed

designer of the plat) located in the

Date of submission with provisions

for dating revisions located in the

surveyor, licensed engineer or

lower right hand corner (if

lower right hand corner

number of person(s) responsible for

corner,

(if applicable),

applicable).

I, John W. Towner, a duly registered Professional Land Surveyor in the State of Colorado, do hereby certify that this plat truly and correctly represents the result of a survey made on June 7, 2000, by me or under my direct supervision and that all monuments exist as shown hereon; that mathematical closure errors are less than 1:10,000; and that said plat has been prepared in full compliance with all applicable laws of the State of Colorado dealing with monuments, subdivision, or surveying of land and all applicable provisions of the El Paso County Land Development Code. I attest the above on this \_\_\_\_\_ day of \_\_\_\_\_\_, 202 .

PINNACLE LAND SURVEYING CO., INC.

John W. Towner, Registered Professional Land Surveyor No. 25968

PCD FILE NO. SF-22-024

THE GLEN AT WIDEFIELD SUBDIVISION FILING NO.12

DRAWN BY: CHECKED BY: DATE: 12/02/21
JOB NO.: 19001800 DWG: 19001800FP.DWG SHEET 1 OF 2

	GLEN 12 AC	CREAGE TABLE				
TRACTS		OWNERSHIP & MAINTENANCI				
TRACT A	2.033 AC	THE GLEN METROPOLITAN DISTRICT				
TRACT B	2.289 AC	THE GLEN METROPOLITAN DISTRICT				
TRACT C	1.201 AC	THE GLEN METROPOLITAN DISTRICT				
TOTAL ACREAGE	5.523 AC					
RIGHT-OF-WAY (R.O.W.)						
TOTAL ACREAGE	4.000 AC					
LOTS (79 TOTAL)						
TOTAL ACREAGE	17.706 AC					
TOTAL GLEN 12						
TOTAL ACREAGE	27.229 AC					

Has this agreement

already been entered

into? If so, please fill

please provide a copy

agreement for review

in the blanks. If not,

of the proposed

and recordation

the proposed or

submittal.

alongside final plat.

Either way, a copy of

recorded park lands

agreement should be

provided with the next

Update this note

