# Letter of Notice to Adjacent Property Owners

December 4th, 2020

Dear Adjacent Property Owner,

This letter is being sent to you because CSpringsDesign construction project in El Paso County at the reference otherwise known as 9177 CUT BANK WAY COLORADO!

Please direct any questions on the proposal to the refe proposal (if required) a notification of the time and pla owners by the El Paso County Planning Department. At information, the file number, and an opportunity to resperson

Please notify additional properties per email sent on 12/23 and per snip below. All properties with a red circle must be notified, for a total of 9 notices.



pergola IL NO 1

this operty t riting or in

Adjacent properties requiring notification are lots 53,54,55, 70, 72 HOMESTEAD AT STERLING RANCH FIL NO 1

For questions specific to this project, please contact the contractor:

Archadeck of Colorado Springs 590 W Highway 105 Suite 162 Monument, CO 80132 work: (719) 793-9412

email: <a href="mailto:coloradosprings@archadeck.net">coloradosprings@archadeck.net</a>

web site: https://coloradosprings.archadeck.com/

Pikes Peak Regional Building Department Contractor ID: 24178 (CSpringsDesign LLC DBA Archadeck of Colorado Springs)

Site Location:

The lot for which this notification is referencing is LOT 71 HOMESTEAD AT STERLING RANCH FIL NO 1 otherwise known as 9177 CUT BANK WAY COLORADO SPRINGS CO, 80908

#### Request and Justification:

The purpose for this application is to request administrative relief from the rear lot setback for LOT 71 HOMESTEAD AT STERLING RANCH FIL NO 1. The request asks for the rear setback requirement be reduced by ~2' to ~23' (vs. the required 25') to allow for a pergola overhang slightly over the existing patio structure. This new setback allowance represents an approximate 8% or less encroachment for the pergola overhang, and allows for the proposed structure to simply cover the existing patio with a typical design for this type of structure. Not allowing would cause a non-standard design compared with pergolas of a similar nature over an existing patio, and would detract from the standard look and feel of an acceptable structure with a normal overhang from outside supporting posts

The requested adjustment of setback outlined above to consist of as follows:

Rear: 23.0' (8% reduction)

Side: No change - 21.78' (only 5' required)

#### **Existing and Proposed Facilities:**

Subdivision infrastructure has been completed, including utility, roads and walk surrounding the lot. No other waivers or requests are anticipated. Please see enclosed Vicinity Map showing Adjacent property owners and site plan for further information.

### Cordially,

Jim Shoff Owner Archadeck of Colorado Springs 590 W Highway 105 Suite 162 Monument, CO 80132

Monument, CO 80132 work: (719) 793-9412


email: <a href="mailto:coloradosprings@archadeck.net">coloradosprings@archadeck.net</a>


web site: <a href="https://coloradosprings.archadeck.com/">https://coloradosprings.archadeck.com/</a>


Pikes Peak Regional Building Department Contractor ID: 24178 (CSpringsDesign LLC DBA Archadeck of Colorado Springs)

#### **Enclosures:**

#### Vicinity Map

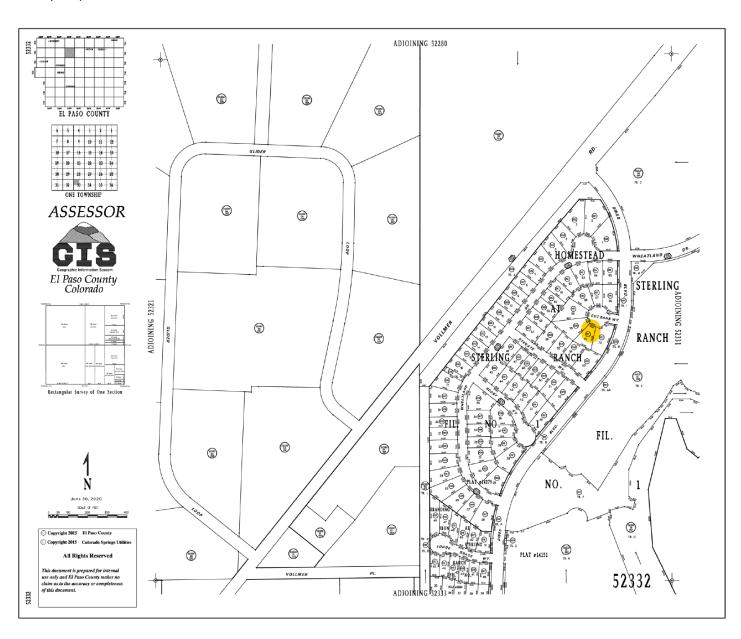

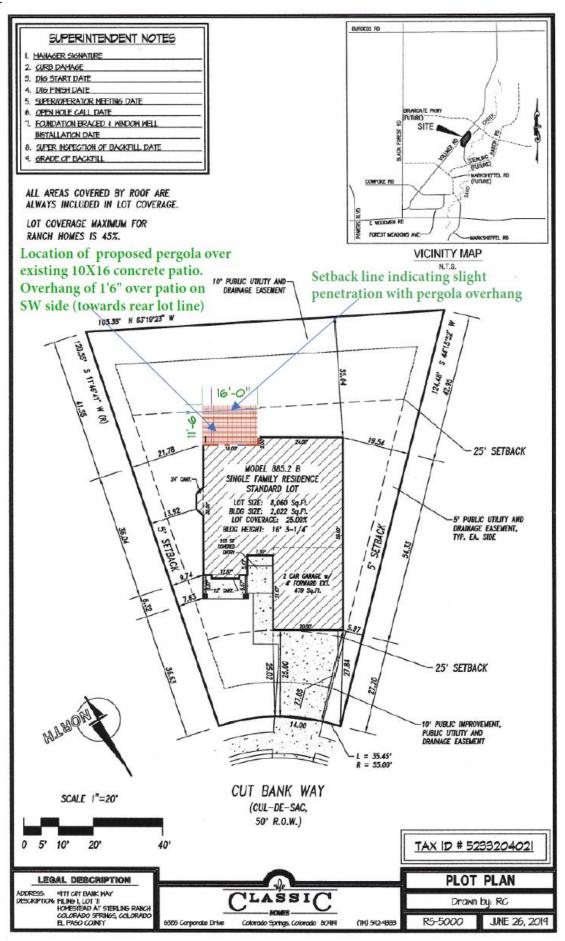

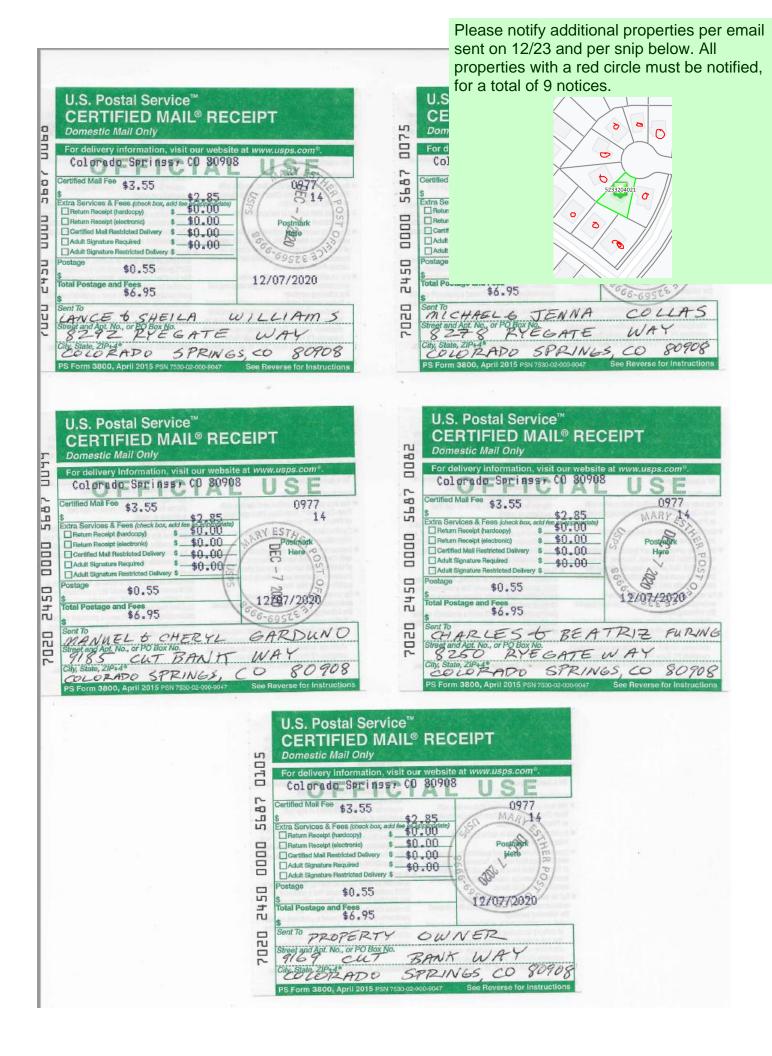

# Adjacent Property Owner Notices\_V1.pdf Markup Summary

## Image (3)



Subject: Image Page Label: 4

Author: Sophie Kiepe

Date: 12/23/2020 1:00:59 PM

Status: Color: Layer: Space:



Subject: Image Page Label: 1

Author: Sophie Kiepe

Date: 12/23/2020 1:02:01 PM

Status:
Color: Layer:
Space:



Subject: Image Page Label: 1

Author: Sophie Kiepe

Date: 12/23/2020 1:02:56 PM

Status: Color: Layer: Space:

# Text Box (2)



Subject: Text Box Page Label: 4 Author: Sophie Kiepe

Date: 12/23/2020 1:00:59 PM

Status: Color: Layer: Space: Please notify additional properties per email sent on 12/23 and per snip below. All properties with a red circle must be notified, for a total of 9 notices.



Subject: Text Box Page Label: 1 Author: Sophie Kiepe Date: 12/23/2020 1:02:41 PM

Status: Color: Layer: Space: Please notify additional properties per email sent on 12/23 and per snip below. All properties with a red circle must be notified, for a total of 9 notices.