
Landscape Plan Drawings_V1 redlines.pdf Markup Summary

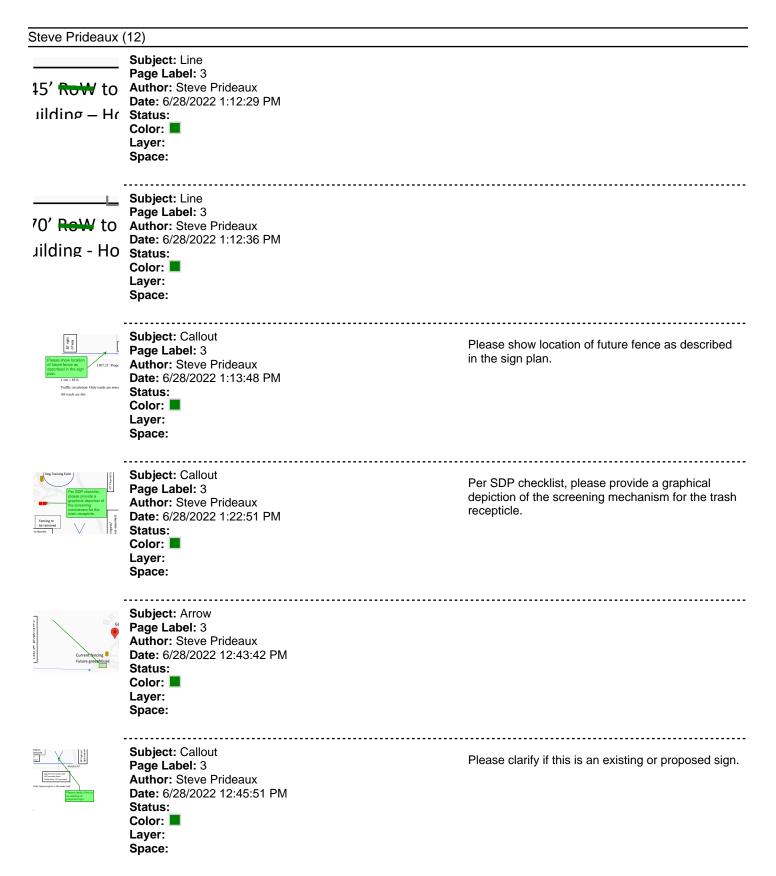

Subject: Callout Provide setback distances from existing and Page Label: 3 proposed structures to all property lines. Author: Steve Prideaux Date: 6/28/2022 12:51:59 PM Status: Color: Layer: Space: Subject: Text Box This level of detail is typically show/provided on the Page Label: 3 site development plan (as opposed to the Author: Steve Prideaux landscaping plan). Date: 6/28/2022 12:56:17 PM Status: Color: Layer: Space: Subject: Group Page Label: 3 Author: Steve Prideaux Date: 6/30/2022 11:10:34 AM Status: Color: Layer: Space: Subject: Callout Is this 76' from the southern property line? Page Label: 3 Author: Steve Prideaux Date: 6/30/2022 11:14:10 AM Status: Color: Layer: Space: Subject: Callout Per SDP checklist, provide parking calculations Page Label: 3 (e.g., required versus proposed). Also need to Author: Steve Prideaux provide open space, landscaping, and Date: 6/30/2022 11:15:04 AM impermeable surface percentages. Status: Color: Layer: Space: Subject: Callout Per SDP checklist, provide parking calculations Page Label: 1 (e.g., required versus proposed). Author: Steve Prideaux Date: 6/30/2022 11:15:47 AM Status: Color: Layer: Space:

12900 Murphy Rd Elbert, Co Property Tax Schedule # 4132000009

Legal Description:

SW4SW4 SEC 32-11-64 AS FOLS: BEG AT SW COR OF SD SEC, TH N 0<40'31" E 1332.94 FT TO NW COR OF SD SW4SW4, N 89<47'36" E 1306.23 FT TO NE COR OF SW4SW4, S 0<37'57" W 1334.29 FT TO SE COR OF SW4SW4, TH S 89<5'11" W 1307.21 FT TO POB, SUBJ TO AND TOG WITH R/W EASEMENT AS DES BY BK 2806-855

The southwest quarter of the southwest quarter of section 32, Township 11 south, range 64 west of the 6th P.M., County of El Paso, state of Colorado, described as follows: beginning at the southwest quarter of section 32, township 11 south, range 64 west; thence, N 0 degrees 40 minutes 31 seconds E A distance of 1332.94 feet to the northwest corner of the southwest quarter of the southwest quarter of said section 32; thence N 89 degrees 47 minutes 36 seconds E a distance of 1306.23 feet to the Northeast corner of the southwest quarter of said section 32; thence S 0 degrees 37 minutes 57 seconds W a distance of 1334.29 feet to the southeast corner of the southwest quarter of said section 32; thence S 89 degrees 51 minutes 11 seconds W a distance of 1307.21 feet to the point of beginning.

Lot size: 40 acres

Lot area coverage: 1,742,668 ft²

Zoning: Zoning District A-35

Proposed/Current Use: Major Dog Kennel, Dog training yards, Residential Housing (1 home, 1 duplex with garage, 1 manufactured home, 1 single wide), Greenhouse, Horse Stable, walking trails.

Total gross building square footage 17,439 ft^2

Open space, landscaping, and impermeable surface 1,725,524 ft² or 1%


Density/total number of dwelling units (residential): 4 residential units - 8,064 ft^2

Parking computations 4 spaces, non-paved - footage included in open space 648 ft^2

Per SDP checklist, provide parking calculations (e.g., required versus proposed). 4/21/2022 American Dog Pros Site Plan Chris Dunlap 719 287-1449 pinnacleK9training@gmail.com

12900 Murphy Rd Elbert, Co Property Tax Schedule # 4132000009


Vicinity map showing the subdivision in relation to section lines and existing or proposed arterial or collector roadways

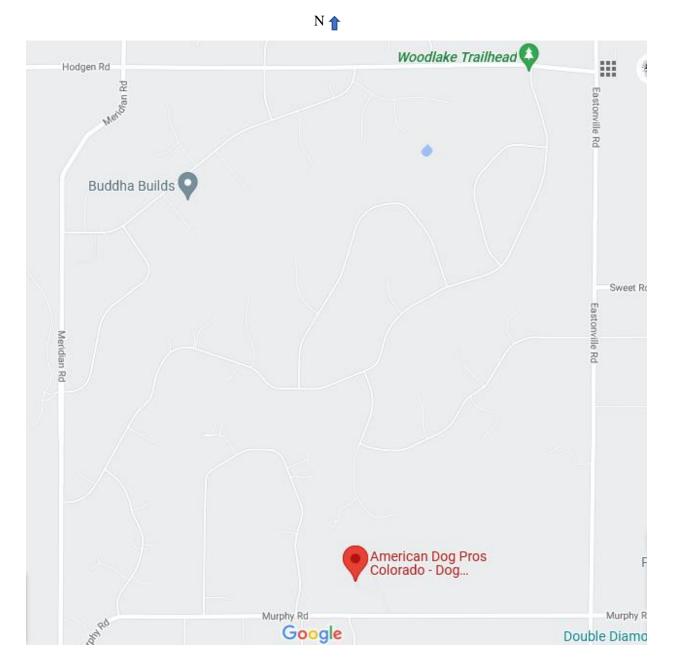

Footprint of all existing and proposed buildings and the setback distances from each existing and proposed structure to the property lines. No sidewalks. (next page)

4/21/2022 American Dog Pros Site Plan Chris Dunlap 719 287-1449 pinnacleK9training@gmail.com

This level of detail is typically show/provided on the site development plan (as opposed to the landscaping plan).

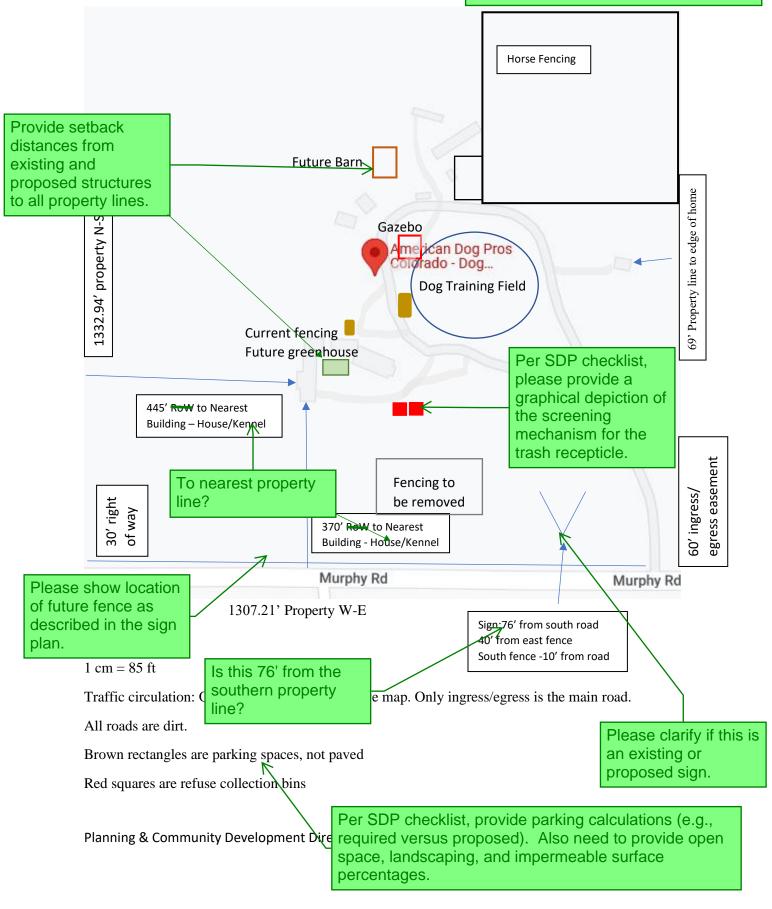

4/21/2022 American Dog Pros Site Plan Chris Dunlap 719 287-1449 pinnacleK9training@gmail.com

12900 Murphy Rd Elbert, Co Property Tax Schedule # 4132000009

All trees are native ponderosa pines.



Proposed landscaping plan is to xeroscape the area between the parking and main building with native Colorado plants. These plants have not been bought as it is not the planting season as of yet. All plants will be waist high to ground cover based on availability.