


Black double lines show outside fence for kennels - Black solid line is the building perimeter. Lighter black lines denote the inside walls.

Training kennels attach to the south east corner of office at an approximate 225 degree angle

This floor plan does not match the outline from the "ILC" Please clarify.

Kennels and home are attached by the south wall and a locking door. The upstairs master bedroom and bathroom are over 39' of the far south section of these kennels. (red)

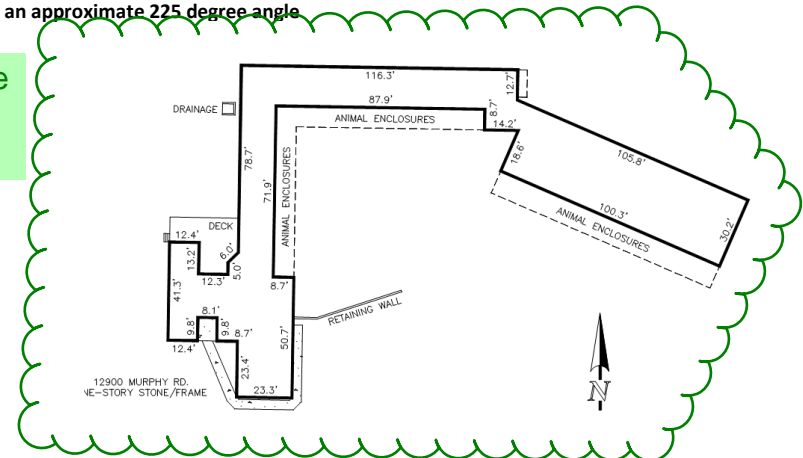

Floor Plans_V2.pdf Markup Summary

9/7/2022 5:06:06 PM (1)




Subject: Image
Page Label: 1
Author: Linda.Nguyen
Date: 9/7/2022 5:06:06 PM
Status:
Color: ■
Layer:
Space:

9/7/2022 5:06:19 PM (1)



Subject: Cloud
Page Label: 1
Author: Linda.Nguyen
Date: 9/7/2022 5:06:19 PM
Status:
Color: ■
Layer:
Space:

9/7/2022 5:06:42 PM (1)

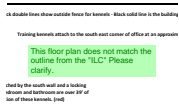

Subject: Text Box
Page Label: 1
Author: Linda.Nguyen
Date: 9/7/2022 5:06:42 PM
Status:
Color: ■
Layer:
Space:

This floor plan does not match the outline from the "ILC" Please clarify.