

Sign Plan_V1.pdf Markup Summary

Steve Prideaux (6)



Subject: Callout
Page Label: 2
Author: Steve Prideaux
Date: 6/28/2022 1:06:47 PM
Status:
Color: ■
Layer:
Space:

Please show sign setback distance to the property line (as opposed to the road).



Subject: Callout
Page Label: 1
Author: Steve Prideaux
Date: 6/30/2022 11:33:51 AM
Status:
Color: ■
Layer:
Space:

Please show location on site development plan.




Subject: Callout
Page Label: 1
Author: Steve Prideaux
Date: 6/30/2022 11:42:46 AM
Status:
Color: ■
Layer:
Space:

Please cite distance from the southern property line.




Subject: Callout
Page Label: 1
Author: Steve Prideaux
Date: 6/30/2022 11:43:07 AM
Status:
Color: ■
Layer:
Space:

Is this the sign copy?

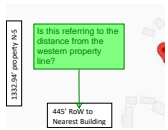


Subject: Callout
Page Label: 2
Author: Steve Prideaux
Date: 6/30/2022 12:43:48 PM
Status:
Color: ■
Layer:
Space:

Is this referring to the distance from the western property line?

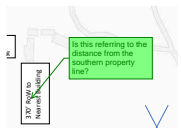

Subject: Callout
Page Label: 2
Author: Steve Prideaux
Date: 6/30/2022 12:44:33 PM
Status:
Color: ■
Layer:
Space:

Is this referring to the distance from the southern property line?

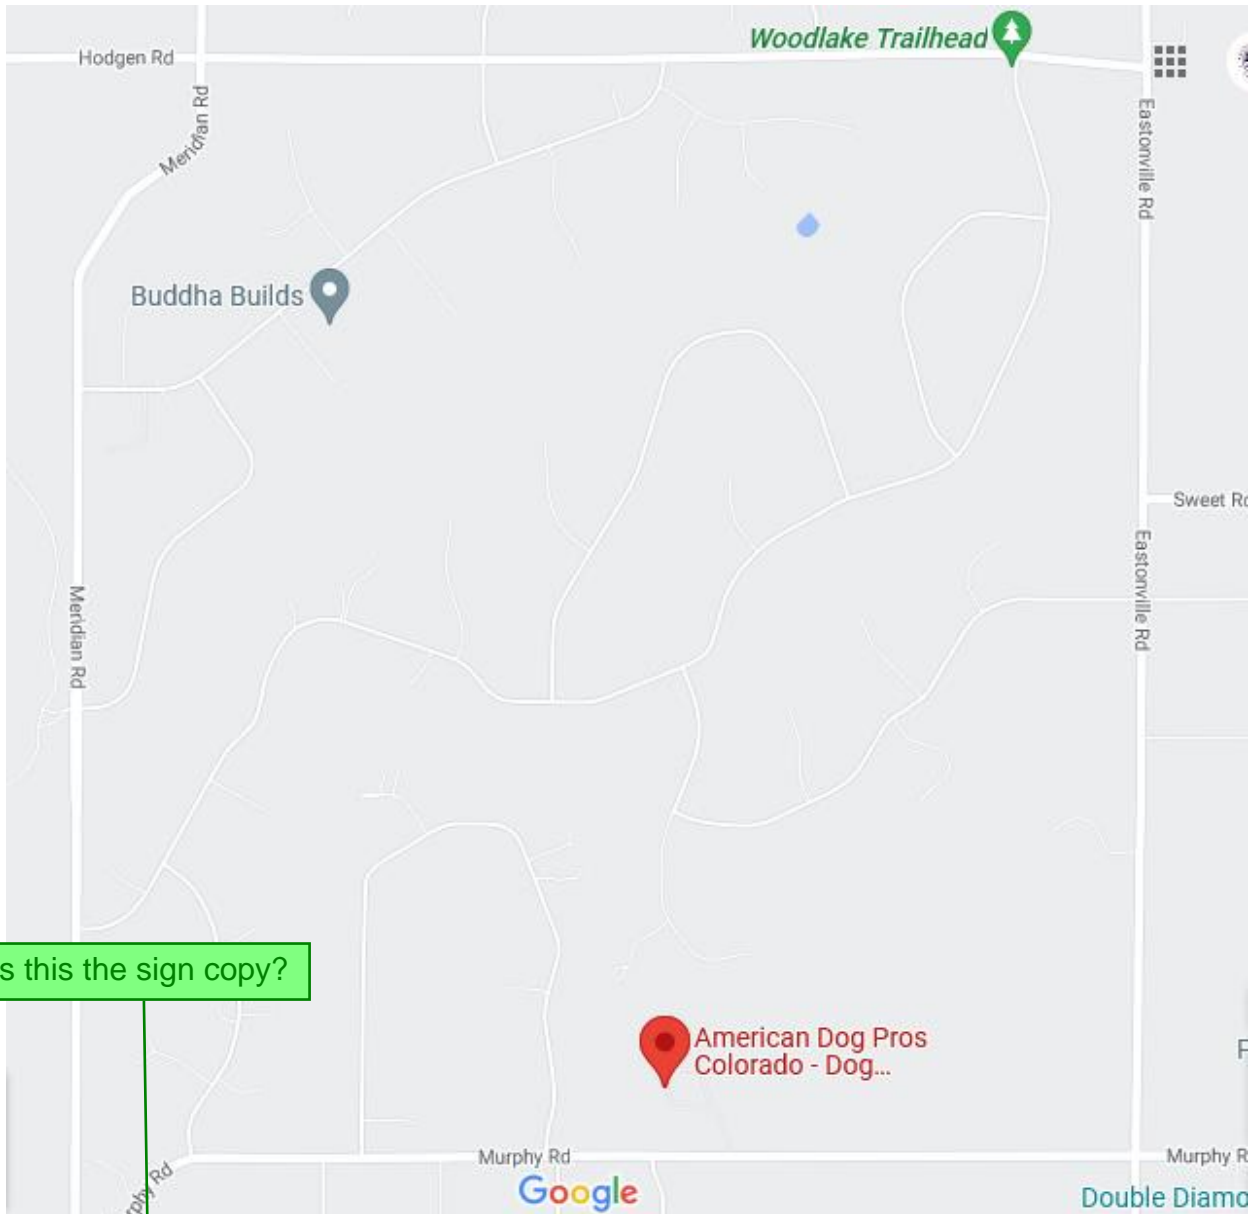

Is this the sign copy?



Please cite distance from the southern property line.

2 - 4'x10' vinyl signs, hung at a V towards the road, 4 ft above ground
→ 76' from Murphy Rd to sign, 40' from East Fence to sign. Sign will not be lit.
Sign square footage: 80 ft²

Please show location on site development plan.

No sight triangles noted, no sidewalks, walls or berms near sign.
→ Future fence will be see through and installed 10 feet or more from south road.

