



VICINITY MAP




**FLOODPLAIN STATEMENT:**

THIS PROPERTY IS NOT LOCATED WITHIN FEMA DESIGNATED SPECIAL FLOOD HAZARD AREA "X" AREAS DETERMINED TO BE OUTSIDE THE 500-YEAR FLOODPLAIN AS INDICATED ON THE FLOOD INSURANCE RATE MAP (FIRM) FOR EL PASO COUNTY, COLORADO AND INCORPORATED AREAS-MAP NUMBER 08041C0276 G EFFECTIVE DECEMBER 7, 2018.


**ADA STATEMENT:**

THE PARTIES RESPONSIBLE FOR THIS PLAN HAVE FAMILIARIZED THEMSELVES WITH ALL CURRENT ACCESSIBILITY CRITERIA AND SPECIFICATIONS AND THE PROPOSED PLAN REFLECTS ALL SITE ELEMENTS REQUIRED BY THE APPLICABLE ADA DESIGN STANDARDS AND GUIDELINES AS PUBLISHED BY THE UNITED STATES DEPARTMENT OF JUSTICE. APPROVAL OF THIS PLAN BY EL PASO COUNTY DOES NOT ASSURE COMPLIANCE WITH THE ADA OR ANY REGULATIONS OR GUIDELINES ENACTED OR PROMULGATED UNDER OR WITH RESPECT TO SUCH LAWS.

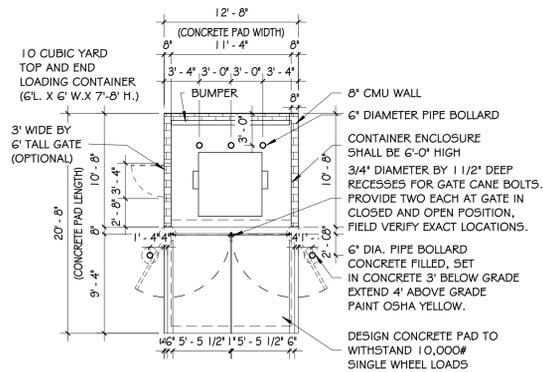


TRASH ENCLOSURE PLAN

SCALE: 1/8" = 1'-0"

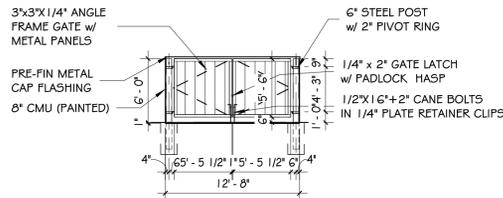

TRASH ENCLOSURE FRONT ELEV

SCALE: 1/8" = 1'-0"

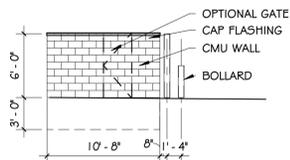

TRASH ENCLOSURE LEFT ELEV

SCALE: 1/8" = 1'-0"

# PLATTE SELF-STORAGE SITE DEVELOPMENT PLAN

6001 E. PLATTE AVE.  
COLORADO SPRINGS, COLORADO 80915

Please include project No. PPR2418

**PROJECT TEAM**

**OWNER:**

Donald Humphrey  
5780 Sayres Road  
Colorado Springs, CO 80927  
Contact: Don Humphrey  
don@donsgardenshop.com  
719-492-8649

**APPLICANT/CONSULTANT:**

RMG-Rocky Mountain Group  
5085 List Drive, Suite 200  
Colorado Springs, CO 80919  
Contact: Keith Moore  
KMoore@rmg-engineers.com  
719-548-0600

**CLIENT REPRESENTATIVE / GENERAL CONTRACTOR:**

Colorado Commercial Construction, Inc.  
12325 Oracle Blvd., Suite 120  
Colorado Springs, CO 80921  
Contact: Josh Beggs  
jbeggs@coccommercial.net  
719-264-6955

**ARCHITECT:**

RMG-Rocky Mountain Group  
5085 List Drive, Suite 200  
Colorado Springs, CO 80919  
Contact: Keith Moore  
KMoore@rmg-engineers.com  
719-548-0600

**CIVIL ENGINEER:**

Terra Nova Engineering Inc.  
721 S. 23rd Street  
Colorado Springs, CO 80904  
Contact: L Ducett, P.E.  
ltnesinc.com  
719-6356422

**LANDSCAPE ARCHITECT:**

Higher Ground Designs, Inc.  
5350 N. Academy Blvd, Suite 207  
Colorado Springs, CO 80918  
Contact: John MacKay  
jmacKay@highergrounddesigns.com  
719-477-4259

**MEP ENGINEER:**

McShea Consulting, LLC  
4445 Northpark Dr., Ste. 200  
Colorado Springs, CO 80907  
Contact: Michael McShea  
mike@mcsheaconsulting.com  
719-358-8208

**SHEET INDEX:**

SHEET NAME:	SHEET NO:
SDP COVER SHEET	DP-1
SITE DEVELOPMENT PLAN	DP-2
UTILITY COVER SHEET	DP-4 (1 of 6)
SANITARY PLAN & PROFILE	DP-5 (2 of 6)
WATER PLAN	DP-6 (3 of 6)
WATER MAIN PLAN & PROFILE	DP-7 (4 of 6)
WATER MAIN PLAN & PROFILE	DP-8 (5 of 6)
WATER MAIN PLAN & PROFILE	DP-9 (6 of 6)
GEC COVER SHEET	DP-10 (1 of 20)
GEC OVERVIEW	DP-11 (2 of 20)
GEC INITIAL GRADING & EROSION CONTROL - NORTH	DP-12 (3 of 20)
GEC INITIAL GRADING & EROSION CONTROL - SOUTH	DP-13 (4 of 20)
GEC GRADING INTERIM - NORTH	DP-14 (5 of 20)
GEC GRADING INTERIM - SOUTH	DP-15 (6 of 20)
GEC GRADING VERTICAL - NORTH	DP-16 (7 of 20)
GEC GRADING VERTICAL - SOUTH	DP-17 (8 of 20)
GEC GRADING DETAILS	DP-18 (9 of 20)
GEC INTERIM EROSION CONTROL - NORTH	DP-19 (10 of 20)
GEC INTERIM EROSION CONTROL - SOUTH	DP-20 (11 of 20)
GEC VERTICAL EROSION CONTROL - NORTH	DP-21 (12 of 20)
GEC VERTICAL EROSION CONTROL - SOUTH	DP-22 (13 of 20)
GEC EROSION CONTROL DETAILS	DP-23 (14 of 20)
GEC EROSION CONTROL DETAILS	DP-24 (15 of 20)
GEC EROSION CONTROL DETAILS	DP-25 (16 of 20)
STORM PLAN & PROFILE	DP-26 (17 of 20)
STORM PLAN & PROFILE	DP-27 (18 of 20)
EXT DET BASIN DETAILS	DP-28 (19 of 20)
EXT DET BASIN DETAILS	DP-29 (20 of 20)
STREET IMPROVEMENT PLAN COVER	DP-30 (1 of 4)
STREET IMPROVEMENT PLAN DETAILS	DP-31 (2 of 4)
STREET IMPROVEMENT PLAN OVERVIEW	DP-32 (3 of 4)
STREET IMPROVEMENT PLAN & PROFILE (NOT USED)	DP-33 (4 of 4)
OVERALL FINAL LANDSCAPE PLAN	DP-34
FINAL LANDSCAPE PLAN - AREA A	DP-35 (1 of 9)
FINAL LANDSCAPE PLAN - AREA B	DP-36 (2 of 9)
FINAL LANDSCAPE PLAN - AREA C	DP-37 (3 of 9)
FINAL LANDSCAPE PLAN - AREA D	DP-38 (4 of 9)
FINAL LANDSCAPE PLAN - AREA E	DP-39 (5 of 9)
FINAL LANDSCAPE PLAN - AREA F&G	DP-40 (6 of 9)
FINAL LANDSCAPE PLAN - AREA F&G	DP-41 (7 of 9)
LANDSCAPE NOTES	DP-42 (8 of 9)
LANDSCAPE DETAILS	DP-43 (9 of 9)
BUILDING PLANS & ELEVATIONS	DP-44 (1 of 2)
BUILDING PLANS & ELEVATIONS	DP-45 (2 of 2)
SITE PHOTOMETRIC PLAN	DP-46 (1 of 2)
LIGHTING DETAILS	DP-47 (2 of 2)

**PROJECT INFORMATION:**

DEVELOPMENT NAME:	PLATT SELF-STORAGE	
DESCRIPTION:	MINI STORAGE	
TAX SCHEDULE NO:	5418000075	
LEGAL DESCRIPTION:	TRACT IN NW1/4 OF SEC 18-14-65 AS FOLS, BEG AT PT ON S RW LN ON US HWY 24 940 FT E OF W LN OF SD SEC, TH E ON SD LN 310 FT, ANG R 90< S 25 FT, ANG L 90< E 155.2 FT ML, S 931.8 FT, W PARA WITH S LN OF N2 426.1 FT ML TO A PT, TH ANG R 89< 59' N 958.2 FT TO POB, W 349.88 FT OF NE4NW4 OF SEC 18 EX HWY BY BK 0509-223 & REC #201040780	
PROJECT ADDRESS:	6001 E. PLATTE AVE. COLORADO SPRINGS, COLORADO 80915	
EXISTING ZONING:	CS CAD-O (NO CHANGE)	
<b>BUILDING SETBACKS:</b>		
FRONT	50'-0"	
SIDE (STREET)	25'-0"	
SIDE (INTERIOR LOT LINE)	25'-0"	
REAR (NEXT TO RR ZONE)	25'-0"	
<b>LANDSCAPE SETBACKS:</b>		
FRONT	15'-0"	
SIDE (STREET)	10'-0"	
SIDE (BUFFER)	15'-0"	
REAR (BUFFER)	15'-0"	
EXISTING LAND USE:	VACANT	
PROPOSED LAND USE:	MINI-STORAGE	
BUILDING HEIGHT:	45' MAX ALLOWED	
<b>BUILDING INFO:</b>		
GROSS BUILDING AREA	PHASE 1	PHASE 2
OFFICE:	900 SF	
STORAGE:	62,400 SF	40,000 SF
BUILDING OCCUPANCY (NON-SEPARATED USES)	B,S-1	
TYPE OF CONSTRUCTION	V-B	
FIRE SPRINKLER	NO	
AREA SEPERATION WALLS	NO	
<b>LOT DATA &amp; COVERAGE:</b>		
SITE AREA:	17.22 AC (750,103.2 S.F.)	
IMPERVIOUS AREA:	PHASE 1	PHASE 2
BUILDING	63,300 SF	40,000 SF
CANOPY	27,890 SF	24,570 SF
PAVED	78,774 SF	51,334 SF
TOTAL	169,764 SF (15.26% LOT)	115,904 SF
PERVIOUS AREA: LANDSCAPING OR (UNDEVELOPED)	PHASE 1	PHASE 2
GRAVEL LOT:	378,015 SF	325,755 SF
TOTAL	202,324 SF	138,680 SF
	580,339 SF (84.74% LOT)	464,435 SF
LOT COVERAGE:	PHASE 1	PHASE 2
	8.4%	13.7%
<b>PARKING DATA:</b>		
MINI STORAGE (1/100 UNITS)	361 UNITS	(4 PS REQD) 264 UNITS (3 PS REQD)
OFFICE: (1/EMPLOYEE)	(1 PS REQD)	(1 PS REQD)
HC ACCESS: 1HC PS (25 PS)	(1 HC PS REQD) INCL	(8 PS REQD)
TOTAL	(5 PS REQD)	(7 TOTAL PS)
PARKING PROVIDED:	(7 TOTAL PS) (INCL 1 HC VAN)	
<b>SIGNAGE:</b>	A SIGNAGE PERMIT FOR EACH SIGN MUST BE OBTAINED FROM THE CITY PRIOR TO PLACING ANY SIGN ON THE PROPERTY. INCLUDES ALL ON-SITE DIRECTIONAL SIGNS.	
PROPOSED DEV. SCHED.	WINTER/SPRING 2024/2025	

**Include:**

A note stating: The owner agrees on behalf of him/herself and any developer or builder successors and assignees that Subdivider and/or said successors and assigns shall be required to pay traffic impact fees in accordance with the El Paso County Road Impact Fee Program Resolution (Resolution No. 19-471), or any amendments thereto, at or prior to the time of building permit submittals. The fee obligation, if not paid at final plat recording, shall be documented on all sales documents and on plat notes to ensure that a title search would find the fee obligation before sale of the property.



PLATTE SELF-STORAGE  
6001 E. PLATTE AVE, COLORADO SPRINGS, COLORADO  
COLORADO COMMERCIAL CONSTRUCTION INC  
12325 ORACLE BLVD, STE 120  
COLORADO SPRINGS, COLORADO 80921  
719-264-6955

SDP COVER SHEET  
SDP - SUBMITTAL

ARCHENG:	kem
DRAWN:	km
CHECKED:	-
DATE:	05.08.24
REVISION:	DATE
JOB NO.:	195706
SHEET NO.:	DP-1
	1 OF 47

Include:  
 1. Please remove contours from site development plan for clarity.  
 2. Location of all sidewalks, trails, fences and walls, retaining walls, or berms.  
 3. Traffic circulation on site including all points of ingress/egress into the property.  
 4. Location of all ADA spaces, ramps and signs, including ADA pathways.

Please show and label the maintenance access connection to a stable, existing/proposed driveway/local roadway.

BUILDING AREA PH1		
SIZE	QUANTITY	Area
BLDG A OFFICE	1	900 SF
BLDG A	1	3,200 SF
BLDG B	1	1,200 SF
BLDG C	1	8,000 SF
BLDG D	1	9,000 SF
BLDG E	1	9,000 SF
BLDG F	1	9,000 SF
BLDG G	1	9,000 SF
BLDG H	1	6,000 SF
BLDG I	1	8,000 SF
Grand total: 10		63,300 SF


RV/BOAT PARKING		
SIZE	QUANTITY	
12x30 PS		62
12x35 PS		60
12x40 PS		25
12x50 PS		10
12x60 PS		11
Grand total:		168

BUILDING AREA PH2		
SIZE	QUANTITY	Area
BLDG J	1	9,000 SF
BLDG K	1	9,000 SF
BLDG L	1	9,000 SF
BLDG M	1	9,000 SF
BLDG N	1	4,000 SF
Grand total: 5		40,000 SF

Please clearly show and label all roadways, including but not limited to:  
 - Public vs. Private roadways  
 - Right-of-Way (ROW) boundaries  
 - Existing and proposed access points should also be clearly indicated.  
 - Additionally, please label any sidewalks, ramps, or other pedestrian infrastructure.

Assign a name/number to all PBMPs and then update all submitted text and drawings accordingly with consistent labeling throughout (example: "Pond A" or "Pond 1").

**1 SITE DEVELOPMENT PLAN**  
 DP-2 SCALE: 1" = 50'-0"

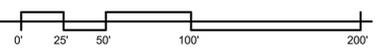

**RMG**  
 Engineers / Architects  
 Southern Colorado  
 5085 1st Drive, Suite 500, Colorado Springs, CO 80919  
 (719) 548-6600 - WWW.RMG-ENGINEERS.COM  
 Southern Colorado, Denver Metro, Montezuma, Colorado

**Colorado Commercial Construction**  
 COLORADO COMMERCIAL CONSTRUCTION INC  
 12255 ORACLE BLVD, STE 100  
 COLORADO SPRINGS, COLORADO 80904  
 719.244.8885

**PLATTE SELF-STORAGE**  
 6001 E. PLATTE AVE, COLORADO SPRINGS, COLORADO  
**COLORADO COMMERCIAL CONSTRUCTION INC**  
 These plans are prepared by RMG, Inc. (RMG) for the use of the Client. RMG is not responsible for any errors or omissions in these plans. The Client is responsible for obtaining all necessary permits and approvals. RMG is not responsible for any delays or costs incurred by the Client due to any errors or omissions in these plans. RMG is not responsible for any damages or injuries resulting from the use of these plans. RMG is not responsible for any changes or modifications to these plans without the written consent of RMG, Inc. in its sole discretion.

**SITE DEVELOPMENT PLAN**  
 SHEET NAME: PLATTE SELF-STORAGE  
 PROJECT STATUS: SDP - SUBMITTAL

ARCHING:	JJZ
DRAWN:	JJZ
CHECKED:	JJZ
DATE:	05.08.24
REVISION:	DATE
JOB NO.:	195706
SHEET NO.:	DP-2