


FILE - ADD23480
ZONING - RR-0.5
PLAT - 10040
APPROVED 183 SQ FT
PATIO ENCLOSURE

Not Required
BESQCP
08/17/2023 1:20:25 PM
dsdmas
EPC Planning & Community
Development Department

APPROVED
Plan Review
08/17/2023 1:20:02 PM
dsdmas
EPC Planning & Community
Development Department


It is the owner's responsibility to coordinate with easement holders to avoid impact to utilities that may be located in the easements.

ANY APPROVAL GIVEN BY
B. BRIGGS COUNTY
DOES NOT OVIATE THE NEED
TO COMPLY WITH APPLICABLE
FEDERAL, STATE, OR LOCAL
LAWS AND/OR REGULATIONS.
Planning & Community Development Department
approval is contingent upon compliance with all
applicable rules on the recorded plat.
An access permit must be granted by the
Planning & Community Development Department
prior to the establishment of any driveway onto a
County road.
Division of easements of any drainage way
is not permitted without approval of the
Planning & Community Development Department.

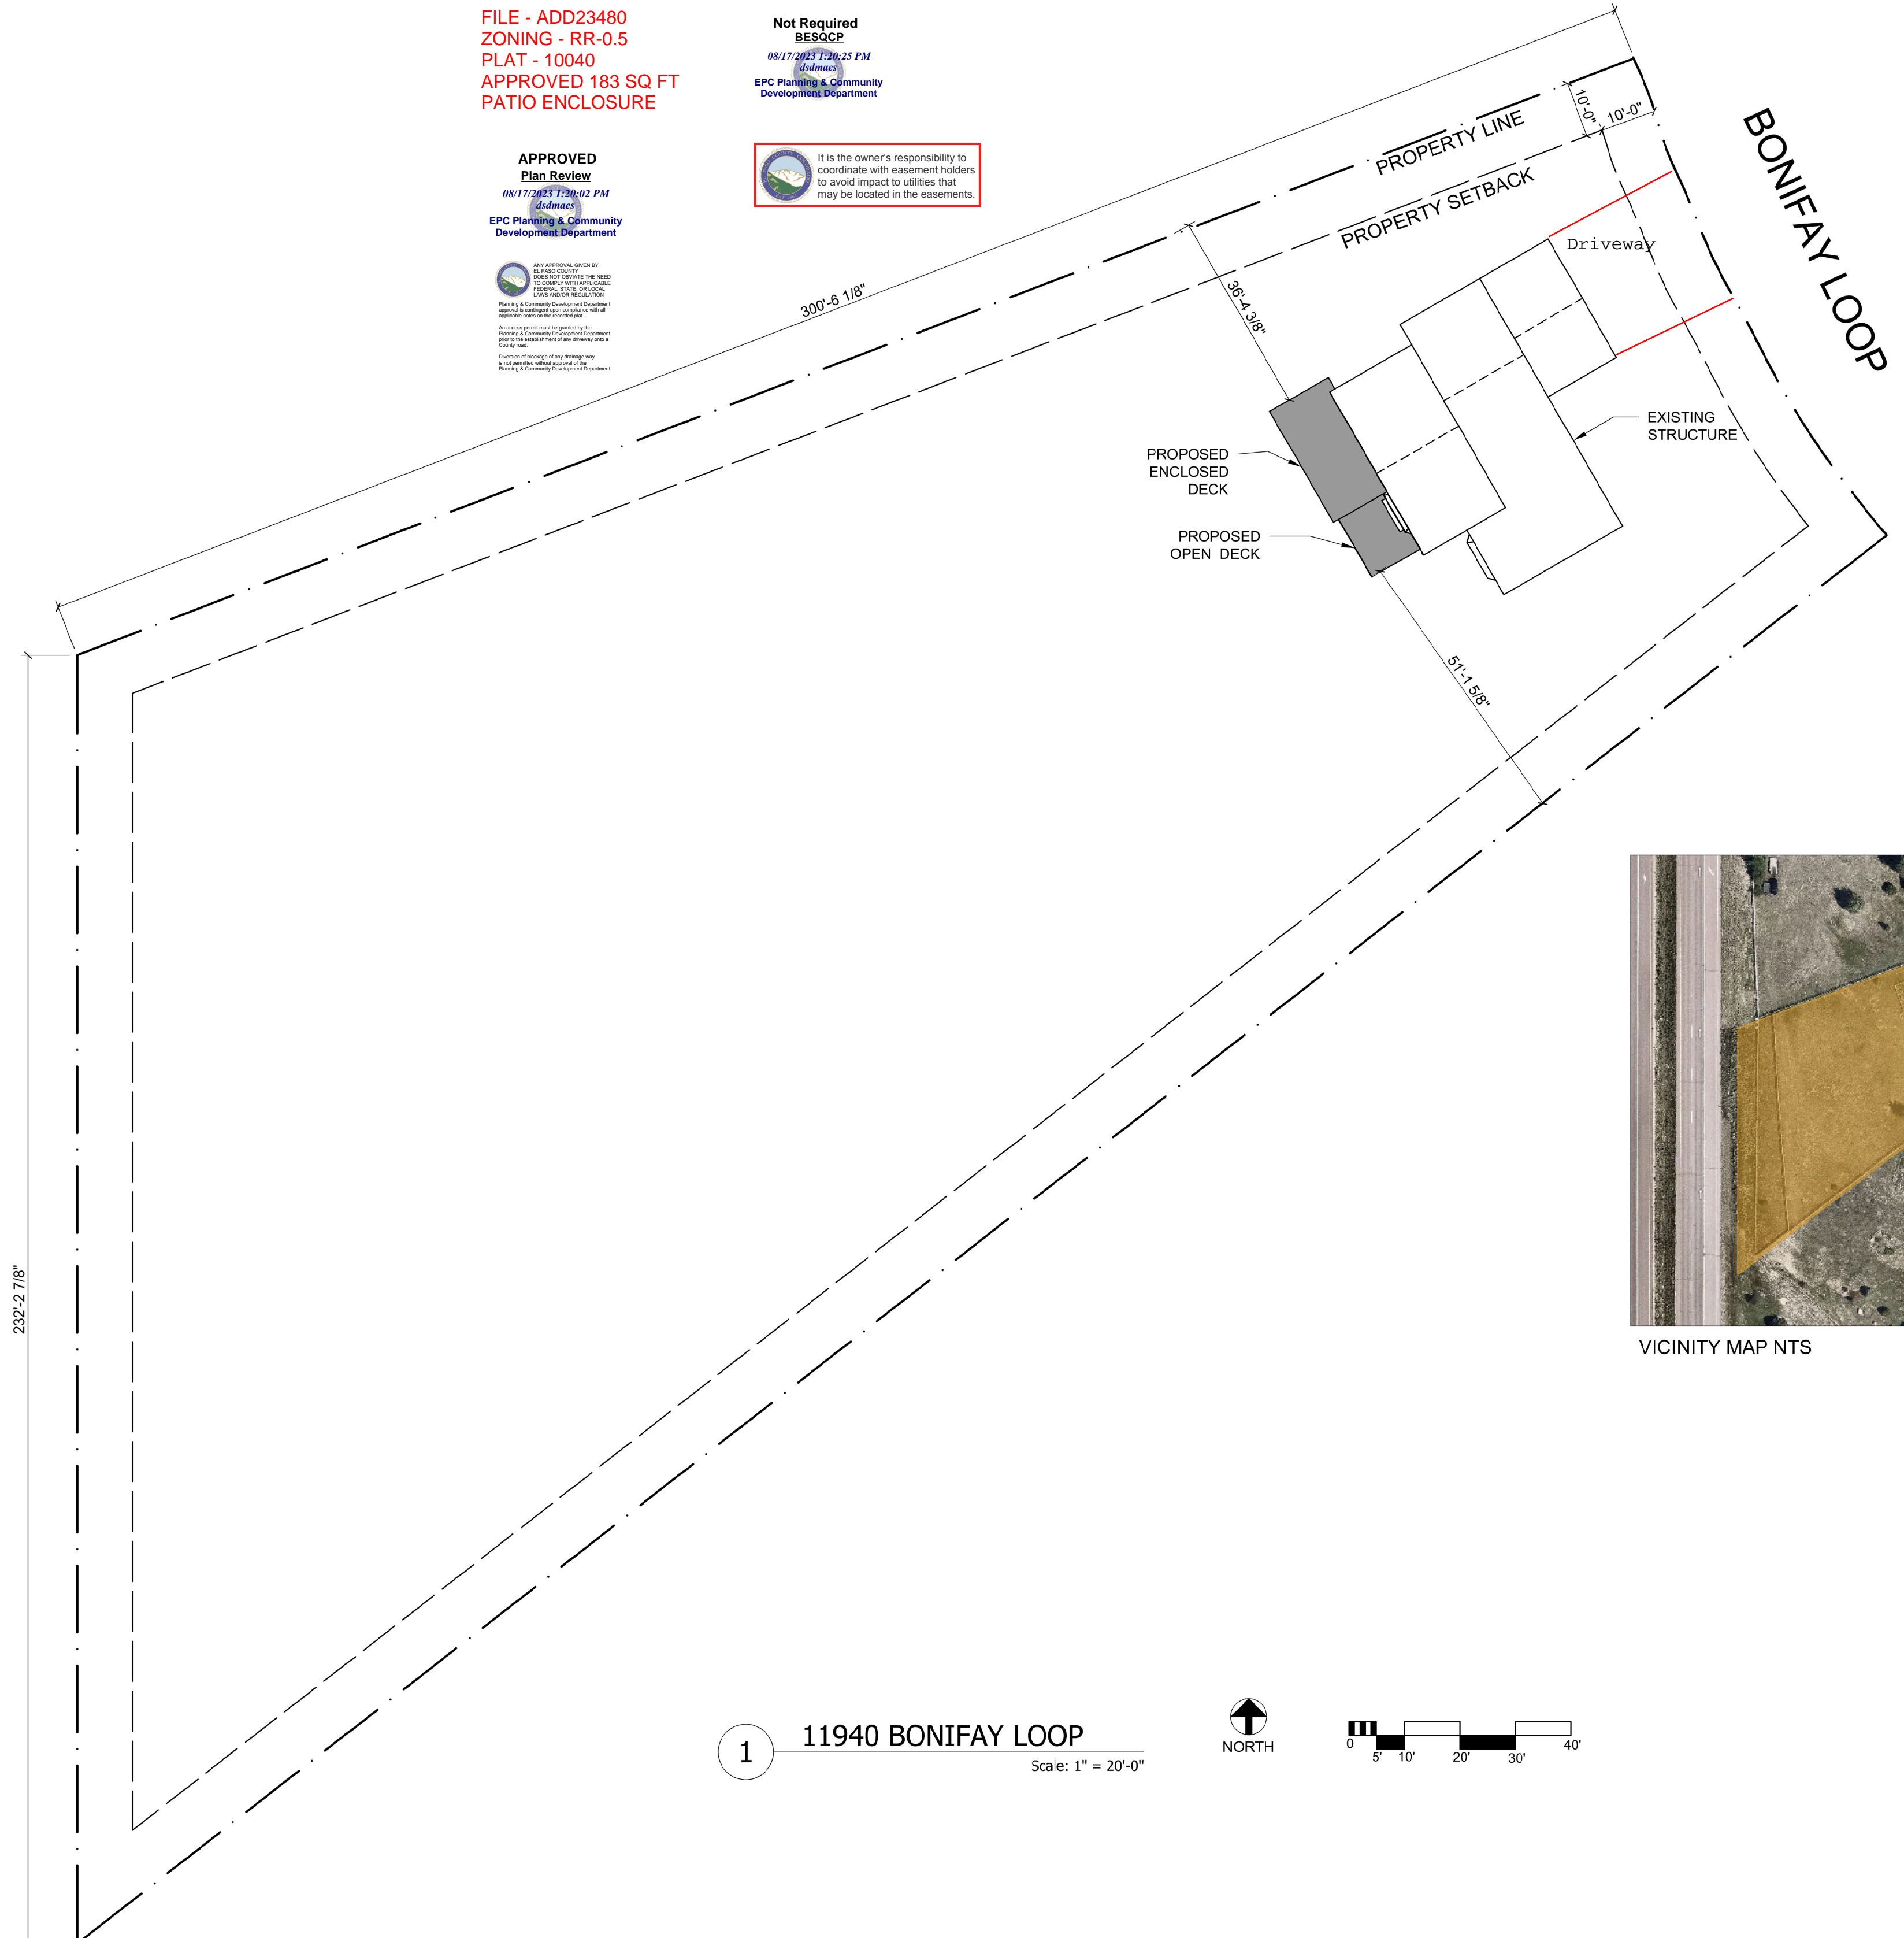

VICINITY MAP NTS

1 11940 BONIFAY LOOP
Scale: 1" = 20'-0"

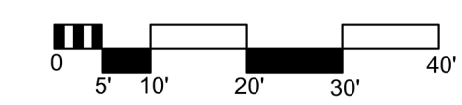

RESIDENTIAL



2017 PPRBC

Address: 11940 BONIFAY LOOP, PEYTON

Parcel: 4231301005

Plan Track #: 177791 

Received: 21-Jun-2023 (SHELLEY)

Description:

PATIO ENCLOSURE

Contractor: HOMEOWNER

Type of Unit:

Required PPRBD Departments (2)

<p>Floodplain</p> <p>(N/A) RBD GIS</p>	<p>Construction</p>
---	----------------------------

Required Outside Departments (1)

County Zoning

APPROVED
Plan Review

08/17/2023 1:21:12 PM
dsdmaes

EPC Planning & Community
Development Department

Release of this plan does not preclude compliance with all applicable codes, ordinances and other pertinent regulations. This plan set must be present on the job site for every inspection.