

**THE COTTAGES AT MESA RIDGE**  
**CONSTRUCTION DRAWING**  
**TABLE OF CONTENTS**

1. EL PASO COUNTY CONSTRUCTION DOCUMENTS AND GRADING AND EROSION CONTROL PLANS (ON SITE)
2. CITY OF FOUNTAIN CONSTRUCTION DOCUMENTS (OFF SITE)
3. FOUNTAIN MUTUAL IRRIGATION COMPANY IRRIGATION PIPE CONSTRUCTION DRAWINGS (OFF SITE)



LEGAL DESCRIPTION:

THAT PORTION OF THE NORTHWEST QUARTER OF SECTION 28 AND THE NORTHEAST QUARTER OF SECTION 29, TOWNSHIP 15 SOUTH, RANGE 65 WEST OF THE 6TH P.M., COUNTY OF EL PASO, STATE OF COLORADO, DESCRIBED AS FOLLOWS:

BASIS OF BEARINGS: BEARINGS ARE BASED UPON THE NORTH LINE OF THE NORTHEAST QUARTER OF SAID SECTION 29, MONUMENTED AT THE WEST END WITH A 3.25" ALUMINUM CAP IN CONCRETE STAMPED "PLS 4842" AND MONUMENTED AT THE EAST END WITH A #6 REBAR AND 3.25" ALUMINUM CAP STAMPED "PLS 38141" AND ASSUMED TO BEAR S 89°57'13" E A FIELD MEASURED DISTANCE OF 2,652.37 FEET.

BENCHMARK: ELEVATIONS ARE BASED UPON THE FOUNTAIN SANITATION DISTRICT POINT N-1, BEING A 2" BRASS CAP IN CONCRETE AT THE NORTHEAST CORNER OF MESA RIDGE PARKWAY AND FOUNTAIN MESA ROAD. (ELEVATION=5750.57 NGVD 29).

BEGINNING AT THE NORTHWEST CORNER OF THE NORTHWEST QUARTER OF SAID SECTION 28; THENCE N 89°41'59" E ALONG THE NORTH LINE OF SAID NORTHWEST QUARTER, A DISTANCE OF 117.50 FEET TO A POINT ON THE WEST LINE OF POWERS BOULEVARD AS RECORDED UNDER BOOK 6788 AT PAGE 531 OF THE RECORDS OF THE EL PASO COUNTY CLERK AND RECORDERS OFFICE; THENCE ALONG THE WEST LINE OF SAID POWERS BOULEVARD, 933.14 FEET ALONG THE ARC OF A 1,096.98 FOOT RADIUS CURVE TO THE RIGHT, HAVING A CENTRAL ANGLE OF 48°44'17" AND A CHORD THAT BEARS S 12°56'23" W, 905.26 FEET TO A POINT ON THE NORTHERLY LINE OF THAT PARCEL OF LAND DESCRIBED UNDER BOOK 5506 AT PAGE 1290 OF SAID RECORDS; THENCE OF THE FOLLOWING EIGHT (8) COURSES ALONG SAID NORTHERLY LINES AND EASTERLY LINES OF SAID PARCEL OF LAND DESCRIBED UNDER BOOK 5506 AT PAGE 1290:

- 1) N 84°16'00" W, A DISTANCE OF 198.99 FEET;
  - 2) 46.11 FEET ALONG THE ARC OF A 540.00 FOOT RADIUS TANGENT CURVE TO THE LEFT, HAVING A CENTRAL ANGLE OF 04°53'33" AND A CHORD THAT BEARS N 86°42'46" W, 46.10 FEET;
  - 3) N 89°09'33" W, A DISTANCE OF 124.09 FEET;
  - 4) 100.02 FEET ALONG THE ARC OF A 140.00 FOOT RADIUS TANGENT CURVE TO THE RIGHT, HAVING A CENTRAL ANGLE OF 40°56'07" AND A CHORD THAT BEARS N 68°41'30" W, 97.91 FEET;
  - 5) N 48°13'27" W, A DISTANCE OF 126.77 FEET;
  - 6) 6.49 FEET ALONG THE ARC OF AN 8.00 FOOT RADIUS TANGENT CURVE TO THE RIGHT, HAVING A CENTRAL ANGLE OF 46°29'23" AND A CHORD THAT BEARS N 24°58'45" W, 6.31 FEET;
  - 7) N 01°44'04" W, A DISTANCE OF 137.18 FEET;
  - 8) 87.71 FEET ALONG THE ARC OF A 135.00 FOOT RADIUS TANGENT CURVE TO THE LEFT, HAVING A CENTRAL ANGLE OF 37°13'35" AND A CHORD THAT BEARS N 20°21'02" W, 86.18 FEET TO THE SOUTHWEST CORNER OF LOT 15, BLOCK 3, SUNRISE RIDGE SUBDIVISION FILING NO. 8 AS RECORDED UNDER RECEPTION NO. 1722613 OF SAID RECORDS;
- THENCE THE FOLLOWING TWO (2) COURSES ALONG THE EASTERLY LINE OF SAID SUNRISE RIDGE SUBDIVISION FILING NO. 8: 1) 511.39 FEET ALONG THE ARC OF A 1,034.60 FOOT RADIUS CURVE TO THE LEFT, HAVING A CENTRAL ANGLE OF 28°19'14" AND A CHORD THAT BEARS N 58°13'41" E, 506.20 FEET TO A POINT OF COMPOUND CURVATURE;
- 2) 283.12 FEET ALONG THE ARC OF A 500.00 FOOT RADIUS CURVE TO THE LEFT, HAVING A CENTRAL ANGLE OF 32°26'36" AND A CHORD THAT BEARS N 27°50'47" E, 279.35 FEET TO A POINT ON THE NORTH LINE OF SAID NORTHEAST QUARTER;
- THENCE N 89°57'13" E ALONG THE NORTH LINE OF SAID NORTHEAST QUARTER, A DISTANCE OF 115.21 FEET TO THE POINT OF BEGINNING.

CONTAINING A CALCULATED AREA OF 445,104 SQUARE FEET (10.218 ACRES) OF LAND, MORE OR LESS.


TO BE PLATTED AS "COTTAGES AT MESA RIDGE"

STANDARD NOTES:

1. ALL DRAINAGE AND ROADWAY CONSTRUCTION SHALL MEET THE STANDARDS AND SPECIFICATIONS OF THE CITY OF COLORADO SPRINGS/EL PASO COUNTY DRAINAGE CRITERIA MANUAL, VOLUMES 1 AND 2, AND THE EL PASO COUNTY ENGINEERING CRITERIA MANUAL
2. CONTRACTOR SHALL BE RESPONSIBLE FOR THE NOTIFICATION AND FILED NOTIFICATION OF ALL EXISTING UTILITIES, WHETHER SHOWN ON THE PLANS OR NOT, BEFORE BEGINNING CONSTRUCTION. LOCATION OF EXISTING UTILITIES SHALL BE VERIFIED BY THE CONTRACTOR PRIOR TO CONSTRUCTION. CALL 811 TO CONTACT THE UTILITY NOTIFICATION CENTER OF COLORADO (UNCC)
3. CONTRACTOR SHALL KEEP A COPY OF THESE APPROVED PLANS, THE GRADING AND EROSION CONTROL PLAN, THE STORMWATER MANAGEMENT PLAN (SWMP), THE SOILS AND GEOTECHNICAL REPORT, AND THE APPROPRIATE DESIGN AND CONSTRUCTION STANDARDS AND SPECIFICATIONS AT THE JOB SITE AT ALL TIMES, INCLUDING THE FOLLOWING:
  - A. EL PASO COUNTY ENGINEERING CRITERIA MANUAL (ECM)
  - B. CITY OF COLORADO SPRINGS/EL PASO COUNTY DRAINAGE CRITERIA MANUAL, VOLUMES 1 AND 2
  - C. COLORADO DEPARTMENT OF TRANSPORTATION (CDOT) STANDARD SPECIFICATIONS FOR ROAD AND BRIDGE CONSTRUCTION
  - D. CDOT M & S STANDARDS
4. NOTWITHSTANDING ANYTHING DEPICTED IN THESE PLANS IN WORDS OR GRAPHIC REPRESENTATION, ALL DESIGN AND CONSTRUCTION RELATED TO ROADS, STORM DRAINAGE AND EROSION CONTROL SHALL CONFORM TO THE STANDARDS AND REQUIREMENTS OF THE MOST RECENT VERSION OF THE RELEVANT ADOPTED EL PASO COUNTY STANDARDS, INCLUDING THE LAND DEVELOPMENT CODE, THE ENGINEERING CRITERIA MANUAL, THE DRAINAGE CRITERIA MANUAL, AND THE DRAINAGE CRITERIA MANUAL VOLUME 2. ANY DEVIATIONS FROM REGULATIONS AND STANDARDS MUST BE REQUESTED, AND APPROVED, IN WRITING. ANY MODIFICATIONS NECESSARY TO MEET CRITERIA AFTER-THE-FACT WILL BE ENTIRELY THE DEVELOPER'S RESPONSIBILITY TO RECTIFY.
5. IT IS THE DESIGN ENGINEER'S RESPONSIBILITY TO ACCURATELY SHOW EXISTING CONDITIONS, BOTH ONSITE AND OFFSITE, ON THE CONSTRUCTION PLANS. ANY MODIFICATIONS NECESSARY DUE TO CONFLICTS, OMISSIONS, OR CHANGED CONDITIONS WILL BE ENTIRELY THE DEVELOPER'S RESPONSIBILITY TO RECTIFY.
6. CONTRACTOR SHALL SCHEDULE A PRE-CONSTRUCTION MEETING WITH EL PASO COUNTY PLANNING AND COMMUNITY DEVELOPMENT DEPARTMENT (PCD) - INSPECTIONS, PRIOR TO STARTING CONSTRUCTION.
7. IT IS THE CONTRACTOR'S RESPONSIBILITY TO UNDERSTAND THE REQUIREMENTS OF ALL JURISDICTIONAL AGENCIES AND TO OBTAIN ALL REQUIRED PERMITS, INCLUDING BUT NOT LIMITED TO EL PASO COUNTY EROSION AND STORMWATER QUALITY CONTROL PERMIT (ESQCP), REGIONAL BUILDING FLOODPLAIN DEVELOPMENT PERMIT, U.S. ARMY CORPS OF ENGINEERS-ISSUED 401 AND/OR 404 PERMITS, AND COUNTY AND STATE FUGITIVE DUST PERMITS.
8. CONTRACTOR SHALL NOT DEVIATE FROM THE PLANS WITHOUT FIRST OBTAINING WRITTEN APPROVAL FROM THE DESIGN ENGINEER AND PCD. CONTRACTOR SHALL NOTIFY THE DESIGN ENGINEER IMMEDIATELY UPON DISCOVERY OF ANY ERRORS OR INCONSISTENCIES.
9. ALL STORM DRAIN PIPE SHALL BE CLASS III RCP UNLESS OTHERWISE NOTED AND APPROVED BY PCD.
10. CONTRACTOR SHALL COORDINATE GEOTECHNICAL TESTING PER ECM STANDARDS. PAVEMENT DESIGN SHALL BE APPROVED BY EL PASO COUNTY PCD PRIOR TO PLACEMENT OF CURB AND GUTTER AND PAVEMENT.
11. ALL CONSTRUCTION TRAFFIC MUST ENTER/EXIT THE SITE AT APPROVED CONSTRUCTION ACCESS POINTS.
12. SIGHT VISIBILITY TRIANGLES AS IDENTIFIED IN THE PLANS SHALL BE PROVIDED AT ALL INTERSECTIONS. OBSTRUCTIONS GREATER THAN 18 INCHES ABOVE FLOWLINE ARE NOT ALLOWED WITHIN SIGHT TRIANGLES.
13. SIGNING AND STRIPING SHALL COMPLY WITH EL PASO COUNTY AND MUTCD CRITERIA. [IF APPLICABLE, ADDITIONAL SIGNING AND STRIPING NOTES WILL BE PROVIDED.]
14. CONTRACTOR SHALL OBTAIN ANY PERMITS REQUIRED BY EL PASO COUNTY DPW, INCLUDING WORK WITHIN THE RIGHT-OF-WAY AND SPECIAL TRANSPORT PERMITS.
15. THE LIMITS OF CONSTRUCTION SHALL REMAIN WITHIN THE PROPERTY LINE UNLESS OTHERWISE NOTED. THE OWNER/DEVELOPER SHALL OBTAIN WRITTEN PERMISSION AND EASEMENTS, WHERE REQUIRED, FROM ADJOINING PROPERTY OWNER(S) PRIOR TO ANY OFF-SITE DISTURBANCE, GRADING, OR CONSTRUCTION.

THE COTTAGES AT MESA RIDGE  
EL PASO COUNTY CONSTRUCTION DOCUMENTS  
AND GRADING AND EROSION CONTROL PLANS

A PORTION OF THE NORTHEAST QUARTER OF SECTION 29, THE SOUTHEAST QUARTER OF SECTION 20, THE SOUTHWEST QUARTER OF SECTION 21, & THE NORTHWEST QUARTER OF SECTION 28, TOWNSHIP 13 SOUTH, RANGE 65 WEST OF THE 6TH P.M., COUNTY OF EL PASO, STATE OF COLORADO

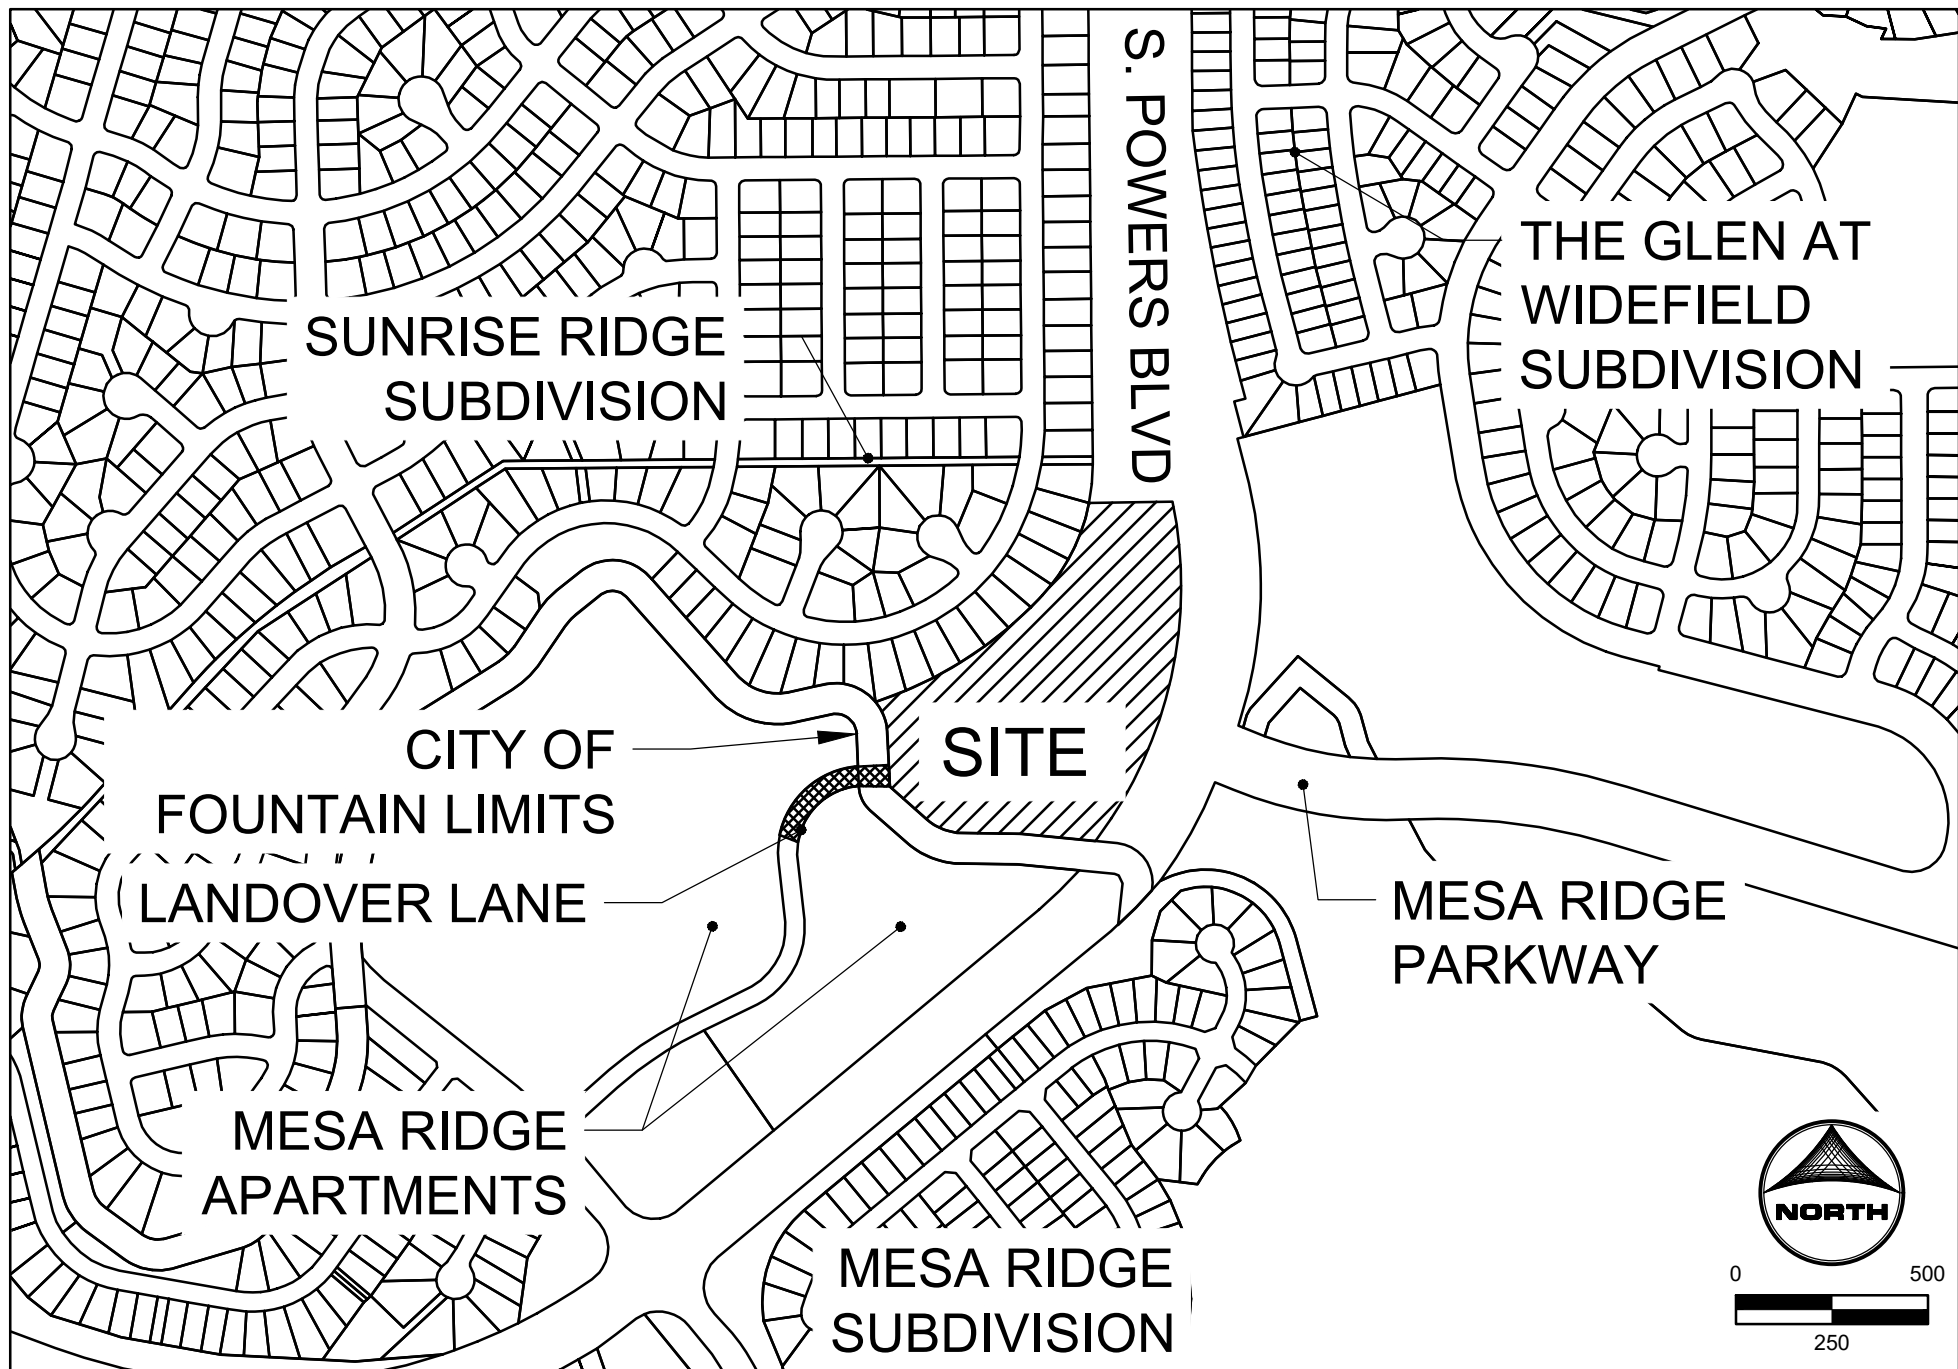

VICINITY MAP  
SCALE: 1"=500'

LEGEND

		EXISTING	PROPOSED
<b>STORM SEWER</b>			
MATCH LINE			
PHASE LINE			
SECTION LINE			
PROPERTY LINE			
EASEMENT LINE			
RIGHT-OF-WAY			
CENTERLINE			
CHAIN LINK FENCE			
WOODEN FENCE			
ROD IRON FENCE			
GUARDRAIL			
CABLE TV			
U.G. ELECTRIC			
OVERHEAD ELECTRIC			
FIBER OPTIC			
GAS MAIN			
SANITARY SEWER			
STORM DRAIN			
TELEPHONE			
WATER MAIN			
SWALE			
TRAIL			
CURB & GUTTER			
DRAINAGE BASIN			
INDEX CONTOUR			
INTER. CONTOUR			
100-YR FLOODPLAIN			
FLOODWAY			
<b>EDGE OF WETLANDS</b>			
<b>DRAINAGE</b>		EXISTING	PROPOSED
<b>DRAINAGE BASIN</b>			
<b>BASIN TAG</b>			
<b>DESIGN POINT</b>			
		<b>STORM SEWER</b>	
		EXISTING	
		PROPOSED	
		MANHOLE	
		STORM INLET	
		FLARED END SECTION	
		RIPRAP	
		<b>SANITARY SEWER</b>	
		CLEAN OUT	
		MANHOLE	
		PLUG	
		<b>WATER</b>	
		FIRE HYDRANT	
		FIRE DEPT. CONNECTION	
		GATE VALVE	
		MANHOLE	
		METER	
		TEE	
		REDUCER	
		<b>DRY UTILITIES</b>	
		ELECTRIC METER	
		ELECTRIC PEDESTAL	
		ELECTRIC CABINET	
		ELECTRIC VAULT	
		FIBER OPTIC PULL BOX	
		FIBER OPTIC MANHOLE	
		FIBER OPTIC PEDESTAL	
		FIBER OPTIC SIGN	
		FIBER OPTIC VAULT	
		GAS METER	
		GAS SIGN	
		GAS VAULT	
		TELEPHONE CABINET	
		TELEPHONE MANHOLE	
		TELEPHONE SIGNALMAST	
		TELEPHONE SIGN	
		TELEPHONE PEDESTAL	
		TRANSFORMER	
		LIGHT POLE	
		FIBER OPTIC VAULT	
		<b>MISCELLANEOUS</b>	
		SIGN	
		BOLLARD	
		ACCESSIBLE PARKING	

SHEET INDEX:

- 1 - COVER
- 2 - GEC NOTES & TYPICAL SECTIONS
- 3 - GEC- INITIAL PLAN
- 4 - GEC- INTERIM PLAN
- 5 - GEC- VERTICAL PLAN
- 6 - 8 - ROADWAY PLAN & PROFILE
- 9 - 10 - CURB RAMP GRADING
- 11 - 19 - DETAILED GRADING
- 20 - NOTES WATER AND SANITARY SEWER
- 21 - 22 - SANITARY PLAN & PROFILE
- 25 - WATER DISTRIBUTION PLAN
- 26 - UTILITY SERVICE PLAN
- 27 - STORM SEWER PLAN AND PROFILE
- 28 - 32 - DETAILS

STAKEHOLDERS:

OWNER:	CSJ NO 1 LLC 111 S. TEJON STREET, SUITE 222 COLORADO SPRINGS, CO 80903
DEVELOPER:	GOODWIN KNIGHT 8605 EXPLORER DRIVE, SUITE 250 COLORADO SPRINGS, CO 80920 DAVE MORRISON
ATTN:	
APPLICANT:	HR GREEN DEVELOPMENT, LLC 1975 RESEARCH PKWY, SUITE 230 COLORADO SPRINGS, CO 80920 PHIL STUEPFERT, KEN HUHN
ATTN:	
SURVEYOR:	BARRON LAND, LLC 2790 N ACADEMY BLVD #311 COLORADO SPRINGS, CO 80917 ATTN: SPENCER BARRON

DEVELOPERS STATEMENT - FOUNTAIN SANITATION DISTRICT

THE OWNER WILL COMPLY WITH THE REQUIREMENTS OF FOUNTAIN SANITATION DISTRICT REGULATIONS AND STANDARD SPECIFICATIONS. OWNER WILL COMPLY WITH THE CONSTRUCTION DRAWINGS PREPARED BY HIS/HER CIVIL ENGINEER.

DEVELOPER/OWNER SIGNATURE: \_\_\_\_\_ DATE: \_\_\_\_\_

NAME OF DEVELOPER/OWNER: \_\_\_\_\_

TITLE: \_\_\_\_\_

PHONE: \_\_\_\_\_

ADDRESS: \_\_\_\_\_

FOUNTAIN SANITATION DISTRICT

PLANS ARE RECOMMENDED FOR USE IN CONSTRUCTION OF WASTEWATER COLLECTION SYSTEM FOR THIS PROJECT. DESIGN ENGINEER OF RECORD TAKES SOLE RESPONSIBILITY FOR ALL DESIGN ASPECTS OF THE PROJECT.

JONATHAN MOORE, P.E. DATE  
FOUNTAIN SANITATION DISTRICT - DISTRICT ENGINEER

OWNER'S STATEMENT

I, THE OWNER/DEVELOPER HAVE READ AND WILL COMPLY WITH THE REQUIREMENTS OF THE GRADING AND EROSION CONTROL PLAN AND ALL OF THE REQUIREMENTS SPECIFIED IN THESE DETAILED PLANS AND SPECIFICATIONS.

OWNER SIGNATURE \_\_\_\_\_ DATE \_\_\_\_\_

OWNER NAME \_\_\_\_\_

ENGINEER'S STATEMENT

THESE DETAILED PLANS AND SPECIFICATIONS WERE PREPARED UNDER MY DIRECTION AND SUPERVISION. SAID PLANS AND SPECIFICATIONS HAVE BEEN PREPARED ACCORDING TO THE CRITERIA ESTABLISHED BY THE COUNTY FOR DETAILED ROADWAY, DRAINAGE, GRADING AND EROSION CONTROL PLANS AND SPECIFICATIONS, AND SAID PLANS AND SPECIFICATIONS ARE IN CONFORMITY WITH APPLICABLE MASTER DRAINAGE PLANS AND MASTER TRANSPORTATION PLANS. SAID PLANS AND SPECIFICATIONS MEET THE PURPOSES FOR WHICH THE PARTICULAR ROADWAY AND DRAINAGE FACILITIES ARE DESIGNED AND ARE CORRECT TO THE BEST OF MY KNOWLEDGE AND I ACCEPT RESPONSIBILITY FOR ANY LIABILITY CAUSED BY ANY NEGLIGENT ACTS, ERRORS OR OMISSIONS ON MY PART IN PREPARATION OF THESE DETAILED PLANS AND SPECIFICATIONS.

KENNETH M. HUHN, P.E. DATE  
KHUHN@HRGREEN.COM  
COLORADO P.E. 0054022

EL PASO COUNTY STATEMENT

COUNTY PLAN REVIEW IS PROVIDED ONLY FOR GENERAL CONFORMANCE WITH COUNTY DESIGN CRITERIA. THE COUNTY IS NOT RESPONSIBLE FOR THE ACCURACY AND ADEQUACY OF THE DESIGN, DIMENSIONS, AND/OR ELEVATIONS WHICH SHALL BE CONFIRMED AT THE JOB SITE. THE COUNTY THROUGH THE APPROVAL OF THIS DOCUMENT ASSUMES NO RESPONSIBILITY FOR COMPLETENESS AND/OR ACCURACY OF THIS DOCUMENT.

FILED IN ACCORDANCE WITH THE REQUIREMENTS OF THE EL PASO COUNTY LAND DEVELOPMENT CODE, DRAINAGE CRITERIA MANUAL VOLUMES 1 AND 2 & ENGINEERING CRITERIA MANUAL AS AMENDED.

IN ACCORDANCE WITH ECM SECTION 1.12, THESE CONSTRUCTION DOCUMENTS WILL BE VALID FOR CONSTRUCTION FOR A PERIOD OF 2 YEARS FROM THE DATE SIGNED BY THE EL PASO COUNTY ENGINEER. IF CONSTRUCTION HAS NOT STARTED WITHIN THOSE 2 YEARS, THE PLANS WILL NEED TO BE RESUBMITTED FOR APPROVAL, INCLUDING PAYMENT OF REVIEW FEES AT THE PLANNING AND COMMUNITY DEVELOPMENT DIRECTORS DISCRETION.

JENNIFER IRVINE, P.E.

DATE \_\_\_\_\_

COUNTY ENGINEER/ ECM ADMINISTRATOR

PCD FILNE NO.: SF2214

DRAWN BY: CBM JOB DATE: 8/22/2022  
APPROVED: KMH JOB NUMBER: 200541  
CAD DATE: 8/31/2022  
CAD FILE: J:\2020\200541\CAD\Draws\C\CDIE\El\_Paso\_Col\Cover

BAR IS ONE INCH ON  
OFFICIAL DRAWINGS.  
0" = 1" IF NOT ONE INCH,  
ADJUST SCALE ACCORDINGLY.

NO.	DATE	BY	REVISION DESCRIPTION



HR GREEN - COLORADO SPRINGS  
7222 COMMERCE CENTER DR SUITE 220  
COLORADO SPRINGS CO 80919  
PHONE: 719.300.4140 TOLL FREE: 800.728.7805  
FAX: 844.273.1057 | HRGreen.com

THE COTTAGES AT MESA RIDGE  
GOODWIN KNIGHT  
EL PASO COUNTY, COLORADO



EL PASO COUNTY CONSTRUCTION DOCUMENTS  
COVER

SHEET  
CV










1



### GRADING AND EROSION CONTROL NOTES:

3. STORMWATER DISCHARGES FROM CONSTRUCTION SITES SHALL NOT CAUSE OR THREATEN TO CAUSE POLLUTION, CONTAMINATION, OR DEGRADATION OF STATE WATERS, ALL WORK AND EARTH DISTURBANCE SHALL BE DONE IN A MANNER THAT MINIMIZES POLLUTION OF ANY ON-SITE OR OFF-SITE WATERS, INCLUDING WETLANDS.
2. NOTWITHSTANDING ANYTHING DEPICTED IN THESE PLANS IN WORDS OR GRAPHIC REPRESENTATION, ALL DESIGN AND CONSTRUCTION RELATED TO ROADS, STORM DRAINAGE, AND EROSION CONTROL SHALL CONFORM TO THE STANDARDS AND REQUIREMENTS OF THE MOST RECENT VERSION OF THE RELEVANT ADOPTED EL PASO COUNTY STANDARDS, INCLUDING THE CRITERIA MANUAL VOLUME 2. ANY DEVIATIONS FROM REGULATIONS AND STANDARDS MUST BE REQUESTED, AND APPROVED, IN WRITING.
3. A SEPARATE STORMWATER MANAGEMENT PLAN (SWMP) FOR THIS PROJECT SHALL BE COMPLETED AND AN EROSION AND STORMWATER QUALITY CONTROL PERMIT (ESQCP) ISSUED PRIOR TO COMMENCING CONSTRUCTION. MANAGEMENT OF THE SWMP DURING CONSTRUCTION IS THE RESPONSIBILITY OF THE DESIGNATED QUALIFIED STORMWATER MANAGER OF CERTIFIED EROSION CONTROL INSPECTOR. THE SWMP SHALL BE LOCATED ON SITE AT ALL TIMES DURING CONSTRUCTION AND SHALL BE KEPT UP TO DATE WITH WORK PROGRESS AND CHANGES IN THE FIELD.
4. ONCE THE ESQCP IS APPROVED AND A "NOTICE TO PROCEED" HAS BEEN ISSUED, THE CONTRACTOR MAY INSTALL THE INITIAL STAGE EROSION AND SEDIMENT CONTROL MEASURES AS INDICATED ON THE APPROVED GEC. A PRECONSTRUCTION MEETING BETWEEN THE CONTRACTOR, ENGINEER, AND THE EL PASO COUNTY WILL BE HELD PRIOR TO ANY CONSTRUCTION. IT IS THE RESPONSIBILITY OF THE APPLICANT TO COORDINATE THE MEETING TIME AND PLACE WITH COUNTY STAFF.
5. CONTROL MEASURES MUST BE INSTALLED PRIOR TO COMMENCEMENT OF ACTIVITIES THAT COULD CONTRIBUTE POLLUTANTS TO STORMWATER. CONTROL MEASURES FOR ALL SLOPES, CHANNELS, DITCHES, AND DISTURBED LAND AREAS SHALL BE INSTALLED IMMEDIATELY UPON COMPLETION OF THE DISTURBANCE.
6. ALL TEMPORARY SEDIMENT AND EROSION CONTROL MEASURES SHALL BE MAINTAINED AND REMAIN IN EFFECTIVE OPERATION CONDITION UNTIL PERMANENT SOIL EROSION CONTROL MEASURES ARE IMPLEMENTED AND FINAL STABILIZATION IS ESTABLISHED. ALL PERSONS ENGAGED IN LAND DISTURBANCE ACTIVITIES SHALL ASSESS THE ADEQUACY OF CONTROL MEASURES AT THE SITE AND IDENTIFY IF CHANGES TO THOSE CONTROL MEASURES ARE NEEDED TO ENSURE THE CONTINUED EFFECTIVE PERFORMANCE OF THE CONTROL MEASURES. ALL CHANGES TO TEMPORARY SEDIMENT AND EROSION CONTROL MEASURES MUST BE INCORPORATED INTO THE STORMWATER MANAGEMENT PLAN.
7. TEMPORARY STABILIZATION SHALL BE IMPLEMENTED ON DISTURBED AREAS AND STOCKPILES WHERE GROUND DISTURBING ACTIVITY HAS PERMANENTLY CEASED OR TEMPORARILY CEASED FOR LONGER THAN 14 DAYS.
8. FINAL STABILIZATION MUST BE IMPLEMENTED AT ALL APPLICABLE CONSTRUCTION SITES. FINAL STABILIZATION IS ACHIEVED WHEN ALL GROUND DISTURBING ACTIVITIES ARE COMPLETE AND ALL DISTURBED AREAS EITHER HAVE A UNIFORM VEGETATIVE COVER WITH INDIVIDUAL PLANT DENSITY OF 70 PERCENT OF PRE-DISTURBANCE LEVELS ESTABLISHED OR EQUIVALENT PERMANENT ALTERNATIVE STABILIZATION METHOD IS IMPLEMENTED. ALL TEMPORARY SEDIMENT AND EROSION CONTROL MEASURES SHALL BE REMOVED UPON FINAL STABILIZATION AND BEFORE PERMIT CLOSURE.
9. ALL PERMANENT STORMWATER FACILITIES SHALL BE INSTALLED AS DESIGNED IN THE APPROVED PLANS. ANY PROPOSED CHANGES THAT EFFECT THE DESIGN OF FUNCTION OF PERMANENT STORMWATER MANAGEMENT STRUCTURES MUST BE APPROVED BY THE ECM ADMINISTRATOR PRIOR TO IMPLEMENTATION.
10. EARTH DISTURBANCES SHALL BE CONDUCTED IN SUCH A MANNER AS TO EFFECTIVELY MINIMIZE ACCELERATED SOIL EROSION AND RESULTING SEDIMENTATION. ALL DISTURBANCES SHALL BE DESIGNED, CONSTRUCTED, AND COMPLETED SO THAT THE EXPOSED AREA OF ANY DISTURBED LAND SHALL BE LIMITED TO THE SHORTEST PRACTICAL PERIOD OF TIME. PRE-EXISTING VEGETATION SHALL BE PROTECTED AND MAINTAINED WITHIN 50 HORIZONTAL FEET OF A WATERS OF THE STATE UNLESS SHOWN TO BE INFEASIBLE AND SPECIFICALLY REQUESTED AND APPROVED.
11. COMPACTION OF SOIL MUST BE PREVENTED IN AREAS DESIGNATED FOR INFILTRATION CONTROL MEASURES OF WHERE FINAL STABILIZATION WILL BE ACHIEVED BY VEGETATIVE COVER. AREAS DESIGNATED FOR INFILTRATION CONTROL MEASURES SHALL ALSO BE PROTECTED FROM SEDIMENTATION DURING CONSTRUCTION UNTIL FINAL STABILIZATION IS ACHIEVED. IF COMPACTION PREVENTION IS NOT FEASIBLE DUE TO SITE CONSTRAINTS, ALL AREAS DESIGNATED FOR INFILTRATION AND VEGETATION CONTROL MEASURES MUST BE LOOSENED PRIOR TO INSTALLATION OF THE CONTROL MEASURE(S).
12. ANY TEMPORARY OR PERMANENT FACILITY DESIGNED AND CONSTRUCTED FOR THE CONVEYANCE OF STORMWATER AROUND, THROUGH, OR FROM THE EARTH DISTURBANCE AREA SHALL BE A STABILIZED CONVEYANCE DESIGNED TO MINIMIZE EROSION AND THE DISCHARGE OF SEDIMENT OFF SITE.
13. CONCRETE WASH WATER SHALL BE CONTAINED AND DISPOSED OF IN ACCORDANCE WITH THE SWMP. NO WASH WATER SHALL BE DISCHARGED TO OR ALLOWED TO ENTER STATE WATERS, INCLUDING ANY SURFACE OR SUBSURFACE STORM DRAINAGE SYSTEM OR FACILITIES. CONCRETE WASHOUTS SHALL NOT BE LOCATED IN AN AREA WHERE SHALLOW GROUNDWATER MAY BE PRESENT, OR WITHIN 50 FEET OF A SURFACE WATER BODY, CREEK OR STREAM.
14. DURING DEWATERING OPERATIONS OF UNCONTAMINATED GROUND WATER MAY BE DISCHARGED ON SITE, BUT SHALL NOT LEAVE THE SITE IN THE FORM OF SURFACE RUNOFF UNLESS AN APPROVED STATE DEWATERING PERMIT IS IN PLACE.
15. EROSION BLANKET OR OTHER PROTECTIVE COVERING SHALL BE USED ON SLOPES STEEPER THAN 3:1.
16. CONTRACTOR SHALL BE RESPONSIBLE FOR THE REMOVAL OF ALL WASTES FROM THE CONSTRUCTION SITE FOR DISPOSAL IN ACCORDANCE WITH LOCAL AND STATE REGULATORY REQUIREMENTS. NO CONSTRUCTION DEBRIS, TREE SLASH, BUILDING MATERIAL WASTES OR UNUSED BUILDING MATERIALS SHALL BE BURIED, DUMPED OR DISCHARGED AT THIS SITE.
17. WASTE MATERIALS SHALL NOT BE TEMPORARILY PLACED OR STORED IN THE STREET, ALLEY OR OTHER PUBLIC WAY, UNLESS IN ACCORDANCE WITH AN APPROVED TRAFFIC CONTROL PLAN. CONTROL MEASURES MAY BE REQUIRED BY EL PASO COUNTY ENGINEERING IF DEEMED NECESSARY, BASED ON SPECIFIC CONDITIONS AND CIRCUMSTANCES.
18. TRACKING OF SOILS AND CONSTRUCTION DEBRIS OFF-SITE SHALL BE MINIMIZED. MATERIALS TRACKED OFF-SITE SHALL BE CLEANED UP PROPERLY AND PROPERLY DISPOSED OF IMMEDIATELY.
19. THE OWNER/DEVELOPER SHALL BE RESPONSIBLE FOR THE REMOVAL OF ALL CONSTRUCTION, DEBRIS, DIRT, TRASH, ROCK, SEDIMENT, SOIL AND SAND THAT MAY ACCUMULATE IN ROADS, STORM DRAINS AND OTHER DRAINAGE CONVEYANCE SYSTEMS AND STORMWATER APPURTENANCES AS A RESULT OF THE SITE DEVELOPMENT.
20. THE QUANTITY OF MATERIALS STORED ON THE PROJECT SITE SHALL BE LIMITED, AS MUCH AS PRACTICAL, TO THAT QUANTITY REQUIRED TO PERFORM THE WORK IN AN ORDERLY SEQUENCE. ALL MATERIALS STORED ON-SITE SHALL BE STORED IN AN EAT, ORDERLY MANNER, IN THEIR ORIGINAL CONTAINERS, WITH ORIGINAL MANUFACTURER'S LABEL.
21. NO CHEMICAL(S) HAVING THE POTENTIAL TO BE RELEASED IN STORMWATER ARE TO BE STORED OR USED ONSITE UNLESS PERMISSION FOR THE USE OF SUCH CHEMICAL(S) IS GRANTED IN WRITING BY THE ECM ADMINISTRATOR. IN GRANTING APPROVAL FOR THE USE OF SUCH CHEMICAL(S) SPECIAL CONDITIONS AND MONITORING MAY BE REQUIRED.
22. BULK STORAGE OF ALLOWED PETROLEUM PRODUCTS OR OTHER ALLOWED LIQUID CHEMICALS IN EXCESS OF 55 GALLONS SHALL REQUIRE ADEQUATE SECONDARY PROTECTION TO CONTAIN ALL SPILLS ONSITE AND TO PREVENT ANY SPILLED MATERIALS FROM ENTERING STATE WATERS, ANY SURFACE OR SUBSURFACE STORM DRAINAGE SYSTEM OR OTHER FACILITIES.
23. NO PERSON SHALL CAUSE THE IMPEDIMENT OF STORMWATER FLOW IN THE CURB AND GUTTER OR DITCH EXCEPT WITH APPROVED SEDIMENT CONTROL MEASURES.
24. OWNER/DEVELOPER AND THEIR AGENTS SHALL COMPLY WITH THE "COLORADO WATER QUALITY CONTROL ACT" (TITLE 25, ARTICLE 8, CRS) AND THE "CLEAN WATER ACT" (33 USC 1344), IN ADDITION TO THE REQUIREMENTS OF THE LAND DEVELOPMENT CODE, DCM VOLUME II AND ECM APPENDIX I. ALL APPROPRIATE PERMITS MUST BE OBTAINED BY THE CONTRACTOR PRIOR TO CONSTRUCTION (1041, NPDES, FLOODPLAIN, 404, FUGITIVE DUST, ETC). IN THE EVENT OF CONFLICTS BETWEEN THESE REQUIREMENTS AND OTHER LAWS RULES OR REGULATIONS OF OTHER FEDERAL, STATE, LOCAL OR COUNTY AGENCIES, THE MOST RESTRICTIVE LAWS, RULES OR REGULATIONS SHALL APPLY.
25. ALL CONSTRUCTION TRAFFIC MUST ENTER/EXIT THE SITE ONLY AT APPROVED CONSTRUCTION ACCESS POINTS.
26. PRIOR TO CONSTRUCTION THE PERMITEE SHALL VERIFY THE LOCATION OF EXISTING UTILITIES.
27. A WATER SOURCE SHALL BE AVAILABLE ON SITE DURING EARTHWORK OPERATIONS AND SHALL BE UTILIZED AS REQUIRED TO MINIMIZE DUST FROM EARTHWORK EQUIPMENT AND WIND.
28. THE SOILS REPORT FOR THE SITE HAS BEEN PREPARED BY ENTECH ENGINEERING, INC. AND SHALL BE CONSIDERED A PART OF THESE PLANS.
29. AT LEAST (10) DAYS PRIOR TO THE ANTICIPATED START OF CONSTRUCTION, FOR PROJECTS THAT WILL DISTURB ONE (1) ACRE OR MORE, THE OWNER OR OPERATOR OF CONSTRUCTION ACTIVITY SHALL SUBMIT A PERMIT APPLICATION FOR STORMWATER DISCHARGE TO THE COLORADO DEPARTMENT OF PUBLIC HEALTH AND ENVIRONMENT, WATER QUALITY DIVISION. THE APPLICATION CONTAINS CERTIFICATION OF COMPLETION OF A STORMWATER MANAGEMENT PLAN (SWMP), OF WHICH THIS GRADING AND EROSION CONTROL PLAN MAY BE A PART. FOR INFORMATION OR APPLICATION MATERIALS CONTACT:

COLORADO DEPARTMENT OF PUBLIC HEALTH AND ENVIRONMENT  
WATER QUALITY CONTROL DIVISION  
WQCD - PERMITS  
4300 CHERR CREEK DRIVE SOUTH  
DENVER, CO 80246-1530  
ATTN: PERMITS UNIT

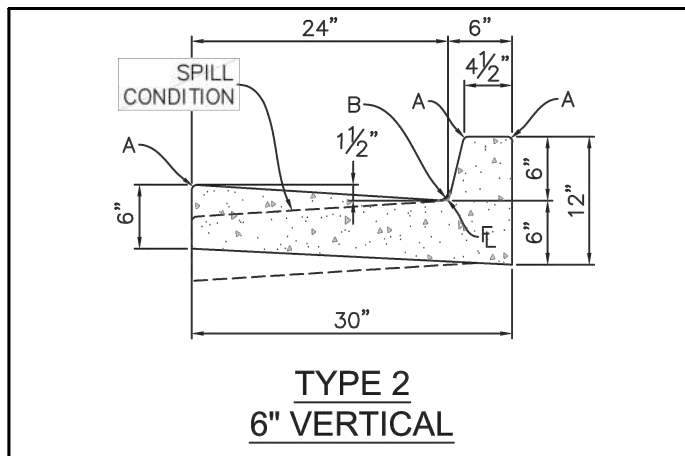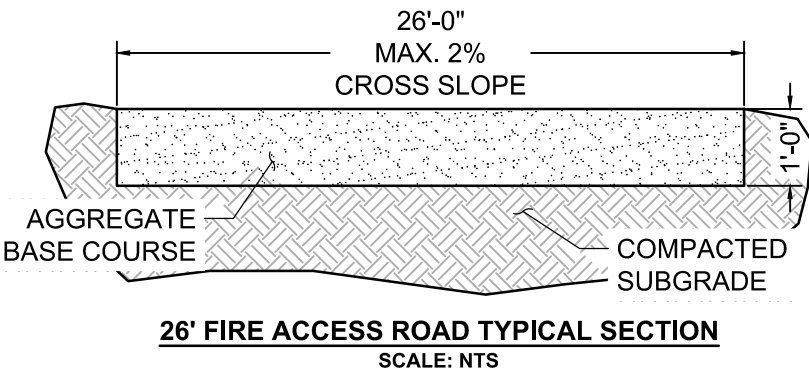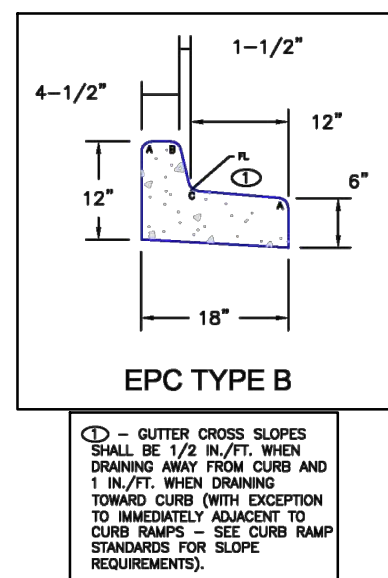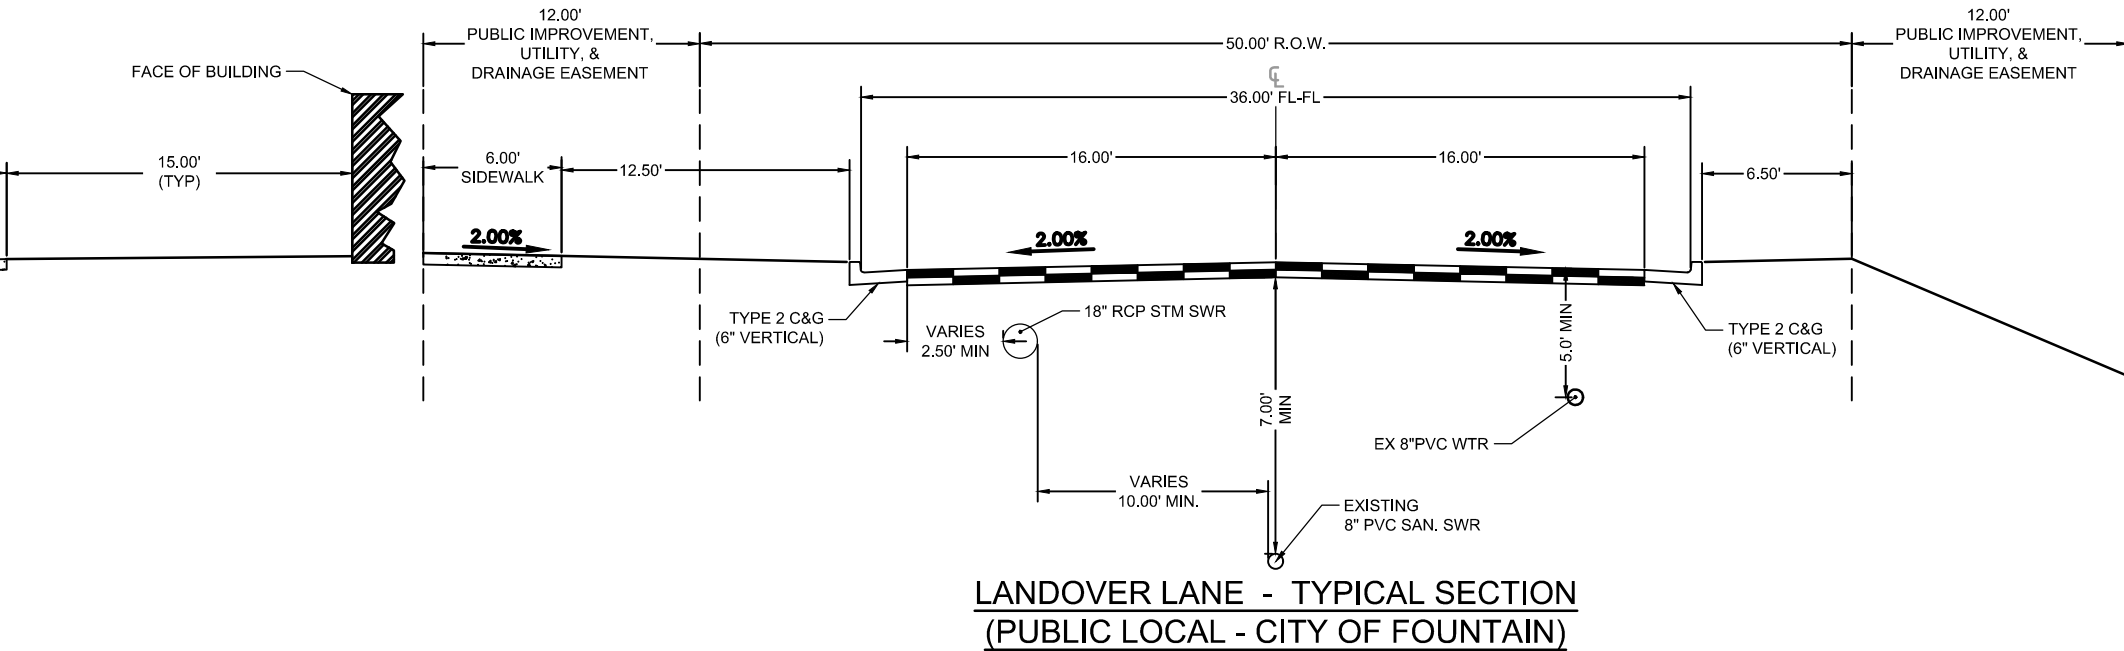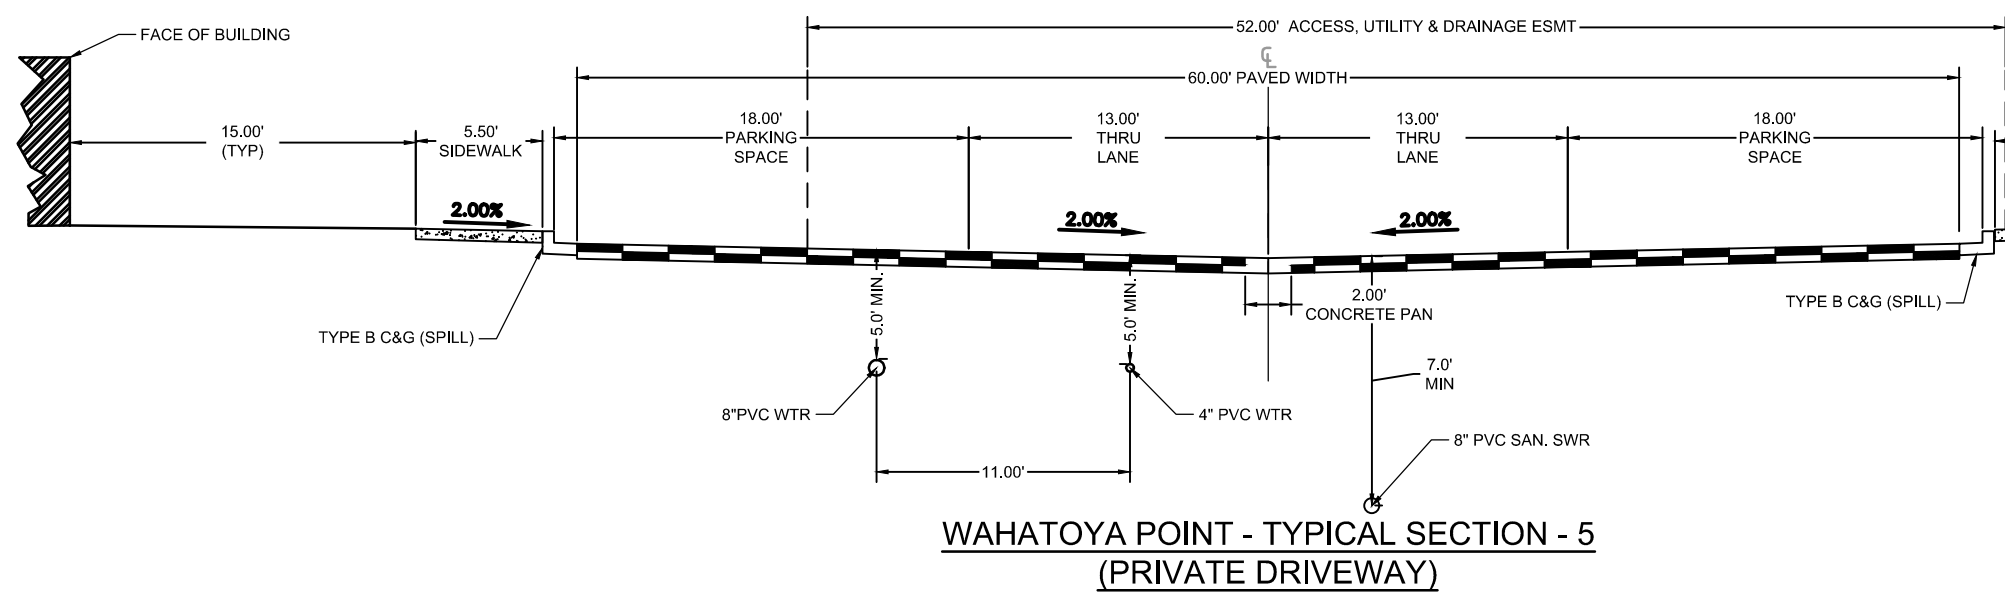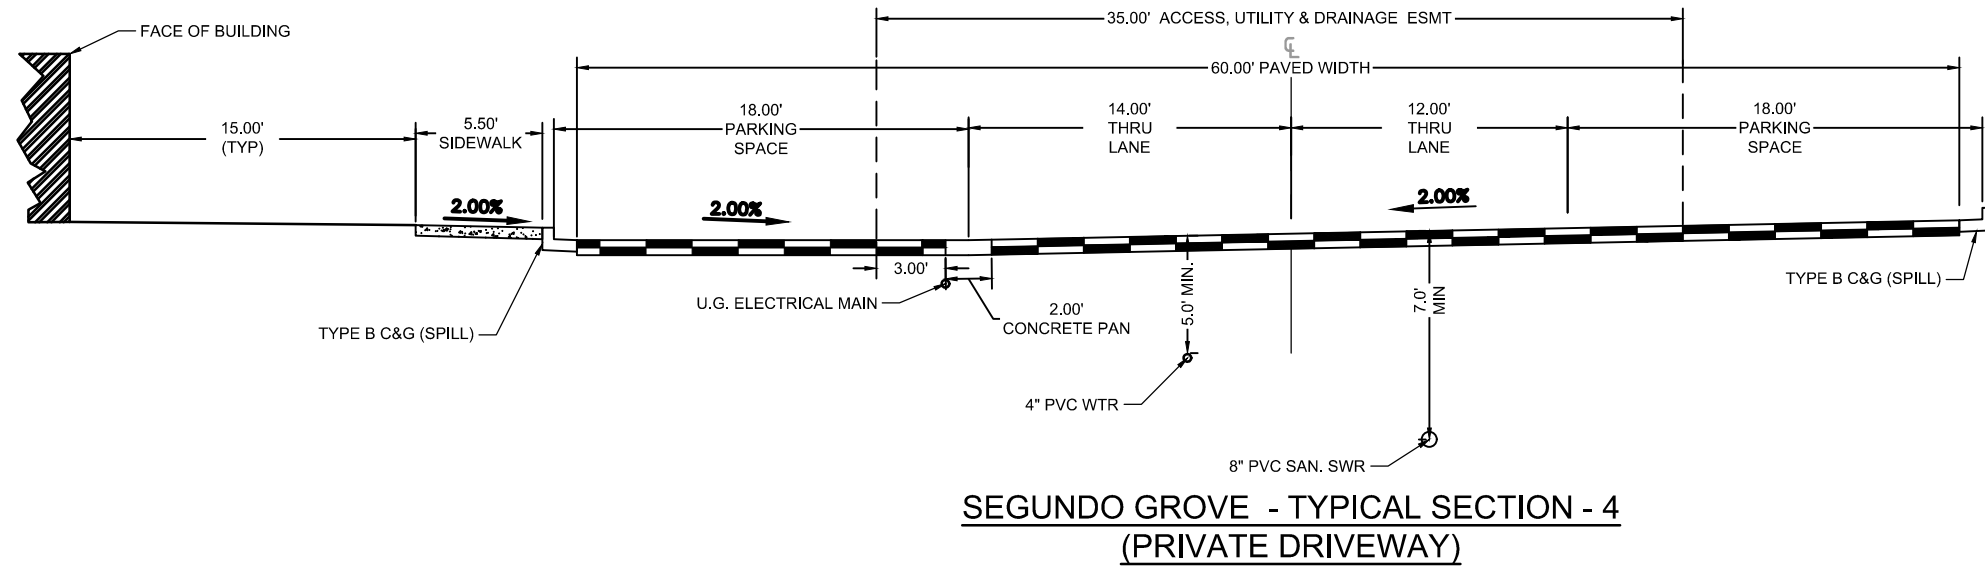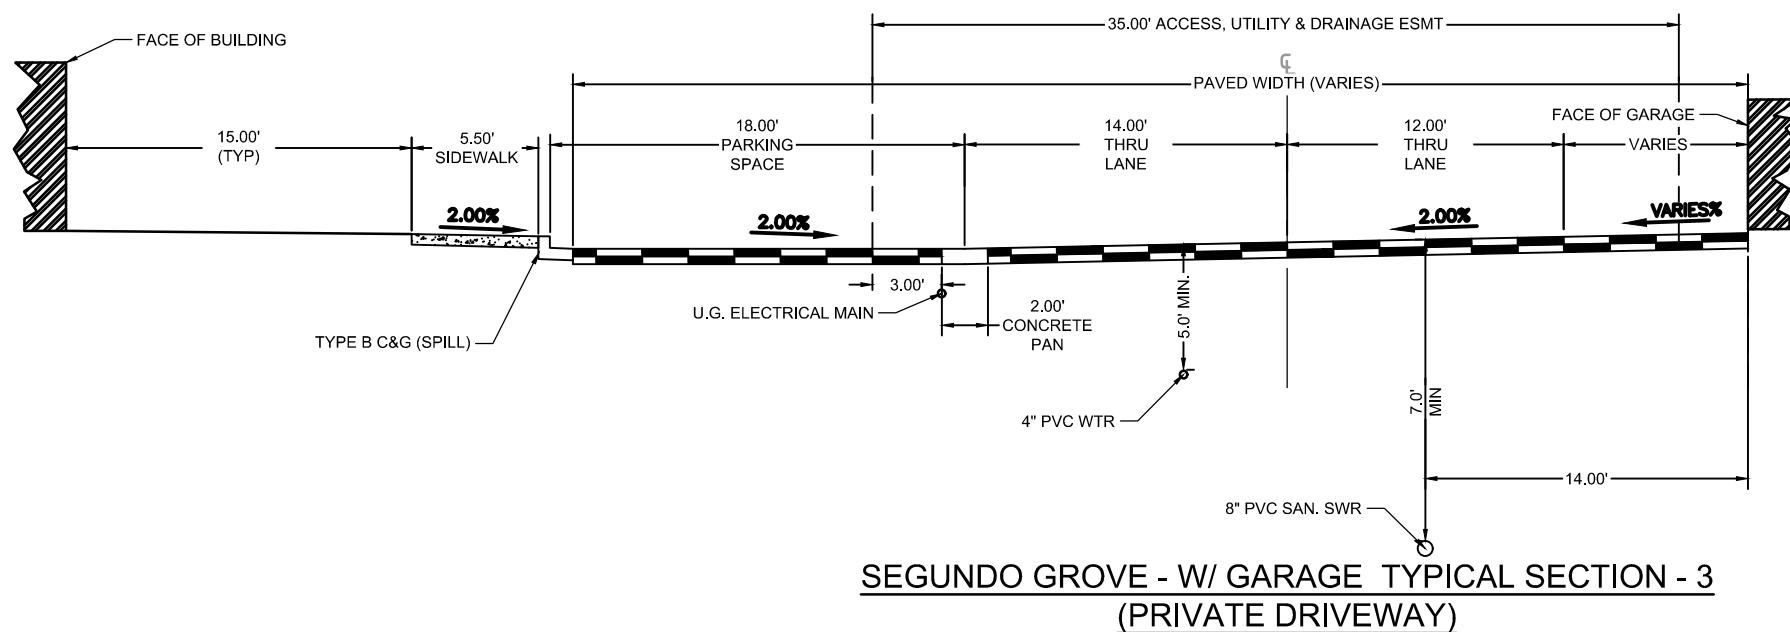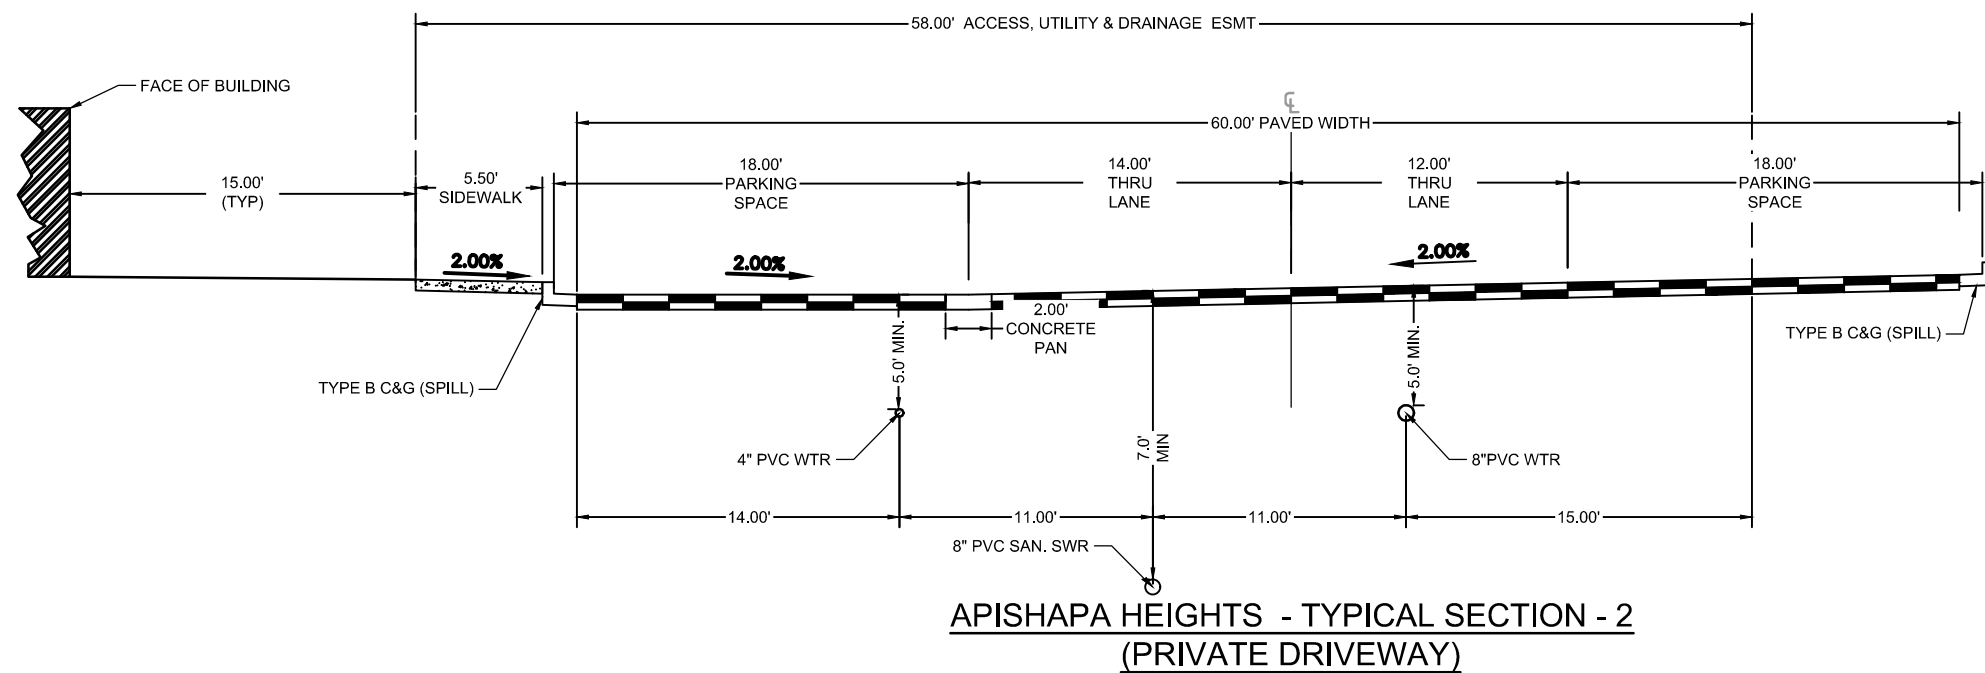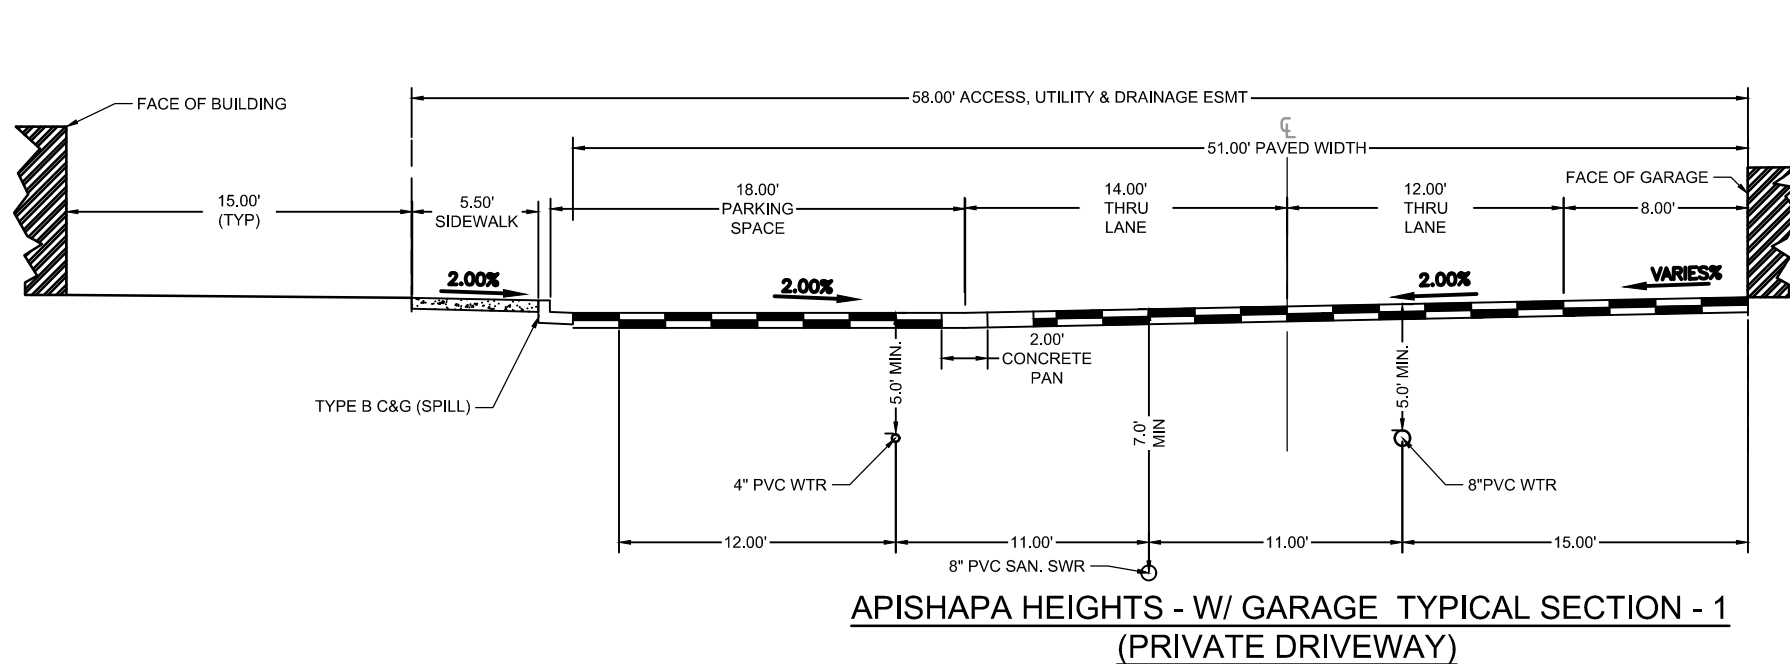

NOT FOR CONSTRUCTION

PCD FILNE NO.: SF2214

DRAWN BY: CBM JOB DATE: 8/22/2022 BAR IS ONE INCH ON  
APPROVED: KMH JOB NUMBER: 200541 OFFICIAL DRAWINGS.  
0 XXXXXXXXXX 1"  
CAD DATE: 9/1/2022 IF NOT ONE INCH,  
CAD FILE: J:\2020\200541\CAD\DWG\C\CD\IE\ Paso\_ColCover ADJUST SCALE ACCORDINGLY.

NO.	DATE	BY	REVISION DESCRIPTION



HR GREEN - COLORADO SPRINGS  
7222 COMMERCE CENTER DR SUITE 220  
COLORADO SPRINGS CO 80919  
PHONE: 719.300.4140 TOLL FREE: 800.728.7805  
FAX: 844.273.1057 | [HRGreen.com](http://HRGreen.com)

THE COTTAGES AT MESA RIDGE  
GOODWIN KNIGHT  
EL PASO COUNTY, COLORADO



EL PASO COUNTY CONSTRUCTION DOCUMENTS

GEC NOTES & TYPICAL SECTIONS

SHEET  
TS

2






1. SEE SHEETS 28 - 31 FOR CITY OF COLORADO SPRINGS GRADING AND EROSION CONTROL DETAILS.
2. ALL STORMWATER MANAGEMENT MEASURES SHOWN ON THIS PLAN MUST BE INSTALLED AND MAINTAINED PER THE COLORADO SPRINGS STORMWATER CONSTRUCTION MANUAL; LATEST REVISIONS.
3. ARE WITHIN LIMITS OF DISTURBANCE TO BE CLEARED, GRUBBED AND STOCKPILED PRIOR TO IMPACT OF ANY FILL.
4. ALL 3:1 SLOPES MUST BE RECEIVE SLOPE TRACKING TREATMENT AND EROSION CONTROL BLANKET.
5. STOCKPILES REQUIRED DURING ONSITE CONSTRUCTION ACTIVITIES WILL BE PLACED AT THE DISCRETION OF THE CONTRACTOR. STOCKPILING OF MATERIAL MUST NOT OCCUR OUTSIDE THE LIMITS OF DISTURBANCE SHOWN ON THIS PLAN.
6. NON-STRUCTURAL CONTROLS (I.E. STREET SWEEPING) WILL BE AT THE DISCRETION OF THE PROJECT'S CERTIFIED GEC ADMINISTRATOR THROUGHOUT THE DURATION OF LAND DISTURBING ACTIVITIES.
7. THERE ARE NO ANTICIPATED ASPHALT AND/OR CONCRETE BATCH PLANTS, OR MASONRY MIX STATIONS ASSOCIATED WITH THIS PROJECT. IF THE CONTRACTOR REQUIRES A ASPHALT/CONCRETE BATCH PLANTS OR MASONRY MIX STATIONS, THESE PLANS WILL BE AMENDED AS REQUIRED.
8. THERE ARE NO EXISTING PRESERVATION EASEMENTS LOCATED ON SITE.
9. THE SITE IS NOT LOCATED IN THE FEMA 100-YR FLOODPLAIN.
10. ONSITE EXISTING VEGETATION IS NATIVE GRASSES AND WEEDS. THERE IS NO NOTABLE VEGETATION OTHERWISE.
11. PROPOSED VEGETATION IS FOUND IN LANDSCAPE PLANS OF THE CONSTRUCTION DRAWINGS.

- ✓ TOTAL DISTURBANCE AREA = 11.33 AC
- ✓ RECEIVING WATERS: JIMMY CAMP CREEK
- ✓ ANTICIPATED START OF CONSTRUCTION: SPRING 2022
- ✓ ANTICIPATED END OF LAND DISTURBANCE: WINTER 2022

	<b>CWA</b>	CONCRETE WASHOUT AREA
	<b>CF</b>	CONSTRUCTION FENCE
	<b>DD</b>	DIVERSION DITCH
	<b>IP</b>	INLET PROTECTION
	<b>CIP</b>	CULVERT INLET PROTECTION
	<b>SCL</b>	SEDIMENT CONTROL LOG
	<b>SF</b>	SILT FENCE
	<b>SSA</b>	STABILIZED STAGING AREA
	<b>SP</b>	STOCKPILE MANAGEMENT
	<b>VTC</b>	VEHICLE TRACKING CONTROL
	<b>LOD</b>	LIMITS OF CONSTRUCTION/ DISTURBANCE
	<b>SM</b>	SEEDING AND MULCHING
	<b>FA</b>	FILL AREA (ALL OTHER AREAS ARE CUT)
	<b>RS</b>	ROCK SOCK
	<b>TSB</b>	TEMPORARY SEDIMENT BASIN
	<b>ECB</b>	EROSION CONTROL BLANKET
<b>TW/BW</b>		ELEVATION OF TOP/BOTTOM OF WALL
		PROP FLOW DIRECTION
		EX FLOW DIRECTION
		EX PROPERTY LINE
		EX RIGHT OF WAY



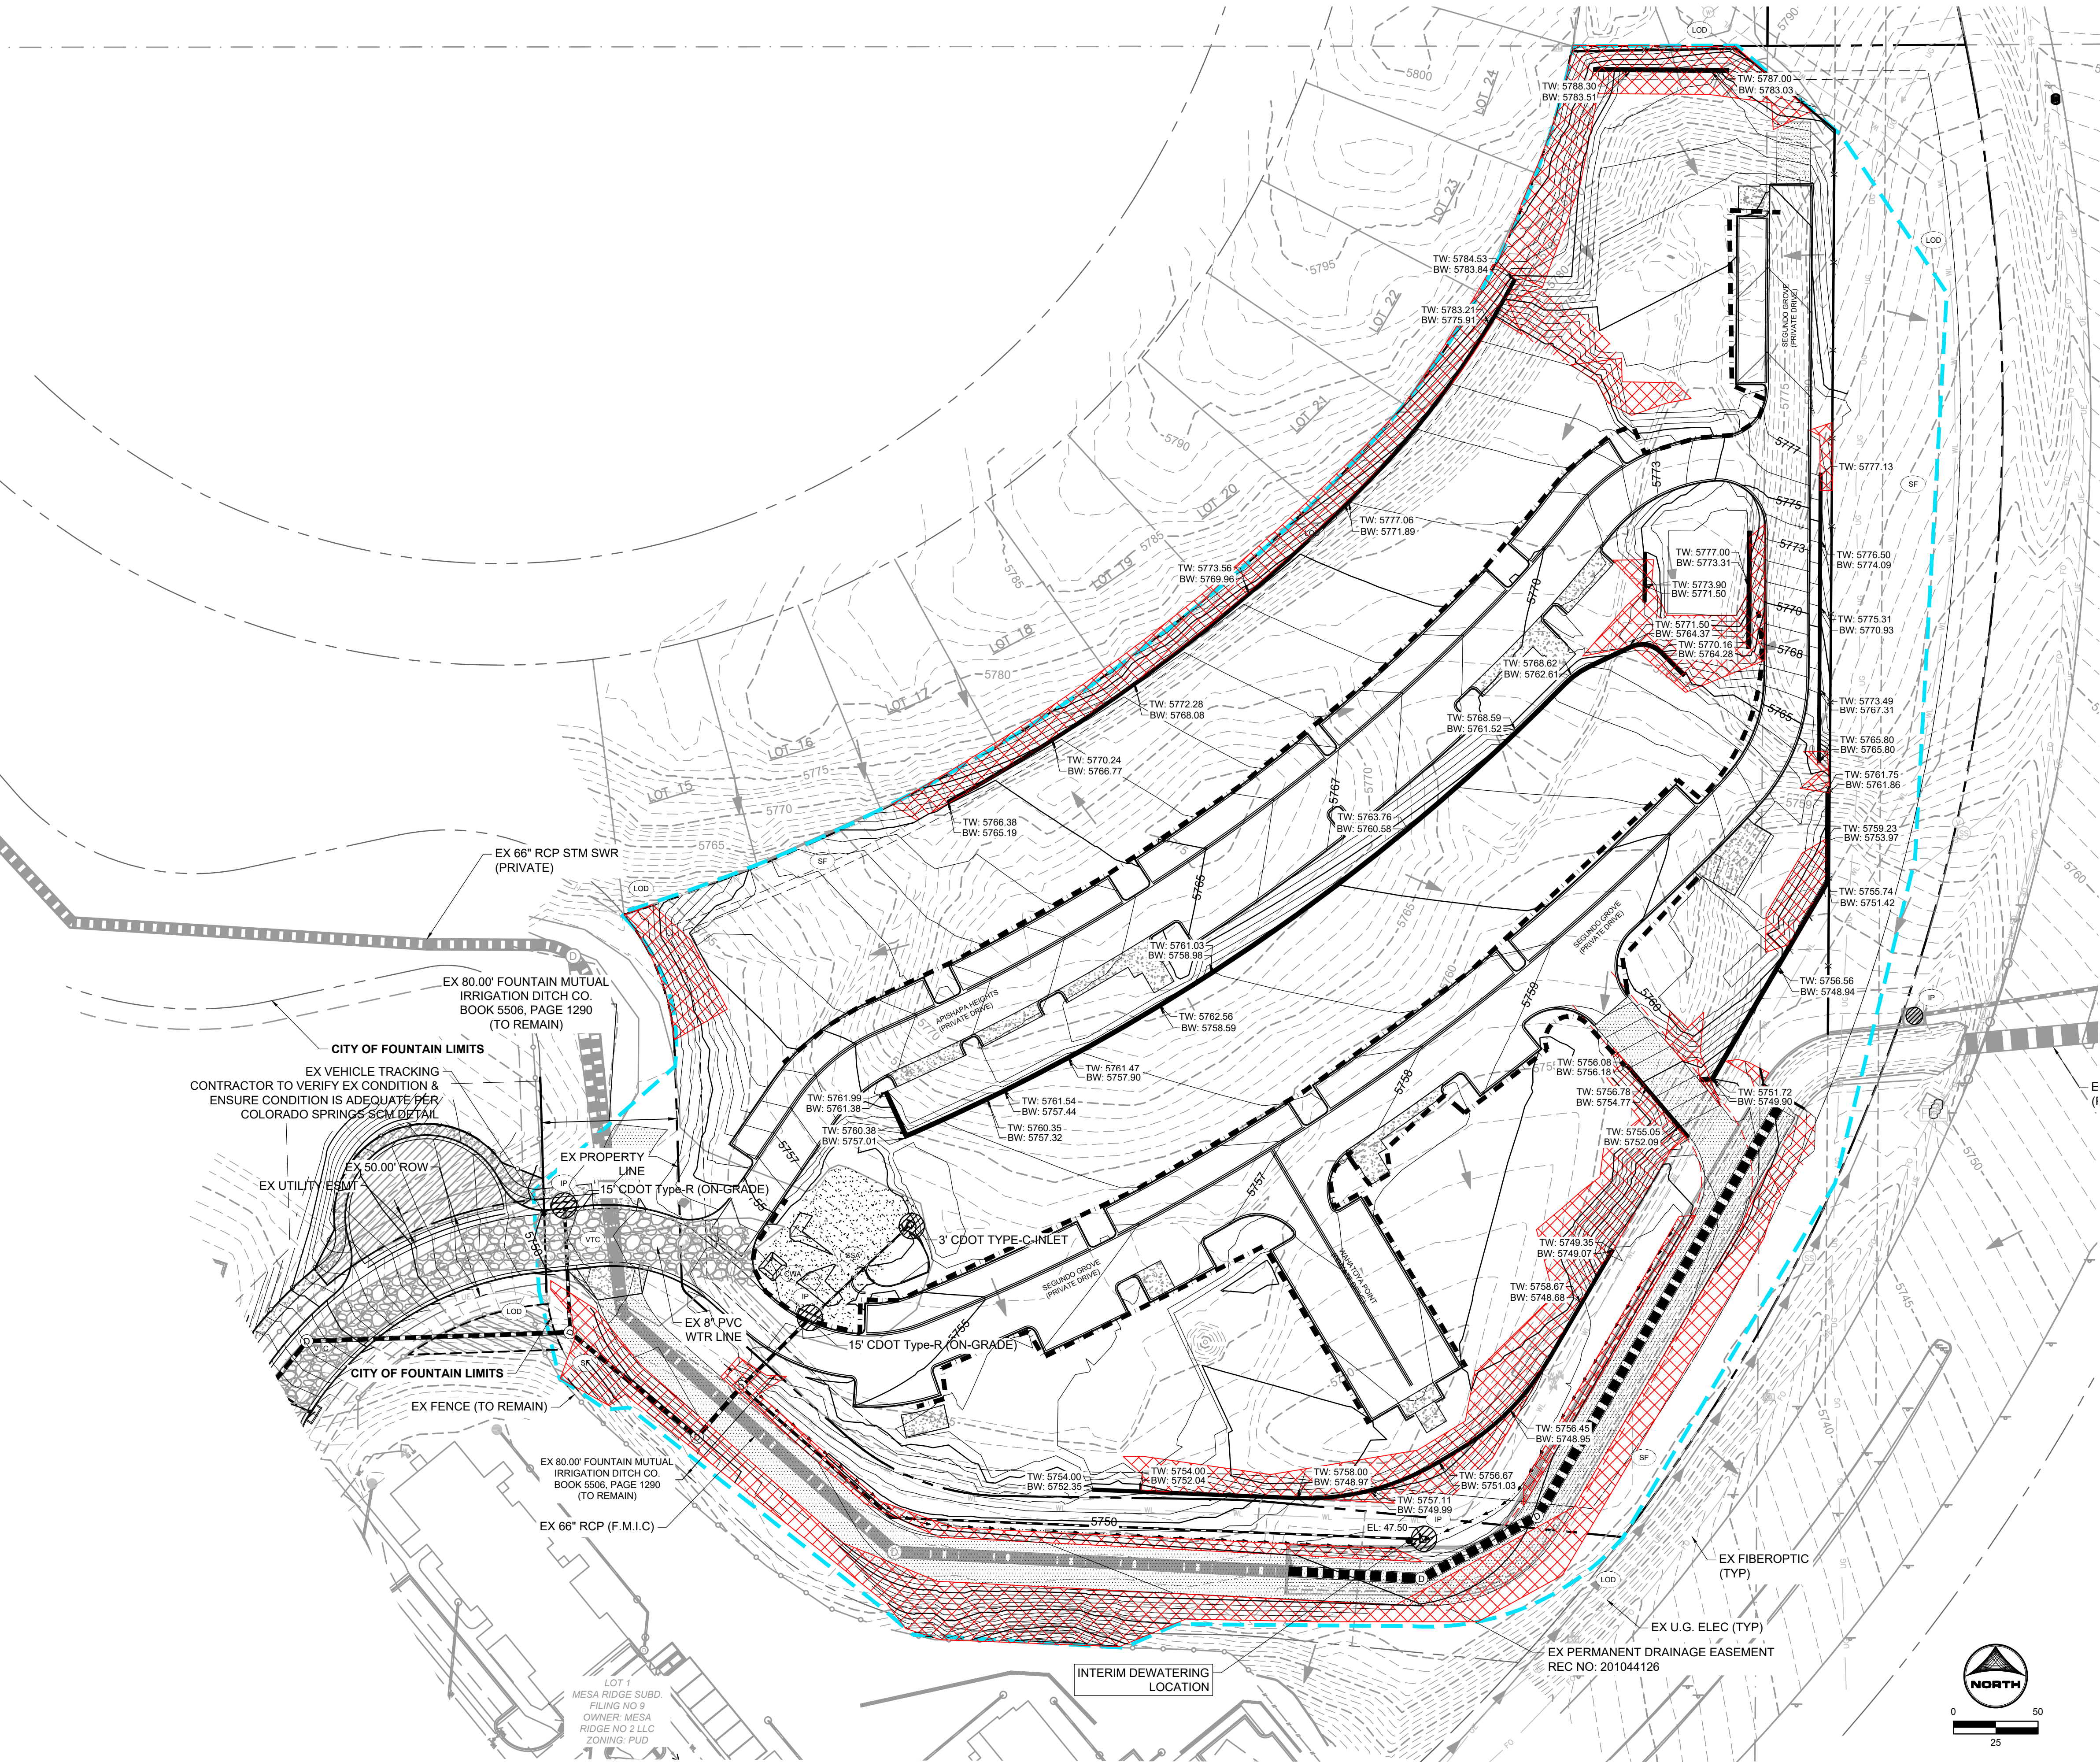

GRADING & EROSION CONTROL PLAN NOTES:

1. SEE SHEETS 28 -31 FOR CITY OF COLORADO SPRINGS GRADING AND EROSION CONTROL DETAILS.
2. ALL STORMWATER MANAGEMENT MEASURES SHOWN ON THIS PLAN MUST BE INSTALLED AND MAINTAINED PER THE COLORADO SPRINGS STORMWATER CONSTRUCTION MANUAL; LATEST REVISIONS.
3. AREA WITHIN LIMITS OF DISTURBANCE TO BE CLEARED, GRUBBED AND STOCKPILED PRIOR TO IMPORT OF ANY FILL.
4. ALL 3:1 SLOPES MUST BE RECEIVE SLOPE TRACKING TREATMENT AND EROSION CONTROL BLANKET.
5. STOCKPILES REQUIRED DURING ONSITE CONSTRUCTION ACTIVITIES WILL BE PLACED AT THE DISCRETION OF THE CONTRACTOR. STOCKPILING OF MATERIAL MUST NOT OCCUR OUTSIDE THE LIMITS OF DISTURBANCE SHOWN ON THIS PLAN.
6. NON-STRUCTURAL CONTROLS (I.E. STREET SWEEPING) WILL BE AT THE DISCRETION OF THE PROJECT'S CERTIFIED GEC ADMINISTRATOR THROUGHOUT THE DURATION OF LAND DISTURBING ACTIVITIES.
7. THERE ARE NO ANTICIPATED ASPHALT AND/OR CONCRETE BATCH PLANTS, OR MASONRY MIX STATIONS ASSOCIATED WITH THIS PROJECT. IF THE CONTRACTOR REQUIRES A ASPHALT/CONCRETE BATCH PLANTS OR MASONRY MIX STATIONS, THESES PLANS WILL BE AMENDED AS REQUIRED.
8. THERE ARE NO EXISTING PRESERVATION: EASEMENTS LOCATED ON SITE.
9. THE SITE IS NOT LOCATED IN THE FEMA 100-YR FLOODPLAIN
10. ONSITE EXISTING VEGETATION IS NATIVE GRASSES AND WEEDS. THERE IS NO NOTABLE VEGETATION OTHERWISE.
11. PROPOSED VEGETATION IS FOUND IN LANDSCAPE PLANS OF THE CONSTRUCTION DRAWINGS

PROJECT INFO:

TOTAL DISTURBANCE AREA = 11.33 AC

RECEIVING WATERS: JIMMY CAMP CREEK

ANTICIPATED START OF CONSTRUCTION: SPRING 2022

ANTICIPATED END OF LAND DISTURBANCE: WINTER 2022

GEC LEGEND:

- |  |       |                                     |
|--|-------|-------------------------------------|
|  | CWA   | CONCRETE WASHOUT AREA               |
|  | CF    | CONSTRUCTION FENCE                  |
|  | DD    | DIVERSION DITCH                     |
|  | IP    | INLET PROTECTION                    |
|  | CIP   | CULVERT INLET PROTECTION            |
|  | SCL   | SEDIMENT CONTROL LOG                |
|  | SF    | SILT FENCE                          |
|  | SSA   | STABILIZED STAGING AREA             |
|  | SP    | STOCKPILE MANAGEMENT                |
|  | VTC   | VEHICLE TRACKING CONTROL            |
|  | LOD   | LIMITS OF CONSTRUCTION/ DISTURBANCE |
|  | SM    | SEEDING AND MULCHING                |
|  | FA    | FILL AREA (ALL OTHER AREAS ARE CUT) |
|  | RS    | ROCK SOCK                           |
|  | TSB   | TEMPORARY SEDIMENT BASIN            |
|  | ECB   | EROSION CONTROL BLANKET             |
|  | TW/BW | ELEVATION OF TOP/BOTTOM OF WALL     |
|  |       | PROP FLOW DIRECTION                 |
|  |       | EX FLOW DIRECTION                   |
|  |       | EX PROPERTY LINE                    |
|  |       | EX RIGHT OF WAY                     |

PCD FILNE NO.: SF2214

DRAWN BY: CBM JOB DATE: 8/31/2022  
APPROVED: KMH JOB NUMBER: 200541  
CAD DATE: 8/31/2022  
CAD FILE: J:\2020\200541\CAD\Drawings\C\CD\IEI\_Paso\_Co\GEC\GEC\_Interim

BAR IS ONE INCH ON OFFICIAL DRAWINGS.  
0 1"  
IF NOT ONE INCH, ADJUST SCALE ACCORDINGLY.

NO.	DATE	BY	REVISION DESCRIPTION



HR GREEN - COLORADO SPRINGS  
7222 COMMERCE CENTER DR SUITE 220  
COLORADO SPRINGS CO 80919  
PHONE: 719.300.4140 TOLL FREE: 800.728.7805  
FAX: 844.273.1057 | HRGreen.com

THE COTTAGES AT MESA RIDGE  
GOODWIN KNIGHT  
EL PASO COUNTY, COLORADO




EL PASO COUNTY CONSTRUCTION DOCUMENTS  
GEC- INTERIM PLAN

SHEET  
EC

4




NOT FOR CONSTRUCTION



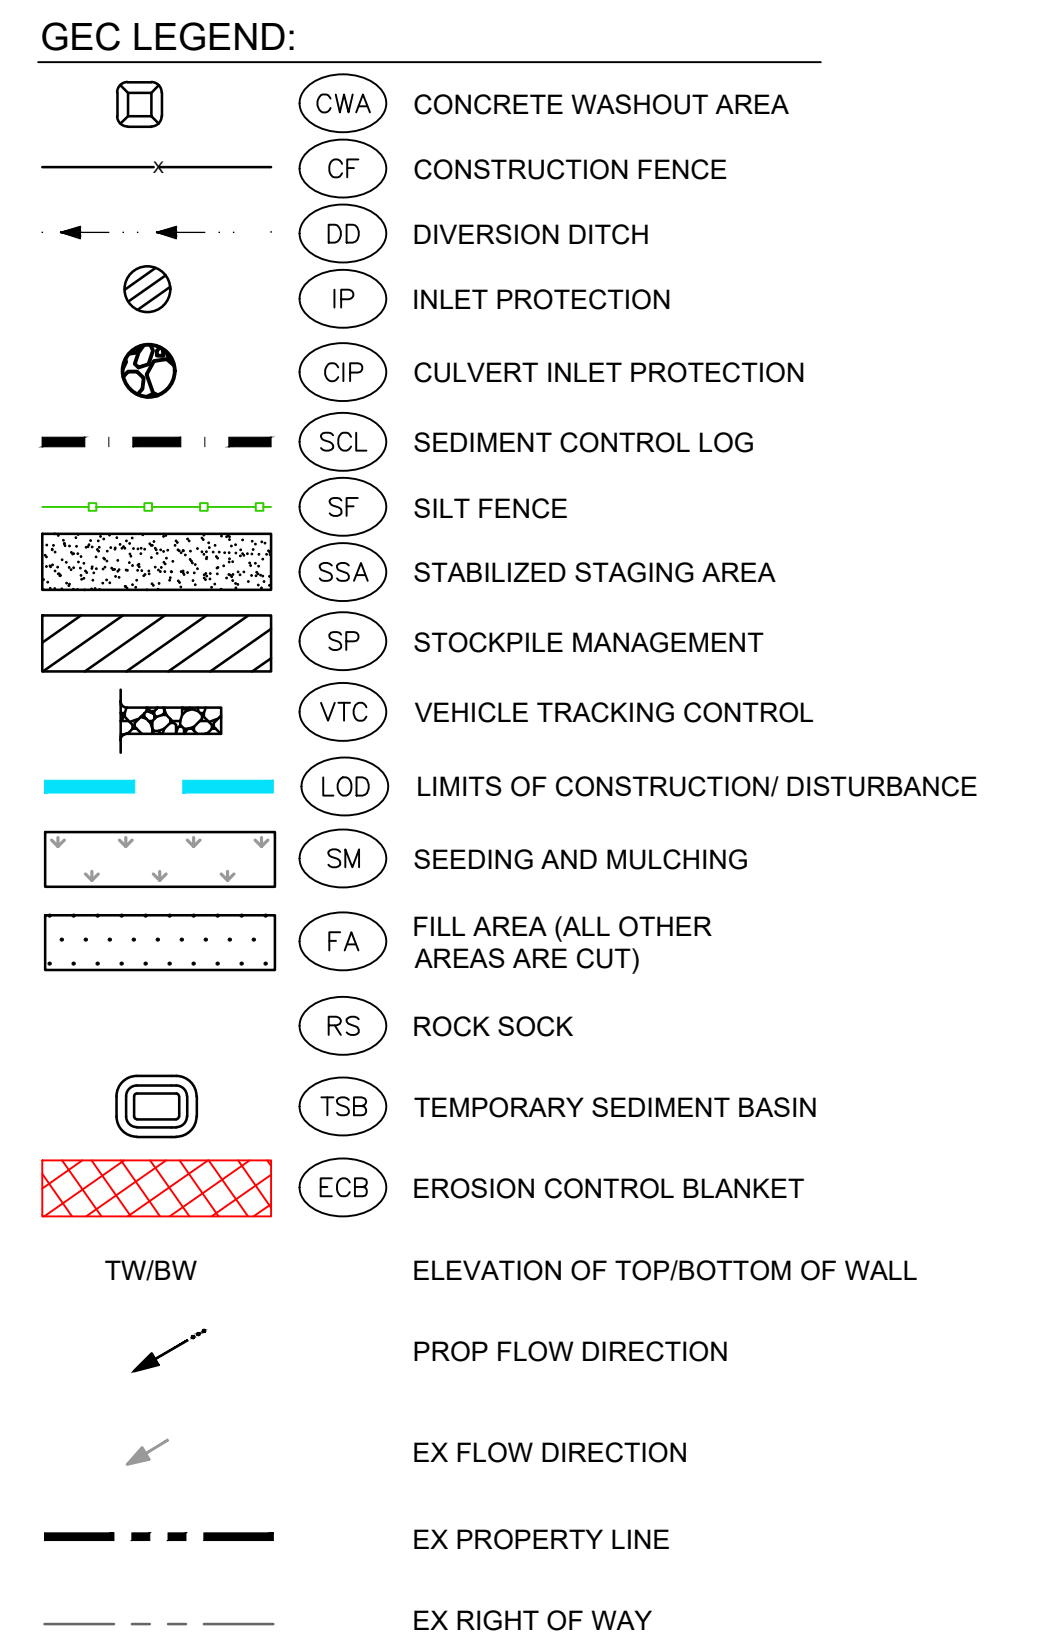


adjust title block  
unresolved.



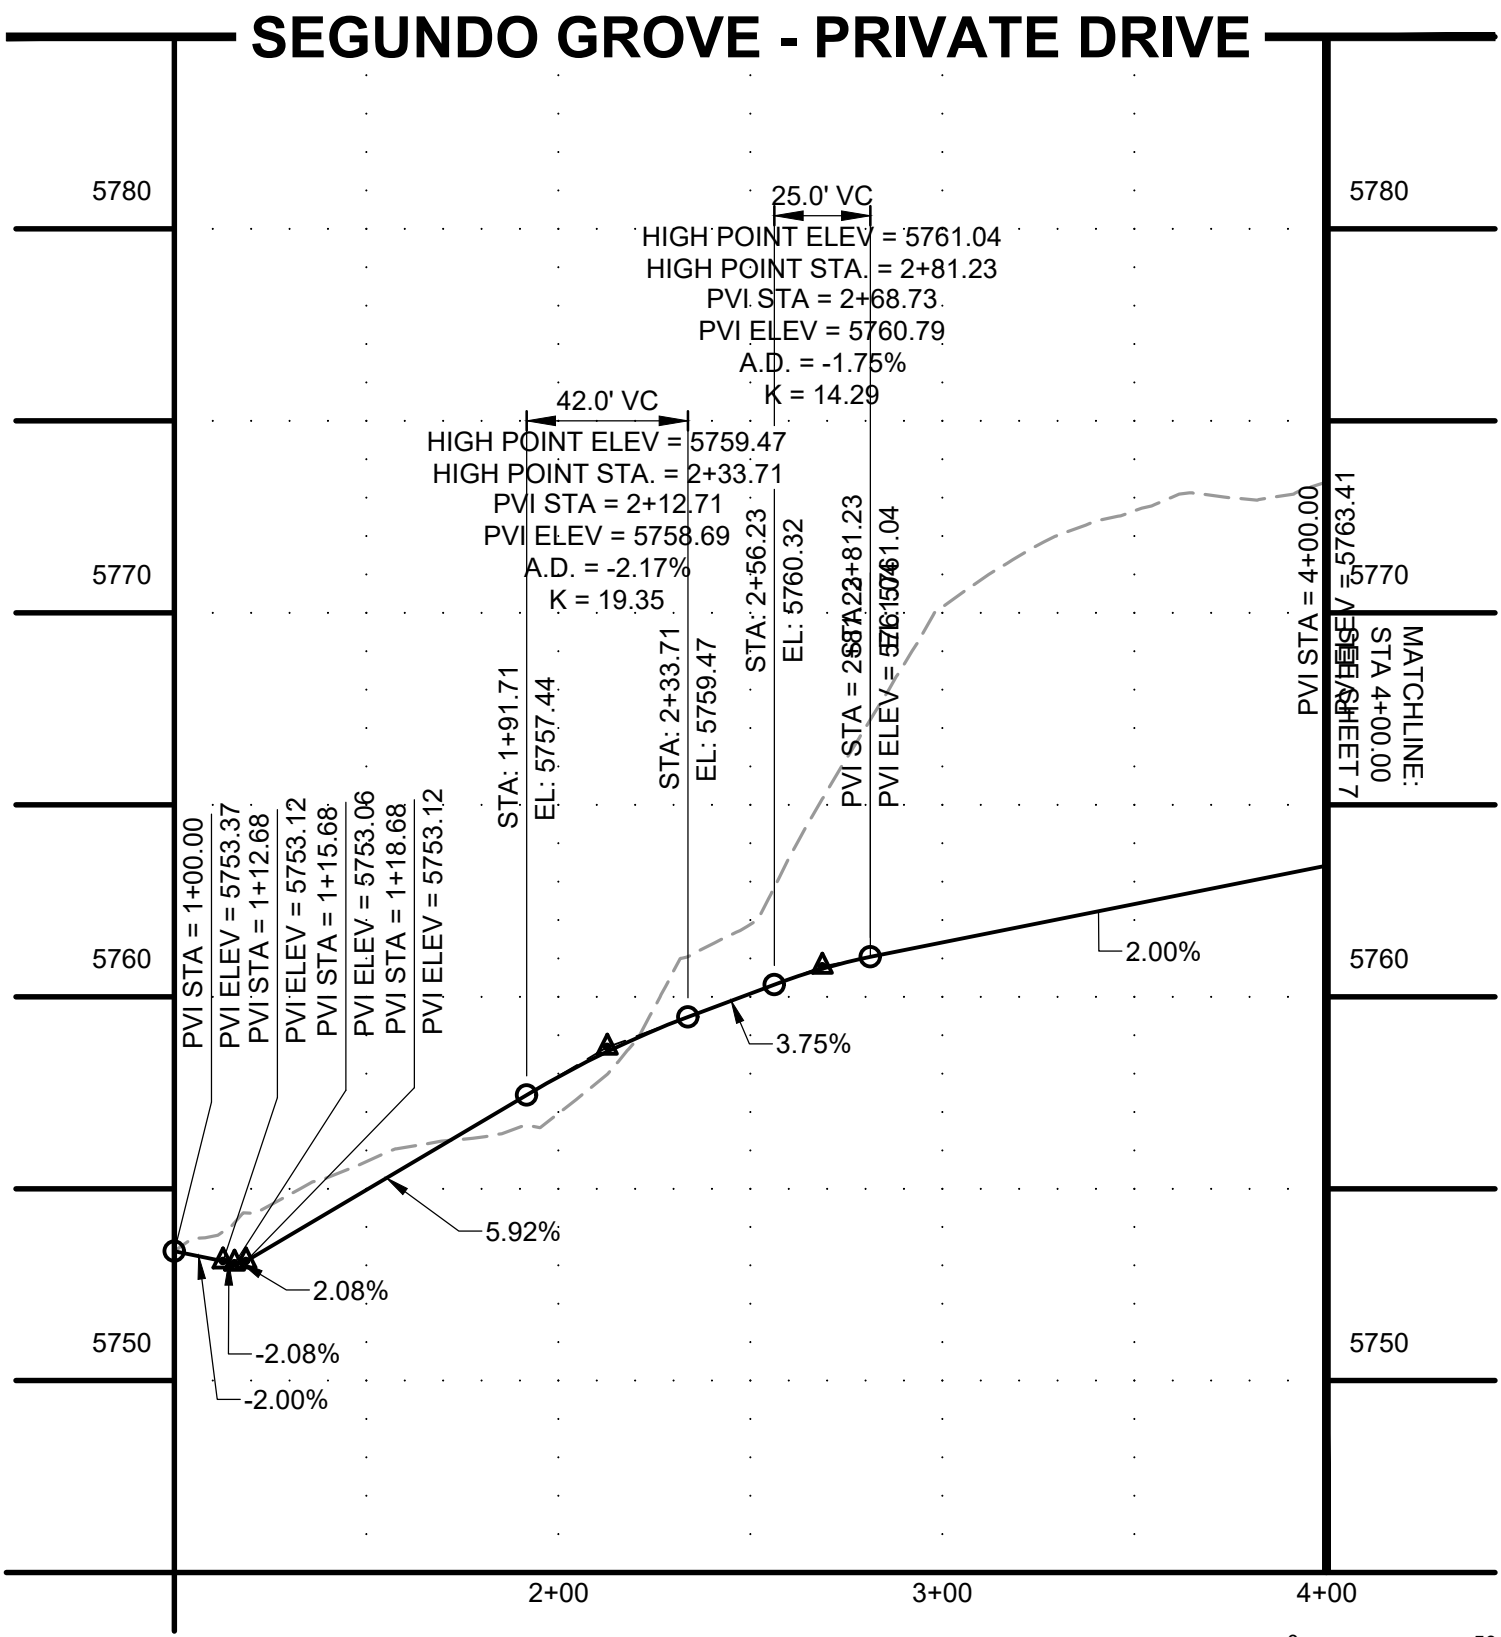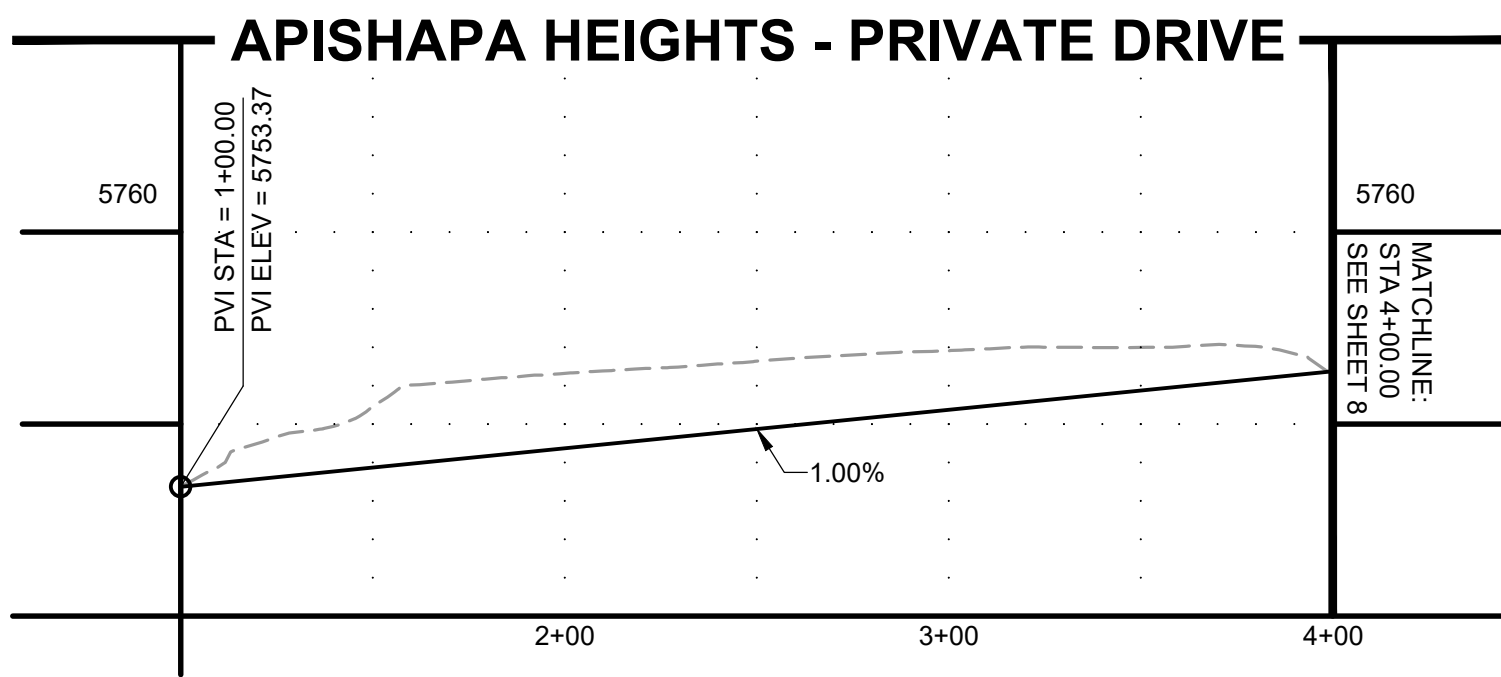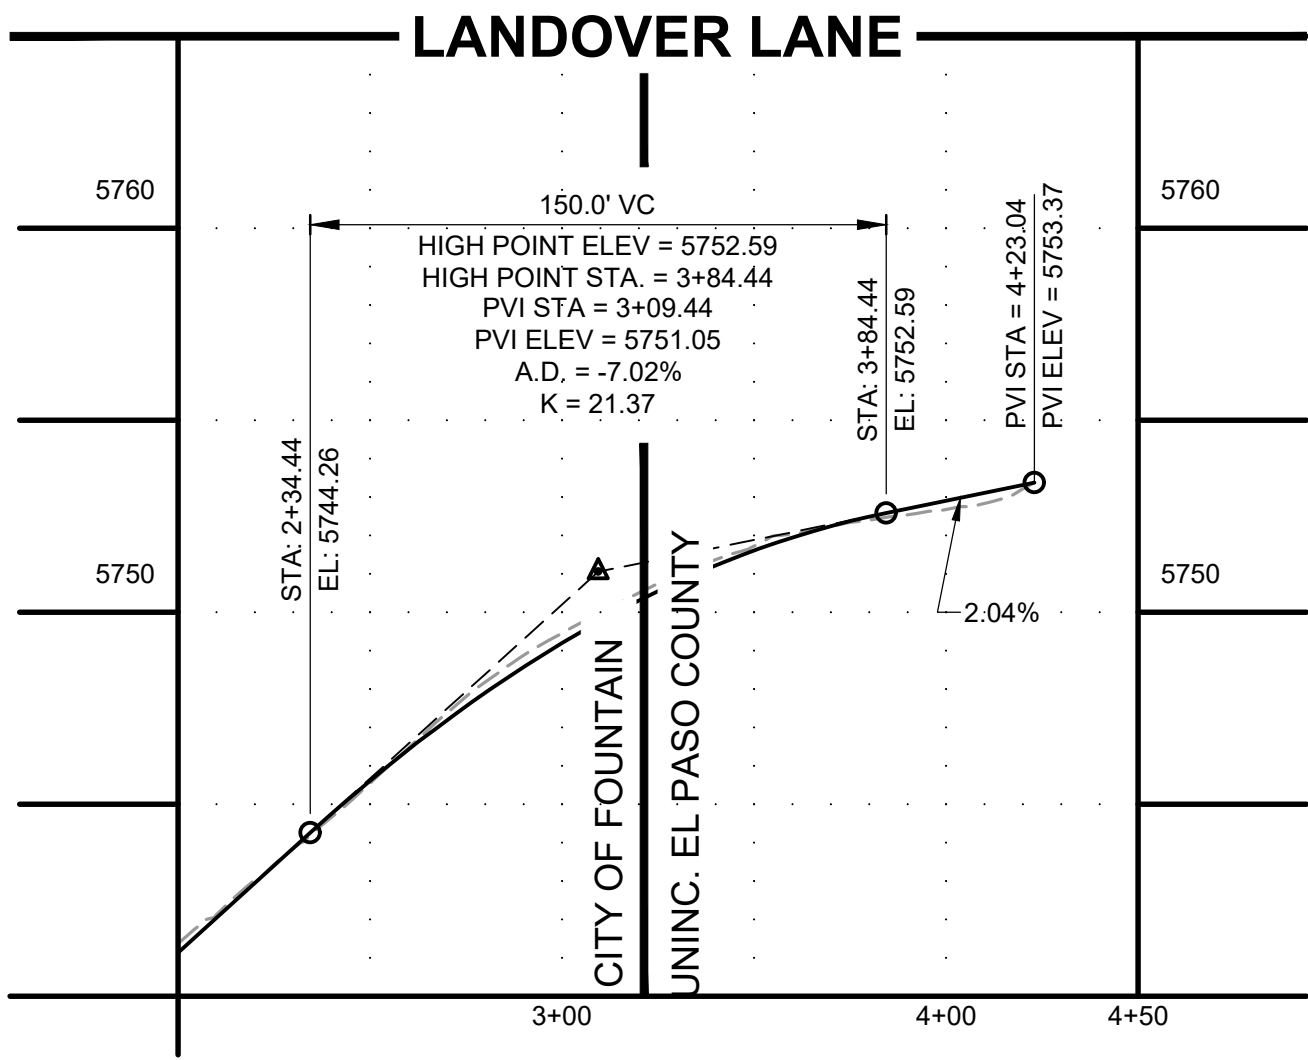


POINT TABLE					
No.	DESC.	ALIGNMENT	STATION	OFFSET	FL E.
1	MATCH EX/BEGIN T2 C&G	LANDOVER LN	STA 3+22.73	18.0' L	5750.38
2	MATCH EX/BEGIN T2 C&G	LANDOVER LN	STA 3+20.15	18.0' R	5749.90
3	PCR	LANDOVER LN	STA 3+92.13	18.0' L	5752.24
4	PCR/ BEGIN TYPE B C&G (CATCH)	APISHAPA HEIGHTS	STA 1+41.66	14.0' L	5753.91
5	PCR/ BEGIN TYPE B C&G (CATCH)	APISHAPA HEIGHTS	STA 1+08.73	35.2' R	5753.34
6	PCR	APISHAPA HEIGHTS	STA 1+36.32	12.0' R	5754.12
7	PC/ END CATCH CURB	APISHAPA HEIGHTS	STA 1+65.86	14.0' L	5755.57
8	PT	APISHAPA HEIGHTS	STA 1+68.86	17.0' L	5755.97
9	PC	APISHAPA HEIGHTS	STA 2+60.53	12.0' R	5760.74
10	PI	APISHAPA HEIGHTS	STA 3+06.84	32.0' L	5761.63
11	PC	APISHAPA HEIGHTS	STA 3+06.84	17.0' L	5761.34
12	PT	APISHAPA HEIGHTS	STA 3+09.89	14.0' L	5761.37
13	HC RAMP MP	APISHAPA HEIGHTS	STA 3+15.07	14.0' L	5761.50
14	PC	APISHAPA HEIGHTS	STA 3+21.08	14.0' L	5761.59
15	PT	APISHAPA HEIGHTS	STA 3+24.12	17.0' L	5761.68
19	PI	APISHAPA HEIGHTS	STA 1+68.86	32.0' L	5756.25
20	PI	APISHAPA HEIGHTS	STA 3+24.12	32.0' L	5762.02
21	PT	APISHAPA HEIGHTS	STA 2+64.06	15.1' R	5761.37
22	END TYPE B C&G	APISHAPA HEIGHTS	STA 2+63.88	20.2' R	5762.00
23	BEGIN TYPE B C&G	APISHAPA HEIGHTS	STA 3+09.65	20.2' R	5762.00
24	PC	APISHAPA HEIGHTS	STA 3+09.74	14.9' R	5761.90
25	PT	APISHAPA HEIGHTS	STA 3+12.71	12.0' R	5761.90
26	HC RAMP MP	APISHAPA HEIGHTS	STA 3+15.06	12.0' R	5762.01
27	PC	APISHAPA HEIGHTS	STA 3+17.41	12.0' R	5762.10
28	PT	APISHAPA HEIGHTS	STA 3+20.38	14.9' R	5762.50
29	END TYPE B C&G	APISHAPA HEIGHTS	STA 3+20.48	20.3' R	5763.10
30	BEGIN TYPE B C&G	APISHAPA HEIGHTS	STA 3+60.90	20.1' R	5763.10
31	PC	APISHAPA HEIGHTS	STA 3+60.90	15.0' R	5762.95
32	PT	APISHAPA HEIGHTS	STA 3+63.86	12.0' R	5762.94
33	PC	APISHAPA HEIGHTS	STA 3+72.97	12.0' R	5763.21
34	PT	APISHAPA HEIGHTS	STA 3+75.93	14.9' R	5763.60
35	END TYPE B C&G	APISHAPA HEIGHTS	STA 3+76.03	20.2' R	5764.20
59	HC RAMP MP	APISHAPA HEIGHTS	STA 1+23.99	20.3' L	5753.04
60	HC RAMP MP	APISHAPA HEIGHTS	STA 1+20.75	16.7' R	5753.21
61	PC	SEGUNDO GROVE	STA 2+01.40	12.0' R	5754.65
62	PC/ END CATCH CURB	SEGUNDO GROVE	STA 2+04.49	14.0' L	5754.16

POINT TABLE					
No.	DESC.	ALIGNMENT	STATION	OFFSET	FL E.
63	PT	SEGUNDO GROVE	STA 2+08.11	17.1' L	5754.29
64	PT	SEGUNDO GROVE	STA 2+04.01	15.0' R	5754.77
65	PI	SEGUNDO GROVE	STA 2+04.01	29.0' R	5755.03
66	PI	SEGUNDO GROVE	STA 2+44.56	29.0' R	5755.49
67	PC	SEGUNDO GROVE	STA 2+44.56	15.0' R	5755.23
68	PI	SEGUNDO GROVE	STA 2+08.11	32.0' L	5754.58
69	PT	SEGUNDO GROVE	STA 2+47.17	12.0' R	5755.10
70	PC	SEGUNDO GROVE	STA 3+03.57	12.0' R	5755.67
71	PT	SEGUNDO GROVE	STA 3+08.51	17.0' R	5755.81
72	PI	SEGUNDO GROVE	STA 3+58.87	32.0' L	5756.05
73	PI	SEGUNDO GROVE	STA 3+08.51	30.0' R	5756.05
74	PI	SEGUNDO GROVE	STA 3+62.04	30.0' R	5756.71
75	PC	SEGUNDO GROVE	STA 3+62.04	15.0' R	5756.28
76	PT	SEGUNDO GROVE	STA 3+65.01	12.0' R	5756.28
77	PC	SEGUNDO GROVE	STA 3+58.87	17.0' L	5755.75
78	PT	SEGUNDO GROVE	STA 3+61.91	14.0' L	5755.73
79	PC	SEGUNDO GROVE	STA 3+73.97	14.0' L	5755.85
80	PC	SEGUNDO GROVE	STA 3+73.06	12.0' R	5756.36
81	PT	SEGUNDO GROVE	STA 3+76.02	15.0' R	5756.43
82	PT	SEGUNDO GROVE	STA 3+77.00	17.0' L	5755.93
83	PI	SEGUNDO GROVE	STA 3+77.00	32.0' L	5756.25
84	PI	SEGUNDO GROVE	STA 3+75.97	30.0' R	5756.75
85	PI	SEGUNDO GROVE	STA 4+19.28	30.0' R	5757.17
86	PC	SEGUNDO GROVE	STA 4+19.28	15.0' R	5757.12
87	PT	SEGUNDO GROVE	STA 4+22.25	12.0' R	5756.86
88	PC	SEGUNDO GROVE	STA 4+41.55	12.0' R	5757.05
89	HC RAMP MP	SEGUNDO GROVE	STA 2+28.22	32.0' L	5754.75
90	HC RAMP MP	SEGUNDO GROVE	STA 1+52.86	14.0' L	5753.57
92	HC RAMP MP	SEGUNDO GROVE	STA 3+69.03	12.0' R	5756.32
93	HC RAMP MP	SEGUNDO GROVE	STA 3+69.10	14.0' L	5755.83
187	BEGIN TYPE B C&G	SEGUNDO GROVE	STA 1+47.35	12.0' R	5753.88
188	END T2 C&G (CATCH)/ BEGIN FL TRANS + FULL CROWN	SEGUNDO GROVE	STA 1+19.13	13.0' R	5753.18
189	BEGIN SUPERELEVATED SECTION	SEGUNDO GROVE	STA 1+75.00	12.0' R	5754.40
190	BEGIN TYPE B C&G (END CATCH CURB)	SEGUNDO GROVE	STA 1+34.26	12.0' R	5753.54

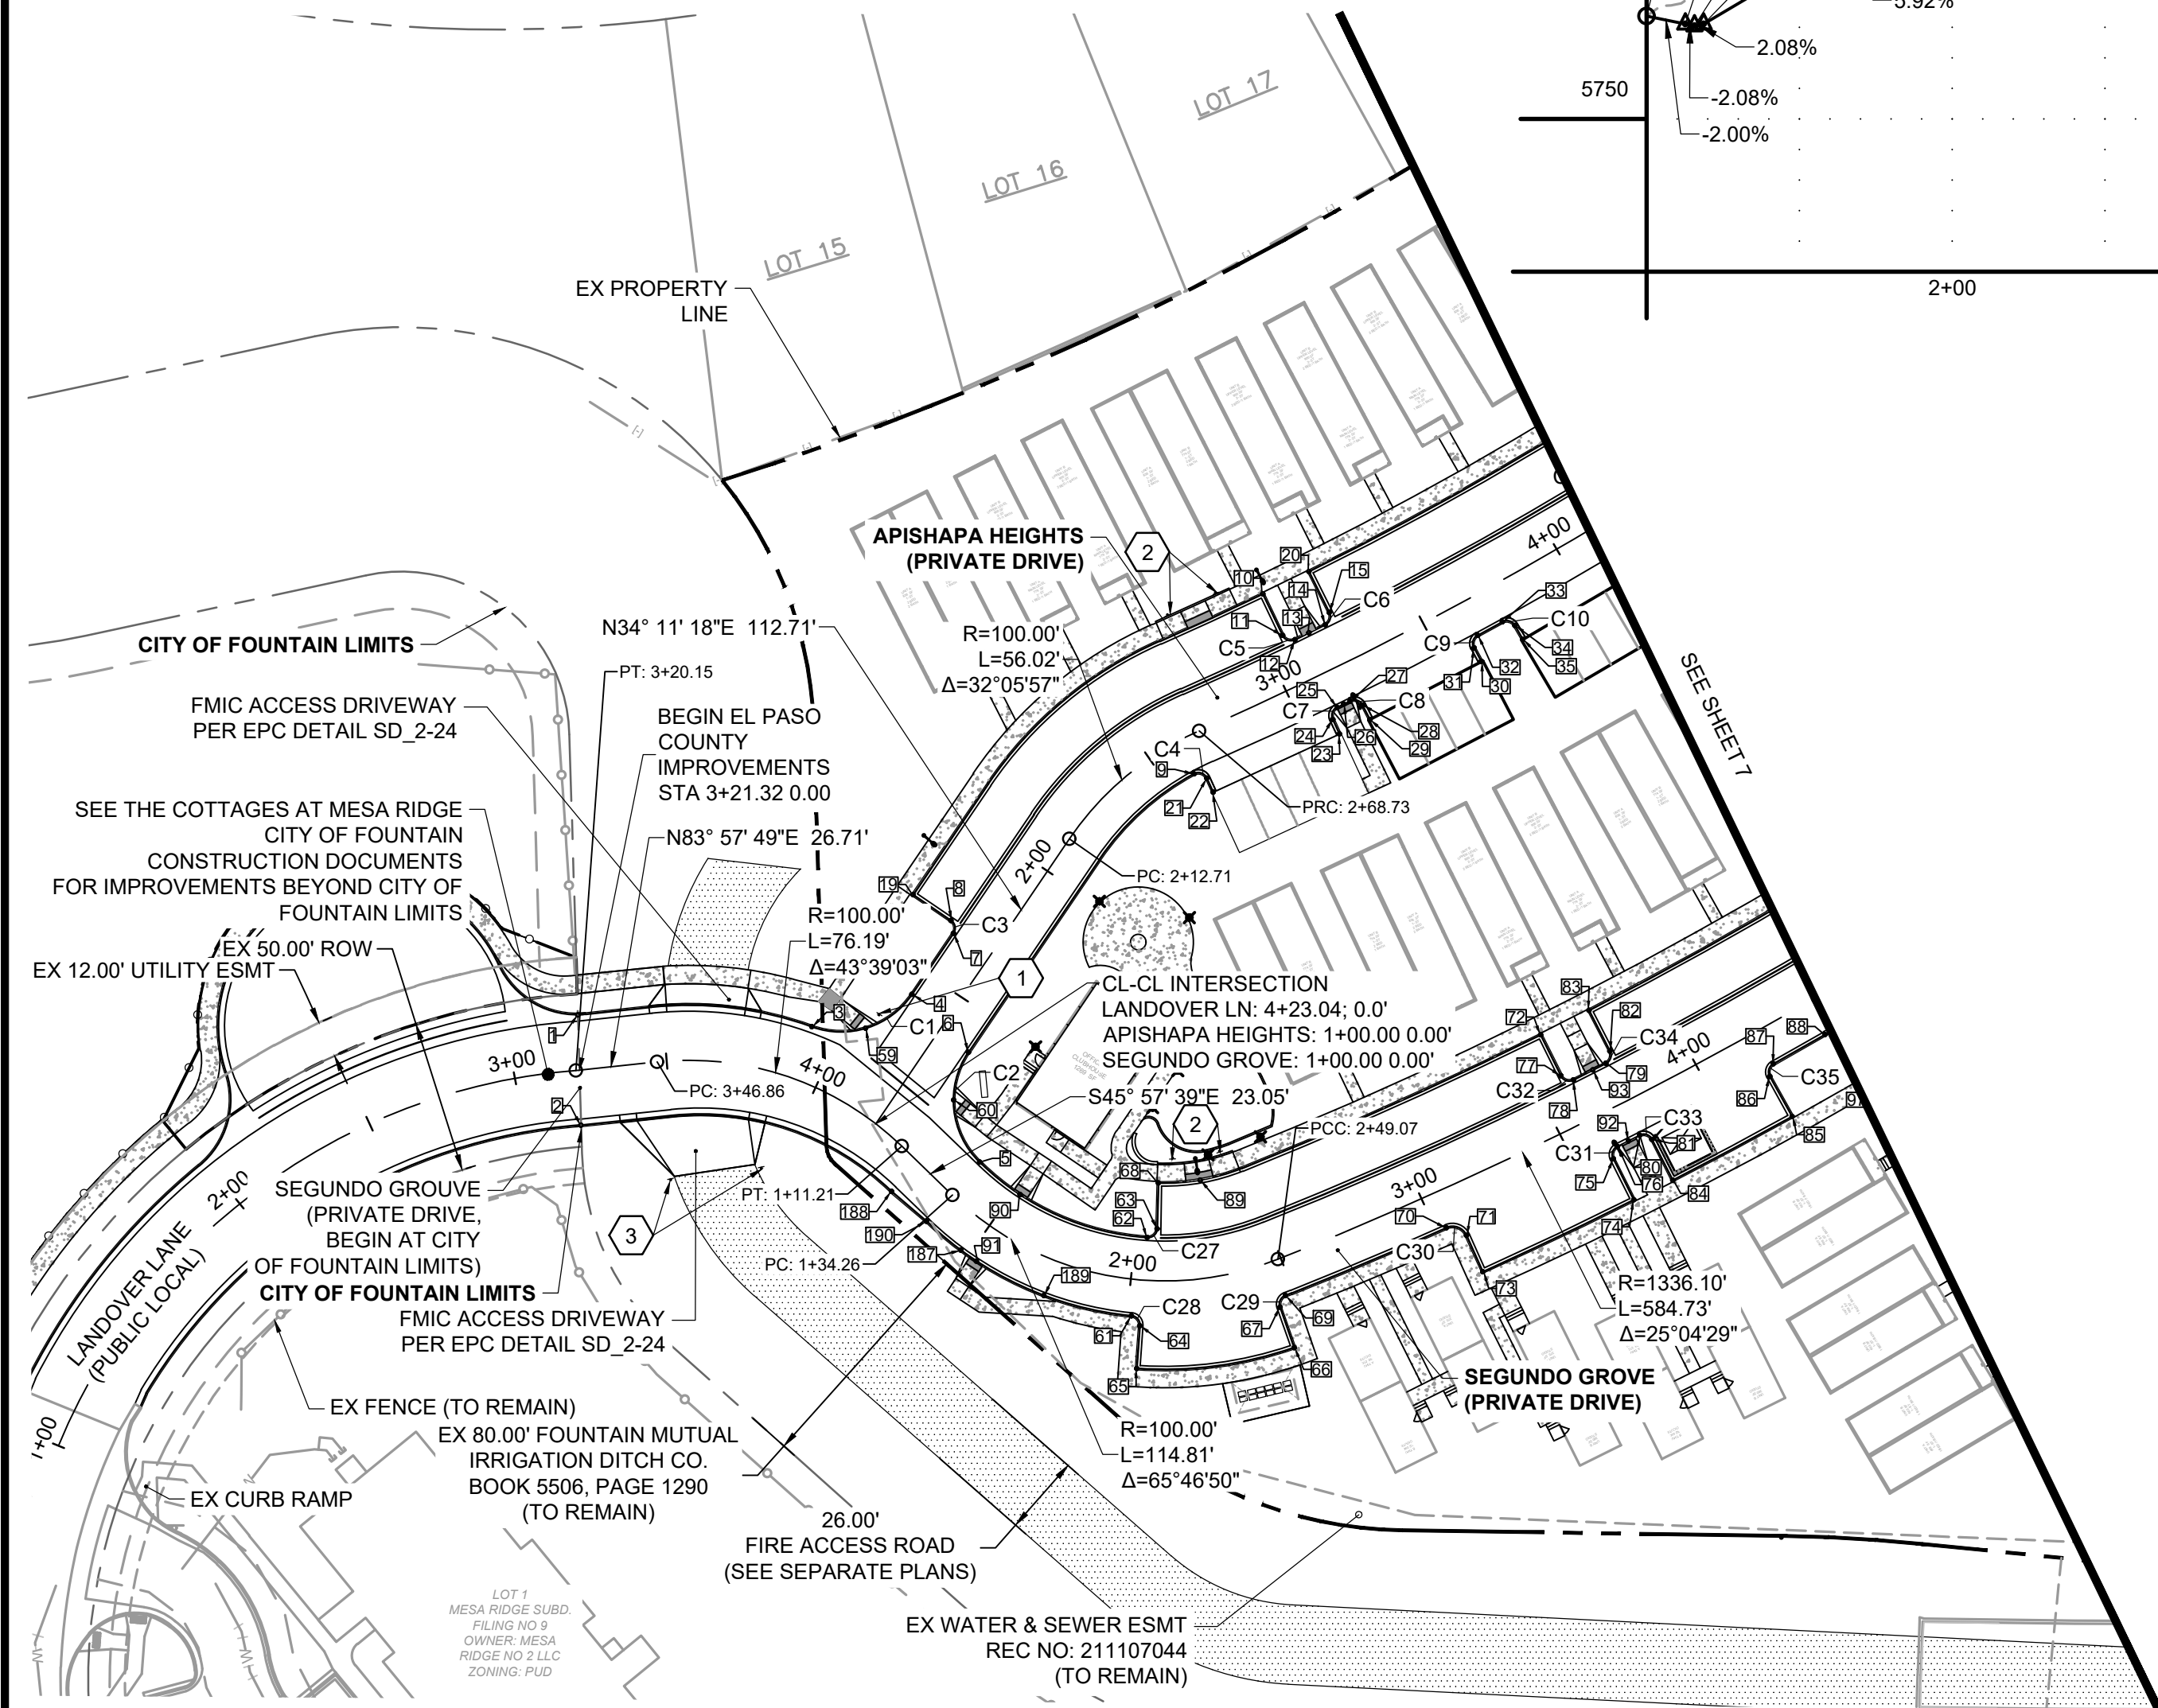


NOTES:  
1. ALL TYPE B C&G IS IN SPILL CONDITION UNLESS OTHERWISE NOTED

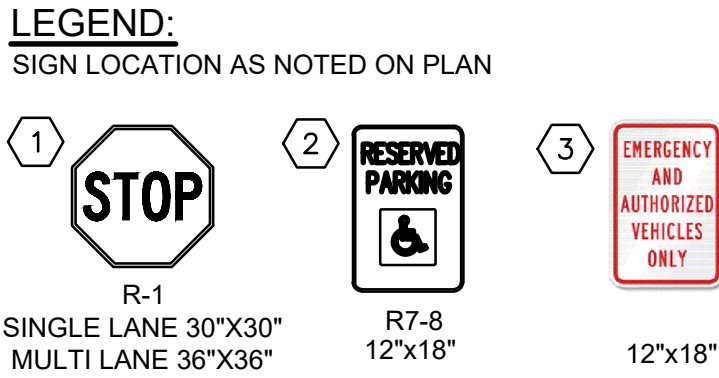

Curve Table				
Curve #	Length	Radius	Delta	Centerline/Flowline
C1	37.00	28.00	75°42'56"	Flowline
C2	39.17	28.00	80°08'56"	Flowline
C3	4.71	3.00	90°00'00"	Flowline
C4	4.91	3.00	93°40'48"	Flowline
C5	4.72	3.00	90°08'58"	Flowline
C6	4.72	3.00	90°08'58"	Flowline
C7	4.65	3.00	88°51'25"	Flowline
C8	4.65	3.00	88°45'05"	Flowline
C9	4.71	3.00	89°52'44"	Flowline
C10	4.65	3.00	88°45'05"	Flowline
C27	4.82	3.00	92°04'17"	Flowline
C28	4.63	3.00	88°30'19"	Flowline
C29	4.63	3.00	88°30'19"	Flowline
C30	7.84	5.00	89°47'18"	Flowline
C31	4.71	3.00	89°52'22"	Flowline
C32	4.72	3.00	90°07'49"	Flowline
C33	4.72	3.00	90°03'49"	Flowline
C34	4.72	3.00	90°07'49"	Flowline

NO.	DATE	BY	REVISION DESCRIPTION




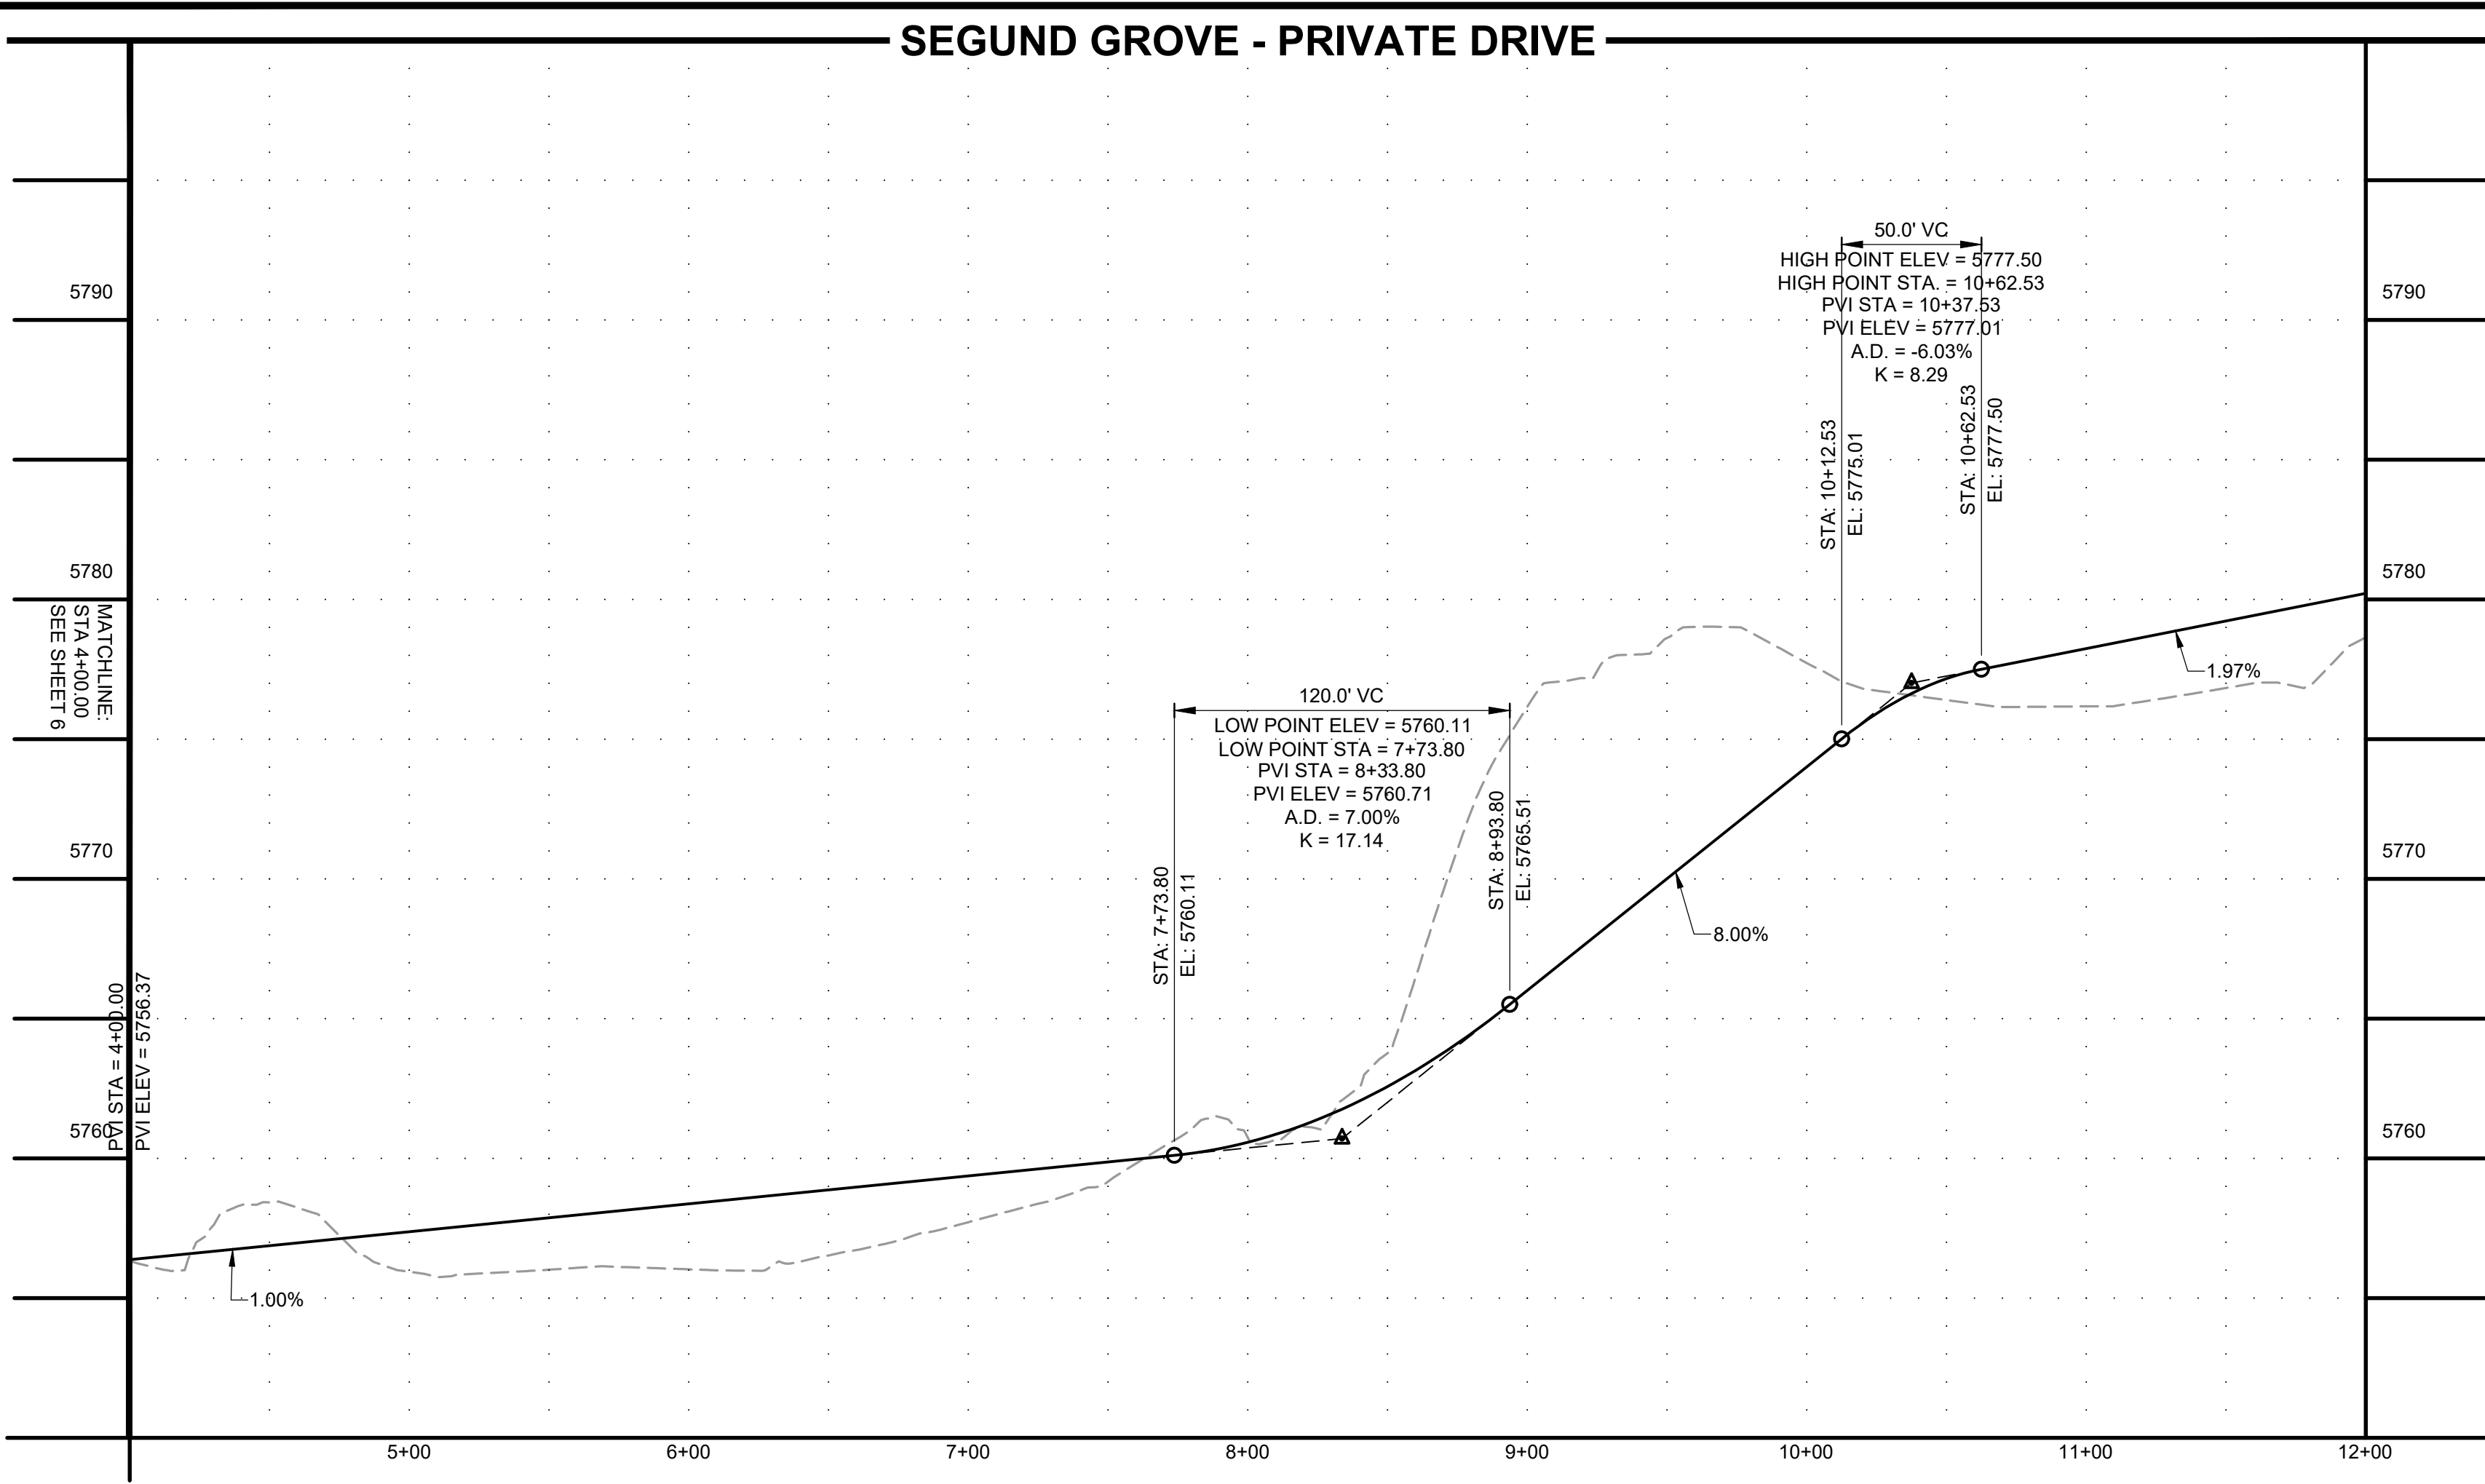


POINT TABLE					
No.	DESC.	ALIGNMENT	STATION	OFFSET	FL EL.
88	PC	SEGUNDO GROVE	STA 4+41.55	12.0' R	5757.05
94	PCC	SEGUNDO GROVE	STA 4+68.15	33.9' R	5757.93
95	HC RAMP MP	SEGUNDO GROVE	STA 4+67.77	32.3' R	5757.90
96	PT	SEGUNDO GROVE	STA 4+65.26	37.6' R	5758.10
97	PI	SEGUNDO GROVE	STA 4+51.25	37.5' R	5758.37
98	PI	WAHATOYA POINT	STA 2+54.80	31.0' R	5759.52
99	PI	WAHATOYA POINT	STA 2+54.80	13.0' R	5759.15
100	PI	WAHATOYA POINT	STA 2+64.80	13.0' R	5759.35
101	END TYPE B C&G	WAHATOYA POINT	STA 2+64.80	7.8' R	5759.42
102	BEGIN TYPE B C&G	WAHATOYA POINT	STA 2+64.80	7.8' L	5759.42
103	PI	WAHATOYA POINT	STA 2+64.80	13.0' L	5759.35
104	PI	WAHATOYA POINT	STA 2+54.80	13.0' L	5759.15
105	PI	WAHATOYA POINT	STA 2+54.80	31.0' L	5759.51
106	PI	SEGUNDO GROVE	STA 5+11.52	38.7' R	5758.36
107	PC	SEGUNDO GROVE	STA 4+97.23	38.2' R	5758.10
108	PCC	SEGUNDO GROVE	STA 4+94.45	34.7' R	5757.96
109	END TYPE B C&G	SEGUNDO GROVE	STA 5+19.07	12.1' R	5758.32
110	HC RAMP MP	SEGUNDO GROVE	STA 5+15.83	12.5' R	5757.79
111	PI	SEGUNDO GROVE	STA 5+06.10	32.0' L	5757.52
112	PC	SEGUNDO GROVE	STA 5+06.10	17.0' L	5757.22
113	PT	SEGUNDO GROVE	STA 5+09.13	14.0' L	5757.22
114	HC RAMP MP	SEGUNDO GROVE	STA 5+17.06	14.0' L	5757.29
115	PC	SEGUNDO GROVE	STA 5+21.08	14.0' L	5757.33
116	PT	SEGUNDO GROVE	STA 5+24.12	17.0' L	5757.40
117	PI	SEGUNDO GROVE	STA 5+24.12	32.0' L	5757.72
118	PI	SEGUNDO GROVE	STA 6+62.37	32.0' L	5759.09
119	PC	SEGUNDO GROVE	STA 6+62.37	17.0' L	5758.78
120	PT	SEGUNDO GROVE	STA 6+65.41	14.0' L	5758.77
121	PC	SEGUNDO GROVE	STA 6+68.55	14.0' L	5758.80
122	PT	SEGUNDO GROVE	STA 6+71.59	17.0' L	5758.87
123	PI	SEGUNDO GROVE	STA 6+71.59	32.0' L	5759.20
124	BEGIN TYPE B C&G	SEGUNDO GROVE	STA 5+84.69	17.2' R	5758.57



POINT TABLE					
No.	DESC.	ALIGNMENT	STATION	OFFSET	FL EL.
125	PC	SEGUNDO GROVE	STA 5+84.73	14.9' R	5758.52
126	PT	SEGUNDO GROVE	STA 5+87.70	12.0' R	5758.49
127	PC	SEGUNDO GROVE	STA 5+98.26	12.0' R	5758.59
128	PT	SEGUNDO GROVE	STA 6+01.23	15.0' R	5758.68
129	PI	SEGUNDO GROVE	STA 6+01.23	30.0' R	5758.99
130	PI	SEGUNDO GROVE	STA 6+45.82	30.0' R	5759.53
131	PC	SEGUNDO GROVE	STA 6+45.82	15.0' R	5759.25
132	PT	SEGUNDO GROVE	STA 6+48.79	12.0' R	5759.12
133	PCR	SEGUNDO GROVE	STA 6+51.00	12.0' R	5759.14
134	END TYPE B C&G	SEGUNDO GROVE	STA 6+78.19	39.6' R	5758.87
135	BEGIN TYPE B C&G	SEGUNDO GROVE	STA 7+03.45	39.3' R	5759.39
136	PCR	SEGUNDO GROVE	STA 7+30.63	12.0' R	5759.94
137	HC RAMP MP	SEGUNDO GROVE	STA 7+23.96	12.8' R	5759.82
138	HC RAMP MP	SEGUNDO GROVE	STA 6+72.17	22.3' R	5759.38
139	PI	SEGUNDO GROVE	STA 8+09.90	32.0' L	5760.72
140	PC	SEGUNDO GROVE	STA 8+09.90	17.0' L	5760.74
141	PT/ BEGIN CATCH CURB	SEGUNDO GROVE	STA 8+12.94	14.0' L	5760.61
142	HC RAMP MP	SEGUNDO GROVE	STA 8+27.83	14.0' L	5761.16
143	HC RAMP MP	SEGUNDO GROVE	STA 8+27.77	12.0' R	5761.74
144	PCR/ END CATCH CURB	SEGUNDO GROVE	STA 9+97.28	14.0' L	5773.45
145	PCR	SEGUNDO GROVE	STA 10+79.52	14.0' L	5777.52
146	HC RAMP MP	SEGUNDO GROVE	STA 10+71.05	15.3' L	5777.35
147	HC RAMP MP	SEGUNDO GROVE	STA 10+71.05	12.0' R	5777.94
148	PT	SEGUNDO GROVE	STA 10+82.51	17.0' L	5777.64
149	PI	SEGUNDO GROVE	STA 10+82.51	32.0' L	5777.95
150	PI	SEGUNDO GROVE	STA 11+81.51	32.0' L	5779.97
151	END TYPE B C&G (END CATCH CURB)	SEGUNDO GROVE	STA 11+94.86	12.0' R	5781.95
191	BEGIN TYPE E C&G	SEGUNDO GROVE	STA 12+00.53	11.7' R	5782.63
192	END TYPE E C&G	SEGUNDO GROVE	STA 12+00.53	13.0' L	5780.50
193	PT/END TYPE B C&G	SEGUNDO GROVE	STA 11+84.86	14.0' L	5779.80
194	PC	SEGUNDO GROVE	STA 11+81.51	17.0' L	5779.75

Curve Table			
Curve #	Length	Radius	Delta
C36	37.60	28.00	76°56'16"
C37	5.37	3.00	102°38'48"
C38	5.17	3.00	98°45'33"
C39	36.19	28.00	74°03'36"
C40	4.72	3.00	90°07'49"
C41	4.72	3.00	90°07'49"
C42	4.66	3.00	88°54'28"
C43	4.71	3.00	89°52'22"
C44	4.71	3.00	89°52'22"
C45	43.27	28.00	88°32'23"
C46	43.03	28.00	88°02'44"
C47	4.72	3.00	90°07'49"
C48	4.72	3.00	90°07'49"
C49	4.72	3.00	90°07'49"
C50	46.52	28.00	95°11'48"
C51	5.06	3.03	95°45'36"

LEGEND:  
SIGN LOCATION AS NOTED ON PLAN

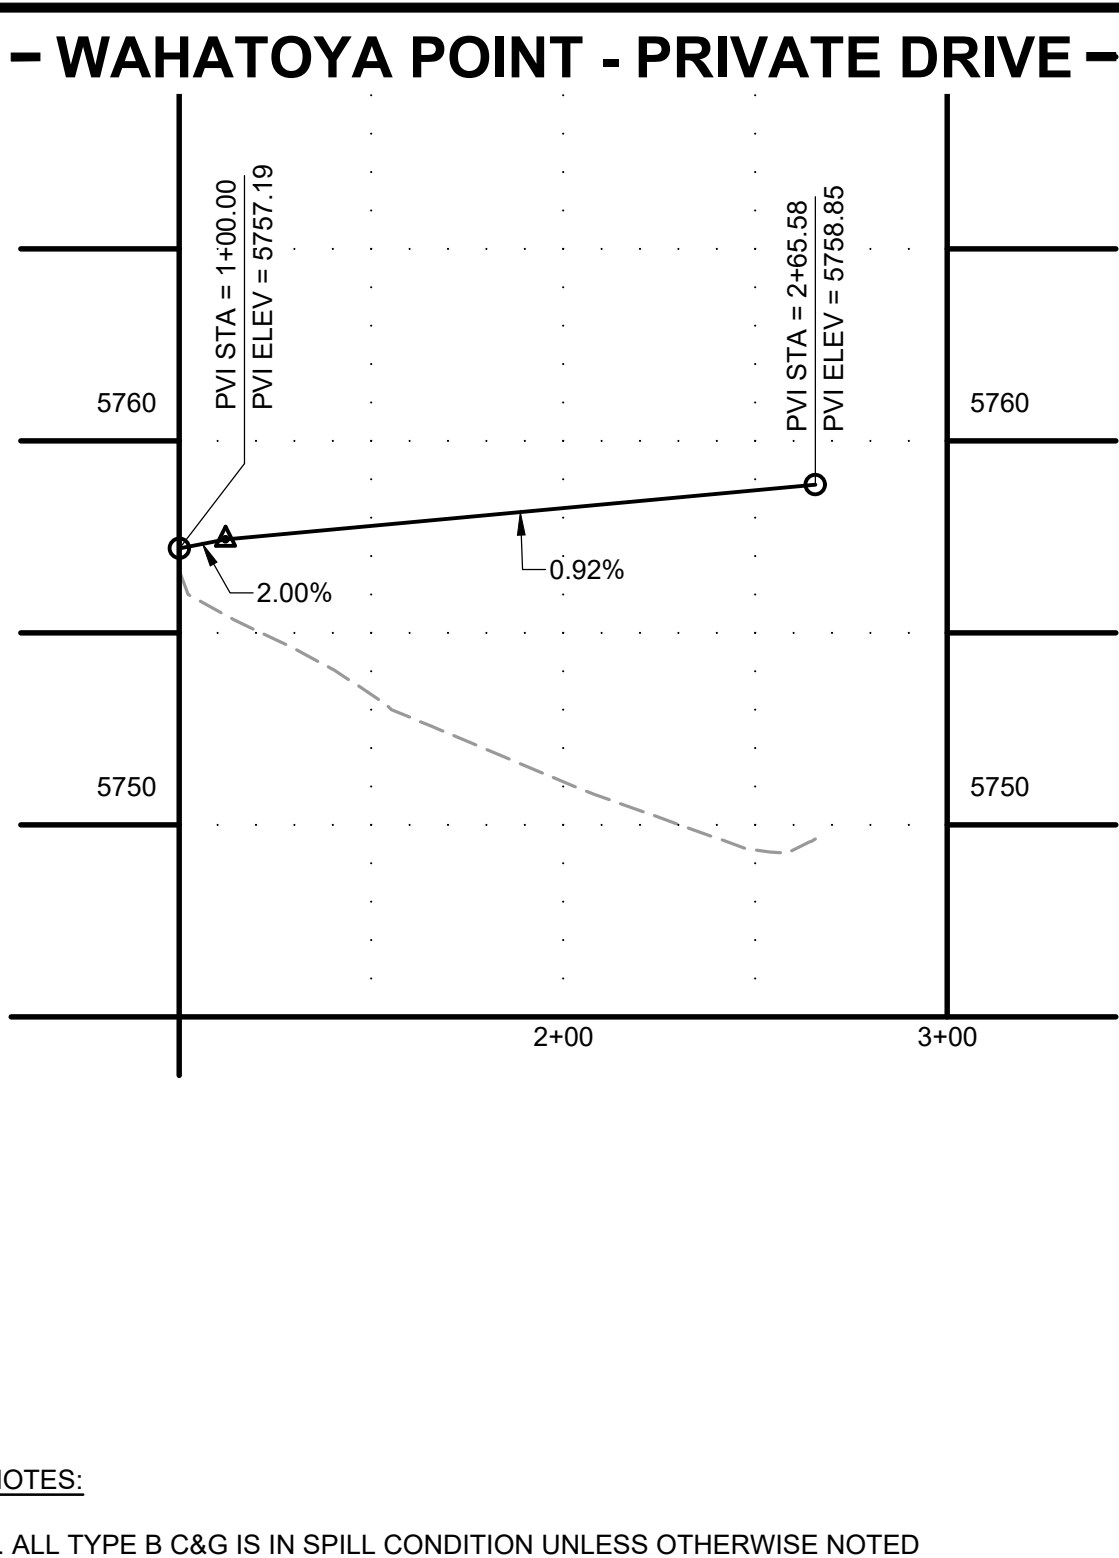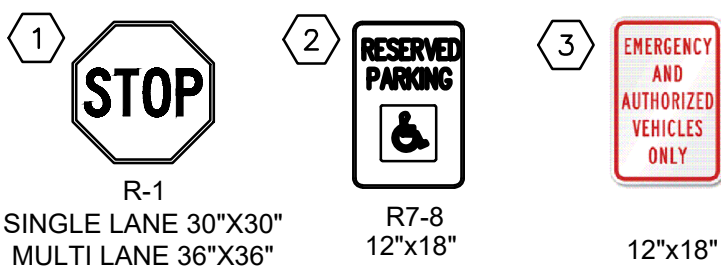

NOTES:  
1. ALL TYPE B C&G IS IN SPILL CONDITION UNLESS OTHERWISE NOTED

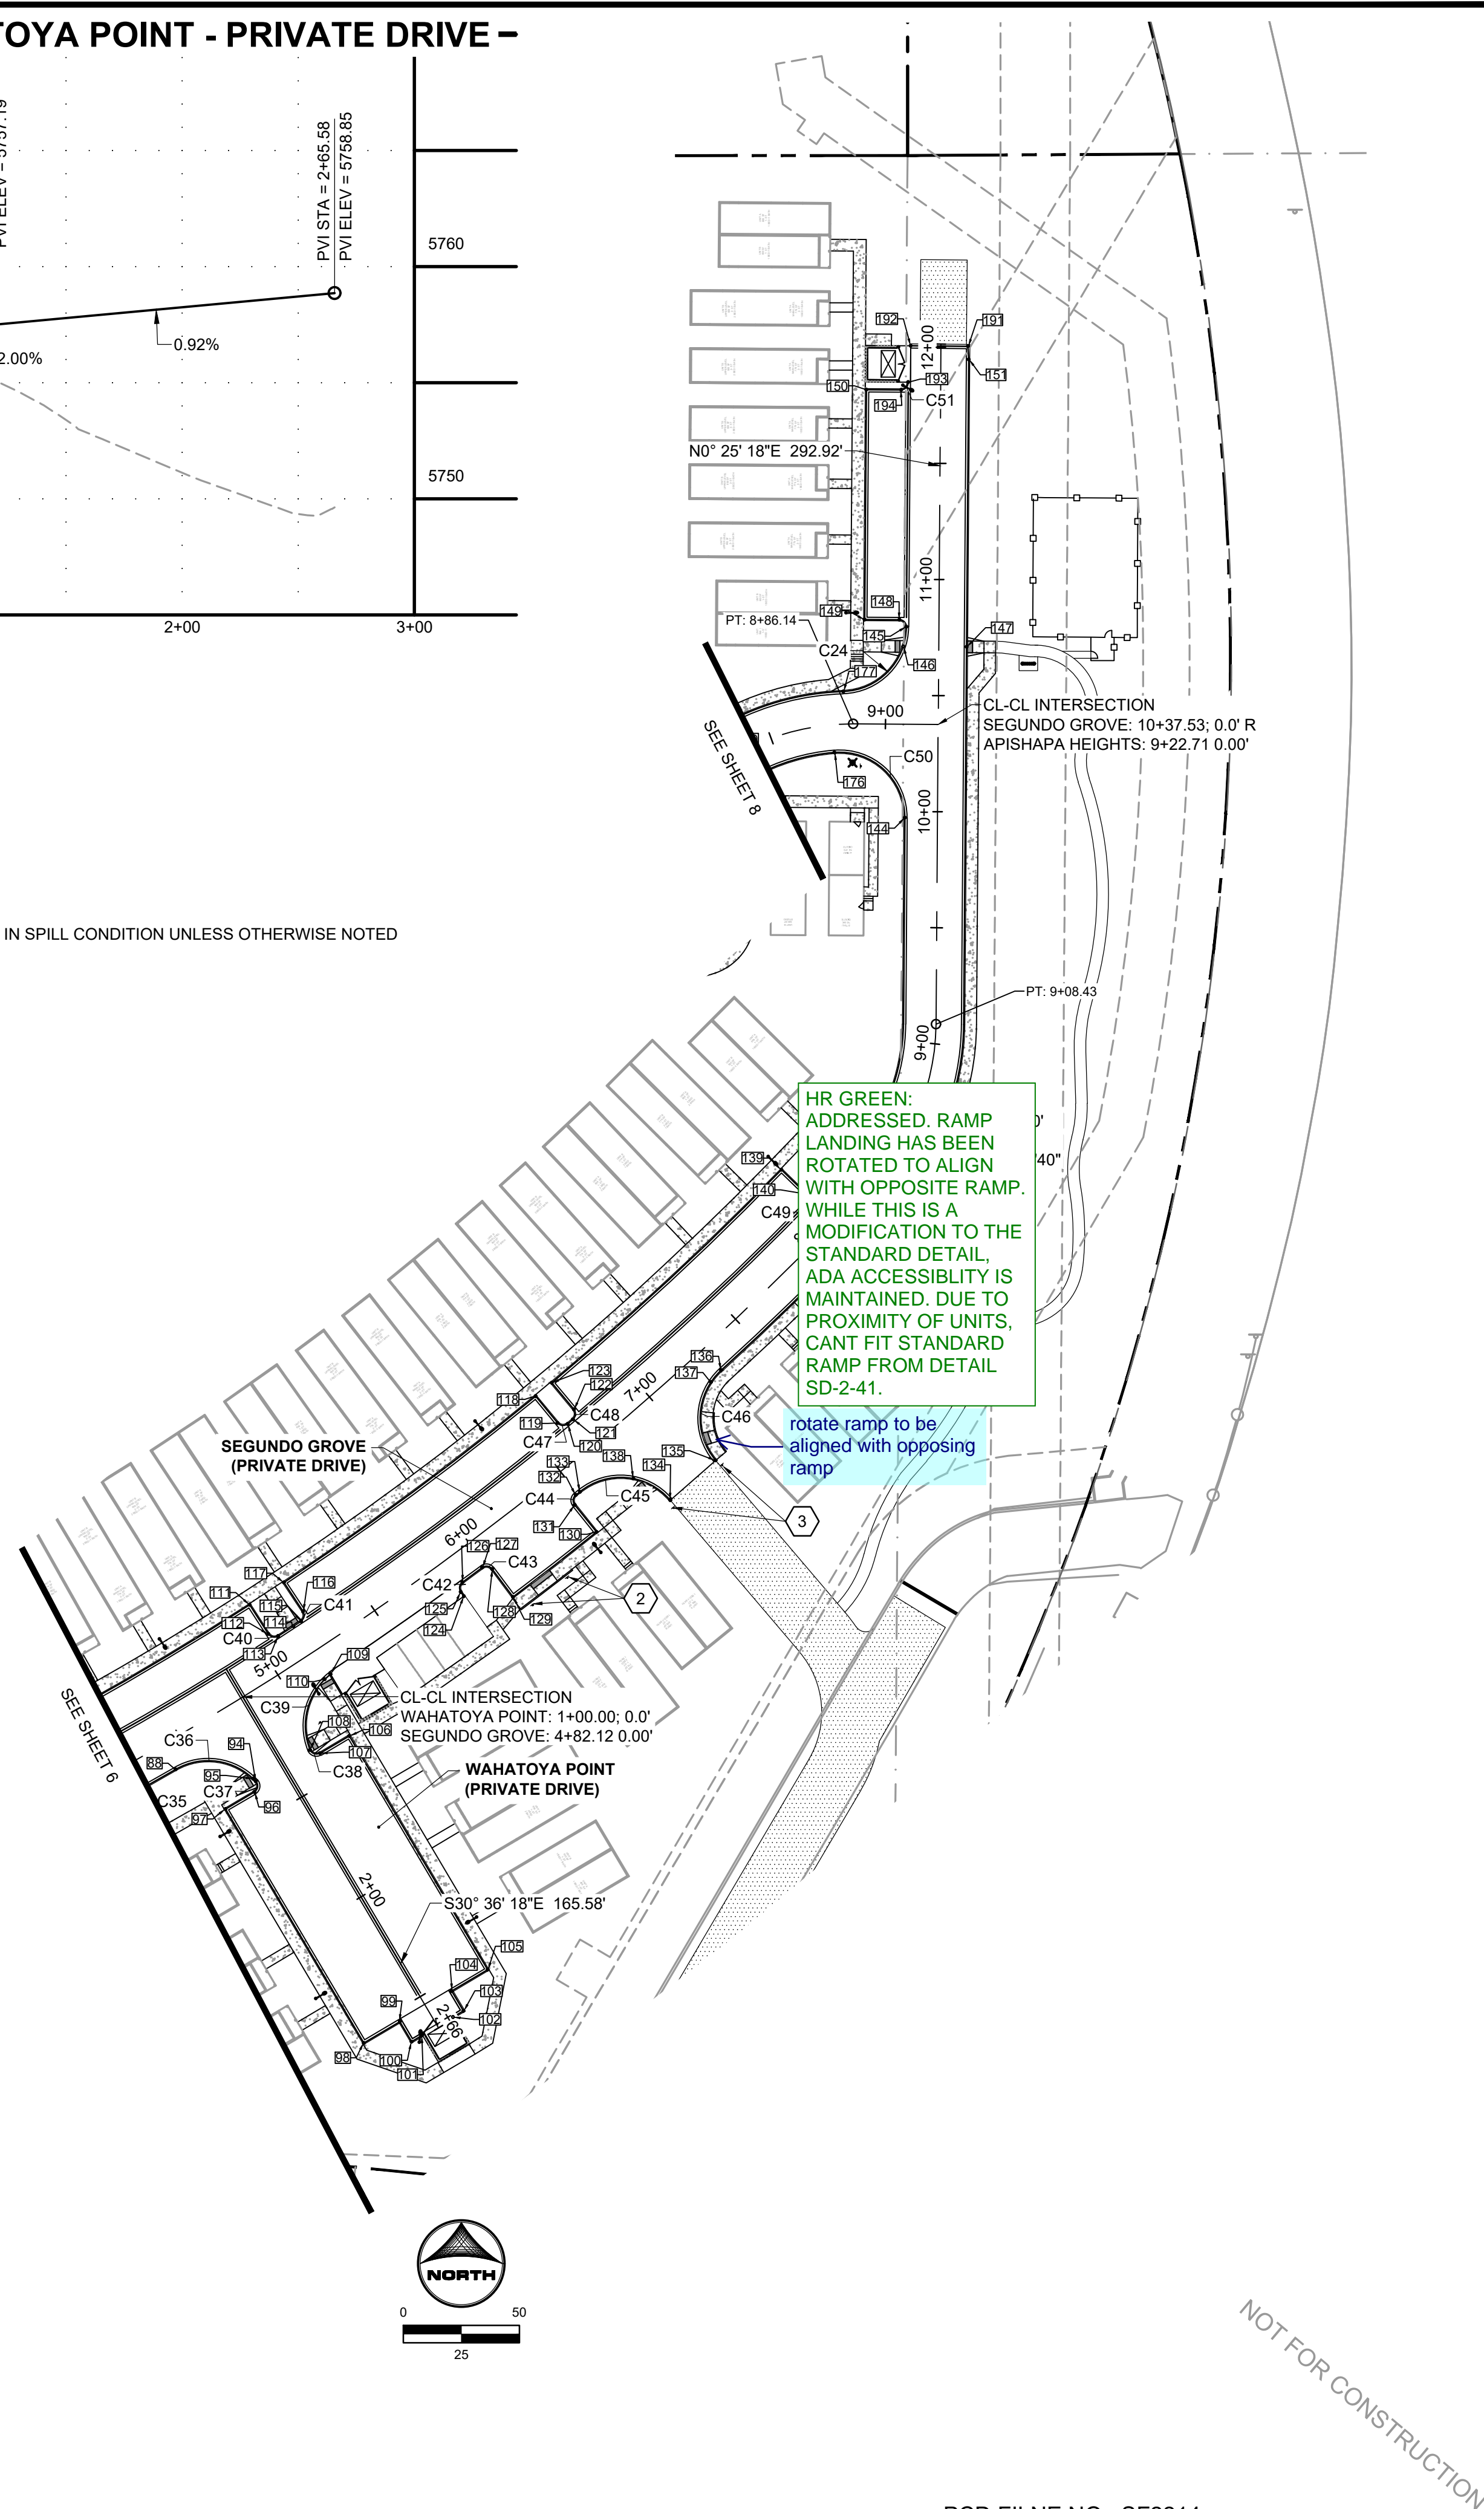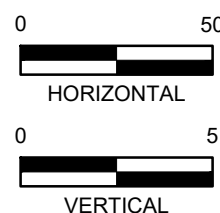

PCD FILNE NO.: SF2214

DRAWN BY: CBM JOB DATE: 9/1/2022  
APPROVED: KMH JOB NUMBER: 200541  
CAD DATE: 9/1/2022  
CAD FILE: J:\2020\200541\CAD\DWG\CD\CDIEI\_Paso\_Co\Roadway

BAR IS ONE INCH ON  
OFFICIAL DRAWINGS.  
IF NOT ONE INCH,  
ADJUST SCALE ACCORDINGLY.

NO.	DATE	BY	REVISION DESCRIPTION

HR GREEN - COLORADO SPRINGS  
7222 COMMERCE CENTER DR SUITE 220  
COLORADO SPRINGS CO 80919  
PHONE: 719.300.4140 TOLL FREE: 800.728.7805  
FAX: 844.273.1057 | HRGreen.com

THE COTTAGES AT MESA RIDGE  
GOODWIN KNIGHT  
EL PASO COUNTY, COLORADO



EL PASO COUNTY CONSTRUCTION DOCUMENTS  
ROADWAY PLAN & PROFILE

SHEET  
RD

7

NOT FOR CONSTRUCTION




POINT TABLE					
No.	DESC.	ALIGNMENT	STATION	OFFSET	FL EL.
51	PT	APISHAPA HEIGHTS	STA 5+72.07	15.0' R	5767.15
52	PI	APISHAPA HEIGHTS	STA 5+72.07	29.0' R	5767.45
53	PI	APISHAPA HEIGHTS	STA 5+84.08	32.0' L	5767.17
54	PC	APISHAPA HEIGHTS	STA 5+84.08	17.0' L	5766.87
55	PT	APISHAPA HEIGHTS	STA 5+87.12	14.0' L	5766.89
56	PC	APISHAPA HEIGHTS	STA 5+90.29	14.0' L	5766.96
57	PT	APISHAPA HEIGHTS	STA 5+93.33	17.0' L	5767.06
58	PI	APISHAPA HEIGHTS	STA 5+93.33	32.0' L	5767.40
152	PI	APISHAPA HEIGHTS	STA 6+61.09	29.0' R	5769.21
153	PC	APISHAPA HEIGHTS	STA 6+61.09	15.0' R	5768.93
154	PT	APISHAPA HEIGHTS	STA 6+64.05	12.0' R	5768.93
155	PC	APISHAPA HEIGHTS	STA 6+73.94	12.0' R	5769.22
156	PT	APISHAPA HEIGHTS	STA 6+76.90	14.9' R	5769.61
157	END TYPE B C&G	APISHAPA HEIGHTS	STA 6+76.99	20.2' R	5770.19
158	PI	APISHAPA HEIGHTS	STA 7+32.41	32.0' L	5770.04
159	PC	APISHAPA HEIGHTS	STA 7+32.41	17.0' L	5769.87
160	PT	APISHAPA HEIGHTS	STA 7+35.49	14.0' L	5769.82
161	HC RAMP MP	APISHAPA HEIGHTS	STA 7+39.69	14.0' L	5769.81


Curve Table			
Curve #	Length	Radius	Delta
C11	4.61	3.00	87°59'29"
C12	4.71	3.00	89°57'01"
C13	4.72	3.00	90°08'58"
C14	4.70	3.00	89°51'16"
C15	4.70	3.00	89°51'16"
C16	4.70	3.00	89°51'16"
C17	4.72	3.00	90°08'58"
C18	4.72	3.00	90°08'58"
C19	4.70	3.00	89°51'16"
C20	4.65	3.00	88°51'27"
C21	4.58	3.00	87°29'50"
C22	4.74	3.00	90°26'34"
C23	4.64	3.00	88°31'51"
C24	43.01	28.00	88°00'41"
C25	4.47	3.00	85°22'45"
C50	46.52	28.00	95°11'48"






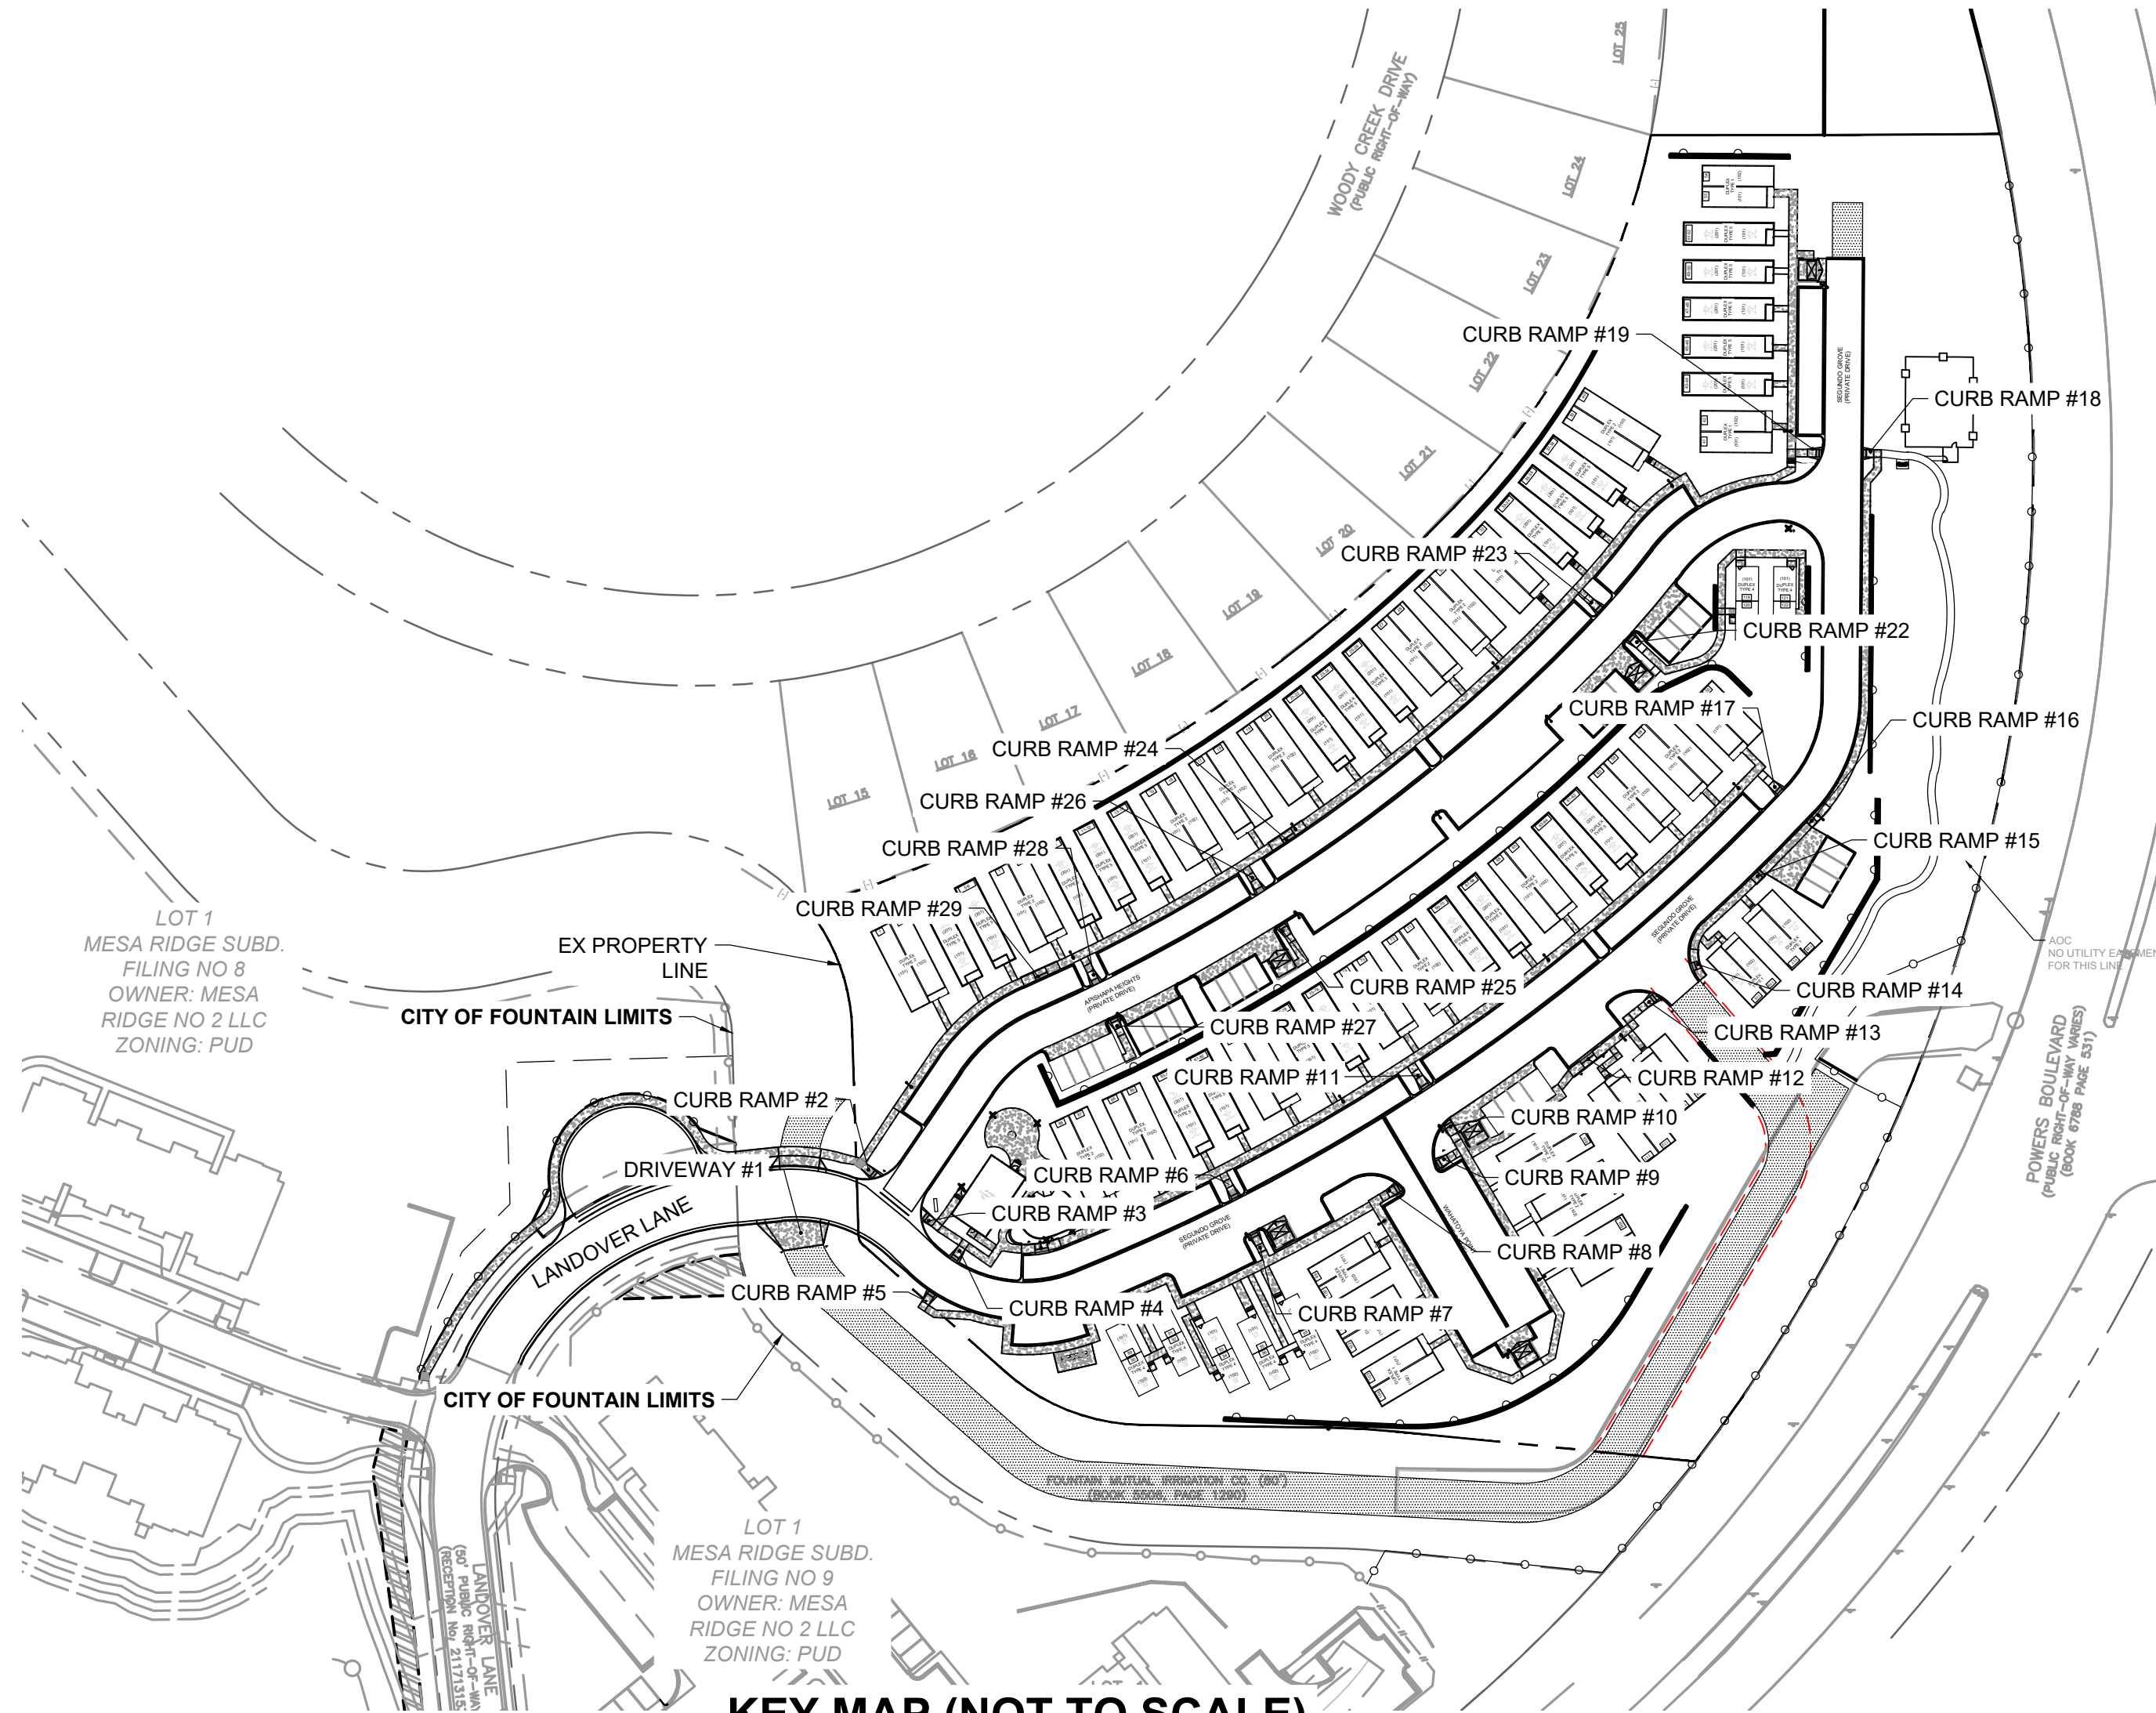


KEY MAP (NOT TO SCALE)

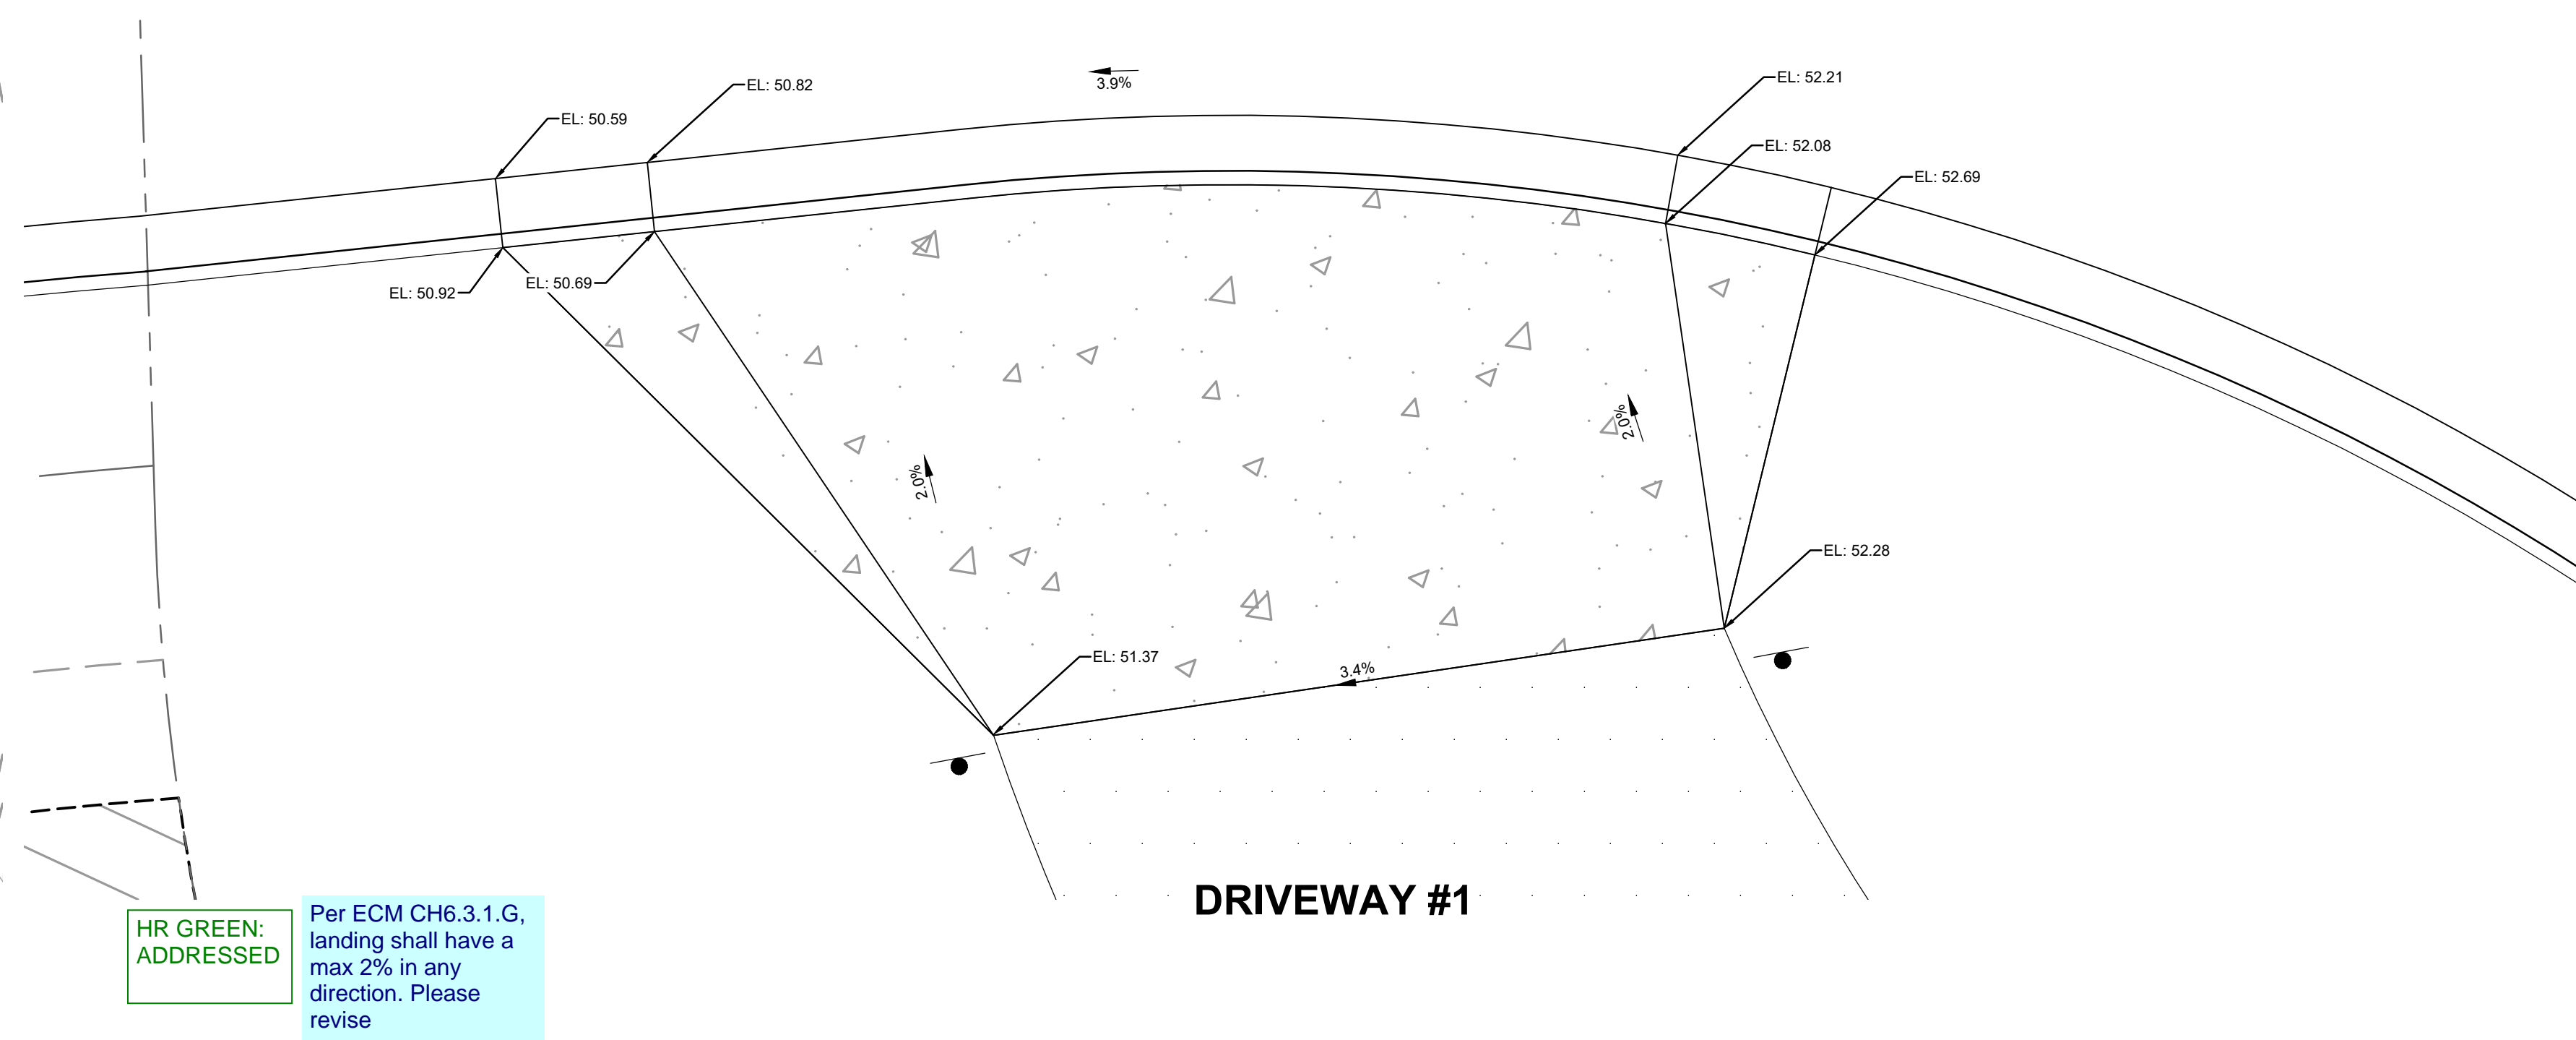


DRIVEWAY #1

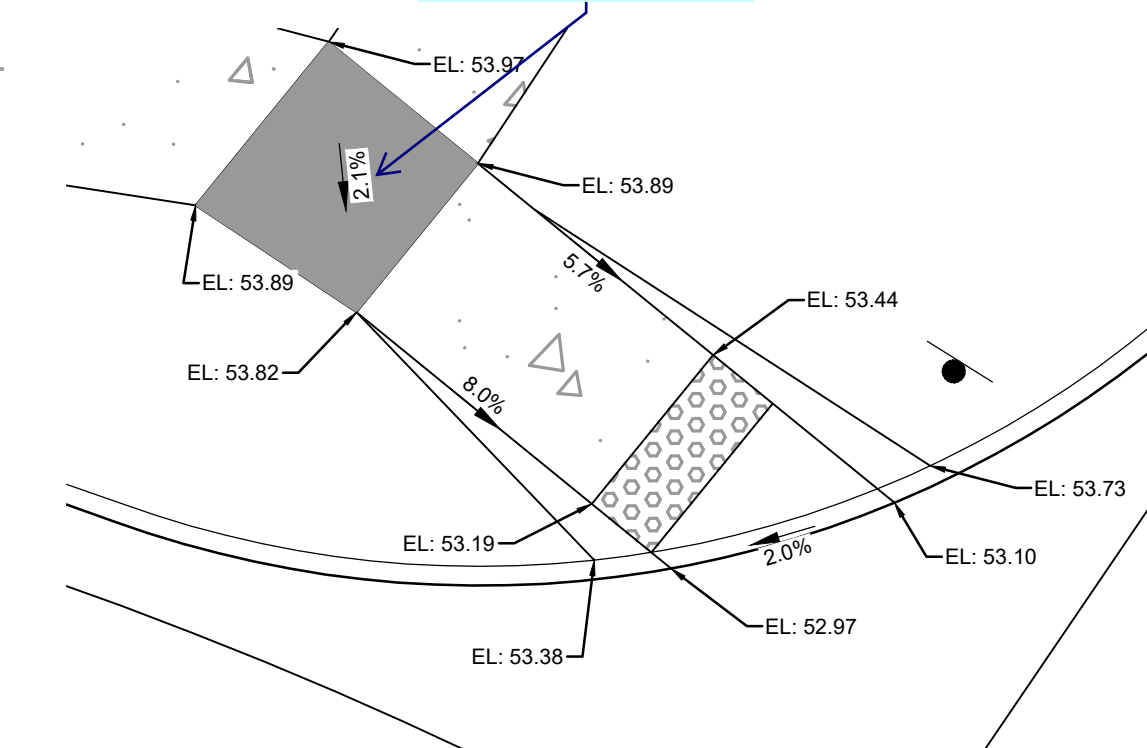


CURB RAMP #2

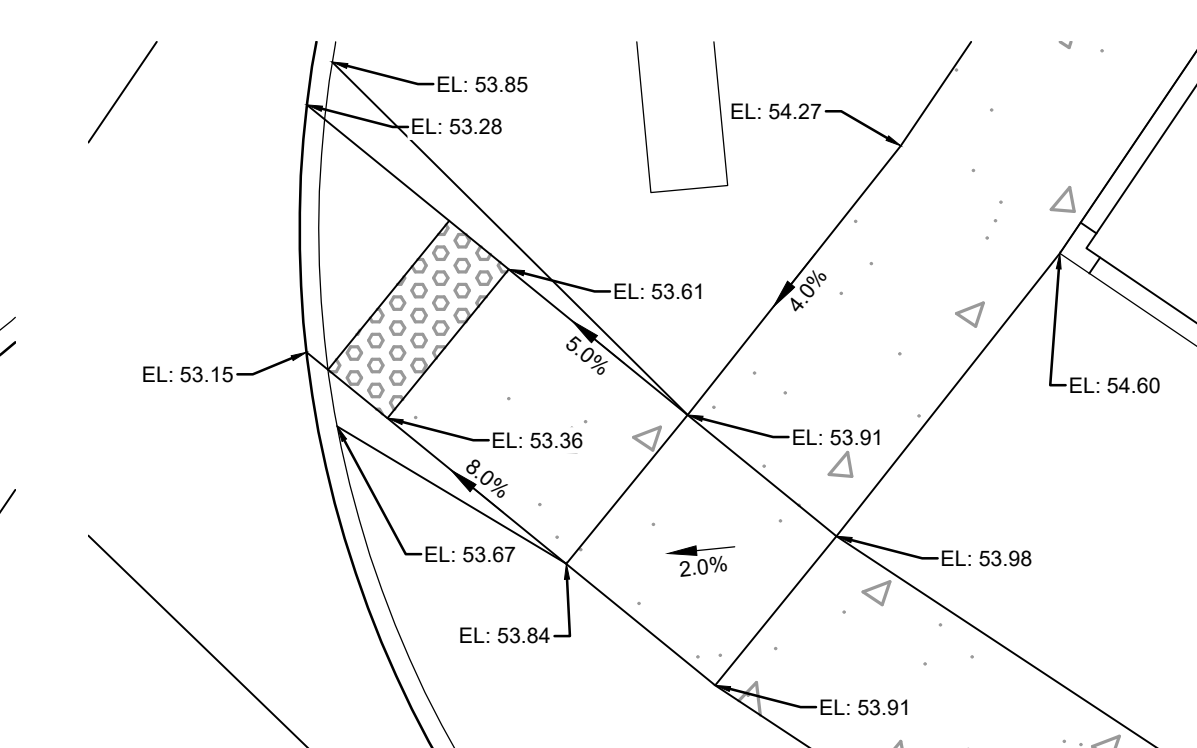


CURB RAMP #3

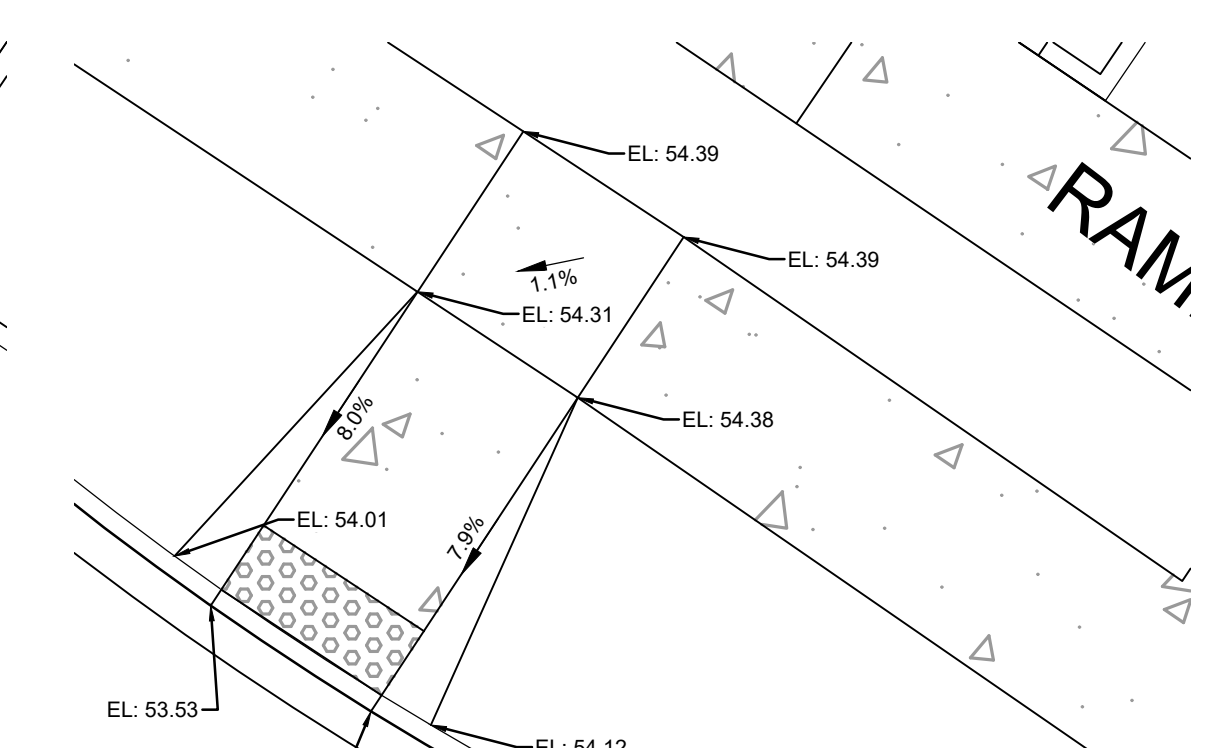


CURB RAMP #4

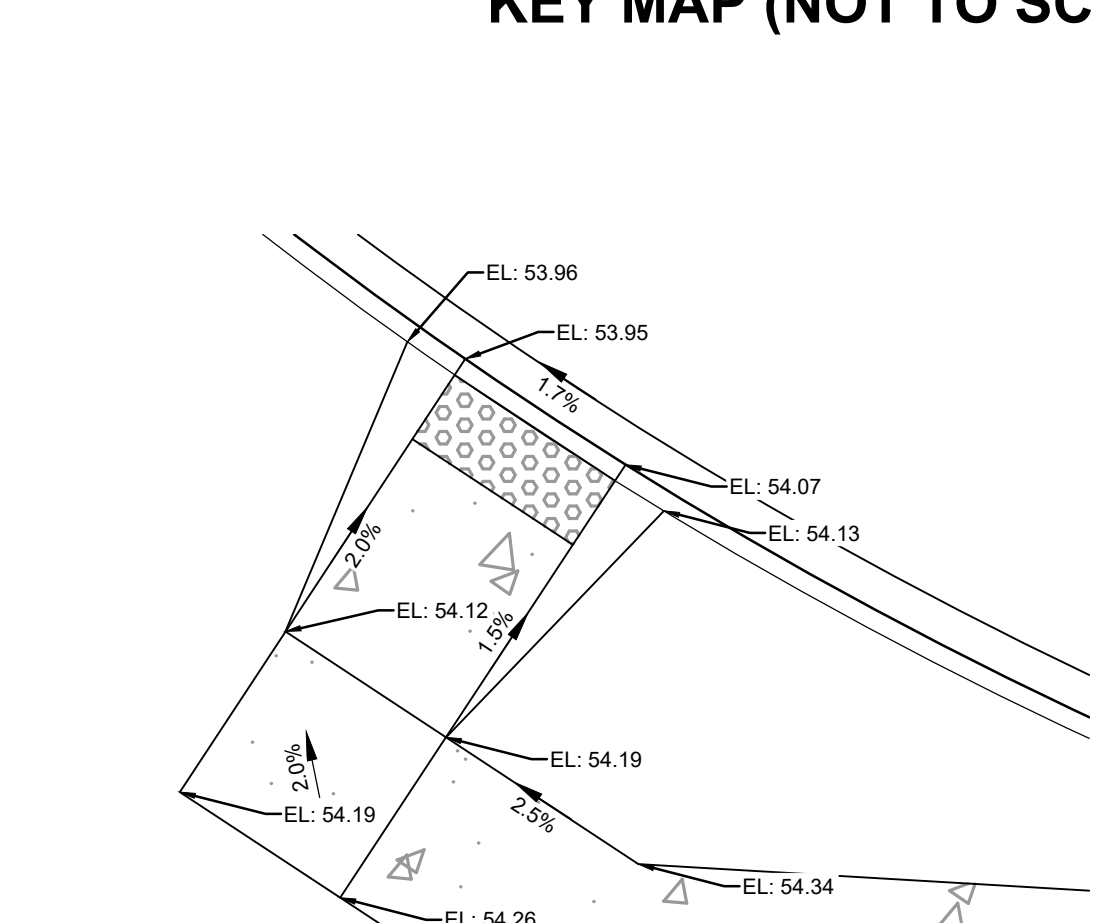


CURB RAMP #5

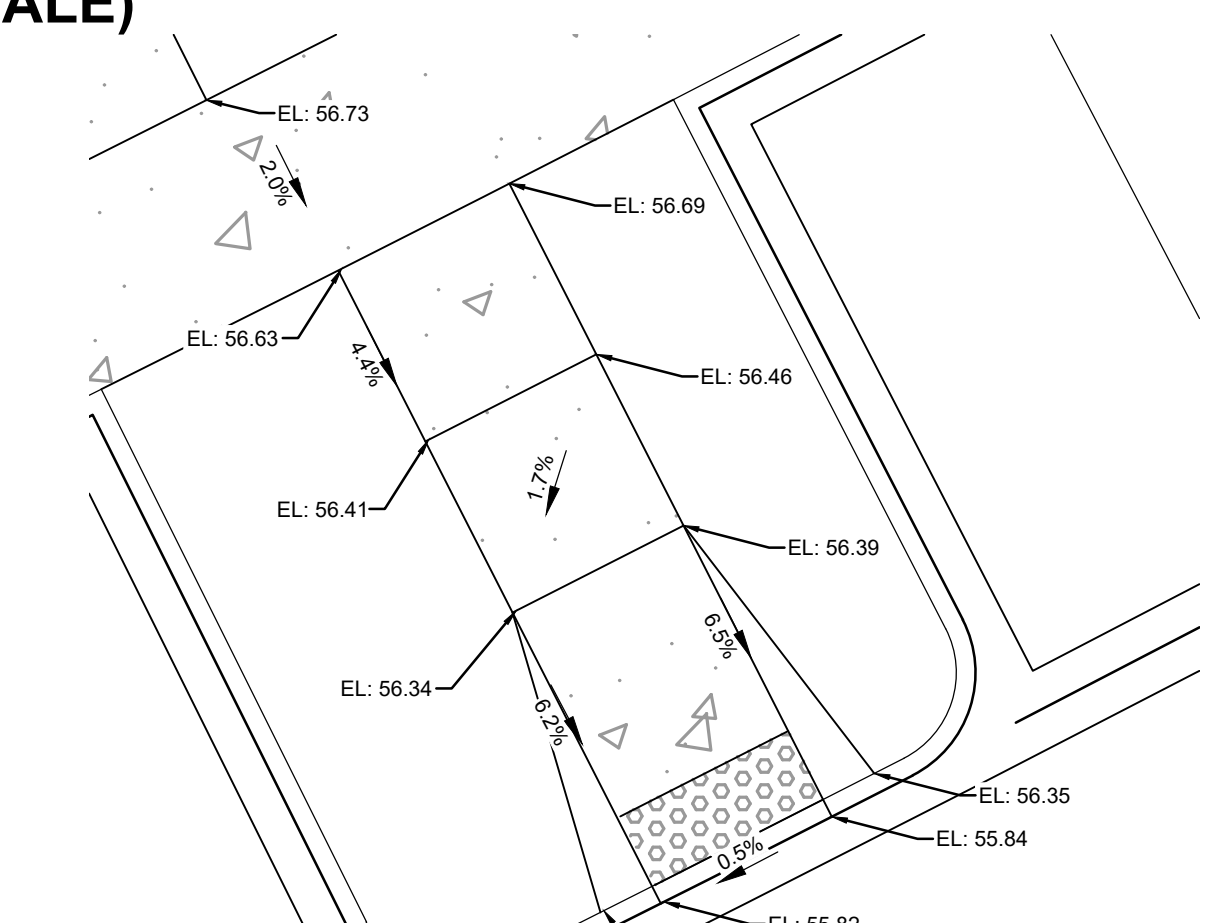


CURB RAMP #6

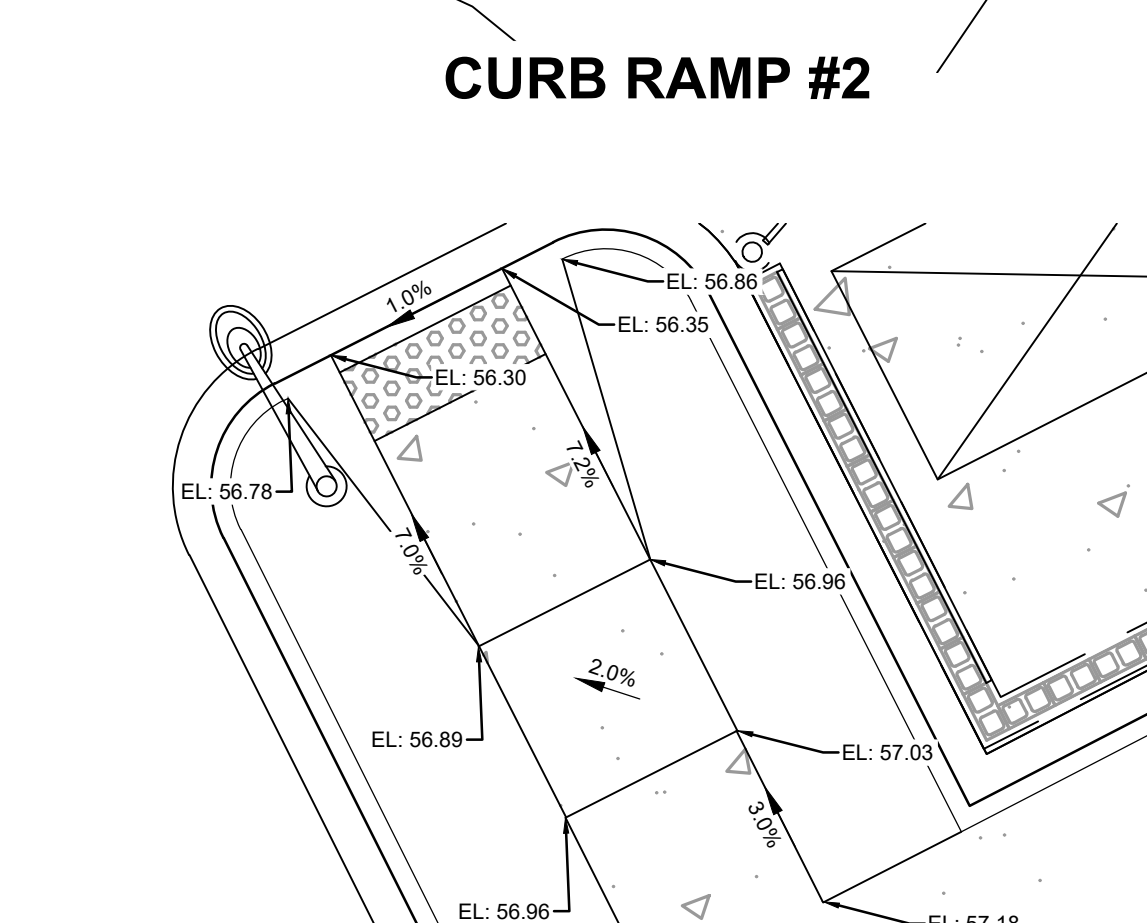


CURB RAMP #7

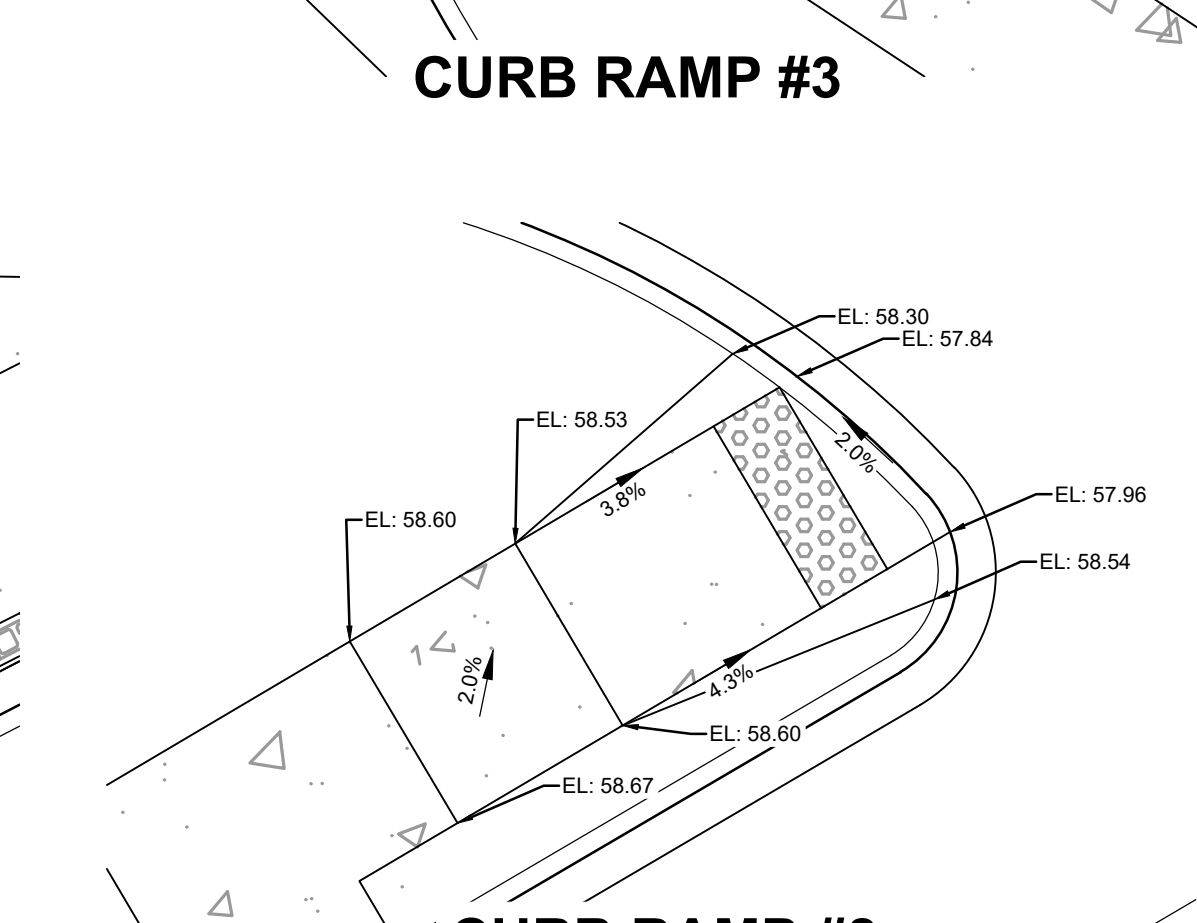


CURB RAMP #8

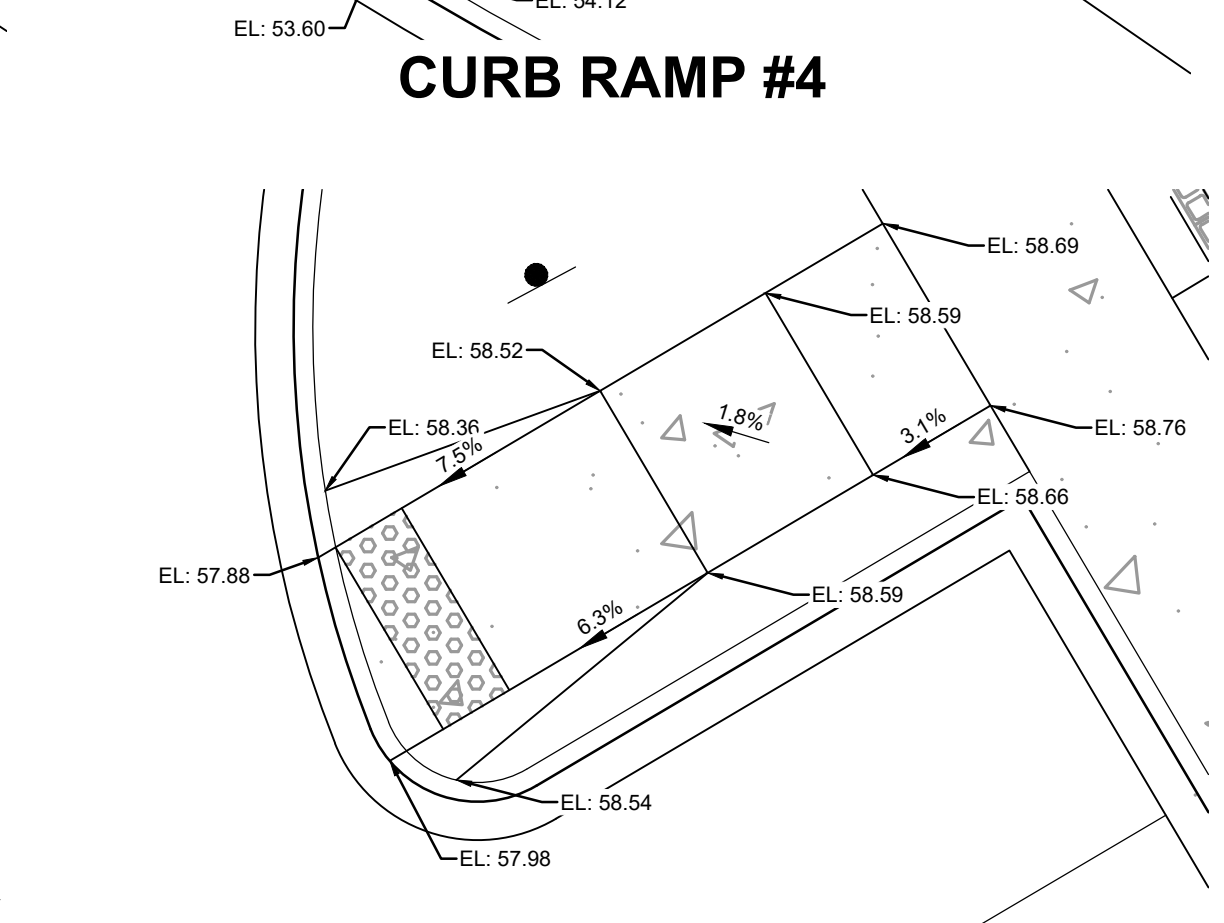


CURB RAMP #9

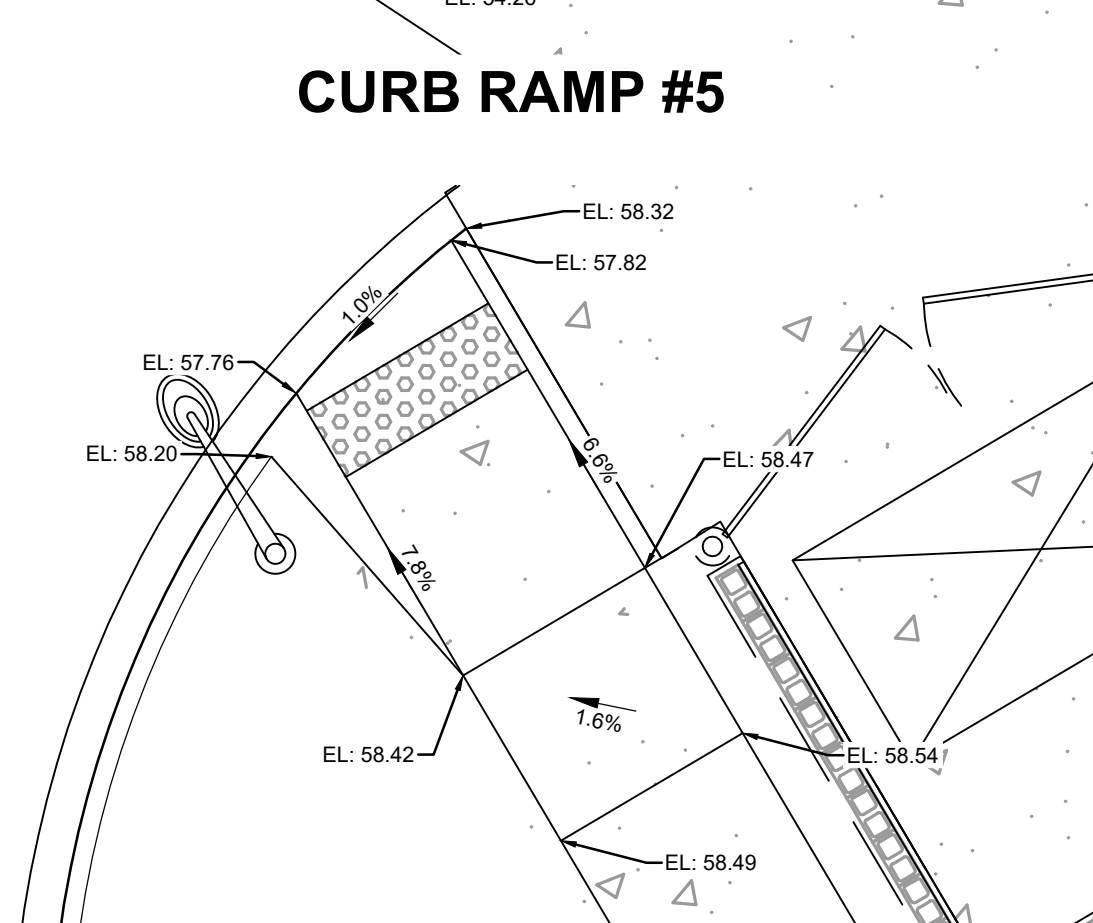


CURB RAMP #10

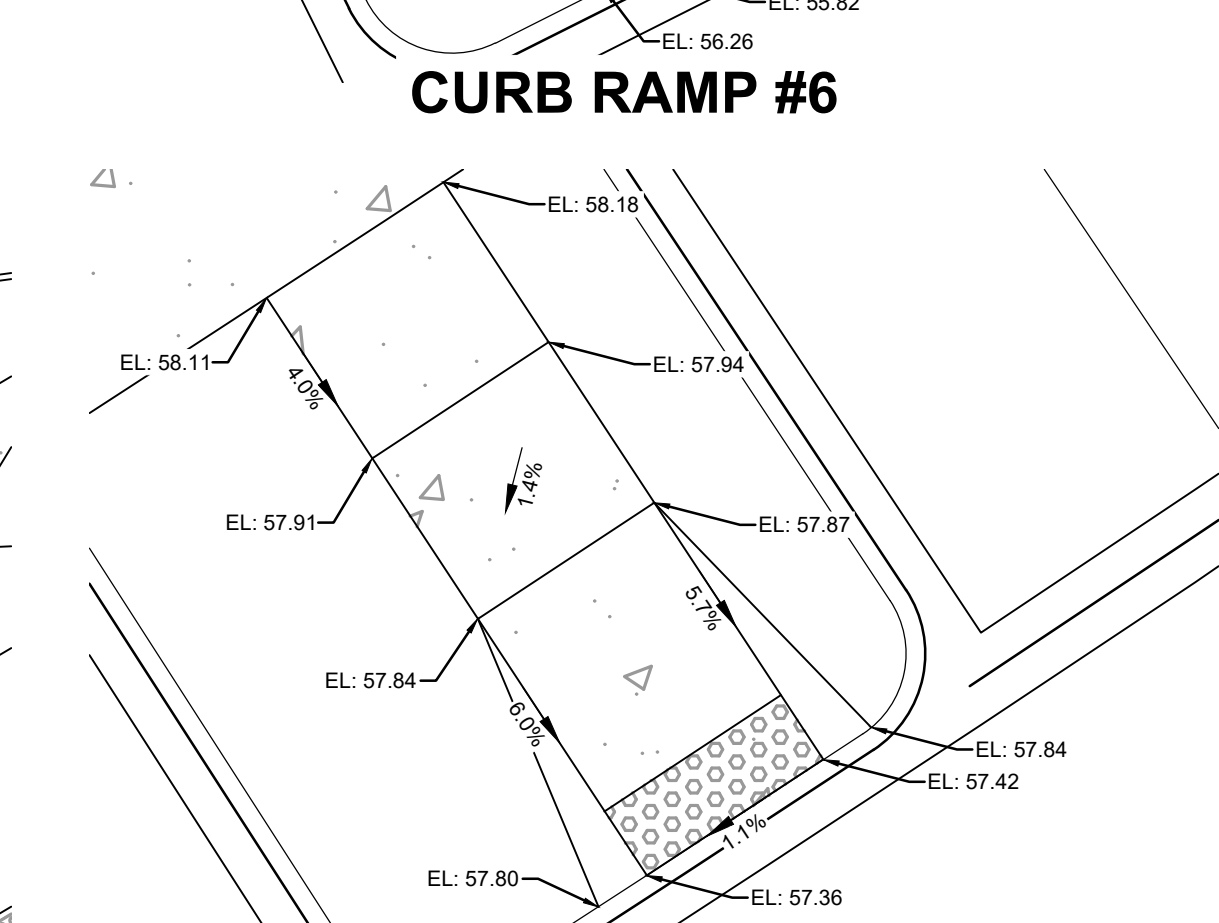

CURB RAMP #11

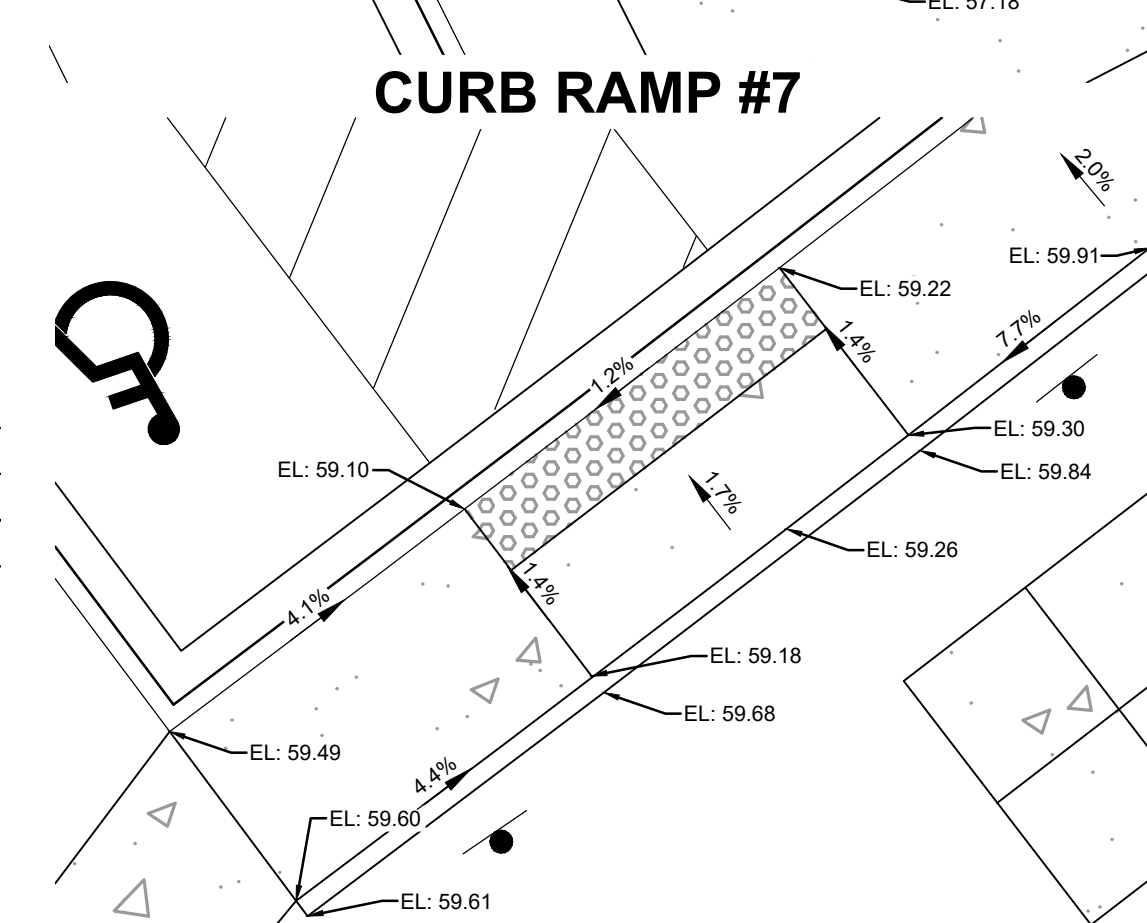

CURB RAMP #12

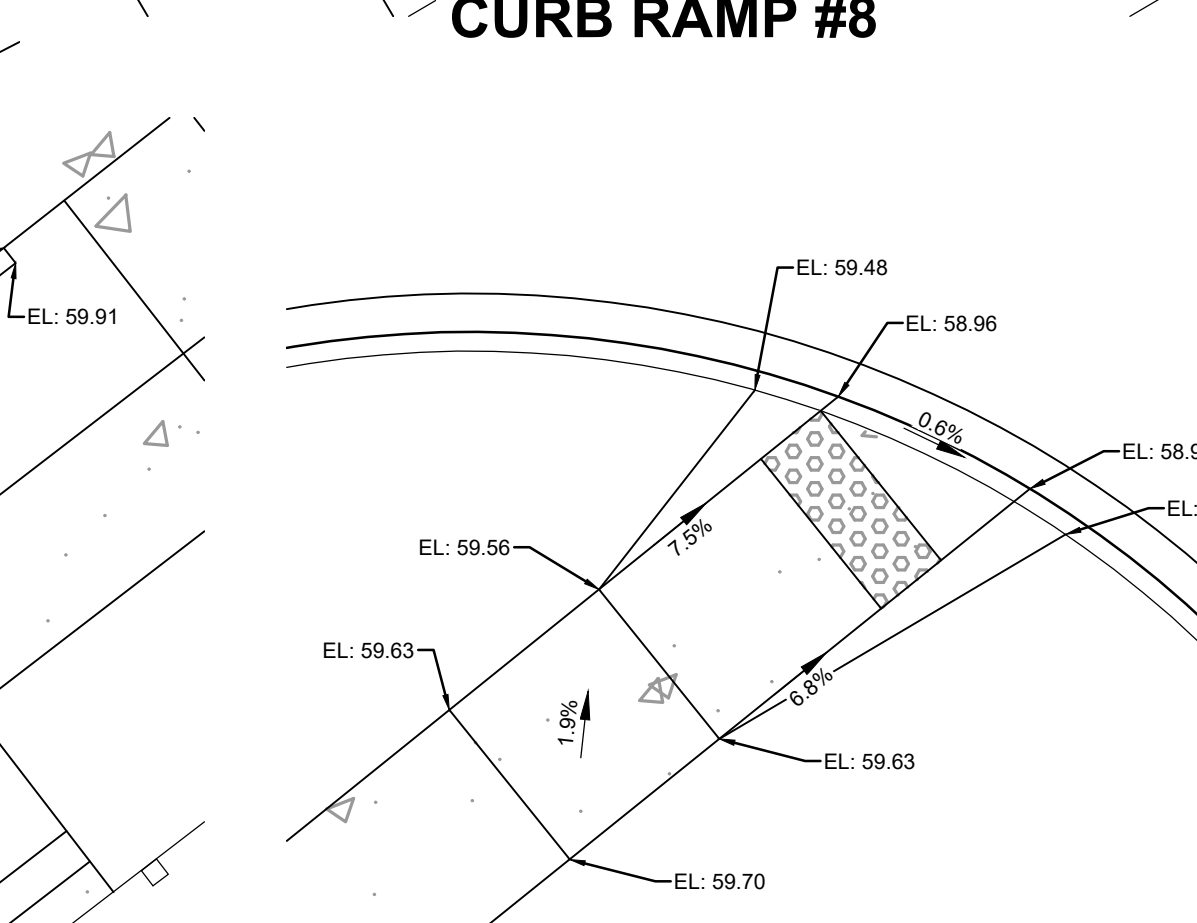

CURB RAMP #13

PCD FILNE NO.: SF2214

NOT FOR CONSTRUCTION

DRAWN BY: CBM JOB DATE: 8/31/2022  
APPROVED: KMH JOB NUMBER: 200541  
CAD DATE: 8/31/2022  
CAD FILE: J:\2020\200541\CAD\DWG\CD\CDIEI\_Paso\_CoCurb\_Ramp\_Grading

BAR IS ONE INCH ON  
OFFICIAL DRAWINGS.  
IF NOT ONE INCH,  
ADJUST SCALE ACCORDINGLY.

NO.	DATE	BY	REVISION DESCRIPTION



HR GREEN - COLORADO SPRINGS  
7222 COMMERCE CENTER DR SUITE 220  
COLORADO SPRINGS CO 80919  
PHONE: 719.300.4140 TOLL FREE: 800.728.7805  
FAX: 844.273.1057 | HRGreen.com

THE COTTAGES AT MESA RIDGE  
GOODWIN KNIGHT  
EL PASO COUNTY, COLORADO







EL PASO COUNTY CONSTRUCTION DOCUMENTS  
CURB RAMP GRADING

SHEET  
GR


9







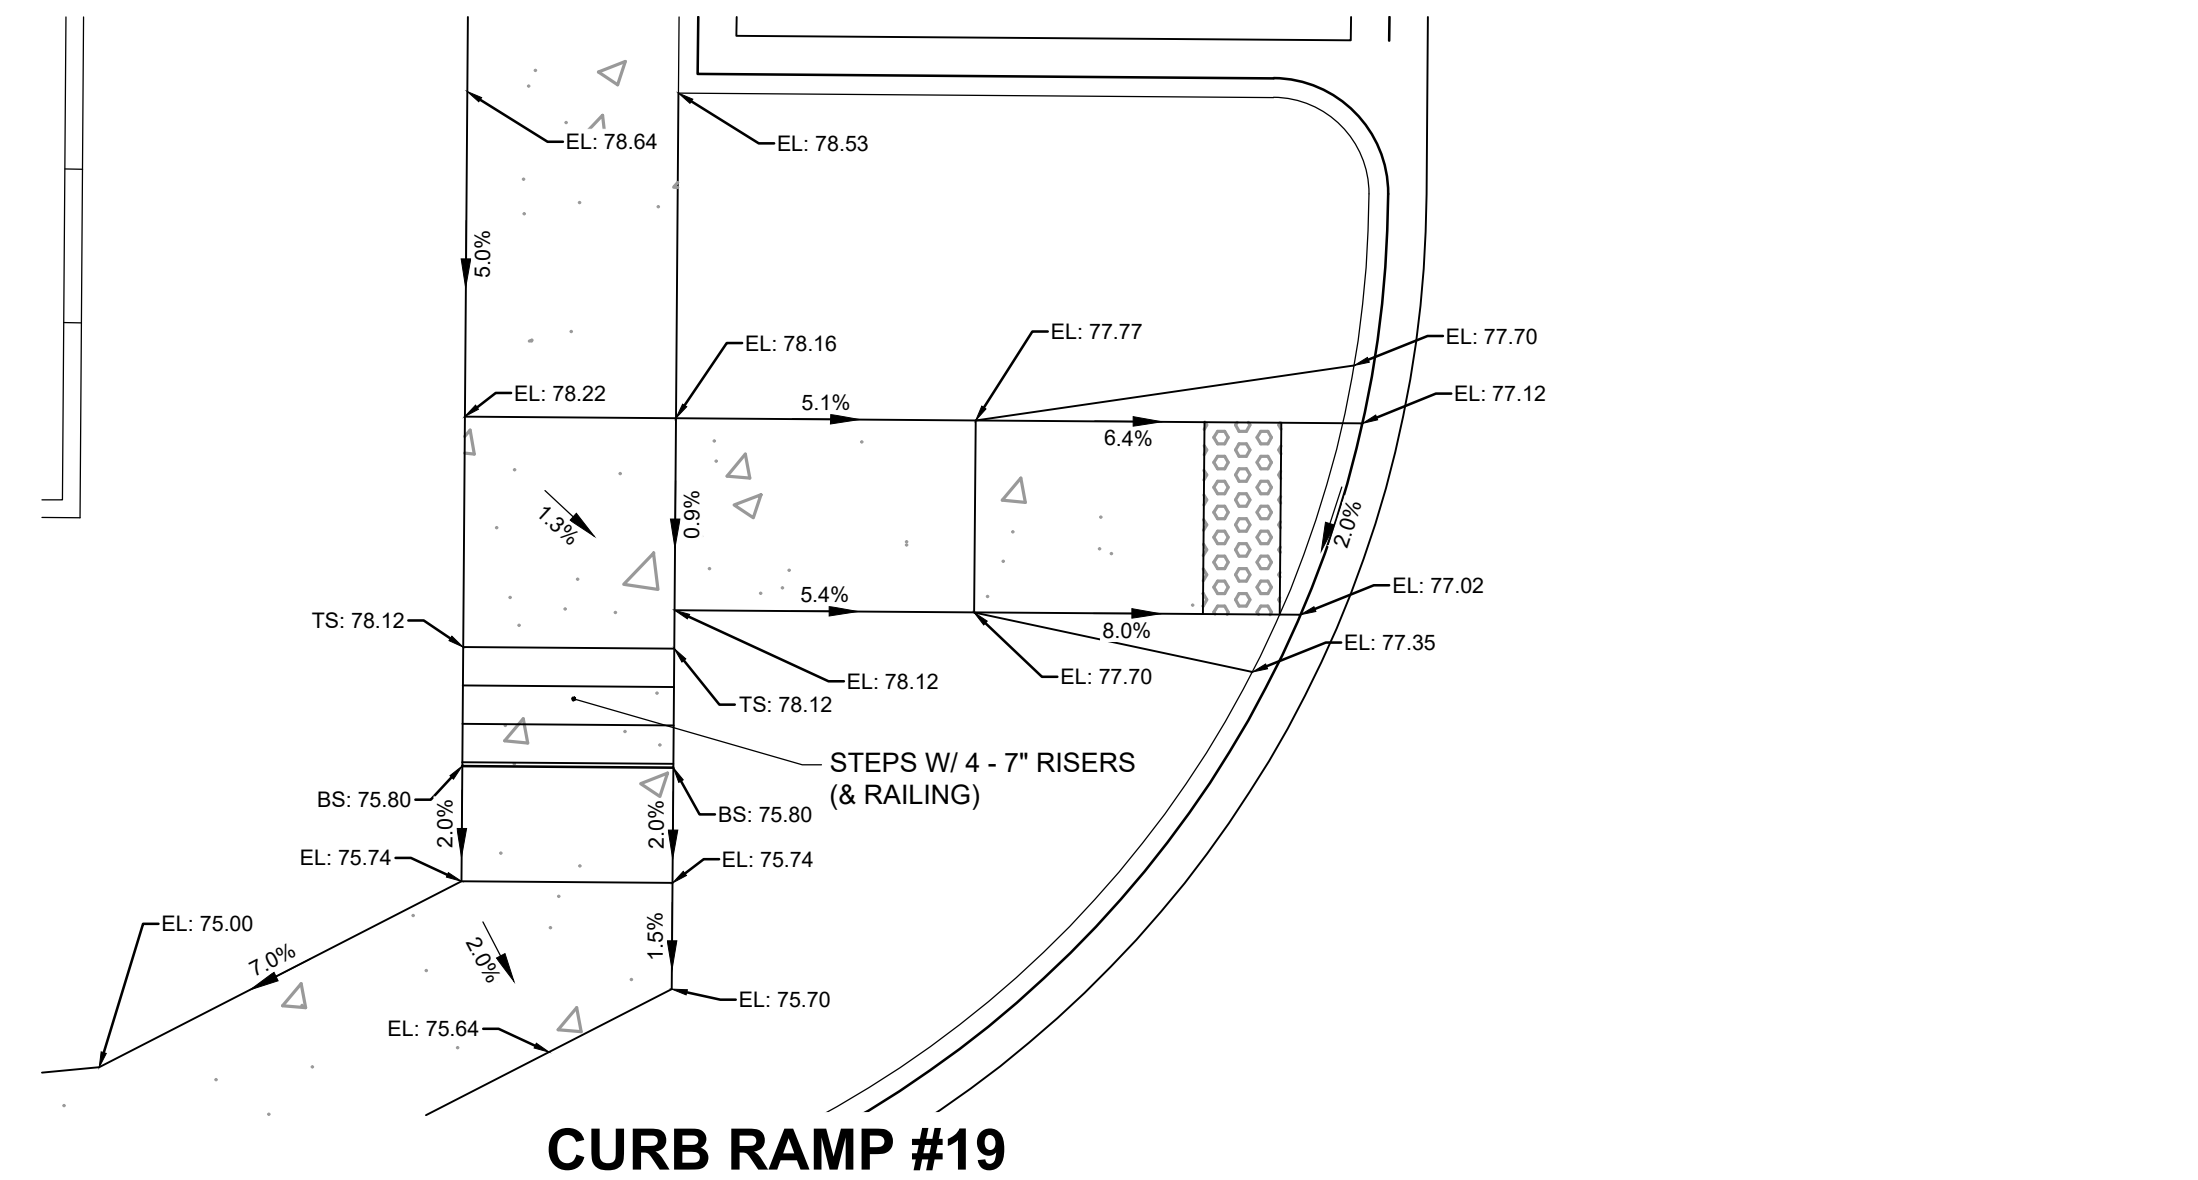
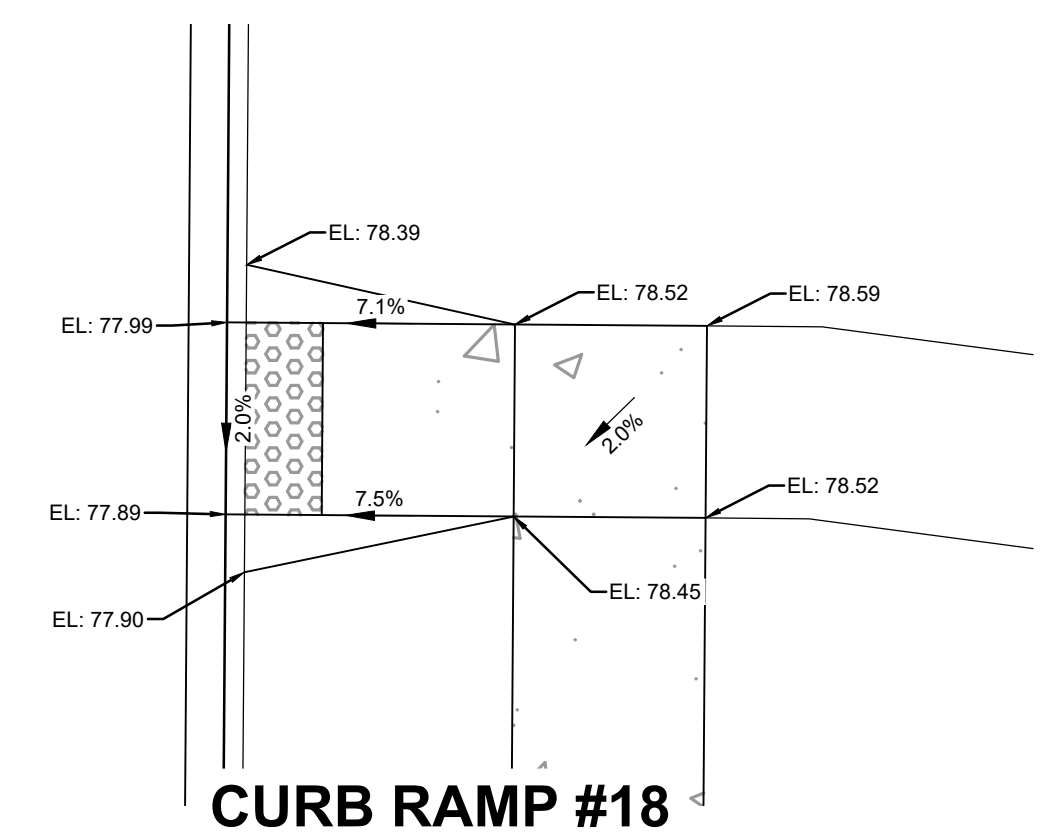
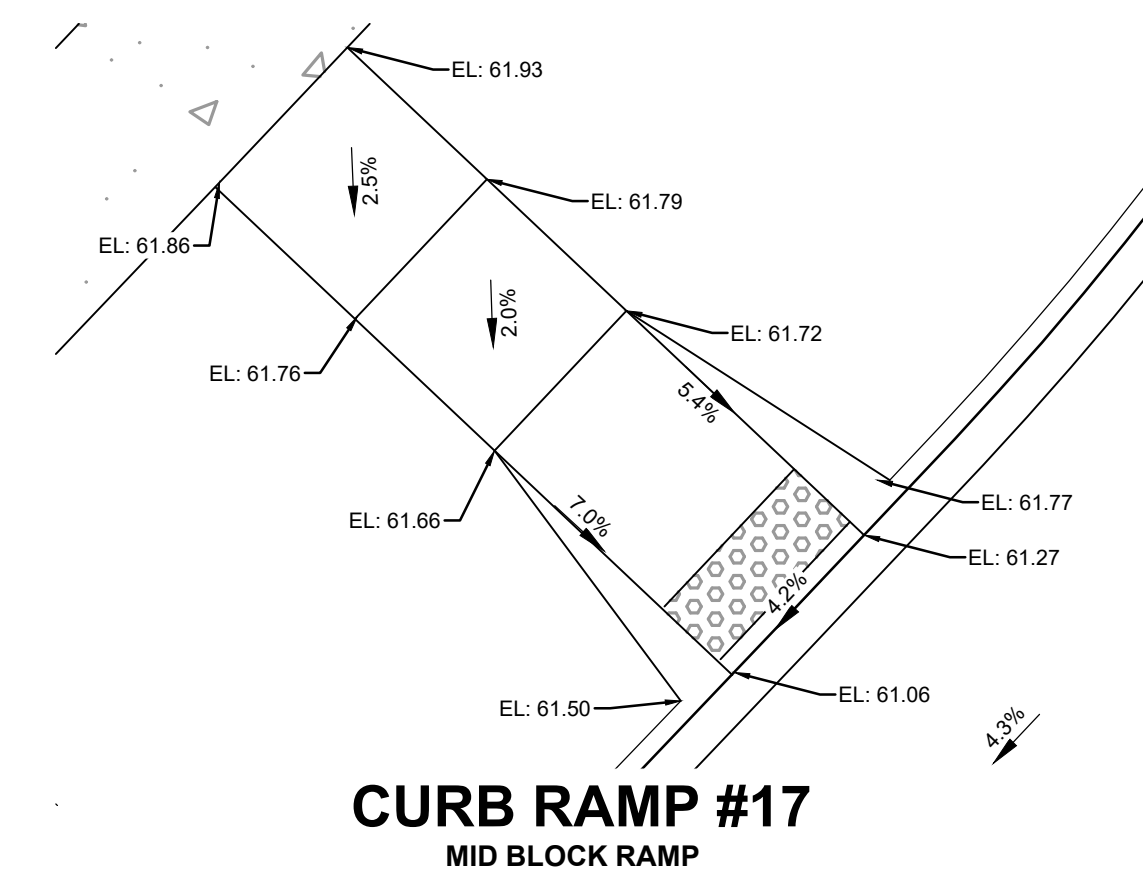
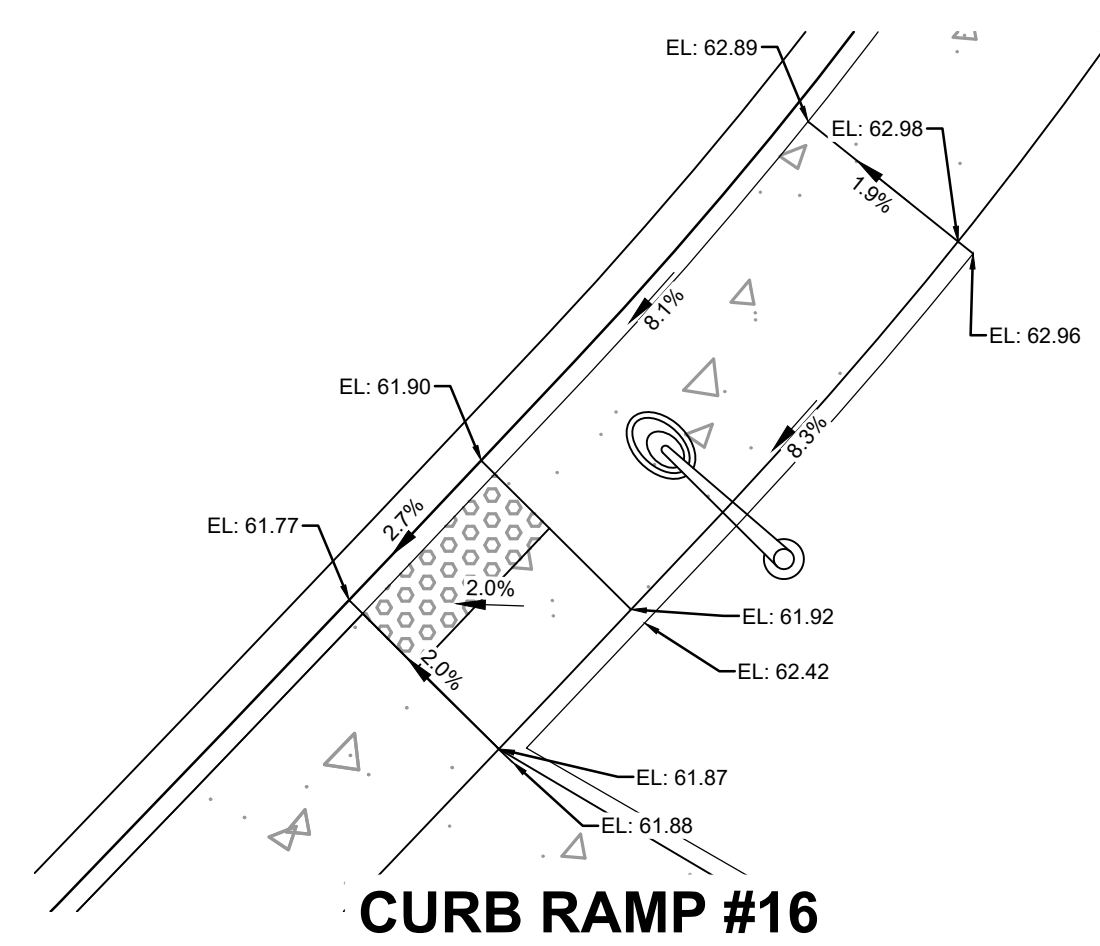


**CURB RAMP #20**  
REMOVED

**CURB RAMP #21**  
REMOVED

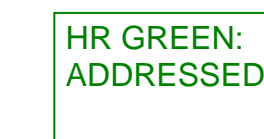


2% max cross slope  
does not appear to be met

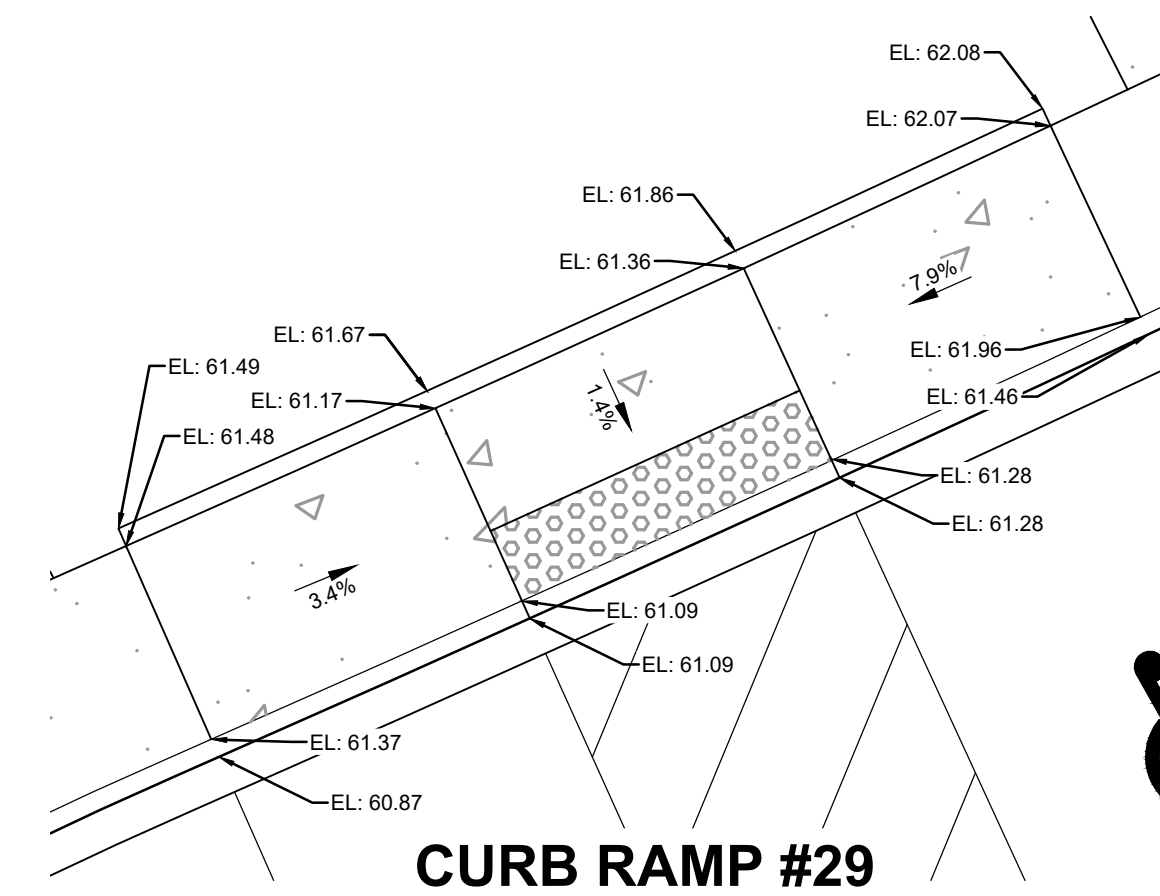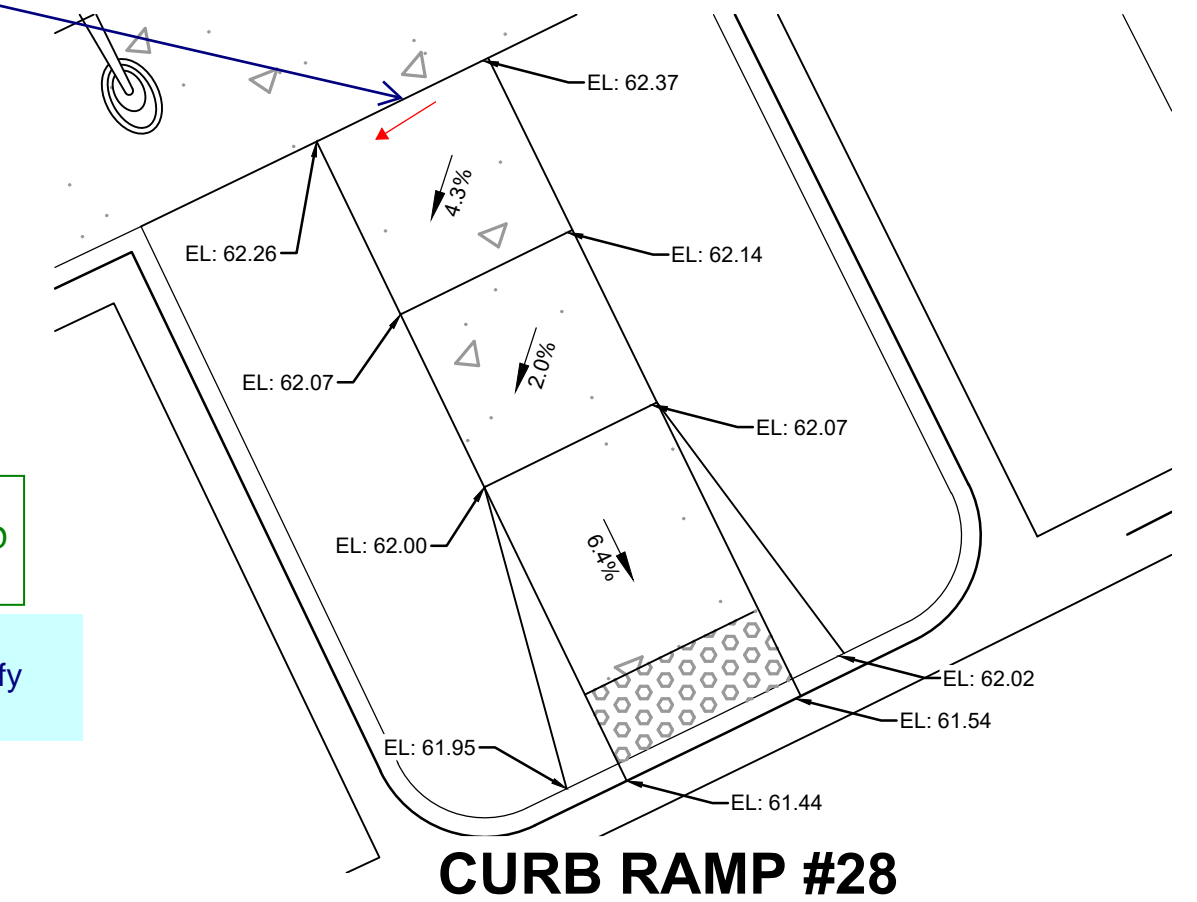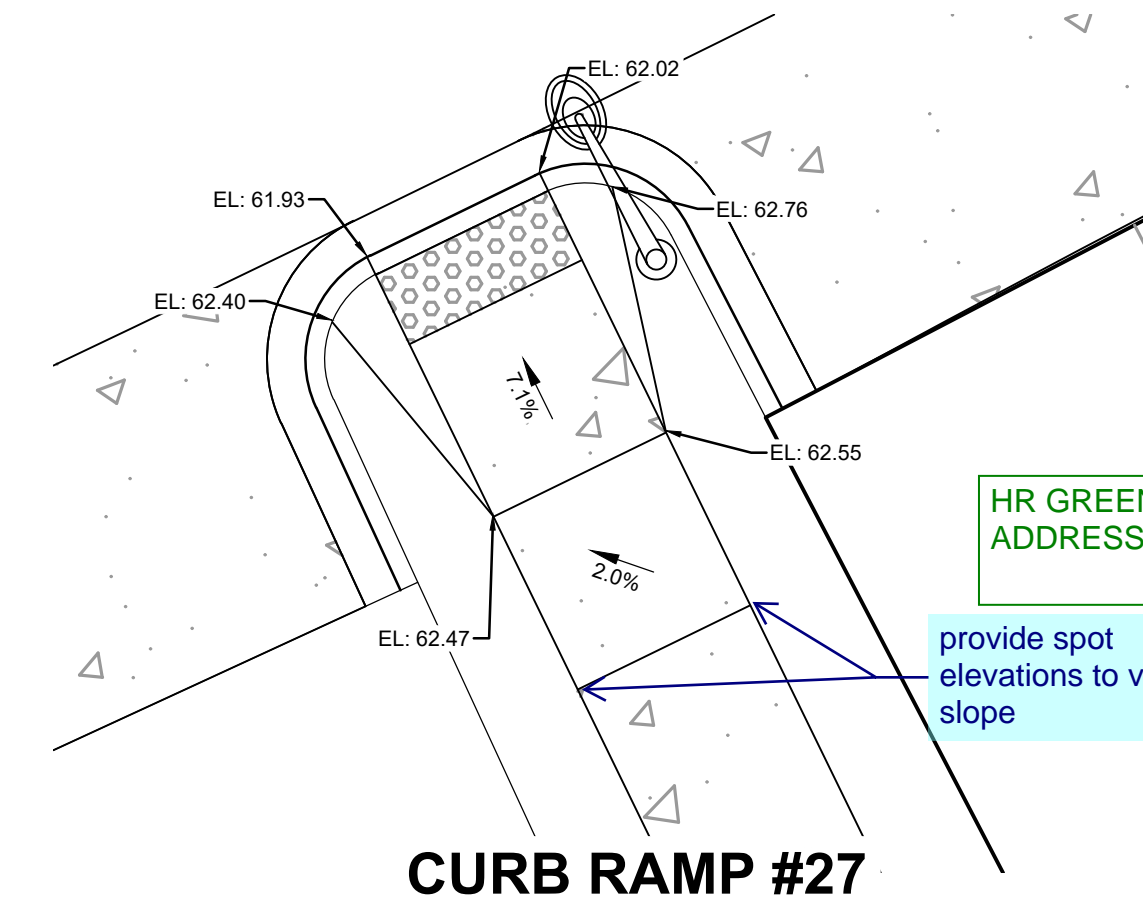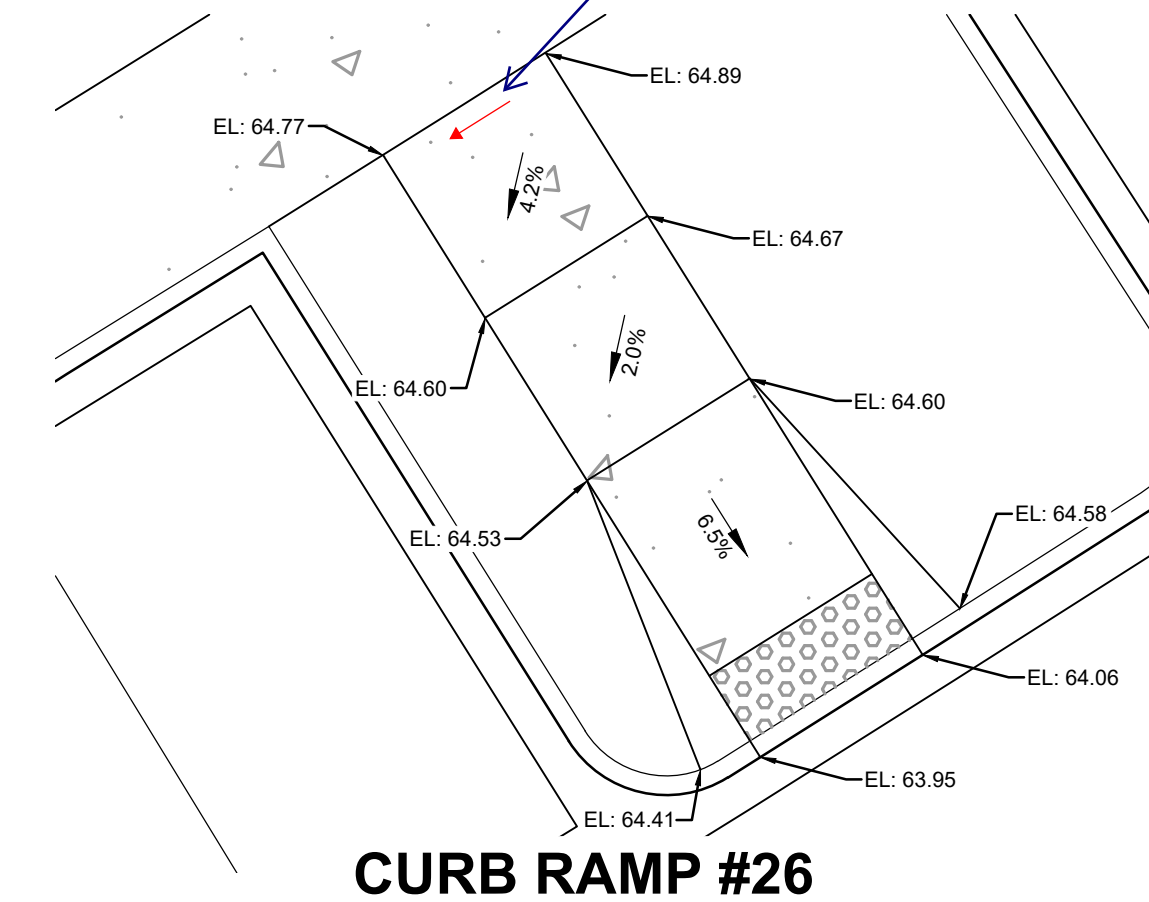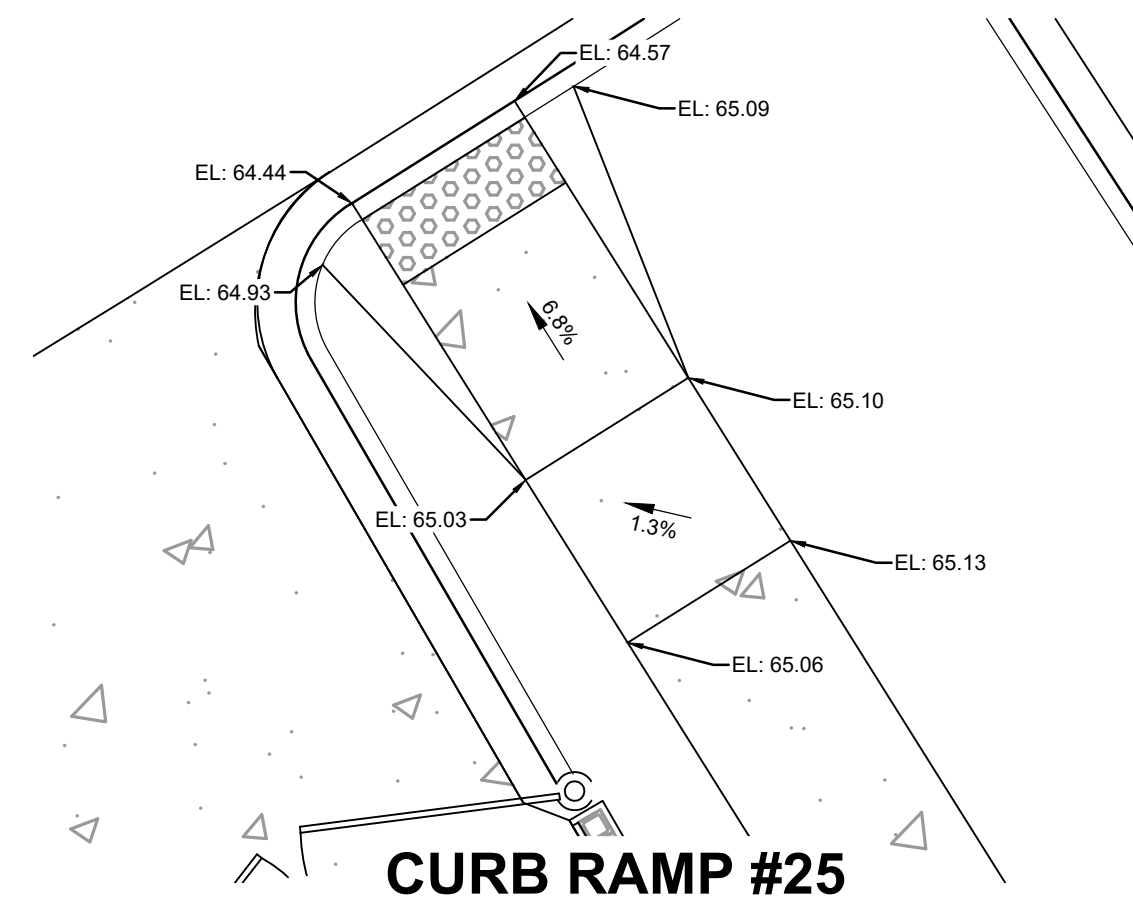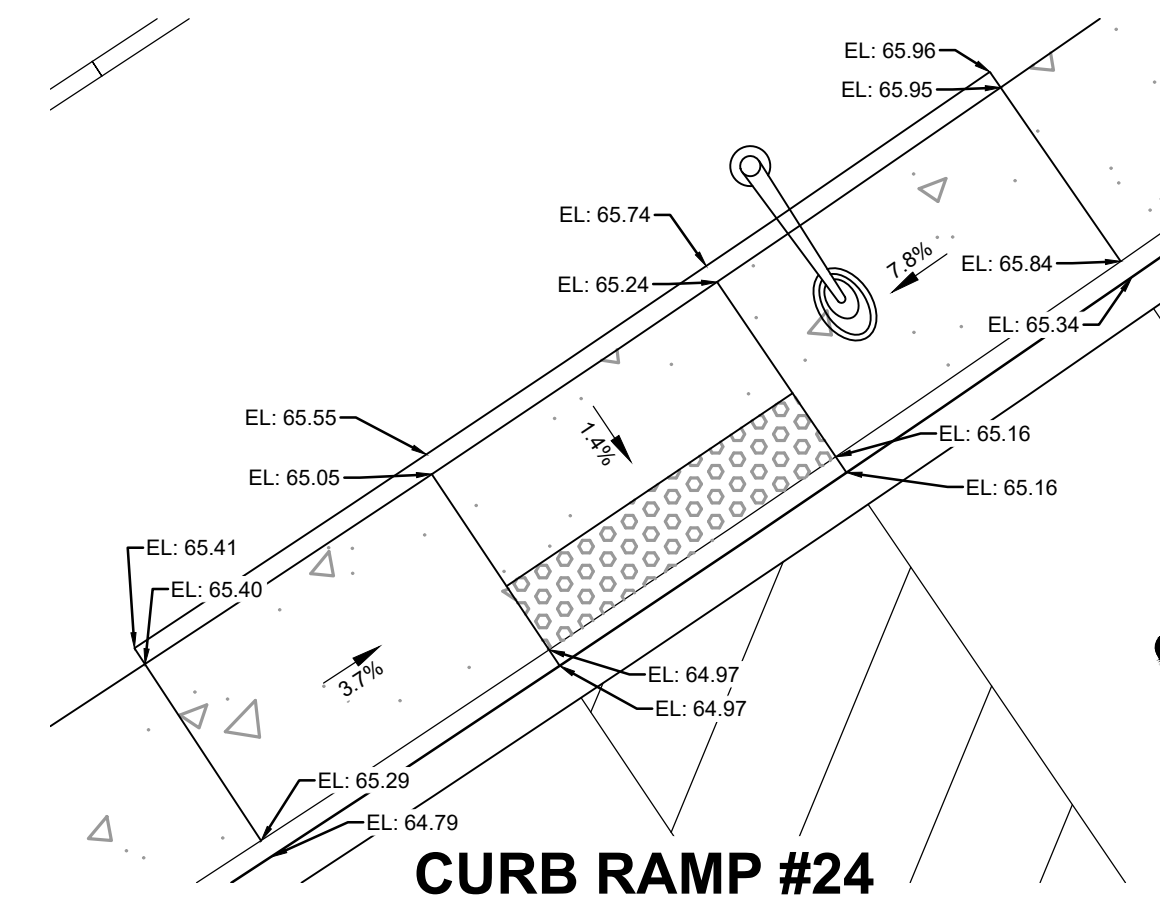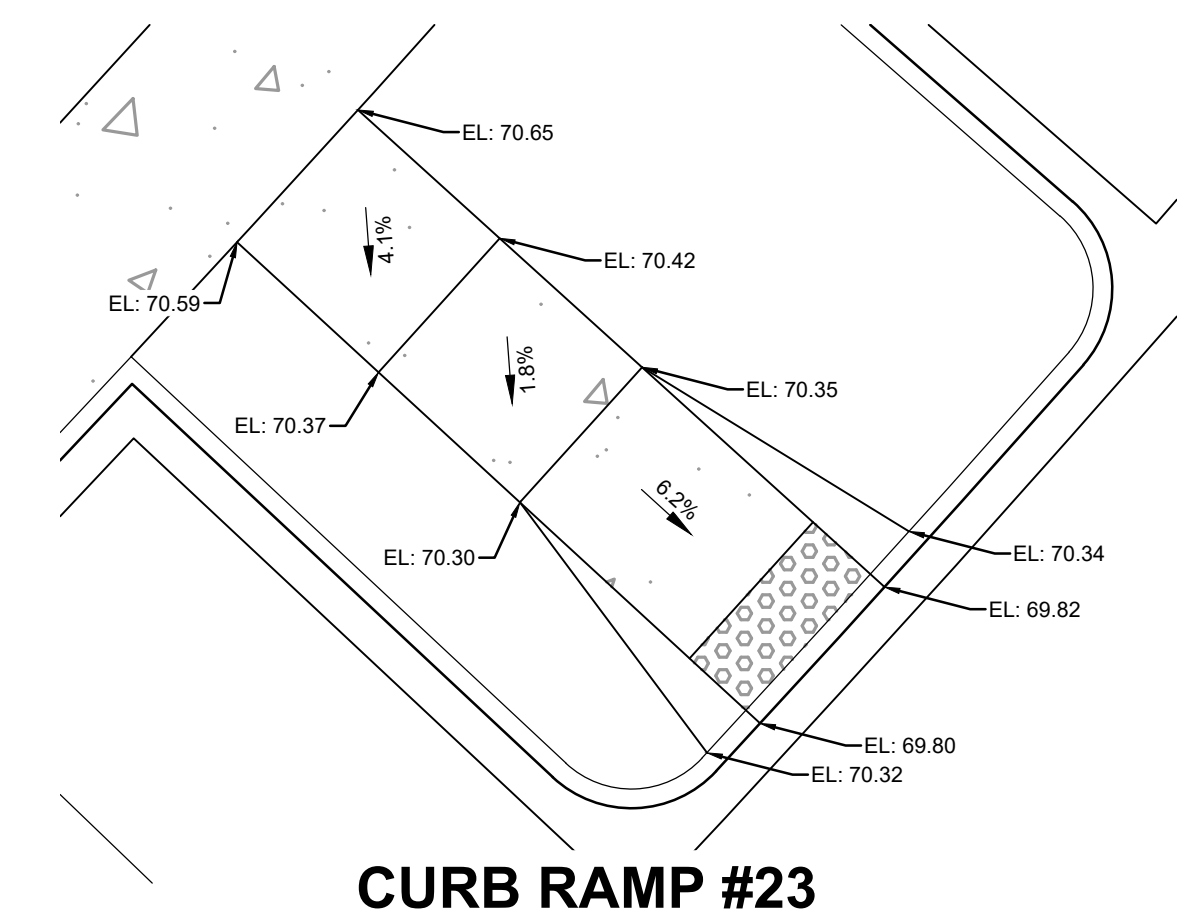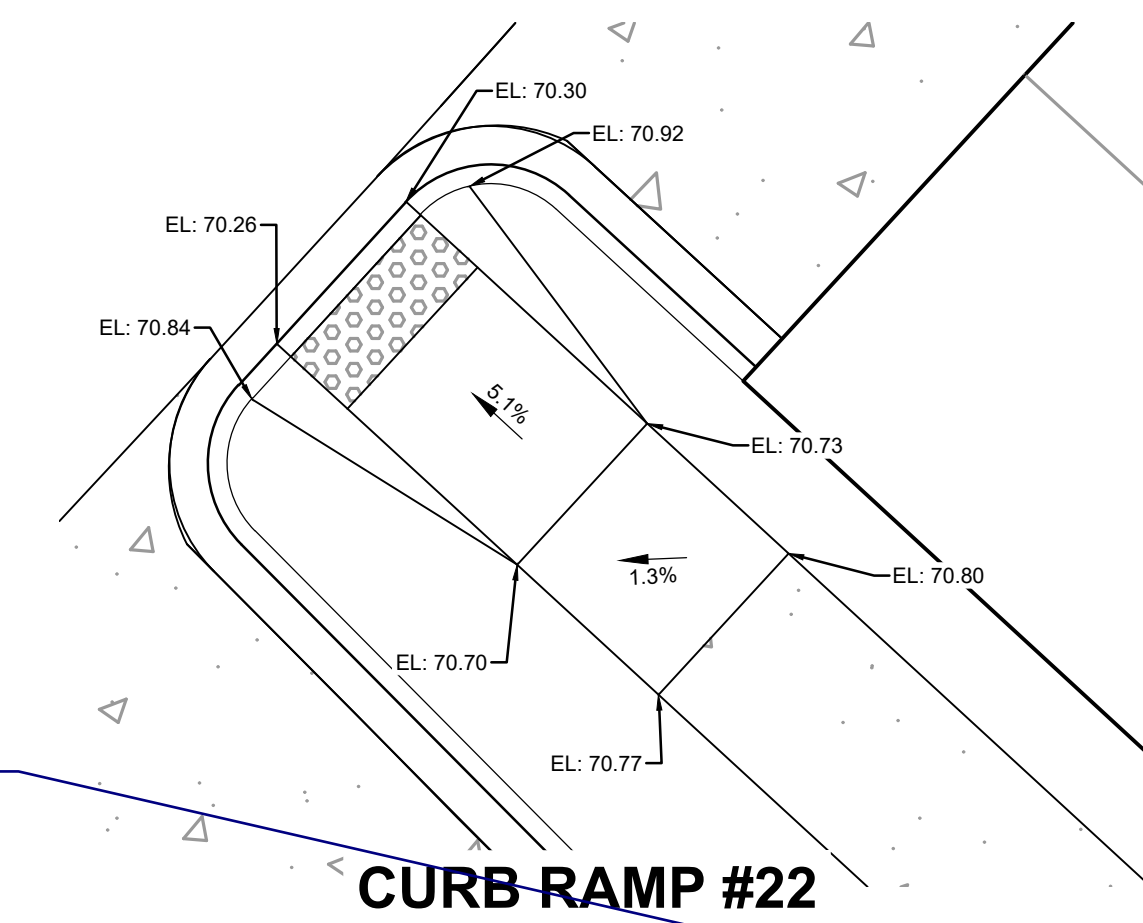

NOT FOR CONSTRUCTION

PCD FILNE NO.: SF2214

DRAWN BY: CBM JOB DATE: 8/31/2022 BAR IS ONE INCH ON  
APPROVED: KMH JOB NUMBER: 200541 OFFICIAL DRAWINGS.  
0  1"  
IF NOT ONE INCH,  
CAD DATE: 8/31/2022 ADJUST SCALE ACCORDINGLY  
CAD FILE: J:\2020\200541\CAD\Drawgs\C\CD\EI Paso\_ColCurb\_Ramp\_Grading

NO.	DATE	BY	REVISION DESCRIPTION



HR GREEN - COLORADO SPRINGS  
7222 COMMERCE CENTER DR SUITE 220  
COLORADO SPRINGS CO 80919  
PHONE: 719.300.4140 TOLL FREE: 800.728.7805  
FAX: 844.273.1057 | [HRGreen.com](http://HRGreen.com)

THE COTTAGES AT MESA RIDGE  
GOODWIN KNIGHT  
EL PASO COUNTY, COLORADO




EL PASO COUNTY CONSTRUCTION DOCUMENTS  
CURB RAMP GRADING

SHEET  
GR

10



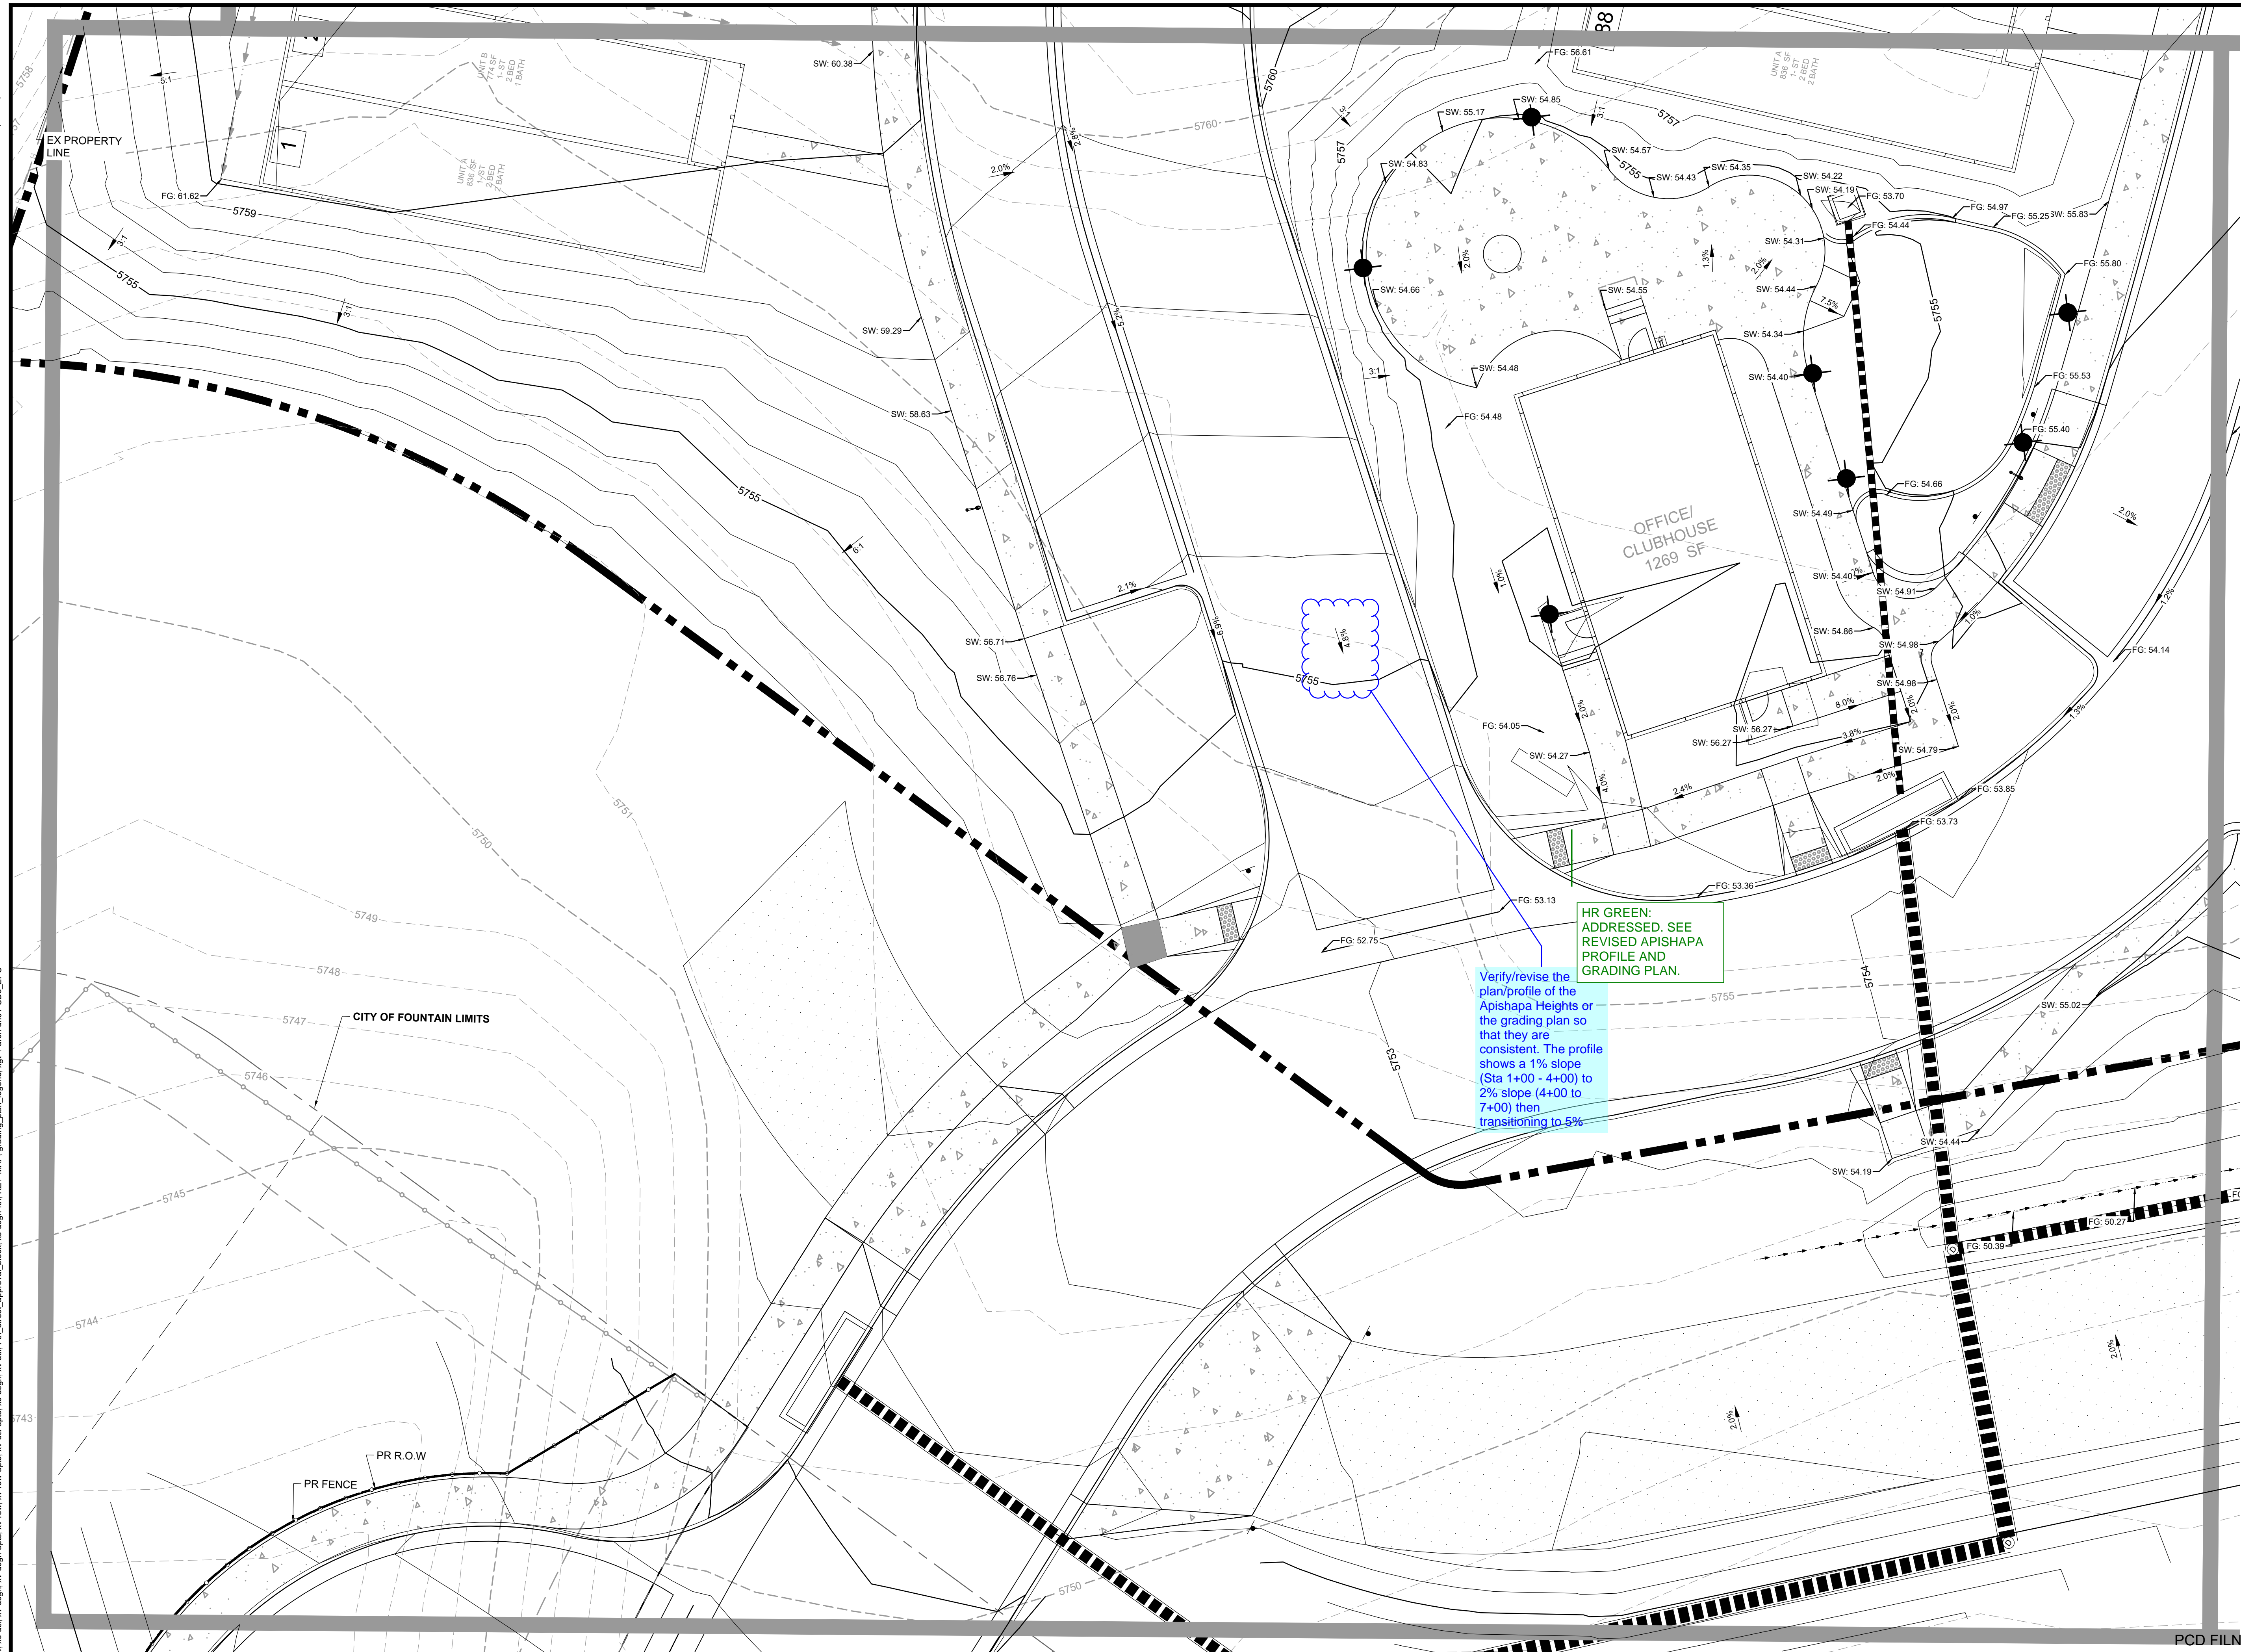


HP = HIGH POINT ELEV.  
LP = LOW POINT ELEV.  
TOF = TOP OF FOUNDATION ELEVATION  
FF = FINISH FLOOR ELEVATION  
BW = FINISHED GRADE AT BOTTOM OF WALL  
TW = FINISHED GRADE AT TOP OF WALL  
TS = TOP OF STAIRS ELEV.  
BS = BOTTOM OF STAIRS ELEV.  
SW = SIDEWALK ELEVATION  
FL = FLOWLINE ELEVATION

Verify/revise the plan/profile of the Apishapa Heights or the grading plan so that they are consistent. The profile shows a 1% slope (Sta 1+00 - 4+00) to 2% slope (4+00 to 7+00) then transitioning to 5%

PCD FILNE NO.: SF2214

DRAWN BY: CBM JOB DATE: 8/31/2022  
APPROVED: KMH JOB NUMBER: 200541  
CAD DATE: 8/31/2022  
CAD FILE: J:\2020\200541\CAD\Drawgs\C\CD\EI Paso\_ColGrading

BAR IS ONE INCH ON  
OFFICIAL DRAWINGS.  
0  1"  
IF NOT ONE INCH,  
ADJUST SCALE ACCORDINGLY

NO.	DATE	BY	REVISION DESCRIPTION



HR GREEN - COLORADO SPRINGS  
7222 COMMERCE CENTER DR SUITE 220  
COLORADO SPRINGS CO 80919  
PHONE: 719.300.4140 TOLL FREE: 800.728.7805  
FAX: 844.273.1057 | [HRGreen.com](http://HRGreen.com)

THE COTTAGES AT MESA RIDGE  
GOODWIN KNIGHT  
EL PASO COUNTY, COLORADO




EL PASO COUNTY CONSTRUCTION DOCUMENTS  
DETAILED GRADING

SHEET  
GR

11


NOT FOR CONSTRUCTION



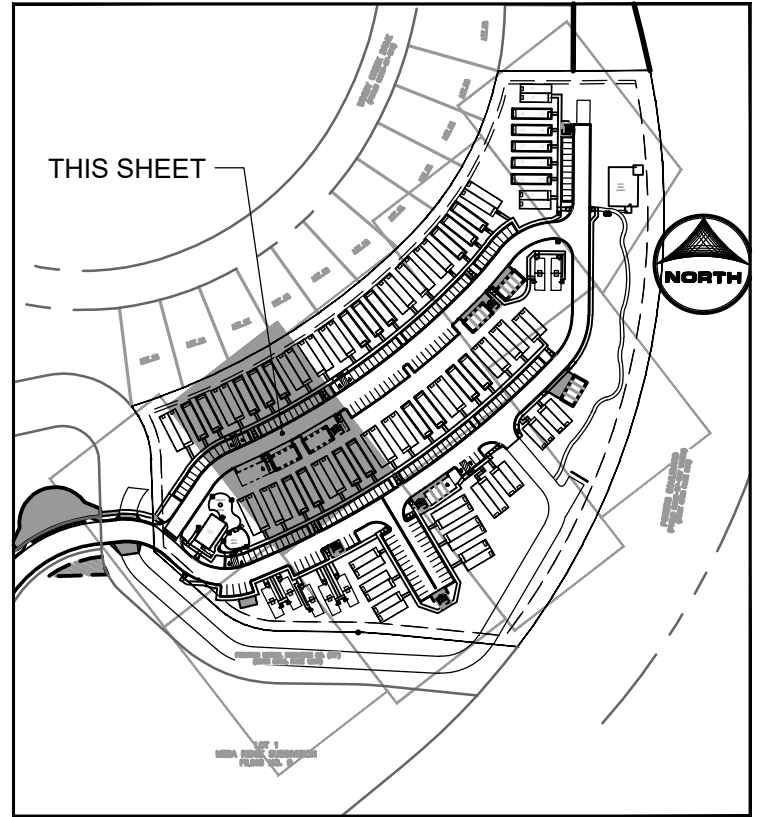



HP = HIGH POINT ELEV.  
LP = LOW POINT ELEV.  
TOF = TOP OF FOUNDATION ELEVATION  
FF = FINISH FLOOR ELEVATION  
BW = FINISHED GRADE AT BOTTOM OF WALL  
TW = FINISHED GRADE AT TOP OF WALL  
TS = TOP OF STAIRS ELEV.  
BS = BOTTOM OF STAIRS ELEV.  
SW = SIDEWALK ELEVATION  
FL = FLOWLINE ELEVATION

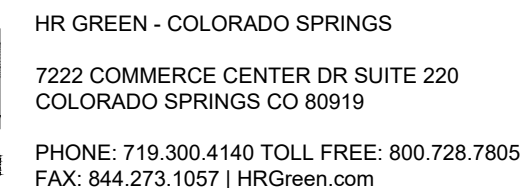


12



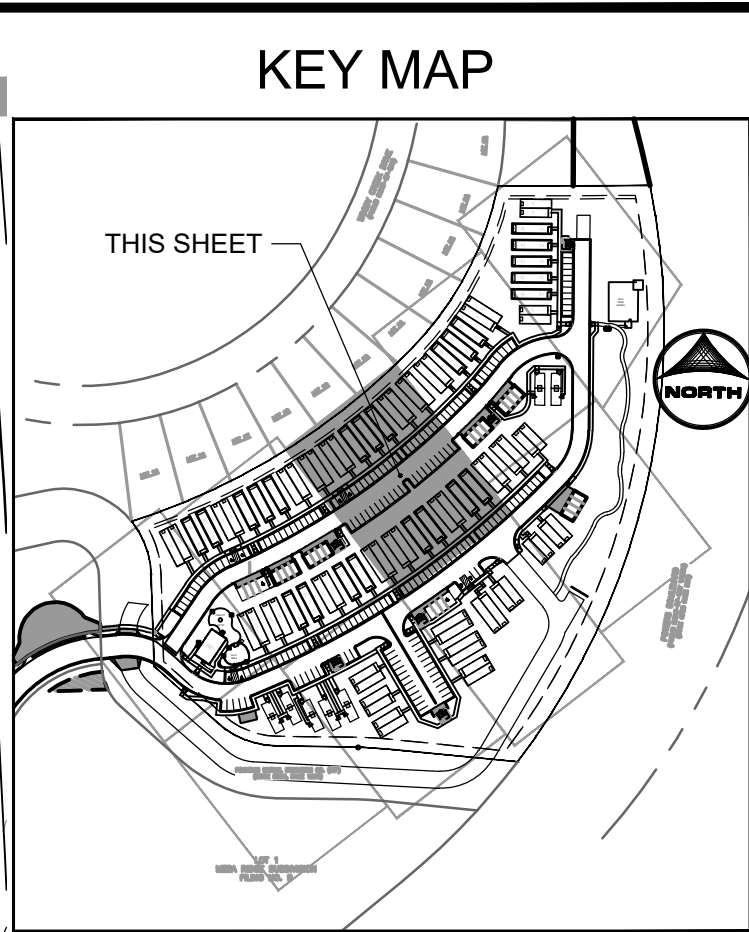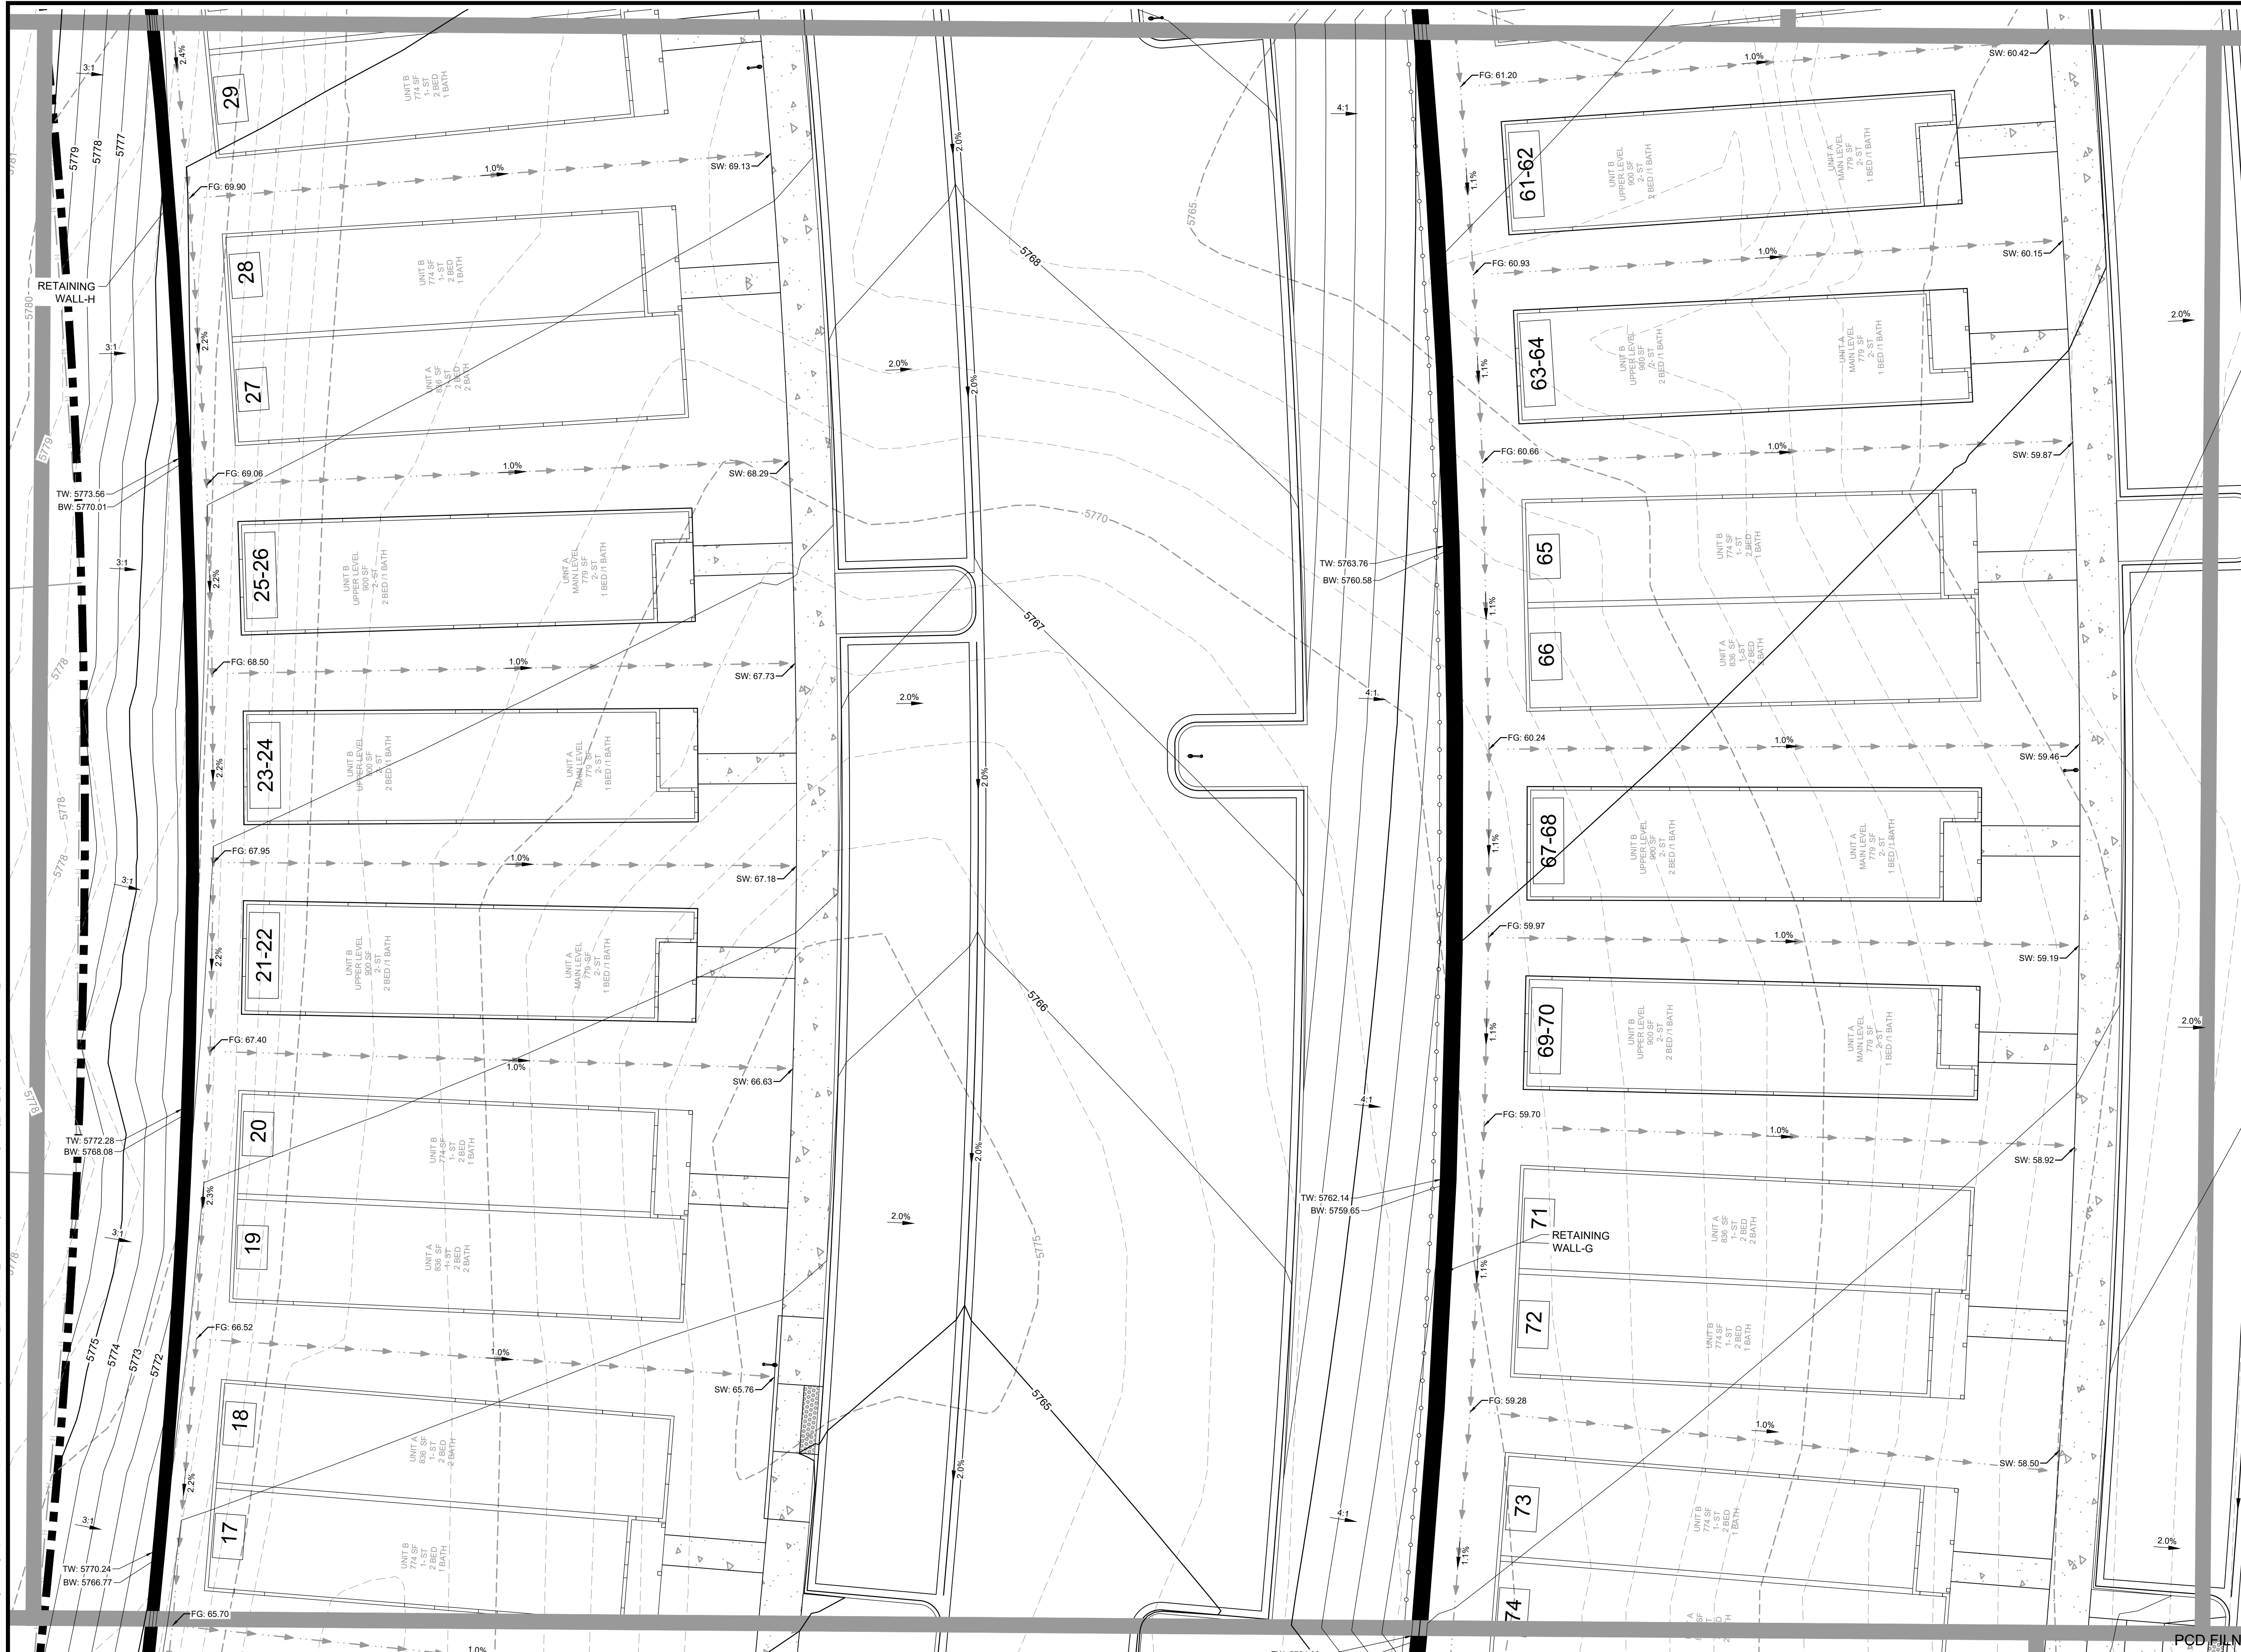

**GRADING PLAN LEGEND**

HP = HIGH POINT ELEV.  
LP = LOW POINT ELEV.  
TOP = TOP OF FOUNDATION ELEVATION  
FF = FINISH FLOOR ELEVATION  
BW = FINISHED GRADE AT BOTTOM OF WALL  
TW = FINISHED GRADE AT TOP OF WALL  
TS = TOP OF STAIRS ELEV.  
BS = BOTTOM OF STAIRS ELEV.  
SW = SIDEWALK ELEVATION  
FL = FLOWLINE ELEVATION

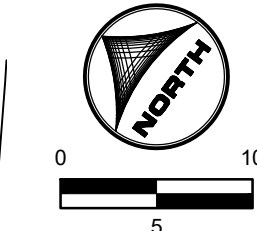

NOT FOR CONSTRUCTION

DRAWN BY: CBM JOB DATE: 8/31/2022  
APPROVED: KMH JOB NUMBER: 200541  
CAD DATE: 8/31/2022  
CAD FILE: J:\2020\200541\CAD\DWG\CD\CDIE\_Paso\_CoGrading

BAR IS ONE INCH ON OFFICIAL DRAWINGS.  
IF NOT ONE INCH, ADJUST SCALE ACCORDINGLY.

NO.	DATE	BY	REVISION DESCRIPTION

HR GREEN - COLORADO SPRINGS  
7222 COMMERCE CENTER DR SUITE 220  
COLORADO SPRINGS CO 80919  
PHONE: 719.300.4140 TOLL FREE: 800.728.7805  
FAX: 844.273.1057 | HRGreen.com


THE COTTAGES AT MESA RIDGE  
GOODWIN KNIGHT  
EL PASO COUNTY, COLORADO



EL PASO COUNTY CONSTRUCTION DOCUMENTS  
DETAILED GRADING


SHEET  
GR  
13



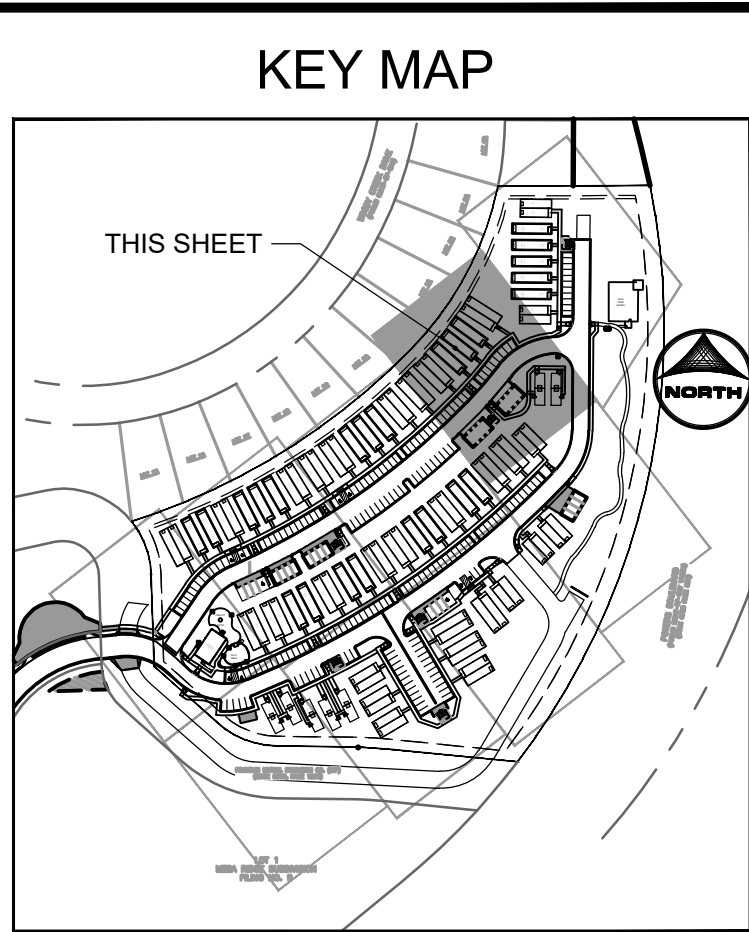

**GRADING PLAN LEGEND**

HP = HIGH POINT ELEV.  
LP = LOW POINT ELEV.  
TOP = TOP OF FOUNDATION ELEVATION  
FF = FINISH FLOOR ELEVATION  
BW = FINISHED GRADE AT BOTTOM OF WALL  
TW = FINISHED GRADE AT TOP OF WALL  
TS = TOP OF STAIRS ELEV.  
BS = BOTTOM OF STAIRS ELEV.  
SW = SIDEWALK ELEVATION  
FL = FLOWLINE ELEVATION

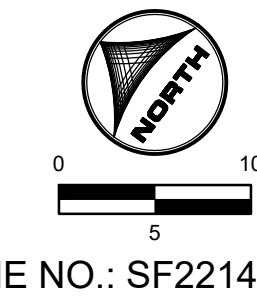

NOT FOR CONSTRUCTION

DRAWN BY: CBM JOB DATE: 8/31/2022  
APPROVED: KMH JOB NUMBER: 200541  
CAD DATE: 8/31/2022  
CAD FILE: J:\2020\200541\CAD\DWG\CD\IEI\_Paso\_ColGrading

BAR IS ONE INCH ON OFFICIAL DRAWINGS.  
IF NOT ONE INCH, ADJUST SCALE ACCORDINGLY.

NO.	DATE	BY	REVISION DESCRIPTION



HR GREEN - COLORADO SPRINGS  
7222 COMMERCE CENTER DR SUITE 220  
COLORADO SPRINGS CO 80919  
PHONE: 719.300.4140 TOLL FREE: 800.728.7805  
FAX: 844.273.1057 | HRGreen.com

THE COTTAGES AT MESA RIDGE  
GOODWIN KNIGHT  
EL PASO COUNTY, COLORADO

EL PASO COUNTY CONSTRUCTION DOCUMENTS  
DETAILED GRADING


SHEET  
GR  
14



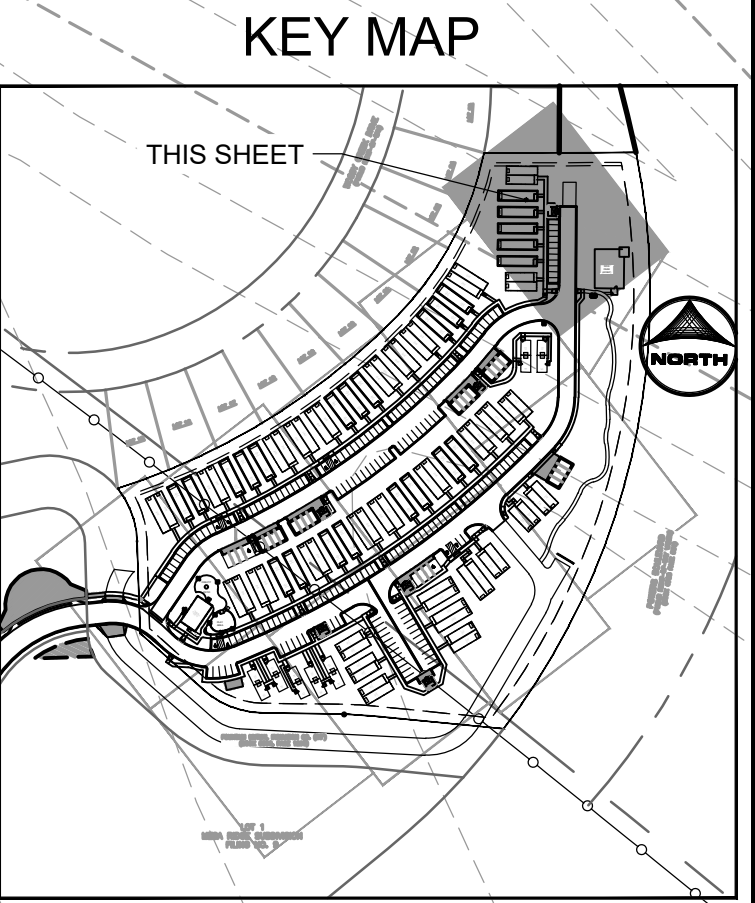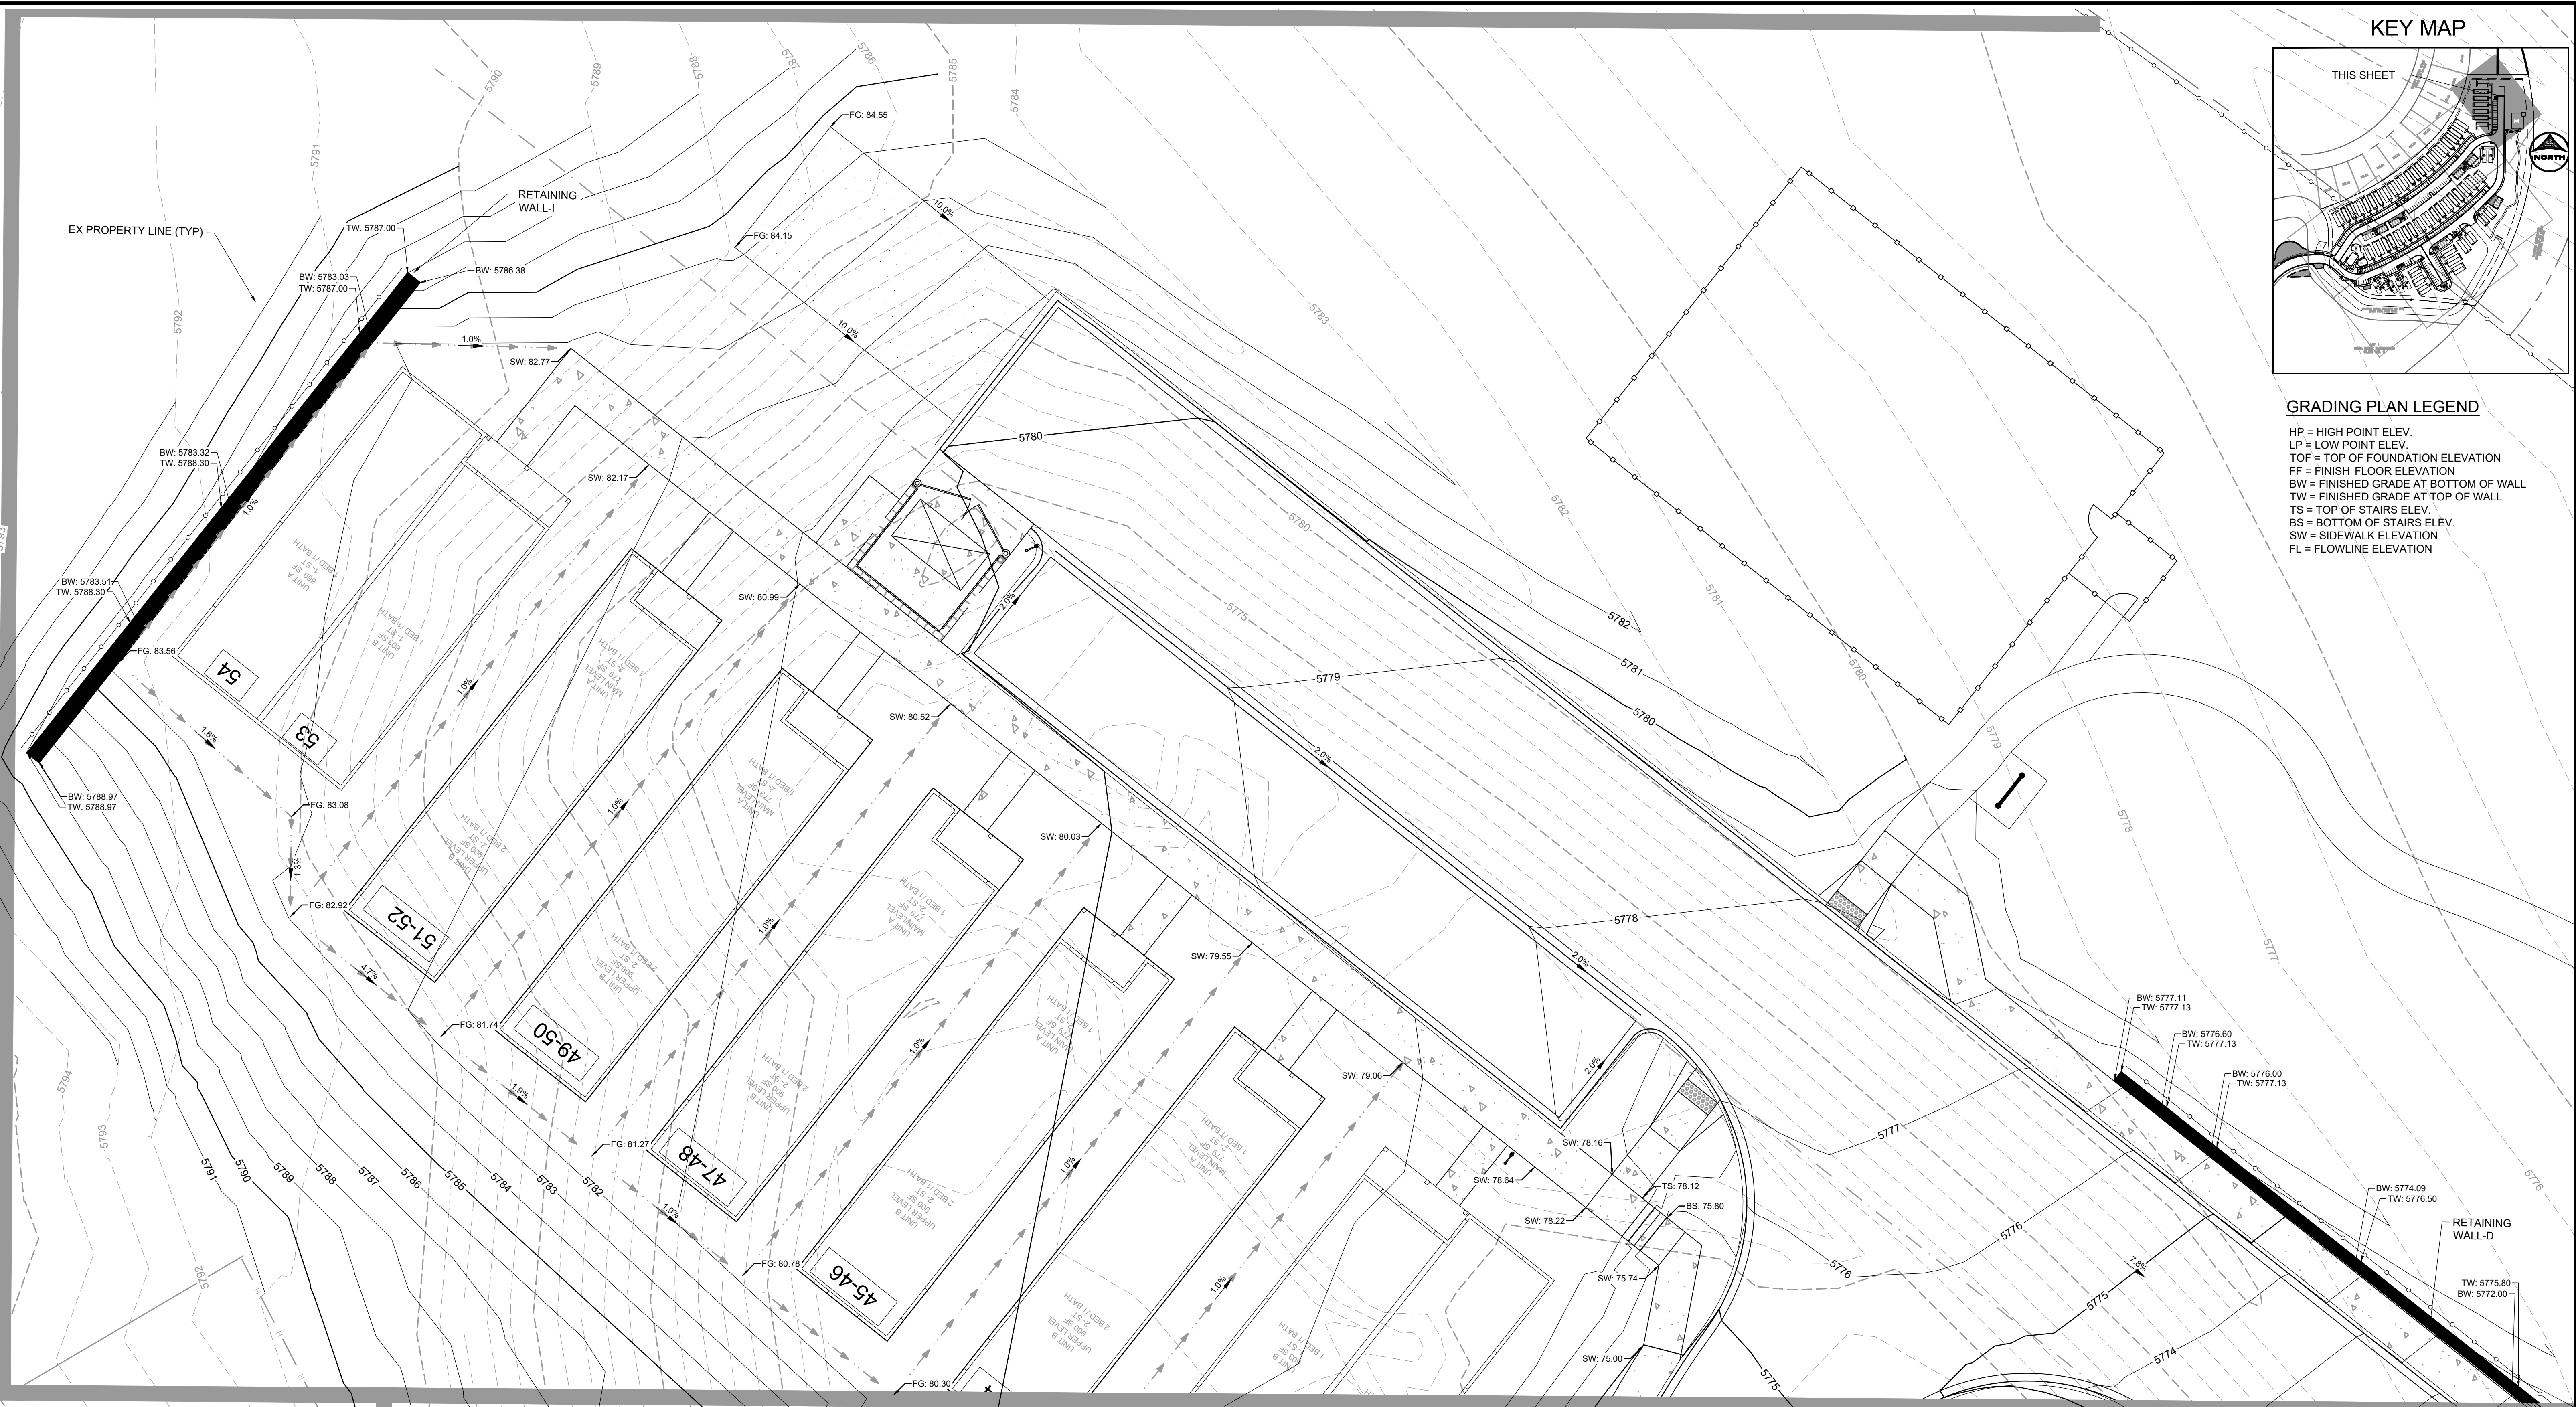

GRADING PLAN LEGEND

HP = HIGH POINT ELEV.  
LP = LOW POINT ELEV.  
TOP = TOP OF FOUNDATION ELEVATION  
FF = FINISH FLOOR ELEVATION  
BW = FINISHED GRADE AT BOTTOM OF WALL  
TW = FINISHED GRADE AT TOP OF WALL  
TS = TOP OF STAIRS ELEV.  
BS = BOTTOM OF STAIRS ELEV.  
SW = SIDEWALK ELEVATION  
FL = FLOWLINE ELEVATION

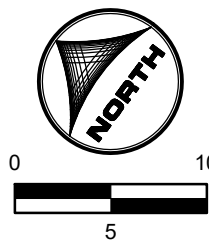

NOT FOR CONSTRUCTION

PCD FILNE NO.: SF2214

DRAWN BY: CBM	JOB DATE: 8/31/2022
APPROVED: KMH	JOB NUMBER: 200541
CAD DATE: 8/31/2022	
CAD FILE: J:\2020\200541\CAD\DWG\CD\CDIEI_Paso_ColGrading	

BAR IS ONE INCH ON OFFICIAL DRAWINGS.  
0 1"  
IF NOT ONE INCH, ADJUST SCALE ACCORDINGLY.

NO.	DATE	BY	REVISION DESCRIPTION

HR GREEN - COLORADO SPRINGS  
7222 COMMERCE CENTER DR SUITE 220  
COLORADO SPRINGS CO 80919  
PHONE: 719.300.4140 TOLL FREE: 800.728.7805  
FAX: 844.273.1057 | HRGreen.com

THE COTTAGES AT MESA RIDGE  
GOODWIN KNIGHT  
EL PASO COUNTY, COLORADO




EL PASO COUNTY CONSTRUCTION DOCUMENTS  
DETAILED GRADING

SHEET  
GR  
15






HP = HIGH POINT ELEV.  
LP = LOW POINT ELEV.  
TOF = TOP OF FOUNDATION ELEVATION  
FF = FINISH FLOOR ELEVATION  
BW = FINISHED GRADE AT BOTTOM OF WALL  
TW = FINISHED GRADE AT TOP OF WALL  
TS = TOP OF STAIRS ELEV.  
BS = BOTTOM OF STAIRS ELEV.  
SW = SIDEWALK ELEVATION  
FL = FLOWLINE ELEVATION

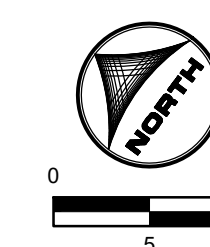

NOT FOR CONSTRUCTION

DRAWN BY: CBM JOB DATE: 8/31/2022 BAR IS ONE INCH ON  
APPROVED: KMH JOB NUMBER: 200541 OFFICIAL DRAWINGS.  
0  1"  
CAD DATE: 8/31/2022 IF NOT ONE INCH,  
CAD FILE: J:\2020\200541\CAD\dwgs\CICD\I Paso\_ColGrading ADJUST SCALE ACCORDINGLY

NO.	DATE	BY	REVISION DESCRIPTION



HR GREEN - COLORADO SPRINGS  
7222 COMMERCE CENTER DR SUITE 220  
COLORADO SPRINGS CO 80919  
PHONE: 719.300.4140 TOLL FREE: 800.728.7805  
FAX: 844.273.1057 | HRGreen.com

THE COTTAGES AT MESA RIDGE  
GOODWIN KNIGHT  
EL PASO COUNTY, COLORADO




EL PASO COUNTY CONSTRUCTION DOCUMENTS  
DETAILED GRADING

SHEET  
GR

16



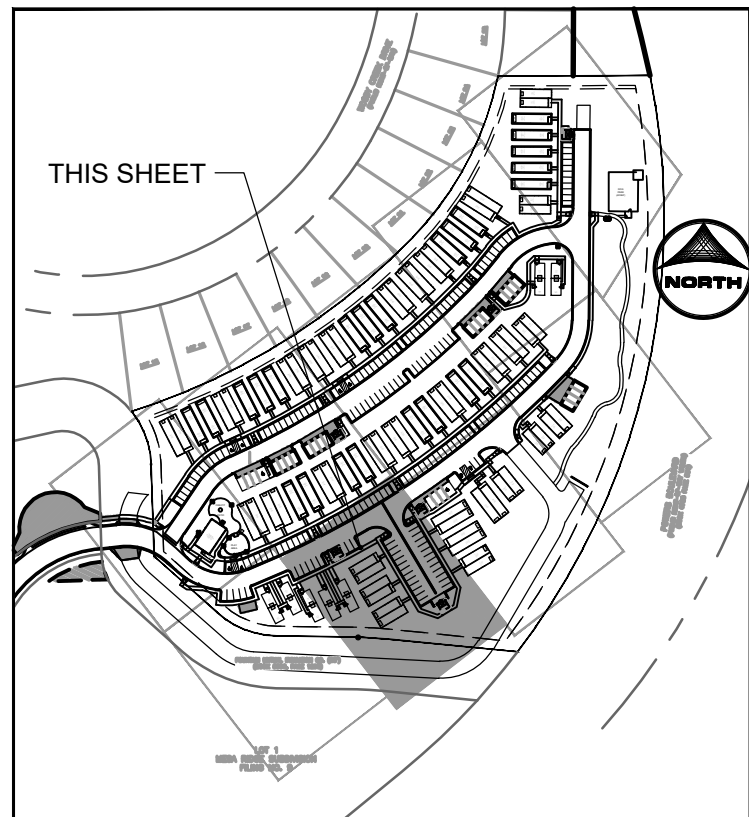

HP = HIGH POINT ELEV.  
LP = LOW POINT ELEV.  
TOF = TOP OF FOUNDATION ELEVATION  
FF = FINISH FLOOR ELEVATION  
BW = FINISHED GRADE AT BOTTOM OF WALL  
TW = FINISHED GRADE AT TOP OF WALL  
TS = TOP OF STAIRS ELEV.  
BS = BOTTOM OF STAIRS ELEV.  
SW = SIDEWALK ELEVATION  
FL = FLOWLINE ELEVATION



NO.	DATE	BY	REVISION DESCRIPTION

THE COTTAGES AT MESA RIDGE  
GOODWIN KNIGHT  
EL PASO COUNTY, COLORADO




17





A detailed site plan showing the proposed parking lot and building footprint. The parking lot is a large, irregularly shaped area with numerous parking spaces, some of which are shaded in gray. A building footprint is shown in the center of the parking lot. The plan includes a north arrow pointing towards the top right, a scale bar indicating 0, 10, and 20 feet, and a label 'THIS SHEET' pointing to the main area. The plan also shows surrounding streets, including 'W. 1st St.' and 'W. 2nd St.', and a 'Proposed' label indicating the area of the new development.


HP = HIGH POINT ELEV.  
LP = LOW POINT ELEV.  
TOF = TOP OF FOUNDATION ELEVATION  
FF = FINISH FLOOR ELEVATION  
BW = FINISHED GRADE AT BOTTOM OF WALL  
TW = FINISHED GRADE AT TOP OF WALL  
TS = TOP OF STAIRS ELEV.  
BS = BOTTOM OF STAIRS ELEV.  
SW = SIDEWALK ELEVATION  
FL = FLOWLINE ELEVATION

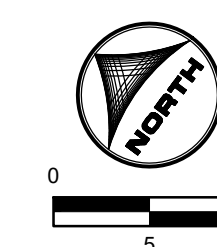

NOT FOR CONSTRUCTION

BAR IS ONE INCH ON  
OFFICIAL DRAWINGS.  
0  1"  
IF NOT ONE INCH,  
JUST SCALE ACCORDINGLY

NO.	DATE	BY	REVISION DESCRIPTION

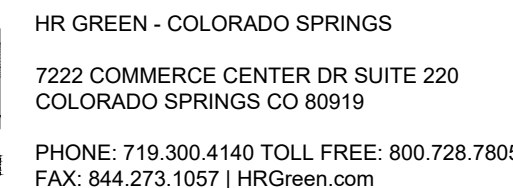

**GOODWIN  
—KNIGHT**


SHEET  
GR

18






## KEY MAP

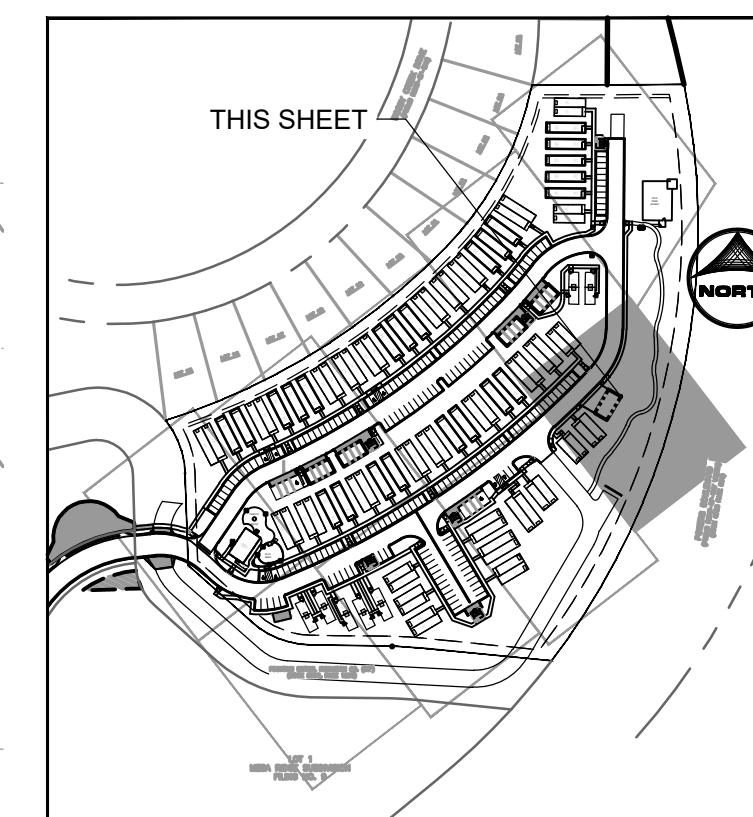


### GRADING PLAN LEGEND

HP = HIGH POINT ELEV.  
LP = LOW POINT ELEV.  
TOF = TOP OF FOUNDATION ELEVATION  
FF = FINISH FLOOR ELEVATION  
BW = FINISHED GRADE AT BOTTOM OF WALL  
TW = FINISHED GRADE AT TOP OF WALL  
TS = TOP OF STAIRS ELEV.  
BS = BOTTOM OF STAIRS ELEV.  
SW = SIDEWALK ELEVATION  
FL = FLOWLINE ELEVATION

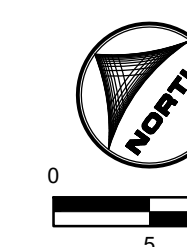

PCD FILNE NO.: SF2214

DRAWN BY: CBM JOB DATE: 8/31/2022  
APPROVED: KMH JOB NUMBER: 200541  
CAD DATE: 8/31/2022  
CAD FILE: J:\2020\200541\CAD\Drawgs\C\CD\IEI Paso\_ColGrading

BAR IS ONE INCH ON  
OFFICIAL DRAWINGS.  
0  1"  
IF NOT ONE INCH,  
ADJUST SCALE ACCORDINGLY

NO.	DATE	BY	REVISION DESCRIPTION



HR GREEN - COLORADO SPRINGS  
7222 COMMERCE CENTER DR SUITE 220  
COLORADO SPRINGS CO 80919  
PHONE: 719.300.4140 TOLL FREE: 800.728.7805  
FAX: 844.273.1057 | [HRGreen.com](http://HRGreen.com)

THE COTTAGES AT MESA RIDGE  
GOODWIN KNIGHT  
EL PASO COUNTY, COLORADO



EL PASO COUNTY CONSTRUCTION DOCUMENTS  
DETAILED GRADING

SHEET  
GR

19



FSD SANITARY SEWER CONSTRUCTION NOTES:

- ALL MATERIALS AND WORKMANSHIP SHALL BE IN CONFORMANCE WITH FOUNTAIN SANITATION DISTRICT DESIGN CRITERIA AND CONSTRUCTION SPECIFICATIONS.
- CONTRACTOR SHALL FIELD VERIFY LOCATION AND ELEVATION OF EXISTING PIPE INVERTS PRIOR TO INSTALLATION OF NEW SANITARY SEWER SYSTEM.
- THE CONTRACTOR ASSUMES RESPONSIBILITY FOR THE PROTECTION OF ALL UTILITIES DURING THE WORK. PRIOR TO ANY EXCAVATION, CONTACT THE UTILITY NOTIFICATION CENTER OF COLORADO AT 811 AT LEAST TWO WORKING DAYS PRIOR TO DIGGING.
- ALL PROPOSED SANITARY SEWER PIPELINES WITHIN THIS PROJECT SHALL BE AIR TESTED AND VIDEO INSPECTED PER THE FOUNTAIN SANITATION DISTRICT (FSD) STANDARD SPECIFICATIONS,
- ALL AS-CONSTRUCTED RECORDS AND OTHER REQUIREMENTS OF THE SUBDIVISION PUBLIC IMPROVEMENTS AGREEMENT SHALL BE COMPLETED PRIOR TO CONSIDERATION OF ACCEPTANCE OF THE SYSTEM BY THE DISTRICT,
- DURING THE CONSTRUCTION OF THE SANITARY SEWER SYSTEM THE CONTRACTOR SHALL HAVE IN HIS/HER POSSESSION AT LEAST ONE "APPROVED FOR CONSTRUCTION" SET OF UPDATED PLANS AT ALL TIMES. APPROVED FIELD MODIFICATIONS TO PLAN SETS SHALL BE CLEARLY IDENTIFIED IN RED INK ON THE PLANS BY THE CONTRACTOR PER FIELD CONSTRUCTION. THESE AS-BUILT CHANGES SHALL BE DATED AND SUBMITTED TO THE ENGINEER OF RECORD. THE ENGINEER OF RECORD SHALL PREPARE A COMPLETE SET OF "AS CONSTRUCTED" DRAWINGS AND DELIVER THE SETS TO THE FOUNTAIN SANITATION DISTRICT PRIOR TO FINAL ACCEPTANCE OF THE SANITARY SEWER SYSTEM.
- WITH PRIOR APPROVAL, THE CONTRACTOR SHALL PROVIDE 3 DEGREE BENDS ON ALL CURVILINEAR SANITARY SEWER PIPE AT THE LOCATIONS DETAILED ON THE APPROVED CONSTRUCTION PLANS.
- SANITARY SEWER SERVICE LINES SHALL BE LOCATED PER THE DETAIL ON THE UTILITY SERVICE PLAN, THE DIMENSIONS GIVEN AT EACH LOT WHERE A TYPICAL INSTALLATION IS REQUIRED OR AT THE DIRECTION OF THE FOUNTAIN SANITATION DISTRICT REPRESENTATIVE.
- SERVICE STUBS SHALL BE INSTALLED A MINIMUM OF TEN (10) FEET INTO THE PROPERTY, UNLESS OTHERWISE SHOWN, AND THE END OF THE STUB SHALL BE MARKED WITH A 2"X4"X12' STEEL OR WOODEN POST PAINTED GREEN.
- OVERLOT GRADING AND STREET SUBGRADE MUST BE WITHIN ± ONE (1) FOOT PRIOR TO ANY UTILITY INSTALLATION.
- CONTRACTOR TO CONSTRUCT ALL MANHOLES AND STRUCTURES TO FINISHED GRADE.
- ALL SANITARY SERVICE PIPE TO BE GREEN GASKET SDR35.
- ALL 3' BENDS SHALL BE A SPIGOT X BELL FITTING. THE SPIGOT END OF EACH BEND FITTING SHALL BE INSERTED IN THE BELL OF A FULL PIECE (13 FEET) OF ASTM D3034 FOR PVC, SDR 26 OR 35 PIPE WITH THE SUBSEQUENT UPSTREAM PIPE SEGMENT BEING A FULL PIECE OF PIPE. EACH JOINT OF PIPE MAY BE DEFLECTED TO A MINIMUM RADIUS OF 200 FEET IN CONFORMANCE WITH THE MANUFACTURER'S SPECIFICATIONS BETWEEN EACH BEND FITTING. THE CONTRACTOR SHALL USE EXTREME CARE AND EXPERT WORKMANSHIP TO PROVIDE PROPER HORIZONTAL AND VERTICAL ALIGNMENT THROUGH SECTIONS WITH 3' BENDS.
- MINIMUM RADIUS FOR SANITARY SEWER WITHOUT JOINT FITTINGS IS 267 FEET USING A 14-FOOT-LONG PIPE SEGMENT.
- CONTRACTOR SHALL BE AWARE THAT WHEN DEBRIS IS DROPPED INTO MANHOLES AND OTHER STRUCTURES, THEY ARE TO IMMEDIATELY REMOVE THIS TO ELIMINATE THE POSSIBILITY OF PROPERTY DAMAGE DUE TO THE DEBRIS-CAUSING BACKUP INTO PRIVATE PROPERTIES. IF AND WHEN IT IS DETERMINED THAT DEBRIS CAUSED A BACKUP, THE CONTRACTOR SHALL BE HELD RESPONSIBLE FOR DAMAGES.
- NO TREES ARE TO BE PLANTED WITHIN ANY SEWER EASEMENT OR WITHIN FIFTEEN (15) FEET OF ANY MANHOLE OR PIPE.
- ACCESS TO MANHOLES AND INLETS SHALL BE MADE AVAILABLE FOR MAINTENANCE PURPOSES.
- ALL MANHOLES SHALL RECEIVE AN EXTERIOR WATERPROOF COATING OF COAL TAR EPOXY, ICS DEVCOE "DEV TAR," OR APPROVED EQUIVALENT.
- ALL MANHOLES SHALL RECEIVE AN EXTERIOR JOINT WRAP TO BEST ASSURE WATERTIGHTNESS. REFER TO THE FOUNTAIN SANITATION DISTRICT STANDARD SPECIFICATIONS FOR MATERIALS AND INSTALLATION REQUIREMENTS.
- ALL SANITARY SEWER MANHOLES ON THIS PROJECT SHALL BE SUBJECT TO VACUUM TESTING PRIOR TO THE CONSIDERATION OF ACCEPTANCE BY THE DISTRICT. AT THE DISTRICT'S SOLE OPTION, ADDITIONAL VACUUM TESTING MAY BE REQUIRED DURING AND PRIOR TO THE CONCLUSION OF THE WARRANTY PERIOD FOR THIS WORK. REFER TO THE FOUNTAIN SANITATION DISTRICT STANDARD SPECIFICATIONS FOR TESTING REQUIREMENTS.
- CLASS "B" GRANULAR BEDDING SHALL BE UTILIZED FOR ALL WASTEWATER PIPELINE CONSTRUCTION ON THIS PROJECT. AS A MINIMUM, THE CLASS "B" BEDDING SHALL BE COMPRISED OF 3/4-INCH CRUSHED ROCK. LARGER AGGREGATE AND/OR ALTERNATIVE GRADATIONS MAY BE NECESSARY IN ORDER TO ADDRESS TRENCH SUBGRADE STABILIZATION CONDITIONS FOUND UPON EXCAVATION OF THE TRENCH IN ADDITION TO THE SPECIFIED CLASS "B" PIPE BEDDING.
- WHERE NECESSARY, THE CONTRACTOR SHALL PROVIDE 3' BENDS ON ALL CURVILVEAR SANITARY SEWER PIPE AT THE LOCATIONS SHOWN ON THE PLANS.
- SANITARY SEWER PIPE SHALL BE POLYVINYL CHLORIDE (PVC), SDR 35, IN ACCORDANCE WITH ASTM D3034 FOR DEPTHS UP TO SIXTEEN (16) FEET. SANITARY SEWER LINES WITH COVER EXCEEDING SIXTEEN (16) FEET FROM FINISHED GRADE SHALL BE POLYVINYL CHLORIDE (PVC), SDR 26, IN ACCORDANCE WITH ASTM D3034. ALL SDR 26 PIPE SHALL BE BEDDED IN CLASS B BEDDING MATERIAL OR WITH RECLAIMED CONCRETE MATERIAL MEETING SANITATION DISTRICT STANDARD.
- MANHOLES SHALL BE STANDARD PRECAST CONCRETE.
- ALL SANITARY SEWER MANHOLES SHALL NOT HAVE ANY ACCESS STEPS INSTALLED INSIDE THE MANHOLE. ANY PRECAST SANITARY MANHOLES WITH STEPS SHALL HAVE THE STEPS REMOVED BY SAW CUTTING STEPS FLUSH TO THE MANHOLE AND ADDING EPOXY TO THE CUT ENDS OF THE STEPS.
- SANITARY SEWER MH COVERS SHALL BE LOCATED ALONG THE CENTERLINE OF THE STREET OR AS CLOSE TO THE CENTERLINE AS IS PRACTICAL.
- IF GROUNDWATER IS ENCOUNTERED DURING TRENCHING THEN THE TRENCH SHALL BE OVEREXCAVATED AND DEWATERED. WELL POINTS SHALL BE PLACED AS NECESSARY TO PREVENT WATER IN THE TRENCH. THE GROUNDWATER LEVEL SHALL BE KEPT 12-INCHES OR MORE BELOW THE UTILITY BEING INSTALLED. OVEREXCAVATED TRENCH DEPTH SHALL BE BACKFILLED WITH 2-INCH MINUS ROCK WITH <5% PASSING NO. 4 SIEVE. DEWATERING SHALL CONTINUE UNTIL SUCH TIME AS IT IS SAFE TO ALLOW THE WATER TABLE TO RISE IN THE EXCAVATION. PIPE TRENCHES SHALL CONTAIN ENOUGH BACKFILL TO PREVENT PIPE FLOATATION.
- IN AREAS WHERE SANITARY SEWER WILL BE PLACED ON FILL THE CONTRACTOR SHALL SUPPLY THE FOUNTAIN SANITATION DISTRICT WITH SOIL DENSITY REPORTS PRIOR TO COMMENCING CONSTRUCTION OF THE PIPELINES. THE DENSITY REPORTS SHALL DEMONSTRATE THAT ALL FILLS PLACED WITHIN PIPELINE CONSTRUCTION SHALL BE COMPACTED TO A MINIMUM OF 95% STANDARD PROCTOR DENSITY OR PER GEOTECHNICAL RECOMMENDATION, WHICHEVER STANDARD IS STRICTER. ADDITIONALLY, FILLS SHALL BE PLACED TO A MINIMUM OF 6' ABOVE THE TOP OF THE PROPOSED PIPE PRIOR TO CONSTRUCTION OF THE PIPELINES.
- THE SANITARY SEWER SERVICES TO BE CONSTRUCTED IN THIS PROJECT SHALL BE CONNECTED TO THE MAIN WITH IN-LINE WYE FITTINGS IN ACCORDANCE WITH FOUNTAIN SANITATION DISTRICT DESIGN CRITERIA AND CONSTRUCTION SPECIFICATIONS. EACH WYE FITTING WILL BE LOCATED NO LESS THAN 3- FEET CLEAR FROM AN ADJACENT SERVICE LINE WYE FITTING. IF TWO (2) SERVICE LINES ARE LOCATED ON THE SAME SIDE OF THE WASTEWATER COLLECTION SYSTEM MAIN, THERE SHALL BE NO LESS THAN 4 FEET OF SPACE BETWEEN THE TWO SEPARATE SEWER SERVICE PIPELINES TO FACILITATE FUTURE EXCAVATION OF EACH WITHOUT DISTURBANCE.
- ALL SANITARY SEWER MAINS AND PIPELINES SHALL BE CONSTRUCTED WITH COPPER TRACER WIRE, 6 GAUGE SOLID COPPER, EXTENDING FROM THE MANHOLE-TO-MANHOLE ON THE MAIN LINES. IN ADDITION, A COPPER TRACER WIRE SHALL EXTEND ALONG EACH SERVICE LINE, CONNECTED TO THE MAIN LINE COPPER TRACER WIRE, TO A LOCATION NO LESS THAN 10 FEET INSIDE THE LOT FRONTAGE. THE TRACER WIRES WILL BE CONTINUED AT THE TIME OF BUILDING SEWER CONSTRUCTION SUBJECT TO THE INSPECTION OF THE FOUNTAIN SANITATION DISTRICT.
- THE TRACER WIRE WILL EXTEND UP THE OUTSIDE OF EACH MANHOLE AND BE INSERTED INTO THE MANHOLE INTERIOR UNDER ADJUSTING RINGS SET ON THE CONE WITH NO LESS THAN 1.5 FEET OF CONDUCTOR COILED AT THE MANHOLE INTERIOR.

FSD SANITARY SERVICE PLAN NOTES:

- ALL CONSTRUCTION METHODS AND MATERIALS SHALL MEET FOUNTAIN SANITATION DISTRICT STANDARD SPECIFICIATIONS.
- FINAL LOCATION OF ALL SEWER, WATER AND GAS SERVICES TO BE APPROVED IN THE FIELD BY THE CONSTRUCTION MANAGER AND DISTRICT INSPECTOR PRIOR TO INSTALLATION.
- PROPERTY END OF ALL SEWER SERVICES TO BE MARKED WITH A 12"x2"x4" STEEL OR WOODEN POST EXTENDING VERTICALLY FROM THE FLOWLINE.
- UTILITY LOCATIONS, WHETHER OR NOT SHOWN ON THIS PLAN, IN NO WAY RELIEVES THE CONTRACTOR FROM THE RESPONSIBILITY FOR CALLING FOR UTILITY LOCATIONS FROM THE APPROPRIATE AUTHORITIES PRIOR TO BEGINNING EXCAVATION. THE CONTRACTOR SHALL BE RESPONSIBLE TO LOCATE AND PROTECT ALL EXISTING UTILITIES WITHIN THE PROJECT. ANY DAMAGE TO EXISTING UTILITIES SHALL BE IMMEDIATELY REPAIRED AT THE CONTRACTOR'S SOLE EXPENSE.
- REUSE OF ANY MATERIAL IS AT THE DISCRETION OF THE DISTRICT INSPECTOR.
- ALL SANITARY SERVICES TO BE INSTALLED AT THE MINIMUM PERMISSIBLE GRADE OF 2.08% UNLESS OTHERWISE PRE-APPROVED BY THE FOUNTAIN SANITATION DISTRICT.
- ALL SANITARY SERVICE PIPE SHALL BE GREEN GASKETED SDR35.
- SANITARY SEWER SERVICE CONNECTIONS ARE TO BE A MINIMUM OF 5' FROM THE MANHOLE.
- THE CONTRACTOR SHALL NOTIFY FOUNTAIN SANITATION DISTRICT'S INSPECTOR (382- 5303) 48 HOURS PRIOR TO THE START OF CONSTRUCTION TO OUTLINE METHODS OF CONSTRUCTION, MATERIALS TO BE USED AND CONSTRUCTION STAKING.
- ALL SANITARY SEWER SERVICE LINES TO THE RESIDENTIAL LOTS SHALL BE 4-INCH DIAMETER PIPE. SEWER SERVICES SHALL BE EXTENDED 10' INTO THE RESIDENTIAL LOTS TO AVOID GAS, ELECTRIC AND WATER EASEMENTS ADJACENT TO THE RIGHT OF WAY.
- ALL TRENCH BACKFILL AND COMPACTION SHALL BE IN ACCORDANCE WITH SECTION PART C, ARTICLE II OF THE FOUNTAIN SANITATION DISTRICT STANDARD SPECIFICATIONS MANUAL.

FSD GENERAL SERVICE PLAN NOTES

THE CONTRACTOR SHALL NOTIFY THE FOUNTAIN SANITATION DISTRICT OFFICE (719-382-5303) A MINIMUM OF 48 HOURS PRIOR TO THE START OF CONSTRUCTION.

GENERAL:

- ALL CONSTRUCTION METHODS AND MATERIALS SHALL MEET FOUNTAIN SANITATION DISTRICT STANDARD SPECIFICIATIONS.
- FOUNTAIN SANITATION DISTRICT DOES NOT GUARANTEE THE ACCURACY OF LOCATIONS OF EXISTING PIPELINES, MANHOLES, AND SERVICE LINES. IF FIELD CONDITIONS ARE FOUND TO BE DIFFERENT THAN SHOWN ON THE PLANS, THE CONTRACTOR SHALL NOTIFY THE DISTRICT INSPECTOR AND THE DESIGN ENGINEER IMMEDIATELY.
- THE CONTRACTOR IS RESPONSIBLE FOR ANY DAMAGE TO ANY UTILITY FACILITIES AS A RESULT OF THEIR ACTIONS. THE CONTRACTOR SHALL MAKE ALL THE REQUIRED REPAIRS IMMEDIATELY TO THE SATISFACTION OF FOUNTAIN SANITATION DISTRICT.
- ALL FIELD STAKING SHALL COMPLY WITH THE WASTEWATER STANDARD SPECIFICATIONS.
- FINAL LOCATION OF ALL WASTEWATER SERVICES SHALL BE APPROVED IN THE FIELD BY THE DISTRICT INSPECTOR.
- ALL TRENCH BACKFILL AND COMPACTION SHALL BE IN ACCORDANCE WITH SECTION PART C, ATRICLE II OF THE FOUNTAIN SANITATION DISTRICT STANDARD SPECIFICATIONS MANUAL.

WIDEFIELD WATER AND SANITATION DISTRICT GENERAL NOTES

- ALL UTILITY CONSTRUCTION TO BE CONDUCTED IN CONFORMANCE WITH THE CURRENT WIDEFIELD WATER AND SANITATION DISTRICT SPECIFICATIONS. COMPACTION REQUIREMENTS SHALL BE 95% STANDARD PROCTOR AS DETERMINED BY ASTM D698, UNLESS OTHERWISE APPROVED BY THE WIDEFIELD WATER AND SANITATION DISTRICT OR A HIGHER STANDARD IS IMPOSED BY ANOTHER AGENCY HAVING RIGHT-OF-WAY JURISDICTION.
- ALL MATERIALS AND WORKMANSHIP SHALL BE SUBJECT TO INSPECTION BY THE WIDEFIELD WATER AND SANITATION DISTRICT. THE WIDEFIELD WATER AND SANITATION DISTRICT RESERVES THE RIGHT TO ACCEPT OR REJECT ANY SUCH MATERIALS AND WORKMANSHIP THAT DOES NOT CONFORM TO ITS STANDARDS AND SPECIFICATIONS.
- THE DEVELOPER OR HIS ENGINEER HAS LOCATED ALL FIRE HYDRANTS AND FUTURE SERVICE STUBS. ANY REQUIRED REALIGNMENT, EITHER HORIZONTAL OR VERTICAL, SHALL BE AT THE EXPENSE OF THE DEVELOPER.
- ALL DUCTILE IRON PIPE, TO INCLUDE FITTINGS, VALVES AND FIRE HYDRANTS WILL BE WRAPPED WITH POLYETHYLENE TUBING, AND ELECTRICALLY ISOLATED.
- ALL DUCTILE IRON PIPE AND FITTINGS SHALL BE DOUBLE BONDED. SPECIFICATIONS FOR CATHODIC PROTECTION ON BOTH DIP MAINS AND PVC MAINS IS SPECIFIED IN THE STANDARDS AND SPECIFICATIONS.
- PVC MAIN LINES SHALL BE INSTALLED WITH COATED NO. 12 TRACER WIRE.
- THE CONTRACTOR IS REQUIRED TO NOTIFY THE WIDEFIELD WATER AND SANITATION DISTRICT (390-7111) A MINIMUM OF 48 HOURS AND A MAXIMUM OF 96 HOURS PRIOR TO THE START OF CONSTRUCTION. THE CONTRACTOR SHALL ALSO NOTIFY AFFECTED UTILITY COMPANIES 48 HOURS PRIOR TO CONSTRUCTION ADJACENT TO THE KNOWN UTILITY LINES.
- THE LOCATION OF ALL UTILITIES AS SHOWN ON THESE DRAWINGS ARE APPROXIMATE ONLY. THE LOCATION OF ALL UTILITIES SHALL BE VERIFIED PRIOR TO CONSTRUCTION BY THE CONTRACTOR.
- THE CONTRACTOR SHALL FIELD EXCAVATE AND VERIFY THE VERTICAL AND HORIZONTAL LOCATION OF ALL TIE-INS. CONTRACTOR SHALL NOTIFY THE WIDEFIELD WATER AND SANITATION DISTRICT AND THE ENGINEER OF THE FIELD VERIFIED INFORMATION PRIOR TO CONSTRUCTION.
- ALL BENDS SHALL BE FIELD STAKED PRIOR TO CONSTRUCTION.
- ANY WATER UTILITY MATERIAL REMOVED AND NOT REUSED SHALL BE RETURNED TO THE WIDEFIELD WATER AND SANITATION DISTRICT IF THE DISTRICT SO REQUESTS.
- THE CONTRACTOR SHALL AT HIS EXPENSE SUPPORT AND PROTECT ALL UTILITY MAINS SO THAT THEY WILL FUNCTION CONTINUOUSLY DURING CONSTRUCTION. SHOULD A UTILITY MAIN FAIL AS A RESULT OF THE CONTRACTOR'S OPERATION, IT WILL BE REPLACED IMMEDIATELY BY EITHER THE CONTRACTOR OR THE WIDEFIELD WATER AND SANITATION DISTRICT AT FULL COST OF LABOR AND MATERIALS TO THE CONTRACTOR.
- ANY PUMPING OR BYPASS OPERATIONS MUST BE REVIEWED AND APPROVED PRIOR TO EXECUTION BY BOTH THE WIDEFIELD WATER AND SANITATION DISTRICT AND THE ENGINEER.
- CONTRACTOR MUST REPLACE OR REPAIR ANY DAMAGE TO ALL SURFACE IMPROVEMENTS, INCLUDING BUT NOT LIMITED TO FENCES, CURB AND GUTTER AND/OR ASPHALT THAT MAY BE CAUSED DURING CONSTRUCTION.
- ALL WATER LINES 6" AND LARGER, AND ALL SEWER LINES 8" AND LARGER, SHALL HAVE AS "AS-BUILT" PLANS PREPARED AND APPROVED PRIOR TO FINAL ACCEPTANCE BY THE WIDEFIELD WATER AND SANITATION DISTRICT.
- PRIOR TO CONSTRUCTION, A PRE-CONSTRUCTION CONFERENCE IS REQUIRED A MINIMUM OF 72 HOURS IN ADVANCE OF COMMENCEMENT OF WORK. TO SET THE PRE-CONSTRUCTION CONFERENCE, CONTACT BRANDON BERNARD-WATER DIVISION MANAGER AND/OR JASON DREESSEN, WASTEWATER DIVISION MANAGER AT (719)955-0548 OF THE WIDEFIELD WATER AND SANITATION DISTRICT FOR A TIME. NO PRE-CONSTRUCTION CONFERENCE TIMES WILL BE SET UNTIL 4 SETS OF SIGNED DRAWINGS ARE RECEIVED BY THE WIDEFIELD W & S DISTRICT. PRE-CONSTRUCTION DATE/INITIALS ----- .

DRAWN BY: CBM

APPROVED: KMH

CAD DATE: 8/31/2022

CAD FILE: J:\2020\200541\CADD\dwgs\C\CDIEI\_Paso\_Co\Notes

JOB DATE: 8/31/2022


JOB NUMBER: 200541

BAR IS ONE INCH ON OFFICIAL DRAWINGS.

0" 1"

IF NOT ONE INCH, ADJUST SCALE ACCORDINGLY.

NO.	DATE	BY	REVISION DESCRIPTION



HR GREEN - COLORADO SPRINGS

7222 COMMERCE CENTER DR SUITE 220

COLORADO SPRINGS CO 80919

PHONE: 719.300.4140 TOLL FREE: 800.728.7805

FAX: 844.273.1057 | HRGreen.com

THE COTTAGES AT MESA RIDGE

GOODWIN KNIGHT

EL PASO COUNTY, COLORADO



PCD FILNE NO.: SF2214

EL PASO COUNTY CONSTRUCTION DOCUMENTS

NOTES WATER AND SANITARY SEWER

SHEET

----


20

NOT FOR CONSTRUCTION







PCD FILNE NO.: SF2214

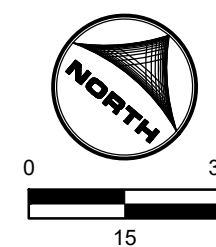

NOT FOR CONSTRUCTION

21



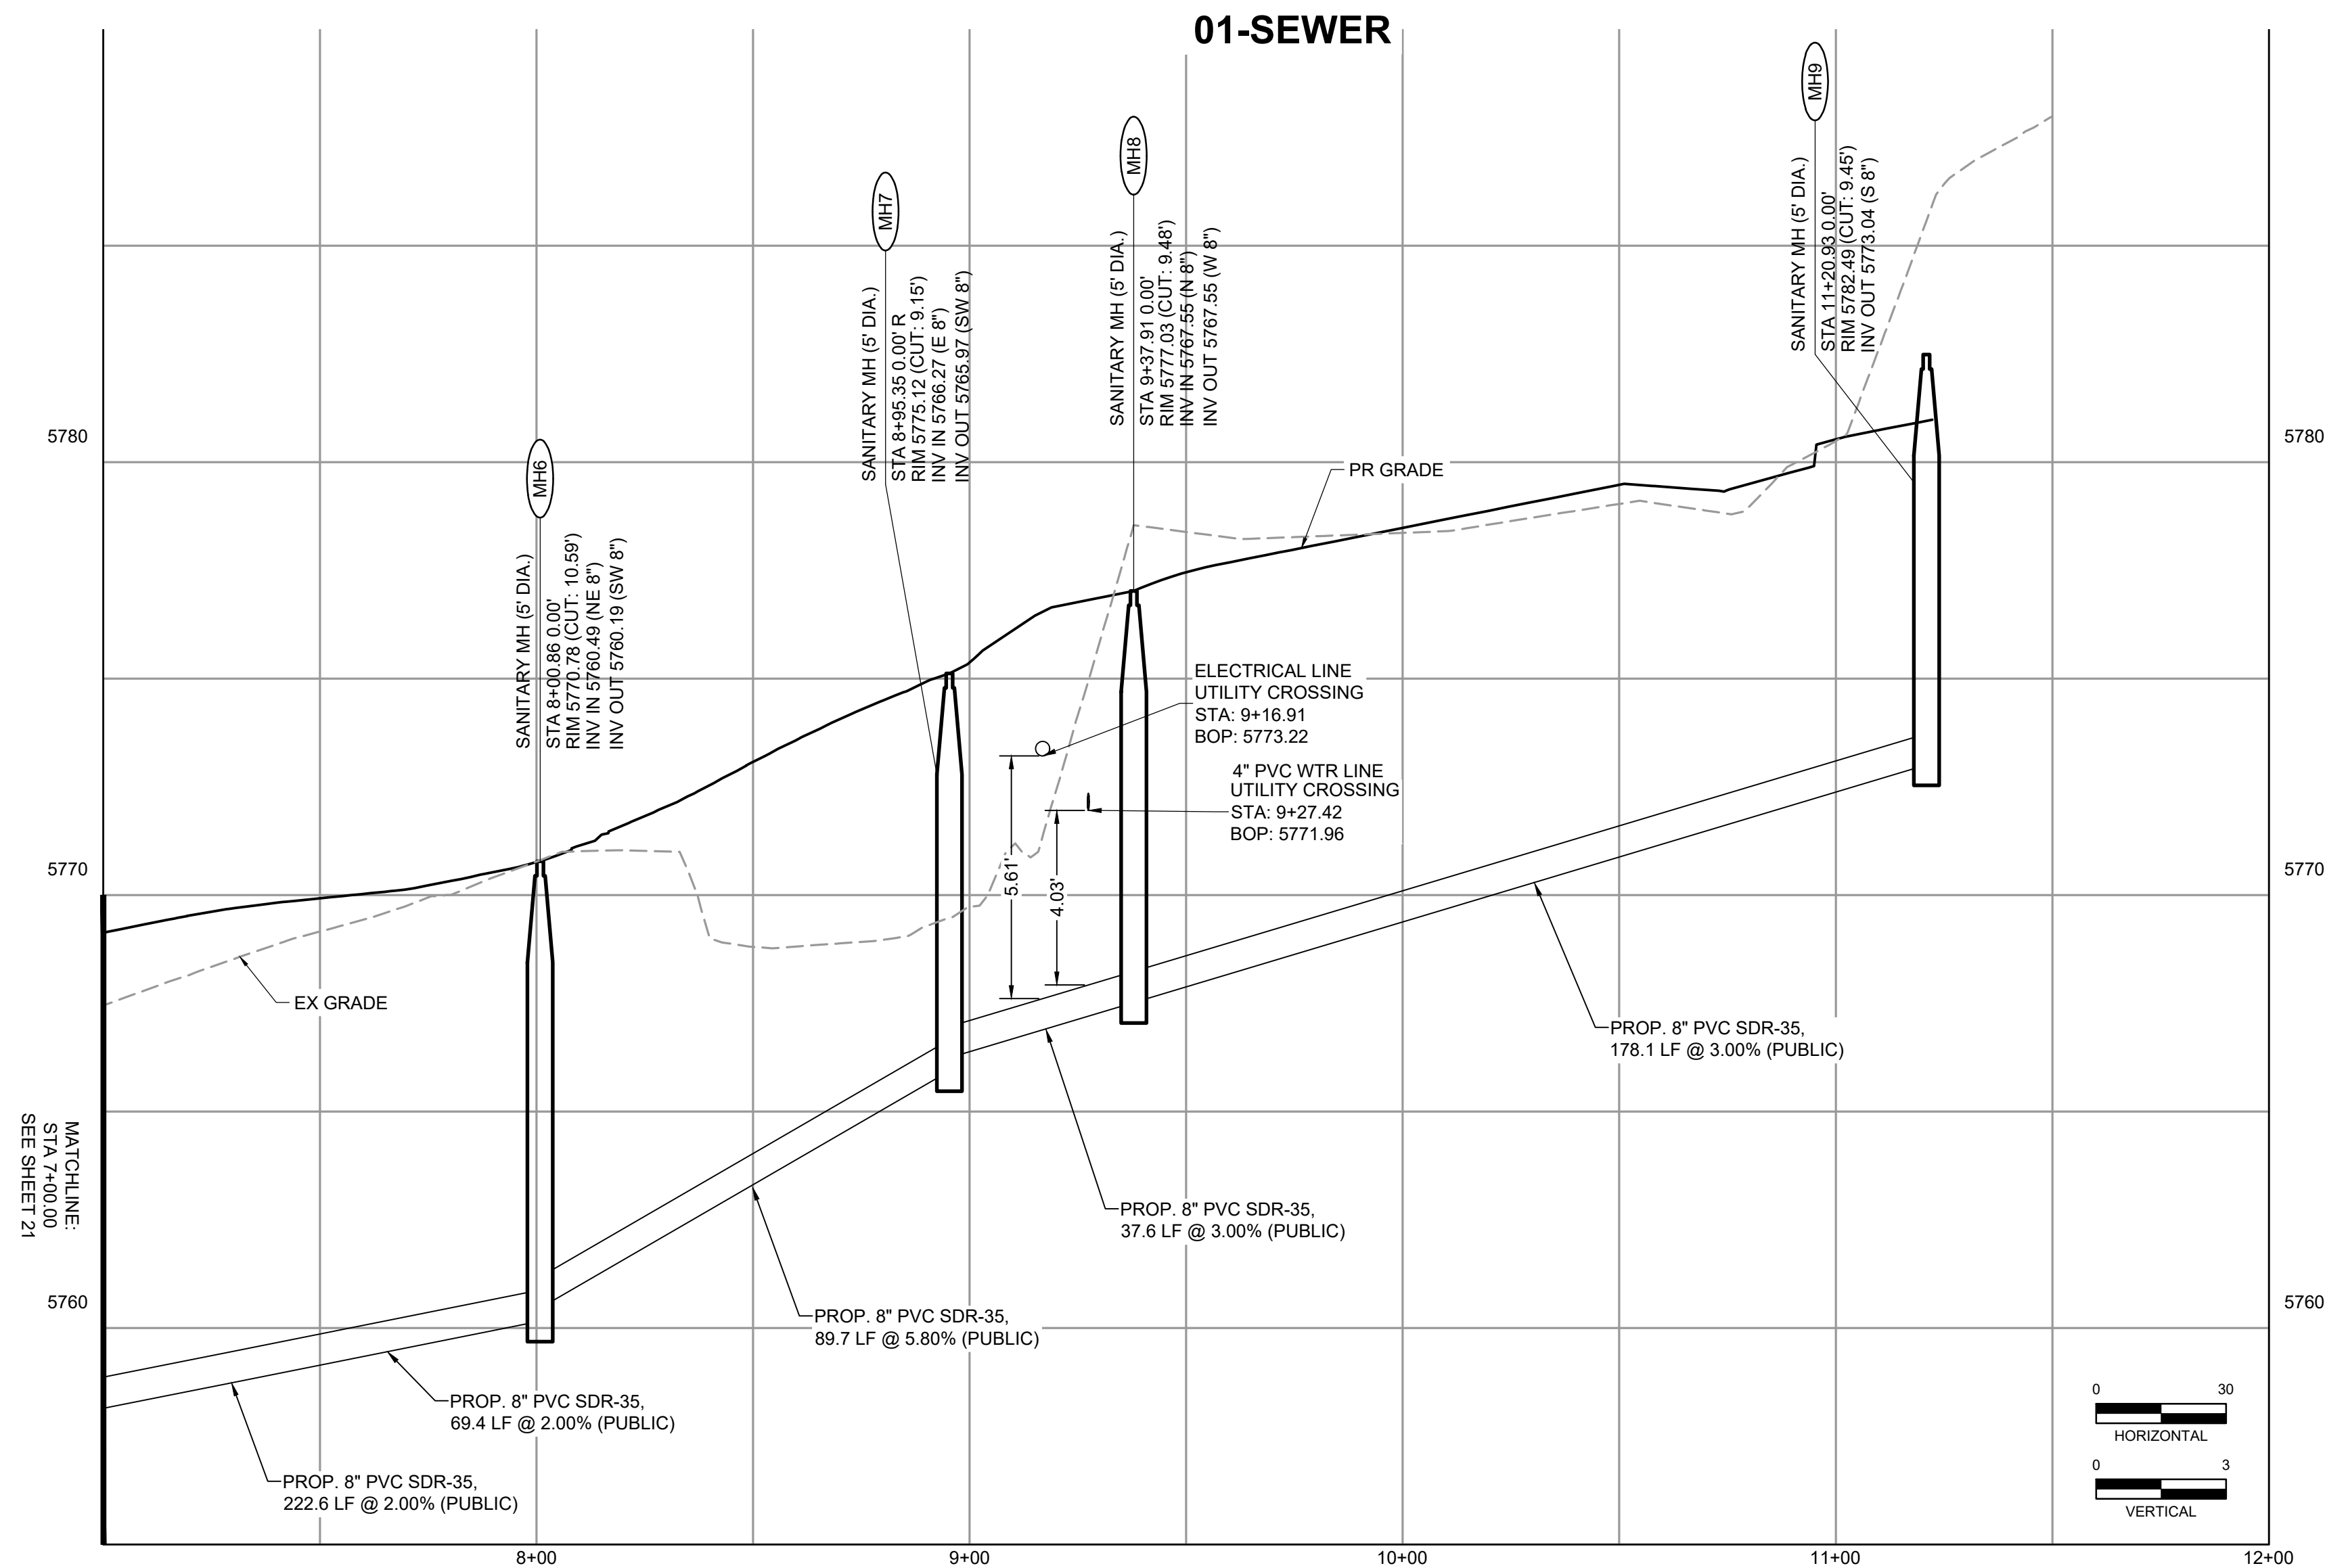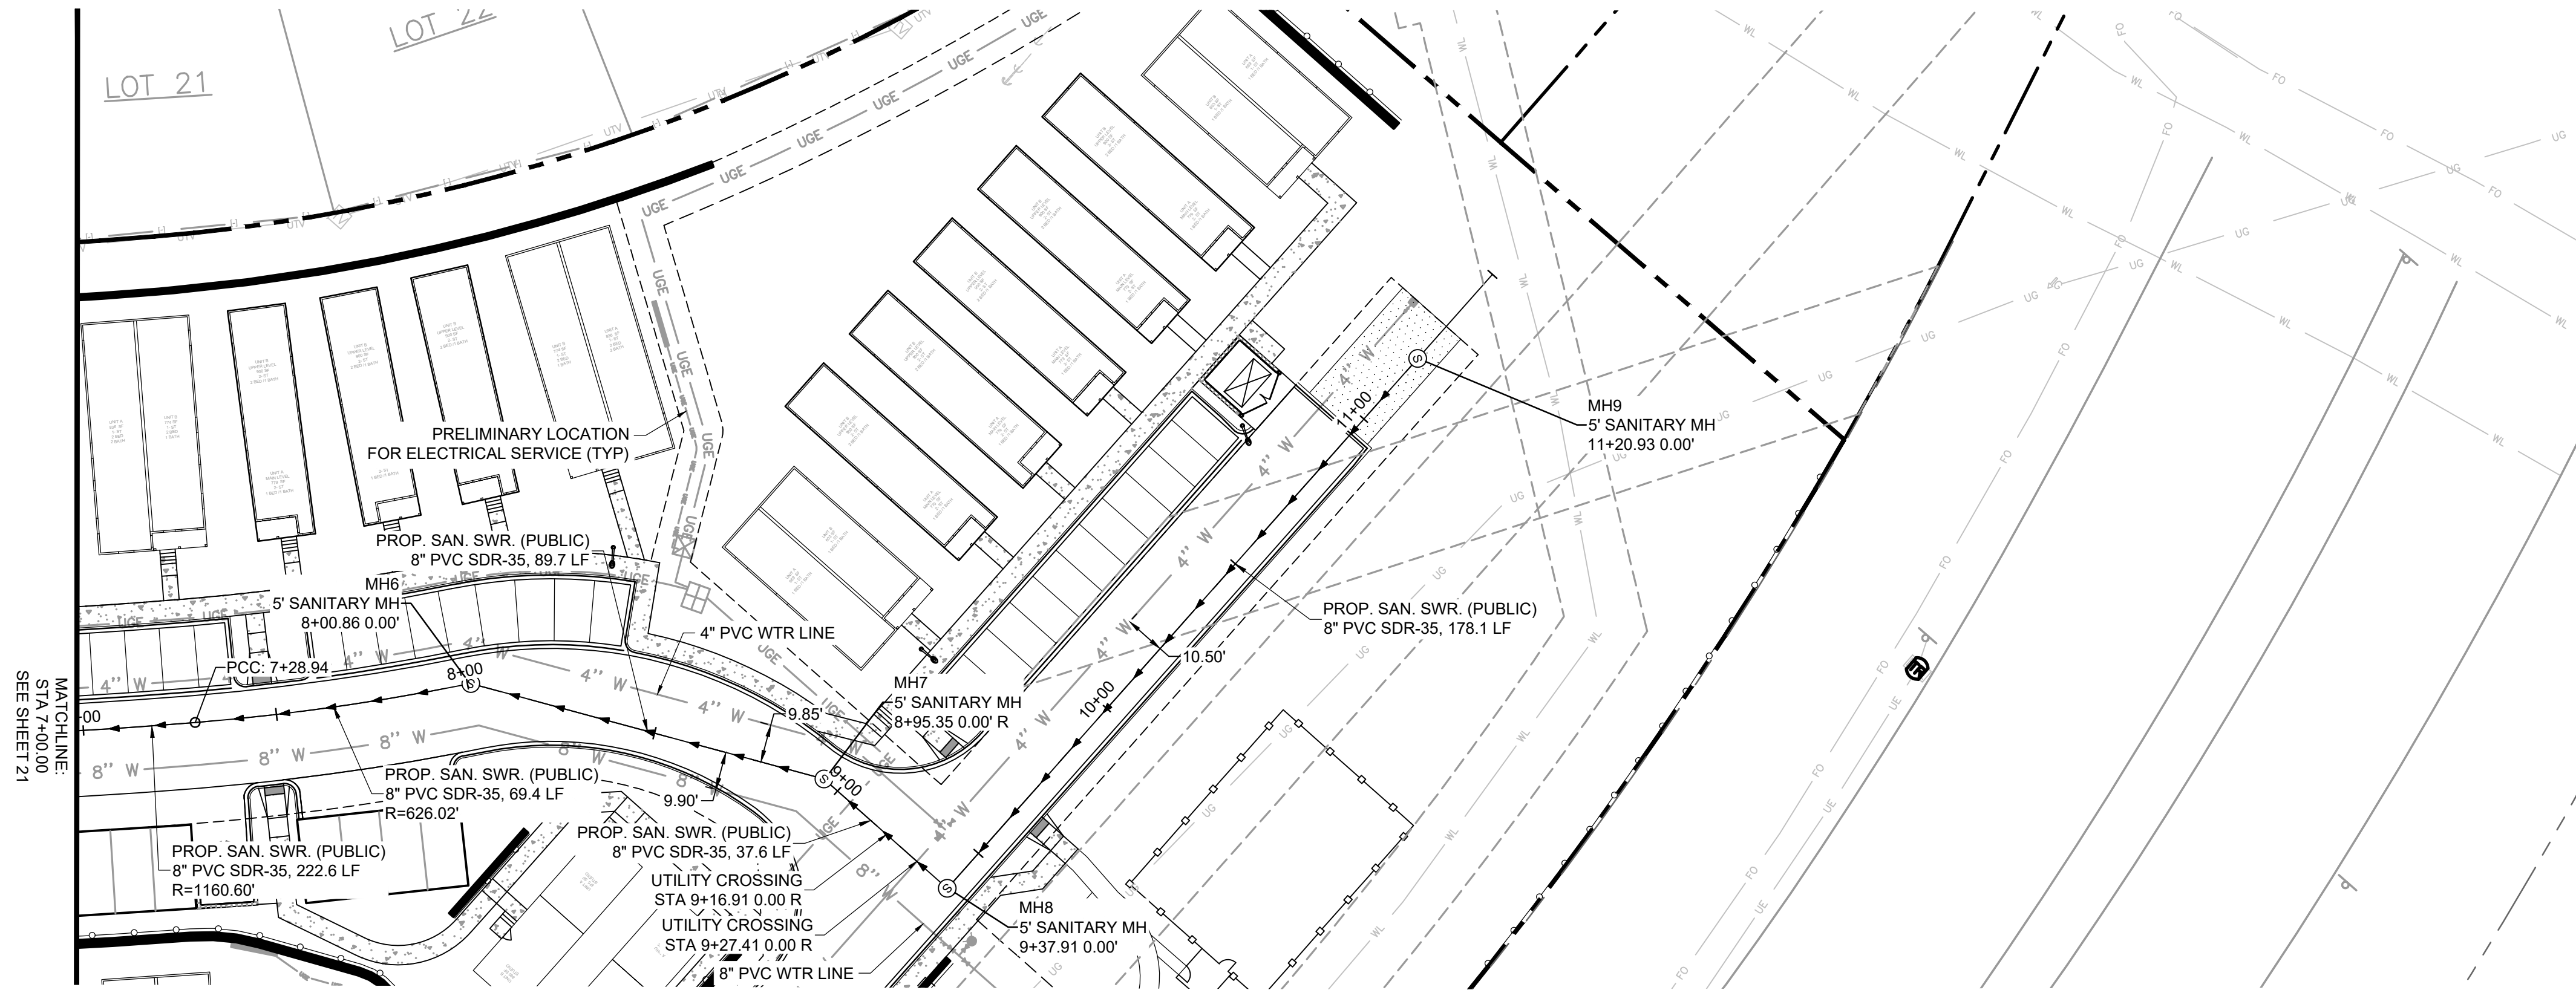

**DEVELOPERS STATEMENT - FOUNTAIN SANITATION DISTRICT**

THE OWNER WILL COMPLY WITH THE REQUIREMENTS OF FOUNTAIN SANITATION DISTRICT REGULATIONS AND STANDARD SPECIFICATIONS. OWNER WILL COMPLY WITH THE CONSTRUCTION DRAWINGS PREPARED BY HIS/HER CIVIL ENGINEER.

DEVELOPER/OWNER SIGNATURE: \_\_\_\_\_ DATE: \_\_\_\_\_

NAME OF DEVELOPER/OWNER: \_\_\_\_\_

TITLE: \_\_\_\_\_


PHONE: \_\_\_\_\_

ADDRESS: \_\_\_\_\_

**FOUNTAIN SANITATION DISTRICT**

PLANS ARE RECOMMENDED FOR USE IN CONSTRUCTION OF WASTEWATER COLLECTION SYSTEM FOR THIS PROJECT. DESIGN ENGINEER OF RECORD TAKES SOLE RESPONSIBILITY FOR ALL DESIGN ASPECTS OF THE PROJECT.

JONATHAN MOORE, P.E. \_\_\_\_\_ DATE: \_\_\_\_\_  
FOUNTAIN SANITATION DISTRICT – DISTRICT ENGINEER

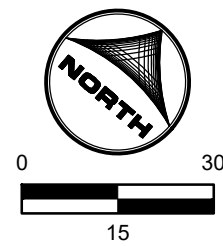

NOT FOR CONSTRUCTION

DRAWN BY: CBM  
APPROVED: KMH  
CAD DATE: 8/31/2022  
CAD FILE: J:\2020\200541\CAD\DWG\CD\CDIEI\_Paso\_Co\Sanitary

JOB DATE: 8/31/2022  
JOB NUMBER: 200541

BAR IS ONE INCH ON OFFICIAL DRAWINGS.  
0" 1"  
IF NOT ONE INCH, ADJUST SCALE ACCORDINGLY.

NO.	DATE	BY	REVISION DESCRIPTION



HRGreen

HR GREEN - COLORADO SPRINGS  
7222 COMMERCE CENTER DR SUITE 220  
COLORADO SPRINGS CO 80919  
PHONE: 719.300.4140 TOLL FREE: 800.728.7805  
FAX: 844.273.1057 | HRGreen.com

THE COTTAGES AT MESA RIDGE  
GOODWIN KNIGHT  
EL PASO COUNTY, COLORADO

EL PASO COUNTY CONSTRUCTION DOCUMENTS  
SANITARY PLAN & PROFILE



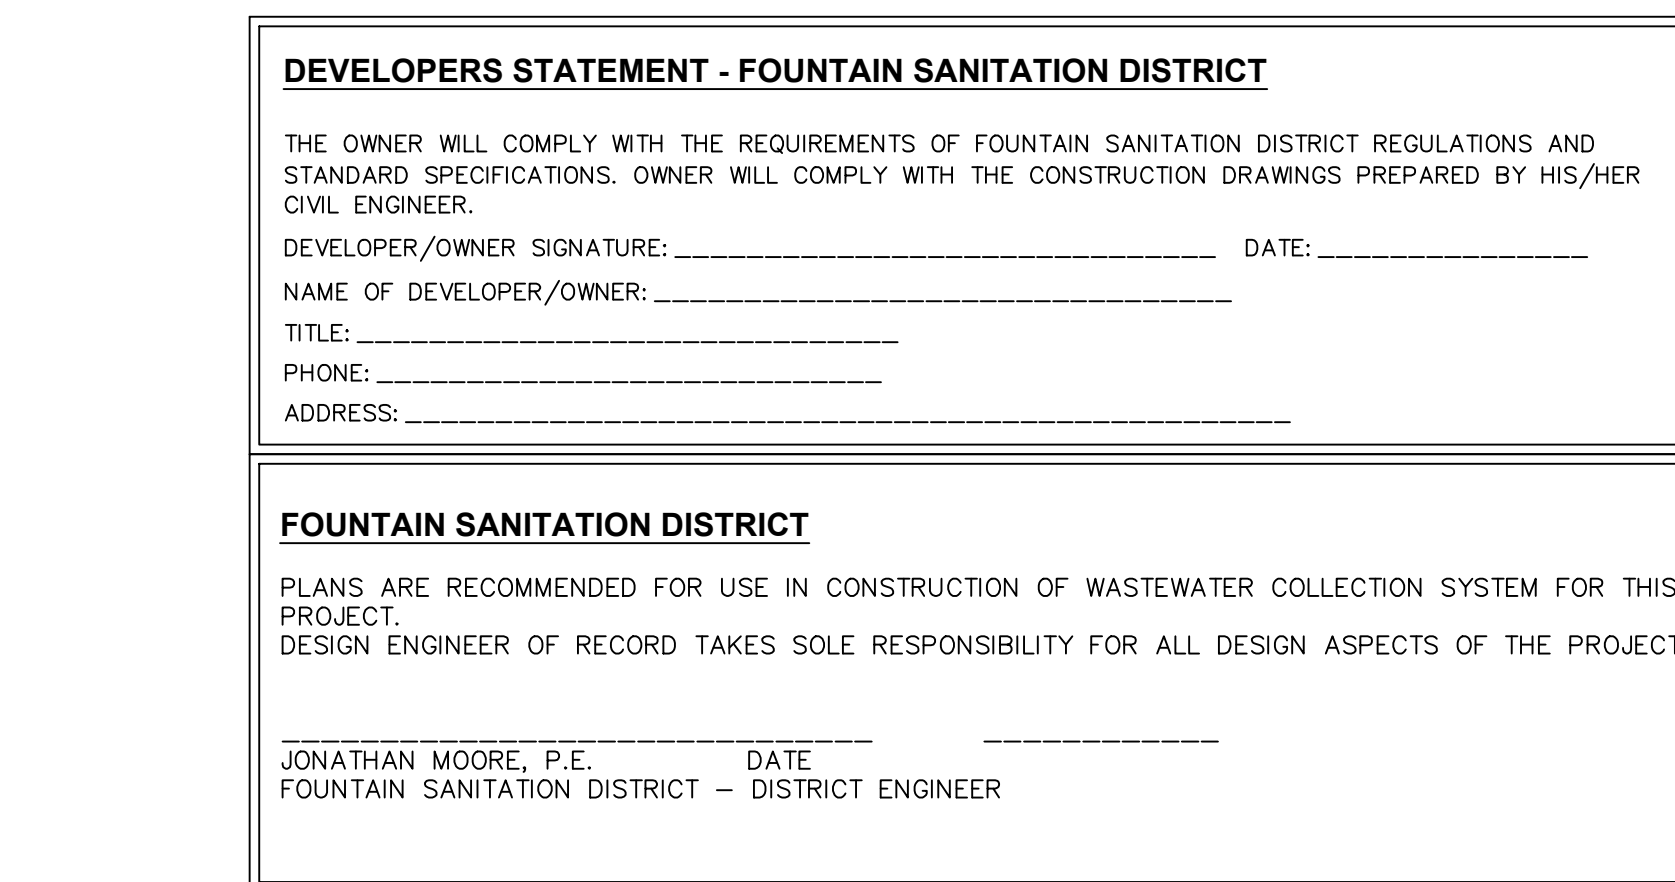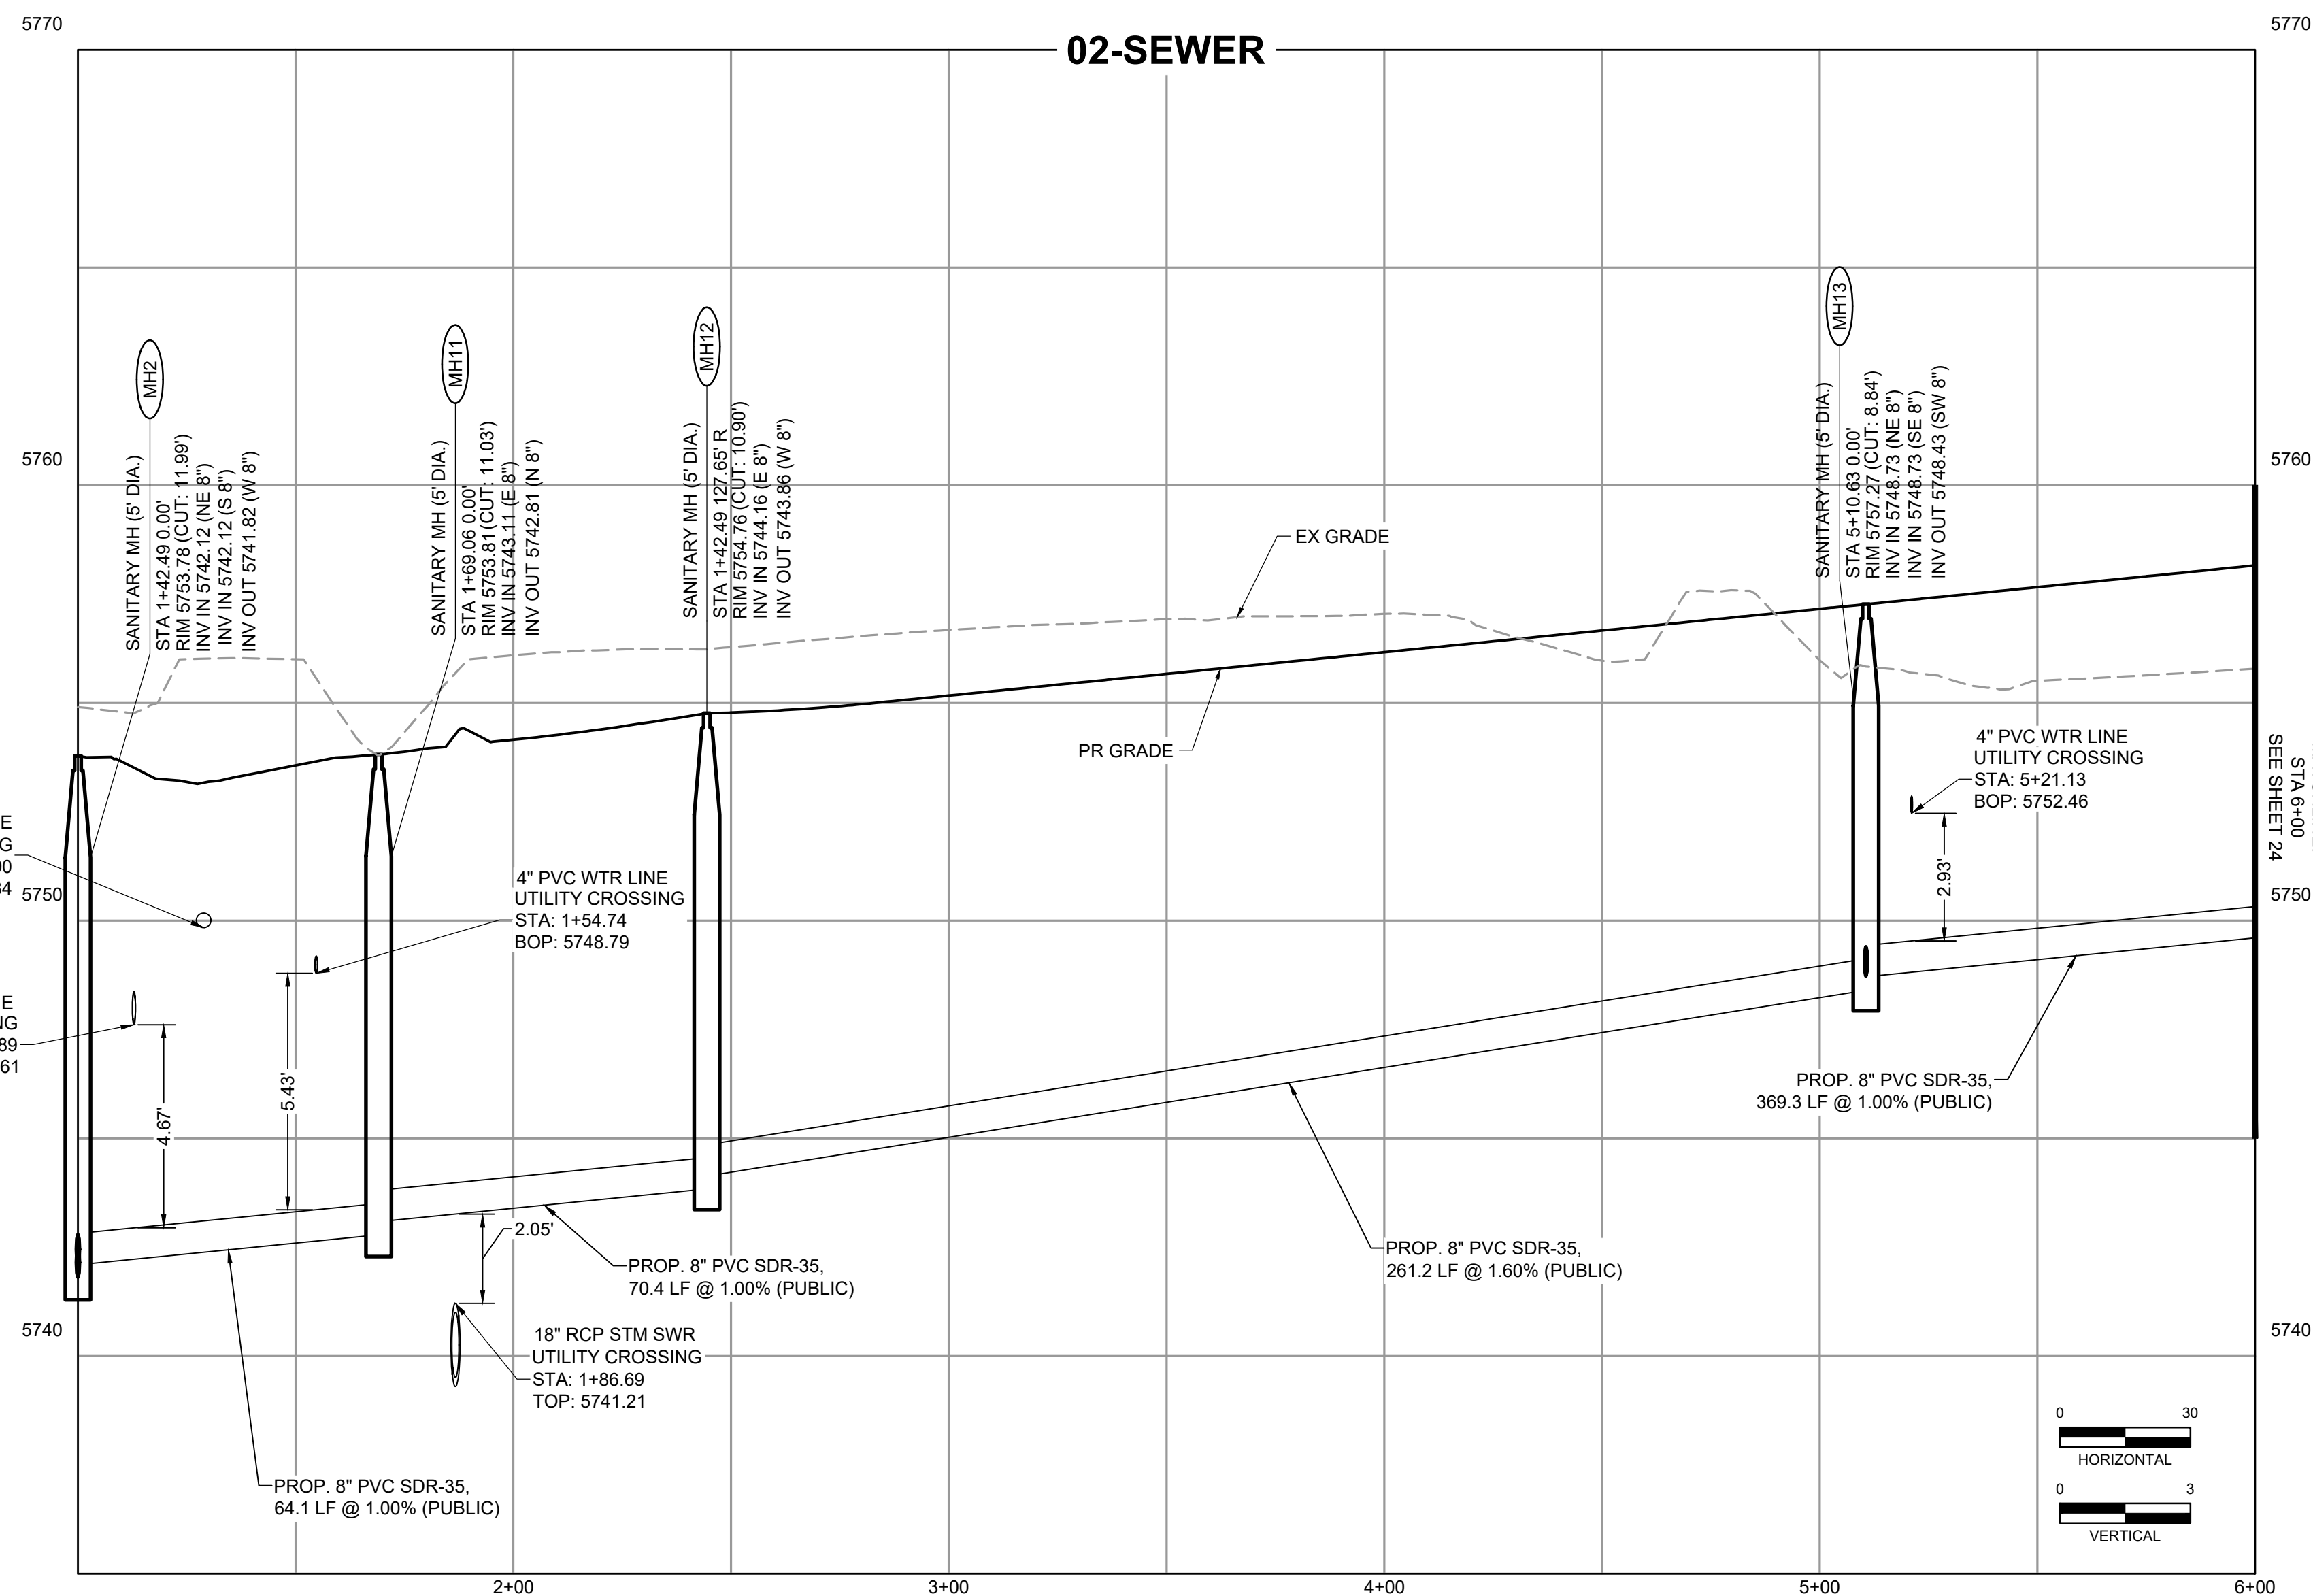

NOT FOR CONSTRUCTION

NO.	DATE	BY	REVISION DESCRIPTION


THE COTTAGES AT MESA RIDGE  
GOODWIN KNIGHT  
EL PASO COUNTY, COLORADO




SHEET  
SAN

23



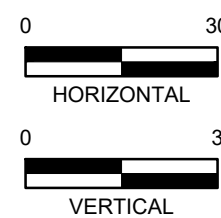


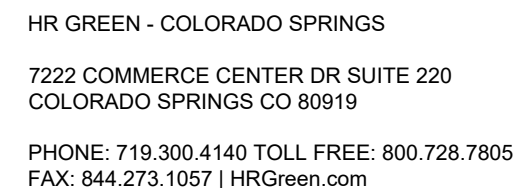
PCD FILNE NO.: SF2214

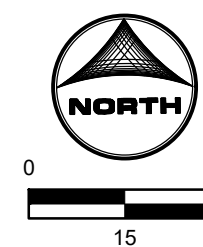

NOT FOR CONSTRUCTION

BAR IS ONE INCH ON  
OFFICIAL DRAWINGS.  
0  1"  
IF NOT ONE INCH,  
ADJUST SCALE ACCORDINGLY

NO.	DATE	BY	REVISION DESCRIPTION



24



### WATER and SEWER MAIN EXTENSIONS

Any changes or alterations affecting the grade, alignment, elevation and/or depth of cover of any water or sewer mains or other appurtenance shown on this drawing shall be the responsibility of the Owner/Developer. The Owner/Developer shall be responsible for all operational damages and defects in installation and material for mains and services from the date of approval until final acceptance is issued.

Signed \_\_\_\_\_ Date \_\_\_\_\_  
Owner/Developer

Print Name \_\_\_\_\_  
DBA \_\_\_\_\_

Address \_\_\_\_\_

### FIRE AUTHORITY APPROVAL

The number of fire hydrants and hydrant locations shown on this water installation plan are correct and adequate to satisfy the fire protection requirements as specified by the Fire District serving the property noted on the plans.

Fire Protection District \_\_\_\_\_

Signed \_\_\_\_\_ Date \_\_\_\_\_  
Fire Protection District

### DISTRICT APPROVALS



The Widefield Water and Sanitation District recognizes the design engineer as having responsibility for the design and has limited its scope of review accordingly.

WIDEFIELD WATER AND SANITATION DISTRICT  
WATER DESIGN APPROVAL


Date: \_\_\_\_\_ By: \_\_\_\_\_  
PROJECT NO. \_\_\_\_\_

In case of errors or omissions with the water design as shown on this document the standards as defined in the "Rules and Regulations for Installation of Water Mains and Services" shall rule.


Approval expires 180 days from Design Approval

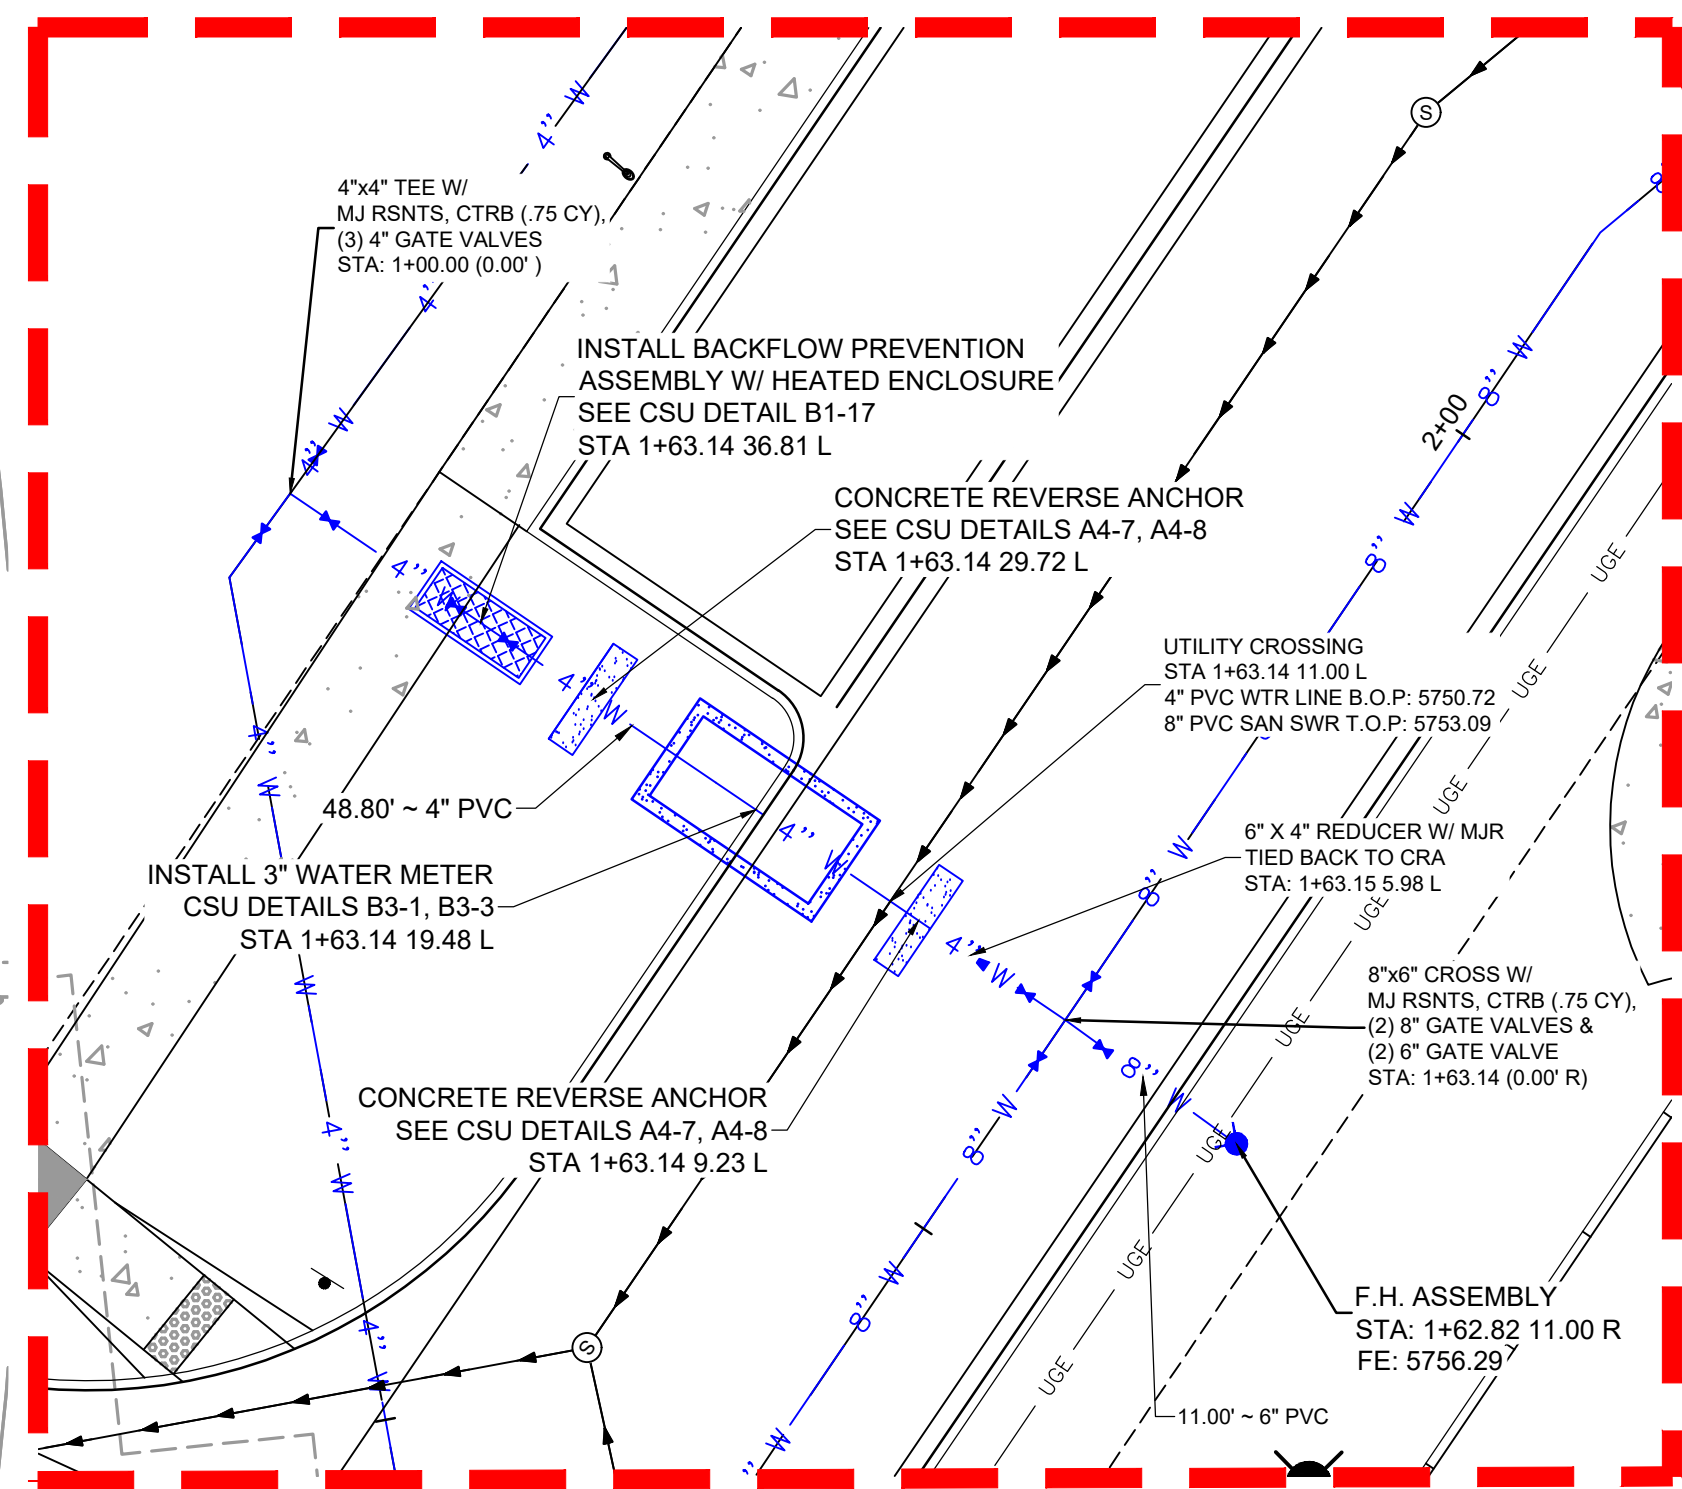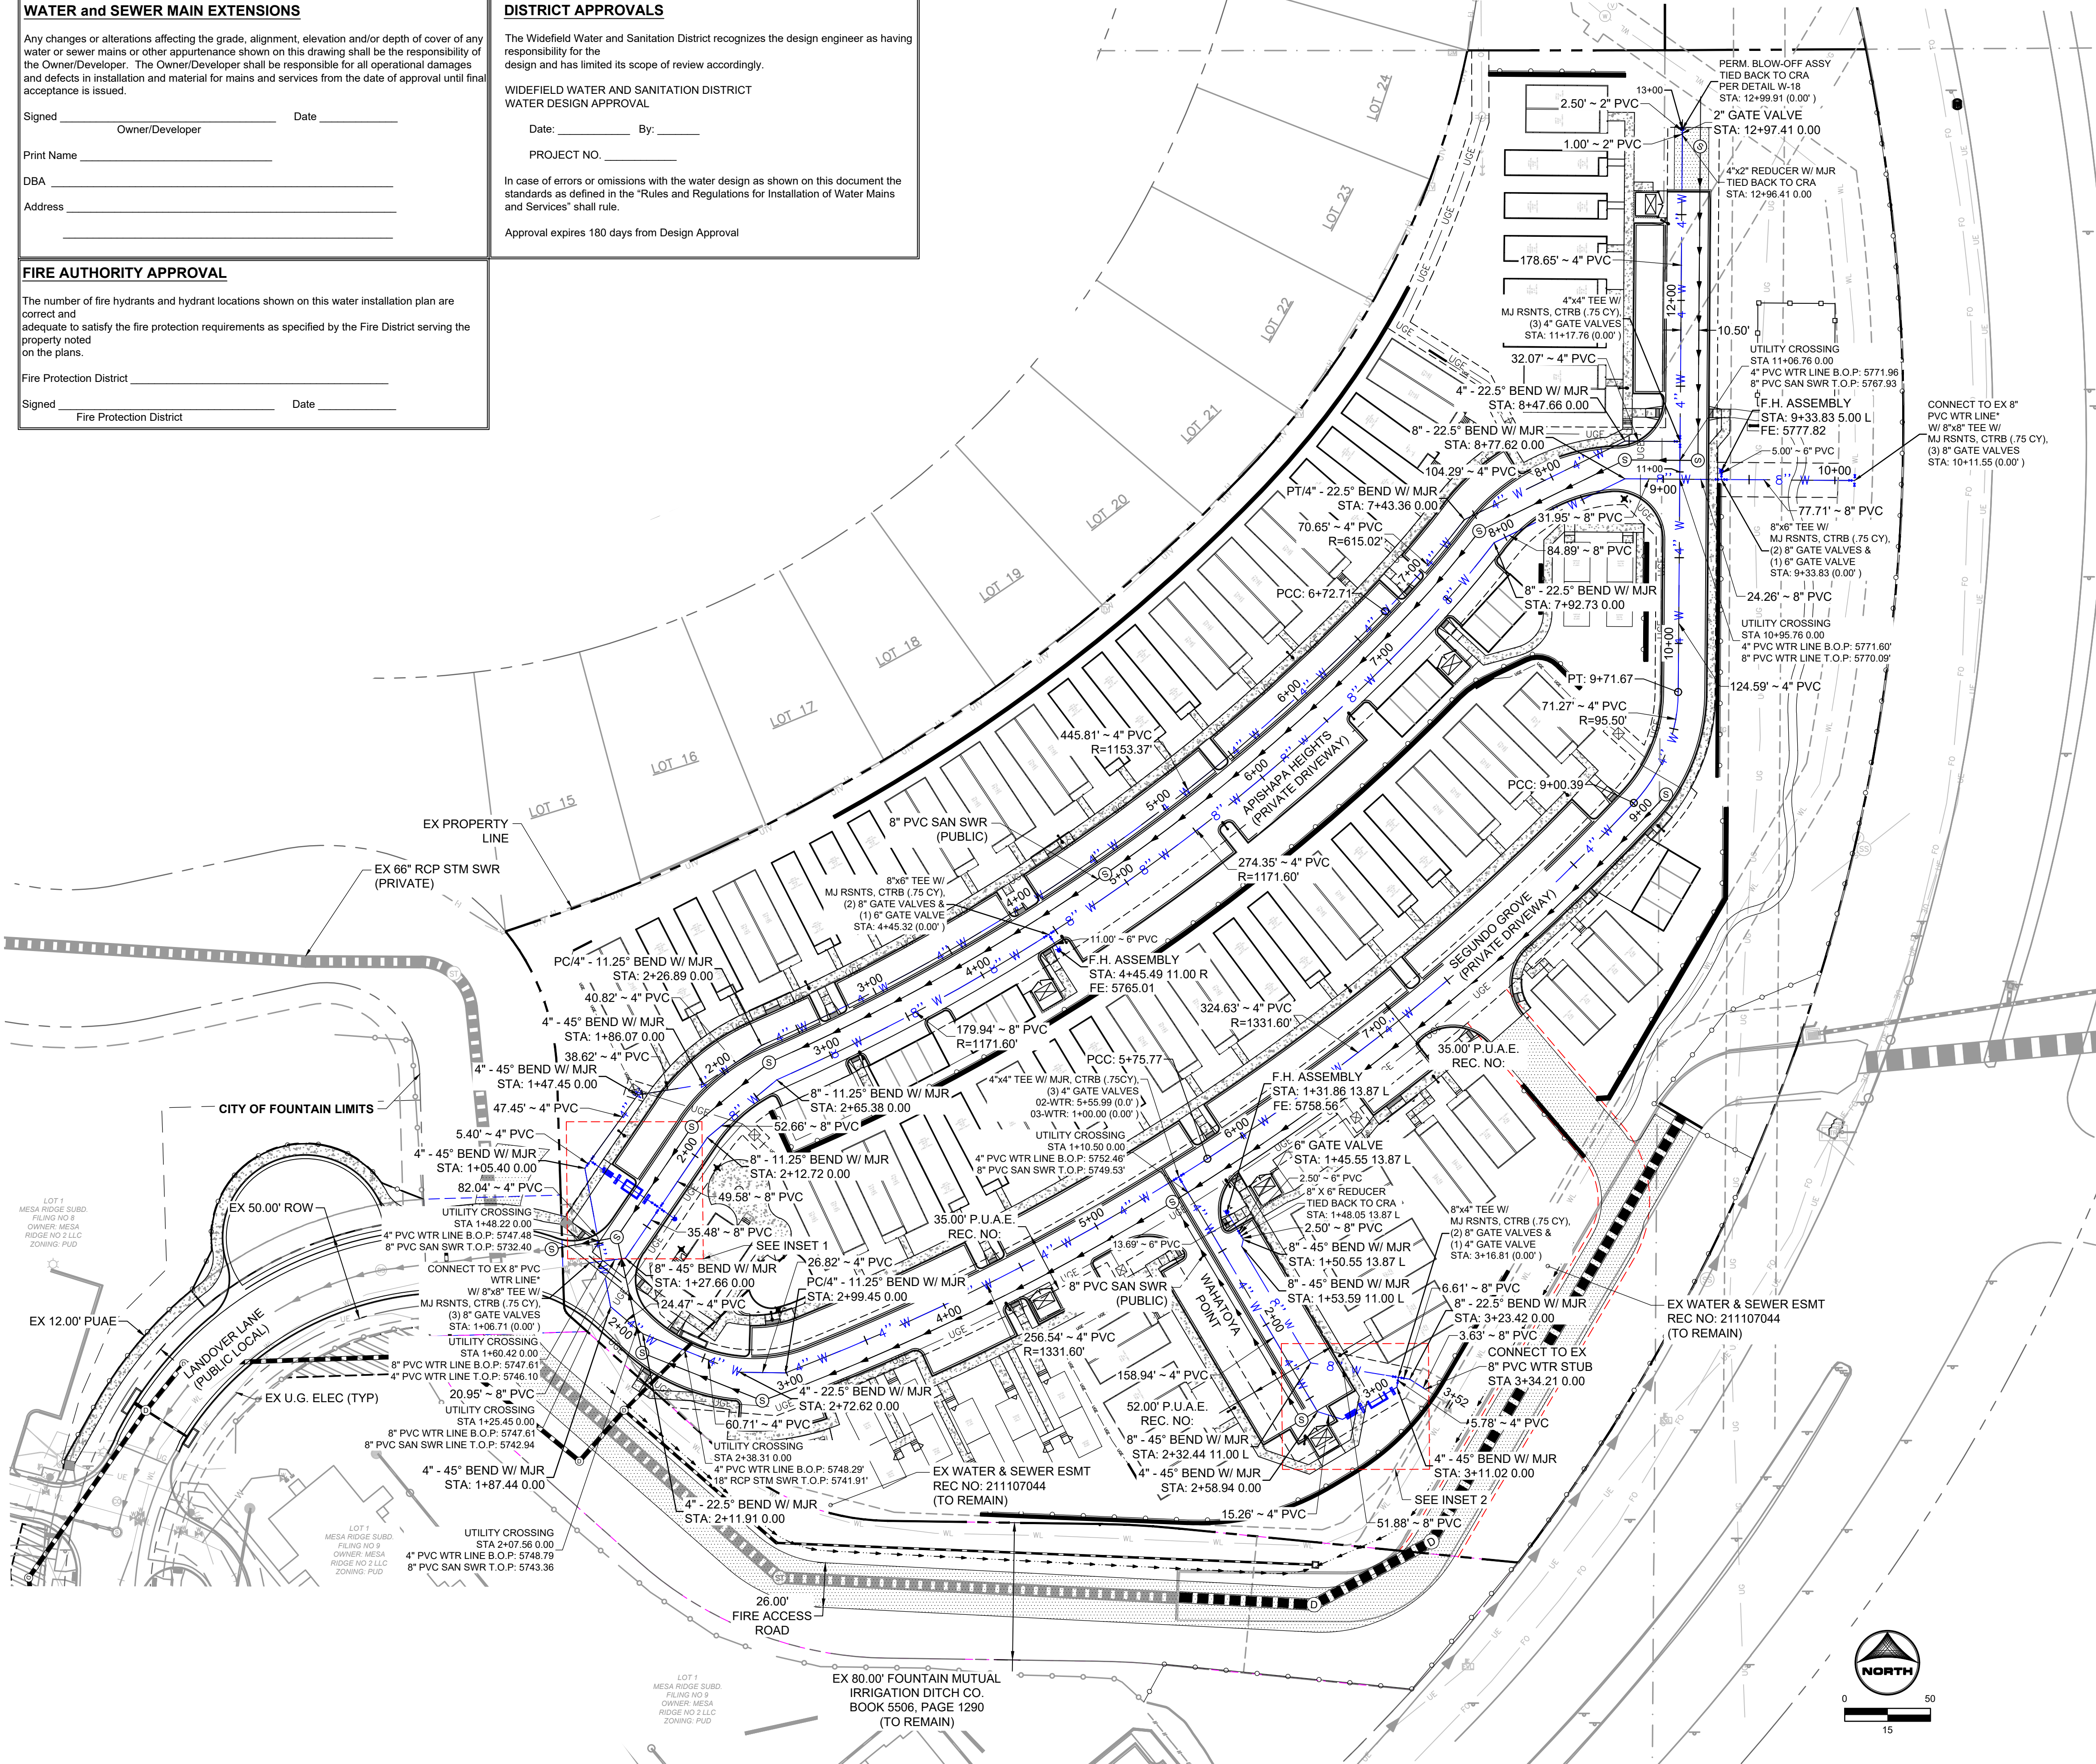

INSET 1

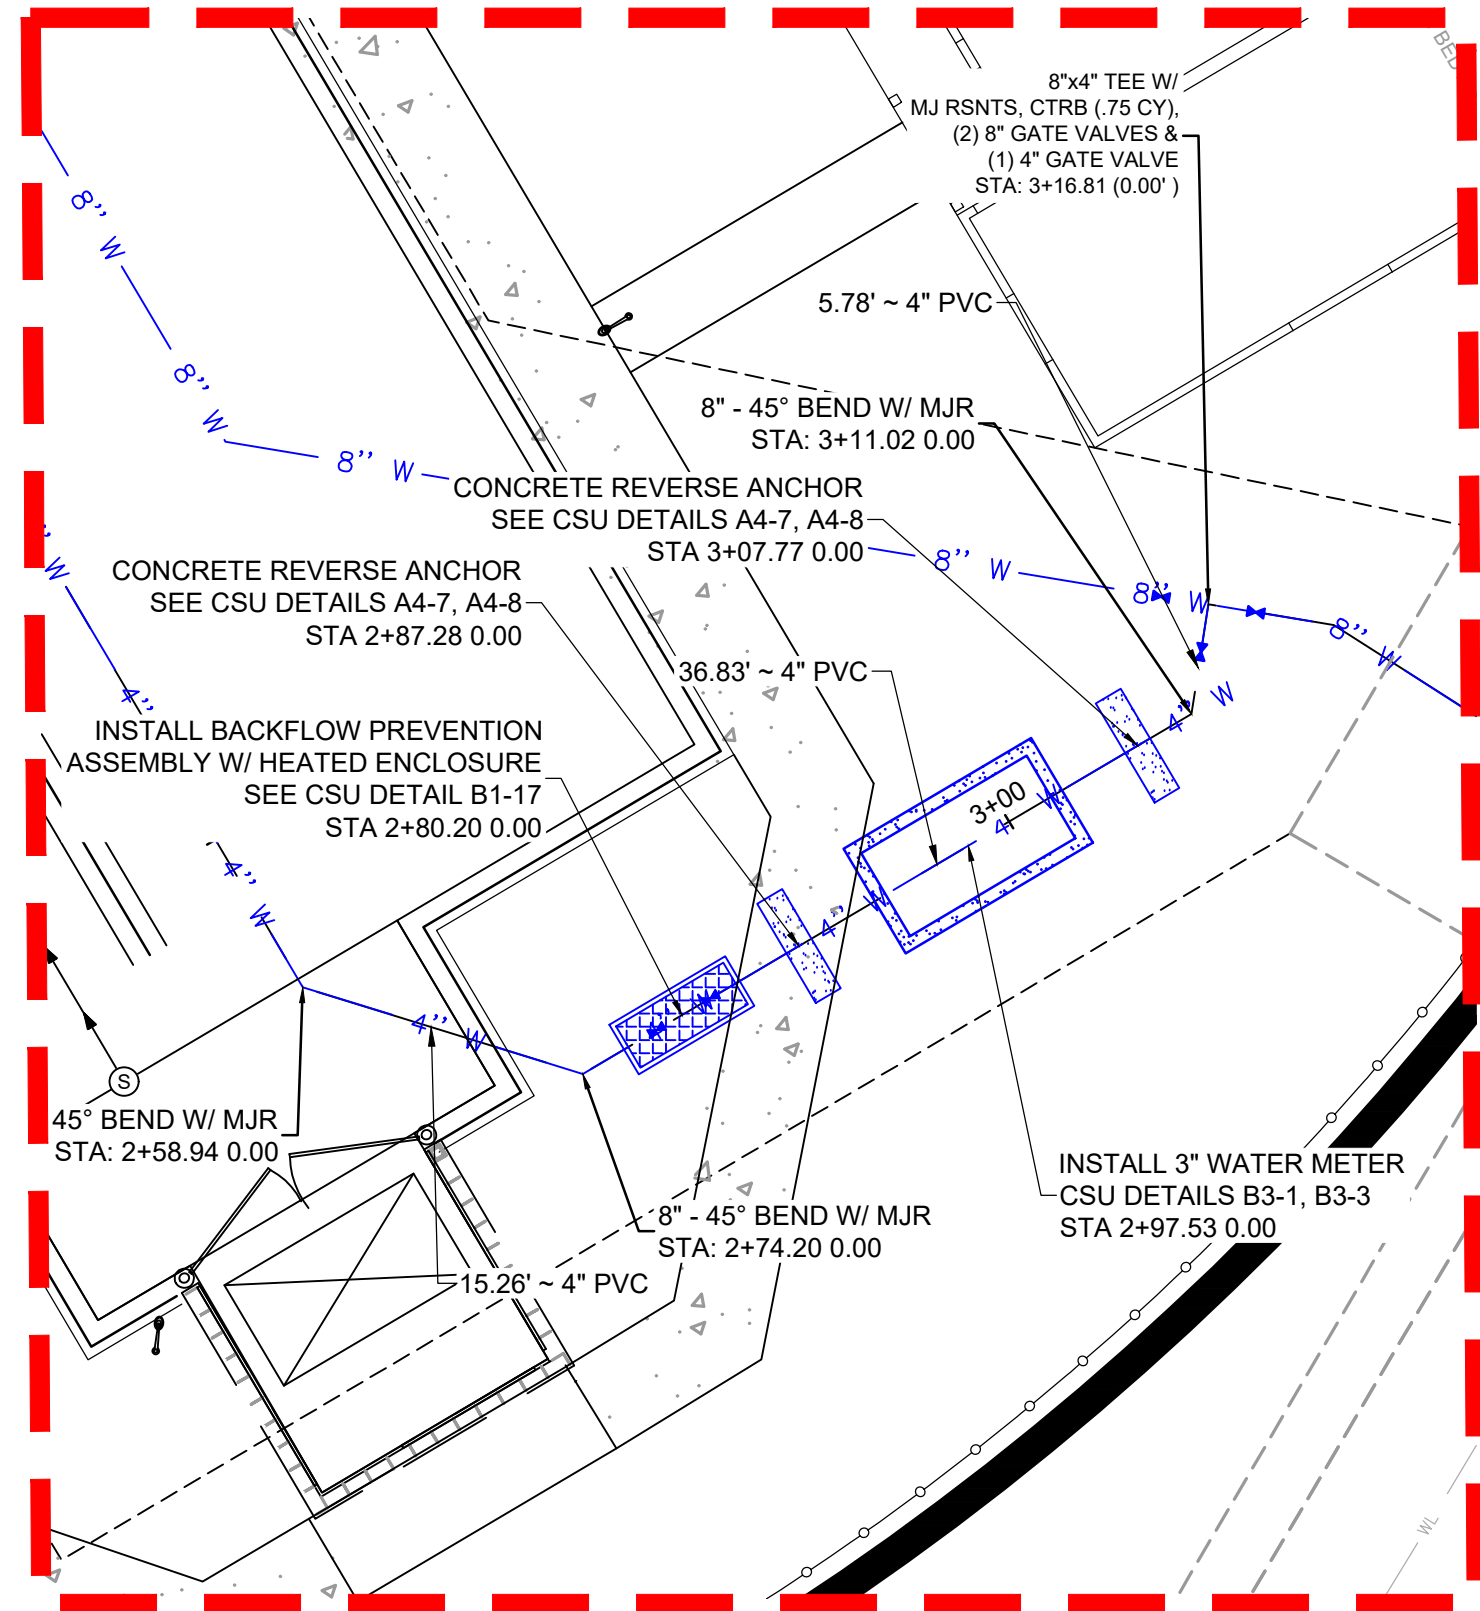

INSET 2

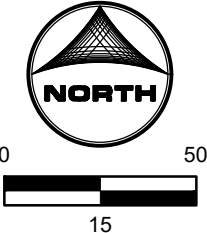

NOT FOR CONSTRUCTION

PCD FILNE NO.: SF2214

DRAWN BY: CBM  
APPROVED: KMH  
CAD DATE: 8/31/2022  
CAD FILE: J:\2020\200541\CAD\DWG\CD\CDIEI\_Paso\_CoWater

JOB DATE: 8/31/2022  
JOB NUMBER: 200541

BAR IS ONE INCH ON  
OFFICIAL DRAWINGS.  
IF NOT ONE INCH,  
ADJUST SCALE ACCORDINGLY.

NO.	DATE	BY	REVISION DESCRIPTION



HR GREEN - COLORADO SPRINGS  
7222 COMMERCE CENTER DR SUITE 220  
COLORADO SPRINGS CO 80919  
PHONE: 719.300.4140 TOLL FREE: 800.728.7805  
FAX: 844.273.1057 | HRGreen.com

THE COTTAGES AT MESA RIDGE  
GOODWIN KNIGHT  
EL PASO COUNTY, COLORADO




CITY OF FOUNTAIN CONSTRUCTION DOCUMENTS  
WATER DISTRIBUTION PLAN

SHEET  
WP

25



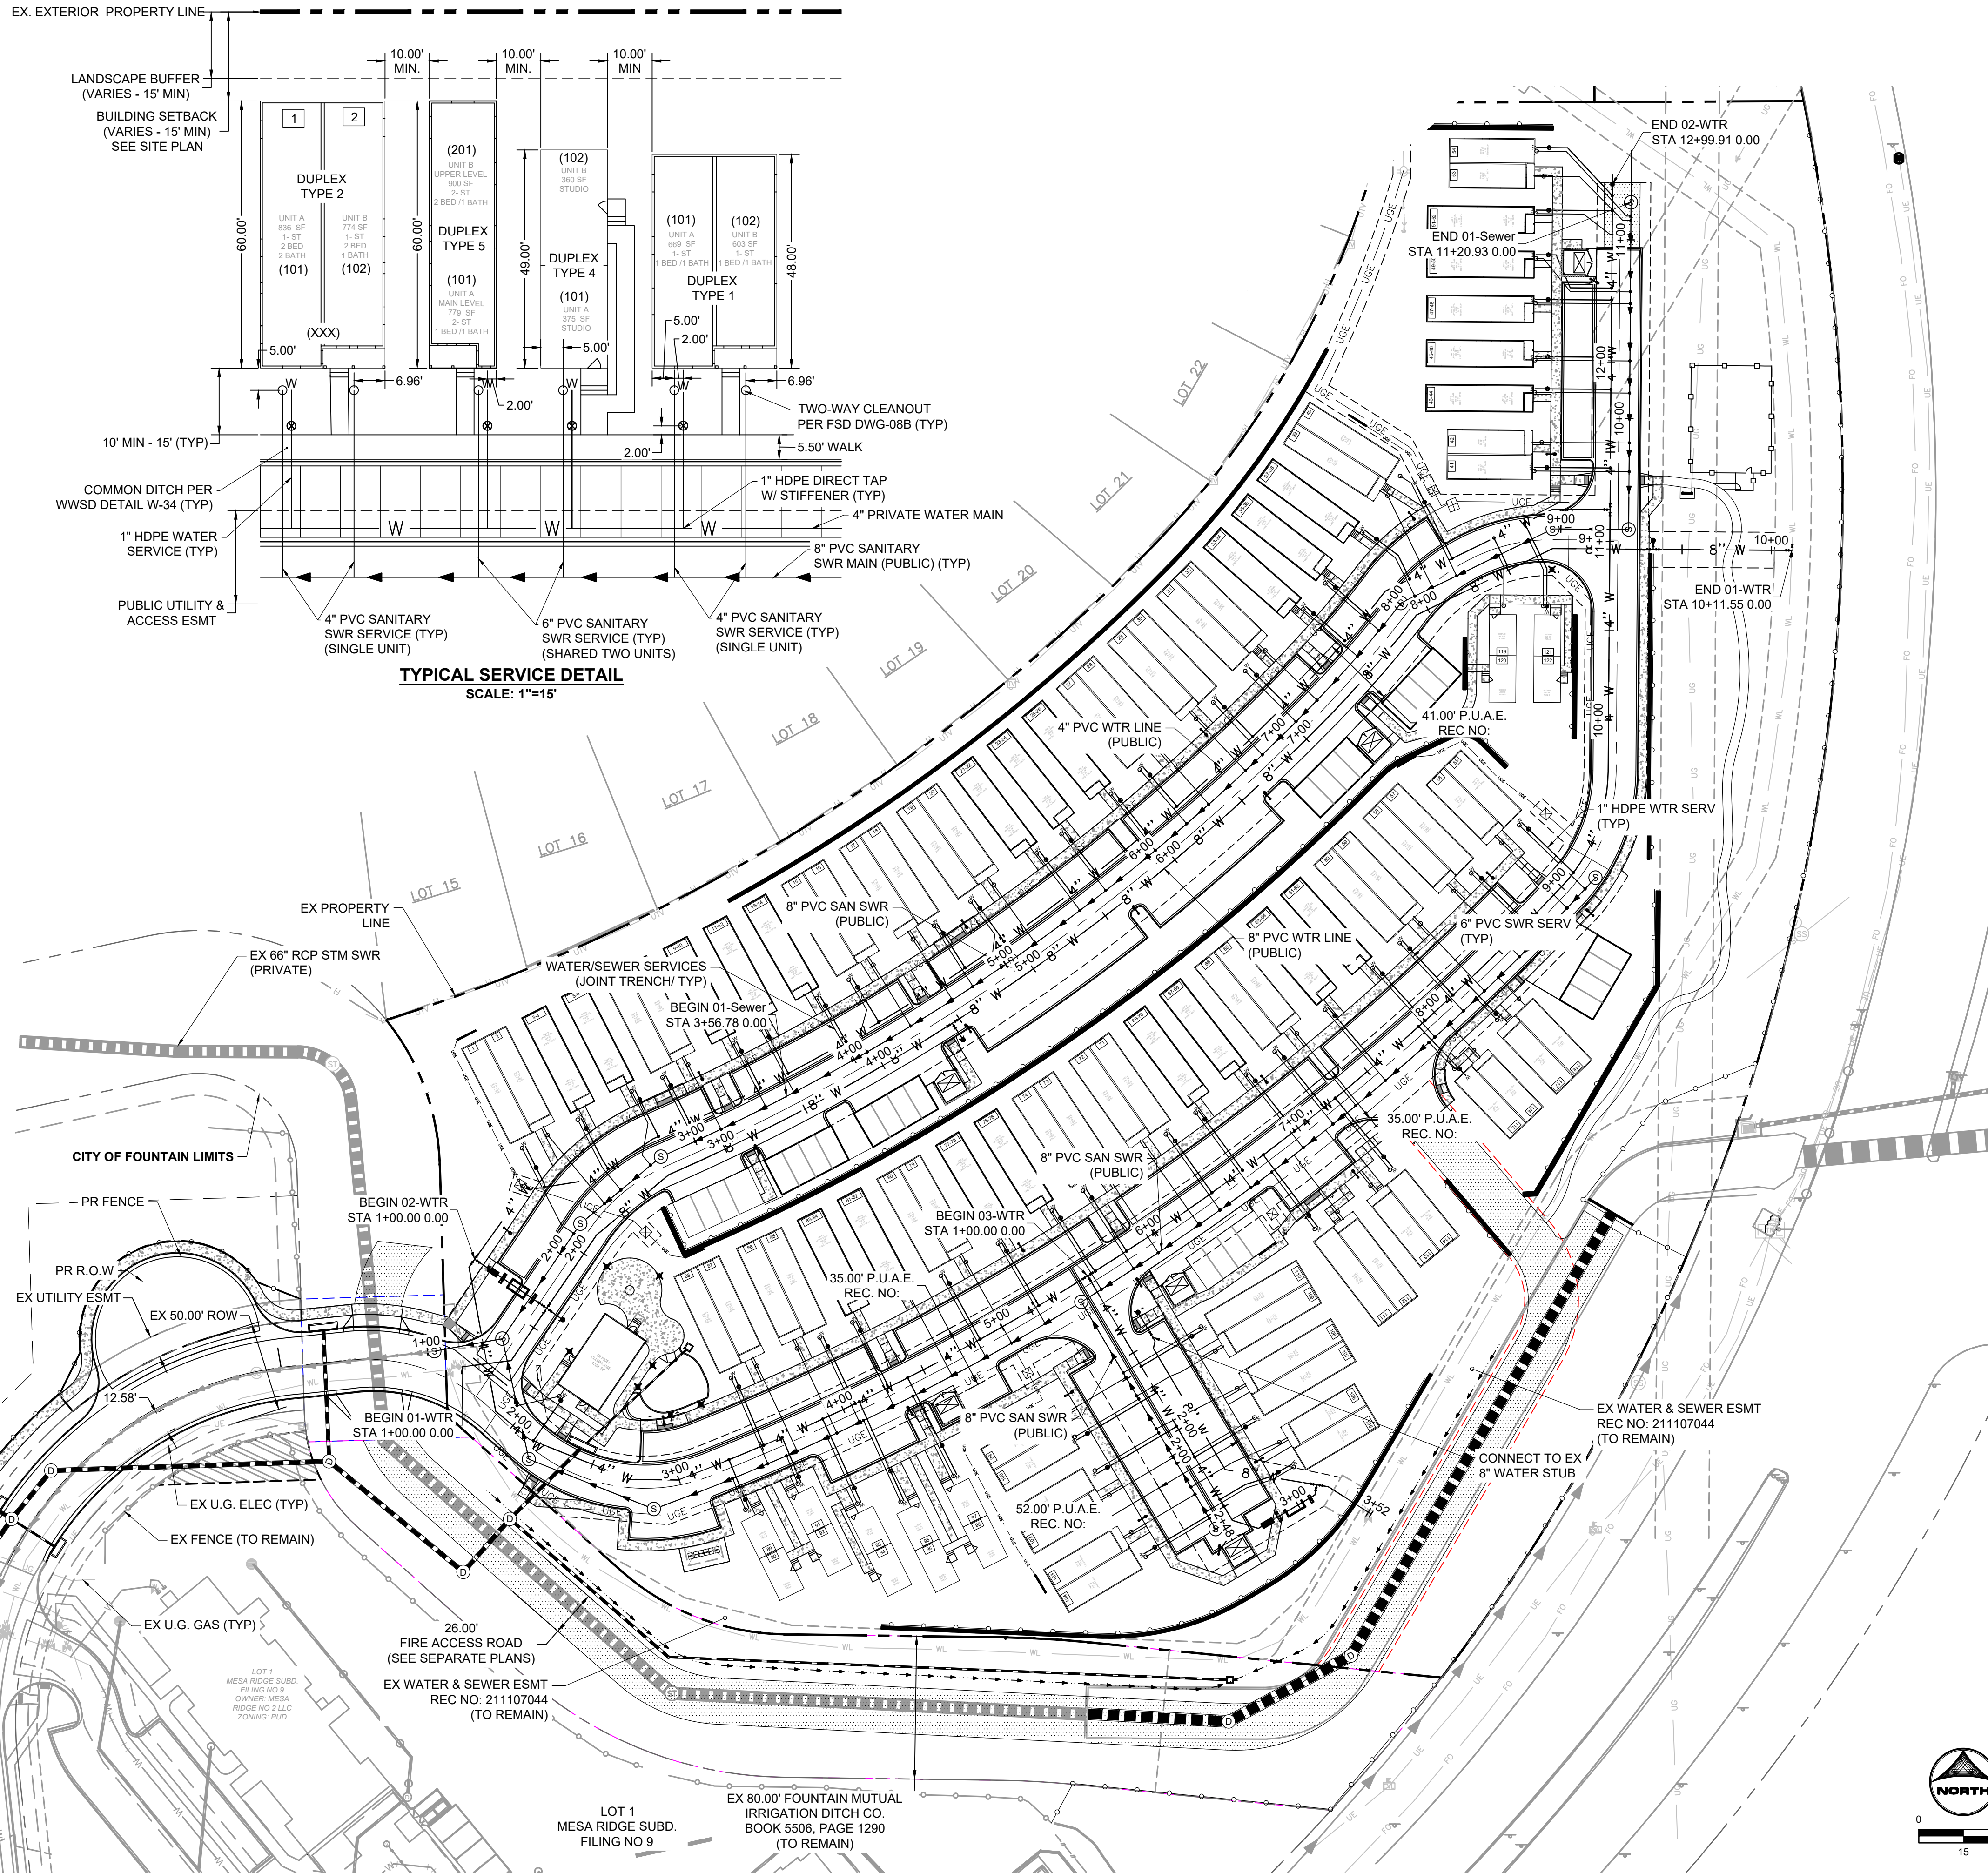


SEWER SERVICES

LOT	ALIGNMENT	STATION	OFFSET	LOT	ALIGNMENT	STATION	OFFSET	LOT	ALIGNMENT	STATION	OFFSET
CH	02-Sewer	STA 1+38.37	0.0'	41	01-Sewer	STA 9+70.23	0.0' R	83-84	02-Sewer	STA 3+90.68	0.0'
1	01-Sewer	STA 2+13.72	0.0'	42	01-Sewer	STA 9+86.27	0.0'	85	02-Sewer	STA 3+69.35	0.0'
2	01-Sewer	STA 2+37.90	0.0'	43-44	01-Sewer	STA 10+14.23	0.0'	86	02-Sewer	STA 3+55.30	0.0' L
3-4	01-Sewer	STA 2+49.75	0.0'	45-46	01-Sewer	STA 10+32.23	0.0'	87	02-Sewer	STA 3+30.96	0.0' L
5-6	01-Sewer	STA 2+71.44	0.0' L	47-48	01-Sewer	STA 10+64.23	0.0'	88	02-Sewer	STA 3+13.00	0.0' L
7	01-Sewer	STA 2+99.91	0.0'	49-50	01-Sewer	STA 10+70.90	0.0' R	89-90	02-Sewer	STA 2+91.75	0.0'
8	01-Sewer	STA 3+15.96	0.0'	51-52	01-Sewer	STA 11+03.11	0.0'	91-92	02-Sewer	STA 3+24.33	0.0'
9-10	01-Sewer	STA 3+43.92	0.0'	53	01-Sewer	STA 11+10.78	0.0'	93-94	02-Sewer	STA 3+49.35	0.0'
11-12	01-Sewer	STA 3+61.64	0.0'	54	01-Sewer	STA 11+13.28	0.0'	95-96	02-Sewer	STA 3+71.85	0.0' R
13-14	01-Sewer	STA 3+98.98	0.0'	55	02-Sewer	STA 8+76.31	0.0'	97-98	02-Sewer	STA 4+02.65	0.0'
15	01-Sewer	STA 4+08.40	0.0'	56	02-Sewer	STA 8+61.57	0.0'	99	03-Sewer	STA 1+49.08	0.0'
16	01-Sewer	STA 4+36.70	0.0'	57	02-Sewer	STA 8+38.01	0.0' L	100	03-Sewer	STA 1+63.12	0.0'
17	01-Sewer	STA 4+64.42	0.0'	58	02-Sewer	STA 8+23.57	0.0'	101	03-Sewer	STA 1+85.12	0.0'
18	01-Sewer	STA 4+78.08	0.0' L	59	02-Sewer	STA 7+96.15	0.0'	102	03-Sewer	STA 2+01.17	0.0'
19	01-Sewer	STA 4+97.10	0.0'	60	02-Sewer	STA 7+79.72	0.0'	103	03-Sewer	STA 2+25.08	0.0'
20	01-Sewer	STA 5+20.54	0.0'	61-62	02-Sewer	STA 7+58.19	0.0'	104	03-Sewer	STA 2+40.72	0.0'
21-22	01-Sewer	STA 5+51.56	0.0'	63-64	02-Sewer	STA 7+21.44	0.0'	105	03-Sewer	STA 2+36.62	0.0'
23-24	01-Sewer	STA 5+69.76	0.0' L	65	02-Sewer	STA 6+99.70	0.0'	106	03-Sewer	STA 2+20.43	0.0' L
25-26	01-Sewer	STA 6+05.35	0.0' L	66	02-Sewer	STA 6+83.29	0.0'	107	03-Sewer	STA 2+05.05	0.0'
27	01-Sewer	STA 6+28.50	0.0'	67-68	02-Sewer	STA 6+61.88	0.0'	108	03-Sewer	STA 1+82.44	0.0'
28	01-Sewer	STA 6+44.96	0.0'	69-70	02-Sewer	STA 6+25.13	0.0'	109	03-Sewer	STA 1+61.12	0.0'
29	01-Sewer	STA 6+72.73	0.0'	71	02-Sewer	STA 6+03.70	0.0'	110	03-Sewer	STA 1+46.05	0.0'
30	01-Sewer	STA 6+85.67	0.0'	72	02-Sewer	STA 5+89.30	0.0'	111-112	02-Sewer	STA 6+39.69	0.0'
31	01-Sewer	STA 7+12.19	0.0'	73	02-Sewer	STA 5+61.75	0.0'	113-114	02-Sewer	STA 6+91.44	0.0'
32	01-Sewer	STA 7+28.94	0.0'	74	02-Sewer	STA 5+45.35	0.0'	115	02-Sewer	STA 7+53.80	0.0'
33-34	01-Sewer	STA 7+62.32	0.0'	75-76	02-Sewer	STA 5+23.84	0.0'	116	02-Sewer	STA 7+68.90	0.0'
35-36	01-Sewer	STA 7+81.29	0.0'	77-78	02-Sewer	STA 4+87.09	0.0'	117	02-Sewer	STA 7+89.92	0.0' L
37-38	01-Sewer	STA 8+09.57	0.0'	79	02-Sewer	STA 4+65.34	0.0' L	118	02-Sewer	STA 8+06.90	0.0'
39	01-Sewer	STA 8+20.55	0.0' R	80	02-Sewer	STA 4+48.94	0.0'	119-120	01-Sewer	STA 8+61.59	0.0' R
40	01-Sewer	STA 8+35.52	0.0' L	81-82	02-Sewer	STA 4+27.43	0.0' L	121-122	01-Sewer	STA 8+80.68	0.0' R

WATER SERVICES

LOT	ALIGNMENT	STATION	OFFSET	LOT	ALIGNMENT	STATION	OFFSET	LOT	ALIGNMENT	STATION	OFFSET
CH	02-WTR	STA 2+14.48	0.0'	41-42	02-WTR	STA 11+41.08	0.0'	83-84	02-WTR	STA 4+28.31	0.0'
1-2	01-WTR	STA 2+12.72	39.5' L	43-44	02-WTR	STA 11+85.08	0.0'	85-86	02-WTR	STA 4+07.44	0.0'
3-4	01-WTR	STA 2+41.41	24.2' L	45-46	02-WTR	STA 12+03.08	0.0' R	87-88	02-WTR	STA 3+51.24	0.0'
5-6	01-WTR	STA 2+68.80	21.9' L	47-48	02-WTR	STA 12+41.74	0.0'	89-90	02-WTR	STA 3+30.15	0.0' L
7-8	01-WTR	STA 2+88.16	22.0' L	49-50	02-WTR	STA 12+93.48	0.0'	91-92	02-WTR	STA 3+62.46	0.0' R
9-10	01-WTR	STA 3+33.01	22.0' L	51-52	02-WTR	STA 12+85.08	0.0' R	93-94	02-WTR	STA 3+87.30	0.0'
11-12	01-WTR	STA 3+51.07	22.0' L	53-54	02-WTR	STA 12+35.08	0.0' R	95-96	02-WTR	STA 4+09.94	0.0' R
13-14	01-WTR	STA 3+88.62	22.0' L	55-56	02-WTR	STA 9+10.38	0.0'	97-98	02-WTR	STA 4+40.19	0.0'
15-16	01-WTR	STA 4+10.38	22.0' L	57-58	02-WTR	STA 8+72.12	0.0' L	99-100	03-WTR	STA 1+75.84	0.0'
17-18	01-WTR	STA 4+68.51	22.0' L	59-60	02-WTR	STA 8+14.30	0.0'	101-102	03-WTR	STA 1+97.84	0.0'
19-20	01-WTR	STA 4+95.40	22.0' L	61-62	02-WTR	STA 7+92.95	0.0'	103-104	03-WTR	STA 2+49.84	0.0'
21-22	01-WTR	STA 5+42.64	22.0' L	63-64	02-WTR	STA 7+56.48	0.0'	105-106	03-WTR	STA 2+45.34	0.0'
23-24	01-WTR	STA 5+61.02	22.0' L	65-66	02-WTR	STA 7+18.63	0.0'	107-108	03-WTR	STA 2+17.77	0.0'
25-26	01-WTR	STA 5+97.29	22.0' L	67-68	02-WTR	STA 6+97.39	0.0'	109-110	03-WTR	STA 1+58.77	0.0' R
27-28	01-WTR	STA 6+20.62	22.0' L	69-70	02-WTR	STA 6+60.92	0.0'	111-112	02-WTR	STA 6+75.37	0.0'
29-30	01-WTR	STA 6+79.22	22.0' L	71-72	02-WTR	STA 6+39.66	0.0'	113-114	02-WTR	STA 7+26.63	0.0'
31-32	01-WTR	STA 7+05.69	22.0' L	73-74	02-WTR	STA 5+81.77	0.0'	115-116	02-WTR	STA 7+88.23	0.0'
33-34	01-WTR	STA 7+55.71	22.0' L	75-76	02-WTR	STA 5+60.99	0.0'	117-118	02-WTR	STA 8+24.35	0.0'
35-36	01-WTR	STA 7+75.36	22.0' L	77-78	02-WTR	STA 5+23.96	0.0'	119-120	01-WTR	STA 8+50.86	19.7' L
37-38	01-WTR	STA 7+98.28	19.7' L	79-80	02-WTR	STA 4+86.11	0.0'	121-122	01-WTR	STA 8+69.75	19.7' L
39-40	01-WTR	STA 8+24.59	19.7' L	81-82	02-WTR	STA 4+64.77	0.0'				

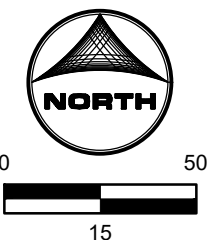

NOT FOR CONSTRUCTION

PCD FILNE NO.: SF2214

DRAWN BY: CBM JOB DATE: 8/31/2022  
APPROVED: KMH JOB NUMBER: 200541  
CAD DATE: 8/31/2022  
CAD FILE: J:\2020\200541\CAD\DWG\CD\CDIE\_Paso\_CoUtil\_Service\_Plan

BAR IS ONE INCH ON  
OFFICIAL DRAWINGS.  
IF NOT ONE INCH,  
ADJUST SCALE ACCORDINGLY.

NO.	DATE	BY	REVISION DESCRIPTION

HR GREEN - COLORADO SPRINGS  
7222 COMMERCE CENTER DR SUITE 220  
COLORADO SPRINGS CO 80919  
PHONE: 719.300.4140 TOLL FREE: 800.728.7805  
FAX: 844.273.1057 | HRGreen.com

THE COTTAGES AT MESA RIDGE  
GOODWIN KNIGHT  
EL PASO COUNTY, COLORADO






EL PASO COUNTY CONSTRUCTION DOCUMENTS  
UTILITY SERVICE PLAN


SHEET  
USP

26



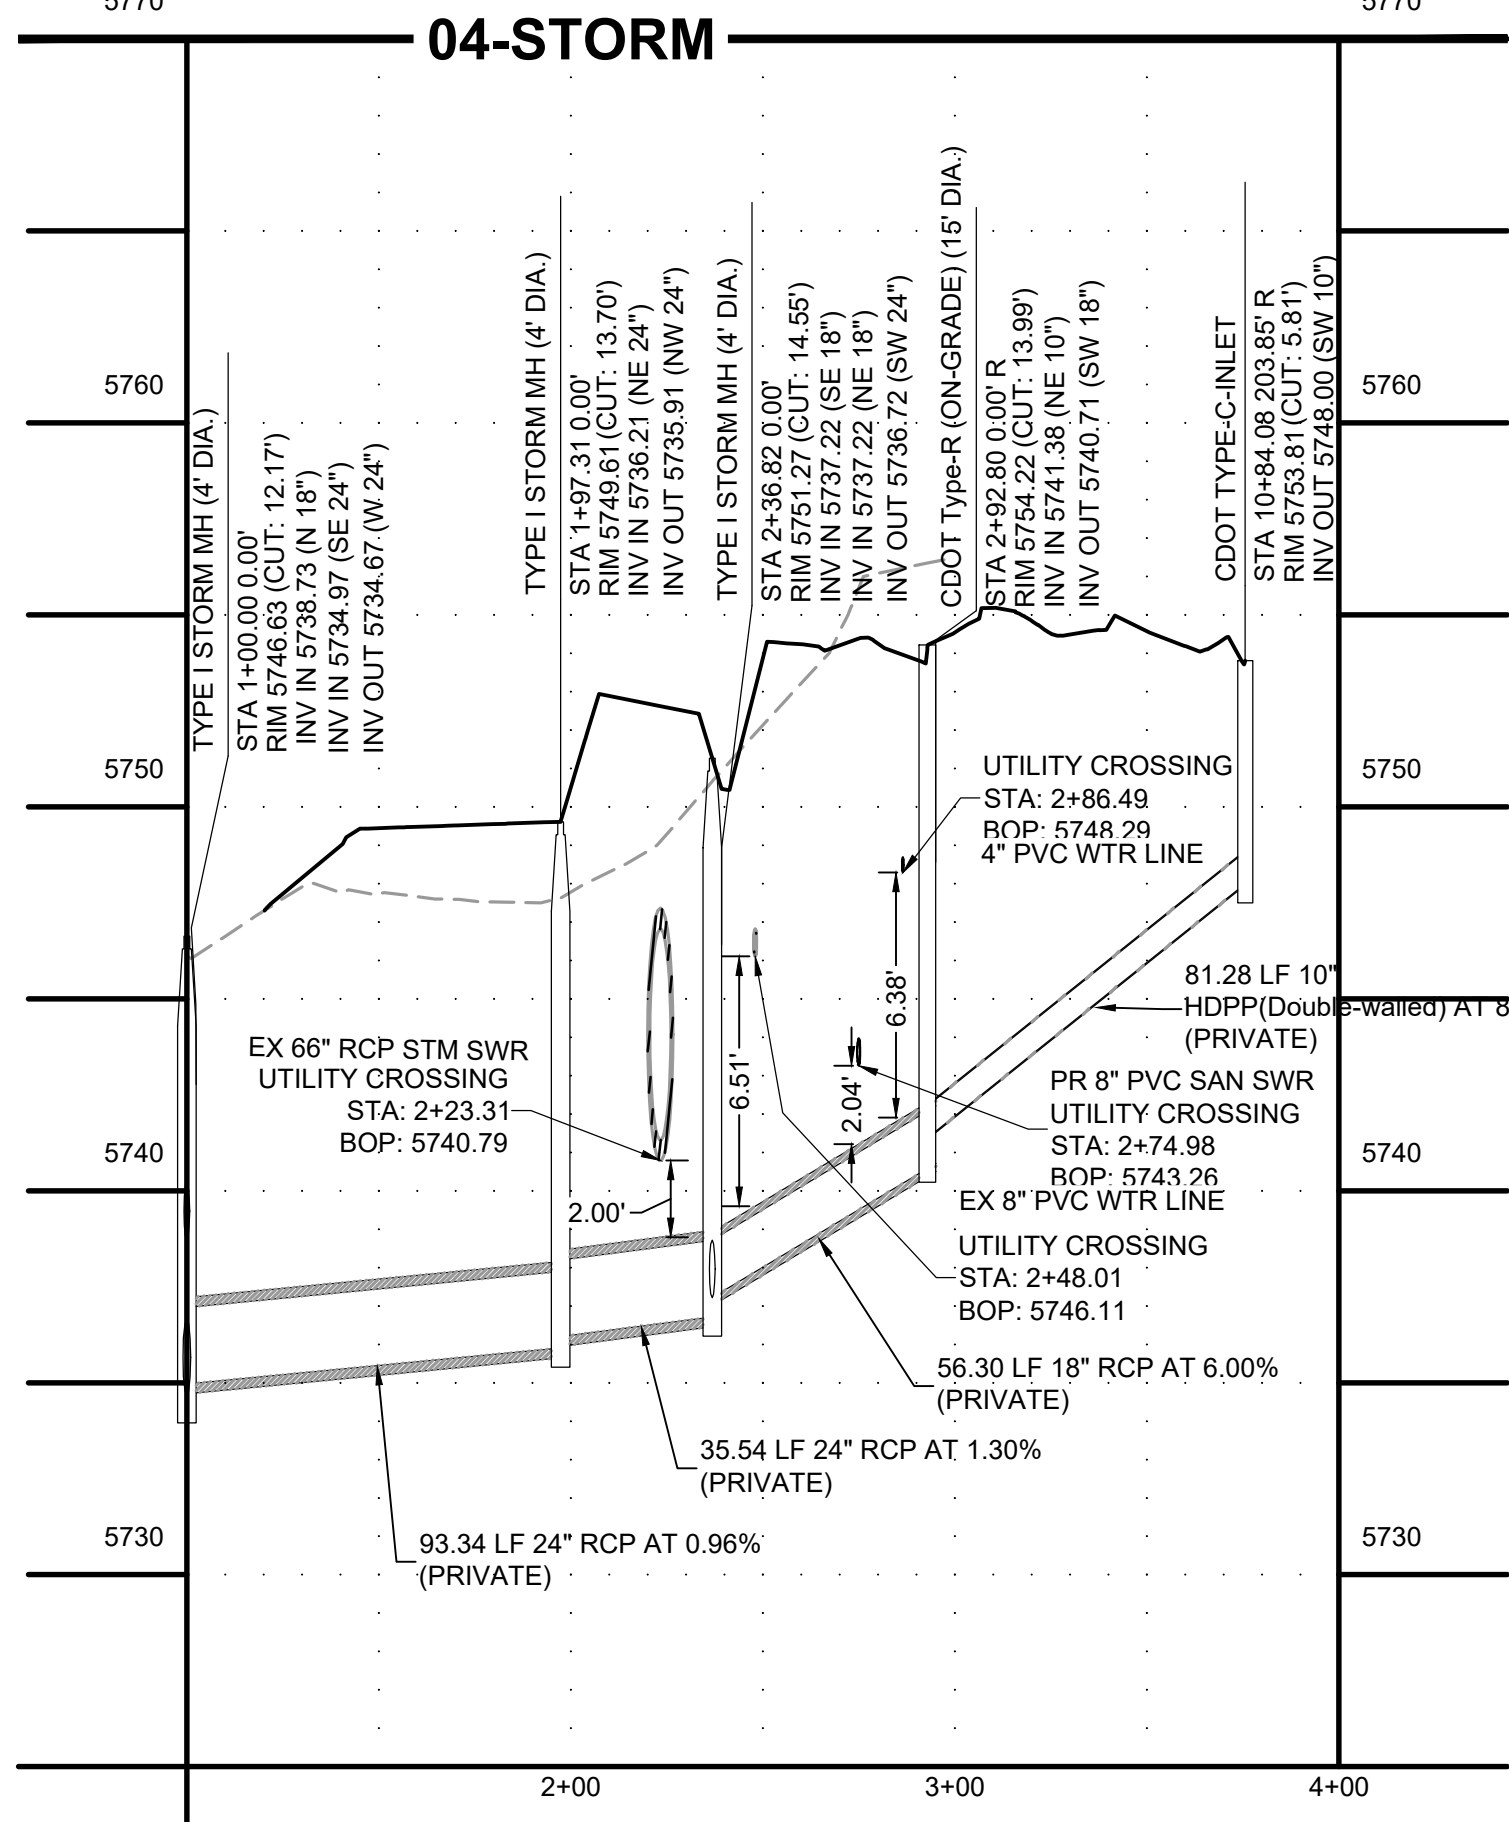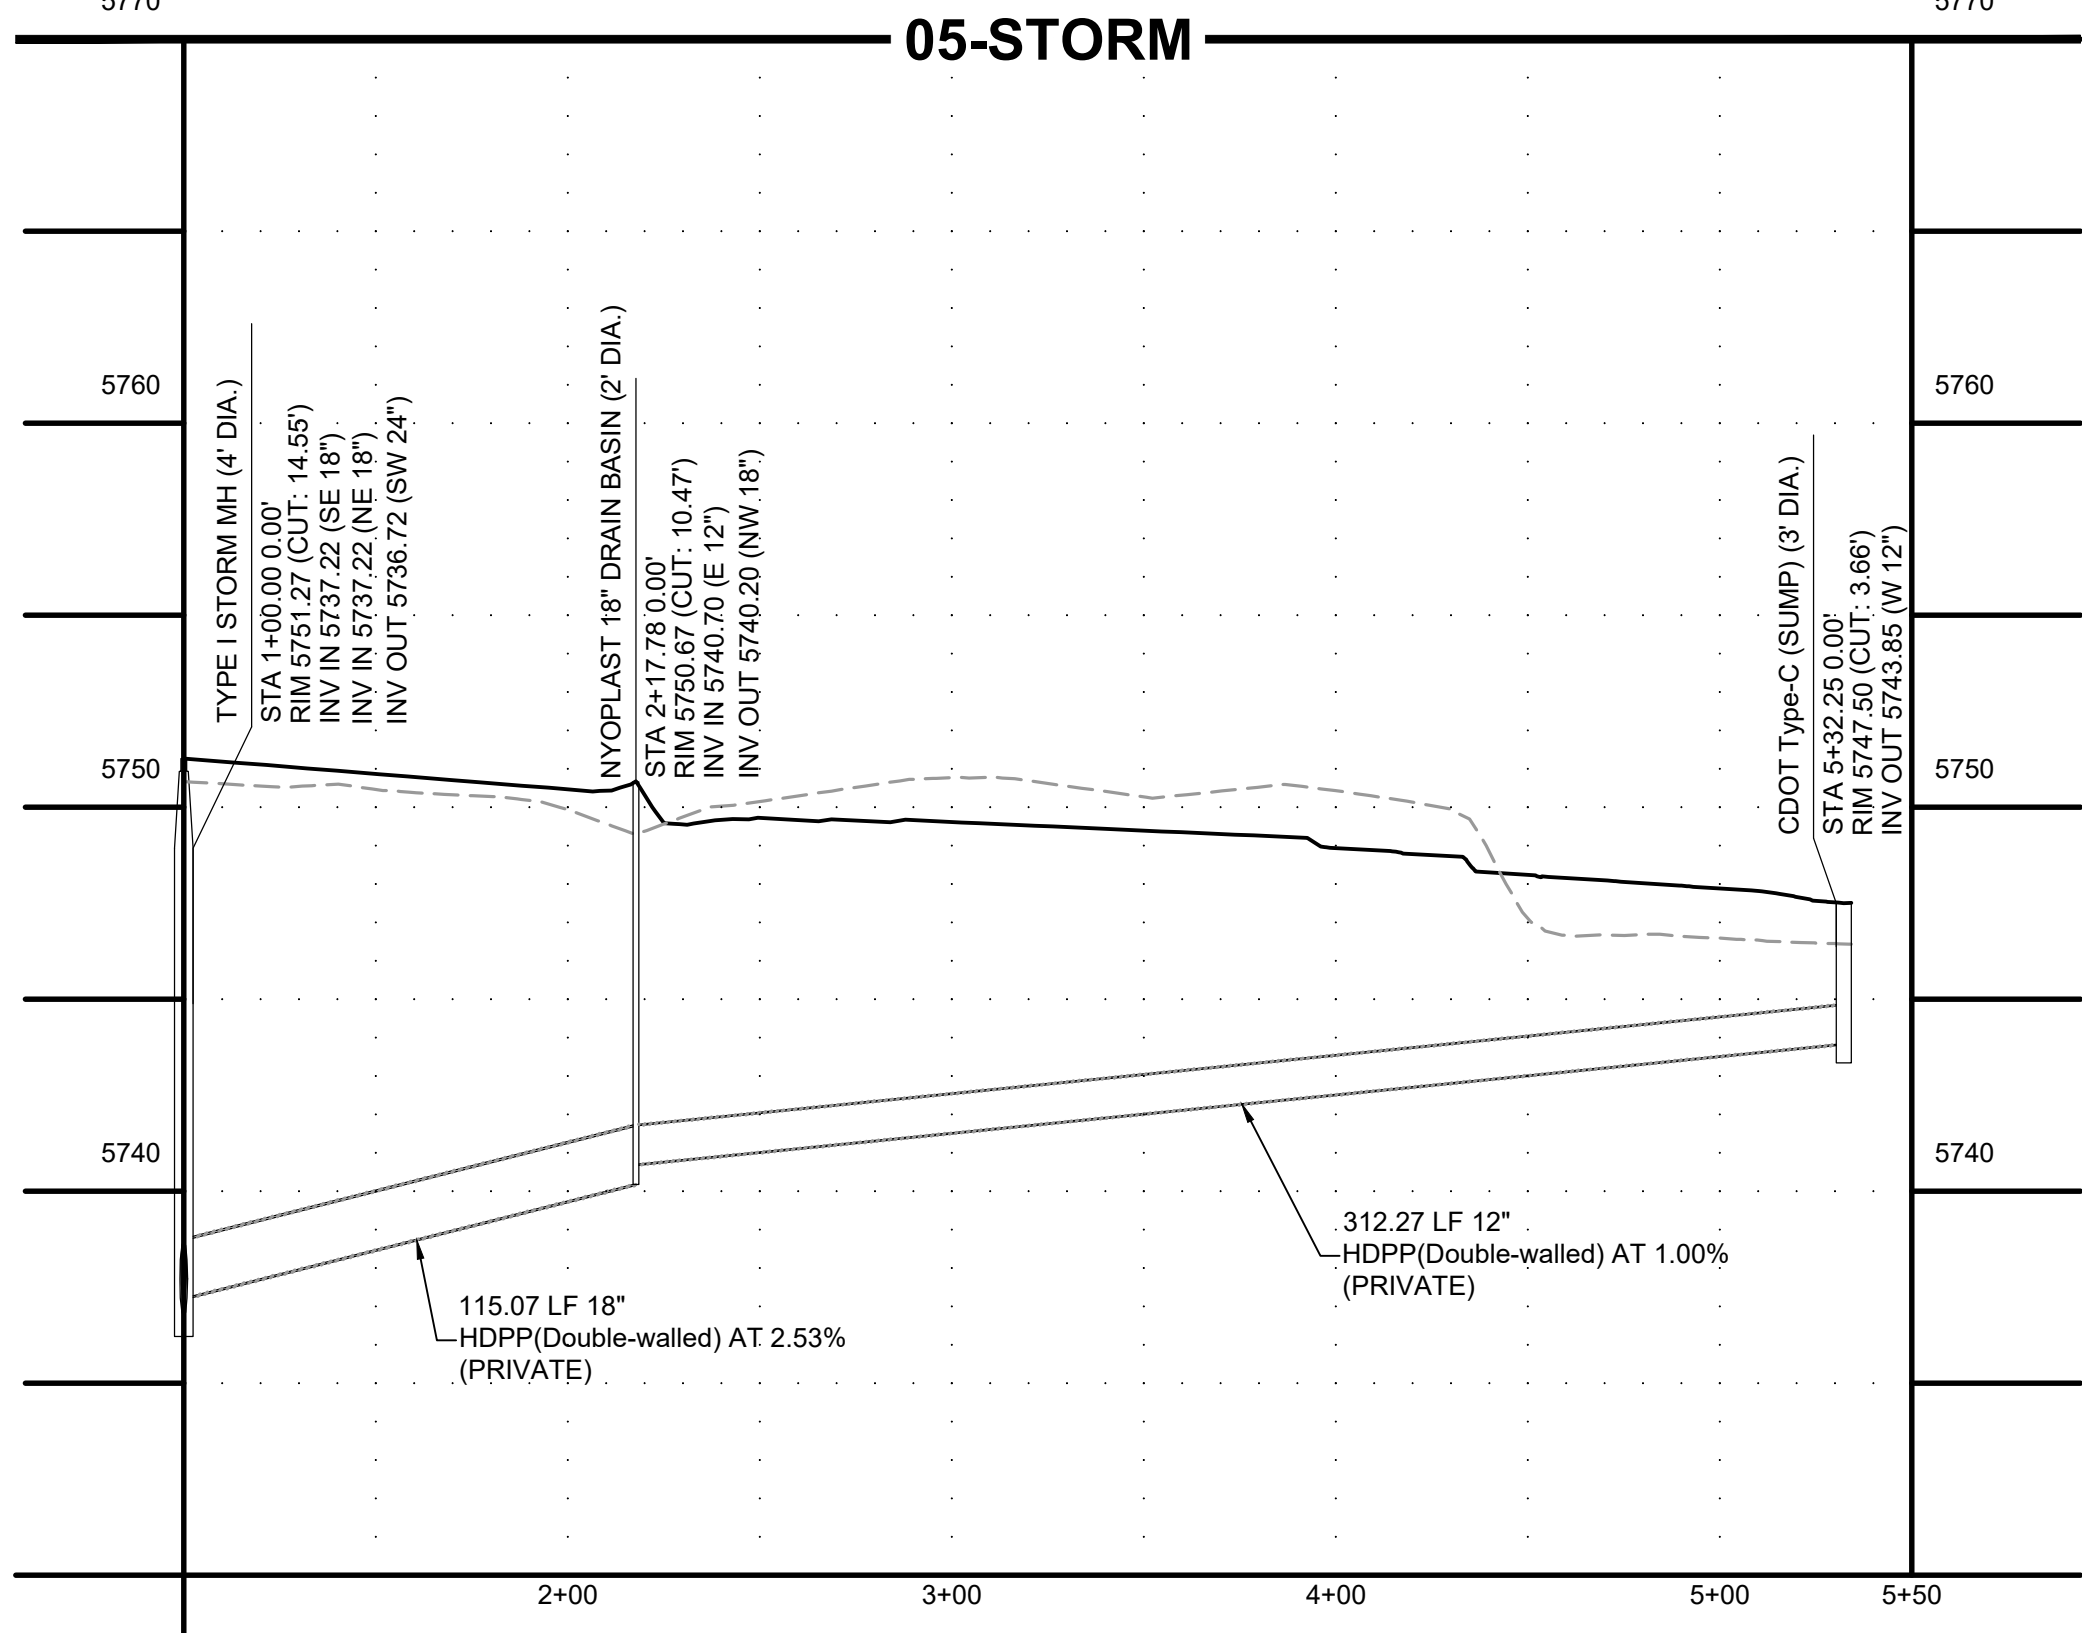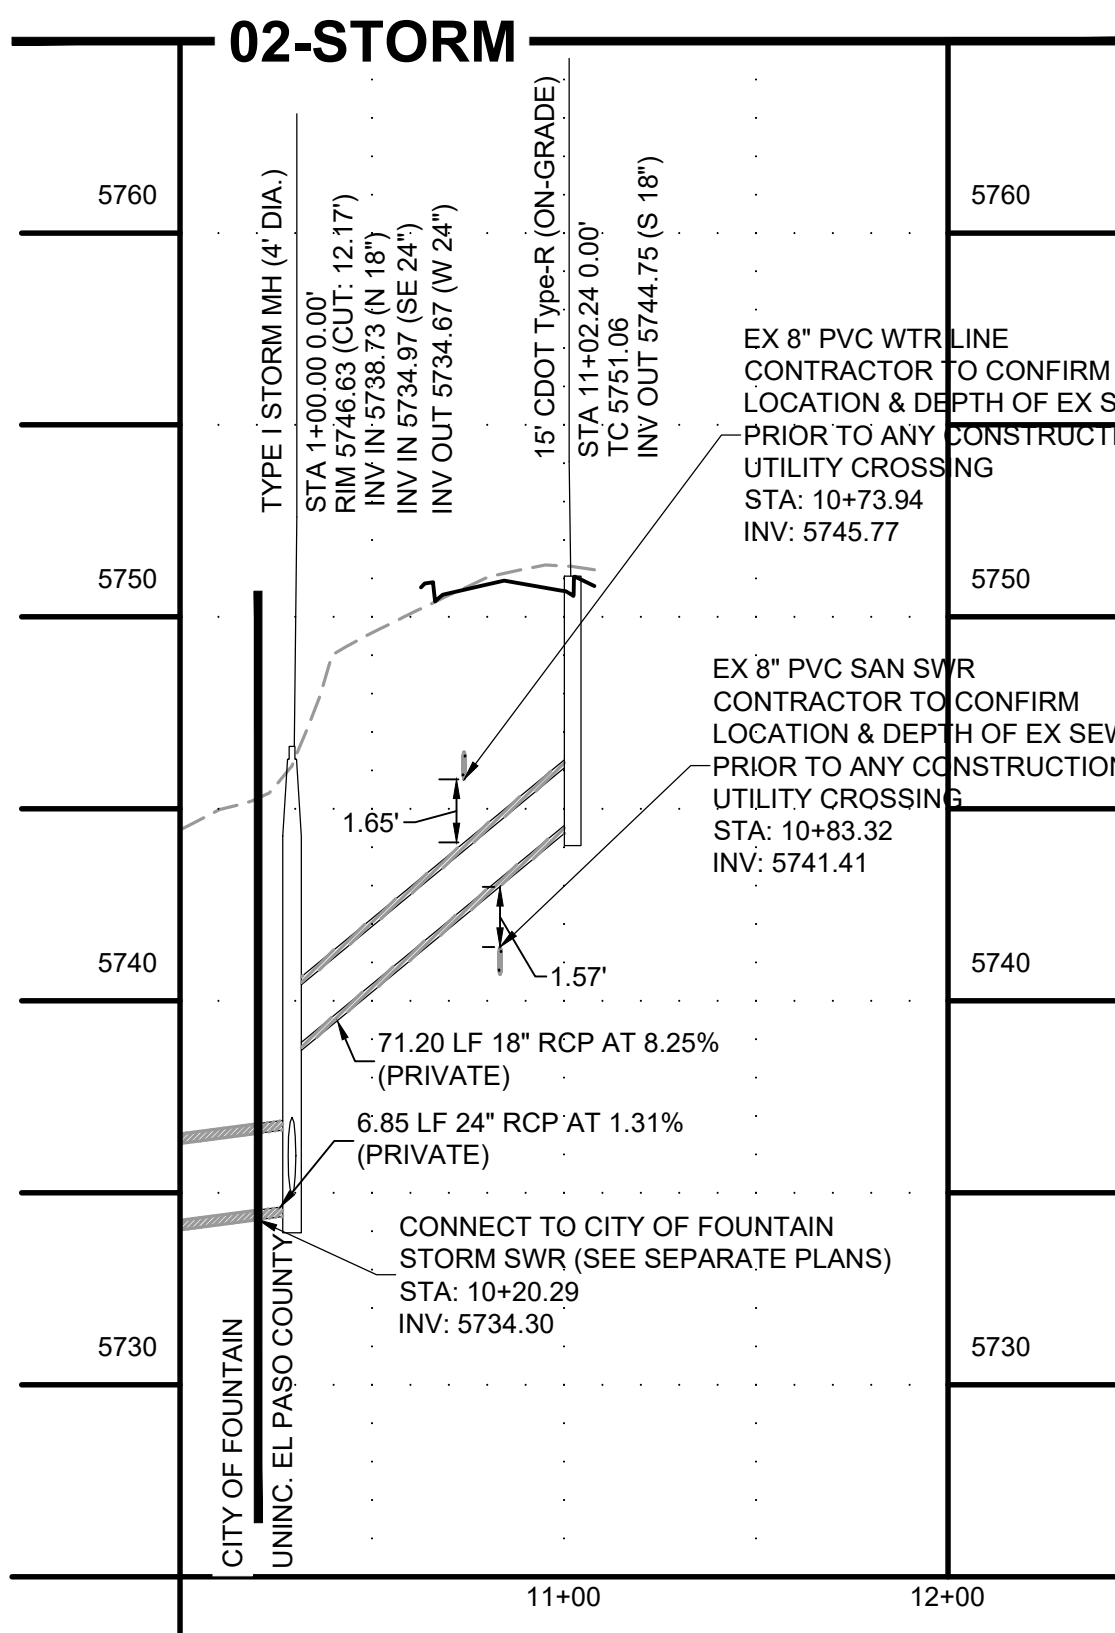

- STORM SEWER CONSTRUCTION NOTES:**
1. ALL RCP STORM SEWER TO BE CLASS III UNLESS OTHERWISE NOTED.
  2. CONTRACTOR SHALL POT HOLE AND VERIFY DEPTH OF EXISTING UTILITY PRIOR TO THE START OF CONSTRUCTION. IF CONFLICTS ARE IDENTIFIED THE CONTRACTOR SHALL CONTACT THE ENGINEER IMMEDIATELY.

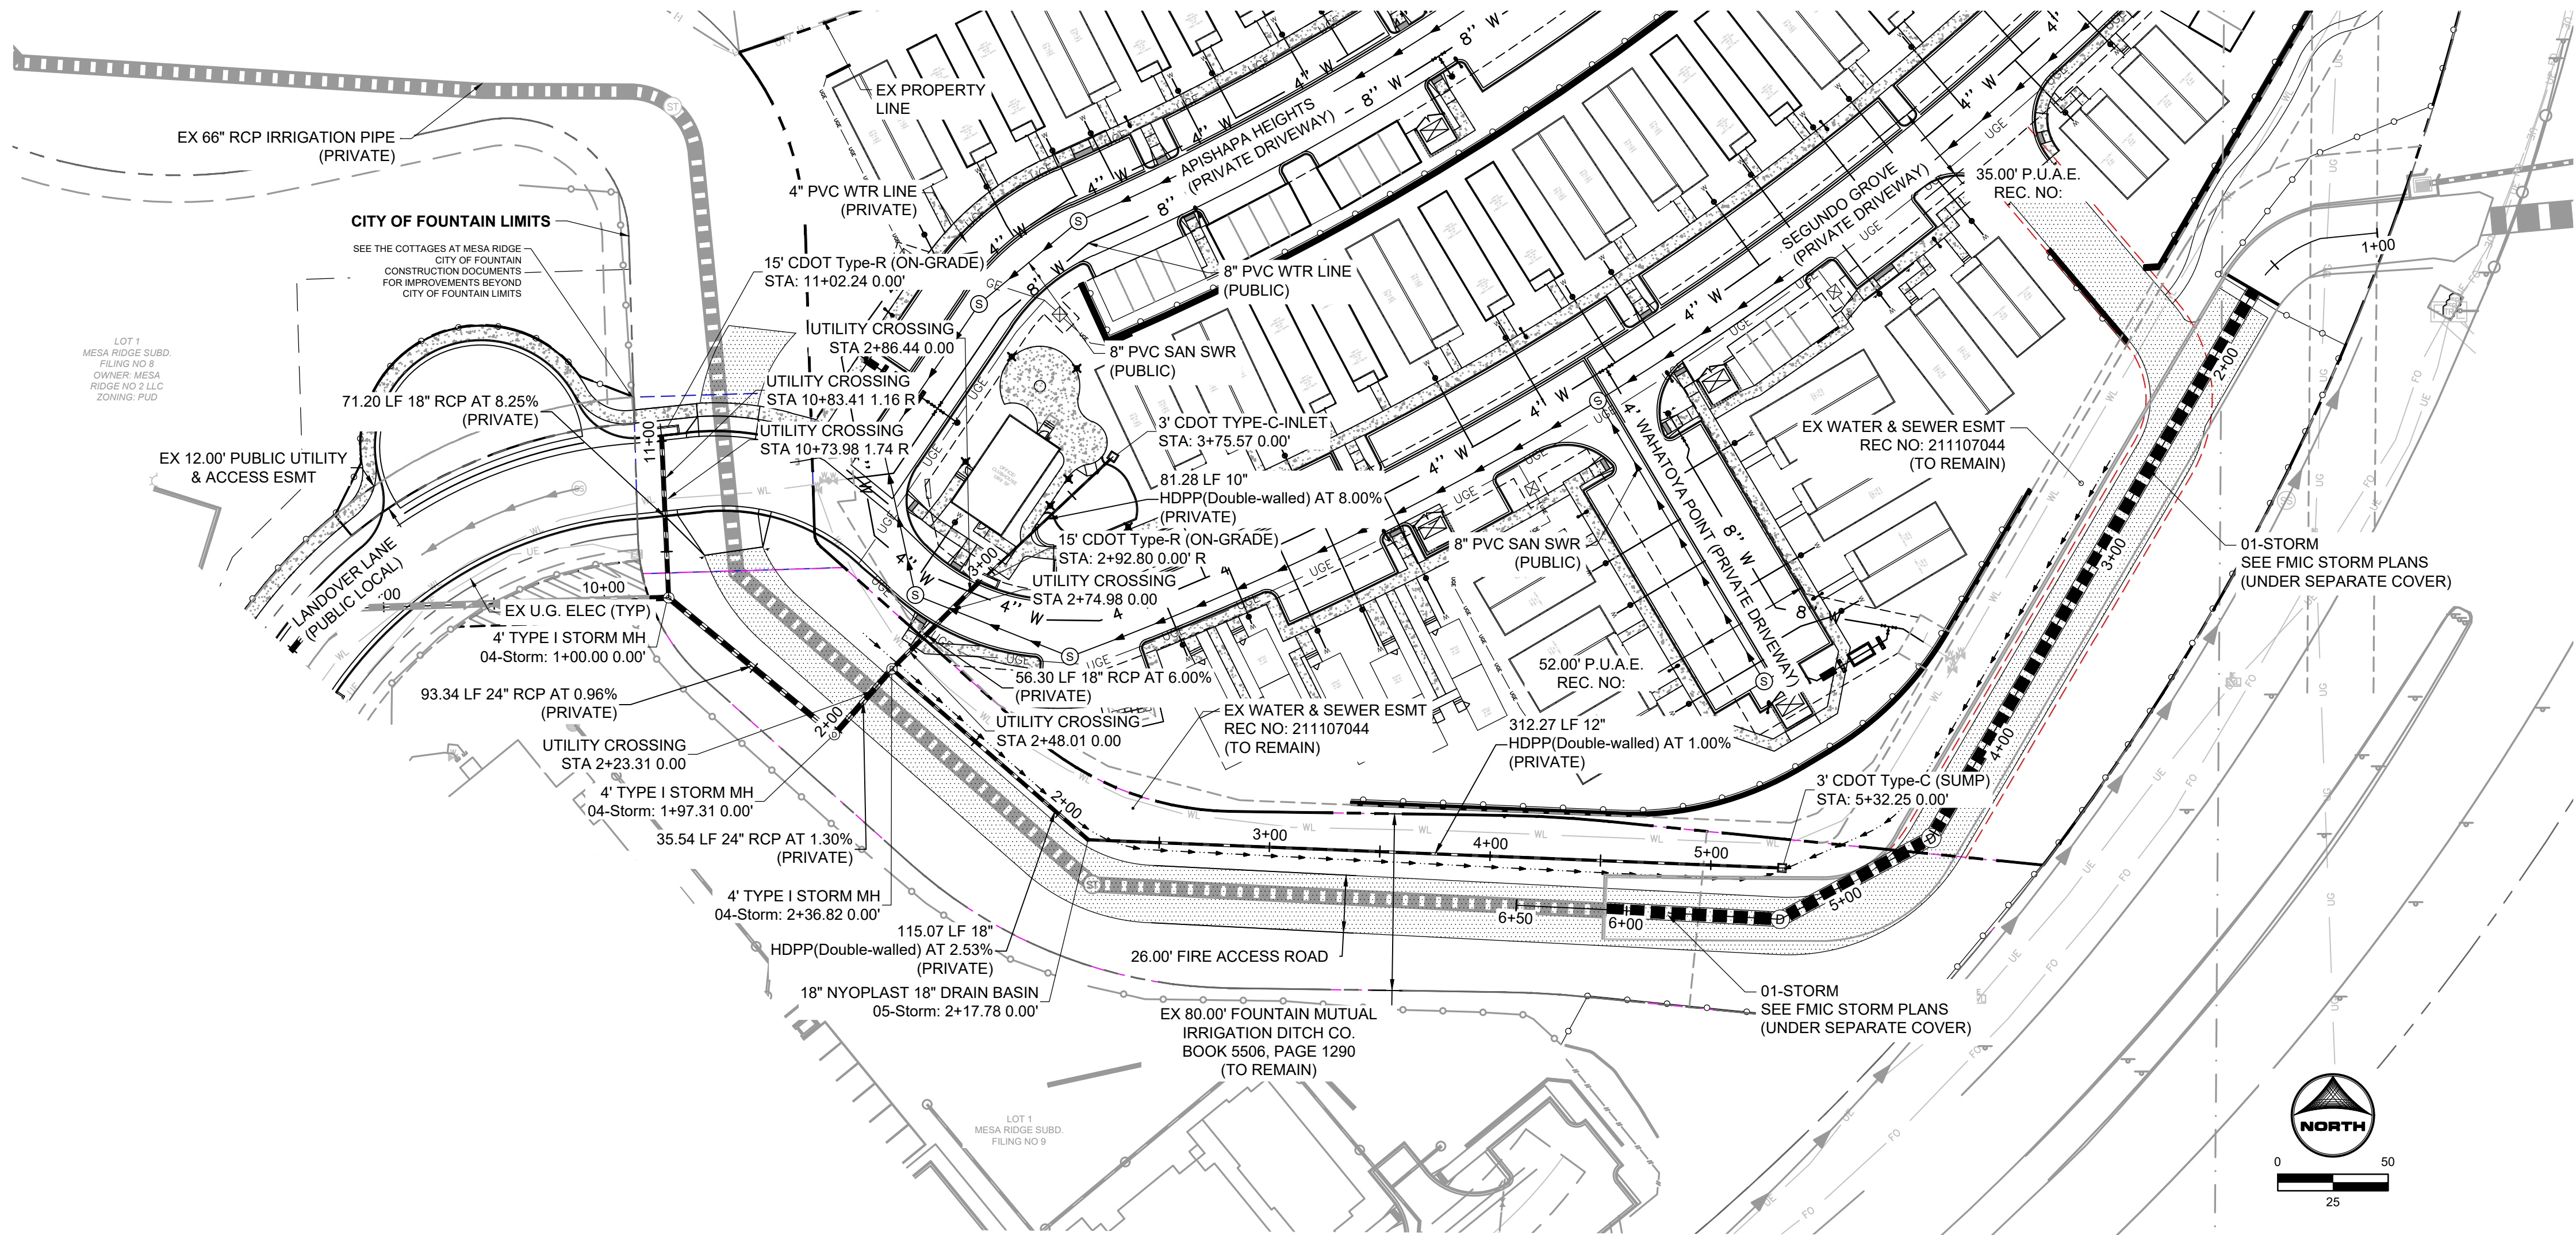

**EL PASO COUNTY STATEMENT**

COUNTY PLAN REVIEW IS PROVIDED ONLY FOR GENERAL CONFORMANCE WITH COUNTY DESIGN CRITERIA. THE COUNTY IS NOT RESPONSIBLE FOR THE ACCURACY AND ADEQUACY OF THE DESIGN, DIMENSIONS, AND/OR ELEVATIONS WHICH SHALL BE CONFIRMED AT THE JOB SITE. THE COUNTY THROUGH THE APPROVAL OF THIS DOCUMENT ASSUMES NO RESPONSIBILITY FOR COMPLETENESS AND/OR ACCURACY OF THIS DOCUMENT.

FILED IN ACCORDANCE WITH THE REQUIREMENTS OF THE EL PASO COUNTY LAND DEVELOPMENT CODE, DRAINAGE CRITERIA MANUAL VOLUMES 1 AND 2 & ENGINEERING CRITERIA MANUAL AS AMENDED.

IN ACCORDANCE WITH ECM SECTION 1.12, THESE CONSTRUCTION DOCUMENTS WILL BE VALID FOR CONSTRUCTION FOR A PERIOD OF 2 YEARS FROM THE DATE SIGNED BY THE EL PASO COUNTY ENGINEER. IF CONSTRUCTION HAS NOT STARTED WITHIN THOSE 2 YEARS, THE PLANS WILL NEED TO BE RESUBMITTED FOR APPROVAL, INCLUDING PAYMENT OF REVIEW FEES AT THE PLANNING AND COMMUNITY DEVELOPMENT DIRECTORS DISCRETION.

JENNIFER IRVINE, P.E. \_\_\_\_\_ DATE \_\_\_\_\_  
COUNTY ENGINEER/ ECM ADMINISTRATOR

HR GREEN:  
ADDRESSED.

**EL PASO COUNTY ENGINEER  
STORM PLAN DESIGN APPROVAL**

PROJECT NUMBER: \_\_\_\_\_  
WORK ORDER NUMBER: \_\_\_\_\_  
SHEET \_\_\_\_\_ OF \_\_\_\_\_

APPROVAL EXPIRES ONE (1) YEAR FROM THE DATE ABOVE AND RESUBMITTAL OF THESE PLANS FOR REVIEW AND APPROVAL IS REQUIRED IF CONSTRUCTION DOES NOT BEGIN DURING THIS PERIOD.

CD FILE NO.: SF2214

DRAWN BY: CBM JOB DATE: 8/31/2022  
APPROVED: KMH JOB NUMBER: 200541  
CAD DATE: 8/31/2022  
CAD FILE: J:\2020\200541\CAD\DWG\CD\CDIE\_Paso\_Co\Storm

BAR IS ONE INCH ON  
OFFICIAL DRAWINGS.  
IF NOT ONE INCH,  
ADJUST SCALE ACCORDINGLY.

NO.	DATE	BY	REVISION DESCRIPTION

HR GREEN - COLORADO SPRINGS  
7222 COMMERCE CENTER DR SUITE 220  
COLORADO SPRINGS CO 80919  
PHONE: 719.300.4140 TOLL FREE: 800.728.7805  
FAX: 844.273.1057 | HRGreen.com

THE COTTAGES AT MESA RIDGE  
GOODWIN KNIGHT  
EL PASO COUNTY, COLORADO



EL PASO COUNTY CONSTRUCTION DOCUMENTS  
STORM SEWER PLAN AND PROFILE





SHEET  
STM

27



















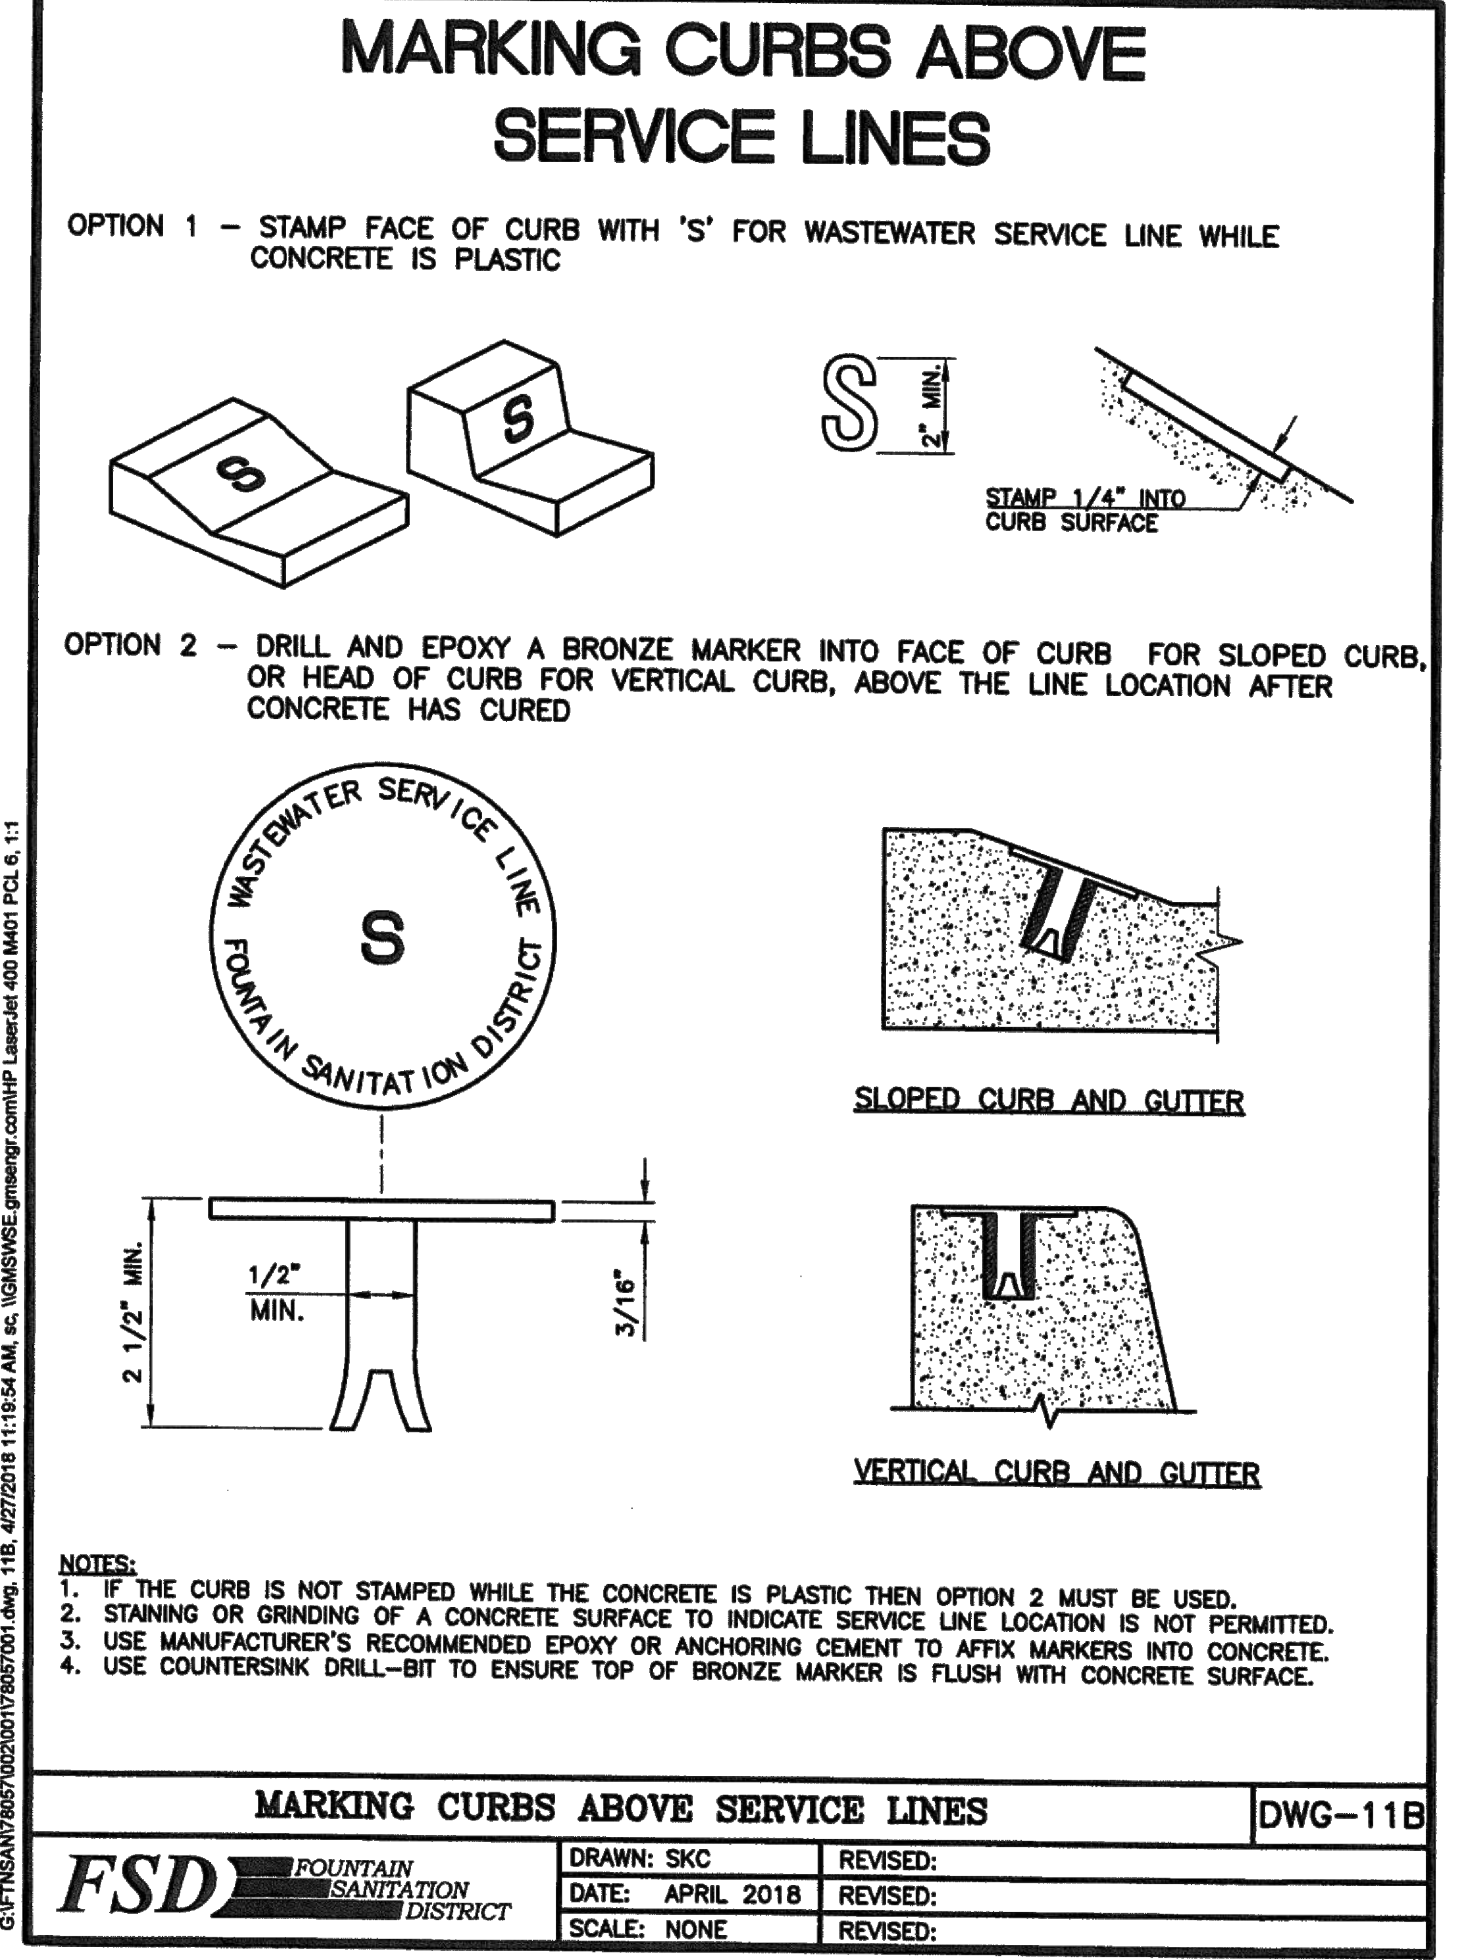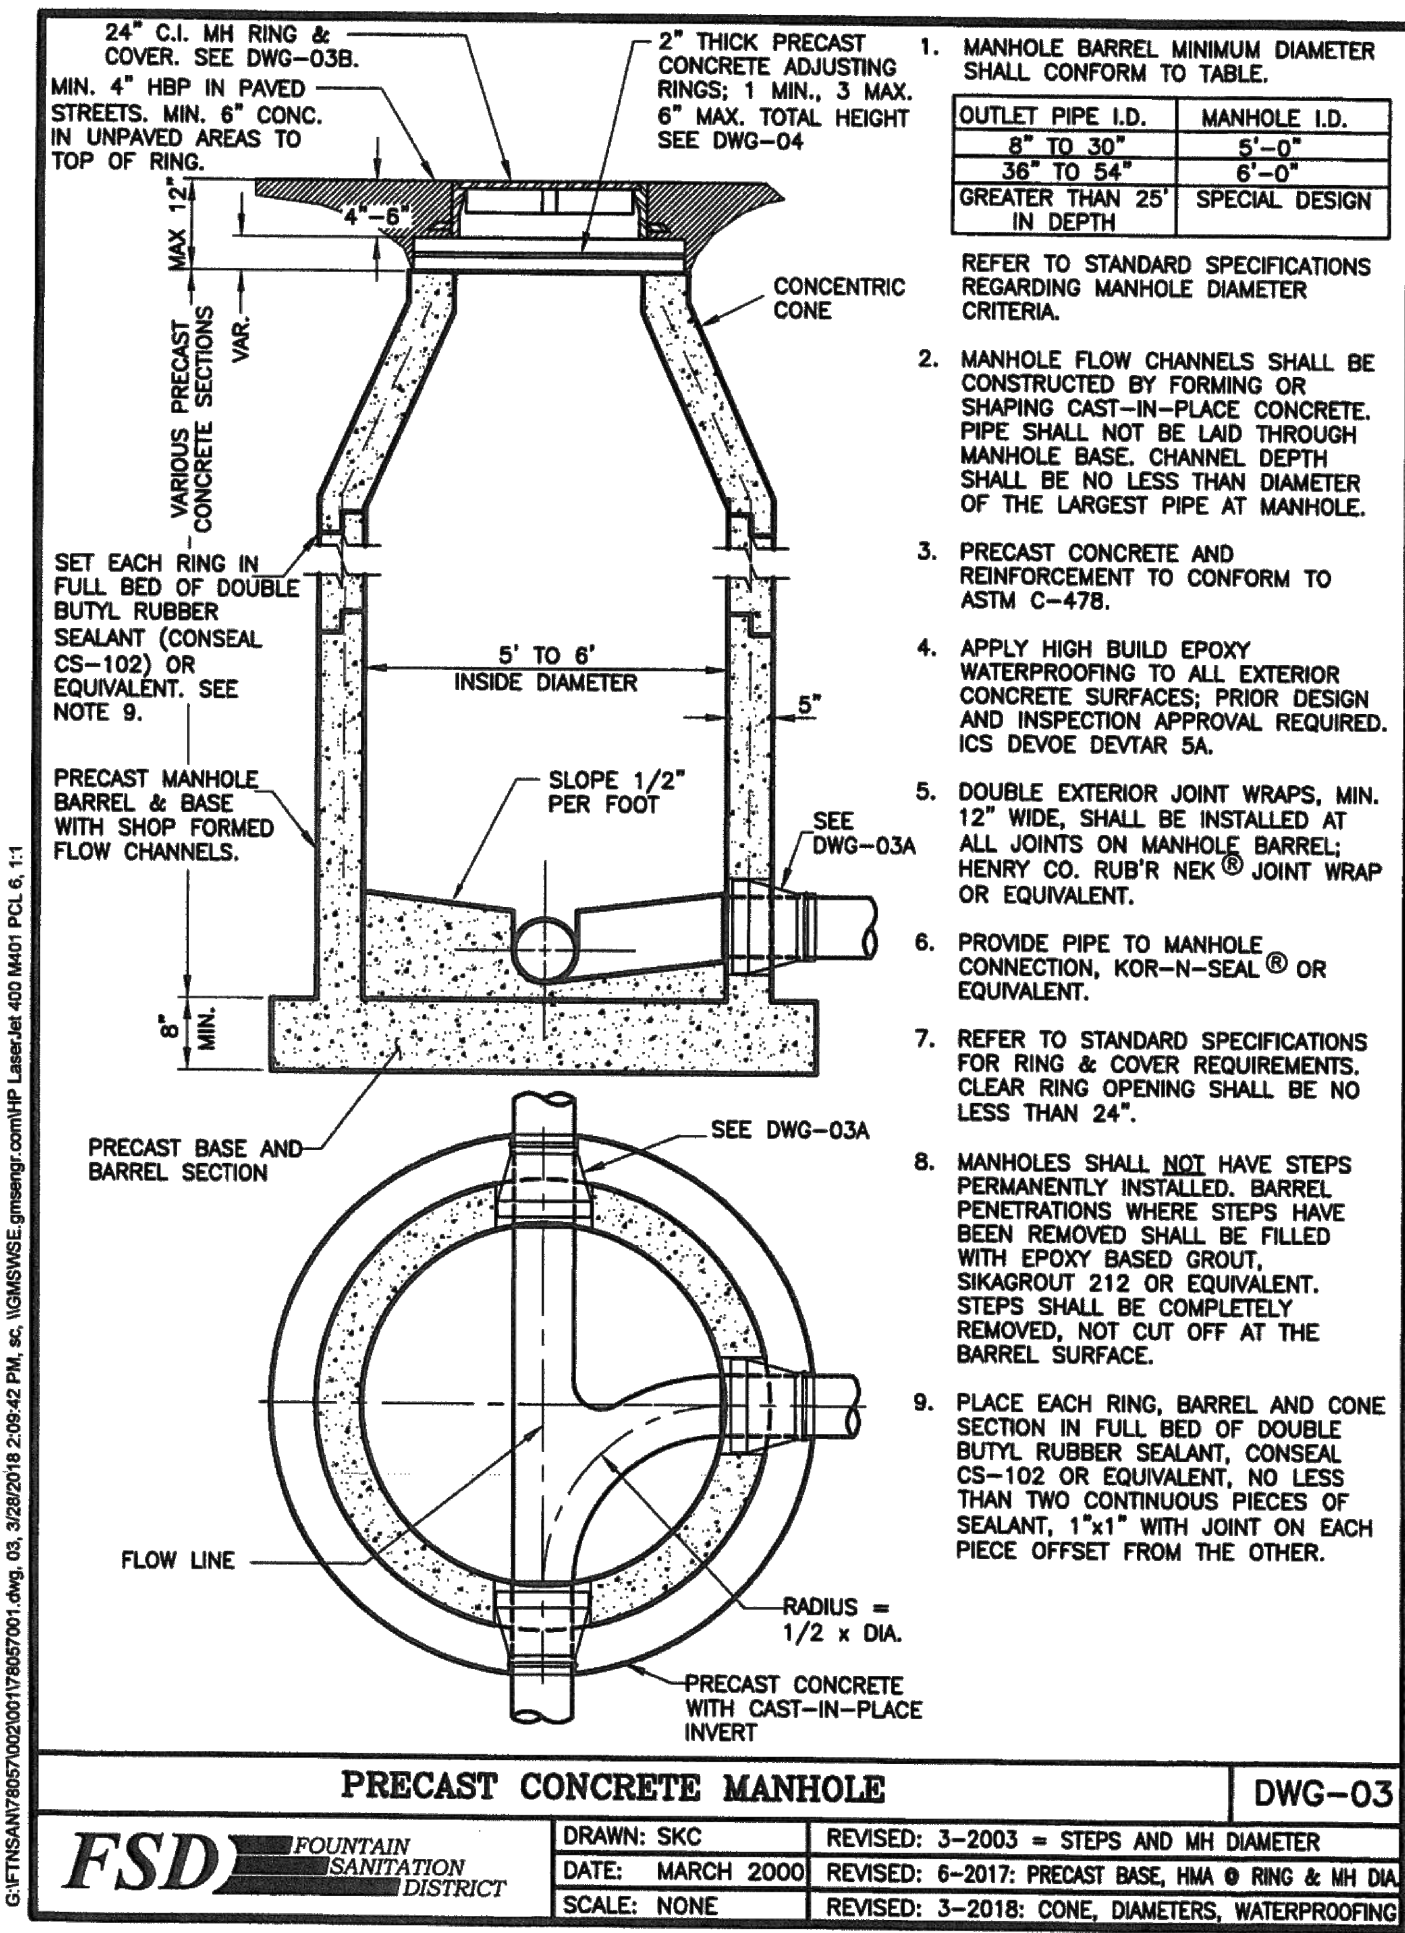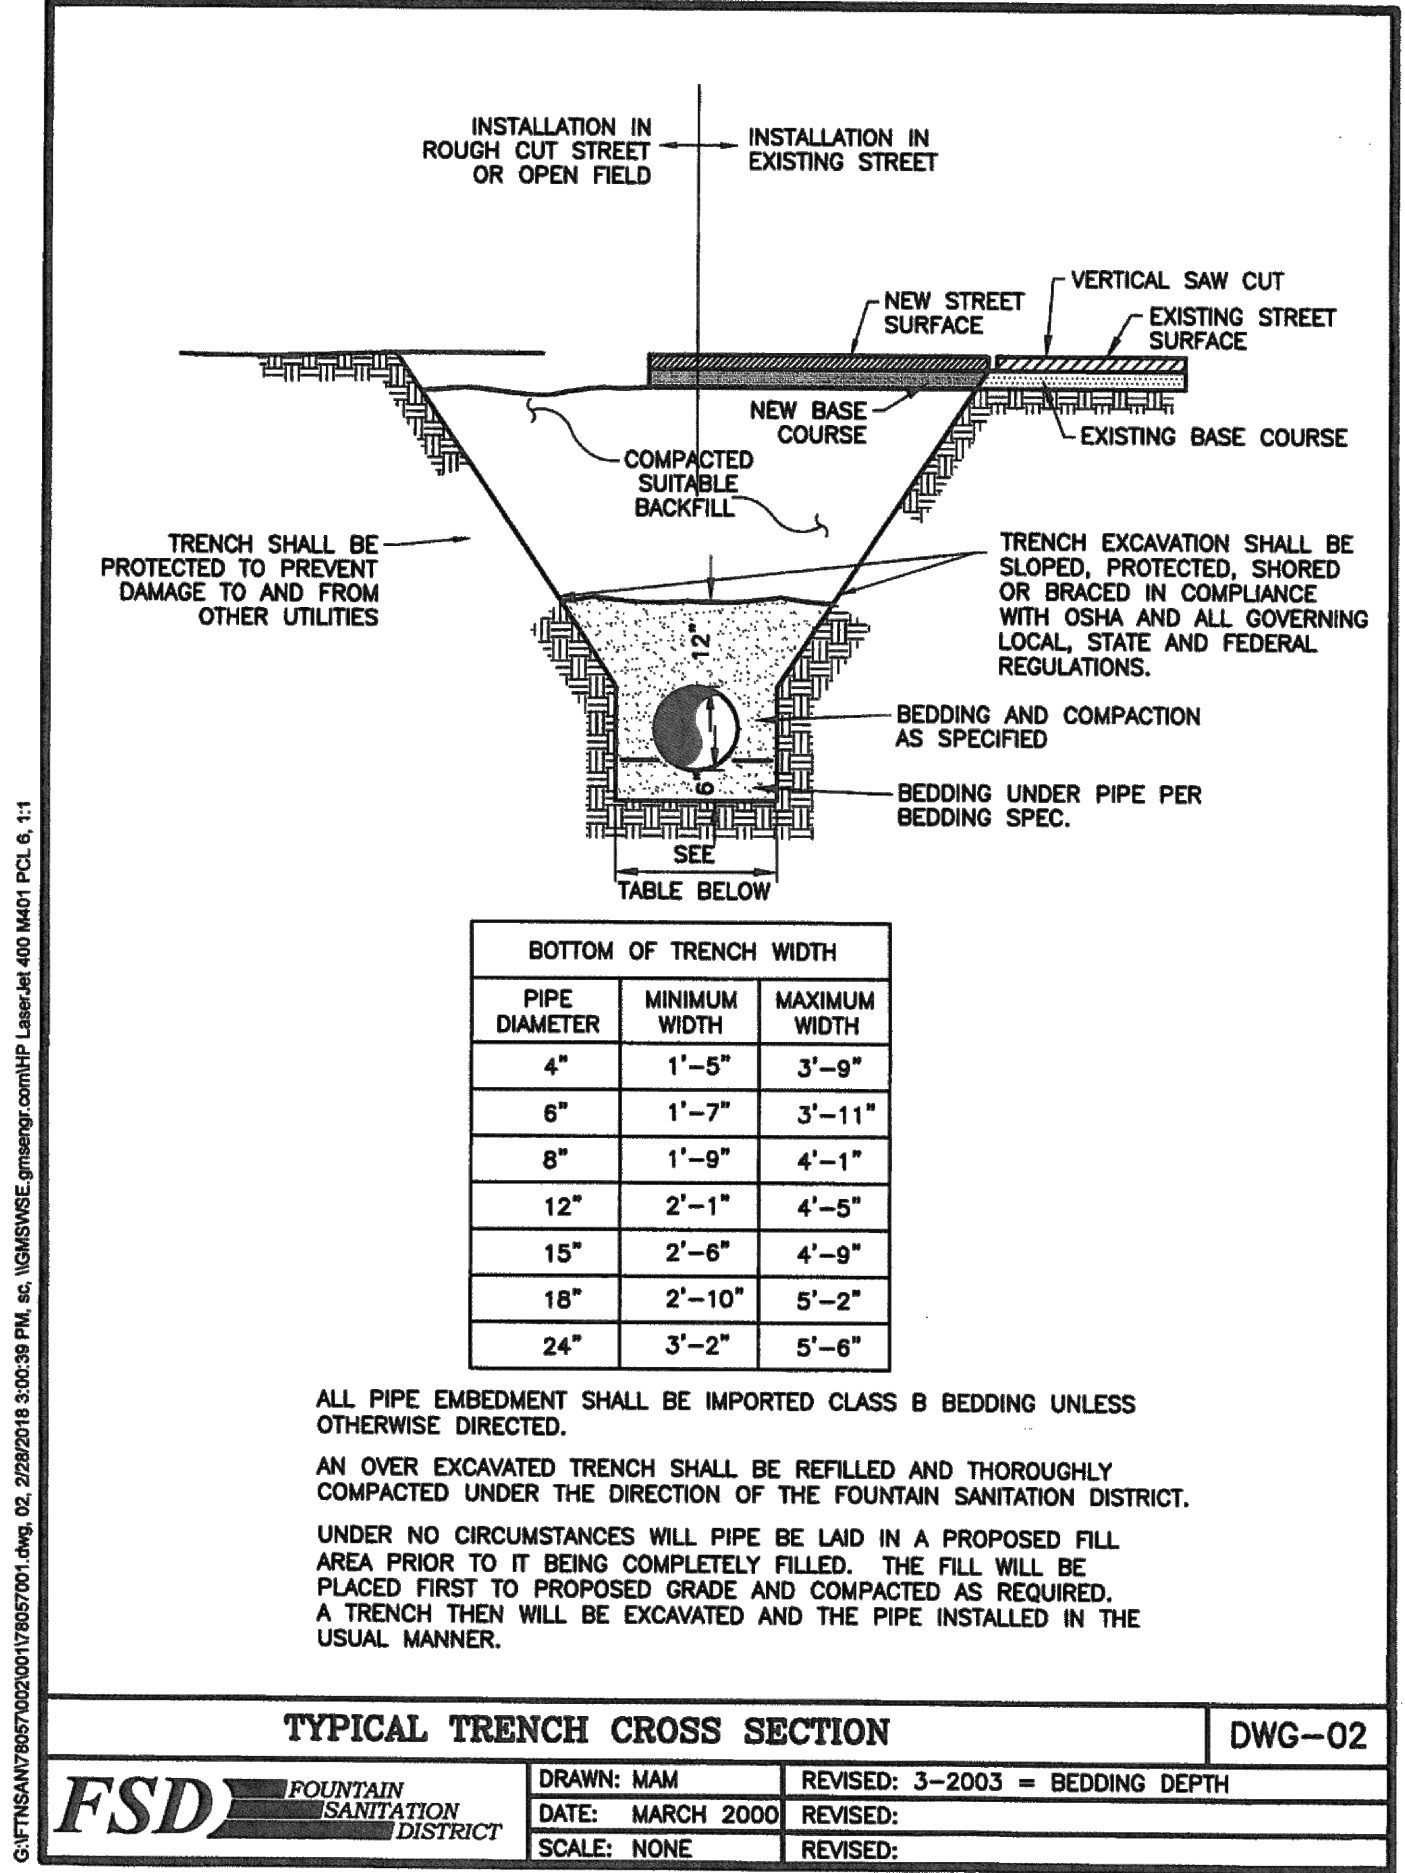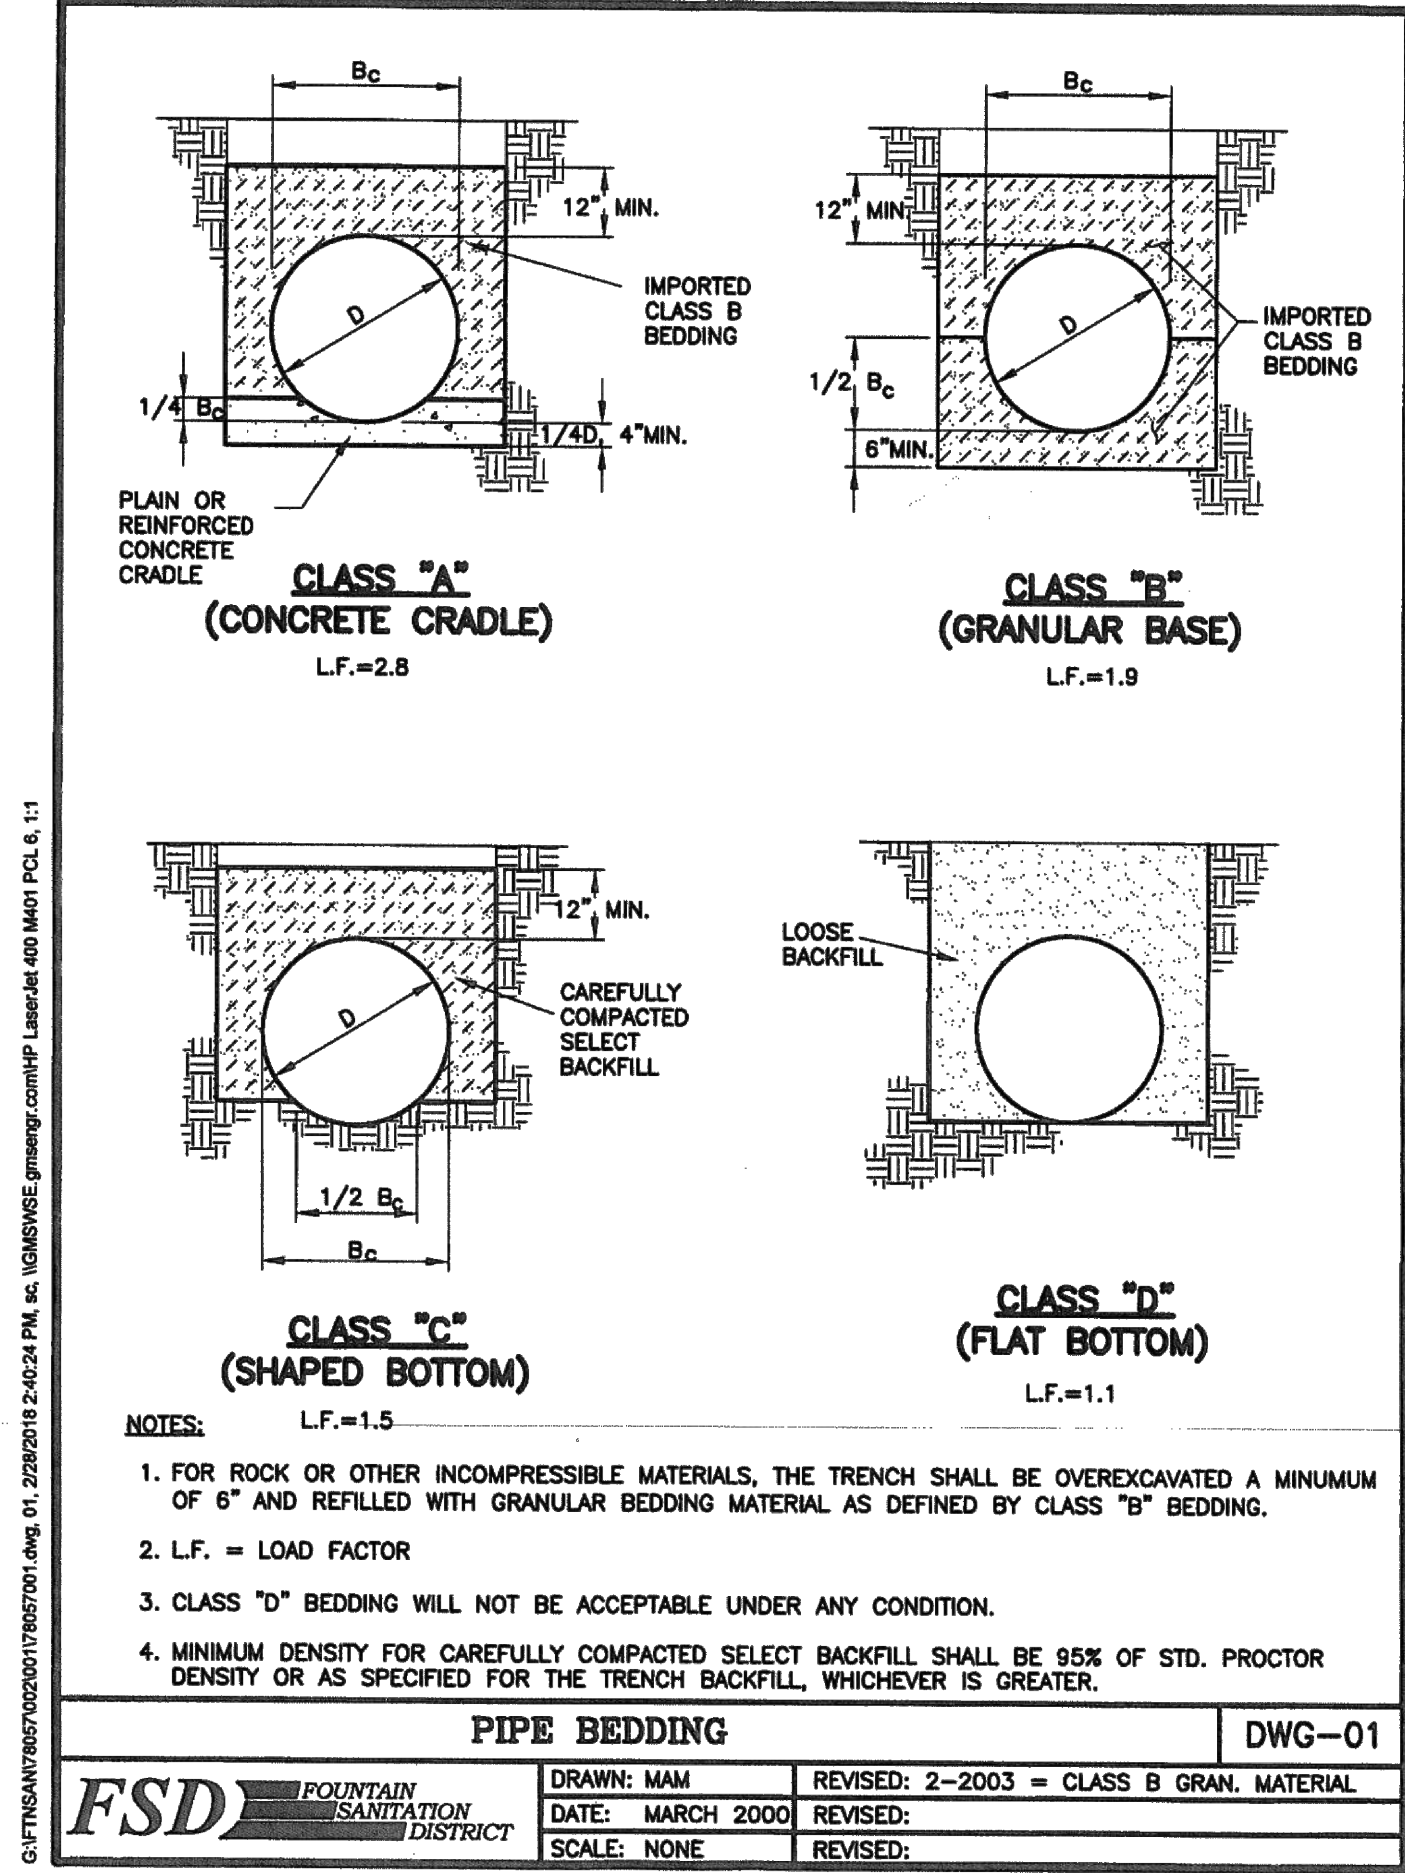








## Stabilized Staging Area (SSA) SM-6

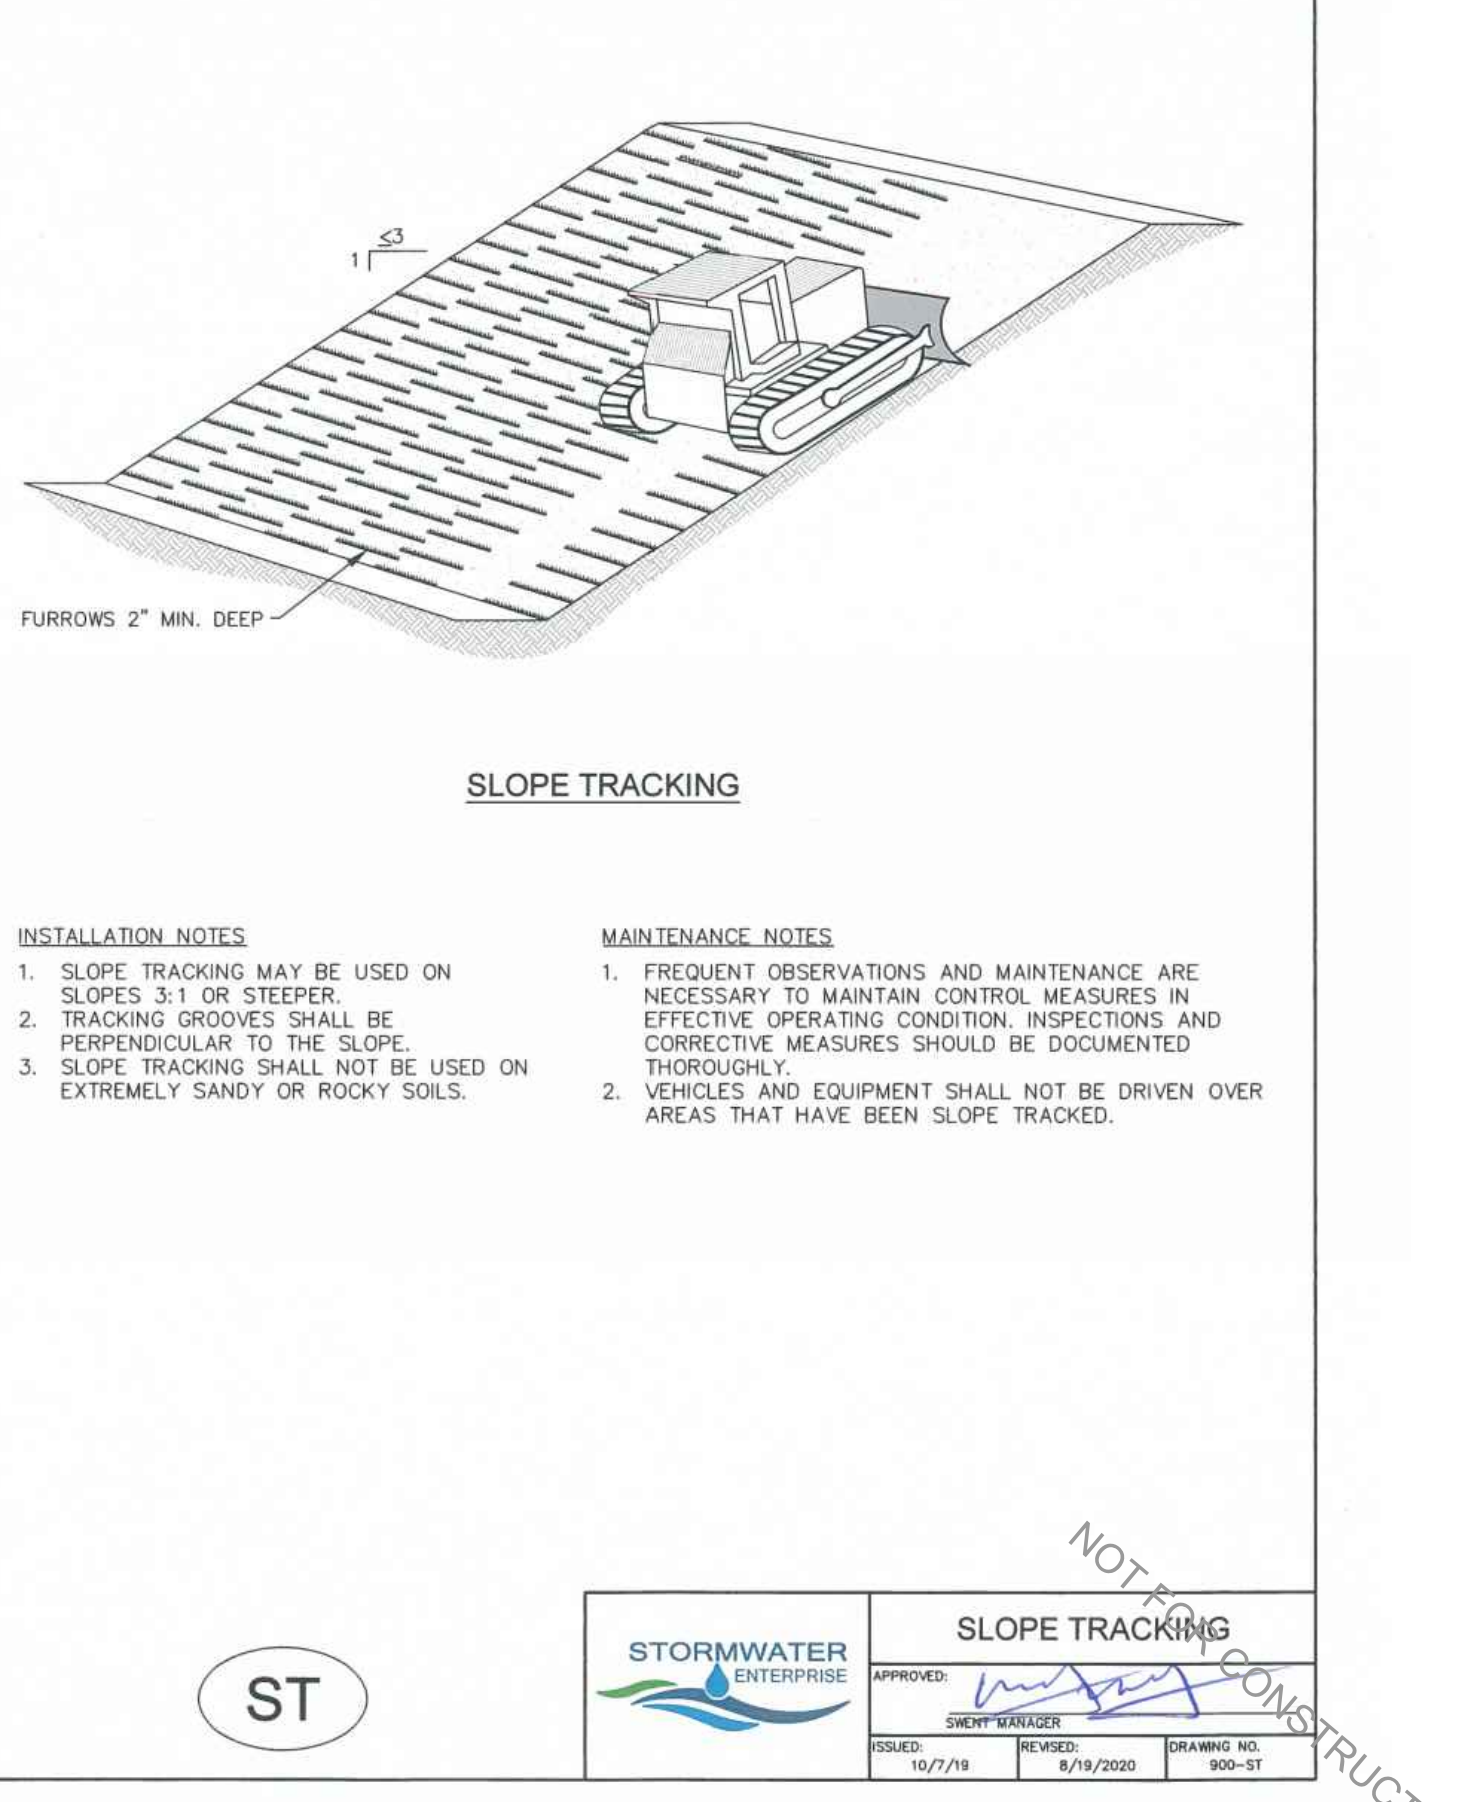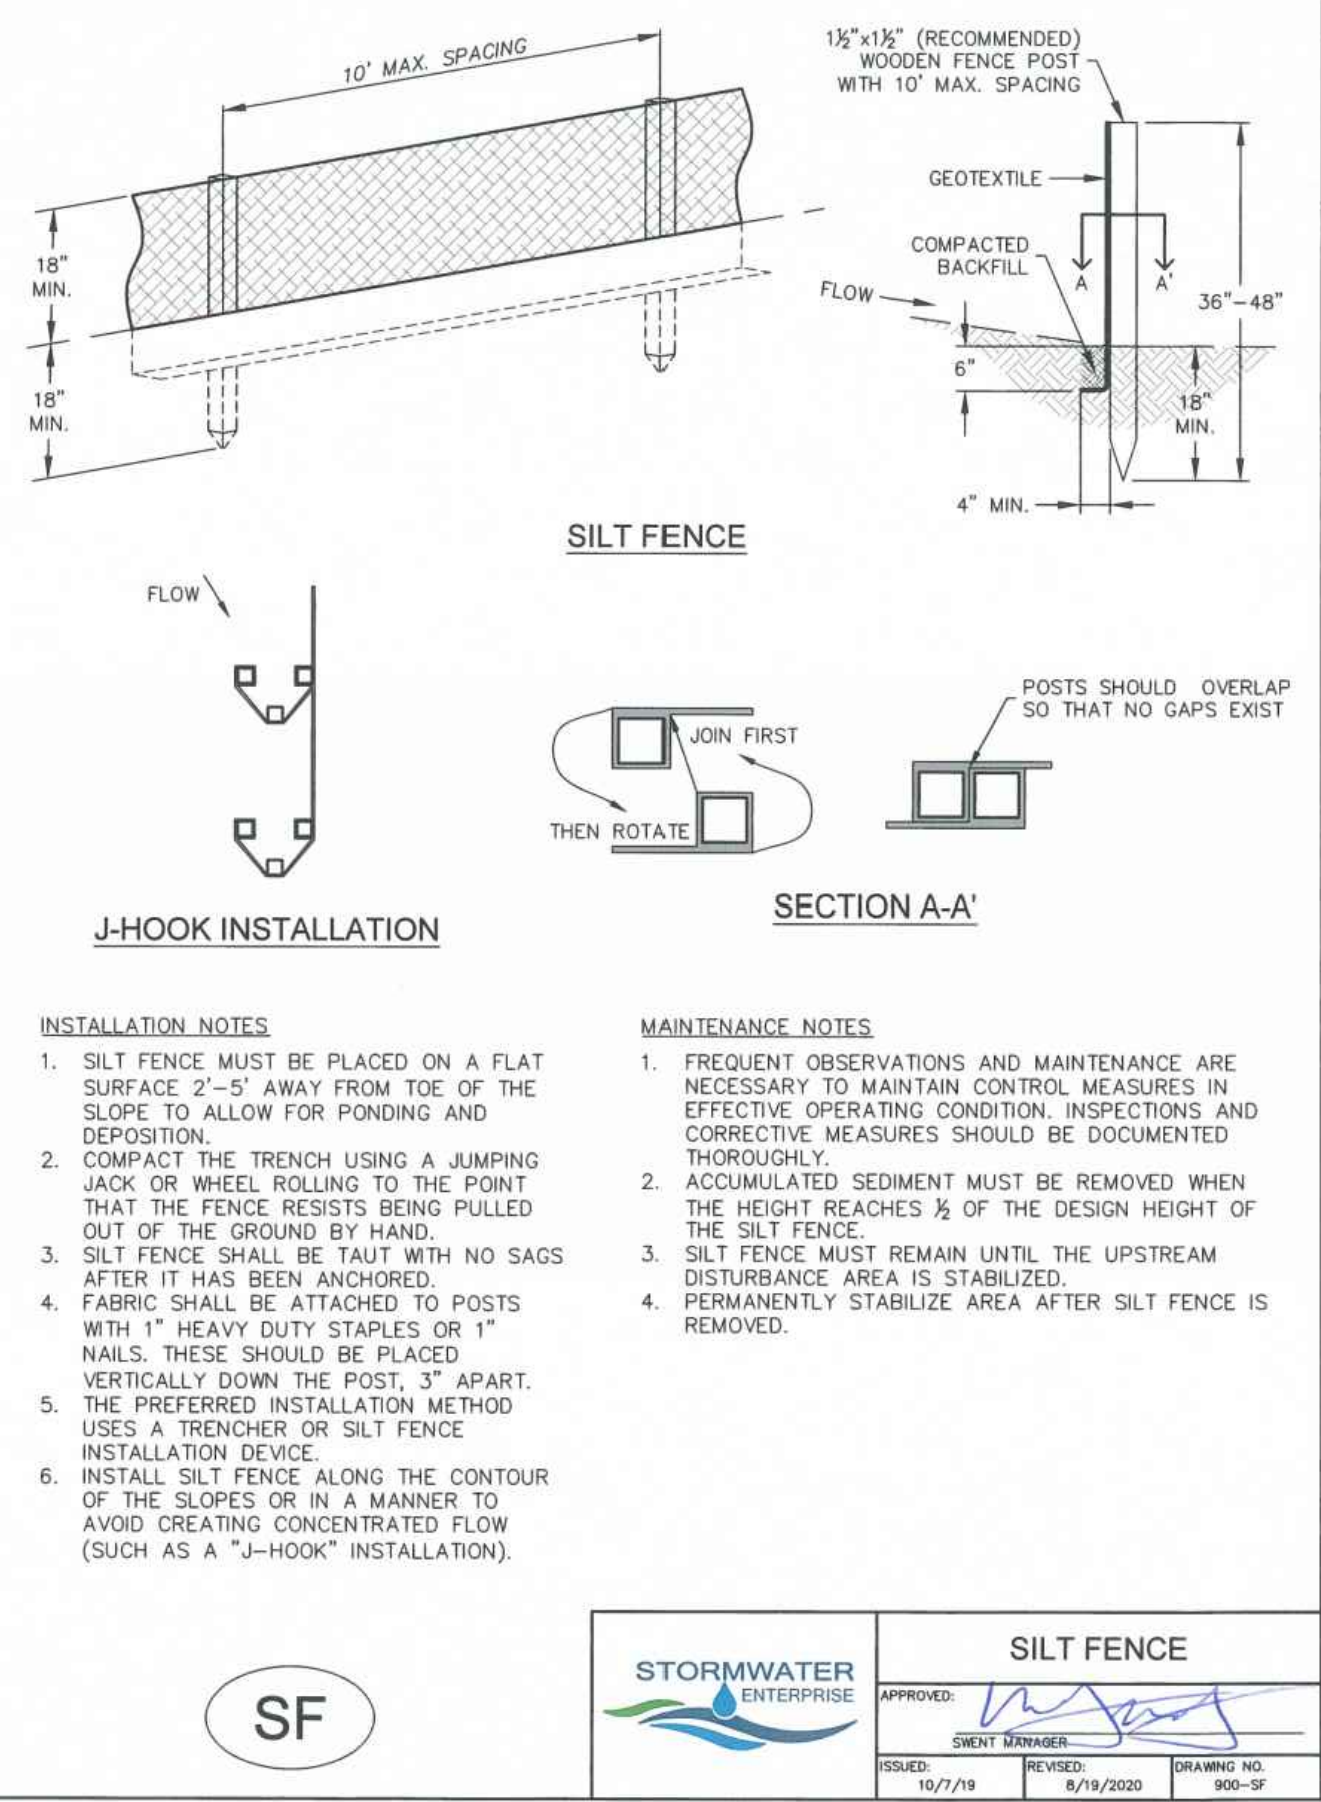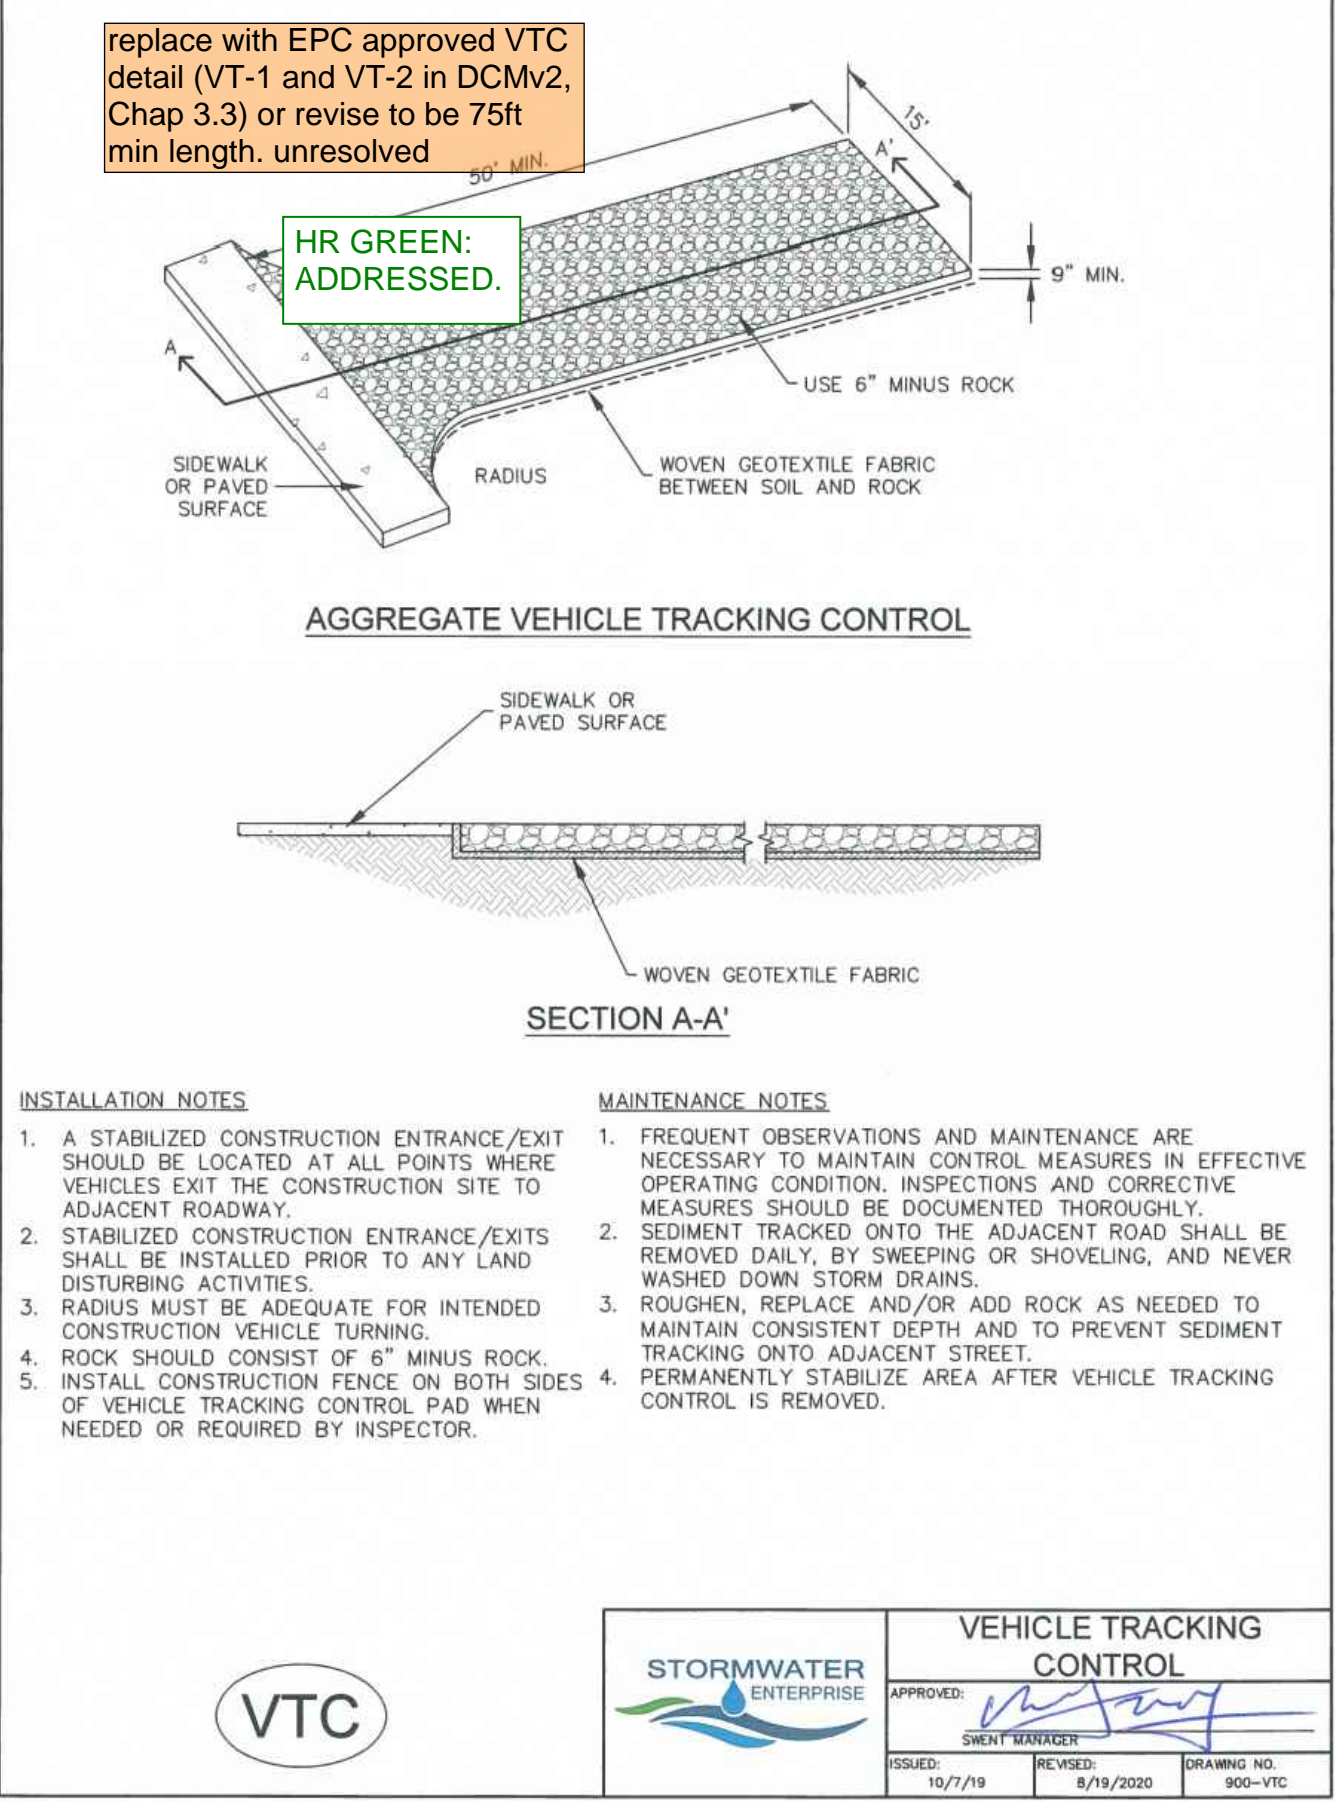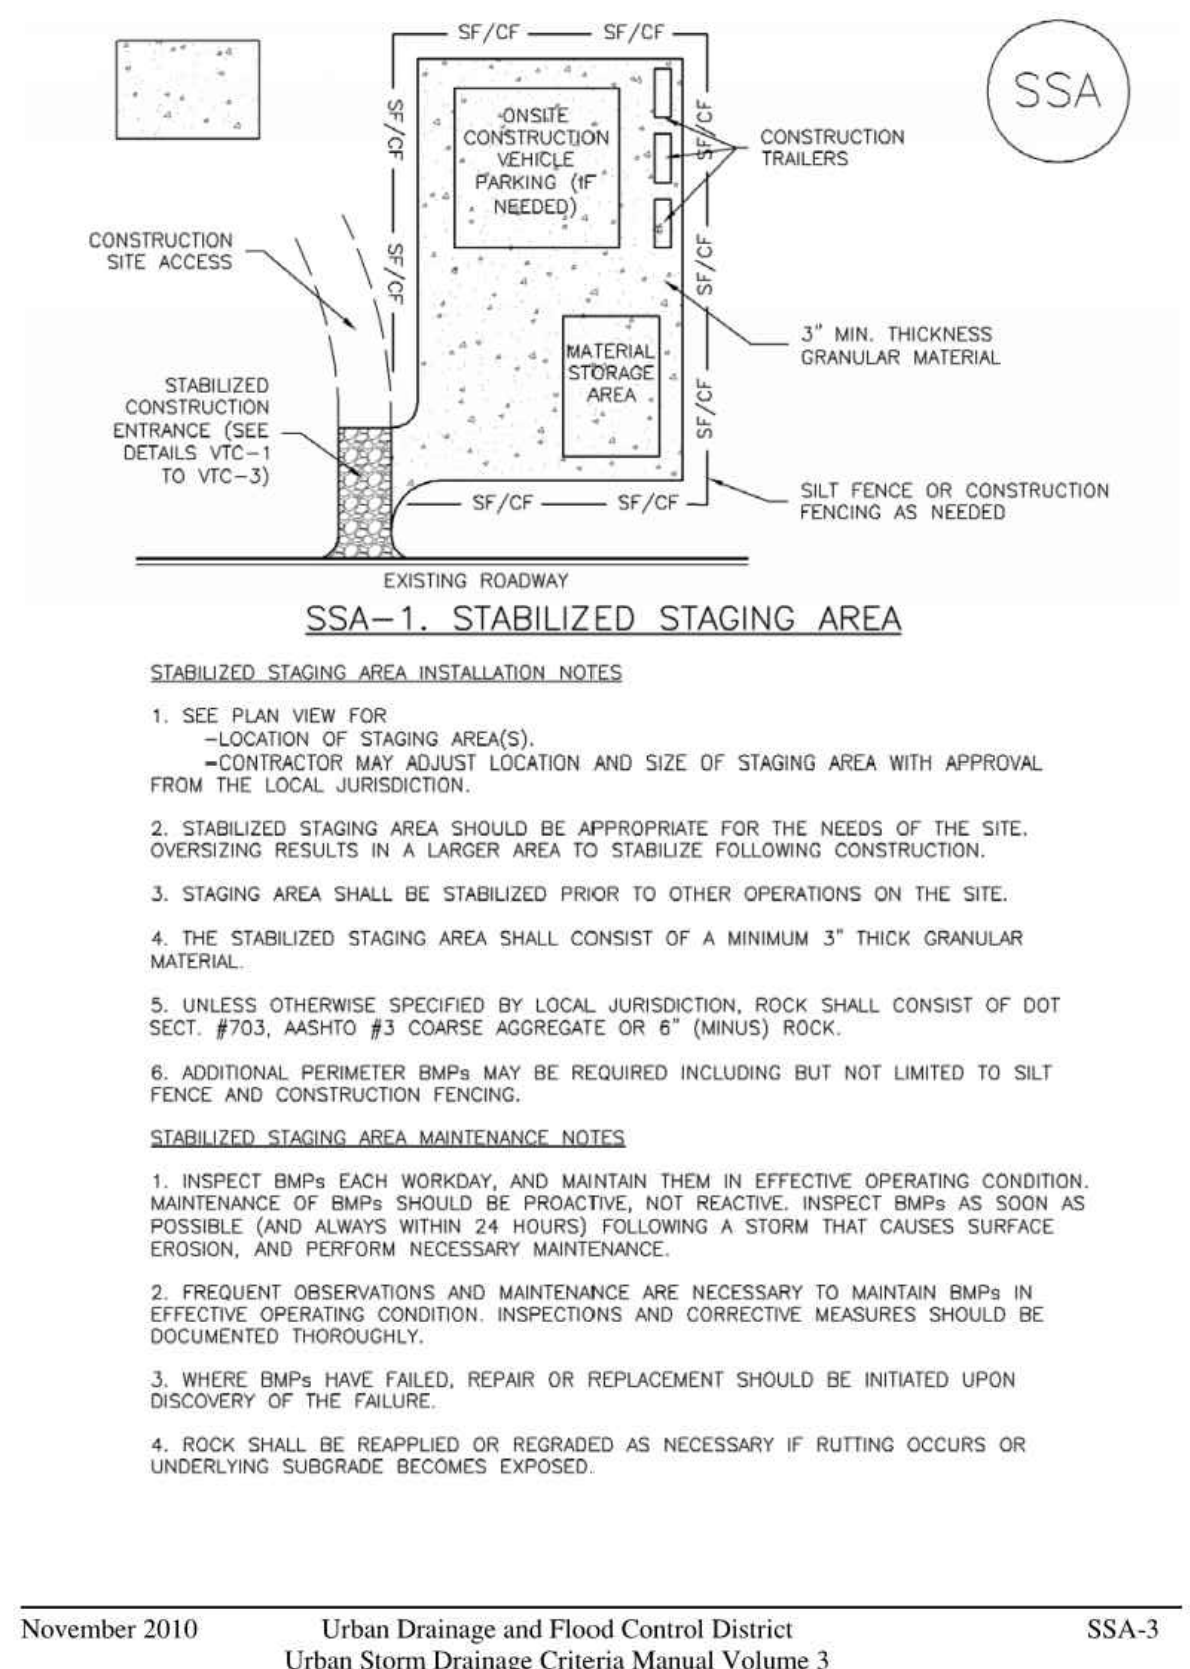





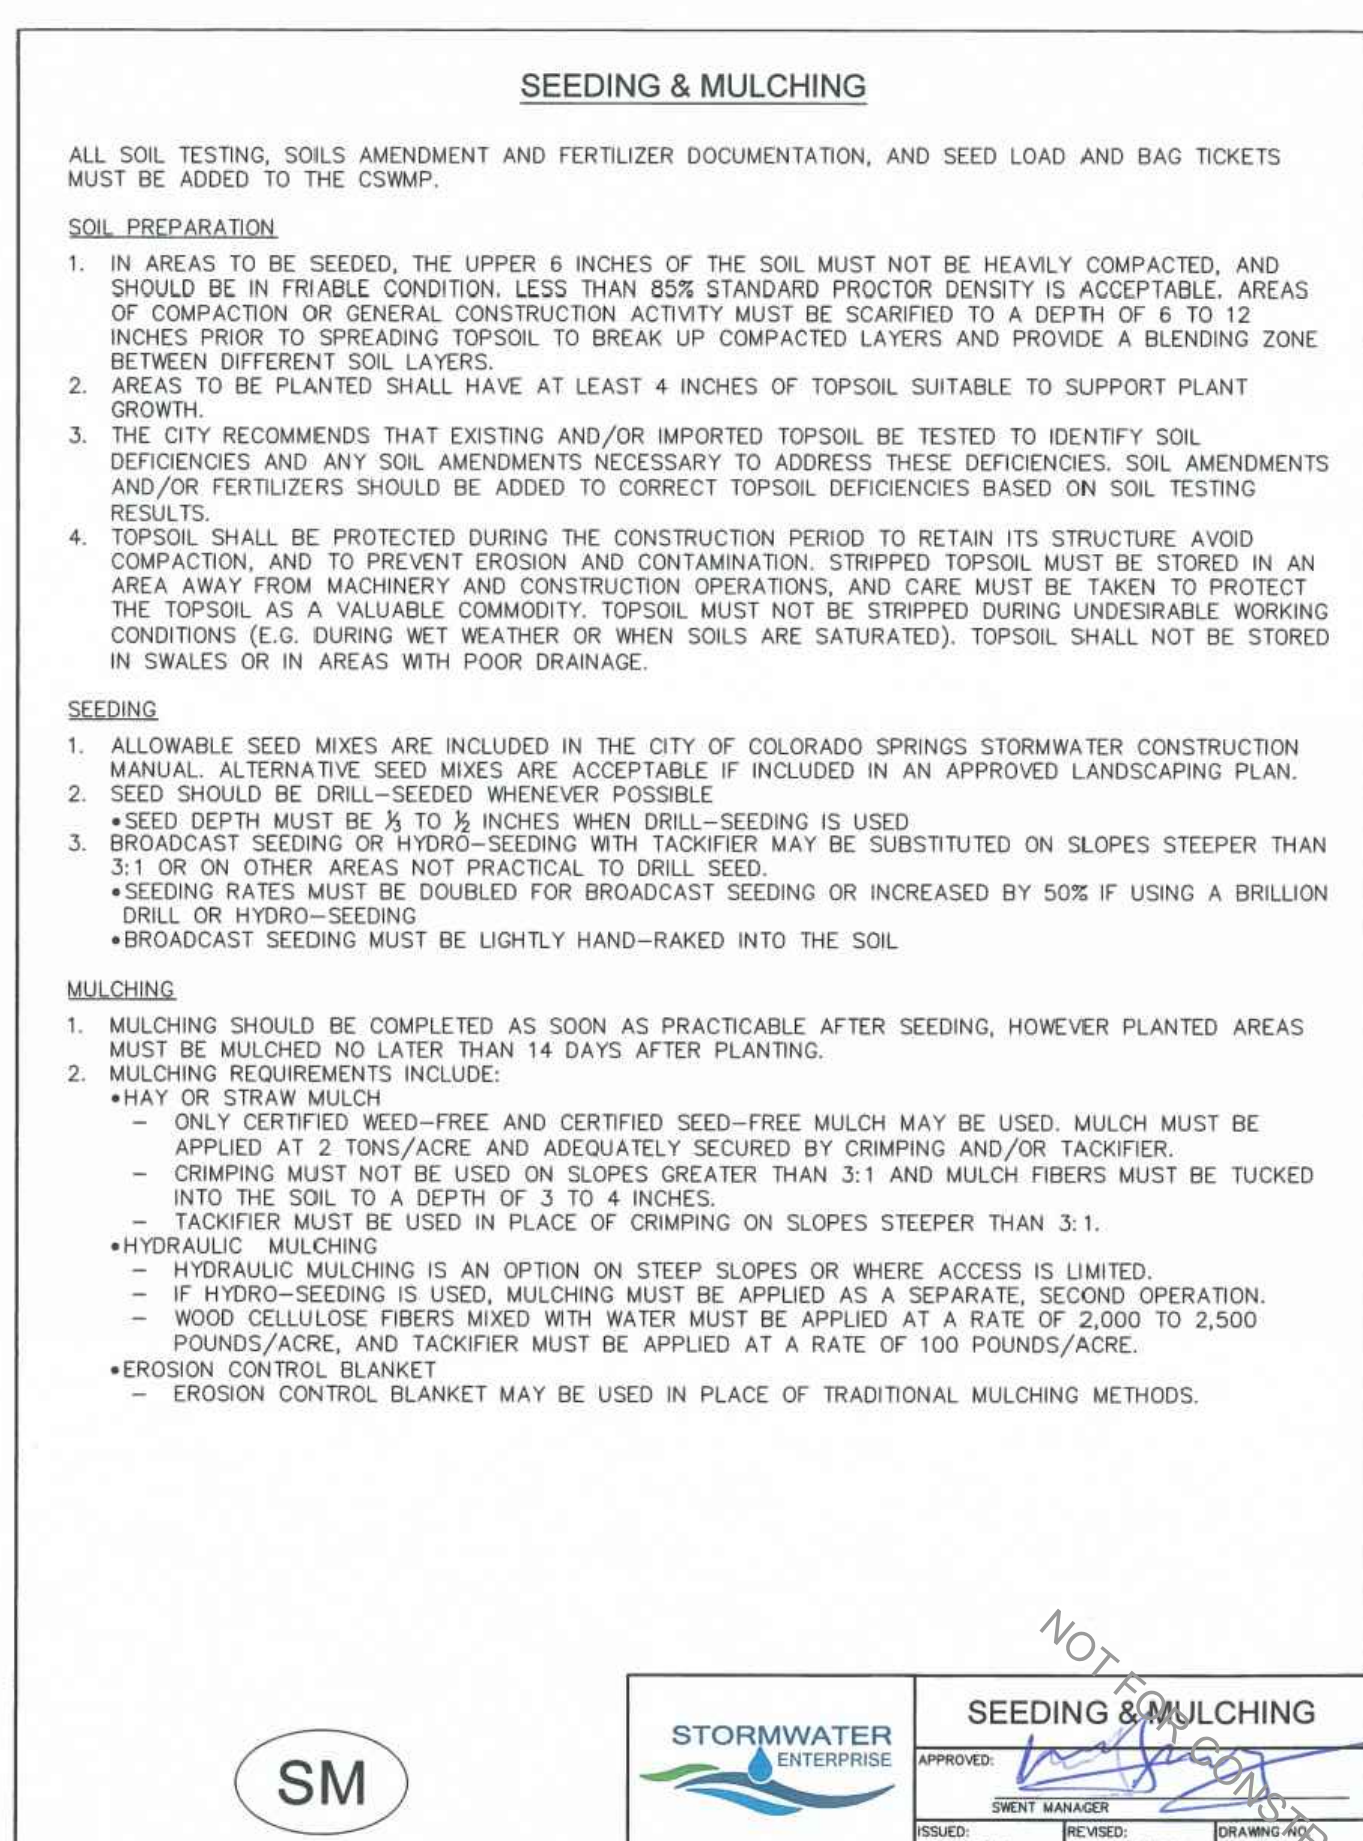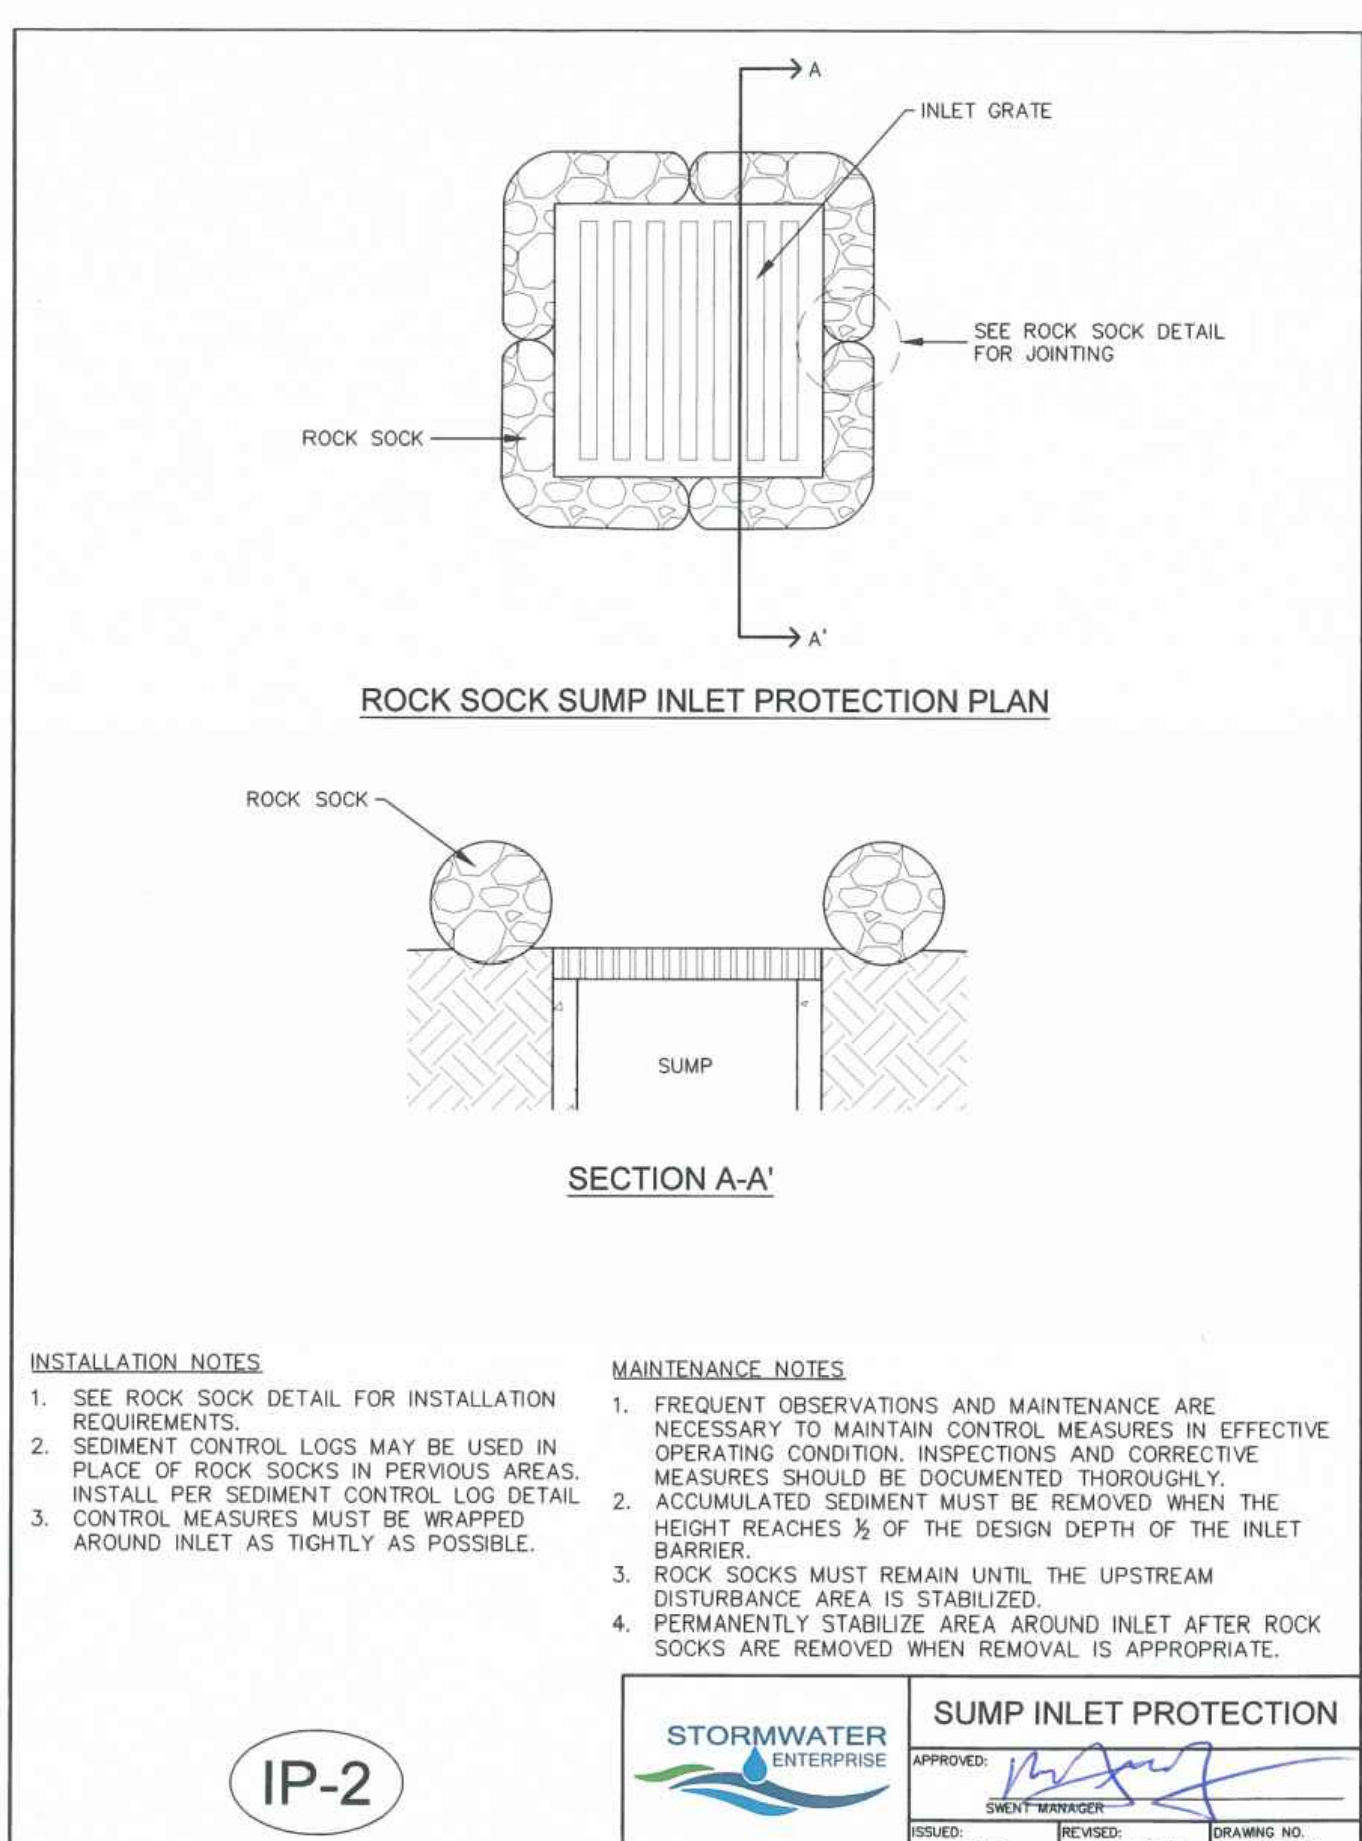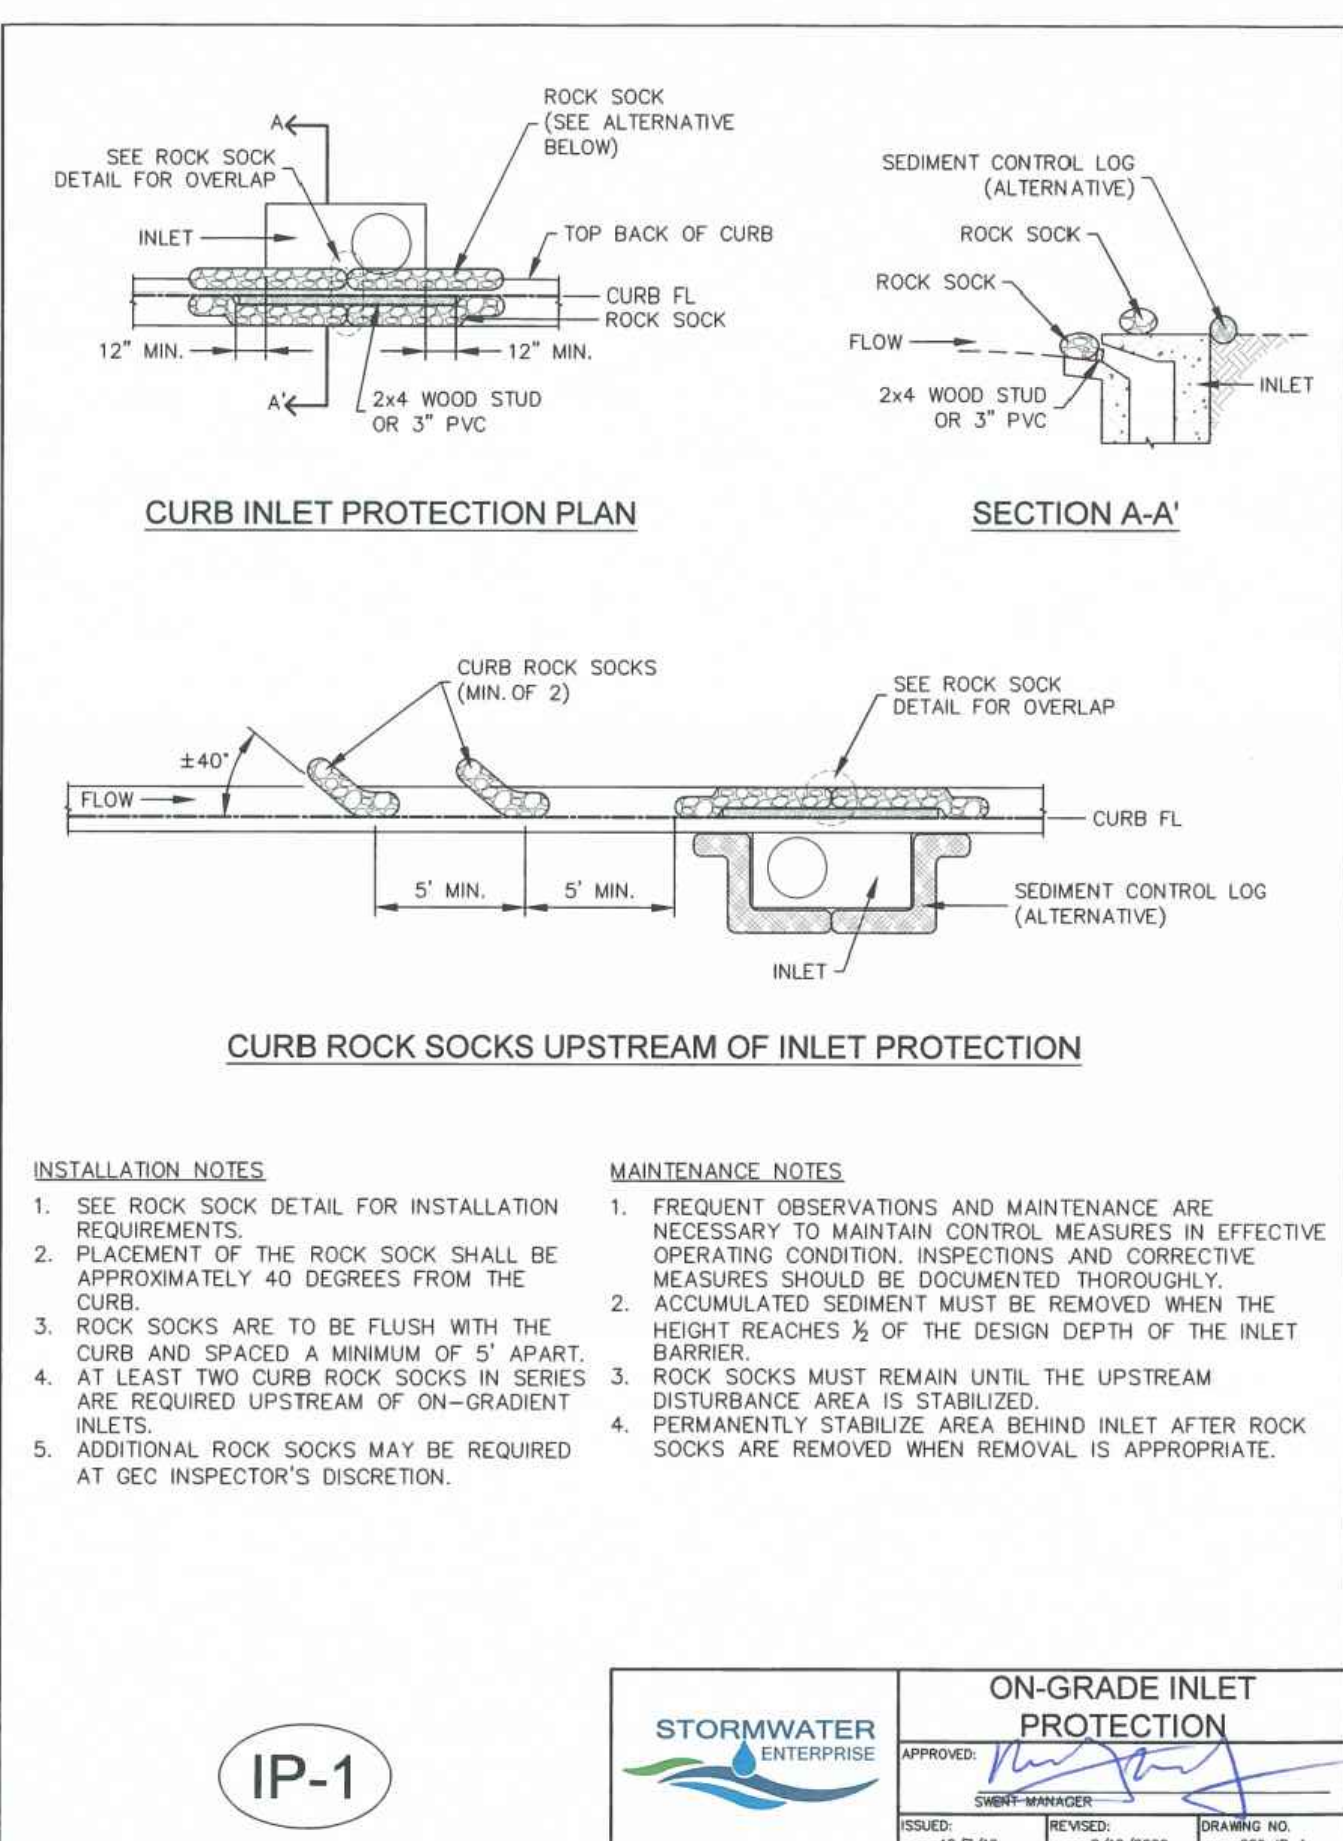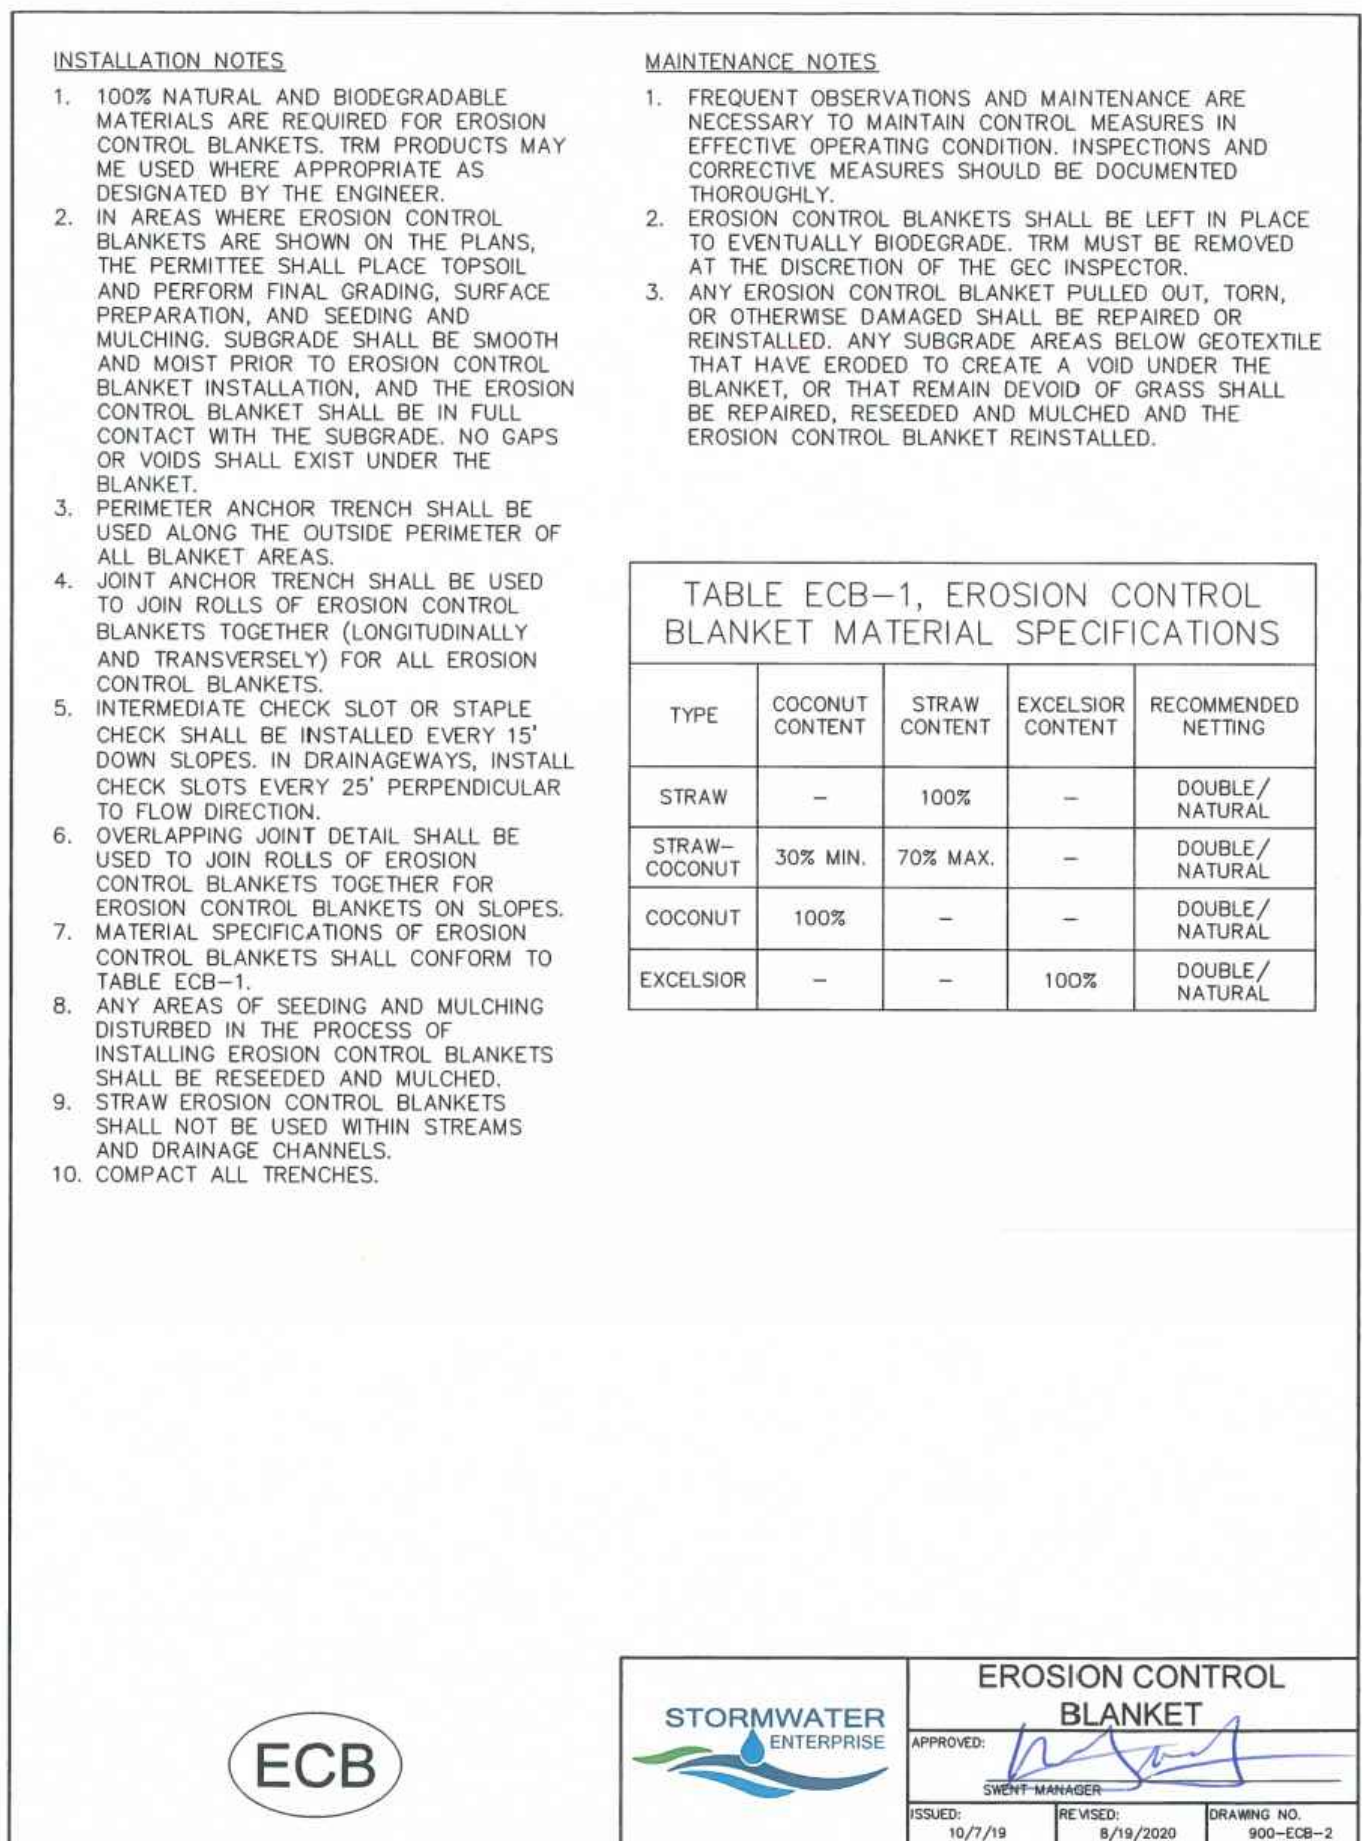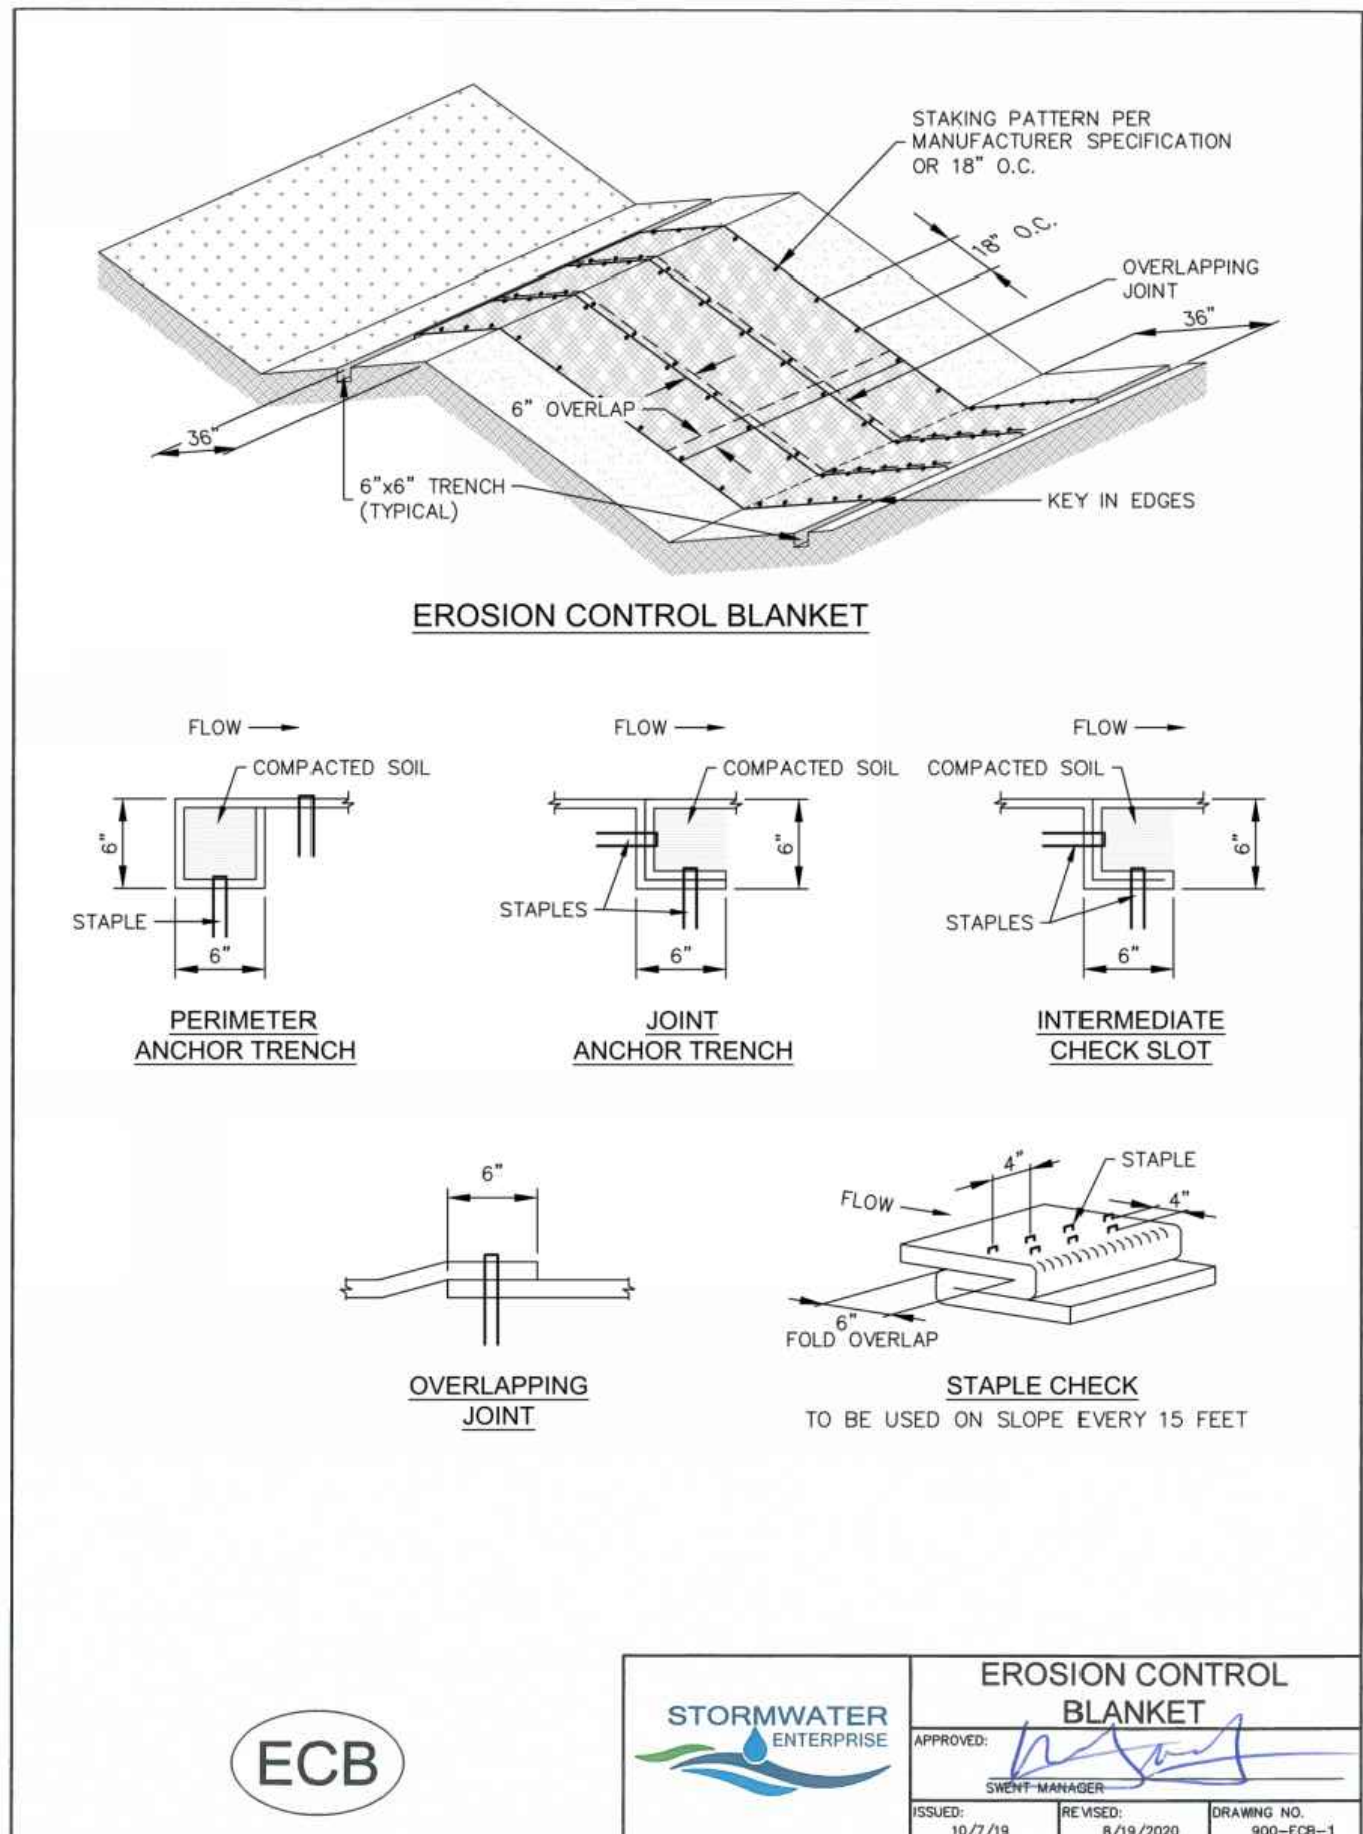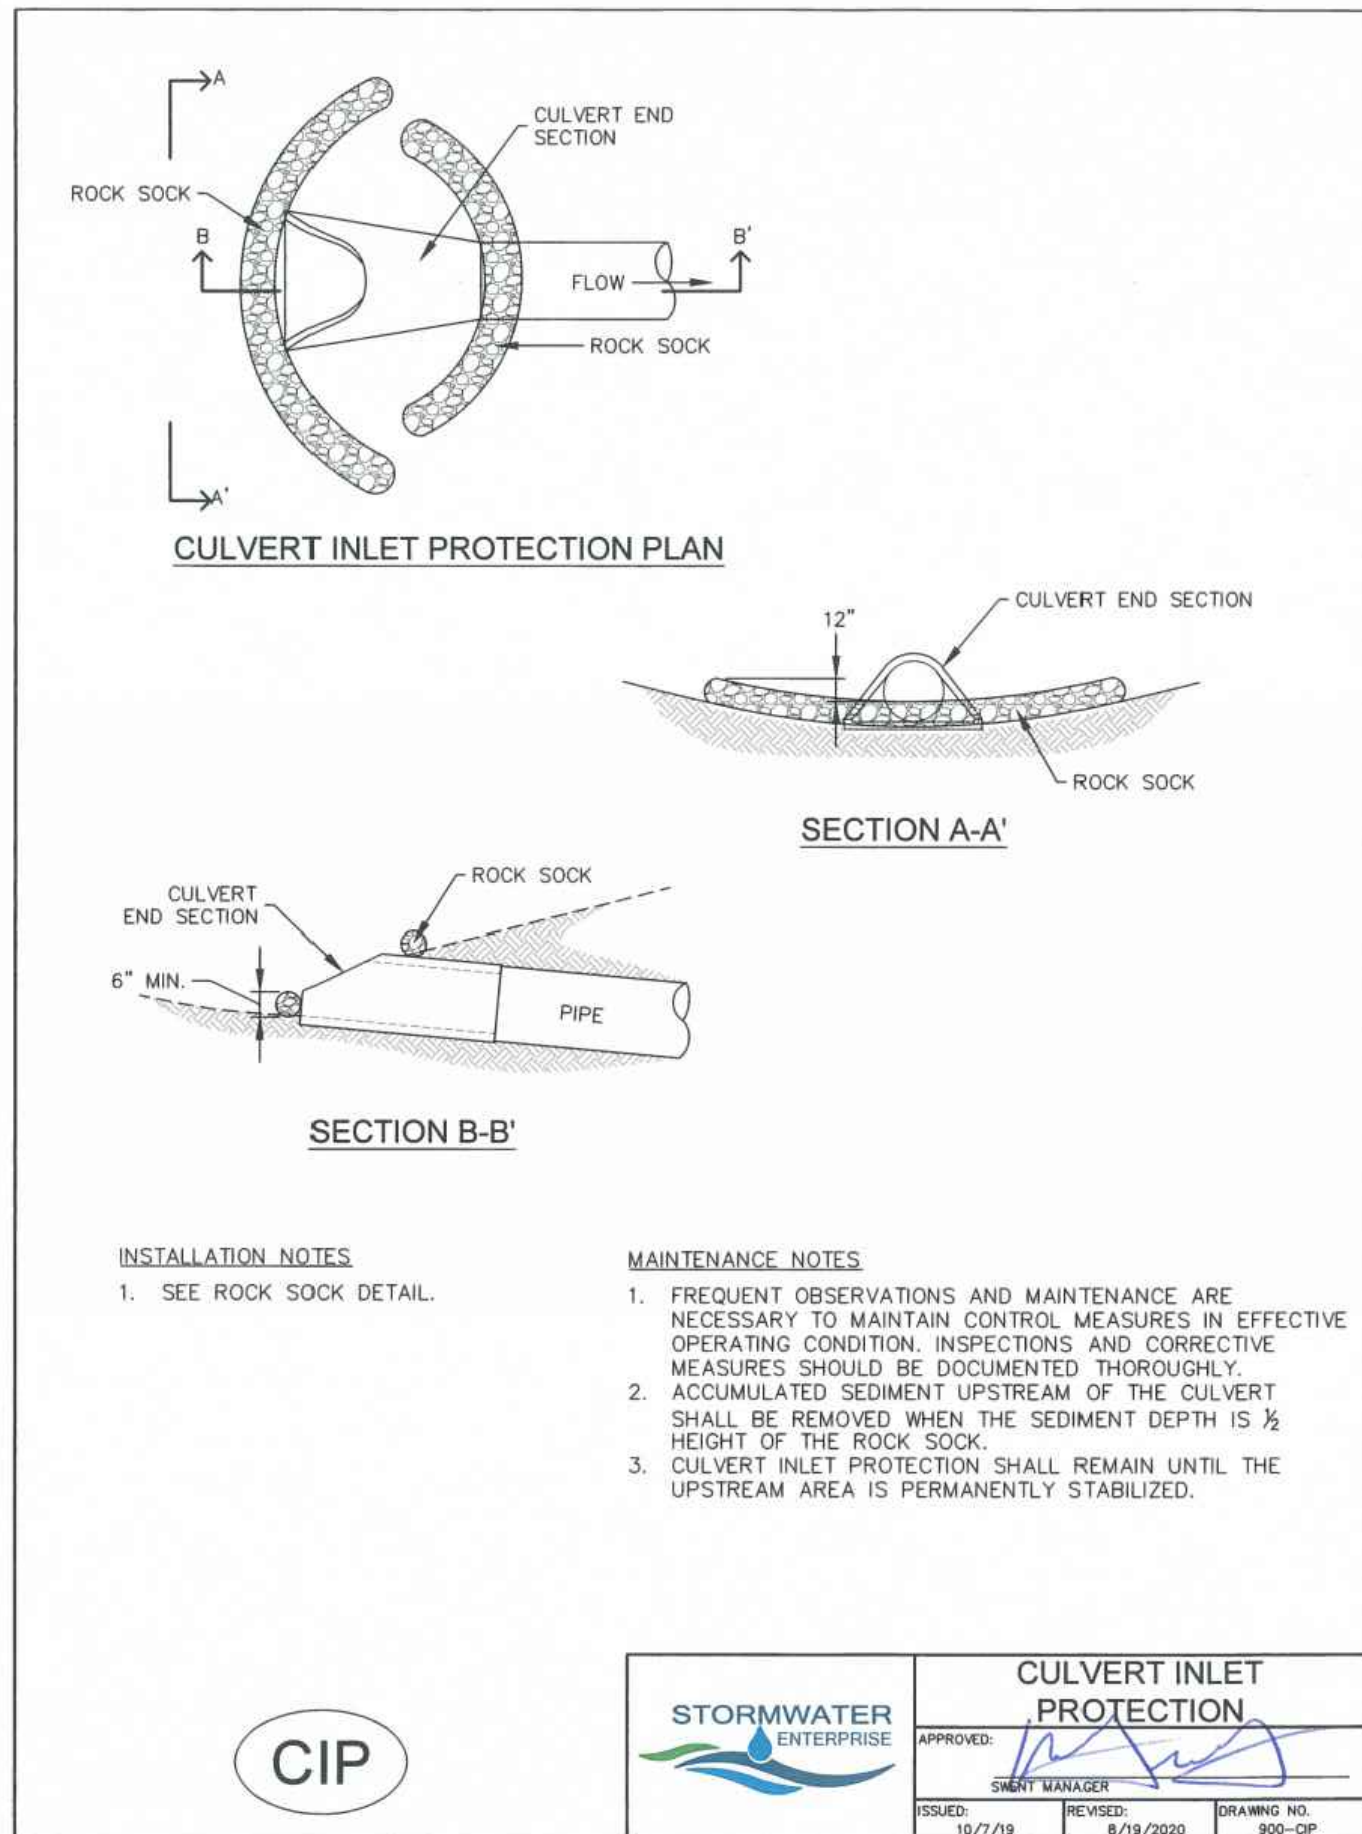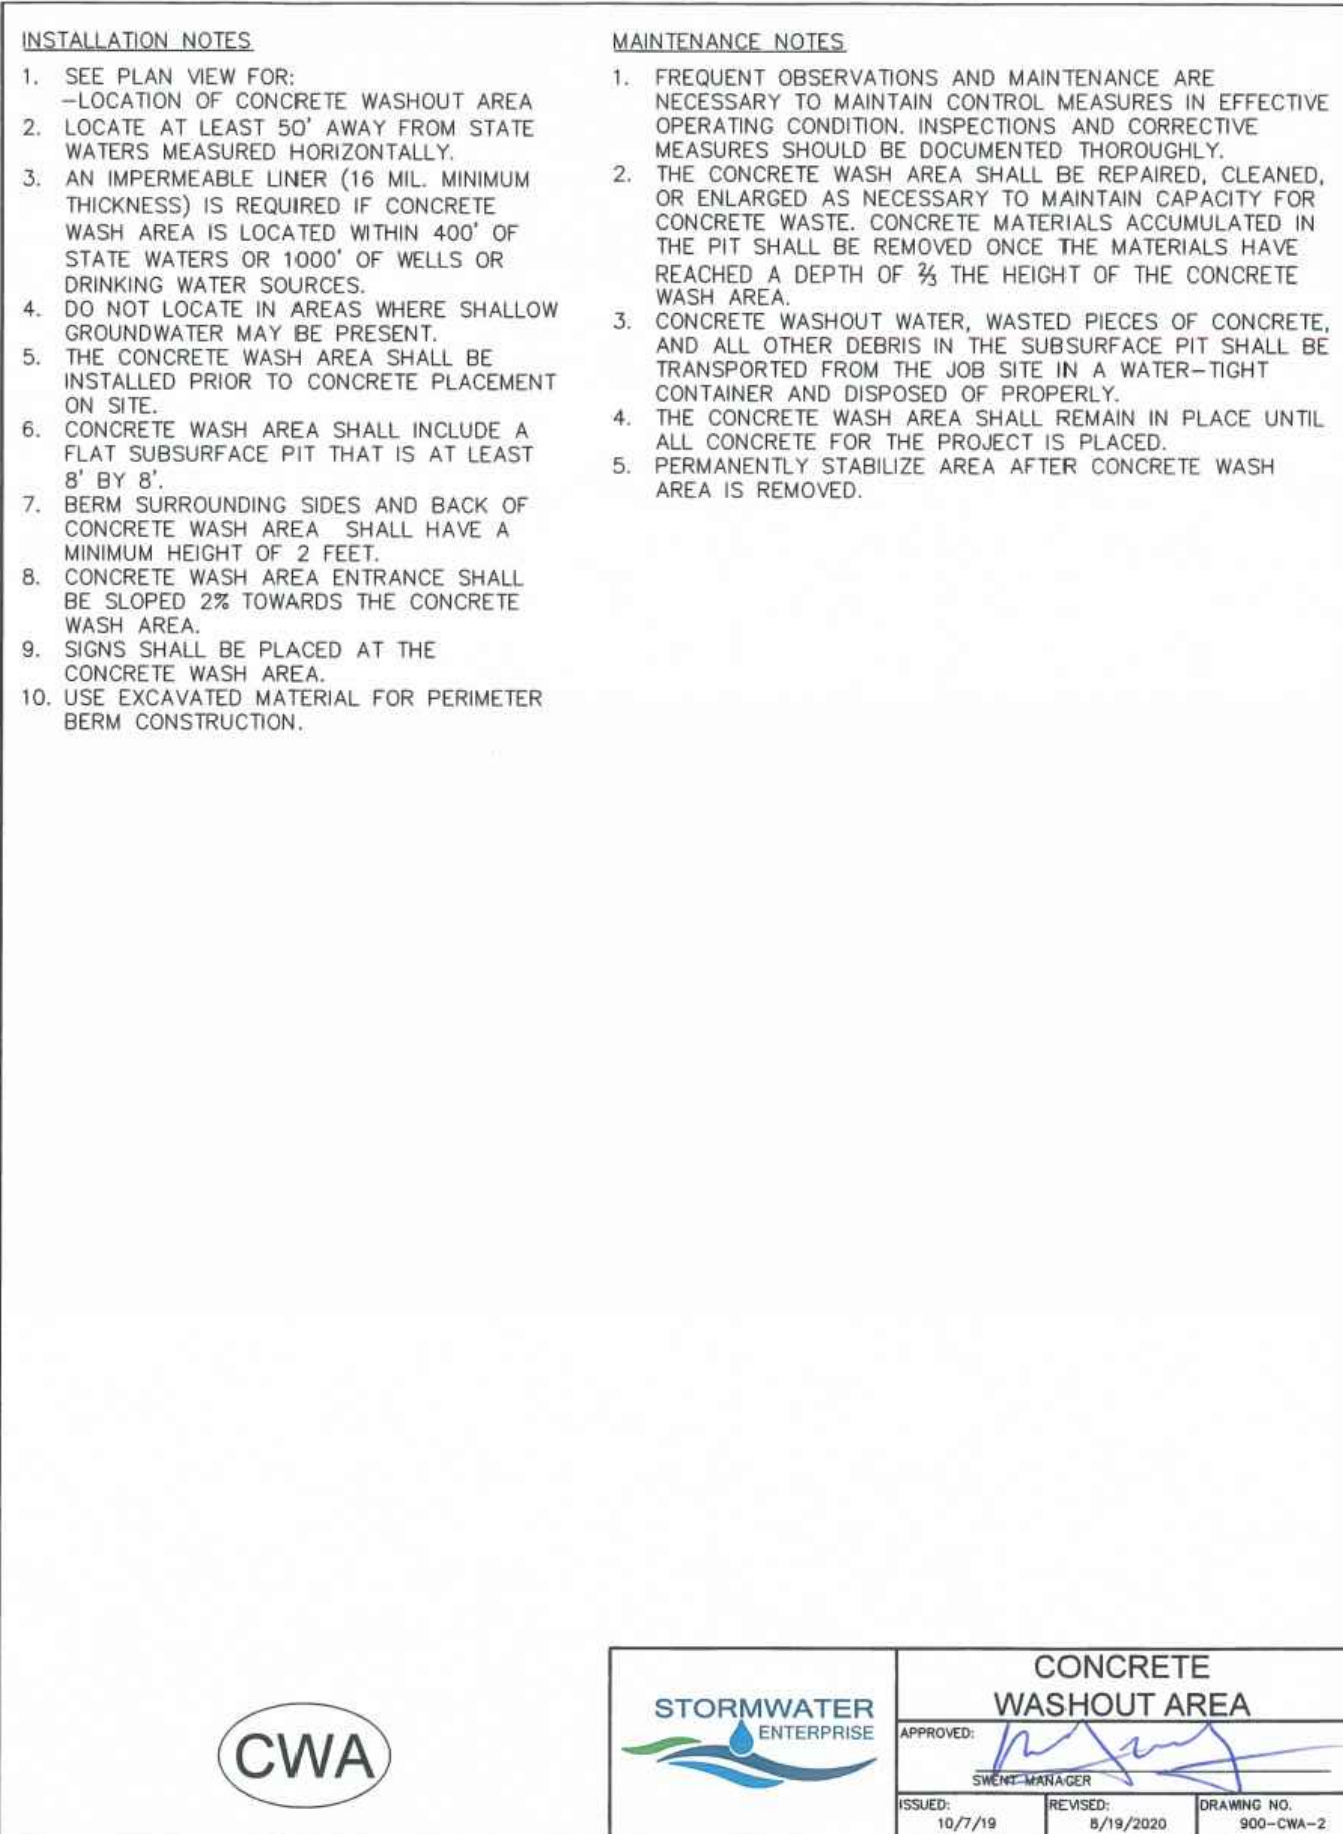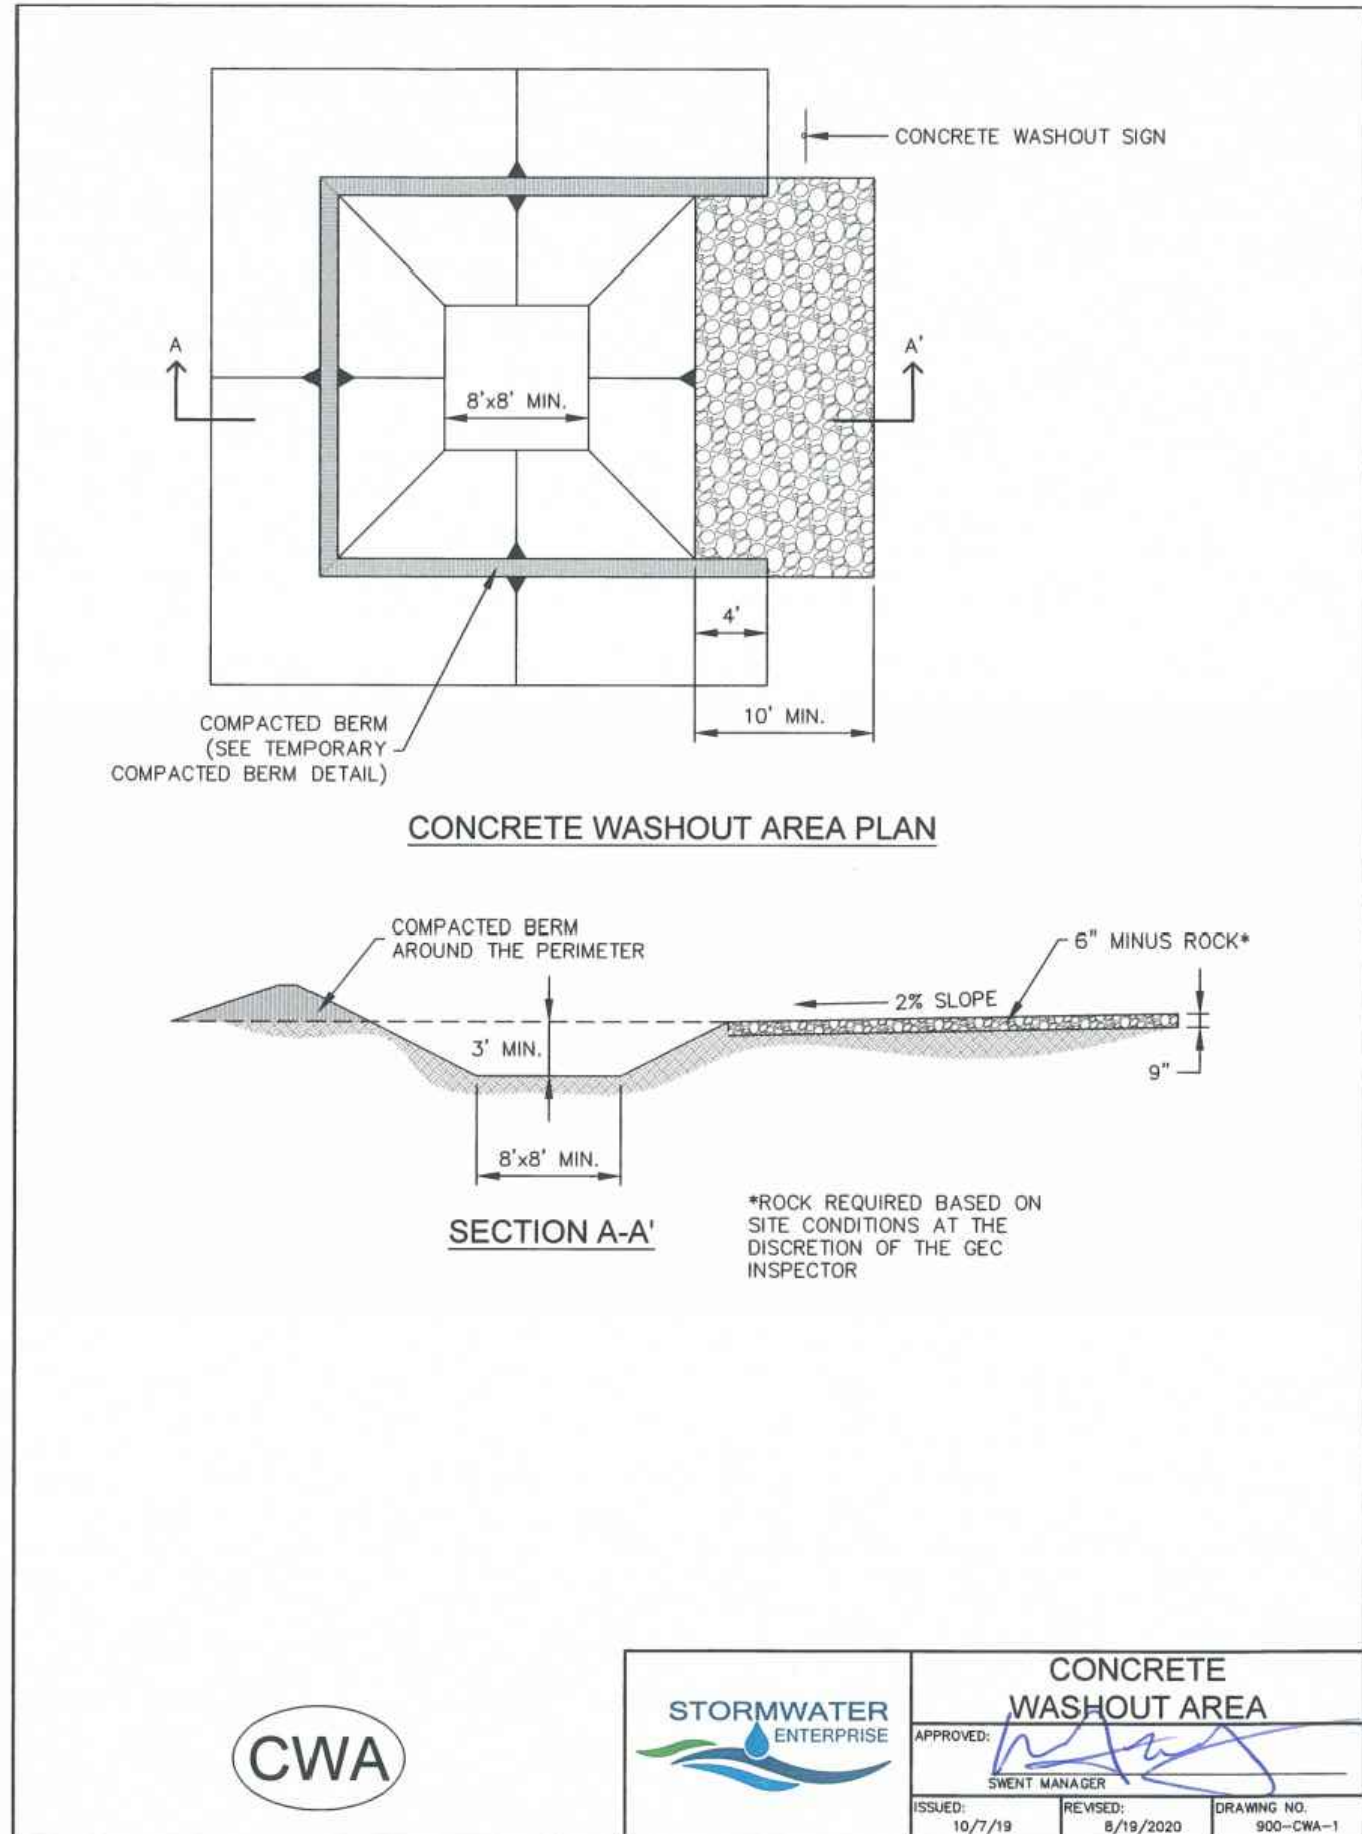



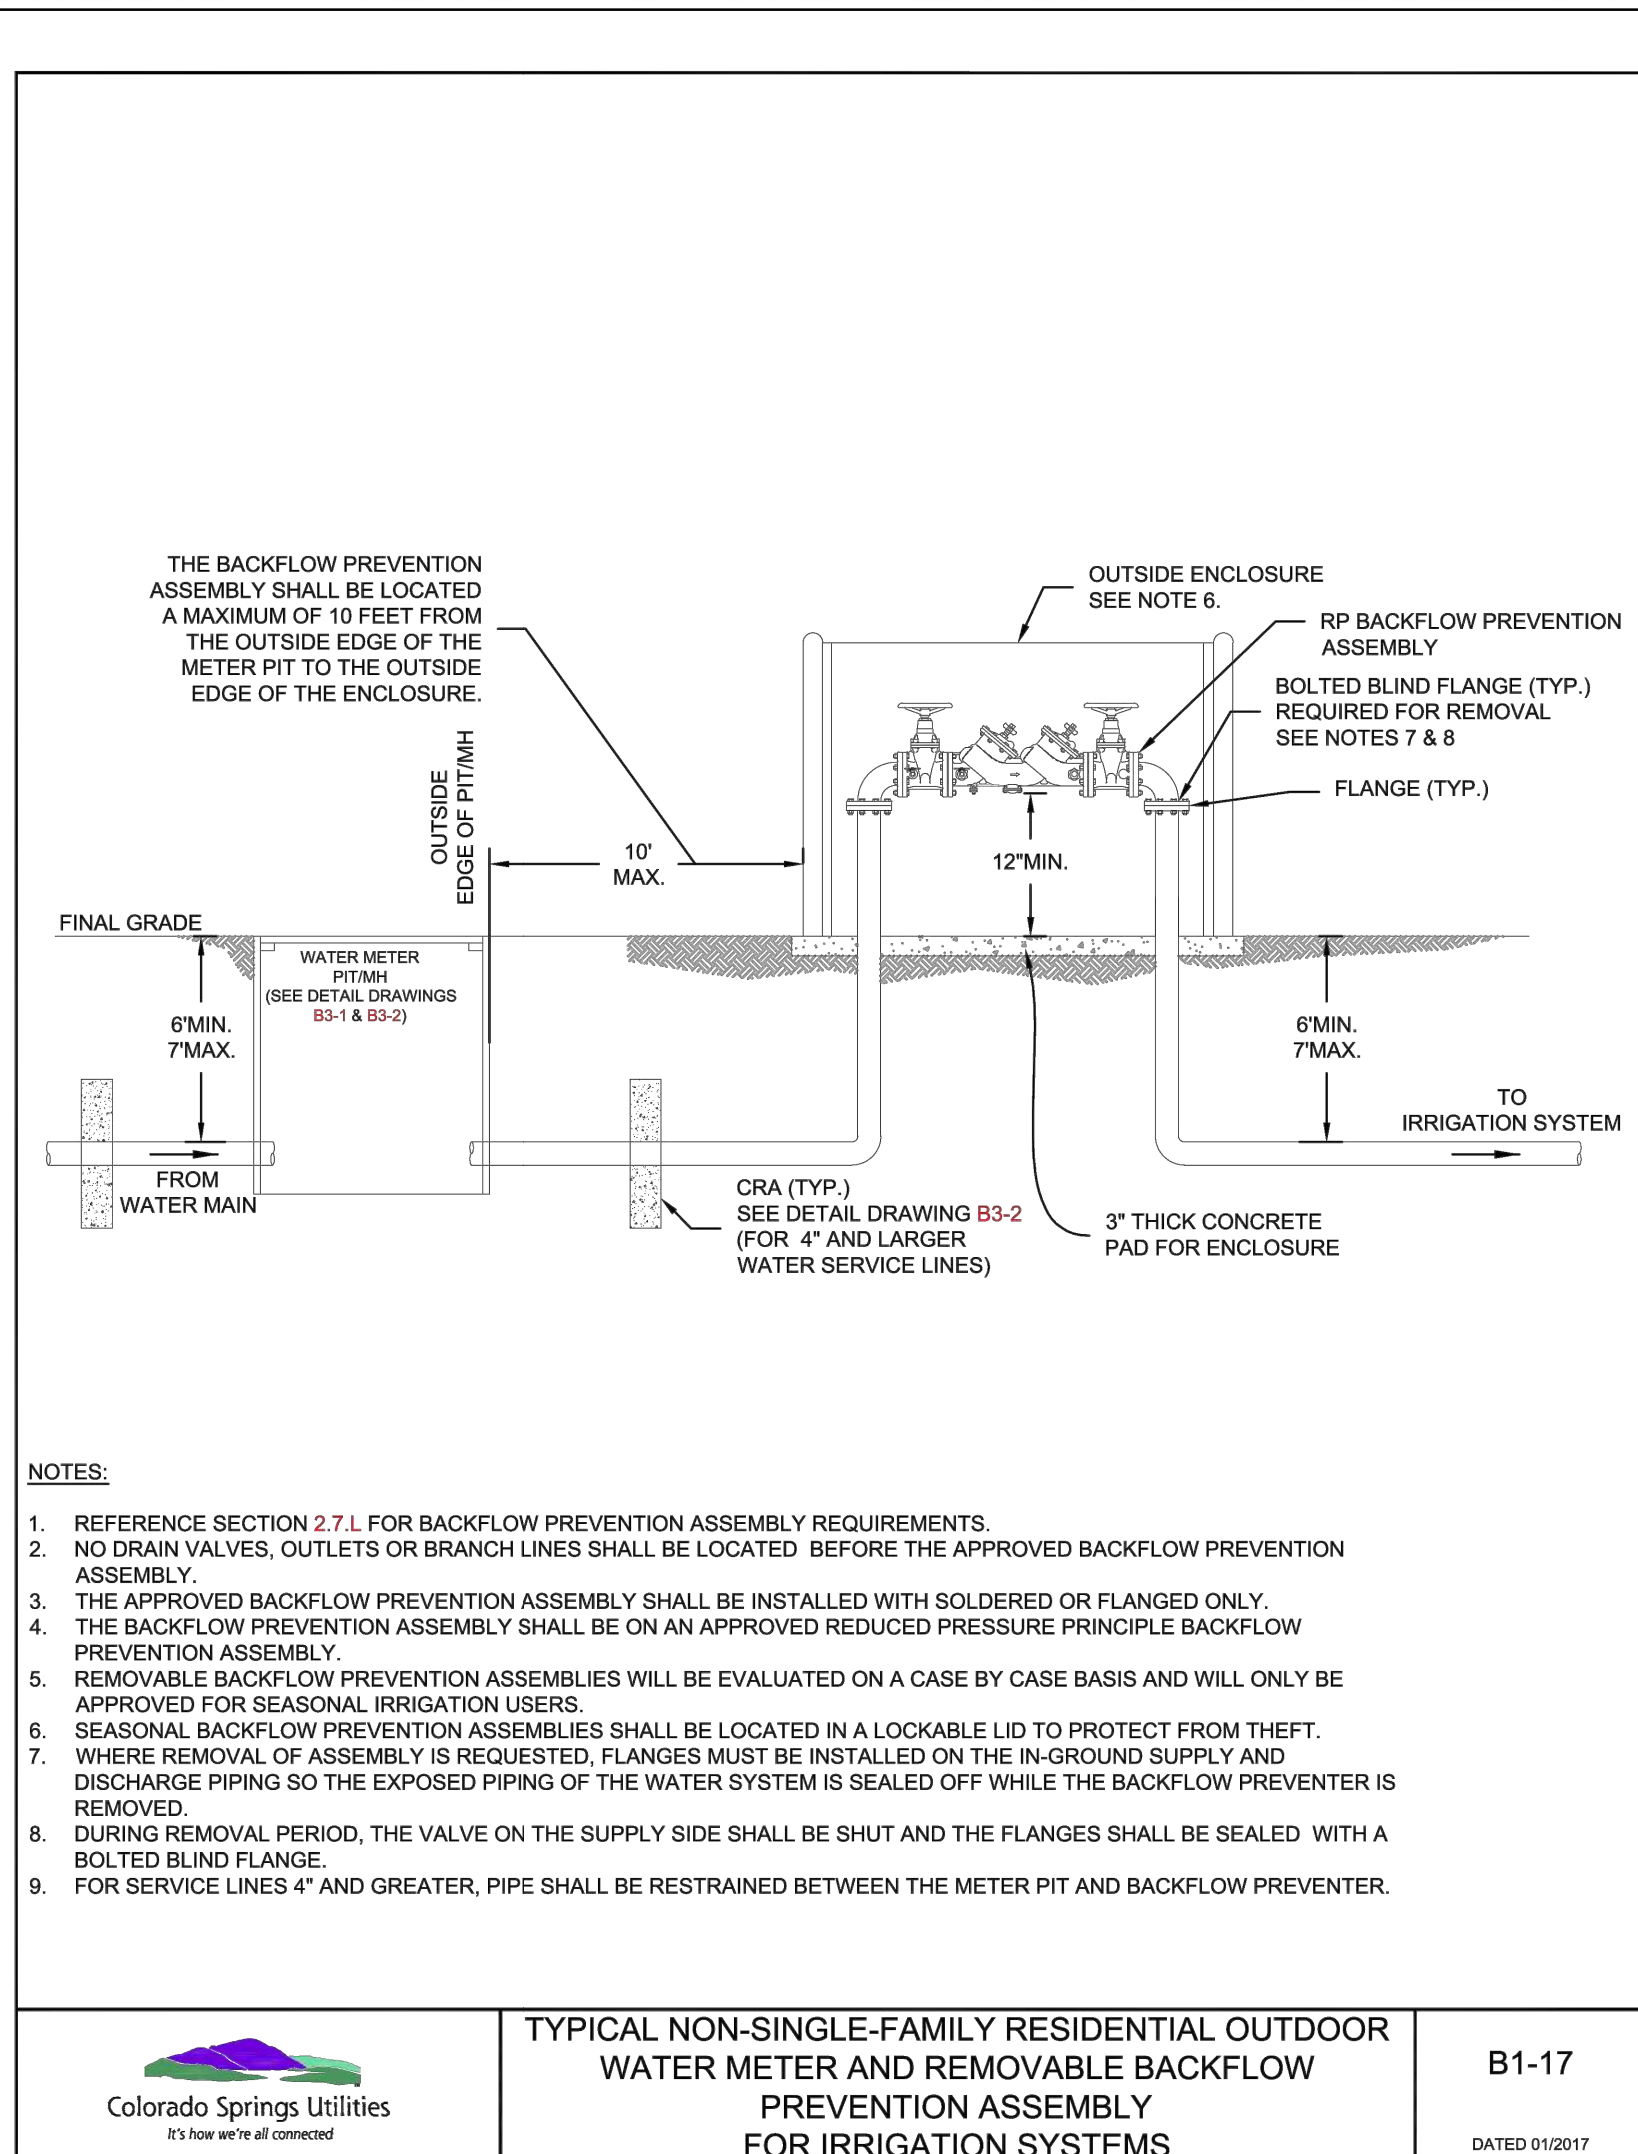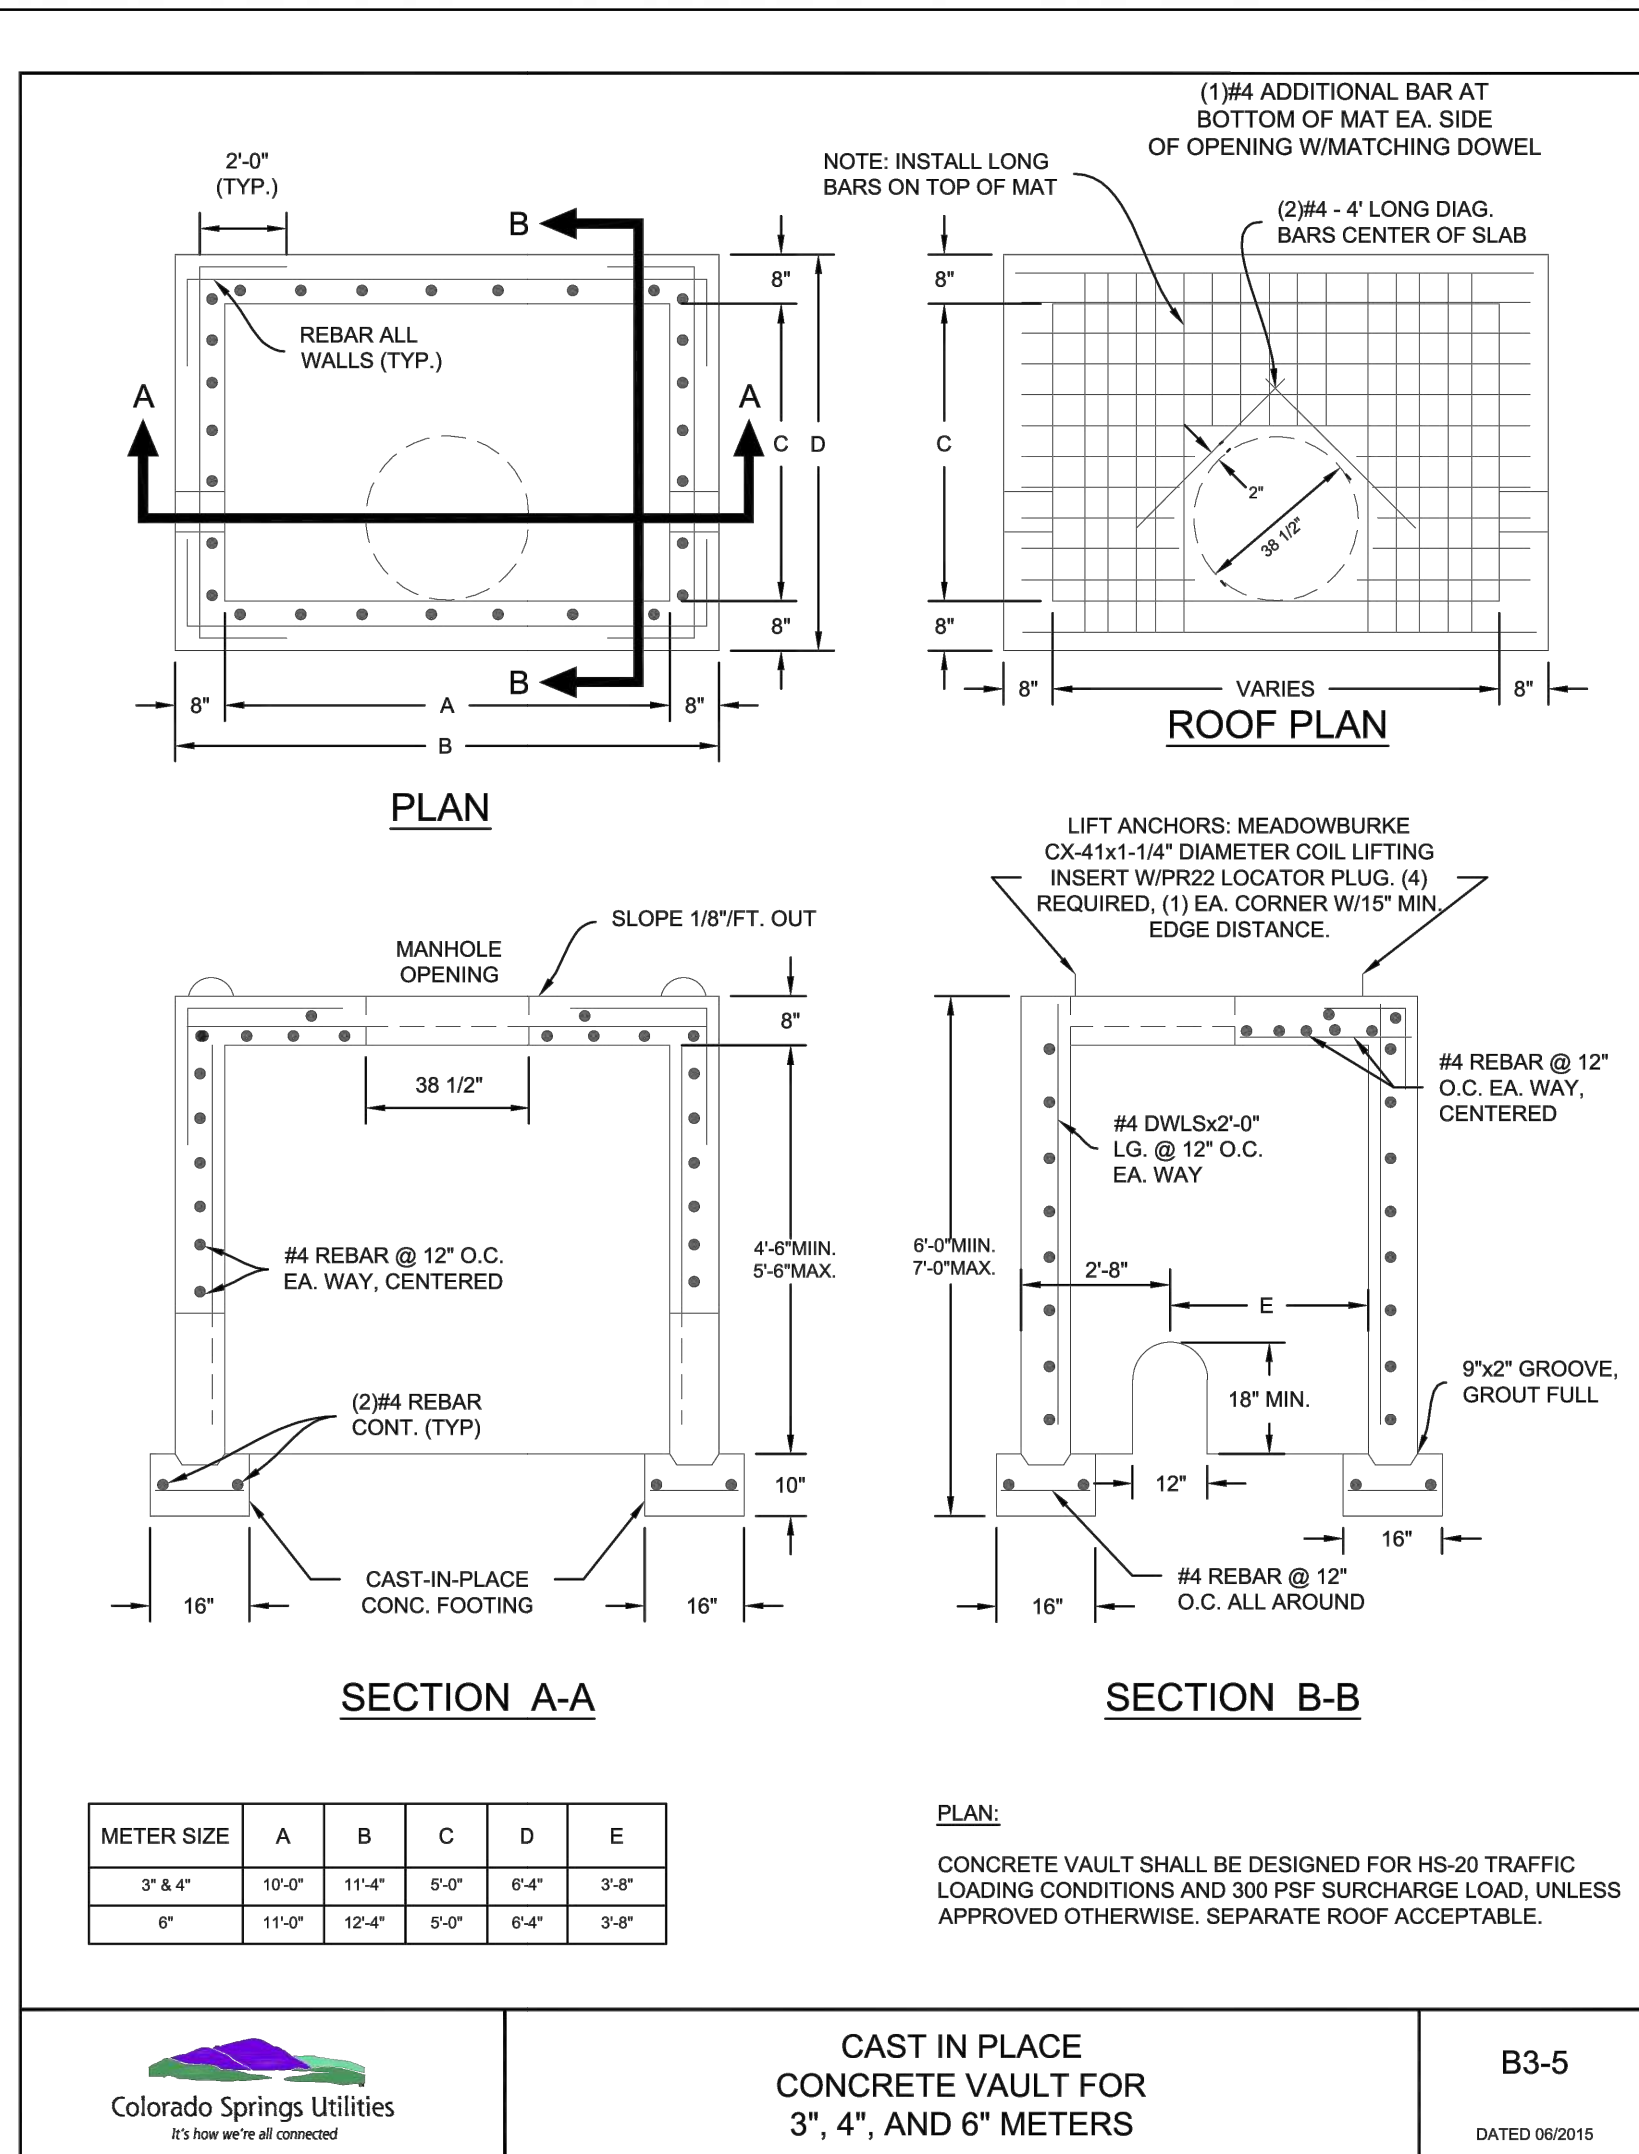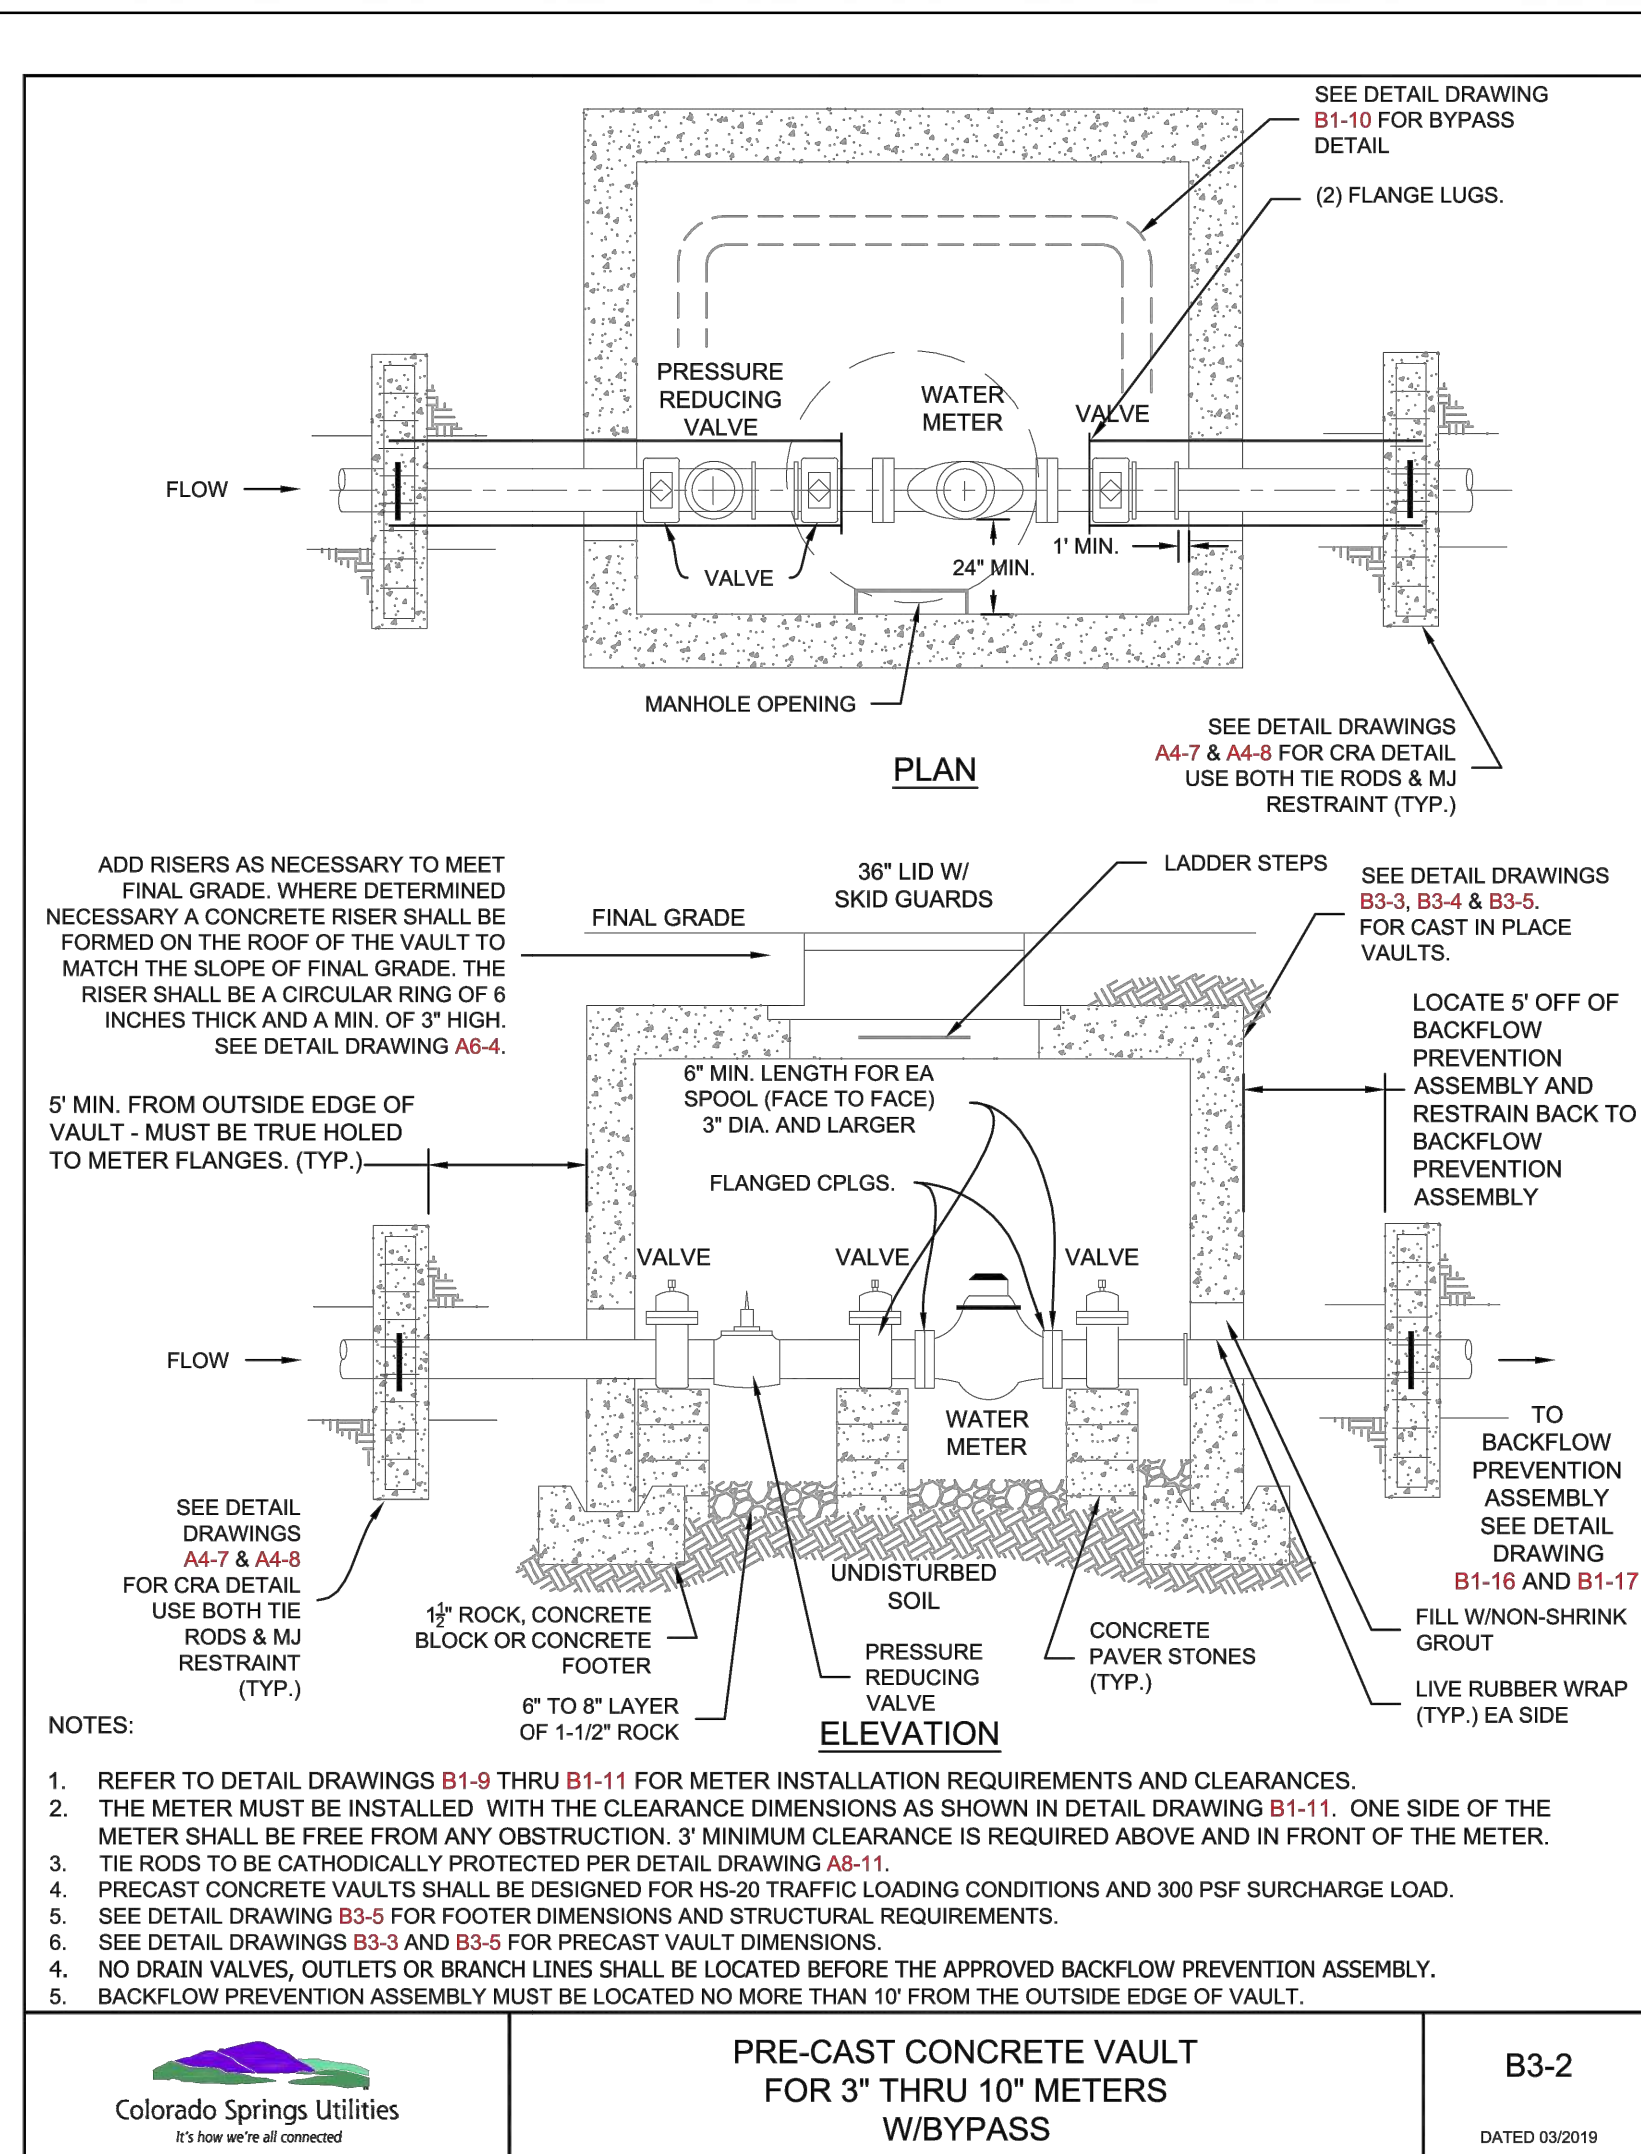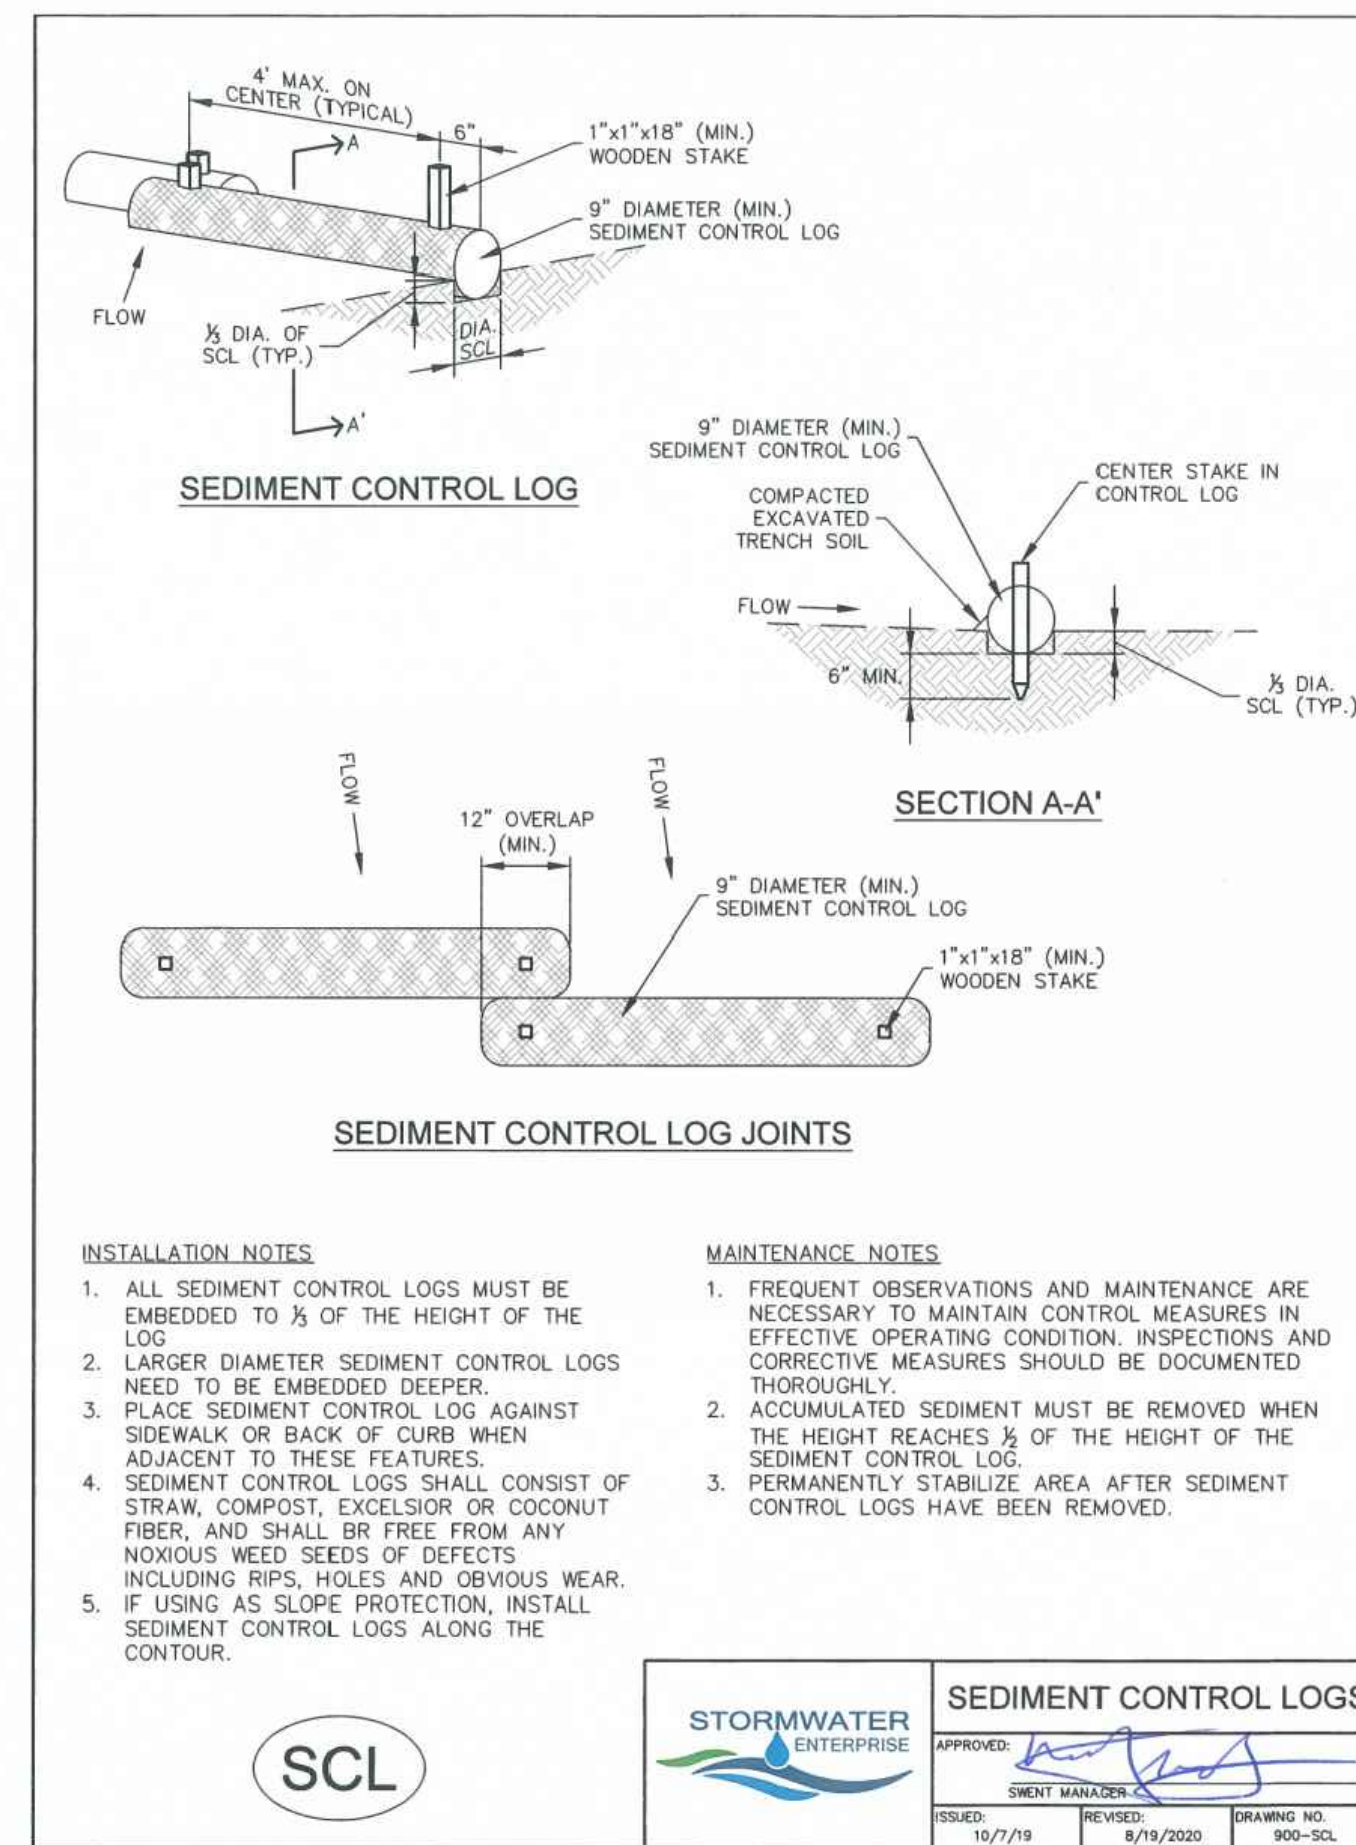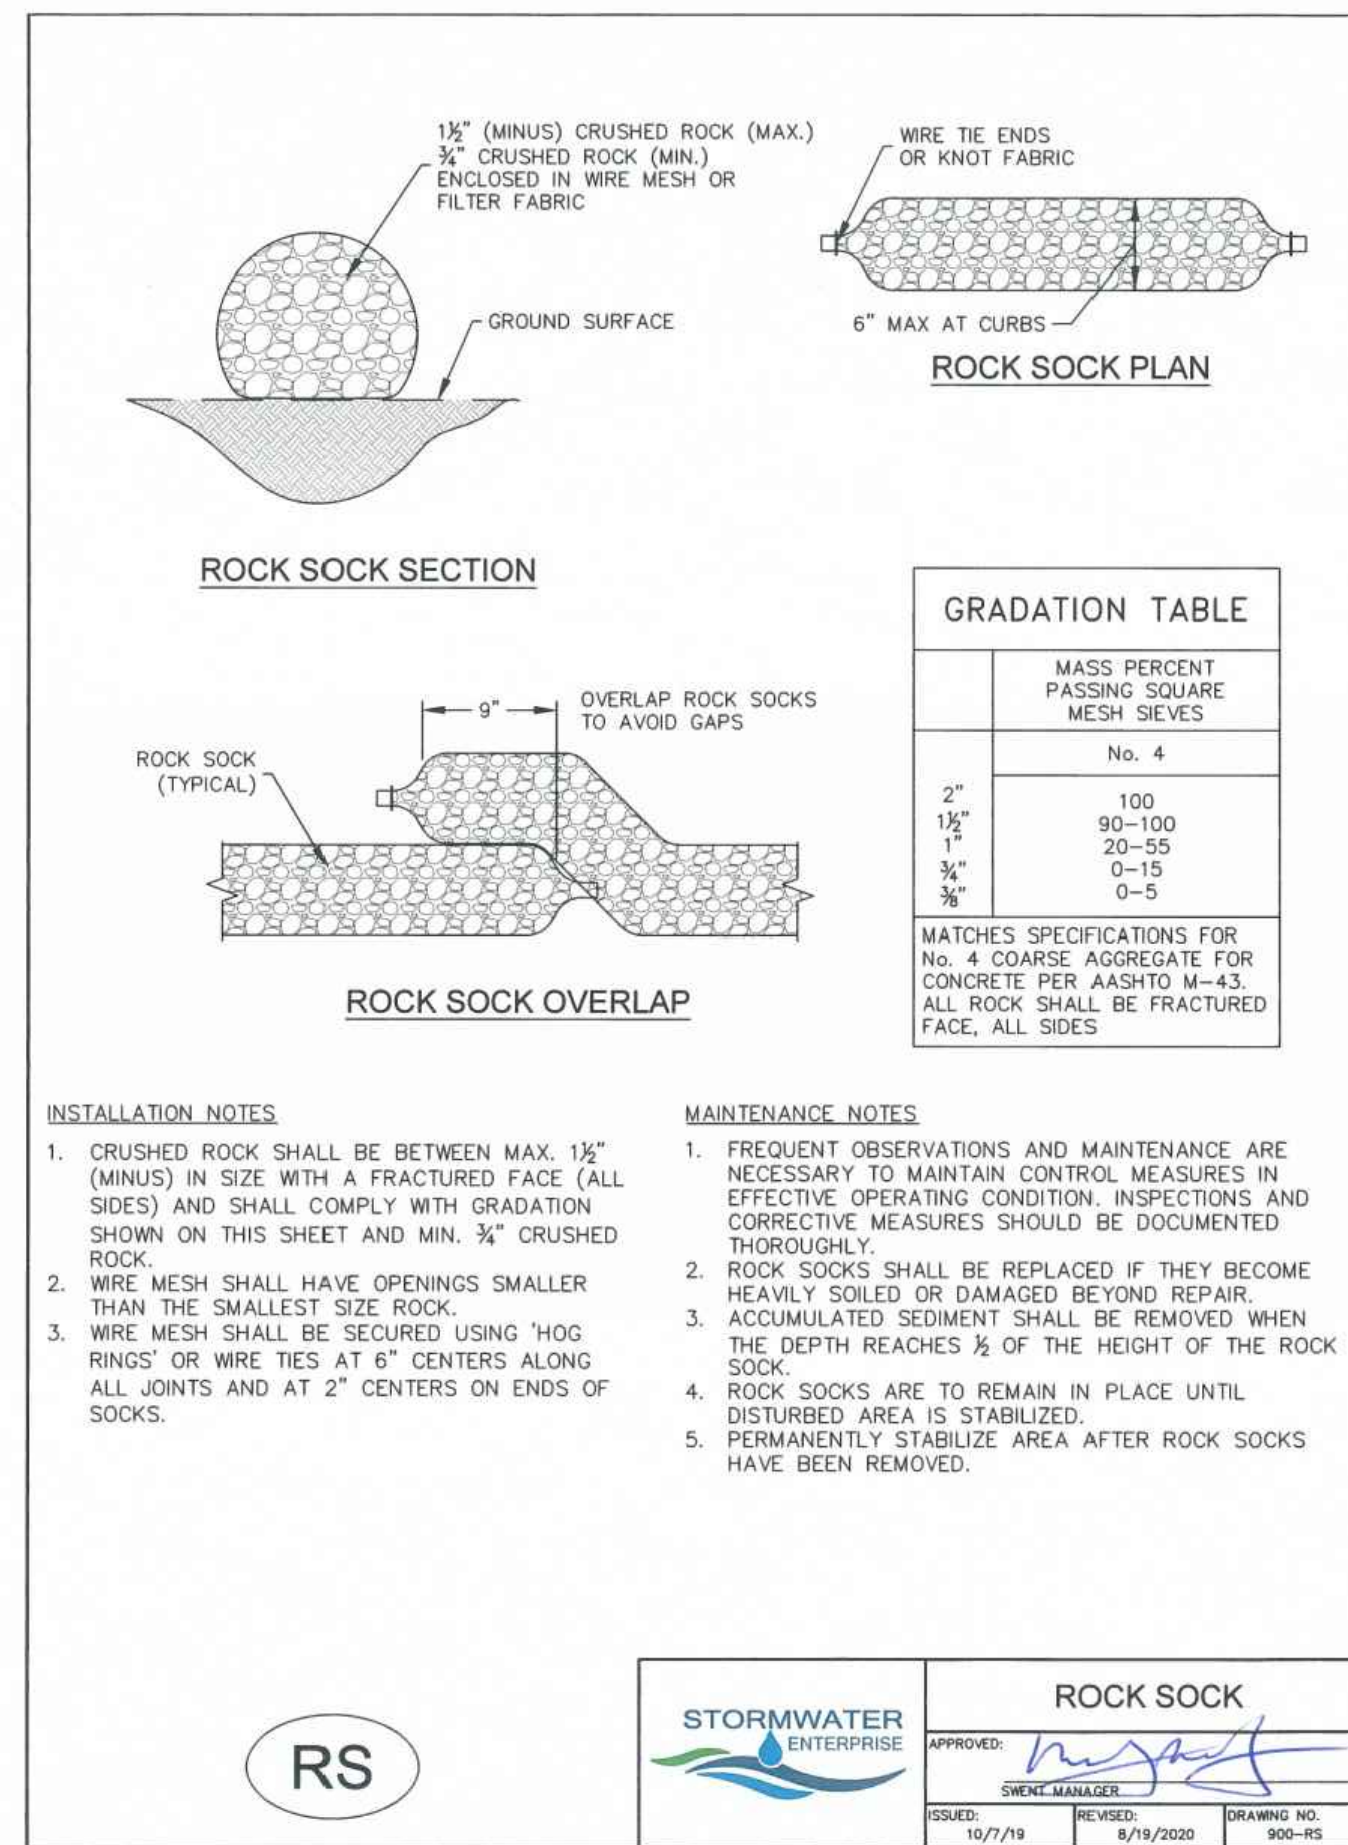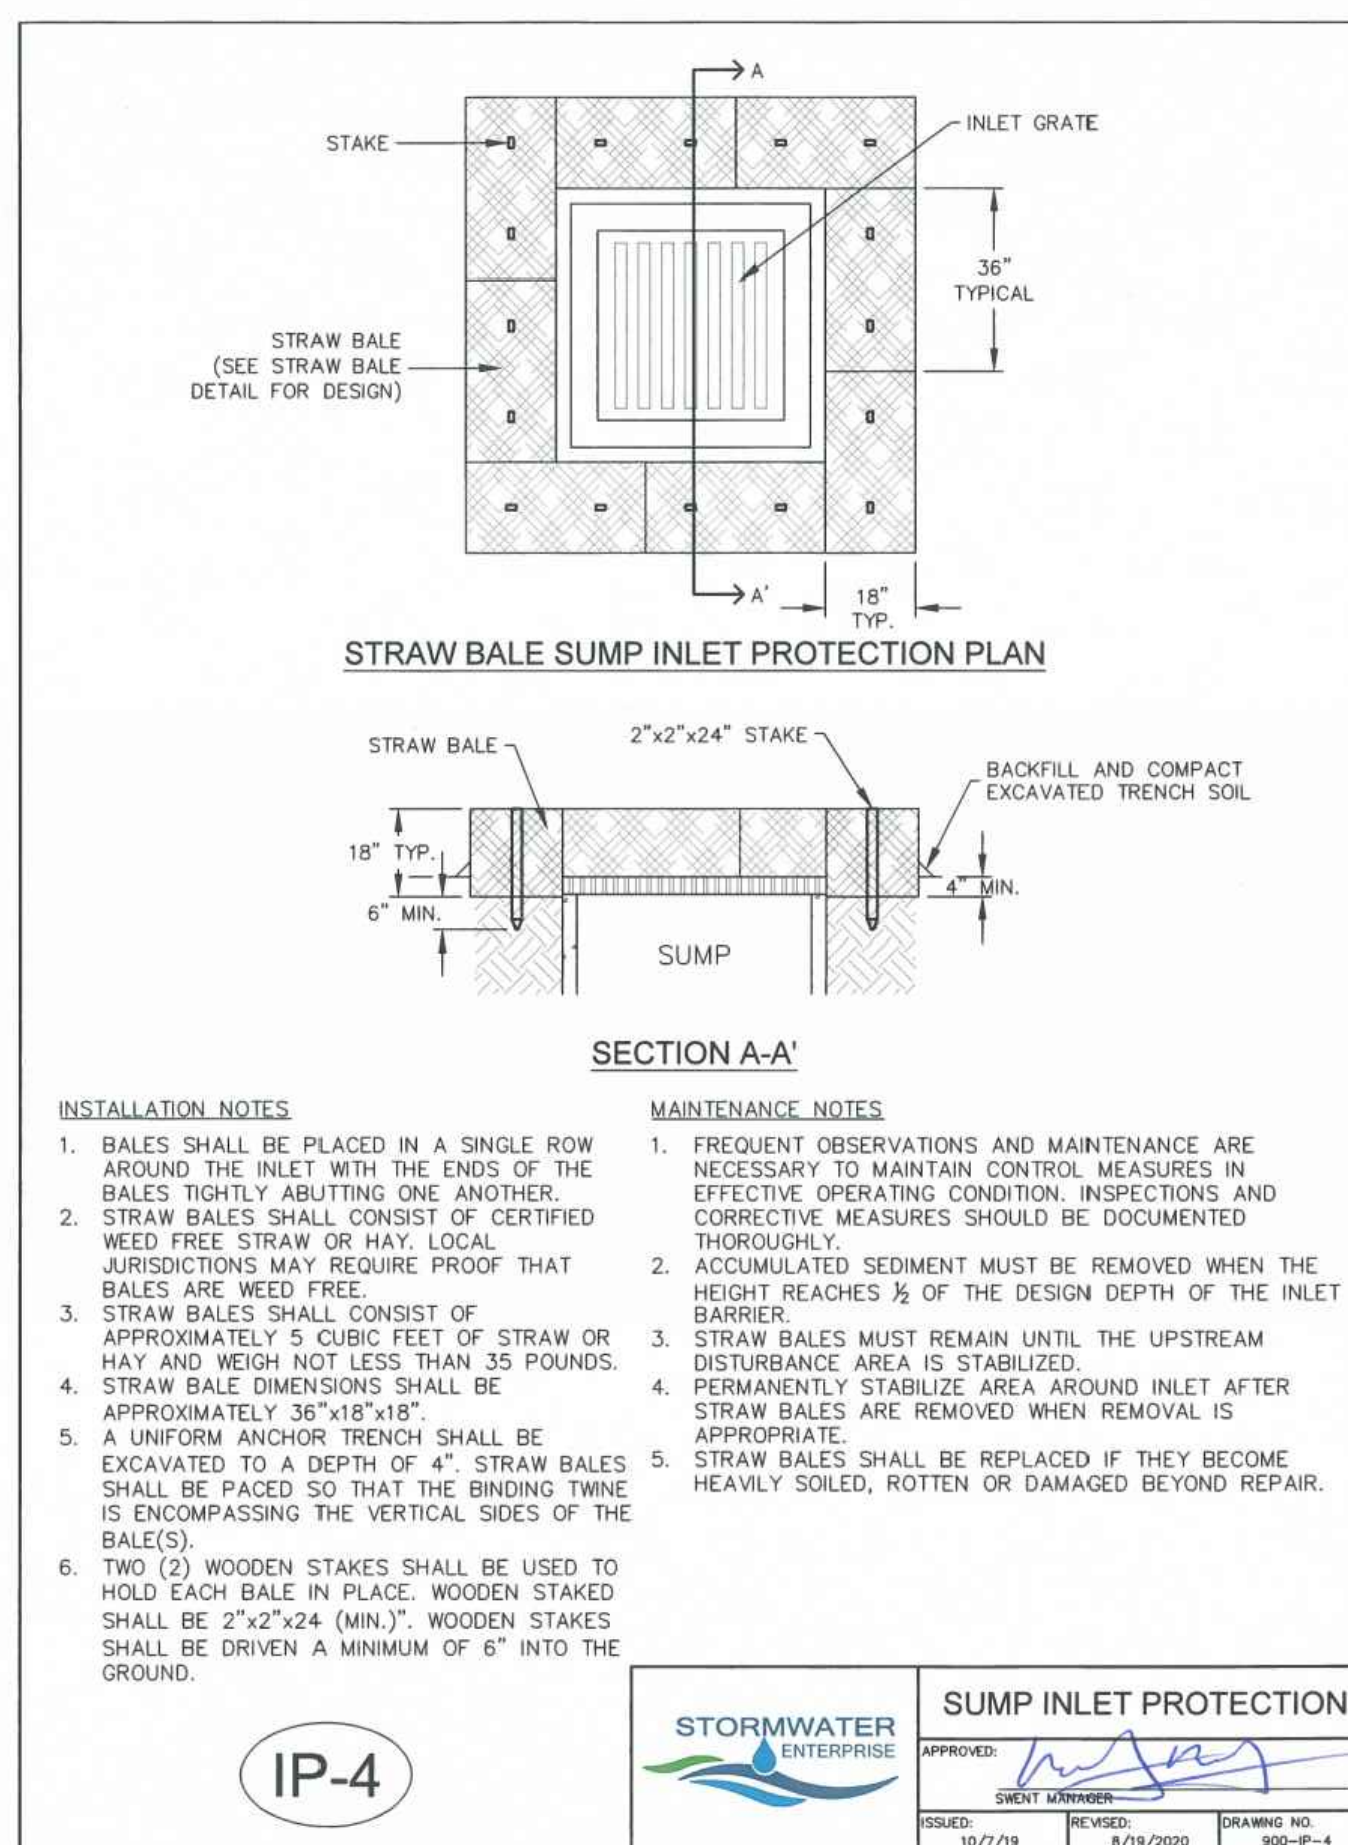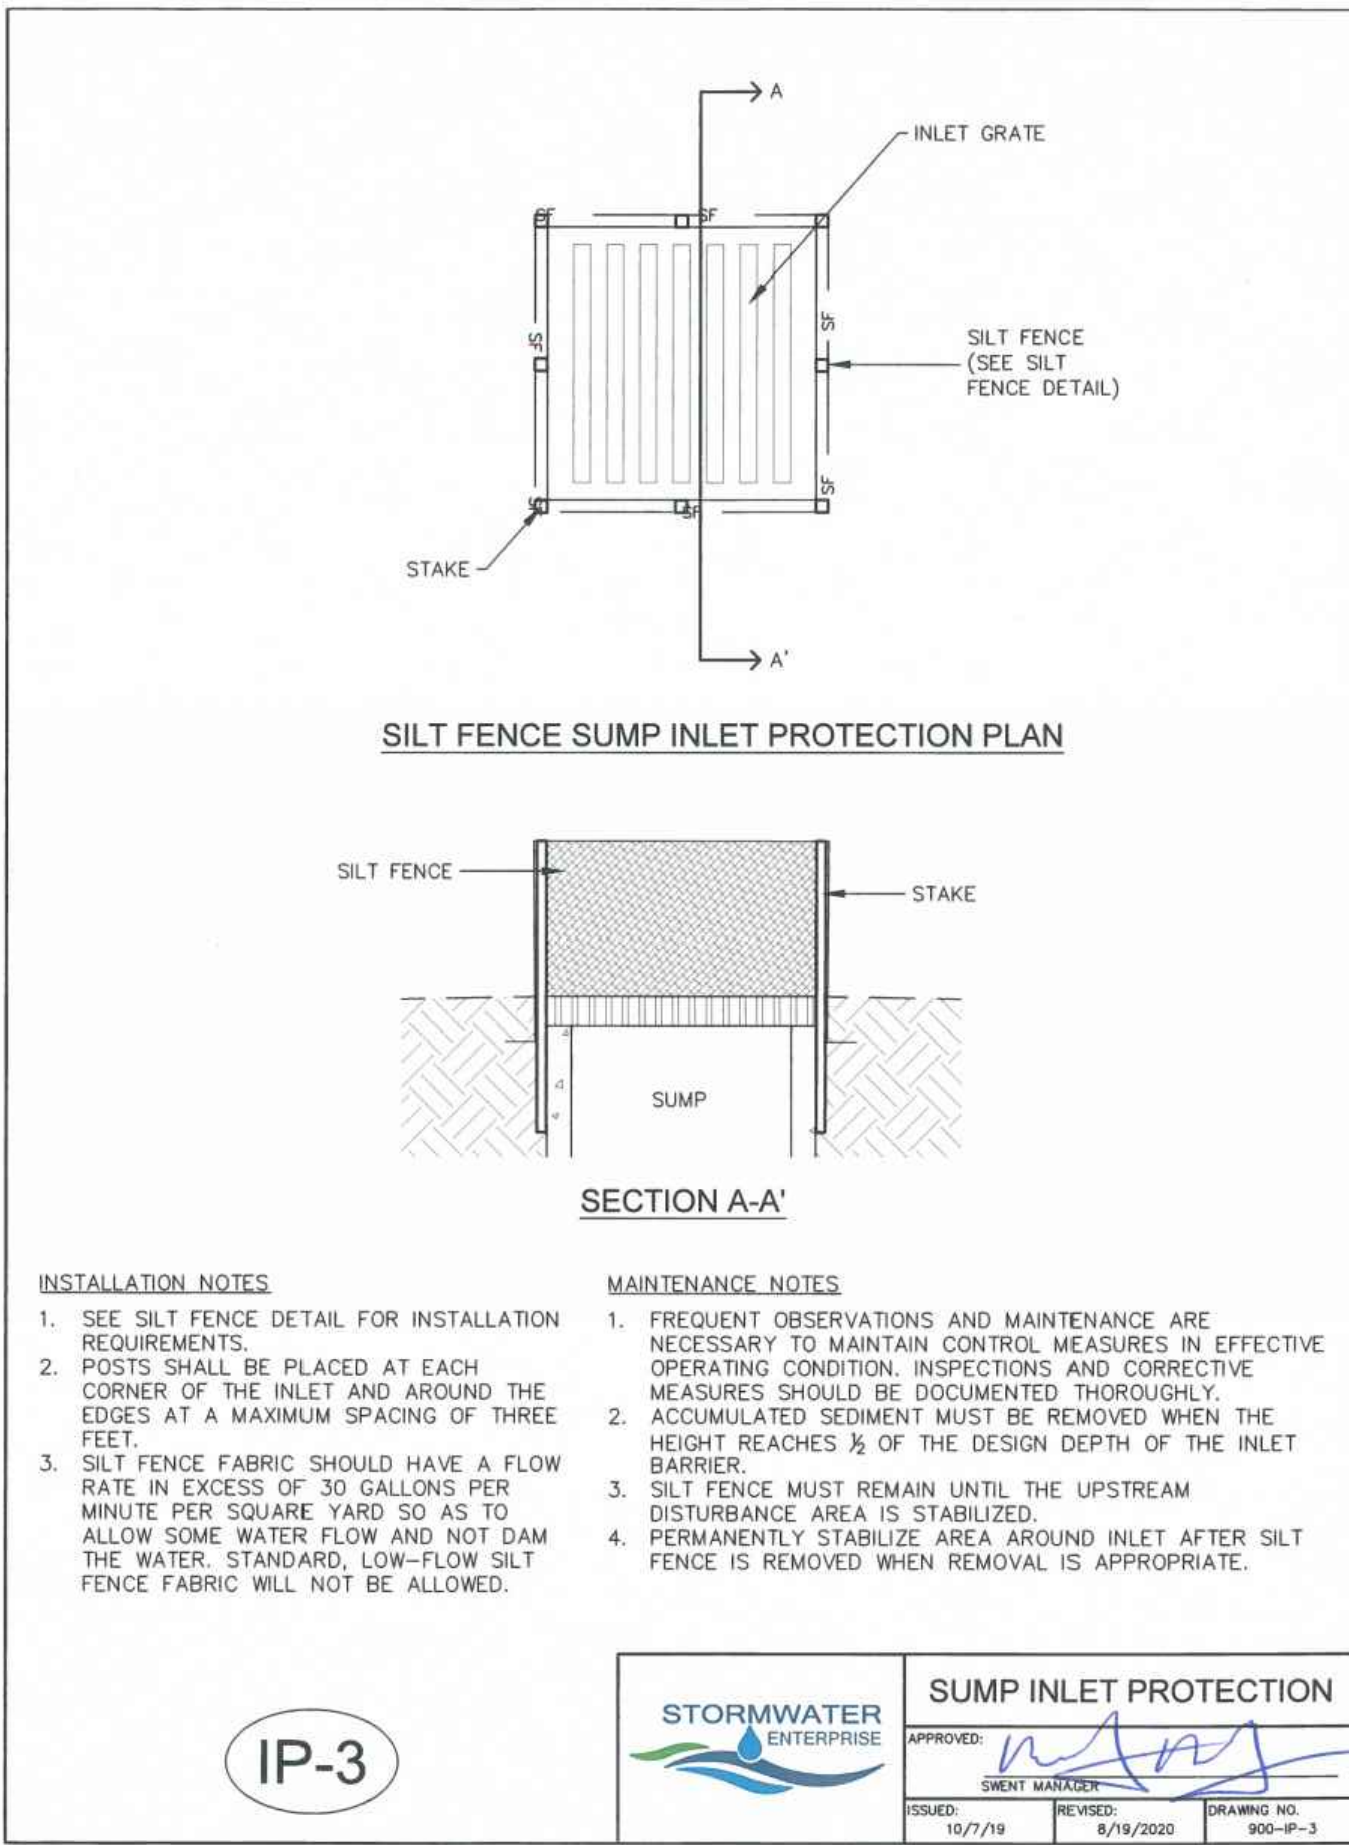




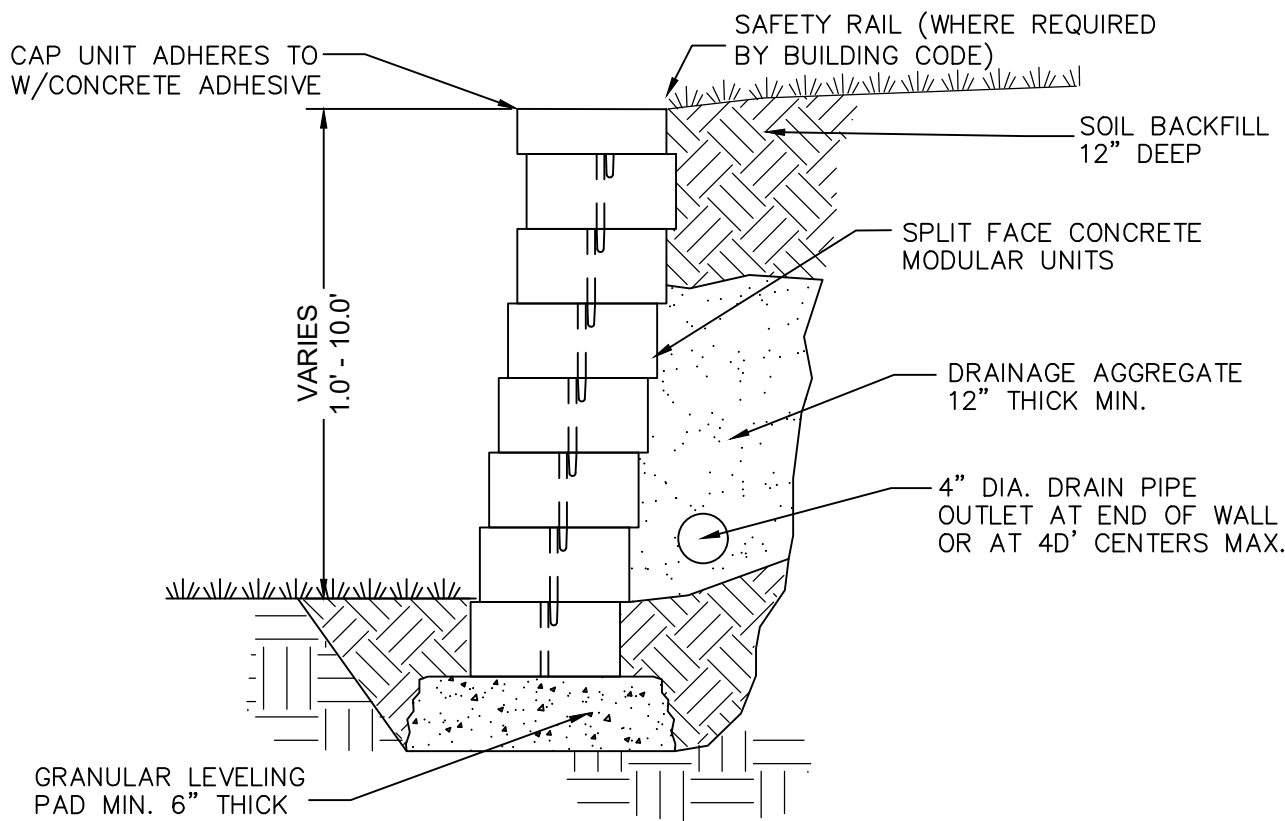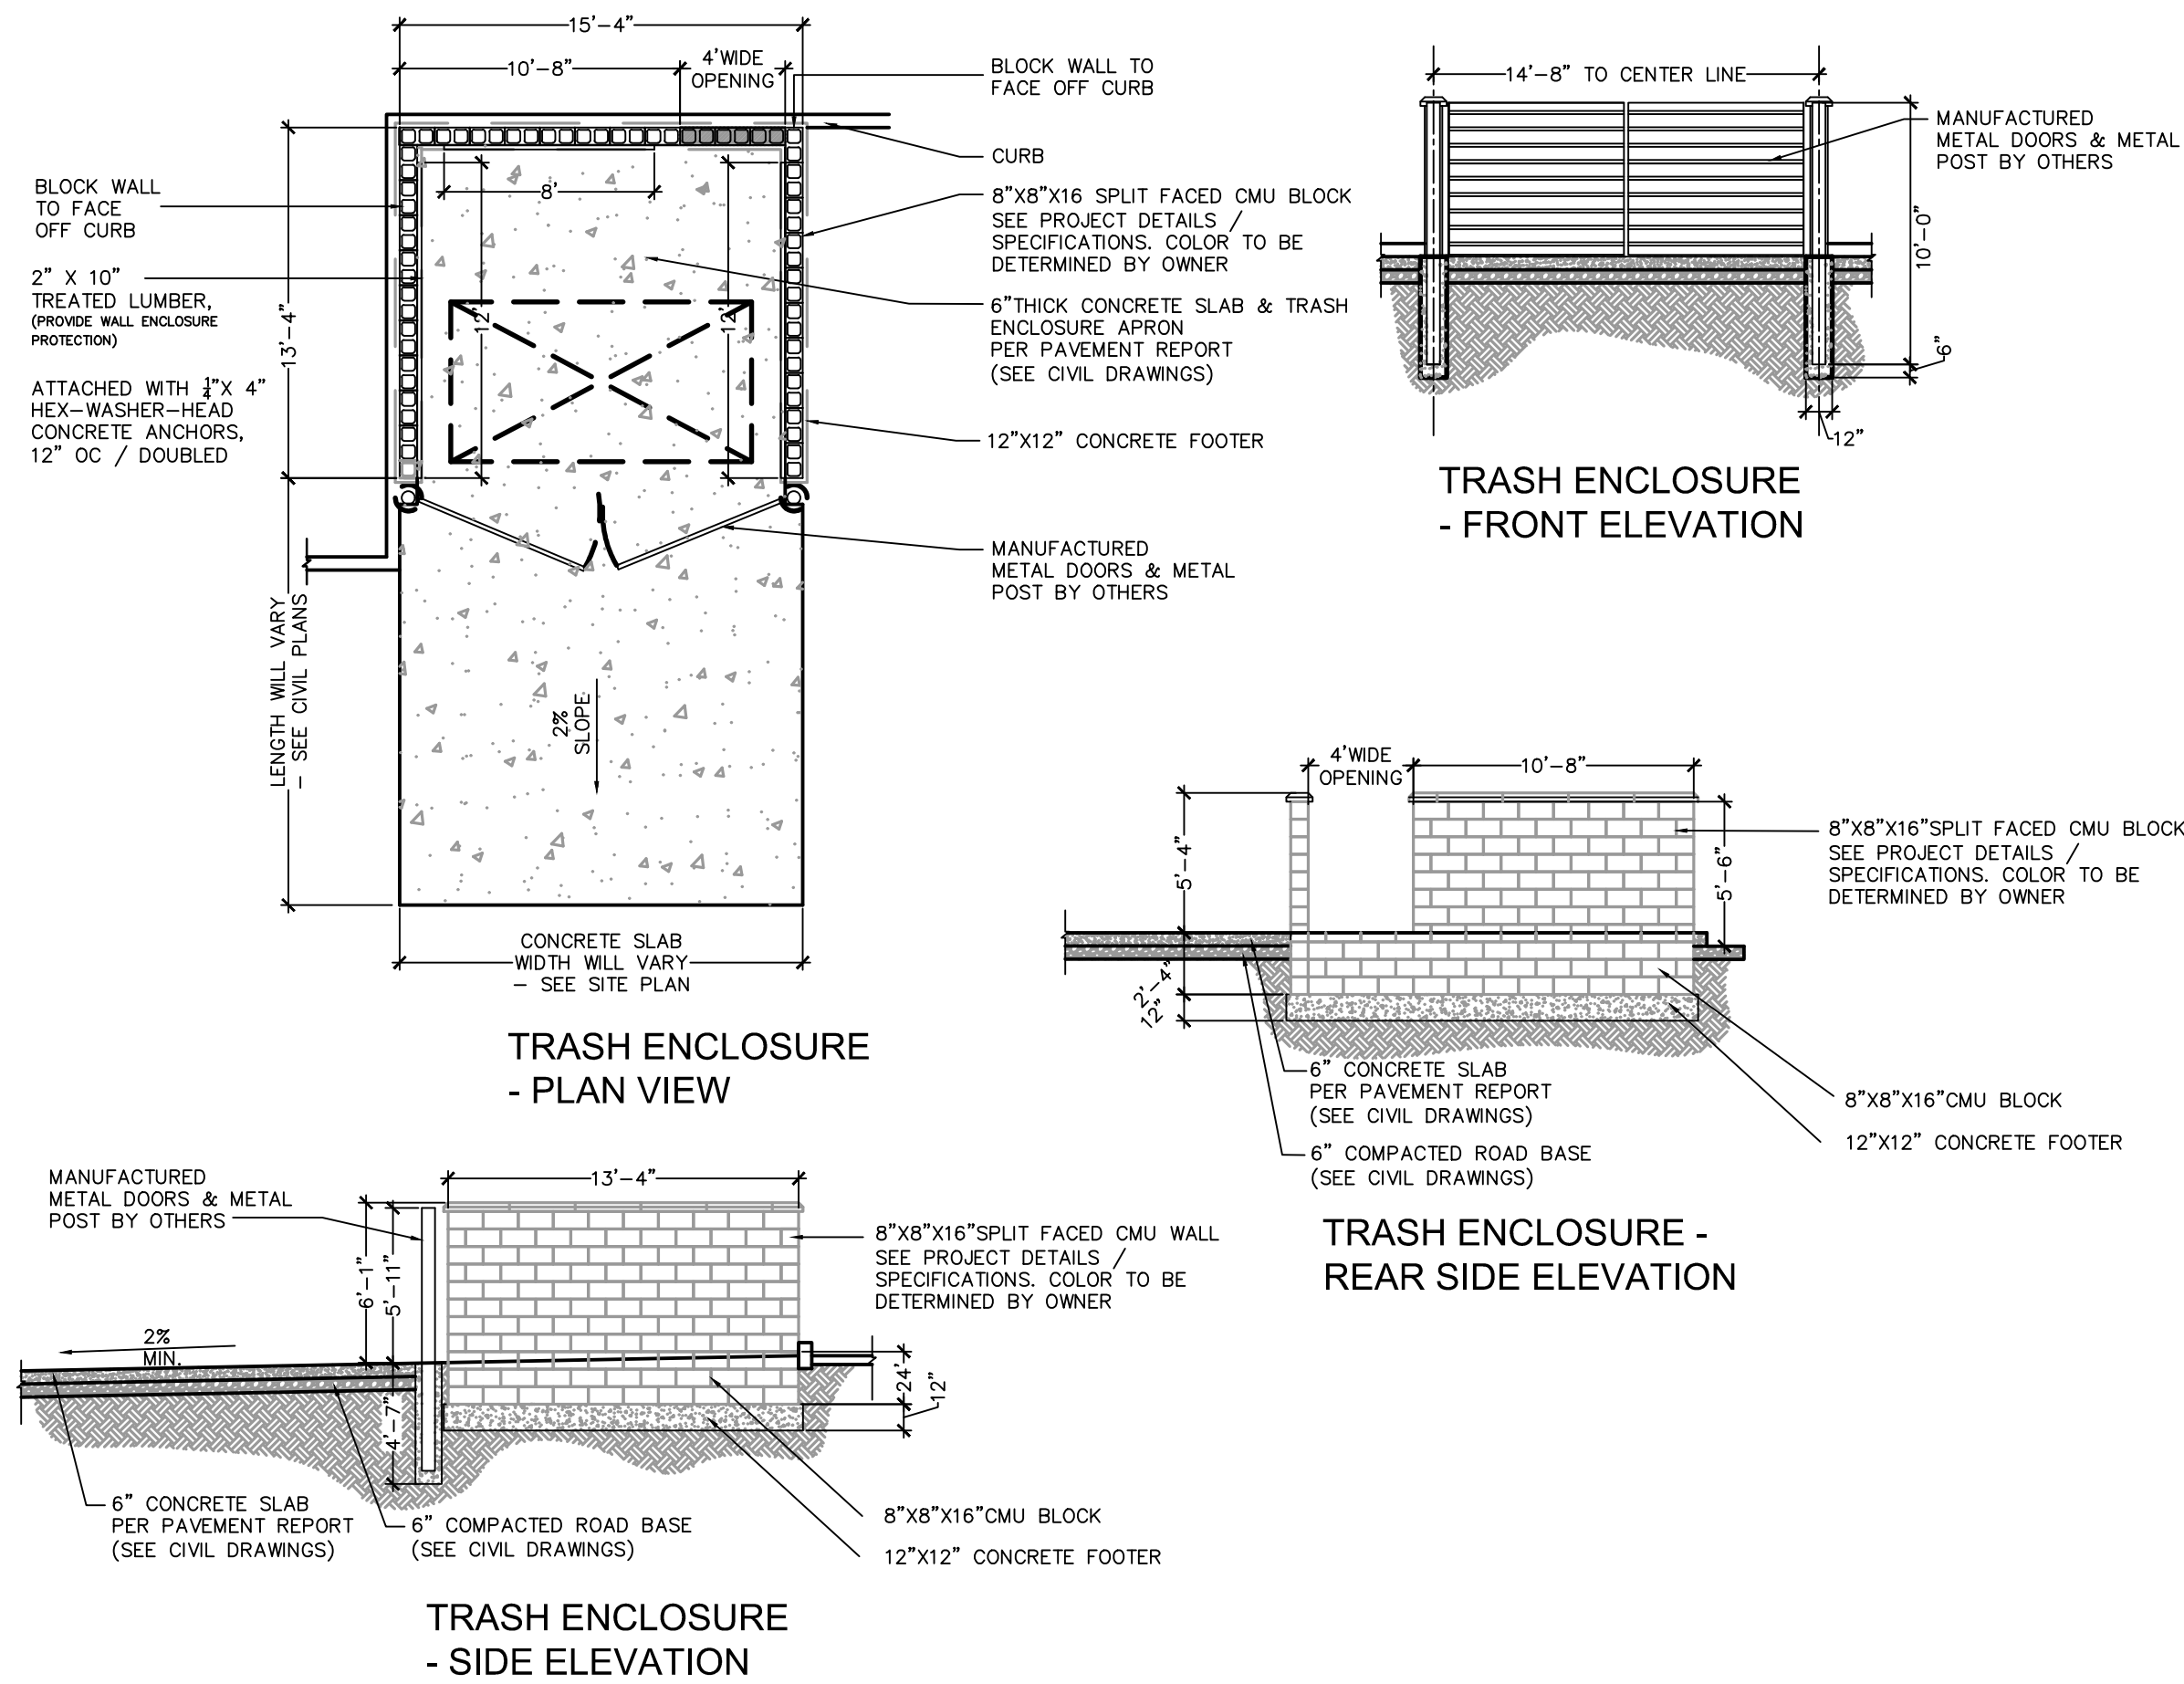


- NOTES:**
1. INSTALLATION TO BE COMPLETED IN ACCORDANCE WITH MANUFACTURER'S SPECIFICATIONS.
  2. RETAINING WALLS TO BE (ALTERNATE #1) AMASTONE MODULAR BLOCK WALL OR EQUAL (FINISH STRAIGHT W/ TEXTURE) OR (ALTERNATE #2) RED-ROCK LEDGESTONE
  3. WALLS THAT RETAIN MORE THAN 4 VERTICAL FEET SHALL REQUIRE A BUILDING PERMIT FROM THE PPRBD. STRUCTURAL DESIGNS TO BE PROVIDED BY CONTRACTOR PRIOR TO CONSTRUCTION.
  4. SEE CONSTRUCTION DRAWING GRADING SHEETS FOR TOP/BOTTOM/HEIGHT OF ALL WALLS
  5. SAFETY RAIL TO BE INSTALLED WHERE REQUIRED BY CODE.

**TYPICAL DETAIL - BLOCK RETAINING WALL**  
**ALTERNATE 1**  
**SCALE: NTS**

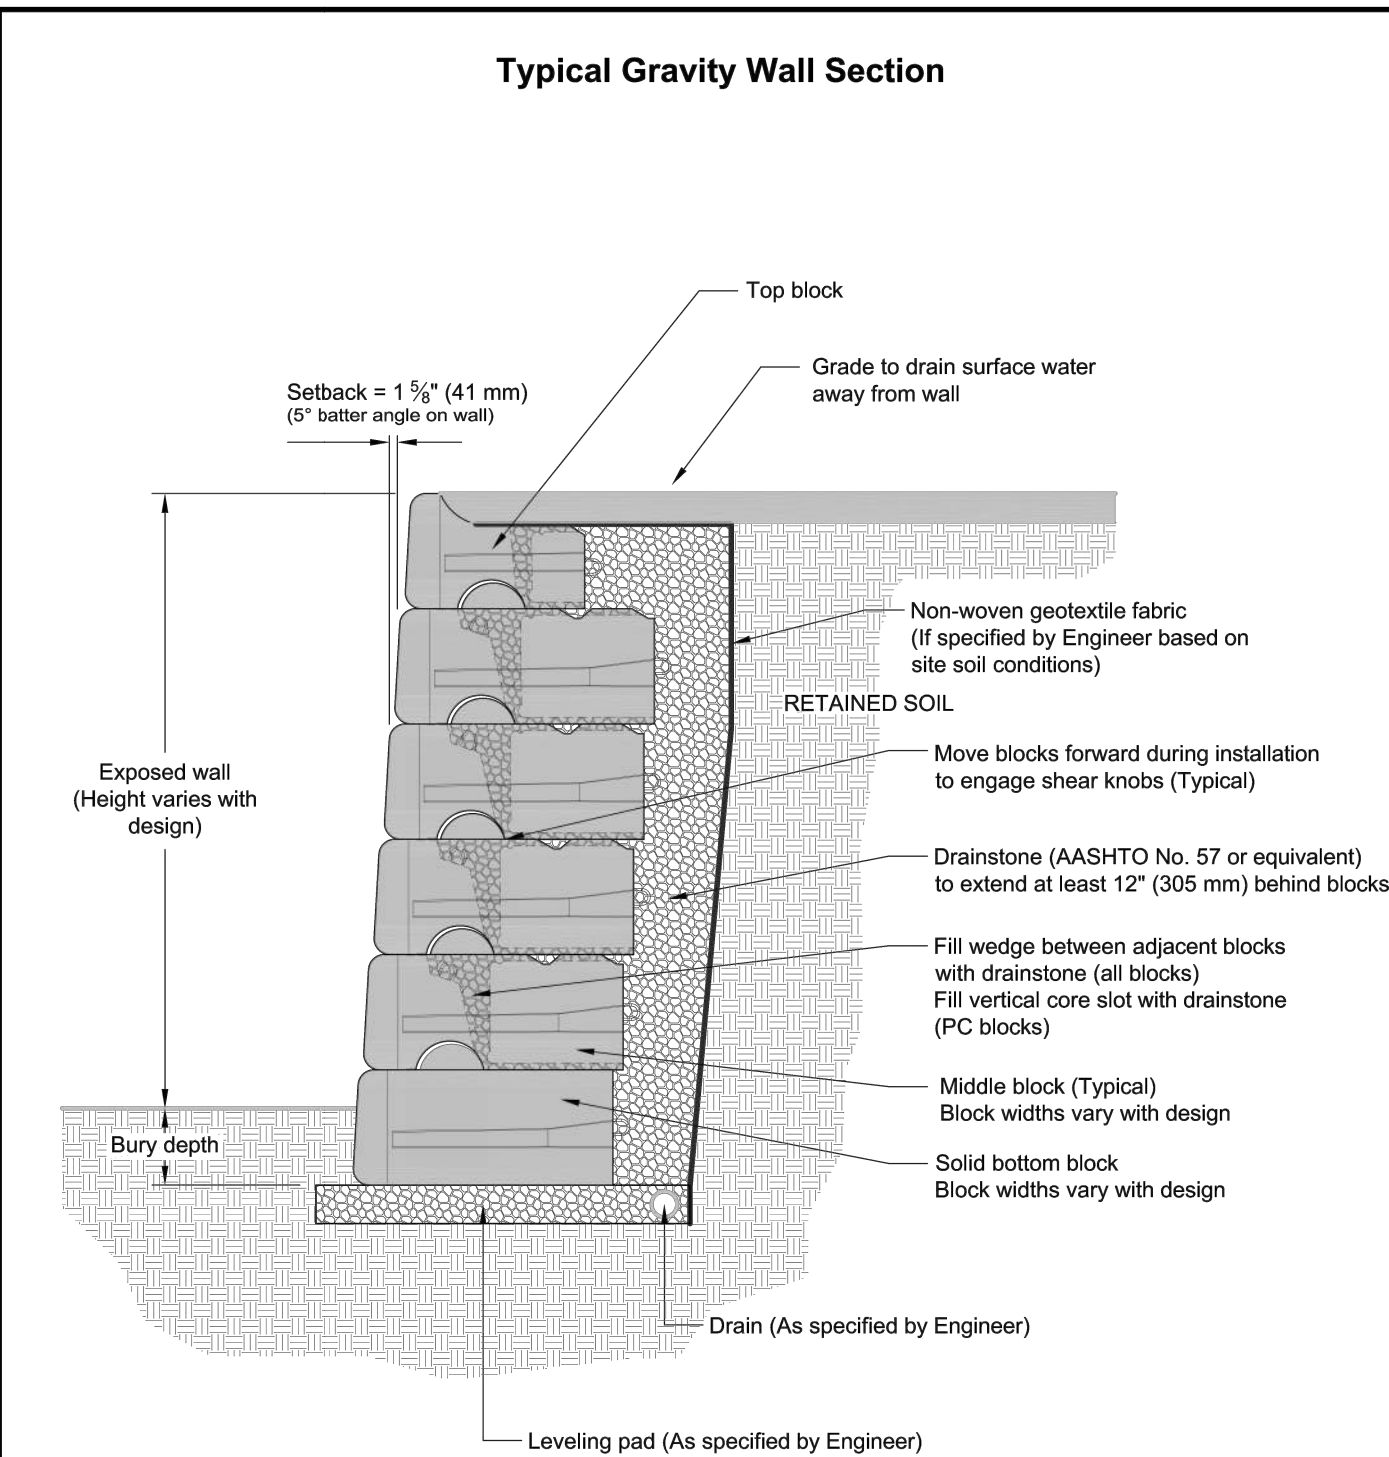

This drawing is for reference only. Determination of the suitability and/or manner of use of any details contained in this document is the sole responsibility of the design engineer of record. Final project designs, including all construction details, shall be prepared by a licensed professional engineer using the actual conditions of the proposed site.

DRAWN BY:	JRJ	TITLE:	Typical Gravity Wall Detail	<b>RED-ROCK</b> 05481 US 31 SOUTH, CHARLEVOLK, MI 49720 (800) 225-8400 ext 3010 • <a href="mailto:engineering@red-rock.com">engineering@red-rock.com</a> <a href="http://www.red-rock.com">www.red-rock.com</a>
APPROVED BY:	JRJ			
DATE:	17MAR2016			
SHEET:	1 of 1	FILE:	1 Typical Gravity Wall Detail 031716.dwg	

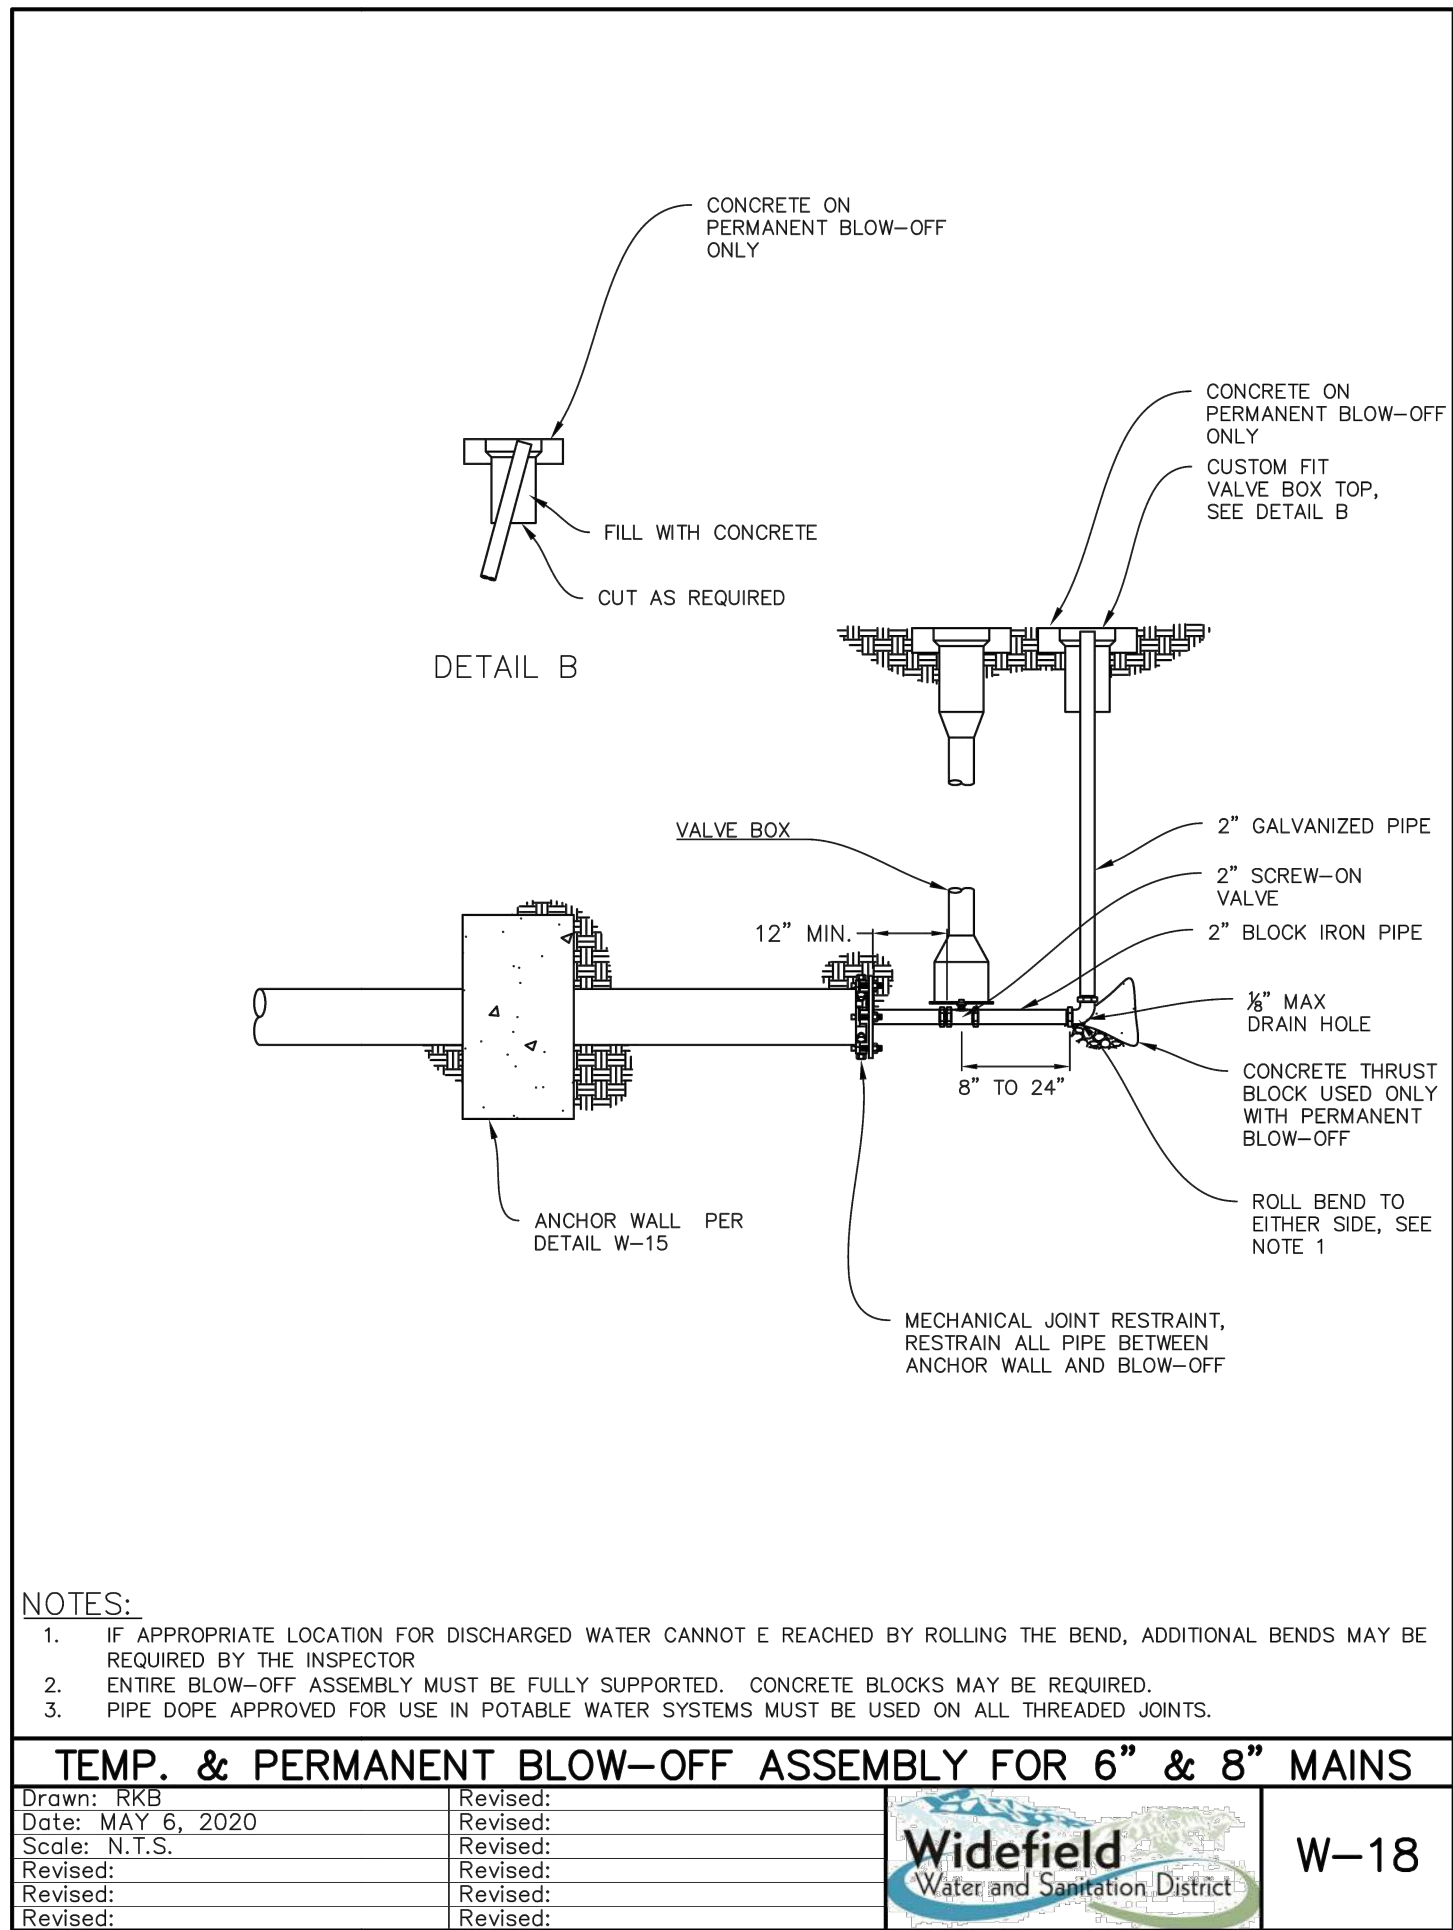


NO.	DATE	BY	REVISION DESCRIPTION



# THE COTTAGES AT MESA RIDGE

## CITY OF FOUNTAIN CONSTRUCTION DOCUMENTS

A PORTION OF THE NORTHEAST QUARTER OF SECTION 29, THE SOUTHEAST QUARTER OF SECTION 20, THE SOUTHWEST QUARTER OF SECTION 21, & THE NORTHWEST QUARTER OF SECTION 28, TOWNSHIP 13 SOUTH, RANGE 65 WEST OF THE 6TH P.M., COUNTY OF EL PASO, STATE OF COLORADO

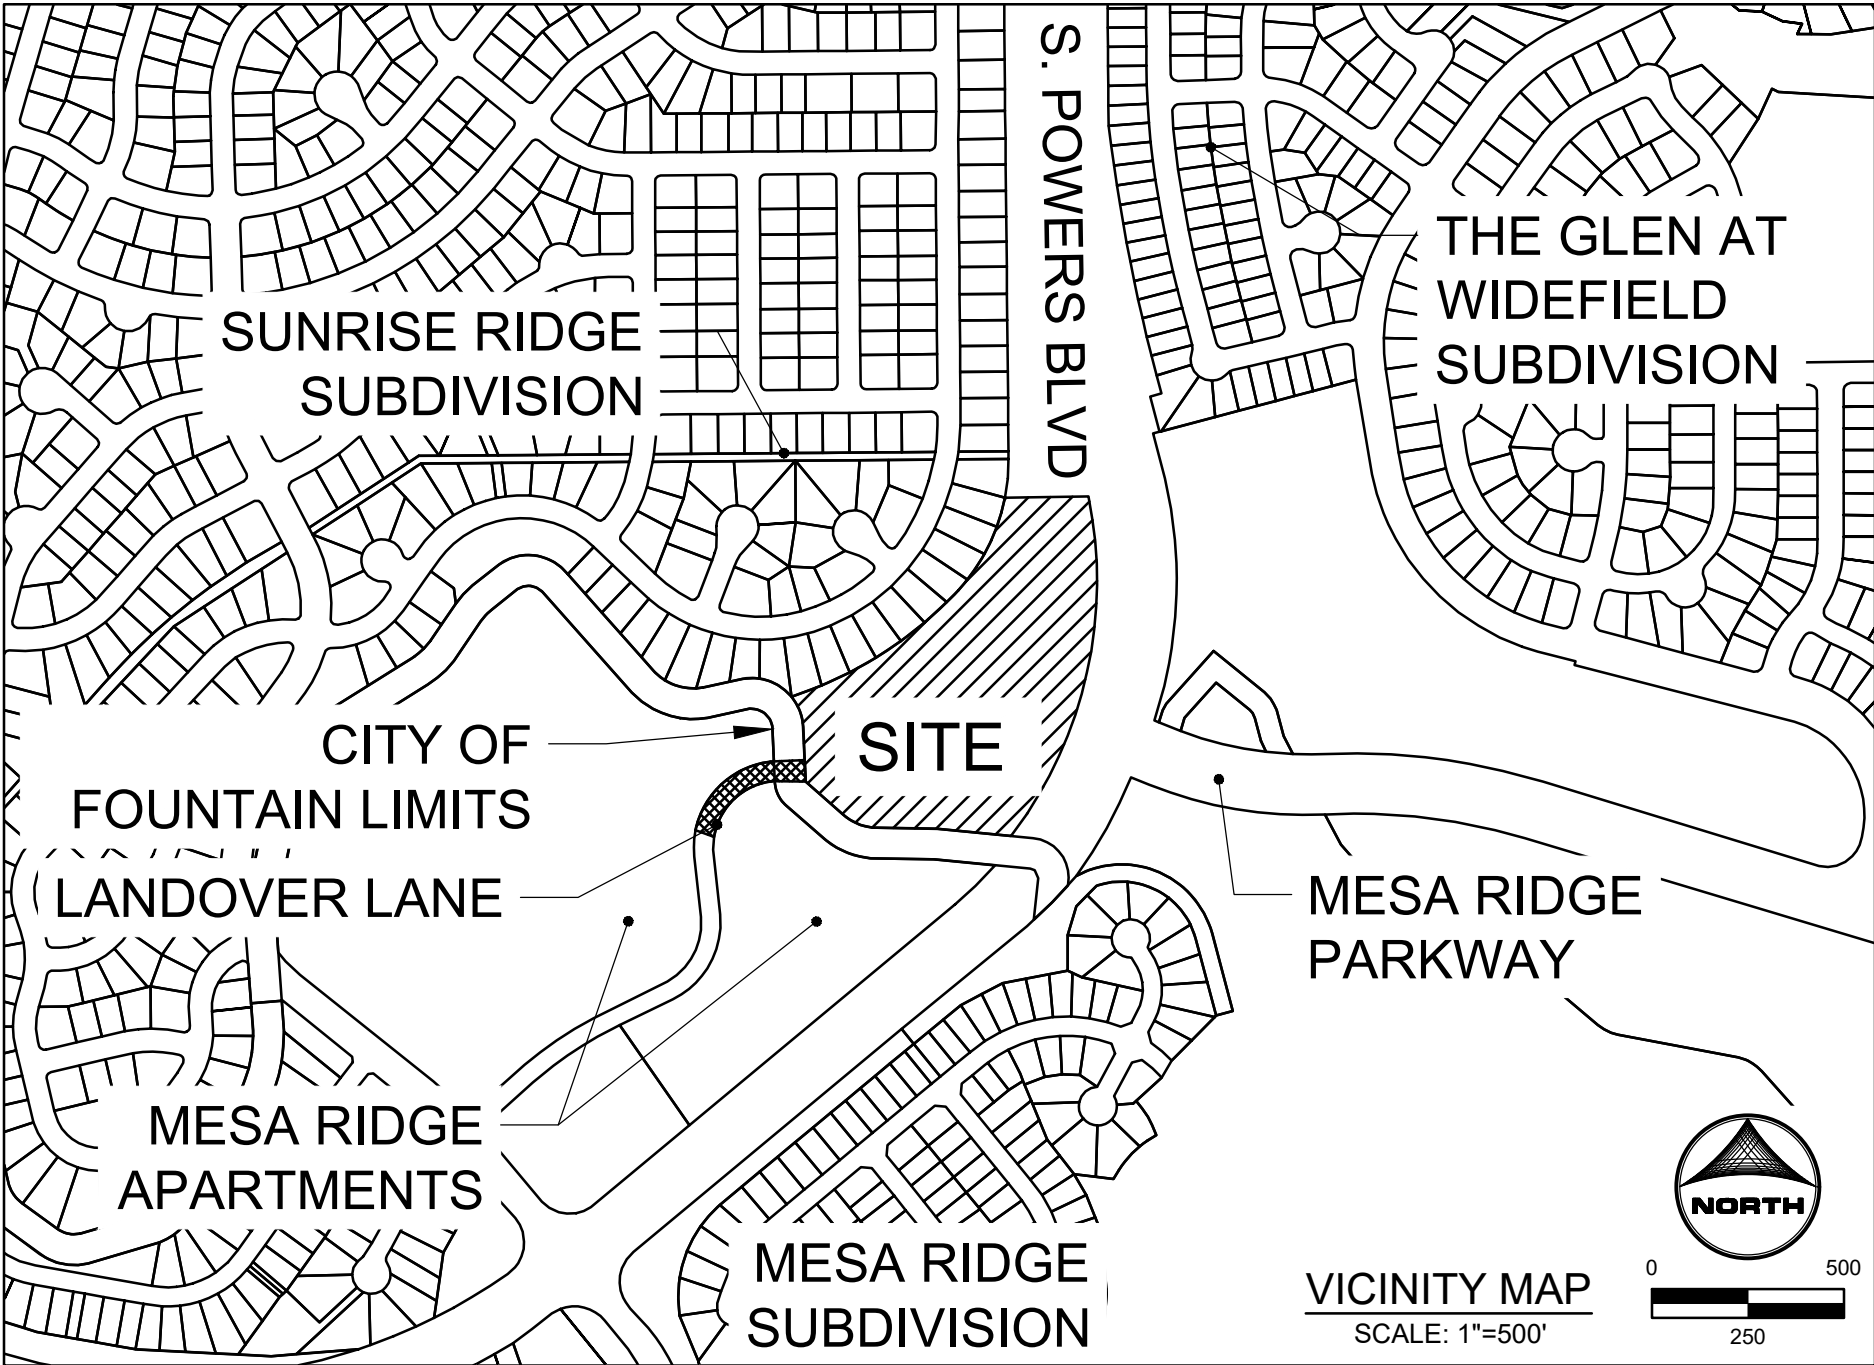

### STAKEHOLDERS:

OWNER:	CSJ NO 1 LLC 111 S. TEJON STREET, SUITE 222 COLORADO SPRINGS, CO 80903
DEVELOPER:	GOODWIN KNIGHT 8605 EXPLORER DRIVE, SUITE 250 COLORADO SPRINGS, CO 80920 DAVE MORRISON
ATTN:	
APPLICANT:	HR GREEN DEVELOPMENT, LLC 1975 RESEARCH PKWY, SUITE 230 COLORADO SPRINGS, CO 80920 PHIL STUEPFERT, KEN HUHN
ATTN:	
SURVEYOR:	BARRON LAND, LLC 2790 N ACADEMY BLVD #311 COLORADO SPRINGS, CO 80917 ATTN: SPENCER BARRON

### SHEET INDEX:

- 1 - COVER
- 2 - LEGEND & TYPICAL SECTIONS
- 3 - DEMOLITION PLAN
- 4 - DETAILED GRADING
- 5 - GEC - INITIAL PLAN
- 6 - GEC - INTERIM-FINAL PLAN
- 7 - LANDOVER LANE - PLAN & PROFILE
- 8 - STORM PLAN & PROFILE
- 9 - STORM PLAN & PROFILE
- 10 - OUTLET STRUCTURE MODIFICATION PLAN
- 11 - STRUCTURAL NOTES & DETAILS
- 12 - DETAILS
- 13 - DETAILS
- 14 - DETAILS

Please provide a note that indicates that the CD's for the City of Fountain portion of the project are for reference only.

HR GREEN:  
ADDRESSED  
(ADD TO  
FINAL PDF  
AS MARK  
UP).

### LEGAL DESCRIPTION:

THAT PORTION OF THE NORTHWEST QUARTER OF SECTION 28 AND THE NORTHEAST QUARTER OF SECTION 29, TOWNSHIP 15 SOUTH, RANGE 65 WEST OF THE 6TH P.M., COUNTY OF EL PASO, STATE OF COLORADO, DESCRIBED AS FOLLOWS:

BASIS OF BEARINGS: BEARINGS ARE BASED UPON THE NORTH LINE OF THE NORTHEAST QUARTER OF SAID SECTION 29, MONUMENTED AT THE WEST END WITH A 3.25" ALUMINUM CAP IN CONCRETE STAMPED "PLS 4842" AND MONUMENTED AT THE EAST END WITH A #6 REBAR AND 3.25" ALUMINUM CAP STAMPED "PLS 38141" AND ASSUMED TO BEAR S 89°57'13" E A FIELD MEASURED DISTANCE OF 2,652.37 FEET.

BENCHMARK: ELEVATIONS ARE BASED UPON THE FOUNTAIN SANITATION DISTRICT POINT N-1, BEING A 2" BRASS CAP IN CONCRETE AT THE NORTHEAST CORNER OF MESA RIDGE PARKWAY AND FOUNTAIN MESA ROAD. (ELEVATION=5750.57 NGVD 29).

BEGINNING AT THE NORTHWEST CORNER OF THE NORTHWEST QUARTER OF SAID SECTION 28; THENCE N 89°41'59" E ALONG THE NORTH LINE OF SAID NORTHWEST QUARTER, A DISTANCE OF 117.30 FEET TO A POINT ON THE WEST LINE OF POWERS BOULEVARD AS RECORDED UNDER BOOK 6788 AT PAGE 531 OF THE RECORDS OF THE EL PASO COUNTY CLERK AND RECORDERS OFFICE; THENCE ALONG THE WEST LINE OF SAID POWERS BOULEVARD, 933.14 FEET ALONG THE ARC OF A 1,096.98 FOOT RADIUS CURVE TO THE RIGHT, HAVING A CENTRAL ANGLE OF 48°44'17" AND A CHORD THAT BEARS S 12°56'23" W, 905.26 FEET TO A POINT ON THE NORTHERLY LINE OF THAT PARCEL OF LAND DESCRIBED UNDER BOOK 5506 AT PAGE 1290 OF SAID RECORDS; THENCE OF THE FOLLOWING EIGHT (8) COURSES ALONG SAID NORTHERLY LINES AND EASTERLY LINES OF SAID PARCEL OF LAND DESCRIBED UNDER BOOK 5506 AT PAGE 1290:

- 1) N 84°16'00" W, A DISTANCE OF 198.99 FEET;
  - 2) 46.11 FEET ALONG THE ARC OF A 540.00 FOOT RADIUS TANGENT CURVE TO THE LEFT, HAVING A CENTRAL ANGLE OF 04°53'33" AND A CHORD THAT BEARS N 86°42'46" W, 46.10 FEET;
  - 3) N 89°09'33" W, A DISTANCE OF 124.09 FEET;
  - 4) 100.02 FEET ALONG THE ARC OF A 140.00 FOOT RADIUS TANGENT CURVE TO THE RIGHT, HAVING A CENTRAL ANGLE OF 40°56'07" AND A CHORD THAT BEARS N 68°41'30" W, 97.91 FEET;
  - 5) N 48°13'27" W, A DISTANCE OF 126.77 FEET;
  - 6) 6.49 FEET ALONG THE ARC OF AN 8.00 FOOT RADIUS TANGENT CURVE TO THE RIGHT, HAVING A CENTRAL ANGLE OF 46°29'23" AND A CHORD THAT BEARS N 24°58'45" W, 6.31 FEET;
  - 7) N 01°44'04" W, A DISTANCE OF 137.18 FEET;
  - 8) 87.71 FEET ALONG THE ARC OF A 135.00 FOOT RADIUS TANGENT CURVE TO THE LEFT, HAVING A CENTRAL ANGLE OF 37°13'35" AND A CHORD THAT BEARS N 20°21'02" W, 86.18 FEET TO THE SOUTHWEST CORNER OF LOT 15, BLOCK 3, SUNRISE RIDGE SUBDIVISION FILING NO. 8 AS RECORDED UNDER RECEPTION NO. 1722613 OF SAID RECORDS;
- THENCE THE FOLLOWING TWO (2) COURSES ALONG THE EASTERLY LINE OF SAID SUNRISE RIDGE SUBDIVISION FILING NO. 8: 1) 511.39 FEET ALONG THE ARC OF A 1,034.60 FOOT RADIUS CURVE TO THE LEFT, HAVING A CENTRAL ANGLE OF 28°19'14" AND A CHORD THAT BEARS N 58°13'41" E, 506.20 FEET TO A POINT OF COMPOUND CURVATURE;
- 2) 283.12 FEET ALONG THE ARC OF A 500.00 FOOT RADIUS CURVE TO THE LEFT, HAVING A CENTRAL ANGLE OF 32°26'36" AND A CHORD THAT BEARS N 27°50'47" E, 279.35 FEET TO A POINT ON THE NORTH LINE OF SAID NORTHEAST QUARTER;
- THENCE N 89°57'13" E ALONG THE NORTH LINE OF SAID NORTHEAST QUARTER, A DISTANCE OF 115.21 FEET TO THE POINT OF BEGINNING.

CONTAINING A CALCULATED AREA OF 445,104 SQUARE FEET (10.218 ACRES) OF LAND, MORE OR LESS.

TO BE PLATTED AS "COTTAGES AT MESA RIDGE"

### GRADING AND EROSION CONTROL NOTES:

1. ANY LAND DISTURBANCE BY ANY OWNER, DEVELOPER, BUILDER, CONTRACTOR, OR OTHER PERSON SHALL COMPLY WITH THE BASIC GRADING, EROSION AND STORMWATER QUALITY CONTROL REQUIREMENTS AND GENERAL PROHIBITIONS NOTED IN THE DRAINAGE CRITERIA MANUAL VOLUME II.
2. NO CLEARING, GRADING, EXCAVATION, FILLING, OR OTHER LAND DISTURBING ACTIVITIES SHALL BE PERMITTED UNTIL SIGNOFF AND ACCEPTANCE OF THE GRADING PLAN AND EROSION AND STORMWATER QUALITY CONTROL PLAN IS RECEIVED FROM EDRD.
3. THE INSTALLATION OF THE FIRST LEVEL OF TEMPORARY EROSION CONTROL FACILITIES AND BMP'S SHALL BE INSTALLED AND INSPECTED PRIOR TO ANY EARTH DISTURBANCE OPERATIONS TAKING PLACE. CALL CITY STORMWATER INSPECTIONS, 385-5980, 48 HOURS PRIOR TO CONSTRUCTION.
4. SEDIMENT (MUD AND DIRT) TRANSPORTED ONTO A PUBLIC ROAD, REGARDLESS OF THE SIZE OF THE SITE, SHALL BE CLEANED IMMEDIATELY.
5. CONCRETE WASH WATER SHALL NOT BE DISCHARGED TO OR ALLOWED TO RUNOFF TO STATE WATERS, INCLUDING ANY SURFACE OR SUBSURFACE STORM DRAINAGE SYSTEM OR FACILITIES.
6. SOIL EROSION CONTROL MEASURES FOR ALL SLOPES, CHANNELS, DITCHES, OR ANY DISTURBED LAND AREA SHALL BE COMPLETED WITHIN TWENTY-ONE (21) CALENDAR DAYS AFTER FINAL GRADING OR FINAL EARTH DISTURBANCE HAS BEEN COMPLETED. DISTURBED AREAS AND STOCKPILES WHICH ARE NOT AT FINAL GRADE BUT WILL REMAIN DORMANT FOR LONGER THAN THIRTY (30) DAYS SHALL ALSO BE MULCHED WITHIN TWENTY-ONE (21) DAYS AFTER INTERIM GRADING. AN AREA THAT IS GOING TO REMAIN IN AN INTERIM STATE FOR MORE THAN SIXTY (60) DAYS SHALL ALSO BE SEEDED. ALL TEMPORARY SOIL EROSION CONTROL MEASURES AND BMP'S SHALL BE MAINTAINED UNTIL PERMANENT SOIL EROSION CONTROL MEASURES ARE IMPLEMENTED.
7. THE GRADING AND EROSION CONTROL PLAN WILL BE SUBJECT TO RE-REVIEW AND RE-ACCEPTANCE BY EDRD SHOULD ANY OF THE FOLLOWING OCCUR: GRADING DOES NOT COMMENCE WITHIN TWELVE (12) MONTHS OF THE CITY ENGINEER'S ACCEPTANCE OF THE PLAN, A CHANGE IN PROPERTY OWNERSHIP, PROPOSED DEVELOPMENT CHANGES, OR PROPOSED GRADING REVISIONS.
8. THE PLAN SHALL NOT SUBSTANTIALLY CHANGE THE DEPTH OF COVER, OR ACCESS EXISTING UTILITY LINES. ACCEPTANCE OF THIS PLAN DOES NOT CONSTITUTE APPROVAL TO GRADE IN ANY UTILITY EASEMENT OR RIGHT-OF-WAY. APPROVALS TO GRADE WITHIN UTILITY EASEMENTS MUST BE OBTAINED FROM THE APPROPRIATE UTILITY COMPANY. IT IS NOT PERMISSIBLE FOR ANY PERSON TO MODIFY THE GRADE OF THE EARTH ON ANY COLORADO SPRINGS UTILITIES EASEMENT OR UTILITY RIGHT-OF-WAY WITHOUT THEIR WRITTEN APPROVAL. THE PLAN SHALL NOT INCREASE OR DIVERT WATER TOWARDS UTILITY FACILITIES. ANY CHANGES TO EXISTING UTILITY FACILITIES TO ACCOMMODATE THE PLAN MUST BE APPROVED BY THE AFFECTED UTILITY OWNER PRIOR TO IMPLEMENTING THE PLAN. THE COST TO RELOCATE OR PROTECT EXISTING UTILITIES OR TO PROVIDE INTERIM ACCESS IS THE APPLICANT'S EXPENSE.

### DETAILED DRAINAGE CONSTRUCTION PLANS AND SPECIFICATIONS ENGINEER'S STATEMENT:

THESE DETAILED PLANS AND SPECIFICATIONS WERE PREPARED UNDER MY DIRECT SUPERVISION. SAID DETAILED PLANS AND SPECIFICATIONS HAVE BEEN PREPARED ACCORDING TO THE ESTABLISHED CRITERIA FOR DETAILED DRAINAGE PLANS AND SPECIFICATIONS, AND SAID DETAILED PLANS AND SPECIFICATIONS ARE IN CONFORMITY WITH THE MASTER PLAN OF THE DRAINAGE BASIN. SAID DRAINAGE PLANS AND SPECIFICATIONS MEET THE PURPOSES FOR WHICH THE PARTICULAR DRAINAGE FACILITY(S) IS DESIGNED. I ACCEPT RESPONSIBILITY FOR ANY LIABILITY CAUSED BY ANY NEGLIGENT ACTS, ERRORS OR OMISSIONS ON MY PART IN PREPARATION OF THE DETAILED PLANS AND SPECIFICATIONS.

SIGNATURE (AFFIX SEAL): \_\_\_\_\_ DATE: \_\_\_\_\_  
COLORADO PROFESSIONAL ENGINEER NO.: \_\_\_\_\_

### CITY OF FOUNTAIN DETAILED DRAINAGE CONSTRUCTION PLANS AND SPECIFICATIONS REVIEW:

PLAN REVIEW BY THE CITY OF FOUNTAIN IS PROVIDED ONLY FOR GENERAL CONFORMANCE WITH THE DESIGN CRITERIA. THE CITY OF FOUNTAIN IS NOT RESPONSIBLE FOR THE ACCURACY AND ADEQUACY OF THE DESIGN, DIMENSIONS, AND/OR ELEVATIONS WHICH SHALL BE CONFIRMED AT THE JOB SITE. THE CITY OF FOUNTAIN, THROUGH THE APPROVAL OF THIS DOCUMENT, ASSUMED NO RESPONSIBILITY FOR COMPLETENESS AND/OR ACCURACY OF THIS DOCUMENT.

BRANDY R WILLIAMS, P.E., CITY ENGINEER DATE: \_\_\_\_\_

### ENGINEER'S STATEMENT

THIS GRADING AND EROSION CONTROL PLAN WAS PREPARED UNDER MY DIRECT SUPERVISION AND IS CORRECT TO THE BEST OF MY KNOWLEDGE AND BELIEF. IF SUCH WORK IS PERFORMED IN ACCORDANCE WITH THE GRADING AND EROSION CONTROL PLAN, THE WORK WILL NOT BECOME A HAZARD TO LIFE AND LIMB, ENDANGER PROPERTY, OR ADVERSELY AFFECT THE SAFETY, USE OR STABILITY OF A PUBLIC WAY, DRAINAGE CHANNEL, OR OTHER PROPERTY.

SIGNATURE (AFFIX SEAL) \_\_\_\_\_ DATE \_\_\_\_\_

### OWNER'S STATEMENT

THE OWNER WILL COMPLY WITH THE REQUIREMENTS OF THE GRADING AND EROSION CONTROL PLAN INCLUDING TEMPORARY CONTROL MEASURE INSPECTION REQUIREMENTS AND FINAL STABILIZATION REQUIREMENTS, ACCORDING TO THE CITY OF COLORADO SPRINGS STORMWATER CONSTRUCTION MANUAL. I ACKNOWLEDGE THE RESPONSIBILITY TO DETERMINE WHETHER THE CONSTRUCTION ACTIVITIES ON THESE PLANS REQUIRE COLORADO DISCHARGE PERMIT SYSTEM (CDPS) PERMITTING FOR STORMWATER DISCHARGES ASSOCIATED WITH CONSTRUCTION ACTIVITY.

DEVELOPER/OWNER SIGNATURE: \_\_\_\_\_ DATE: \_\_\_\_\_

NAME OF DEVELOPER/OWNER: \_\_\_\_\_

DBA: \_\_\_\_\_ PHONE: \_\_\_\_\_

TITLE: \_\_\_\_\_ EMAIL: \_\_\_\_\_

ADDRESS: \_\_\_\_\_

FAX: \_\_\_\_\_

### CITY OF FOUNTAIN GRADING AND EROSION CONTROL REVIEW:

THIS GRADING PLAN AND EROSION CONTROL PLAN IS FILED IN ACCORDANCE WITH SECTION 12.04.160 OF THE CODE OF THE CITY OF FOUNTAIN. THIS PLAN IS REVIEWED WITH THE DRAINAGE CRITERIA MANUAL, VOL. I (JANUARY 2024) AND VOL. II (DECEMBER 2020); STORMWATER CONSTRUCTION MANUAL; LATEST REVISIONS.

BRANDY R WILLIAMS, P.E., CITY ENGINEER DATE: \_\_\_\_\_

NOTES: \_\_\_\_\_

DRAWN BY: NQJ JOB DATE: 8/22/2022  
APPROVED: KMH JOB NUMBER: 200541  
CAD DATE: 8/22/2022  
CAD FILE: J:\2020\200541\CAD\DWG\IC\CDIC.O.F\Cover

BAR IS ONE INCH ON  
OFFICIAL DRAWINGS.  
0" 1"  
IF NOT ONE INCH,  
ADJUST SCALE ACCORDINGLY.

NO.	DATE	BY	REVISION DESCRIPTION



HR GREEN - COLORADO SPRINGS  
7222 COMMERCE CENTER DR SUITE 220  
COLORADO SPRINGS CO 80919  
PHONE: 719.300.4140 TOLL FREE: 800.728.7805  
FAX: 844.273.1057 | HRGreen.com

THE COTTAGES AT MESA RIDGE  
GOODWIN KNIGHT  
FOUNTAIN, COLORADO




CITY OF FOUNTAIN CONSTRUCTION DOCUMENTS  
COVER

SHEET  
CV

1

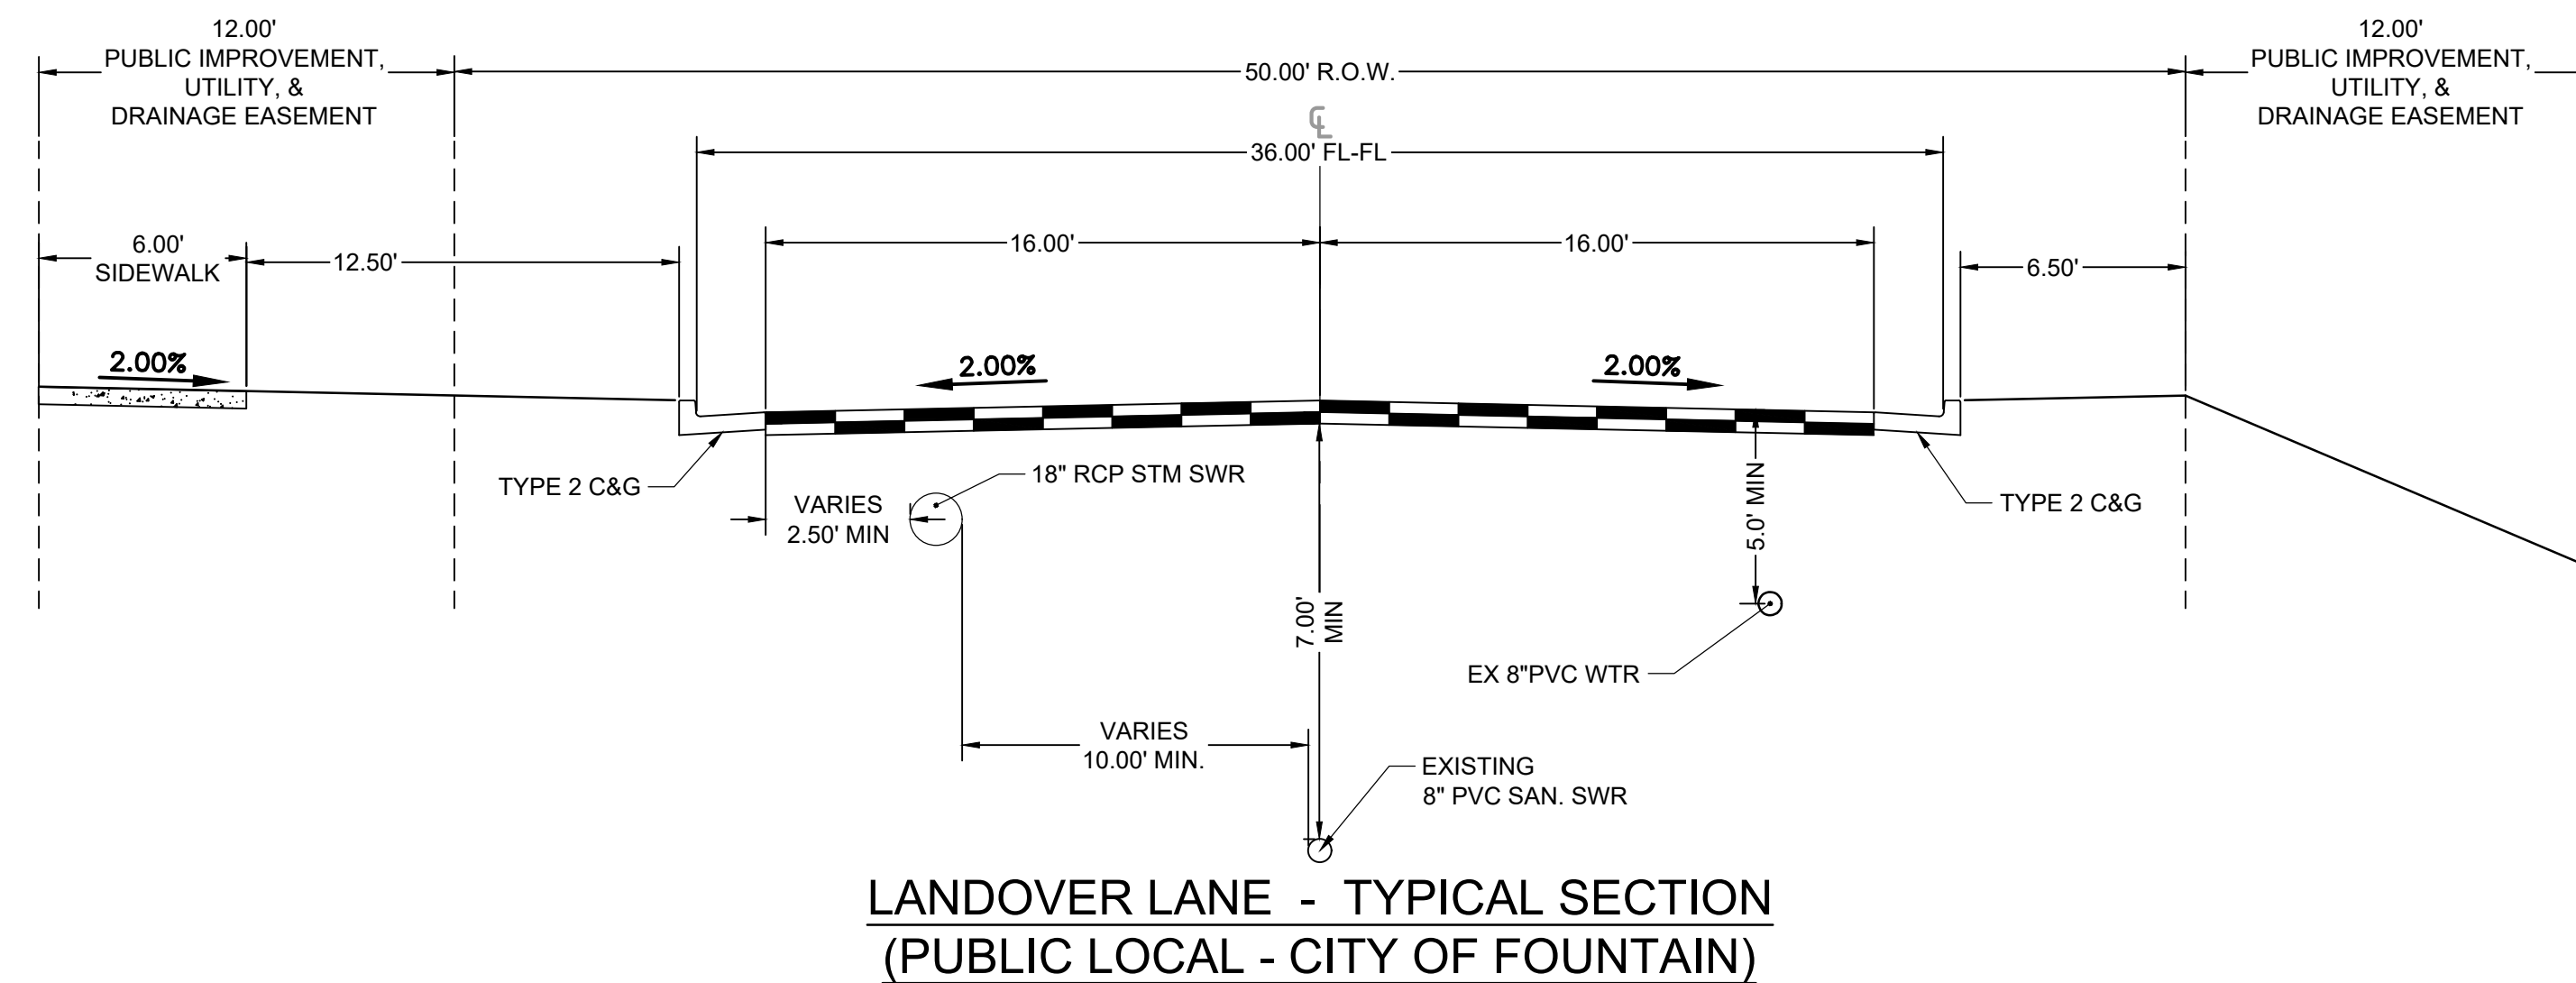


[illegible]

NOT FOR CONSTRUCTION

NO.	DATE	BY	REVISION DESCRIPTION



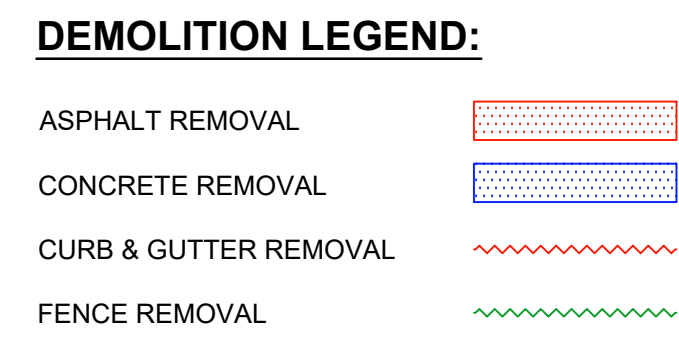

<b>ENGINEER'S STATEMENT:</b>	
SIGNATURE (AFFIX SEAL): _____	DATE: _____
COLORADO PROFESSIONAL ENGINEER NO: _____	


**ACCEPTANCE:**

THESE PLANS SUBMITTED APPEAR TO BE IN CONFORMANCE WITH THE CITY OF FOUNTAIN SUBMITTAL REQUIREMENTS AND STANDARD ENGINEERING PRINCIPLES AND PRACTICES APPEAR TO HAVE BEEN FOLLOWED. THE PROFESSIONAL ENGINEER SUBMITTED AND SEALING THE PLANS IS SOLELY RESPONSIBLE FOR THEIR ACCURACY AND VALIDITY. THE REVIEW IS ONLY VALID FOR ONE (1) YEAR FROM THE DATE BELOW.


BRANDY R WILLIAMS, P.E., CITY ENGINEER

DATE: \_\_\_\_\_



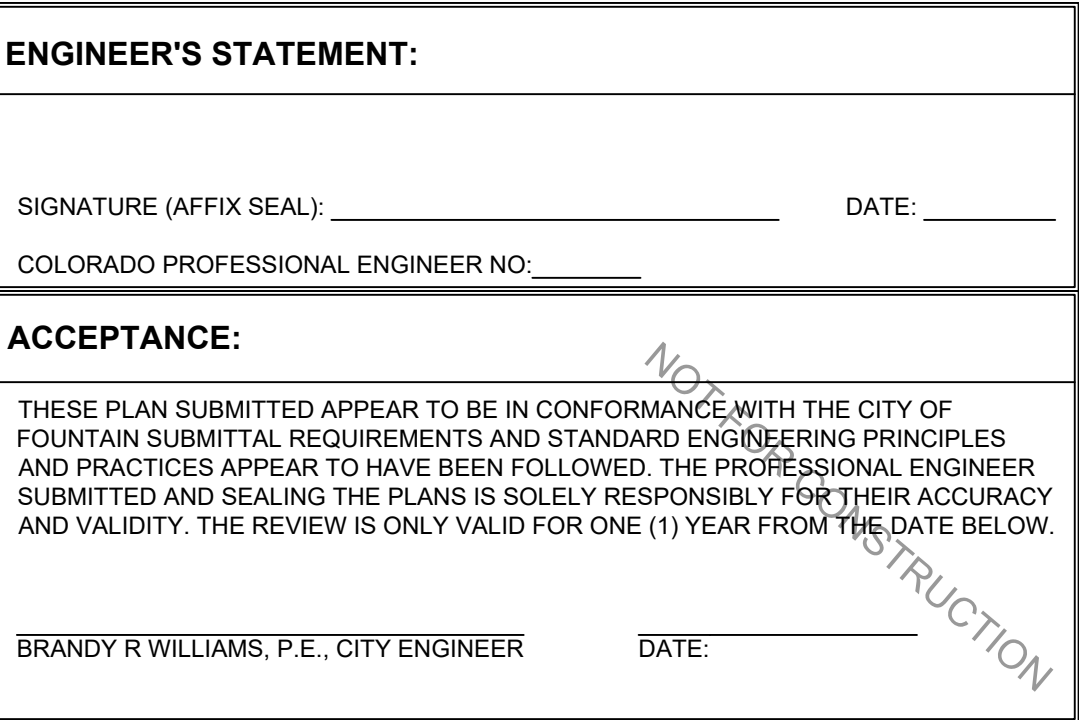



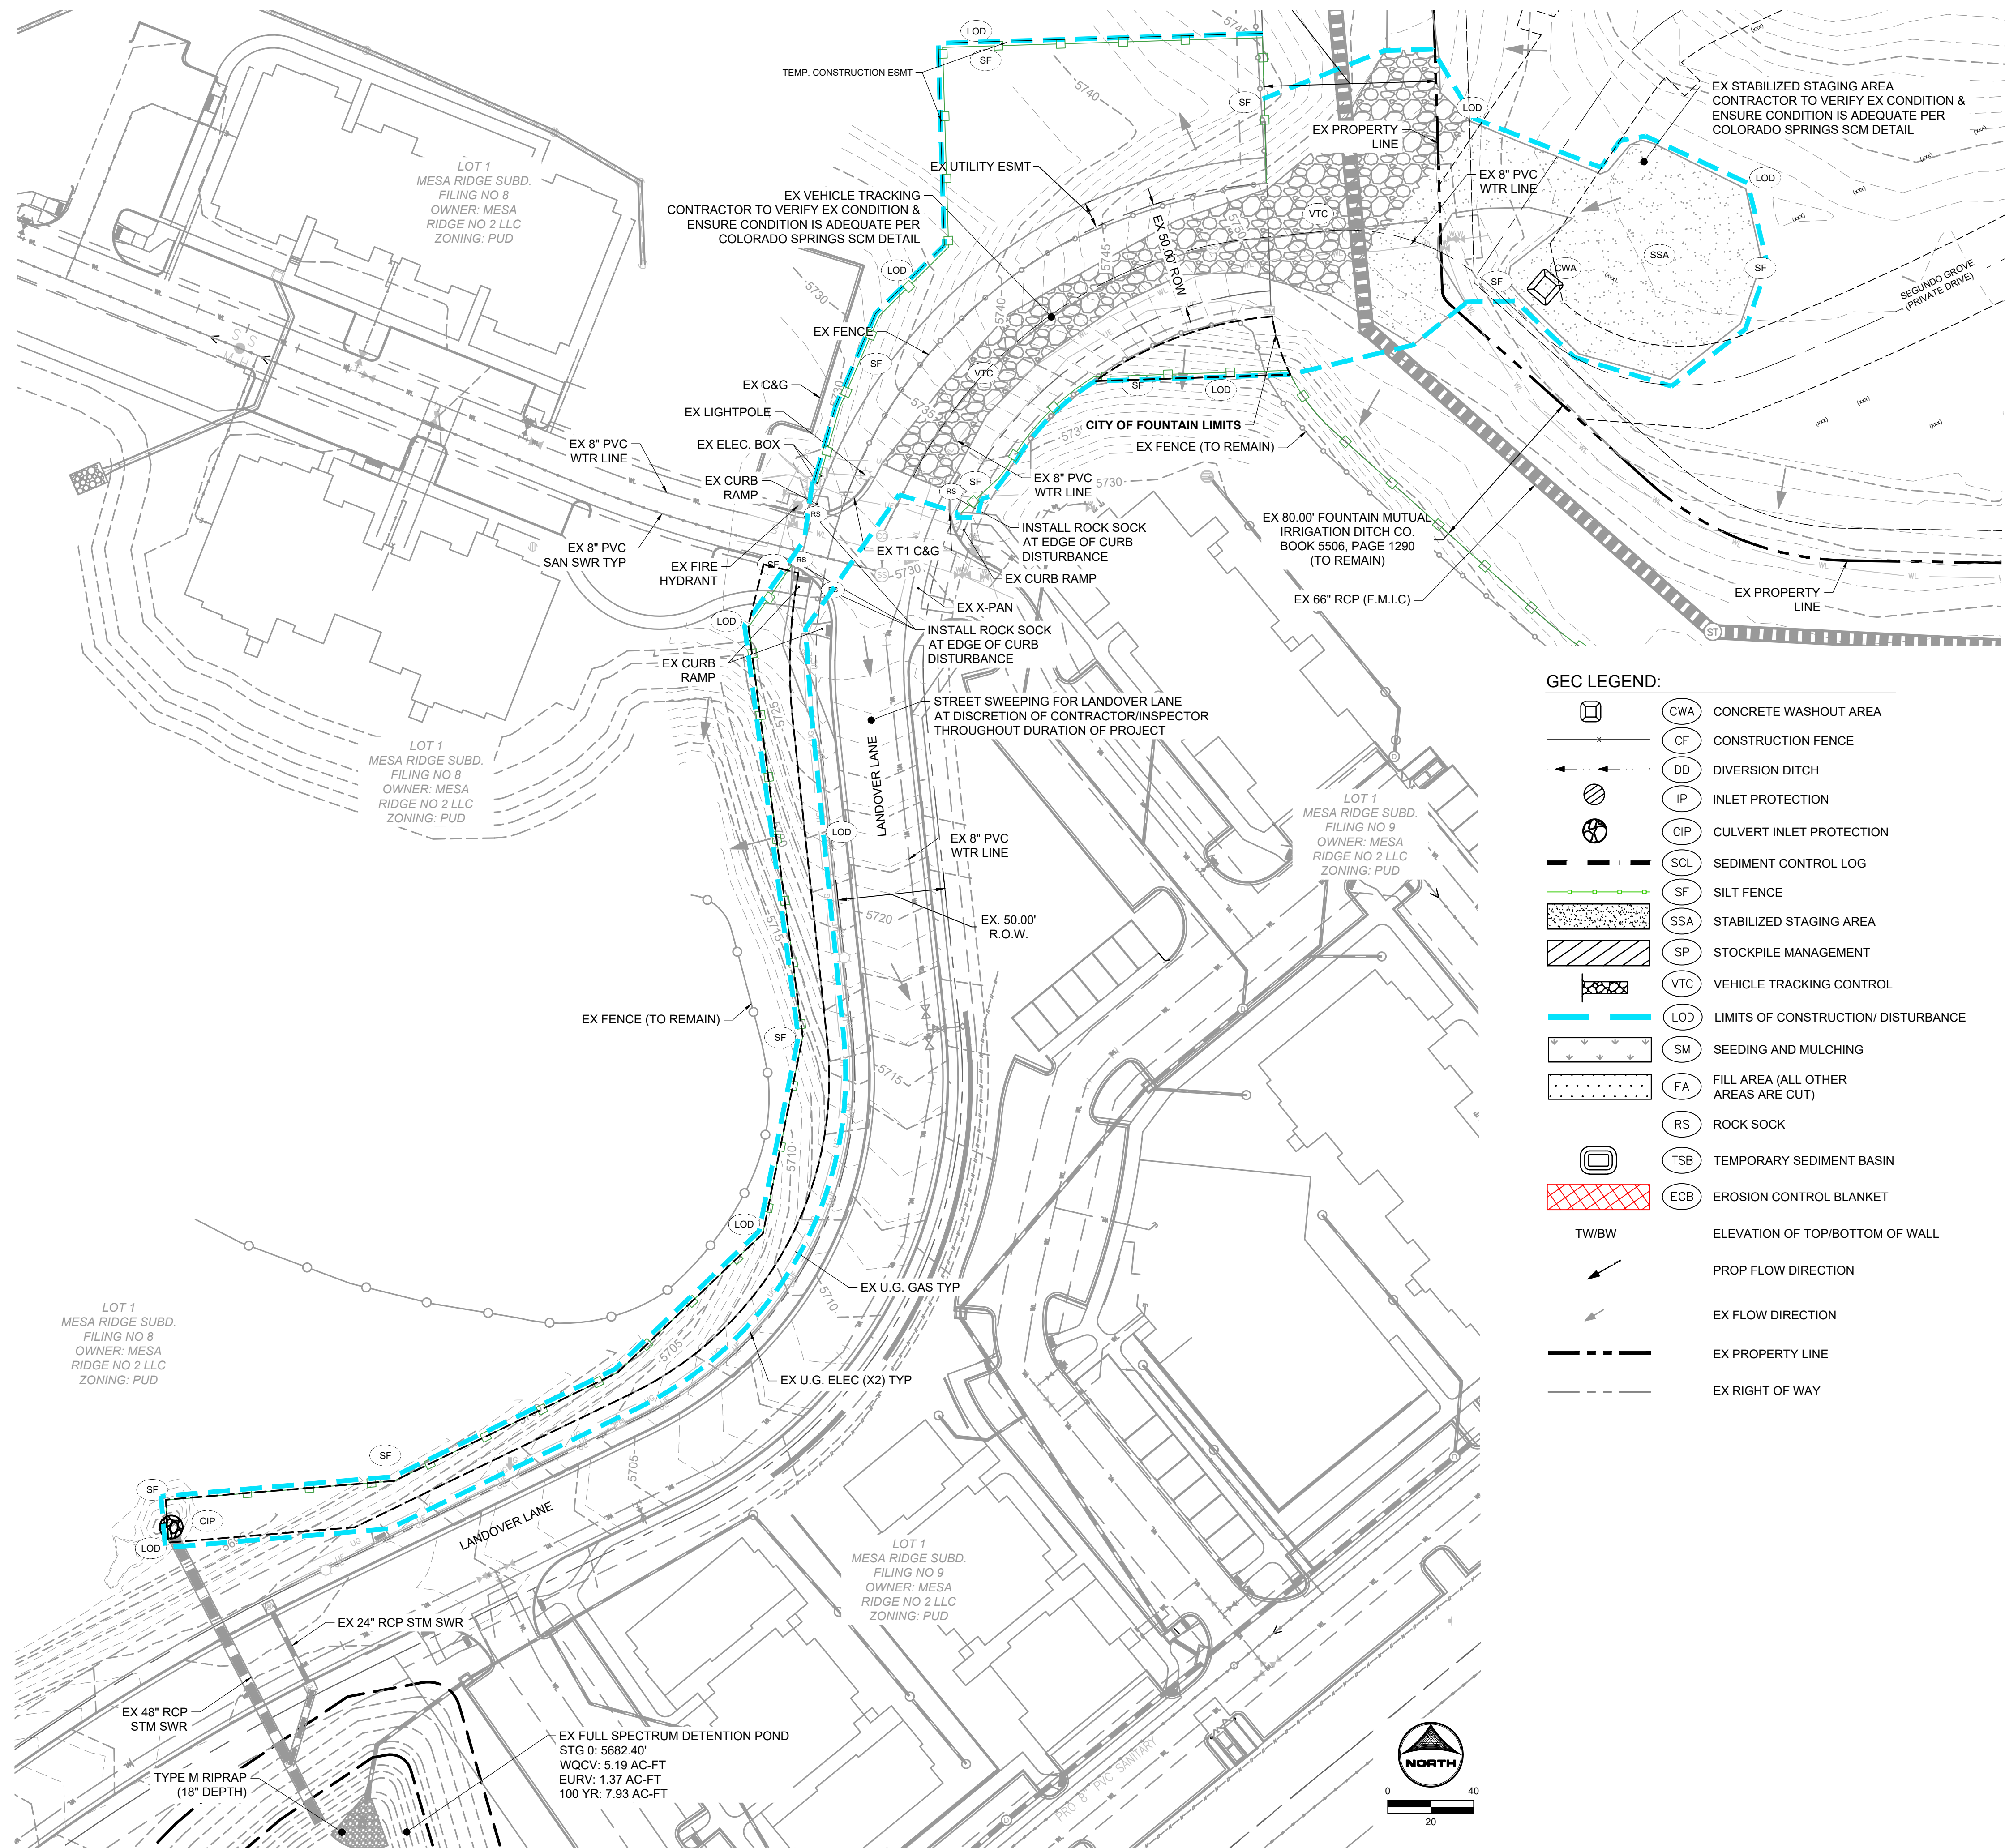

1. SEE SHEETS 11-13 FOR CITY OF COLORADO SPRINGS GRADING AND EROSION CONTROL DETAILS.
2. ALL STORMWATER MANAGEMENT MEASURES SHOWN ON THIS PLAN MUST BE INSTALLED AND MAINTAINED PER THE COLORADO SPRINGS STORMWATER CONSTRUCTION MANUAL; LATEST REVISIONS.
3. ALL AREAS WITHIN LIMITS OF DISTURBANCE TO BE CLEARED, GRUBBED AND STOCKPILED PRIOR TO IMPORT OF ANY FILL.
4. ALL 3:1 SLOPES MUST BE RECEIVE SLOPE TRACKING TREATMENT AND EROSION CONTROL BLANKET.
5. STOCKPILES REQUIRED DURING ONSITE CONSTRUCTION ACTIVITIES WILL BE PLACED AT THE DISCRETION OF THE CONTRACTOR. STOCKPILING OF MATERIAL MUST NOT OCCUR OUTSIDE THE LIMITS OF DISTURBANCE SHOWN ON THIS PLAN.
6. NON-STRUCTURAL CONTROLS (I.E. STREET SWEEPING) WILL BE AT THE DISCRETION OF THE PROJECT'S CERTIFIED GEC ADMINISTRATOR THROUGHOUT THE DURATION OF LAND DISTURBING ACTIVITIES.
7. THERE ARE NO ANTICIPATED ASPHALT AND/OR CONCRETE BATCH PLANTS, OR MASONRY MIX STATIONS ASSOCIATED WITH THIS PROJECT. IF THE CONTRACTOR REQUIRES A ASPHALT/CONCRETE BATCH PLANTS OR MASONRY MIX STATIONS, THESE PLANS WILL BE REVISED.
8. THERE ARE NO EXISTING PRESERVATION EASEMENTS LOCATED ON SITE.
9. ONITE EXISTING VEGETATION IS NATIVE GRASSES AND WEEDS. THERE IS NO NOTABLE VEGETATION OTHERWISE.

TOTAL DISTURBANCE AREA = 1.31 AC  
RECEIVING WATERS: JIMMY CAMP CREEK  
ANTICIPATED START OF CONSTRUCTION: SPRING 2023  
ANTICIPATED END OF LAND DISTURBANCE: FALL 2023  
ANTICIPATED FINAL STABILIZATION: WINTER 2023

THIS GRADING AND EROSION CONTROL PLAN WAS PREPARED UNDER MY DIRECT SUPERVISION AND IS CORRECT TO THE BEST OF MY KNOWLEDGE AND BELIEF. IF SUCH WORK IS PERFORMED IN ACCORDANCE WITH THE GRADING AND EROSION CONTROL PLAN, THE WORK WILL NOT BECOME A HAZARD TO LIFE AND LIMB, ENDANGER PROPERTY, OR ADVERSELY AFFECT THE SAFETY, USE OR STABILITY OF A PUBLIC WAY, DRAINAGE CHANNEL, OR OTHER PROPERTY.

SIGNATURE (AFFIX SEAL) \_\_\_\_\_ DATE \_\_\_\_\_

THE OWNER WILL COMPLY WITH THE REQUIREMENTS OF THE GRADING AND EROSION CONTROL PLAN INCLUDING TEMPORARY CONTROL MEASURE INSPECTION REQUIREMENTS AND FINAL STABILIZATION REQUIREMENTS, ACCORDING TO THE CITY OF COLORADO SPRINGS STORMWATER CONSTRUCTION MANUAL. I ACKNOWLEDGE THE RESPONSIBILITY TO DETERMINE WHETHER THE CONSTRUCTION ACTIVITIES ON THESE PLANS REQUIRE COLORADO DISCHARGE PERMIT SYSTEM (CDPS) PERMITTING FOR STORMWATER DISCHARGES ASSOCIATED WITH CONSTRUCTION ACTIVITY.

DEVELOPER/OWNER SIGNATURE: \_\_\_\_\_ DATE: \_\_\_\_\_

NAME OF DEVELOPER/OWNER:

DBA: \_\_\_\_\_ PHONE: \_\_\_\_\_

TITLE: \_\_\_\_\_ EMAIL: \_\_\_\_\_

ADDRESS: \_\_\_\_\_

FAX: \_\_\_\_\_

THIS GRADING PLAN AND EROSION CONTROL PLAN IS FILED IN ACCORDANCE WITH SECTION 12.04.160 OF THE CODE OF THE CITY OF FOUNTAIN. THIS PLAN IS REVIEWED WITH THE DRAINAGE CRITERIA MANUAL, VOL. I (JANUARY 2021) AND VOL. II (DECEMBER 2020): STORMWATER CONSTRUCTION MANUAL: LATEST REVISIONS.

BRANDY R WILLIAMS, P.E., CITY ENGINEER DATE

NOTES:

DRAWN BY: NQJ JOB DATE: 8/22/2022 BAR IS ONE INCH ON  
APPROVED: KMH JOB NUMBER: 200541 OFFICIAL DRAWINGS.  
0 XXXXXXXXXX 1"  
CAD DATE: 8/22/2022 IF NOT ONE INCH.  
CAD FILE: J:\2020\200541\CAD\DWG\SC\CD\O.C.F\GEC\_Initial ADJUST SCALE ACCORDINGLY

NO.	DATE	BY	REVISION DESCRIPTION



HR GREEN - COLORADO SPRINGS  
7222 COMMERCE CENTER DR SUITE 220  
COLORADO SPRINGS CO 80919  
PHONE: 719.300.4140 TOLL FREE: 800.728.7805  
FAX: 844.273.1057 | [HRGreen.com](http://HRGreen.com)

THE COTTAGES AT MESA RIDGE  
GOODWIN KNIGHT  
FOUNTAIN, COLORADO



CITY OF FOUNTAIN CONSTRUCTION DOCUMENTS

GEC - INITIAL PLAN

SHEET  
GEC

5

NOT FOR CONSTRUCTION





1. SEE SHEETS 11-13 FOR CITY OF COLORADO SPRINGS GRADING AND EROSION CONTROL DETAILS.
2. ALL STORMWATER MANAGEMENT MEASURES SHOWN ON THIS PLAN MUST BE INSTALLED AND MAINTAINED PER THE COLORADO SPRINGS STORMWATER CONSTRUCTION MANUAL; LATEST REVISIONS.
3. AREA WITHIN LIMITS OF DISTURBANCE TO BE CLEARED, GRUBBED AND STOCKPILED PRIOR TO IMPACT OF ANY FILL.
4. ALL 3:1 SLOPES MUST BE RECEIVE SLOPE TRACKING TREATMENT AND EROSION CONTROL BLANKET.
5. STOCKPILES REQUIRED DURING ONSITE CONSTRUCTION ACTIVITIES MUST BE PLACED AT THE DISCRETION OF THE CONTRACTOR. STOCKPILING OF MATERIAL MUST NOT OCCUR OUTSIDE THE LIMITS OF DISTURBANCE SHOWN ON THIS PLAN.
6. NON-STRUCTURAL CONTROLS (I.E. STREET SWEEPING) WILL BE AT THE DISCRETION OF THE PROJECT'S CERTIFIED GEC ADMINISTRATOR THROUGHOUT THE DURATION OF LAND DISTURBING ACTIVITIES.
7. THERE ARE NO ANTICIPATED ASPHALT AND/OR CONCRETE BATCH PLANTS, OR MASONRY MIX STATIONS ASSOCIATED WITH THIS PROJECT. IF THE CONTRACTOR REQUIRES A ASPHALT/CONCRETE BATCH PLANTS OR MASONRY MIX STATIONS, THESE PLANS WILL BE REVIEWED AS PERMITTED.
8. THERE ARE NO EXISTING PRESERVATION EASEMENTS LOCATED ON SITE.
9. ONSITE EXISTING VEGETATION IS NATIVE GRASSES AND WEEDS. THERE IS NO NOTABLE VEGETATION OTHERWISE.

TOTAL DISTURBANCE AREA = 1.31 AC  
RECEIVING WATERS: JIMMY CAMP CREEK  
ANTICIPATED START OF CONSTRUCTION: SPRING 2023  
ANTICIPATED END OF LAND DISTURBANCE: FALL 2023  
ANTICIPATED FINAL STABILIZATION: WINTER 2023

THIS GRADING AND EROSION CONTROL PLAN WAS PREPARED UNDER MY DIRECT SUPERVISION AND IS CORRECT TO THE BEST OF MY KNOWLEDGE AND BELIEF. IF SUCH WORK IS PERFORMED IN ACCORDANCE WITH THE GRADING AND EROSION CONTROL PLAN, THE WORK WILL NOT BECOME A HAZARD TO LIFE AND LIMB, ENDANGER PROPERTY, OR ADVERSELY AFFECT THE SAFETY, USE OR STABILITY OF A PUBLIC WAY, DRAINAGE CHANNEL, OR OTHER PROPERTY.

### OWNER'S STATEMENT

THE OWNER WILL COMPLY WITH THE REQUIREMENTS OF THE GRADING AND EROSION CONTROL PLAN INCLUDING TEMPORARY CONTROL MEASURE INSPECTION REQUIREMENTS AND FINAL STABILIZATION REQUIREMENTS. ACCORDING TO THE CITY OF COLORADO SPRINGS STORMWATER CONSTRUCTION MANUAL, I ACKNOWLEDGE THE RESPONSIBILITY TO DETERMINE WHETHER THE CONSTRUCTION ACTIVITIES ON THESE PLANS REQUIRE COLORADO DISCHARGE PERMIT SYSTEM (CDPS) PERMITTING FOR STORMWATER DISCHARGES ASSOCIATED WITH CONSTRUCTION ACTIVITY.

DEVELOPER/OWNER SIGNATURE: \_\_\_\_\_ DATE: \_\_\_\_\_

NAME OF DEVELOPER/OWNER: \_\_\_\_\_

DBA: \_\_\_\_\_ PHONE: \_\_\_\_\_

TITLE: \_\_\_\_\_ EMAIL: \_\_\_\_\_

ADDRESS: \_\_\_\_\_

FAX: \_\_\_\_\_

## CITY OF FOUNTAIN GRADING AND EROSION CONTROL REVIEW:


THIS GRADING PLAN AND EROSION CONTROL PLAN IS FILED IN ACCORDANCE WITH SECTION 12.04.160 OF THE CODE OF THE CITY OF FOUNTAIN. THIS PLAN IS REVIEWED WITH THE DRAINAGE CRITERIA MANUAL, VOL. I (JANUARY 2021) AND VOL. II (DECEMBER 2020): STORMWATER CONSTRUCTION MANUAL: LATEST REVISIONS.

BRANDY R WILLIAMS, P.E., CITY ENGINEER	DATE
--	------

NOTES:

BAR IS ONE INCH ON  
OFFICIAL DRAWINGS.  
0  1"  
IF NOT ONE INCH,  
JUST SCALE ACCORDINGLY

NO.	DATE	BY	REVISION DESCRIPTION

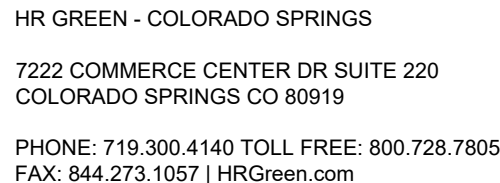

THE COTTAGES AT MESA RIDGE  
GOODWIN KNIGHT  
FOUNTAIN, COLORADO



SHEET  
GEC

NOT FOR CONSTRUCTION





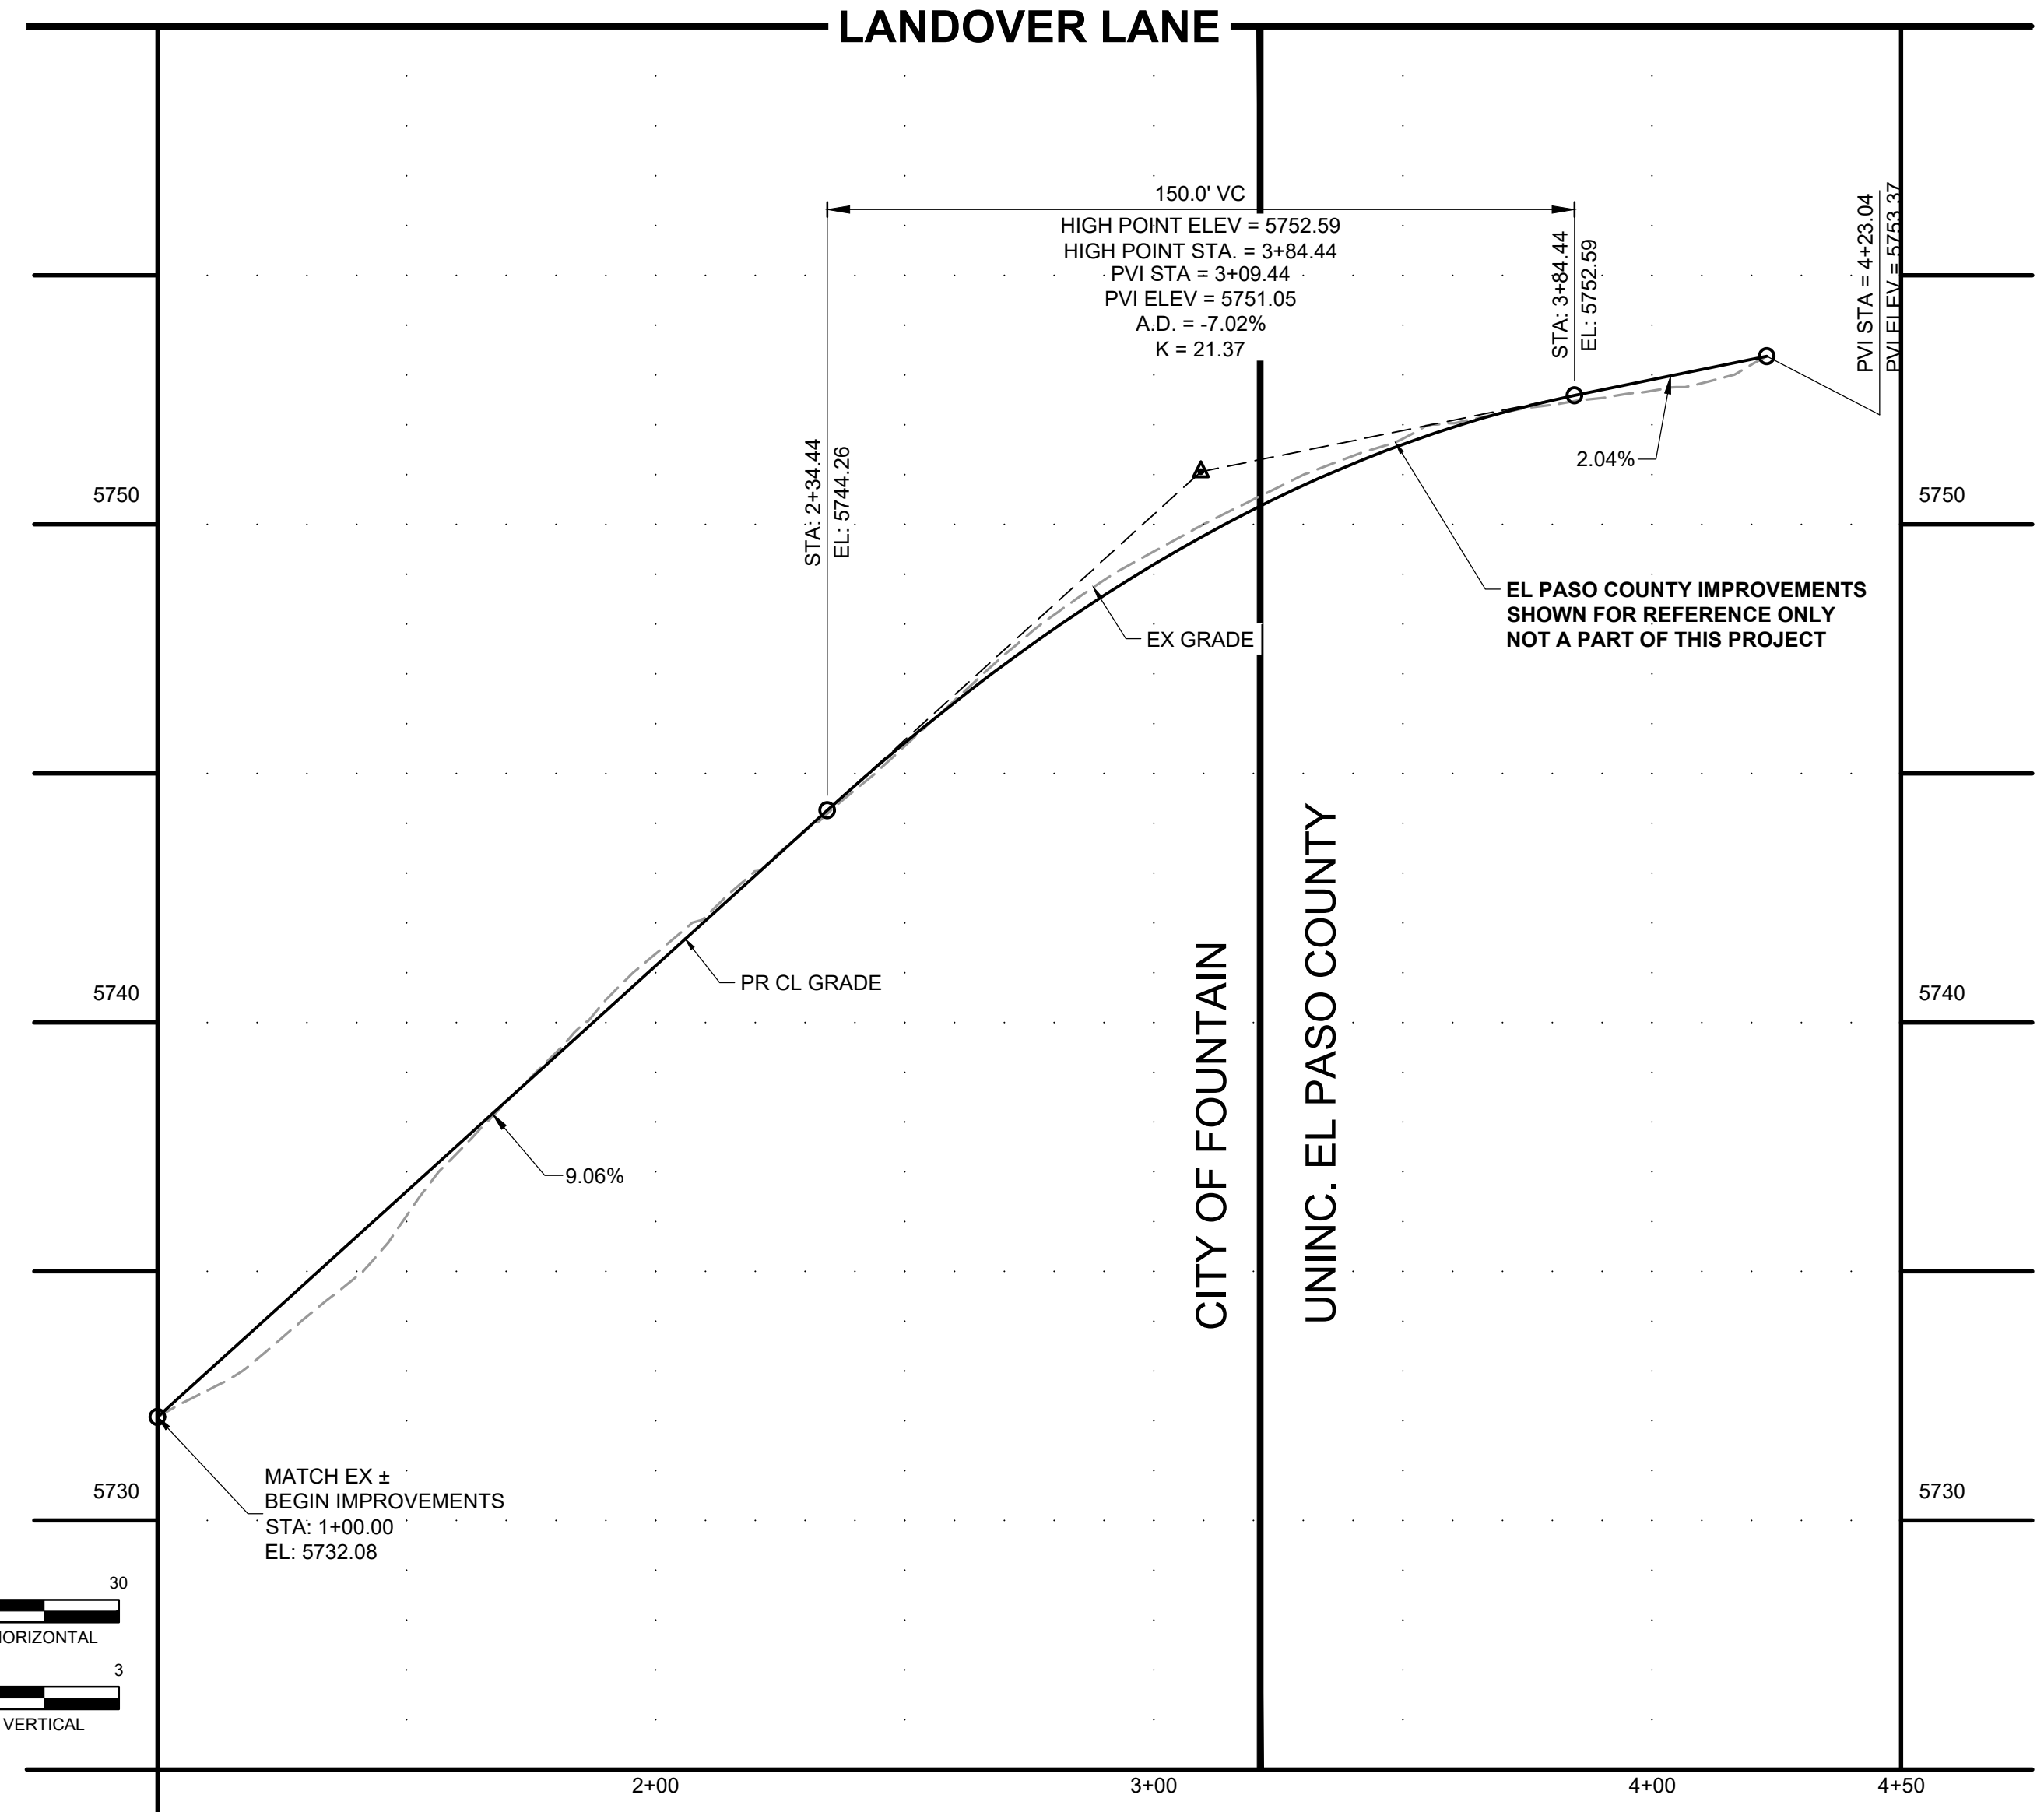


Diagram illustrating the dimensions and components of a Type 2 6 inch Vertical spill containment berm. The diagram shows a cross-section of the berm with a total width of 24 inches and a total height of 6 inches. The berm is divided into two sections: a 12-inch wide section on the left and a 12-inch wide section on the right. The left section has a 6-inch high wall and a 6-inch deep base. The right section has a 6-inch high wall and a 6-inch deep base. The top surface of the berm is 24 inches wide. The bottom surface is 30 inches wide. The diagram is labeled "TYPE 2 6 inch VERTICAL" and "SPILL CONDITION".



<b>ENGINEER'S STATEMENT:</b>	
SIGNATURE (AFFIX SEAL): _____	DATE: _____
COLORADO PROFESSIONAL ENGINEER NO: _____	
<b>ACCEPTANCE:</b>	
<p>THESE PLANS SUBMITTED APPEAR TO BE IN CONFORMANCE WITH THE CITY OF FOUNTAIN SUBMITTAL REQUIREMENTS AND STANDARD ENGINEERING PRINCIPLES AND PRACTICES APPEAR TO HAVE BEEN FOLLOWED. THE PROFESSIONAL ENGINEER SUBMITTED AND SEALING THE PLANS IS SOLELY RESPONSIBLE FOR THEIR ACCURACY AND VALIDITY. THE REVIEW IS ONLY VALID FOR ONE (1) YEAR FROM THE DATE BELOW.</p>	
BRANDY R WILLIAMS, P.E., CITY ENGINEER	DATE: _____

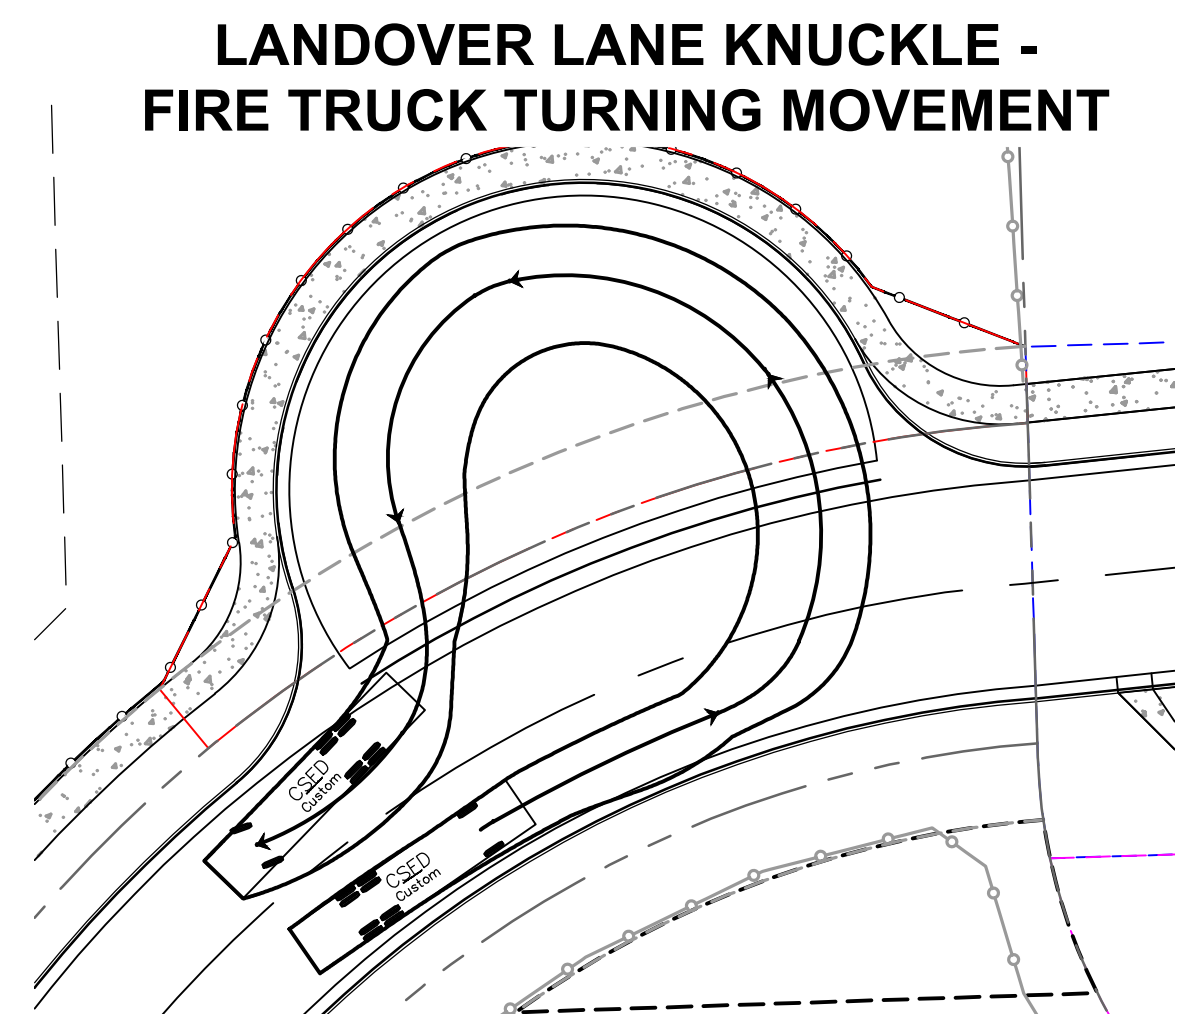

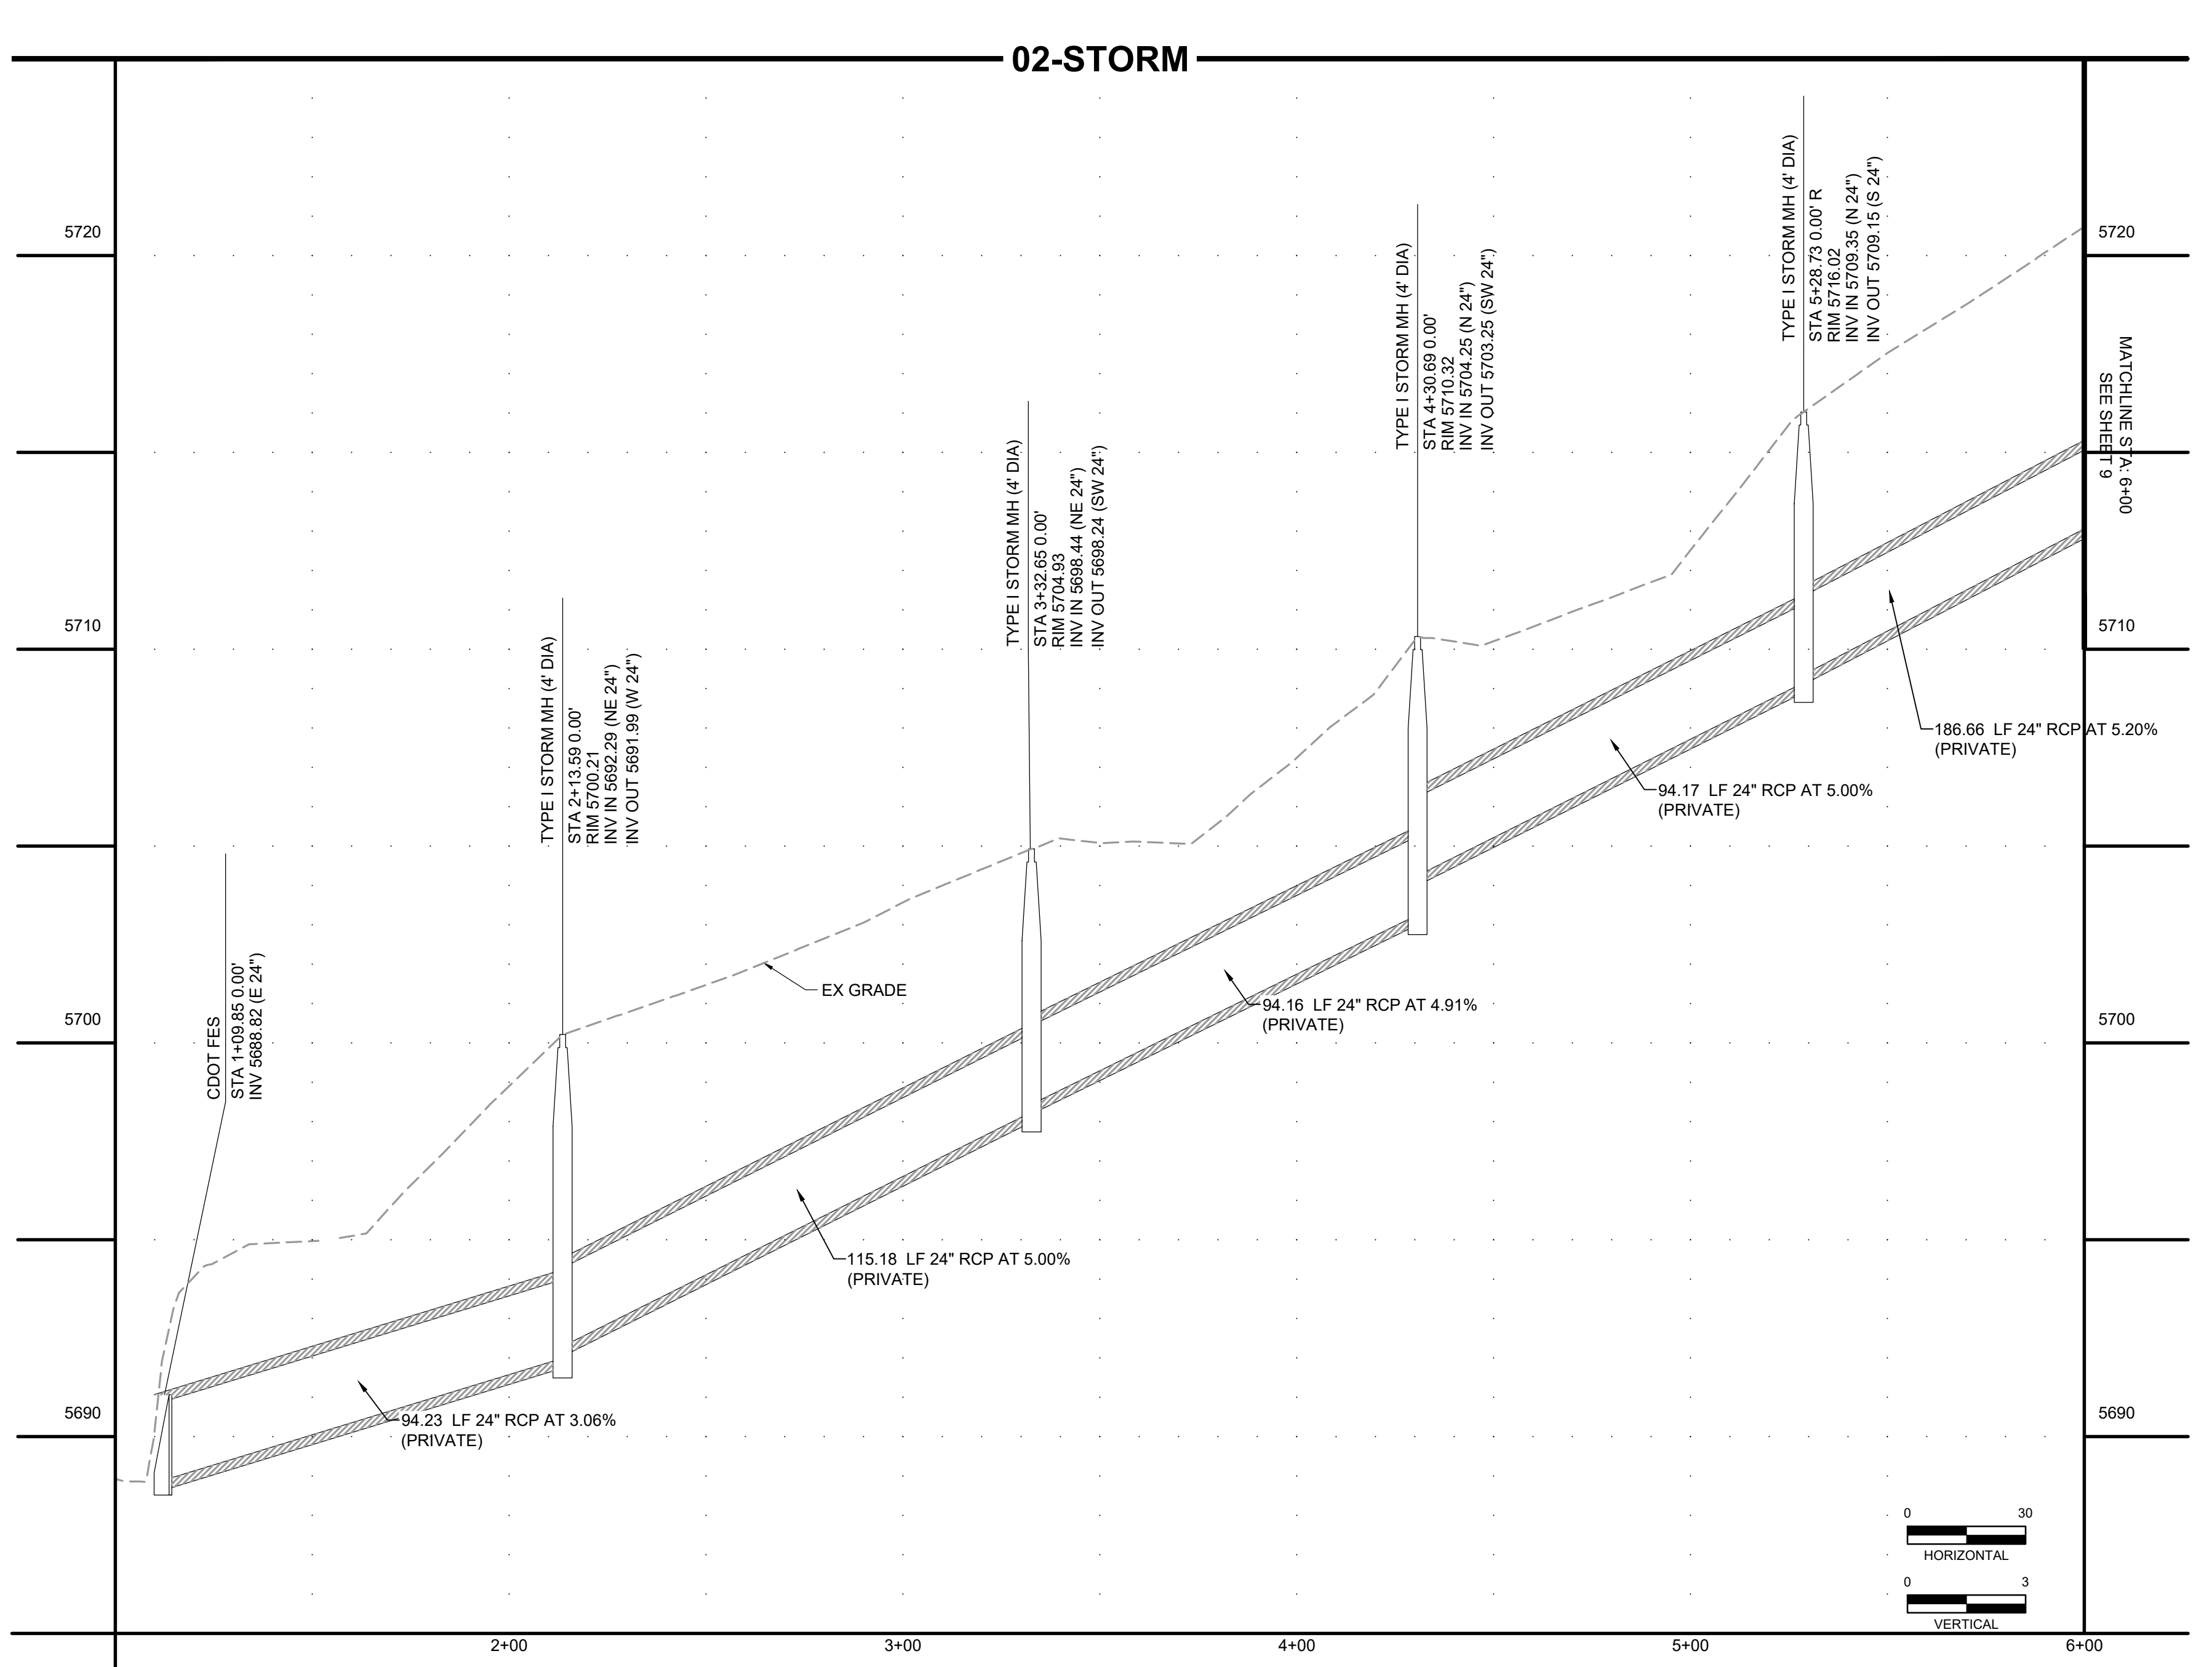

1. ALL RCP STORM SEWER TO BE CLASS III UNLESS OTHERWISE NOTED.
2. CONTRACTOR SHALL POTHOLE AND VERIFY DEPTH OF EXISTING UTILITY PRIOR TO THE START OF CONSTRUCTION. IF CONFLICTS ARE IDENTIFIED THE CONTRACTOR SHALL CONTACT THE ENGINEER IMMEDIATELY.

THESE DETAILED PLANS AND SPECIFICATIONS WERE PREPARED UNDER MY DIRECT SUPERVISION. SAID DETAILED PLANS AND SPECIFICATIONS HAVE BEEN PREPARED ACCORDING TO THE ESTABLISHED CRITERIA FOR DETAILED DRAINAGE PLANS AND SPECIFICATIONS, AND SAID DETAILED PLANS AND SPECIFICATIONS ARE IN CONFORMITY WITH THE MASTER PLAN OF THE DRAINAGE BASIN. SAID DRAINAGE PLANS AND SPECIFICATIONS MEET THE PLUS MINUS 10% REQUIREMENT FOR PARTICULAR DRAINAGE FACILITY(S) IS DESIGNED. I ACCEPT RESPONSIBILITY FOR ANY LIABILITY CAUSED BY ANY NEGLIGENT ACTS, ERRORS OR OMISSIONS ON MY PART IN PREPARATION OF THE DETAILED PLANS AND SPECIFICATIONS.


COLORADO PROFESSIONAL ENGINEER NO: \_\_\_\_\_

PLAN REVIEW BY THE CITY OF FOUNTAIN IS PROVIDED ONLY FOR GENERAL CONFORMANCE WITH THE DESIGN CRITERIA. THE CITY OF FOUNTAIN IS NOT RESPONSIBLE FOR THE ACCURACY AND ADEQUACY OF THE DESIGN, DIMENSIONS, AND/OR ELEVATIONS WHICH SHALL BE CONFIRMED AT THE JOB SITE. THE CITY OF FOUNTAIN, THROUGH THE APPROVAL OF THIS DOCUMENT, ASSUMED NO RESPONSIBILITY FOR COMPLETENESS AND/OR ACCURACY OF THIS DOCUMENT.

DATE: \_\_\_\_\_

BAR IS ONE INCH ON  
OFFICIAL DRAWINGS.  
0  1"  
IF NOT ONE INCH,  
JUST SCALE ACCORDINGLY.

NO.	DATE	BY	REVISION DESCRIPTION

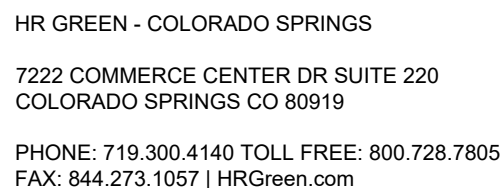


SHEET  
STM

8

NOT FOR CONSTRUCTION




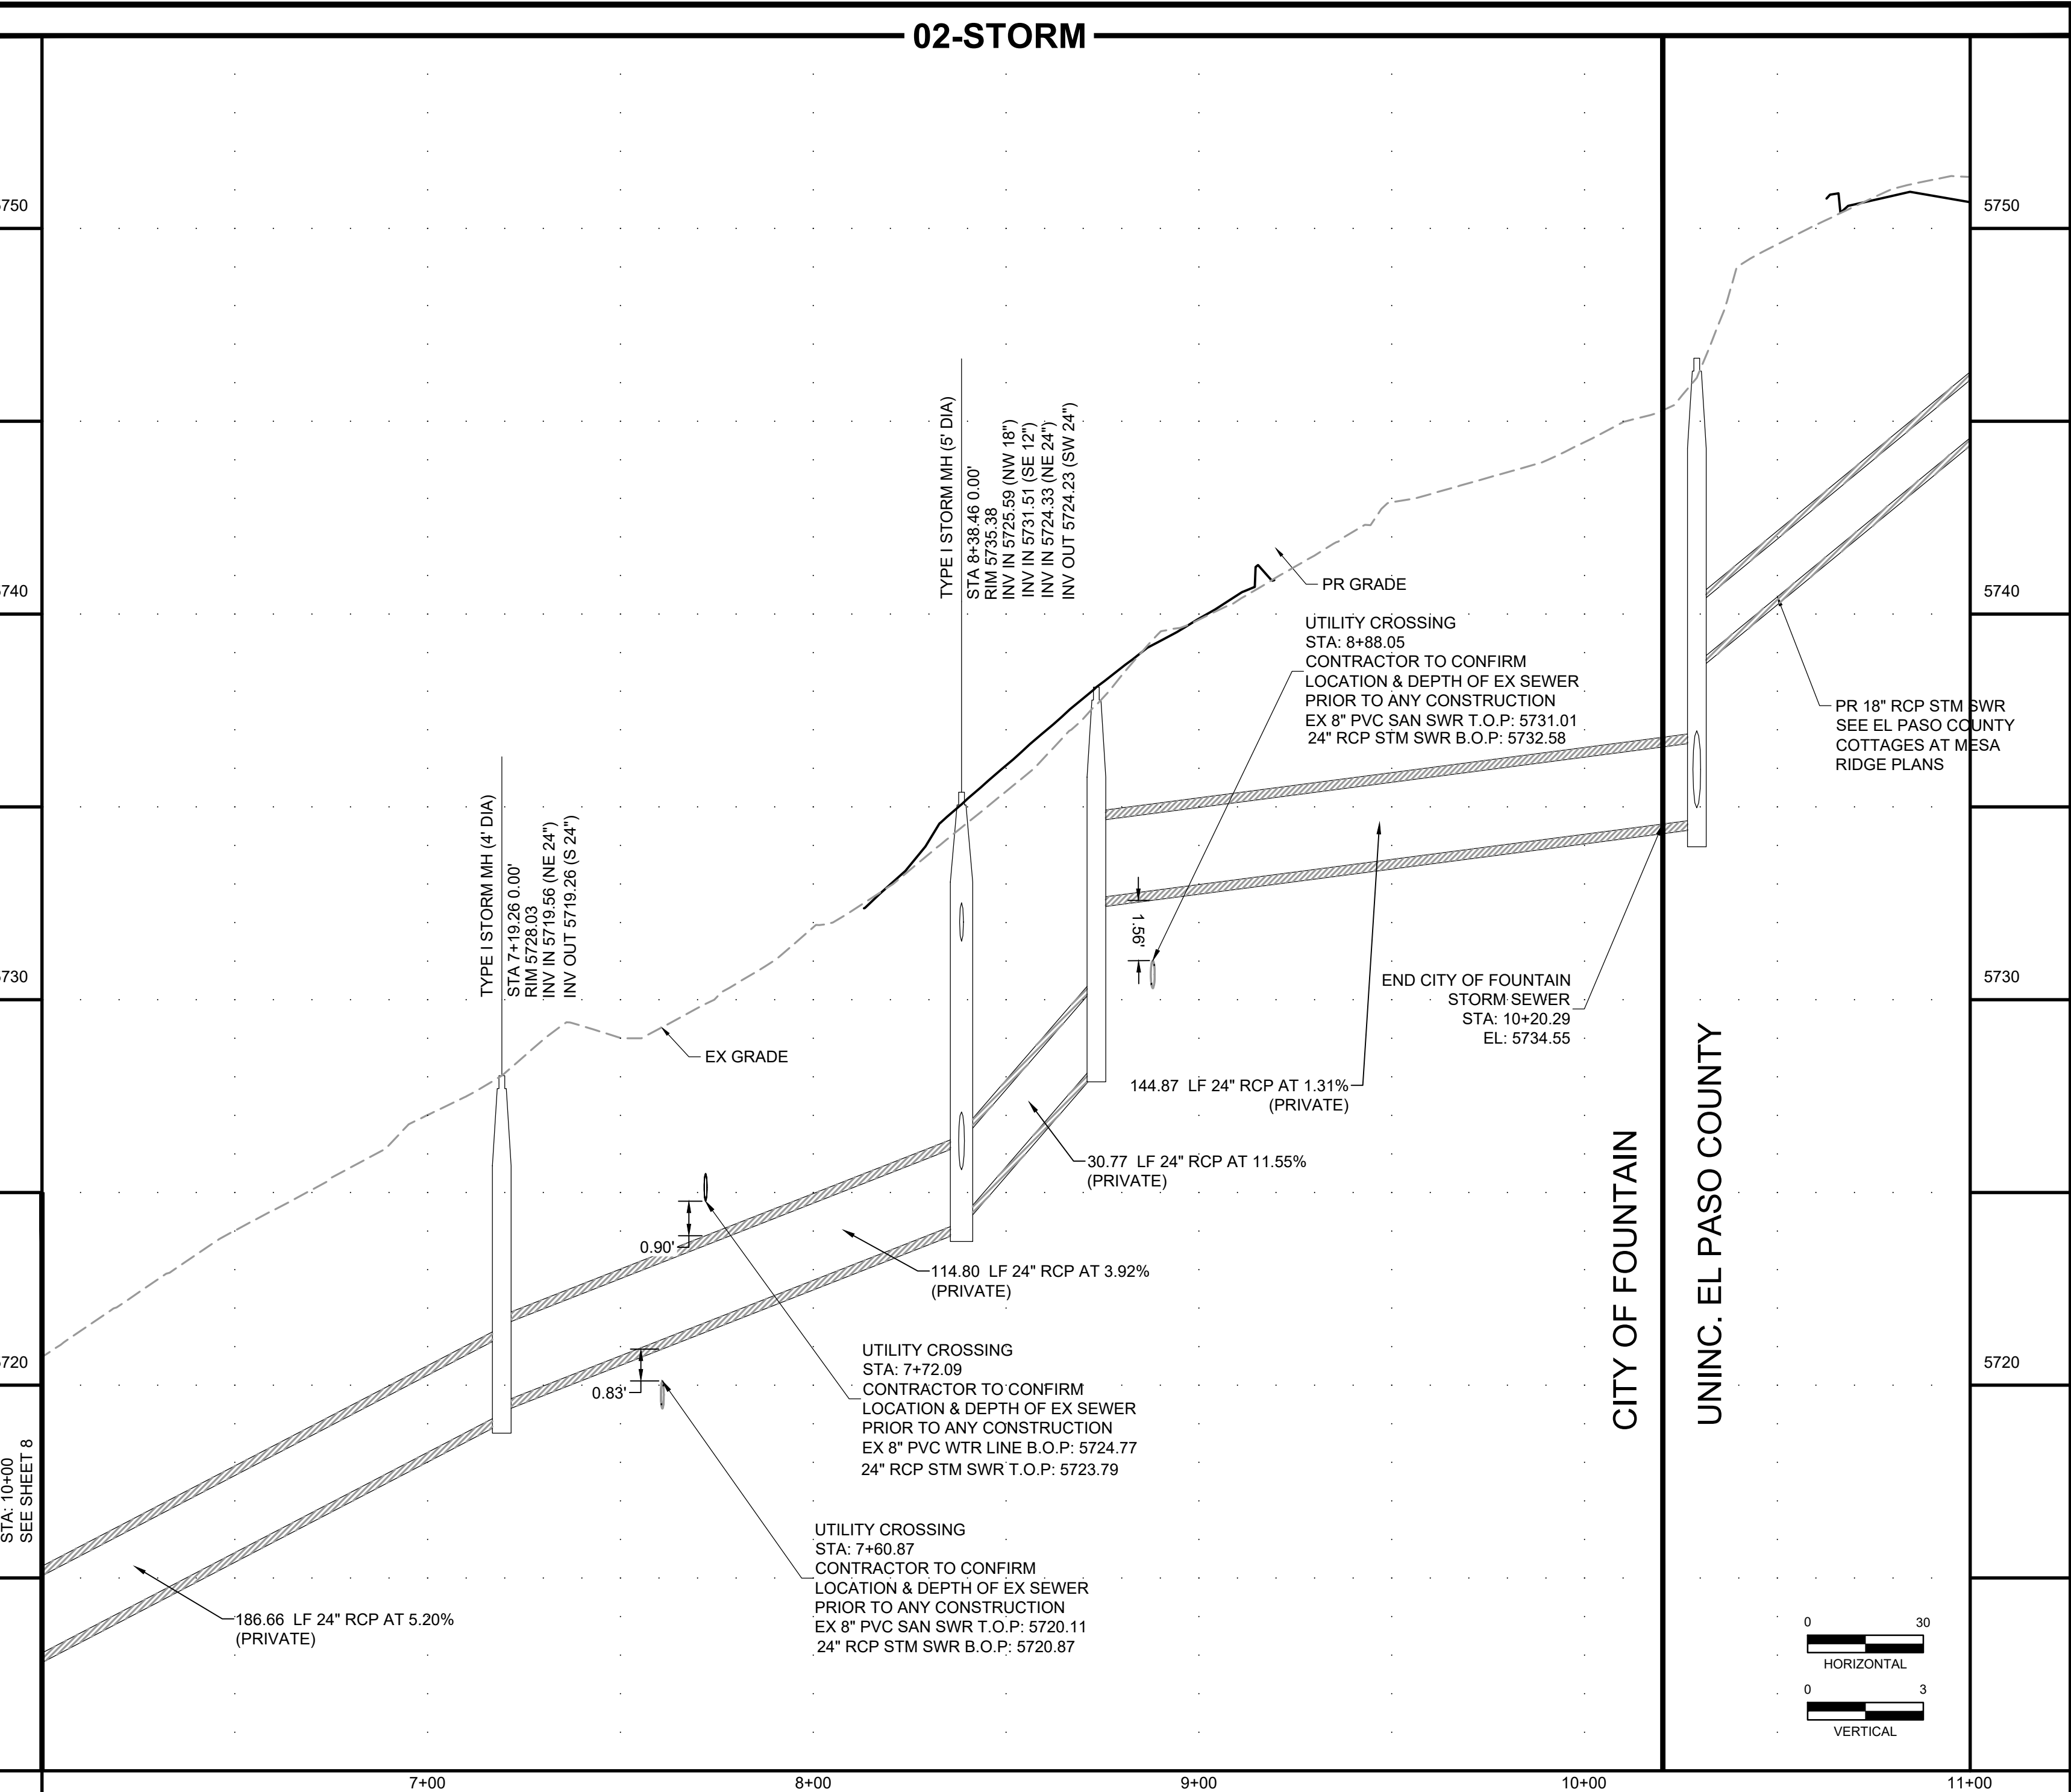


<b>ENGINEER'S STATEMENT:</b>	
SIGNATURE (AFFIX SEAL): _____	DATE: _____
COLORADO PROFESSIONAL ENGINEER NO: _____	
<b>ACCEPTANCE:</b>	
THESE PLAN SUBMITTED APPEAR TO BE IN CONFORMANCE WITH THE CITY OF FOUNTAIN SUBMITTAL REQUIREMENTS AND STANDARD ENGINEERING PRINCIPLES AND PRACTICES APPEAR TO HAVE BEEN FOLLOWED. THE PROFESSIONAL ENGINEER SUBMITTED AND SEALING THE PLANS IS SOLELY RESPONSIBLY FOR THEIR ACCURACY AND VALIDITY. THE REVIEW IS ONLY VALID FOR ONE (1) YEAR FROM THE DATE BELOW.	
BRANDY R WILLIAMS, P.E., CITY ENGINEER	DATE: _____

NOT FOR CONSTRUCTION



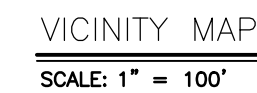

NO.	DATE	BY	REVISION DESCRIPTION

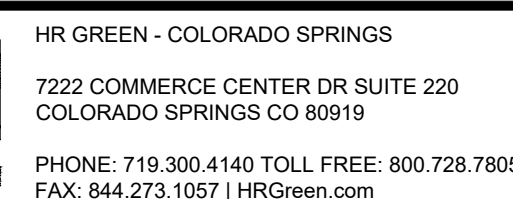

10

**SCALE:**  
 $\frac{3}{4}'' = 1'$

NOT FOR CONSTRUCTION







<b>SCOPE</b>	
THE NOTES ON THIS SHEET AND DETAILS ON THIS SHEET ARE TYPICAL AND APPLY TO ALL CONCRETE POND STRUCTURES WHETHER SPECIFICALLY CALLED OUT OR NOT, EXCEPT WHERE THERE ARE SPECIFIC INDICATIONS TO THE CONTRARY ON STRUCTURAL SHEETS. IF THERE ARE QUESTIONS, THEY SHALL BE SUBMITTED TO THE STRUCTURAL ENGINEER AND ANSWERED IN WRITING PRIOR TO CONSTRUCTION.	
<b>G2. APPLICABLE SPECIFICATIONS AND CODE</b>	
A. COLORADO BUILDING CODE 2021: 2021 INTERNATIONAL BUILDING CODE WITH AMENDMENTS.	
B. ACI 350-20	
C. ACI 318-19	
D. AISC STEEL MANUAL 15TH EDITION	
E. AWS D1.1 - STRUCTURAL WELDING CODE - STEEL	
F. ASCE - 7-16 MINIMUM DESIGN LOADS FOR BUILDINGS AND OTHER STRUCTURES	
<b>G3. DESIGN CRITERIA</b>	
APPLIES TO ALL STRUCTURES (UNO)	
1. DEAD LOAD:	
1.1.1. ACTUAL TRIBUTARY STRUCTURE WEIGHT	
2.1.1. WALKWAYS, STAIRS, GRATING	100 PSF
3. WIND:	
3.1.1. BASIC WIND SPEED (ULTIMATE):	SPECIAL REGION
3.1.2. EXPOSURE:	C
3.1.3. IMPORTANCE FACTOR, Iw:	1.0
3.1.4. RISK CATEGORY:	II
4. SEISMIC:	
4.1. ABOVE GRADE STRUCTURES AND BELOW GRADE WATER BEARING STRUCTURES:	
4.1.1. RISK CATEGORY:	1.00
4.1.2. IMPORTANCE FACTOR, Ie:	1.0
4.1.3. SPECTRAL RESPONSE ACCELERATION, Ss:	0.186
4.1.4. SPECTRAL RESPONSE ACCELERATION, S1:	0.057
4.1.4.1. SITE CLASS:	D
4.1.4.2. SEISMIC DESIGN CATEGORY:	B
4.1.4.3. SPECTRAL RESPONSE COEFFICIENT, SDS:	0.199
4.1.4.4. SPECTRAL RESPONSE COEFFICIENT, SD1:	0.09
5. SNOW LOAD:	
5.1. GROUND SNOW LOAD, Pg:	SPECIAL REGION
6. HYDROSTATIC LOAD:	63 PSF / FT
<b>G4. THE FOLLOWING GEOTECHNICAL VALUES IN SECTION G5 ARE THE BASIS OF THIS STRUCTURAL DESIGN. CONTRACTOR MUST VERIFY THE REQUIREMENTS WITH THE SOIL'S ADJACENT AND UNDERNEATH THE STRUCTURES. THIS MUST BE VALIDATED WITH A SITE GEOTECHNICAL REPORT AND/OR LOCAL GEOTECHNICAL INSPECTION FOR EACH STRUCTURE. DO NOT BEAR FOUNDATIONS ON UNSUITABLE FILL INCLUDING, BUT NOT LIMITED TO: MUD, ORGANIC SILT, ORGANIC CLAYS, PEAT, UNPREPARED FILL, OR EXPANSIVE SOILS. VALIDATE SUITABLE SUBGRADE WITH GEOTECHNICAL FIRM. OVEREXCAVATE AND REPLACE WITH SUITABLE STRUCTURAL FILL AS DIRECTED BY THE GEOTECHNICAL FIRM. ALL GEOTECHNICAL WORK MUST BE PERFORMED BY A GEOTECHNICAL ENGINEER LICENSED WITHIN THE STATE OF COLORADO.</b>	
1. REFERENCE SITE GEOTECHNICAL REPORT: ENTECH ENGINEERING, INC. JOB NO. 211100, DATED DECEMBER 22, 2021. FOLLOW ALL GEOTECHNICAL RECOMMENDATIONS. IN THE EVENT OF CONFLICT WITH DESIGN DOCUMENTS THEN FOLLOW THE MOST STRINGENT DESIGN CRITERIA AND VERIFY WITH ENGINEER IN WRITING PER NOTE G1.	
<b>G5. SOIL CHARACTERISTICS</b>	
1. NET ALLOWABLE SOIL BEARING CAPACITY:	1,500 PSF (MIN)
2. ALLOWABLE LATERAL EARTH PRESSURE (EPF):	115 PSF (MAX) / FT (SAT)
3. ALLOWABLE LATERAL HYDROSTATIC PRESSURE:	63 PSF / FT
4. SOIL UNIT WEIGHT:	120 PCF
5. ALL BACKFILL ADJACENT TO AND UNDERNEATH STRUCTURES MUST BE:	COOT CLASS 6 AGG BASE
6. ALL BACKFILL UNDERNEATH STRUCTURES MUST BE COMPACTED TO:	98% STANDARD PROCTOR
7. ALL BACKFILL ADJACENT TO STRUCTURES MUST BE COMPACTED TO:	95% STANDARD PROCTOR
8. MAXIMUM BACKFILL LIFT HEIGHT:	8"
<b>G6. SAFETY</b>	
SAFETY AND STRUCTURE STABILITY DURING CONSTRUCTION ARE THE SOLE RESPONSIBILITY OF THE CONTRACTOR. STRUCTURES HAVE BEEN DESIGNED TO RESIST THE DESIGN LIVE LOADS ONLY AS A COMPLETED STRUCTURE. CONTRACTOR MUST LOCATE ALL UNDERGROUND UTILITIES, PER OSHA REQUIREMENTS, TO ENSURE ALL UTILITIES ARE NOT DAMAGED.	
<b>G7. DO NOT BACKFILL AGAINST WALLS PRIOR TO GROUND LEVEL CONCRETE FRAMING AND SLAB HAVE REACHED THEIR 28-DAY DESIGN STRENGTH.</b>	
<b>G8. OPENINGS</b>	
OPENINGS FOR PIPES, DUCTS, CONDUITS, ETC. ARE NOT ALL SHOWN ON THE STRUCTURAL DRAWINGS. COORDINATE AND PROVIDE OPENINGS AS REQUIRED TO ACCOMMODATE ALL WORK SHOWN OR SPECIFIED IN THE CONTRACT DOCUMENTS AND OTHERWISE REQUIRED FOR THE FURNISHING OF A FUNCTIONALLY COMPLETE PROJECT. REINFORCE AROUND OPENINGS PER STANDARD STRUCTURAL DETAILS.	
<b>G9. SPECIAL INSPECTIONS</b>	
THE FOLLOWING SPECIAL STRUCTURAL INSPECTIONS SHALL BE PERFORMED IN ACCORDANCE WITH CHAPTER 17 OF THE 2021 INTERNATIONAL BUILDING CODE AND THE SPECIFICATIONS. THE CONTRACTOR SHALL NOTIFY AND ACCOMMODATE THE APPLICABLE INSPECTOR DURING APPROPRIATE PHASES OF THE WORK AS REQUIRED BY EACH INSPECTION.	
STRUCTURAL FILL PLACEMENT, EXISTING SITE CONDITIONS PER IBC TABLE 1704.7.	
CONCRETE, REINFORCING STEEL AND BOLTS INSTALLED IN CONCRETE PER IBC TABLE 1704.4.	
CONTINUOUS CONCRETE PLACEMENT AND CURING PER IBC TABLE 1704.4.	
CONCRETE ROUGHEN AND KEYED CONSTRUCTION JOINTS	
EXPANSION ANCHORS AND ADHESIVE BOLT / DOWEL / ROD INSTALLATION	
<b>G10. TYPICAL DETAILS</b>	
THE TYPICAL DETAILS DEPICT TYPICAL DETAILING TO BE USED ON THIS PROJECT, IF CONDITIONS ARE NOT EXPLICITLY SHOWN ON THE DRAWINGS THEY SHALL BE MADE SIMILAR TO THE TYPICAL DETAILS. OBTAIN APPROVAL OF ENGINEER IN WRITING FOR SIMILAR CONDITIONS PRIOR TO CONSTRUCTION.	
<b>G11. THE CONTRACTOR SHALL FIELD VERIFY ALL DIMENSIONS AND ELEVATIONS OF EXISTING CONSTRUCTION AS REQUIRED TO COORDINATE NEW CONSTRUCTION. SUBMIT REQUIRED CHANGES FOR APPROVAL.</b>	
<b>CONCRETE</b>	
<b>C1. DESIGN STRENGTHS:</b>	
<b>CONCRETE</b>	
GENERAL USE STRUCTURAL CONCRETE:	$F_c = 4,500$ PSI
<b>REINFORCING</b>	
$F_y = 60,000$ PSI	
<b>C2. CONCRETE MATERIAL SCHEDULE</b>	
GENERAL USE STRUCTURAL CONCRETE:	
PORTLAND CEMENT - ASTM C150:	TYPE III
FLY ASH - ASTM C618:	15% MAX
AGGREGATE - COARSE - ASTM C33:	1" MAX
AIR ENTRAINMENT - ASTM C260:	6% $\pm$ 1%
SUPERPLASTICIZER - ASTM C494:	TYPE F
WATER TO CEMENT RATIO - MAXIMUM:	0.42
SLUMP:	2"-4"
PLACEMENT BY PUMP:	
AT PUMP:	2'-6"
AT DISCHARGE OF LINE:	1'-4"
<b>C3. CONCRETE COVER</b>	
FOR CAST-IN-PLACE CONCRETE, PROVIDE CONCRETE COVER FOR REINFORCING AS FOLLOWS, UNLESS NOTED OTHERWISE:	
CONCRETE DEPOSITED AGAINST EARTH:	3"
ALL OTHER:	2"
SEE DRAWINGS FOR EXCEPTIONS.	
<b>C4. REINFORCING PLACEMENT REQUIREMENTS TO BE WITH ACI 117 TOLERANCES.</b>	
<b>C5. REFER TO OTHER DISCIPLINE DRAWINGS PRIOR TO CONSTRUCTION FOR EMBEDDED ITEMS AND PENETRATIONS NOT SHOWN ON STRUCTURAL DRAWINGS. AS REQUIRED TO ACCOMMODATE ALL WORK SHOWN OR SPECIFIED IN THE CONTRACT DOCUMENTS AND OTHERWISE REQUIRED FOR THE FURNISHING OF A FUNCTIONALLY COMPLETE PROJECT. REINFORCE AROUND OPENINGS PER STANDARD STRUCTURAL DETAILS UNLESS OTHERWISE SHOWN.</b>	
<b>C6. PROVIDE 3/4" CHAMFERS AT ALL EXPOSED EDGES UNLESS NOTED OTHERWISE. NOT ALL CHAMFERS MAY BE SHOWN ON DRAWINGS.</b>	
<b>C7. FIELD ADJUST REINFORCING AT OPENINGS AND EMBEDDED ITEMS AS INDICATED.</b>	

- S1. ALL STEEL SHALL BE HOT DIP GALVANIZED, UNLESS NOTED OTHERWISE.
- S2. STEEL SHAPES SHALL CONFORM TO THE FOLLOWING REQUIREMENTS:
1. W-SHAPES & T-WHAPES: ASTM A992
  2. S-SHAPES, CHANNELS, ANGLES & PLATES: ASTM A36
  3. SMOOTH & THREADED RODS: ASTM A36
  4. HSS-SHAPES: ASTM A500 GR. B
  5. PIPE: ASTM A53 GR. B
  6. HIGH-STRENGTH STRUCTURAL BOLTS: ASTM A325
  7. HARDENED WASHERS: ASTM F436
  8. HEAVY HEX NUTS: ASTM F594
  9. SHEAR STUDS AND HEADED STUDS: ASTM A108 GR. 1015 T0102.
- S3. STEEL WELDS SHALL BE E70XX ELECTRODES, UNLESS NOTED OTHERWISE.
- S4. GUARDRAIL MUST BE DESIGNED AND DETAILED BY THE FABRICATOR TO MEET OSHA REQUIREMENTS.

TABLE  
TYPICAL REINFORCEMENT SPLICE AND HOOK TABLE  
SCALE: NOT TO SCALE






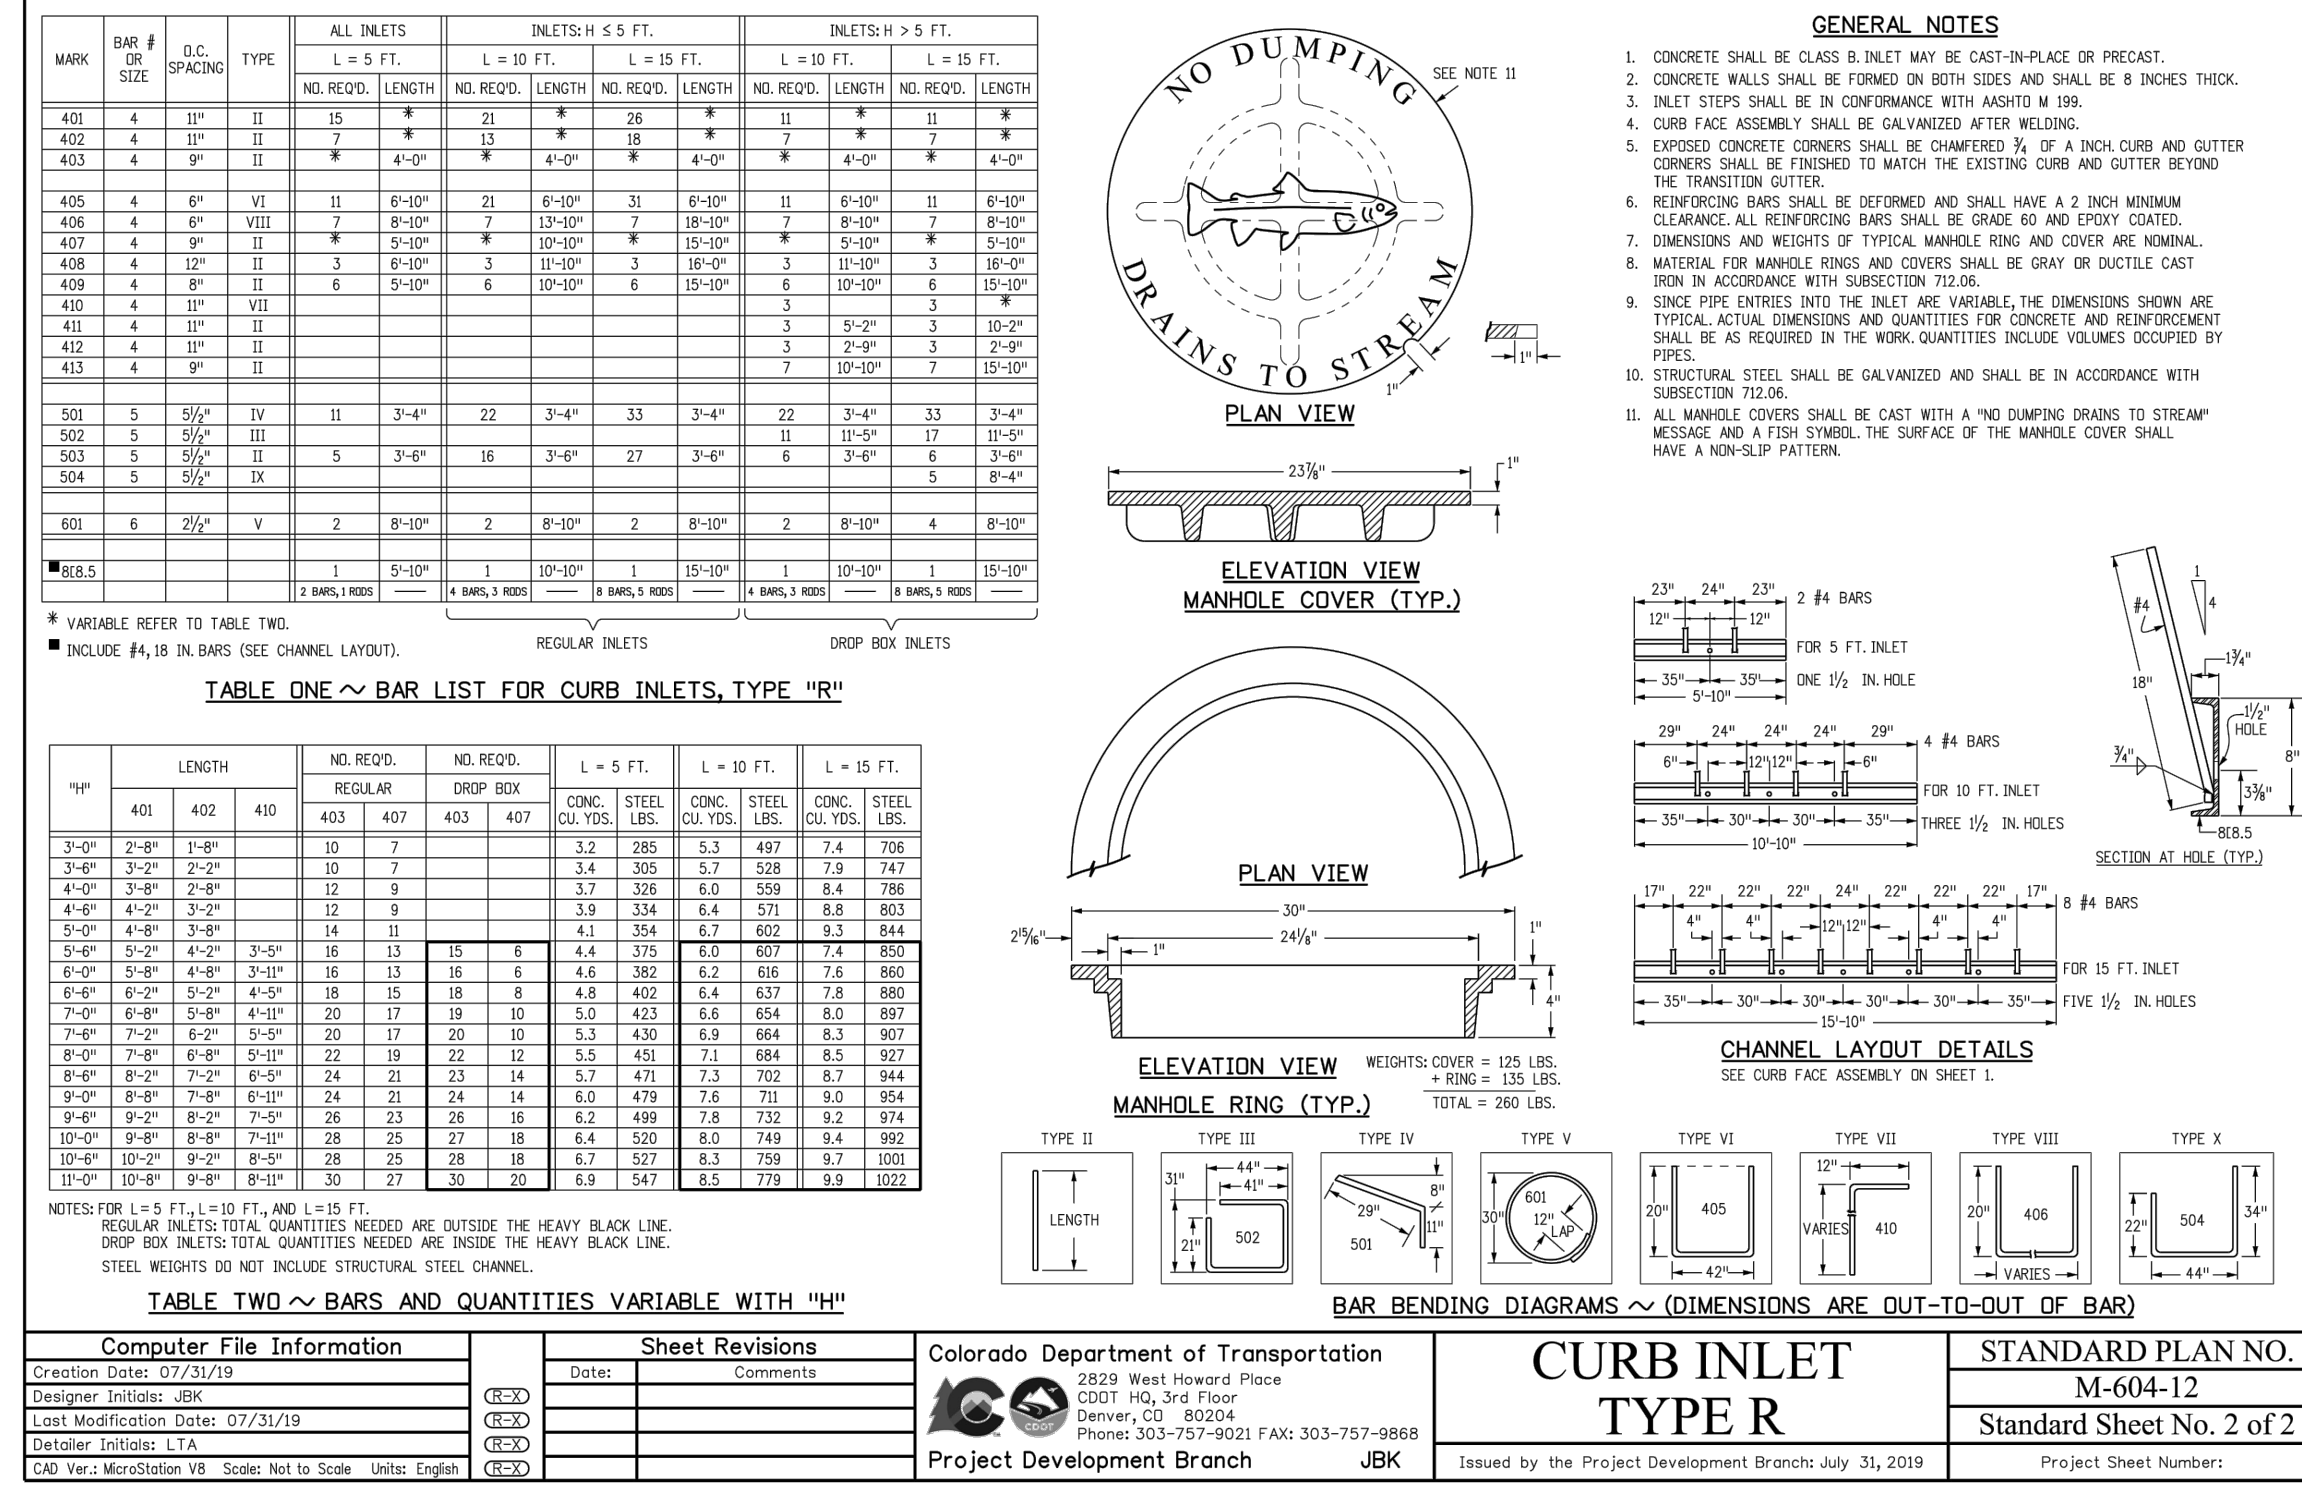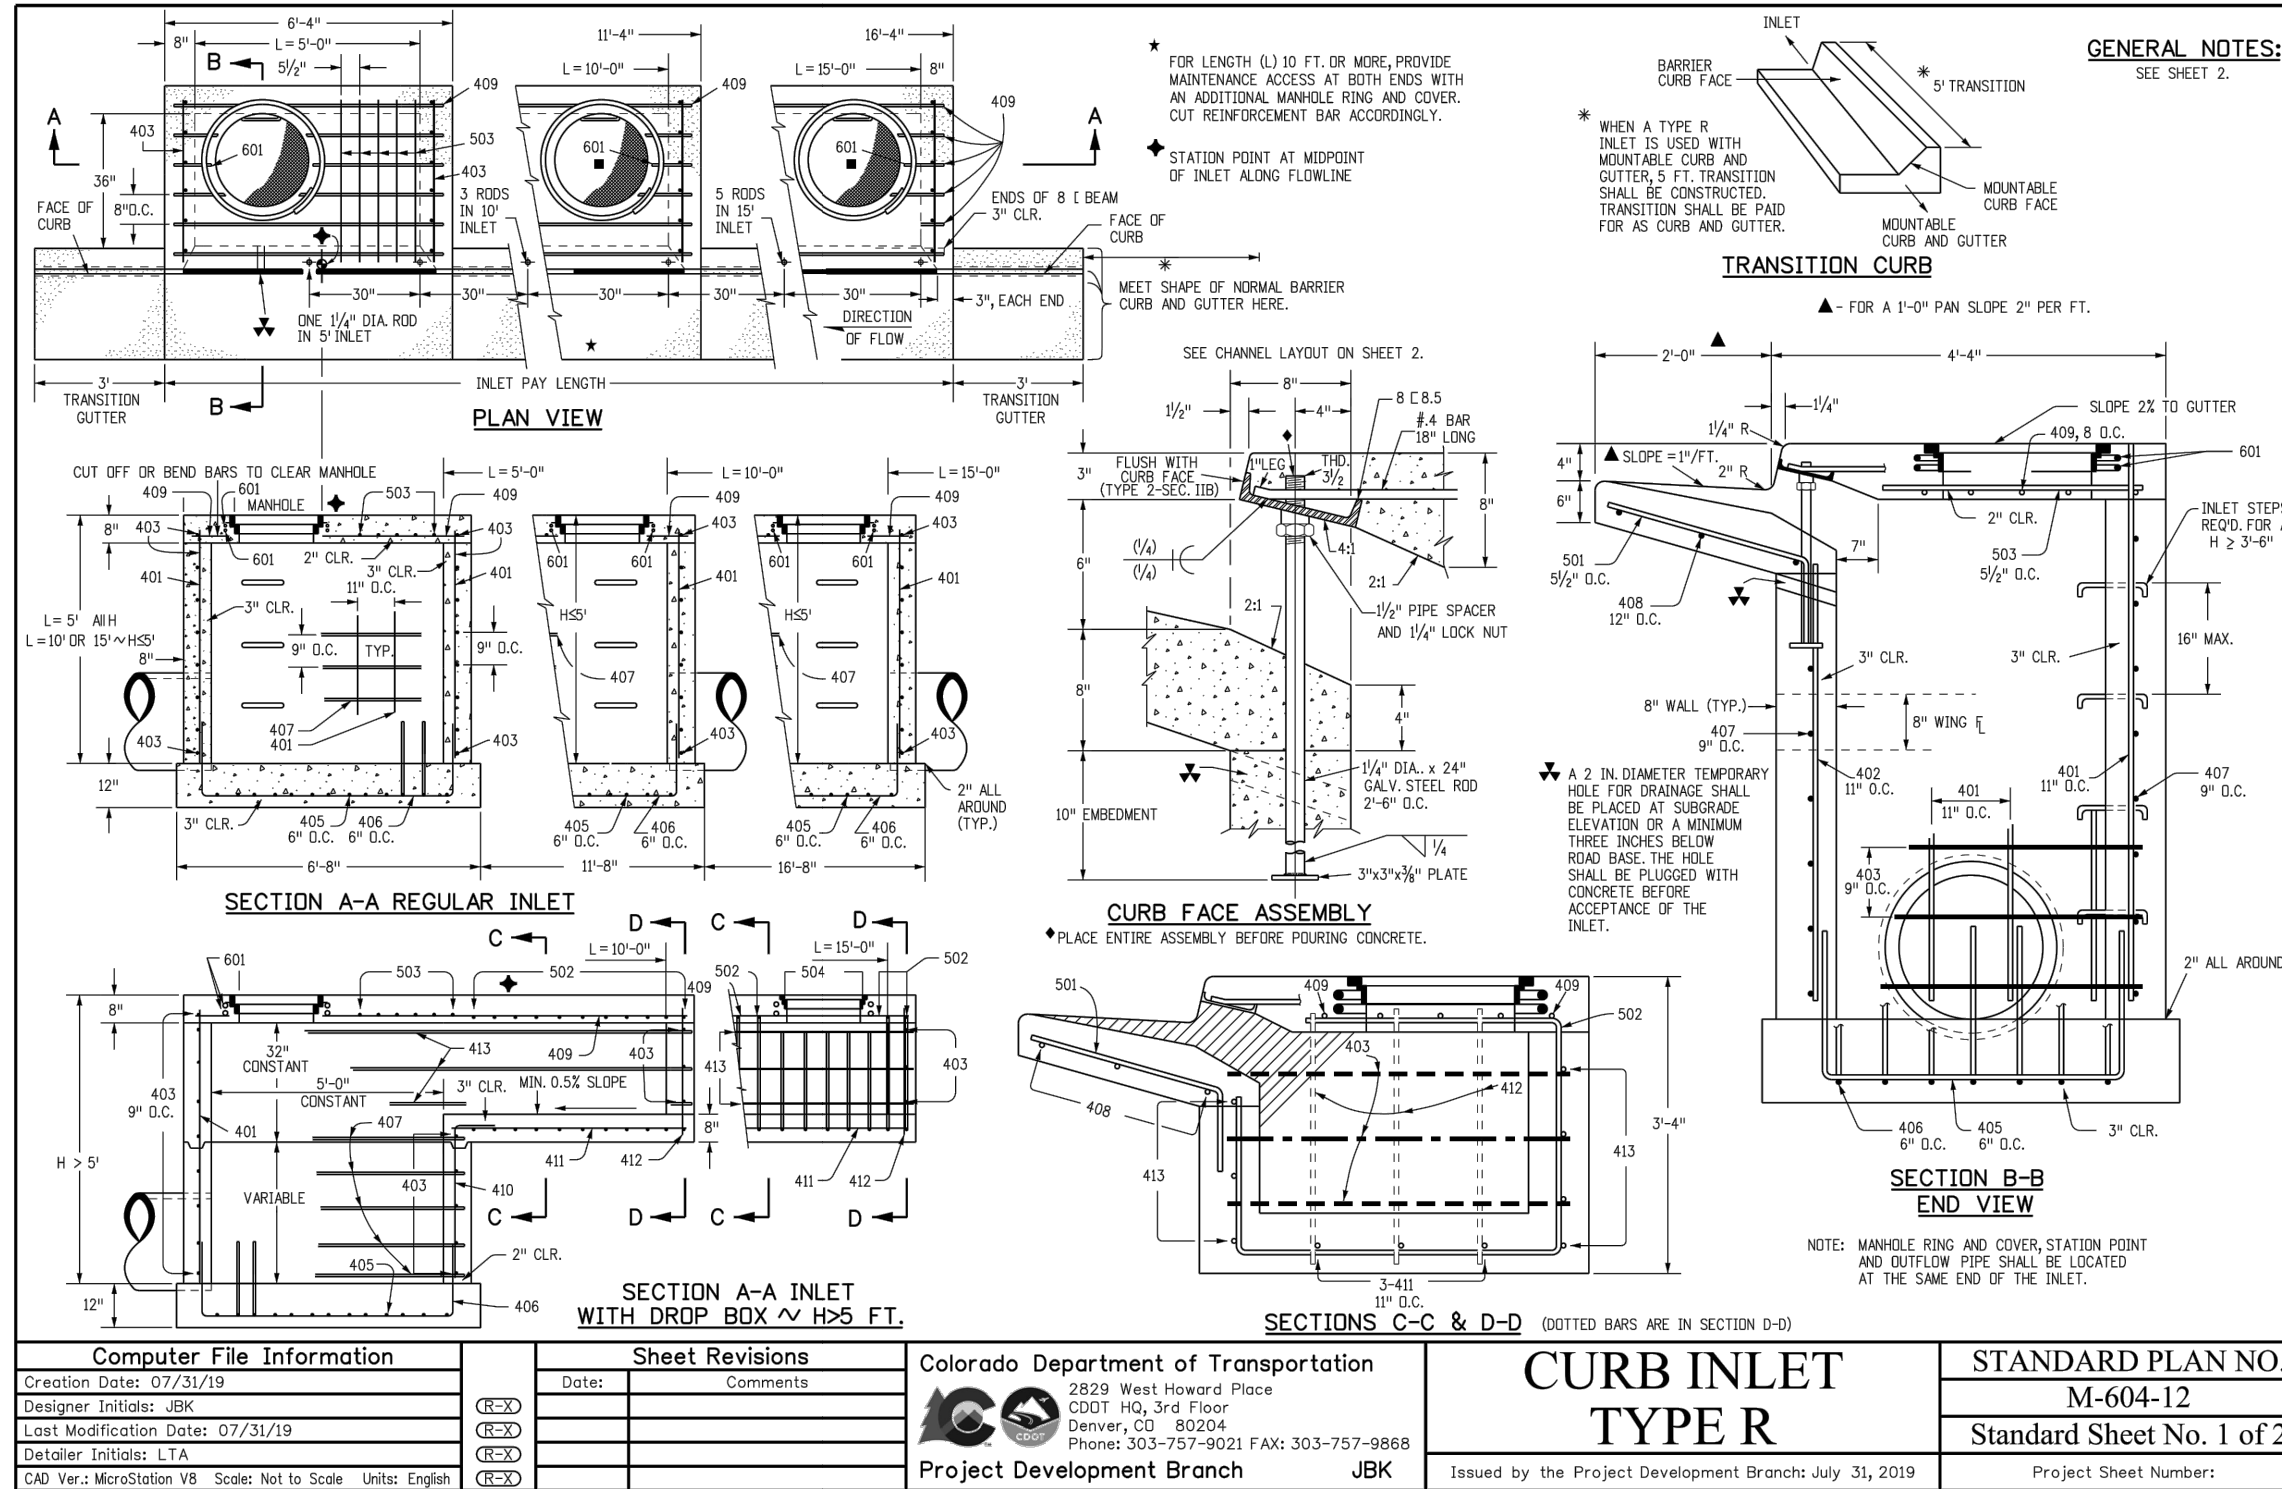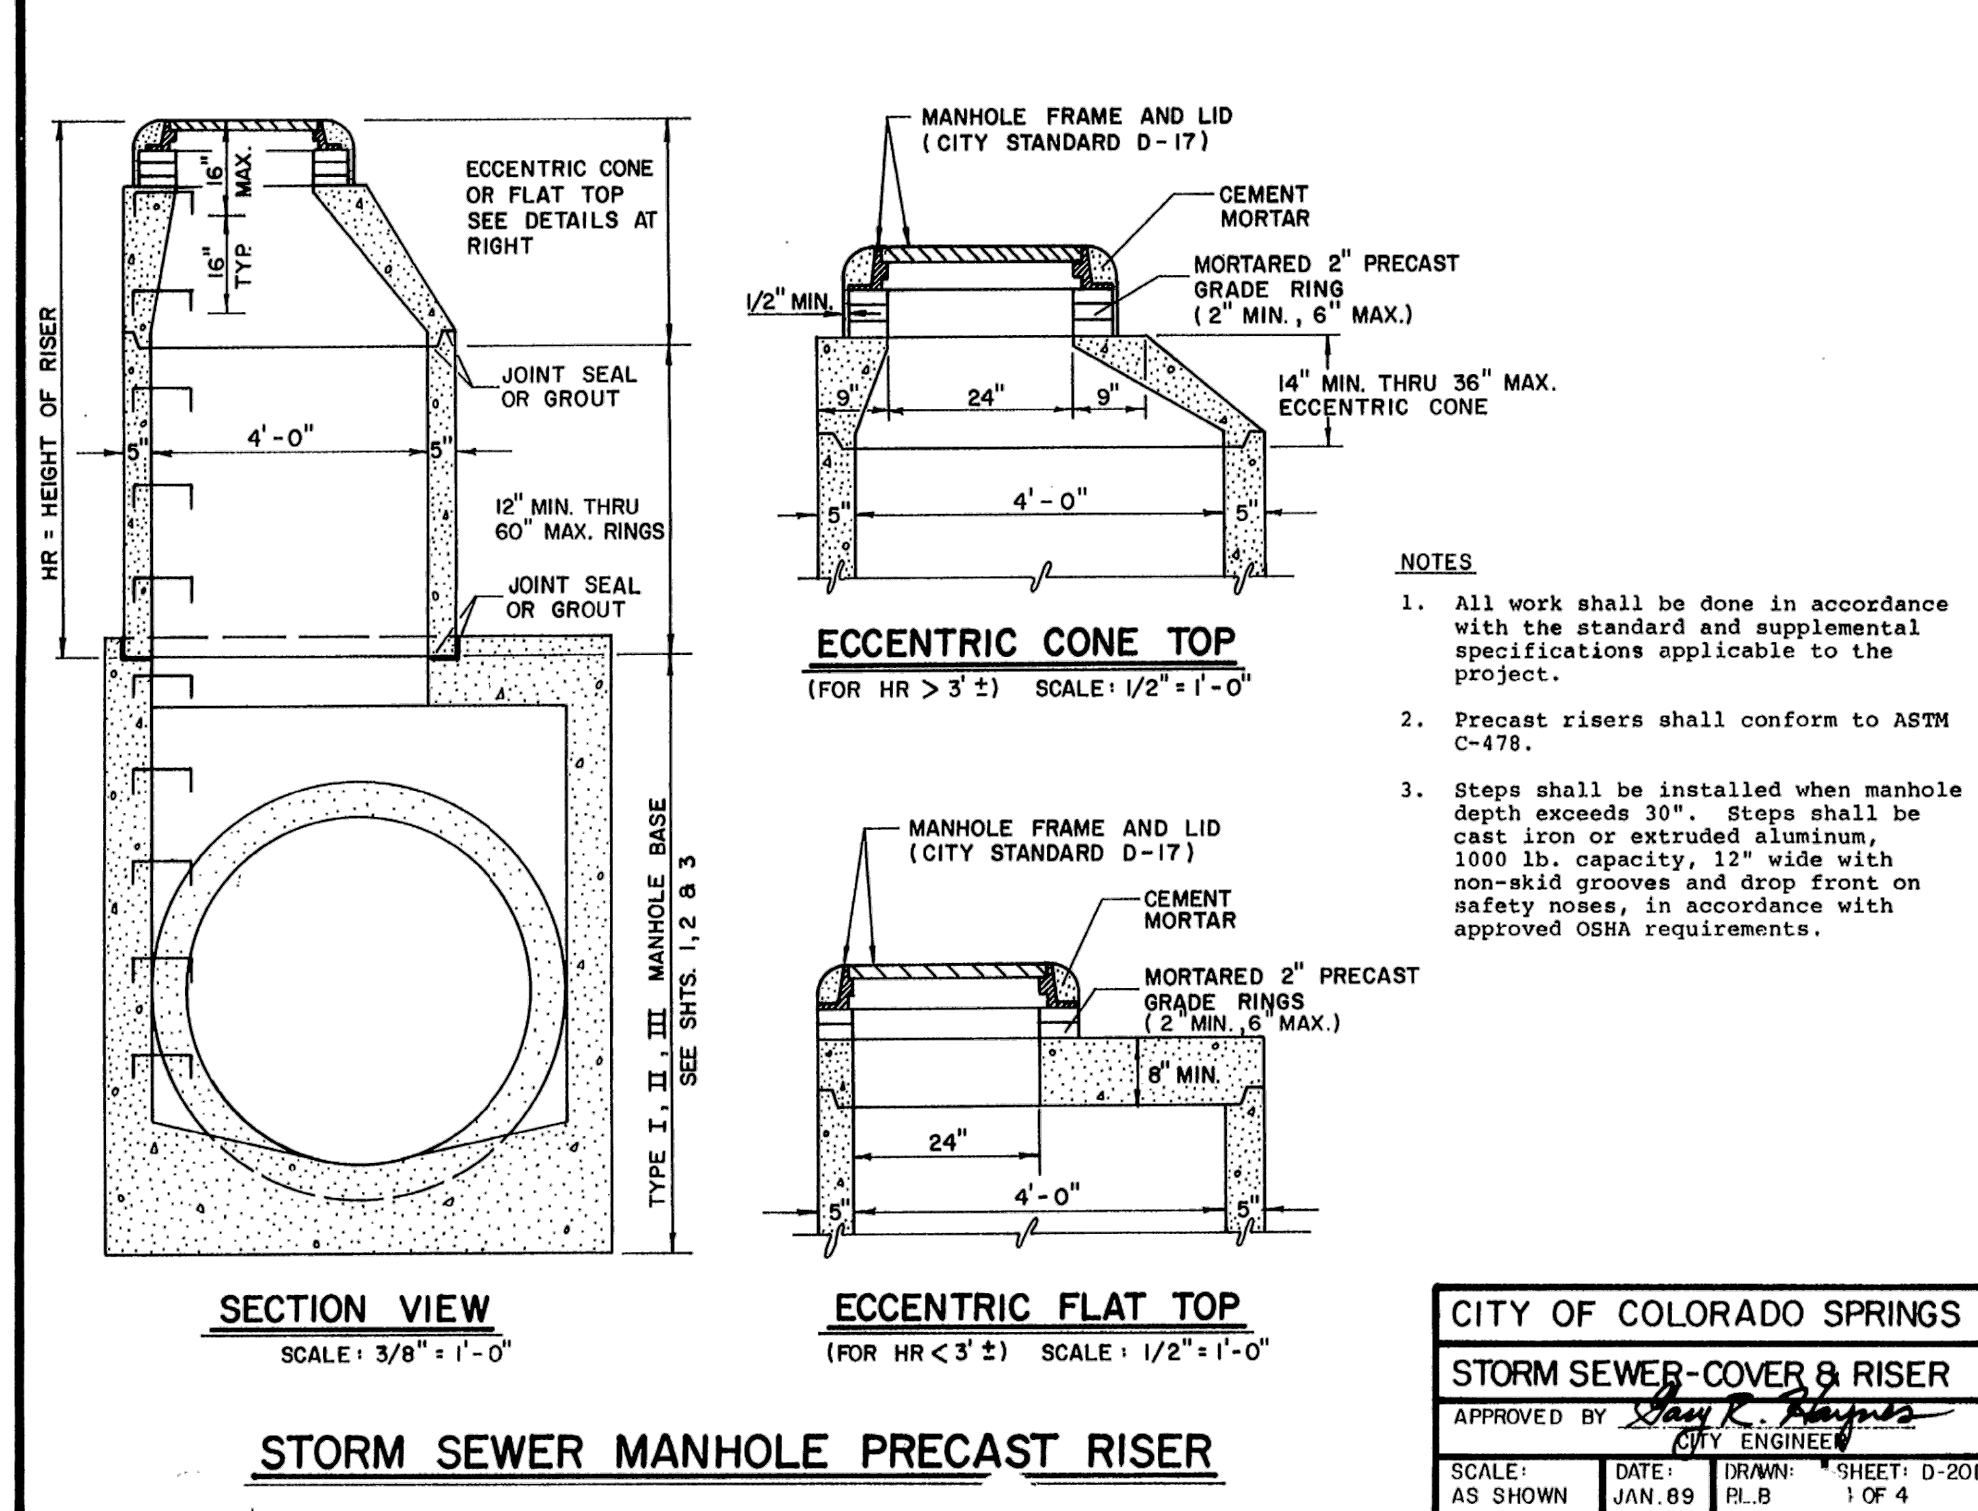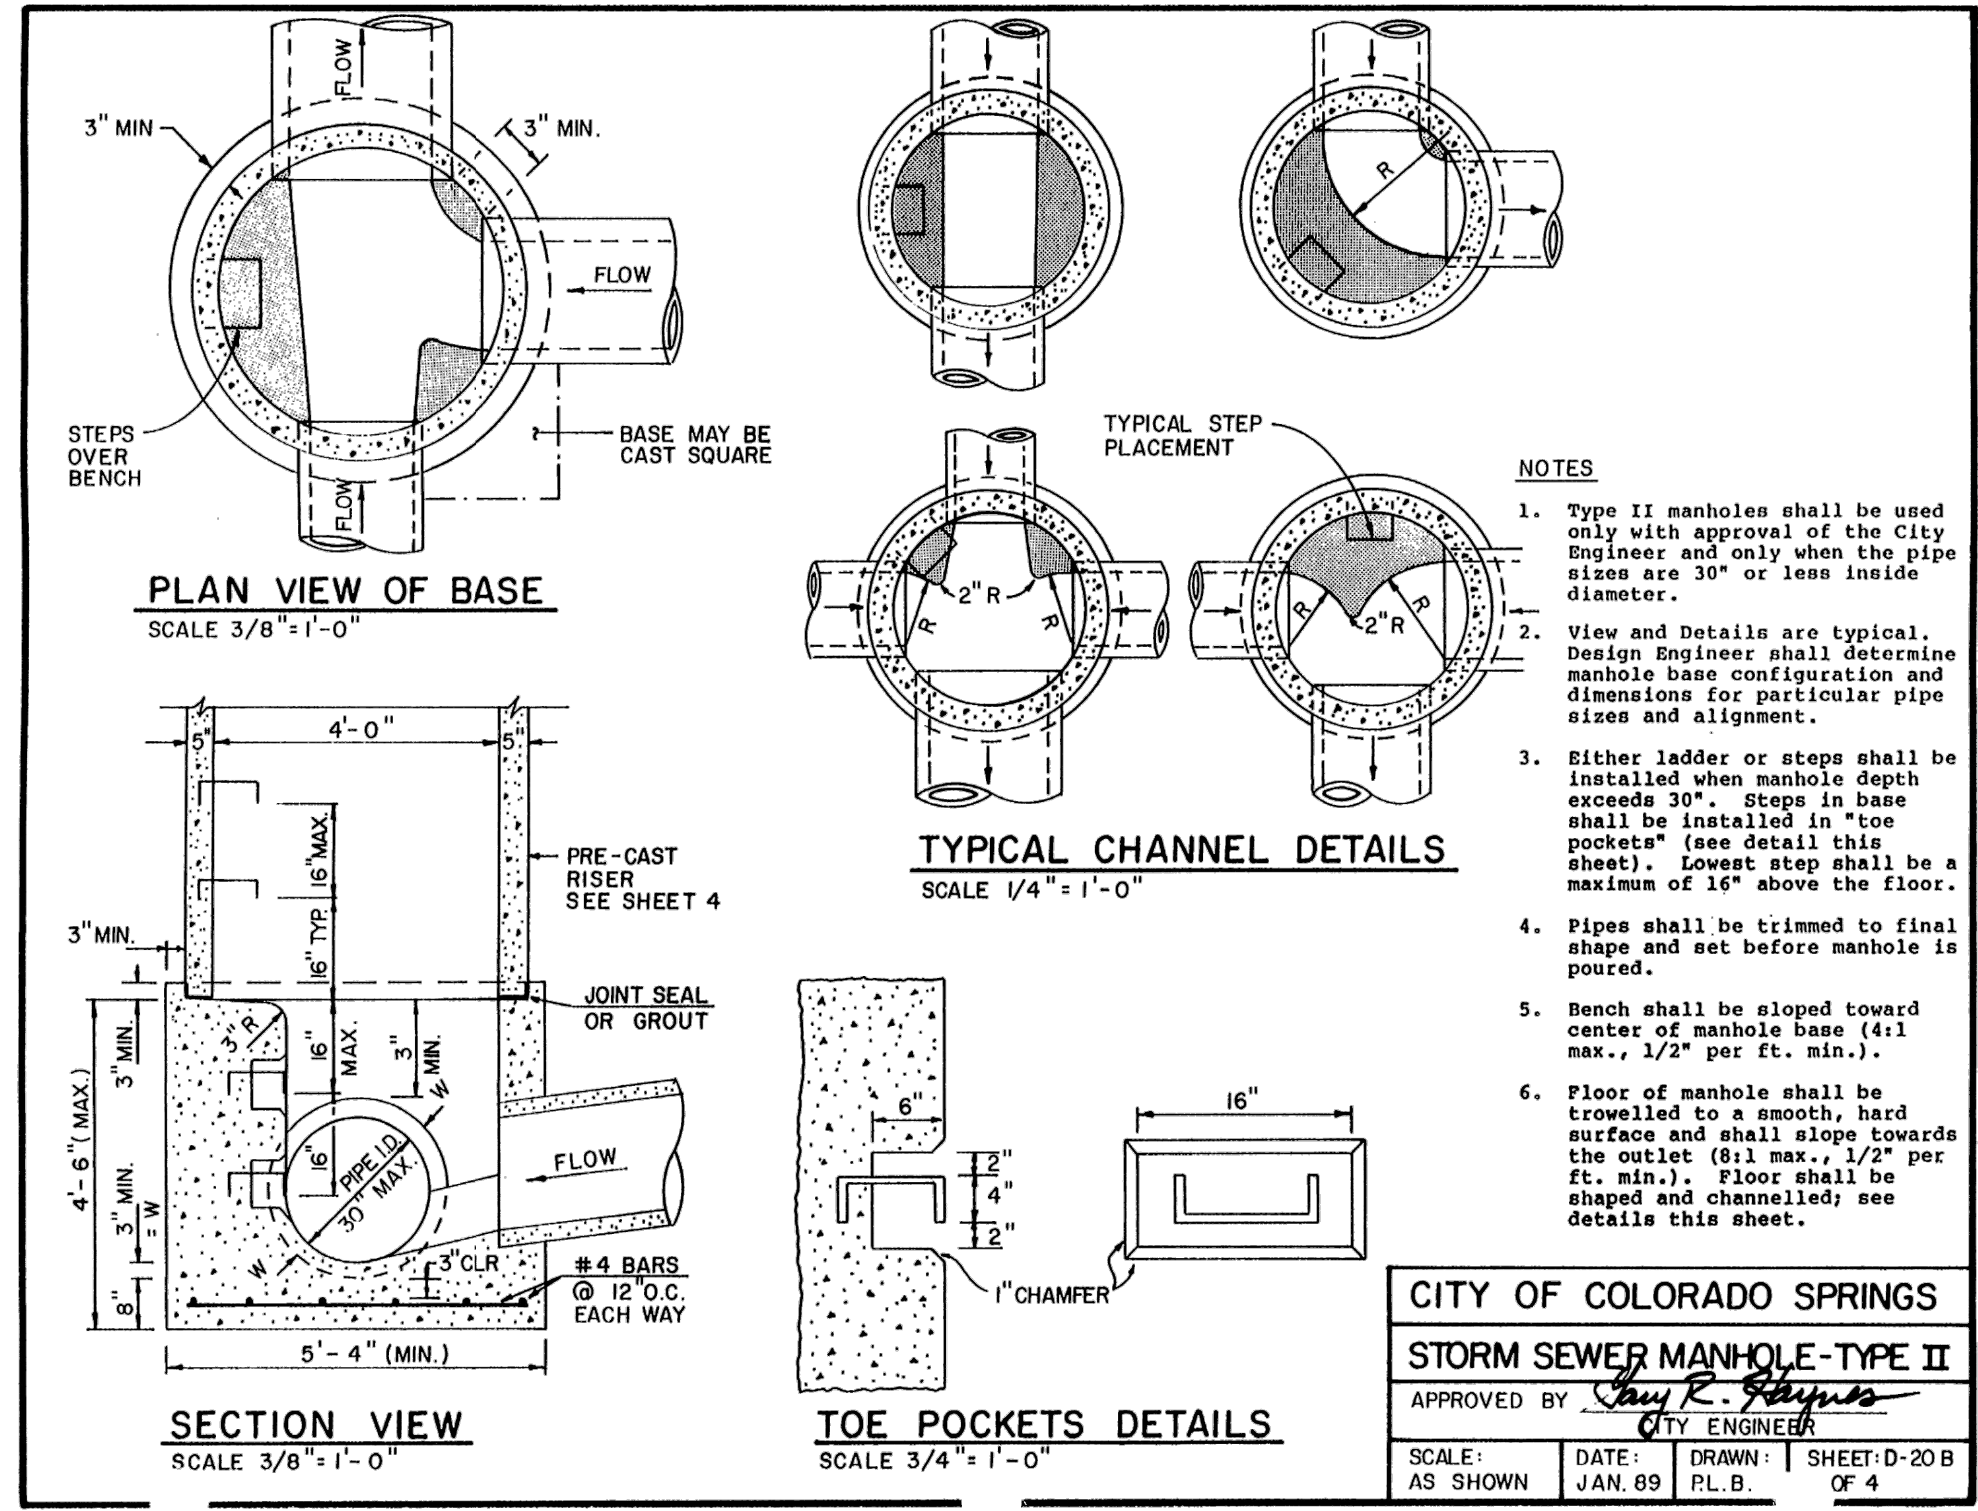



Stabilized Staging Area (SSA)

SM-6

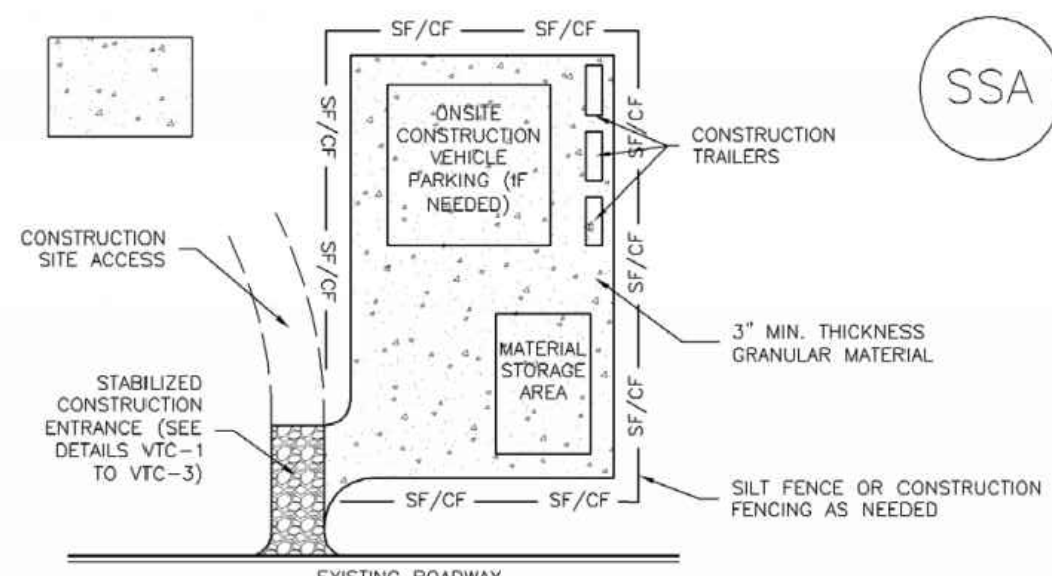

SSA-1. STABILIZED STAGING AREA

STABILIZED STAGING AREA INSTALLATION NOTES

1. SEE PLAN VIEW FOR:  
-LOCATION OF STAGING AREA(S).  
-CONTRACTOR MAY ADJUST LOCATION AND SIZE OF STAGING AREA WITH APPROVAL FROM THE LOCAL JURISDICTION.

2. STABILIZED STAGING AREA SHOULD BE APPROPRIATE FOR THE NEEDS OF THE SITE. OVERSIZING RESULTS IN A LARGER AREA TO STABILIZE FOLLOWING CONSTRUCTION.

3. STAGING AREA SHALL BE STABILIZED PRIOR TO OTHER OPERATIONS ON THE SITE.

4. THE STABILIZED STAGING AREA SHALL CONSIST OF A MINIMUM 3" THICK GRANULAR MATERIAL.

5. UNLESS OTHERWISE SPECIFIED BY LOCAL JURISDICTION, ROCK SHALL CONSIST OF DOT SECT. #703, AASHTO #3 COARSE AGGREGATE OR 6" (MINUS) ROCK.

6. ADDITIONAL PERIMETER BMPs MAY BE REQUIRED INCLUDING BUT NOT LIMITED TO SILT FENCE AND CONSTRUCTION FENCING.


STABILIZED STAGING AREA MAINTENANCE NOTES

1. INSPECT BMPs EACH WORKDAY, AND MAINTAIN THEM IN EFFECTIVE OPERATING CONDITION. MAINTENANCE OF BMPs SHOULD BE PROACTIVE, NOT REACTIVE. INSPECT BMPs AS SOON AS POSSIBLE (AND ALWAYS WITHIN 24 HOURS) FOLLOWING A STORM THAT CAUSES SURFACE EROSION, AND PERFORM NECESSARY MAINTENANCE.


2. FREQUENT OBSERVATIONS AND MAINTENANCE ARE NECESSARY TO MAINTAIN BMPs IN EFFECTIVE OPERATING CONDITION. INSPECTIONS AND CORRECTIVE MEASURES SHOULD BE DOCUMENTED THOROUGHLY.

3. WHERE BMPs HAVE FAILED, REPAIR OR REPLACEMENT SHOULD BE INITIATED UPON DISCOVERY OF THE FAILURE.

4. ROCK SHALL BE REAPPLIED OR REGRADED AS NECESSARY IF RUTTING OCCURS OR UNDERLYING SUBGRADE BECOMES EXPOSED.

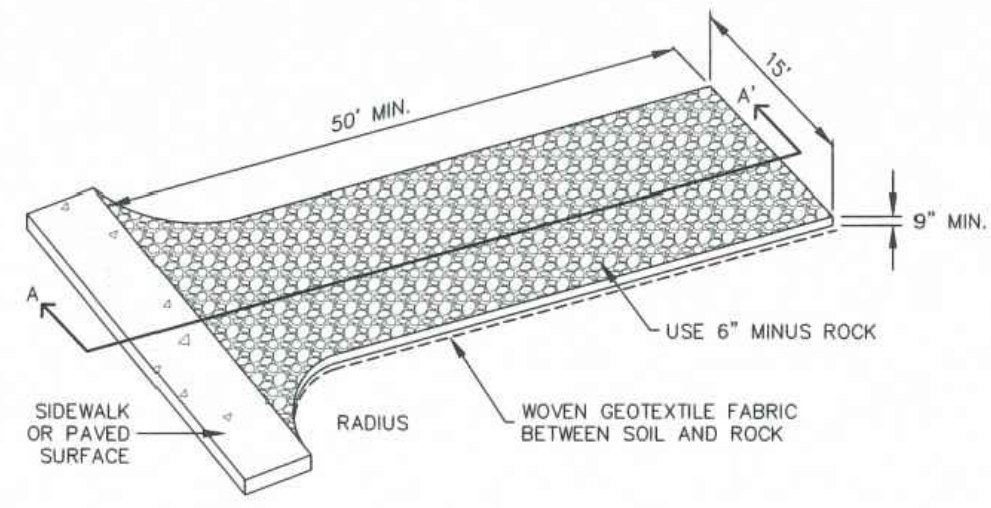

AGGREGATE VEHICLE TRACKING CONTROL

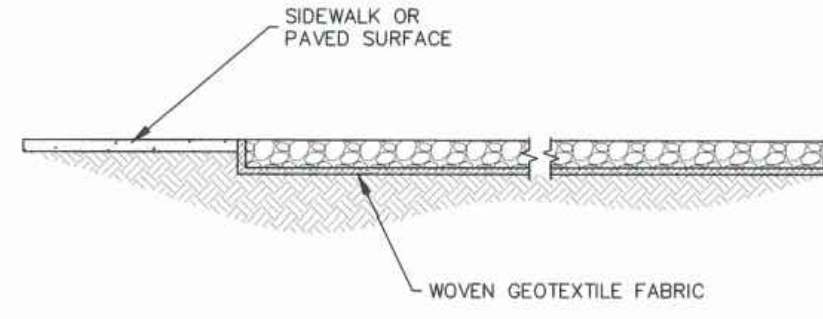

SECTION A-A'

INSTALLATION NOTES


1. A STABILIZED CONSTRUCTION ENTRANCE/EXIT SHOULD BE LOCATED AT ALL POINTS WHERE VEHICLES EXIT THE CONSTRUCTION SITE TO ADJACENT ROADWAY.
2. STABILIZED CONSTRUCTION ENTRANCE/EXITS SHALL BE INSTALLED PRIOR TO ANY LAND DISTURBING ACTIVITIES.
3. RADIUS MUST BE ADEQUATE FOR INTENDED CONSTRUCTION VEHICLE TURNING.
4. ROCK SHOULD CONSIST OF 6" MINUS ROCK.
5. INSTALL CONSTRUCTION FENCE ON BOTH SIDES OF VEHICLE TRACKING CONTROL PAD WHEN NEEDED OR REQUIRED BY INSPECTOR.

MAINTENANCE NOTES

1. FREQUENT OBSERVATIONS AND MAINTENANCE ARE NECESSARY TO MAINTAIN CONTROL MEASURES IN EFFECTIVE OPERATING CONDITION. INSPECTIONS AND CORRECTIVE MEASURES SHOULD BE DOCUMENTED THOROUGHLY.
2. SEDIMENT TRACKED ONTO THE ADJACENT ROAD SHALL BE REMOVED DAILY, BY SWEEPING OR SHOVELING, AND NEVER WASHED DOWN STORM DRAINS.
3. ROUGHEN, REPLACE AND/OR ADD ROCK AS NEEDED TO MAINTAIN CONSISTENT DEPTH AND TO PREVENT SEDIMENT TRACKING ONTO ADJACENT STREET.
4. PERMANENTLY STABILIZE AREA AFTER VEHICLE TRACKING CONTROL IS REMOVED.

VTC

STORMWATER ENTERPRISE	
VEHICLE TRACKING CONTROL	
APPROVED:	SWIFT MANAGER
ISSUED:	REVISED:
10/7/19	8/19/2020
DRAWING NO. 900-VTC	

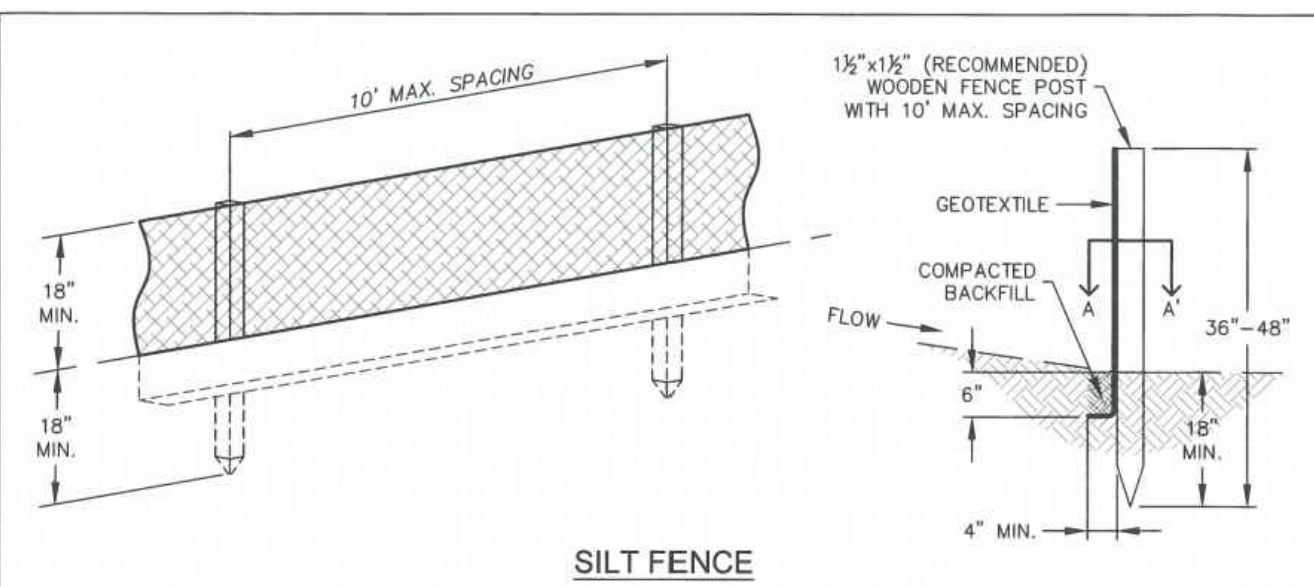

SILT FENCE

J-HOOK INSTALLATION

INSTALLATION NOTES


1. SILT FENCE MUST BE PLACED ON A FLAT SURFACE 2'-5' AWAY FROM TOE OF THE SLOPE TO ALLOW FOR FLOODING AND DEPOSITION.
2. COMPACT THE TRENCH USING A JUMPING JACK OR WHEEL ROLLING TO THE POINT THAT THE FENCE RESISTS BEING PULLED OUT OF THE GROUND BY HAND.
3. SILT FENCE SHALL BE TAUT WITH NO SAGS AFTER IT HAS BEEN ANCHORED.
4. FABRIC SHALL BE ATTACHED TO POSTS WITH 1" HEAVY DUTY STAPLES OR 1" NAILS. THESE SHOULD BE PLACED VERTICALLY DOWN THE POST, 3" APART.
5. THE PREFERRED INSTALLATION METHOD USES A TRENCHER OR SILT FENCE INSTALLATION DEVICE.
6. INSTALL SILT FENCE LONG THE CONTOUR OF THE SLOPES OR IN A MANNER TO AVOID CREATING CONCENTRATED FLOW (SUCH AS A "J-HOOK" INSTALLATION).

MAINTENANCE NOTES

1. FREQUENT OBSERVATIONS AND MAINTENANCE ARE NECESSARY TO MAINTAIN CONTROL MEASURES IN EFFECTIVE OPERATING CONDITION. INSPECTIONS AND CORRECTIVE MEASURES SHOULD BE DOCUMENTED THOROUGHLY.
2. ACCUMULATED SEDIMENT MUST BE REMOVED WHEN THE HEIGHT REACHES 1/2 OF THE DESIGN HEIGHT OF THE SILT FENCE.
3. SILT FENCE MUST REMAIN UNTIL THE UPSTREAM DISTURBANCE AREA IS STABILIZED.
4. PERMANENTLY STABILIZE AREA AFTER SILT FENCE IS REMOVED.

SF

STORMWATER ENTERPRISE	
SILT FENCE	
APPROVED:	SWIFT MANAGER
ISSUED:	REVISED:
10/7/19	8/19/2020
DRAWING NO. 900-SF	

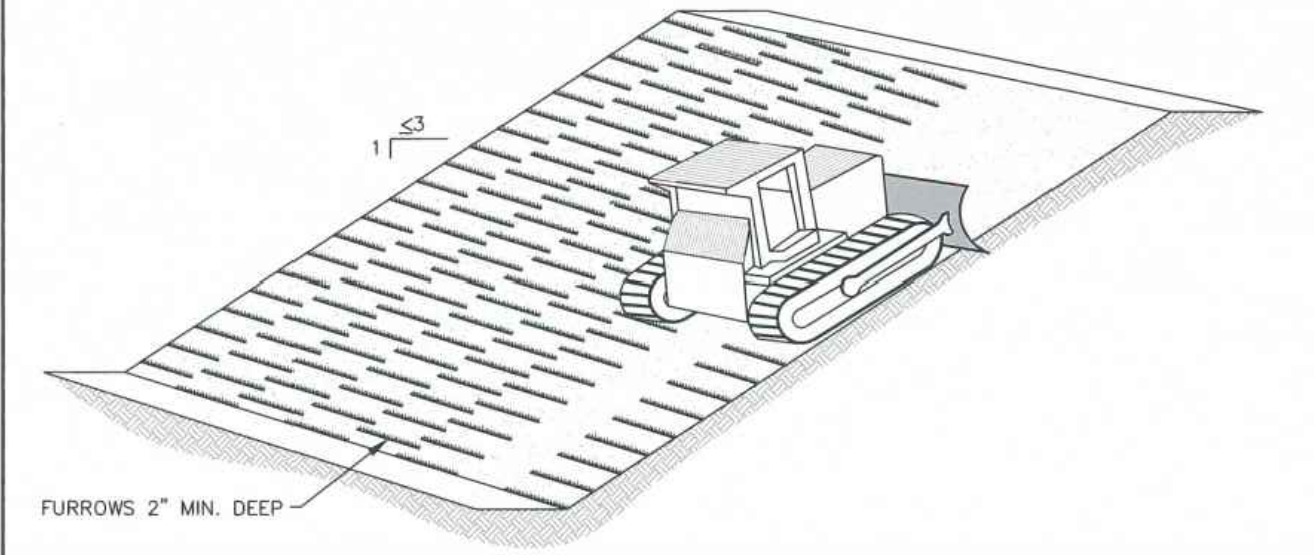

SLOPE TRACKING

INSTALLATION NOTES

1. SLOPE TRACKING MAY BE USED ON SLOPES 3:1 OR STEEPER.
2. TRACKING GROOVES SHALL BE PERPENDICULAR TO THE SLOPE.
3. SLOPE TRACKING SHALL NOT BE USED ON EXTREMELY SANDY OR ROCKY SOILS.

MAINTENANCE NOTES

1. FREQUENT OBSERVATIONS AND MAINTENANCE ARE NECESSARY TO MAINTAIN CONTROL MEASURES IN EFFECTIVE OPERATING CONDITION. INSPECTIONS AND CORRECTIVE MEASURES SHOULD BE DOCUMENTED THOROUGHLY.
2. VEHICLES AND EQUIPMENT SHALL NOT BE DRIVEN OVER AREAS THAT HAVE BEEN SLOPE TRACKED.


ST

STORMWATER ENTERPRISE	
SLOPE TRACKING	
APPROVED:	SWIFT MANAGER
ISSUED:	REVISED:
10/7/19	8/19/2020
DRAWING NO. 900-ST	

November 2010

Urban Drainage and Flood Control District  
Urban Storm Drainage Criteria Manual Volume 3

SSA-3

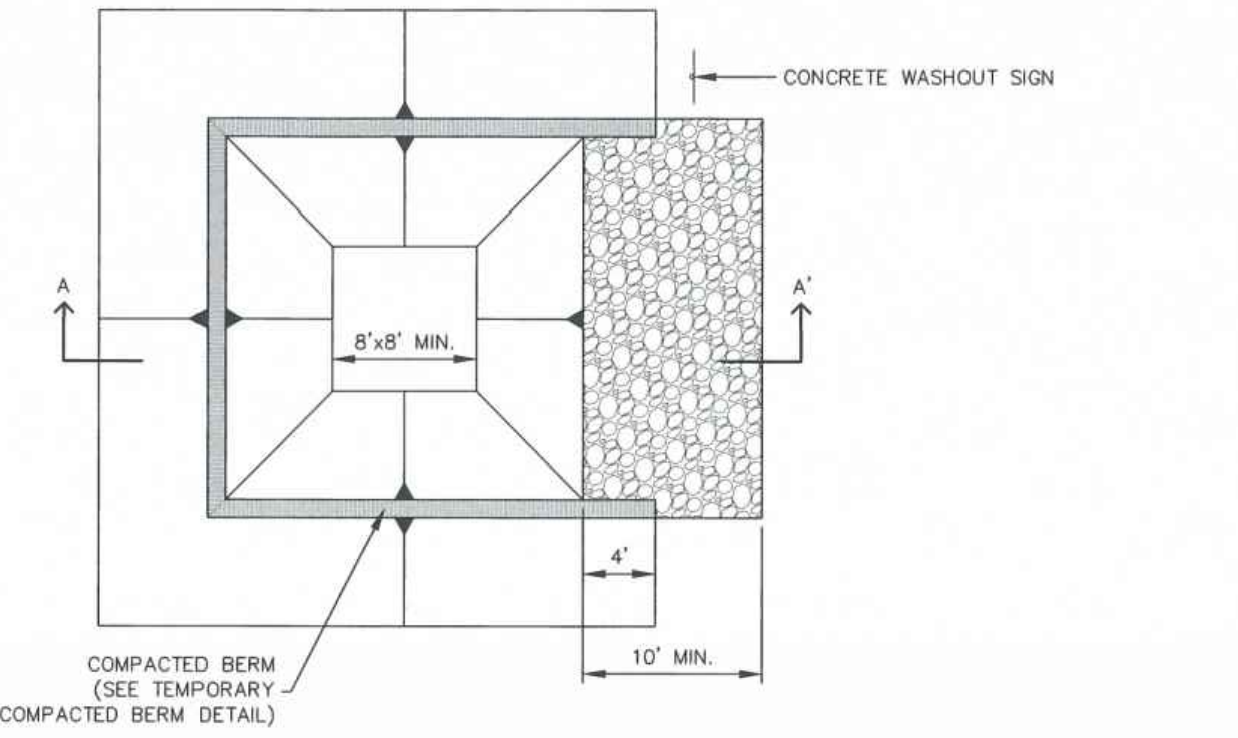

CONCRETE WASHOUT AREA PLAN

SECTION A-A'

\*ROCK REQUIRED BASED ON SITE CONDITIONS AT THE DISCRETION OF THE GEC INSPECTOR

CWA

STORMWATER ENTERPRISE	
CONCRETE WASHOUT AREA	
APPROVED:	SWIFT MANAGER
ISSUED:	REVISED:
10/7/19	8/19/2020
DRAWING NO. 900-CWA-1	

INSTALLATION NOTES


1. SEE PLAN VIEW FOR:  
-LOCATION OF CONCRETE WASHOUT AREA  
-LOCATE AT LEAST 50' AWAY FROM STATE WATERS MEASURED HORIZONTALLY
3. AN IMPERMEABLE LINER (16 MIL. MINIMUM THICKNESS) IS REQUIRED IF CONCRETE WASH AREA IS LOCATED WITHIN 400' OF STATE WATERS OR 1000' OF WELLS OR DRINKING WATER SOURCES.
4. DO NOT LOCATE IN AREAS WHERE SHALLOW GROUNDWATER MAY BE PRESENT.
5. THE CONCRETE WASH AREA SHALL BE INSTALLED PRIOR TO CONCRETE PLACEMENT ON SITE.
6. CONCRETE WASH AREA SHALL INCLUDE A FLAT SUBSURFACE PIT THAT IS AT LEAST 8' BY 8'.
7. BERM SURROUNDING SIDES AND BACK OF CONCRETE WASH AREA SHALL HAVE A MINIMUM HEIGHT OF 2 FEET.
8. CONCRETE WASH AREA ENTRANCE SHALL BE SLOPED 2% TOWARDS THE CONCRETE WASH AREA.
9. SIGNS SHALL BE PLACED AT THE CONCRETE WASH AREA.
10. USE EXCAVATED MATERIAL FOR PERIMETER BERM CONSTRUCTION.

MAINTENANCE NOTES

1. FREQUENT OBSERVATIONS AND MAINTENANCE ARE NECESSARY TO MAINTAIN CONTROL MEASURES IN EFFECTIVE OPERATING CONDITION. INSPECTIONS AND CORRECTIVE MEASURES SHOULD BE DOCUMENTED THOROUGHLY.
2. THE CONCRETE WASH AREA SHALL BE REPAIRED, CLEANED, OR ENLARGED AS NECESSARY TO MAINTAIN CAPACITY FOR CONCRETE WASTE. CONCRETE MATERIALS ACCUMULATED IN THE PIT SHALL BE REMOVED ONCE THE MATERIALS HAVE REACHED A DEPTH OF 1/2 THE HEIGHT OF THE CONCRETE WASH AREA.
3. CONCRETE WASHOUT WATER, WASTED PIECES OF CONCRETE, AND ALL OTHER DEBRIS IN THE SUBSURFACE PIT SHALL BE TRANSPORTED FROM THE JOB SITE IN A WATER-TIGHT CONTAINER AND DISPOSED OF PROPERLY.
4. THE CONCRETE WASH AREA SHALL REMAIN IN PLACE UNTIL ALL CONCRETE FOR THE PROJECT IS PLACED.
5. PERMANENTLY STABILIZE AREA AFTER CONCRETE WASH AREA IS REMOVED.

CWA

STORMWATER ENTERPRISE	
CONCRETE WASHOUT AREA	
APPROVED:	SWIFT MANAGER
ISSUED:	REVISED:
10/7/19	8/19/2020
DRAWING NO. 900-CWA-2	

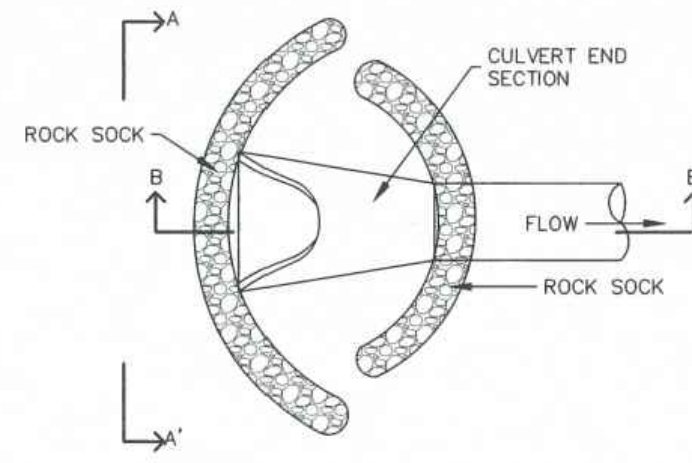

CULVERT INLET PROTECTION PLAN

SECTION A-A'

SECTION B-B'

INSTALLATION NOTES


1. SEE ROCK SOCK DETAIL.

MAINTENANCE NOTES


1. FREQUENT OBSERVATIONS AND MAINTENANCE ARE NECESSARY TO MAINTAIN CONTROL MEASURES IN EFFECTIVE OPERATING CONDITION. INSPECTIONS AND CORRECTIVE MEASURES SHOULD BE DOCUMENTED THOROUGHLY.
2. ACCUMULATED SEDIMENT UPSTREAM OF THE CULVERT SHALL BE REMOVED WHEN THE SEDIMENT DEPTH IS 1/2 HEIGHT OF THE ROCK SOCK.
3. CULVERT INLET PROTECTION SHALL REMAIN UNTIL THE UPSTREAM AREA IS PERMANENTLY STABILIZED.

CIP

STORMWATER ENTERPRISE	
CULVERT INLET PROTECTION	
APPROVED:	SWIFT MANAGER
ISSUED:	REVISED:
10/7/19	8/19/2020
DRAWING NO. 900-CIP	

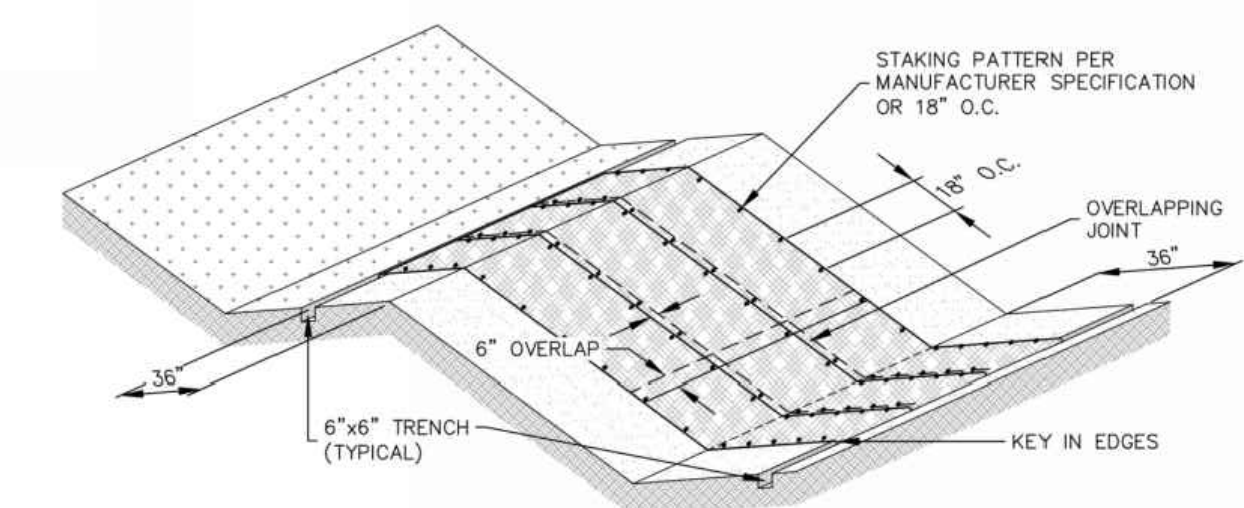


EROSION CONTROL BLANKET

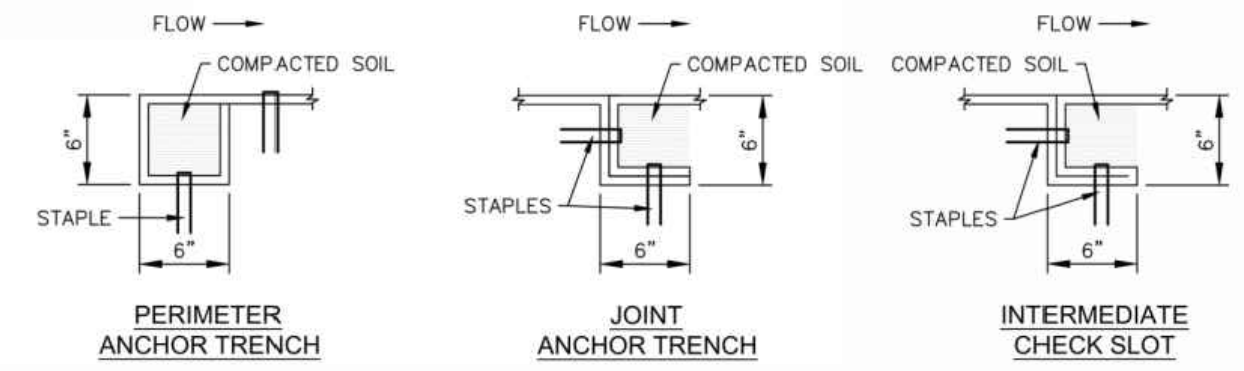


PERIMETER ANCHOR TRENCH

JOINT ANCHOR TRENCH

INTERMEDIATE CHECK SLOT

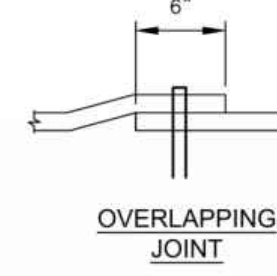

OVERLAPPING JOINT

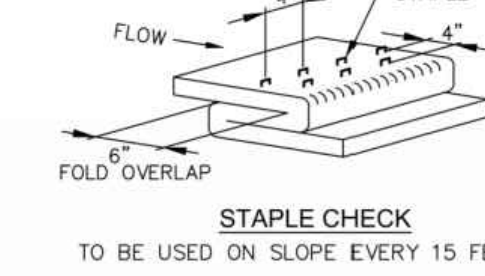

STAPLE CHECK TO BE USED ON SLOPE EVERY 15 FEET

ECB

STORMWATER ENTERPRISE	
EROSION CONTROL BLANKET	
APPROVED:	SWIFT MANAGER
ISSUED:	REVISED:
10/7/19	8/19/2020
DRAWING NO. 900-ECB-1	



**INSTALLATION NOTES**

- 100% NATURAL AND BIODEGRADABLE MATERIALS ARE REQUIRED FOR EROSION CONTROL BLANKETS. TRM PRODUCTS MAY BE USED WHERE APPROPRIATE AS DESIGNATED BY THE ENGINEER.
- IN AREAS WHERE EROSION CONTROL BLANKETS ARE SHOWN ON THE PLANS, THE PERMITTEE SHALL PLACE TOPSOIL AND PERFORM FINAL GRADING, SURFACE PREPARATION, AND SEEDING AND MULCHING. SUBGRADE SHALL BE SMOOTH AND MOST PRIOR TO EROSION CONTROL BLANKET INSTALLATION, AND THE EROSION CONTROL BLANKET SHALL BE IN FULL CONTACT WITH THE SUBGRADE. NO GAPS OR VOIDS SHALL EXIST UNDER THE BLANKET.
- PERIMETER ANCHOR TRENCH SHALL BE USED ALONG THE OUTSIDE PERIMETER OF ALL BLANKET AREAS.
- JOINT ANCHOR TRENCH SHALL BE USED TO JOIN ROLLS OF EROSION CONTROL BLANKETS TOGETHER (LONGITUDINALLY AND TRANSVERSELY) FOR ALL EROSION CONTROL BLANKETS.
- INTERMEDIATE CHECK SLOT OR STAPLE CHECK SHALL BE INSTALLED EVERY 15' DOWN SLOPES. IN DRAINAGEWAYS, INSTALL CHECK SLOTS EVERY 25' PERPENDICULAR TO FLOW DIRECTION.
- OVERLAPPING JOINT DETAIL SHALL BE USED TO JOIN ROLLS OF EROSION CONTROL BLANKETS TOGETHER FOR EROSION CONTROL BLANKETS ON SLOPES.
- MATERIAL SPECIFICATIONS OF EROSION CONTROL BLANKETS SHALL CONFORM TO TABLE ECB-1.
- ANY AREAS OF SEEDING AND MULCHING DISTURBED IN THE PROCESS OF INSTALLING EROSION CONTROL BLANKETS SHALL BE RESEEDED AND MULCHED.
- STRAW EROSION CONTROL BLANKETS SHALL NOT BE USED WITHIN STREAMS AND DRAINAGE CHANNELS.
- COMPACT ALL TRENCHES.

**MAINTENANCE NOTES**

- FREQUENT OBSERVATIONS AND MAINTENANCE ARE NECESSARY TO MAINTAIN CONTROL MEASURES IN EFFECTIVE OPERATING CONDITION. INSPECTIONS AND CORRECTIVE MEASURES SHOULD BE DOCUMENTED THOROUGHLY.
- EROSION CONTROL BLANKETS SHALL BE LEFT IN PLACE TO EVENTUALLY BIODEGRADE. TRM MUST BE REMOVED AT THE DISCRETION OF THE GEC INSPECTOR.
- ANY EROSION CONTROL BLANKET PULLED OUT, TORN, OR OTHERWISE DAMAGED SHALL BE REPAIRED OR REINSTALLED. ANY SUBGRADE AREAS BELOW GEOTEXTILE THAT HAVE ERODED TO CREATE A VOID UNDER THE BLANKET, OR THAT REMAIN DEVOID OF GRASS, SHALL BE REPAIRED, RESEEDED AND MULCHED AND THE EROSION CONTROL BLANKET REINSTALLED.

**TABLE ECB-1, EROSION CONTROL BLANKET MATERIAL SPECIFICATIONS**

TYPE	COCONUT CONTENT	STRAW CONTENT	EXCELSIOR CONTENT	RECOMMENDED NETTING
STRAW	—	100%	—	DOUBLE/NATURAL
STRAW-COCONUT	30% MIN.	70% MAX.	—	DOUBLE/NATURAL
COCONUT	100%	—	—	DOUBLE/NATURAL
EXCELSIOR	—	—	100%	DOUBLE/NATURAL

**EROSION CONTROL BLANKET**

APPROVED: *[Signature]*

ISSUED: 10/7/19 REVISED: 8/19/2020 DRAWING NO. 900-ECB-2

**CURB INLET PROTECTION PLAN**

**CURB ROCK SOCKS UPSTREAM OF INLET PROTECTION**

**INSTALLATION NOTES**

- SEE ROCK SOCK DETAIL FOR INSTALLATION REQUIREMENTS.
- PLACEMENT OF THE ROCK SOCK SHALL BE APPROXIMATELY 40 DEGREES FROM THE CURB.
- ROCK SOCKS ARE TO BE FLUSH WITH THE CURB AND SPACED A MINIMUM OF 5' APART.
- AT LEAST TWO CURB ROCK SOCKS IN SERIES ARE REQUIRED UPSTREAM OF ON-GRADE INLETS.
- ADDITIONAL ROCK SOCKS MAY BE REQUIRED AT GEC INSPECTOR'S DISCRETION.

**MAINTENANCE NOTES**

- FREQUENT OBSERVATIONS AND MAINTENANCE ARE NECESSARY TO MAINTAIN CONTROL MEASURES IN EFFECTIVE OPERATING CONDITION. INSPECTIONS AND CORRECTIVE MEASURES SHOULD BE DOCUMENTED THOROUGHLY.
- ACCUMULATED SEDIMENT MUST BE REMOVED WHEN THE HEIGHT REACHES 1/2 OF THE DESIGN DEPTH OF THE INLET BARRIER.
- ROCK SOCKS MUST REMAIN UNTIL THE UPSTREAM DISTURBANCE AREA IS STABILIZED.
- PERMANENTLY STABILIZE AREA BEHIND INLET AFTER ROCK SOCKS ARE REMOVED WHEN REMOVAL IS APPROPRIATE.

**ON-GRADE INLET PROTECTION**

APPROVED: *[Signature]*

ISSUED: 10/7/19 REVISED: 8/19/2020 DRAWING NO. 900-IP-1

**ROCK SOCK SUMP INLET PROTECTION PLAN**

**SECTION A-A'**

**INSTALLATION NOTES**

- SEE ROCK SOCK DETAIL FOR INSTALLATION REQUIREMENTS.
- SEDIMENT CONTROL LOGS MAY BE USED IN PLACE OF ROCK SOCKS IN PERVIOUS AREAS. INSTALL PER SEDIMENT CONTROL LOG DETAIL.
- CONTROL MEASURES MUST BE WRAPPED AROUND INLET AS TIGHTLY AS POSSIBLE.

**MAINTENANCE NOTES**

- FREQUENT OBSERVATIONS AND MAINTENANCE ARE NECESSARY TO MAINTAIN CONTROL MEASURES IN EFFECTIVE OPERATING CONDITION. INSPECTIONS AND CORRECTIVE MEASURES SHOULD BE DOCUMENTED THOROUGHLY.
- ACCUMULATED SEDIMENT MUST BE REMOVED WHEN THE HEIGHT REACHES 1/2 OF THE DESIGN DEPTH OF THE INLET BARRIER.
- ROCK SOCKS MUST REMAIN UNTIL THE UPSTREAM DISTURBANCE AREA IS STABILIZED.
- PERMANENTLY STABILIZE AREA AROUND INLET AFTER ROCK SOCKS ARE REMOVED WHEN REMOVAL IS APPROPRIATE.

**SUMP INLET PROTECTION**

APPROVED: *[Signature]*

ISSUED: 10/7/19 REVISED: 8/19/2020 DRAWING NO. 900-IP-2

**SEEDING & MULCHING**

ALL SOIL TESTING, SOILS AMENDMENT AND FERTILIZER DOCUMENTATION, AND SEED LOAD AND BAG TICKETS MUST BE ADDED TO THE CSWMP.

**SOIL PREPARATION**

- IN AREAS TO BE SEED, THE UPPER 6 INCHES OF THE SOIL MUST NOT BE HEAVILY COMPACTED, AND SHOULD BE IN FRABLE CONDITION. LESS THAN 85% STANDARD PROCTOR DENSITY IS ACCEPTABLE. AREAS OF COMPACTION OR GENERAL CONSTRUCTION ACTIVITY MUST BE SCARIFIED TO A DEPTH OF 6 TO 12 INCHES PRIOR TO SPREADING TOPSOIL TO BREAK UP COMPACTED LAYERS AND PROVIDE A BLENDING ZONE BETWEEN DIFFERENT SOIL LAYERS.
- AREAS TO BE PLANTED SHALL HAVE AT LEAST 4 INCHES OF TOPSOIL SUITABLE TO SUPPORT PLANT GROWTH.
- THE CITY RECOMMENDS THAT EXISTING AND/OR IMPORTED TOPSOIL BE TESTED TO IDENTIFY SOIL DEFICIENCIES AND ANY SOIL AMENDMENTS NECESSARY TO ADDRESS THESE DEFICIENCIES. SOIL AMENDMENTS AND/OR FERTILIZERS SHOULD BE ADDED TO CORRECT TOPSOIL DEFICIENCIES BASED ON SOIL TESTING RESULTS.
- TOPSOIL SHALL BE PROTECTED DURING THE CONSTRUCTION PERIOD TO RETAIN ITS STRUCTURE AVOID COMPACTION, AND TO PREVENT EROSION AND CONTAMINATION. STRIPPED TOPSOIL MUST BE STORED IN AN AREA AWAY FROM MACHINERY AND CONSTRUCTION OPERATIONS, AND CARE MUST BE TAKEN TO PROTECT THE TOPSOIL AS A VALUABLE COMMODITY. TOPSOIL MUST NOT BE STRIPPED DURING UNDESIRABLE WORKING CONDITIONS (E.G. DURING WET WEATHER OR WHEN SOILS ARE SATURATED). TOPSOIL SHALL NOT BE STORED IN SWALES OR IN AREAS WITH POOR DRAINAGE.

**SEEDING**

- ALLOWABLE SEED MIXES ARE INCLUDED IN THE CITY OF COLORADO SPRINGS STORMWATER CONSTRUCTION MANUAL. ALTERNATIVE SEED MIXES ARE ACCEPTABLE IF INCLUDED IN AN APPROVED LANDSCAPING PLAN.
- SEED SHOULD BE DRILL-SEEDED WHENEVER POSSIBLE.
  - SEED DEPTH MUST BE 1/2 TO 3/4 INCHES WHEN DRILL-SEEDED IS USED.
- BROADCAST SEEDING OR HYDRO-SEEDED WITH TACKIFIER MAY BE SUBSTITUTED ON SLOPES STEEPER THAN 3:1 OR ON OTHER AREAS NOT PRACTICAL TO DRILL SEED.
  - SEEDING RATES MUST BE DOUBLED FOR BROADCAST SEEDING OR INCREASED BY 50% IF USING A BRILLION DRILL OR HYDRO-SEEDED.
  - BROADCAST SEEDINGS MUST BE LIGHTLY HAND-RAKED INTO THE SOIL.

**MULCHING**

- MULCHING SHOULD BE COMPLETED AS SOON AS PRACTICABLE AFTER SEEDING, HOWEVER PLANTED AREAS MUST BE MULCHED NO LATER THAN 14 DAYS AFTER PLANTING.
- MULCHING REQUIREMENTS INCLUDE:
  - HAY OR STRAW MULCH
    - ONLY CERTIFIED WEED-FREE AND CERTIFIED SEED-FREE MULCH MAY BE USED. MULCH MUST BE APPLIED AT 2 TONS/ACRE AND ADEQUATELY SECURED BY CRIMPING AND/OR TACKIFIER.
    - CRIMPING MUST NOT BE USED ON SLOPES GREATER THAN 3:1 AND MULCH FIBERS MUST BE TUCKED INTO THE SOIL TO A DEPTH OF 3 TO 4 INCHES.
  - TACKIFIER MUST BE USED IN PLACE OF CRIMPING ON SLOPES STEEPER THAN 3:1.
- HYDRAULIC MULCHING
  - HYDRAULIC MULCHING IS AN OPTION ON STEEP SLOPES OR WHERE ACCESS IS LIMITED.
  - IF HYDRO-SEEDED IS USED, MULCHING MUST BE APPLIED AS A SEPARATE, SECOND OPERATION.
  - WOOD CELLULOSE FIBERS MIXED WITH WATER MUST BE APPLIED AT A RATE OF 2,000 TO 2,500 POUNDS/ACRE, AND TACKIFIER MUST BE APPLIED AT A RATE OF 100 POUNDS/ACRE.

**EROSION CONTROL BLANKET**

- EROSION CONTROL BLANKET MAY BE USED IN PLACE OF TRADITIONAL MULCHING METHODS.

**SEEDING & MULCHING**

APPROVED: *[Signature]*

ISSUED: 10/7/19 REVISED: 8/19/2020 DRAWING NO. 900-SM

**SILT FENCE SUMP INLET PROTECTION PLAN**

**SECTION A-A'**

**INSTALLATION NOTES**

- SEE SILT FENCE DETAIL FOR INSTALLATION REQUIREMENTS.
- POSTS SHALL BE PLACED AT EACH CORNER OF THE INLET AND AROUND THE EDGES AT A MAXIMUM SPACING OF THREE FEET.
- SILT FENCE FABRIC SHOULD HAVE A FLOW RATE IN EXCESS OF 30 GALLONS PER MINUTE PER SQUARE YARD SO AS TO ALLOW SOME WATER FLOW AND NOT DAM THE WATER. STANDARD, LOW-FLOW SILT FENCE FABRIC WILL NOT BE ALLOWED.

**MAINTENANCE NOTES**

- FREQUENT OBSERVATIONS AND MAINTENANCE ARE NECESSARY TO MAINTAIN CONTROL MEASURES IN EFFECTIVE OPERATING CONDITION. INSPECTIONS AND CORRECTIVE MEASURES SHOULD BE DOCUMENTED THOROUGHLY.
- ACCUMULATED SEDIMENT MUST BE REMOVED WHEN THE HEIGHT REACHES 1/2 OF THE DESIGN DEPTH OF THE INLET BARRIER.
- SILT FENCE MUST REMAIN UNTIL THE UPSTREAM DISTURBANCE AREA IS STABILIZED.
- PERMANENTLY STABILIZE AREA AROUND INLET AFTER SILT FENCE IS REMOVED WHEN REMOVAL IS APPROPRIATE.

**SUMP INLET PROTECTION**

APPROVED: *[Signature]*

ISSUED: 10/7/19 REVISED: 8/19/2020 DRAWING NO. 900-IP-3

**STRAW BALE SUMP INLET PROTECTION PLAN**

**SECTION A-A'**

**INSTALLATION NOTES**

- BALES SHALL BE PLACED IN A SINGLE ROW AROUND THE INLET WITH THE ENDS OF THE BALES TIGHTLY ADJUTING ONE ANOTHER.
- STRAW BALES SHALL CONSIST OF CERTIFIED WEED FREE STRAW OR HAY. LOCAL JURISDICTIONS MAY REQUIRE PROOF THAT BALES ARE WEED FREE.
- STRAW BALES SHALL CONSIST OF APPROXIMATELY 5 CUBIC FEET OF STRAW OR HAY AND WEIGH NOT LESS THAN 35 POUNDS.
- STRAW BALE DIMENSIONS SHALL BE APPROXIMATELY 36"x18"x18".
- A UNIFORM ANCHOR TRENCH SHALL BE EXCAVATED TO A DEPTH OF 4". STRAW BALES SHALL BE PACED SO THAT THE BINDING TWINE IS ENCOMPASSING THE VERTICAL SIDES OF THE BALE(S).
- TWO (2) WOODEN STAKES SHALL BE USED TO HOLD EACH BALE IN PLACE. WOODEN STAKES SHALL BE 2"x2"x24" (MIN.), WOODEN STAKES SHALL BE DRIVEN A MINIMUM OF 6" INTO THE GROUND.

**MAINTENANCE NOTES**

- FREQUENT OBSERVATIONS AND MAINTENANCE ARE NECESSARY TO MAINTAIN CONTROL MEASURES IN EFFECTIVE OPERATING CONDITION. INSPECTIONS AND CORRECTIVE MEASURES SHOULD BE DOCUMENTED THOROUGHLY.
- ACCUMULATED SEDIMENT MUST BE REMOVED WHEN THE HEIGHT REACHES 1/2 OF THE DESIGN DEPTH OF THE INLET BARRIER.
- STRAW BALES MUST REMAIN UNTIL THE UPSTREAM DISTURBANCE AREA IS STABILIZED.
- PERMANENTLY STABILIZE AREA AROUND INLET AFTER STRAW BALES ARE REMOVED WHEN REMOVAL IS APPROPRIATE.
- STRAW BALES SHALL BE REPLACED IF THEY BECOME HEAVILY SOILED, ROTTEN OR DAMAGED BEYOND REPAIR.

**SUMP INLET PROTECTION**

APPROVED: *[Signature]*

ISSUED: 10/7/19 REVISED: 8/19/2020 DRAWING NO. 900-IP-4

**ROCK SOCK SECTION**

**ROCK SOCK OVERLAP**

**ROCK SOCK PLAN**

**GRADATION TABLE**

	MASS PERCENT PASSING SQUARE MESH SIEVES
	No. 4
2"	100
1 1/2"	90-100
1"	20-55
3/4"	0-15
3/8"	0-5

MATCHES SPECIFICATIONS FOR No. 4 COARSE AGGREGATE FOR CONCRETE PER AASHTO M-43. ALL ROCK SHALL BE FRACTURED FACE, ALL SIDES

**INSTALLATION NOTES**

- CRUSHED ROCK SHALL BE BETWEEN MAX. 1 1/2" (MINUS) IN SIZE WITH A FRACTURED FACE (ALL SIDES) AND SHALL COMPLY WITH GRADATION SHOWN ON THIS SHEET AND MIN. 3/4" CRUSHED ROCK.
- WIRE MESH SHALL HAVE OPENINGS SMALLER THAN THE SMALLEST SIZE ROCK.
- WIRE MESH SHALL BE SECURED USING "HOG RINGS" OR WIRE TIES AT 6" CENTERS ALONG ALL JOINTS AND AT 2" CENTERS ON ENDS OF SOCKS.

**MAINTENANCE NOTES**

- FREQUENT OBSERVATIONS AND MAINTENANCE ARE NECESSARY TO MAINTAIN CONTROL MEASURES IN EFFECTIVE OPERATING CONDITION. INSPECTIONS AND CORRECTIVE MEASURES SHOULD BE DOCUMENTED THOROUGHLY.
- ROCK SOCKS SHALL BE REPLACED IF THEY BECOME HEAVILY SOILED OR DAMAGED BEYOND REPAIR.
- ACCUMULATED SEDIMENT SHALL BE REMOVED WHEN THE DEPTH REACHES 1/2 OF THE HEIGHT OF THE ROCK SOCK.
- ROCK SOCKS ARE TO REMAIN IN PLACE UNTIL DISTURBANCE AREA IS STABILIZED.
- PERMANENTLY STABILIZE AREA AFTER ROCK SOCKS HAVE BEEN REMOVED.

**ROCK SOCK**

APPROVED: *[Signature]*

ISSUED: 10/7/19 REVISED: 8/19/2020 DRAWING NO. 900-RS

**SEDIMENT CONTROL LOG**

**SECTION A-A'**

**SEDIMENT CONTROL LOG JOINTS**

**INSTALLATION NOTES**

- ALL SEDIMENT CONTROL LOGS MUST BE EMBEDDED TO 1/2 OF THE HEIGHT OF THE LOG.
- LARGER DIAMETER SEDIMENT CONTROL LOGS NEED TO BE EMBEDDED DEEPER.
- PLACE SEDIMENT CONTROL LOG AGAINST SIDEWALK OR BACK OF CURB WHEN ADJACENT TO THESE FEATURES.
- SEDIMENT CONTROL LOGS SHALL CONSIST OF STRAW, COMPOST, EXCELSIOR OR COCONUT FIBER, AND SHALL BE FREE FROM ANY NOXIOUS WEED SEEDS OF DEFECTS INCLUDING RIPS, HOLES AND OBVIOUS WEAR.
- IF USING AS SLOPE PROTECTION, INSTALL SEDIMENT CONTROL LOGS ALONG THE CONTOUR.

**MAINTENANCE NOTES**

- FREQUENT OBSERVATIONS AND MAINTENANCE ARE NECESSARY TO MAINTAIN CONTROL MEASURES IN EFFECTIVE OPERATING CONDITION. INSPECTIONS AND CORRECTIVE MEASURES SHOULD BE DOCUMENTED THOROUGHLY.
- ACCUMULATED SEDIMENT MUST BE REMOVED WHEN THE HEIGHT REACHES 1/2 OF THE HEIGHT OF THE SEDIMENT CONTROL LOG.
- PERMANENTLY STABILIZE AREA AFTER SEDIMENT CONTROL LOGS HAVE BEEN REMOVED.

**SEDIMENT CONTROL LOGS**

APPROVED: *[Signature]*

ISSUED: 10/7/19 REVISED: 8/19/2020 DRAWING NO. 900-SCL



# THE COTTAGES AT MESA RIDGE FOUNTAIN MUTUAL IRRIGATION COMPANY IRRIGATION PIPE CONSTRUCTION DRAWINGS

A PORTION OF THE NORTHEAST QUARTER OF SECTION 29, THE SOUTHEAST QUARTER  
OF SECTION 20, THE SOUTHWEST QUARTER OF SECTION 21, & THE NORTHWEST  
QUARTER OF SECTION 28 TOWNSHIP 15 SOUTH, RANGE 65 WEST OF THE 6TH P.M.  
COUNTY OF EL PASO, STATE OF COLORADO

## BASIS OF BEARINGS:

BEARINGS ARE BASED UPON THE NORTH LINE OF THE NORTHEAST QUARTER OF SAID SECTION 29, MONUMENTED AT THE WEST END WITH A 3.25" ALUMINUM CAP IN CONCRETE STAMPED "PLS 4842" AND MONUMENTED AT THE EAST END WITH A #6 REBAR AND 3.25" ALUMINUM CAP STAMPED "PLS 38141" AND ASSUMED TO BEAR S 89°57'13" E A FIELD MEASURED DISTANCE OF 2,652.37 FEET.

## BENCHMARK:

ELEVATIONS ARE BASED UPON THE FOUNTAIN SANITATION DISTRICT POINT N-1, BEING A 2" BRASS CAP IN CONCRETE AT THE NORTHEAST CORNER OF MESA RIDGE PARKWAY AND FOUNTAIN MESA ROAD. (ELEVATION=5750.57 NGVD 29).

## LEGAL DESCRIPTION:

THAT PORTION OF THE NORTHWEST QUARTER OF SECTION 28 AND THE NORTHEAST QUARTER OF SECTION 29, TOWNSHIP 15 SOUTH, RANGE 65 WEST OF THE 6TH P.M., COUNTY OF EL PASO, STATE OF COLORADO, DESCRIBED AS FOLLOWS:

BASIS OF BEARINGS: BEARINGS ARE BASED UPON THE NORTH LINE OF THE NORTHEAST QUARTER OF SAID SECTION 29, MONUMENTED AT THE WEST END WITH A 3.25" ALUMINUM CAP IN CONCRETE STAMPED "PLS 4842" AND MONUMENTED AT THE EAST END WITH A #6 REBAR AND 3.25" ALUMINUM CAP STAMPED "PLS 38141" AND ASSUMED TO BEAR S 89°57'13" E A FIELD MEASURED DISTANCE OF 2,652.37 FEET.


BENCHMARK: ELEVATIONS ARE BASED UPON THE FOUNTAIN SANITATION DISTRICT POINT N-1, BEING A 2" BRASS CAP IN CONCRETE AT THE NORTHEAST CORNER OF MESA RIDGE PARKWAY AND FOUNTAIN MESA ROAD. (ELEVATION=5750.57 NGVD 29).

BEGINNING AT THE NORTHWEST CORNER OF THE NORTHWEST QUARTER OF SAID SECTION 28; THENCE N 89°41'59" E ALONG THE NORTH LINE OF SAID NORTHWEST QUARTER, A DISTANCE OF 117.30 FEET TO A POINT ON THE WEST LINE OF POWERS BOULEVARD AS RECORDED UNDER BOOK 6788 AT PAGE 531 OF THE RECORDS OF THE EL PASO COUNTY CLERK AND RECORDERS OFFICE; THENCE ALONG THE WEST LINE OF SAID POWERS BOULEVARD, 933.14 FEET ALONG THE ARC OF A 1,096.98 FOOT RADIUS CURVE TO THE RIGHT, HAVING A CENTRAL ANGLE OF 48°44'17" AND A CHORD THAT BEARS S 12°56'23" W, 905.26 FEET TO A POINT ON THE NORTHERLY LINE OF THAT PARCEL OF LAND DESCRIBED UNDER BOOK 5506 AT PAGE 1290 OF SAID RECORDS; THENCE OF THE FOLLOWING EIGHT (8) COURSES ALONG SAID NORTHERLY LINES AND EASTERLY LINES OF SAID PARCEL OF LAND DESCRIBED UNDER BOOK 5506 AT PAGE 1290:

- 1) N 84°16'00" W, A DISTANCE OF 198.99 FEET;
  - 2) 46.11 FEET ALONG THE ARC OF A 540.00 FOOT RADIUS TANGENT CURVE TO THE LEFT, HAVING A CENTRAL ANGLE OF 04°53'33" AND A CHORD THAT BEARS N 86°42'46" W, 46.10 FEET;
  - 3) N 89°09'33" W, A DISTANCE OF 124.09 FEET;
  - 4) 100.02 FEET ALONG THE ARC OF A 140.00 FOOT RADIUS TANGENT CURVE TO THE RIGHT, HAVING A CENTRAL ANGLE OF 40°56'07" AND A CHORD THAT BEARS N 68°41'30" W, 97.91 FEET;
  - 5) N 48°13'27" W, A DISTANCE OF 126.77 FEET;
  - 6) 6.49 FEET ALONG THE ARC OF AN 8.00 FOOT RADIUS TANGENT CURVE TO THE RIGHT, HAVING A CENTRAL ANGLE OF 46°29'23" AND A CHORD THAT BEARS N 24°58'45" W, 6.31 FEET;
  - 7) N 01°44'04" W, A DISTANCE OF 137.18 FEET;
  - 8) 87.71 FEET ALONG THE ARC OF A 135.00 FOOT RADIUS TANGENT CURVE TO THE LEFT, HAVING A CENTRAL ANGLE OF 37°13'35" AND A CHORD THAT BEARS N 20°21'02" W, 86.18 FEET TO THE SOUTHWEST CORNER OF LOT 15, BLOCK 3, SUNRISE RIDGE SUBDIVISION FILING NO. 8 AS RECORDED UNDER RECEPTION NO. 1722613 OF SAID RECORDS;
- THENCE THE FOLLOWING TWO (2) COURSES ALONG THE EASTERLY LINE OF SAID SUNRISE RIDGE SUBDIVISION FILING NO. 8: 1) 511.39 FEET ALONG THE ARC OF A 1,034.60 FOOT RADIUS CURVE TO THE LEFT, HAVING A CENTRAL ANGLE OF 28°19'14" AND A CHORD THAT BEARS N 58°13'41" E, 506.20 FEET TO A POINT OF COMPOUND CURVATURE;
- 2) 283.12 FEET ALONG THE ARC OF A 500.00 FOOT RADIUS CURVE TO THE LEFT, HAVING A CENTRAL ANGLE OF 32°26'36" AND A CHORD THAT BEARS N 27°50'47" E, 279.35 FEET TO A POINT ON THE NORTH LINE OF SAID NORTHEAST QUARTER;
- THENCE N 89°57'13" E ALONG THE NORTH LINE OF SAID NORTHEAST QUARTER, A DISTANCE OF 115.21 FEET TO THE POINT OF BEGINNING.

CONTAINING A CALCULATED AREA OF 445,104 SQUARE FEET (10.218 ACRES) OF LAND, MORE OR LESS.

TO BE PLATTED AS "COTTAGES AT MESA RIDGE"

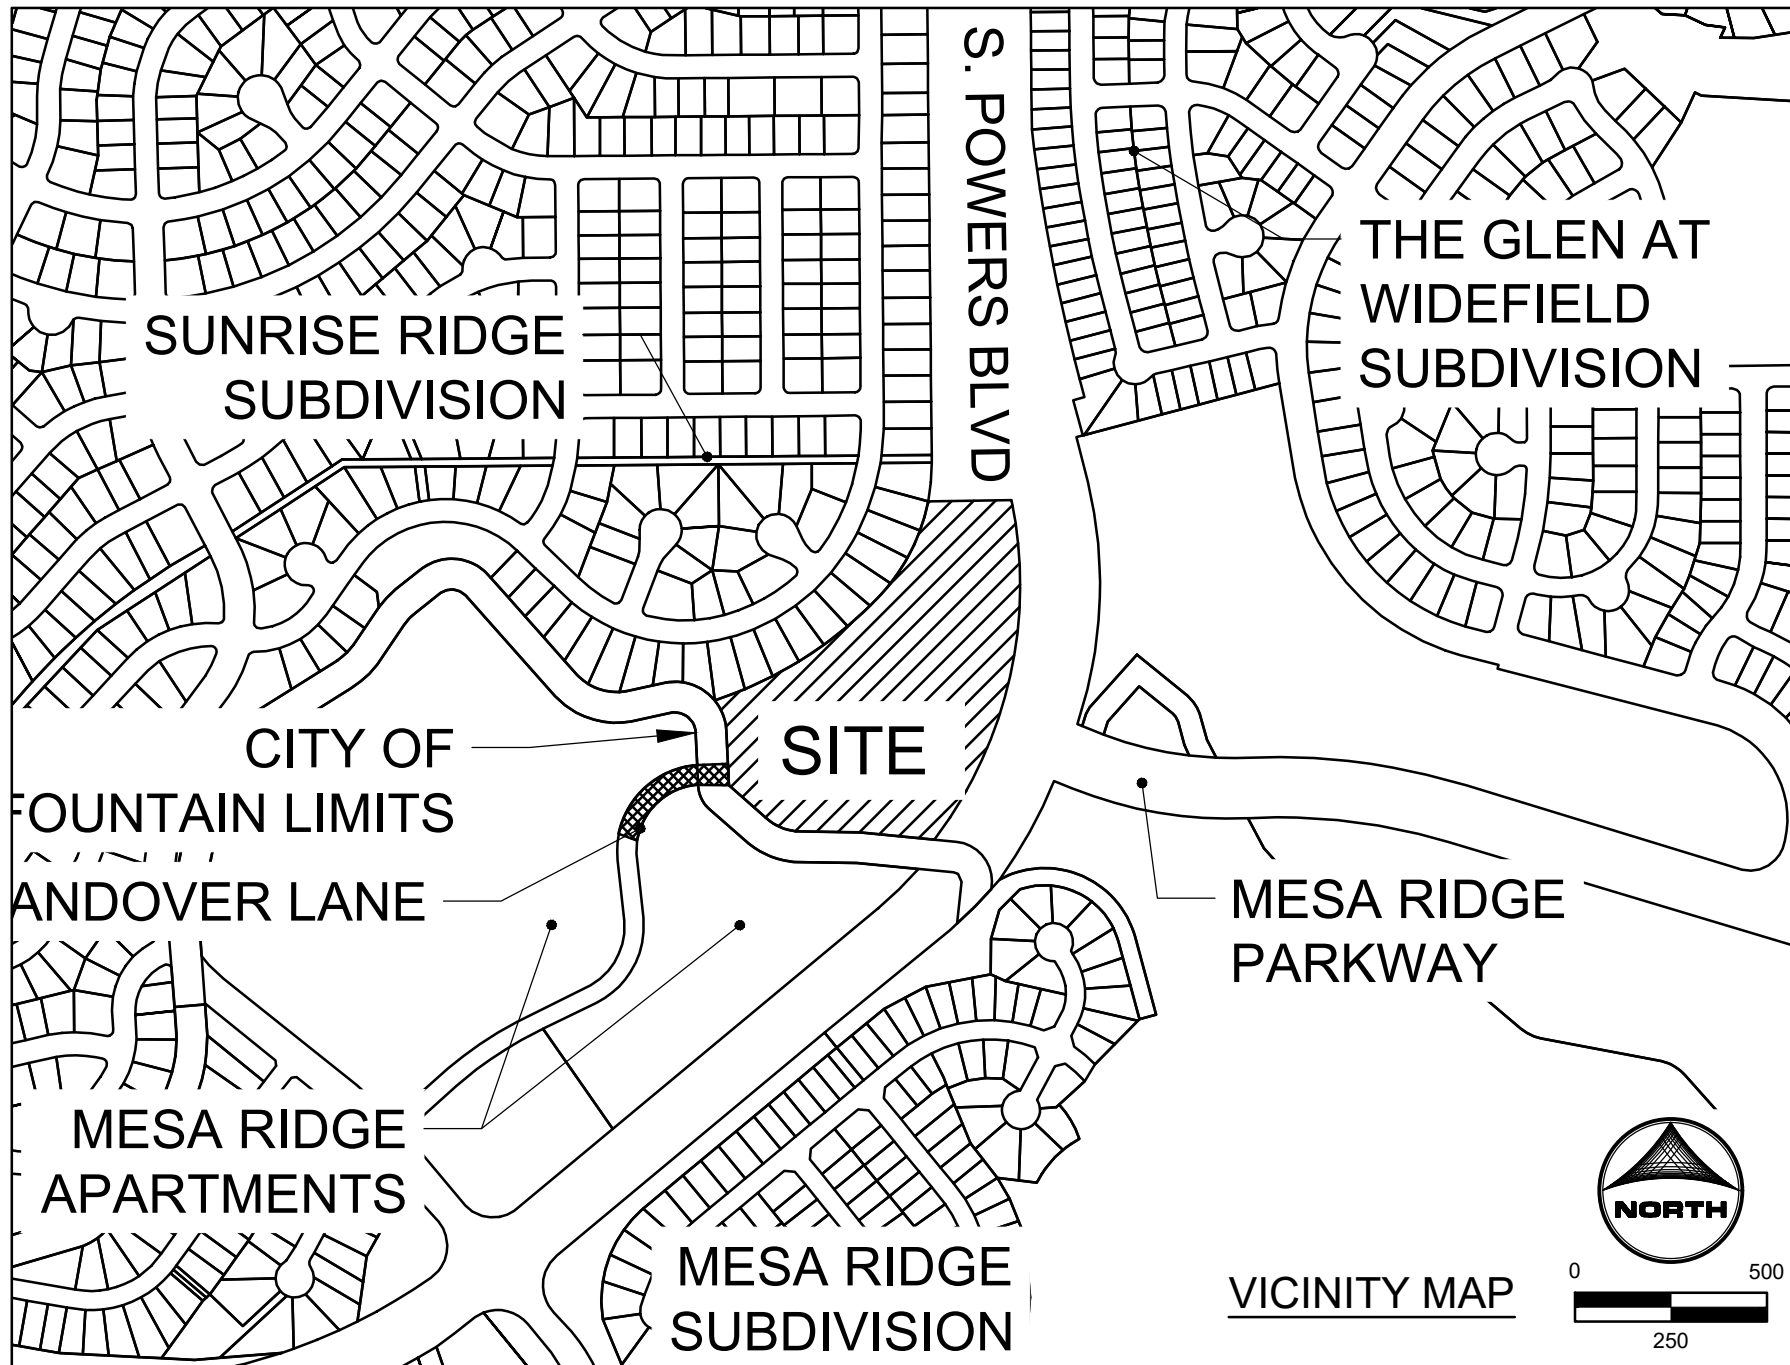

## SHEET INDEX:

- 1 - COVER SHEET
- 2 - STORM PLAN
- 3 - STORM SEWER - PLAN & PROFILE
- 4 - CONSTRUCTION DETAILS

## GENERAL NOTES:

1. ALL CONSTRUCTION WORK SHALL BE COORDINATED WITH FMIC PERSONNEL DURING THE SUMMER MONTHS TO NOT INTERFERE WITH OPERATION OF THE DITCH.
2. THE FOLLOWING ITEMS PROPOSED WITHIN THE FMIC RIGHT OF WAY SHALL BE PERMANENTLY MAINTAINED BY THE APPLICANT:
  - A. PRIVATE STORM SEWER
  - B. EMERGENCY ACCESS ROAD
  - C. PRIVATE ACCESS ROAD (LANDOVER LANE EXTENSION SITE ENTRANCE)
  - D. LANDSCAPING AND IRRIGATION ITEMS
  - E. FENCES & GATES
3. THE FOLLOWING ITEMS PROPOSED WITHIN THE FMIC RIGHT OF WAY SHALL BE PERMANENTLY MAINTAINED BY THE NOTED AGENCIES NOTED:
  - A. SANITARY SEWER WITHIN LANDOVER LANE (FOUNTAIN SANITATION DISTRICT)
  - B. WATER LINE WITHIN LANDOVER LANE (EXISTING WATER LINE SUBJECT TO PRIOR AGREEMENTS WITH WIDEFIELD WATER AND SANITATION DISTRICT)

## OWNER STATEMENT:

THE UNDERSIGNED OWNER/DEVELOPER AGREES TO INSTALL THE PROPOSED FACILITIES AS DEPICTED ON THESE PLANS. ANY CHANGES REQUIRED DUE TO FIELD CONDITIONS SHALL BE BROUGHT TO THE ATTENTION OF FMIC FOR THEIR REVIEW AND COMMENT.

OWNER/DEVELOPER \_\_\_\_\_

TITLE: \_\_\_\_\_

ADDRESS: \_\_\_\_\_

\_\_\_\_\_

\_\_\_\_\_

DATE: \_\_\_\_\_

## ENGINEER'S STATEMENT

THIS STORM SEWER PLAN WAS PREPARED UNDER MY DIRECT SUPERVISION AND IS CORRECT TO THE BEST OF MY KNOWLEDGE AND BELIEF. I ACCEPT RESPONSIBILITY FOR ANY LIABILITY CAUSED BY ANY NEGLIGENT ACTS, ERROR OR OMISSIONS ON MY PART IN PREPARATION OF THIS STORM SEWER PLAN.


KEN M. HUHN, P.E.  
KHUHN@HRGREEN.COM  
COLORADO P.E. 0054022

DATE

NOT FOR CONSTRUCTION

DRAWN BY: NQJ	JOB DATE: 4/12/2022	BAR IS ONE INCH ON OFFICIAL DRAWINGS.
APPROVED: KMH	JOB NUMBER: 200541	0" = 1"
CAD DATE: 8/22/2022		IF NOT ONE INCH, ADJUST SCALE ACCORDINGLY.
CAD FILE: J:\2020\200541\CAD\DWG\IC\CD\FM\IC\FM\IC_Cover		

NO.	DATE	BY	REVISION DESCRIPTION

HRGreen

HR GREEN - COLORADO SPRINGS

7222 COMMERCE CENTER DR SUITE 220  
COLORADO SPRINGS CO 80919

PHONE: 719.300.4140 TOLL FREE: 800.728.7805  
FAX: 844.273.1057 | HRGreen.com

THE COTTAGES AT MESA RIDGE  
GOODWIN KNIGHT  
EL PASO COUNTY, COLORADO






IRRIGATION PIPE CONSTRUCTION DRAWINGS  
COVER SHEET

SHEET  
CV

1



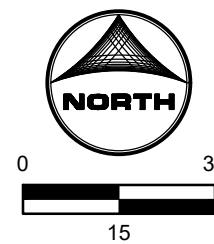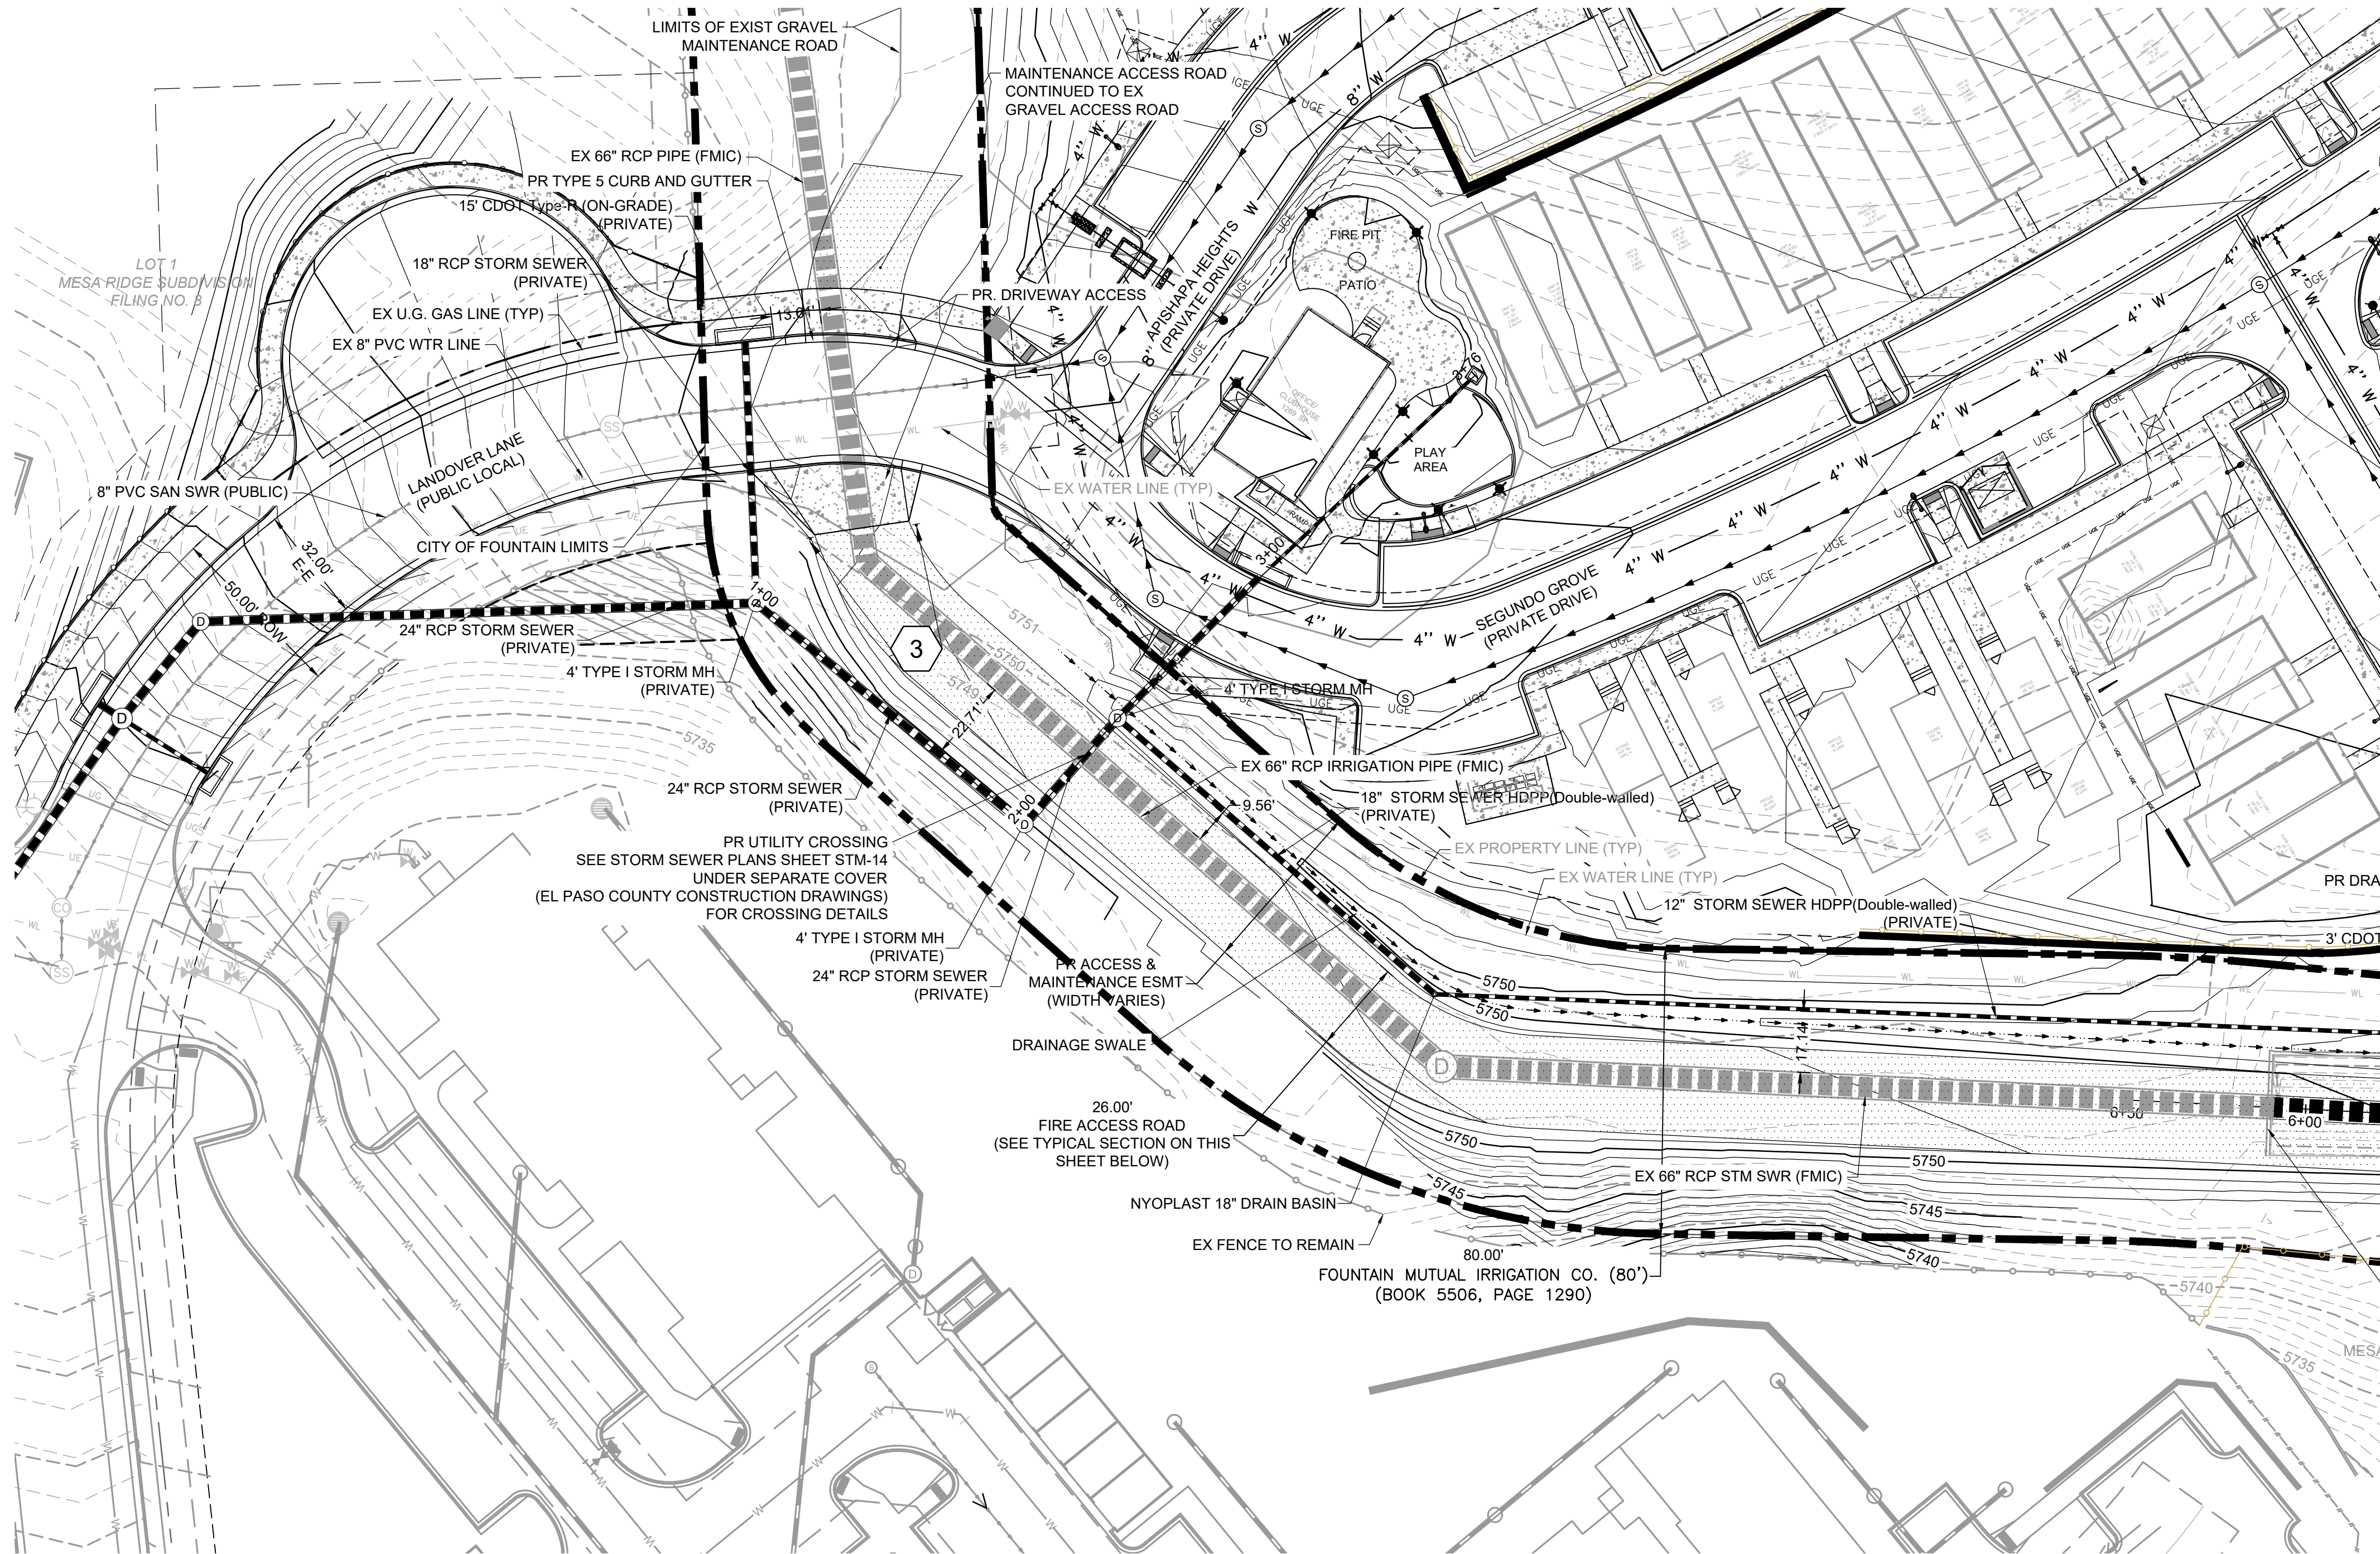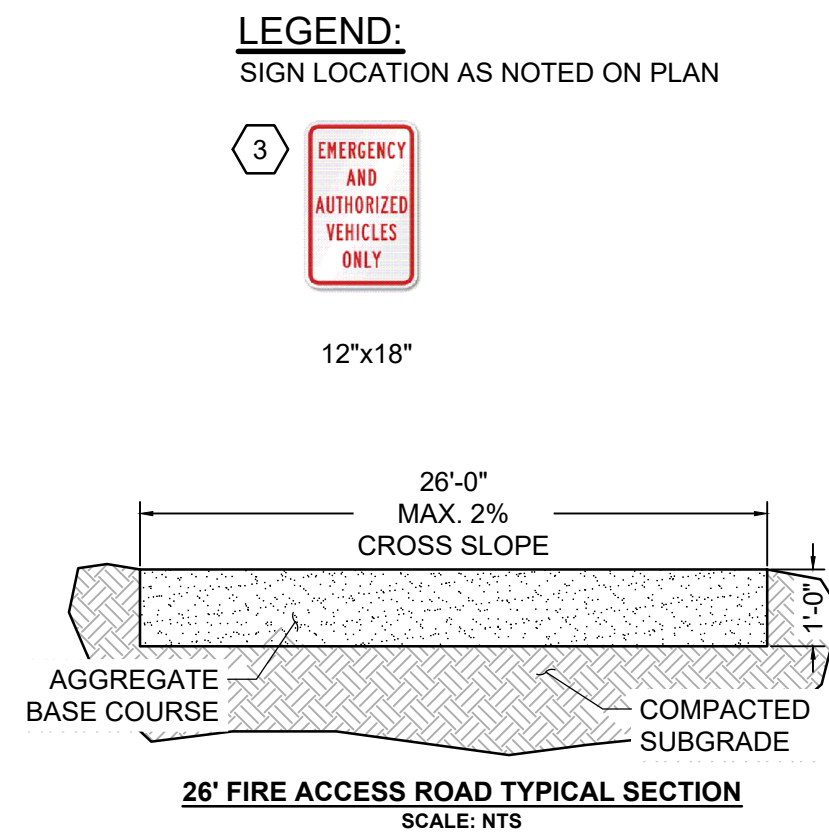


NOT FOR CONSTRUCTION


DRAWN BY: NQJ	JOB DATE: 8/22/2022	BAR IS ONE INCH ON OFFICIAL DRAWINGS.
APPROVED: KMH	JOB NUMBER: 200541	0" 1"
CAD DATE: 8/22/2022		IF NOT ONE INCH, ADJUST SCALE ACCORDINGLY.
CAD FILE: J:\2020\200541\CAD\Drawings\CD\FMIC\FMIC_Storm		

NO.	DATE	BY	REVISION DESCRIPTION

**HRGreen**

HR GREEN - COLORADO SPRINGS  
7222 COMMERCE CENTER DR SUITE 220  
COLORADO SPRINGS CO 80919  
PHONE: 719.300.4140 TOLL FREE: 800.728.7805  
FAX: 844.273.1057 | HRGreen.com

**THE COTTAGES AT MESA RIDGE**  
**GOODWIN KNIGHT**  
**EL PASO COUNTY, COLORADO**




**IRRIGATION PIPE CONSTRUCTION DRAWINGS**  
**STORM PLAN**

**SHEET**  
**STM**


**2**



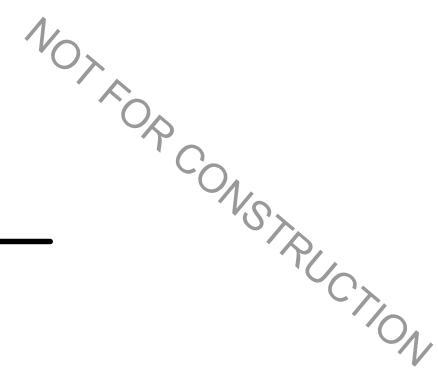


NO.	DATE	BY	REVISION DESCRIPTION

THE COTTAGES AT MESA RIDGE  
GOODWIN KNIGHT  
EL PASO COUNTY, COLORADO

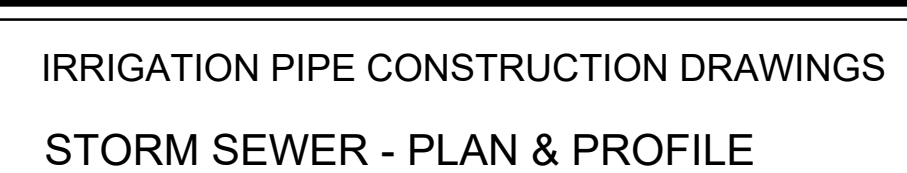


SHEET STM	3
--------------	---




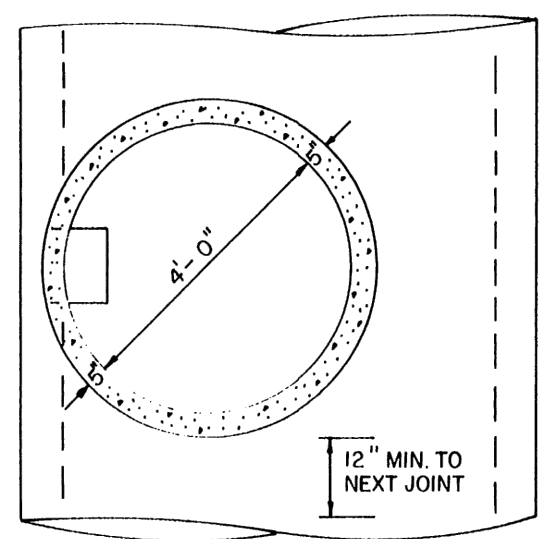


PLAN VIEW  
SCALE 3/8" = 1'-0"

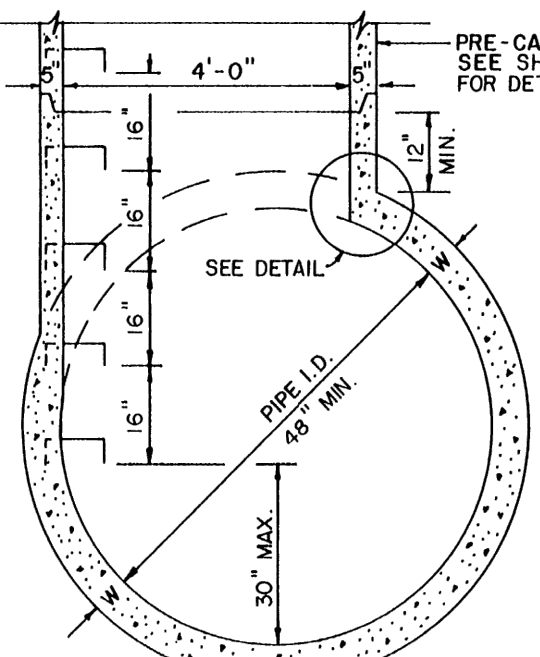

SECTION VIEW  
SCALE 3/8" = 1'-0"

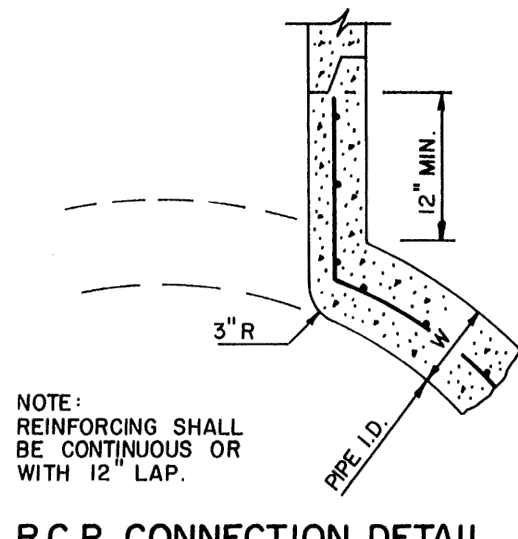


R.C.P. CONNECTION DETAIL  
SCALE 3/4" = 1'-0"

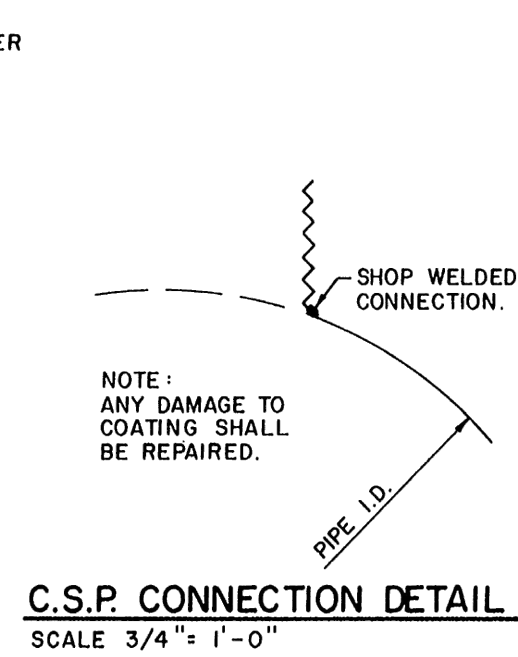

C.S.P. CONNECTION DETAIL  
SCALE 3/4" = 1'-0"

NOTES:

- Type III manholes shall be used only with approval by the city engineer and only when all of the following conditions are met:
  - Pipe is 48" or larger inside diameter.
  - No change in pipe size.
  - No change in pipe material.
  - No change in horizontal alignment.
  - Slope is flat and continuous.
- Type III manholes shall be fabricated by the manufacturer/supplier and delivered to the site as a single unit. Field fabrication shall not be permitted.
- Either ladder or steps shall be installed. Lowest step shall be a maximum of 30" above the invert of the pipe.

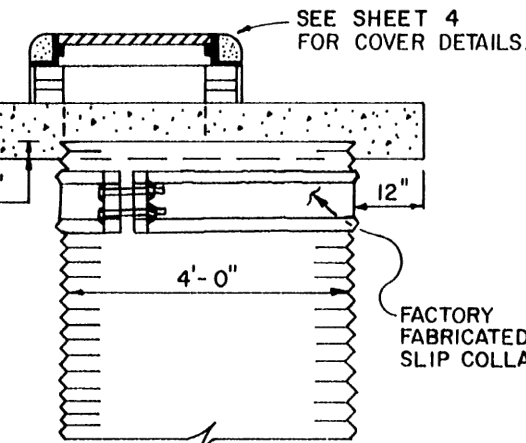


SPECIAL LID FOR USE WITH C.S.P. RISER  
SCALE 3/8" = 1'-0"

CITY OF COLORADO SPRINGS


STORM SEWER MANHOLE-TYPE III

APPROVED BY: *Ray R. Haynes*  
CITY ENGINEER  
SCALE: DATE: DRAWN: SHEET: D-20C  
AS SHOWN JAN. 89 PL. B 3 OF 4

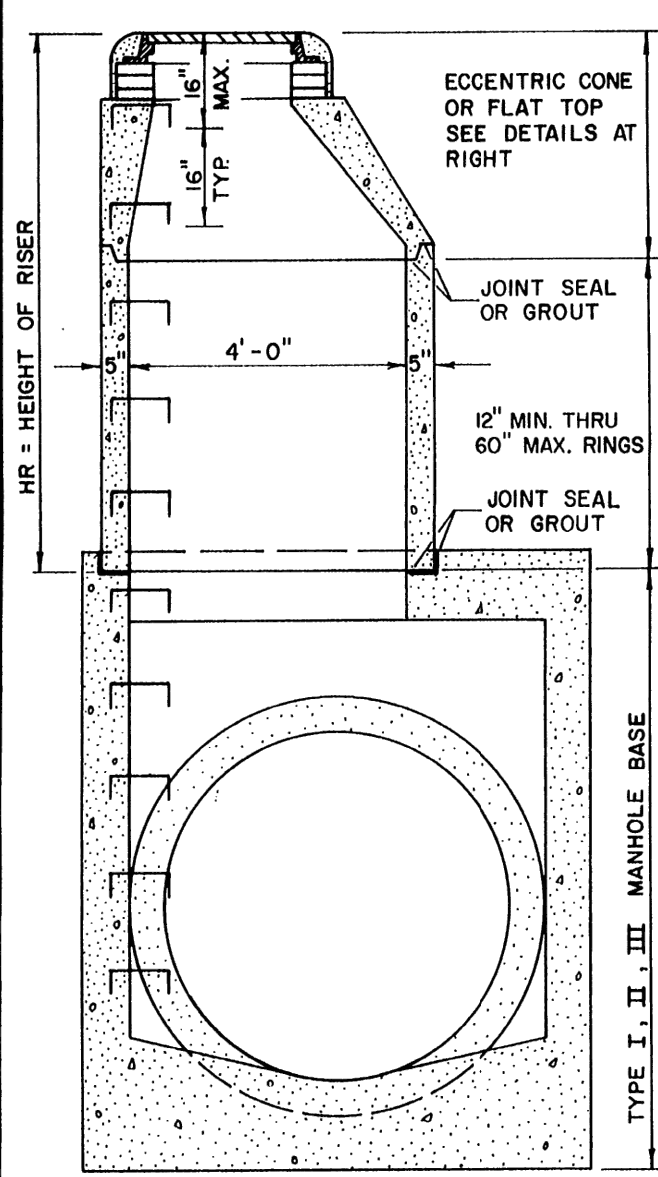


SECTION VIEW  
SCALE 3/8" = 1'-0"

STORM SEWER MANHOLE PRECAST RISER

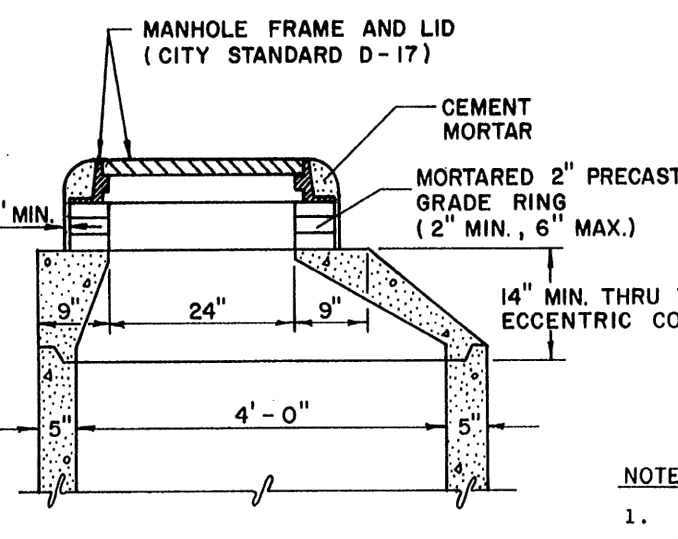

ECCENTRIC CONE TOP  
(FOR HR > 3') SCALE: 1/2" = 1'-0"

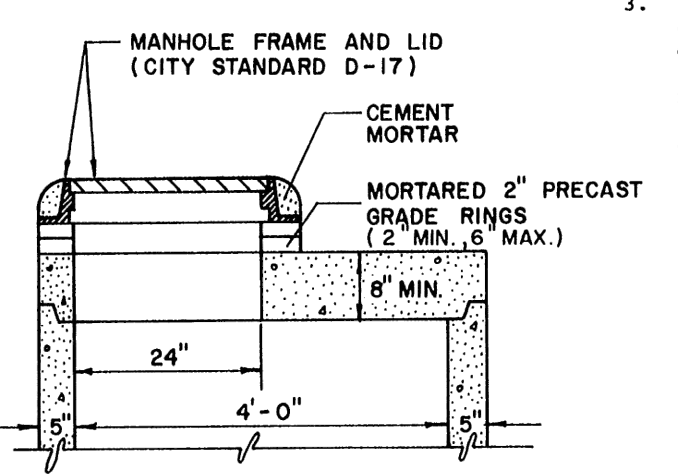

ECCENTRIC FLAT TOP  
(FOR HR < 3') SCALE: 1/2" = 1'-0"


NOTES:

- All work shall be done in accordance with the standard and supplemental specifications applicable to the project.
- Precast risers shall conform to ASTM C-478.
- Steps shall be installed when manhole depth exceeds 30". Steps shall be cast iron or extruded aluminum, 1000 lb. capacity, 12" wide with non-skid grooves and drop front on safety noses, in accordance with approved OSHA requirements.


CITY OF COLORADO SPRINGS

STORM SEWER-COVER & RISER

APPROVED BY: *Ray R. Haynes*  
CITY ENGINEER  
SCALE: DATE: DRAWN: SHEET: D-20D  
AS SHOWN JAN. 89 PL. B 1 OF 4

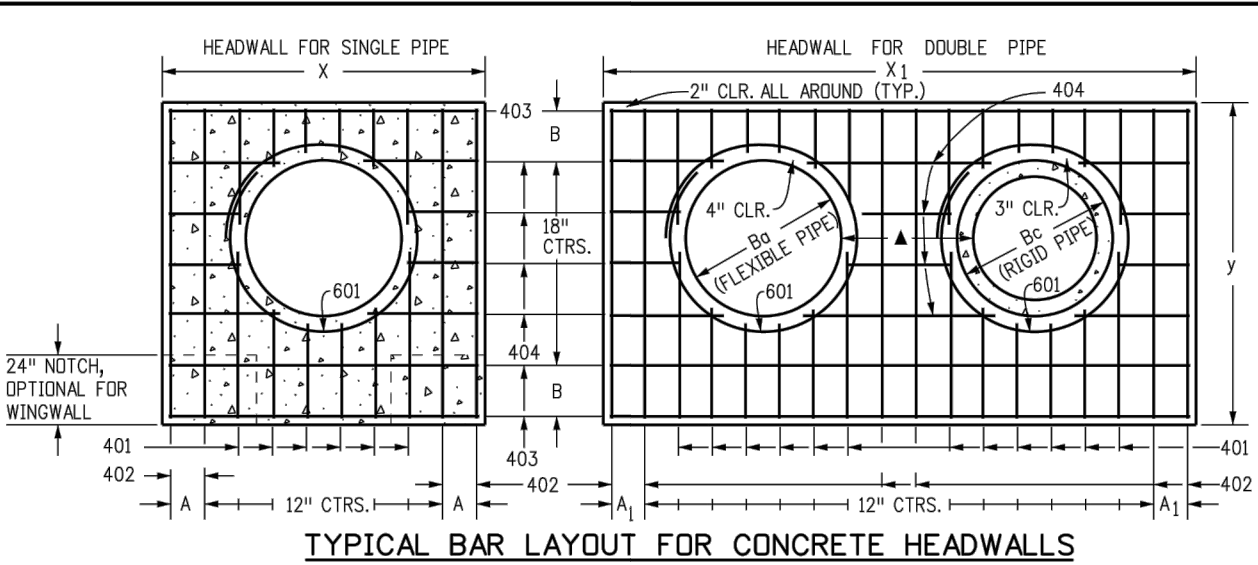


TYPICAL BAR LAYOUT FOR CONCRETE HEADWALLS

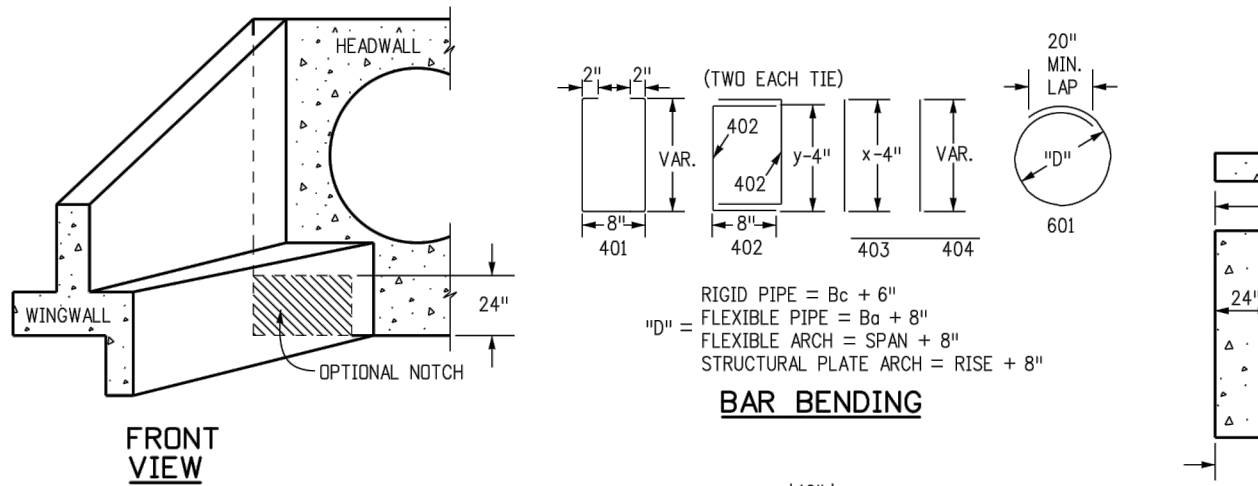


FRONT VIEW

TOP VIEW

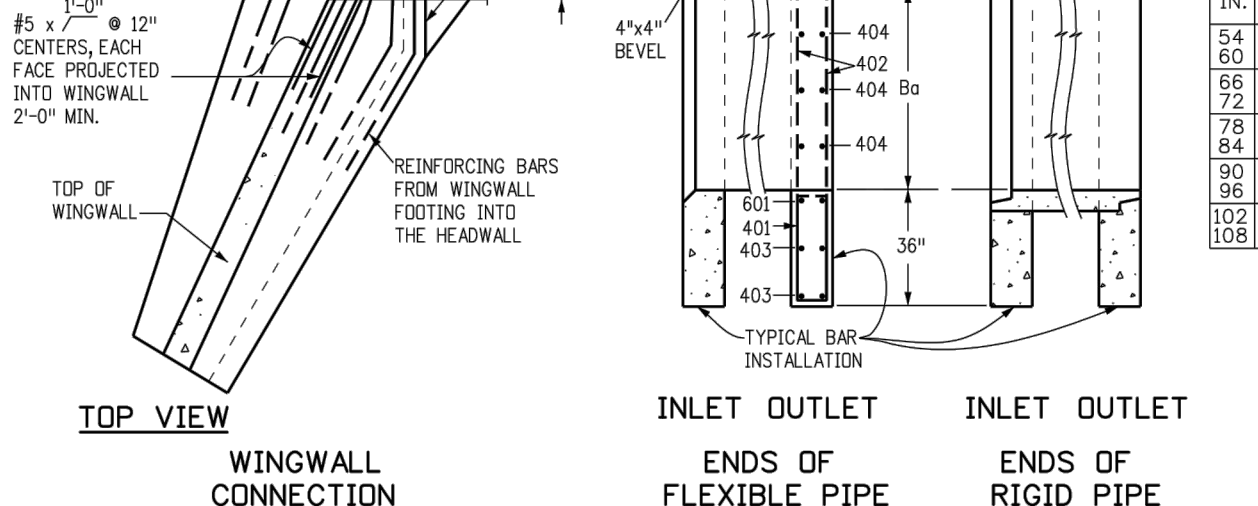


WINGWALL CONNECTION

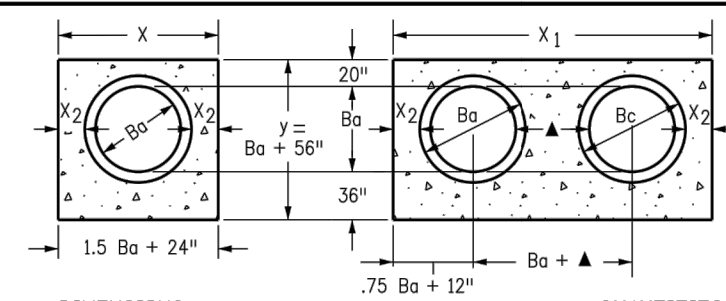


HEADWALL FOR RIGID ROUND PIPE

DIMENSIONS										QUANTITIES									
B <sub>o</sub>	X	A	X <sub>1</sub>	A <sub>1</sub>	Y	B	CONCRETE	STEEL		B <sub>o</sub>	X	A	X <sub>1</sub>	A <sub>1</sub>	Y	B	CONCRETE	STEEL	
IN.	IN.	IN.	IN.	IN.	IN.	IN.	CU. YD.	DBL. LBS.		IN.	IN.	IN.	IN.	IN.	IN.	IN.	CU. YD.	DBL. LBS.	
54	65	8-9	8 1/2	15-6	7	9-2	17	20	2.12	3.55	209	364							
60	72	9-6	9	16-6	10	9-8	11	21	2.35	3.99	236	414							
66	79	10-3	11 1/2	18-6	7	10-2	14	22	2.60	4.44	249	453							
72	86	11-0	12	20-0	10	10-8	17	23	2.85	4.91	270	476							
78	93	11-9	12 1/2	21-3	11	11-2	11	24	3.11	5.29	306	527							
84	100	12-6	13 1/2	22-6	11	11-8	14	25	3.38	5.68	333	572							
90	107	13-3	14 1/2	23-9	12	12-2	17	26	3.66	6.08	358	603							
96	114	14-0	15	25-0	10	12-8	11	27	3.94	6.48	379	649							
102	121	14-9	15 1/2	26-3	11	13-2	14	28	4.24	6.89	400	664							
108	128	15-6	16 1/2	27-6	12	13-8	17	29	4.54	7.30	424	707							

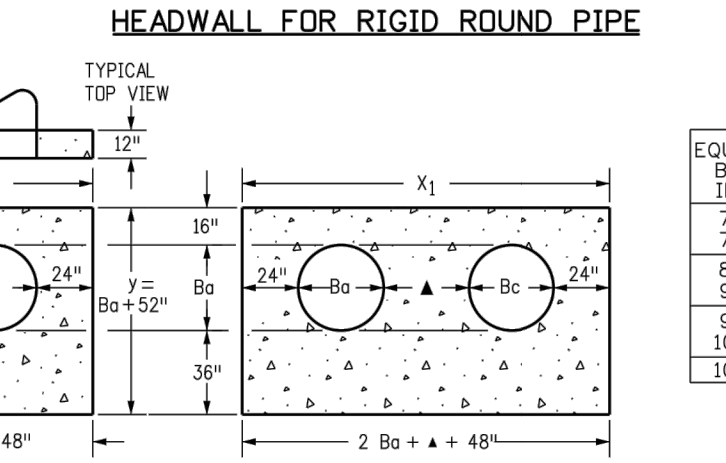


HEADWALL FOR FLEXIBLE ROUND PIPE

DIMENSIONS										QUANTITIES									
B <sub>o</sub>	X	A	X <sub>1</sub>	A <sub>1</sub>	Y	B	CONCRETE	STEEL		B <sub>o</sub>	X	A	X <sub>1</sub>	A <sub>1</sub>	Y	B	CONCRETE	STEEL	
IN.	IN.	IN.	IN.	IN.	IN.	IN.	CU. YD.	DBL. LBS.		IN.	IN.	IN.	IN.	IN.	IN.	IN.	CU. YD.	DBL. LBS.	
54	8-6	7	15-3	11 1/2	8-10	15	2.19	3.81	211	358									
60	9-0	10	16-6	12	9-10	16	2.38	4.25	217	396									
66	9-6	7	17-9	13 1/2	9-10	17	2.58	4.70	252	454									
72	10-0	10	19-0	14 1/2	10-4	18	2.78	5.17	255	472									
78	10-6	7	20-0	15 1/2	10-10	19	2.98	5.56	275	499									
84	11-0	10	21-0	16 1/2	11-4	20	3.19	5.95	297	553									
90	11-6	7	22-0	17 1/2	11-10	21	3.40	6.36	317	517									
96	12-0	10	23-0	18 1/2	12-4	22	3.62	6.79	320	527									
102	12-6	7	24-0	19 1/2	12-10	23	3.84	7.21	364	663									
108	13-0	10	25-0	20 1/2	13-4	24	4.06	7.63	362	678									

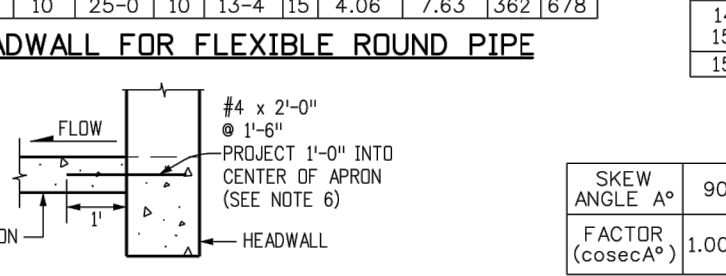

HEADWALL FOR STRUCTURAL PLATE ARCH

- GENERAL NOTES
- CONCRETE SHALL BE CLASS B.
  - HEADWALL SHALL BE PERPENDICULAR TO THE PIPE & UNLESS OTHERWISE SHOWN ON THE PLANS, TABULATED DIMENSIONS AND QUANTITIES MUST BE ADJUSTED FOR SKEWED INSTALLATIONS.
  - FOR WINGWALL DETAILS, SEE STANDARD PLAN M-601-20.
  - VOLUME OCCUPIED BY PIPE HAS BEEN DEDUCTED FROM STEEL AND CONCRETE QUANTITIES.
  - EXPOSED CONCRETE CORNERS SHALL BE CHAMFERED 3/4" IN.
  - ALL REINFORCING BARS SHALL HAVE A 2 IN. MINIMUM CLEARANCE.
- ▲ WHEN TWO OR MORE PIPES ARE LAID SIDE BY SIDE, THEY SHALL BE PLACED SO THAT THE ADJACENT PIPES WILL BE 1/2 INSIDE DIAMETER APART, OR 1/2 INSIDE SPAN APART, OR 3 FT. APART (INCLUDING WALL THICKNESS), WHICHEVER IS LESS.
- ADD 0.69 x (X OR X<sub>1</sub>) (LBS.) WHEN APRON IS REQUIRED.

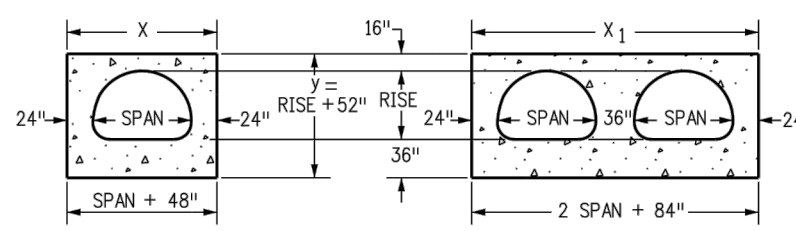

HEADWALL FOR FLEXIBLE PIPE ARCH

DIMENSIONS										QUANTITIES			
EQUIV.	SPAN	RISE	X		A <sub>1</sub>	Y		B	CONCRETE		STEEL		
			FT.	IN.		FT.	IN.		CU. YD.	DBL. CU. YD.	SQ. LBS.	DBL. LBS.	
72	81	59	10-9	8½	20-6	7	9-3	17½	2.72	5.10	250	467	
78	87	63	11-3	11½	21-6	7	9-7	18½	2.85	5.34	275	531	
84	93	67	11-9	11½	22-10	9	9-11	19½	3.08	5.79	290	547	
90	103	71	12-7	12½	24-2	11	10-3	15	3.30	6.21	321	591	
96	112	75	13-4	12	25-8	8	10-7	16½	3.52	6.65	314	606	
102	117	79	13-9	14½	26-6	7	10-11	17½	3.63	6.86	356	672	
108	128	83	14-8	15½	28-4	12	11-3	18½	3.96	7.51	376	699	

DIMENSIONS										QUANTITIES			
SPAN IN.	RISE FT.-IN.	X FT.-IN.	A IN.	X <sub>1</sub> FT.-IN.	A <sub>1</sub> IN.	FT.-Y. IN.	B IN.	CONCRETE		STEEL ■			
								SGL CU. YD.	DBL CU. YD.	SGL LBS.	DBL LBS.		
66	4-7	10-1	10½	19-2	11	8-11	15½	2.52	4.70	232	424		
75	5-1	11-0	11½	21-0	10	9-5	16½	2.80	5.25	282	509		
84	5-7	11-11	12½	22-10	9	9-11	17½	3.08	5.79	291	540		
93	6-1	12-10	13½	24-8	8	10-5	18½	3.36	6.33	309	622		
102	6-7	13-9	14½	26-6	7	10-11	19½	3.63	6.86	379	673		
111	7-1	14-11	15½	28-10	9	11-5	20½	4.05	7.67	377	711		
120	7-7	15-10	16½	30-8	8	11-11	21½	4.36	8.28	395	731		
132	8-4	16-10	17½	32-8	8	12-8	22½	4.75	9.03	441	839		
141	8-9	18-1	18½	35-2	11	13-1	23½	5.17	9.86	448	931		
150	9-3	19-4	19½	37-8	8	13-7	24½	5.59	10.88	490	953		
159	9-10	19-10	20½	38-8	8	14-2	25½	5.89	11.25	534	1019		

DIMENSIONS										QUANTITIES											
EQUIV.	SPAN	RISE	X	A	X <sub>1</sub>	A <sub>1</sub>	Y	B	CONCRETE	STEEL	EQUIV.	SPAN	RISE	X	A	X <sub>1</sub>	A <sub>1</sub>	Y	B	CONCRETE	STEEL
IN.	IN.	IN.	IN.	IN.	IN.	IN.	IN.	IN.	CU. YD.	DBL. LBS.	IN.	IN.	IN.	IN.	IN.	IN.	IN.	IN.	IN.	CU. YD.	DBL. LBS.
-0	5-1	11-0	10	21-0	10	9-5	9 1/2	2.80	5.25	282	509										
-1	5-7	11-11	9 1/2	22-10	9	9-11	12 1/2	3.08	5.79	291	540										
-10	6-1	12-10	9	24-8	8	10-5	15 1/2	3.36	6.33	309	622										
-9	6-7	13-9	8 1/2	26-6	7	10-11	9 1/2	3.63	6.86	379	673										
-9-11	7-1	14-11	9 1/2	28-10	9	11-5	12 1/2	4.05	7.67	377	711										
-10	7-7	15-10	9	30-8	8	11-11	15 1/2	4.36	8.28	395	731										
-10-10	8-4	16-10	9	32-8	8	12-8	11	4.75	9.03	441	839										
-4-1	8-9	18-1	10 1/2	35-2	11	13-1	13 1/2	5.17	9.86	448	931										
-4-4	9-3	19-4	12	37-8	8	13-7	16 1/2	5.69	10.88	490	953										
-4-10	9-10	19-10	12 1/2	38-8	8	14-2	17 1/2	5.89	11.25	534	1019										

-10	9-10	19-10	9	38-8	8	14-2	11	5.89	11.25	534	1019
HEADWALL FOR STRUCTURAL PLATE ARCH											
	80	75	70	65	60	55	50	45	40	35	30
4	1.015	1.035	1.064	1.103	1.155	1.221	1.305	1.414	1.556	1.743	2.000