


please label use of each suite

Proposed Floor Plan
Scale: 1/8" = 1'-0"

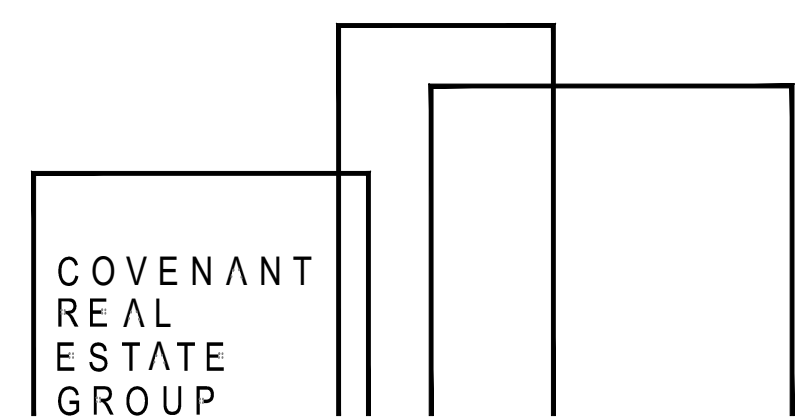

2460 PASEO VERDE PKWY #145 HENDERSON, NV 89074 | 714.845.8500

Conceptual Floor Plan Falcon Marketplace- Lot 7

NWC E. Woodmen Road & Meridian Road
Falcon, CO 80831

A-2 FLOOR PLAN

August 16, 2021 SCALE: 1/8" = 1'-0"

LOCATION- BOX/2021/ COVENANT/ FALCON /CITY / PLANNING /1ST SUB/FLOOR PLAN
The plans, ideas, arrangements and designs indicated or represented by this drawing are owned by, and are the property of COVENANT GROUP, and were created and developed solely for use on, and in connection with this specific project, and shall not be used, in whole or in part, for any purpose for which they were not originally intended without written permission from COVENANT GROUP ©2021.