

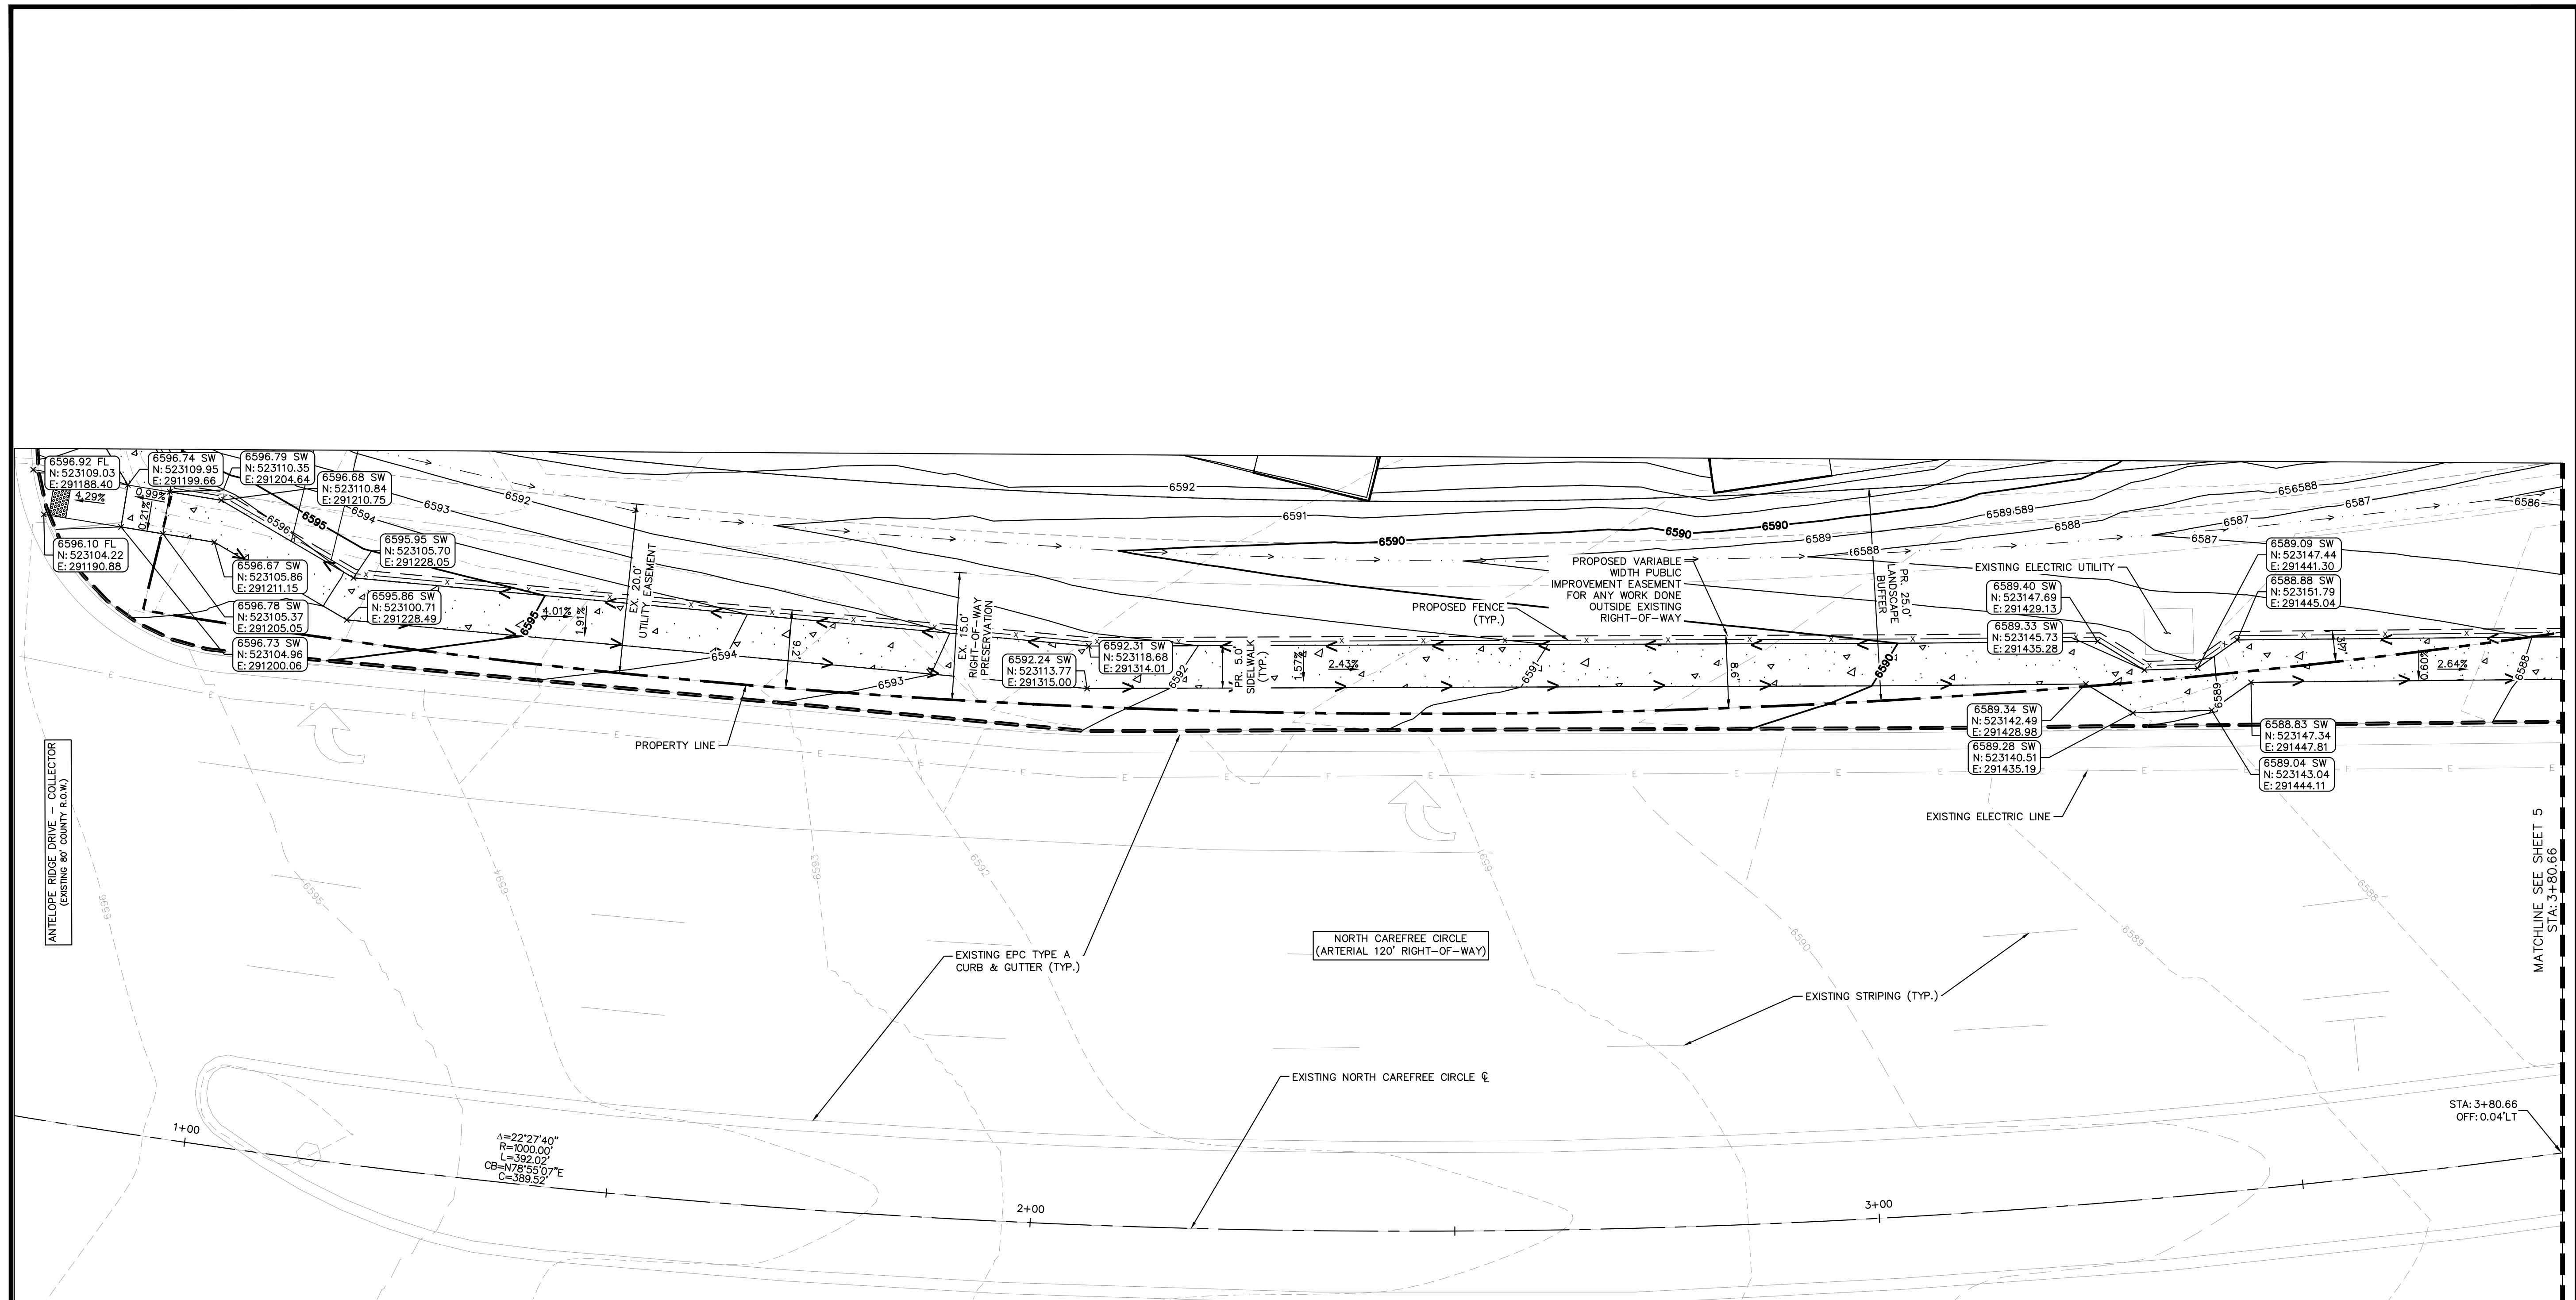


K:\COS_LA\196160000 - Windemere\CADD\PlanSheets\SDP_P.dwg Evans, Wyatt 3/30/2026 8:25 AM

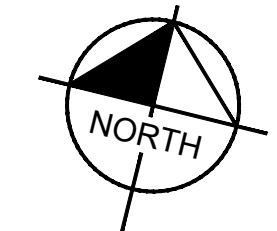

PROPOSED SIDEWALK (NORTH CAREFREE CIRCLE)

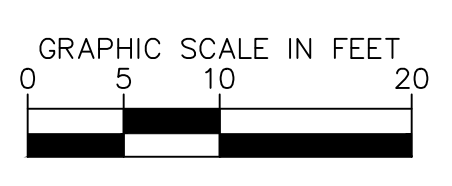

LEGEND

---	PROPERTY LINE
W	EXISTING WATER LINE
G	EXISTING GAS LINE
OE	EXISTING OVERHEAD ELECTRIC
E	EXISTING ELECTRIC UTILITY
SS	EXISTING SANITARY SEWER
---	EXISTING STORM PIPE
W	PROPOSED WATER LINE
S	PROPOSED SANITARY SEWER
X	PROPOSED FENCE

NO.	REVISION	BY	DATE	APPR

Kimley»Horn
 2026 KIMLEY-HORN AND ASSOCIATES, INC.
 2 North Nevada Avenue, Suite 900
 Colorado Springs, Colorado 80903 (719) 453-0180


DESIGNED BY: NMB
 DRAWN BY: DPM
 CHECKED BY: NMB
 DATE: 02/25/2026

WINDERMERE FILING NO. 2
 SITE DEVELOPMENT PLAN
 EL PASO COUNTY, COLORADO
 PUBLIC IMPROVEMENTS PLAN



PRELIMINARY
 FOR REVIEW ONLY
 NOT FOR
 CONSTRUCTION

PROJECT NO.
 196160000
 SHEET
4

K:\COS_LA\196160000 - Windemere\CADD\PlanSheets\SDP_P\dwg Evans, Wyatt 3/30/2026 8:25 AM

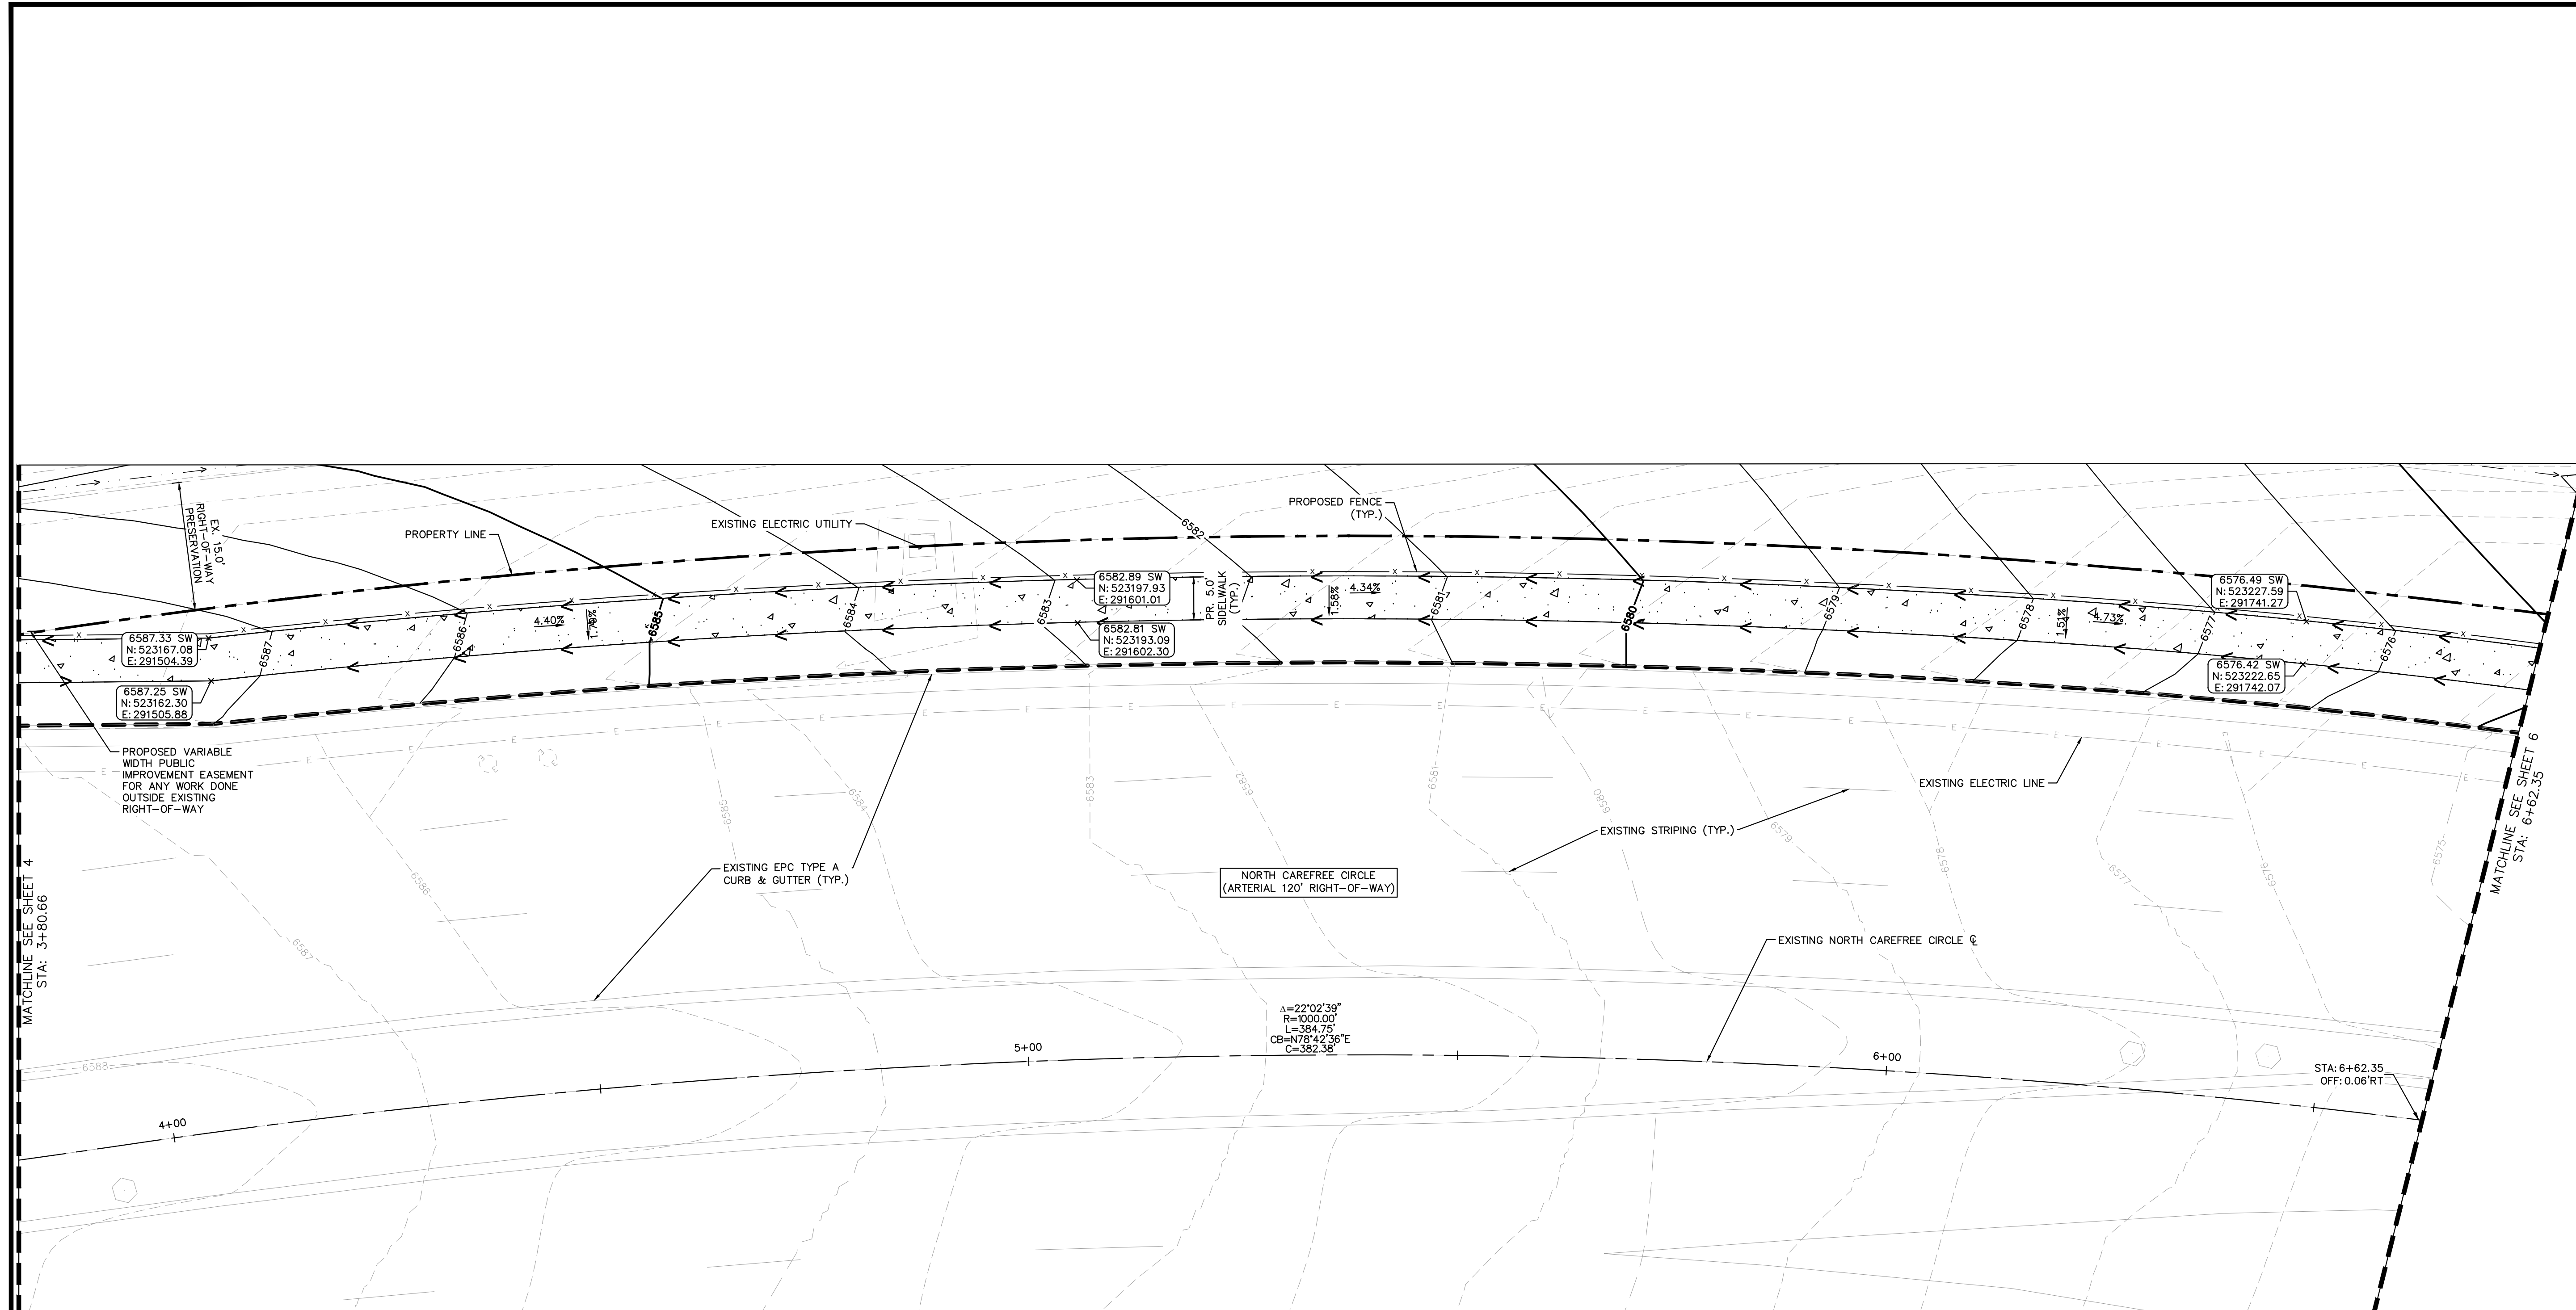

PROPOSED SIDEWALK
(NORTH CAREFREE CIRCLE)

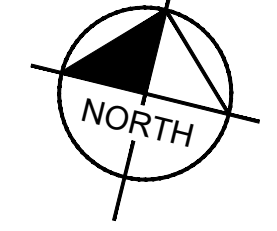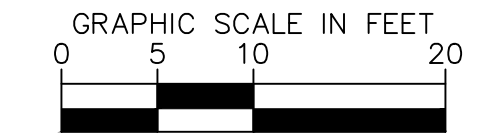

LEGEND

---	PROPERTY LINE
W	EXISTING WATER LINE
G	EXISTING GAS LINE
OE	EXISTING OVERHEAD ELECTRIC
E	EXISTING ELECTRIC UTILITY
SS	EXISTING SANITARY SEWER
---	EXISTING STORM PIPE
w	PROPOSED WATER LINE
s	PROPOSED SANITARY SEWER
x	PROPOSED FENCE

NO.	REVISION	BY	DATE	APPR

Kimley»Horn
 2026 KIMLEY-HORN AND ASSOCIATES, INC.
 2 North Nevada Avenue, Suite 900
 Colorado Springs, Colorado 80903 (719) 453-0180


DESIGNED BY: NMB
 DRAWN BY: DPM
 CHECKED BY: NMB
 DATE: 02/25/2026

WINDERMERE FILING NO. 2
 SITE DEVELOPMENT PLAN
 EL PASO COUNTY, COLORADO
 PUBLIC IMPROVEMENTS PLAN


PRELIMINARY
 FOR REVIEW ONLY
 NOT FOR
 CONSTRUCTION

PROJECT NO.
196160000
 SHEET
5


K:\COS_LA\196160000 - Windemere\CADD\PlanSheets\SDP\PIP_DET.dwg Evans, Wyatt 3/30/2026 8:25 AM

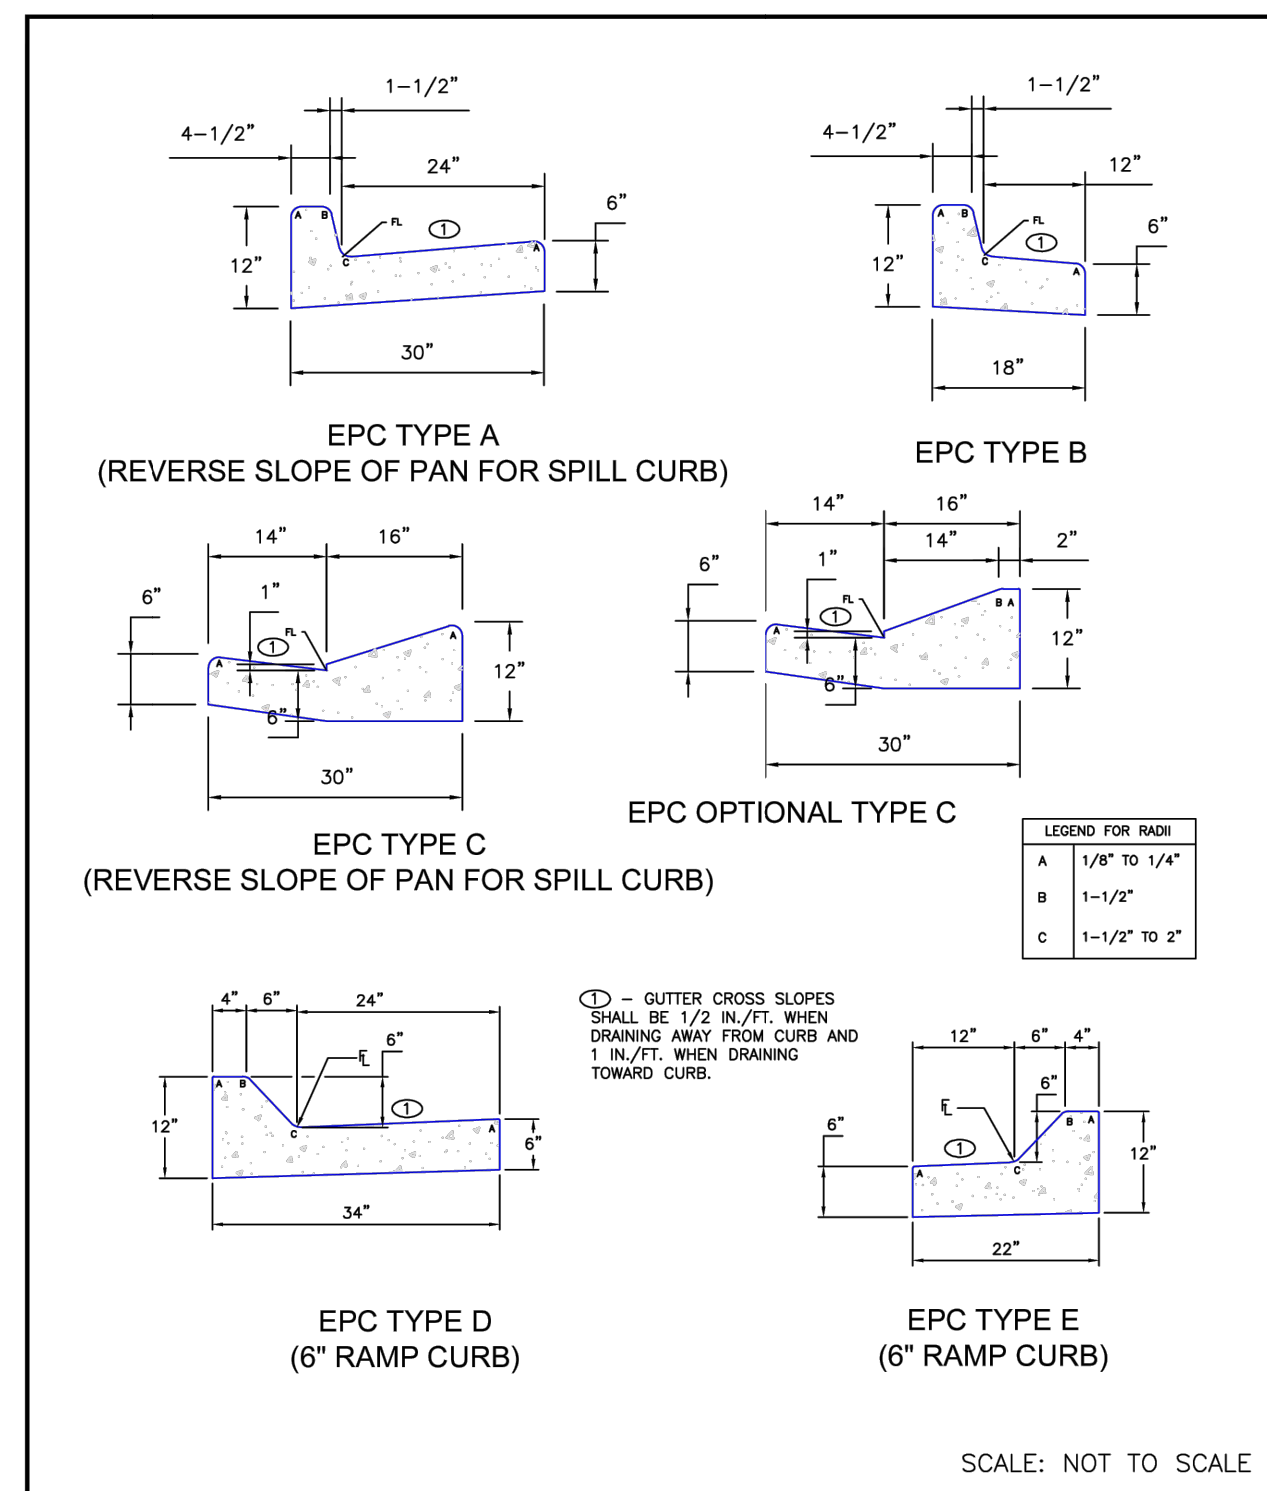


DATE APPROVED: 8/11/11	Typical Curb and Gutter Details Standard Drawing	FILE NAME: SD_2-20
DEPARTMENT OF TRANSPORTATION: André P. Brackin	REVISION DATE: 12/8/15	

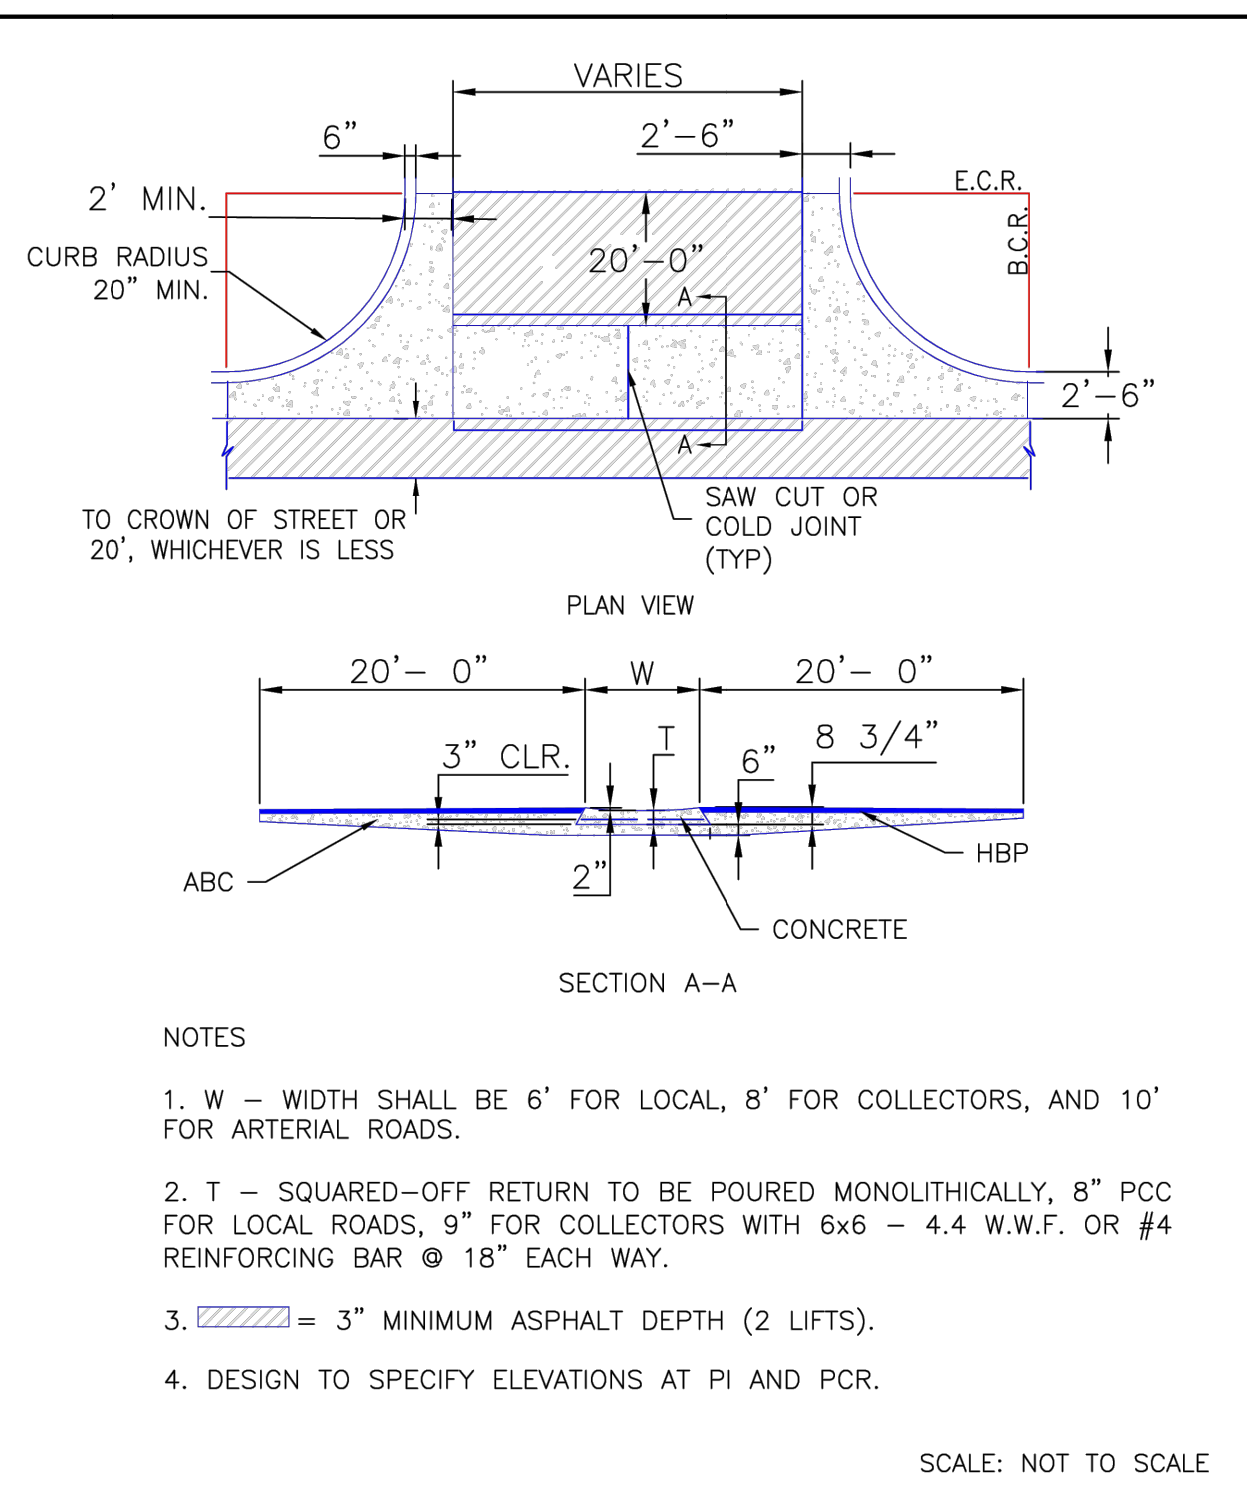


DATE APPROVED: 8/11/11	Typical Cross Pan Layout Detail Standard Drawing	FILE NAME: SD_2-26
DEPARTMENT OF TRANSPORTATION: André P. Brackin	REVISION DATE: 12/8/15	

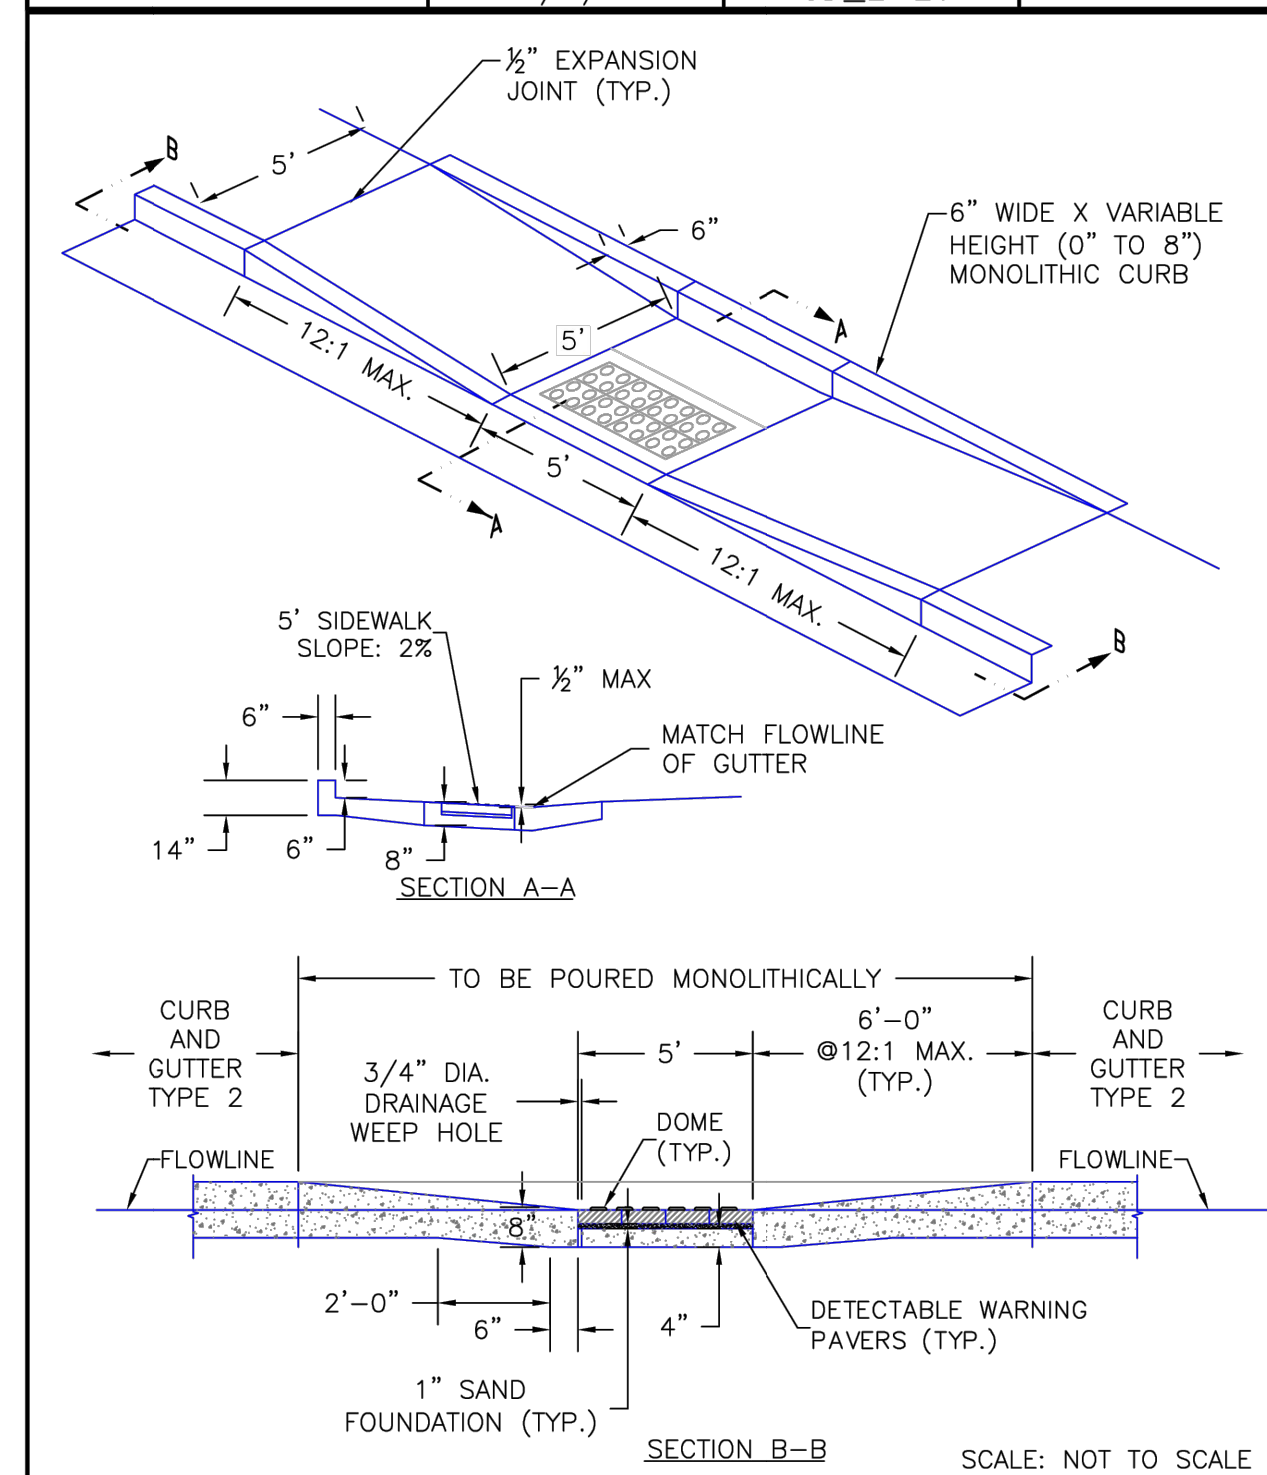


DATE APPROVED: 8/11/11	Parallel Pedestrian Ramp Detail Standard Drawing	FILE NAME: SD_2-50
DEPARTMENT OF TRANSPORTATION: André P. Brackin	REVISION DATE: 12/8/15	

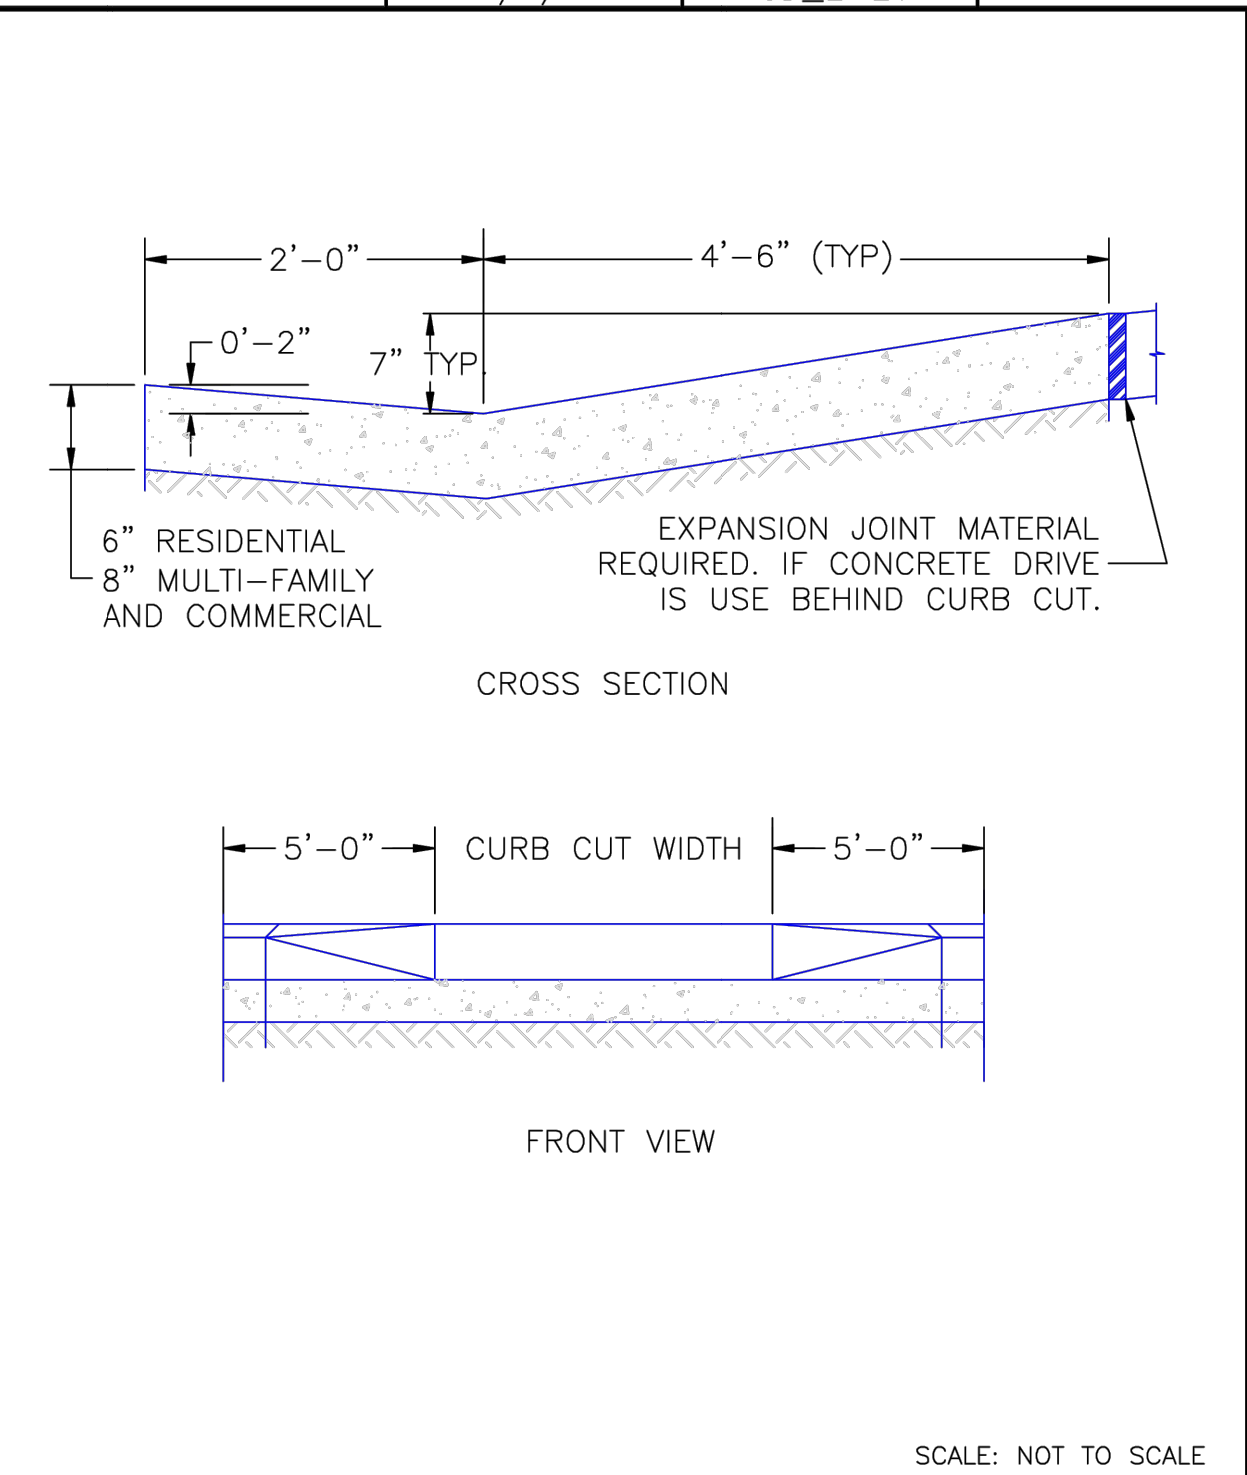


DATE APPROVED: 8/11/11	Driveway Cut Detail Standard Drawing	FILE NAME: SD_2-23
DEPARTMENT OF TRANSPORTATION: André P. Brackin	REVISION DATE: 11/10/04	

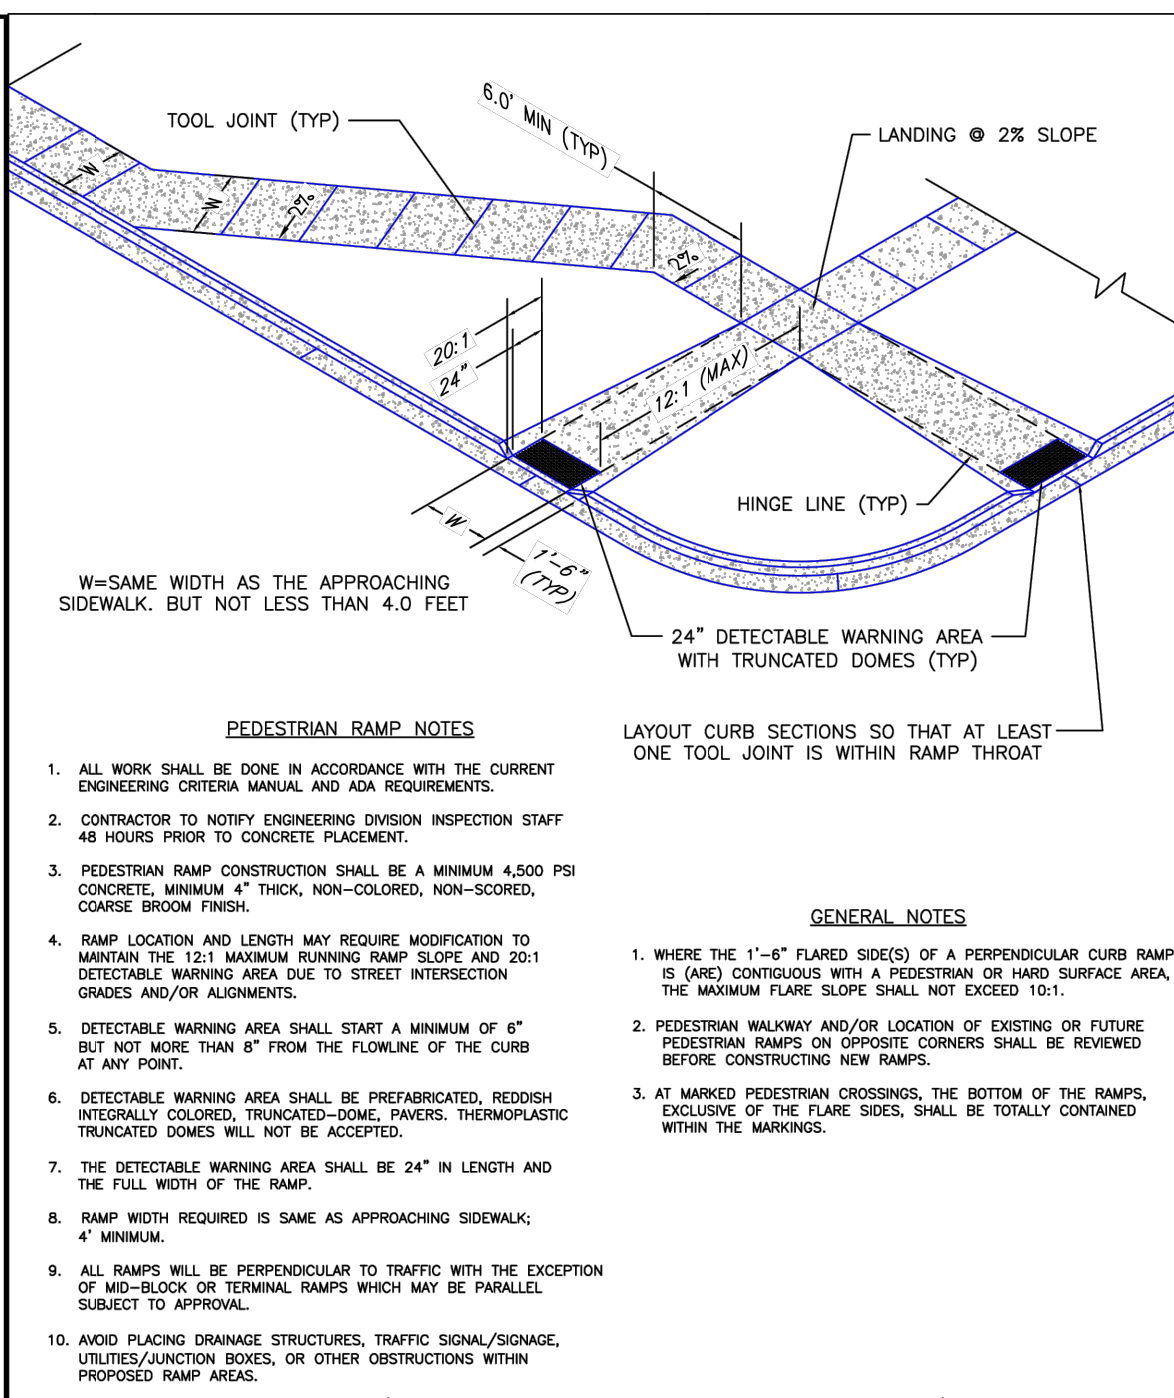


DATE APPROVED: 7/9/09	Pedestrian Intersection Ramp Standard Drawing	FILE NAME: SD_2-41
DEPARTMENT OF TRANSPORTATION: André P. Brackin	REVISION DATE: 12/8/15	

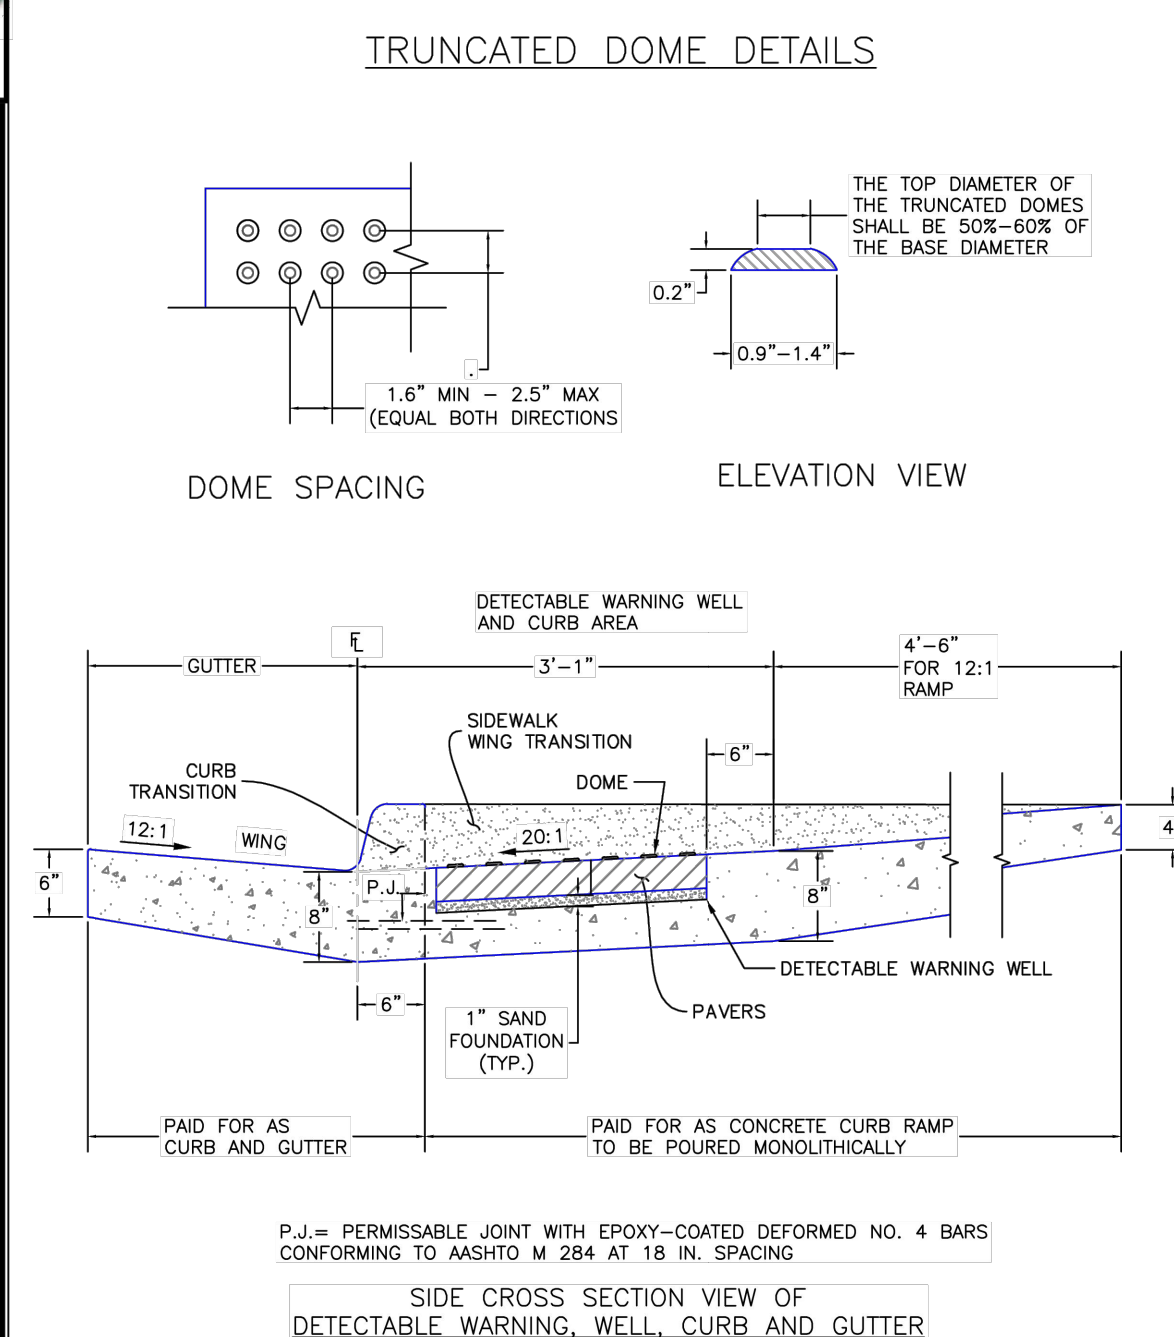

DATE APPROVED: 1/1/08	Truncated Dome Details Standard Drawing	FILE NAME: SD_2-42
DEPARTMENT OF TRANSPORTATION: John A. McCarty	REVISION DATE: 11/25/15	

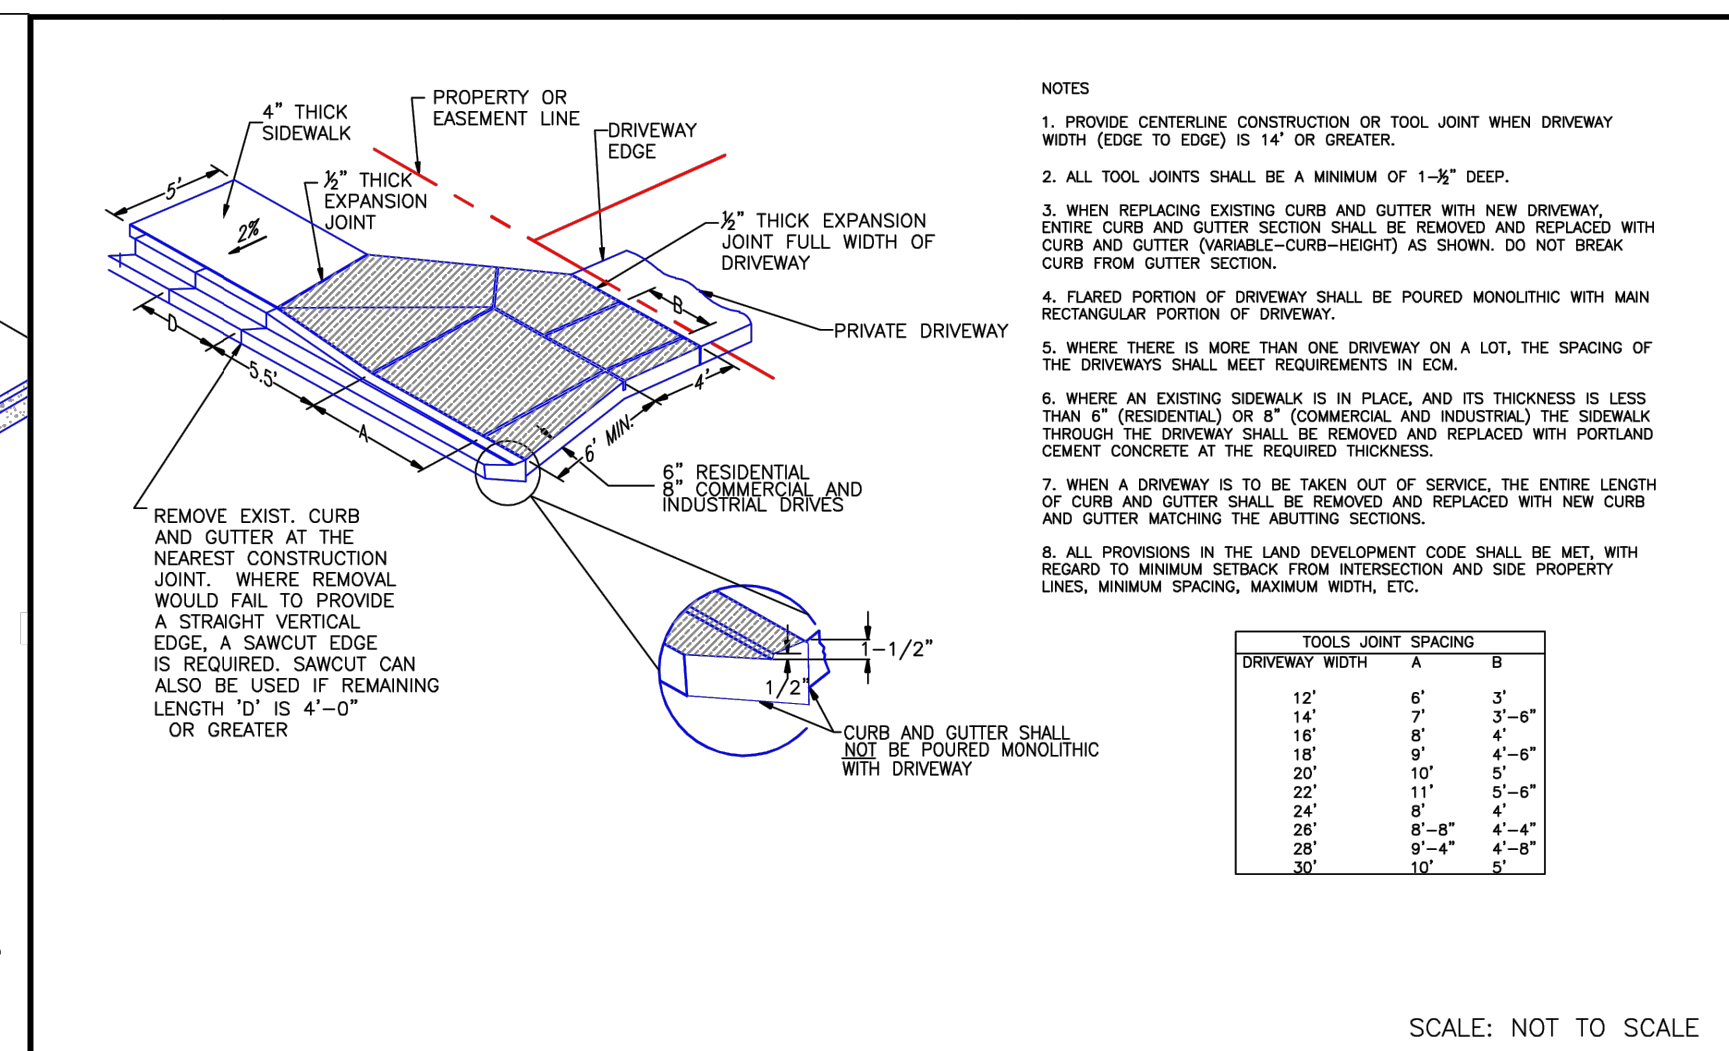

DATE APPROVED: 8/11/11	Driveway Detail With Attached Sidewalk Standard Drawing	FILE NAME: SD_2-24
DEPARTMENT OF TRANSPORTATION: André P. Brackin	REVISION DATE: 11/10/04	

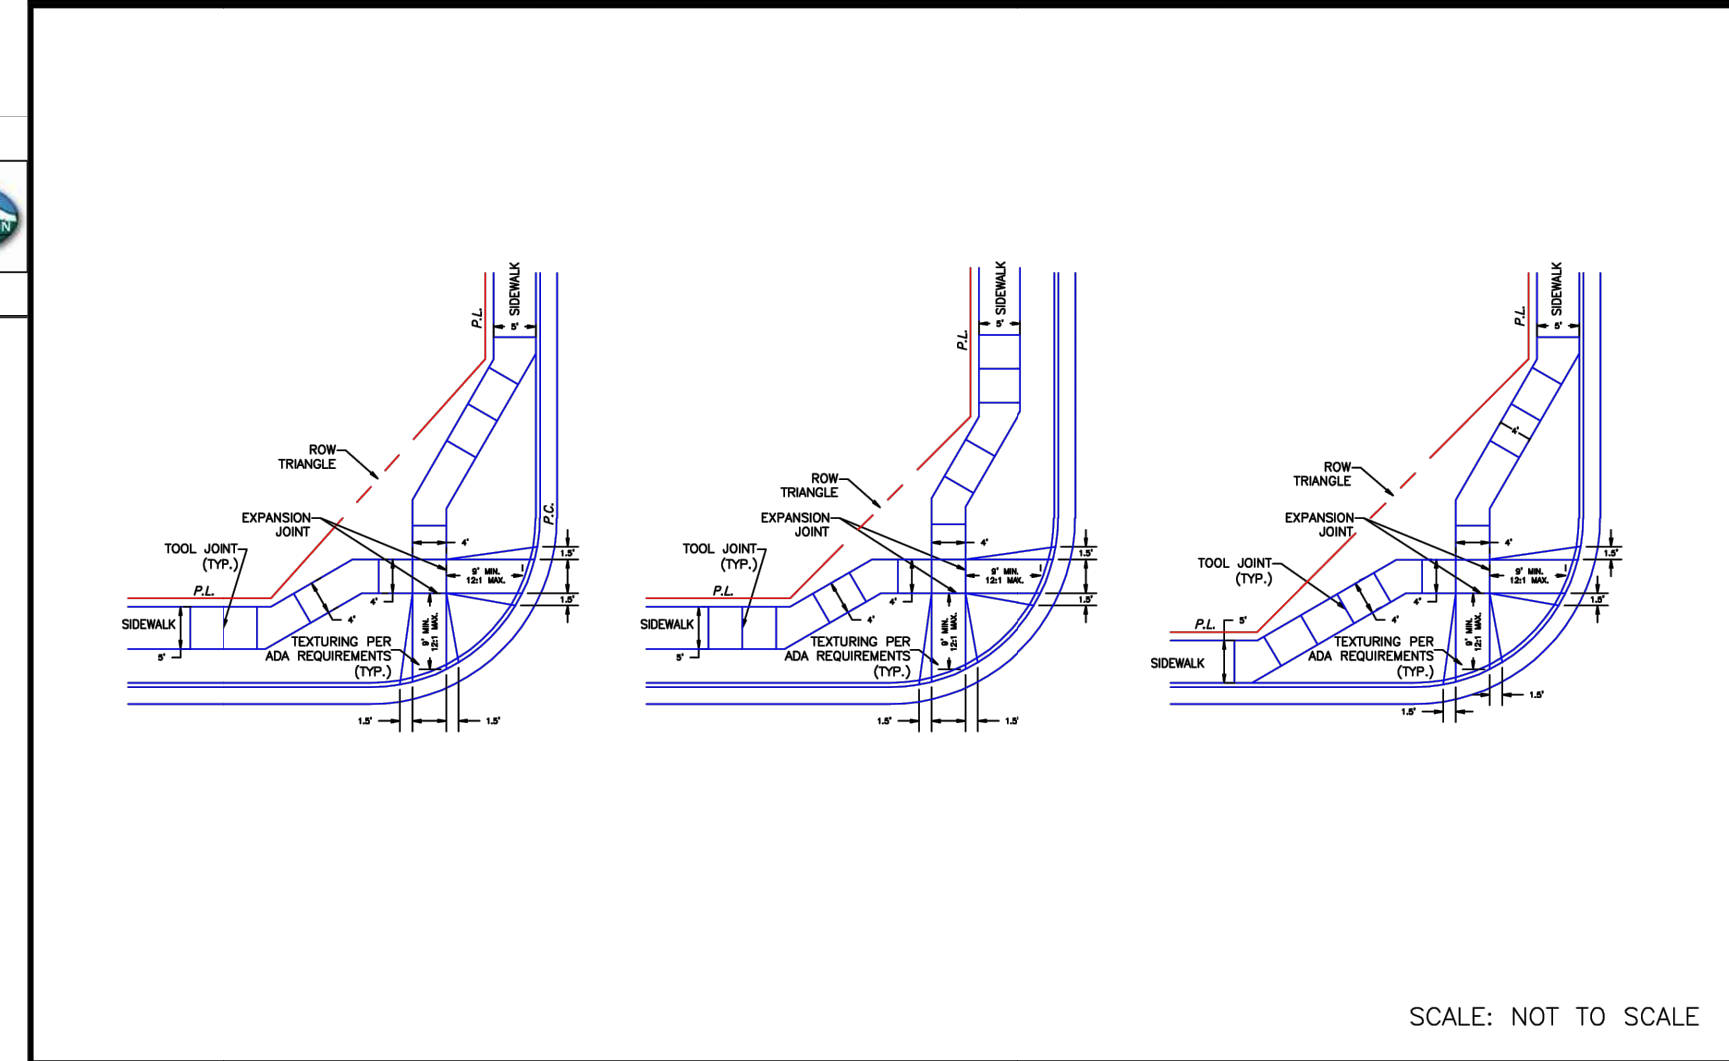

DATE APPROVED: 9/16/10	Pedestrian Intersection Ramp Detail Standard Drawing	FILE NAME: SD_2-40
DEPARTMENT OF TRANSPORTATION: André P. Brackin	REVISION DATE: 11/10/04	

NO.	REVISION	DATE	BY	APPR

Kimley»Horn

2026 KIMLEY-HORN AND ASSOCIATES, INC.
2 North Nevada Avenue, Suite 900
Colorado Springs, Colorado 80903 (719) 453-0180

DESIGNED BY: NMB
DRAWN BY: DPM
CHECKED BY: NMB
DATE: 02/25/2026

WINDERMERE FILING NO. 2
SITE DEVELOPMENT PLAN
EL PASO COUNTY, COLORADO
STANDARD DETAILS

PRELIMINARY
FOR REVIEW ONLY
NOT FOR CONSTRUCTION

Kimley»Horn
Kimley-Horn and Associates, Inc.

PROJECT NO.
196160000

SHEET
10



30"x30"
MINIMUM SIZE

BACKGROUND
4090 (3M-WHITE DIAMOND GRADE) OR EQUIVALENT
FOREGROUND
1172 C (3M-RED EC FILM) OR EQUIVALENT

MUTCD R1-1 STOP SIGN DETAIL
NOT TO SCALE

D3-1 WITH "NO OUTLET PATCH"



R4-4
BEGIN RIGHT TURN LANE - YIELD TO BIKES

Colors: Legend - BLACK
Background - WHITE (RETROREFLECTIVE)
Arrows - BLACK



R3-7R
MANDATORY MOVEMENT LANE CONTROL

Colors: Legend - BLACK
Background - WHITE (RETROREFLECTIVE)

MUTCD R4-4 & R3-7R RIGHT TURN LANE SIGNAGE DETAILS
(ANTELOPE RIDGE DR.)
NOT TO SCALE


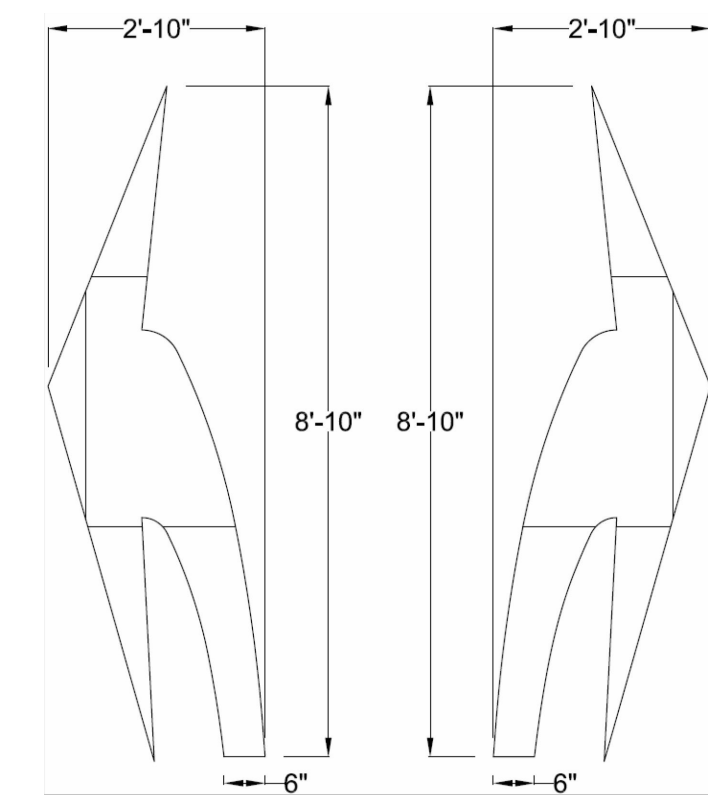



FIGURE 2 - PAVEMENT MARKING DETAIL FOR NARROW ARROWS

RIGHT TURN LANE PAVEMENT MARKINGS
(ANTELOPE RIDGE DR.)
NOT TO SCALE

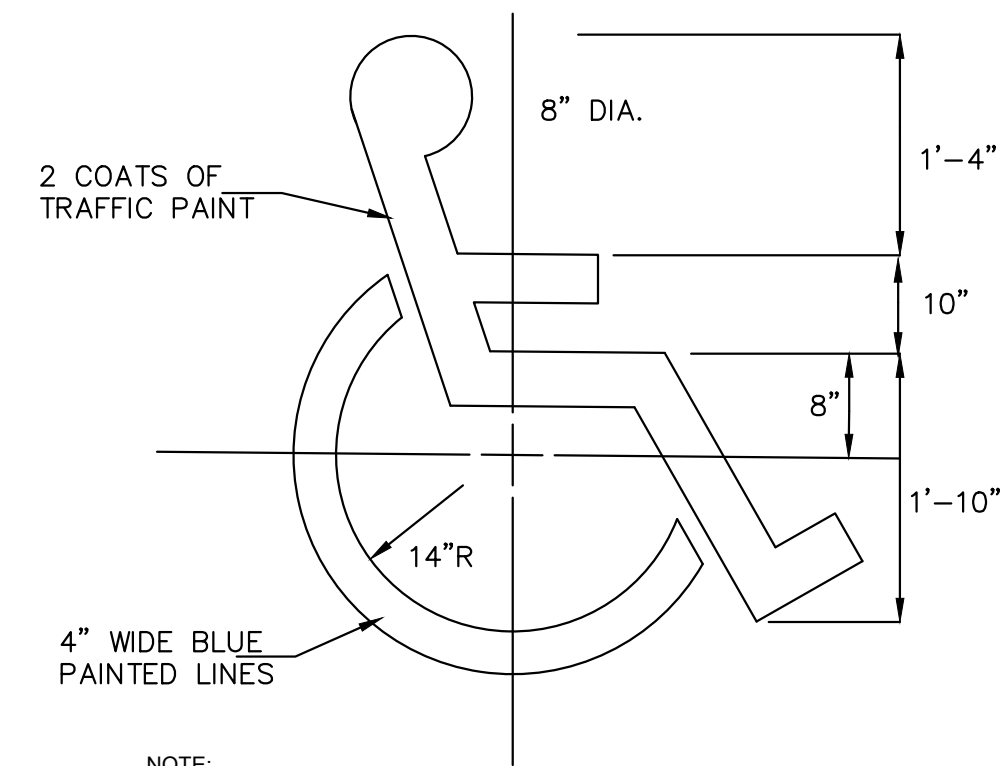

NOTE:
1. ALL TRAFFIC MARKINGS TO BE LATEX AS PER DIMENSIONS SHOWN.


HANDICAP SYMBOL
NOT TO SCALE

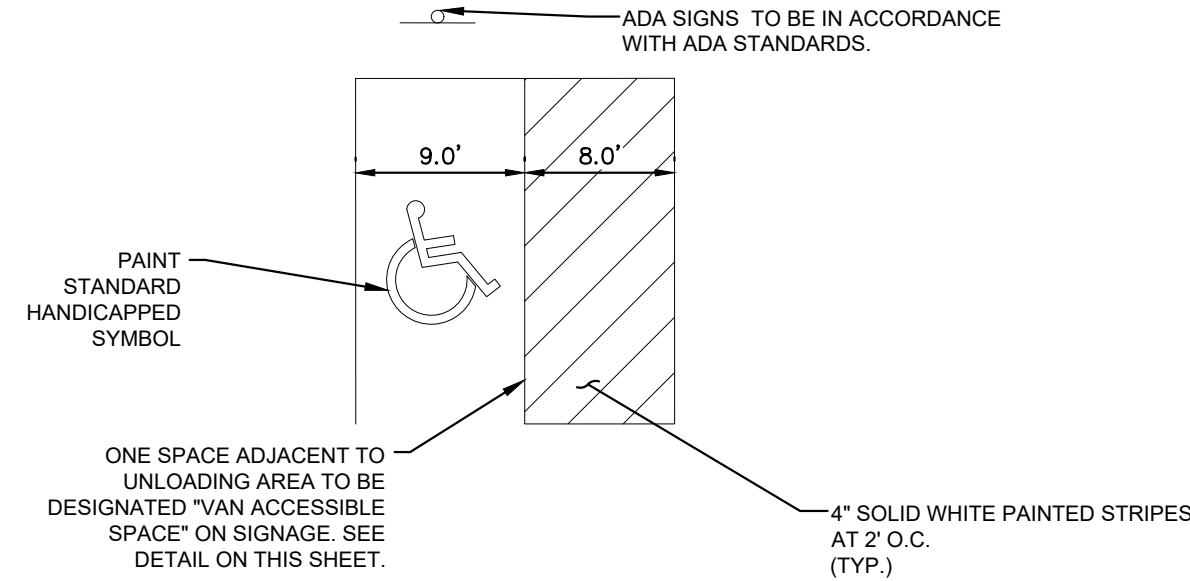


ONE SPACE ADJACENT TO UNLOADING AREA TO BE DESIGNATED "VAN ACCESSIBLE SPACE" ON SIGNAGE. SEE DETAIL ON THIS SHEET.

NOTES:
1. DIMENSIONS MAY VARY REFER TO SITE GEOMETRICS PLAN.
2. SIGNAGE AND MARKINGS TO BE IN ACCORDANCE WITH FEDERAL, STATE AND LOCAL REGULATIONS.

VAN ACCESSIBLE PARKING DETAIL
NOT TO SCALE

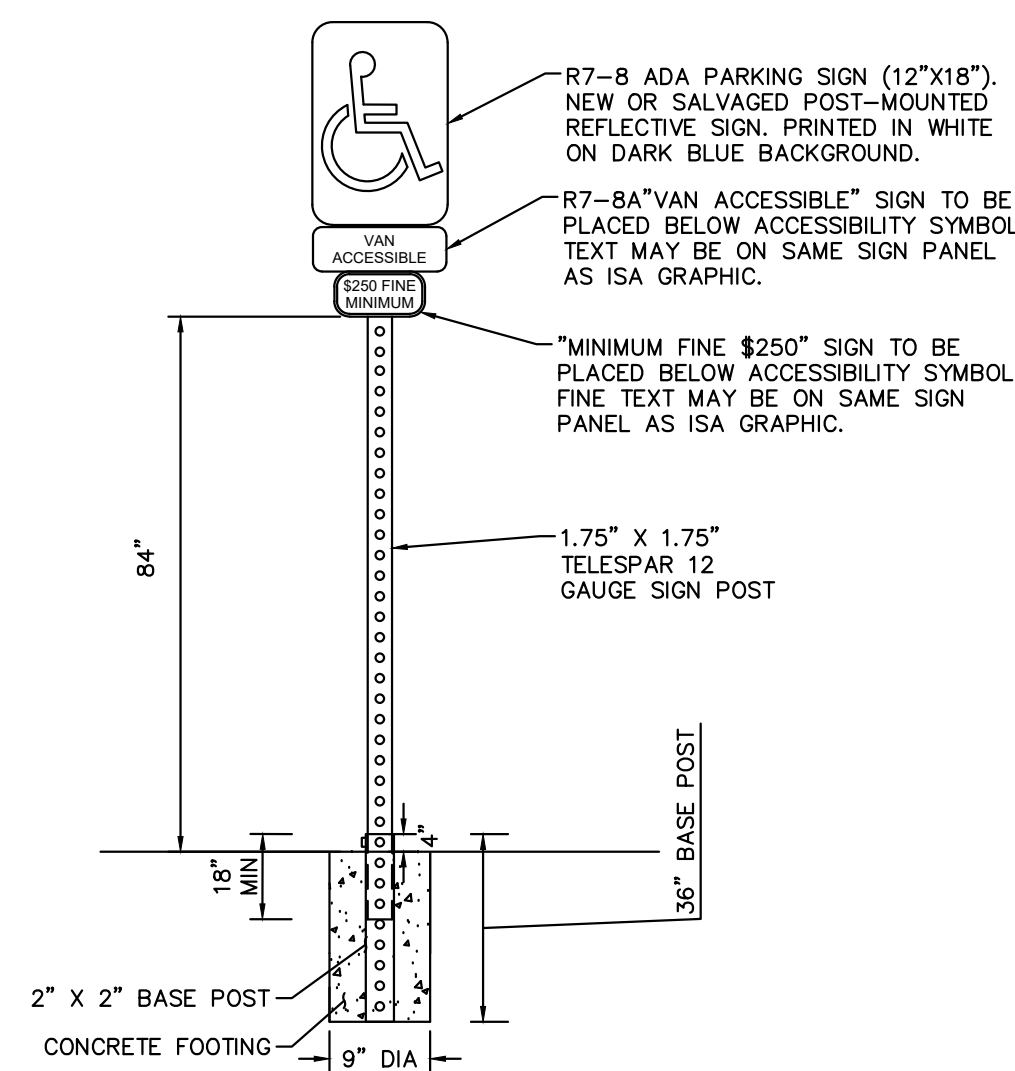

ADA SIGNAGE DETAIL
NOT TO SCALE

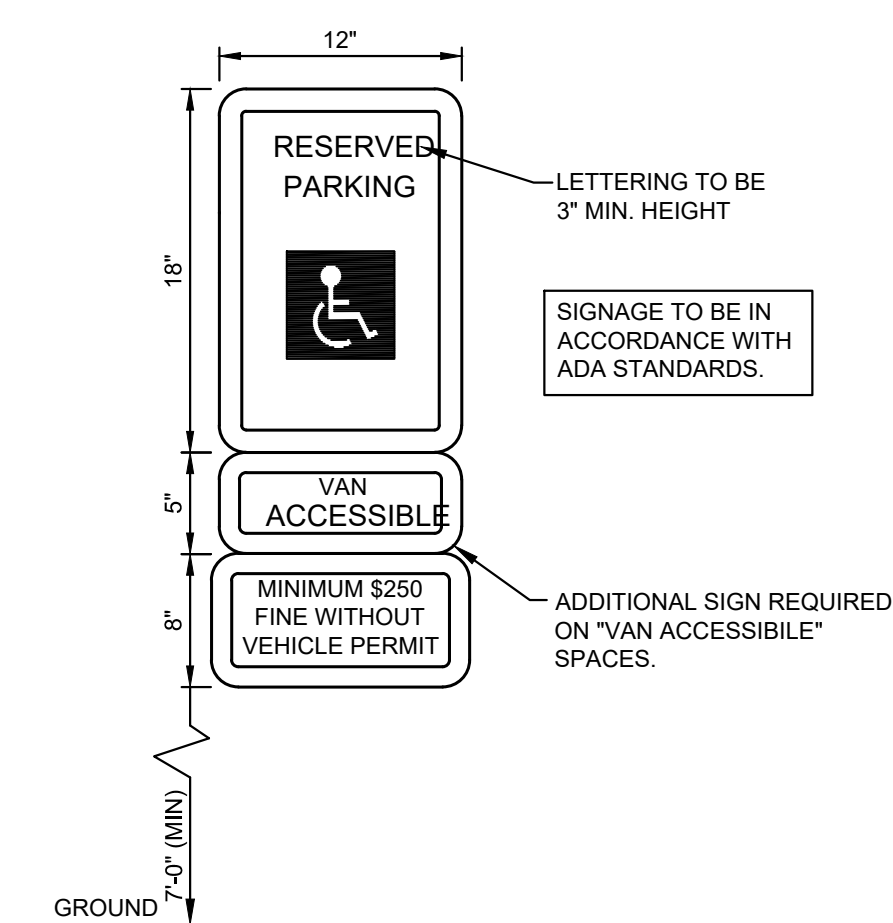

ADA SIGNAGE DETAIL
NOT TO SCALE

NO.	REVISION	BY	DATE	APPR

Kimley»Horn
2026 KIMLEY-HORN AND ASSOCIATES, INC.
2 North Nevada Avenue, Suite 900
Colorado Springs, Colorado 80903 (719) 453-0180

DESIGNED BY: NMB
DRAWN BY: DPM
CHECKED BY: NMB
DATE: 02/25/2026

WINDERMERE FILING NO. 2
SITE DEVELOPMENT PLAN
EL PASO COUNTY, COLORADO
STANDARD DETAILS


PRELIMINARY
FOR REVIEW ONLY
NOT FOR
CONSTRUCTION

PROJECT NO.
196160000


SHEET

11


K:\COS_LA\196160000 - Windemere\CADD\PlanSheets\SDF\PIP_DET.dwg Evans, Wyatt 3/30/2026 8:25 AM

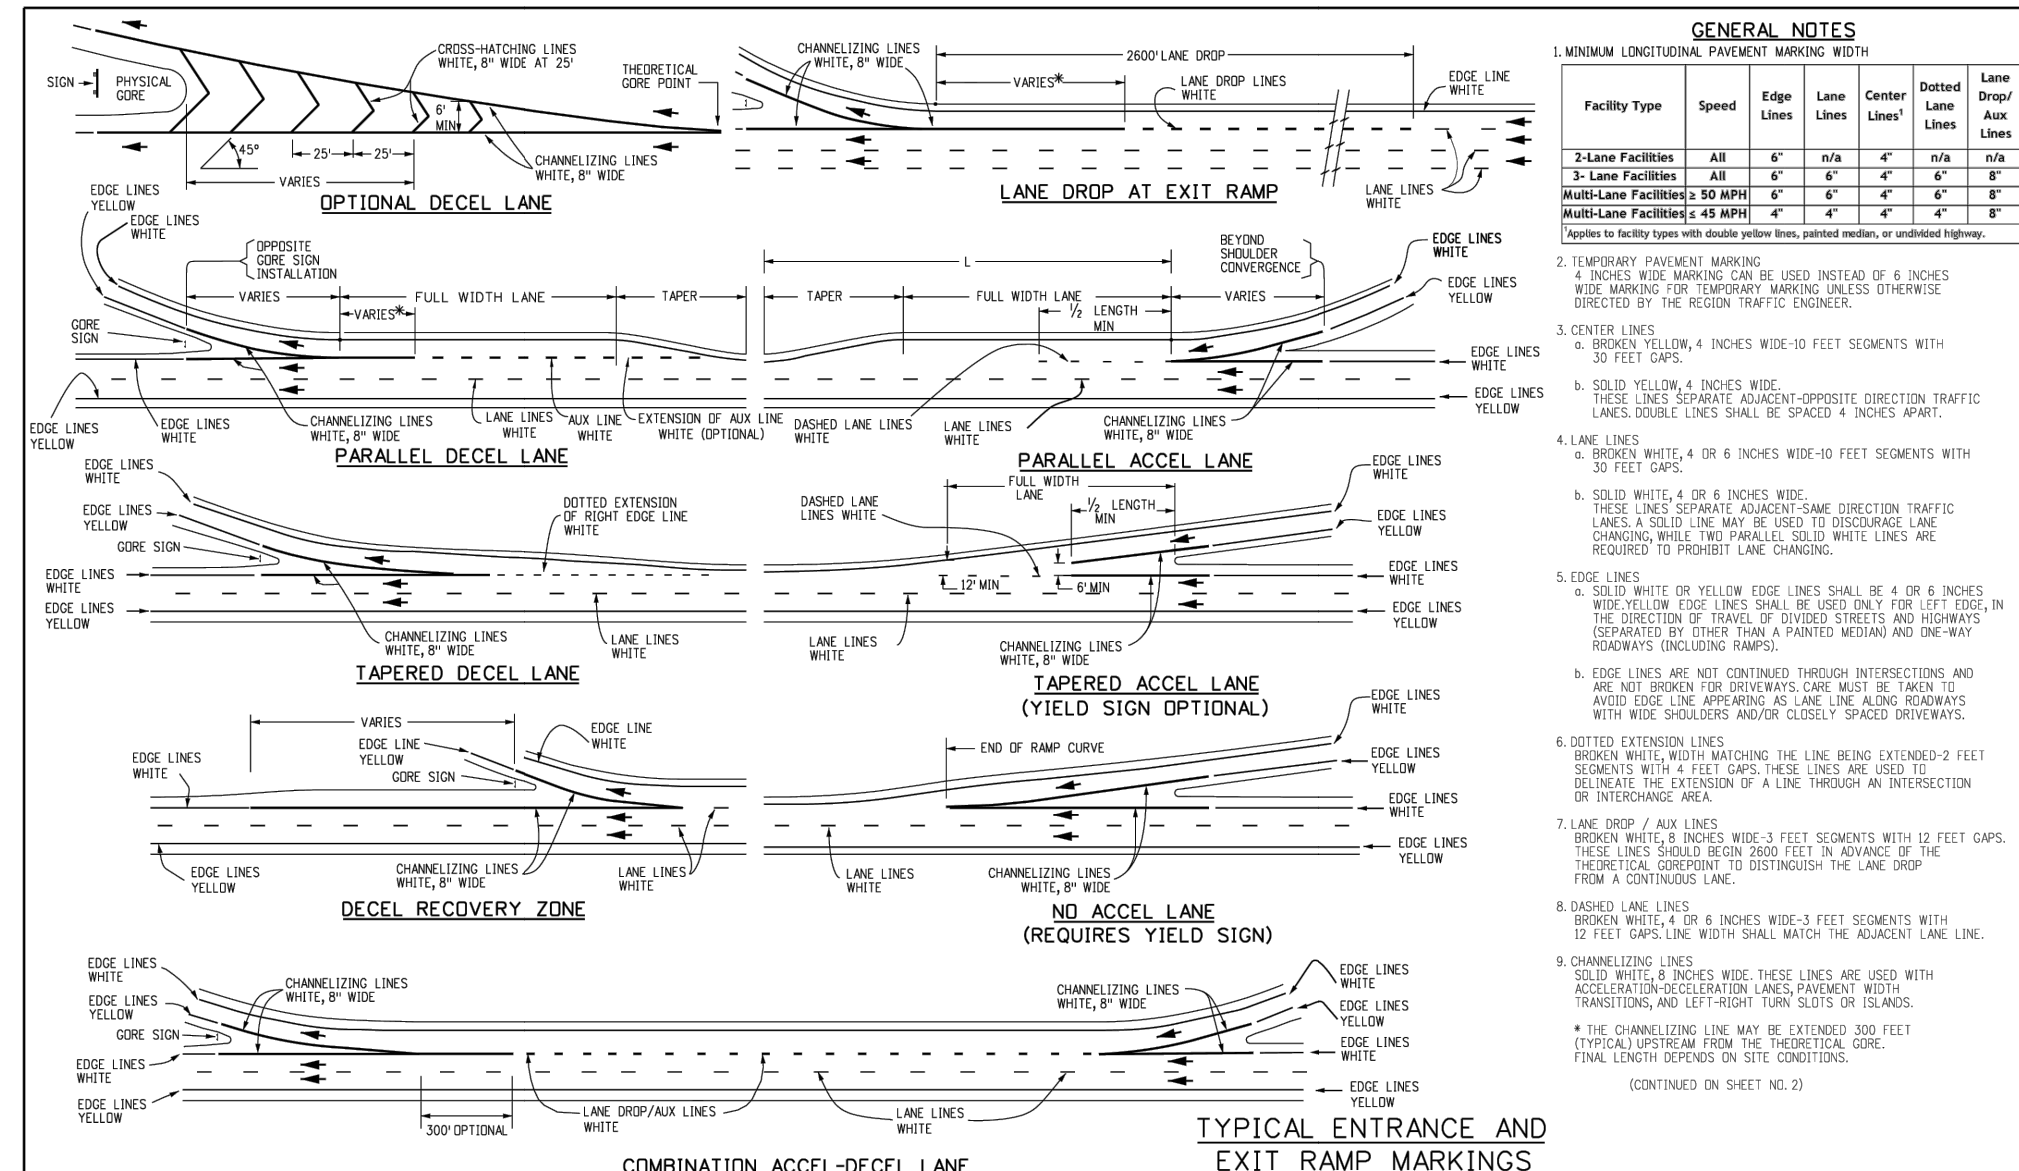


Computer File Information	Sheet Revisions	Colorado Department of Transportation	PAVEMENT MARKINGS	STANDARD PLAN NO. S-627-1	Computer File Information	Sheet Revisions	Colorado Department of Transportation	PAVEMENT MARKINGS	STANDARD PLAN NO. S-627-1
Creation Date: 02/20/24	Date: 02/20/24	2829 W. Harvard Pl., Denver, CO 80204	Issued By: Traffic Safety & Engineering Branch July 31, 2009	Standard Sheet No. 1 of 11	Creation Date: 02/20/24	Date: 02/20/24	2829 W. Harvard Pl., Denver, CO 80204	Issued By: Traffic Safety & Engineering Branch July 31, 2009	Standard Sheet No. 2 of 11

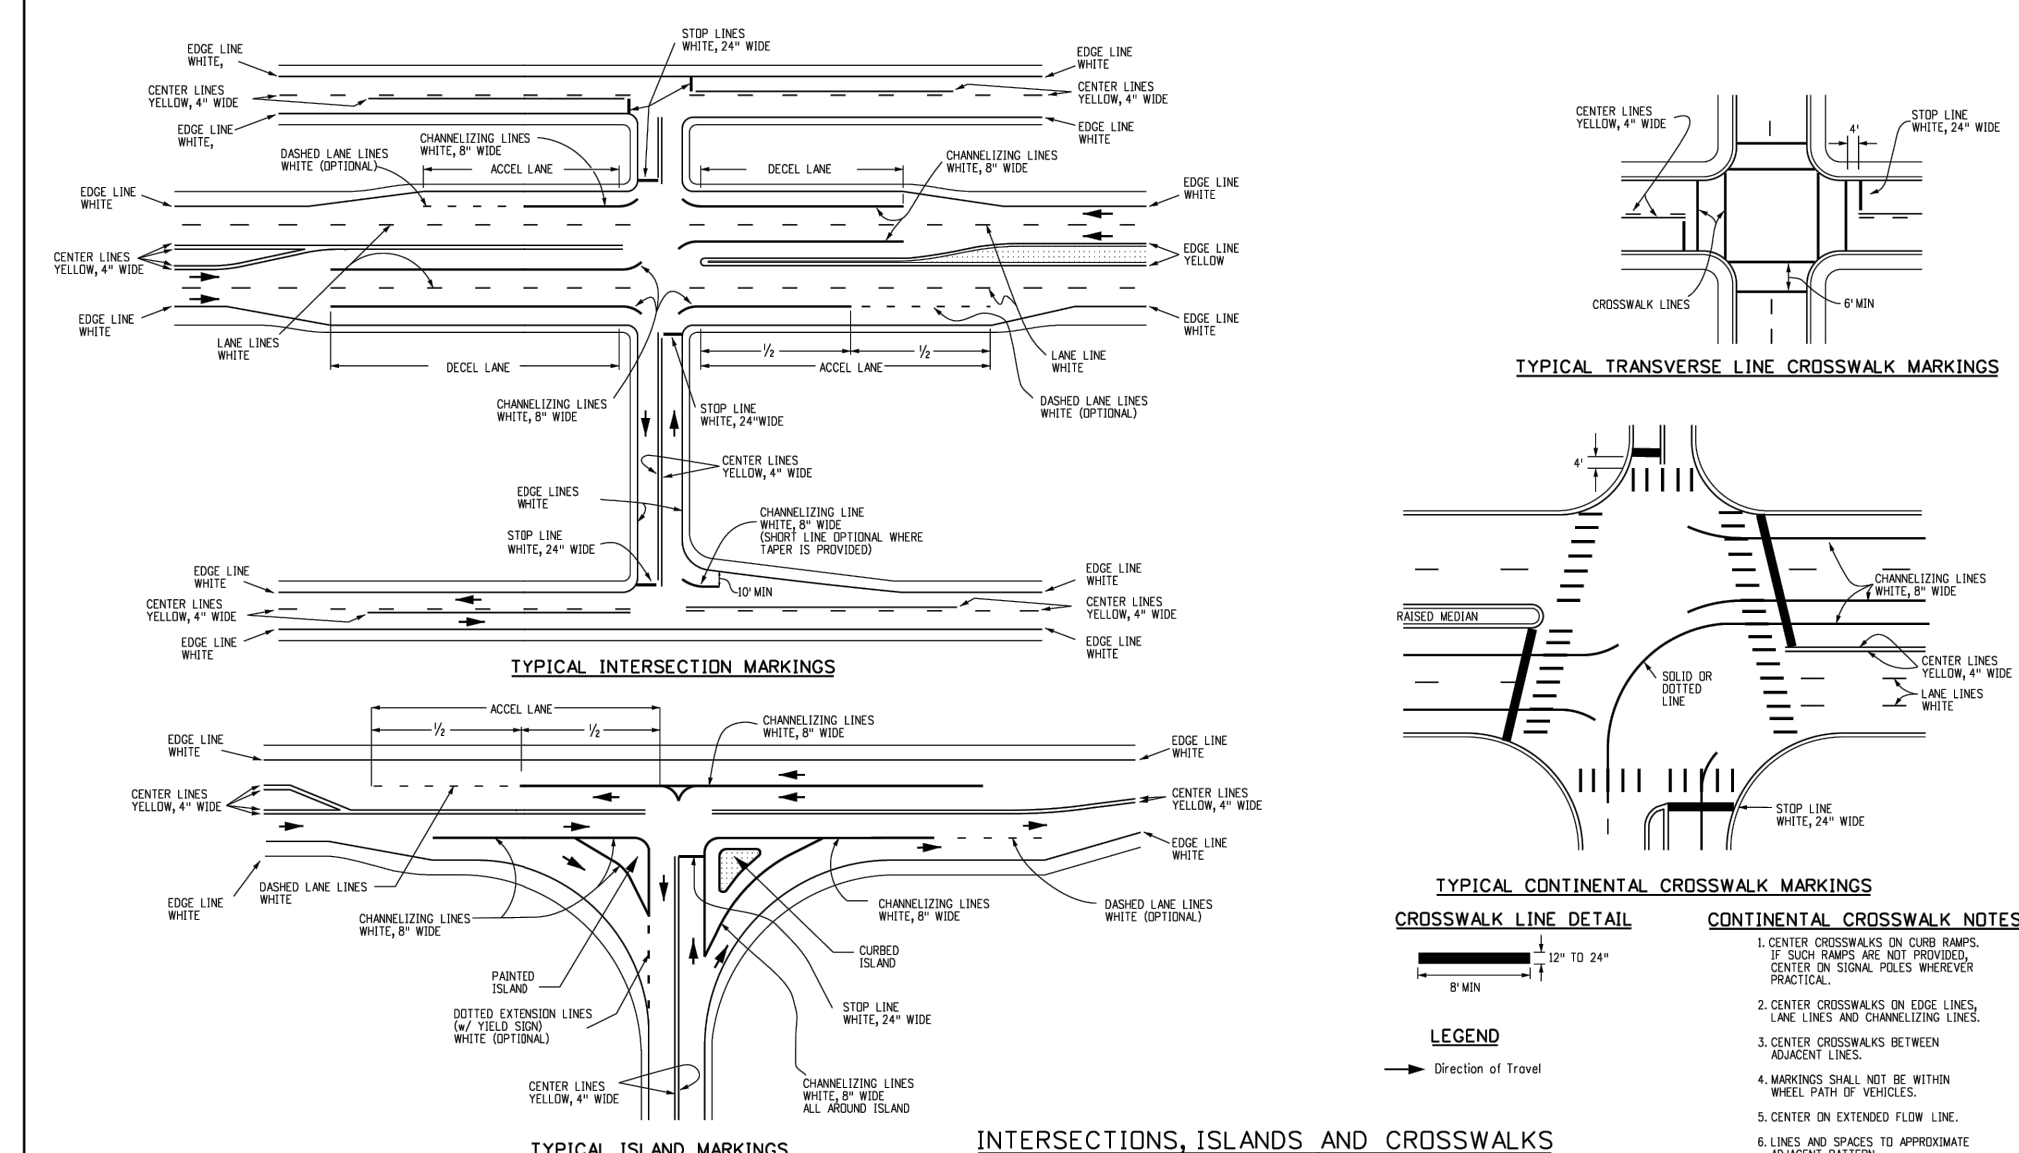

Computer File Information	Sheet Revisions	Colorado Department of Transportation	PAVEMENT MARKINGS	STANDARD PLAN NO. S-627-1	Computer File Information	Sheet Revisions	Colorado Department of Transportation	PAVEMENT MARKINGS	STANDARD PLAN NO. S-627-1
Creation Date: 02/20/24	Date: 02/20/24	2829 W. Harvard Pl., Denver, CO 80204	Issued By: Traffic Safety & Engineering Branch July 31, 2009	Standard Sheet No. 3 of 11	Creation Date: 02/20/24	Date: 02/20/24	2829 W. Harvard Pl., Denver, CO 80204	Issued By: Traffic Safety & Engineering Branch July 31, 2009	Standard Sheet No. 5 of 11

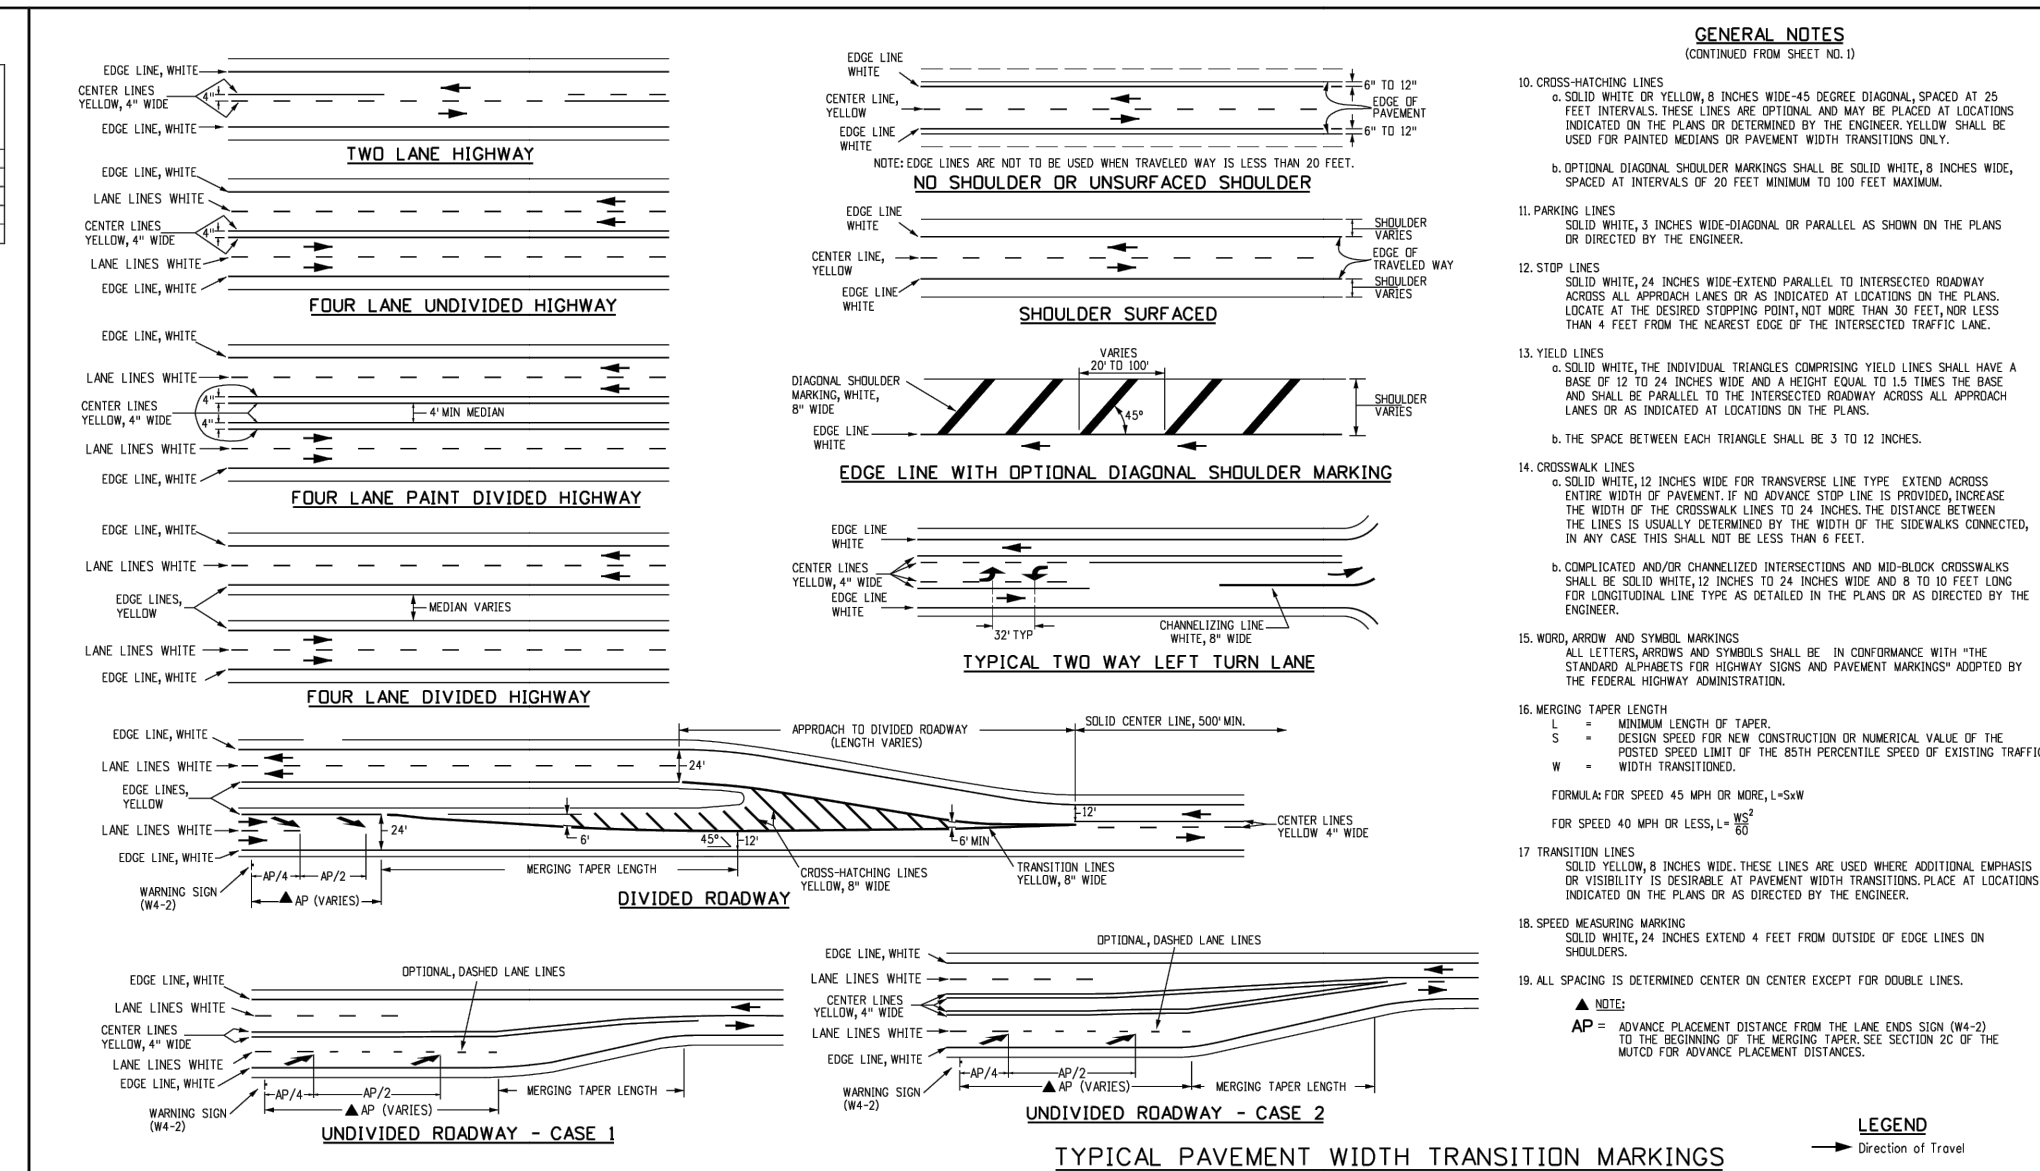

Computer File Information	Sheet Revisions	Colorado Department of Transportation	PAVEMENT MARKINGS	STANDARD PLAN NO. S-627-1	Computer File Information	Sheet Revisions	Colorado Department of Transportation	PAVEMENT MARKINGS	STANDARD PLAN NO. S-627-1
Creation Date: 02/20/24	Date: 02/20/24	2829 W. Harvard Pl., Denver, CO 80204	Issued By: Traffic Safety & Engineering Branch July 31, 2009	Standard Sheet No. 2 of 11	Creation Date: 02/20/24	Date: 02/20/24	2829 W. Harvard Pl., Denver, CO 80204	Issued By: Traffic Safety & Engineering Branch July 31, 2009	Standard Sheet No. 2 of 11

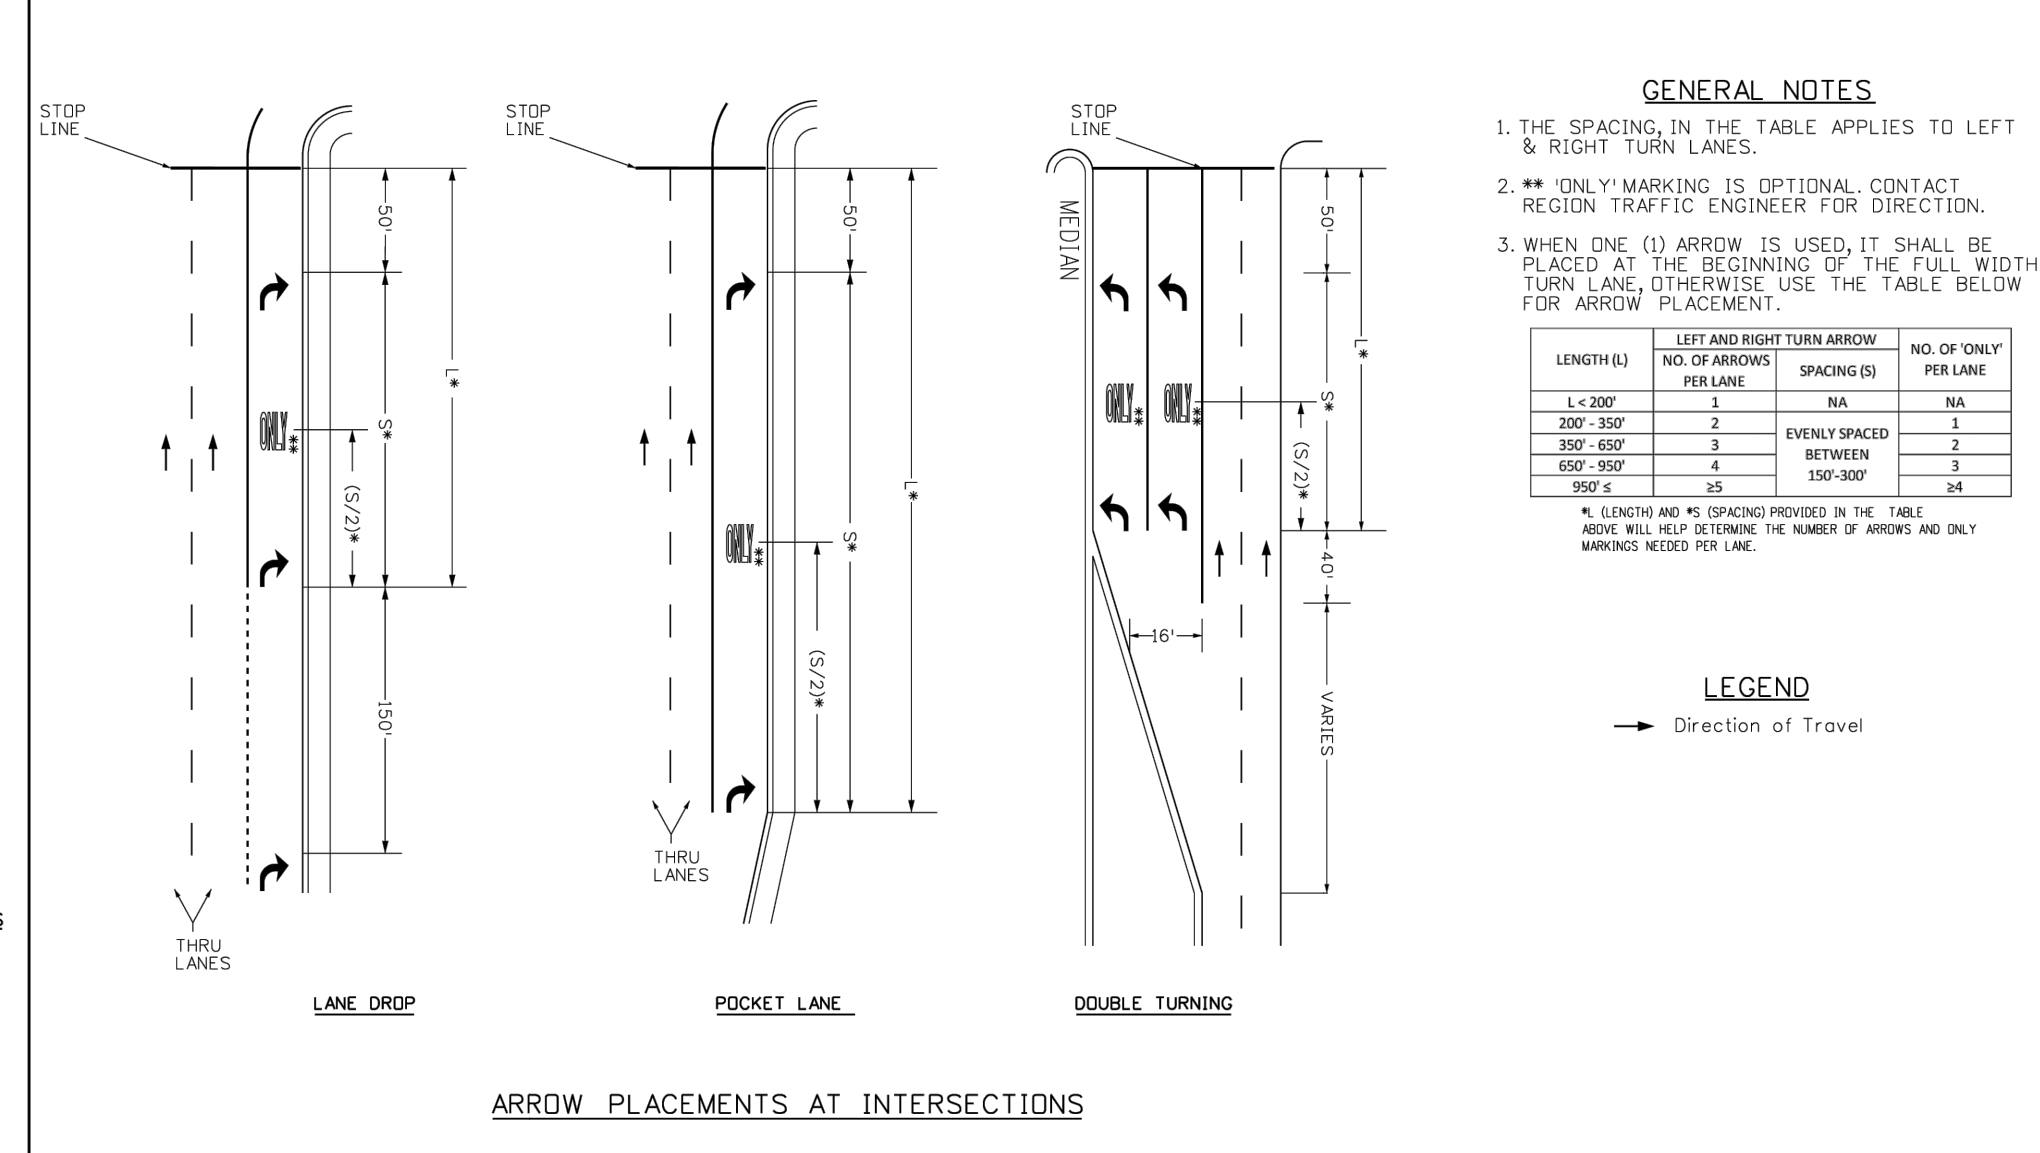

Computer File Information	Sheet Revisions	Colorado Department of Transportation	PAVEMENT MARKINGS	STANDARD PLAN NO. S-627-1	Computer File Information	Sheet Revisions	Colorado Department of Transportation	PAVEMENT MARKINGS	STANDARD PLAN NO. S-627-1
Creation Date: 02/20/24	Date: 02/20/24	2829 W. Harvard Pl., Denver, CO 80204	Issued By: Traffic Safety & Engineering Branch July 31, 2009	Standard Sheet No. 3 of 11	Creation Date: 02/20/24	Date: 02/20/24	2829 W. Harvard Pl., Denver, CO 80204	Issued By: Traffic Safety & Engineering Branch July 31, 2009	Standard Sheet No. 5 of 11

GENERAL NOTES

- THE SPACING IN THE TABLE APPLIES TO LEFT & RIGHT TURN LANES.
- OPTIONAL CONTACT REGION TRAFFIC ENGINEER FOR DIRECTION.
- WHEN ONE (1) ARROW IS USED IT SHALL BE PLACED AT THE BEGINNING OF THE FULL WIDTH TURN LANE, OTHERWISE USE THE TABLE BELOW FOR ARROW PLACEMENTS.

LENGTH(S)	LEFT AND RIGHT TURN ARROW SPACING(S)		NO. OF ONLY PER LANE
	NO. OF ARROWS	SPACING(S)	
L < 200'	1	NA	NA
200' - 300'	2	BETWEEN	2
300' - 600'	3	BETWEEN	3
600' - 900'	4	BETWEEN	4
900' >	5	BETWEEN	5

* LENGTHS AND #S SPACING PROVIDED IN THE TABLE WILL HELP DETERMINE THE NUMBER OF ARROWS AND ONLY MARKINGS NEEDED PER LANE.

NO.	REVISION	DATE	BY	APPR
-----	----------	------	----	------

Kimley»Horn

2026 KIMLEY-HORN AND ASSOCIATES, INC.
2 North Nevada Avenue, Suite 900
Colorado Springs, Colorado 80903 (719) 453-0180

DESIGNED BY: NMB
DRAWN BY: DPM
CHECKED BY: NMB
DATE: 02/25/2026


WINDERMERE FILING NO. 2
SITE DEVELOPMENT PLAN
EL PASO COUNTY, COLORADO
STANDARD DETAILS

PRELIMINARY
FOR REVIEW ONLY
NOT FOR CONSTRUCTION



Kimley»Horn
Kimley-Horn and Associates, Inc.

PROJECT NO.
196160000

SHEET
12

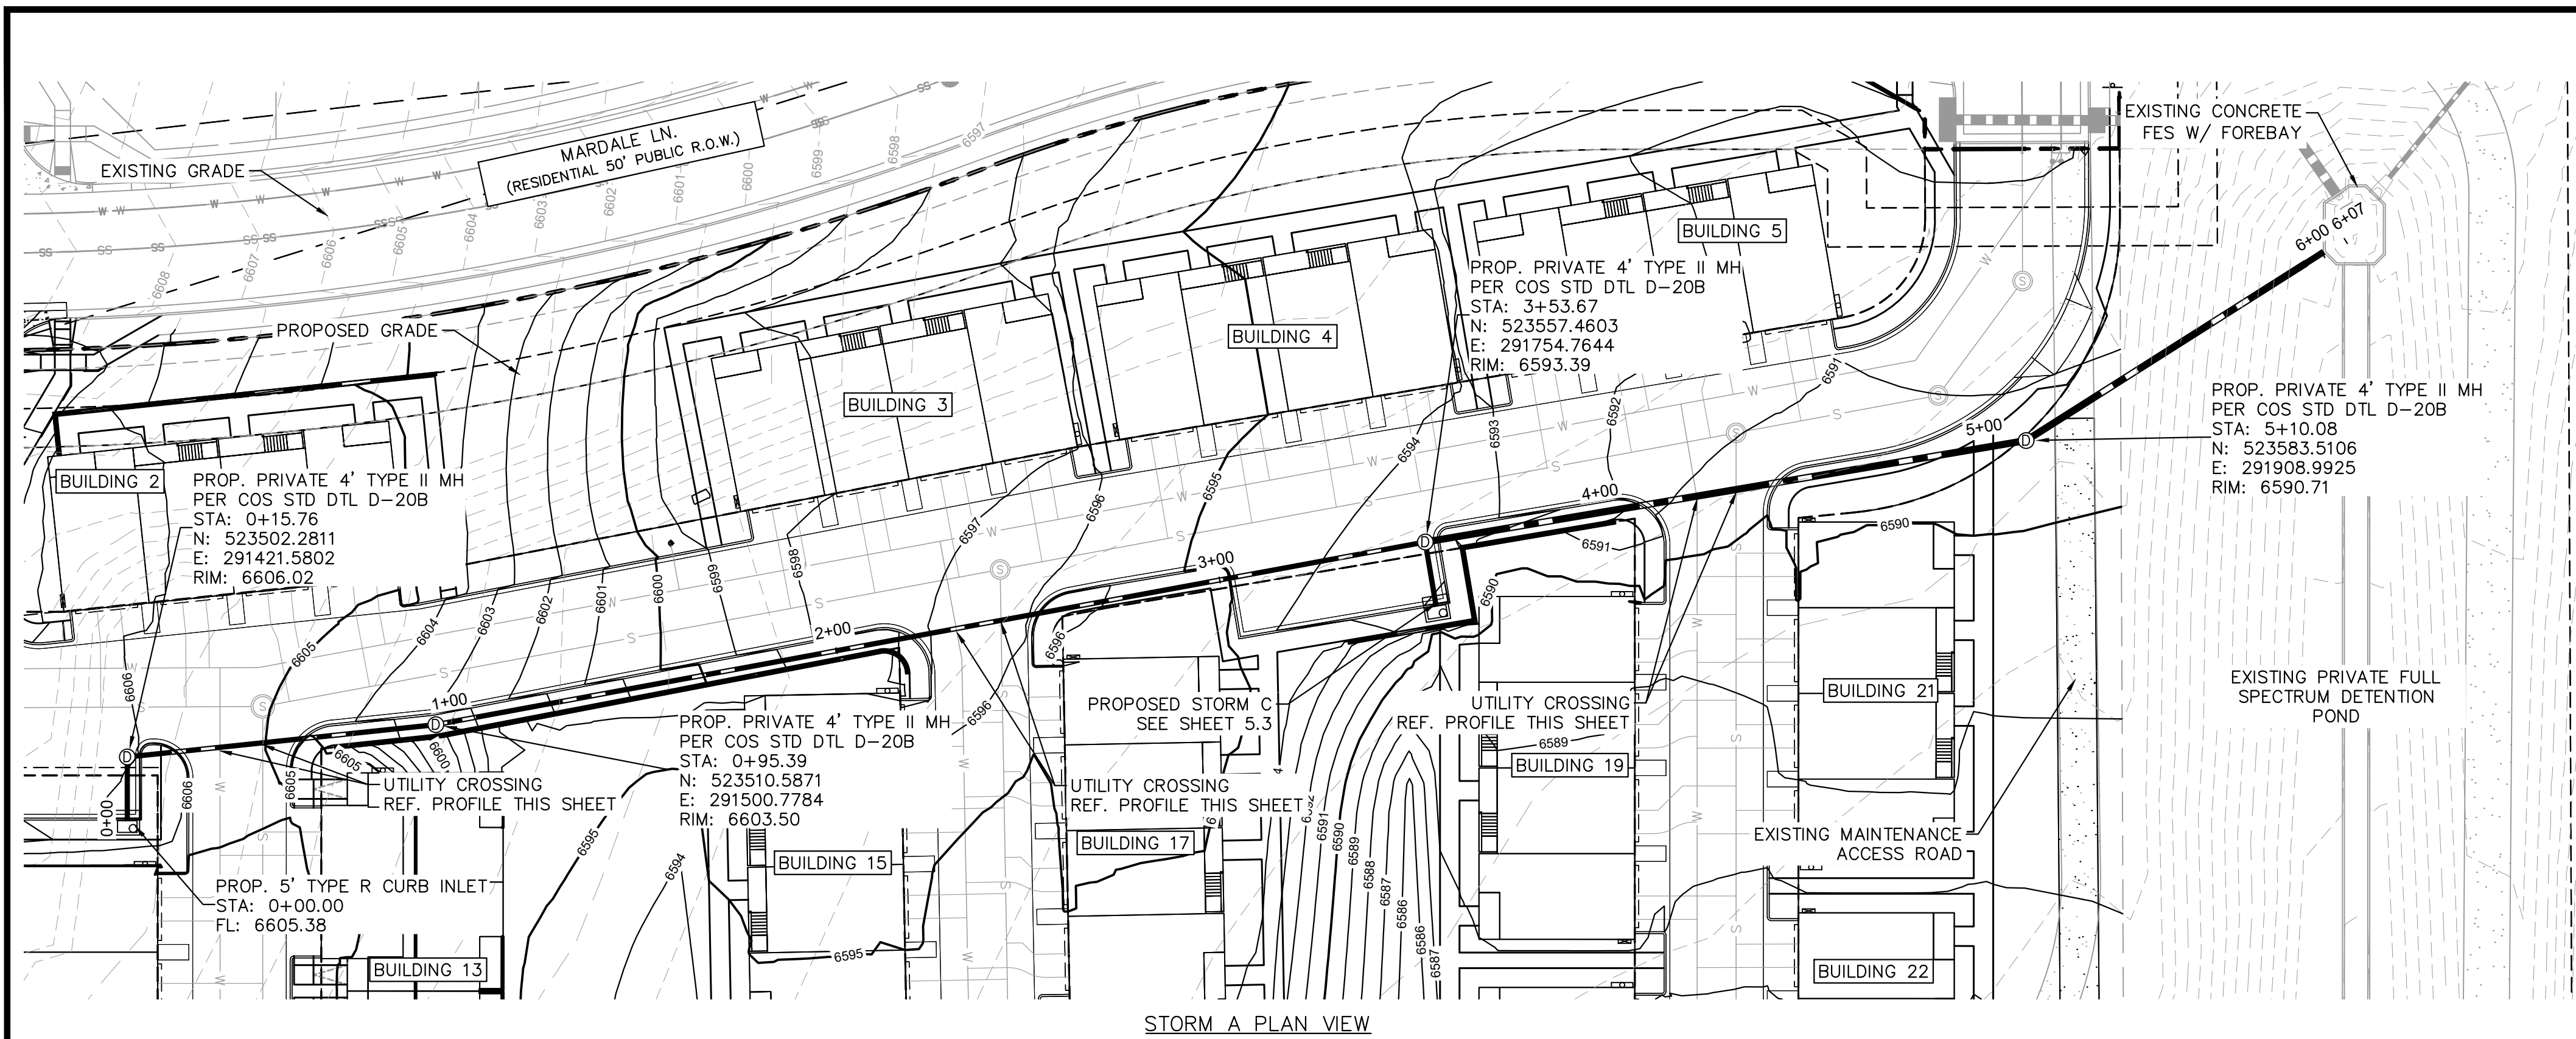

STORM A PLAN VIEW

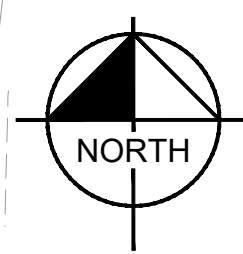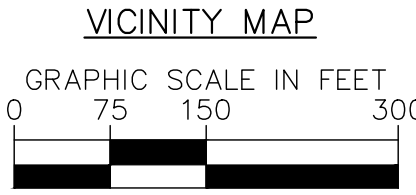


LEGEND


- PROPERTY LINE
- x - x - PROPOSED FENCE
- w - PROPOSED 6" PVC WATER MAIN
- s - PROPOSED 8" PVC SANITARY MAIN
- PROPOSED PVC STORM MAIN

NOTES

1. ALL EXISTING UTILITIES TO REMAIN UNLESS OTHERWISE NOTED.
2. UTILITIES TO BE REMOVED ARE TO BE CAPPED IN PLACE IN ACCORDANCE WITH LOCAL UTILITY REGULATIONS.
3. THE LOCATION AND/OR ELEVATION OF EXISTING UTILITIES AS SHOWN ON THESE PLANS IS BASED ON RECORDS OF THE VARIOUS UTILITY COMPANIES, AND WHERE POSSIBLE, MEASUREMENTS TAKEN IN THE FIELD. THE INFORMATION IS NOT TO BE RELIED ON AS BEING EXACT OR COMPLETE.
4. ALL PR. STORMWATER INFRASTRUCTURE DEPICTED ON THESE PLANS IS TO BE PRIVATELY OWNED AND MAINTAINED UNLESS OTHERWISE NOTED.
5. ALL PR. CURB & GUTTER IS EPC TYBE B PER EL PASO COUNTY STANDARD DETAIL SD_2-20 UNLESS OTHERWISE NOTED.
6. ALL CURB INLET ELEVATIONS ARE SHOWN AT TOP OF CURB. CURB FLOWLINE ELEVATION IS EQUAL TO RIM ELEVATION MINUS 6-INCHES.
7. SEE PLANS FOR MAINLINE SIZES.
8. WATER TIGHT JOINTS TO BE USED WHEN 100-YEAR HGL IS OUTSIDE OF PIPE.

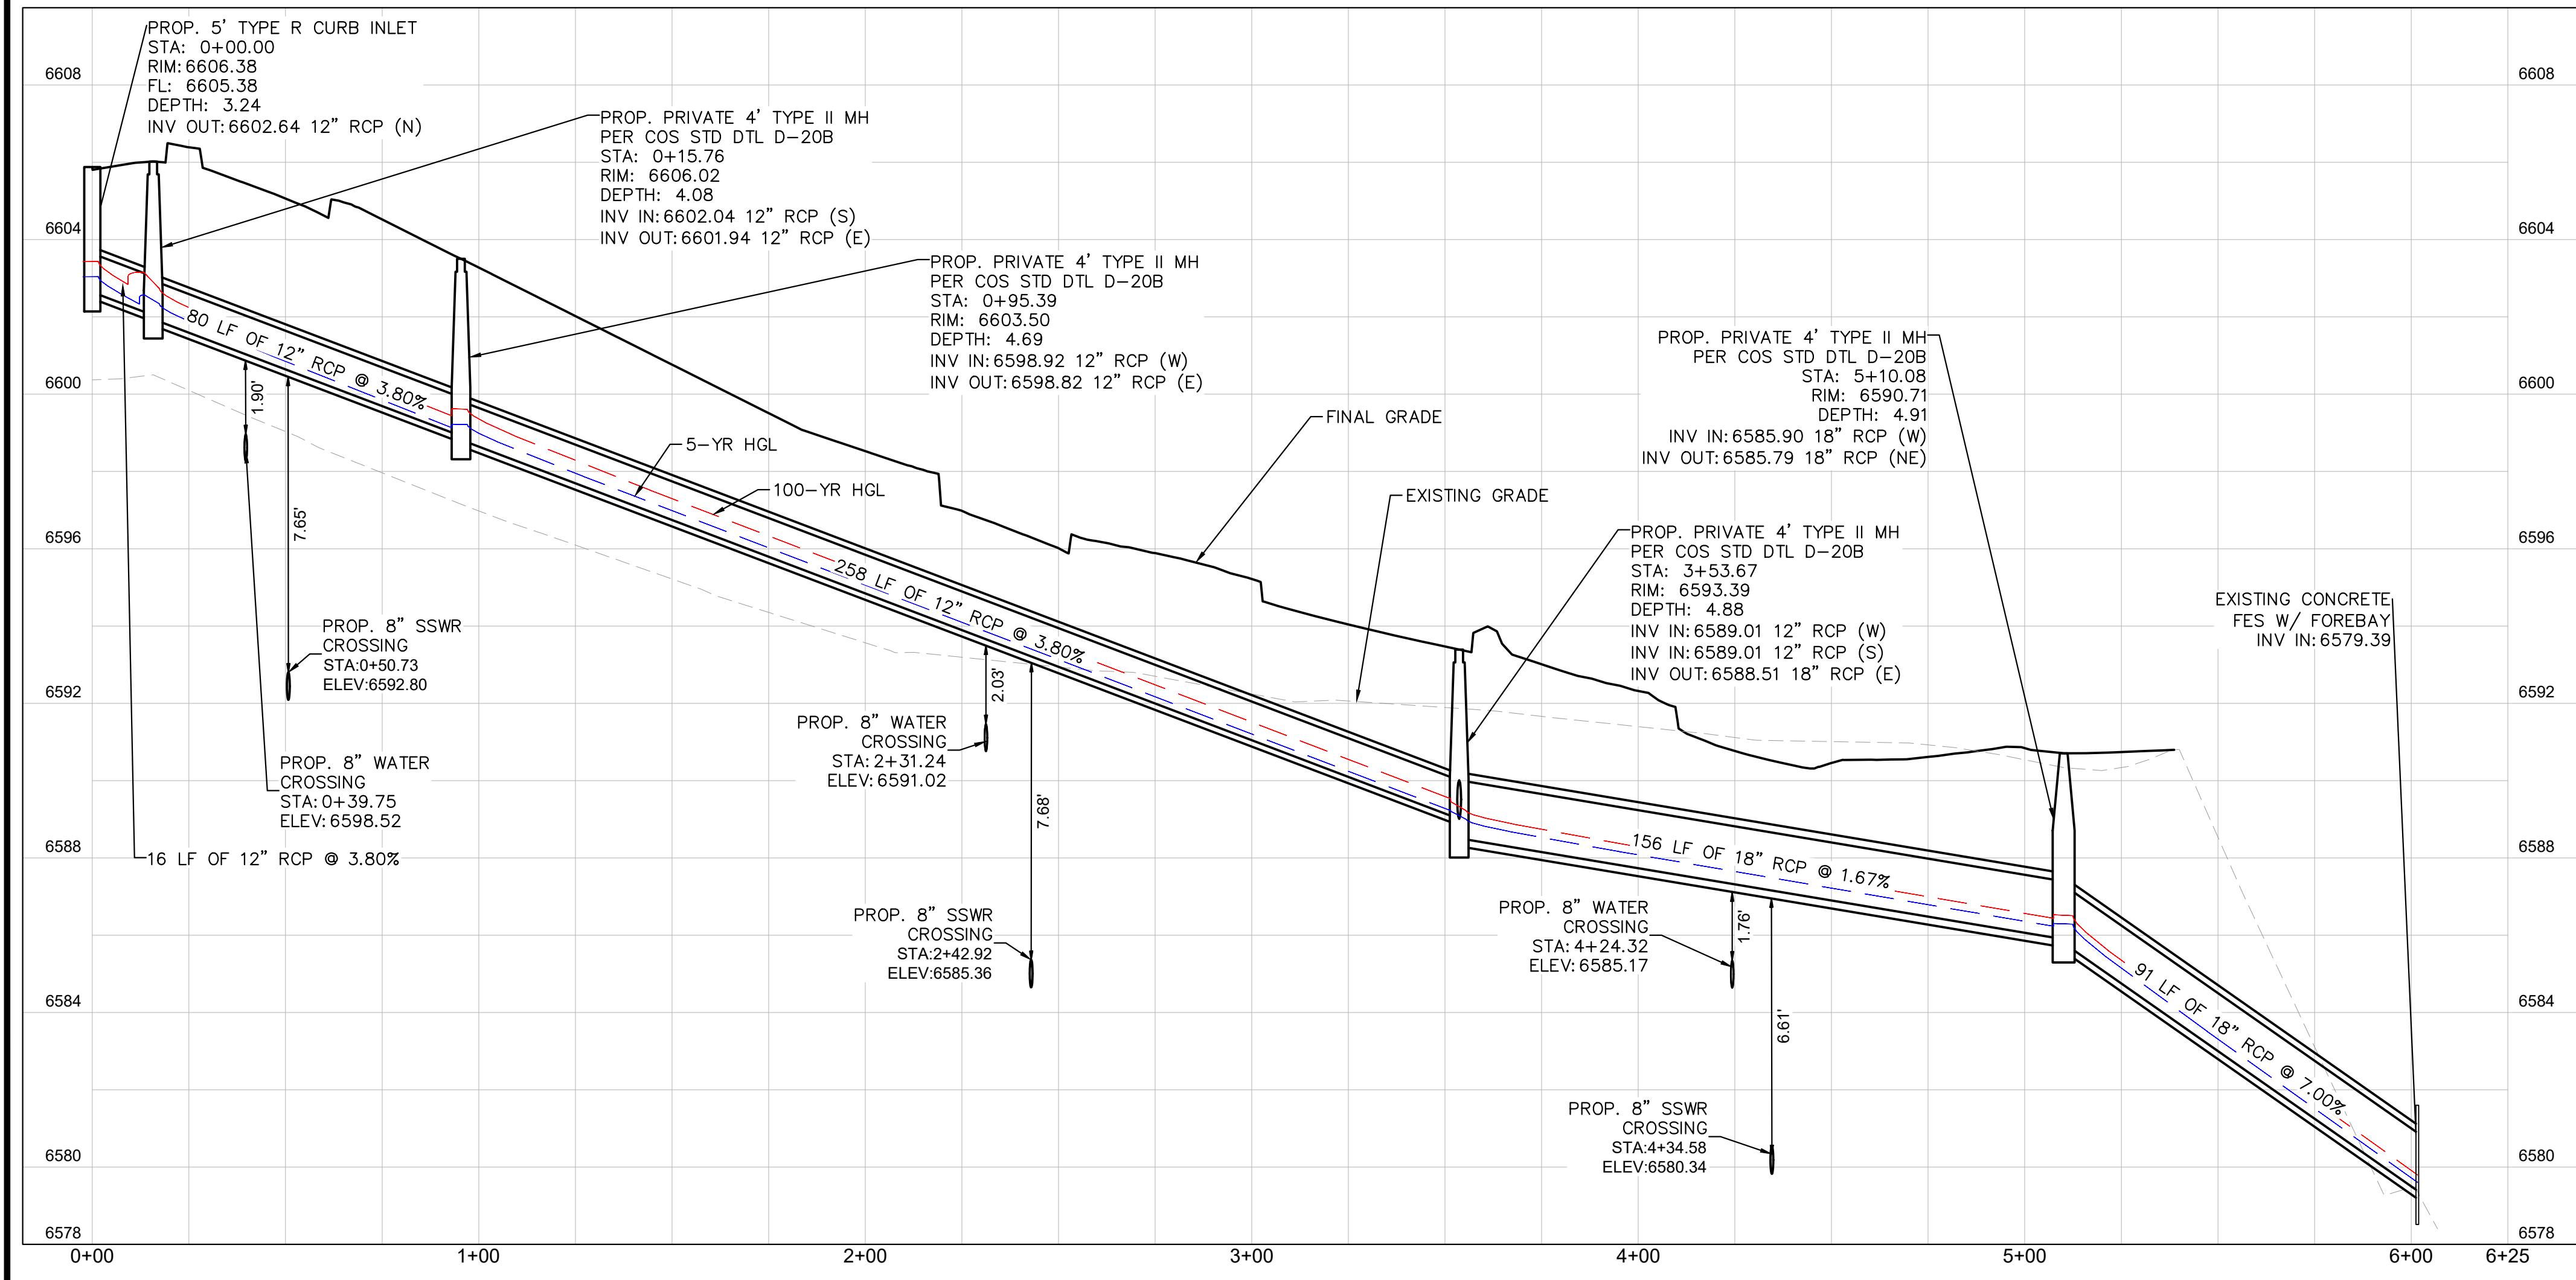

STORM A PROFILE VIEW

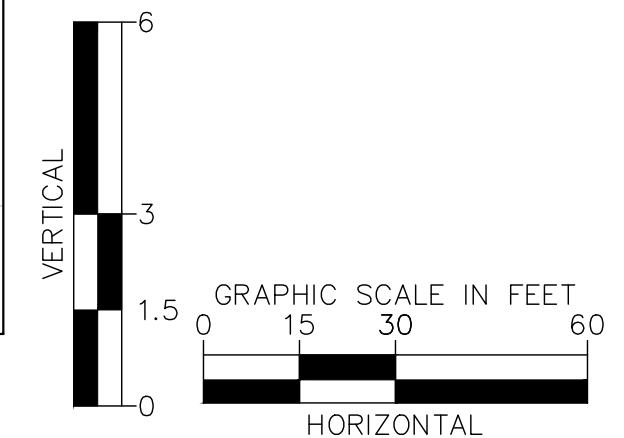

NO.	REVISION	BY	DATE	APPR

Kimley»Horn
 2025 KIMLEY-HORN AND ASSOCIATES, INC.
 2 North Nevada Avenue, Suite 900
 Colorado Springs, Colorado 80903 (719) 453-0180


DESIGNED BY: AJV
 DRAWN BY: TJK
 CHECKED BY: JCP
 DATE: 06/13/2025

WINDEMERE FILING 2 MULTI-FAMILY
 CONSTRUCTION DOCUMENTS
 STORM PLAN AND PROFILE

PROJECT NO.
196160000
 SHEET
C2.0

K:\COS_LA\196160000 - Windemere\CADD\PlanSheets\CDS_CD_STORM.dwg Evans, Wyatt 3/30/2026 8:19 AM

K:\COS_LA\196160000 - Windemere\CADD\PlanSheets\CDS\CD_STORM.dwg Evans, Wyatt 3/30/2026 8:20 AM

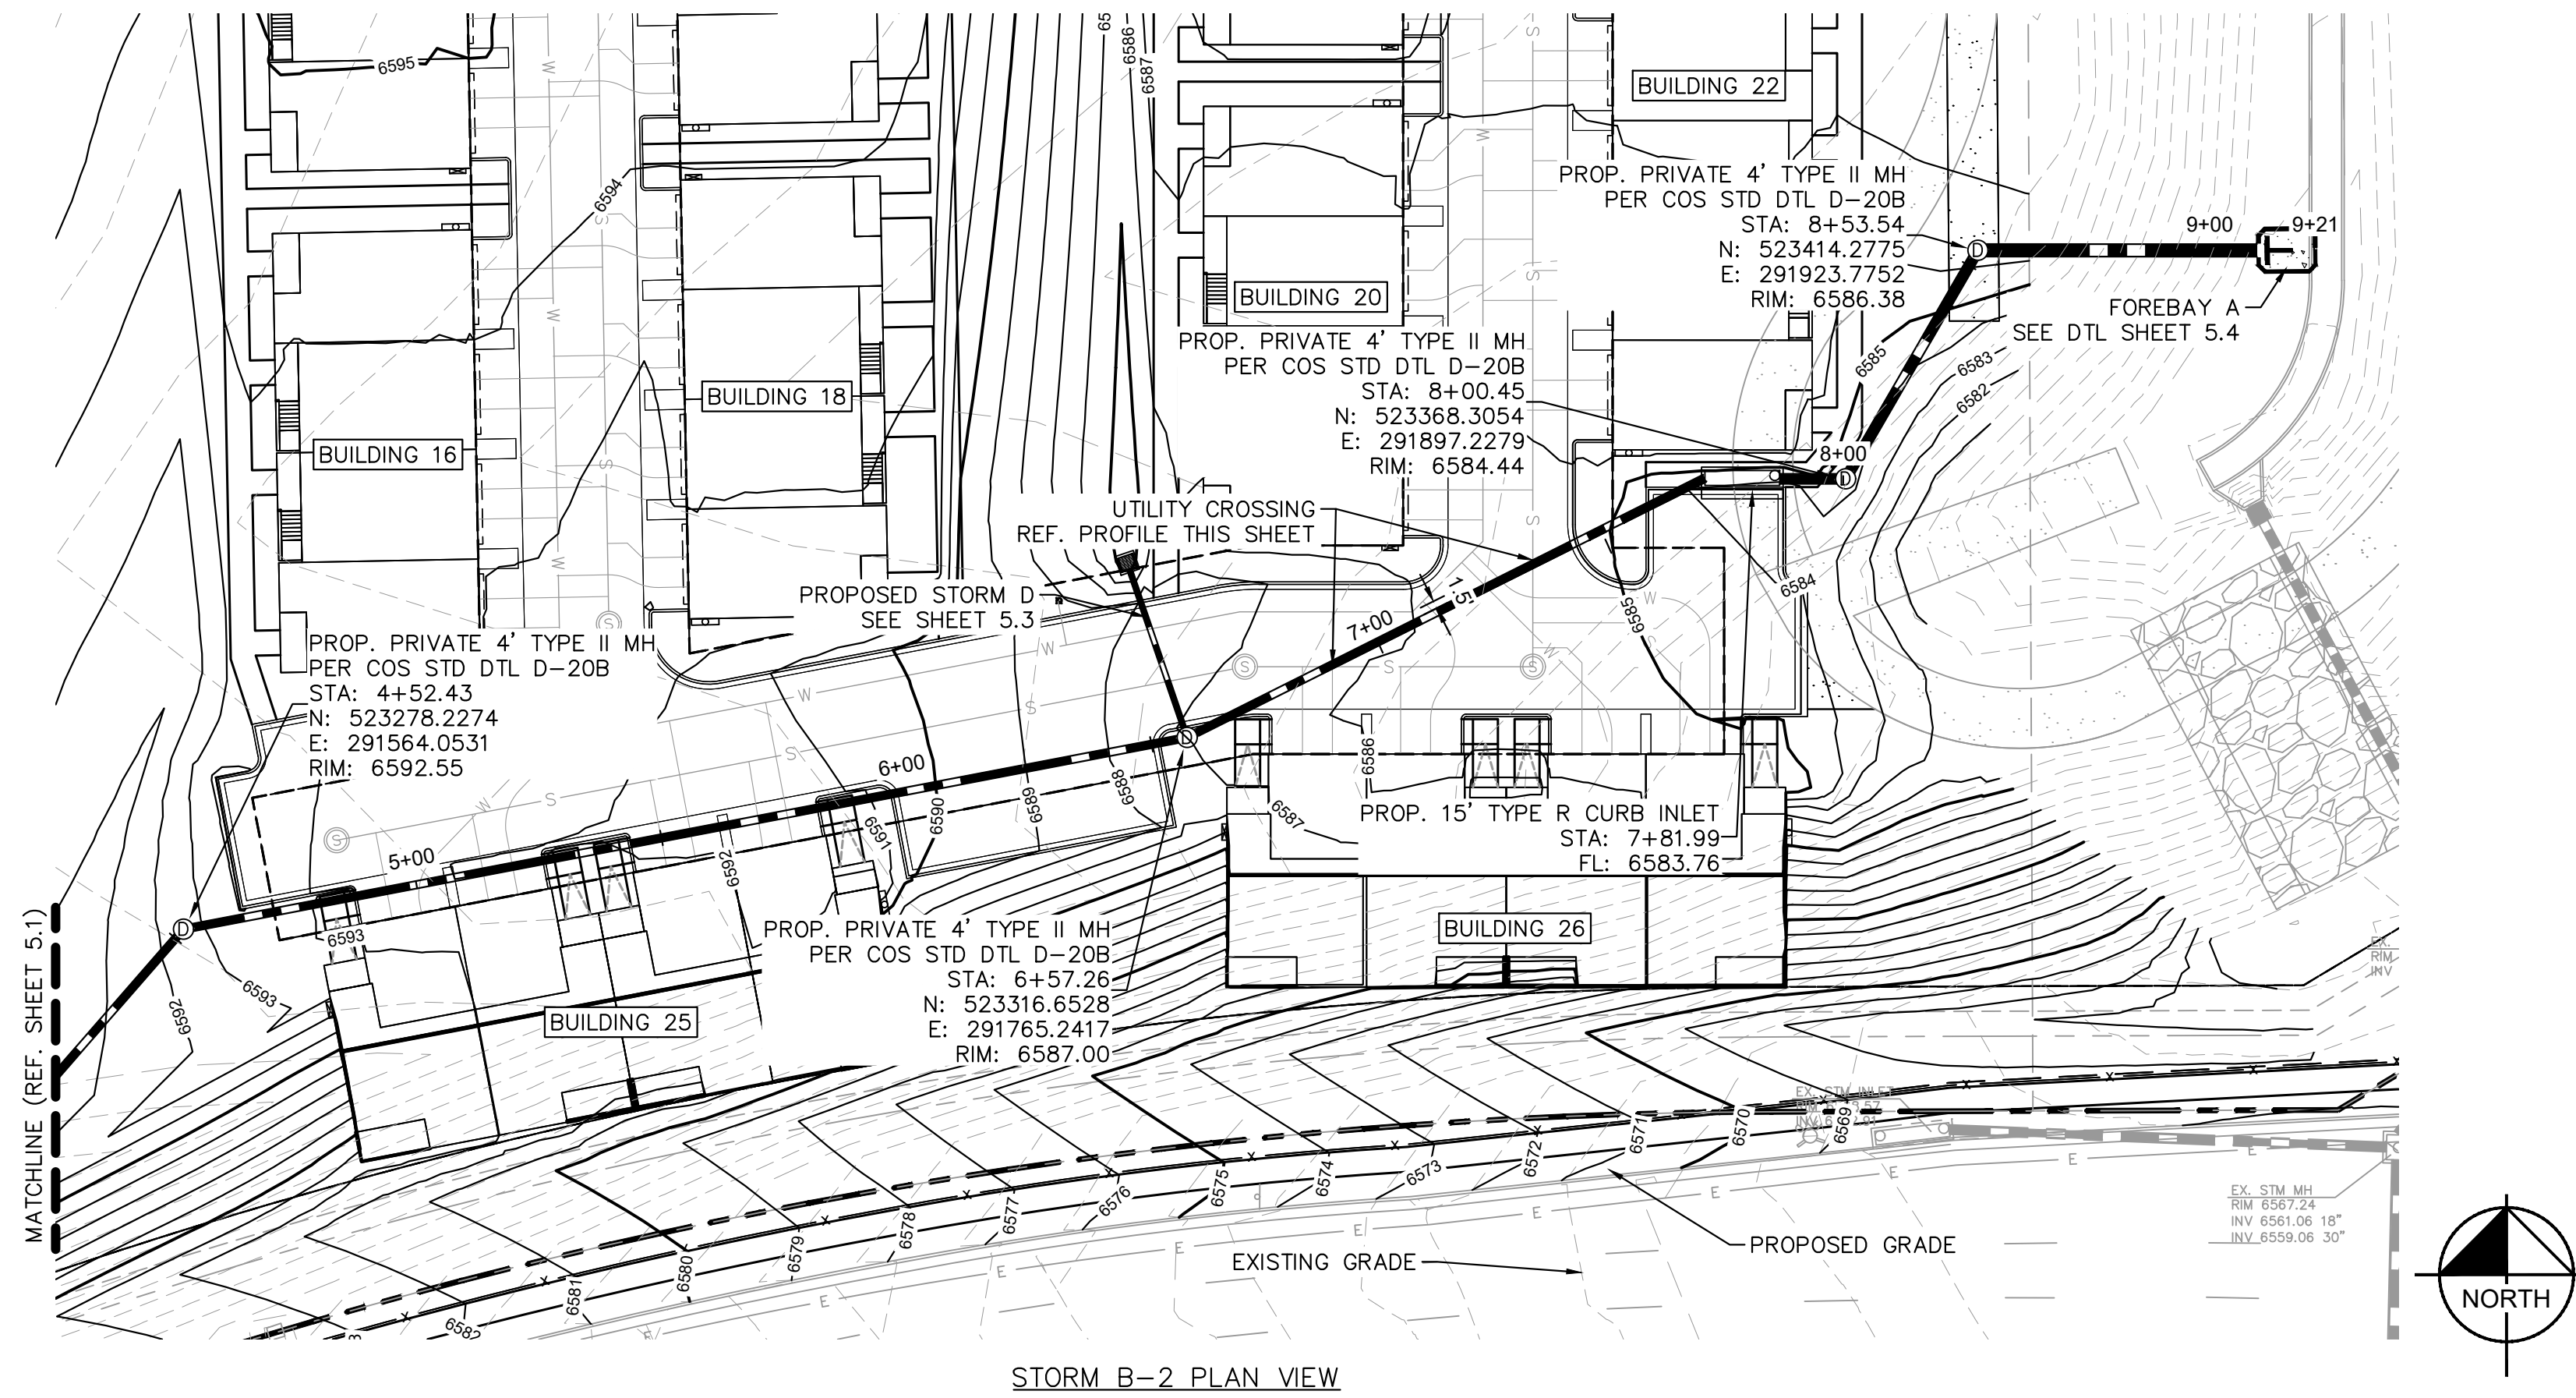


LEGEND

- PROPERTY LINE
- x-x- PROPOSED FENCE
- W- PROPOSED 6" PVC WATER MAIN
- S- PROPOSED 8" PVC SANITARY MAIN
- PROPOSED PVC STORM MAIN

NOTES

1. ALL EXISTING UTILITIES TO REMAIN UNLESS OTHERWISE NOTED.
2. UTILITIES TO BE REMOVED ARE TO BE CAPPED IN PLACE IN ACCORDANCE WITH LOCAL UTILITY REGULATIONS.
3. THE LOCATION AND/OR ELEVATION OF EXISTING UTILITIES AS SHOWN ON THESE PLANS IS BASED ON RECORDS OF THE VARIOUS UTILITY COMPANIES, AND WHERE POSSIBLE, MEASUREMENTS TAKEN IN THE FIELD. THE INFORMATION IS NOT TO BE RELIED ON AS BEING EXACT OR COMPLETE.
4. ALL PR. STORMWATER INFRASTRUCTURE DEPICTED ON THESE PLANS IS TO BE PRIVATELY OWNED AND MAINTAINED UNLESS OTHERWISE NOTED.
5. ALL PR. CURB & GUTTER IS EPC TYBE B PER EL PASO COUNTY STANDARD DETAIL SD_2-20 UNLESS OTHERWISE NOTED.
6. ALL CURB INLET RIM ELEVATIONS ARE SHOWN AT TOP OF CURB. CURB FLOWLINE ELEVATION IS EQUAL TO RIM ELEVATION MINUS 6-INCHES.
7. SEE PLANS FOR MAINLINE SIZES.
8. WATER TIGHT JOINTS TO BE USED WHEN 100-YEAR HGL IS OUTSIDE OF PIPE.

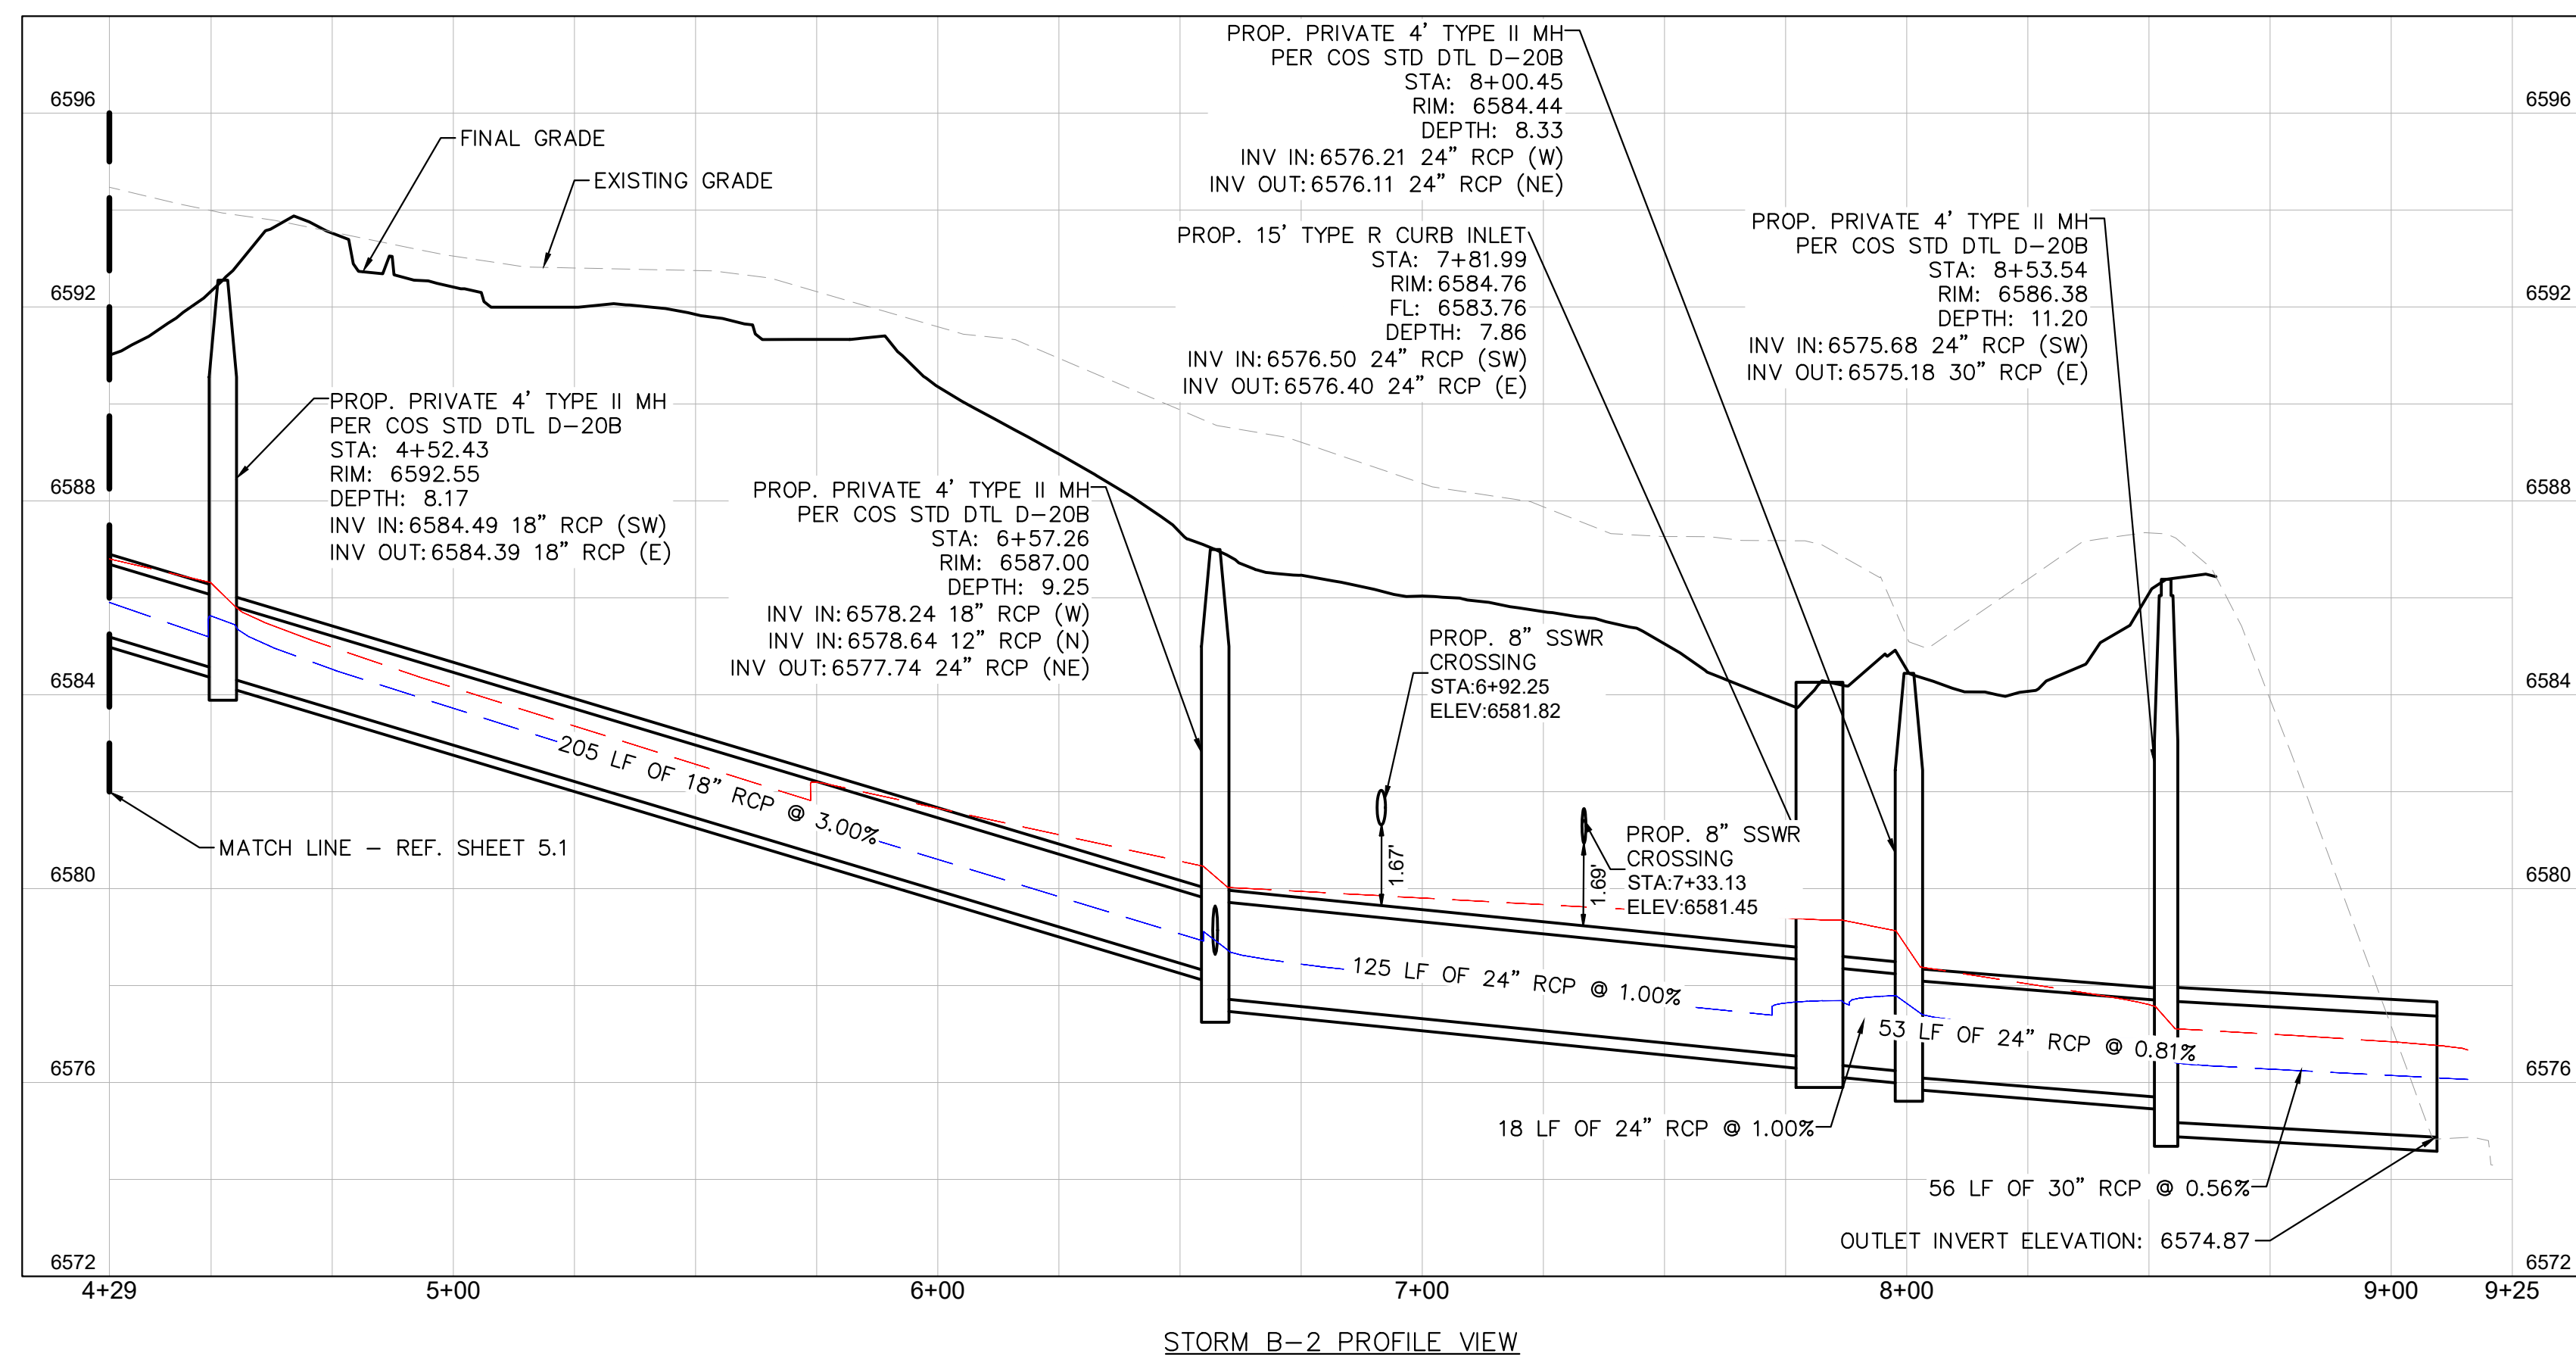

NO.	REVISION	BY	DATE	APPR

Kimley»Horn
 2025 KIMLEY-HORN AND ASSOCIATES, INC.
 2 North Nevada Avenue, Suite 900
 Colorado Springs, Colorado 80903 (719) 453-0180

DESIGNED BY: AJV
 DRAWN BY: TJK
 CHECKED BY: JCP
 DATE: 06/13/2025





WINDEMERE FILING 2 MULTI-FAMILY
 CONSTRUCTION DOCUMENTS
 STORM PLAN AND PROFILE

PROJECT NO.
196160000

SHEET
C2.2



K:\COS_LA\196160000 - Windemere\CADD\PlanSheets\CDS_CD_STORM.dwg Evans, Wyatt 3/30/2026 8:20 AM

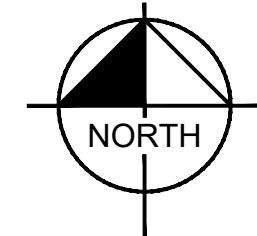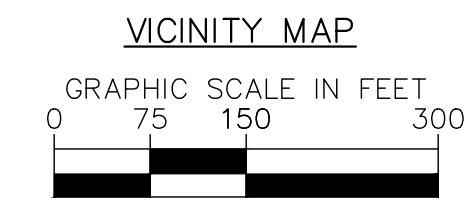
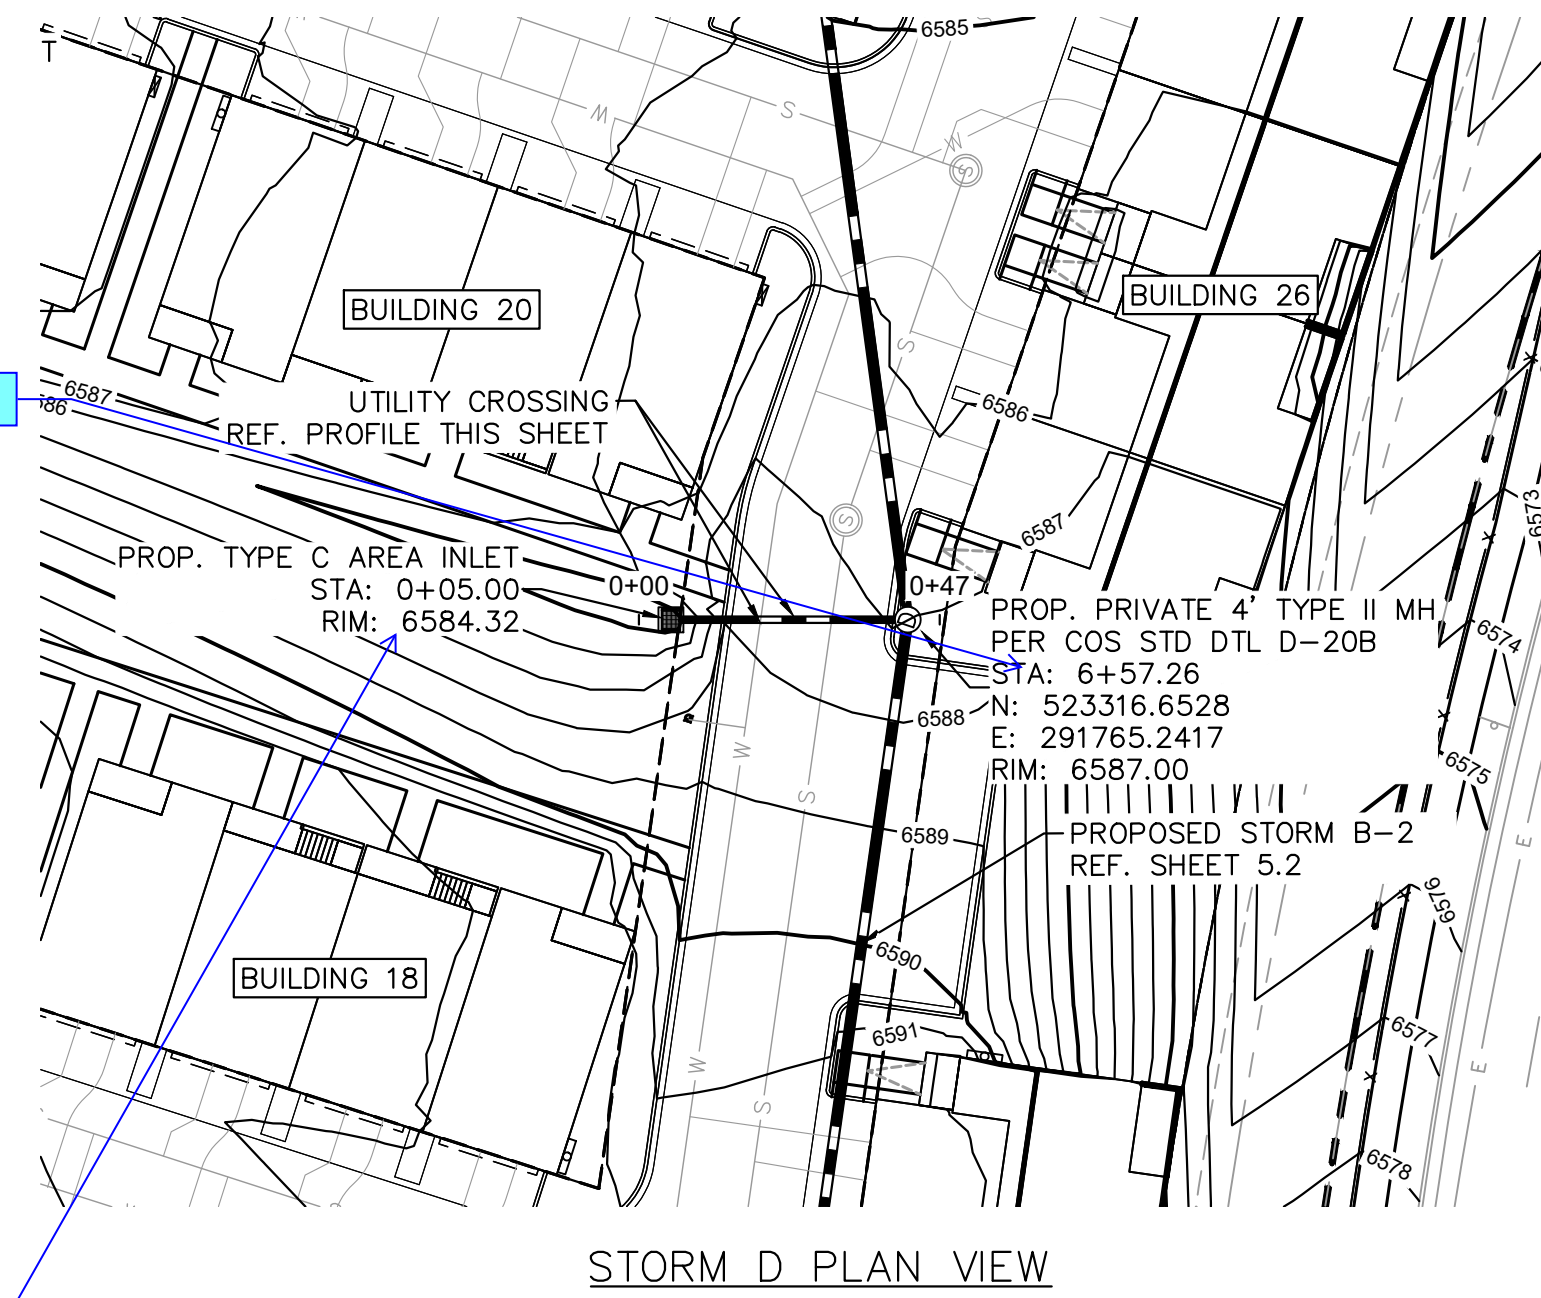
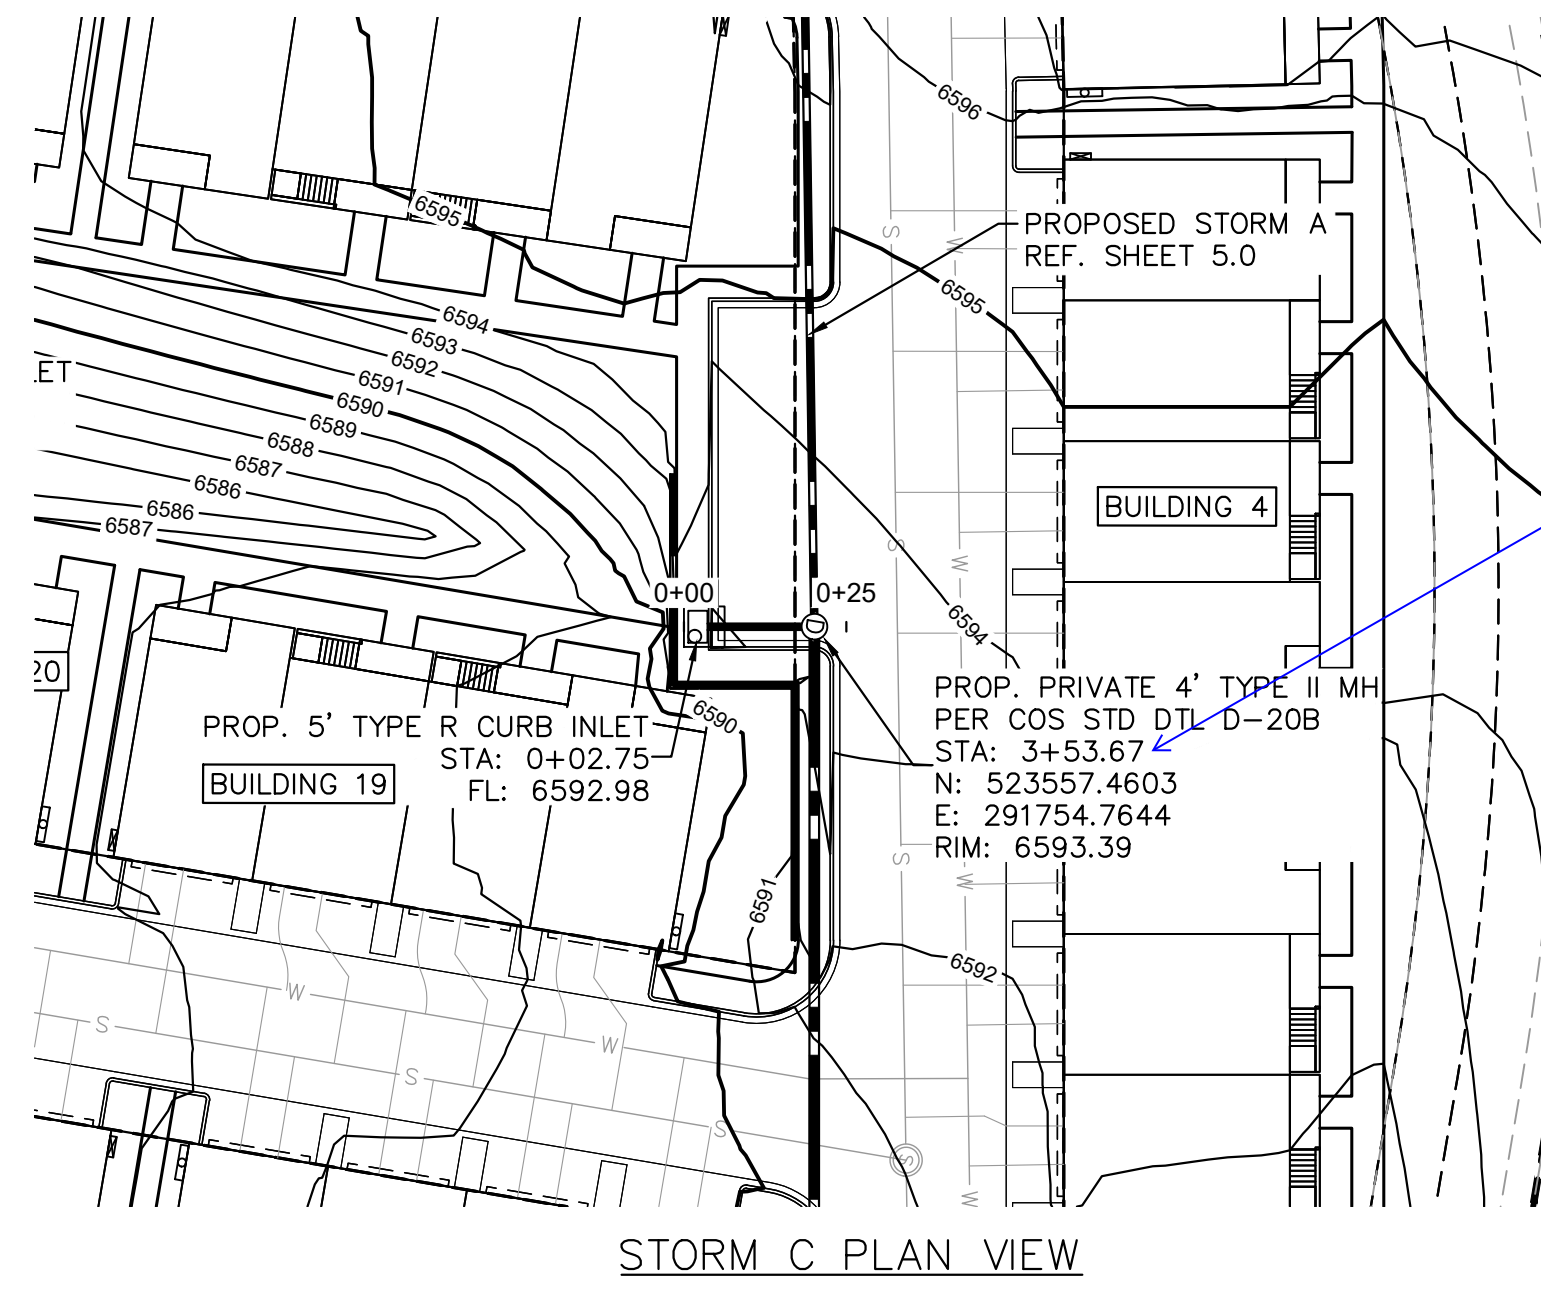


LEGEND

- PROPERTY LINE
- x - x - PROPOSED FENCE
- w - PROPOSED 6" PVC WATER MAIN
- s - PROPOSED 8" PVC SANITARY MAIN
- PROPOSED PVC STORM MAIN

NOTES

1. ALL EXISTING UTILITIES TO REMAIN UNLESS OTHERWISE NOTED.
2. UTILITIES TO BE REMOVED ARE TO BE CAPPED IN PLACE IN ACCORDANCE WITH LOCAL UTILITY REGULATIONS.
3. THE LOCATION AND/OR ELEVATION OF EXISTING UTILITIES AS SHOWN ON THESE PLANS IS BASED ON RECORDS OF THE VARIOUS UTILITY COMPANIES, AND WHERE POSSIBLE, MEASUREMENTS TAKEN IN THE FIELD. THE INFORMATION IS NOT TO BE RELIED ON AS BEING EXACT OR COMPLETE.
4. ALL PR. STORMWATER INFRASTRUCTURE DEPICTED ON THESE PLANS IS TO BE PRIVATELY OWNED AND MAINTAINED UNLESS OTHERWISE NOTED.
5. ALL PR. CURB & GUTTER IS EPC TYBE B PER EL PASO COUNTY STANDARD DETAIL SD_2-20 UNLESS OTHERWISE NOTED.
6. ALL CURB INLET RIM ELEVATIONS ARE SHOWN AT TOP OF CURB. CURB FLOWLINE ELEVATION IS EQUAL TO RIM ELEVATION MINUS 6-INCHES.
7. SEE PLANS FOR MAINLINE SIZES.
8. WATER TIGHT JOINTS TO BE USED WHEN 100-YEAR HGL IS OUTSIDE OF PIPE.

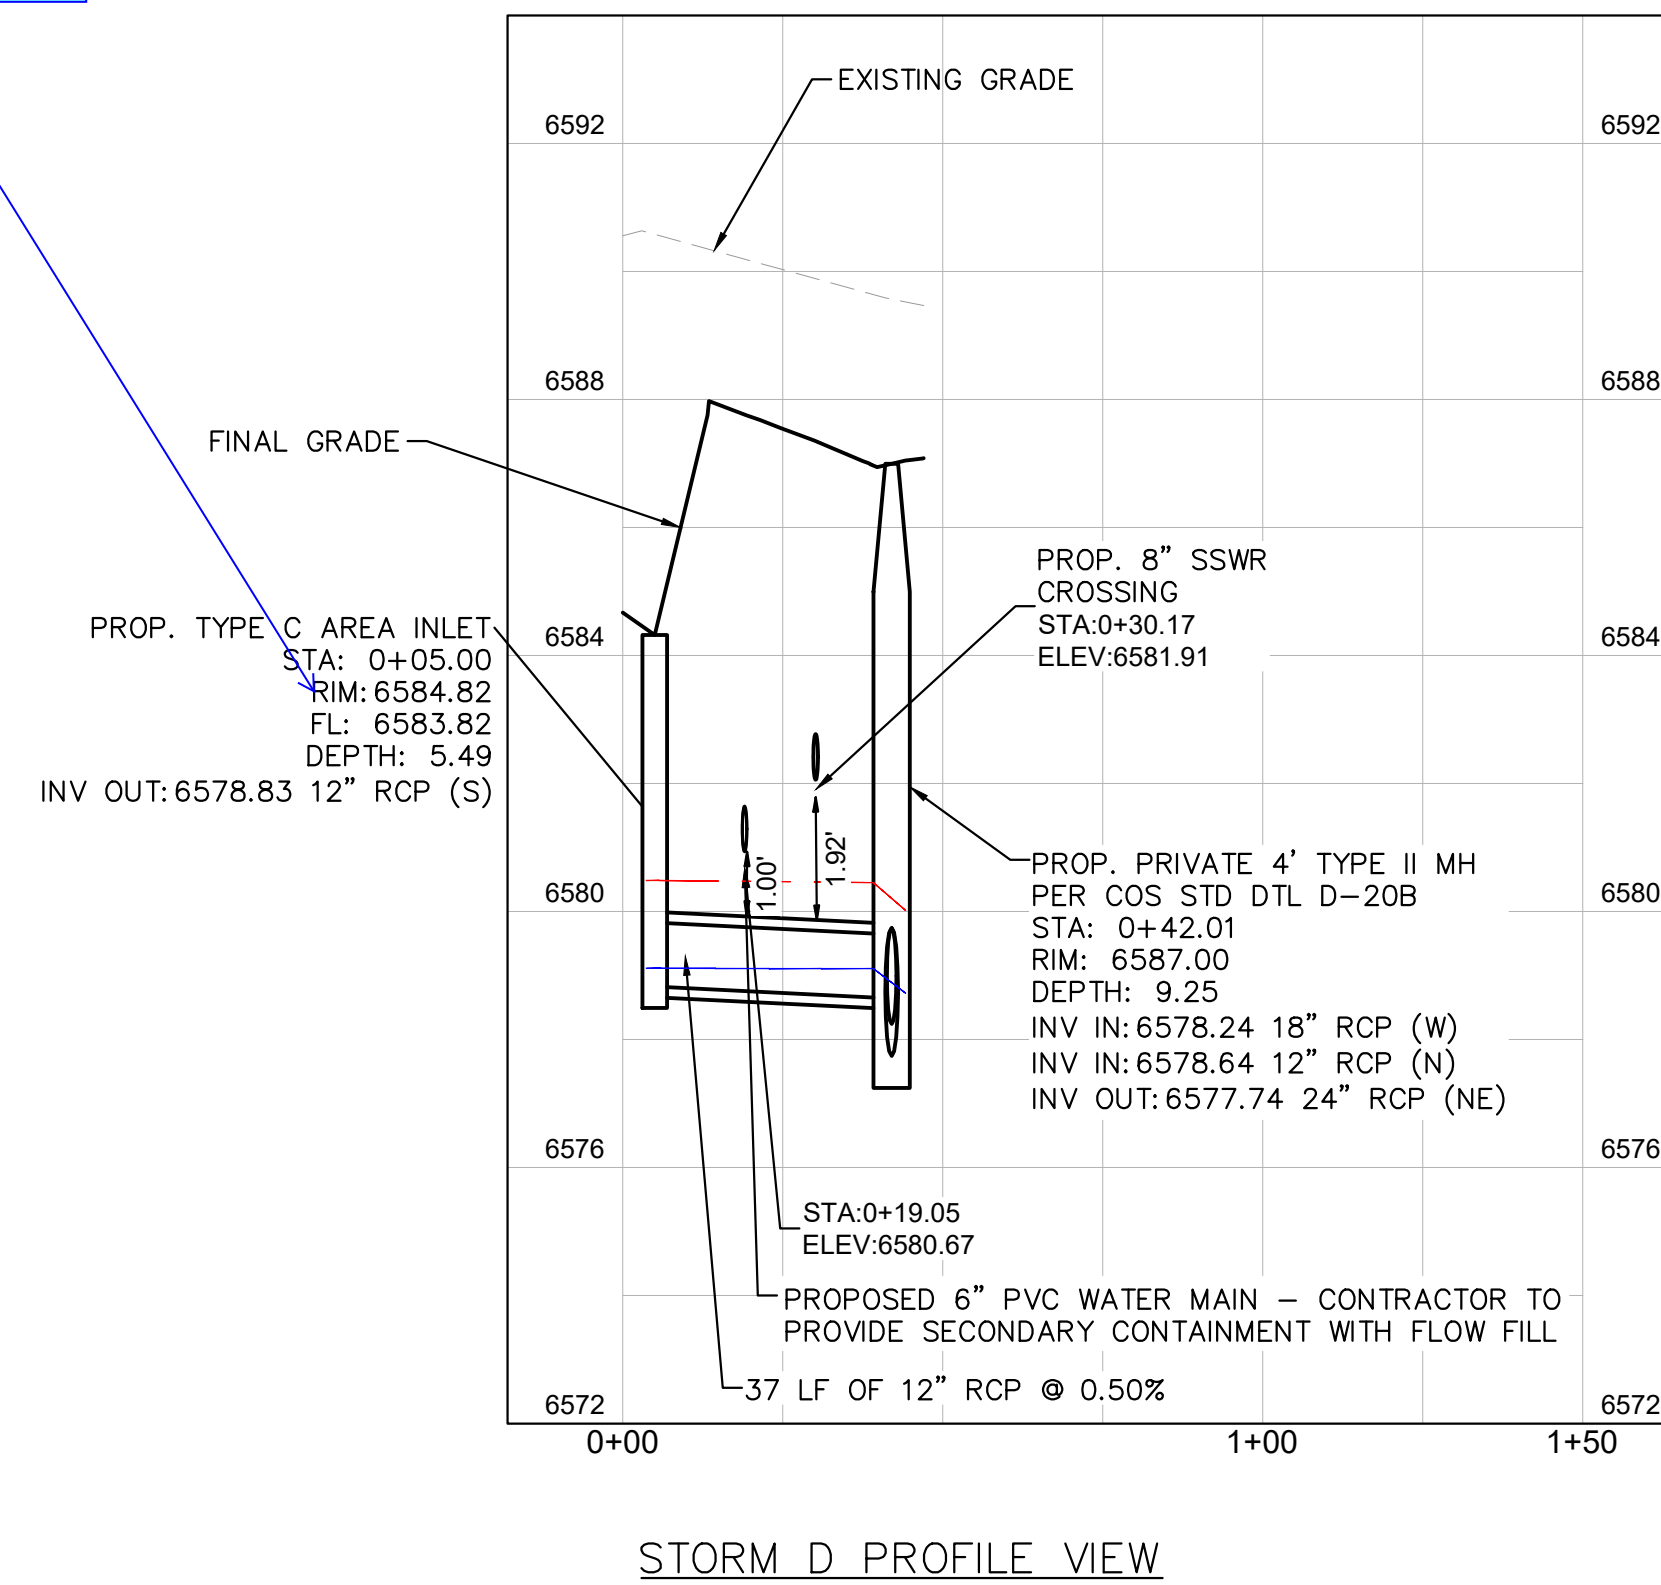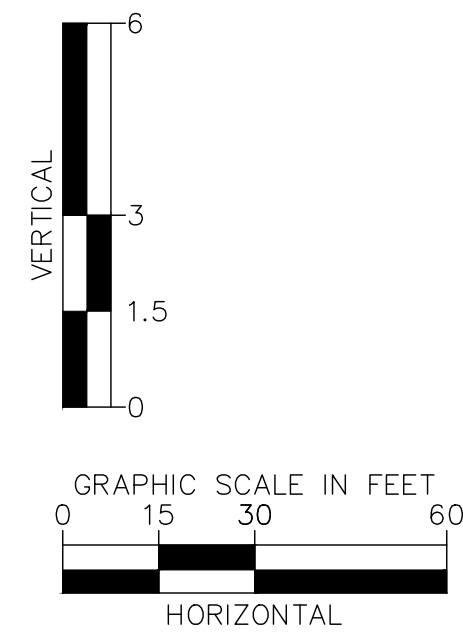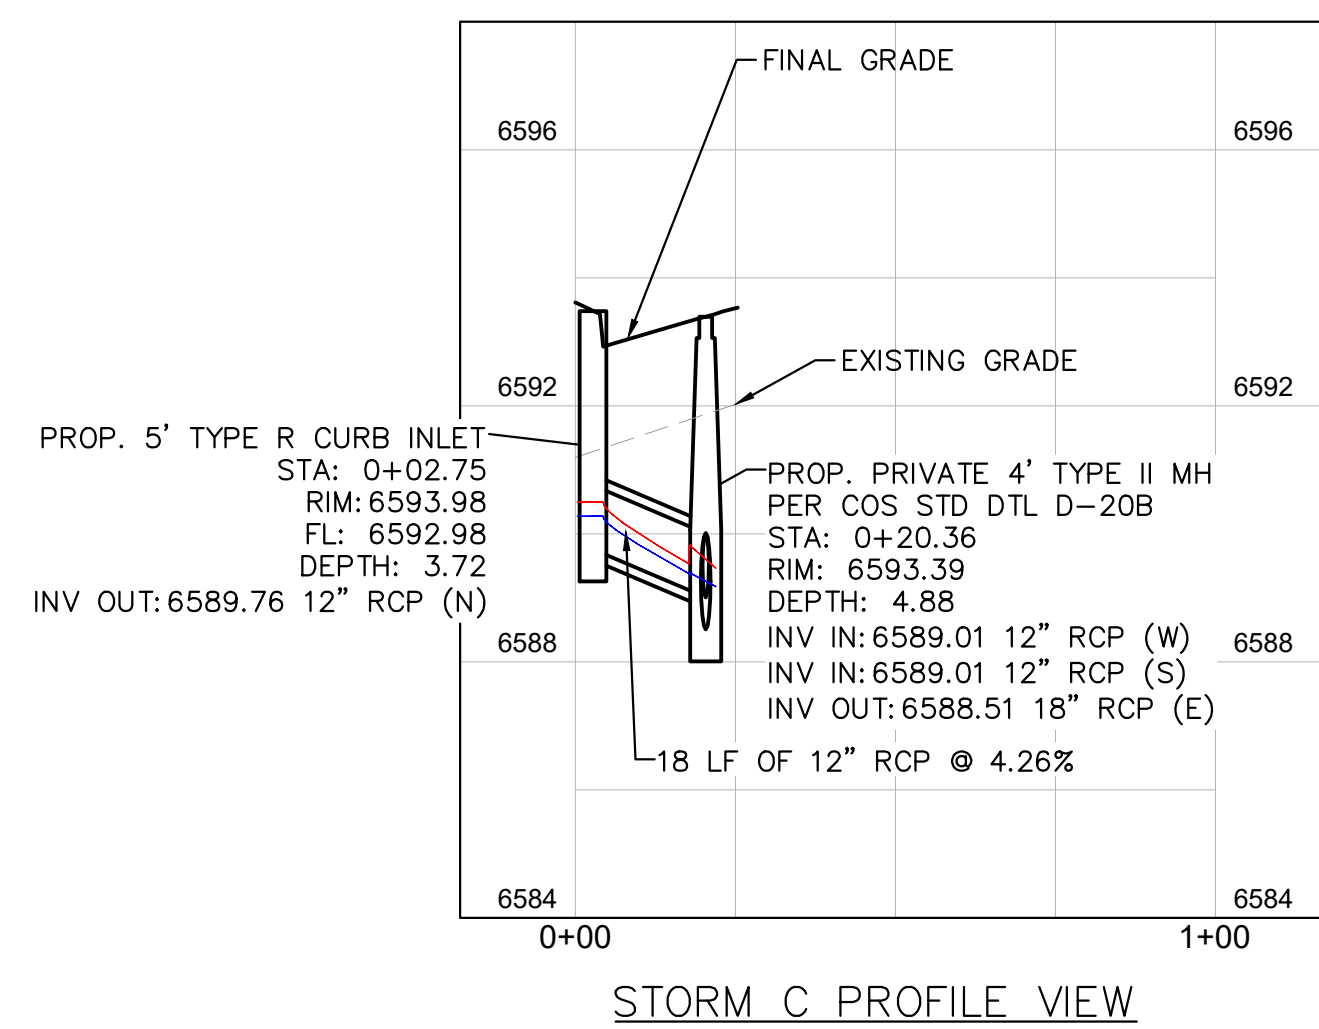

NO.	REVISION	BY	DATE	APPR

Kimley»Horn
2025 KIMLEY-HORN AND ASSOCIATES, INC.
2 North Nevada Avenue, Suite 900
Colorado Springs, Colorado 80903 (719) 453-0180


DESIGNED BY: AJV
DRAWN BY: TJK
CHECKED BY: JCP
DATE: 06/13/2025

WINDEMERE FILING 2 MULTI-FAMILY
CONSTRUCTION DOCUMENTS
STORM PLAN AND PROFILE


PROJECT NO.
196160000

SHEET
C2.3




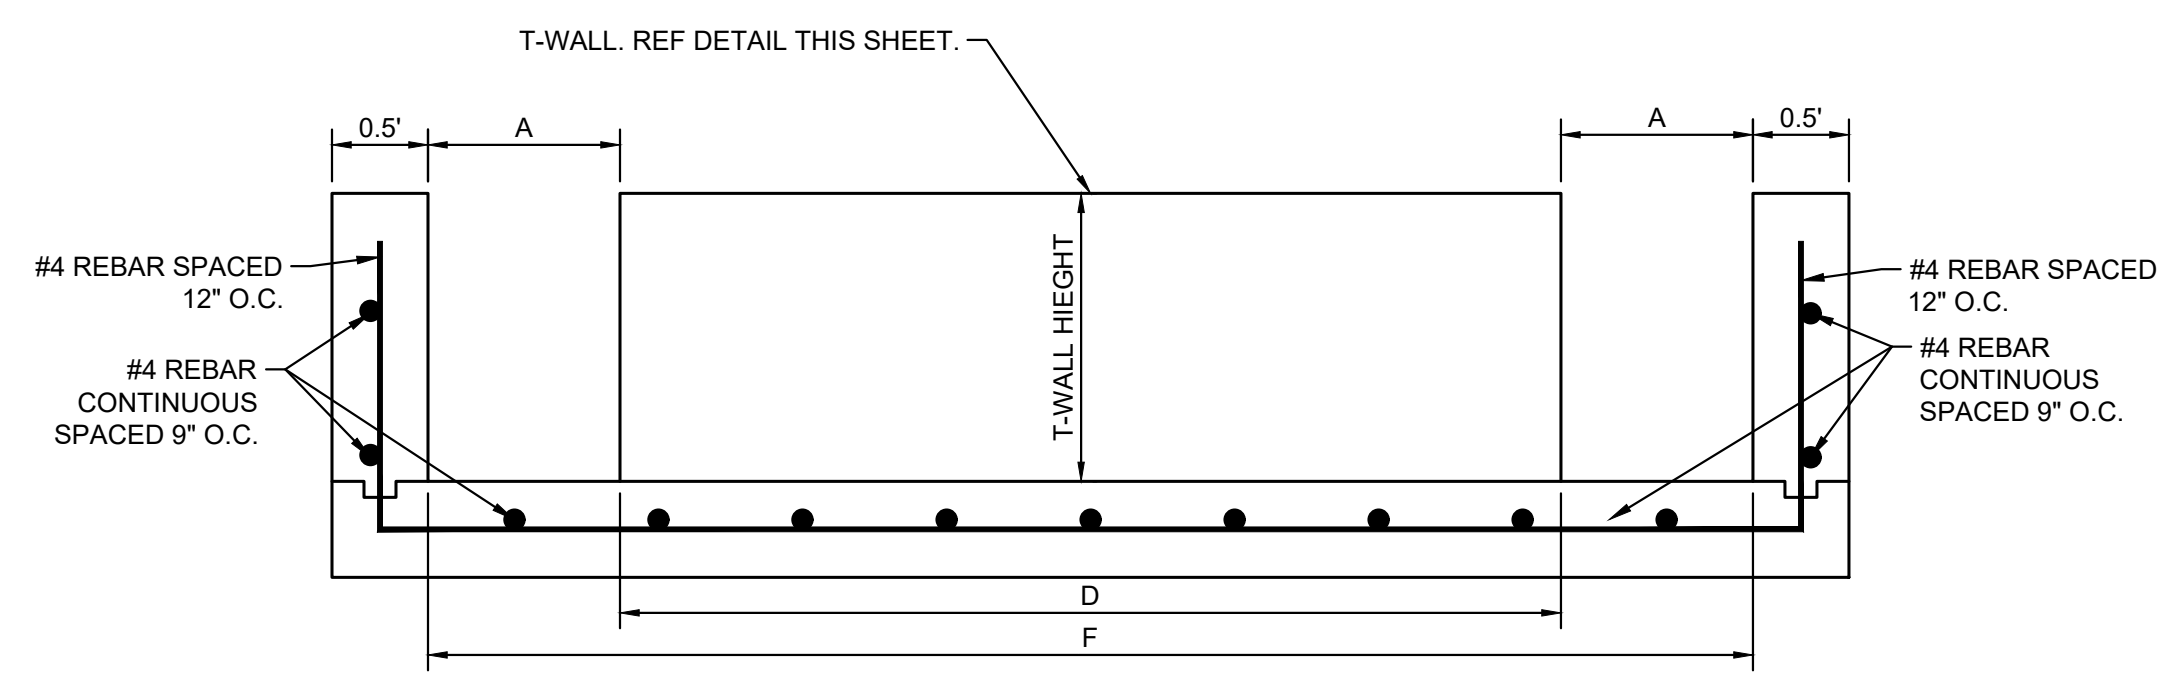


FOREBAY DETAIL W/ CONCRETE BOTTOM
N.T.S.

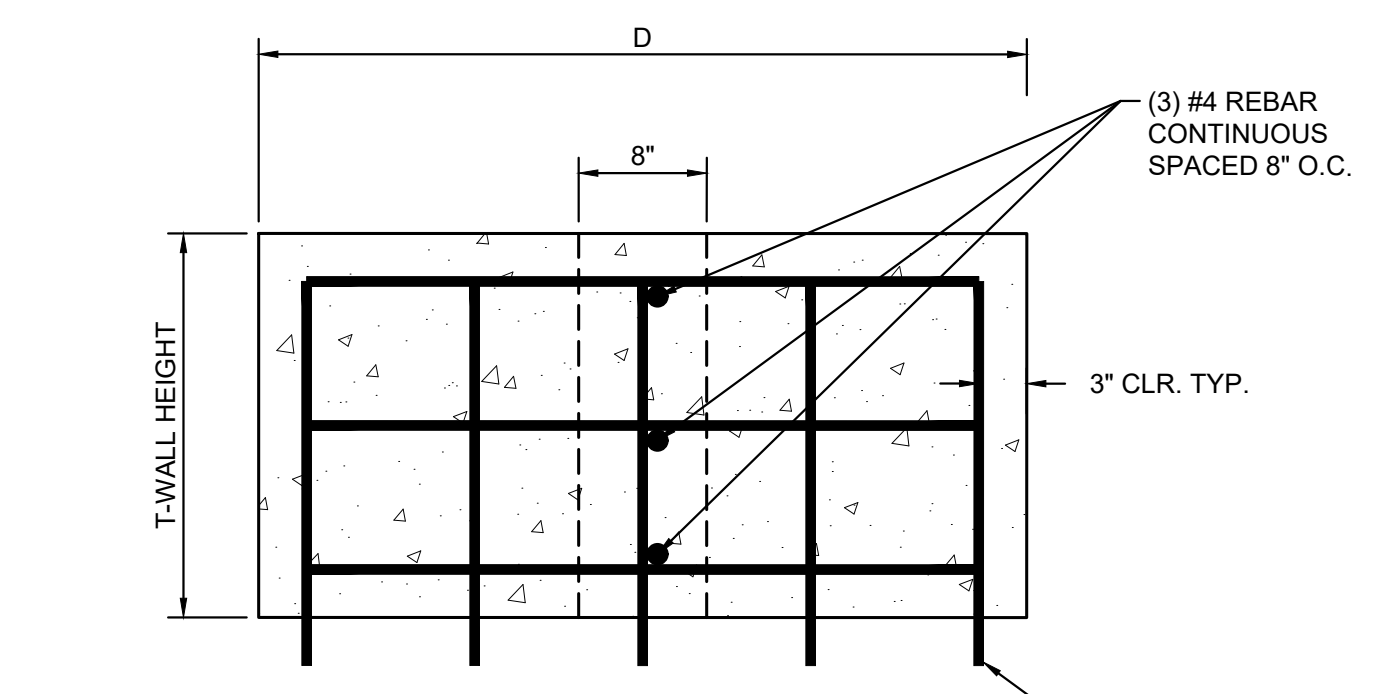



FOREBAY T-WALL DETAIL
N.T.S.

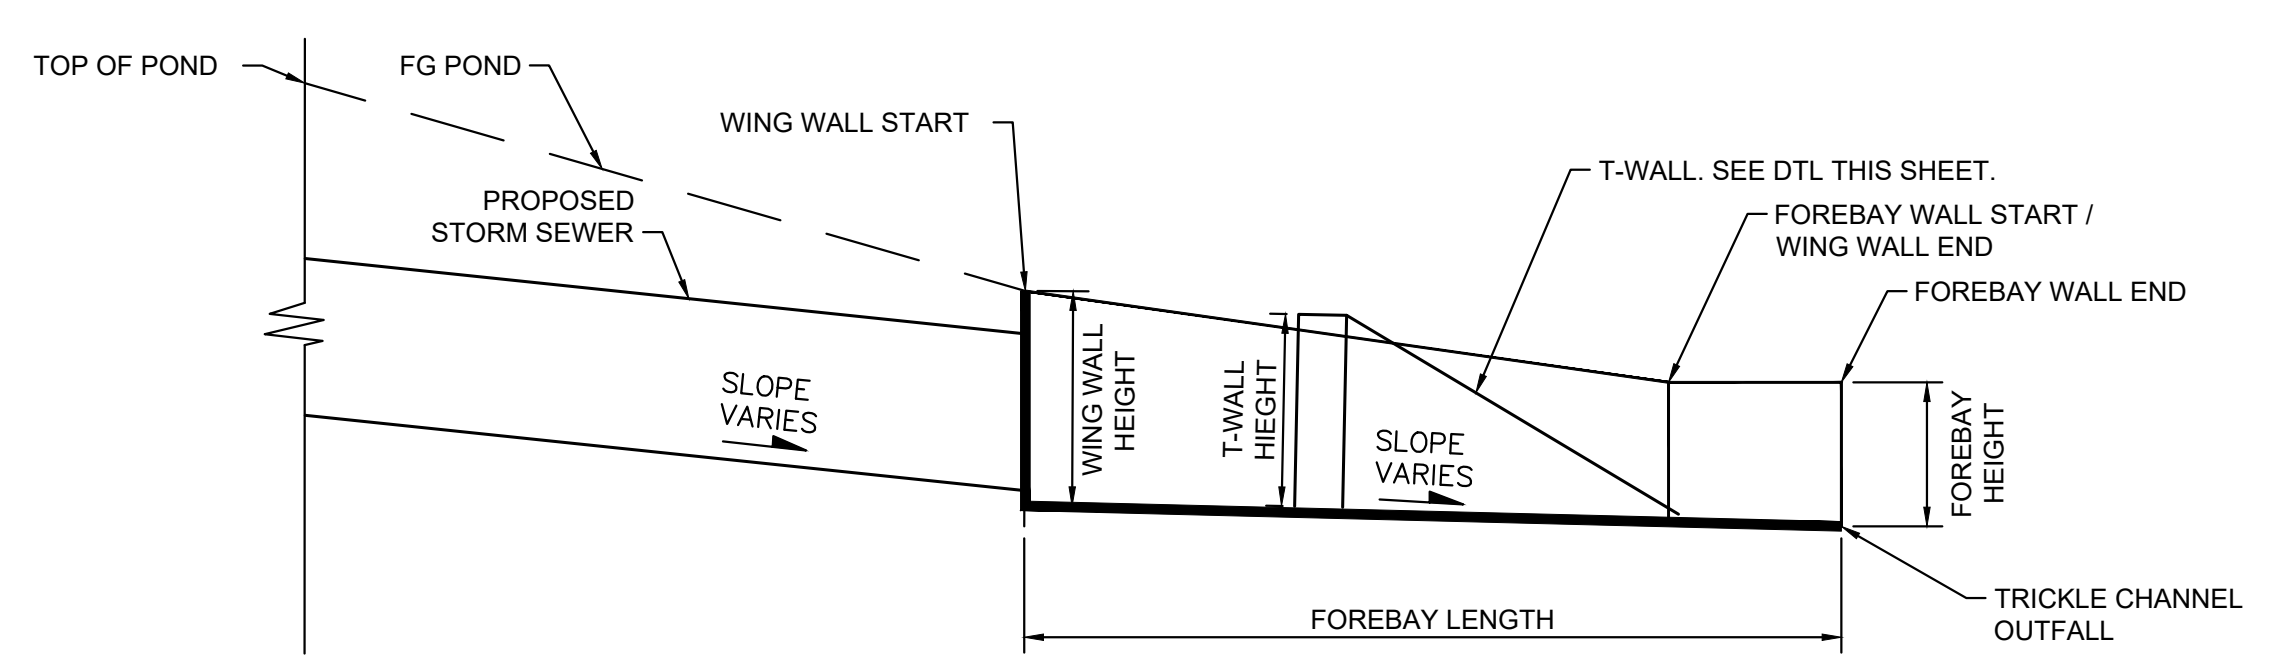

FOREBAY PROFILE VIEW
N.T.S.

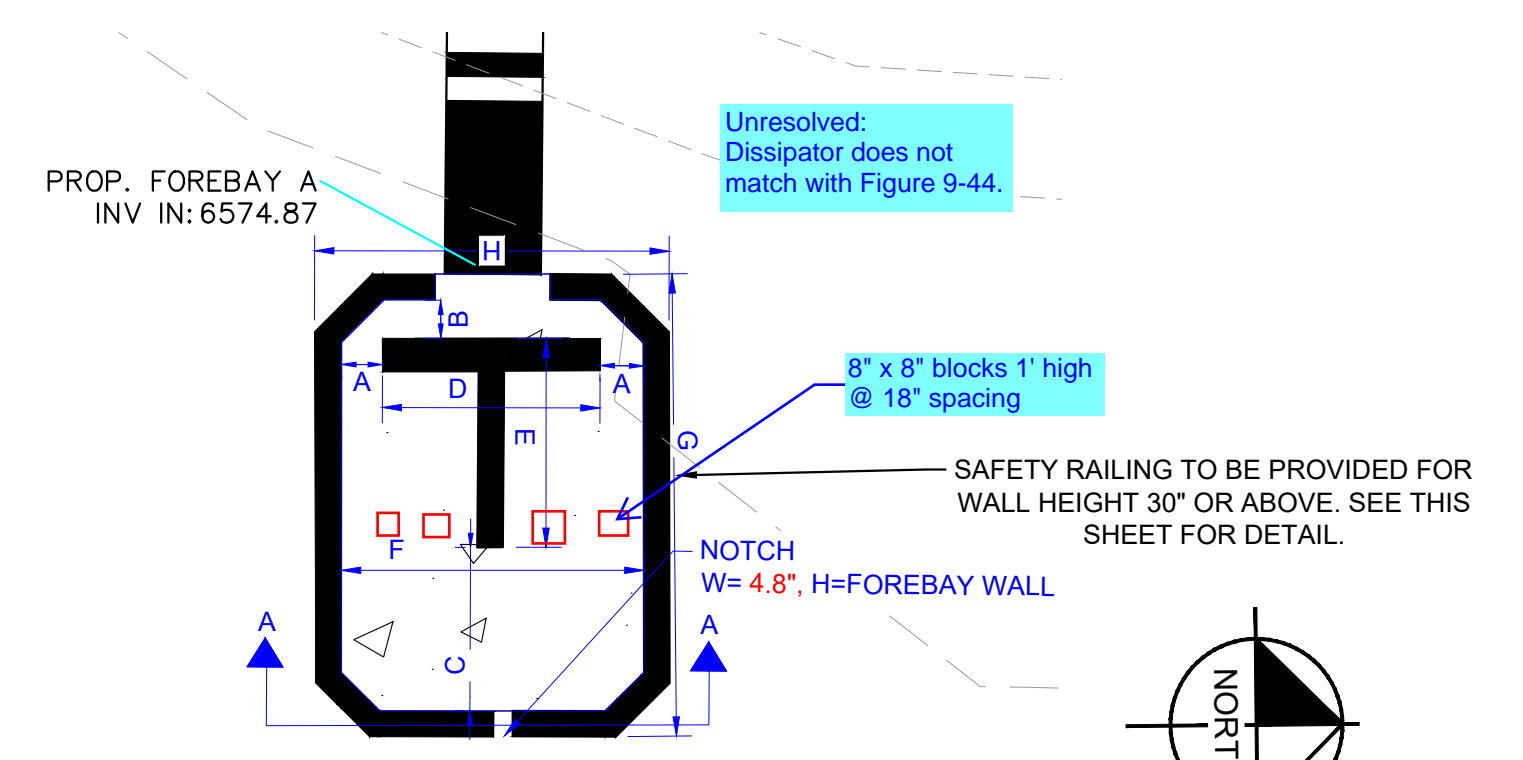

FOREBAY A
(SEE DTL SHEET C2.5 FOR WING WALL REINFORCEMENT)

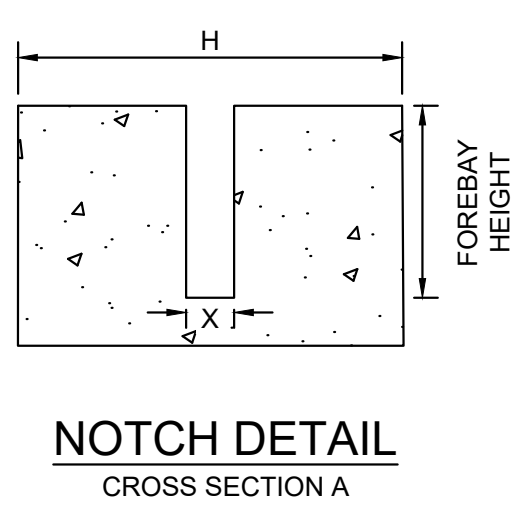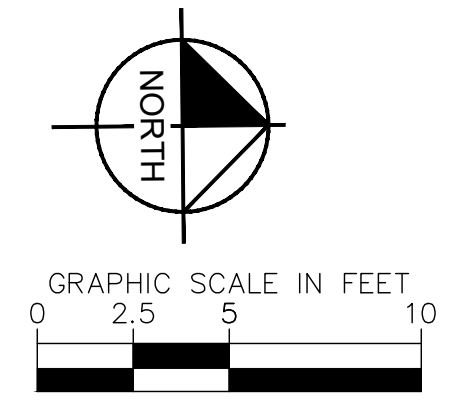

NOTCH DETAIL
CROSS SECTION A


HEIGHTS (FT)	
LOCATION	FOREBAY A
WING WALL	3.75
T-WALL	3.5
FOREBAY	2.5
X = NOTCH WIDTH (INCH)	4.8

LENGTHS (FT)	
LOCATION	FOREBAY A
A	1.0
B	1.0
C	4.0
D	5.5
E	5.5
F	8.0
G	12.0
H	9.0

1.5' Minimum per Fig 9-44

5' per Figure 9-44

2.666666'

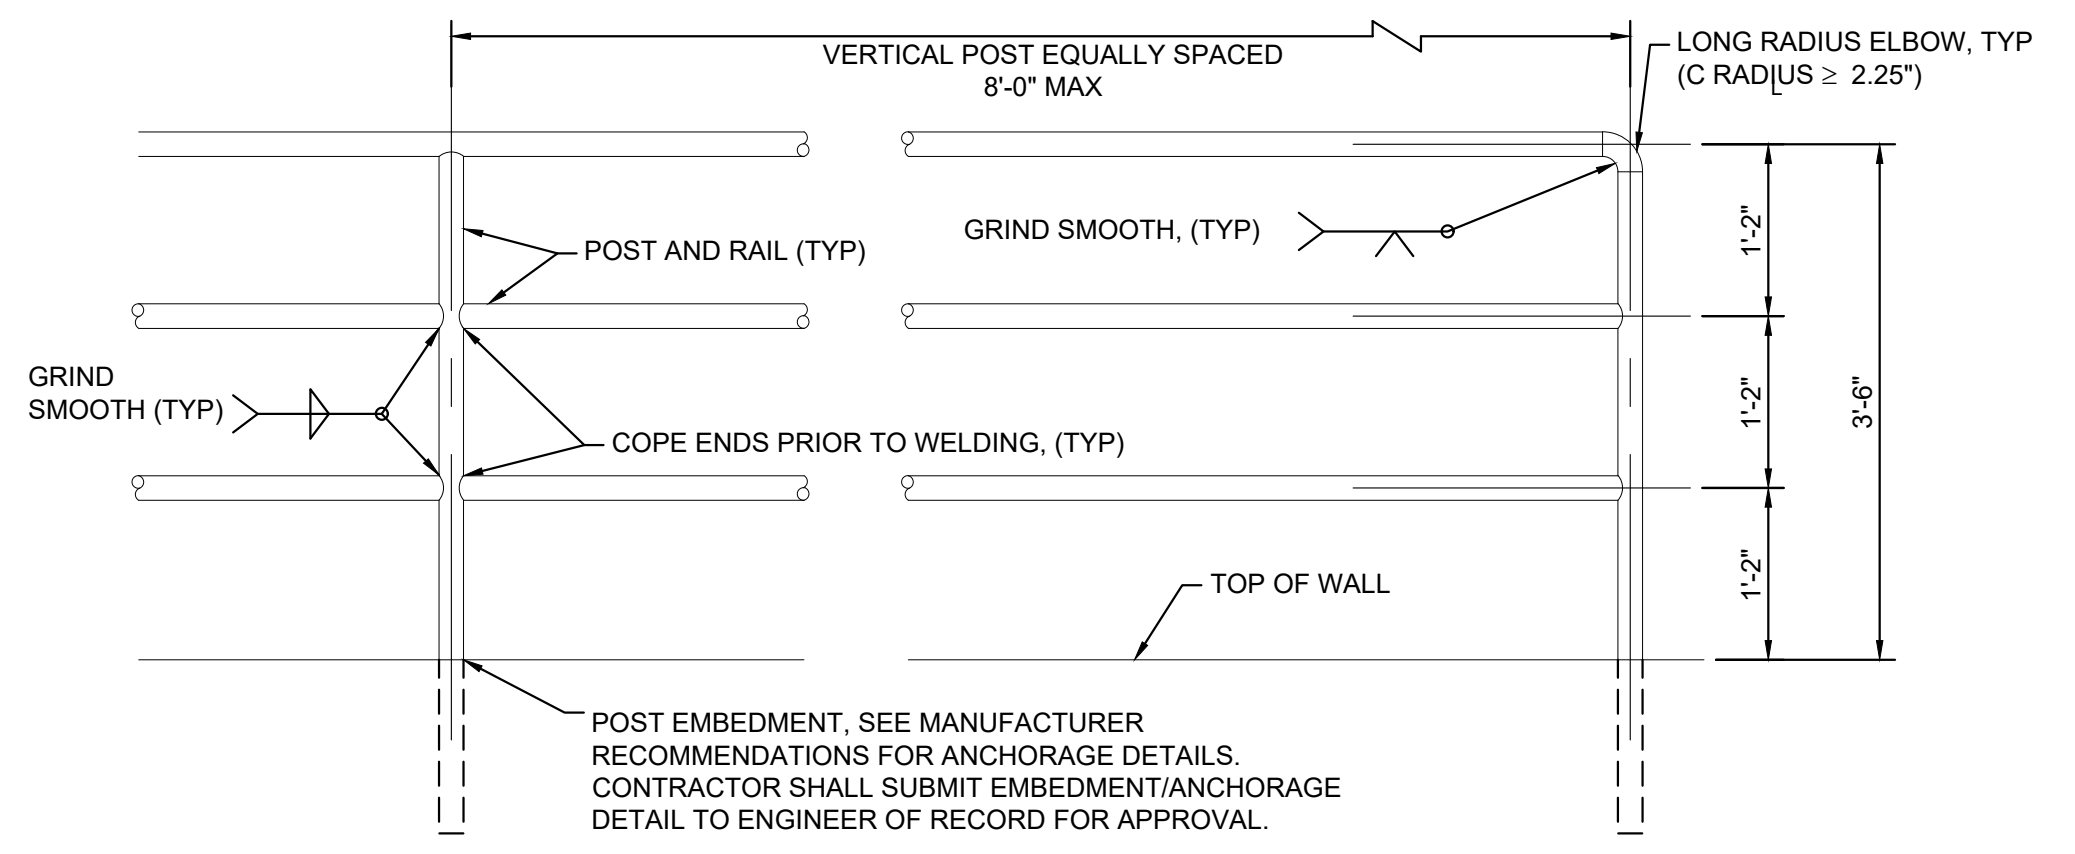

SAFETY RAILING

SAFETY RAILING NOTES:

- SAFETY RAILING TO BE PROVIDED AROUND MICROPPOOL AND FOREBAYS.
- POSTS AND RAILS SHALL BE 1.5" SCHEDULE 40 STEEL PIPE ASTM A 53, GRADE B (2.72 #/LF, 1.9" O.D.).
- SHOP PRIME RAIL WITH RUST INHIBITING PRIMER (FIELD REPAIR PRIMER AS NEEDED). RAIL FINISH PAINT SHALL BE BENJAMIN MOORE (BM) 1001 (4B) NORTH CREEK BROWN, SATIN FINISH.
- VERTICAL POSTS TO BE EVENLY SPACED.
- REMOVE ALL SHARP EDGES.
- THE ANCHORAGE EMBEDMENT SHALL BE LOCATED BEHIND THE MSE BLOCK WALL OR CONCRETE WALL AND ANCHORED PER MANUFACTURER RECOMMENDATIONS.

NO.	REVISION	BY	DATE	APPR

Kimley»Horn
2025 KIMLEY-HORN AND ASSOCIATES, INC.
2 North Nevada Avenue, Suite 900
Colorado Springs, Colorado 80903 (719) 453-0180

DESIGNED BY: AJV
DRAWN BY: TJK
CHECKED BY: JCP
DATE: 06/13/2025

WINDEMERE FILING 2 MULTI-FAMILY
CONSTRUCTION DOCUMENTS
STORM PLAN AND PROFILE



PROJECT NO.
196160000

SHEET
C2.4



K:\COS_LA\196160000 - Windemere\CADD\PlanSheets\CDS\CD_STORM.dwg Evens, Wyatt 3/30/2026 8:20 AM

K:\COS_LA\196160000 - Windermere\CADD\PlanSheets\CD_UT.dwg Evans, Wyatt 3/30/2026 8:21 AM

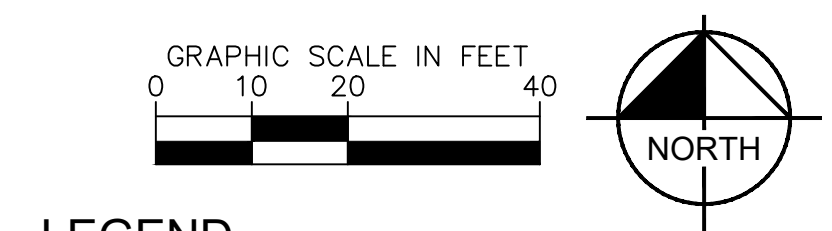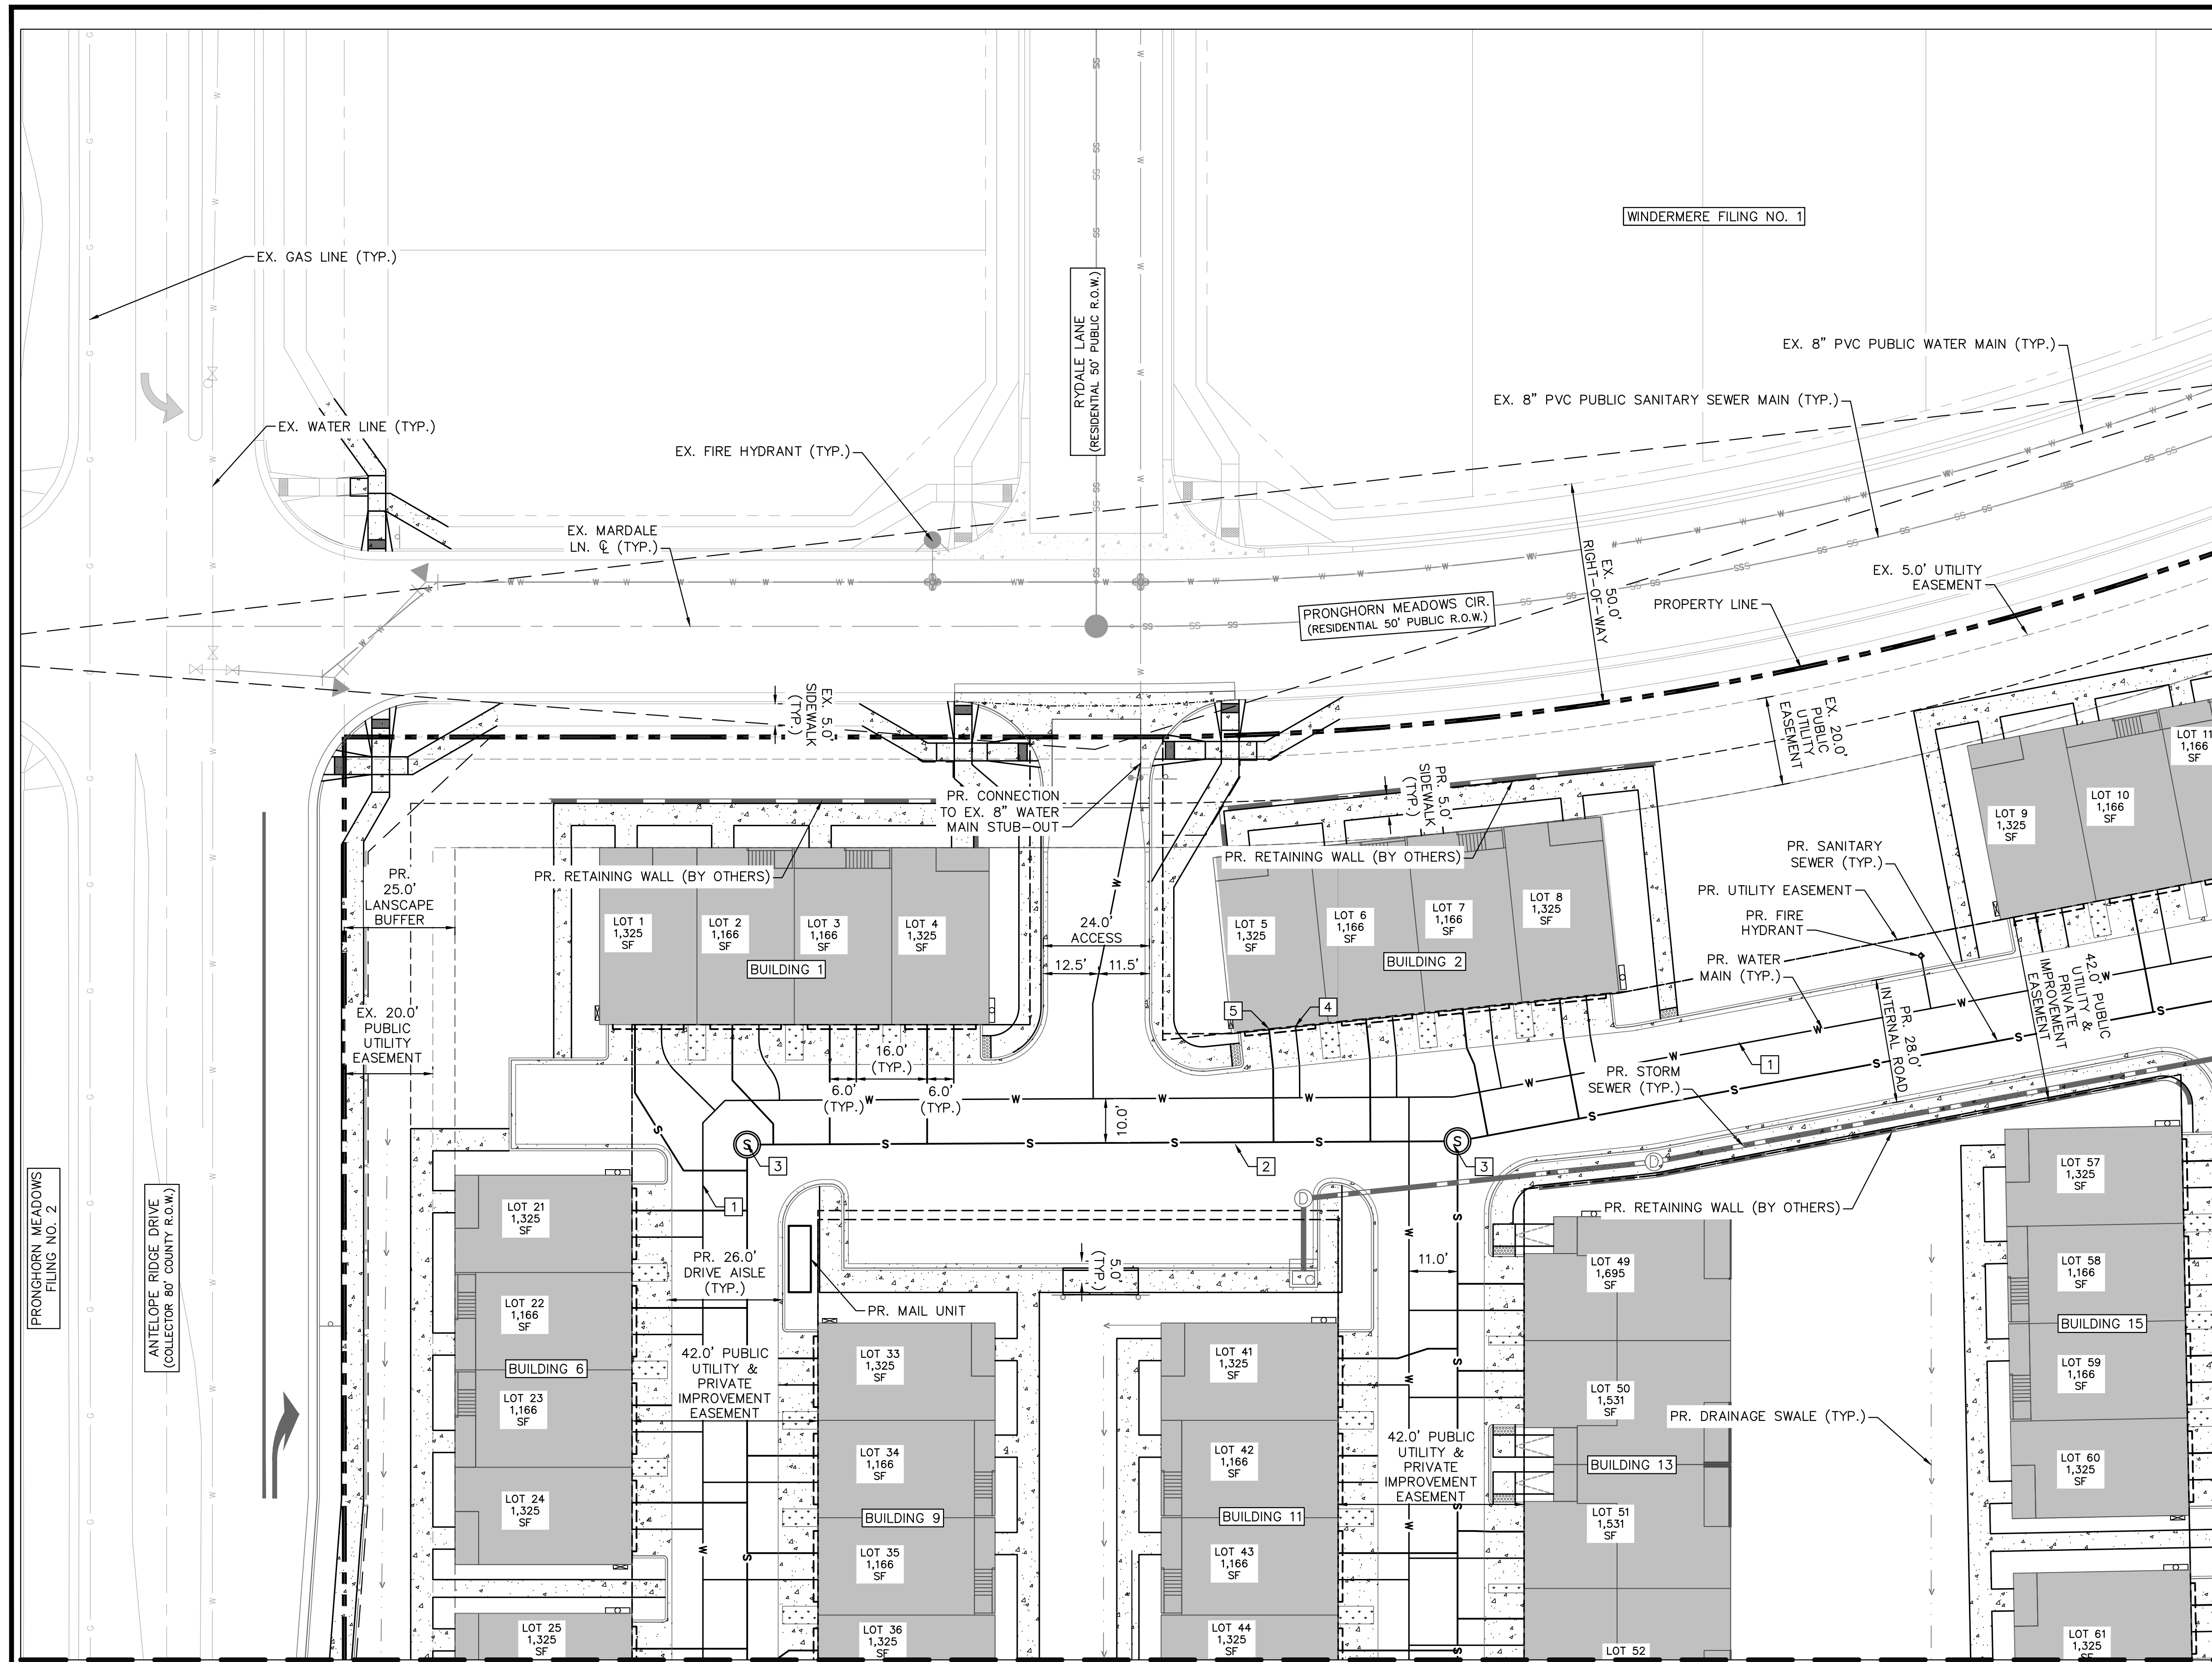

LEGEND

---	PROPERTY LINE
W	EXISTING WATER LINE
G	EXISTING GAS LINE
OE	EXISTING OVERHEAD ELECTRIC
E	EXISTING ELECTRIC UTILITY
SS	EXISTING SANITARY SEWER
---	EXISTING STORM PIPE
W	PROPOSED WATER LINE
S	PROPOSED SANITARY SEWER
---	PROPOSED STORM PIPE
→	PROPOSED DRAINAGE SWALE FLOW DIRECTION
X	PROPOSED FENCE
[Pattern]	EXISTING POND MAINTENANCE ACCESS ROAD
[Pattern]	PROPOSED POND MAINTENANCE ACCESS ROAD
[Pattern]	EXISTING SPILLWAY/RIPRAP
[Pattern]	PROPOSED CONCRETE
[Pattern]	PROPOSED LANDSCAPING

- KEY NOTES**
- 1 PROPOSED PUBLIC 8" PVC WATER MAIN
 - 2 PROPOSED PUBLIC 8" PVC SANITARY SEWER MAIN
 - 3 PROPOSED PUBLIC 5" DIA. SANITARY SEWER MANHOLE
 - 4 PROPOSED 1" PVC PRIVATE WATER SERVICE, TYPICAL
 - 5 PROPOSED 4" PVC PRIVATE SANITARY SEWER SERVICE, TYPICAL
 - 6 PROPOSED HYDRANT LATERAL

NO.	REVISION	BY	DATE	APPR

Kimley»Horn
 2026 KIMLEY-HORN AND ASSOCIATES, INC.
 2 North Nevada Avenue, Suite 900
 Colorado Springs, Colorado 80903 (719) 453-0180

DESIGNED BY: NMB
 DRAWN BY: DPM
 CHECKED BY: NMB
 DATE: 02/25/2026

WINDERMERE FILING NO. 2
 SITE DEVELOPMENT PLAN
 EL PASO COUNTY, COLORADO
 UTILITY PLAN



PRELIMINARY
 FOR REVIEW ONLY
 NOT FOR
 CONSTRUCTION

Kimley»Horn
 Kimley-Horn and Associates, Inc.

PROJECT NO.
 196160000

SHEET
C3.1

K:\COS_LA\196160000 - Windemere\CADD\PlanSheets\CDs_CD_UT.dwg Evans, Wyatt 3/30/2026 8:21 AM

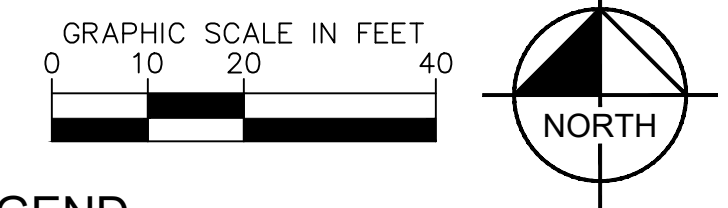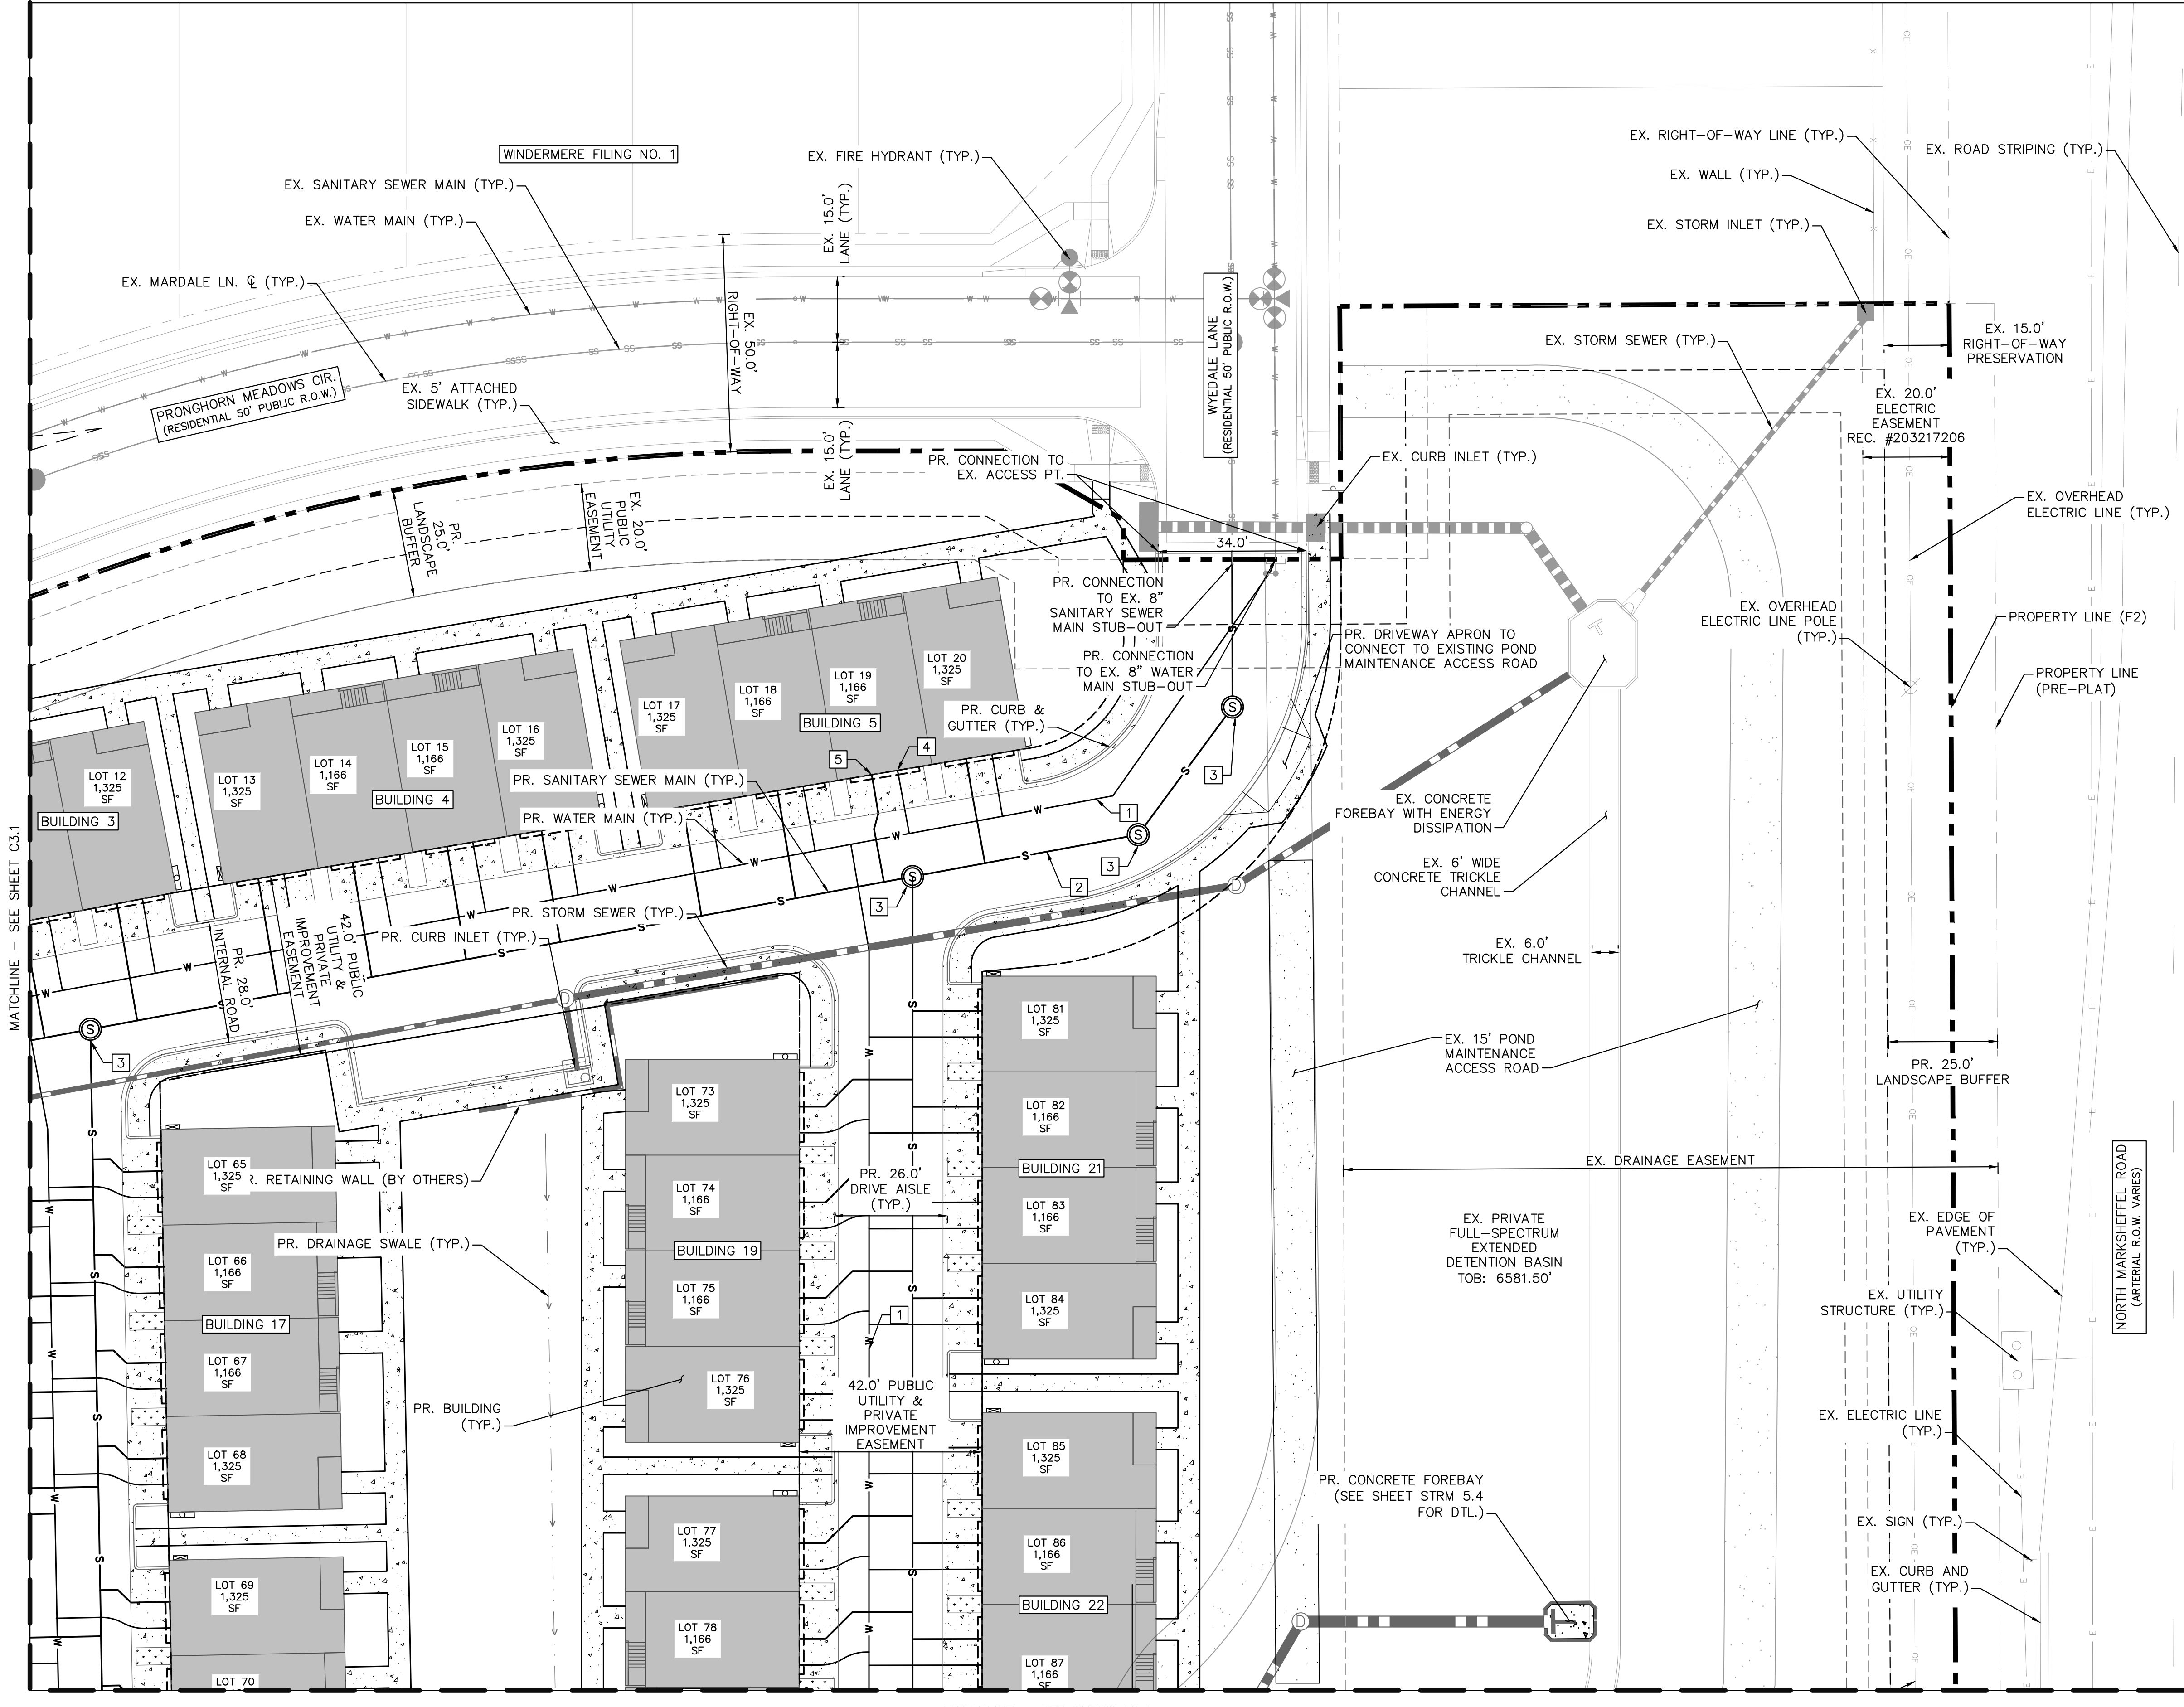

- LEGEND**
- — — — — PROPERTY LINE
 - — — — — EXISTING WATER LINE
 - — — — — EXISTING GAS LINE
 - — — — — EXISTING OVERHEAD ELECTRIC
 - — — — — EXISTING ELECTRIC UTILITY
 - — — — — EXISTING SANITARY SEWER
 - — — — — EXISTING STORM PIPE
 - — — — — PROPOSED WATER LINE
 - — — — — PROPOSED SANITARY SEWER
 - — — — — PROPOSED STORM PIPE
 - — — — — PROPOSED DRAINAGE SWALE
 - — — — — PROPOSED FENCE
 - — — — — EXISTING POND MAINTENANCE ACCESS ROAD
 - — — — — PROPOSED POND MAINTENANCE ACCESS ROAD
 - — — — — EXISTING SPILLWAY/RIPRAP
 - — — — — PROPOSED CONCRETE
 - — — — — PROPOSED LANDSCAPING

- KEY NOTES**
- 1 PROPOSED PUBLIC 6" PVC WATER MAIN
 - 2 PROPOSED PUBLIC 8" PVC SANITARY SEWER MAIN
 - 3 PROPOSED PUBLIC 5" DIA. SANITARY SEWER MANHOLE
 - 4 PROPOSED 1" PRIVATE WATER SERVICE, TYPICAL
 - 5 PROPOSED 4" PRIVATE SANITARY SEWER SERVICE, TYPICAL

NO.	REVISION	DATE	BY	APPR

Kimley»Horn
 2026 KIMLEY-HORN AND ASSOCIATES, INC.
 2 North Nevada Avenue, Suite 900
 Colorado Springs, Colorado 80903 (719) 453-0180


DESIGNED BY: NMB
 DRAWN BY: DPM
 CHECKED BY: NMB
 DATE: 02/25/2026

WINDERMERE FILING NO. 2
 SITE DEVELOPMENT PLAN
 EL PASO COUNTY, COLORADO
 UTILITY PLAN

PRELIMINARY
 FOR REVIEW ONLY
 NOT FOR
 CONSTRUCTION

PROJECT NO.
 196160000
 SHEET
 C3.2

K:\COS_LA\196160000 - Windemere\CADD\PlanSheets\CDs\CD_UT.dwg Evans, Wyatt 3/30/2026 8:21 AM

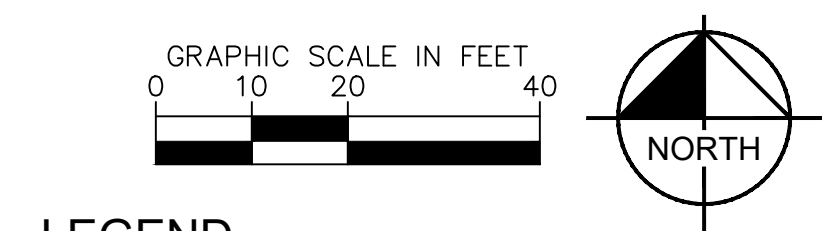

- LEGEND**
- PROPERTY LINE
 - EXISTING WATER LINE
 - EXISTING GAS LINE
 - EXISTING OVERHEAD ELECTRIC
 - EXISTING ELECTRIC UTILITY
 - EXISTING SANITARY SEWER
 - EXISTING STORM PIPE
 - PROPOSED WATER LINE
 - PROPOSED SANITARY SEWER
 - PROPOSED STORM PIPE
 - PROPOSED DRAINAGE SWALE
 - PROPOSED FENCE
 - EXISTING POND MAINTENANCE ACCESS ROAD
 - PROPOSED POND MAINTENANCE ACCESS ROAD
 - EXISTING SPILLWAY/RIPRAP
 - PROPOSED CONCRETE
 - PROPOSED LANDSCAPING

- KEY NOTES**
- 1 PROPOSED PUBLIC 6" PVC WATER MAIN
 - 2 PROPOSED PUBLIC 8" PVC SANITARY SEWER MAIN
 - 3 PROPOSED PUBLIC 5' DIA. SANITARY SEWER MANHOLE
 - 4 PROPOSED 1" PRIVATE WATER SERVICE, TYPICAL
 - 5 PROPOSED 4" PRIVATE SANITARY SEWER SERVICE, TYPICAL

BY DATE APPR

REVISION NO.

Kimley»Horn

2026 KIMLEY-HORN AND ASSOCIATES, INC.
2 North Nevada Avenue, Suite 900
Colorado Springs, Colorado 80903 (719) 453-0180

DESIGNED BY: NMB
DRAWN BY: DPM
CHECKED BY: NMB
DATE: 02/25/2026


WINDERMERE FILING NO. 2
SITE DEVELOPMENT PLAN
EL PASO COUNTY, COLORADO
UTILITY PLAN

PRELIMINARY
FOR REVIEW ONLY
NOT FOR
CONSTRUCTION


Kimley»Horn
Kimley-Horn and Associates, Inc.

PROJECT NO.
196160000

SHEET
C3.3

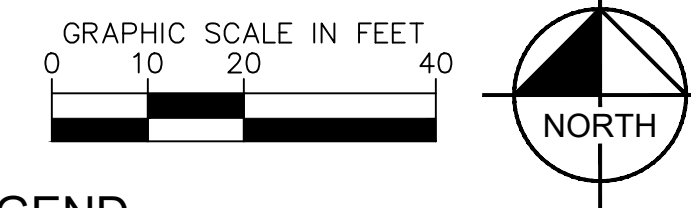

MATCHLINE - SEE SHEET C3.2

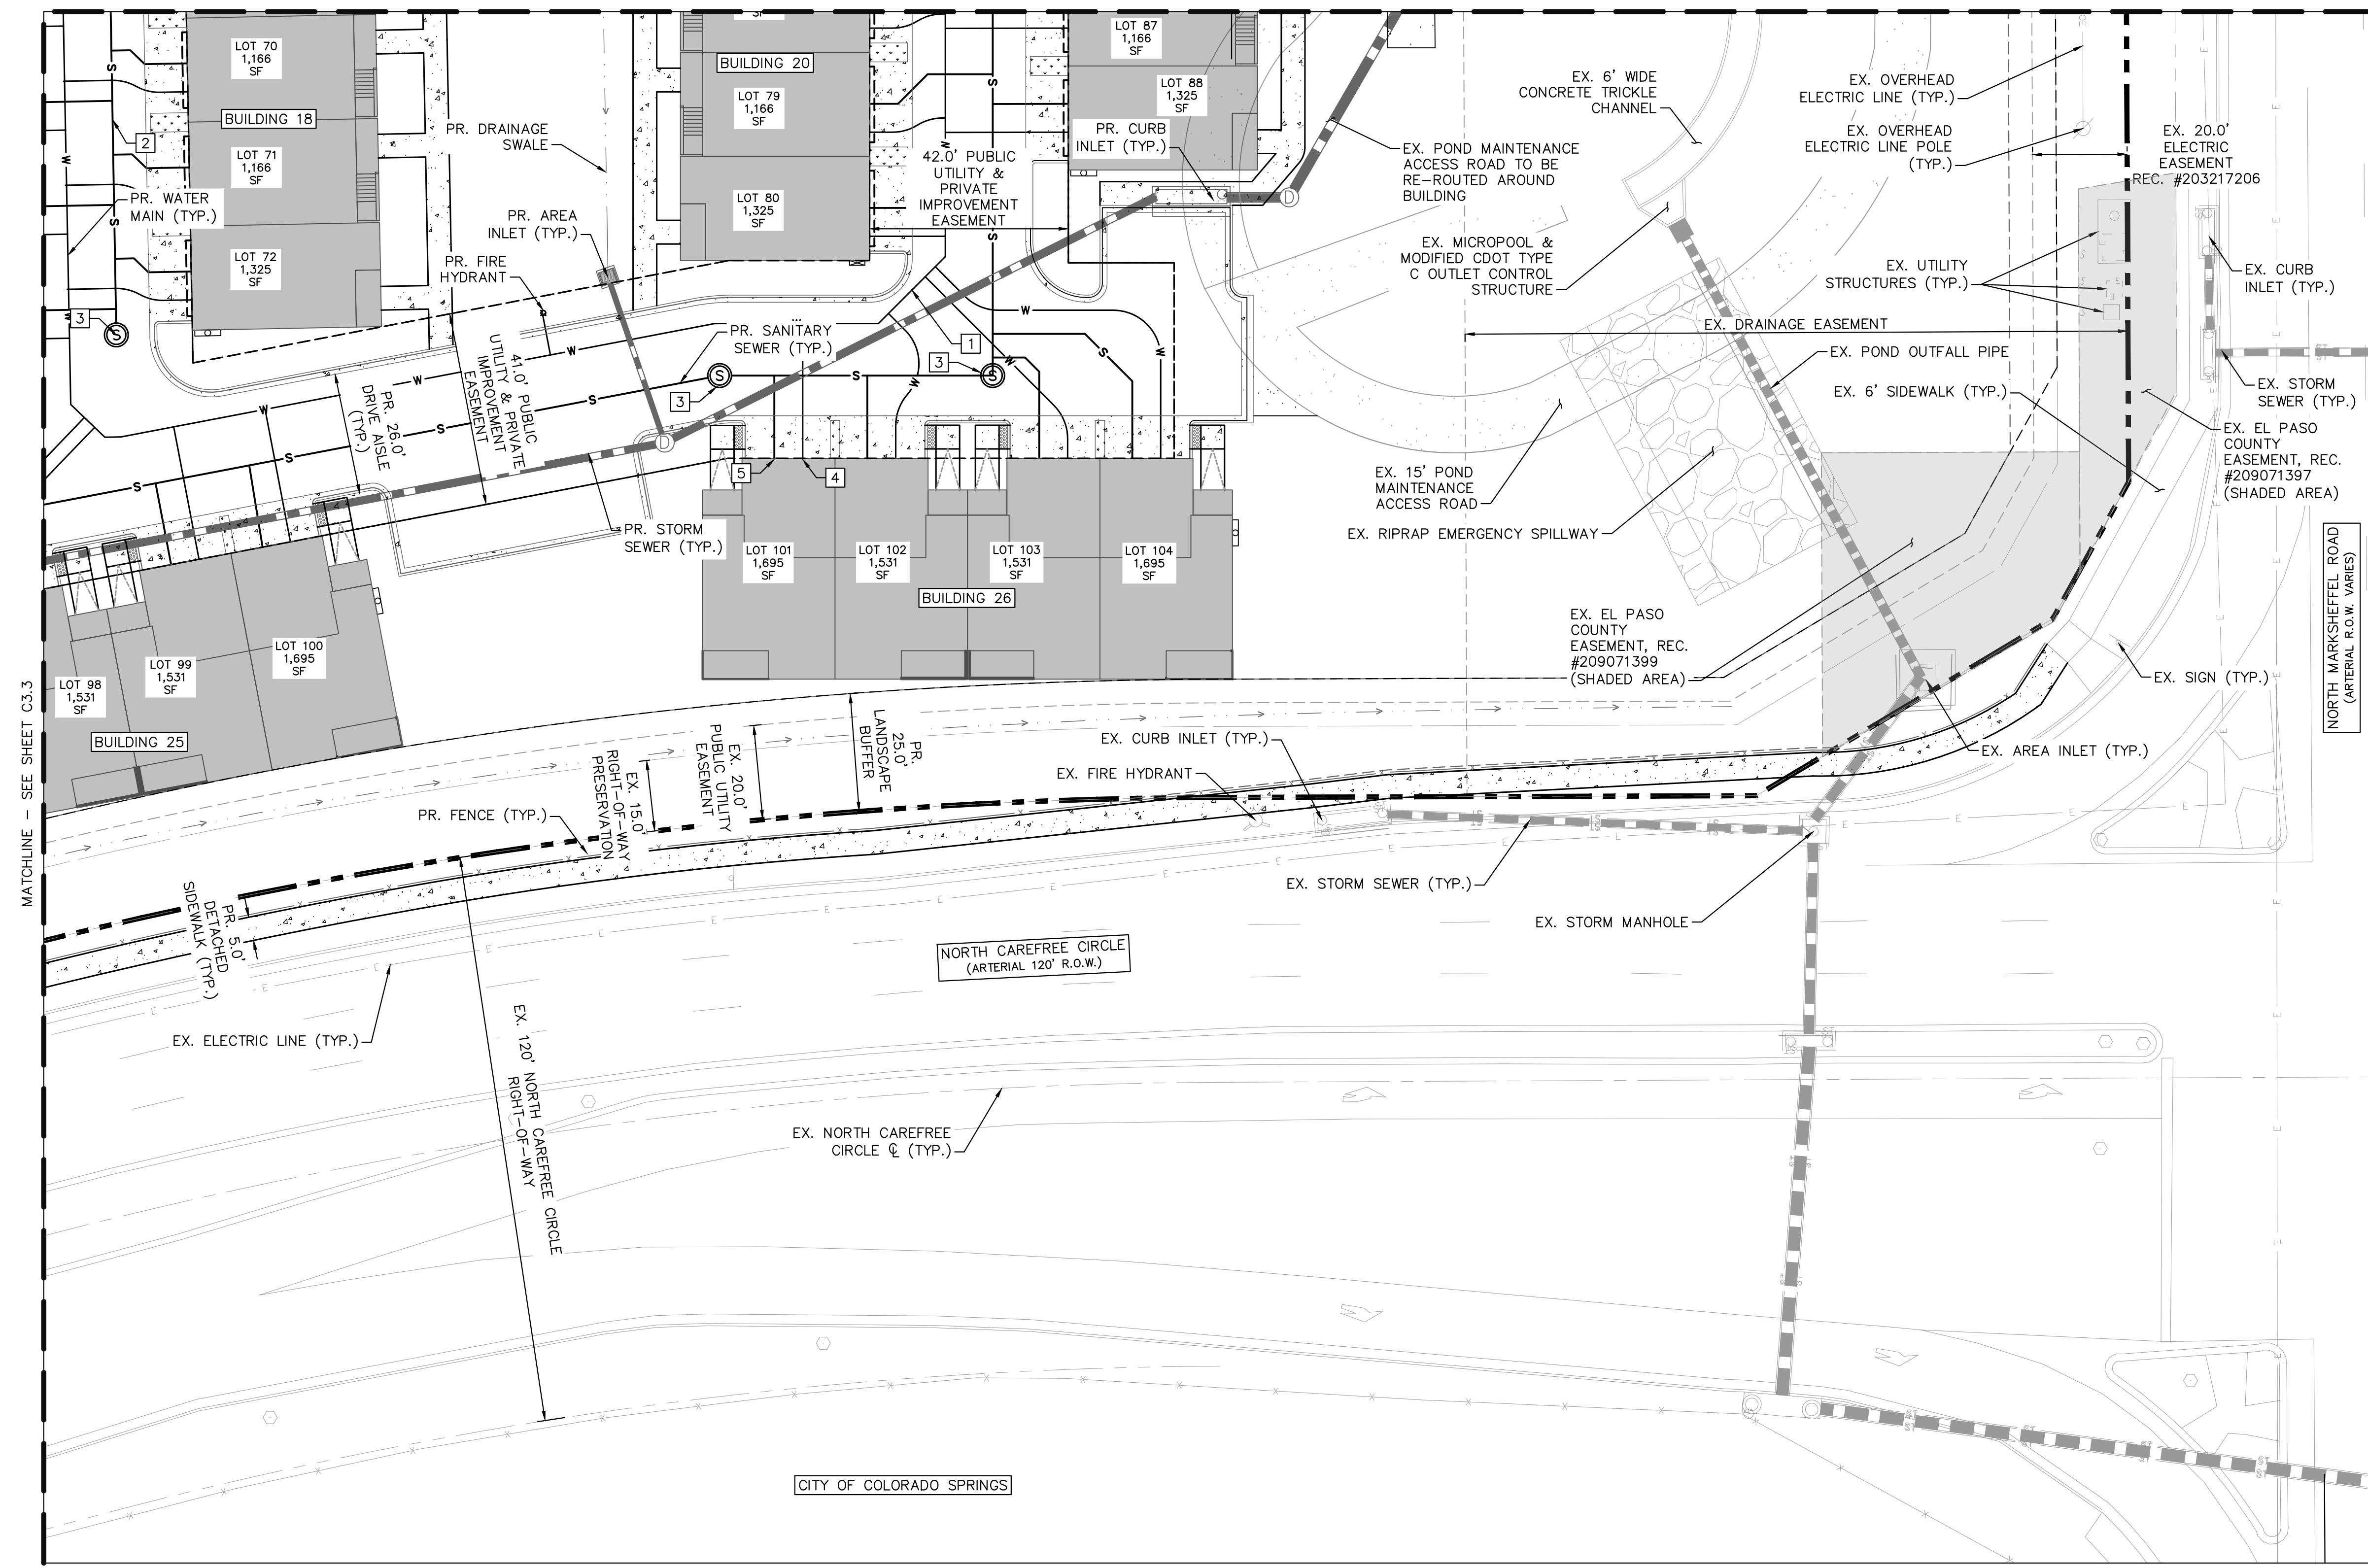

- LEGEND**
- PROPERTY LINE
 - W — EXISTING WATER LINE
 - G — EXISTING GAS LINE
 - OE — EXISTING OVERHEAD ELECTRIC
 - E — EXISTING ELECTRIC UTILITY
 - SS — EXISTING SANITARY SEWER
 - — EXISTING STORM PIPE
 - W — PROPOSED WATER LINE
 - S — PROPOSED SANITARY SEWER
 - — PROPOSED STORM PIPE
 - — PROPOSED DRAINAGE SWALE
 - — PROPOSED FENCE
 - — EXISTING POND MAINTENANCE ACCESS ROAD
 - — PROPOSED POND MAINTENANCE ACCESS ROAD
 - — EXISTING SPILLWAY/RIPRAP
 - — PROPOSED CONCRETE
 - — PROPOSED LANDSCAPING

- KEY NOTES**
- 1 PROPOSED PUBLIC 6" PVC WATER MAIN
 - 2 PROPOSED PUBLIC 8" PVC SANITARY SEWER MAIN
 - 3 PROPOSED PUBLIC 5' DIA. SANITARY SEWER MANHOLE
 - 4 PROPOSED 1" PRIVATE WATER SERVICE, TYPICAL
 - 5 PROPOSED 4" PRIVATE SANITARY SEWER SERVICE, TYPICAL

BY: DATE: APPR

NO. REVISION

Kimley»Horn

2026 KIMLEY-HORN AND ASSOCIATES, INC.
2 North Nevada Avenue, Suite 900
Colorado Springs, Colorado 80903 (719) 453-0180

DESIGNED BY: NMB
DRAWN BY: DPM
CHECKED BY: NMB
DATE: 02/25/2026

WINDERMERE FILING NO. 2
SITE DEVELOPMENT PLAN
EL PASO COUNTY, COLORADO
UTILITY PLAN




PRELIMINARY
FOR REVIEW ONLY
NOT FOR
CONSTRUCTION

Kimley»Horn
Kimley-Horn and Associates, Inc.

PROJECT NO.
196160000

SHEET
C3.4

K:\COS_LA\196160000 - Windermere\CADD\PlanSheets\CDs_CD_WT.dwg Evans, Wyatt 3/30/2026 8:22 AM

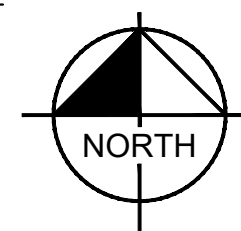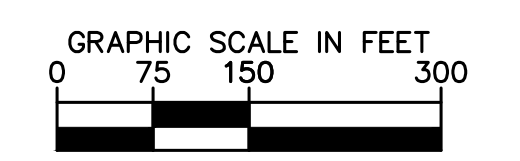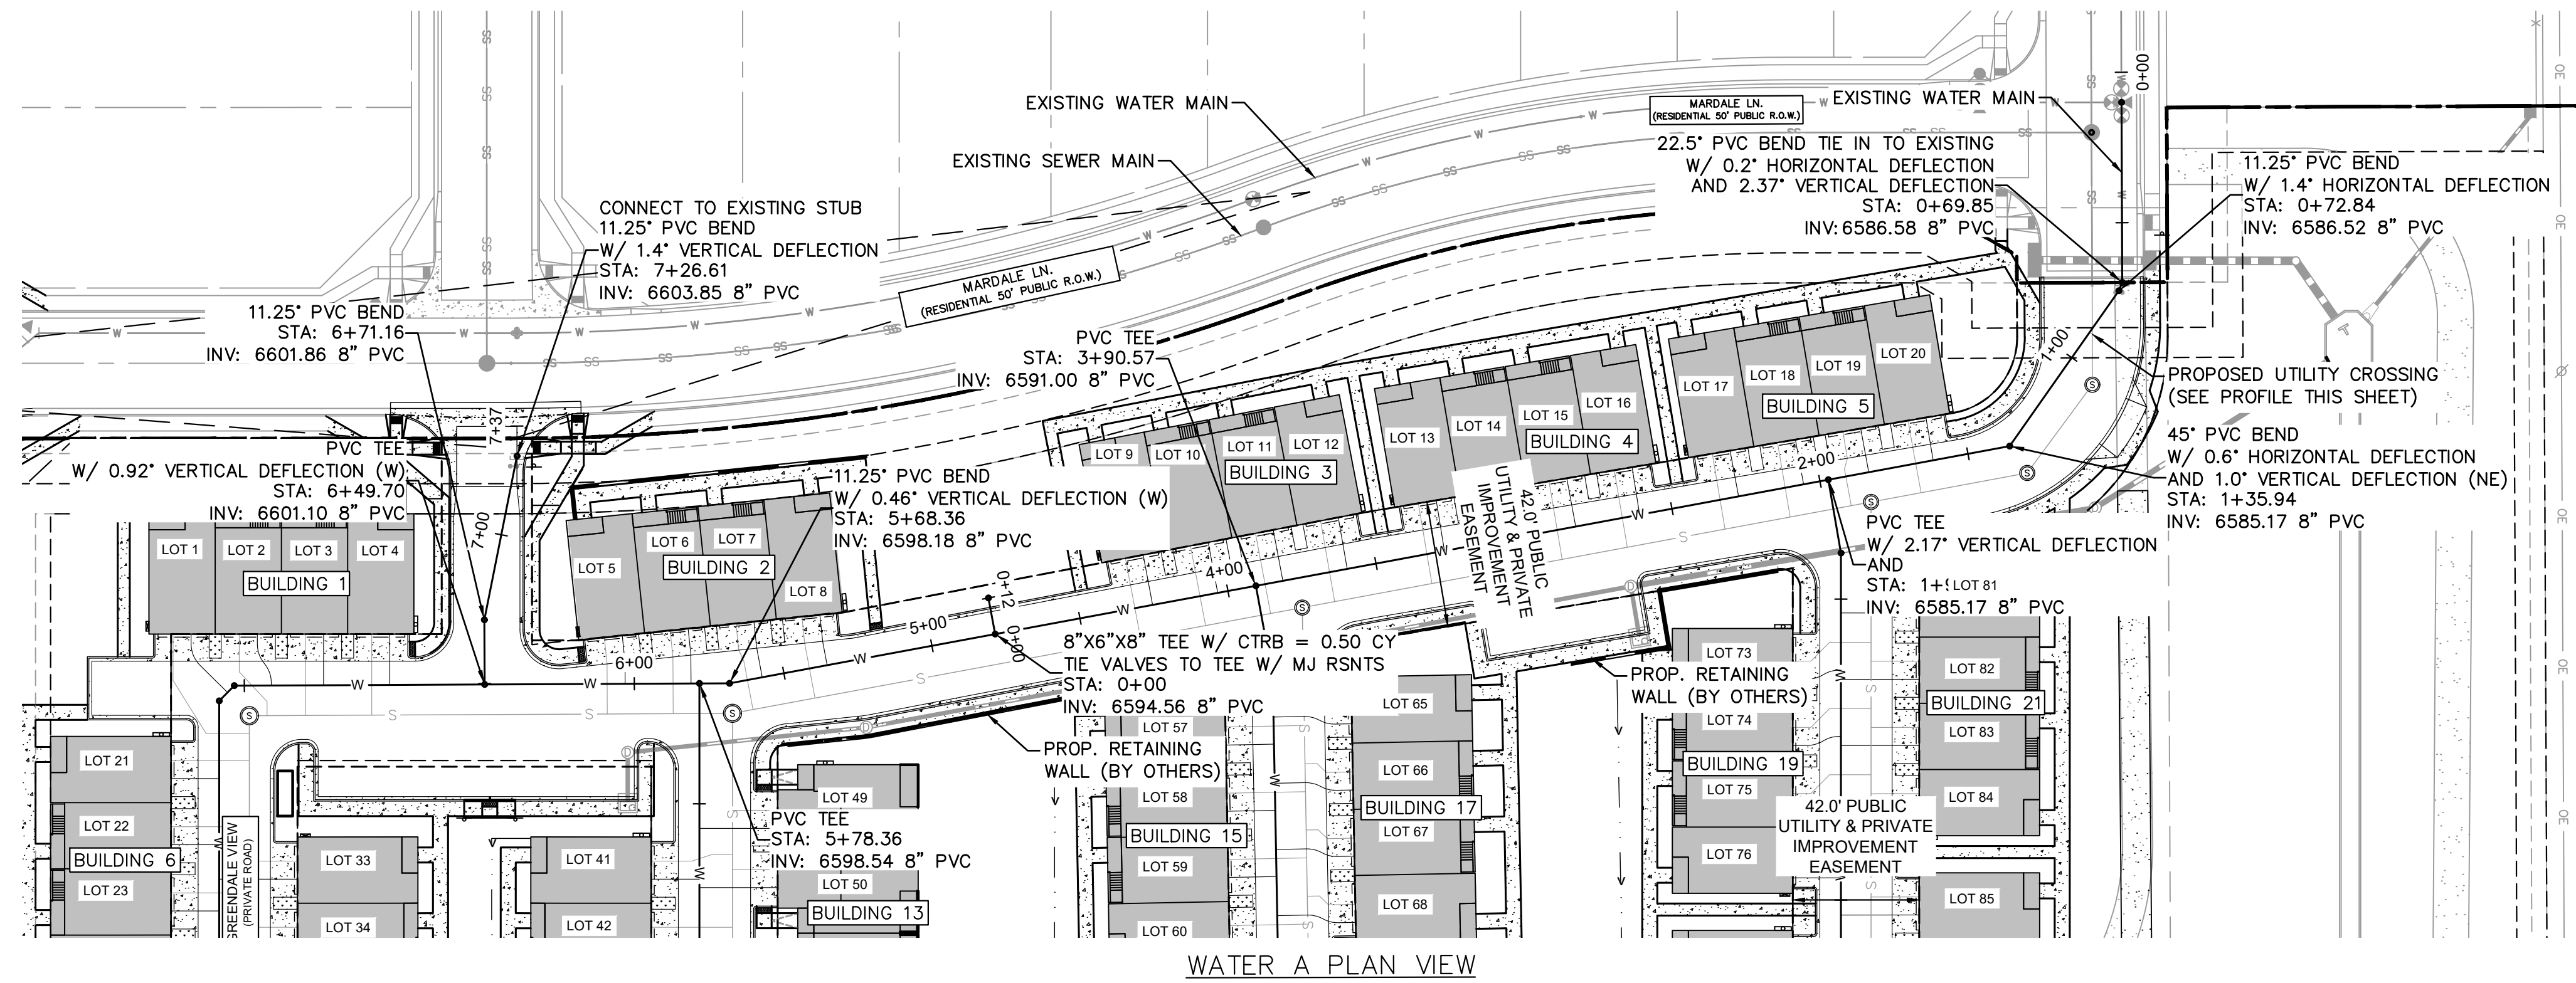


LEGEND

- PROPERTY LINE
- x-x- PROPOSED FENCE
- w- PROPOSED 8" PVC WATER MAIN
- s- PROPOSED 8" PVC SANITARY MAIN
- PROPOSED PVC STORM MAIN

NOTES

1. ALL EXISTING UTILITIES TO REMAIN UNLESS OTHERWISE NOTED.
2. UTILITIES TO BE REMOVED ARE TO BE CAPPED IN PLACE IN ACCORDANCE WITH LOCAL UTILITY REGULATIONS.
3. THE LOCATION AND/OR ELEVATION OF EXISTING UTILITIES AS SHOWN ON THESE PLANS IS BASED ON RECORDS OF THE VARIOUS UTILITY COMPANIES, AND WHERE POSSIBLE, MEASUREMENTS TAKEN IN THE FIELD. THE INFORMATION IS NOT TO BE RELIED ON AS BEING EXACT OR COMPLETE.
5. ALL PR. CURB & GUTTER IS EPC TYBE B PER EL PASO COUNTY STANDARD DETAIL SD_2-20 UNLESS OTHERWISE NOTED.
6. SEE PLANS FOR MAINLINE SIZES.
7. ALL WATER SERVICES ARE 1" X 6" TAPS BY DEVELOPER UNLESS OTHERWISE NOTED ON PLANS.

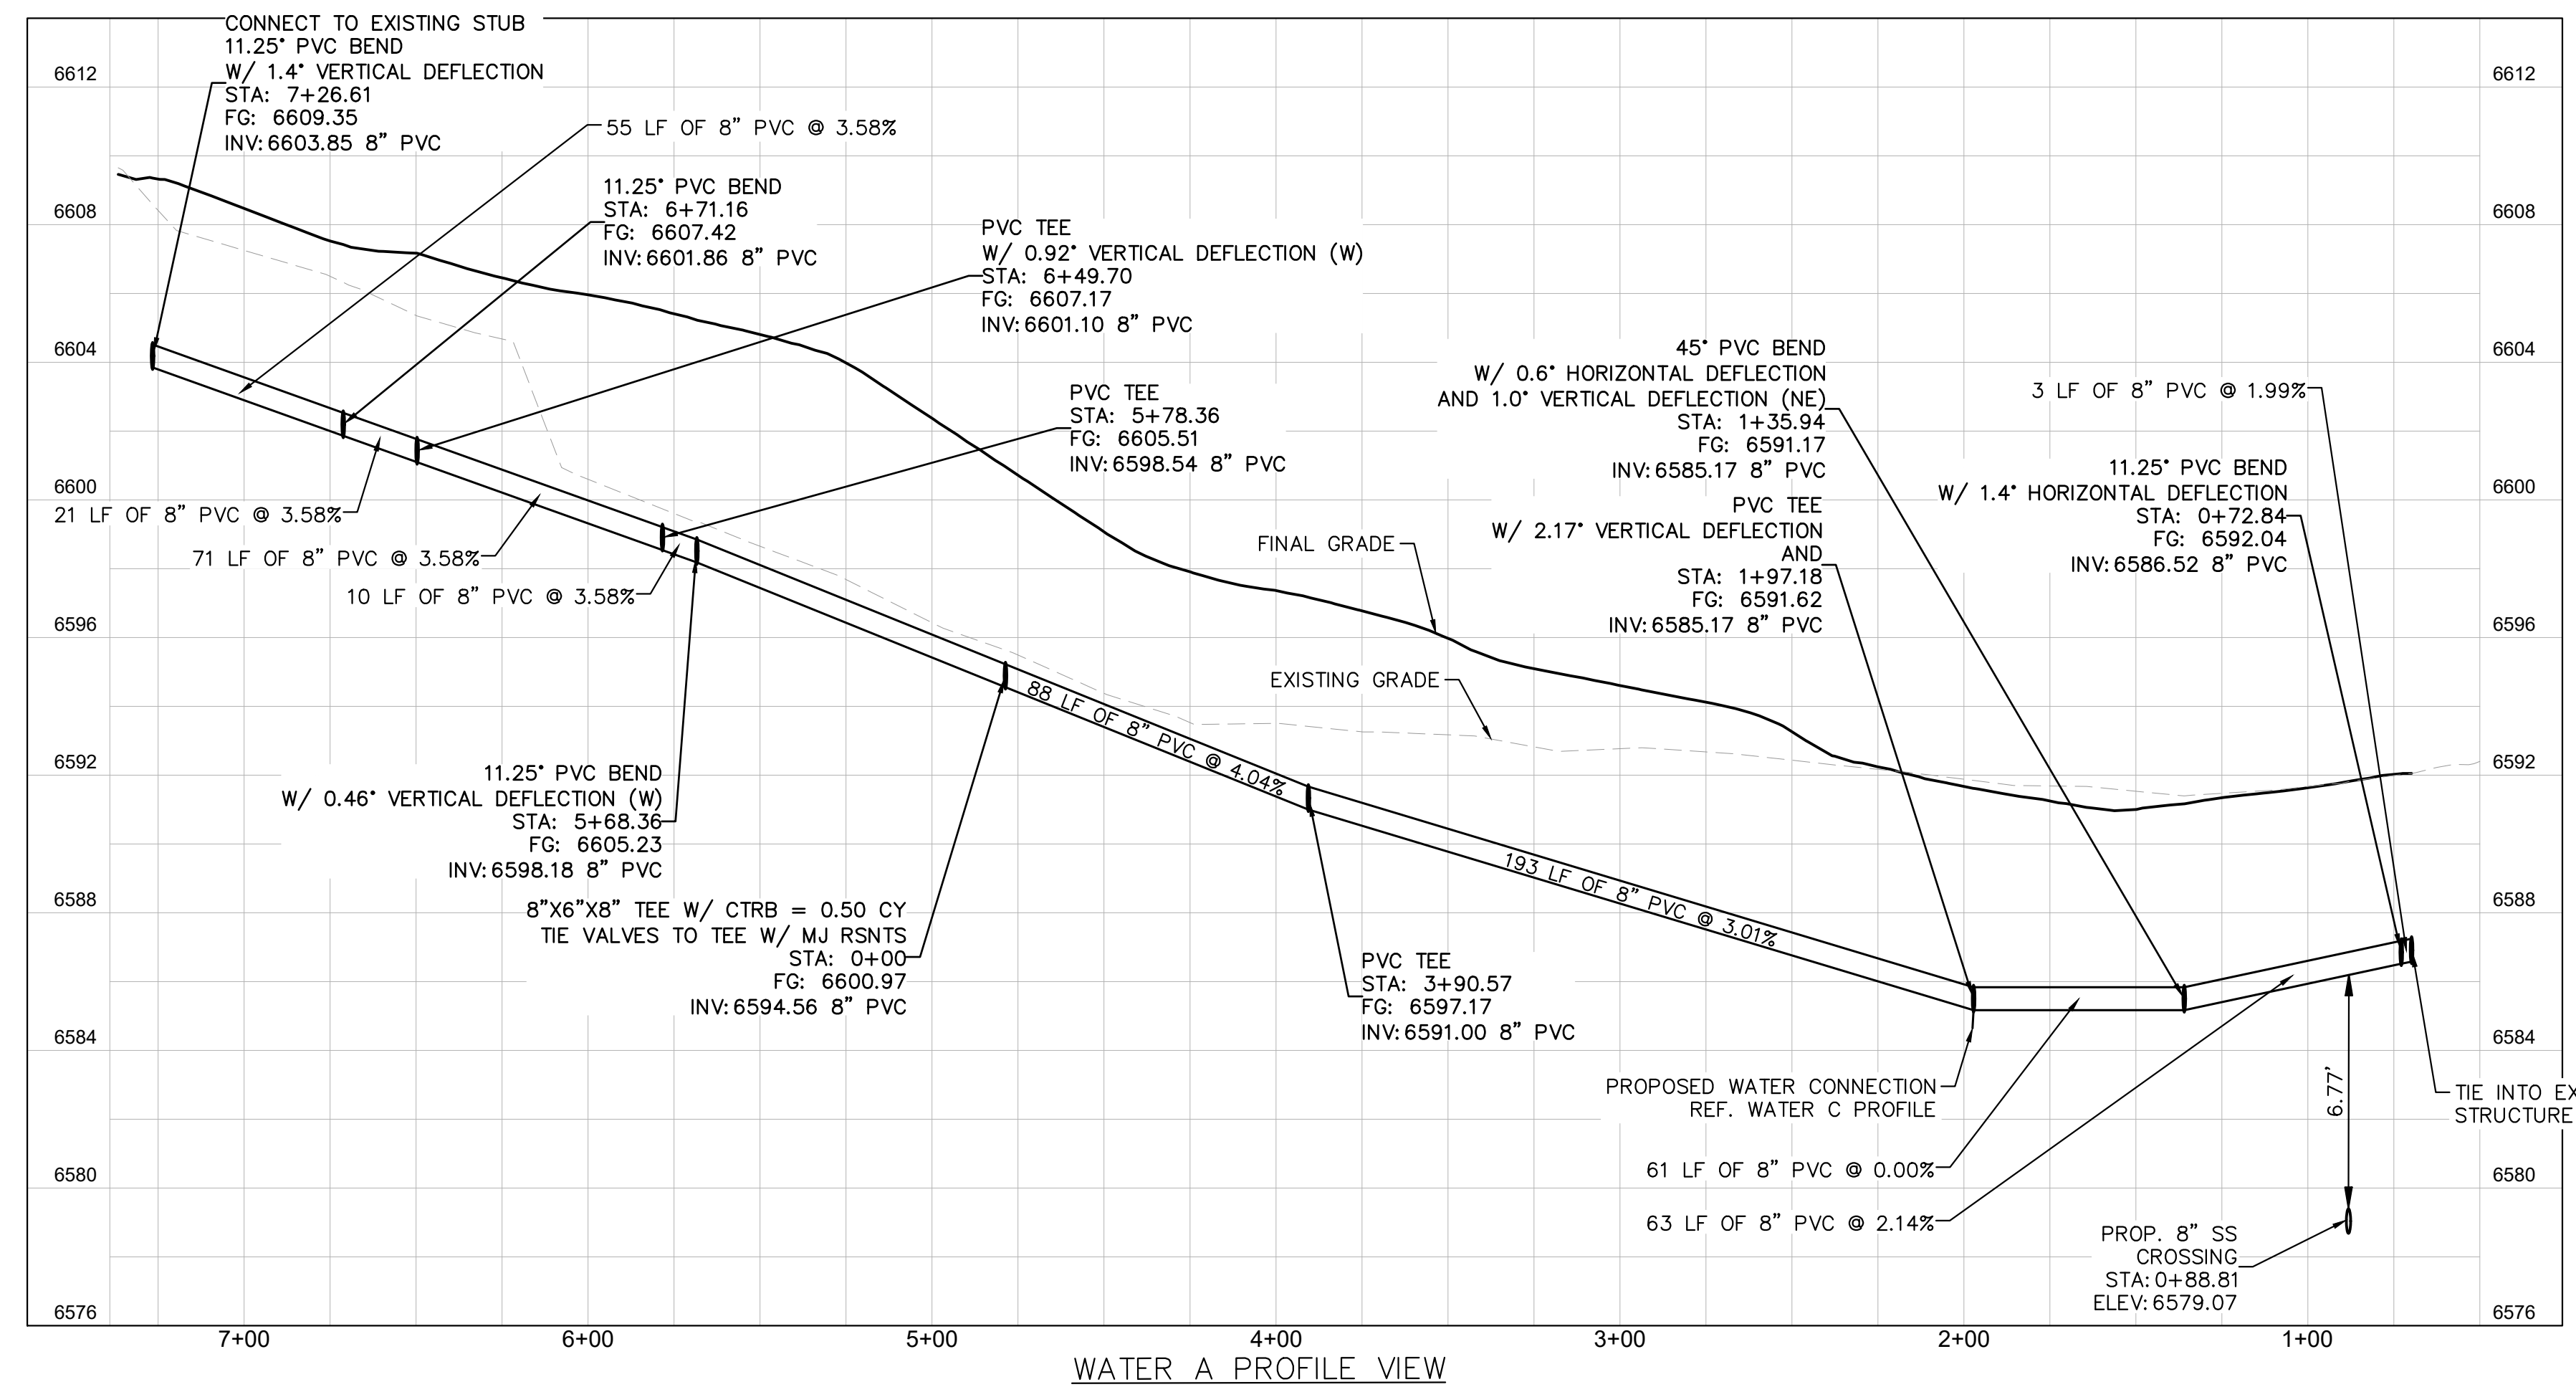

NO.	REVISION	BY	DATE	APPR

Kimley-Horn
2026 KIMLEY-HORN AND ASSOCIATES, INC.
2 North Nevada Avenue, Suite 900
Colorado Springs, Colorado 80903 (719) 453-0180

DESIGNED BY: NMB
DRAWN BY: DPM
CHECKED BY: NMB
DATE: 01/13/2026

WINDERMERE FILING NO. 2
CONSTRUCTION DOCUMENTS
EL PASO COUNTY, COLORADO
WATER A P&P


PRELIMINARY
FOR REVIEW ONLY
NOT FOR CONSTRUCTION

Kimley-Horn and Associates, Inc.

PROJECT NO.
196160000

SHEET
C3.5


K:\COS_LA\196160000 - Windemere\CADD\PlanSheets\CDS_CD_WT.dwg Evans, Wyatt 3/30/2026 8:22 AM

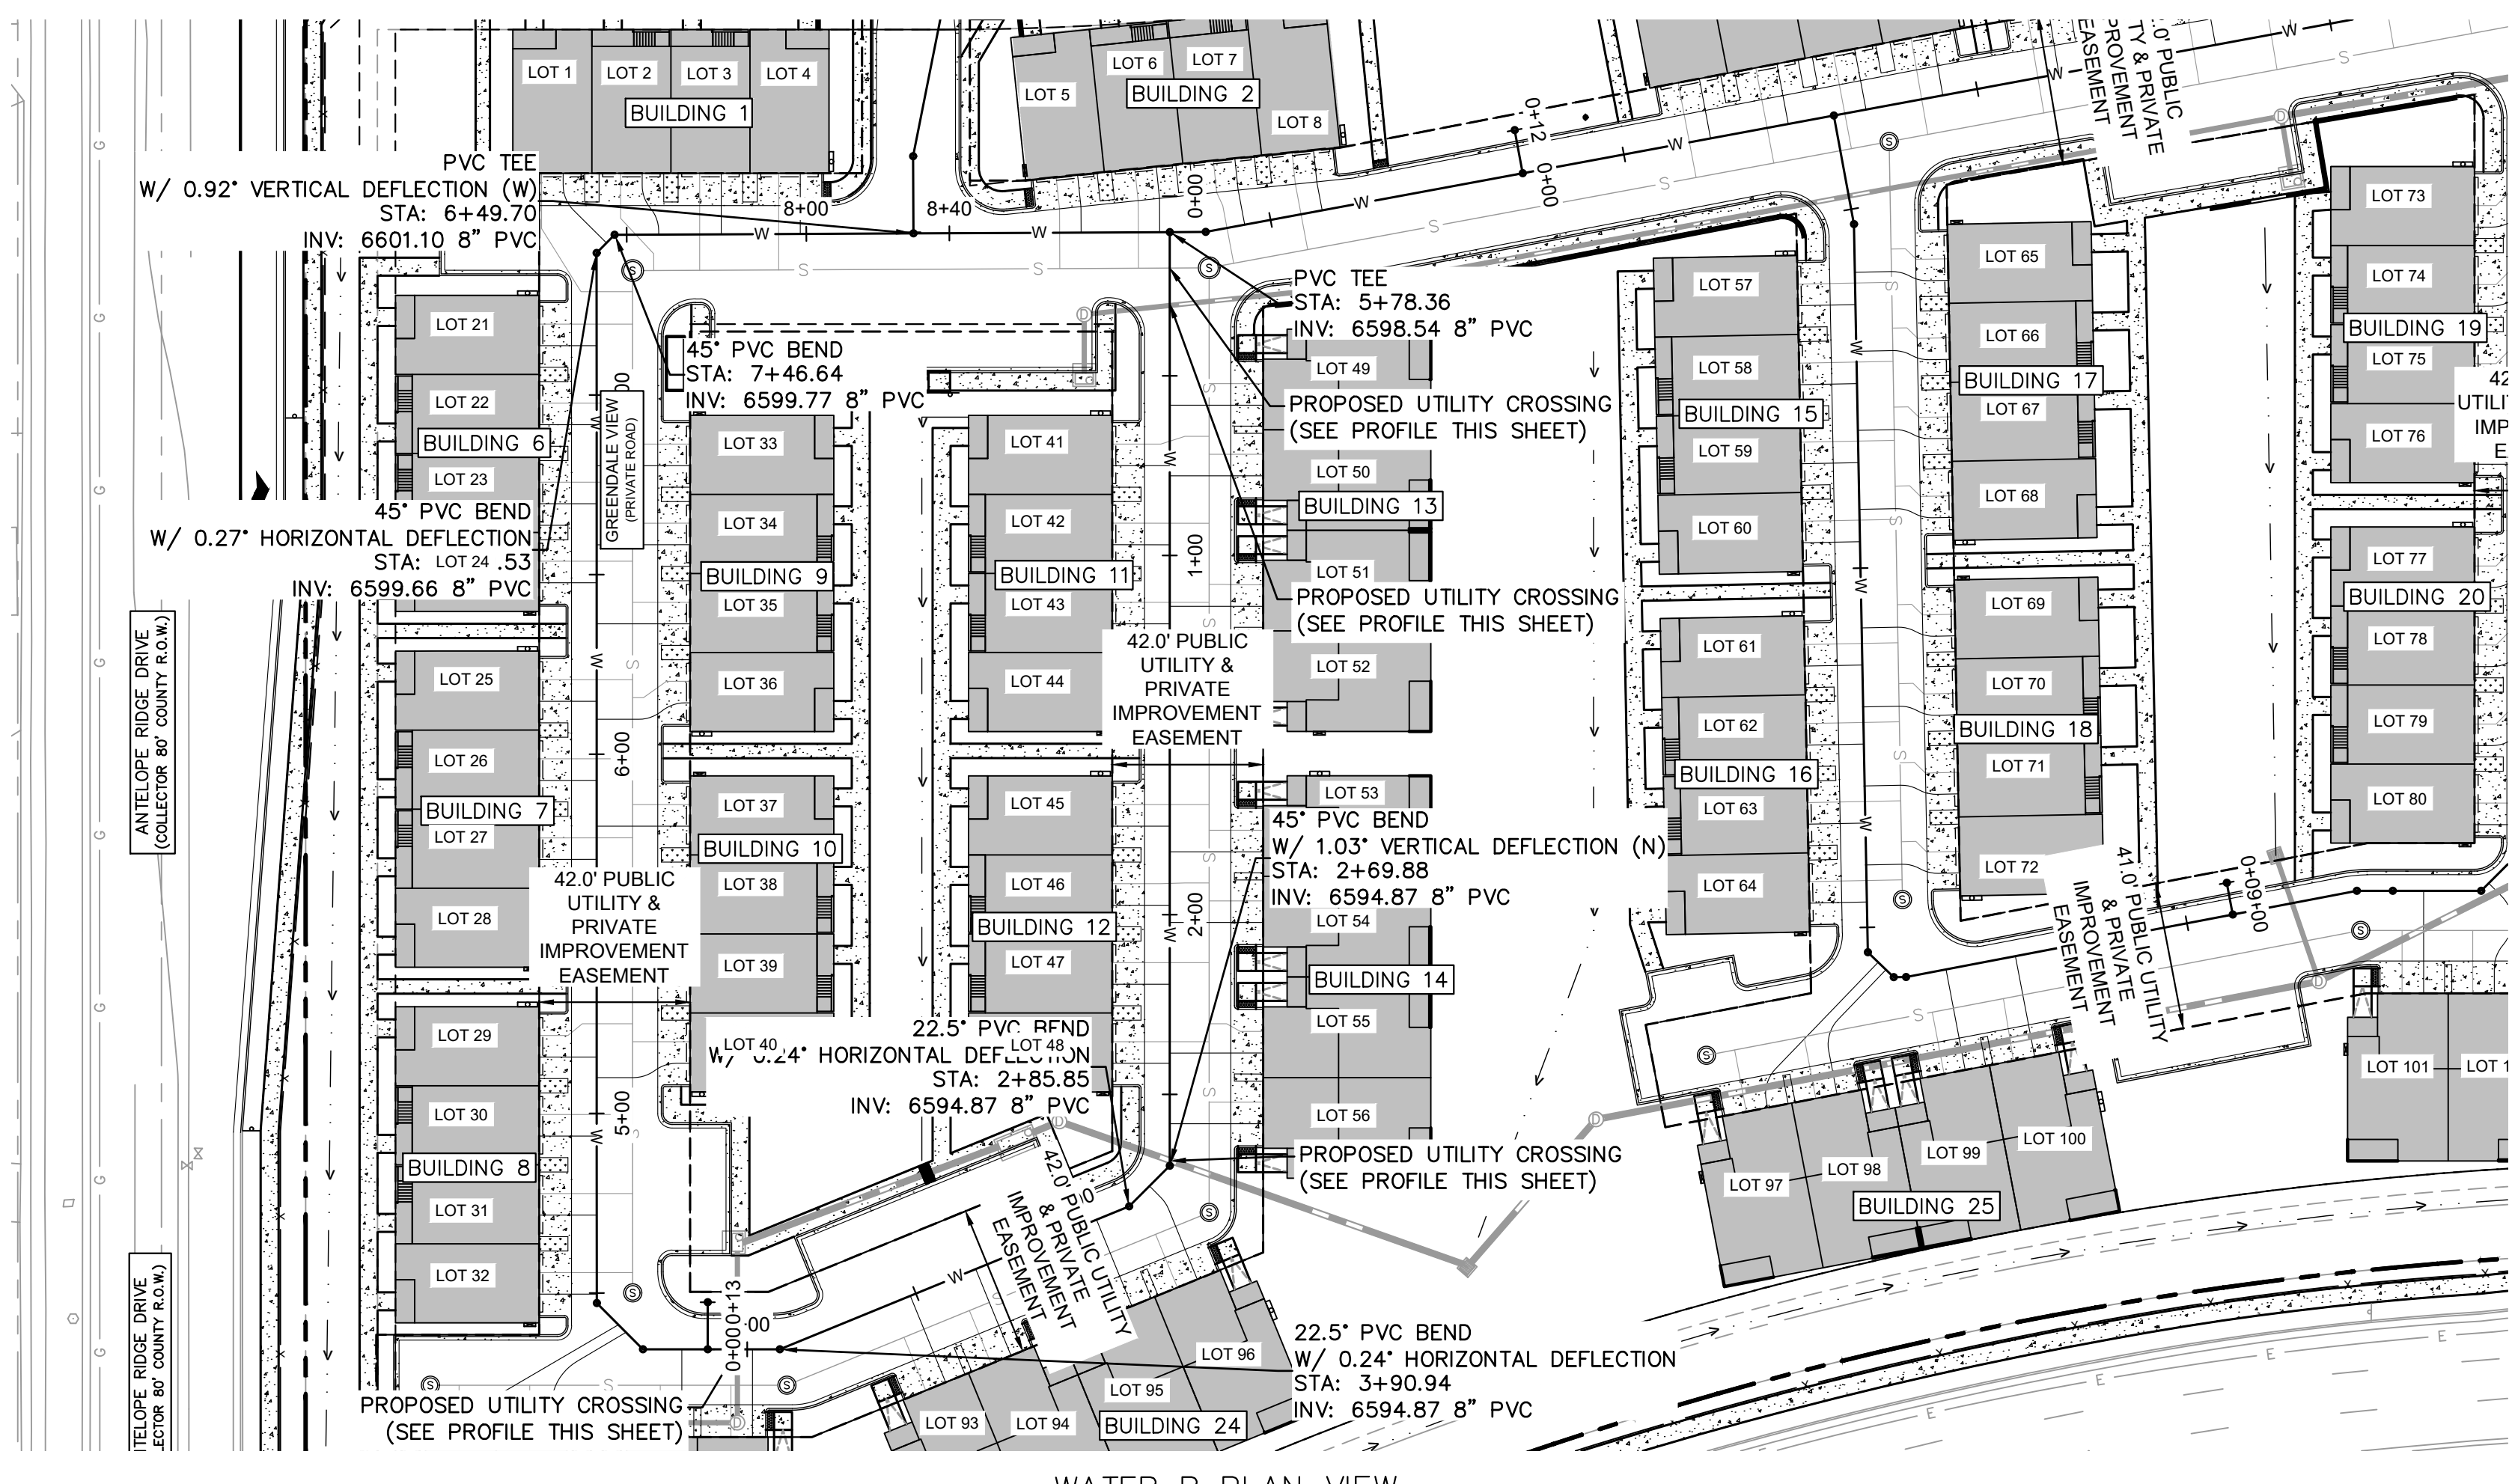

WATER B PLAN VIEW



VICINITY MAP

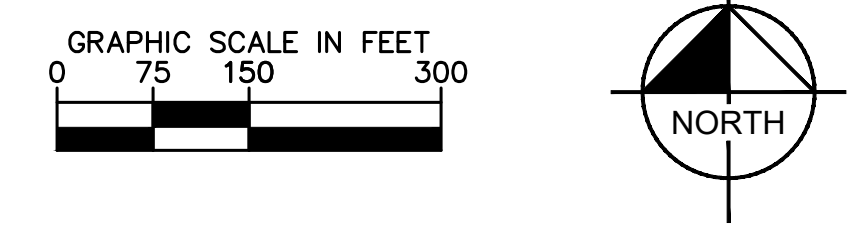


LEGEND

- — — — — PROPERTY LINE
- x - x - PROPOSED FENCE
- W - PROPOSED 8" PVC WATER MAIN
- S - PROPOSED 8" PVC SANITARY MAIN
- - - - - PROPOSED PVC STORM MAIN

NOTES

1. ALL EXISTING UTILITIES TO REMAIN UNLESS OTHERWISE NOTED.
2. UTILITIES TO BE REMOVED ARE TO BE CAPPED IN PLACE IN ACCORDANCE WITH LOCAL UTILITY REGULATIONS.
3. THE LOCATION AND/OR ELEVATION OF EXISTING UTILITIES AS SHOWN ON THESE PLANS IS BASED ON RECORDS OF THE VARIOUS UTILITY COMPANIES, AND WHERE POSSIBLE, MEASUREMENTS TAKEN IN THE FIELD. THE INFORMATION IS NOT TO BE RELIED ON AS BEING EXACT OR COMPLETE.
5. ALL PR. CURB & GUTTER IS EPC TYBE B PER EL PASO COUNTY STANDARD DETAIL SD_2-20 UNLESS OTHERWISE NOTED.
6. SEE PLANS FOR MAINLINE SIZES.
7. ALL WATER SERVICES ARE 1" X 6" TAPS BY DEVELOPER UNLESS OTHERWISE NOTED ON PLANS.

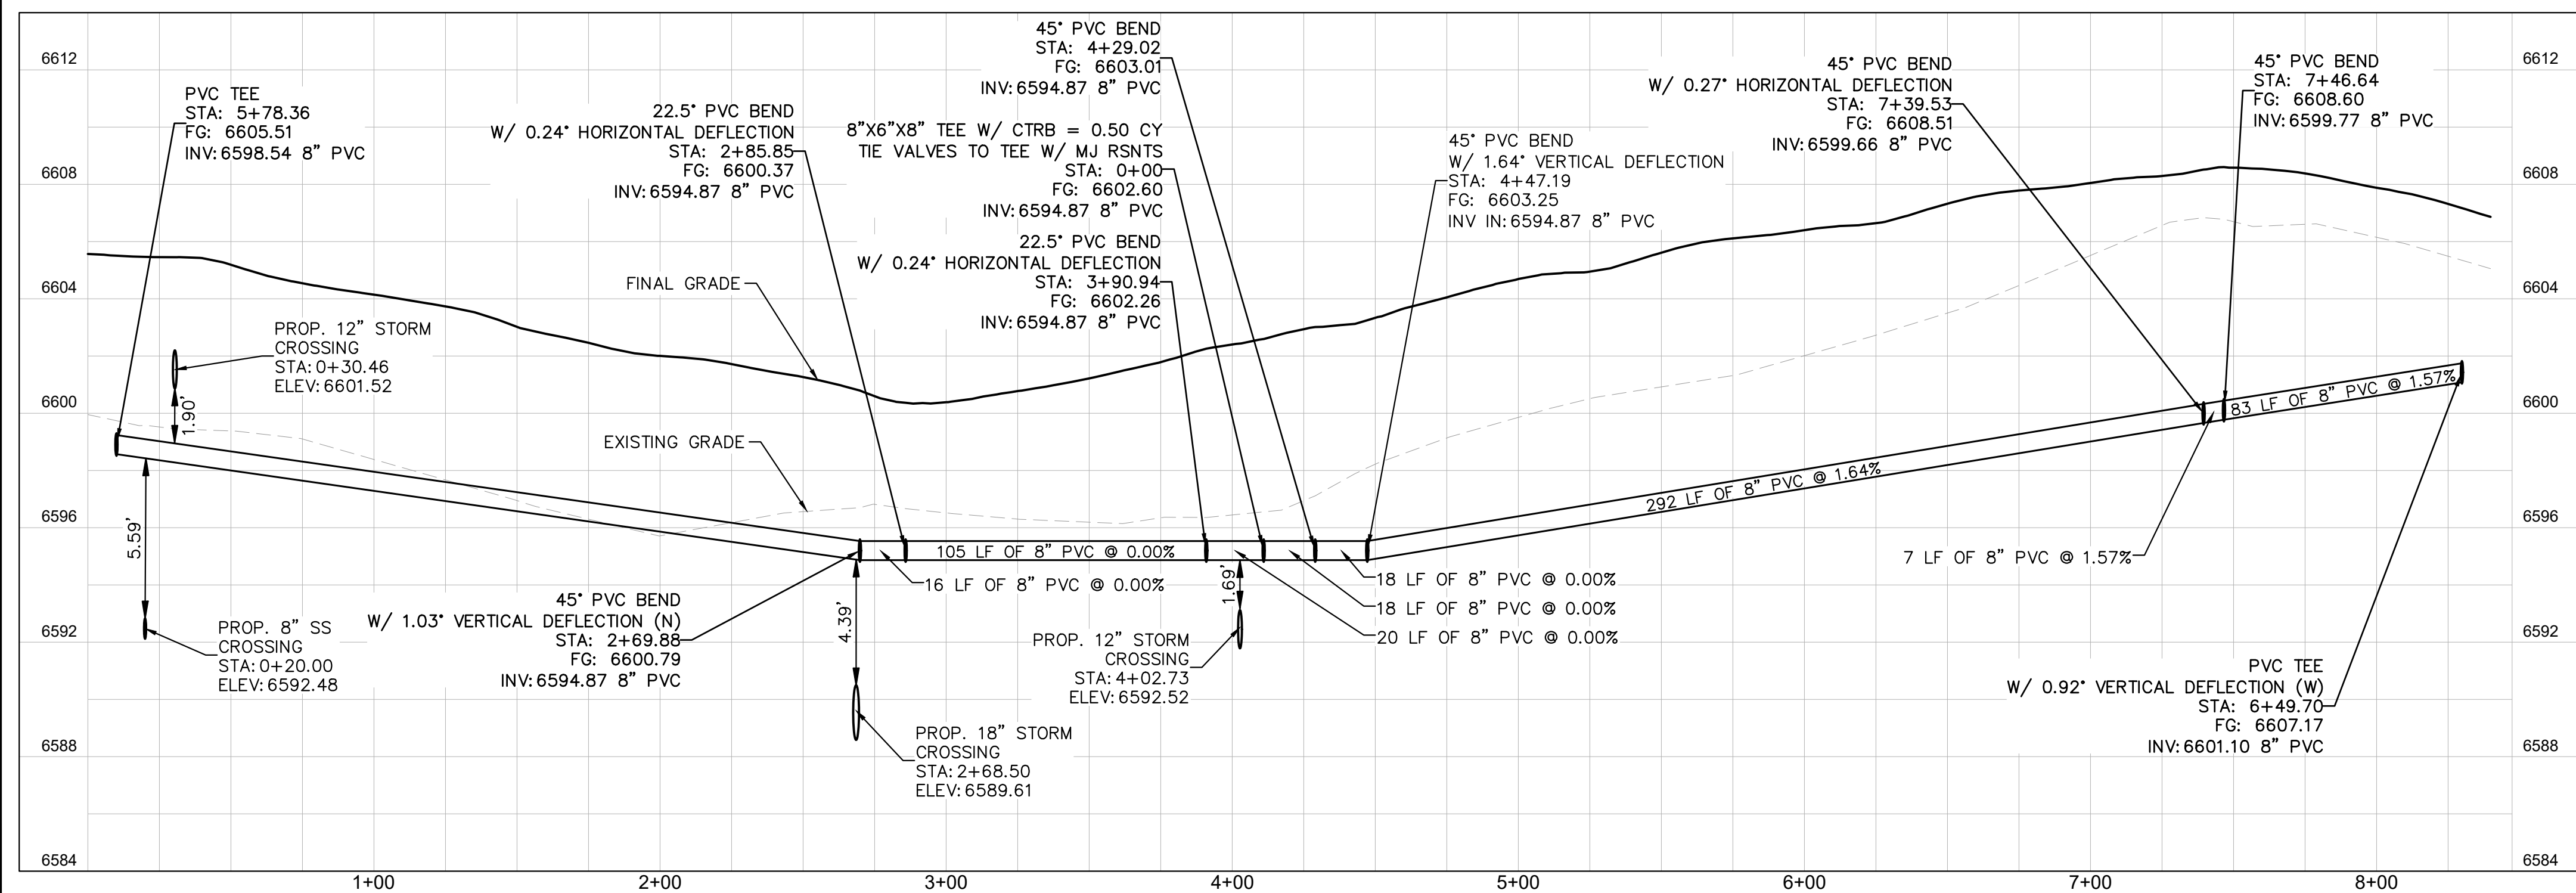

WATER B PROFILE VIEW

NO.	REVISION	BY	DATE	APPR

Kimley»Horn
 2026 KIMLEY-HORN AND ASSOCIATES, INC.
 2 North Nevada Avenue, Suite 900
 Colorado Springs, Colorado 80903 (719) 453-0180


DESIGNED BY: NMB
 DRAWN BY: DPM
 CHECKED BY: NMB
 DATE: 01/13/2026

WINDEMERE FILING NO. 2
 CONSTRUCTION DOCUMENTS
 EL PASO COUNTY, COLORADO
 WATER B P&P

PRELIMINARY
 FOR REVIEW ONLY
 NOT FOR
 CONSTRUCTION
Kimley»Horn
 Kimley-Horn and Associates, Inc.

PROJECT NO.
 196160000
 SHEET
C3.6



K:\COS_LA\196160000 - Windemere\CADD\PlanSheets\CDS_CD_WT.dwg Evans, Wyatt 3/30/2026 8:22 AM

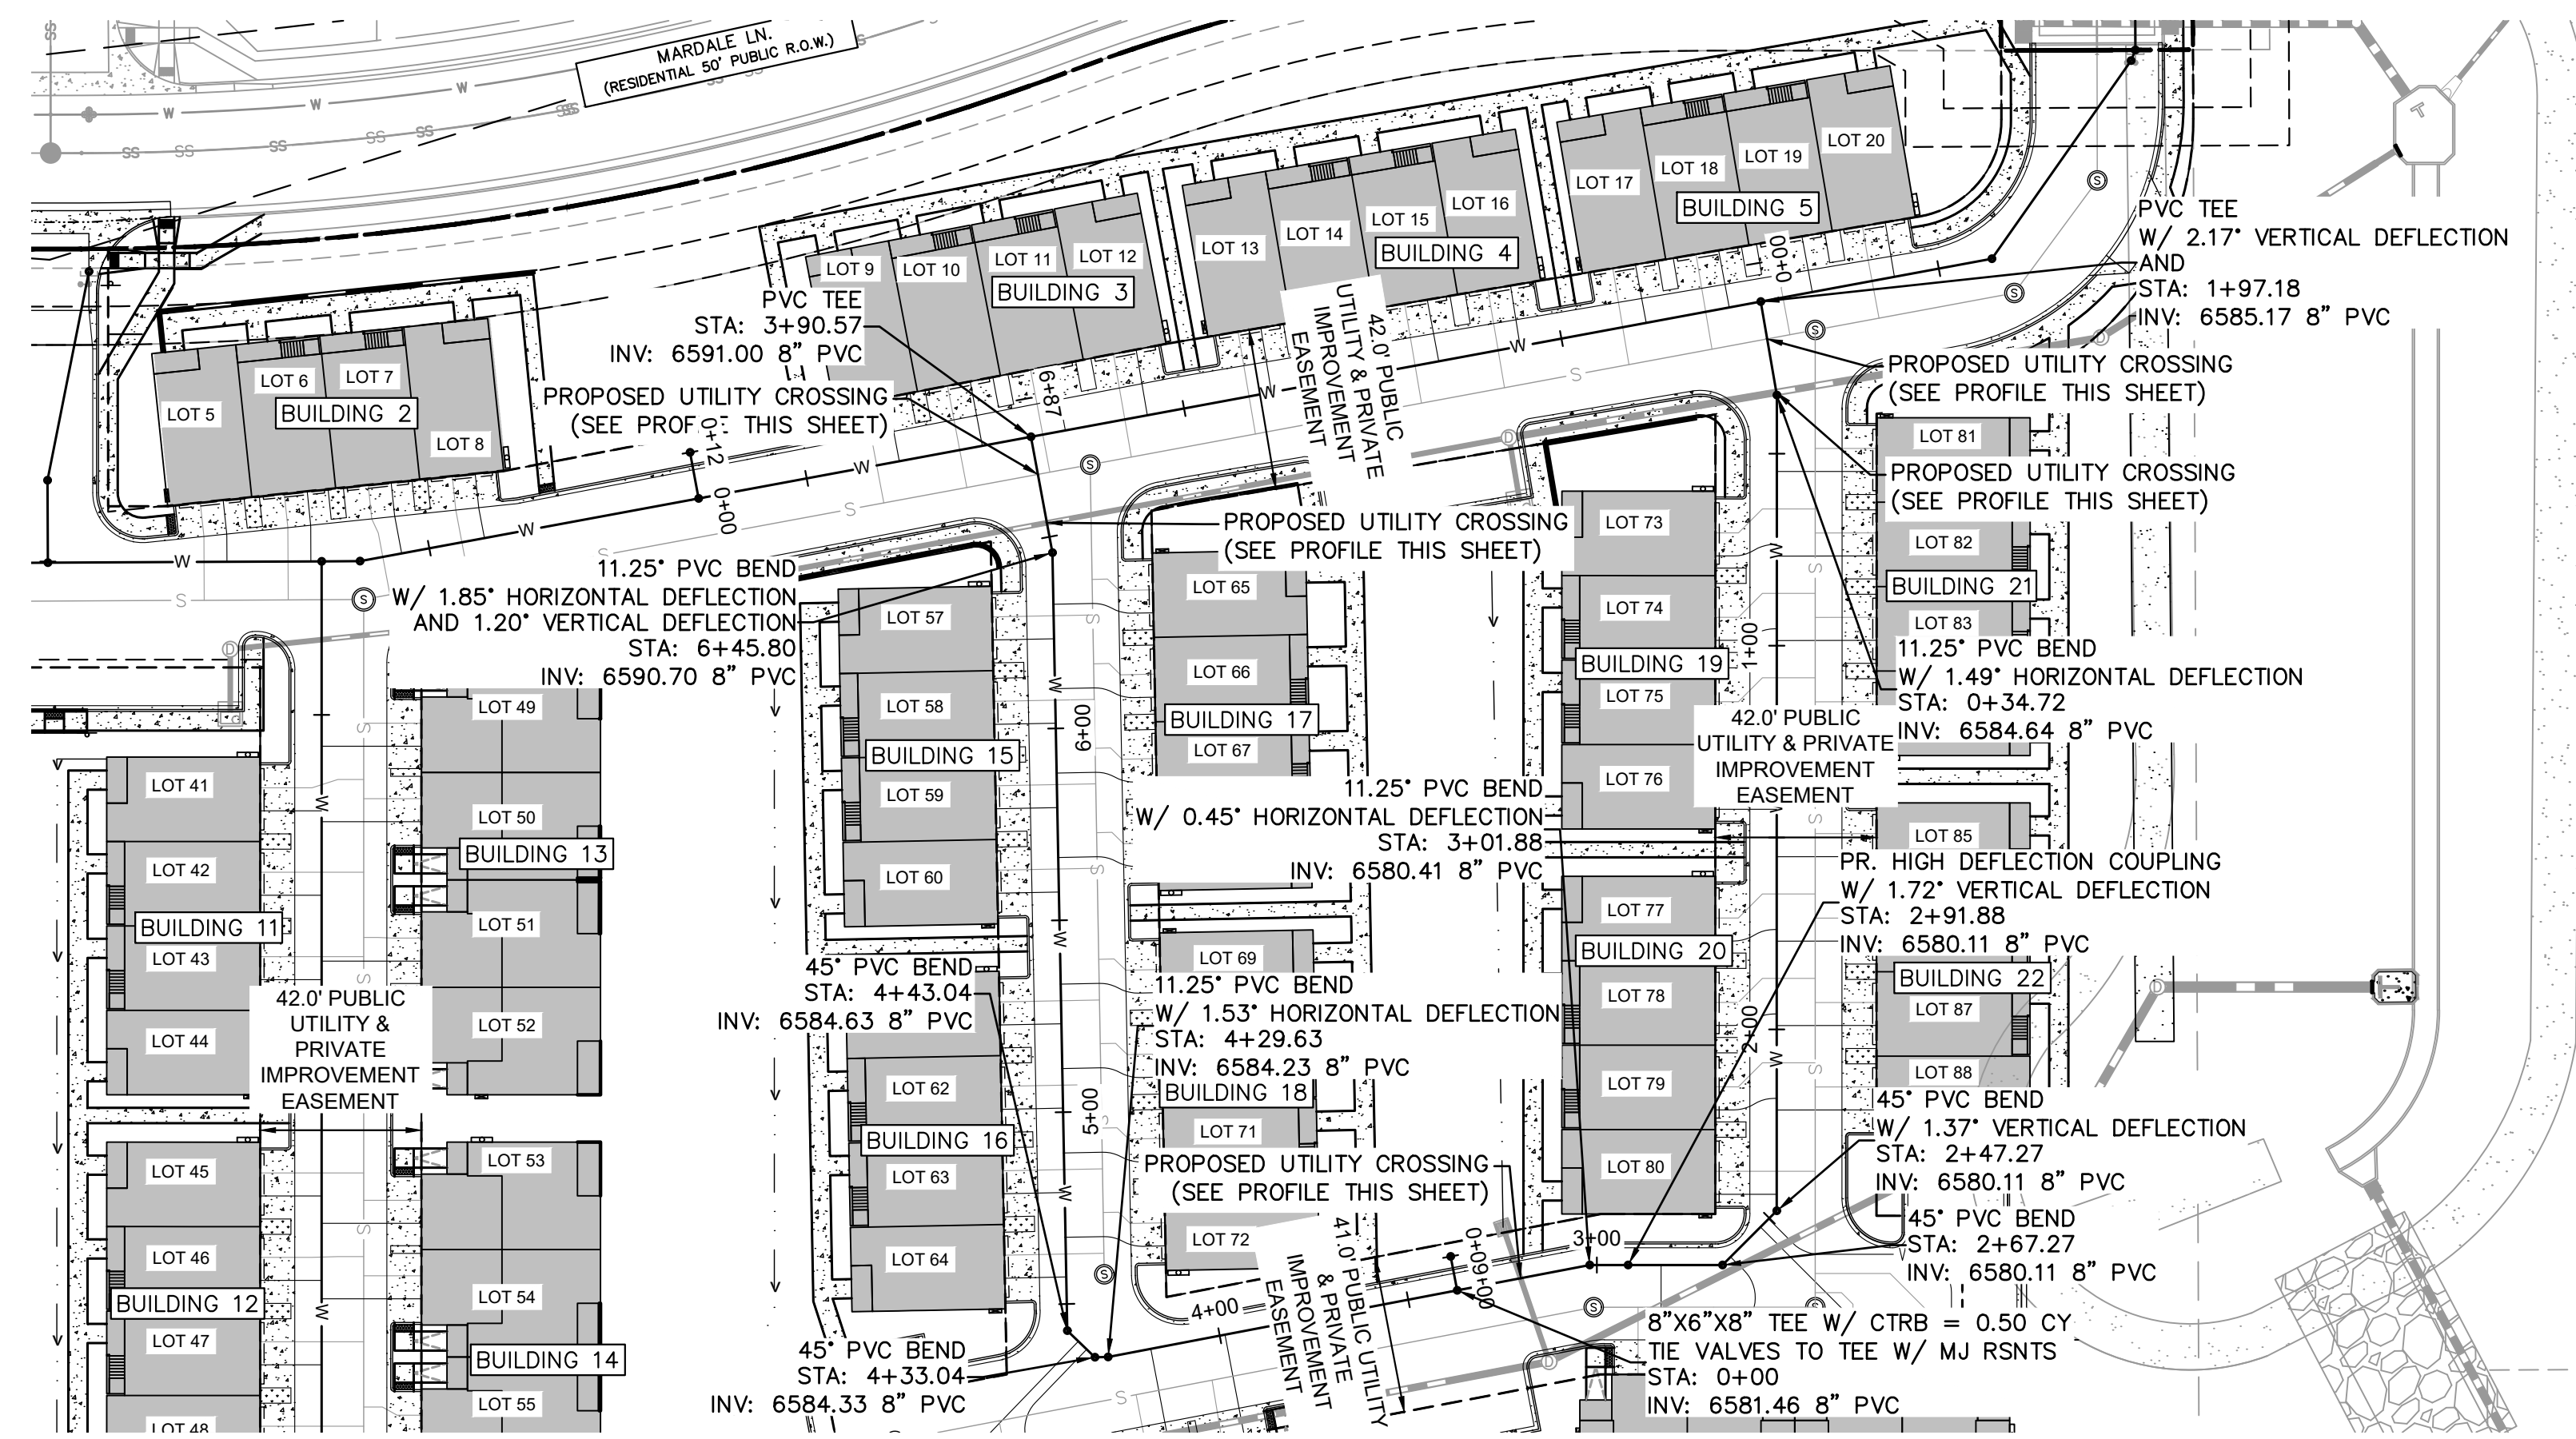

WATER C PLAN VIEW



VICINITY MAP

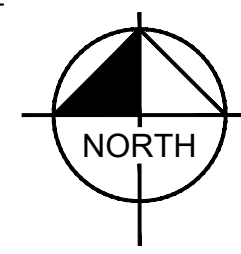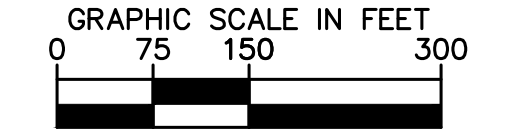


LEGEND



- PROPERTY LINE
- x-x- PROPOSED FENCE
- W- PROPOSED 8" PVC WATER MAIN
- S- PROPOSED 8" PVC SANITARY MAIN
- PROPOSED PVC STORM MAIN

NOTES

1. ALL EXISTING UTILITIES TO REMAIN UNLESS OTHERWISE NOTED.
2. UTILITIES TO BE REMOVED ARE TO BE CAPPED IN PLACE IN ACCORDANCE WITH LOCAL UTILITY REGULATIONS.
3. THE LOCATION AND/OR ELEVATION OF EXISTING UTILITIES AS SHOWN ON THESE PLANS IS BASED ON RECORDS OF THE VARIOUS UTILITY COMPANIES, AND WHERE POSSIBLE, MEASUREMENTS TAKEN IN THE FIELD. THE INFORMATION IS NOT TO BE RELIED ON AS BEING EXACT OR COMPLETE.
5. ALL PR. CURB & GUTTER IS EPC TYBE B PER EL PASO COUNTY STANDARD DETAIL SD_2-20 UNLESS OTHERWISE NOTED.
6. SEE PLANS FOR MAINLINE SIZES.
7. ALL WATER SERVICES ARE 1" X 6" TAPS BY DEVELOPER UNLESS OTHERWISE NOTED ON PLANS.

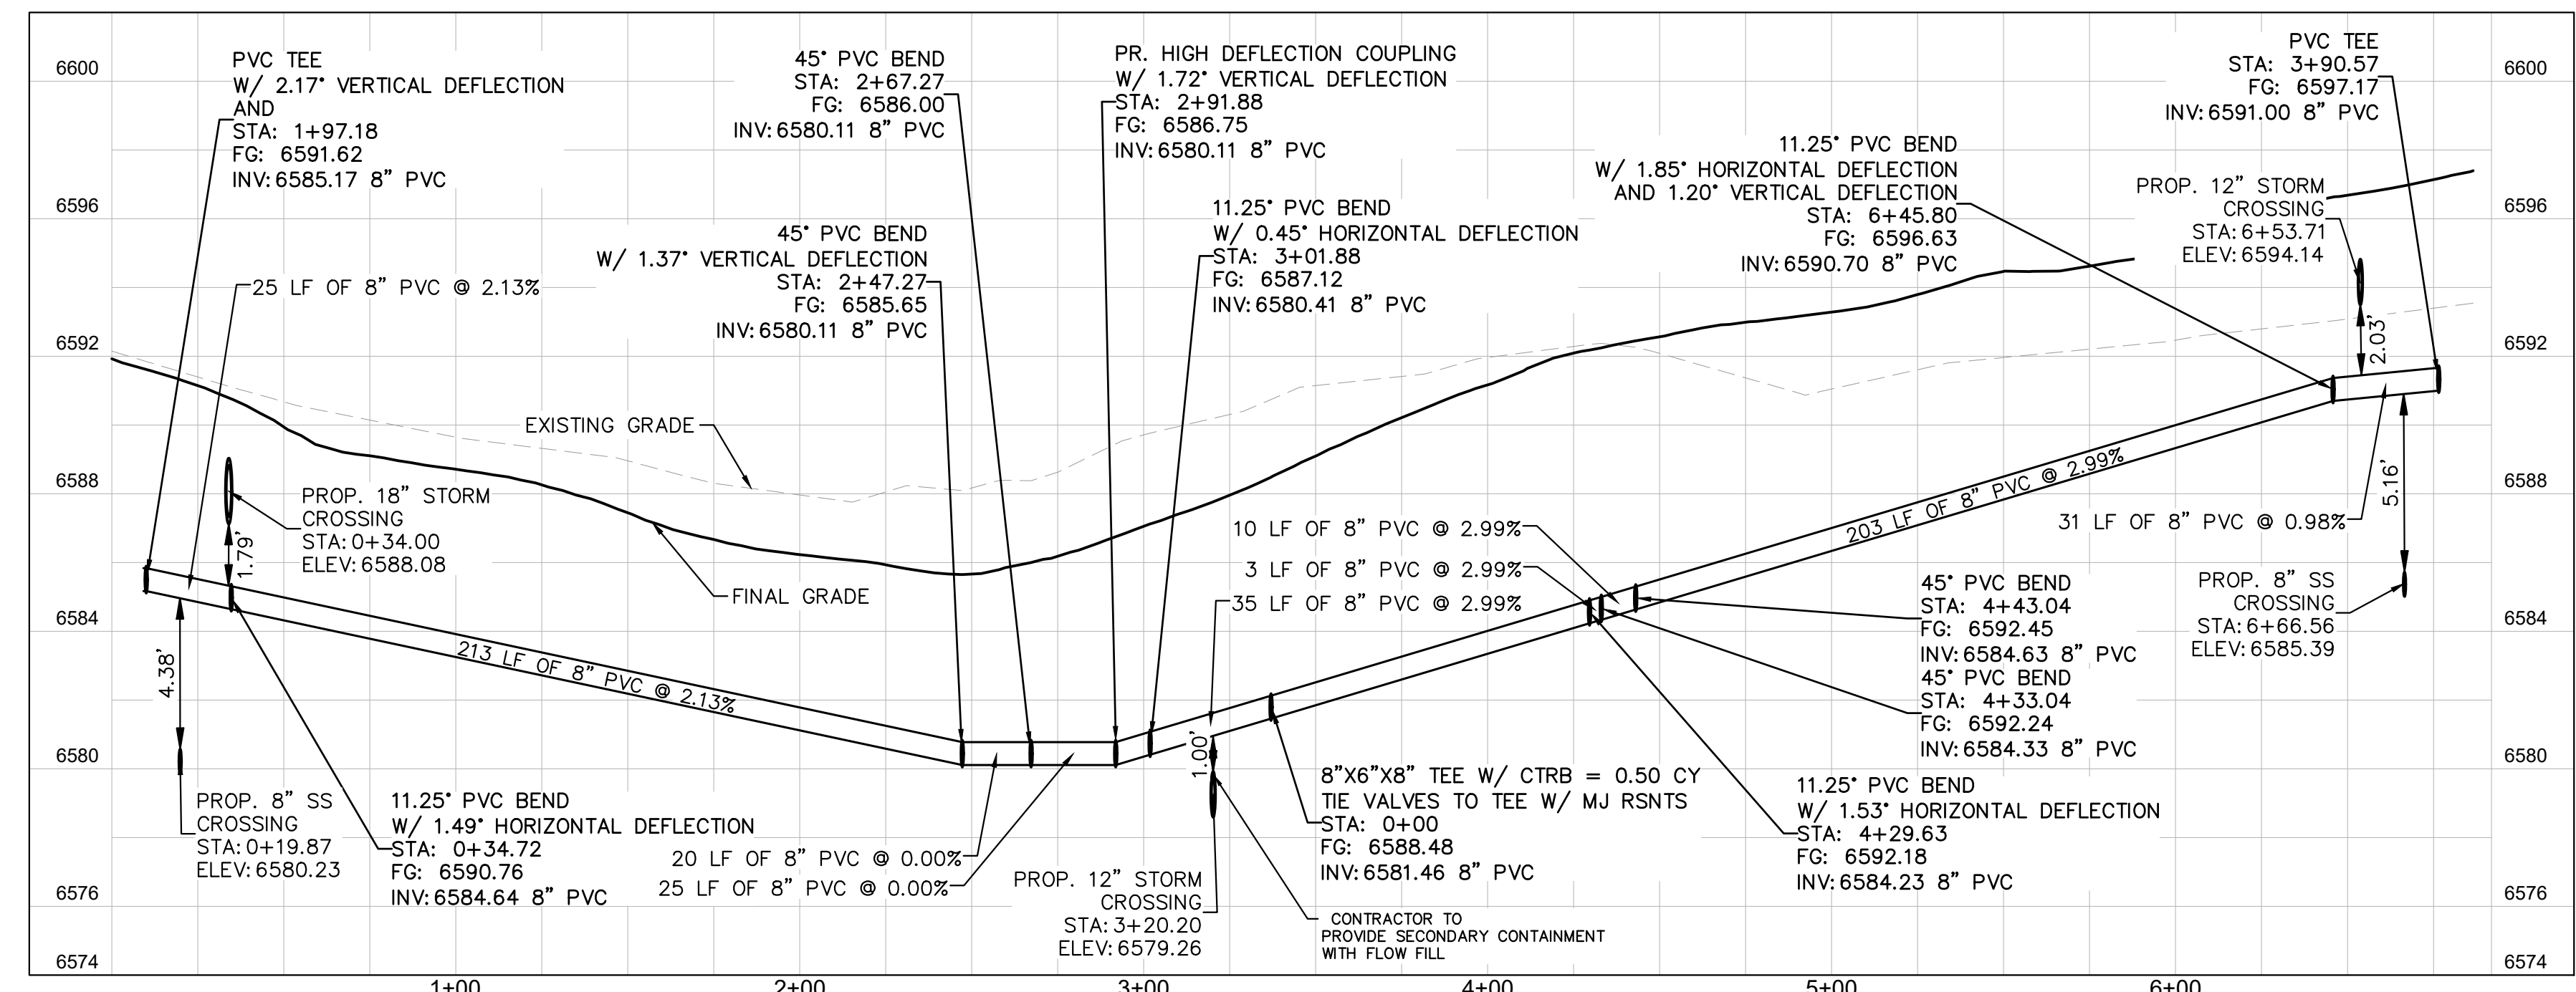

WATER C PROFILE VIEW

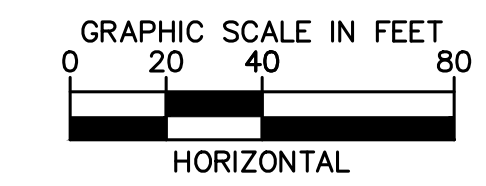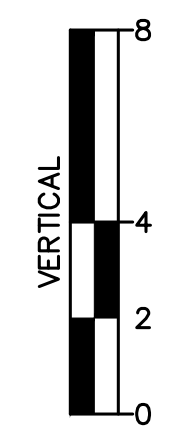

NO.	REVISION	BY	DATE	APPR

Kimley»Horn
 2026 KIMLEY-HORN AND ASSOCIATES, INC.
 2 North Nevada Avenue, Suite 900
 Colorado Springs, Colorado 80903 (719) 453-0180






DESIGNED BY: NMB
 DRAWN BY: DPM
 CHECKED BY: NMB
 DATE: 01/13/2026

WINDERMERE FILING NO. 2
 CONSTRUCTION DOCUMENTS
 EL PASO COUNTY, COLORADO
 WATER C P&P

PRELIMINARY
 FOR REVIEW ONLY
 NOT FOR CONSTRUCTION
Kimley»Horn
 Kimley-Horn and Associates, Inc.

PROJECT NO.
 196160000
 SHEET
 C3.7

K:\COS_LA\196160000 - Windemere\CADD\PlanSheets\CDS_CD_WT.dwg Evans, Wyatt 3/30/2026 8:22 AM

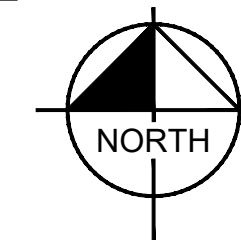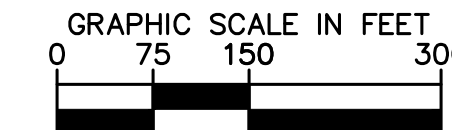
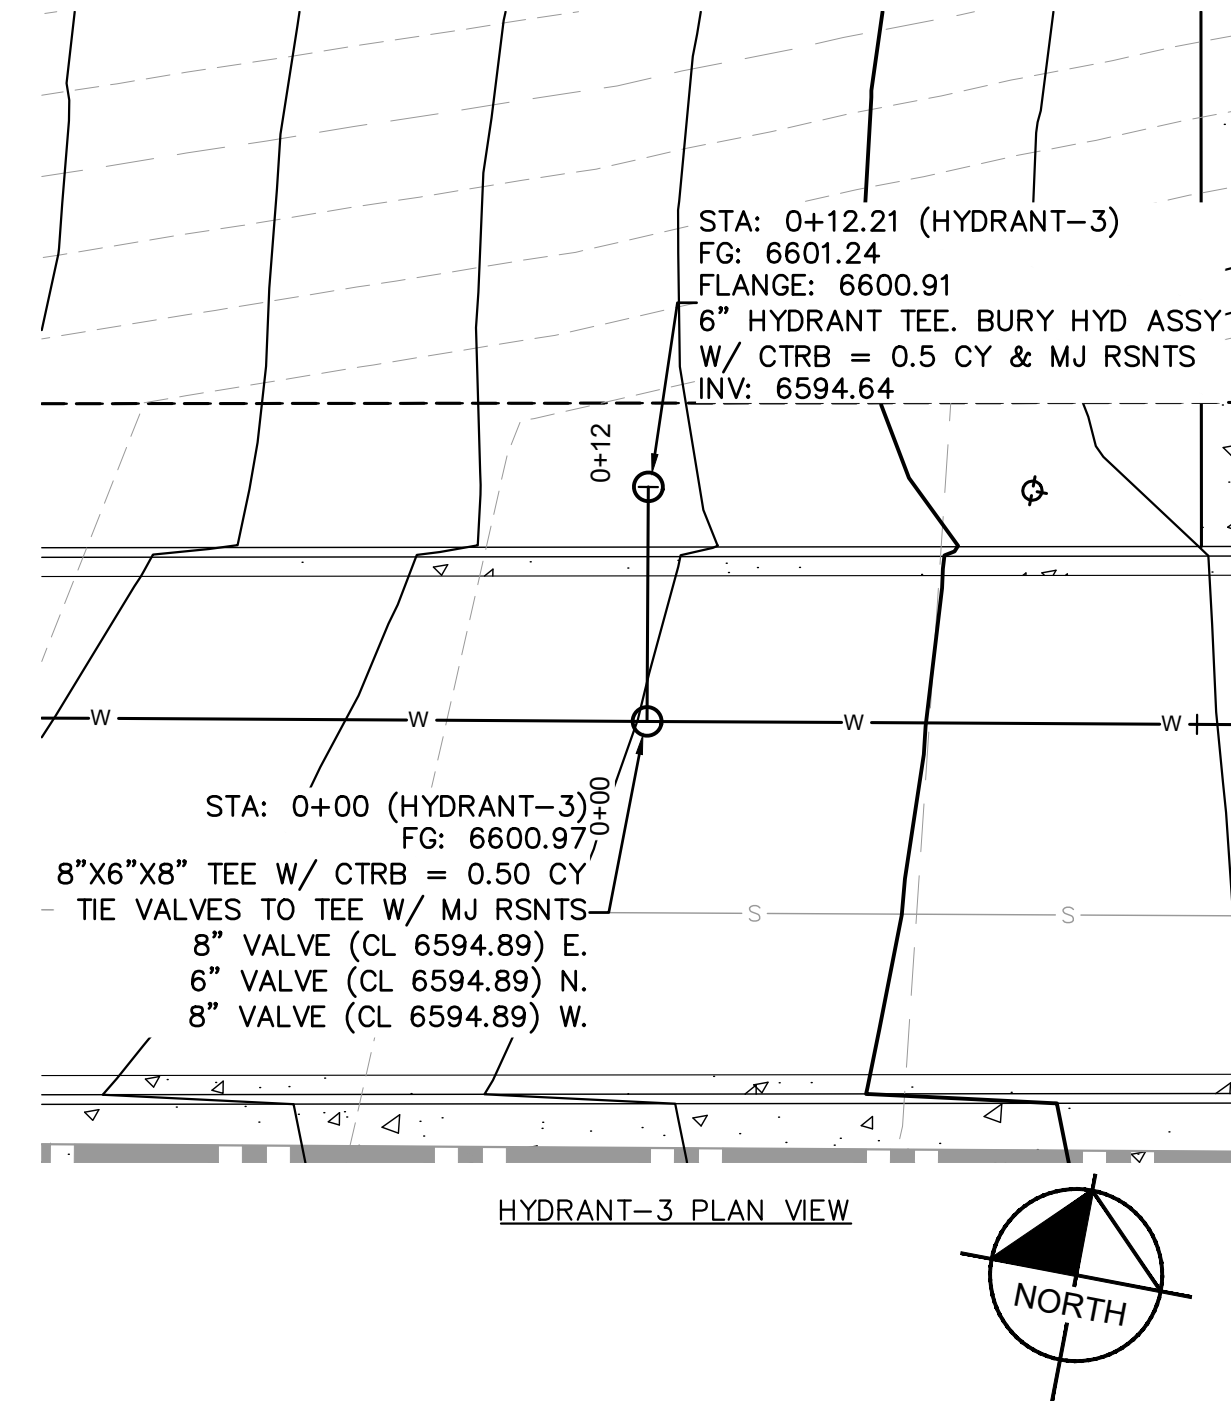
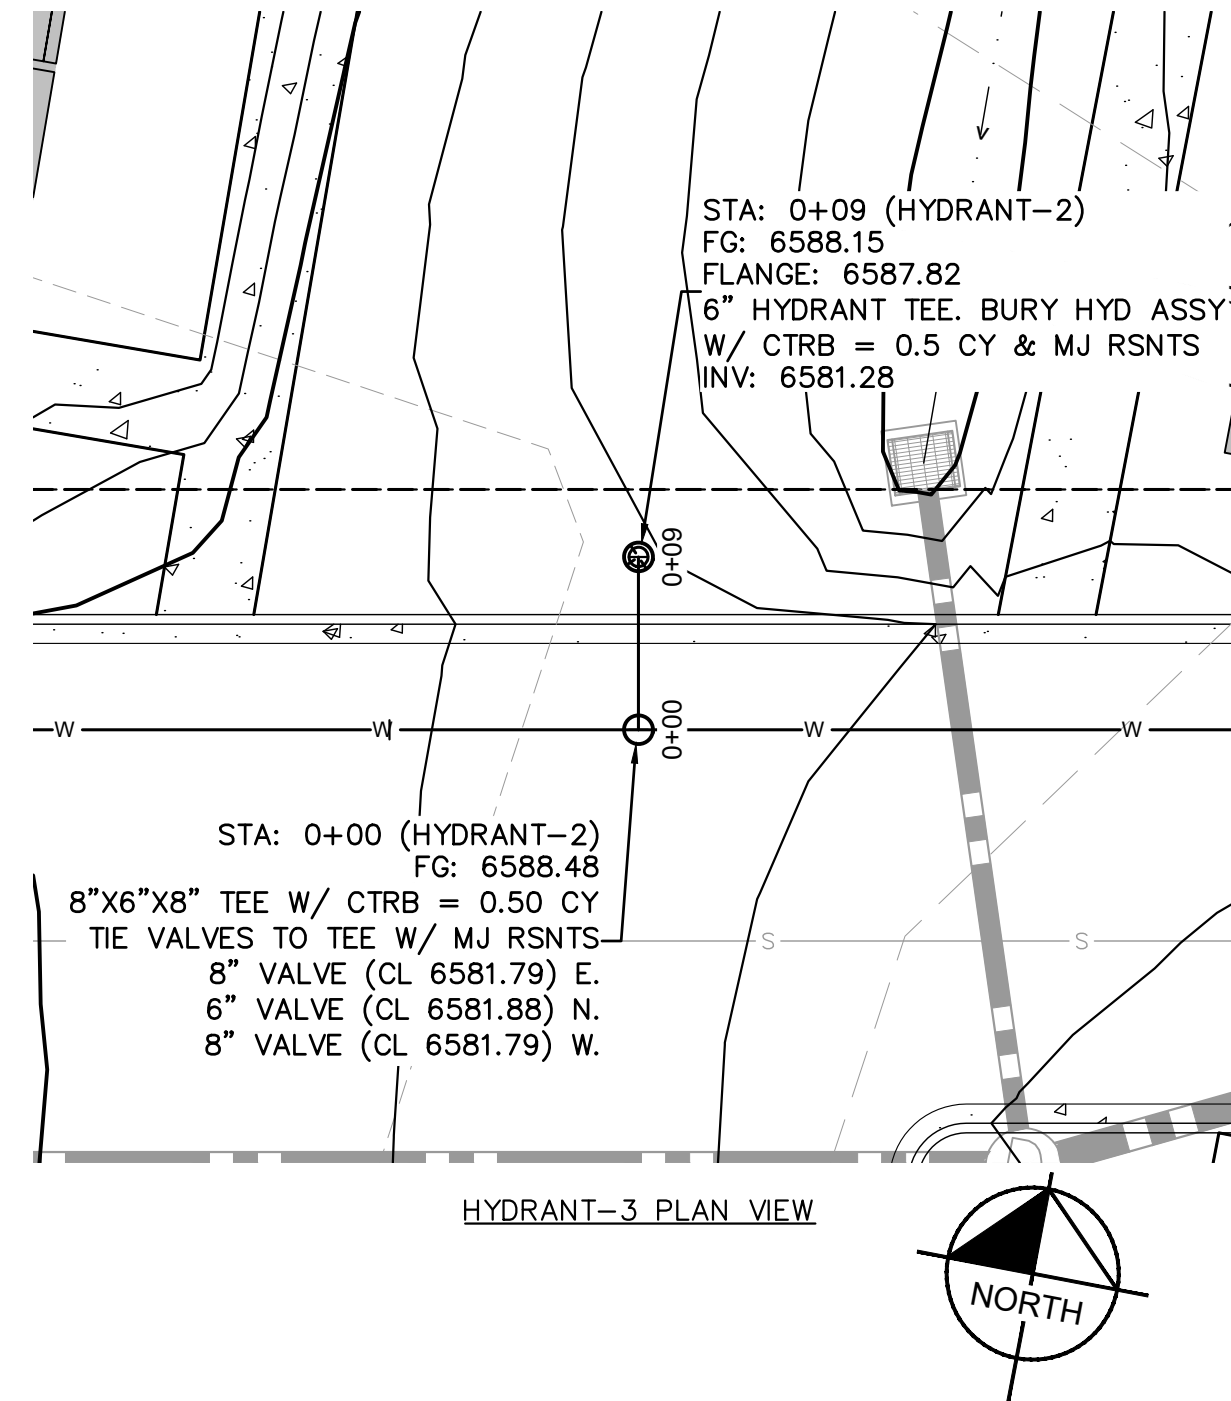
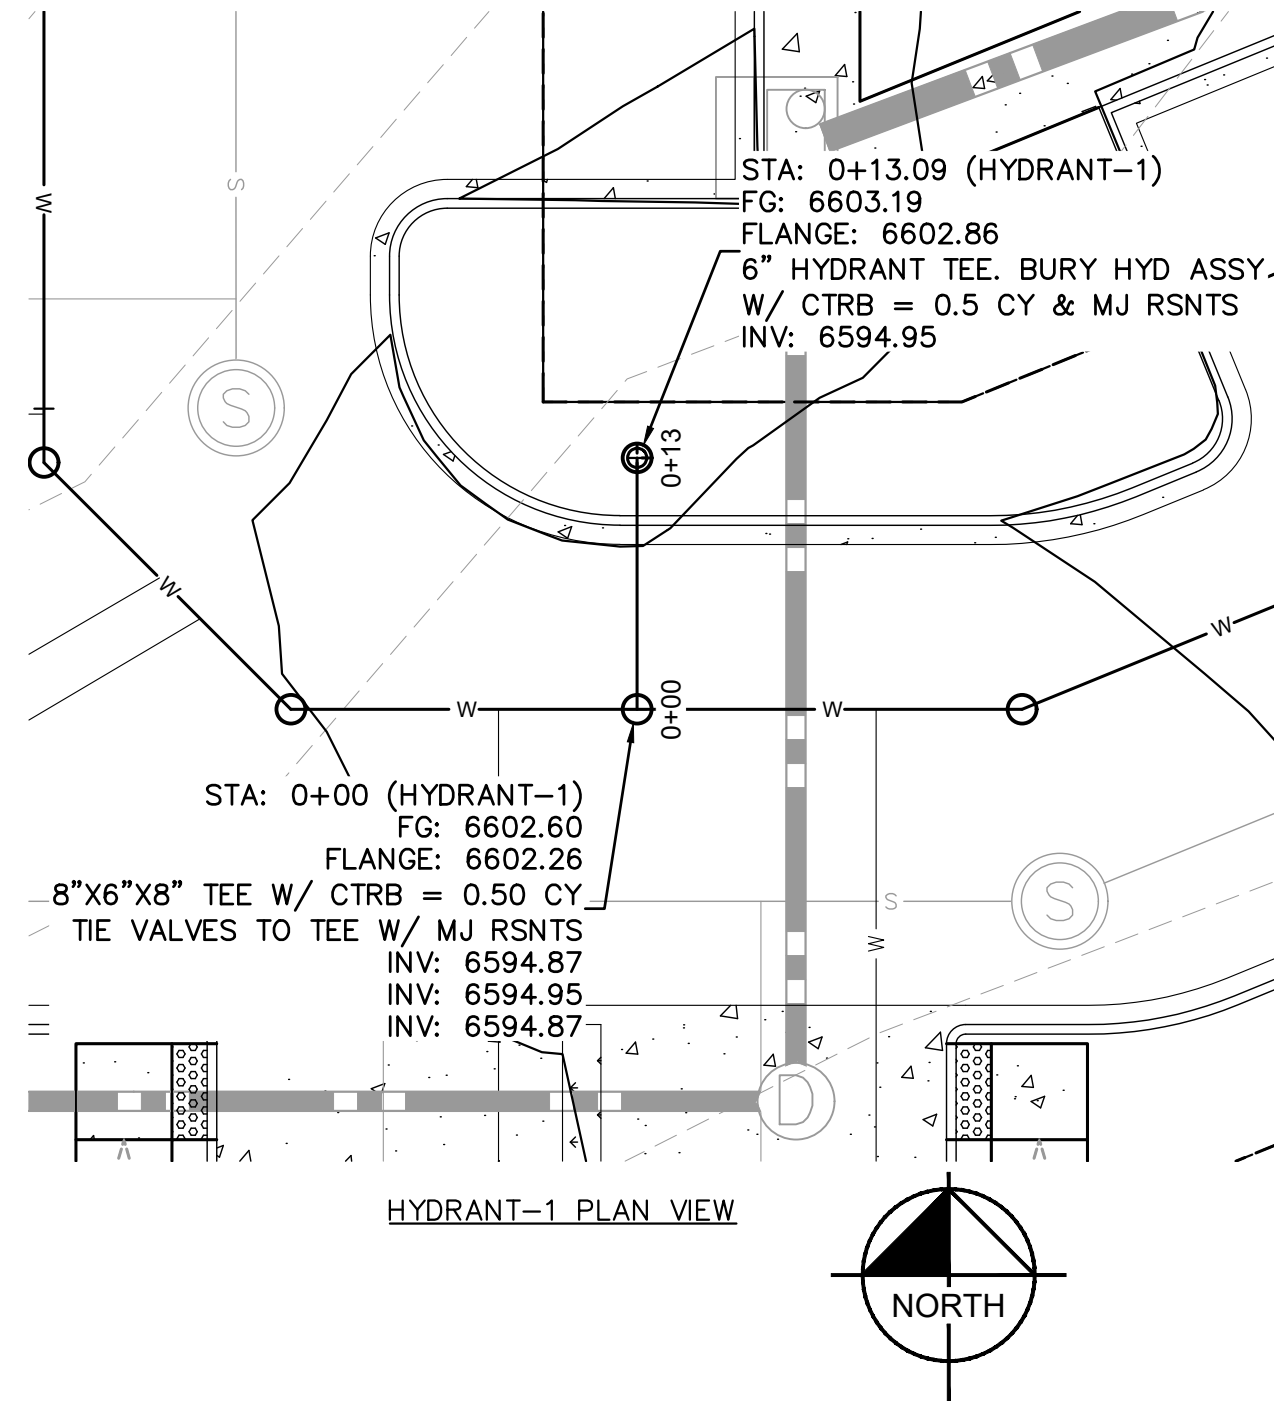


LEGEND

- PROPERTY LINE
- x-x- PROPOSED FENCE
- w- PROPOSED 8" PVC WATER MAIN
- s- PROPOSED 8" PVC SANITARY MAIN
- PROPOSED PVC STORM MAIN

NOTES

1. ALL EXISTING UTILITIES TO REMAIN UNLESS OTHERWISE NOTED.
2. UTILITIES TO BE REMOVED ARE TO BE CAPPED IN PLACE IN ACCORDANCE WITH LOCAL UTILITY REGULATIONS.
3. THE LOCATION AND/OR ELEVATION OF EXISTING UTILITIES AS SHOWN ON THESE PLANS IS BASED ON RECORDS OF THE VARIOUS UTILITY COMPANIES, AND WHERE POSSIBLE, MEASUREMENTS TAKEN IN THE FIELD. THE INFORMATION IS NOT TO BE RELIED ON AS BEING EXACT OR COMPLETE.
5. ALL PR. CURB & GUTTER IS EPC TYBE B PER EL PASO COUNTY STANDARD DETAIL SD_2-20 UNLESS OTHERWISE NOTED.
6. SEE PLANS FOR MAINLINE SIZES.
7. ALL WATER SERVICES ARE 1" X 6" TAPS BY DEVELOPER UNLESS OTHERWISE NOTED ON PLANS.

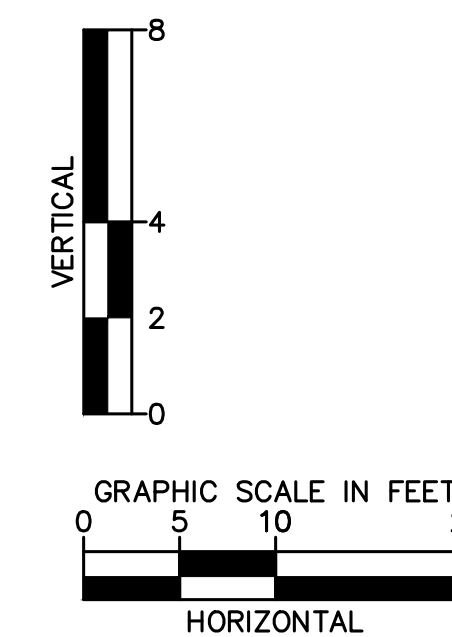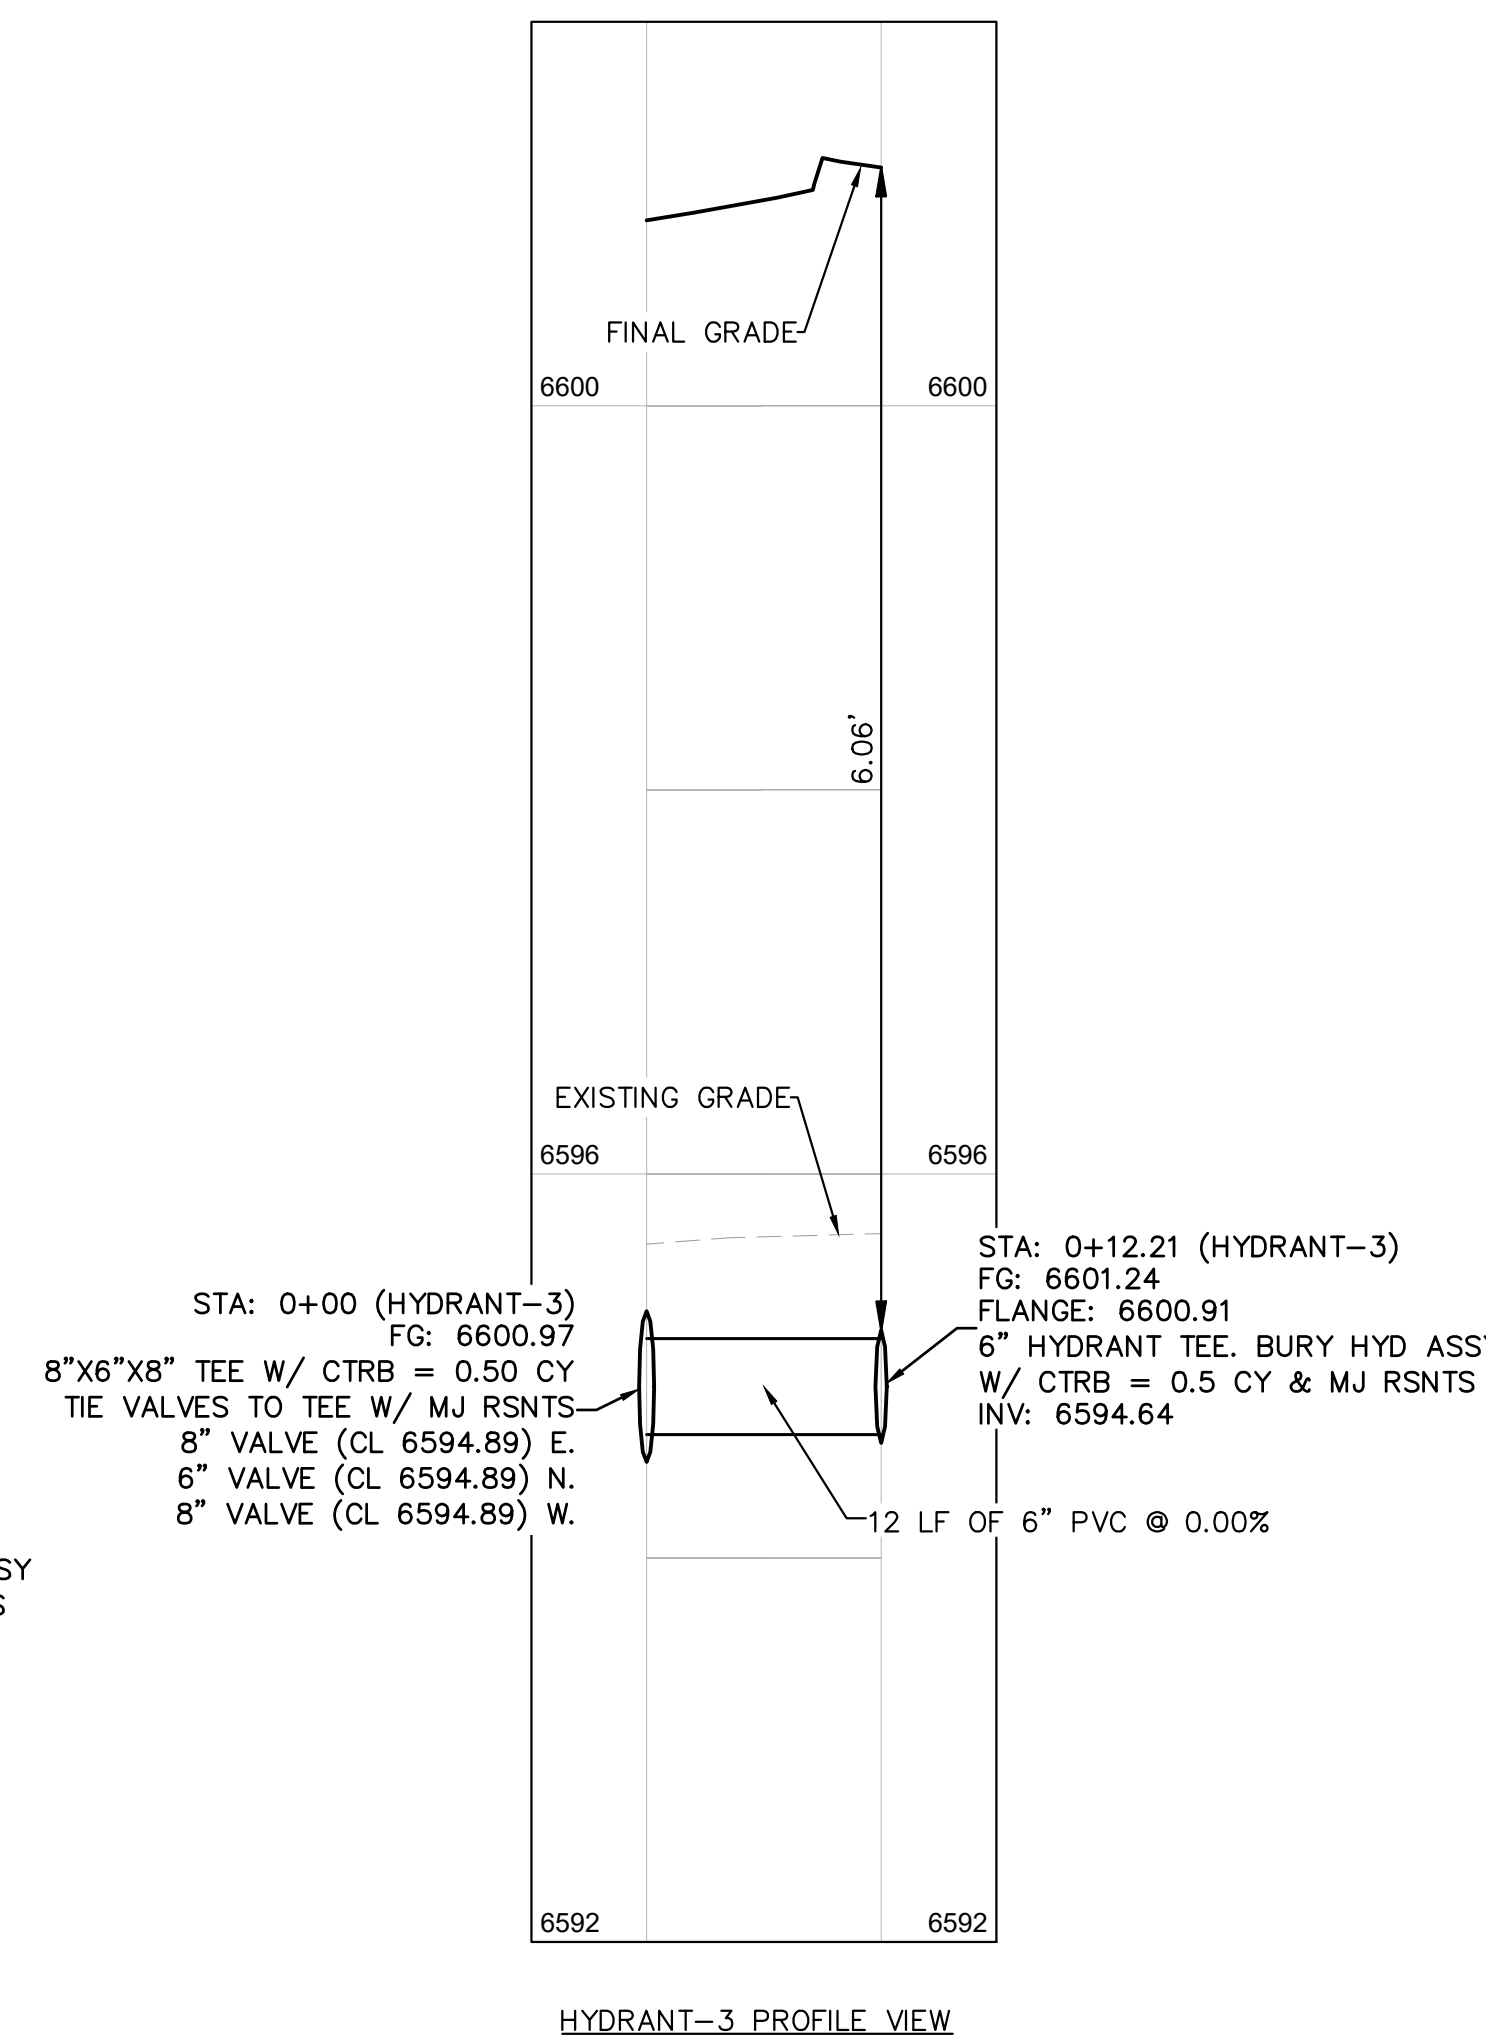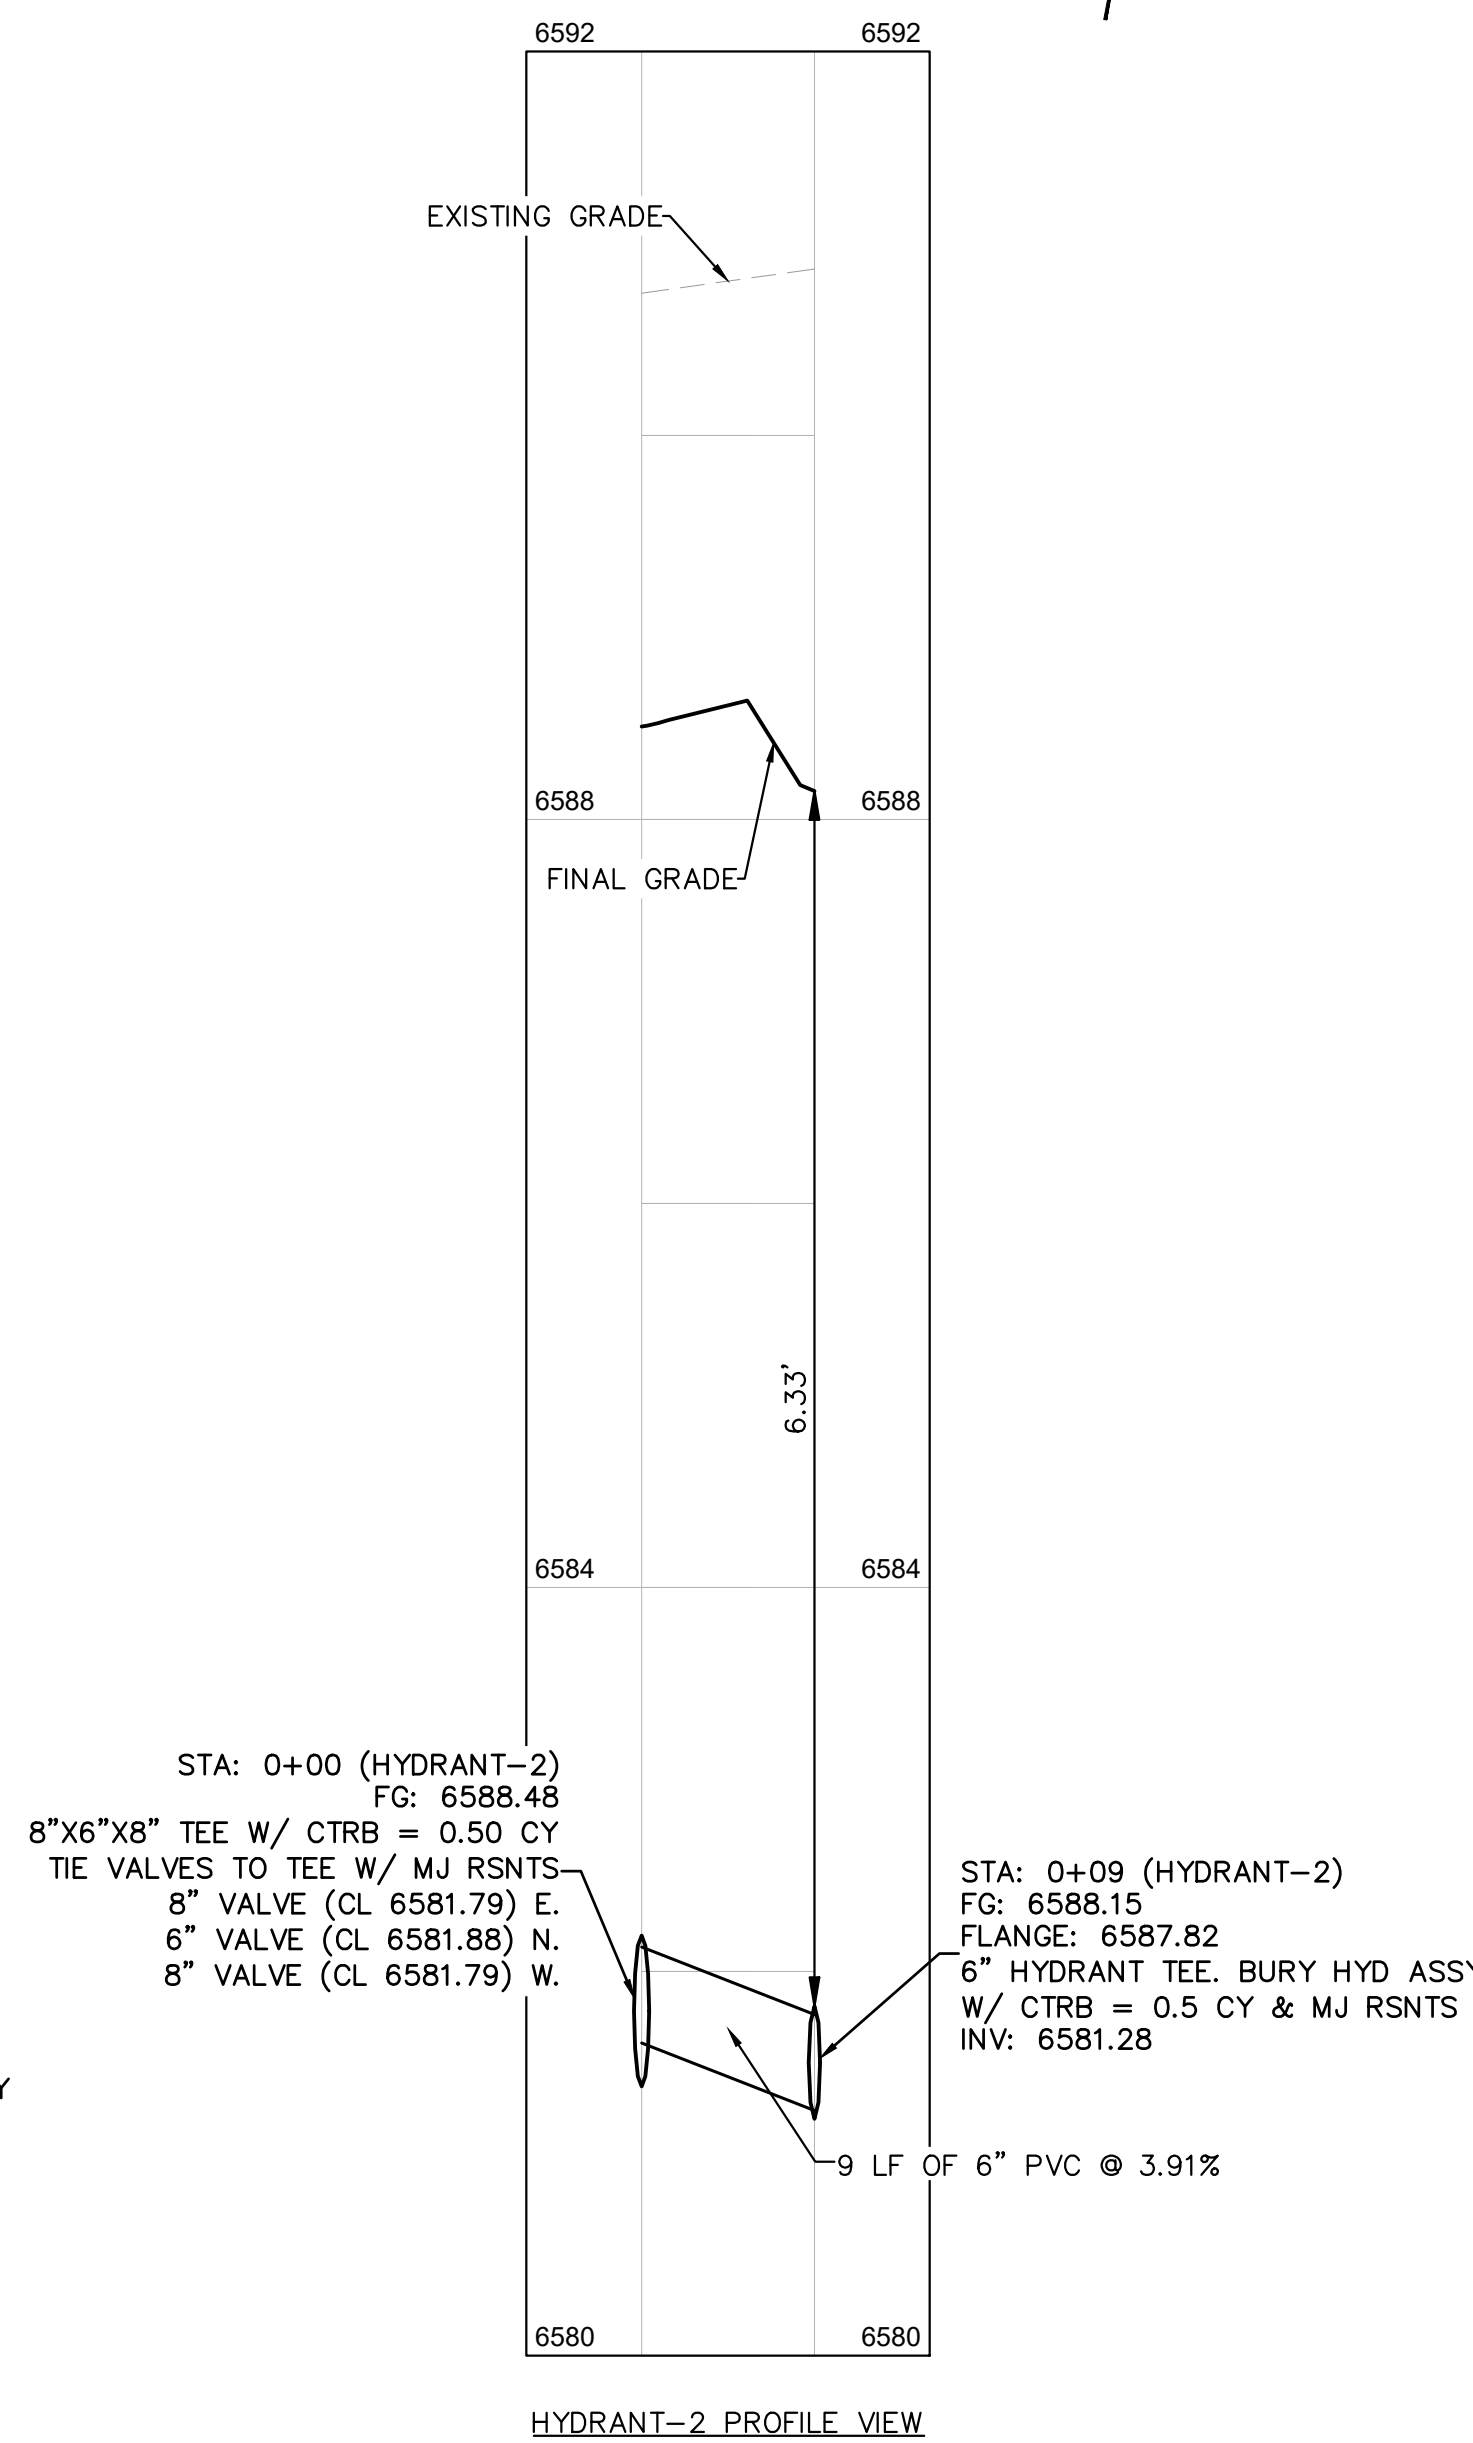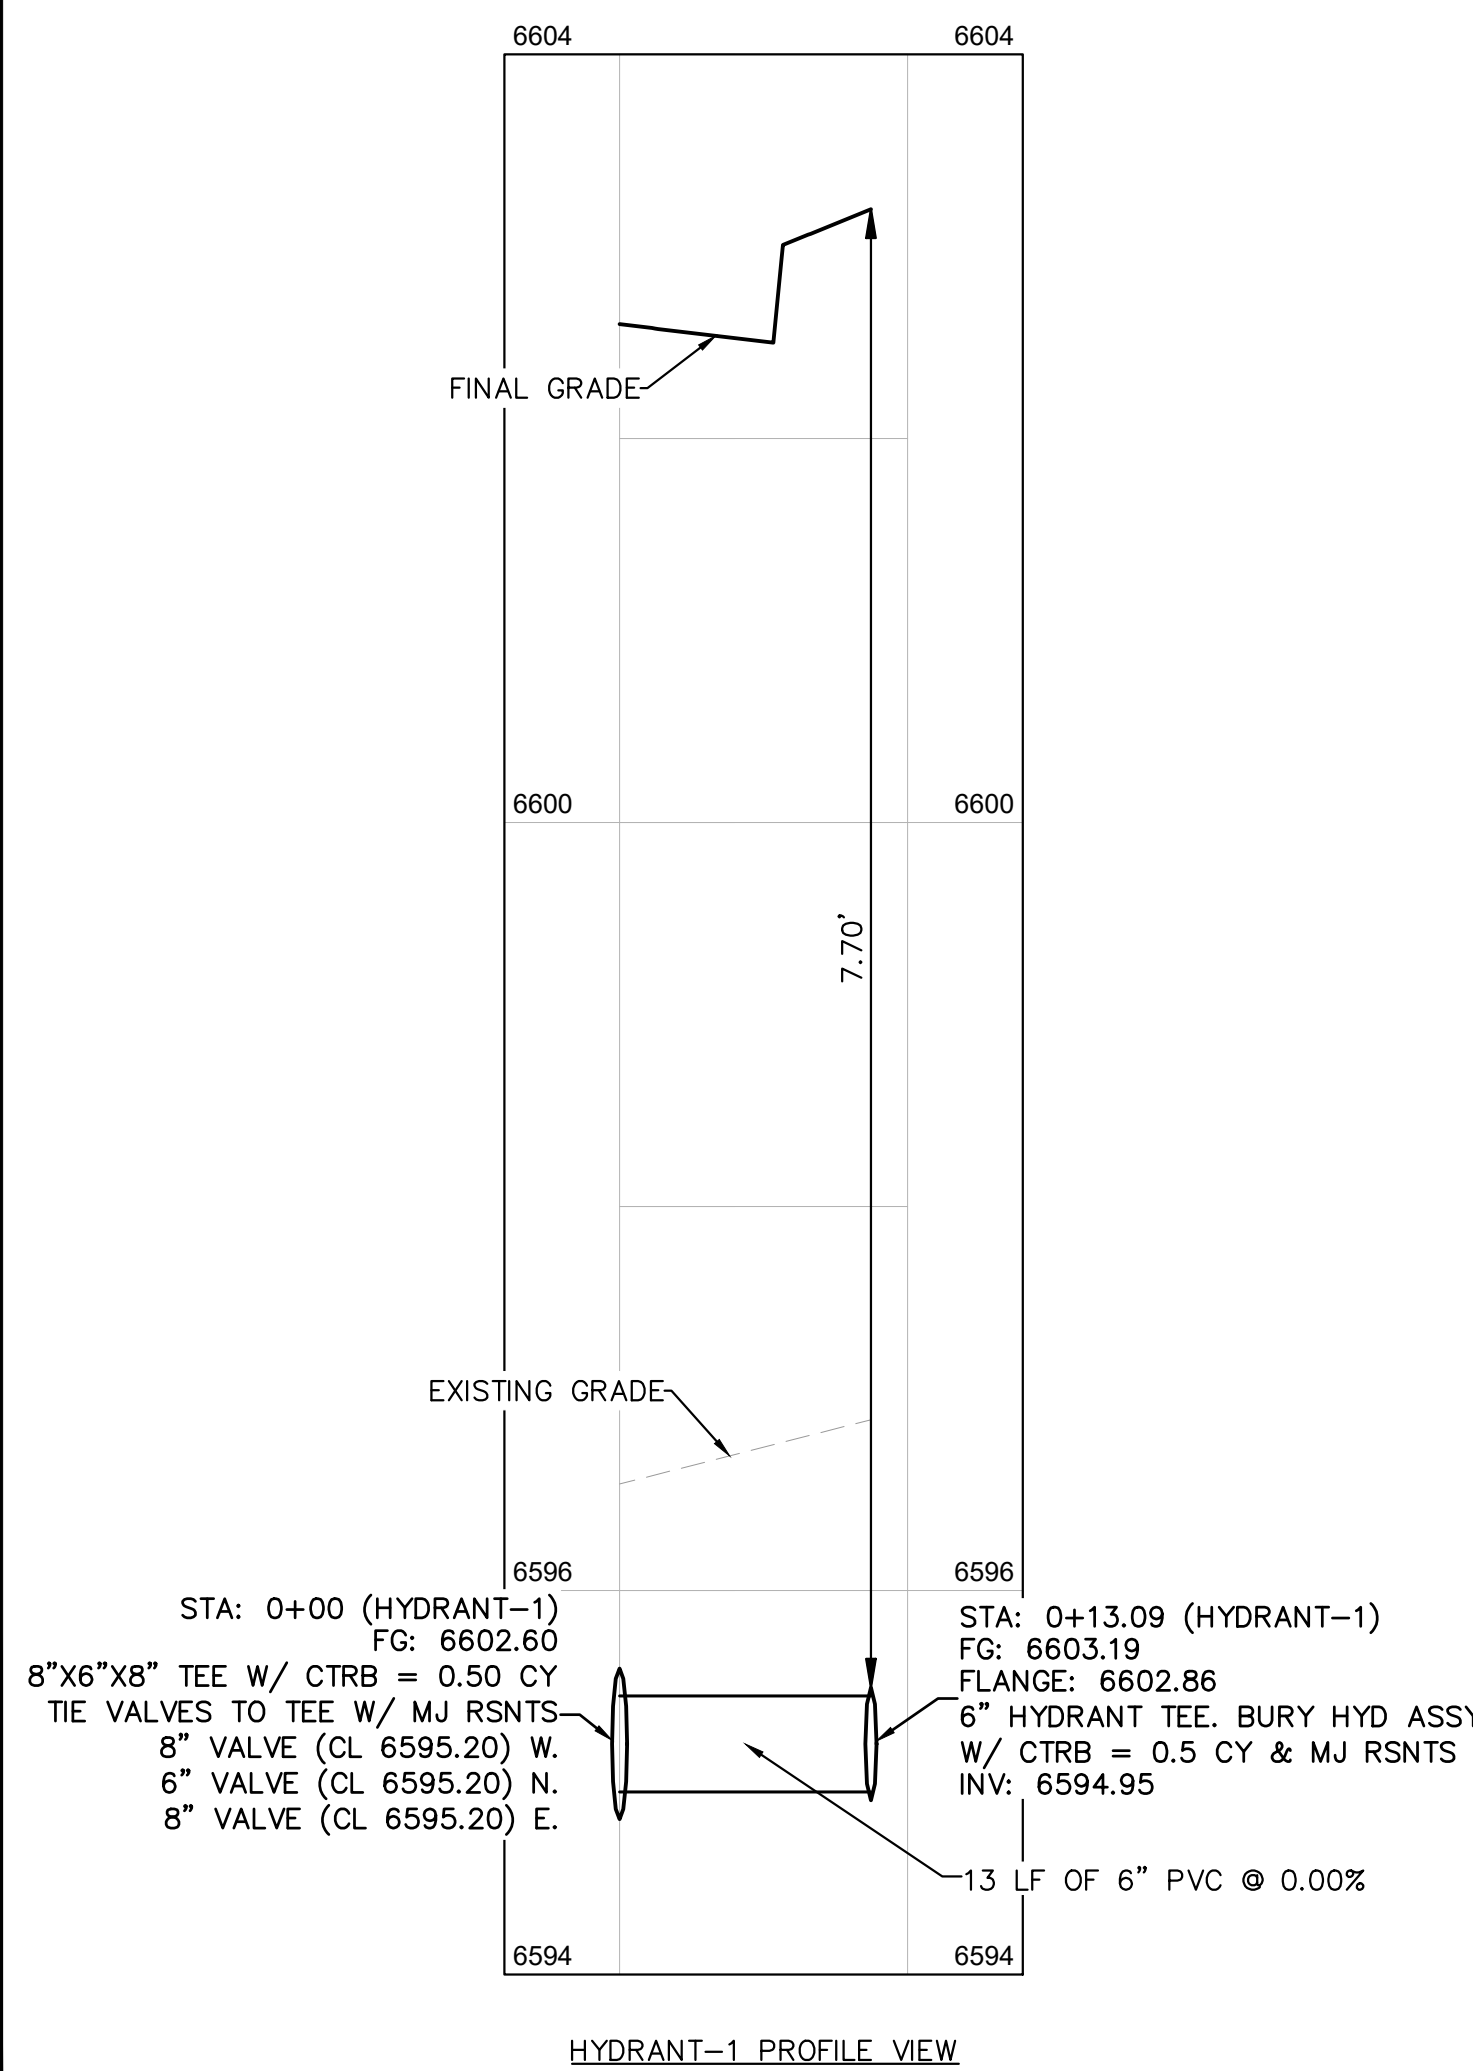

NO.	REVISION	BY	DATE	APPR

Kimley»Horn
2026 KIMLEY-HORN AND ASSOCIATES, INC.
2 North Nevada Avenue, Suite 900
Colorado Springs, Colorado 80903 (719) 453-0180

DESIGNED BY: NMB
DRAWN BY: DPM
CHECKED BY: NMB
DATE: 01/13/2026






WINDERMERE FILING NO. 2
CONSTRUCTION DOCUMENTS
EL PASO COUNTY, COLORADO
FIRE HYDRANTS

PRELIMINARY
FOR REVIEW ONLY
NOT FOR
CONSTRUCTION
Kimley»Horn
Kimley-Horn and Associates, Inc.

PROJECT NO.
196160000

SHEET
C3.8

K:\COS_LA\196160000 - Windemere\CADD\PlanSheets\CDS\CD_SSWR.dwg Evans, WY 3/30/2026 8:23 AM

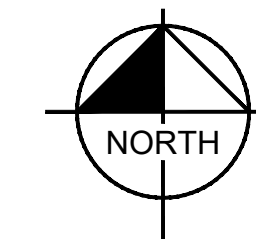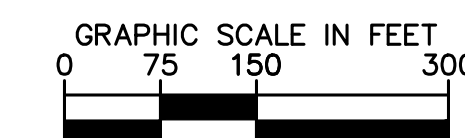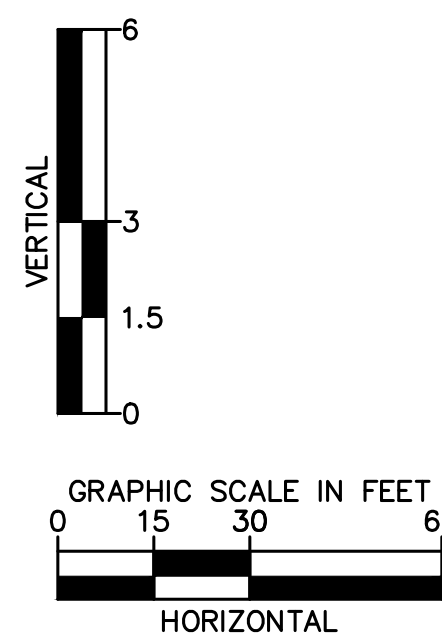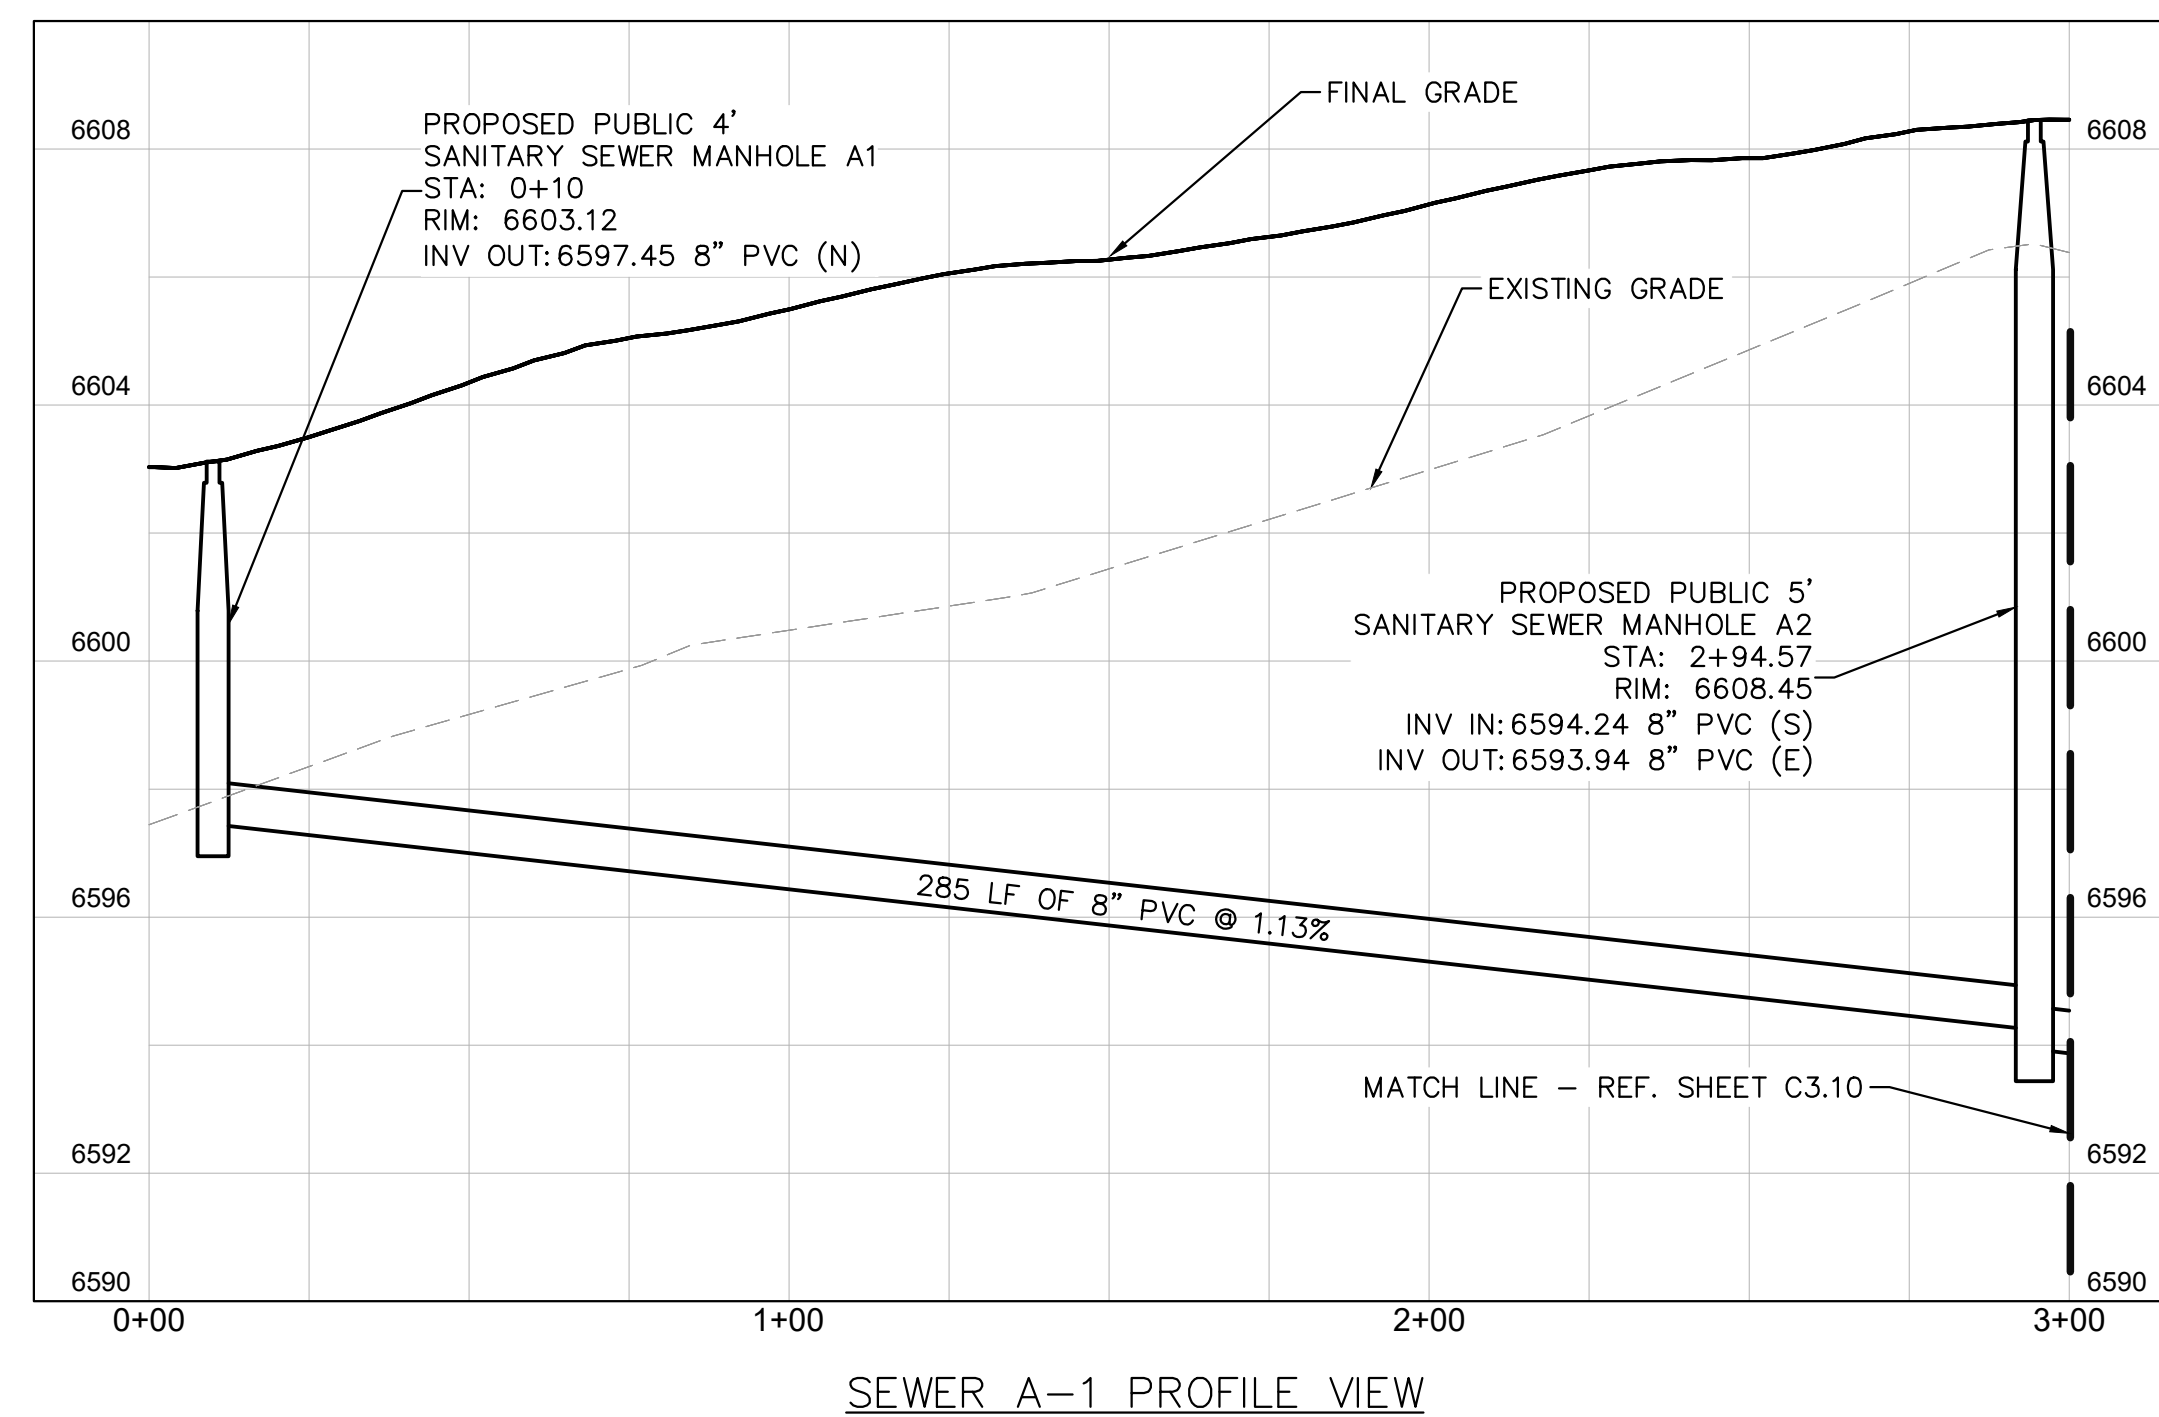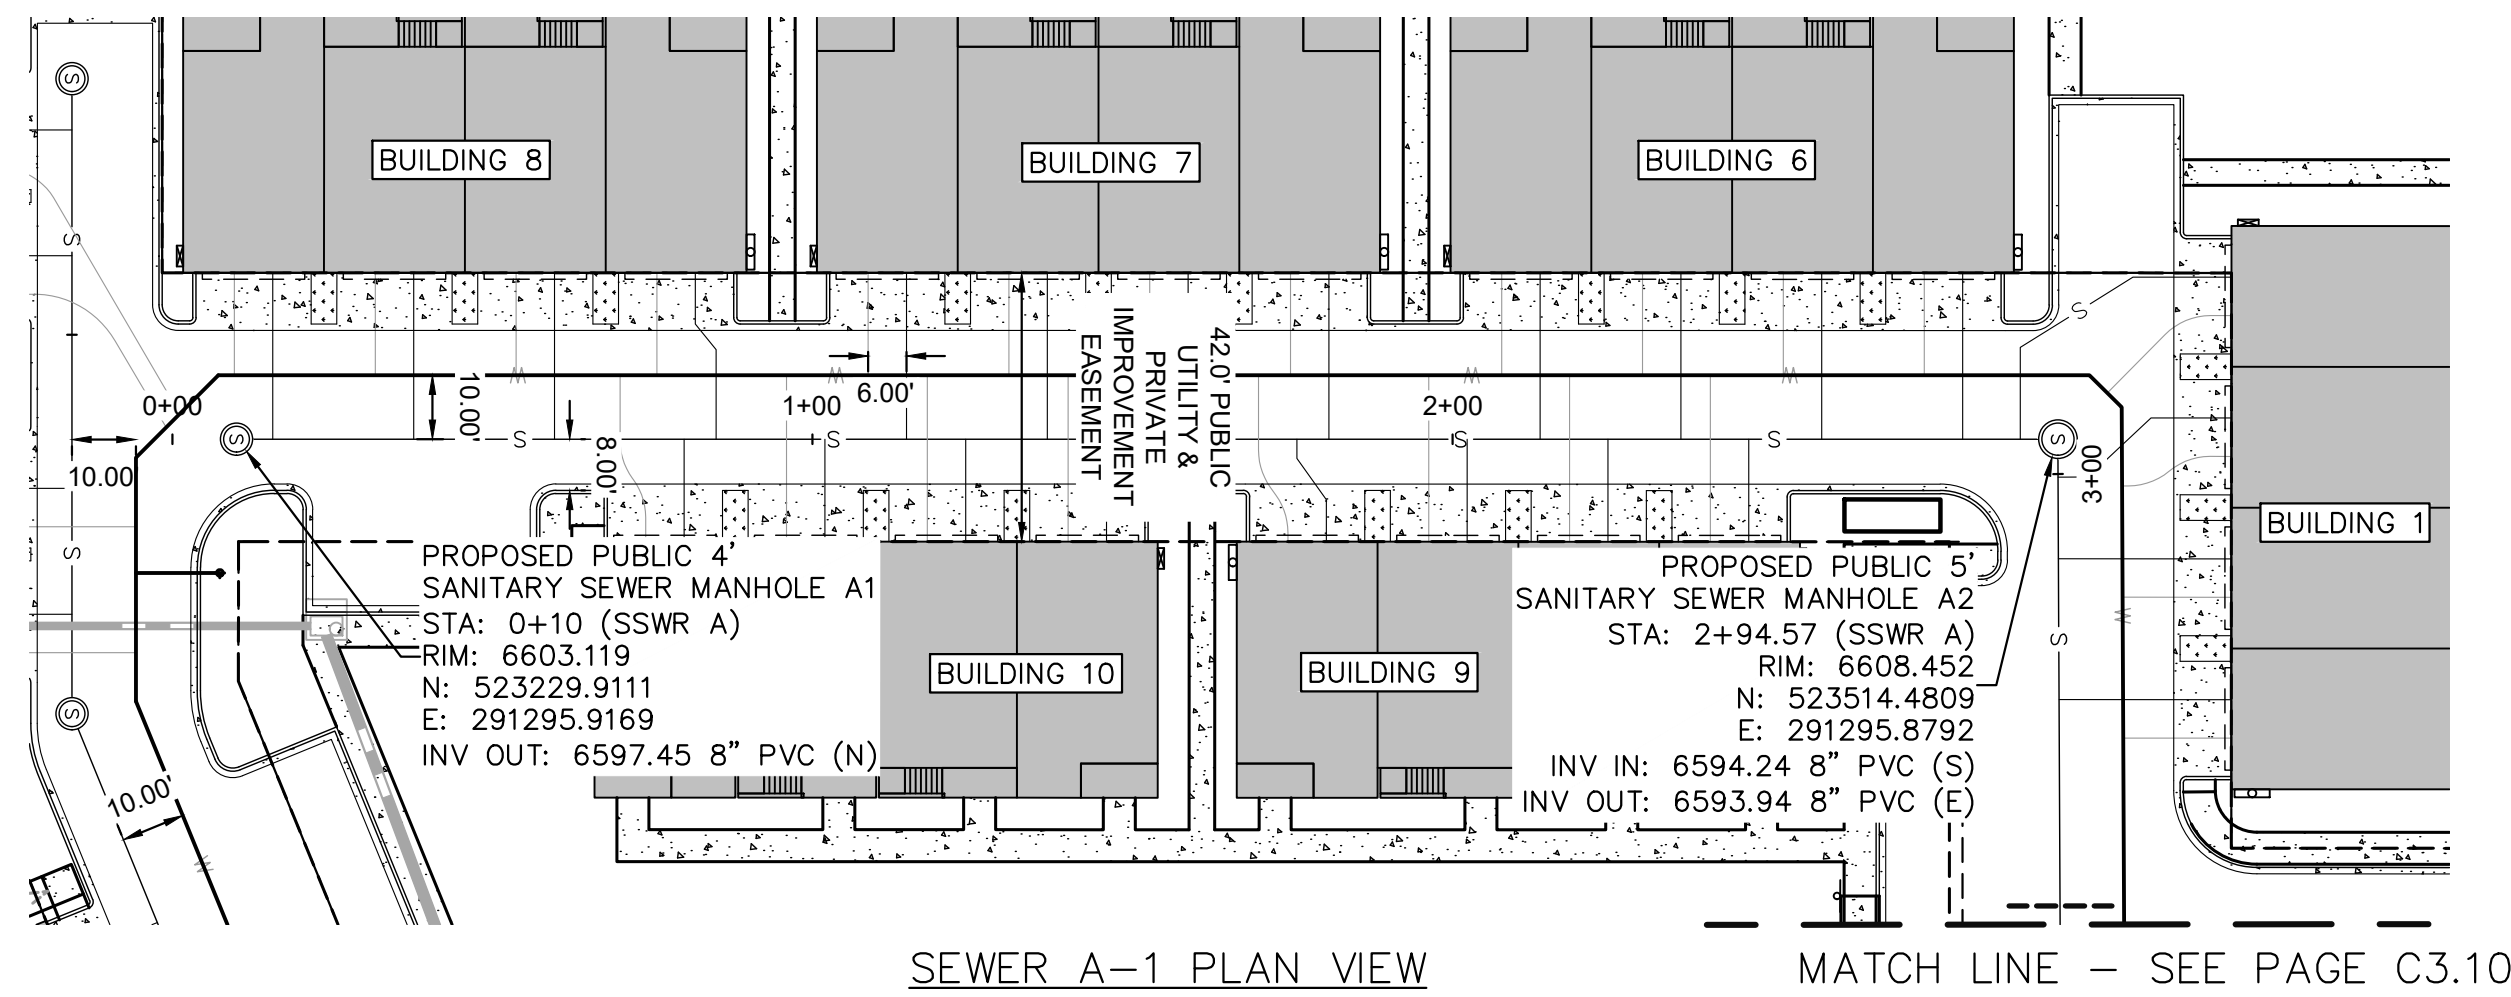

LEGEND

- PROPERTY LINE
- x-x- PROPOSED FENCE
- w- PROPOSED 6" PVC WATER MAIN
- s- PROPOSED 8" PVC SANITARY MAIN
- - - - - PROPOSED PVC STORM MAIN

NOTES

1. ALL EXISTING UTILITIES TO REMAIN UNLESS OTHERWISE NOTED.
2. UTILITIES TO BE REMOVED ARE TO BE CAPPED IN PLACE IN ACCORDANCE WITH LOCAL UTILITY REGULATIONS.
3. THE LOCATION AND/OR ELEVATION OF EXISTING UTILITIES AS SHOWN ON THESE PLANS IS BASED ON RECORDS OF THE VARIOUS UTILITY COMPANIES, AND WHERE POSSIBLE, MEASUREMENTS TAKEN IN THE FIELD. THE INFORMATION IS NOT TO BE RELIED ON AS BEING EXACT OR COMPLETE.
5. ALL PR. CURB & GUTTER IS EPC TYBE B PER EL PASO COUNTY STANDARD DETAIL SD_2-20 UNLESS OTHERWISE NOTED.
6. SEE PLANS FOR MAINLINE SIZES.
7. ALL CLEANOUTS TO BE INSTALLED PER COLORADO SPRINGS UTILITIES STANDARD DETAIL C 5-4.
8. ALL SANITARY SERVICES ARE 4" PVC WITH TAPS BY DEVELOPER UNLESS OTHERWISE NOTED ON PLANS.
9. SELECT BEDDING TO BE PER COLORADO SPRINGS UTILITIES WASTEWATER LESS SPECIFICATIONS.
10. MINIMUM SLOPES FOR WASTEWATER SERVICE LINES:
 - 10.1. 4" PVC (SDR 35) - 2.08% OR 1/4" PER FOOT
 - 10.2. 4" DUCTILE IRON PIPE/4" SCH 40 PVC - 1.04% OR 1/8" PER FOOT
 - 10.3. 6" PIPE - 1.04% OR 1/8" PER FOOT

NO.	REVISION	BY	DATE	APPR

Kimley»Horn
 2026 KIMLEY-HORN AND ASSOCIATES, INC.
 2 North Nevada Avenue, Suite 900
 Colorado Springs, Colorado 80903 (719) 453-0180

DESIGNED BY: NMB
 DRAWN BY: DPM
 CHECKED BY: NMB
 DATE: 01/13/2026



WINDERMERE FILING NO. 2
 CONSTRUCTION DOCUMENTS
 EL PASO COUNTY, COLORADO
 SSWR A-1 P&P

PRELIMINARY
 FOR REVIEW ONLY
 NOT FOR
 CONSTRUCTION
Kimley»Horn
 Kimley-Horn and Associates, Inc.

PROJECT NO.
 196160000




SHEET
 C3.9

K:\COS_LA\196160000 - Windermere\CADD\PlanSheets\CDS_CD_SSWR.dwg Evans, Wyatt 3/30/2026 8:23 AM

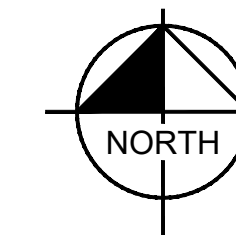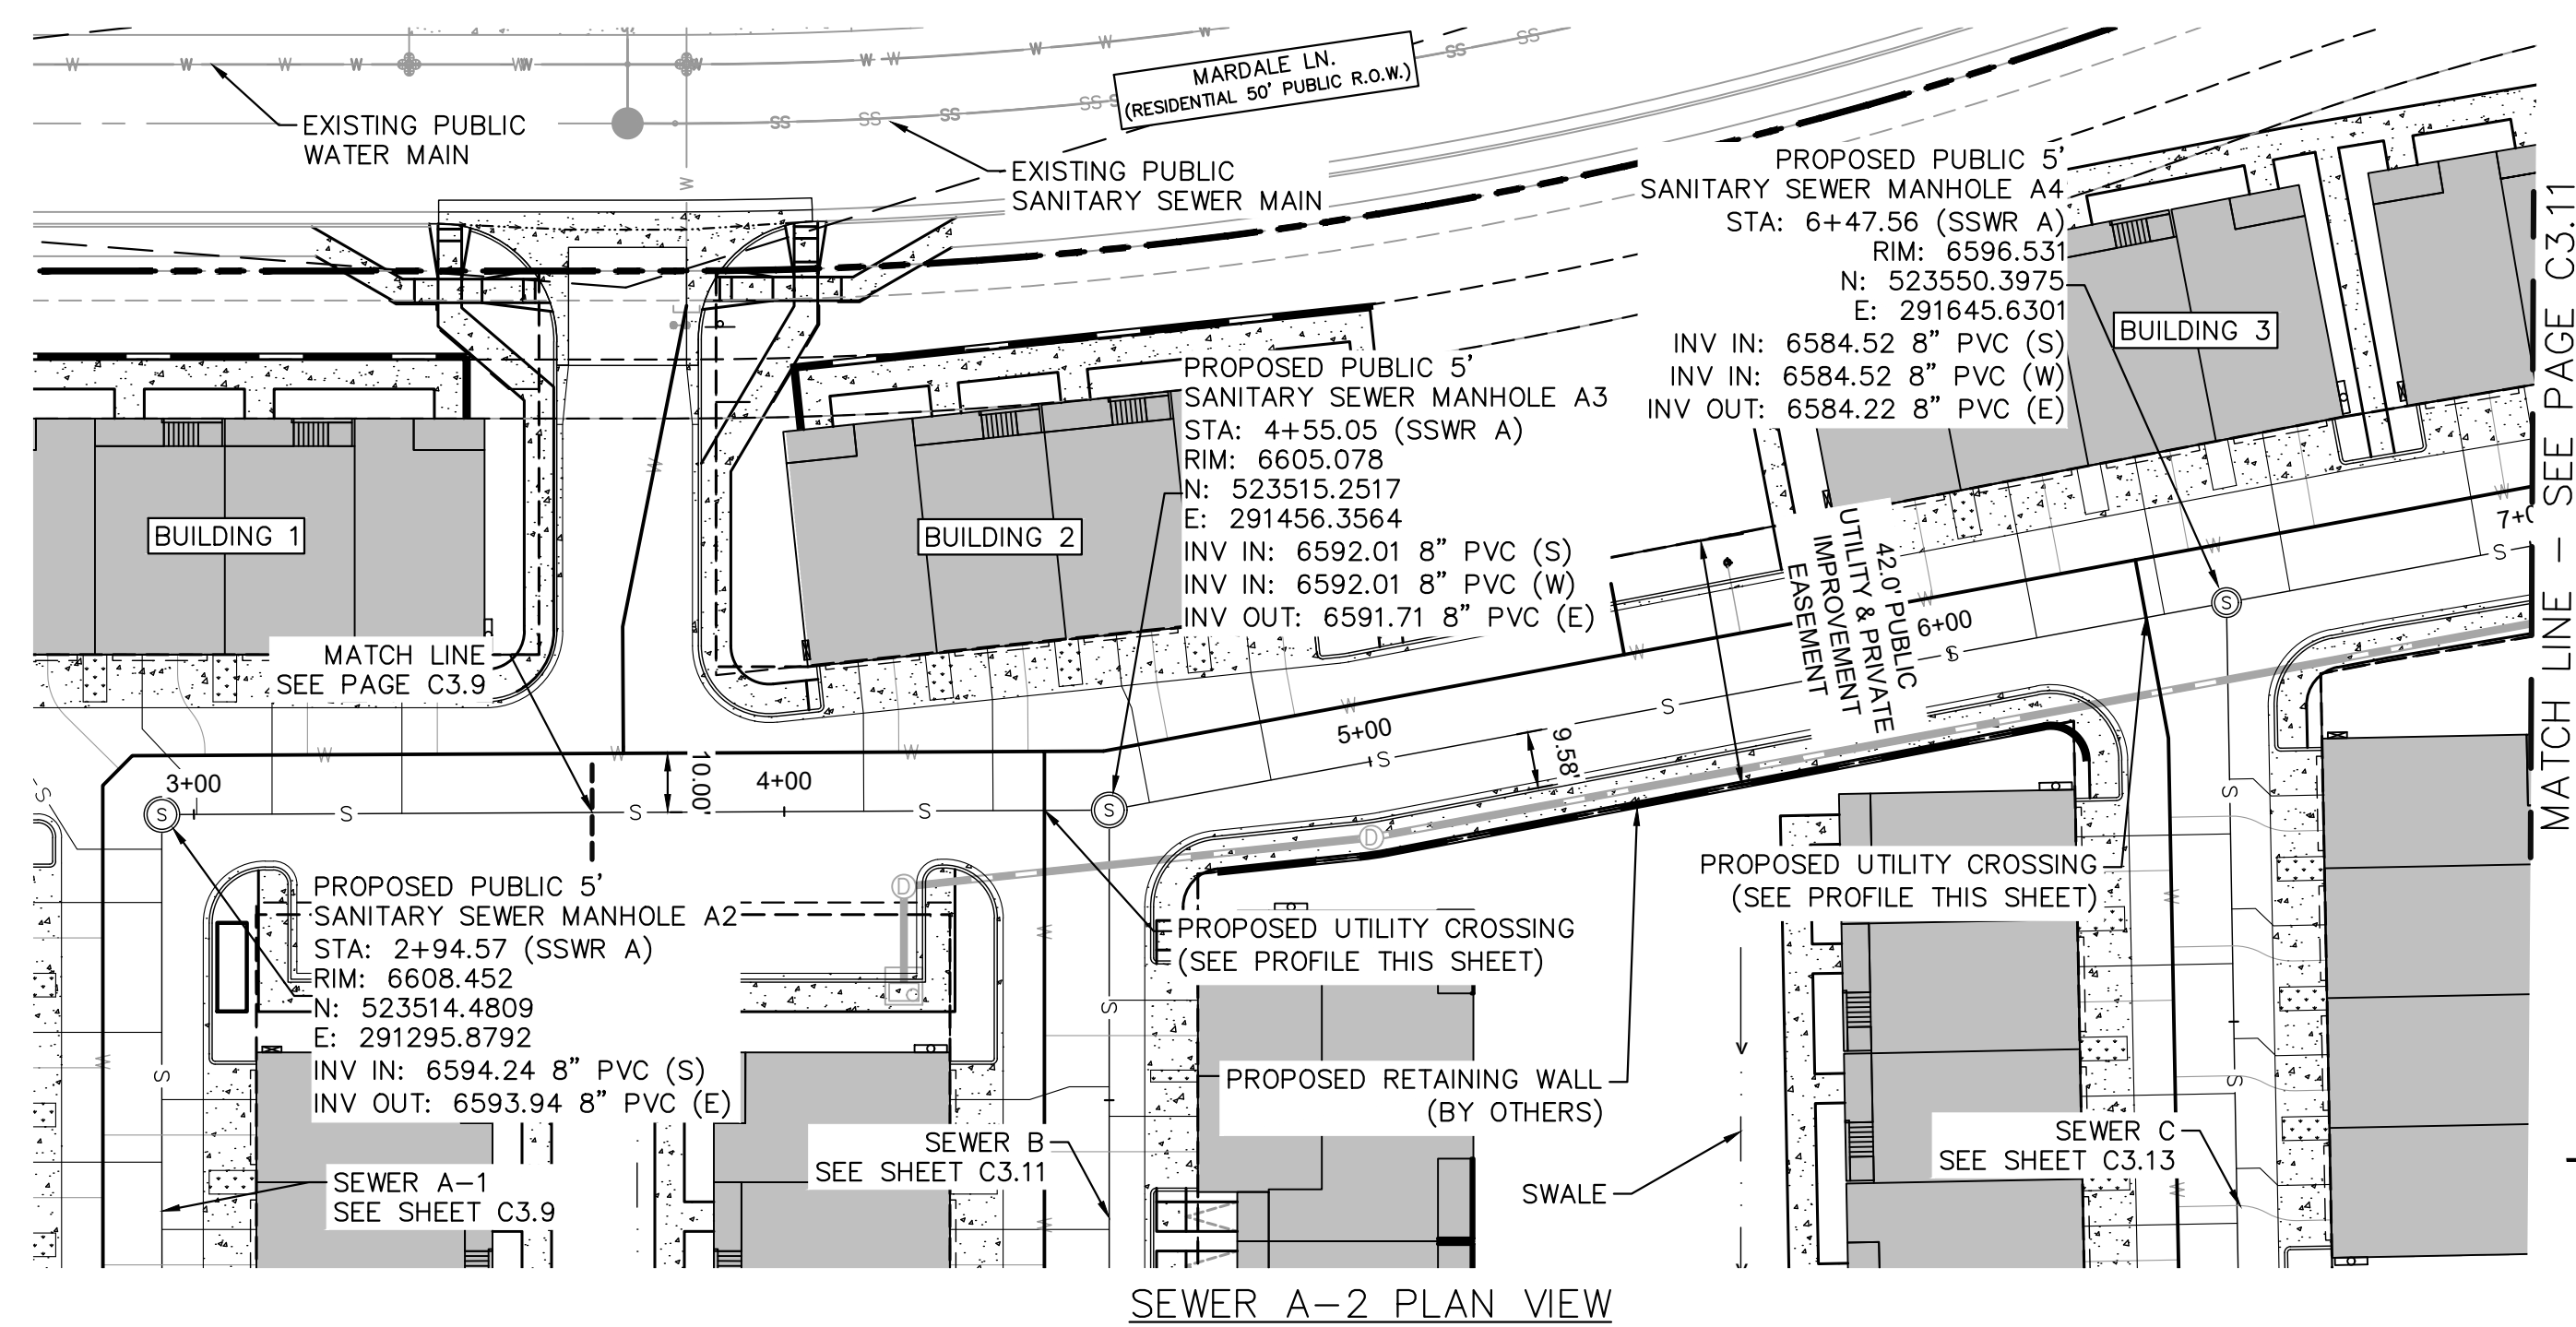

LEGEND

- PROPERTY LINE
- x-x- PROPOSED FENCE
- w- PROPOSED 6" PVC WATER MAIN
- s- PROPOSED 8" PVC SANITARY MAIN
- PROPOSED PVC STORM MAIN

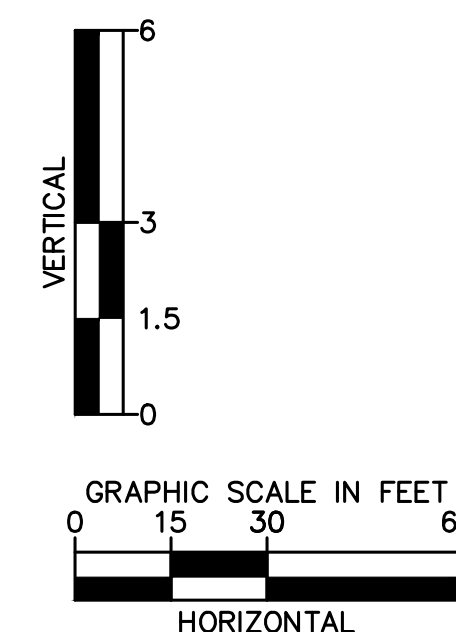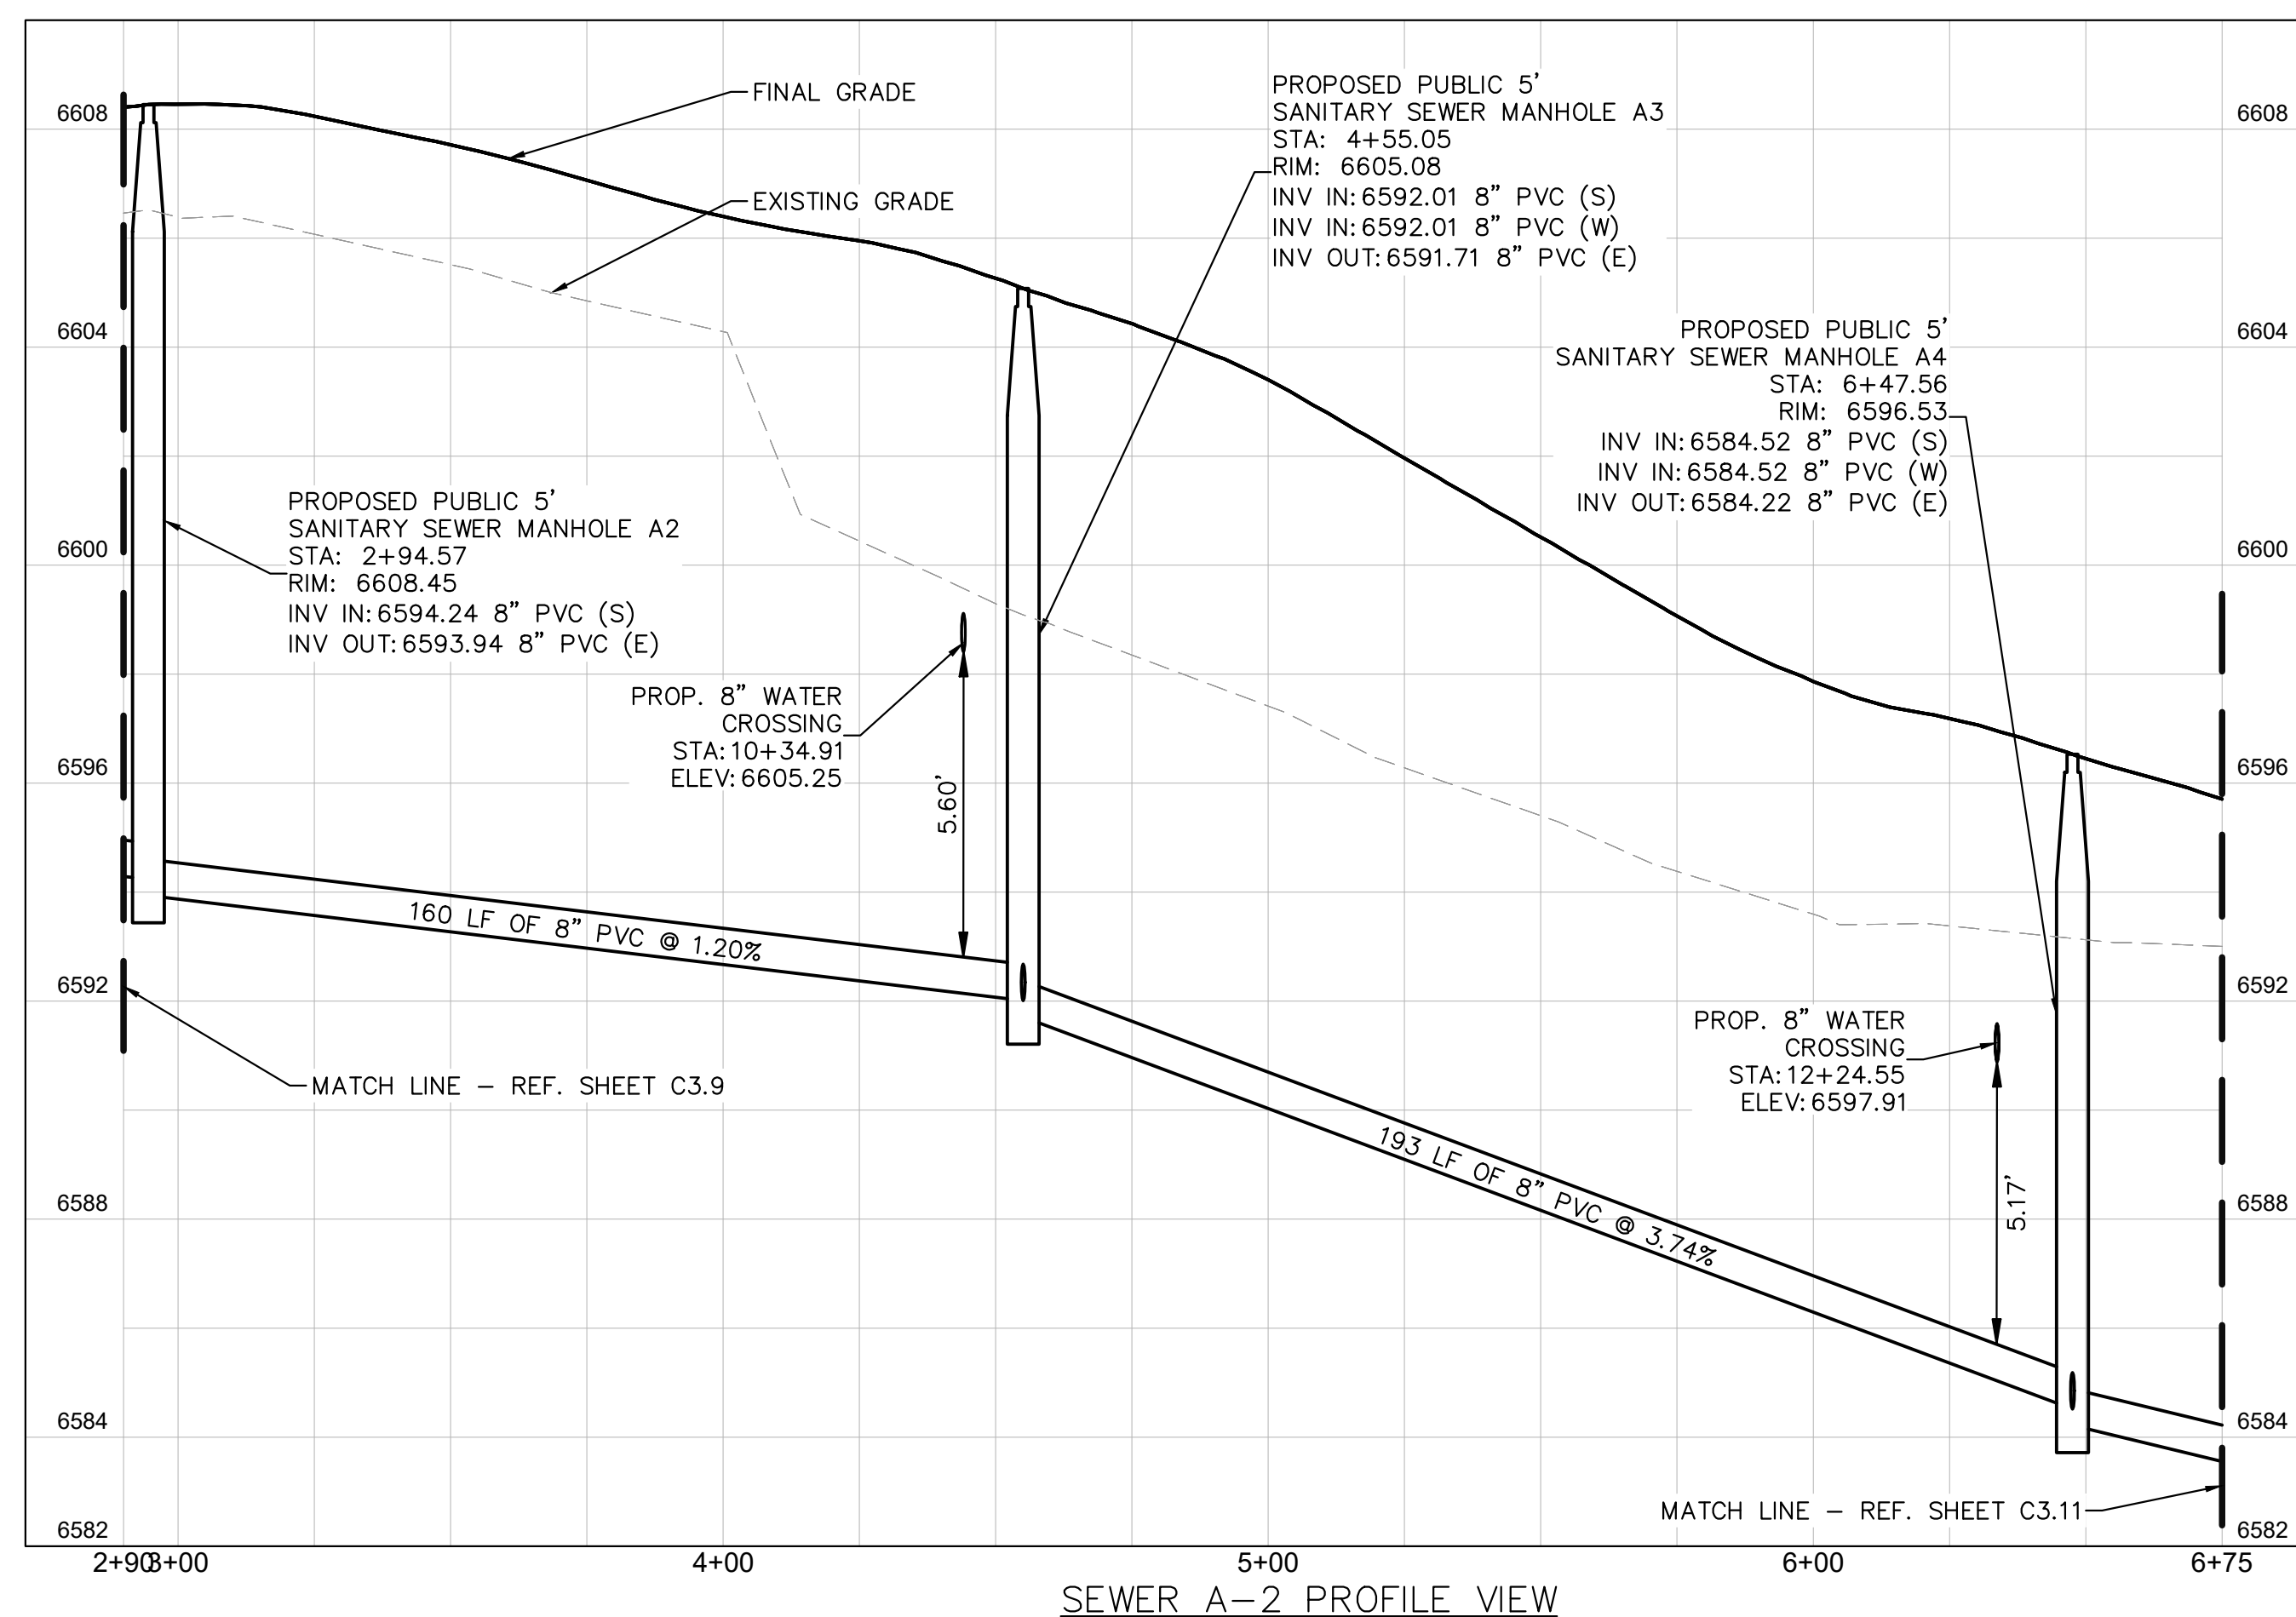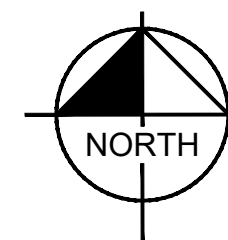

NOTES

1. ALL EXISTING UTILITIES TO REMAIN UNLESS OTHERWISE NOTED.
2. UTILITIES TO BE REMOVED ARE TO BE CAPPED IN PLACE IN ACCORDANCE WITH LOCAL UTILITY REGULATIONS.
3. THE LOCATION AND/OR ELEVATION OF EXISTING UTILITIES AS SHOWN ON THESE PLANS IS BASED ON RECORDS OF THE VARIOUS UTILITY COMPANIES, AND WHERE POSSIBLE, MEASUREMENTS TAKEN IN THE FIELD. THE INFORMATION IS NOT TO BE RELIED ON AS BEING EXACT OR COMPLETE.
4. ALL PR. CURB & GUTTER IS EPC TYBE B PER EL PASO COUNTY STANDARD DETAIL SD_2-20 UNLESS OTHERWISE NOTED.
5. SEE PLANS FOR MAINLINE SIZES.
6. ALL CLEANOUTS TO BE INSTALLED PER COLORADO SPRINGS UTILITIES STANDARD DETAIL C 5-4.
7. ALL SANITARY SERVICES ARE 4" PVC WITH TAPS BY DEVELOPER UNLESS OTHERWISE NOTED ON PLANS.
8. SELECT BEDDING TO BE PER COLORADO SPRINGS UTILITIES WASTEWATER LESS SPECIFICATIONS.
9. MINIMUM SLOPES FOR WASTEWATER SERVICE LINES:
 - 10.1. 4" PVC (SDR 35) - 2.08% OR 1/4" PER FOOT
 - 10.2. 4" DUCTILE IRON PIPE/4" SCH 40 PVC - 1.04% OR 1/8" PER FOOT
 - 10.3. 6" PIPE - 1.04% OR 1/8" PER FOOT

NO.	REVISION	BY	DATE	APPR

Kimley»Horn
 2026 KIMLEY-HORN AND ASSOCIATES, INC.
 2 North Nevada Avenue, Suite 900
 Colorado Springs, Colorado 80903 (719) 453-0180



DESIGNED BY: NMB
 DRAWN BY: DPM
 CHECKED BY: NMB
 DATE: 01/13/2026

WINDERMERE FILING NO. 2
 CONSTRUCTION DOCUMENTS
 EL PASO COUNTY, COLORADO
 SSWR A-2 P&P

PRELIMINARY
 FOR REVIEW ONLY
 NOT FOR CONSTRUCTION
Kimley»Horn
 Kimley-Horn and Associates, Inc.

PROJECT NO.
 196160000
 SHEET
 C3.10

K:\COS_LA\196160000 - Windermere\CADD\PlanSheets\CDS_CD_SSWR.dwg Evans, Wyatt 3/30/2026 8:23 AM

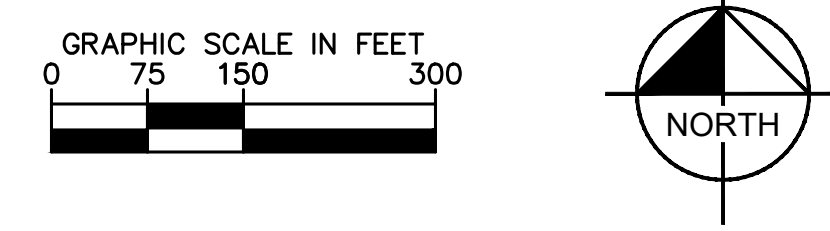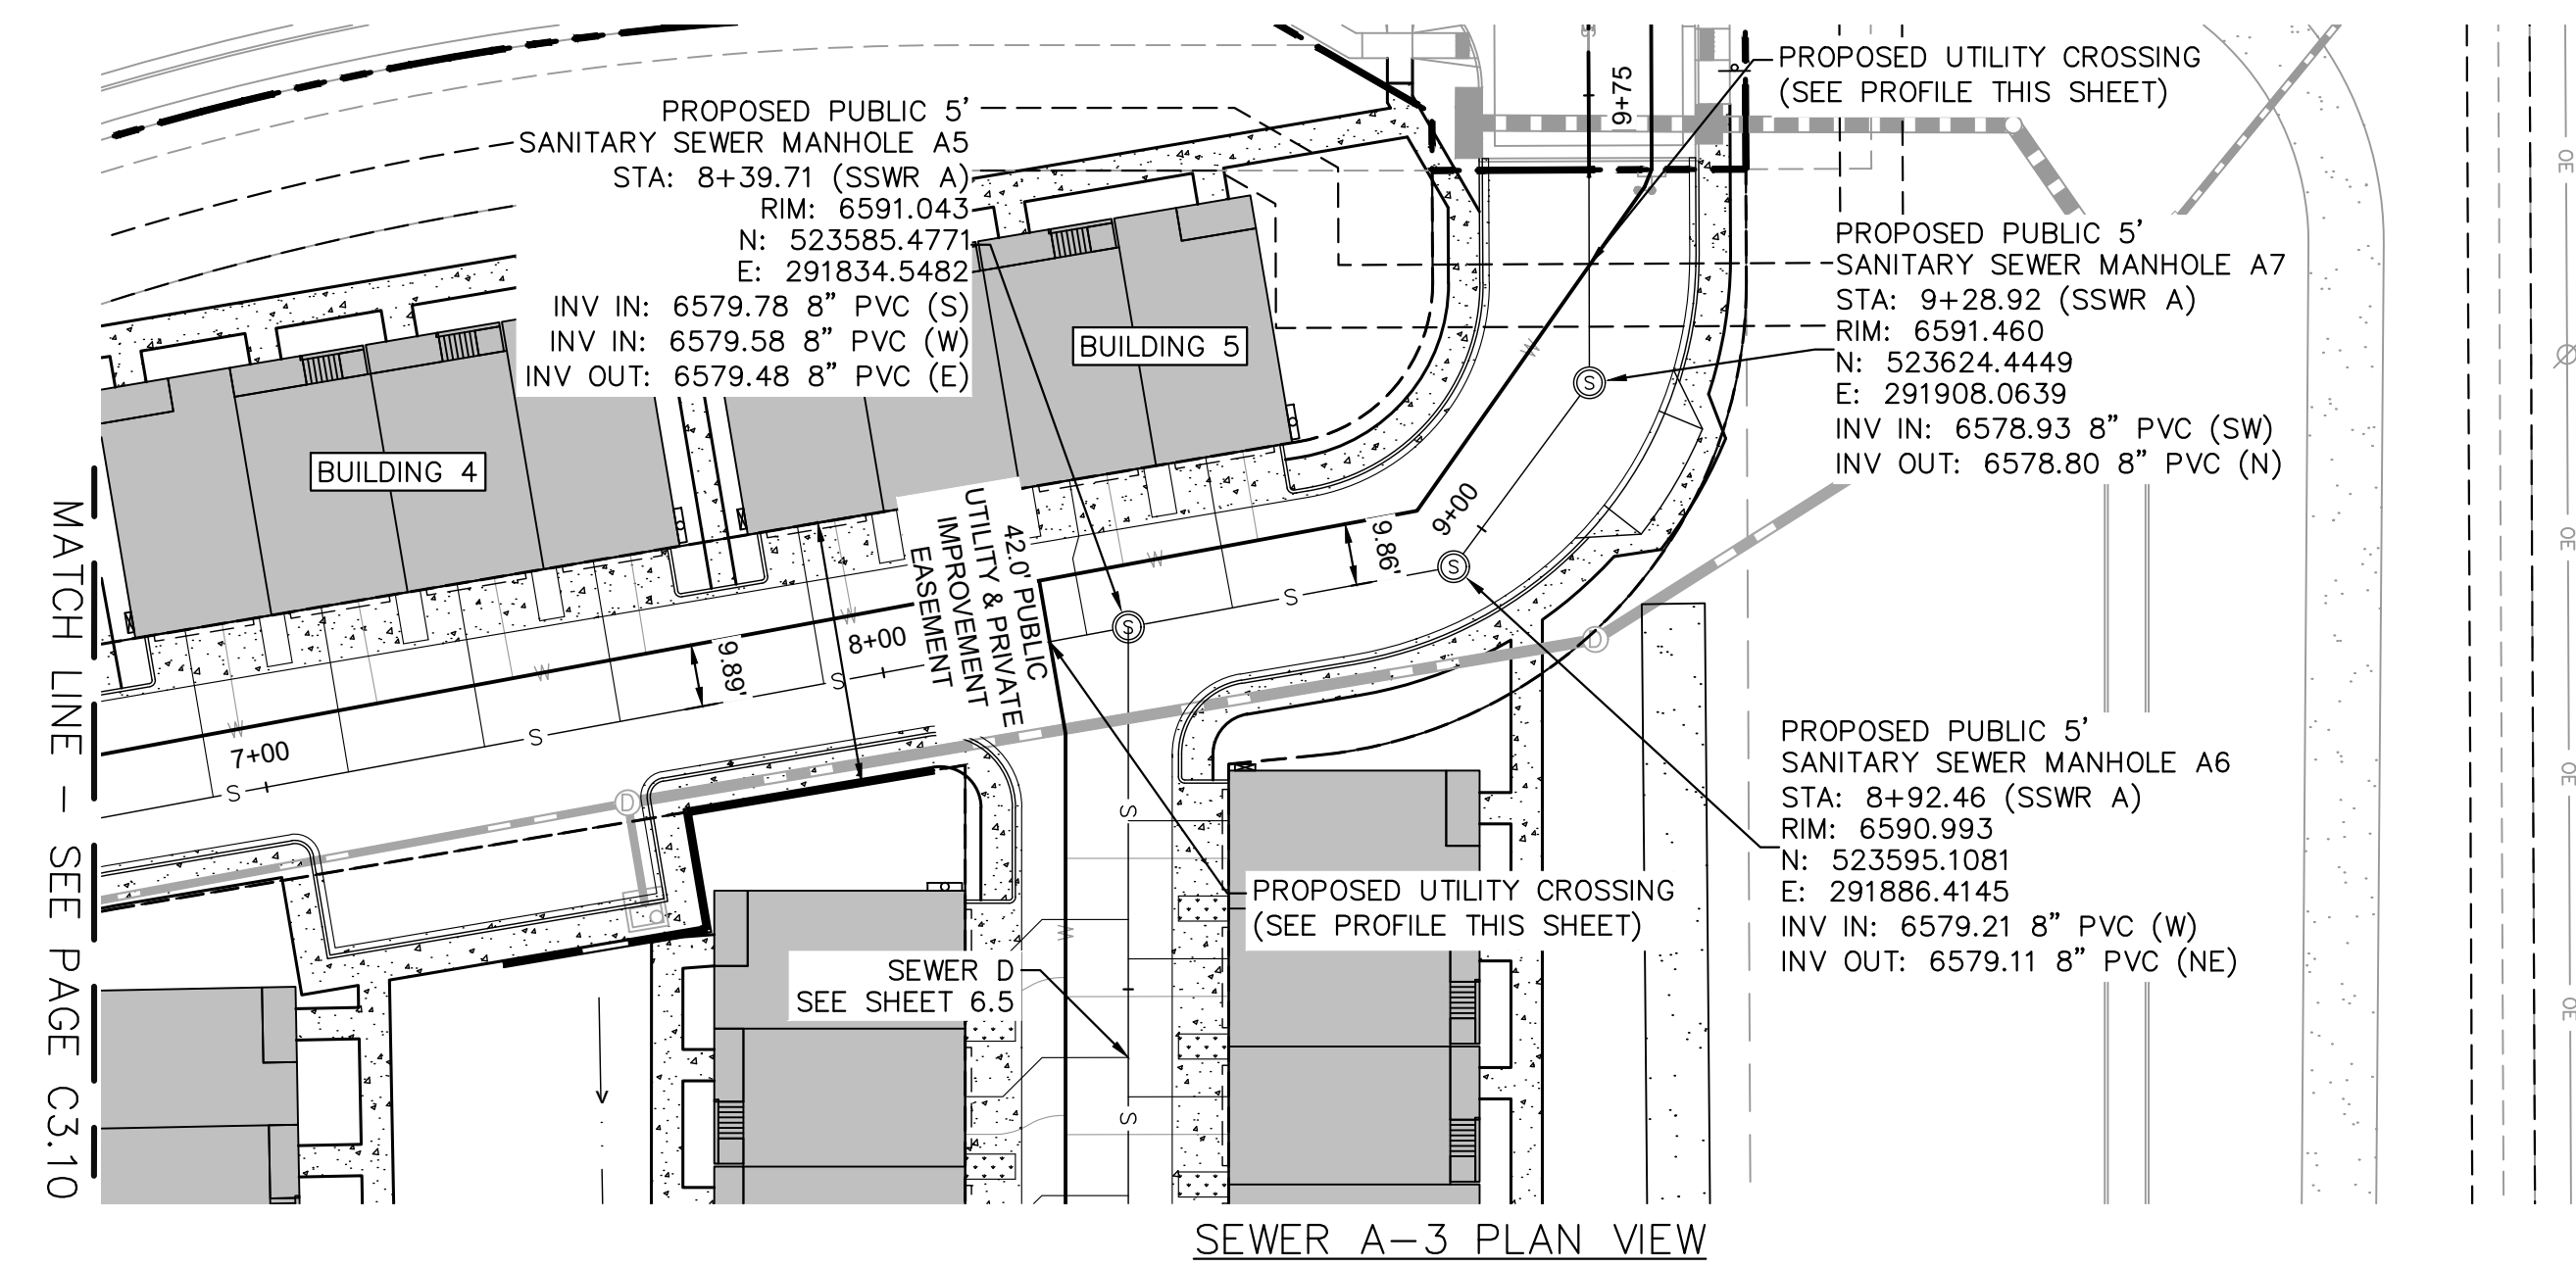


LEGEND

- PROPERTY LINE
- x-x- PROPOSED FENCE
- w- PROPOSED 6" PVC WATER MAIN
- s- PROPOSED 8" PVC SANITARY MAIN
- PROPOSED PVC STORM MAIN

NOTES

1. ALL EXISTING UTILITIES TO REMAIN UNLESS OTHERWISE NOTED.
2. UTILITIES TO BE REMOVED ARE TO BE CAPPED IN PLACE IN ACCORDANCE WITH LOCAL UTILITY REGULATIONS.
3. THE LOCATION AND/OR ELEVATION OF EXISTING UTILITIES AS SHOWN ON THESE PLANS IS BASED ON RECORDS OF THE VARIOUS UTILITY COMPANIES, AND WHERE POSSIBLE, MEASUREMENTS TAKEN IN THE FIELD. THE INFORMATION IS NOT TO BE RELIED ON AS BEING EXACT OR COMPLETE.
5. ALL PR. CURB & GUTTER IS EPC TYBE B PER EL PASO COUNTY STANDARD DETAIL SD_2-20 UNLESS OTHERWISE NOTED.
6. SEE PLANS FOR MAINLINE SIZES.
7. ALL CLEANOUTS TO BE INSTALLED PER COLORADO SPRINGS UTILITIES STANDARD DETAIL C 5-4.
8. ALL SANITARY SERVICES ARE 4" PVC WITH TAPS BY DEVELOPER UNLESS OTHERWISE NOTED ON PLANS.
9. SELECT BEDDING TO BE PER COLORADO SPRINGS UTILITIES WASTEWATER_LESS SPECIFICATIONS.
10. MINIMUM SLOPES FOR WASTEWATER SERVICE LINES:
 - 10.1. 4" PVC (SDR 35) - 2.08% OR 1/4" PER FOOT
 - 10.2. 4" DUCTILE IRON PIPE/4" SCH 40 PVC - 1.04% OR 1/8" PER FOOT
 - 10.3. 6" PIPE - 1.04% OR 1/8" PER FOOT

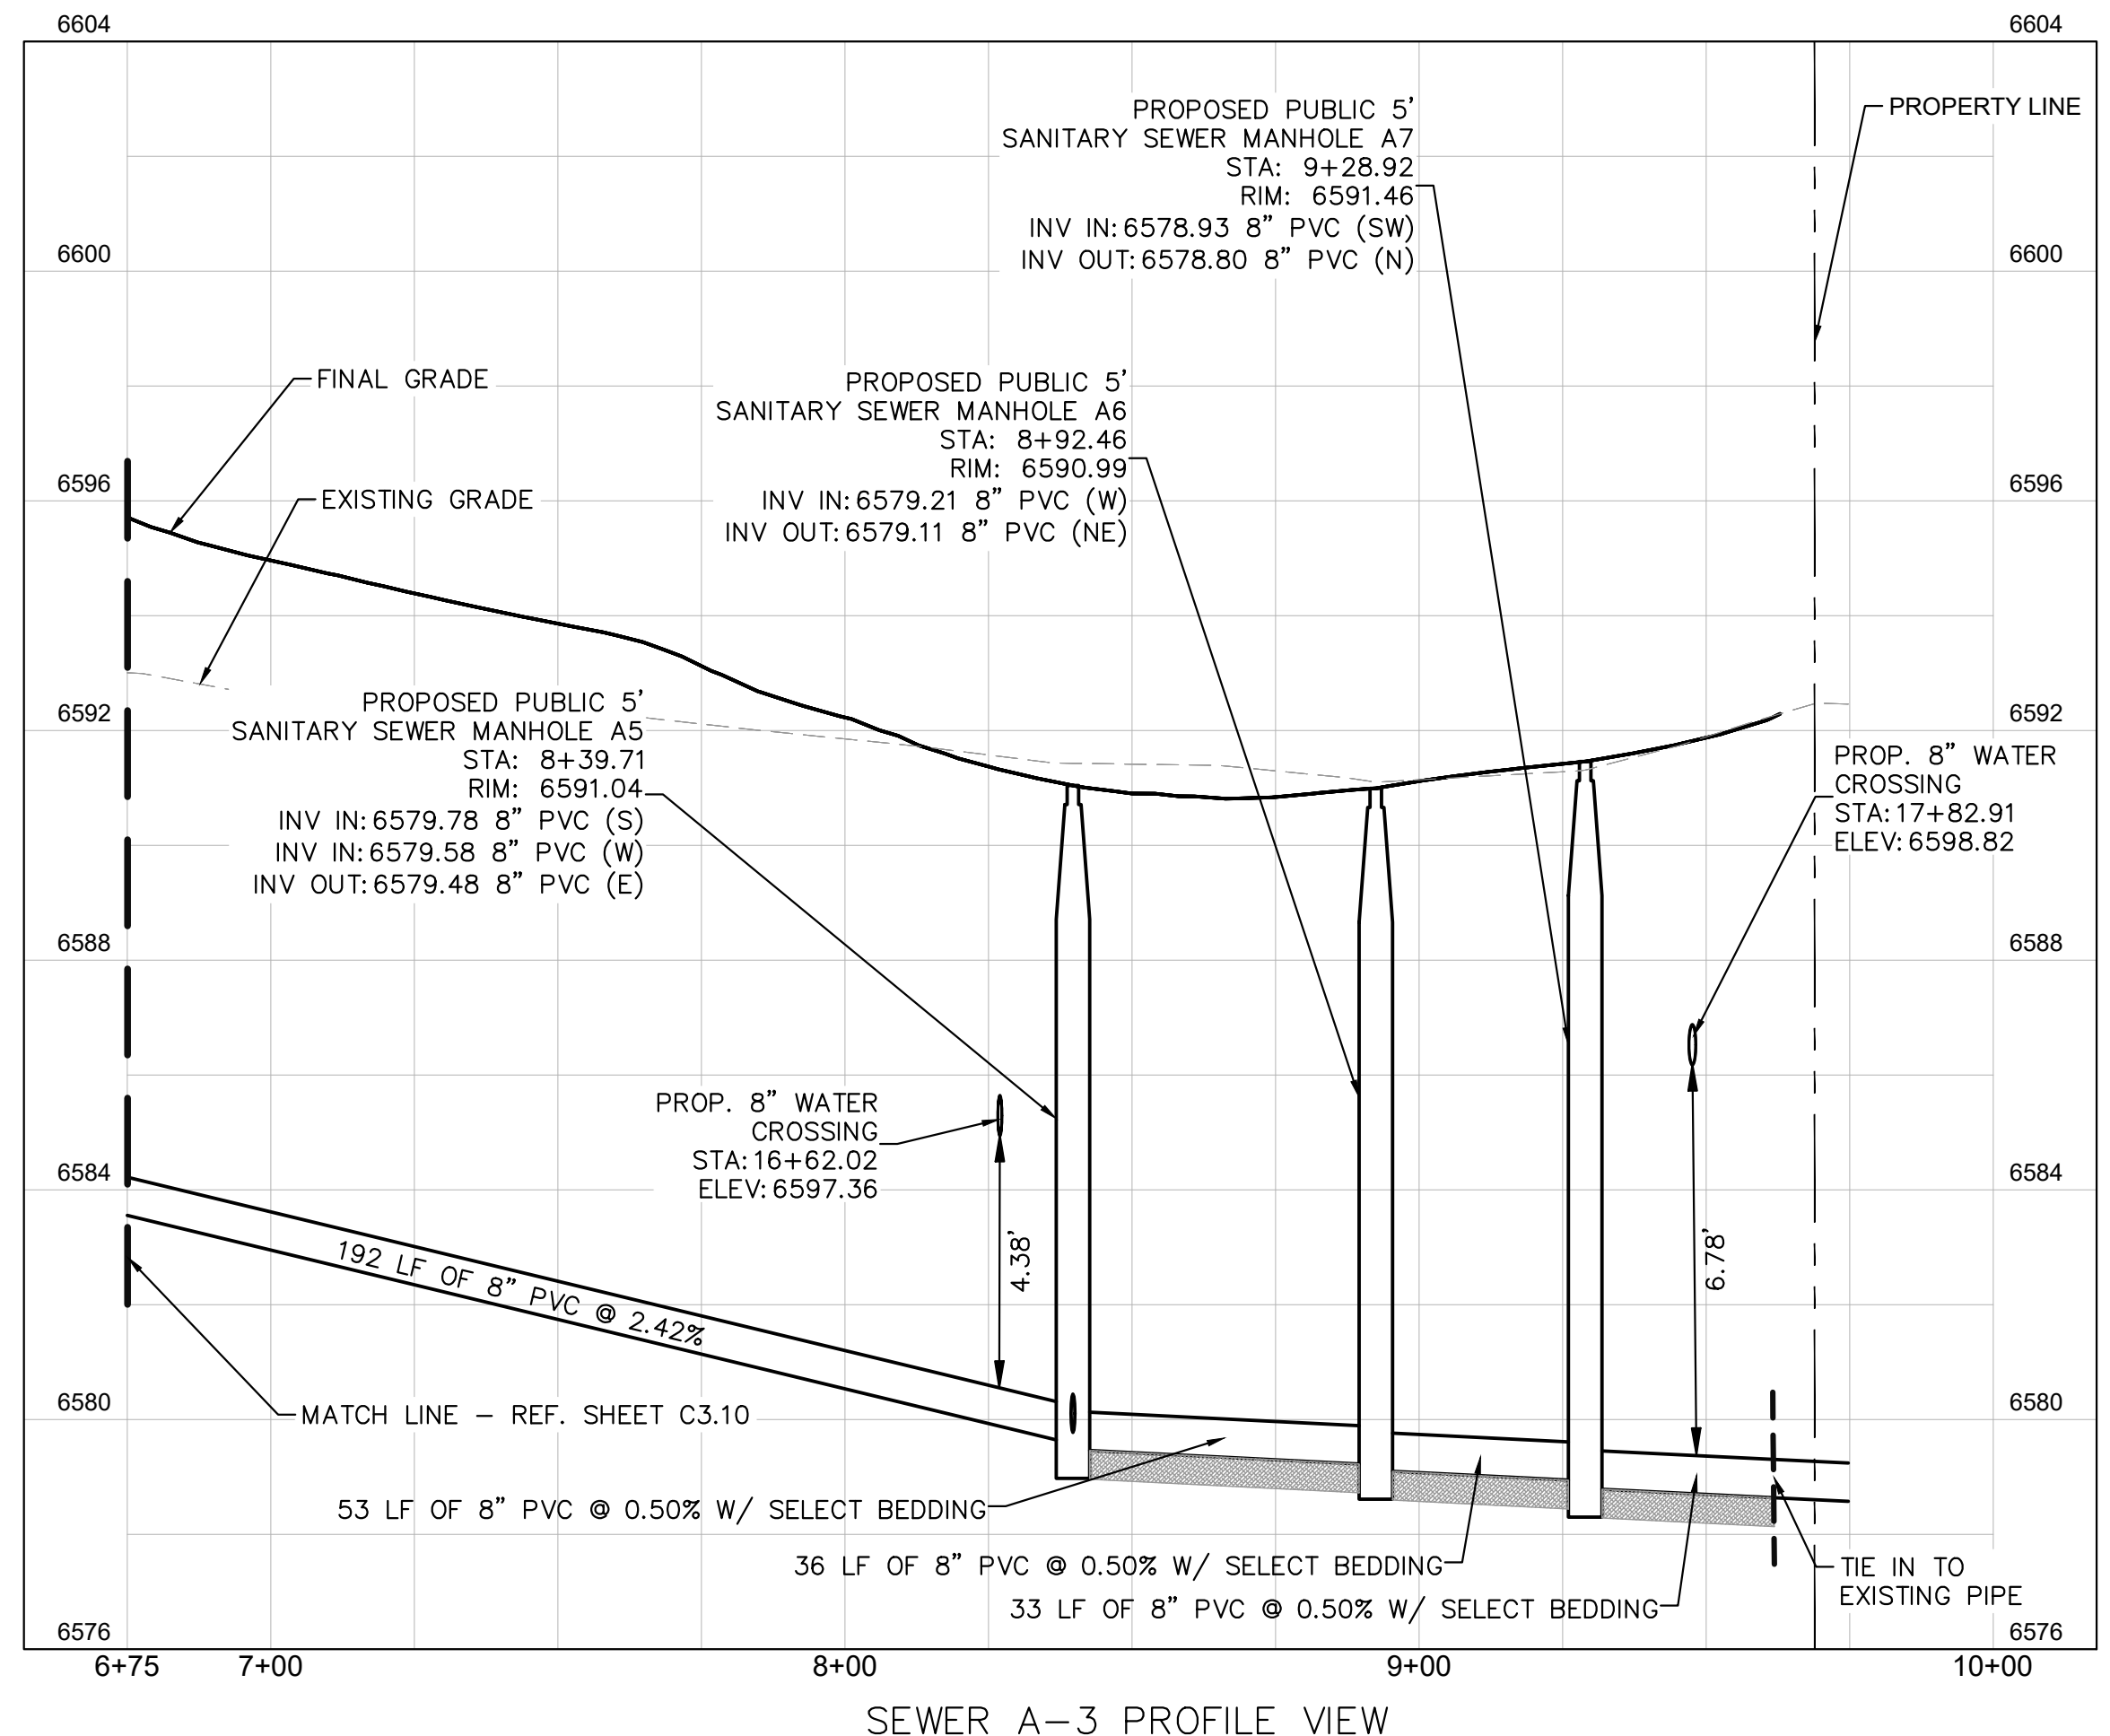

NO.	REVISION	BY	DATE	APPR

Kimley»Horn
 2026 KIMLEY-HORN AND ASSOCIATES, INC.
 2 North Nevada Avenue, Suite 900
 Colorado Springs, Colorado 80903 (719) 453-0180



DESIGNED BY: NMB
 DRAWN BY: DPM
 CHECKED BY: NMB
 DATE: 01/13/2026

WINDERMERE FILING NO. 2
 CONSTRUCTION DOCUMENTS
 EL PASO COUNTY, COLORADO
 SSWR A-3 P&P

PRELIMINARY
 FOR REVIEW ONLY
 NOT FOR CONSTRUCTION
Kimley»Horn
 Kimley-Horn and Associates, Inc.

PROJECT NO.
 196160000
 SHEET
 C3.11

K:\COS_LA\196160000 - Windermere\CADD\PlanSheets\CDS_CD_SSWR.dwg Evans, Wyatt 3/30/2026 8:23 AM

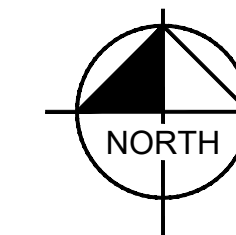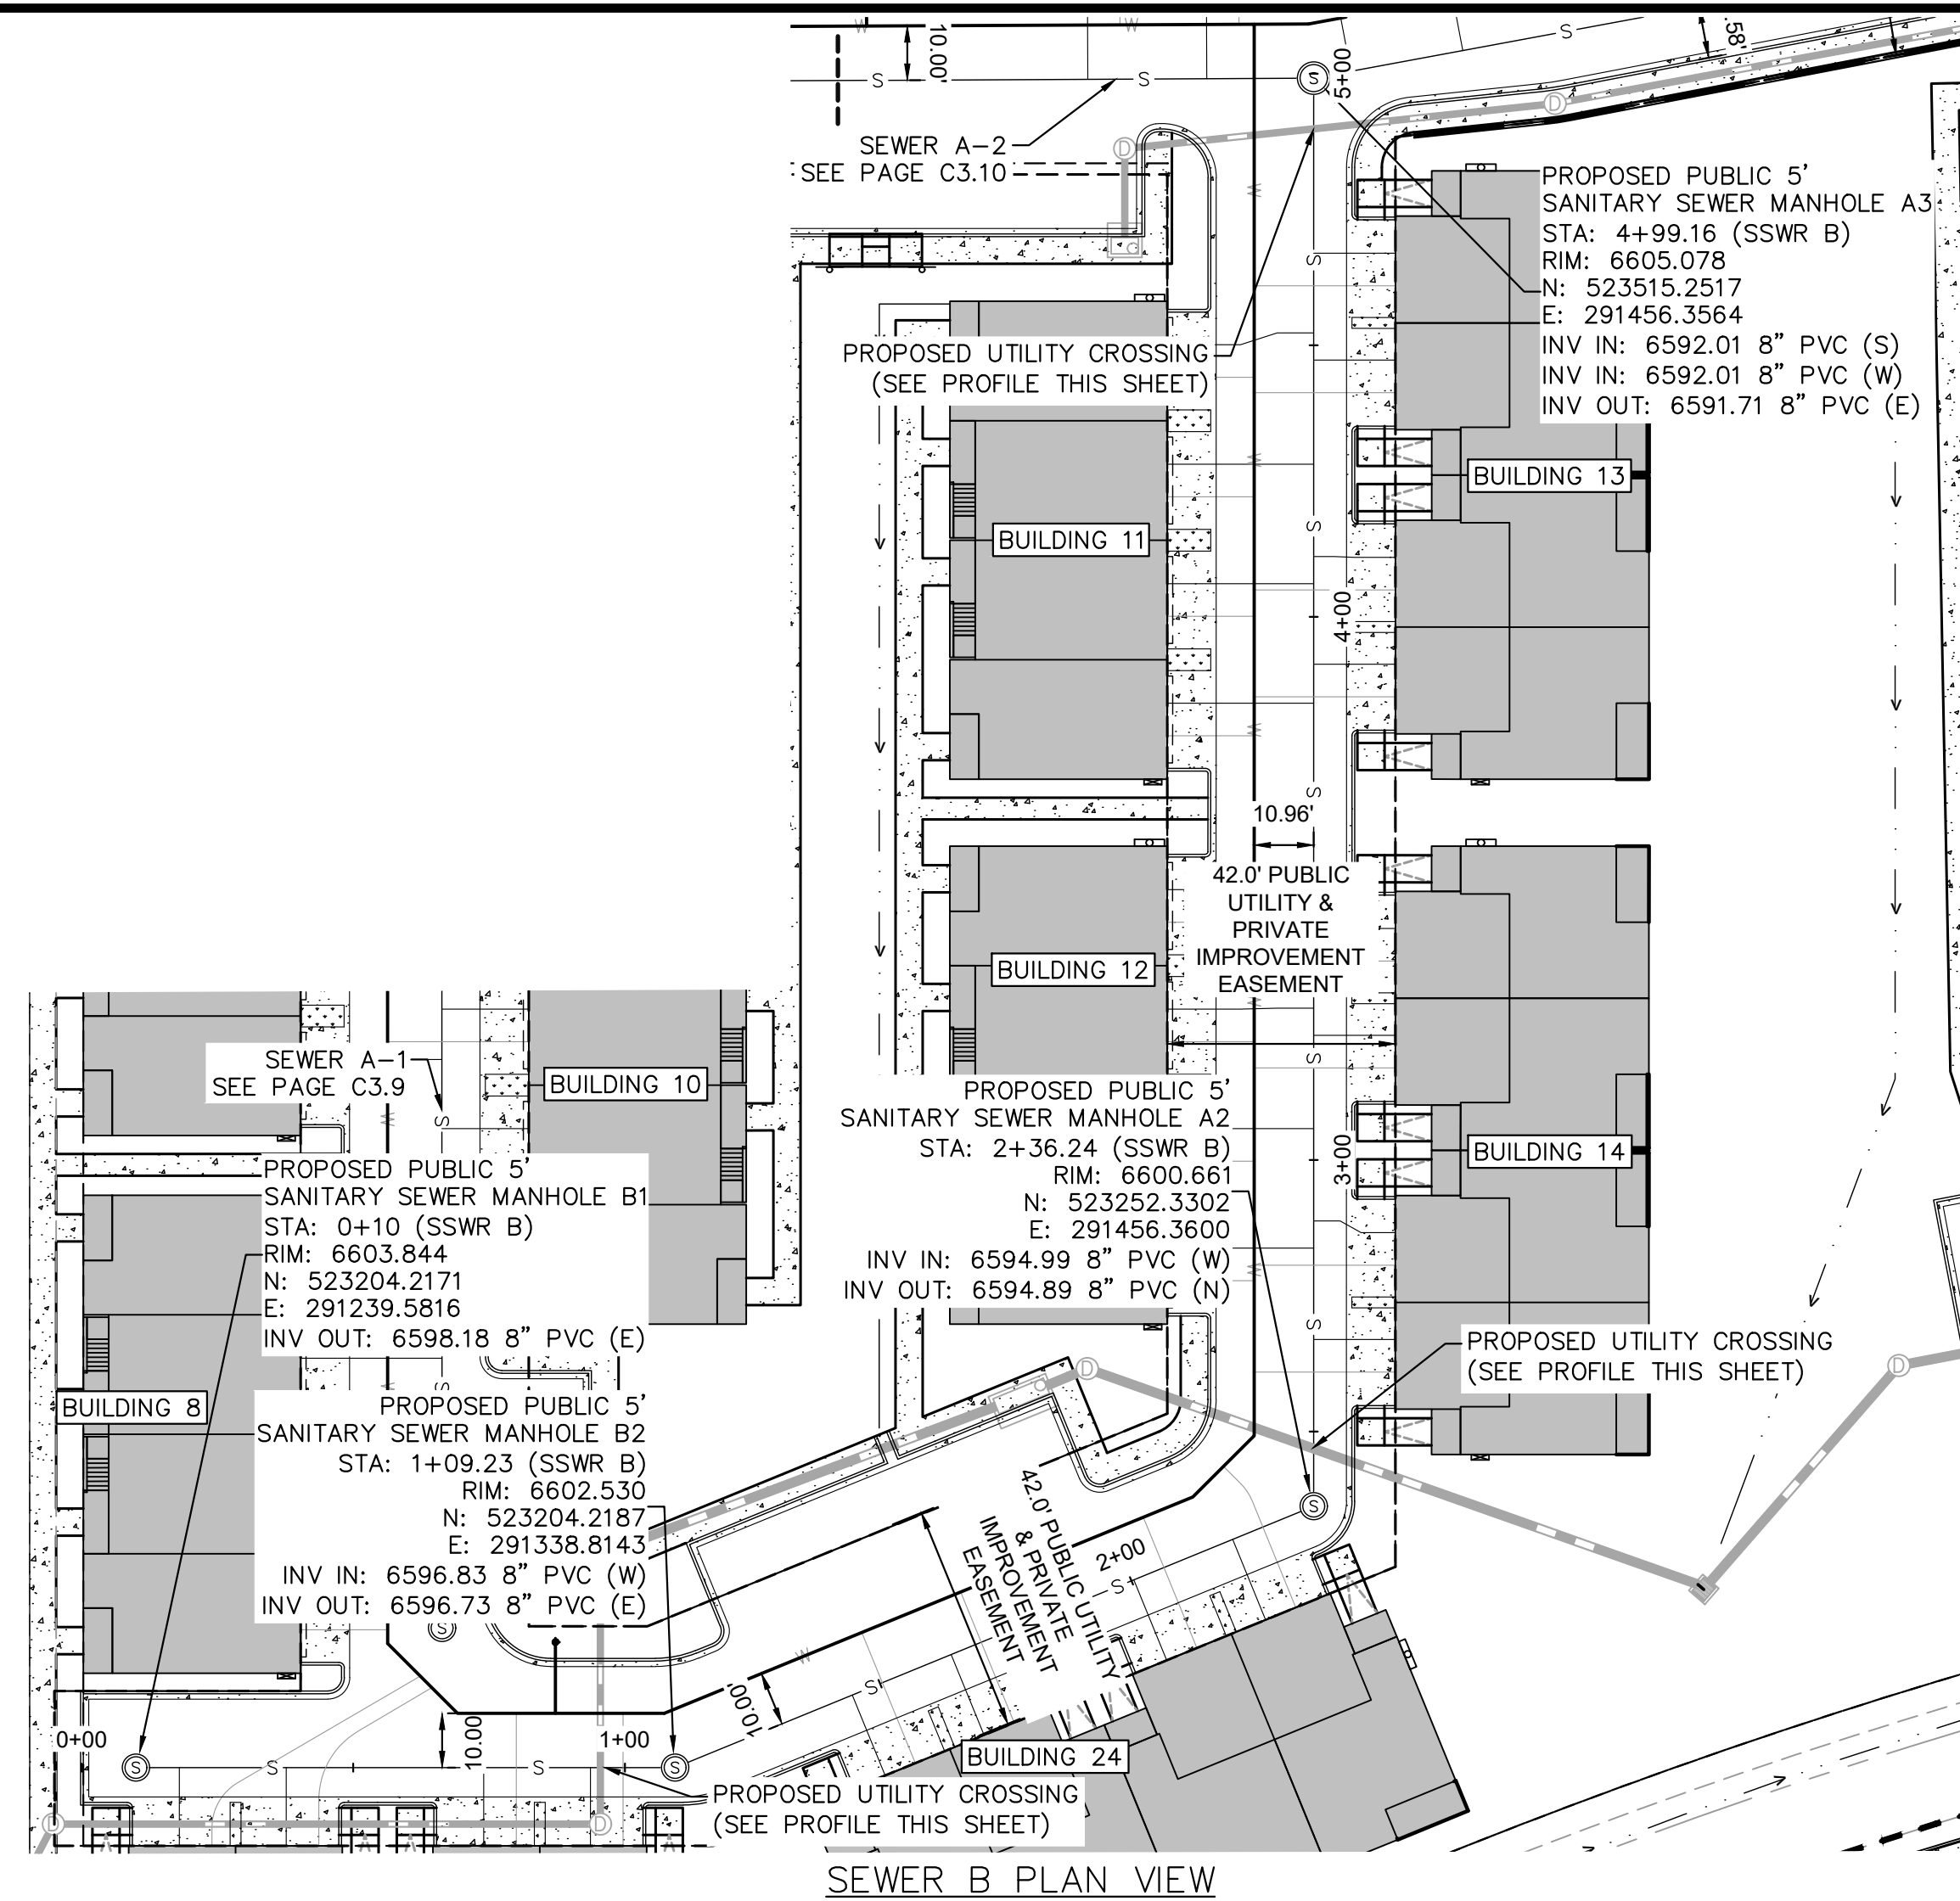


LEGEND

- PROPERTY LINE
- x-x- PROPOSED FENCE
- w- PROPOSED 6" PVC WATER MAIN
- s- PROPOSED 8" PVC SANITARY MAIN
- PROPOSED PVC STORM MAIN

NOTES

1. ALL EXISTING UTILITIES TO REMAIN UNLESS OTHERWISE NOTED.
2. UTILITIES TO BE REMOVED ARE TO BE CAPPED IN PLACE IN ACCORDANCE WITH LOCAL UTILITY REGULATIONS.
3. THE LOCATION AND/OR ELEVATION OF EXISTING UTILITIES AS SHOWN ON THESE PLANS IS BASED ON RECORDS OF THE VARIOUS UTILITY COMPANIES, AND WHERE POSSIBLE, MEASUREMENTS TAKEN IN THE FIELD. THE INFORMATION IS NOT TO BE RELIED ON AS BEING EXACT OR COMPLETE.
5. ALL PR. CURB & GUTTER IS EPC TYBE B PER EL PASO COUNTY STANDARD DETAIL SD_2-20 UNLESS OTHERWISE NOTED.
6. SEE PLANS FOR MAINLINE SIZES.
7. ALL CLEANOUTS TO BE INSTALLED PER COLORADO SPRINGS UTILITIES STANDARD DETAIL C 5-4.
8. ALL SANITARY SERVICES ARE 4" PVC WITH TAPS BY DEVELOPER UNLESS OTHERWISE NOTED ON PLANS.
9. SELECT BEDDING TO BE PER COLORADO SPRINGS UTILITIES WASTEWATER LESS SPECIFICATIONS.
10. MINIMUM SLOPES FOR WASTEWATER SERVICE LINES:
 - 10.1. 4" PVC (SDR 35) - 2.08% OR 1/4" PER FOOT
 - 10.2. 4" DUCTILE IRON PIPE/4" SCH 40 PVC - 1.04% OR 1/8" PER FOOT
 - 10.3. 6" PIPE - 1.04% OR 1/8" PER FOOT

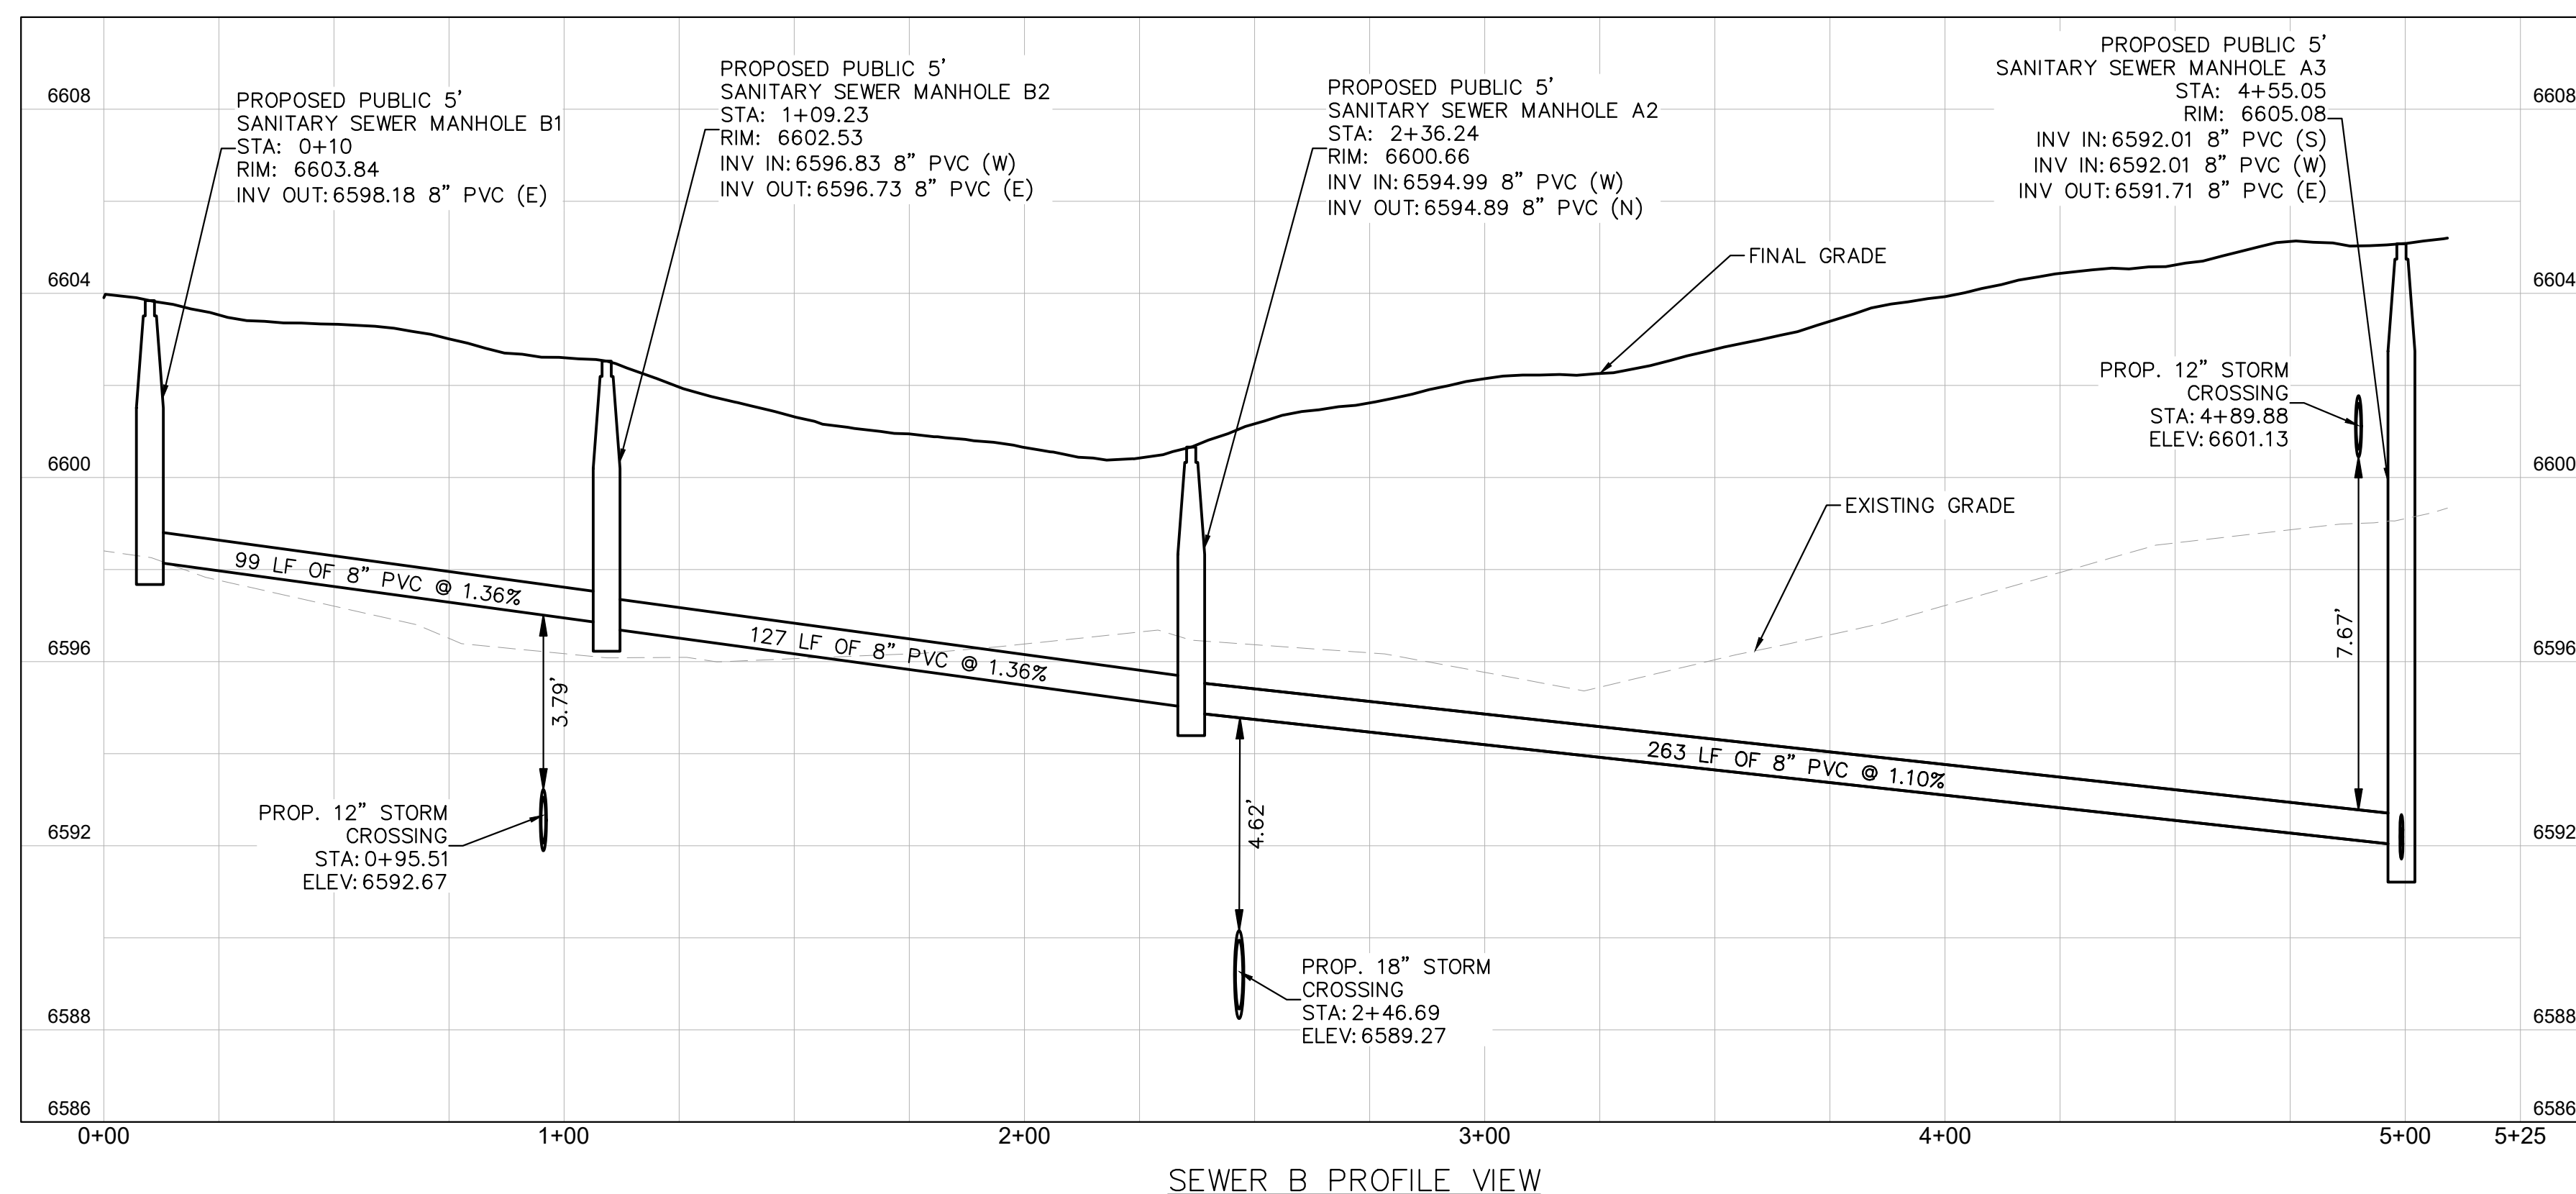

NO.	REVISION	BY	DATE	APPR

Kimley»Horn
2026 KIMLEY-HORN AND ASSOCIATES, INC.
2 North Nevada Avenue, Suite 900
Colorado Springs, Colorado 80903 (719) 453-0180


DESIGNED BY: NMB
DRAWN BY: DPM
CHECKED BY: NMB
DATE: 01/13/2026

WINDERMERE FILING NO. 2
CONSTRUCTION DOCUMENTS
EL PASO COUNTY, COLORADO
SSWR B P&P


PRELIMINARY
FOR REVIEW ONLY
NOT FOR CONSTRUCTION
Kimley»Horn
Kimley-Horn and Associates, Inc.

PROJECT NO.
196160000
SHEET
C3.12




K:\COS_LA\196160000 - Windermere\CADD\PlanSheets\CDs\CD_SSWR.dwg Evans, Wyatt 3/30/2026 8:24 AM

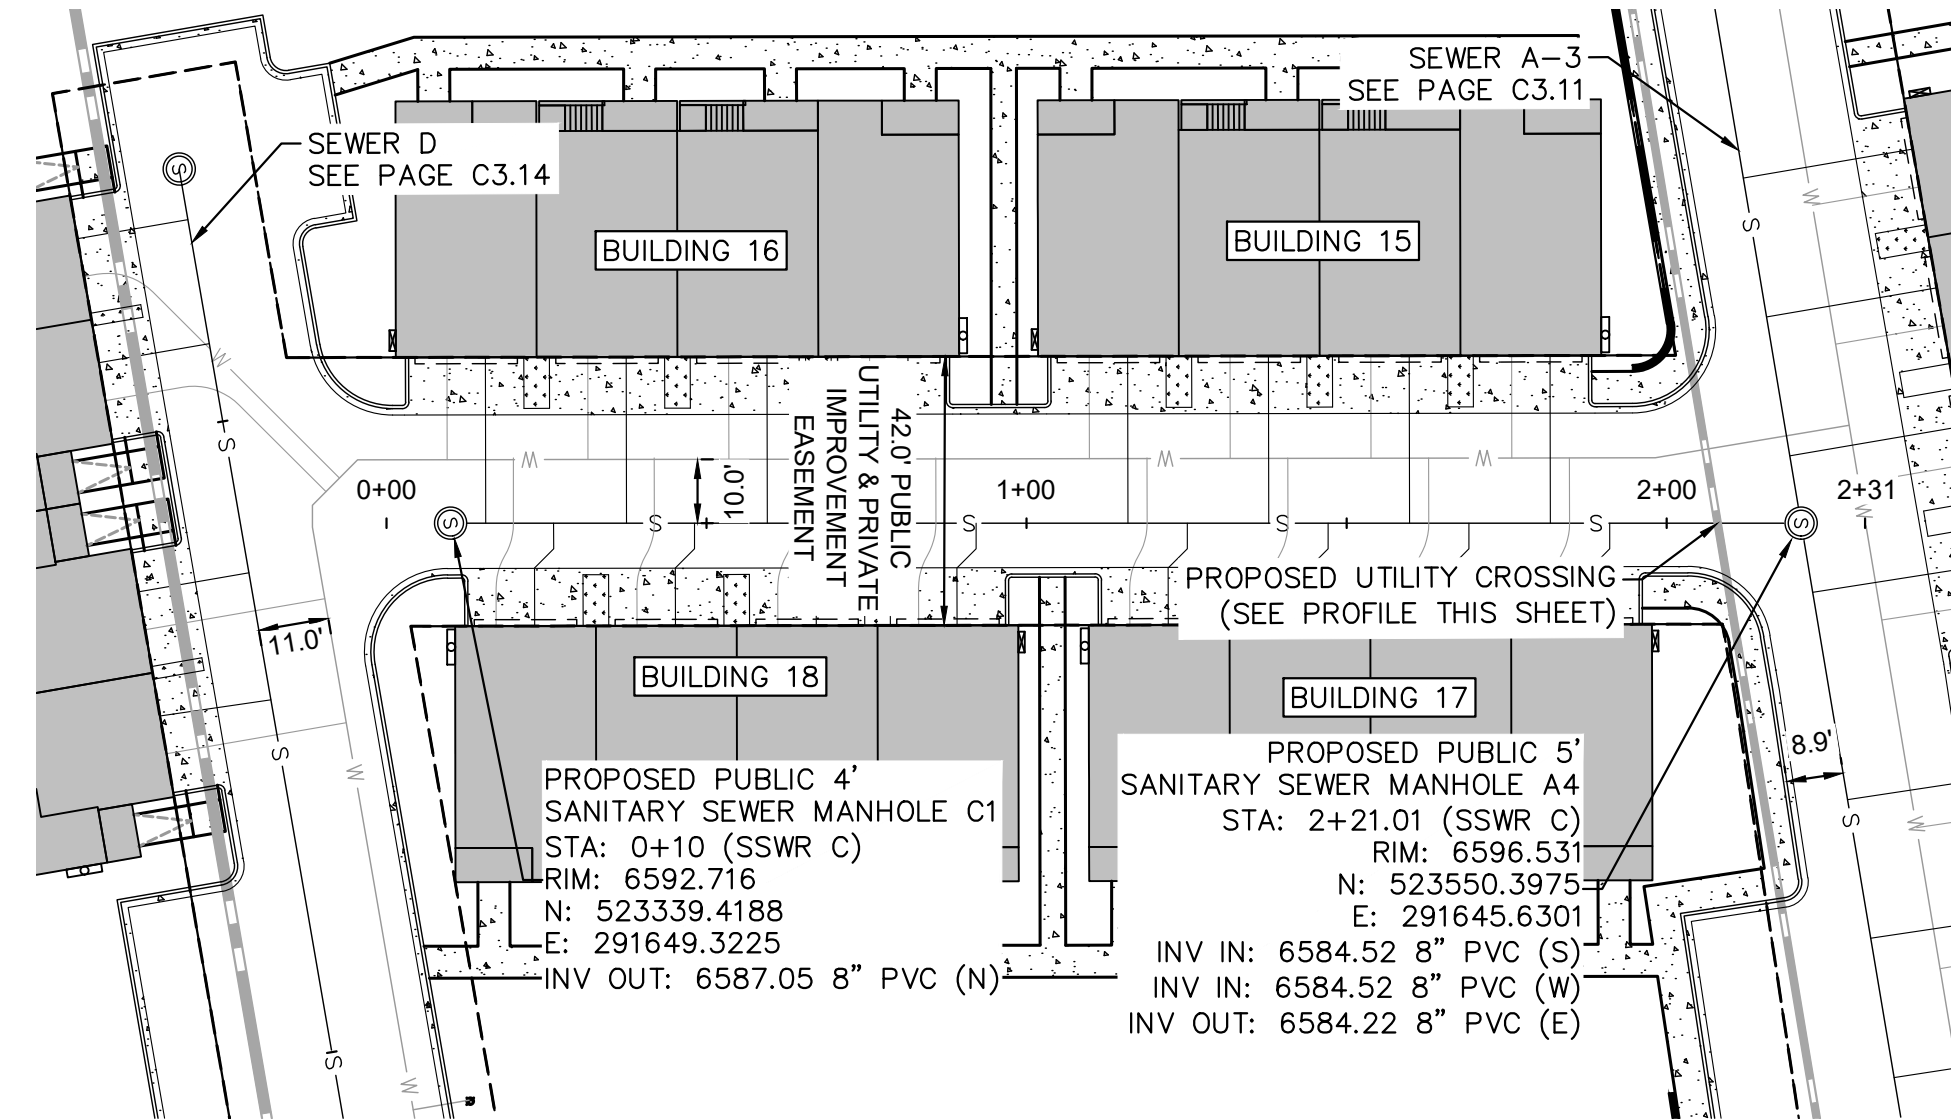

SEWER C PLAN VIEW

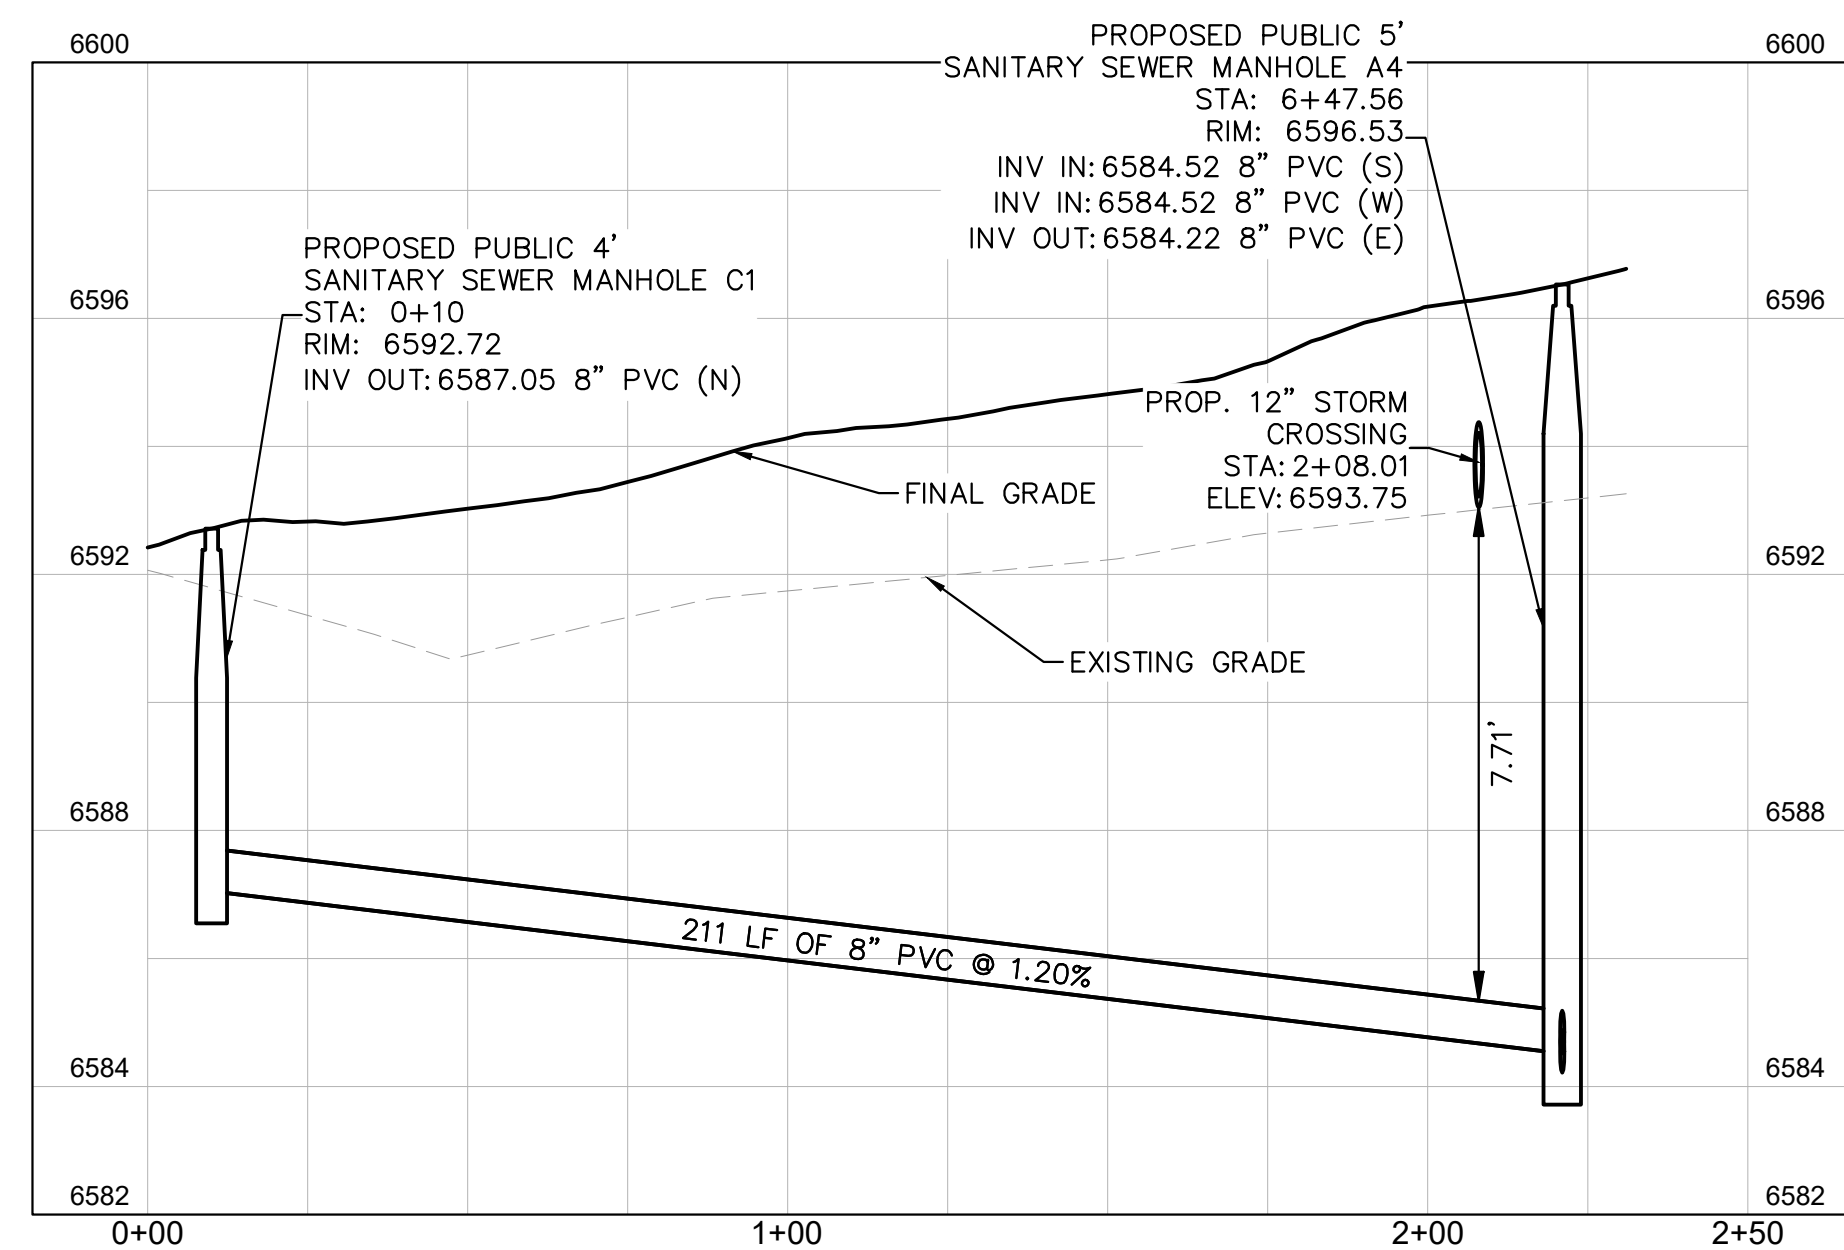

SEWER C PROFILE VIEW

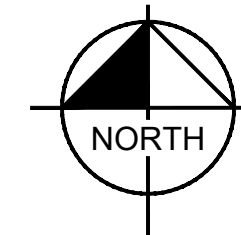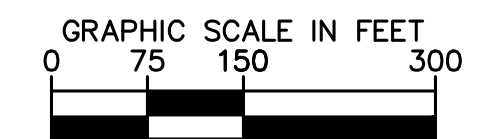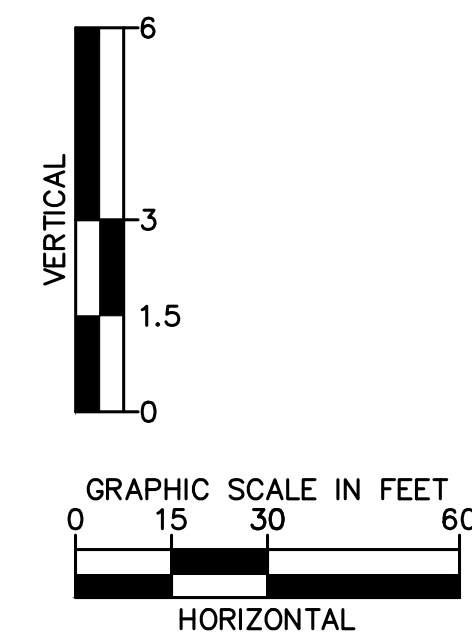

LEGEND

- PROPERTY LINE
- x-x- PROPOSED FENCE
- w- PROPOSED 6" PVC WATER MAIN
- s- PROPOSED 8" PVC SANITARY MAIN
- PROPOSED PVC STORM MAIN

NOTES

1. ALL EXISTING UTILITIES TO REMAIN UNLESS OTHERWISE NOTED.
2. UTILITIES TO BE REMOVED ARE TO BE CAPPED IN PLACE IN ACCORDANCE WITH LOCAL UTILITY REGULATIONS.
3. THE LOCATION AND/OR ELEVATION OF EXISTING UTILITIES AS SHOWN ON THESE PLANS IS BASED ON RECORDS OF THE VARIOUS UTILITY COMPANIES, AND WHERE POSSIBLE, MEASUREMENTS TAKEN IN THE FIELD. THE INFORMATION IS NOT TO BE RELIED ON AS BEING EXACT OR COMPLETE.
5. ALL PR. CURB & GUTTER IS EPC TYBE B PER EL PASO COUNTY STANDARD DETAIL SD_2-20 UNLESS OTHERWISE NOTED.
6. SEE PLANS FOR MAINLINE SIZES.
7. ALL CLEANOUTS TO BE INSTALLED PER COLORADO SPRINGS UTILITIES STANDARD DETAIL C 5-4.
8. ALL SANITARY SERVICES ARE 4" PVC WITH TAPS BY DEVELOPER UNLESS OTHERWISE NOTED ON PLANS.
9. SELECT BEDDING TO BE PER COLORADO SPRINGS UTILITIES WASTEWATER LESS SPECIFICATIONS.
10. MINIMUM SLOPES FOR WASTEWATER SERVICE LINES:
 - 10.1. 4" PVC (SDR 35) - 2.08% OR 1/4" PER FOOT
 - 10.2. 4" DUCTILE IRON PIPE/4" SCH 40 PVC - 1.04% OR 1/8" PER FOOT
 - 10.3. 6" PIPE - 1.04% OR 1/8" PER FOOT

NO.	REVISION	BY	DATE	APPR

Kimley»Horn

2026 KIMLEY-HORN AND ASSOCIATES, INC.
2 North Nevada Avenue, Suite 900
Colorado Springs, Colorado 80903 (719) 453-0180

DESIGNED BY: NMB
DRAWN BY: DPM
CHECKED BY: NMB
DATE: 01/13/2026

WINDERMERE FILING NO. 2
CONSTRUCTION DOCUMENTS
EL PASO COUNTY, COLORADO
SSWR C P&P




PRELIMINARY
FOR REVIEW ONLY
NOT FOR
CONSTRUCTION

Kimley»Horn
Kimley-Horn and Associates, Inc.

PROJECT NO.
196160000

SHEET
C3.13

K:\COS_LA\196160000 - Windemere\CADD\PlanSheets\CDS_CD_SSWR.dwg Evans, WYatt 3/30/2026 8:24 AM

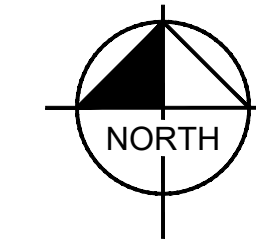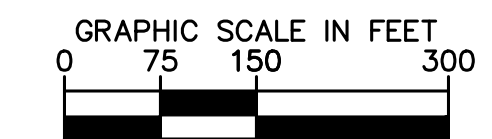
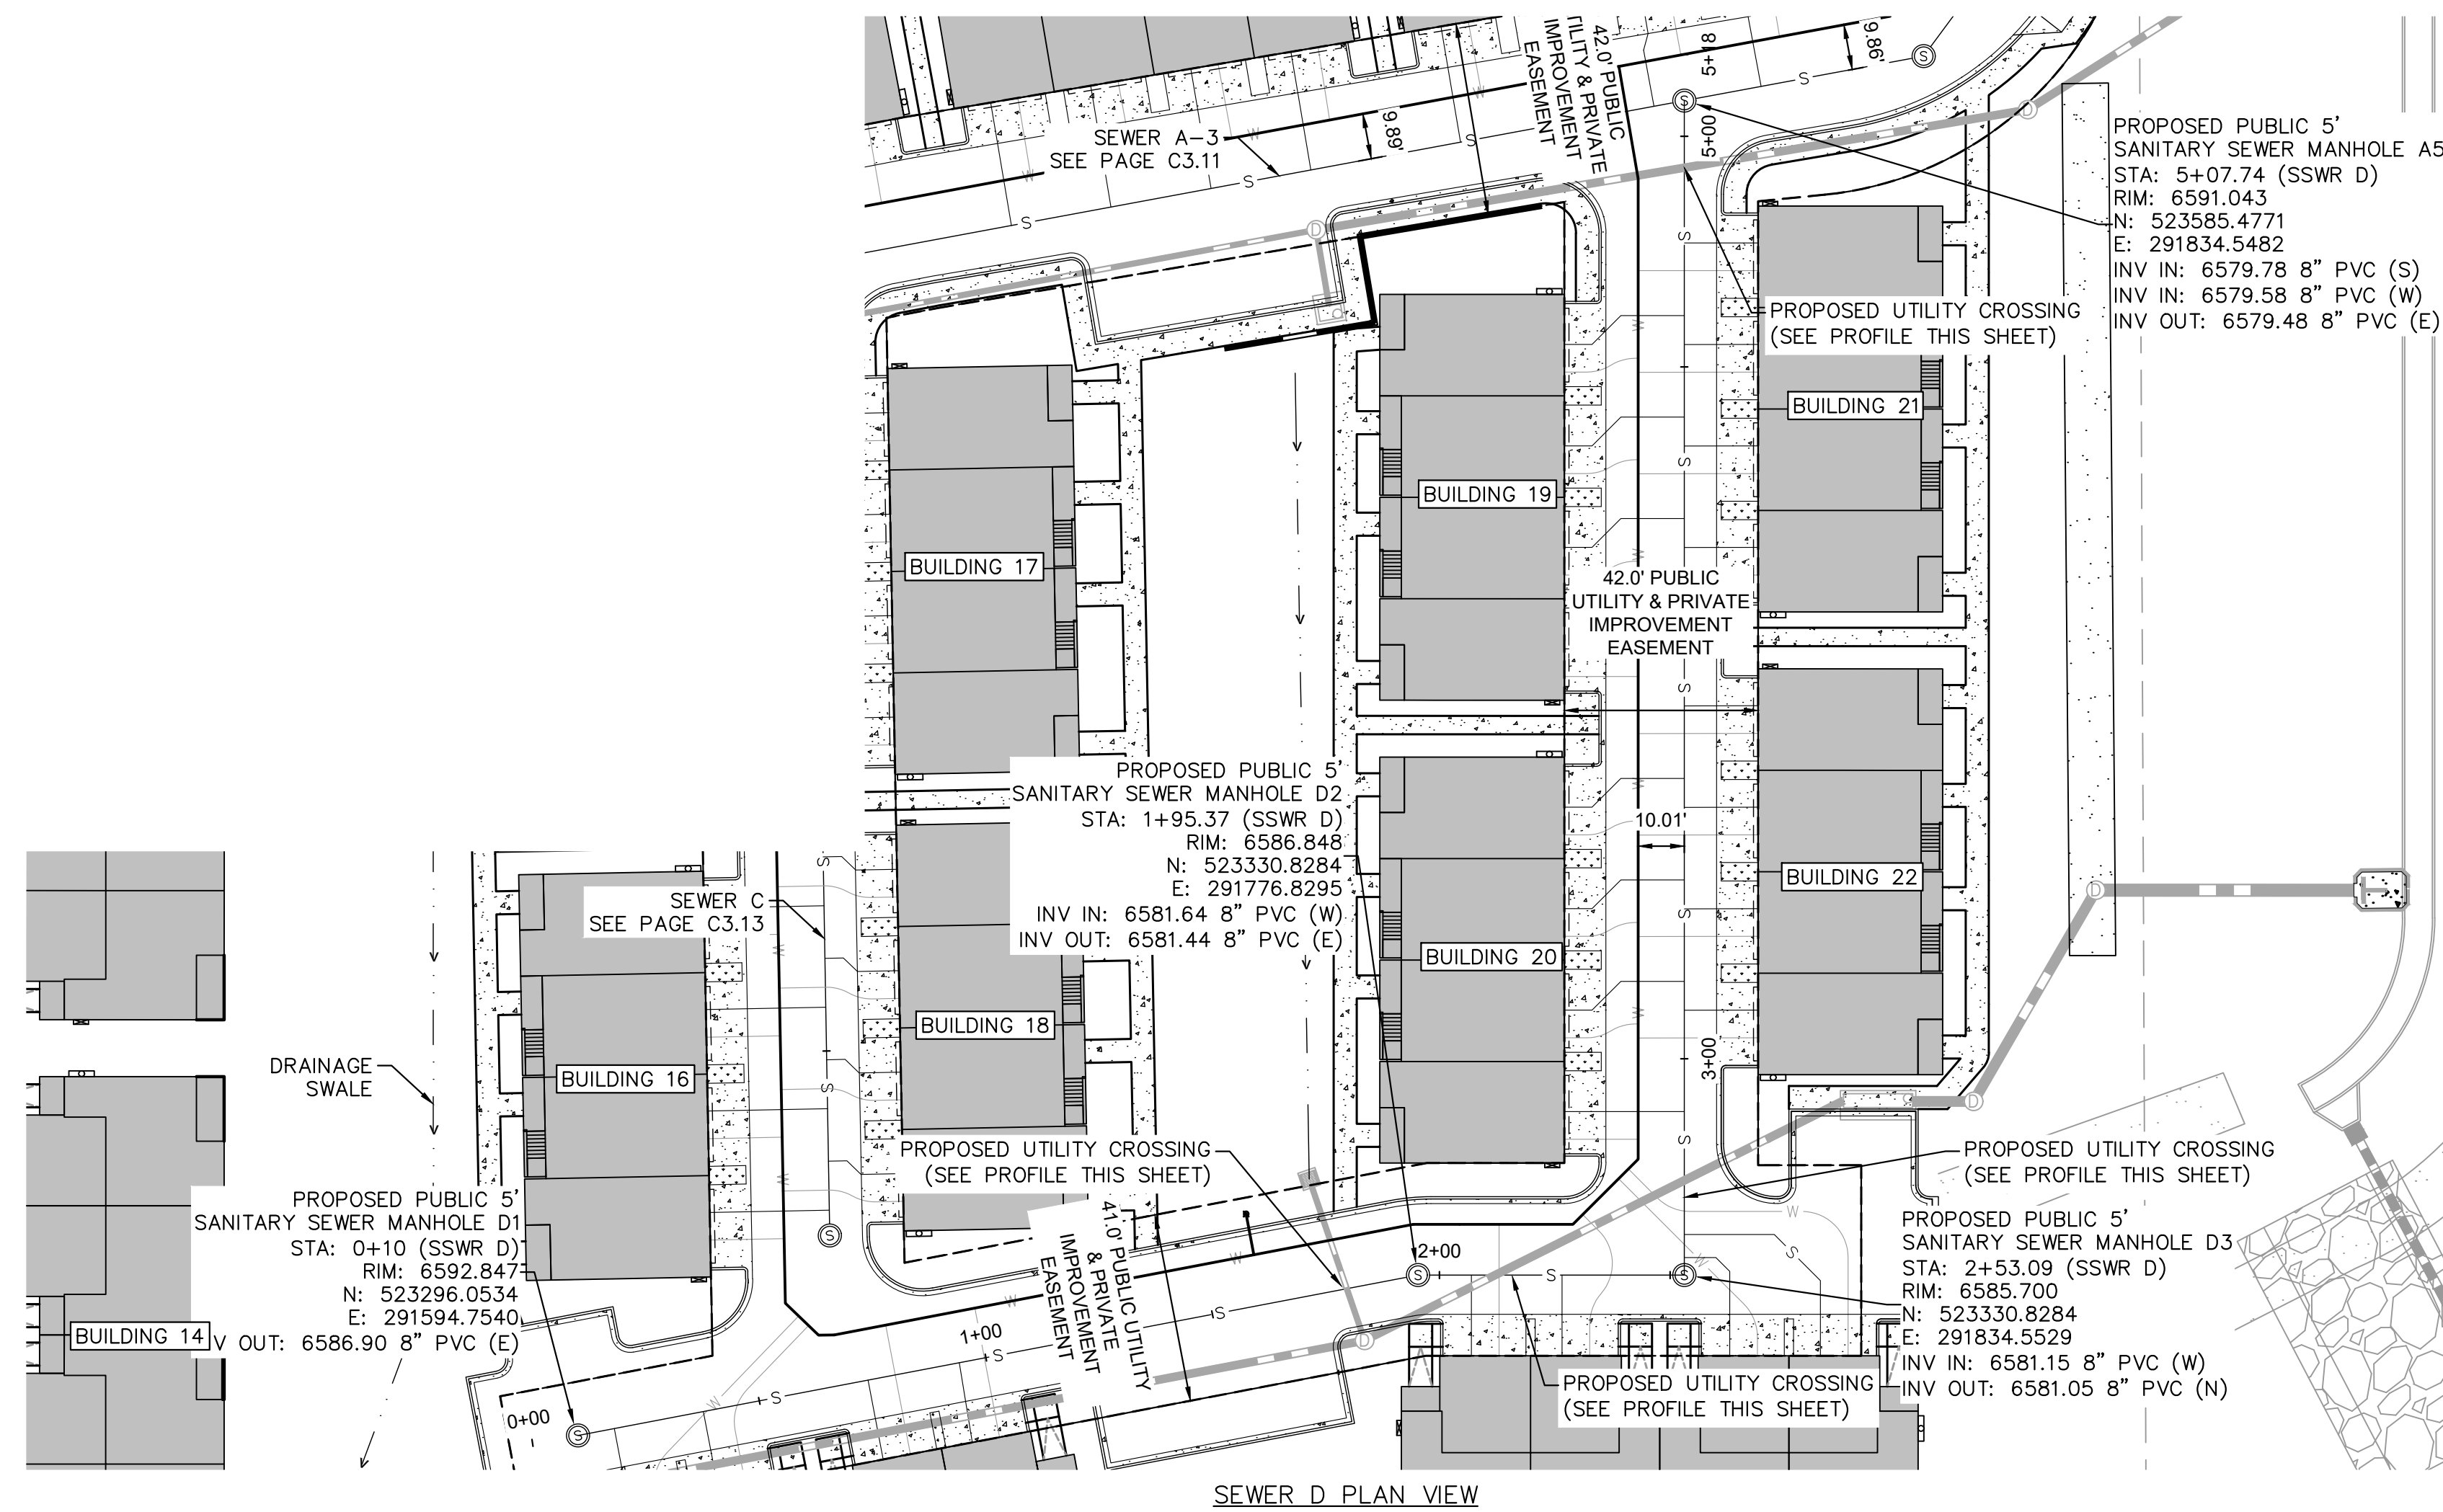


LEGEND

- PROPERTY LINE
- x-x- PROPOSED FENCE
- w- PROPOSED 6" PVC WATER MAIN
- s- PROPOSED 8" PVC SANITARY MAIN
- - - - - PROPOSED PVC STORM MAIN

NOTES

1. ALL EXISTING UTILITIES TO REMAIN UNLESS OTHERWISE NOTED.
2. UTILITIES TO BE REMOVED ARE TO BE CAPPED IN PLACE IN ACCORDANCE WITH LOCAL UTILITY REGULATIONS.
3. THE LOCATION AND/OR ELEVATION OF EXISTING UTILITIES AS SHOWN ON THESE PLANS IS BASED ON RECORDS OF THE VARIOUS UTILITY COMPANIES, AND WHERE POSSIBLE, MEASUREMENTS TAKEN IN THE FIELD. THE INFORMATION IS NOT TO BE RELIED ON AS BEING EXACT OR COMPLETE.
5. ALL PR. CURB & GUTTER IS EPC TYBE B PER EL PASO COUNTY STANDARD DETAIL SD_2-20 UNLESS OTHERWISE NOTED.
6. SEE PLANS FOR MAINLINE SIZES.
7. ALL CLEANOUTS TO BE INSTALLED PER COLORADO SPRINGS UTILITIES STANDARD DETAIL C 5-4.
8. ALL SANITARY SERVICES ARE 4" PVC WITH TAPS BY DEVELOPER UNLESS OTHERWISE NOTED ON PLANS.
9. SELECT BEDDING TO BE PER COLORADO SPRINGS UTILITIES WASTEWATER_LESS SPECIFICATIONS.
10. MINIMUM SLOPES FOR WASTEWATER SERVICE LINES:
 - 10.1. 4" PVC (SDR 35) - 2.08% OR 1/4" PER FOOT
 - 10.2. 4" DUCTILE IRON PIPE/4" SCH 40 PVC - 1.04% OR 1/8" PER FOOT
 - 10.3. 6" PIPE - 1.04% OR 1/8" PER FOOT

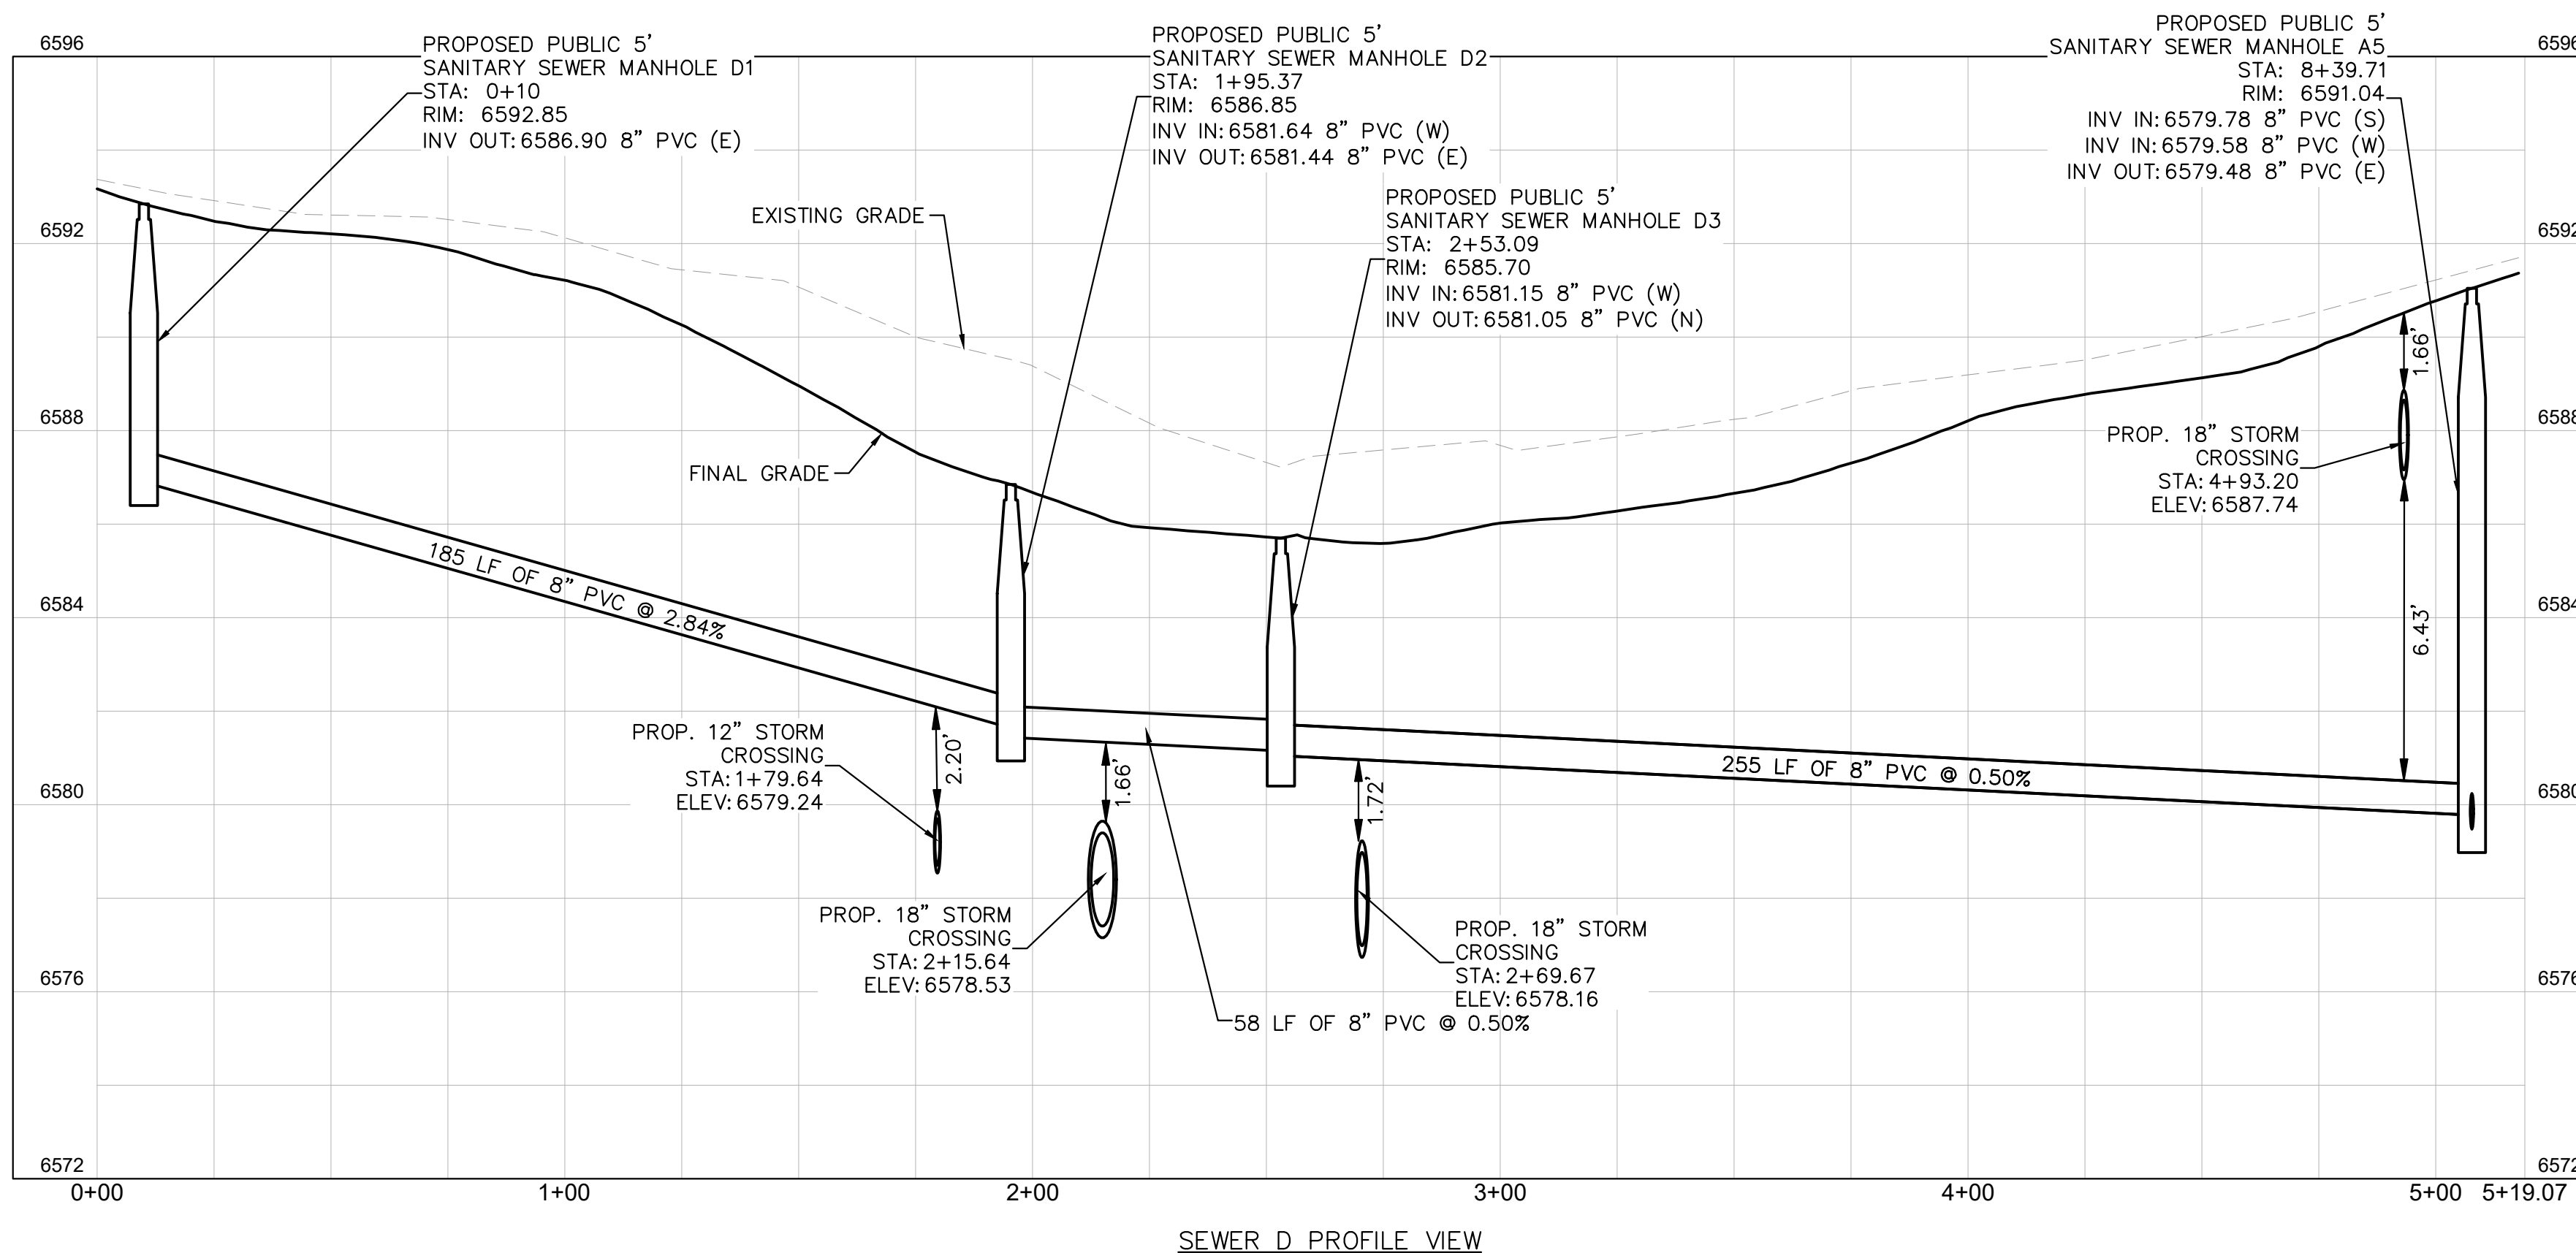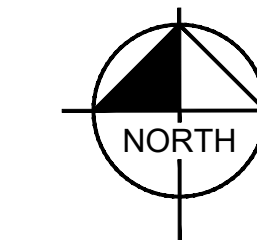

NO.	REVISION	BY	DATE	APPR

Kimley»Horn
2026 KIMLEY-HORN AND ASSOCIATES, INC.
2 North Nevada Avenue, Suite 900
Colorado Springs, Colorado 80903 (719) 453-0180

DESIGNED BY: NMB
DRAWN BY: DPM
CHECKED BY: NMB
DATE: 01/13/2026

WINDERMERE FILING NO. 2
CONSTRUCTION DOCUMENTS
EL PASO COUNTY, COLORADO
SSWR D P&P

PRELIMINARY
FOR REVIEW ONLY
NOT FOR CONSTRUCTION
Kimley»Horn
Kimley-Horn and Associates, Inc.

PROJECT NO.
196160000

SHEET
C3.14


K:\COS_LA\196160000 - Windermere\CADD\PlanSheets\GEC\GEC_CV.dwg Evans, Wyatt 3/30/2026 8:16 AM

STANDARD NOTES FOR EL PASO COUNTY:

- STORMWATER DISCHARGES FROM CONSTRUCTION SITES SHALL NOT CAUSE OR THREATEN TO CAUSE POLLUTION, CONTAMINATION, OR DEGRADATION OF STATE WATERS. ALL WORK AND EARTH DISTURBANCE SHALL BE DONE IN A MANNER THAT MINIMIZES POLLUTION OF ANY ON-SITE WATERS, INCLUDING WETLANDS.
- NOTWITHSTANDING ANYTHING DEPICTED IN THESE PLANS IN WORDS OR GRAPHIC REPRESENTATION, ALL DESIGN AND CONSTRUCTION RELATED TO ROADS, STORM DRAINAGE AND EROSION CONTROL SHALL CONFORM TO THE STANDARDS AND REQUIREMENTS OF THE MOST RECENT VERSION OF THE RELEVANT ADOPTED EL PASO COUNTY STANDARDS, INCLUDING THE LAND DEVELOPMENT CODE, THE ENGINEERING CRITERIA MANUAL, THE DRAINAGE CRITERIA MANUAL, AND THE DRAINAGE CRITERIA MANUAL VOLUME 2. ANY DEVIATIONS FROM REGULATIONS AND STANDARDS MUST BE REQUESTED, AND APPROVED IN WRITING.
- A SEPARATE STORMWATER MANAGEMENT PLAN (SWMP) FOR THIS PROJECT SHALL BE COMPLETED AND AN EROSION AND STORMWATER QUALITY CONTROL PERMIT (ESQCP) ISSUED PRIOR TO COMMENCING CONSTRUCTION. MANAGEMENT OF THE SWMP DURING CONSTRUCTION IS THE RESPONSIBILITY OF THE DESIGNATED QUALIFIED STORMWATER MANAGER OR CERTIFIED EROSION CONTROL INSPECTOR. THE SWMP SHALL BE LOCATED ON SITE AT ALL TIMES DURING CONSTRUCTION AND SHALL BE KEPT UP TO DATE WITH WORK PROGRESS IN THE FIELD.
- ONCE THE ESQCP IS APPROVED AND A "NOTICE TO PROCEED" HAS BEEN ISSUED, THE CONTRACTOR MAY INSTALL THE INITIAL STAGE EROSION AND SEDIMENT CONTROL MEASURES AS INDICATED ON THE APPROVED GEC. A PRE-CONSTRUCTION MEETING BETWEEN THE CONTRACTOR, ENGINEER, AND EL PASO COUNTY WILL BE HELD PRIOR TO ANY CONSTRUCTION. IT IS THE RESPONSIBILITY OF THE APPLICANT TO COORDINATE THE MEETING TIME AND PLACE WITH COUNTY STAFF.
- CONTROL MEASURES MUST BE INSTALLED PRIOR TO COMMENCEMENT OF ACTIVITIES THAT COULD CONTRIBUTE POLLUTANTS TO STORMWATER. CONTROL MEASURES FOR ALL SLOPES, CHANNELS, DITCHES AND DISTURBED LAND AREAS SHALL BE INSTALLED IMMEDIATELY UPON COMPLETION OF THE DISTURBANCE.
- ALL TEMPORARY SEDIMENT AND EROSION CONTROL MEASURES SHALL BE MAINTAINED AND REMAIN IN EFFECTIVE OPERATING CONDITION UNTIL PERMANENT SOIL EROSION CONTROL MEASURES ARE IMPLEMENTED AND FINAL STABILIZATION IS ESTABLISHED. ALL PERSONS ENGAGED IN LAND DISTURBANCE ACTIVITIES SHALL ASSESS THE ADEQUACY OF CONTROL MEASURES AT THE SITE AND IDENTIFY IF CHANGES TO THOSE CONTROL MEASURES ARE NEEDED TO ENSURE THE CONTINUED EFFECTIVE PERFORMANCE OF THE CONTROL MEASURES. ALL CHANGES TO TEMPORARY SEDIMENT AND EROSION CONTROL MEASURES MUST BE INCORPORATED INTO THE STORMWATER MANAGEMENT PLAN.
- TEMPORARY STABILIZATION SHALL BE IMPLEMENTED ON DISTURBED AREAS AND STOCKPILES WHERE GROUND DISTURBING CONSTRUCTION ACTIVITY HAS PERMANENTLY CEASED OR TEMPORARILY CEASED FOR LONGER THAN 14 DAYS.
- FINAL STABILIZATION MUST BE IMPLEMENTED AT ALL APPLICABLE CONSTRUCTION SITES. FINAL STABILIZATION IS ACHIEVED WHEN ALL GROUND DISTURBING ACTIVITIES ARE COMPLETE AND ALL DISTURBED AREAS EITHER HAVE A UNIFORM VEGETATIVE COVER WITH INDIVIDUAL PLAN DENSITY OF 70% OF PRE-DISTURBED LEVELS ESTABLISHED OR EQUIVALENT PERMANENT ALTERNATIVE STABILIZATION METHOD IS IMPLEMENTED. ALL TEMPORARY SEDIMENT AND EROSION CONTROL MEASURES SHALL BE REMOVED UPON FINAL STABILIZATION AND BEFORE PERMIT CLOSURE.
- ALL PERMANENT STORMWATER MANAGEMENT FACILITIES SHALL BE INSTALLED AS DESIGNED IN THE APPROVED PLANS. ANY PROPOSED CHANGES THAT EFFECT THE DESIGN OR FUNCTION OF PERMANENT STORMWATER MANAGEMENT STRUCTURES MUST BE APPROVED BY THE ECM ADMINISTRATOR PRIOR TO IMPLEMENTATION.
- EARTH DISTURBANCES SHALL BE CONDUCTED IN SUCH A MANNER SO AS TO EFFECTIVELY MINIMIZE ACCELERATED SOIL EROSION AND RESULTING SEDIMENTATION. ALL DISTURBANCES SHALL BE DESIGNED, CONSTRUCTED, AND COMPLETED SO THAT THE EXPOSED AREA OF ANY DISTURBED LAND SHALL BE LIMITED TO THE SHORTEST PRACTICAL PERIOD OF TIME. PRE-EXISTING VEGETATION SHALL BE PROTECTED AND MAINTAINED WITHIN 50 HORIZONTAL FEET OF A WATERS OF THE STATE UNLESS SHOWN TO BE INFEASIBLE AND SPECIFICALLY REQUESTED AND APPROVED.
- COMPACTION OF SOIL MUST BE PREVENTED IN AREAS DESIGNATED FOR INFILTRATION CONTROL MEASURES OR WHERE FINAL STABILIZATION WILL BE ACHIEVED BY VEGETATIVE COVER. AREAS DESIGNATED FOR INFILTRATION CONTROL MEASURES SHALL ALSO BE PROTECTED FROM SEDIMENTATION DURING CONSTRUCTION UNTIL FINAL STABILIZATION IS ACHIEVED. IF COMPACTION PREVENTION IS NOT FEASIBLE DUE TO SITE CONSTRAINTS, ALL AREAS DESIGNATED FOR INFILTRATION AND VEGETATION CONTROL MEASURES MUST BE LOOSENED PRIOR TO INSTALLATION OF THE CONTROL MEASURE(S).
- ANY TEMPORARY OR PERMANENT FACILITY DESIGNED AND CONSTRUCTED FOR THE CONVEYANCE OF STORMWATER AROUND, THROUGH, OR FROM THE EARTH DISTURBANCE AREA SHALL BE A STABILIZED CONVEYANCE DESIGNED TO MINIMIZE EROSION AND THE DISCHARGE OF SEDIMENT OFF SITE.
- CONCRETE WASH WATER SHALL BE CONTAINED AND DISPOSED OF IN ACCORDANCE WITH THE SWMP. NO WASH WATER SHALL BE DISCHARGED TO OR ALLOWED TO ENTER STATE WATERS, INCLUDING ANY SURFACE OR SUBSURFACE STORM DRAINAGE SYSTEM OR FACILITIES. CONCRETE WASHOUTS SHALL NOT BE LOCATED IN AN AREA WHERE SHALLOW GROUNDWATER MAY BE PRESENT, OR WITHIN 50 FEET OF A SURFACE WATER BODY, CREEK, OR STREAM.
- DURING DEWATERING OPERATIONS OF UNCONTAMINATED GROUND WATER MAY BE DISCHARGED ON SITE, BUT SHALL NOT LEAVE THE SITE IN THE FORM OF SURFACE RUNOFF UNLESS AN APPROVED STATE DEWATERING PERMIT IS IN PLACE.
- EROSION CONTROL BLANKETING OR OTHER PROTECTIVE COVERING SHALL BE USED ON SLOPES STEEPER THAN 3:1.
- CONTRACTOR SHALL BE RESPONSIBLE FOR THE REMOVAL OF ALL WASTES FROM THE CONSTRUCTION SITE FOR DISPOSAL IN ACCORDANCE WITH LOCAL AND STATE REGULATORY REQUIREMENTS. NO CONSTRUCTION DEBRIS, TREE SLASH, BUILDING MATERIAL WASTES OR UNUSED BUILDING MATERIALS SHALL BE BURIED, DUMPED, OR DISCHARGED AT THE SITE.
- WASTE MATERIALS SHALL NOT BE TEMPORARILY PLACED OR STORED IN THE STREET, ALLEY, OR OTHER PUBLIC WAY, UNLESS IN ACCORDANCE WITH AN APPROVED TRAFFIC CONTROL PLAN. CONTROL MEASURES MAY BE REQUIRED BY EL PASO COUNTY ENGINEERING IF DEEMED NECESSARY, BASED ON SPECIFIC CONDITIONS AND CIRCUMSTANCES.
- TRACKING OF SOILS AND CONSTRUCTION DEBRIS OFF-SITE SHALL BE MINIMIZED. MATERIALS TRACKED OFF-SITE SHALL BE CLEANED UP AND PROPERLY DISPOSED OF IMMEDIATELY.
- THE OWNER/DEVELOPER SHALL BE RESPONSIBLE FOR THE REMOVAL OF ALL CONSTRUCTION DEBRIS, DIRT, TRASH, ROCK, SEDIMENT, SOIL AND SAND THAT MAY ACCUMULATE IN ROADS, STORM DRAINS, AND OTHER DRAINAGE CONVEYANCE SYSTEMS AND STORMWATER APPURTENANCES AS A RESULT OF SITE DEVELOPMENT.
- THE QUANTITY OF MATERIALS STORED ON THE PROJECT SITE SHALL BE LIMITED, AS MUCH AS PRACTICAL, TO THAT QUANTITY REQUIRED TO PERFORM THE WORK IN AN ORDERLY SEQUENCE. ALL MATERIALS STORED ON-SITE SHALL BE STORED IN A NEAT, ORDERLY MANNER, IN THEIR ORIGINAL CONTAINERS, WITH ORIGINAL MANUFACTURER'S LABELS.
- NO CHEMICAL(S) HAVING THE POTENTIAL TO BE RELEASED IN STORMWATER ARE TO BE STORED OR USED ON-SITE UNLESS PERMISSION FOR THE USE OF SUCH CHEMICAL(S) IS GRANTED IN WRITING BY THE ECM ADMINISTRATOR. IN GRANTING APPROVAL FOR THE USE OF SUCH CHEMICAL(S), SPECIAL CONDITIONS AND MONITORING MAY BE REQUIRED.
- BULK STORAGE OF ALLOWED PETROLEUM PRODUCTS OR OTHER ALLOWED LIQUID CHEMICALS IN EXCESS OF 55 GALLONS SHALL REQUIRE ADEQUATE SECONDARY CONTAINMENT PROTECTION TO CONTAIN ALL SPILLS ON-SITE AND TO PREVENT ANY SPILLED MATERIALS FROM ENTERING STATE WATERS, ANY SURFACE OR SUBSURFACE STORM DRAINAGE SYSTEM OR OTHER FACILITIES.
- NO PERSON SHALL CAUSE THE IMPEDIMENT OF STORMWATER FLOW IN THE CURB AND GUTTER OR DITCH EXCEPT WITH APPROVED SEDIMENT CONTROL MEASURES.
- OWNER/DEVELOPER AND THEIR AGENTS SHALL COMPLY WITH THE "COLORADO WATER QUALITY CONTROL ACT" (TITLE 25, ARTICLE 8, CRS), AND THE "CLEAN WATER ACT" (33 USC 1344), IN ADDITION TO THE REQUIREMENTS OF THE LAND DEVELOPMENT CODE, DCM VOLUME II AND THE ECM APPENDIX I. ALL APPROPRIATE PERMITS MUST BE OBTAINED BY THE CONTRACTOR PRIOR TO CONSTRUCTION (1041, NPDES, FLOODPLAIN, 404, FUGITIVE DUST, ETC.). IN THE EVENT OF CONFLICTS BETWEEN THESE REQUIREMENTS AND OTHER LAWS, RULES, OR REGULATIONS OF OTHER FEDERAL, STATE, LOCAL OR COUNTY AGENCIES, THE MOST RESTRICTIVE LAWS, RULES, OR REGULATIONS SHALL APPLY.
- ALL CONSTRUCTION TRAFFIC MUST ENTER/EXIT THE SITE ONLY AT APPROVED CONSTRUCTION ACCESS POINTS.
- PRIOR TO CONSTRUCTION THE PERMITTEE SHALL VERIFY THE LOCATION OF EXISTING UTILITIES.
- A WATER SOURCE SHALL BE AVAILABLE ON SITE DURING EARTHWORK OPERATIONS AND SHALL BE UTILIZED AS REQUIRED TO MINIMIZE DUST FROM EARTHWORK EQUIPMENT AND WIND.
- THE SOILS REPORT FOR THIS SITE HAS BEEN PREPARED BY ENTECH ENGINEERING, INC. ON JANUARY 25, 2022, AND SHALL BE CONSIDERED A PART OF THESE PLANS.
- AT LEAST TEN (10) DAYS PRIOR TO THE ANTICIPATED START OF CONSTRUCTION, FOR PROJECTS THAT WILL DISTURB ONE (1) ACRE OR MORE, THE OWNER OR OPERATOR OF CONSTRUCTION ACTIVITY SHALL SUBMIT A PERMIT APPLICATION FOR STORMWATER DISCHARGE TO THE COLORADO DEPARTMENT OF PUBLIC HEALTH AND ENVIRONMENT, WATER QUALITY DIVISION. THE APPLICATION CONTAINS CERTIFICATION OF COMPLETION OF A STORMWATER MANAGEMENT PLAN (SWMP), OF WHICH THIS GRADING AND EROSION CONTROL PLAN MAY BE A PART. FOR INFORMATION OR APPLICATION MATERIALS CONTACT:
- NO BATCH PLANTS ARE ANTICIPATED TO UTILIZED ON-SITE

COLORADO DEPARTMENT OF PUBLIC HEALTH AND ENVIRONMENT
 WATER QUALITY CONTROL DIVISION
 WQCD - PERMITS
 4300 CHERRY CREEK DRIVE SOUTH
 DENVER, CO 80246-1530
 ATTN: PERMITS UNIT

WINDERMERE FILING NO. 2 GRADING & EROSION CONTROL PLANS 7653 MARDALE LN. TRACT B, WINDERMERE FILING NO. 1 COUNTY OF EL PASO, STATE OF COLORADO

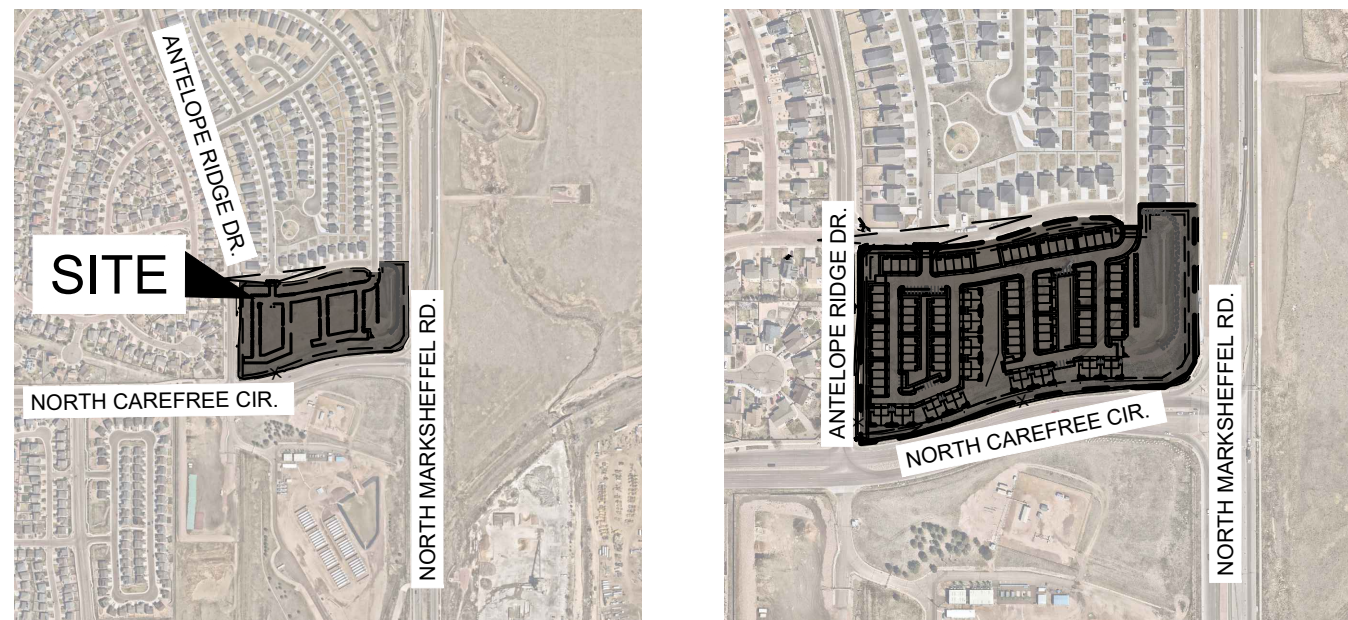

VICINITY MAP 1" = 1000' PROJECT LAYOUT MAP 1" = 500'

DESIGN TEAM CONTACTS:

OWNER:
 COLO WINDERMERE #2, LLC
 4164 AUSTIN BLUFFS PKWY. #361
 COLORADO SPRINGS, CO 80918
 TEL: 719.200.9594
 CONTACT: JAMES TODD STEPHENS

ENGINEER:
 KIMLEY-HORN AND ASSOCIATES, INC.
 2 NEVADA NORTH AVE., SUITE 900
 COLORADO SPRINGS, CO 80903
 TEL: (719) 453-0180
 CONTACT: NOAH BREHMER, P.E.

SURVEYOR:
 DREXEL, BARRELL & CO.
 3 SOUTH 7TH STREET
 COLORADO SPRINGS, CO 80905
 TEL: (719) 260-0887
 CONTACT: JOHN C. DAY, P.L.S.

AGENCY CONTACTS:

EL PASO COUNTY DEVELOPMENT SERVICES DEPARTMENT:
 2880 INTERNATIONAL CIRCLE
 SUITE 110
 COLORADO SPRINGS, CO 80910
 PHONE: 719.520.3600

WATER & WASTEWATER:
 CHEROKEE METROPOLITAN DISTRICT
 6250 PALMER PARK BLVD.
 COLORADO SPRINGS, CO 80910
 PHONE: 719.595.5080

Sheet List Table	
Sheet Number	Sheet Title
C4.0	COVER SHEET
C4.1	INITIAL PLAN
C4.2	INTERIM PLAN
C4.3	FINAL PLAN
C4.4	CUT & FILL PLAN
C4.5	DETAILS
C4.6	DETAILS
C4.7	DETAILS
C4.8	DETAILS

LIMITS OF CONSTRUCTION

ONSITE IMPROVEMENTS	= ±7.61 ACRES
OFFSITE IMPROVEMENTS	= ±0.46 ACRES
TOTAL	= ±8.07 ACRES
TOTAL AREA OF LAND DISTURBANCE	= ±8.07 ACRES

LEGAL DESCRIPTION:
 TRACT B, WINDERMERE FILING NO. 1

LAND AREA:
 TOTAL PROPERTY AREA: ±9.13 ACRES

FLOOD PLAIN NOTE:
 THE PROPOSED PROJECT SITE IS LOCATED IN ZONE X, AN "AREA OF MINIMAL FLOOD HAZARD". FEDERAL EMERGENCY MANAGEMENT AGENCY, FLOOD INSURANCE RATE MAP (FIRM), PANEL #08041C0543G EFFECTIVE DATE DECEMBER 7, 2018.

SOIL TYPE:
 100% +/- TYPE "A" SOILS ARE FOUND ON SITE.

THE EXISTING SITE IS CURRENTLY PARTIALLY VEGETATED WITH SOME NATIVE GRASSES AND SHRUBS PER SITE VISITS AND AERIAL IMAGERY.

SCHEDULE:
 ANTICIPATED START DATE: 2ND QUARTER OF 2026
 ANTICIPATED END DATE: 4TH QUARTER OF 2026

RECEIVING WATER:
 THIS SITE IS TRIBUTARY TO SAND CREEK DRAINAGE BASIN

OWNER'S SIGNATURE BLOCK

I, THE OWNER/DEVELOPER HAVE READ AND WILL COMPLY WITH ALL OF THE REQUIREMENTS SPECIFIED IN THESE DETAILED PLANS AND SPECIFICATIONS.

NAME _____ DATE _____

ENGINEER'S SIGNATURE BLOCK

THESE DETAILED PLANS AND SPECIFICATIONS WERE PREPARED UNDER MY DIRECTION AND SUPERVISION. SAID PLANS AND SPECIFICATIONS HAVE BEEN PREPARED ACCORDING TO THE CRITERIA ESTABLISHED BY THE COUNTY FOR DETAILED ROADWAY, DRAINAGE, GRADING AND EROSION CONTROL PLANS AND SPECIFICATIONS AND SAID PLANS AND SPECIFICATIONS ARE IN CONFORMITY WITH THE APPLICABLE MASTER DRAINAGE PLANS AND MASTER TRANSPORTATION PLANS. SAID PLANS AND SPECIFICATIONS MEET THE PURPOSES FOR WHICH THE PARTICULAR ROADWAY AND DRAINAGE FACILITIES ARE DESIGNED AND ARE CORRECT TO THE BEST OF MY KNOWLEDGE AND BELIEF. I ACCEPT RESPONSIBILITY FOR ANY LIABILITY CAUSED BY ANY NEGLIGENT ACTS, ERRORS OR OMISSIONS ON MY PART IN PREPARATION OF THE DETAILED PLANS AND SPECIFICATIONS

NOAH BREHMER, P.E. - KIMLEY-HORN AND ASSOCIATES, INC. DATE _____

EL PASO COUNTY REVIEW STATEMENT

COUNTY PLAN REVIEW IS PROVIDED ONLY FOR GENERAL CONFORMANCE WITH COUNTY DESIGN CRITERIA. THE COUNTY IS NOT RESPONSIBLE FOR THE ACCURACY AND ADEQUACY OF THE DESIGN DIMENSIONS AND/OR ELEVATIONS WHICH SHALL BE CONFIRMED AT THE JOB SITE. THE COUNTY THROUGH THE APPROVAL OF THIS DOCUMENT ASSUMES NO RESPONSIBILITY FOR COMPLETENESS AND/OR ACCURACY OF THIS DOCUMENT.

FILED IN ACCORDANCE WITH THE REQUIREMENTS OF THE EL PASO COUNTY LAND DEVELOPMENT CODE, DRAINAGE CRITERIA MANUAL, VOLUMES 1 AND 2, AND ENGINEERING CRITERIA MANUAL AS AMENDED.

IN ACCORDANCE WITH ECM SECTION 1.12, THESE CONSTRUCTION DOCUMENTS WILL BE VALID FOR CONSTRUCTION FOR A PERIOD OF 2 YEARS FROM THE DATE SIGNED BY THE EL PASO COUNTY ENGINEER. IF CONSTRUCTION HAS NOT STARTED WITHIN THOSE 2 YEARS, THE PLANS WILL NEED TO BE RESUBMITTED FOR APPROVAL, INCLUDING PAYMENT OF REVIEW FEES AT THE PLANNING AND COMMUNITY DEVELOPMENT DIRECTIONS DISCRETION.

PCD FILE # PPR2442 JOSHUA PALMER, COUNTY ENGINEER / ECM ADMINISTRATOR DATE _____

NO.	REVISION	BY	DATE	APPR

Kimley»Horn
 2026 KIMLEY-HORN AND ASSOCIATES, INC.
 2 North Nevada Avenue, Suite 900
 Colorado Springs, Colorado 80903 (719) 453-0180


DESIGNED BY: NMB
 DRAWN BY: DPM
 CHECKED BY: NMB
 DATE: 03/30/2026

**WINDERMERE FILING NO. 2
 GRADING AND EROSION CONTROL PLANS
 EL PASO COUNTY, COLORADO
 COVER SHEET**

PRELIMINARY
 FOR REVIEW ONLY
 NOT FOR
 CONSTRUCTION
 Kimley»Horn
 Kimley-Horn and Associates, Inc.

PROJECT NO.
 196160000
 SHEET
C4.0

K:\COS_LA\196160000 - Windemere\CADD\PlanSheets\GEC\GEC_INITIAL.dwg Evans, Wyatt 3/30/2026 8:16 AM

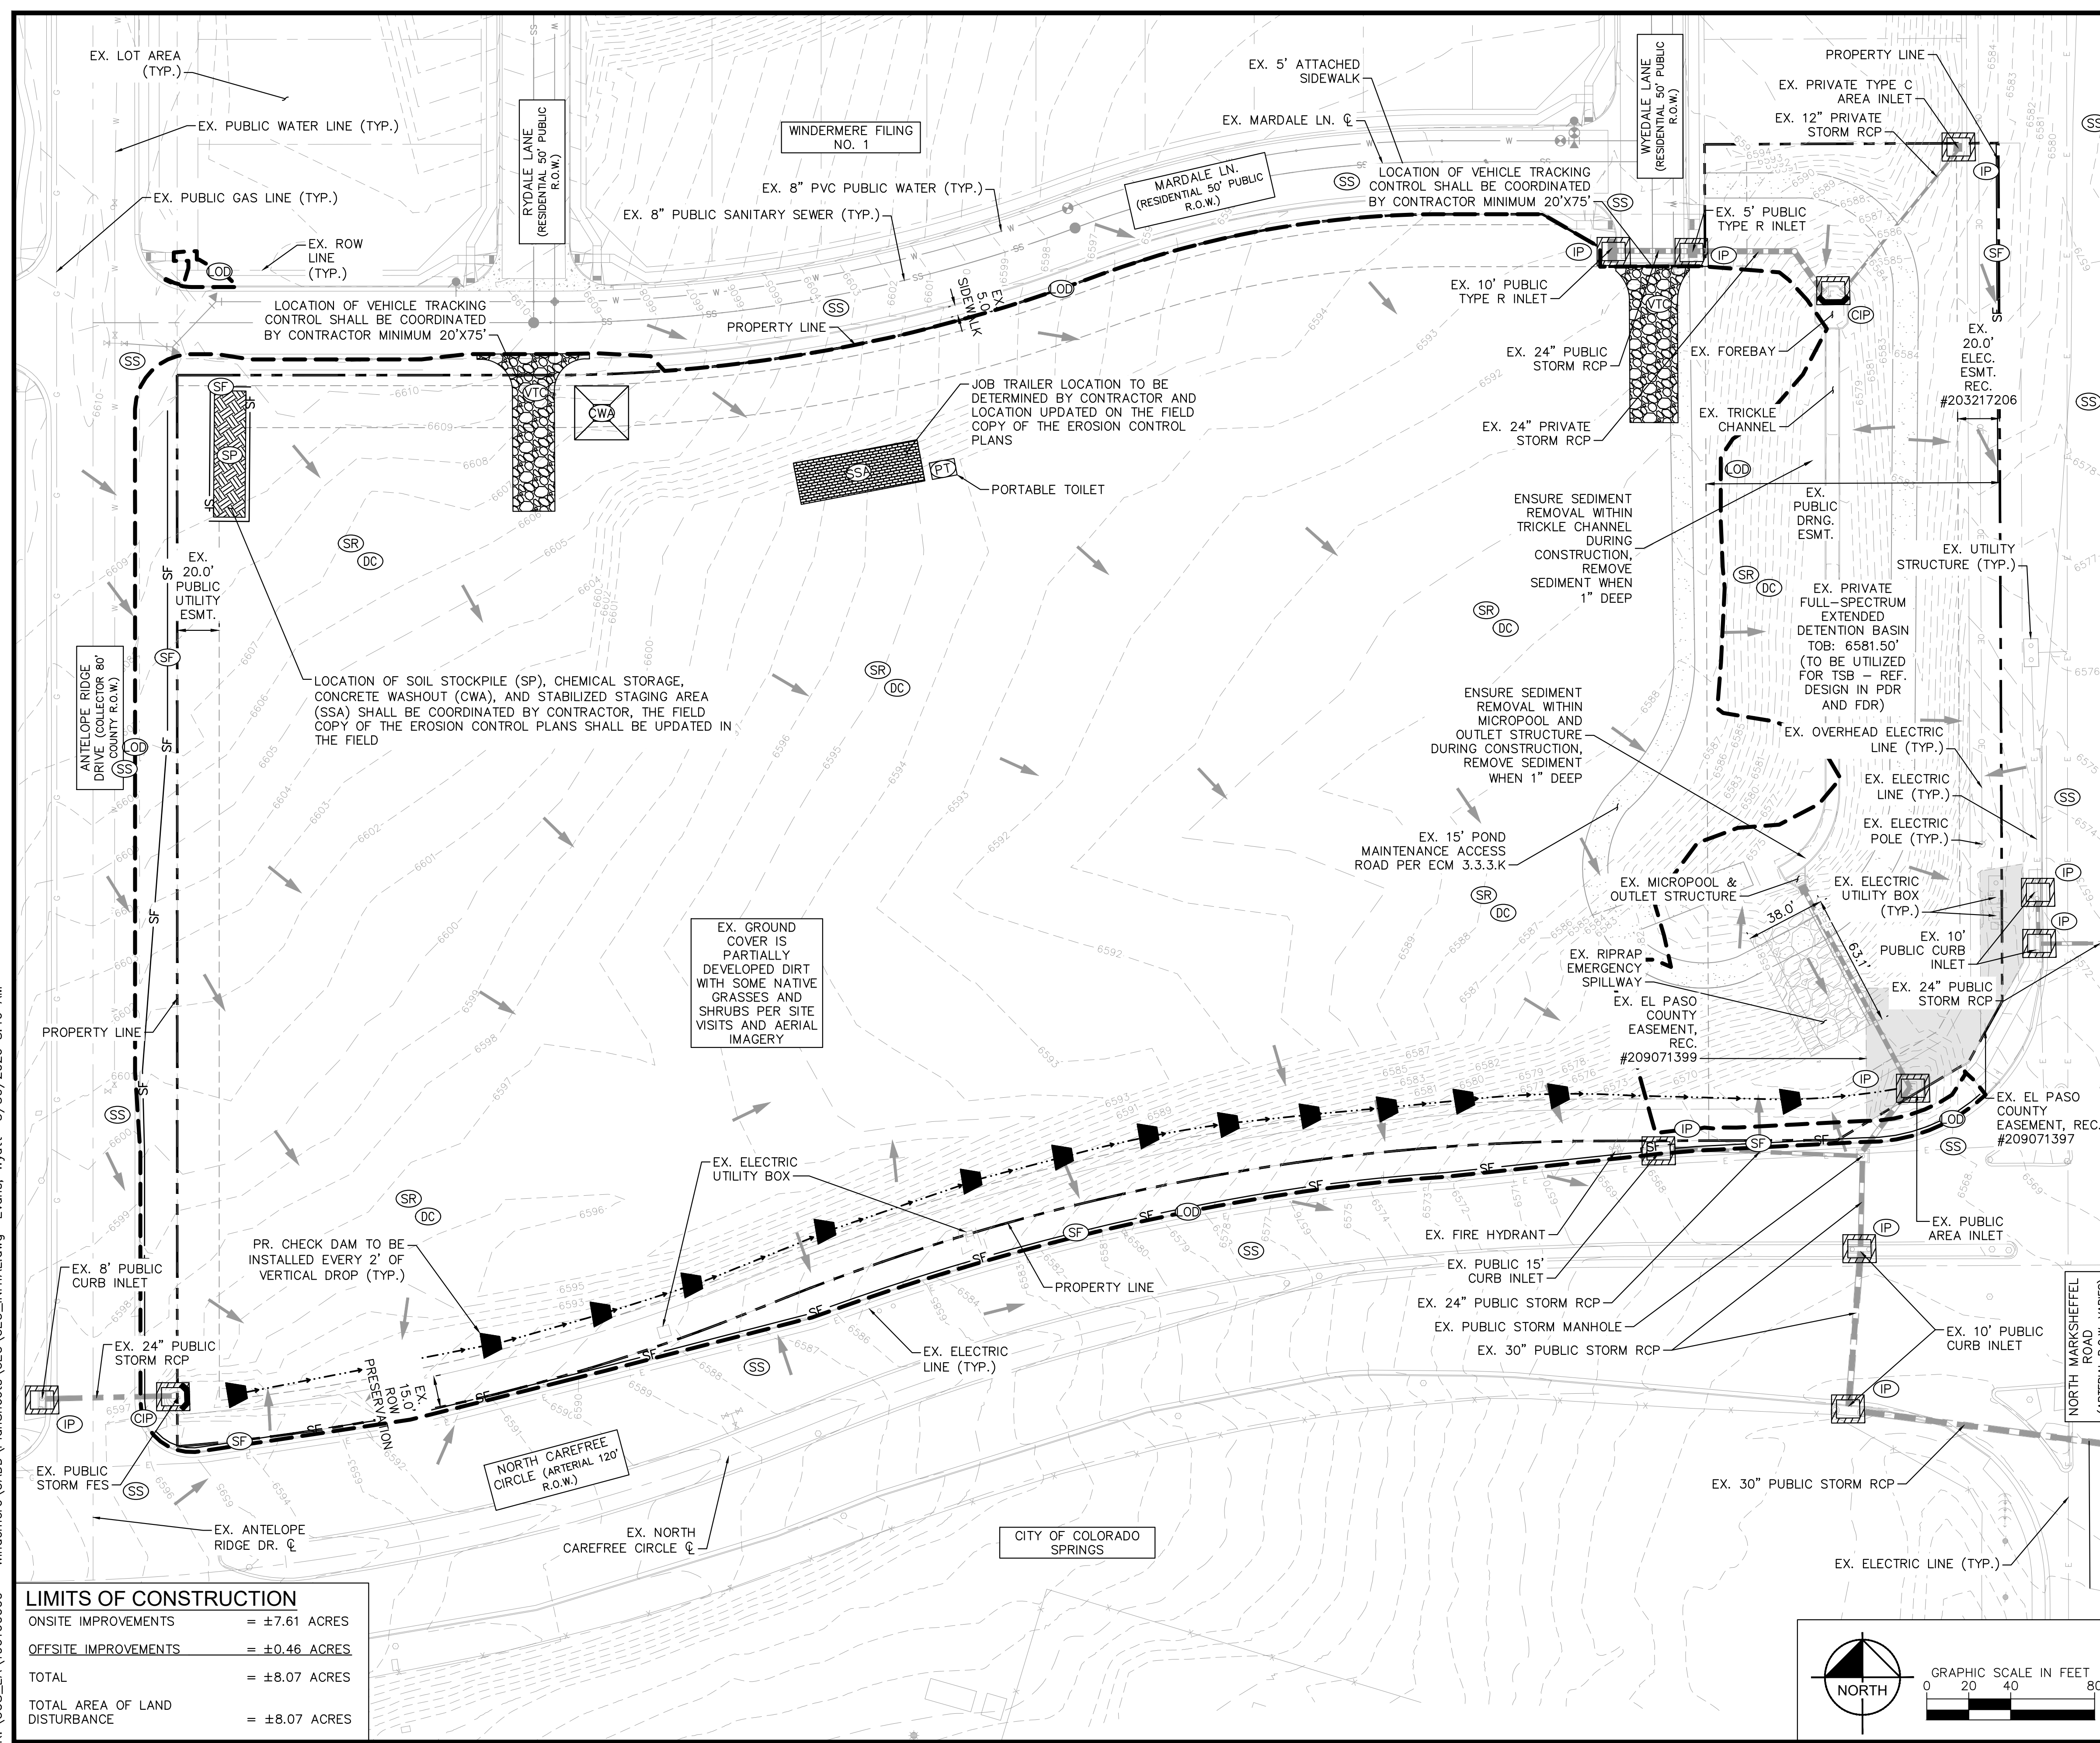


LEGEND

	PROPERTY LINE
	EX. LOT LINE
	EX. EASEMENT LINE
	EXISTING MAJOR CONTOUR
	EXISTING MINOR CONTOUR
	LIMITS OF CONSTRUCTION/ DISTURBANCE
	SILT FENCE
	EXISTING SANITARY SEWER
	EXISTING WATER LINE
	EXISTING STORM SEWER PIPE
	EXISTING GAS LINE
	EXISTING OVERHEAD ELECTRIC LINE
	EXISTING UNDERGROUND ELECTRIC UTILITY
	TEMPORARY DRAINAGE SWELL
	SSA STABILIZED STAGING AREA
	CWA CONCRETE WASHOUT
	VTC VEHICLE TRACKING CONTROL
	SP SOIL STOCKPILE
	SR SURFACE ROUGHENING
	IP INLET PROTECTION
	EXISTING FLOW DIRECTION ARROW
	CIP CULVERT INLET PROTECTION
	SS STREET SWEEPING AND VACUUMING PER UDFCD DETAIL SM-7
	CD CHECK DAM
	DC DUST CONTROL PER UDFCD DETAIL EC-14
	S EX. SPILLWAY/RIPRAP

- ### NOTES
1. THE INTENT OF THIS PLAN IS TO IDENTIFY THE EROSION CONTROL PRACTICES RECOMMENDED. THE CONTRACTOR SHALL REFERENCE ADDITIONAL CONSTRUCTION PLANS FOR DEMOLITION OF EXISTING AND CONSTRUCTION OF PROPOSED IMPROVEMENTS.
 2. ADJACENT STREETS AND SIDEWALK SHALL BE KEPT CLEAN AND FREE OF SEDIMENT AND/OR DEBRIS AT ALL TIMES. CONTRACTOR SHALL PERFORM STREET SWEEPING AT ALL TIMES DURING ACTIVE TRACKING AND AT A MINIMUM ON A DAILY BASIS AT THE END OF EACH CONSTRUCTION DAY.
 3. TEMPORARY STABILIZATION (TS) SHALL BE IMPLEMENTED WITHIN THE DISTURBED PORTIONS OF THE PROJECT SITE NO LATER THAN 14 DAYS FOLLOWING THE CEASE OF CONSTRUCTION ACTIVITIES WITHIN THE DISTURBED AREAS.
 4. PERMANENT STABILIZATION (PS) MAY BE USED WITHIN AREAS OF TEMPORARY STABILIZATION (TS) AT THE CONTRACTOR'S DISCRETION. STABILIZATION SHALL BE APPLIED IN ACCORDANCE WITH APPLICABLE TEMPORARY STABILIZATION SEQUENCING REQUIREMENTS.
 5. CONTRACTOR SHALL UTILIZE ROLLED EROSION CONTROL PRODUCTS ON ALL SLOPES 3H:1V OR GREATER TO ACHIEVE REQUIRED STABILIZATION.
 6. CONTRACTOR SHALL MAINTAIN ACCEPTABLE EROSION CONTROL PRACTICES WITHIN THE ANTICIPATED LIMITS OF CONSTRUCTION IDENTIFIED HEREIN. BEST MANAGEMENT PRACTICES AND STABILIZATION SHALL BE COMPLETED AS IDENTIFIED HEREIN IN ACCORDANCE WITH OWNER REQUIREMENTS.
 7. ALL WORK IN THE NORTH CAREFREE CIRCLE/NORTH MARKSHEFFEL ROAD ROW REQUIRES A ROW PERMIT FROM COLORADO SPRINGS. CONTRACTOR IS RESPONSIBLE FOR APPLYING FOR AND OBTAINING ALL NECESSARY ROW PERMITS. CONTRACTOR SHALL REFER TO THE APPROVED GEOTECHNICAL REPORT FOR OVEREXCAVATION REQUIREMENTS AND ADDITIONAL INFORMATION.
 8. ALL INITIAL BMP'S MUST BE INSTALLED AND A NTP ISSUED PRIOR TO COMMENCEMENT OF ON-SITE GRADING AND CONSTRUCTION ACTIVITIES.
 9. DEMOLITION, REMOVAL AND SOIL TREATMENT SHALL BE IN ACCORDANCE WITH THE GEOTECHNICAL ENGINEER RECOMMENDATIONS AS NOTED IN THE APPROVED PROJECT GEOTECHNICAL REPORT.
 10. CONTRACTOR TO NOTE PROXIMITY OF EXISTING IMPROVEMENTS ADJACENT TO THE SITE AND PROVIDE NECESSARY MEASURES TO PROTECT ALL FACILITIES AND STRUCTURES IN PLACE.
 11. CONTRACTOR SHALL MAINTAIN STABILIZED STAGING AREA (SSA), VEHICLE TRACKING CONTROL (VTC), AND CONCRETE WASHOUT AREA (CWA) AT THE CONSTRUCTION ENTRANCE AT ALL TIMES. CONTRACTOR SHALL UPDATE THE EROSION CONTROL PLAN IN THE FIELD TO INDICATE THE LOCATION OF THE SSA, VTC, AND CWA BMP'S AS EXCAVATION SEQUENCING DICTATES.
 12. CONTRACTOR MAY SUBSTITUTE SEDIMENT CONTROL LOGS (SCL) FOR SILT FENCE (SF) AS PERIMETER CONTROL, DEPENDING UPON SITE CONDITIONS. SCL AND SF MAY BE INTERCHANGED DEPENDING ON SITE CONDITIONS.
 13. CONTRACTOR SHALL OBTAIN R.O.W. PERMITS FOR ANY R.O.W. CLOSURES.
 14. SEE FINAL LANDSCAPING PLAN IN THE DEVELOPMENT PLAN FOR FINAL STABILIZATION MEASURES.
 15. THE CONTRACTOR WILL BE RESPONSIBLE FOR ANY RE-EXCAVATION OF SEDIMENT AND DEBRIS THAT COLLECTS IN THE EXISTING AND BE REQUIRED TO ENSURE THAT THE BASIN MEETS THE DESIGN GRADES FOLLOWING CONSTRUCTION. THE STORM LINES SHALL ALSO BE CLEANED AND FREE OF SEDIMENT ONCE THE SITE BECOMES STABILIZED.

LIMITS OF CONSTRUCTION

ONSITE IMPROVEMENTS	= ±7.61 ACRES
OFFSITE IMPROVEMENTS	= ±0.46 ACRES
TOTAL	= ±8.07 ACRES
TOTAL AREA OF LAND DISTURBANCE	= ±8.07 ACRES

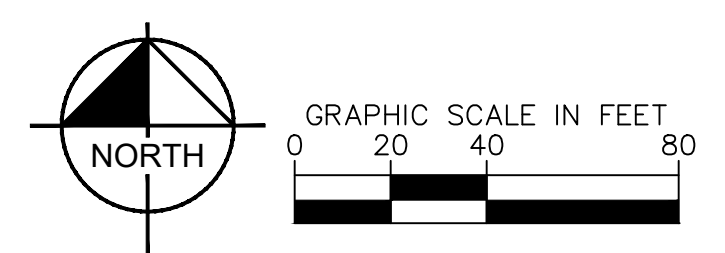

NO.	REVISION	DATE	APPRO

Kimley»Horn
 2026 KIMLEY-HORN AND ASSOCIATES, INC.
 2 North Nevada Avenue, Suite 900
 Colorado Springs, Colorado 80903 (719) 453-0180

DESIGNED BY: NMB
 DRAWN BY: DPM
 CHECKED BY: NMB
 DATE: 03/30/2026


WINDERMERE FILING NO. 2
 GRADING AND EROSION CONTROL PLANS
 EL PASO COUNTY, COLORADO
 INITIAL PLAN

PRELIMINARY
 FOR REVIEW ONLY
 NOT FOR CONSTRUCTION
 Kimley»Horn
 Kimley-Horn and Associates, Inc.

PROJECT NO.
 196160000

SHEET
 C4.1

K:\COS_LA\196160000 - Windmere\CADD\PlanSheets\GEC\GEC_INTERIM.dwg Evans, Wyatt 3/30/2026 8:17 AM

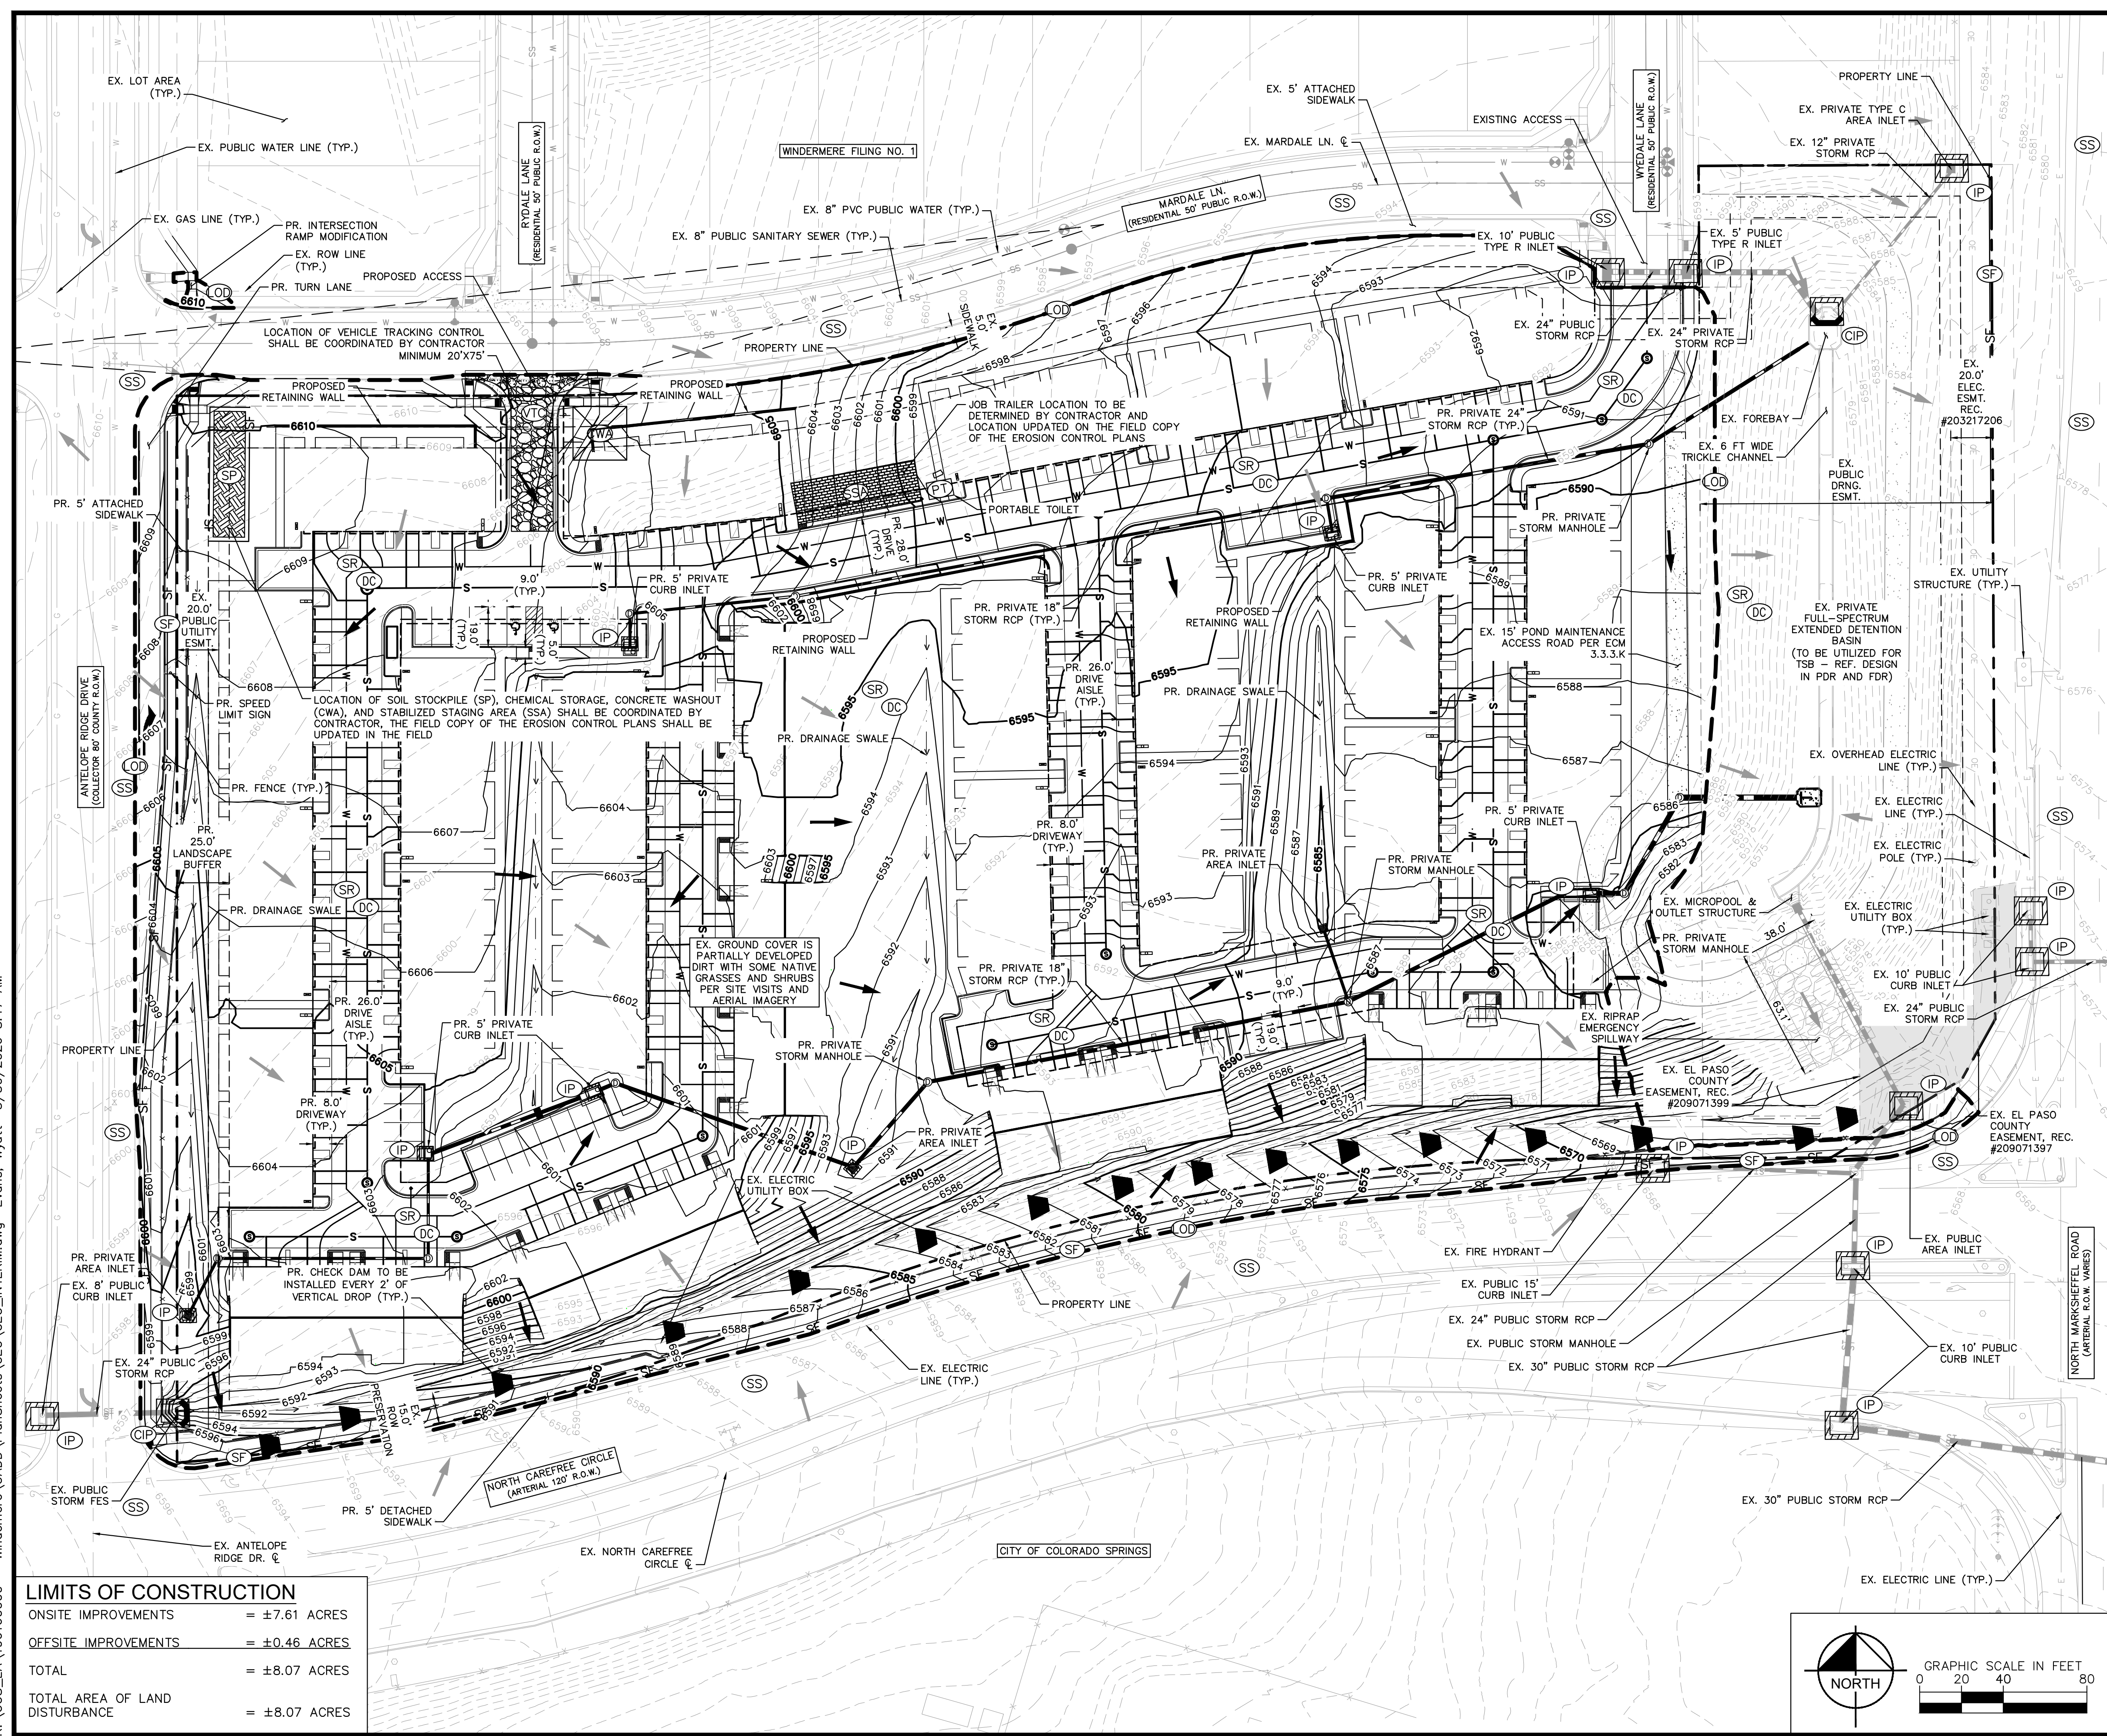


LEGEND

	PROPERTY LINE
	EX. LOT LINE
	EX. EASEMENT LINE
	EXISTING MAJOR CONTOUR
	EXISTING MINOR CONTOUR
	LIMITS OF CONSTRUCTION/DISTURBANCE
	SILT FENCE
	EXISTING SANITARY SEWER
	EXISTING WATER LINE
	EXISTING STORM SEWER PIPE
	EXISTING GAS LINE
	EXISTING OVERHEAD ELECTRIC LINE
	EXISTING UNDERGROUND ELECTRIC UTILITY
	TEMPORARY DRAINAGE SWELL
	STABILIZED STAGING AREA
	CONCRETE WASHOUT
	VEHICLE TRACKING CONTROL
	SOIL STOCKPILE
	SURFACE ROUGHENING
	INLET PROTECTION
	EXISTING FLOW DIRECTION ARROW
	CULVERT INLET PROTECTION
	STREET SWEEPING AND VACUUMING PER UDFCD DETAIL SM-7
	CHECK DAM
	DUST CONTROL PER UDFCD DETAIL EC-14
	EX. SPILLWAY/RIPRAP

- ### NOTES
- THE INTENT OF THIS PLAN IS TO IDENTIFY THE EROSION CONTROL PRACTICES RECOMMENDED. THE CONTRACTOR SHALL REFERENCE ADDITIONAL CONSTRUCTION PLANS FOR DEMOLITION OF EXISTING AND CONSTRUCTION OF PROPOSED IMPROVEMENTS.
 - ADJACENT STREETS AND SIDEWALK SHALL BE KEPT CLEAN AND FREE OF SEDIMENT AND/OR DEBRIS AT ALL TIMES. CONTRACTOR SHALL PERFORM STREET SWEEPING AT ALL TIMES DURING ACTIVE TRACKING AND AT A MINIMUM ON A DAILY BASIS AT THE END OF EACH CONSTRUCTION DAY.
 - TEMPORARY STABILIZATION (TS) SHALL BE IMPLEMENTED WITHIN THE DISTURBED PORTIONS OF THE PROJECT SITE NO LATER THAN 14 DAYS FOLLOWING THE CEASE OF CONSTRUCTION ACTIVITIES WITHIN THE DISTURBED AREAS.
 - PERMANENT STABILIZATION (PS) MAY BE USED WITHIN AREAS OF TEMPORARY STABILIZATION (TS) AT THE CONTRACTOR'S DISCRETION. STABILIZATION SHALL BE APPLIED IN ACCORDANCE WITH APPLICABLE TEMPORARY STABILIZATION SEQUENCING REQUIREMENTS.
 - CONTRACTOR SHALL UTILIZE ROLLED EROSION CONTROL PRODUCTS ON ALL SLOPES 3H:1V OR GREATER TO ACHIEVE REQUIRED STABILIZATION.
 - CONTRACTOR SHALL MAINTAIN ACCEPTABLE EROSION CONTROL PRACTICES WITHIN THE ANTICIPATED LIMITS OF CONSTRUCTION IDENTIFIED HEREIN. BEST MANAGEMENT PRACTICES AND STABILIZATION SHALL BE COMPLETED AS IDENTIFIED HEREIN IN ACCORDANCE WITH OWNER REQUIREMENTS.
 - ALL WORK IN THE NORTH CAREFREE CIRCLE/NORTH MARKSHEFFEL RD ROW REQUIRES A ROW PERMIT FROM COLORADO SPRINGS. CONTRACTOR IS RESPONSIBLE FOR APPLYING FOR AND OBTAINING ALL NECESSARY ROW PERMITS.
 - CONTRACTOR SHALL REFER TO THE APPROVED GEOTECHNICAL REPORT FOR OVEREXCAVATION REQUIREMENTS AND ADDITIONAL INFORMATION.
 - SILT FENCE TO BE INSTALLED PRIOR TO COMMENCEMENT OF ON-SITE GRADING AND CONSTRUCTION ACTIVITIES.
 - DEMOLITION, REMOVAL AND SOIL TREATMENT SHALL BE IN ACCORDANCE WITH THE GEOTECHNICAL ENGINEER RECOMMENDATIONS AS NOTED IN THE APPROVED PROJECT GEOTECHNICAL REPORT.
 - CONTRACTOR TO NOTE PROXIMITY OF EXISTING IMPROVEMENTS ADJACENT TO THE SITE AND PROVIDE NECESSARY MEASURES TO PROTECT ALL FACILITIES AND STRUCTURES IN PLACE.
 - CONTRACTOR SHALL MAINTAIN STABILIZED STAGING AREA (SSA), VEHICLE TRACKING CONTROL (VTC), AND CONCRETE WASHOUT AREA (CWA) AT THE CONSTRUCTION ENTRANCE AT ALL TIMES. CONTRACTOR SHALL UPDATE THE EROSION CONTROL PLAN IN THE FIELD TO INDICATE THE LOCATION OF THE SSA, VTC, AND CWA Bmps AS EXCAVATION SEQUENCING DICTATES.
 - CONTRACTOR MAY SUBSTITUTE SEDIMENT CONTROL LOGS (SCL) FOR SILT FENCE (SF) AS PERMETER CONTROL, DEPENDING UPON SITE CONDITIONS. SCL, AND SF MAY BE INTERCHANGED DEPENDING ON SITE CONDITIONS. CONTRACTOR SHALL OBTAIN R.O.W. PERMITS FOR ANY R.O.W. CLOSURES.
 - SEE FINAL LANDSCAPING PLAN IN THE DEVELOPMENT PLAN FOR FINAL STABILIZATION MEASURES.

LIMITS OF CONSTRUCTION

ONSITE IMPROVEMENTS	= ±7.61 ACRES
OFFSITE IMPROVEMENTS	= ±0.46 ACRES
TOTAL	= ±8.07 ACRES
TOTAL AREA OF LAND DISTURBANCE	= ±8.07 ACRES

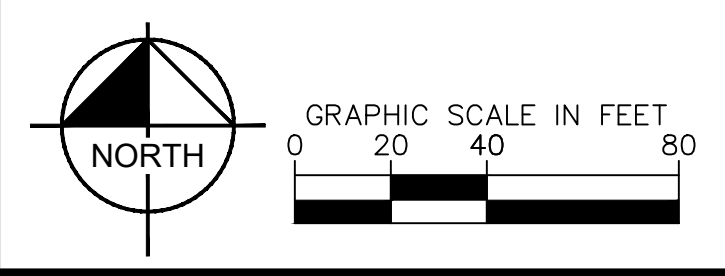

NO.	REVISION	DATE	APPR

Kimley»Horn
2026 KIMLEY-HORN AND ASSOCIATES, INC.
2 North Nevada Avenue, Suite 900
Colorado Springs, Colorado 80903 (719) 453-0180

DESIGNED BY: NMB
DRAWN BY: DPM
CHECKED BY: NMB
DATE: 03/30/2026


WINDMERE FILING NO. 2
GRADING AND EROSION CONTROL PLANS
EL PASO COUNTY, COLORADO
INTERIM PLAN

PRELIMINARY
FOR REVIEW ONLY
NOT FOR CONSTRUCTION

PROJECT NO.
196160000

SHEET
C4.2

K:\COS_LA\196160000 - Windermere\CADD\PlanSheets\GEC\GEC_FINAL.dwg Evans, Wyatt 3/30/2026 8:17 AM

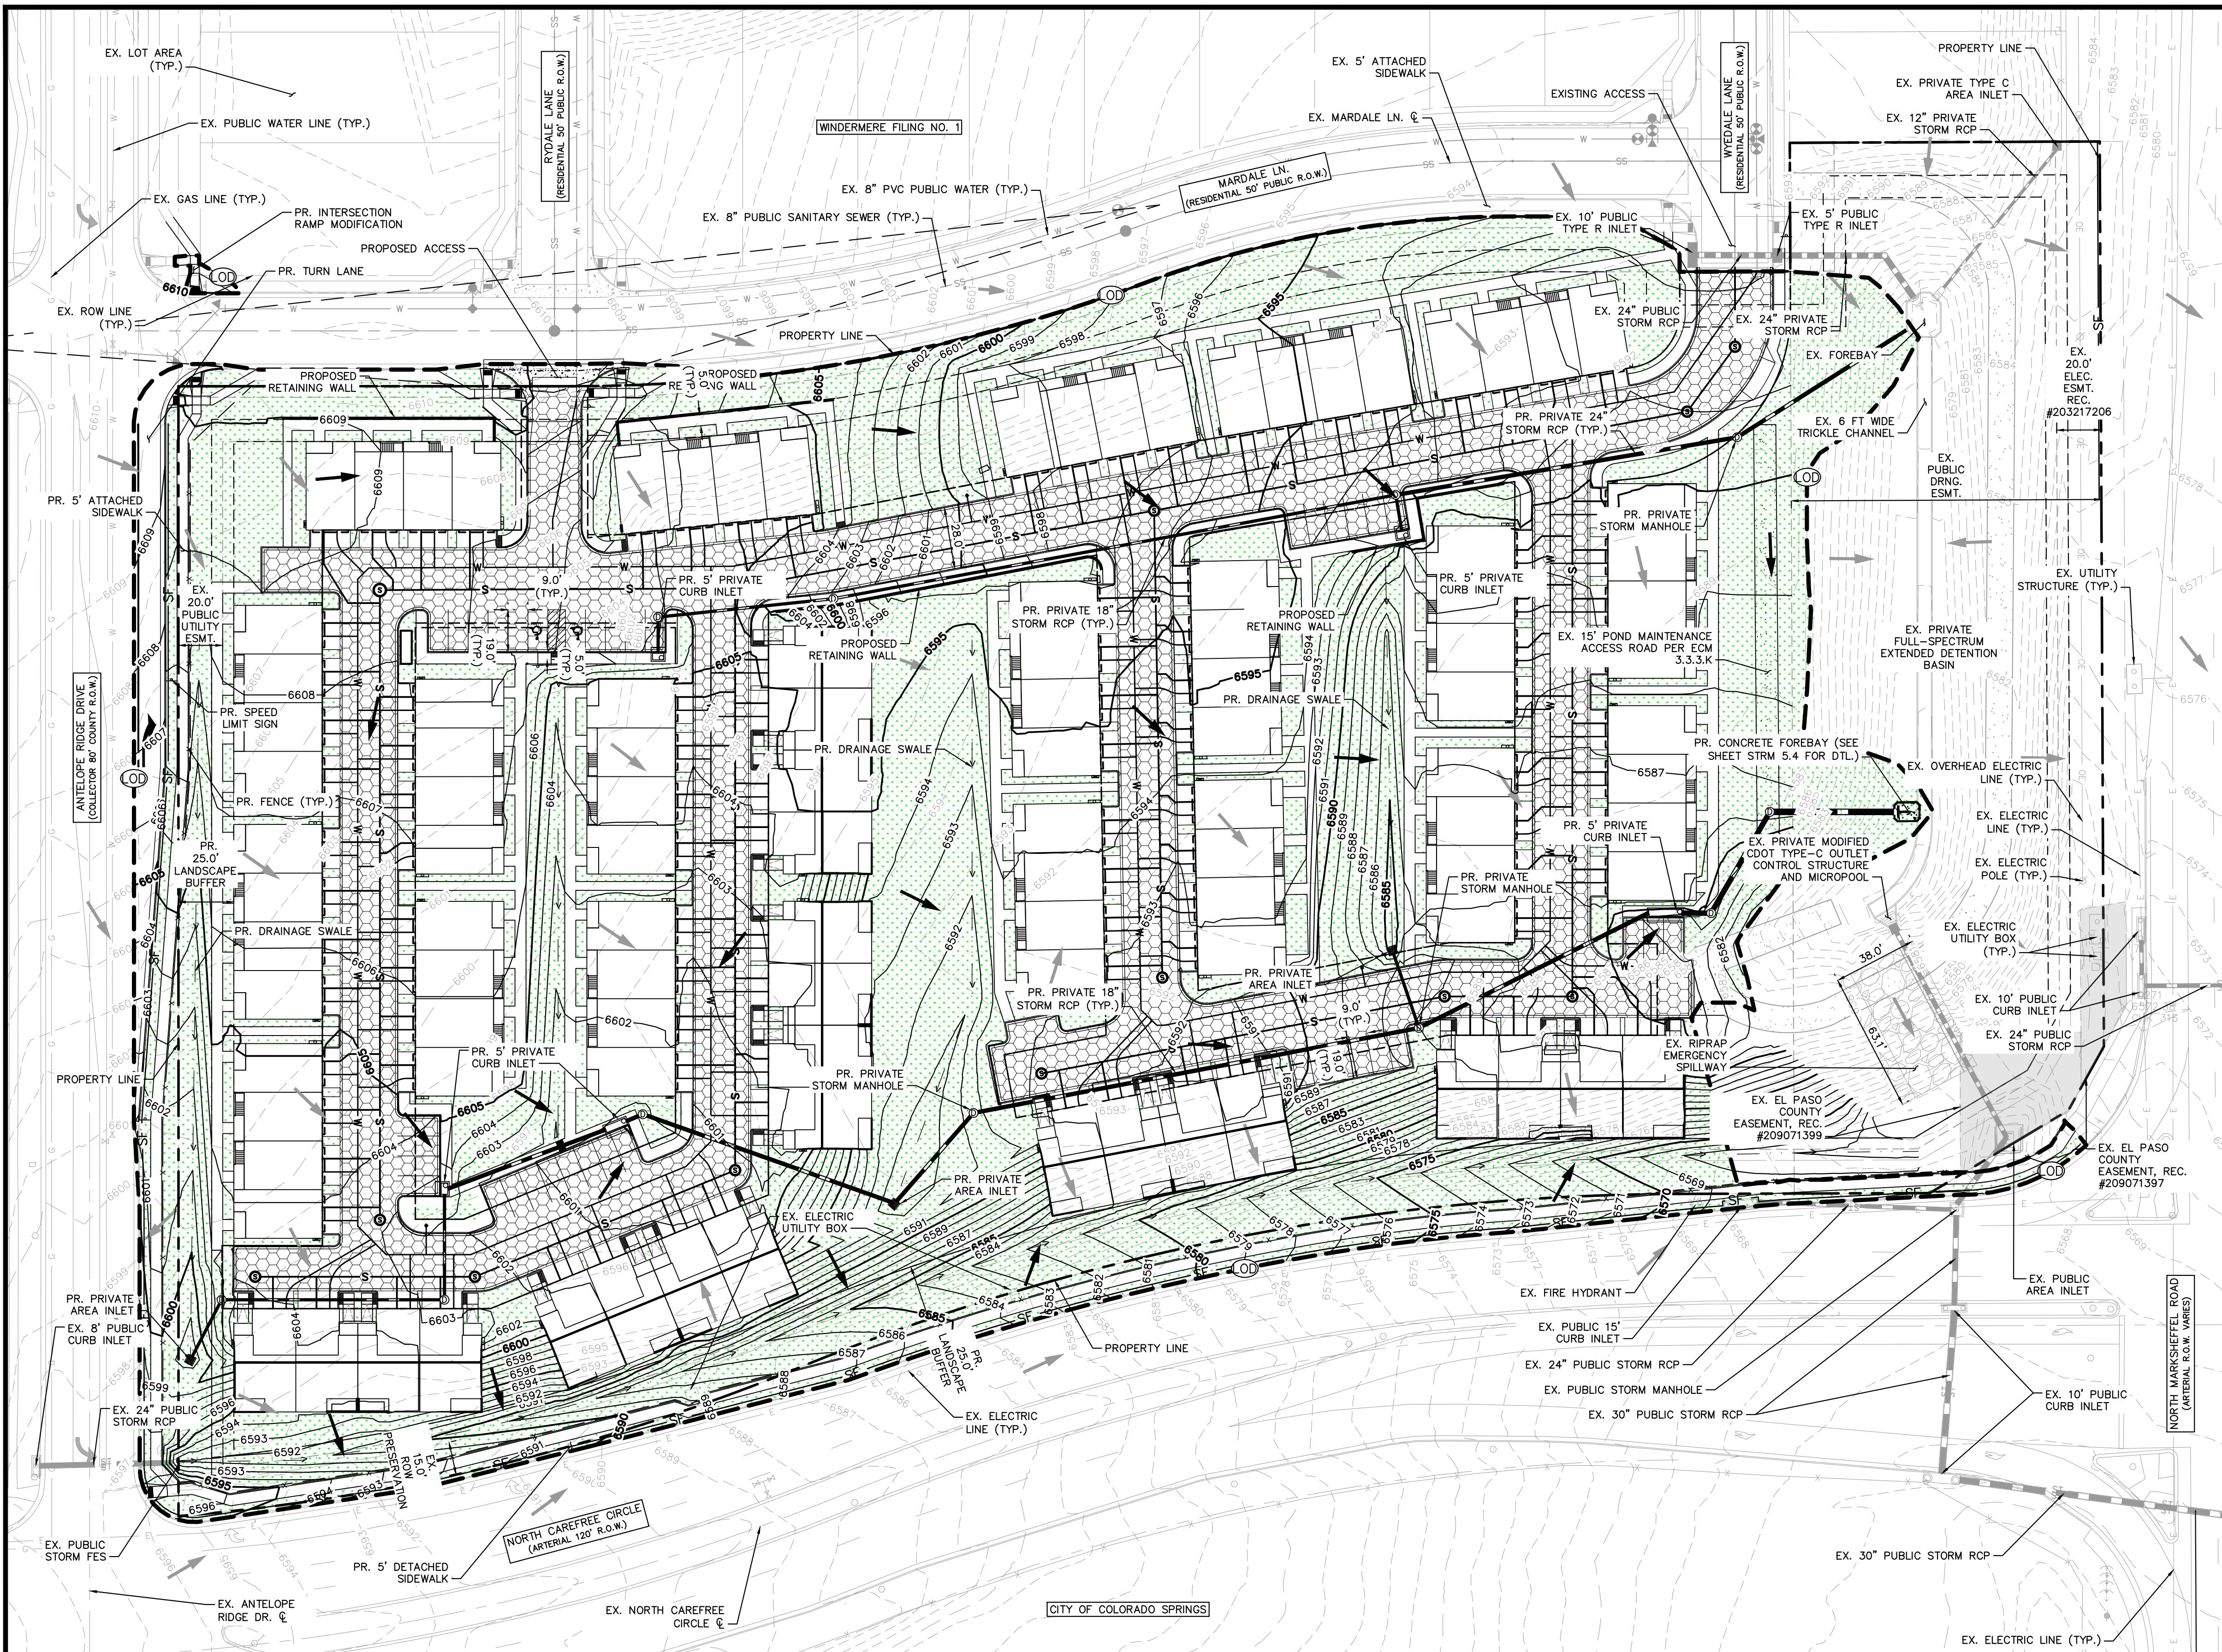

LEGEND

	PROPERTY LINE
	EX. LOT LINE
	EX. EASEMENT LINE
	EXISTING MAJOR CONTOUR
	EXISTING MINOR CONTOUR
	LIMITS OF CONSTRUCTION/DISTURBANCE
	SILT FENCE
	EXISTING SANITARY SEWER
	EXISTING WATER LINE
	EXISTING STORM SEWER PIPE
	EXISTING GAS LINE
	EXISTING OVERHEAD ELECTRIC LINE
	EXISTING UNDERGROUND ELECTRIC UTILITY
	PR. STORM PIPE
	PR. WATER LINE
	PR. SANITARY SEWER LINE
	PR. ASPHALT
	EXISTING FLOW DIRECTION ARROW
	PROPOSED FLOW DIRECTION ARROW
	EX. SPILLWAY/RIPRAP

- ### NOTES
1. THE INTENT OF THIS PLAN IS TO IDENTIFY THE EROSION CONTROL PRACTICES RECOMMENDED. THE CONTRACTOR SHALL REFERENCE ADDITIONAL CONSTRUCTION PLANS FOR DEMOLITION OF EXISTING AND CONSTRUCTION OF PROPOSED IMPROVEMENTS.
 2. ADJACENT STREETS AND SIDEWALK SHALL BE KEPT CLEAN AND FREE OF SEDIMENT AND/OR DEBRIS AT ALL TIMES. CONTRACTOR SHALL PERFORM STREET SWEEPING AT ALL TIMES DURING ACTIVE TRACKING AND AT A MINIMUM ON A DAILY BASIS AT THE END OF EACH CONSTRUCTION DAY.
 3. TEMPORARY STABILIZATION (TS) SHALL BE IMPLEMENTED WITHIN THE DISTURBED PORTIONS OF THE PROJECT SITE NO LATER THAN 14 DAYS FOLLOWING THE CEASE OF CONSTRUCTION ACTIVITIES WITHIN THE DISTURBED AREAS.
 4. PERMANENT STABILIZATION (PS) MAY BE USED WITHIN AREAS OF TEMPORARY STABILIZATION (TS) AT THE CONTRACTOR'S DISCRETION. STABILIZATION SHALL BE APPLIED IN ACCORDANCE WITH APPLICABLE TEMPORARY STABILIZATION SEQUENCING REQUIREMENTS.
 5. CONTRACTOR SHALL UTILIZE ROLLED EROSION CONTROL PRODUCTS ON ALL SLOPES 3H:1V OR GREATER TO ACHIEVE REQUIRED STABILIZATION.
 6. CONTRACTOR SHALL MAINTAIN ACCEPTABLE EROSION CONTROL PRACTICES WITHIN THE ANTICIPATED LIMITS OF CONSTRUCTION IDENTIFIED HEREIN. BEST MANAGEMENT PRACTICES AND STABILIZATION SHALL BE COMPLETED AS IDENTIFIED HEREIN IN ACCORDANCE WITH OWNER REQUIREMENTS.
 7. ALL WORK IN THE NORTH CAREFREE CIRCLE/NORTH MARKSHEFFEL RD ROW REQUIRES A ROW PERMIT FROM COLORADO SPRINGS. CONTRACTOR IS RESPONSIBLE FOR APPLYING FOR AND OBTAINING ALL NECESSARY ROW PERMITS.
 8. CONTRACTOR SHALL REFER TO THE APPROVED GEOTECHNICAL REPORT FOR OVEREXCAVATION REQUIREMENTS AND ADDITIONAL INFORMATION.
 9. SILT FENCE TO BE INSTALLED PRIOR TO COMMENCEMENT OF ONSITE GRADING AND CONSTRUCTION ACTIVITIES.
 10. DEMOLITION, REMOVAL AND SOIL TREATMENT SHALL BE IN ACCORDANCE WITH THE GEOTECHNICAL ENGINEER RECOMMENDATIONS AS NOTED IN THE APPROVED PROJECT GEOTECHNICAL REPORT.
 11. CONTRACTOR TO NOTE PROXIMITY OF EXISTING IMPROVEMENTS ADJACENT TO THE SITE AND PROVIDE NECESSARY MEASURES TO PROTECT ALL FACILITIES AND STRUCTURES IN PLACE.
 12. CONTRACTOR SHALL MAINTAIN STABILIZED STAGING AREA (SSA), VEHICLE TRACKING CONTROL (VTC), AND CONCRETE WASHOUT AREA (CWA) AT THE CONSTRUCTION ENTRANCE AT ALL TIMES. CONTRACTOR SHALL UPDATE THE EROSION CONTROL PLAN IN THE FIELD TO INDICATE THE LOCATION OF THE SSA, VTC, AND CWA BMPs AS EXCAVATION SEQUENCING DICTATES.
 13. CONTRACTOR MAY SUBSTITUTE SEDIMENT CONTROL LOGS (SCL) FOR SILT FENCE (SF) AS PERMETER CONTROL, DEPENDING UPON SITE CONDITIONS. SCL AND SF MAY BE INTERCHANGED DEPENDING ON SITE CONDITIONS.
 14. CONTRACTOR SHALL OBTAIN R.O.W. PERMITS FOR ANY R.O.W. CLOSURES.
 15. SEE FINAL LANDSCAPING PLAN IN THE DEVELOPMENT PLAN FOR FINAL STABILIZATION MEASURES.

LIMITS OF CONSTRUCTION

ONSITE IMPROVEMENTS	= ±7.81 ACRES
OFFSITE IMPROVEMENTS	= ±0.46 ACRES
TOTAL	= ±8.27 ACRES
TOTAL AREA OF LAND DISTURBANCE	= ±8.27 ACRES


	PR. PAVED ASPHALT
	PR. SEEDING & MULCHING (FINAL STABILIZATION)
	PR. GRAVEL

NORTH

GRAPHIC SCALE IN FEET
0 20 40 80

<h2 style="margin: 0;">Kimley»Horn</h2> <p style="font-size: 8px; margin: 0;">2026 KIMLEY-HORN AND ASSOCIATES, INC. 2 North Nevada Avenue, Suite 900 Colorado Springs, Colorado 80903 (719) 453-0180</p>	<p style="font-size: 10px; margin: 0;">DESIGNED BY: NMB DRAWN BY: DPM CHECKED BY: NMB DATE: 03/30/2026</p>
<h3 style="margin: 0;">WINDERMERE FILING NO. 2</h3> <p style="font-size: 8px; margin: 0;">GRADING AND EROSION CONTROL PLANS EL PASO COUNTY, COLORADO FINAL PLAN</p>	
<p style="font-size: 8px; margin: 0;">PRELIMINARY FOR REVIEW ONLY NOT FOR CONSTRUCTION</p> <p style="font-size: 8px; margin: 0;">Kimley-Horn and Associates, Inc.</p>	
<p style="font-size: 8px; margin: 0;">PROJECT NO. 196160000</p> <p style="font-size: 8px; margin: 0;">SHEET</p> <p style="font-size: 12px; margin: 0;">C4.3</p>	

K:\COS_LA\196160000 - Windermere\CADD\PlanSheets\GEC\GEC_CF.dwg Evans, Wyatt 3/30/2026 8:17 AM

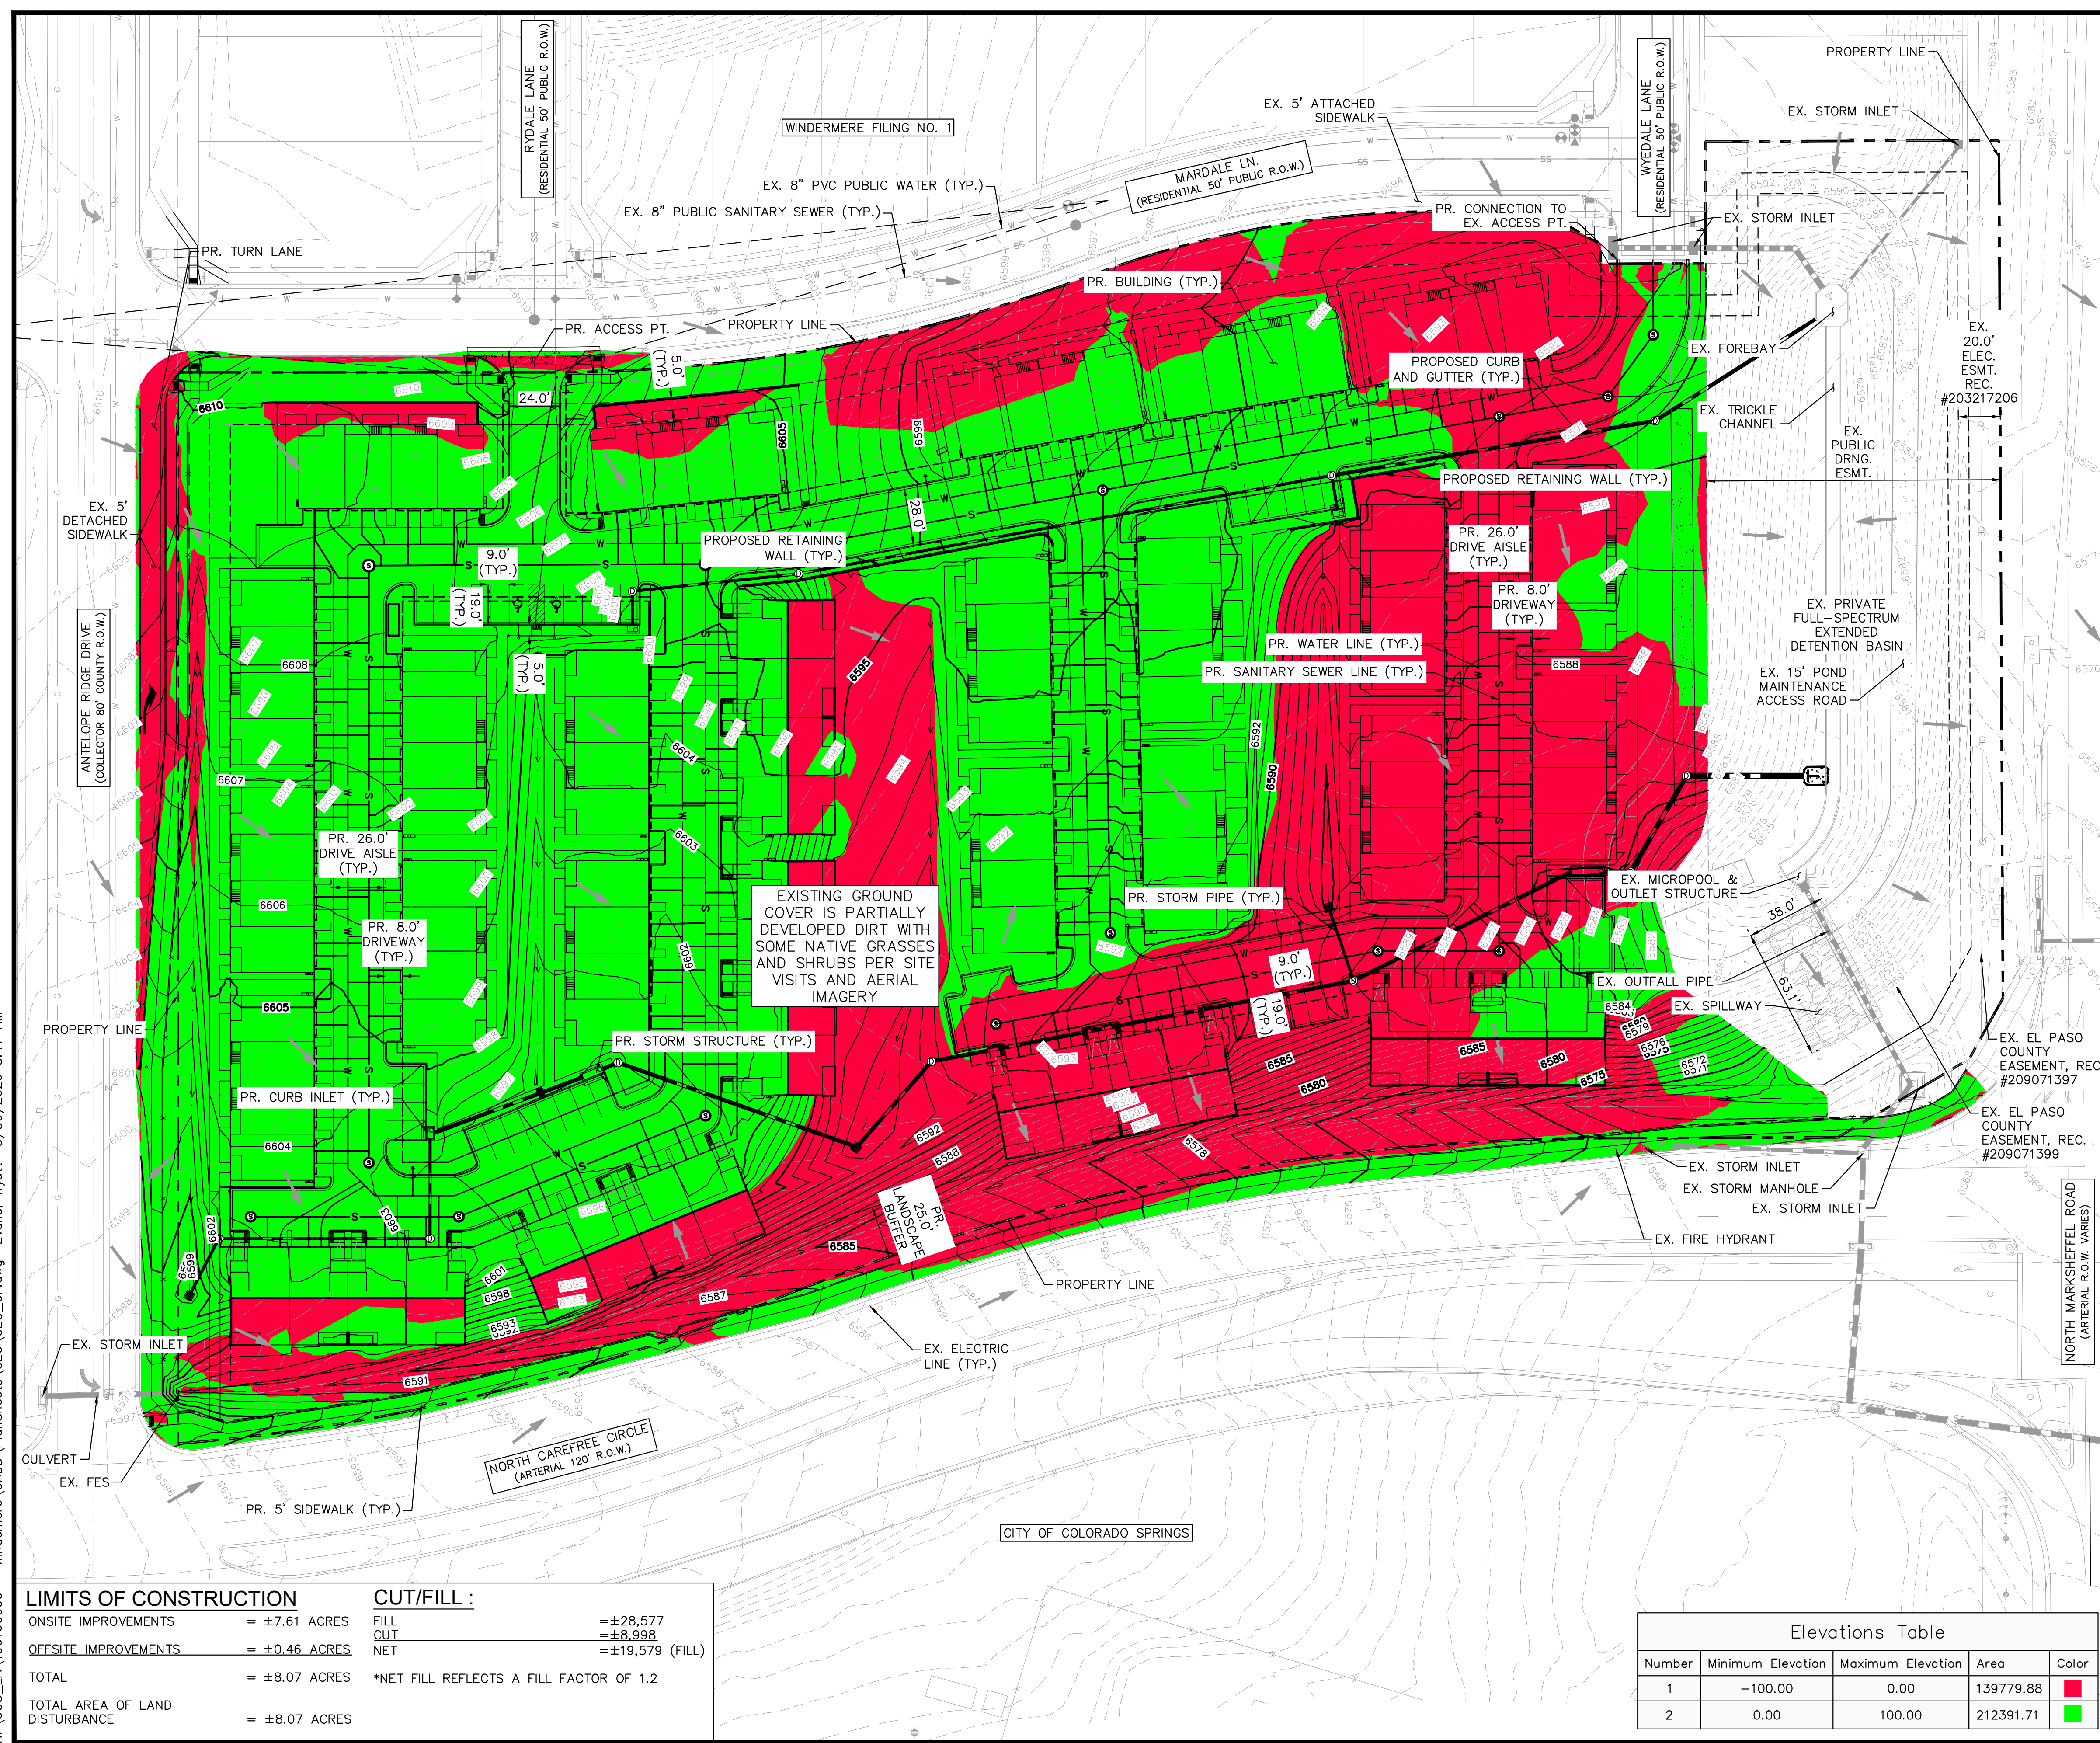

LEGEND

	PROPERTY LINE
	EX. LOT LINE
	EX. EASEMENT LINE
	EXISTING MAJOR CONTOUR
	EXISTING MINOR CONTOUR
	EXISTING SANITARY SEWER
	EXISTING WATER LINE
	EXISTING STORM SEWER PIPE
	EXISTING GAS LINE
	EXISTING OVERHEAD ELECTRIC LINE
	EXISTING UNDERGROUND ELECTRIC UTILITY
	PR. STORM PIPE
	PR. WATER LINE
	PR. SANITARY SEWER LINE
	EXISTING FLOW DIRECTION ARROW
	PROPOSED FLOW DIRECTION ARROW
	EX. SPILLWAY/RIPRAP

- ### NOTES
- THE INTENT OF THIS PLAN IS TO IDENTIFY THE EROSION CONTROL PRACTICES RECOMMENDED. THE CONTRACTOR SHALL REFERENCE ADDITIONAL CONSTRUCTION PLANS FOR DEMOLITION OF EXISTING AND CONSTRUCTION OF PROPOSED IMPROVEMENTS.
 - ADJACENT STREETS AND SIDEWALK SHALL BE KEPT CLEAN AND FREE OF SEDIMENT AND/OR DEBRIS AT ALL TIMES. CONTRACTOR SHALL PERFORM STREET SWEEPING AT ALL TIMES DURING ACTIVE TRACKING AND AT A MINIMUM ON A DAILY BASIS AT THE END OF EACH CONSTRUCTION DAY.
 - TEMPORARY STABILIZATION (TS) SHALL BE IMPLEMENTED WITHIN THE DISTURBED PORTIONS OF THE PROJECT SITE NO LATER THAN 14 DAYS FOLLOWING THE CEASE OF CONSTRUCTION ACTIVITIES WITHIN THE DISTURBED AREAS.
 - PERMANENT STABILIZATION (PS) MAY BE USED WITHIN AREAS OF TEMPORARY STABILIZATION (TS) AT THE CONTRACTOR'S DISCRETION. STABILIZATION SHALL BE APPLIED IN ACCORDANCE WITH APPLICABLE TEMPORARY STABILIZATION SEQUENCING REQUIREMENTS.
 - CONTRACTOR SHALL UTILIZE ROLLED EROSION CONTROL PRODUCTS ON ALL SLOPES 3H:1V OR GREATER TO ACHIEVE REQUIRED STABILIZATION.
 - CONTRACTOR SHALL MAINTAIN ACCEPTABLE EROSION CONTROL PRACTICES WITHIN THE ANTICIPATED LIMITS OF CONSTRUCTION IDENTIFIED HEREIN. BEST MANAGEMENT PRACTICES AND STABILIZATION SHALL BE COMPLETED AS IDENTIFIED HEREIN IN ACCORDANCE WITH OWNER REQUIREMENTS.
 - ALL WORK IN THE NORTH CAREFREE CIRCLE/NORTH MARKSHEFFEL RD ROW REQUIRES A ROW PERMIT FROM COLORADO SPRINGS. CONTRACTOR IS RESPONSIBLE FOR APPLYING FOR AND OBTAINING ALL NECESSARY ROW PERMITS.
 - CONTRACTOR SHALL REFER TO THE APPROVED GEOTECHNICAL REPORT FOR OVEREXCAVATION REQUIREMENTS AND ADDITIONAL INFORMATION.
 - SILT FENCE TO BE INSTALLED PRIOR TO COMMENCEMENT OF ONSITE GRADING AND CONSTRUCTION ACTIVITIES.
 - DEMOLITION, REMOVAL AND SOIL TREATMENT SHALL BE IN ACCORDANCE WITH THE GEOTECHNICAL ENGINEER RECOMMENDATIONS AS NOTED IN THE APPROVED PROJECT GEOTECHNICAL REPORT.
 - CONTRACTOR TO NOTE PROXIMITY OF EXISTING IMPROVEMENTS ADJACENT TO THE SITE AND PROVIDE NECESSARY MEASURES TO PROTECT ALL FACILITIES AND STRUCTURES IN PLACE.
 - CONTRACTOR SHALL MAINTAIN STABILIZED STAGING AREA (SSA), VEHICLE TRACKING CONTROL (VTC), AND CONCRETE WASHOUT AREA (CWA) AT THE CONSTRUCTION ENTRANCE AT ALL TIMES. CONTRACTOR SHALL UPDATE THE EROSION CONTROL PLAN IN THE FIELD TO INDICATE THE LOCATION OF THE SSA, VTC, AND CWA Bmps AS EXCAVATION SEQUENCING DICTATES.
 - CONTRACTOR MAY SUBSTITUTE SEDIMENT CONTROL LOGS (SCL) FOR SILT FENCE (SF) AS PERMETER CONTROL, DEPENDING UPON SITE CONDITIONS. SCL, AND SF MAY BE INTERCHANGED DEPENDING ON SITE CONDITIONS.
 - CONTRACTOR SHALL OBTAIN R.O.W. PERMITS FOR ANY R.O.W. CLOSURES.
 - SEE FINAL LANDSCAPING PLAN IN THE DEVELOPMENT PLAN FOR FINAL STABILIZATION MEASURES.

LIMITS OF CONSTRUCTION

ONSITE IMPROVEMENTS	= ±7.61 ACRES
OFFSITE IMPROVEMENTS	= ±0.46 ACRES
TOTAL	= ±8.07 ACRES
TOTAL AREA OF LAND DISTURBANCE	= ±8.07 ACRES

CUT/FILL :

FILL	=±28,577
CUT	=±8,998
NET	=±19,579 (FILL)

*NET FILL REFLECTS A FILL FACTOR OF 1.2

Elevations Table

Number	Minimum Elevation	Maximum Elevation	Area	Color
1	-100.00	0.00	139779.88	Red
2	0.00	100.00	212391.71	Green

<h1 style="margin: 0;">Kimley»Horn</h1> <p style="font-size: 8px; margin: 0;">2026 KIMLEY-HORN AND ASSOCIATES, INC. 2 North Nevada Avenue, Suite 900 Colorado Springs, Colorado 80903 (719) 453-0180</p>	<p style="font-size: 8px; margin: 0;">DESIGNED BY: NMB DRAWN BY: DPM CHECKED BY: NMB DATE: 03/30/2026</p>
<h2 style="margin: 0;">WINDERMERE FILING NO. 2</h2> <p style="font-size: 8px; margin: 0;">GRADING AND EROSION CONTROL PLANS EL PASO COUNTY, COLORADO CUT & FILL PLAN</p>	
<p style="font-size: 8px; margin: 0;">PRELIMINARY FOR REVIEW ONLY NOT FOR CONSTRUCTION</p> <p style="font-size: 8px; margin: 0;">Kimley»Horn Kimley-Horn and Associates, Inc.</p>	
<p style="font-size: 8px; margin: 0;">PROJECT NO. 196160000</p> <p style="font-size: 8px; margin: 0;">SHEET</p> <p style="font-size: 12px; margin: 0;">C4.4</p>	

K:\COS_LA\196160000 - Windermere\CADD\PlanSheets\GEC\GEC_DTL--void.dwg Evans, Wyatt 3/30/2026 8:43 AM

Stabilized Staging Area (SSA)

SM-6

Description

A stabilized staging area is a clearly designated area where construction equipment and vehicles, stockpiles, waste bins, and other construction-related materials are stored. The contractor office trailer may also be located in this area. Depending on the size of the construction site, more than one staging area may be necessary.



Photograph SSA-1. Example of a staging area with a gravel surface to prevent mud tracking and reduce runoff. Photo courtesy of Douglas County.

Appropriate Uses

Most construction sites will require a staging area, which should be clearly designated in SWMP drawings. The layout of the staging area may vary depending on the type of construction activity. Staging areas located in roadways due to space constraints require special measures to avoid materials being washed into storm inlets.

Design and Installation

Stabilized staging areas should be completed prior to other construction activities beginning on the site. Major components of a stabilized staging area include:

- Appropriate space to contain storage and provide for loading/unloading operations, as well as parking if necessary.
- A stabilized surface, either paved or covered, with 3-inch diameter aggregate or larger.
- Perimeter controls such as silt fence, sediment control logs, or other measures.
- Construction fencing to prevent unauthorized access to construction materials.
- Provisions for Good Housekeeping practices related to materials storage and disposal, as described in the Good Housekeeping BMP Fact Sheet.
- A stabilized construction entrance/exit, as described in the Vehicle Tracking Control BMP Fact Sheet, to accommodate traffic associated with material delivery and waste disposal vehicles.

Over-sizing the stabilized staging area may result in disturbance of existing vegetation in excess of that required for the project. This increases costs, as well as requirements for long-term stabilization following the construction period. When designing the stabilized staging area, minimize the area of disturbance to the extent practical.

Stabilized Staging Area	
Erosion Control	Yes
Sediment Control	Moderate
Site/Material	Yes

November 2010 Urban Drainage and Flood Control District SSA-1
Urban Storm Drainage Criteria Manual Volume 3

SM-6 Stabilized Staging Area (SSA)

Minimizing Long-Term Stabilization Requirements

- Utilize off-site parking and restrict vehicle access to the site.
- Use construction mats in lieu of rock when staging is provided in an area that will not be disturbed otherwise.
- Consider use of a bermed contained area for materials and equipment that do not require a stabilized surface.
- Consider phasing of staging areas to avoid disturbance in an area that will not be otherwise disturbed.

See Detail SSA-1 for a typical stabilized staging area and SSA-2 for a stabilized staging area when materials staging in roadways is required.

Maintenance and Removal


Maintenance of stabilized staging areas includes maintaining a stable surface cover of gravel, repairing perimeter controls, and following good housekeeping practices.

When construction is complete, debris, unused stockpiles and materials should be recycled or properly disposed. In some cases, this will require disposal of contaminated soil from equipment leaks in an appropriate landfill. Staging areas should then be permanently stabilized with vegetation or other surface cover planned for the development.

SSA-2 November 2010 Urban Drainage and Flood Control District
Urban Storm Drainage Criteria Manual Volume 3

Stabilized Staging Area (SSA)

SM-6

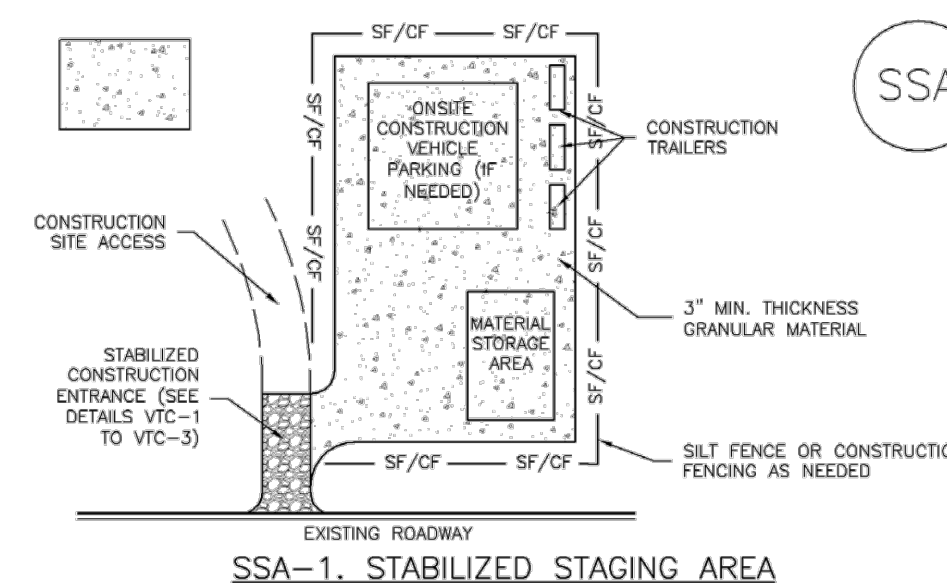

SSA-1. STABILIZED STAGING AREA

- STABILIZED STAGING AREA INSTALLATION NOTES**
1. SEE PLAN VIEW FOR -LOCATION OF STAGING AREA(S). -CONTRACTOR MAY ADJUST LOCATION AND SIZE OF STAGING AREA WITH APPROVAL FROM THE LOCAL JURISDICTION.
 2. STABILIZED STAGING AREA SHOULD BE APPROPRIATE FOR THE NEEDS OF THE SITE. OVERSIZING RESULTS IN A LARGER AREA TO STABILIZE FOLLOWING CONSTRUCTION.
 3. STAGING AREA SHALL BE STABILIZED PRIOR TO OTHER OPERATIONS ON THE SITE.
 4. THE STABILIZED STAGING AREA SHALL CONSIST OF A MINIMUM 3" THICK GRANULAR MATERIAL.
 5. UNLESS OTHERWISE SPECIFIED BY LOCAL JURISDICTION, ROCK SHALL CONSIST OF DOT SECT. #703, AASHTO #3 COARSE AGGREGATE OR 6" (MINUS) ROCK.
 6. ADDITIONAL PERIMETER BMPs MAY BE REQUIRED INCLUDING BUT NOT LIMITED TO SILT FENCE AND CONSTRUCTION FENCING.


- STABILIZED STAGING AREA MAINTENANCE NOTES**
1. INSPECT BMPs EACH WORKDAY, AND MAINTAIN THEM IN EFFECTIVE OPERATING CONDITION. MAINTENANCE OF BMPs SHOULD BE PROACTIVE, NOT REACTIVE. INSPECT BMPs AS SOON AS POSSIBLE (AND ALWAYS WITHIN 24 HOURS) FOLLOWING A STORM THAT CAUSES SURFACE EROSION, AND PERFORM NECESSARY MAINTENANCE.
 2. FREQUENT OBSERVATIONS AND MAINTENANCE ARE NECESSARY TO MAINTAIN BMPs IN EFFECTIVE OPERATING CONDITION. INSPECTIONS AND CORRECTIVE MEASURES SHOULD BE DOCUMENTED THOROUGHLY.
 3. WHERE BMPs HAVE FAILED, REPAIR OR REPLACEMENT SHOULD BE INITIATED UPON DISCOVERY OF THE FAILURE.
 4. ROCK SHALL BE REAPPLIED OR REGRADED AS NECESSARY IF FRUITING OCCURS OR UNDERLYING SUBGRADE BECOMES EXPOSED.

November 2010 Urban Drainage and Flood Control District SSA-3
Urban Storm Drainage Criteria Manual Volume 3



SM-6 Stabilized Staging Area (SSA)

- STABILIZED STAGING AREA MAINTENANCE NOTES**
5. STABILIZED STAGING AREA SHALL BE ENLARGED IF NECESSARY TO CONTAIN PARKING, STORAGE, AND UNLOADING/LOADING OPERATIONS.
 6. THE STABILIZED STAGING AREA SHALL BE REMOVED AT THE END OF CONSTRUCTION. THE GRANULAR MATERIAL SHALL BE REMOVED OR, IF APPROVED BY THE LOCAL JURISDICTION, USED ON SITE, AND THE AREA COVERED WITH TOPSOIL, SEEDS AND MULCHED OR OTHERWISE STABILIZED IN A MANNER APPROVED BY LOCAL JURISDICTION.
- NOTE: MANY MUNICIPALITIES PROHIBIT THE USE OF RECYCLED CONCRETE AS GRANULAR MATERIAL FOR STABILIZED STAGING AREAS DUE TO DIFFICULTIES WITH RE-ESTABLISHMENT OF VEGETATION IN AREAS WHERE RECYCLED CONCRETE WAS PLACED.
- NOTE: MANY JURISDICTIONS HAVE BMP DETAILS THAT VARY FROM LDFCD STANDARD DETAILS. CONSULT WITH LOCAL JURISDICTIONS AS TO WHICH DETAIL SHOULD BE USED WHEN DIFFERENCES ARE NOTED.
- (DETAILS ADAPTED FROM DOUGLAS COUNTY, COLORADO, NOT AVAILABLE IN AUTOCAD)

SSA-4 November 2010 Urban Drainage and Flood Control District
Urban Storm Drainage Criteria Manual Volume 3

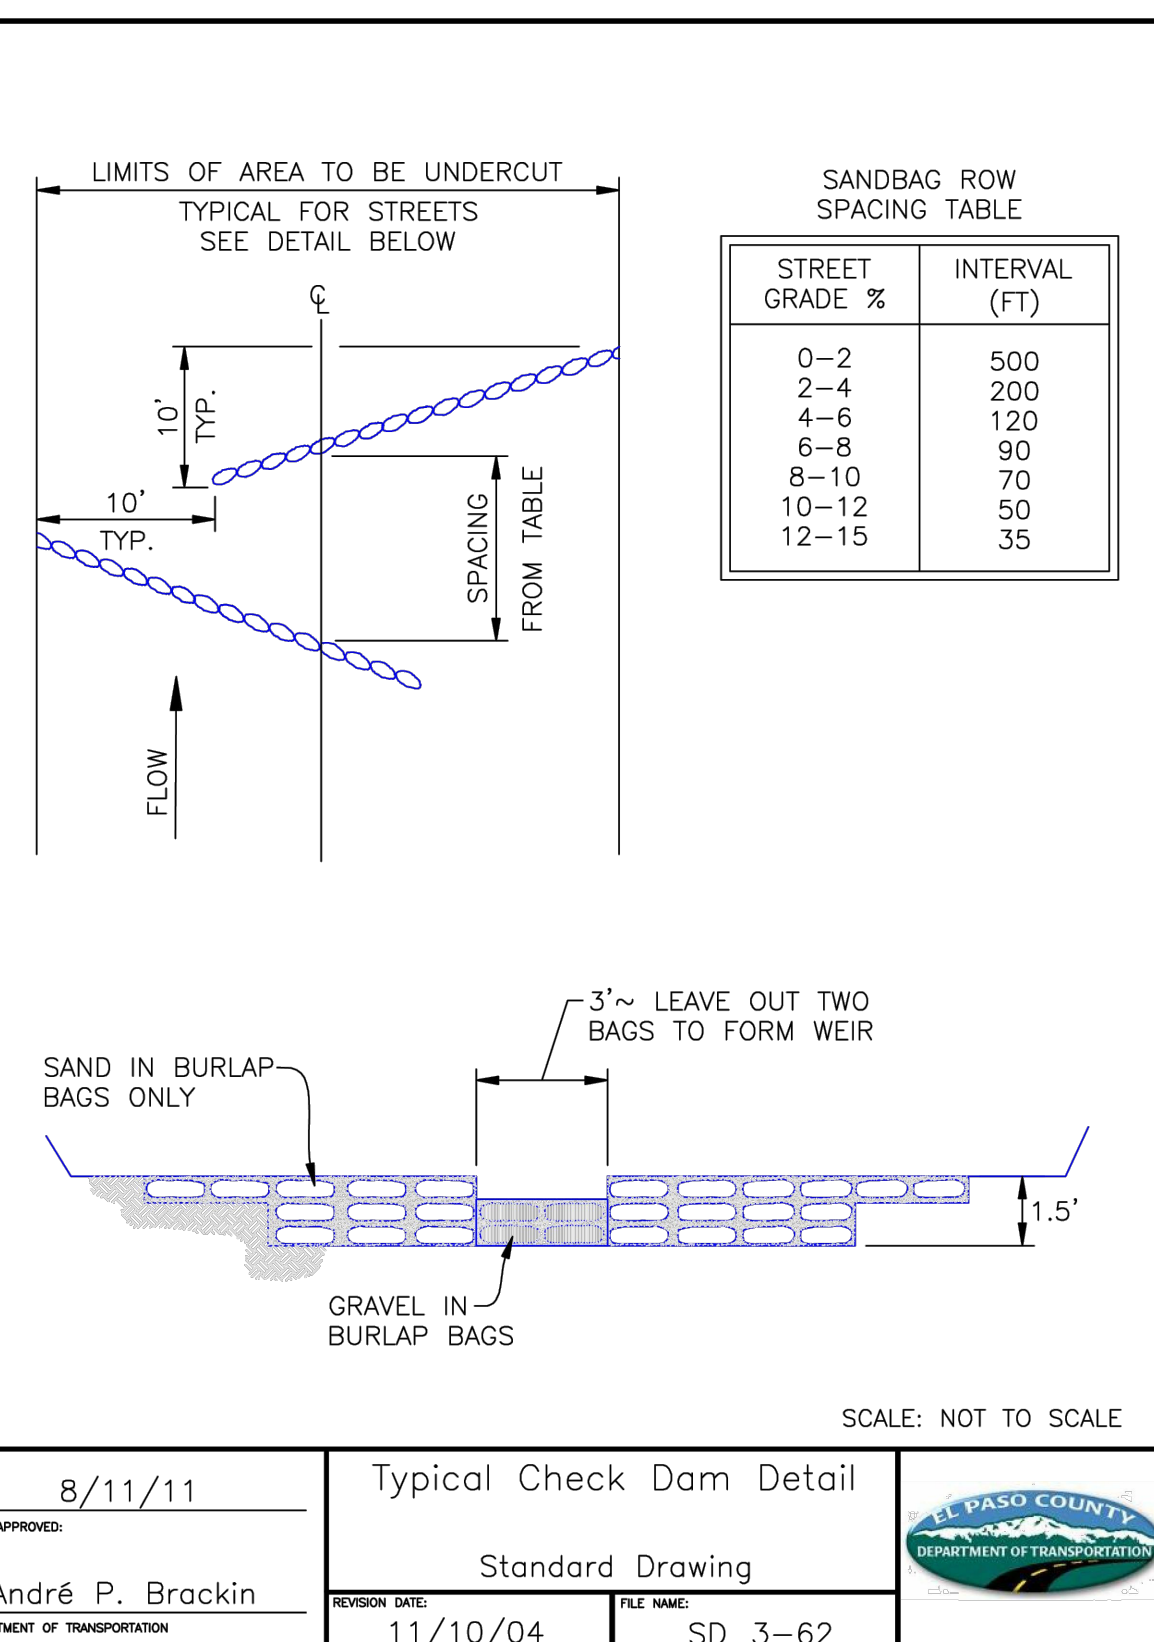

DATE APPROVED: 8/11/11	APPROVED: André P. Brackin	DEPARTMENT OF TRANSPORTATION
REVISION DATE: 11/10/04	FILE NAME: SD_3-62	STANDARD DRAWING

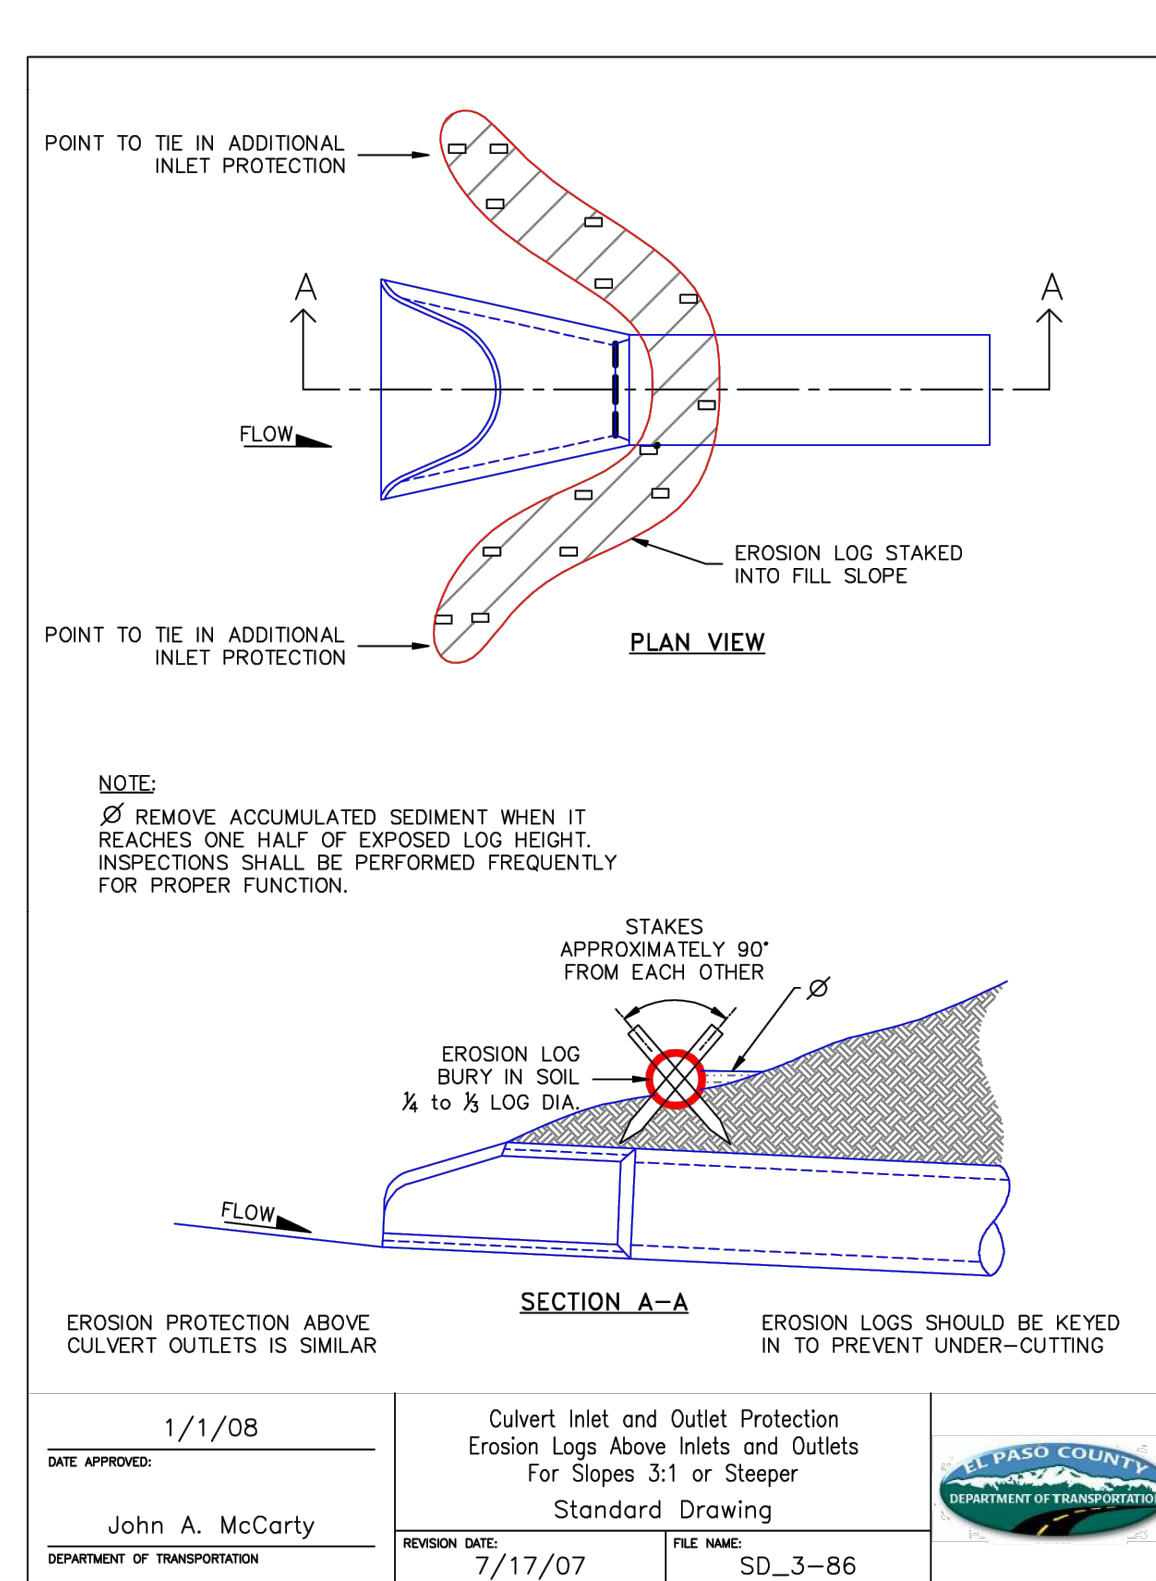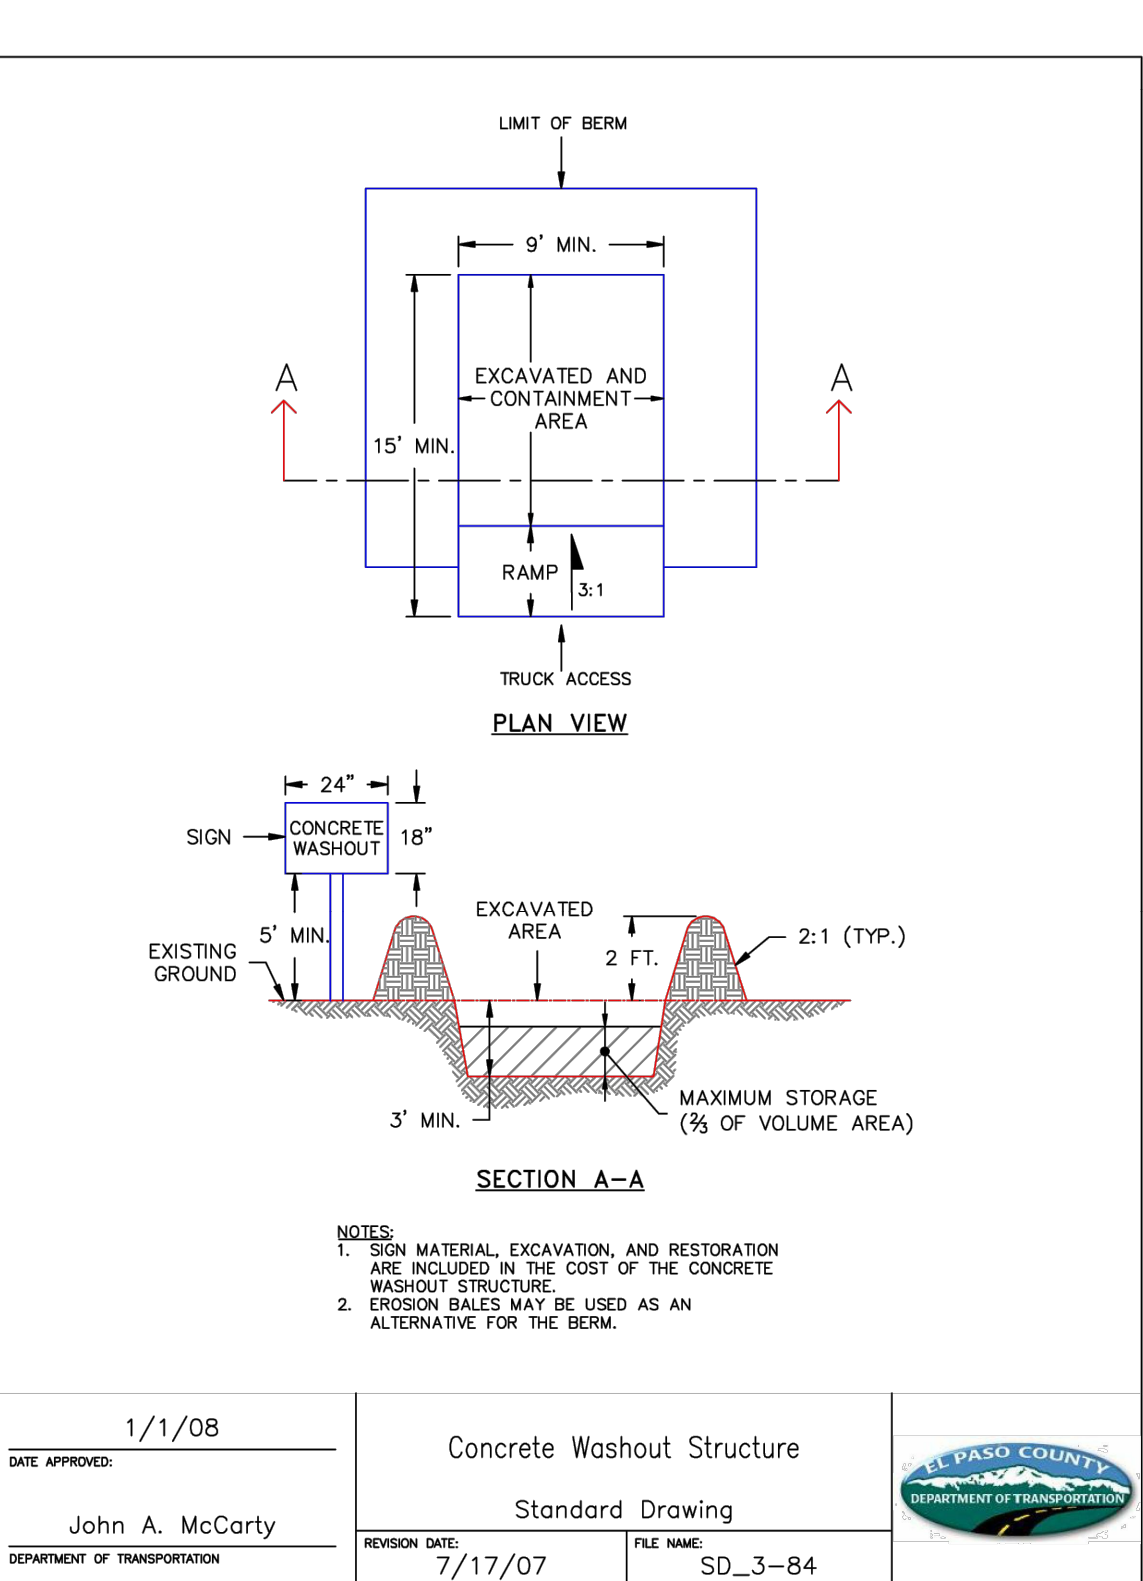

PORTABLE TOILET
PT

City of Colorado Springs Stormwater Enterprise
Construction Control Measures December 2020
This sheet and next 3.

NO.	REVISION	DATE	APPR.

Kimley»Horn
2026 KIMLEY-HORN AND ASSOCIATES, INC.
2 North Nevada Avenue, Suite 900
Colorado Springs, Colorado 80903 (719) 453-0180

DESIGNED BY: NMB
DRAWN BY: DPM
CHECKED BY: NMB
DATE: 03/30/2026

WINDERMERE FILING NO. 2
GRADING AND EROSION CONTROL PLANS
EL PASO COUNTY, COLORADO
DETAILS

PRELIMINARY
FOR REVIEW ONLY
NOT FOR CONSTRUCTION
Kimley»Horn
Kimley-Horn and Associates, Inc.

PROJECT NO.
196160000
SHEET
####

PT
Portable Toilet

1.0 DESCRIPTION

- The portable toilet detail provides requirements for portable toilet use on construction sites.

2.0 PURPOSE

- Used to minimize the risk of pollutant migration to State Waters.

3.0 IMPLEMENTATION

- Place portable toilet a minimum of 10 feet from the back of curb or on a trailer for road projects or sites that are mostly paved.
- Anchor portable toilet to the ground, at a minimum of two opposing corners (on a diagonal) using U-shaped rebar stakes.

4.0 TIMING

- Install as needed.
- Remove prior to the end of construction. Permanently stabilize any disturbed areas associated with the installation, maintenance, and/or removal of the toilets.


5.0 MAINTENANCE

- Portable toilets shall be serviced at the necessary intervals to eliminate the possibility of overflow.

City of Colorado Springs
Stormwater Enterprise



Construction Control Measures
December 2020

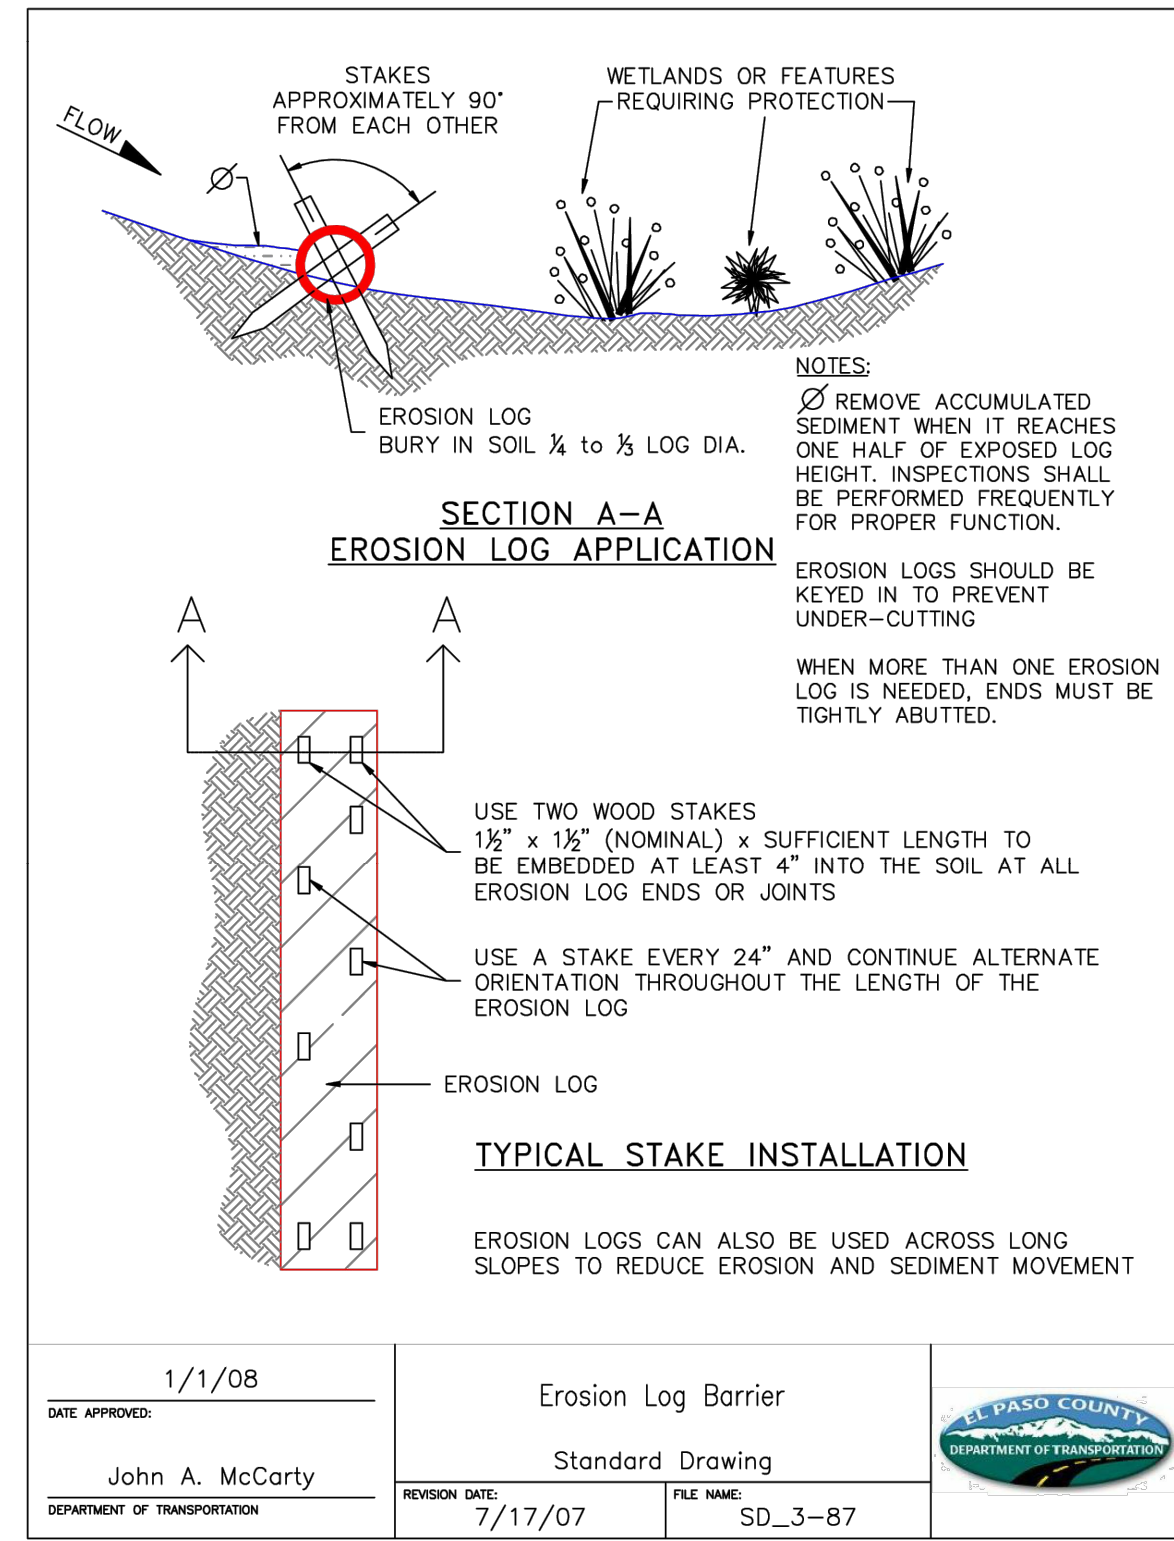

City of Colorado Springs
Stormwater Enterprise



Construction Control Measures
December 2020

SEEDING AND MULCHING

SM



City of Colorado Springs
Stormwater Enterprise

SM
Seeding and Mulching

1.0 DESCRIPTION

- The preparation of soil, application of mulch, and application of seed to disturbed areas.

2.0 PURPOSE

- Used to control runoff and erosion on disturbed areas by establishing vegetative cover.
- Reduces erosion and sediment loss.
- Provides permanent stabilization in disturbed areas.

3.0 IMPLEMENTATION

- All soil testing, soil amendment and fertilizer documentation, and seed load and bag tickets must be added to the CSWMP.
- Properly prepare soil prior to seeding and mulching.
- Apply seed mixes as specified in the City of Colorado Springs Stormwater Construction Manual. Alternative seed mixes are acceptable if included in an approved Landscaping Plan.
- Mulch seeded areas using hay or straw mulch, hydraulic mulching, or install erosion control blanket.

4.0 TIMING

- Seed and mulch disturbed areas after final grading.
- Seeding and mulching may also be used as a temporary erosion control measure during construction.

5.0 MAINTENANCE

- Repair and reseed bare areas as necessary.
- Restrict vehicle access to seeded areas.

City of Colorado Springs
Stormwater Enterprise



Construction Control Measures
December 2020

SEEDING & MULCHING

ALL SOIL TESTING, SOILS AMENDMENT AND FERTILIZER DOCUMENTATION, AND SEED LOAD AND BAG TICKETS MUST BE ADDED TO THE CSWMP.

SOIL PREPARATION

- IN AREAS TO BE SEEDDED, THE UPPER 6 INCHES OF THE SOIL MUST NOT BE HEAVILY COMPACTED, AND SHOULD BE IN FRAGILE CONDITION. LESS THAN 85% STANDARD PROCTOR DENSITY IS ACCEPTABLE. AREAS OF COMPACTED OR GENERAL CONSTRUCTION ACTIVITY MUST BE SCARIFIED TO A DEPTH OF 6 TO 12 INCHES PRIOR TO SPREADING TOPSOIL TO BREAK UP COMPACTED LAYERS AND PROVIDE A BLENDING ZONE BETWEEN DIFFERENT SOIL LAYERS.
- AREAS TO BE PLANTED SHALL HAVE AT LEAST 4 INCHES OF TOPSOIL SUITABLE TO SUPPORT PLANT GROWTH.
- THE CITY RECOMMENDS THAT EXISTING AND/OR IMPORTED TOPSOIL BE TESTED TO IDENTIFY SOIL DEFICIENCIES AND ANY SOIL AMENDMENTS NECESSARY TO ADDRESS THESE DEFICIENCIES. SOIL AMENDMENTS AND/OR FERTILIZERS SHOULD BE ADDED TO CORRECT TOPSOIL DEFICIENCIES BASED ON SOIL TESTING RESULTS.
- TOPSOIL SHALL BE PROTECTED DURING THE CONSTRUCTION PERIOD TO RETAIN ITS STRUCTURE AVOID COMPACTING, AND TO PREVENT EROSION AND CONTAMINATION. STRIPPED TOPSOIL MUST BE STORED IN AN AREA AWAY FROM MACHINERY AND CONSTRUCTION OPERATIONS, AND CARE MUST BE TAKEN TO PROTECT THE TOPSOIL AS A VALUABLE COMMODITY. TOPSOIL MUST NOT BE STRIPPED DURING UNDESIRABLE WORKING CONDITIONS (E.G. DURING WET WEATHER OR WHEN SOILS ARE SATURATED). TOPSOIL SHALL NOT BE STORED IN SWALES OR IN AREAS WITH POOR DRAINAGE.

SEEDING

- ALLOWABLE SEED MIXES ARE INCLUDED IN THE CITY OF COLORADO SPRINGS STORMWATER CONSTRUCTION MANUAL. ALTERNATIVE SEED MIXES ARE ACCEPTABLE IF INCLUDED IN AN APPROVED LANDSCAPING PLAN.
- SEED SHOULD BE DRILL-SEED WHENEVER POSSIBLE.
- SEED DEPTH MUST BE 1/2 TO 3/4 INCHES WHEN DRILL-SEEDING IS USED.
- BROADCAST SEEDING OR HYDRO-SEEDING WITH TACKIFIER MAY BE SUBSTITUTED ON SLOPES STEEPER THAN 3:1 OR ON OTHER AREAS NOT PRACTICAL TO DRILL SEED.
- SEEDING RATES MUST BE DOUBLED FOR BROADCAST SEEDING OR INCREASED BY 50% IF USING A BRILLION DRILL OR HYDRO-SEEDING.
- BROADCAST SEEDING MUST BE LIGHTLY HAND-RAKED INTO THE SOIL.

MULCHING

- MULCHING SHOULD BE COMPLETED AS SOON AS PRACTICABLE AFTER SEEDING. HOWEVER PLANTED AREAS MUST BE MULCHED NO LATER THAN 14 DAYS AFTER PLANTING.
- MULCHING REQUIREMENTS INCLUDE:
 - HAY OR STRAW MULCH
 - ONLY CERTIFIED WEED-FREE AND CERTIFIED SEED-FREE MULCH MAY BE USED. MULCH MUST BE APPLIED AT 2 TONS/ACRE AND ADEQUATELY SECURED BY CRIMPING AND/OR TACKIFIERS.
 - CRIMPING MUST NOT BE USED ON SLOPES GREATER THAN 3:1 AND MULCH FIBERS MUST BE TUCKED INTO THE SOIL TO A DEPTH OF 3 TO 4 INCHES.
 - TACKIFIERS MUST BE USED IN PLACE OF CRIMPING ON SLOPES STEEPER THAN 3:1.
 - HYDRAULIC MULCHING
 - HYDRAULIC MULCHING IS AN OPTION ON STEEP SLOPES OR WHERE ACCESS IS LIMITED.
 - IF HYDRO-SEEDING IS USED, MULCHING MUST BE APPLIED AS A SEPARATE, SECOND OPERATION.
 - WOOD CELLULOSE FIBERS MIXED WITH WATER MUST BE APPLIED AT A RATE OF 2,000 TO 2,500 POUNDS/ACRE, AND TACKIFIER MUST BE APPLIED AT A RATE OF 100 POUNDS/ACRE.
 - EROSION CONTROL BLANKET
 - EROSION CONTROL BLANKET MAY BE USED IN PLACE OF TRADITIONAL MULCHING METHODS.

SM

STORMWATER ENTERPRISE
SEEDING & MULCHING
APPROVED: [Signature]
DATE: 10/7/19
REVISION: 6/18/2020
DRAWING NO: 800-SM

City of Colorado Springs
Stormwater Enterprise



Construction Control Measures
December 2020

SILT FENCE

SF



1.0 DESCRIPTION

- Silt fence is a temporary sediment barrier consisting of woven geotextile fabric attached to supporting posts and trenched into the soil.

2.0 PURPOSE

- Used to intercept sheet flow prior to leaving a construction site.
- May be used around the perimeter of a construction site.

3.0 IMPLEMENTATION

- Install silt fence to intercept sheet flow runoff from disturbed areas.
- Silt fence is not designed to be used as a filter fabric.
- Do not install silt fence across streams, channels, swales, ditches, or other drainageways.
- Install silt fence along the contour of slopes or in a manner to avoid creating concentrated flow (i.e. "J-hook" installation).
- The maximum tributary drainage area per 100 linear feet of silt fence is 1/4 acre.
- Properly installed silt fence should not be easily pulled out by hand and there should be no gaps between the ground and fabric.

4.0 TIMING

- Install prior to land disturbing activities.
- Remove silt fence after the upstream area has been permanently stabilized.


5.0 MAINTENANCE

- Remove and properly dispose of sediment when it has accumulated to 1/2 of the height of the exposed silt fence.
- Inspect for and repair or replace damaged silt fence.

City of Colorado Springs
Stormwater Enterprise



Construction Control Measures
December 2020

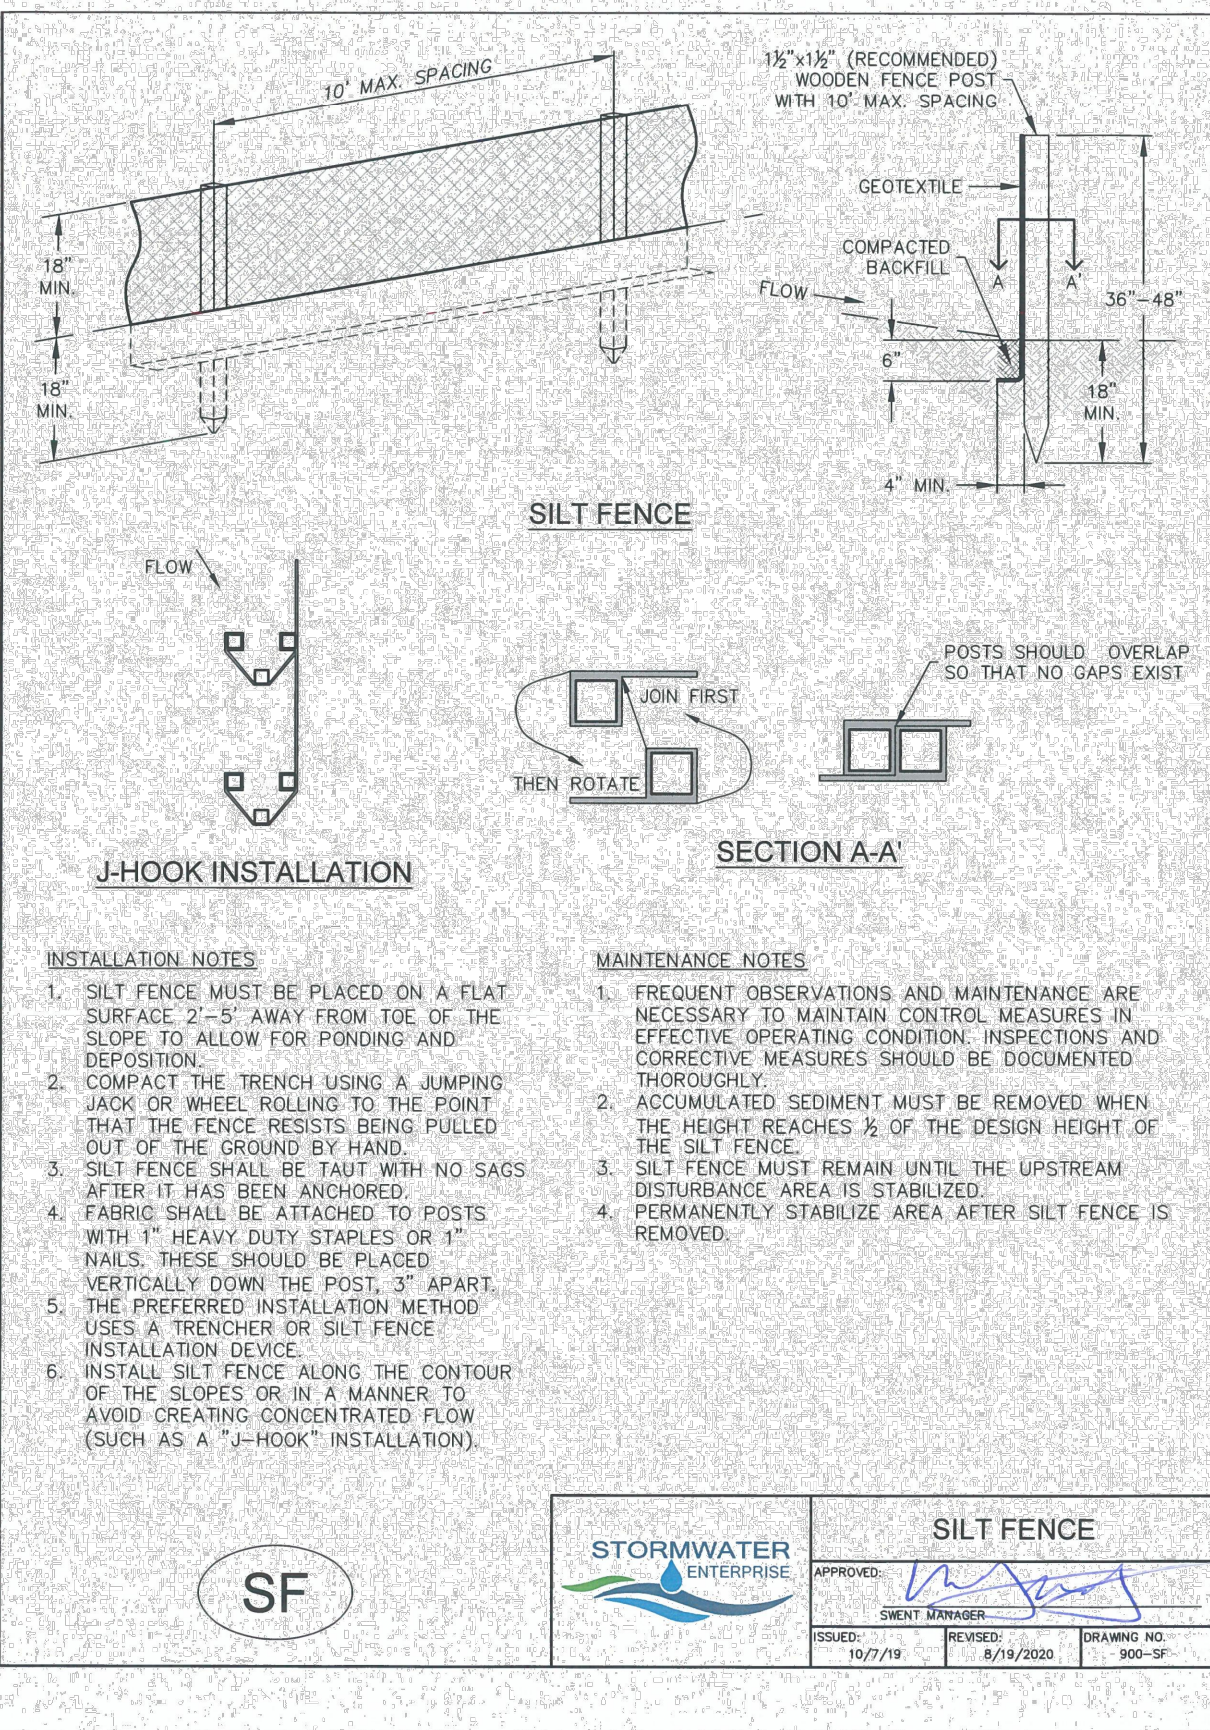

City of Colorado Springs
Stormwater Enterprise

NO.	REVISION	BY	DATE	APPR

Kimley»Horn
2026 KIMLEY-HORN AND ASSOCIATES, INC.
2 North Nevada Avenue, Suite 900
Colorado Springs, Colorado 80903 (719) 453-0180

DESIGNED BY: NMB
DRAWN BY: DPM
CHECKED BY: NMB
DATE: 03/30/2026


WINDERMERE FILING NO. 2
GRADING AND EROSION CONTROL PLANS
EL PASO COUNTY, COLORADO
DETAILS

PRELIMINARY
FOR REVIEW ONLY
NOT FOR CONSTRUCTION
Kimley»Horn
Kimley-Horn and Associates, Inc.


PROJECT NO.
196160000
SHEET
####

V4_Construction Drawings (Plans-Profiles).pdf Markup Summary

CDurham (11)

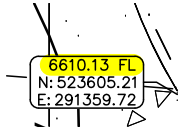


Subject: Highlight
Page Label: [34] 3 PUBLIC IMPROVEMENTS PLAN
Author: CDurham
Date: 4/13/2026 4:59:30 PM
Status:
Color:
Layer:
Space:

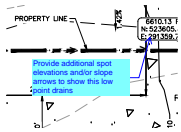


Subject: Callout
Page Label: [34] 3 PUBLIC IMPROVEMENTS PLAN
Author: CDurham
Date: 4/13/2026 5:06:01 PM
Status:
Color:
Layer:
Space:

Provide additional spot elevations and/or slope arrows to show this low point drains

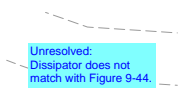


Subject: Text Box
Page Label: [15] C2.4 FOREBAY DETAILS
Author: CDurham
Date: 4/13/2026 5:18:54 PM
Status:
Color:
Layer:
Space:

Unresolved:
Dissipator does not match with Figure 9-44.

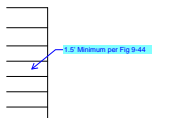


Subject: Callout
Page Label: [15] C2.4 FOREBAY DETAILS
Author: CDurham
Date: 4/13/2026 5:17:00 PM
Status:
Color:
Layer:
Space:

1.5' Minimum per Fig 9-44

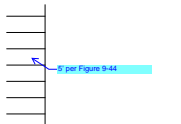

Subject: Callout
Page Label: [15] C2.4 FOREBAY DETAILS
Author: CDurham
Date: 4/13/2026 5:17:54 PM
Status:
Color:
Layer:
Space:

5' per Figure 9-44

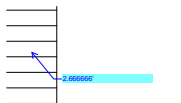

Subject: Callout
Page Label: [15] C2.4 FOREBAY DETAILS
Author: CDurham
Date: 4/13/2026 5:18:32 PM
Status:
Color:
Layer:
Space:


2.666666'



Subject: Rectangle
Page Label: [15] C2.4 FOREBAY DETAILS
Author: CDurham
Date: 4/13/2026 5:19:08 PM
Status:
Color: ■
Layer:
Space:




Subject: Rectangle
Page Label: [15] C2.4 FOREBAY DETAILS
Author: CDurham
Date: 4/13/2026 5:19:24 PM
Status:
Color: ■
Layer:
Space:

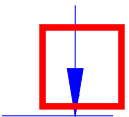

Subject: Rectangle
Page Label: [15] C2.4 FOREBAY DETAILS
Author: CDurham
Date: 4/13/2026 5:19:32 PM
Status:
Color: ■
Layer:
Space:



Subject: Rectangle
Page Label: [15] C2.4 FOREBAY DETAILS
Author: CDurham
Date: 4/13/2026 5:19:39 PM
Status:
Color: ■
Layer:
Space:

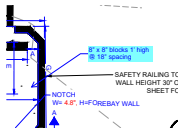

Subject: Callout
Page Label: [15] C2.4 FOREBAY DETAILS
Author: CDurham
Date: 4/13/2026 5:20:45 PM
Status:
Color: ■
Layer:
Space:


8" x 8" blocks 1' high @ 18" spacing

Joseph Sandstrom (8)




Subject: Callout
Page Label: [12] C2.1 STORM B-1
Author: Joseph Sandstrom
Date: 4/6/2026 11:34:40 AM
Status:
Color: ■
Layer:
Space:


Unresolved Review 3 comment:
Rim elevation doesn't match (typical comment)

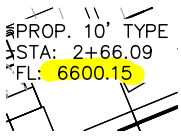


Subject: Highlight
Page Label: [12] C2.1 STORM B-1
Author: Joseph Sandstrom
Date: 4/6/2026 11:33:13 AM
Status:
Color: ■
Layer:
Space:

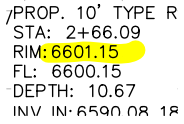


Subject: Highlight
Page Label: [12] C2.1 STORM B-1
Author: Joseph Sandstrom
Date: 4/6/2026 11:33:23 AM
Status:
Color: ■
Layer:
Space:

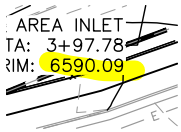

Subject: Highlight
Page Label: [12] C2.1 STORM B-1
Author: Joseph Sandstrom
Date: 4/6/2026 11:34:12 AM
Status:
Color: ■
Layer:
Space:

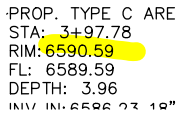


Subject: Highlight
Page Label: [12] C2.1 STORM B-1
Author: Joseph Sandstrom
Date: 4/6/2026 11:34:17 AM
Status:
Color: ■
Layer:
Space:

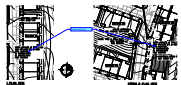

Subject: Callout
Page Label: [14] C2.3 STORM C&D
Author: Joseph Sandstrom
Date: 4/6/2026 11:51:28 AM
Status:
Color: ■
Layer:
Space:

Update stationing

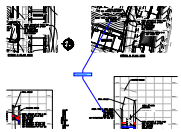

Subject: Callout
Page Label: [14] C2.3 STORM C&D
Author: Joseph Sandstrom
Date: 4/6/2026 11:51:05 AM
Status:
Color: ■
Layer:
Space:

Update elevations.



Subject: Cloud+
Page Label: [1] C4.5 DETAILS
Author: Joseph Sandstrom
Date: 4/6/2026 12:59:22 PM
Status:
Color: ■
Layer:
Space:

This sheet and next 3.