


Vicinity Location Map_V1.pdf Markup Summary

6/27/2022 8:21:17 PM (1)

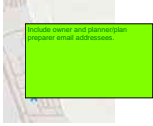

Subject: Text Box
Page Label: [1] VICINITY MAP
Author: Rob Stauffacher
Date: 6/27/2022 8:21:17 PM
Status:
Color: ■
Layer:
Space:

Include owner and planner/plan preparer email addressees.



Know what's below.
Call before you dig.

Matrix
Excellence by Design

2435 RESEARCH PARKWAY, SUITE
300 COLORADO SPRINGS, CO 80920
PHONE: (719) 575-0100



LAND DEVELOPMENT
CONSULTANTS, LLC

950 S. CHERRY ST., SUITE 512
DENVER, CO 80246

OWNER/DEVELOPER:




ROCKY MOUNTAINS DIVISION
5500 S QUEBEC STREET, SUITE 100
GREENWOOD VILLAGE, CO 80111
PHONE: (720) 758-6223

SEAL

FOR AND ON BEHALF OF MATRIX DESIGN GROUP, INC

VICINITY MAP:

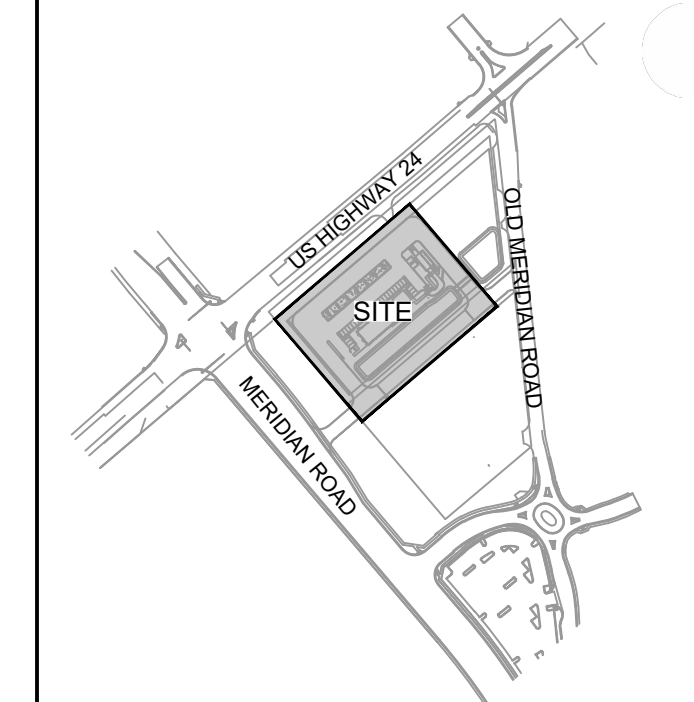

PROJECT:

CIRCLE K STORES INC.

**HIGHWAY 24 & MERIDIAN ROAD
FALCON, CO**

REVISION HISTORY:

NO.	DATE	DESCRIPTION	BY

DRAWING INFORMATION:

PROJECT NO: 21.1207.037

DRAWN BY: LCB

CHECKED BY: NMS


DESIGNED BY: NMS

SHEET TITLE:

VICINITY MAP

SHEET 1 OF 1

ISSUE DATE: MARCH 2022

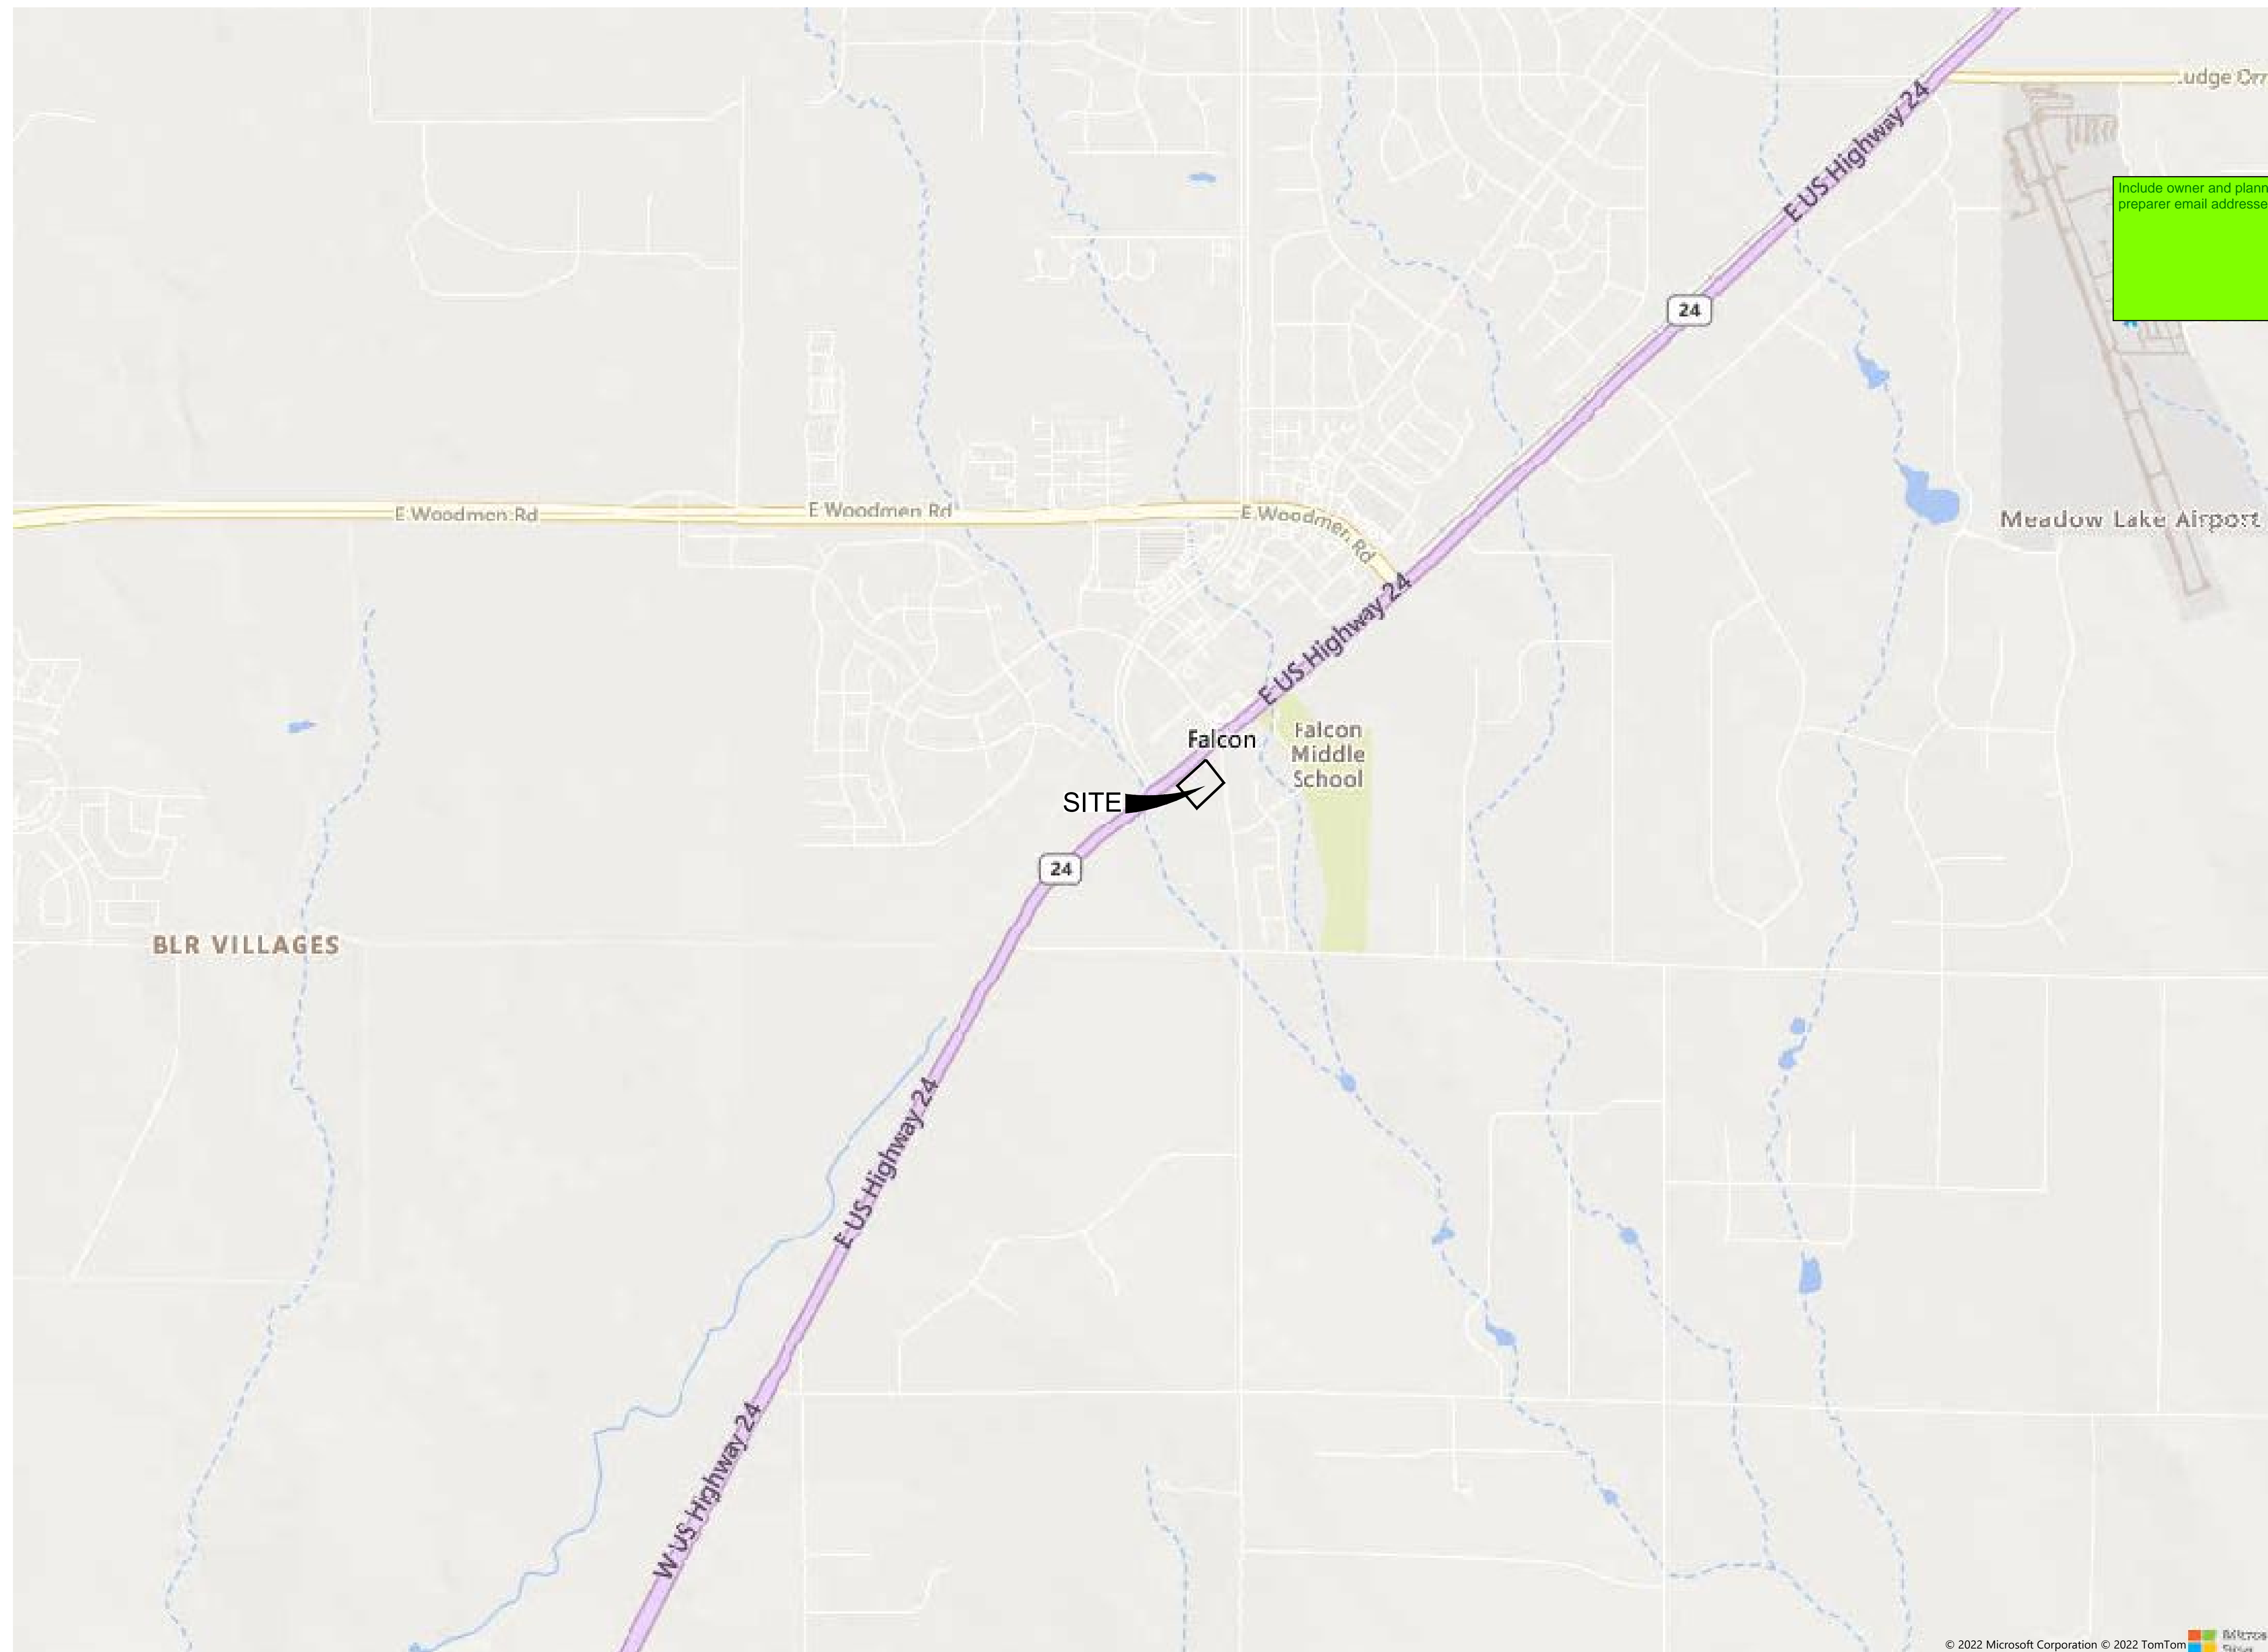

Include owner and planner/planner preparer email addresses.



FILE LOCATION: S:\CIRCLE K HWY 24 & MERIDIAN\DWG\PREP\VICINITY MAP.DWG