

Released for Permit

07/25/2014 2:38:31 PM

REGIONAL
Building Department
Becky A

ENUMERATION

It is the owner's responsibility to coordinate with easement holders to avoid impact to utilities that may be located in the easements.



APPROVED
Plan Review
08/01/2024 1:32:03 PM
dschurk@tulane.edu
EPC Planning & Community
Development Department

ANY APPROVAL GIVEN BY THE PASO COUNTY DOES NOT OBVIATE THE NEED FOR AN APPROVAL FROM THE FEDERAL, STATE, OR LOCAL LAWS AND/OR REGULATION

Planning & Community Development Department approval is contingent upon compliance with all applicable rules as the recorded final.

An access permit must be granted by the Planning & Community Development Department prior to the establishment of any driveway onto a property road.

Diversion of blockage of any drainage way is not permitted without approval of the Planning & Community Development Department.

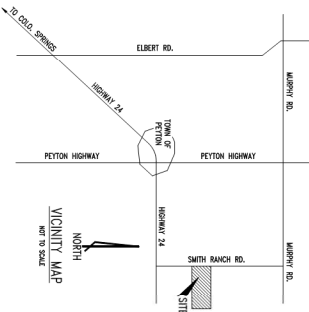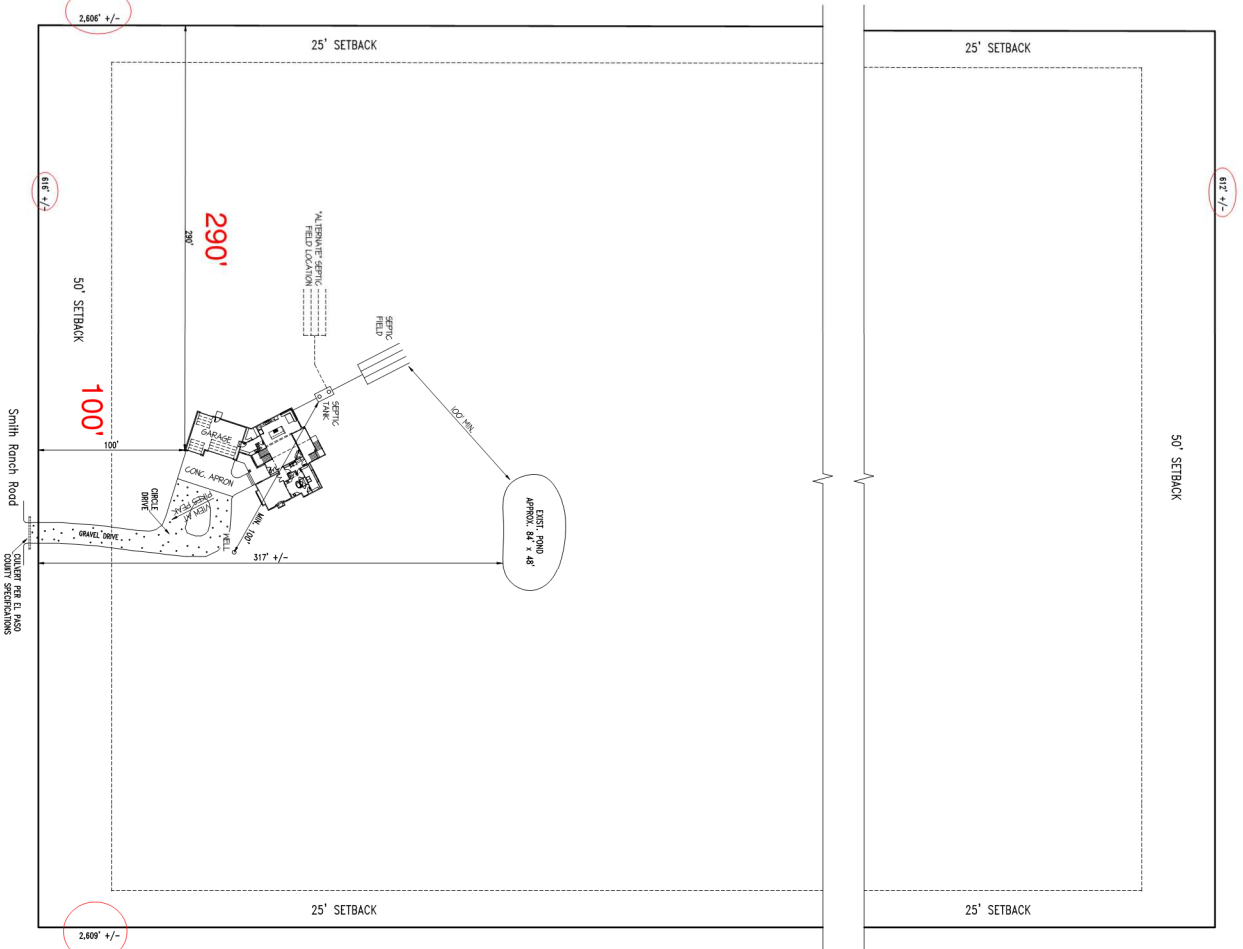

Note: all dimensions to be verified

Zoned: RR-5
Tax No. 3200000767

SINGLE FAMILY RESIDENCE

LOT SIZE: 35 +/- ACRES
BLDG. SIZE: 3,321 Sq.Ft.
LOT COVERAGE: .021%
BLDG. MAX. HEIGHT: 32.00 Ft.
BLDG. AVG. HEIGHT: 27 Ft.



PLAN SCALE 1"=40'

Kevin and Genevieve
Keyes Residence

FINELINE
Design & Drafting, Inc.



4880 Sandstone Dr.
Monroeville, Colorado 80132
Phone: (714) 481-0281
E-mail: fine-line-design & consult, inc.
www.finedesignanddrafting.com

Drawn by: *Kerrie K. Christensen*

[illegible]

REVISION:

1	10	20	30	40	50	60	70	80	90	100
11	21	31	41	51	61	71	81	91	101	111
12	22	32	42	52	62	72	82	92	102	112
13	23	33	43	53	63	73	83	93	103	113
56	66	76	86	96	106	116	126	136	146	156
57	67	77	87	97	107	117	1			

BUILDER
Cuyala
Construction, Inc.
Don & John Cuyala
P.O. Box 1392
Monument, CO 80132
(719) 488-2426

DATE: 10-18-2023

ADDRESS: Keyes Residence
13885 Smith Ranch Rd.
Peyton, CO 80831
El Paso County

SHEET OF

SHEET OF
SP/12

RESIDENTIAL

2023 PPRBC
2021 IECC



Parcel: 3200000767

Address: 13885 SMITH RANCH RD, PEYTON

Plan Track #: 192360 Received: 24-Jul-2024 (BRIANNAM)

Description: Required PPRBD Departments (6)

RESIDENCE

Contractor: CUVALA CONSTRUCTION, INC.

Type of Unit:		
Garage	905	
Lower Level 1	2026	
Main Level	2097	
	5028	Total Square Feet

Enumeration

Released for Permit


Becky A
ENUMERATION

07/25/2024 3:48:29 PM

Floodplain

(N/A) RBD GIS

Construction

Released for Permit


Christineh
CONSTRUCTION

07/31/2024 12:27:26 PM

Electrical

Mechanical

Released for Permit


trevorh
MECHANICAL

07/31/2024 4:11:16 PM

Plumbing

Released for Permit


shanen
PLUMBING

08/01/2024 10:56:37 AM

Release of this plan does not preclude compliance with all applicable codes, ordinances and other pertinent regulations. This plan set must be present on the job site for every inspection.

Required Outside Departments (1)

County Zoning
APPROVED
Plan Review

08/01/2024 1:32:50 PM
dstdarchuleta

EPC Planning & Community
Development Department