

MASTER DEVELOPMENT DRAINAGE PLAN

FOR

CROSSROADS NORTH

A RESUBDIVISION OF HILLCREST ACRES

EL PASO COUNTY, COLORADO

MARCH 2022

Prepared for:

Colorado Springs Equities LLC
90 S. Cascade, Suite 1500
Colorado Springs, CO 80903
(719) 475-7621

Prepared by:



CIVIL CONSULTANTS, INC.

212 N. Wahsatch Avenue, Suite 305
Colorado Springs, CO 80903
(719) 955-5485

Project #18-001
PCD Project #SP 20-207

and Preliminary
Drainage Report
Unresolved.

**MASTER DEVELOPMENT DRAINAGE PLAN FOR
CROSSROADS NORTH
A RESUBDIVISION OF HILLCREST ACRES
EL PASO COUNTY COLORADO**

DRAINAGE PLAN STATEMENTS

ENGINEERS STATEMENT

The attached drainage plan and report was prepared under my direction and supervision and are correct to the best of my knowledge and belief. Said drainage report has been prepared according to the criteria established by the County for drainage reports and said report is in conformity with the master plan of the drainage basin. I accept responsibility for any liability caused by any negligent acts, errors or omissions on my part in preparing this report.

Virgil A. Sanchez, P.E. #37160
For and on Behalf of M&S Civil Consultants, Inc

DEVELOPER'S STATEMENT

I, the developer(s) have read and will comply with all the requirements specified in this drainage report and plan.

BY: _____

TITLE: _____

DATE: _____

ADDRESS: Colorado Springs Equities LLC
90 S. Cascade, Suite 1500
Colorado Springs, CO 80903

EL PASO COUNTY'S STATEMENT

Filed in accordance with the requirements of El Paso County Land Development Code, Drainage Criteria Manual Volumes 1 and 2, and the Engineering Manual, as amended.

BY: _____ DATE: _____

Jennifer Irvin, P.E.
County Engineer / ECM Administrator

CONDITIONS:

Replace with

Joshua Palmer, P.E.
Interim County Engineer/ECM Administrator

**MASTER DEVELOPMENT DRAINAGE PLAN FOR
CROSSROADS NORTH
A RESUBDIVISION OF HILLCREST ACRES
EL PASO COUNTY COLORADO**

TABLE OF CONTENTS

PURPOSE	4
GENERAL LOCATION AND DESCRIPTION	4
JIMMY CAMP CREEK DBPS & MARKSHEFFEL ROAD FDR	5
WETLANDS	5
CHANNEL IMPROVEMENTS	5
SOILS	5
HYDROLOGIC CALCULATIONS	5
HYDRAULIC CALCULATIONS	5
FLOODPLAIN STATEMENT	5
DRAINAGE CRITERIA	6
FOUR STEP PROCESS	6
EXISTING DRAINAGE CONDITIONS	6
PROPOSED DRAINAGE CONDITIONS	11
WATER QUALITY PROVISIONS AND MAINTENANCE	16
INTER-BASIN TRANSFER	18
EROSION CONTROL	18
DRAINAGE & BRIDGE FEES	18
SUMMARY	19
REFERENCES	20

APPENDIX

Vicinity Map

Soils Map

FIRM Panels

Hydrologic Calculations

Hydraulic Calculations / Pond Calculations

Marksheffel Road Final Drainage Report Excerpts

Jimmy Camp Creek DBPS Excerpts

Reagan Ranch MDDP Excerpts

Drainage Maps

**MASTER DEVELOPMENT DRAINAGE PLAN FOR
CROSSROADS NORTH
A RESUBDIVISION OF HILLCREST ACRES
EL PASO COUNTY COLORADO**

PURPOSE

This document is intended to serve as the Master Development Drainage Plan for Crossroads North. The purpose of this document is to identify and analyze the onsite drainage patterns and to ensure that post development runoff is routed through the site safely and in a manner that satisfies the requirements set forth by the El Paso County and City of Colorado Springs Drainage Criteria Manual. The proposed principal use for the site will be commercial. The parcel is currently zoned by El Paso County for commercial regional, industrial, and light industrial as CR, M, and I-2, respectively. A final drainage report shall be required with a submittal of the final plat.

GENERAL LOCATION AND DESCRIPTION

Crossroads North is located northeast of Highway 24 and Highway 94, in a portion of the south half of Section 8 and the northeast quarter of Section 8, Township 14 South, Range 65 West of the 6th Principal Meridian, within unincorporated El Paso County, Colorado. The site is bound on the south by Colorado Highway 94, to the north by Colorado Highway 24 and Marksheffel Road, and to the east by Marksheffel Road. Drainage flows from this site are tributary to the Jimmy Camp Creek Drainage Basin and Peterson Field Drainage Basin.

Crossroads North consists of approximately 44.34 acres within unincorporated El Paso County and is presently undeveloped. Improvements proposed for this portion of the site include paved streets, parking lots, sidewalks, commercial buildings, full spectrum detention ponds, and utilities as normally constructed for a commercial development. As a part of the Crossroads North development, approximately 19 acres of property owned by the City of Colorado Springs along Highway 94 will also be improved. It is proposed that the City's property will be developed into sporting fields, landscaping, parking areas, and tracts for detention. The total disturbance of the entire project is approximately 65 acres. Existing vegetation is sparse, consisting of native grasses. Existing site terrain generally slopes from north to southwest, and north to southeast, at grade rates that vary between 2% and 9%.

Land use for Crossroads North is currently listed as AG (Grazing Land). The total disturbance of the entire project is approximately 65 acres. A request for approval of early grading plans has been submitted with this MDDP and Preliminary Plan.

Four (4) full spectrum detention ponds will provide water quality treatment and detention for the proposed development. The outlet structures from the two southernmost proposed ponds will tie into two existing storm sewer systems; one at the northwest corner of Marksheffel Road and Highway 94 and the other at the northeast corner of Highway 24 and Highway 94.

JIMMY CAMP CREEK DBPS & MARKSHEFFEL ROAD FINAL DRAINAGE REPORT

Excerpts of these two reports are include in the appendix of this report. The DBPS “Future Conditions Planning Information” map delineates this property as “Remaining areas with no detailed development plan”. The “Future Conditions Land Use Map” delineates this site as “Low-Med Single Family Res, 4-8 Du/Ac, 40-50% percent impervious, and a Curve Number as 75-87”. Since the proposed site will utilize the DBPS recommended Full Spectrum Detention method, the DBPS land use assumptions do not change the project’s release rates. The Marksheffel Road Final Drainage Report is provided in the appendix to show and verify the drainage calculations for the existing facilities in Marksheffel Road and Highway 94. This report uses this data to compare the design flows in the existing system with the proposed flow for this development.

WETLANDS

There are no apparent wetlands within the boundary of this project.

CHANNEL IMPROVEMENTS

The proposed project is not adjacent to Jimmy Camp Creek or any other significant drainageway. No channel improvements are necessary as a part of this project.

SOILS

Soils for this project are delineated by the map in the appendix as Blakeland Loamy Sand (8) and have been characterized as Hydrologic Soil Types "A". Soils in the study area are shown as mapped by S.C.S. in the "Soils Survey of El Paso County Area". See Appendix for soils report.

HYDROLOGIC CALCULATIONS

Hydrologic calculations were performed using the El Paso County and City of Colorado Springs Storm Drainage Design Criteria manual and where applicable the Urban Storm Drainage Criteria Manual. The Rational Method was used to estimate stormwater runoff anticipated from design storms with 5-year and 100-year recurrence intervals.

HYDRAULIC CALCULATIONS

Hydraulic calculations were estimated using the Manning's Formula and the methods described in the El Paso County and City of Colorado Springs Storm Drainage Design Criteria manual. The relevant data sheets are included in the Appendix of this report.

FLOODPLAIN STATEMENT

According to the Federal Emergency Management Agency (FEMA) Flood Insurance Rate Map (FIRM) Panel Nos. 08041C0756G, 08041C0758G, 08041C0758G, and 08041C0758G revised December 7, 2018. No portion of this site is located within the 100 year floodplain. See Appendix.

DRAINAGE CRITERIA

This drainage analysis has been prepared in accordance with the current City of Colorado Springs/El Paso County Drainage Criteria Manual. Calculations were performed to determine runoff quantities for the 5-year and 100-year frequency storms for developed conditions using the Rational Method as required for basins having areas less than 100 acres. See Appendix for calculations.

FOUR STEP PROCESS

Step 1 Employ Runoff Reduction Practices – Parking lot surface drainage will be directed towards landscaped areas to minimize direct connection of impervious surfaces.

Step 2 Stabilize Drainageways –The site is several miles upstream of the Jimmy Camp Creek or Sand Creek Drainageway. Crossroads North site proposes (4) Full Spectrum Detention Facilities before flows are discharged to the existing systems along Marksheffel Road and Highway 94. The developed flows from the onsite ponds discharge less than historic flows into the existing systems. Therefore, the downstream drainageways will see less peak flows.

Step 3 Provide Water Quality Capture Volume (WQCV) – Four (4) Full Spectrum Detention facilities are proposed to provide WQCV treatment from the site.

Step 4 Consider Need for Industrial and Commercial BMP's – This submittal provides an early grading and erosion control plan with BMPs in place. The proposed project will use silt fence, vehicle tracking control pads, straw bale barriers, sediment basins, erosion control blanketing, inlet protection, mulching and reseeding, and other BMP's to mitigate the potential for erosion across the site. Specialized BMP's shall be considered with the final drainage report and subsequent lot reports due to the nature of the proposed commercial uses.

EXISTING DRAINAGE CONDITIONS

Two major basin divides occur within the Hillcrest Acres Subdivision. The major basin divide between the Sand Creek and Jimmy Camp Creek watersheds is formed by US Highway 24 that borders the northwest boundary of the subdivision. The major basin divide between the Jimmy Camp Creek and the Peterson Field basin runs near the southwest corner of the site. Most of the land within the Hillcrest Acres subdivision discharges to the Marksheffel Road right-of-way. The City property along Highway 94 drains to the Hwy 94 right-of-way and concentrates at either the intersection of Hwy 94/24 or the intersection at Hwy 94 and Marksheffel Road.

Refer to the drainage basin descriptions below, the Marksheffel Road Final Drainage Report, as well as the Existing Drainage Map located within the Appendix of this report for detailed descriptions of historic drainage patterns.

Detailed Drainage Discussion

Design Point 1

Basin 664R consists of approximately 1.09 acres of the eastern half of existing Marksheffel Road and portions of Highway 24 located to the north and east of the site. The basin consists of an asphalt paved roadway surface, curb and gutter and a raised concrete median. Runoff from the basin is collected and conveyed within the roadway and 6" vertical curb and gutter to an existing public 5' Type R inlet (**IN664**) located at **Design Point 1** (Q5=5.1 Q100=9.1 cfs). Runoff collected by the inlet (Q5=2.7 Q100=3.4 cfs) is conveyed within a public 24" storm sewer (**PR664**) that discharges to an existing 5' wide

trapezoidal swale located on site. A riprap pad is located at the terminus of the storm sewer and riprap check dams have been installed below **DP1** to aid in damping discharge and preventing erosion. Runoff bypassing the inlet continues south within the curb and gutter to downstream infrastructure.

Design Point 2

Basin 662L consists of approximately 1.21 acres of existing western half of Marksheffel Road and portions of Highway 24 located to the north and east of the site. The basin consists of an asphalt paved roadway surface and curb and gutter. Runoff from the basin ($Q_5=5.6$, $Q_{100}=10.0$ cfs) is collected and conveyed within the western 6" vertical curb and gutter and pavement to a 5' Type R inlet (**IN662**) located at **Design Point 2**. Runoff collected by the inlet ($Q_5=3.0$ $Q_{100}=3.8$ cfs) is conveyed within a public 24" storm sewer (**PR662**) that discharges to the onsite 5' wide swale. A riprap pad is located at the terminus of the storm sewer. Runoff bypassing the inlet continues south within the curb and gutter to downstream infrastructure.

Design Point 3

Basin 661L consists of approximately 0.07 acres of the western half of Marksheffel Road located to the north and east of the site. The basin consists of an asphalt paved roadway surface and existing curb and gutter. Runoff from the basin ($Q_5=0.3$, $Q_{100}=0.6$ cfs) is collected and conveyed within the western 6" vertical curb and gutter and pavement to a 5' Type R inlet (**IN661**) located at **Design Point 3**. Runoff from **Basin 661L** combines with flow by from **IN662** at peak flow rates of 2.9 and 6.7 cfs in the 5 and 100 year events respectively. Runoff collected by the inlet ($Q_5=1.9$, $Q_{100}=3.2$ cfs) is conveyed within a public 18" storm sewer (**PR661**) that discharges to the onsite 5' swale. A riprap pad is located at the terminus of the storm sewer. Runoff bypassing the inlet continues south within the curb and gutter to downstream infrastructure.

Design Point 4


Basin A consists of approximately 4.67 acres within public right of way, north of the site which occurs as a result of the relocation of Marksheffel Road. This area is currently undeveloped and is covered in sparse prairie grasses and vegetation. Runoff from the basin ($Q_5=1.4$, $Q_{100}=10.2$ cfs) drains northwest to the southeast where it combines with the up-gradient roadway discharge from **DP's 1-3** within the existing onsite 5' earthen swale at **Design Point 4**. The combined runoff at **DP4** has been calculated to reach peak flow rates of 7.9 and 20.3 cfs in the 5 and 100 year storm events respectively. The runoff continues south into **Basin B**.

Design Point 5

Basin 654R consists of approximately 1.62 acres of existing Marksheffel Road, located to the east of the site. This basin consists of an asphalt paved roadway surface and existing curb and gutter. Runoff from the basin ($Q_5=7.1$, $Q_{100}=12.8$ cfs) drains from the west across the street onto the east side gutter, and then flows south until it combines with flow by of **IN664** is collected by an existing Type R 5' inlet (**IN654**: $Q_5=4.0$, $Q_{100}=5.4$ cfs). Runoff collected through this inlet will be conveyed within a 24" public storm sewer (**PR654**) across to the western side of the road where it will discharge into the existing 5' wide onsite swale. The combined flows for the 5 and 100 year events that reach the design point are $Q_5=10.3$ and $Q_{100}=21.6$ cfs. A riprap pad is located at the terminus of the storm sewer. Runoff bypassing the inlet continues south within the curb and gutter to downstream infrastructure.

Design Point 6

Basin B consists of 3.64 undeveloped acres, where a majority of the area is in Lots 19, 20, and the 5' swale on the west side of Marksheffel Road. **Basin B** is situated in the northeast corner of the proposed site. Runoff produced within **Basin B** is anticipated to reach peak runoff rates of $Q_5=1.0$ and $Q_{100}=7.3$ cfs and will flow south towards **Design Point 6**, where it combines with runoff of **DP4**, **DP5**, and **PR654**. The combined flows for the 5 and 100 year events in this basin are 10.5 and 28.4 cfs, respectively. Runoff from this design point continues to flow south.

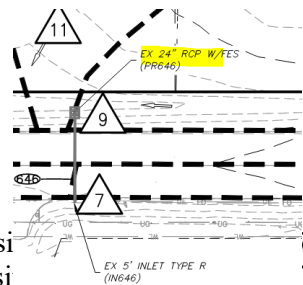

Revise. Drainage Map identifies this as 24"

Design Point 7

Basin 646R consists of approximately 7.5 acres of undeveloped land located to the east of the site. This basin consists of an asphalt paved roadway surface and existing curb and gutter. Runoff from the basin ($Q_5=3.4$, $Q_{100}=4.7$ cfs) drains from the crown of the road down to the east side gutter, and then flows south until it combines with **Basin 646R** and is collected by an existing Type R 5' inlet **IN646** at the design point ($Q_5=3.4$, $Q_{100}=4.7$ cfs). Runoff collected through this inlet will be conveyed to the western side of the road by entering an 18" public storm sewer **PR646** where it will discharge into the existing 5' wide onsite swale. The total combined 5 year and 100 year flows for this design point are 7.9 and 18.2 cfs, respectively. A riprap pad is located at the terminus of the storm sewer. Runoff bypassing the inlet continues south within the curb and gutter to downstream infrastructure.

Design Point 8

Basins C and D consist of approximately 2.51 and 2.10 acres, respectively, of existing U.S. Highway 24 located to the northwest of the site. These basins consist of an asphalt paved roadway, and a grass-lined swale on the east side. Runoff from the two basins (**Basin C**: $Q_5=5.5$, $Q_{100}=11.3$ cfs; **Basin D**: $Q_5=3.7$, $Q_{100}=8.8$) are conveyed south in the swale towards **Design Point 22**, where they combine at peak flowrates of $Q_5=8.6$, $Q_{100}=18.8$ cfs in the 5 and 100 year events, respectively. CDOT will repair this ditch so that flows do not enter the site.

Design Point 9

Basin E consists of approximately 10.82 acres of Lots 17, 18, and 19 located on the north side of the site. Currently the basin consists of undeveloped land covered by sparse prairie grasses and vegetation. Runoff from the basin ($Q_5=2.9$, $Q_{100}=21.1$ cfs) combines with runoff from **DP6**, **DP8**, and **PR646** in the 5' swale. The combined runoff at **DP9** has been calculated to reach peak flow rates of 23.5 and 69.0 cfs in the 5 and 100-year storm events, respectively.

Design Point 10

Basin H consists of approximately 15.03 acres of Lots 13, 14, and 15, along the west side of the site. This undeveloped basin is sparse prairie grasses and vegetation. Runoff from the basin ($Q_5=3.4$, $Q_{100}=25.3$ cfs) drains from the south to north until it collecting in a localized depression area. The effects from temporary ponding were not considered in hydrologic analysis. Runoff continues east, where it enters **Basin G**.

Design Point 11

Basin G consists of approximately 8.99 acres of Lots 15, 16, and 18 located near the center of the site. This basin consists of undeveloped land covered by sparse prairie grasses and vegetation. **Basin G** ($Q_5=2.2$, $Q_{100}=15.9$ cfs) drains west to east where it collects with flow from **DP10** and **Basin F** (similar to Basins C and D) in the swale, and continues south. The combined flow at **DP11** has been calculated to reach peak flow rates of 6.8 and 45.2 cfs in the 5 and 100 year storm events, respectively.

Design Point 12

Basin 641L consists of approximately 1.58 acres of the west side of Marksheffel Road, located east of the site. This basin is mainly comprised of an asphalt paved roadway surface and existing curb and gutter. Runoff from the basin ($Q_5=5.8$, $Q_{100}=10.4$ cfs) is directed to a 5' Type R existing inlet at the design point (**IN640**: $Q_5=2.9$, $Q_{100}=3.8$ cfs). Runoff collected by this inlet is conveyed to the 5' swale via a public 24" storm sewer, **PR640**. A riprap pad is located at the terminus of the storm sewer. Runoff bypassing the inlet continues south within the curb and gutter to downstream infrastructure.

Design Point 13

Basin I consists of approximately 4.22 acres of Lots 12 and 16, located along the east side of the site. This undeveloped basin is covered by sparse prairie grasses and vegetation, and a portion of a dirt road. Runoff from the basin ($Q_5=1.1$, $Q_{100}=8.4$ cfs) drains from the southern side of the basin, and then flows northeast until it combines with flows from **DP 9**, **DP11**, and **PR640**. An existing private 42" culvert (**PR639**) directs runoff under the Air Lane Drive entrance. The combined flow for the 5 year and 100 year events at the design point are 36.6 and 138.0 cfs, respectively. Flow from here will continue to head south in the 5' swale into the next basin.

Design Point 14

Basin 637R consists of approximately 0.91 acres of the eastern side of Marksheffel Road, located to the east of the site. This basin consists of a roadway surface and curb and gutter. Runoff from the basin ($Q_5=3.1$, $Q_{100}=5.5$ cfs) drains from the median on the west side into the east side gutter, and then flows south until it combines with **FBIN646** at 5 and 100 year peak runoffs of 5.9 and 14.5 cfs, and is collected by an existing Type R 5' inlet at the design point (**IN636**: $Q_5=3.0$, $Q_{100}=4.3$ cfs). Runoff collected through this inlet is conveyed to the western side of the road through an existing public 24" storm sewer (**PR636**) where it will discharge into the existing 5' wide onsite swale. A riprap pad is located at the terminus of the storm sewer. Runoff bypassing the inlet continues south within the curb and gutter to downstream infrastructure.

Design Point 15

Basin J consists of approximately 2.88 acres of Lots 10, 11, and 12, on the east side of the site. This undeveloped basin is covered by sparse prairie grasses and vegetation, a portion of a dirt road, and a swale on the west side of the road. Runoff from the basin ($Q_5=0.8$, $Q_{100}=5.6$ cfs) drains from the western side of the basin, and then flows east until it combines with flows from **DP13** and **PR636**. The combined flow for the 5 year and 100 year events at **DP15** are 38.3 and 139.7 cfs, respectively. This flow continues south within the 5' swale on the west side of the road.

Design Point 16

Basin J1 consists of approximately 2.67 acres of Lots 10 and 11, and a portion of the swale on the located on the southeast side of the site. This undeveloped basin is comprised of sparse prairie grasses and vegetation, and a portion of the existing 5' swale on the west of the road. Runoff from the basin ($Q_5=0.7$, $Q_{100}=4.9$ cfs) drains from the western side of the basin, and then flows southeast until it combines with flows from **DP15**. The combined flow for the 5 year and 100 year events at the design point are 35.3 and 131.7 cfs, respectively. This flow will collect in an existing Type C area inlet and will continue south-southwest through an existing 24" public storm sewer, **PRE2**, into an existing concrete channel and water quality pond. Flows are currently expected to overtop the pipe and berm. An existing rip rap rundown is provided to prevent erosion.

Design Point 17

Basin 631R consists of approximately 0.56 acres of the existing eastern side of Marksheffel Road, located to the southeast of the site. This basin consists of an asphalt paved roadway surface and existing curb and gutter. Runoff from the basin ($Q_5=2.4$, $Q_{100}=4.2$ cfs) drains from the median on the west side into the east side gutter, and then flows south until it combines with **FBIN636** at 5 and 100 year peak runoffs of 4.0 and 11.7 cfs, and is collected by an existing Type R 5' inlet at the design point (**IN630A**: $Q_5=2.5$, $Q_{100}=4.1$ cfs). Runoff collected through this inlet is conveyed to the western side of the road through an existing public 24" storm sewer (**PR630A**) where it will discharge into existing public 24" storm sewer (**PR630B**), which then discharges into the existing water quality pond. A riprap pad is located at the terminus of the storm sewer. Runoff bypassing the inlet continues south within the curb and gutter to downstream infrastructure.

Design Point 18

Basin 632L consists of approximately 1.21 acres of the existing western side of Marksheffel Road, located to the southeast of the site. This basin consists of an asphalt paved roadway surface and existing curb and gutter. Runoff from the basin ($Q_5=4.5$, $Q_{100}=8.1$ cfs) drains from the median on the east side into the west side gutter, and then flows south, combining with **FBIN640** at rates of $Q_5=5.8$ and $Q_{100}=11.6$ cfs until it is collected by an existing Type R 15' inlet at the design point (**IN630B**: $Q_5=5.8$, $Q_{100}=10.3$ cfs). Runoff collected through this inlet is conveyed west through an existing public 24" storm sewer (**PR630B**), where it discharges into the existing concrete channel. A riprap pad is located at the terminus of the storm sewer. Runoff bypassing the inlet continues south within the curb and gutter to downstream infrastructure.

Design Point 19

Basin L consists of approximately 0.35 acres of the existing western side of Marksheffel Road, on the southeast side of the site, which curves and turns into U.S. Highway 94, located to the south of the site. This basin consists of an asphalt paved roadway surface with an existing curb and gutter along a portion of the road. Runoff from the basin ($Q_5=1.6$, $Q_{100}=2.9$ cfs) drains from the median on the south side into the north side gutter, and then drains east. It combines with **FBIN630B** at rates of 1.7 and 4.9 cfs in the 5 and 100 year events, and is then collected by an existing public 12" plastic corrugated pipe (**PRE1**) at **DP19** ($Q_5=1.7$, $Q_{100}=4.1$ cfs). The collected flows are then conveyed north to a small concrete detention area. A riprap pad is located at the terminus of the plastic storm sewer. Runoff bypassing the inlet continues east within the curb and gutter to downstream infrastructure.

Design Point 20

Basin K consists of approximately 3.33 acres of Lot 11 public right of way on the south side of the site. This undeveloped basin is comprised of sparse prairie grasses and vegetation. Runoff from the basin ($Q_5=0.9$, $Q_{100}=6.8$ cfs) drains from the northern side of the basin to the south until it combines with flows from **DP16**, **PR630B**, and **PRE1** in the existing water quality pond at the southeastern end of the site. A rip rap pad is located at the terminus of the outlet structure. The combined flow for the 5 year and 100 year events at the design point are 42.2 and 149.5 cfs, respectively. From here the flow will continue to drain west.

Design Point 21

Basin M consists of approximately 13.93 acres of Lots 9, 10, 16 and public right of way, and is located on the south side of the site. This undeveloped basin is comprised primarily of sparse prairie grasses and vegetation. Runoff from the basin ($Q_5=4.0$, $Q_{100}=28.8$ cfs) drains from the northern side of the basin to the south until it combines with flows from **DP20** at the existing water quality pond outlet structure at the southeastern end of the site. **Basin N** consists of approximately 0.71 acres of the existing northern side of U.S. Highway 94, located to the south of the site. This basin consists of an asphalt paved roadway surface and existing grassy swale on the north side of the road. Runoff from this basin ($Q_5=3.3$, $Q_{100}=5.9$ cfs) drains from the median on the south side into the aforementioned swale to the north, and then flows east until it combines with flows from **Basin M** and **DP20**. Combined flows for the 5 year and 100 year events are 47.4 and 177.1 cfs, respectively. From here, the combined flows drain offsite to the south through an existing 42" CMP storm sewer (**E3**), which discharges into a broad, natural swale.

Design Point 22

Basin O consists of approximately 11.52 acres of Lots 9, 13, 16 and public right of way, and is located on the southwestern side of the site. This undeveloped basin is comprised primarily of sparse prairie grasses and vegetation, with a 31' wide dirt road running through it. Runoff from the basin ($Q_5=2.7$, $Q_{100}=20.2$ cfs) drains from the northeast side of the basin to the southwest until it runs into a localized depression. **Basin P** has a similar land description as the aforementioned basin, except it is approximately 9.17 acres in size, contains a portion of the grassy swale on the eastern side of U.S. Highway 24, and is comprised of Lot 6, 14, and public right of way. Runoff from this basin ($Q_5=2.4$,

Q100=17.9 cfs) drains from north to south, and also drains into the depression. Lastly, **Basin Q** consists of approximately 1.41 acres of existing U.S. Highway 94, and is located on the southwestern side of the site. This basin is comprised of an asphalt paved roadway surface. Runoff from this basin (Q5=6.6, Q100=11.8 cfs) also drains into the depression. Flows for the 5 and 100 year storms at this design point are 10.4 and 51.1 cfs, respectively. This flow then exits the site through an existing public 48" corrugated metal pipe (E4).

PROPOSED DRAINAGE CHARACTERISTICS

General Concept Drainage Discussion

The majority of the site will consist of neighborhood commercial and light industrial zones, asphalt, curb, four full spectrum detention basins, and landscaping. The site will typically drain across asphalt and impermeable surfaces which direct runoff primarily to the south and southwest to proposed private pipe systems which direct runoff to one of four private ponds. The outlet structures of the proposed FSD ponds will release runoff to the existing public 42" and 48" CMP public storm sewers located at the southeast and southwest corners of the site, respectively. A survey and inspection of these existing structures shall be made before use. The existing public 42" storm sewer connects to a proposed storm sewer system on the adjacent property, where it eventually reaches Jimmy Camp Creek. The concept storm system is proposed with the Reagan Ranch master development. An excerpt map of the MDDP for this development is included in the Appendix to show the general storm system location. The 48" CMP ties into an existing public storm sewer system which will route the remaining treated runoff to Sand Creek. For more information of drainage basins, existing and proposed structures refer to the Proposed Drainage Map located within the Appendix of this report.

Detailed Drainage Discussion

Design Point 1

Basin 664R consists of approximately 1.09 acres of the eastern half of existing Marksheffel Road and portions of Highway 24 located to the north and east of the site. The basin consists of an asphalt paved roadway surface, curb and gutter, and a raised concrete median. Runoff from the basin (Q5=5.1, Q100=9.1 cfs) is collected and conveyed within the roadway and 6" vertical curb and gutter to an existing public 5' Type R inlet (**IN664**) located at **Design Point 1** (Q5=5.1, Q100=9.1 cfs). Runoff intercepted by the inlet (Q5=2.7, Q100=3.4 cfs) is conveyed within a public 24" storm sewer (**PR664**) that discharges to an existing 5' bottom swale located off site. A riprap pad is located at the terminus of the storm sewer and riprap check dams have been installed below **DP1** to aid in damping discharge and preventing erosion. Runoff bypassing the inlet continues south within the curb and gutter to downstream infrastructure.

Design Point 2

Basin 662L consists of approximately 1.21 acres of existing western half of Marksheffel Road and portions of Highway 24 located to the north and east of the site. The basin consists of an asphalt paved roadway surface and curb and gutter. Runoff from the basin (Q5=5.6, Q100=10.0 cfs) is conveyed within the western 6" vertical curb and gutter and pavement to a 5' Type R inlet (**IN662**: Q5=3.0, Q100=3.8 cfs) located at **DP2**. This intercepted portion of flow is then conveyed within a public 24" storm sewer (**PR662**) that discharges to the onsite 5' wide swale. A riprap pad is located at the terminus of the storm sewer. Runoff bypassing the inlet continues south within the curb and gutter to downstream infrastructure.

Design Point 3

Basin 661L consists of approximately 0.07 acres of the western half of Marksheffel Road located to the north and east of the site. The basin consists of an asphalt paved roadway surface and existing curb and gutter. Runoff from the basin (Q5=0.3, Q100=0.6 cfs) combines with flowby from **DP2**, and is collected and conveyed within the western 6" vertical curb and gutter to a 5' Type R inlet (**IN661**: Q5=1.9, Q100=3.2 cfs) located at **Design Point 3**. The total flows that reach **DP3** are 2.9 and 6.7 cfs in the 5 and

100 year events, respectively. The intercepted portion of flow is then conveyed within a public 18" storm sewer (**PR661**) that discharges to the onsite 5' swale. A riprap pad is located at the terminus of the storm sewer. Runoff bypassing the inlet continues south within the curb and gutter to downstream infrastructure.

Design Point 4

Basin OS-1 consists of approximately 5.86 undeveloped acres of Tract D and Tract A that are located to the north of the site. The basin consists of sparse prairie grasses and natural vegetation. Runoff from the basin (Q5=1.6, Q100=11.9 cfs) is collected and conveyed in a 5' bottom earthen swale on the east side of the basin where it combines with flows from **DP3**. The combined 5 year and 100 year flow at this design point are 9.8 and 27.5 cfs, respectively. The runoff at this design point continues south towards downstream infrastructure.

Design Point 5

Basin 654R consists of approximately 1.62 acres of existing Marksheffel Road, located to the east of the site. This basin consists of an asphalt paved roadway surface and existing curb and gutter. Runoff from the basin (Q5=7.1, Q100=12.8 cfs) drains from the west across the street onto the east side gutter, and then flows south until it combines with flow bys of **DP1** and **DP3**, which is collected by an existing Type R 5' inlet (**IN654**:Q5=4.0, Q100=5.4 cfs) at the design point. Runoff collected through this inlet will be conveyed within a proposed 24" public storm sewer (**PR654**) across to the western side of the road where it will discharge into the existing 5' bottom roadside ditch at rates of 10.3 and 21.6 cfs in the 5 year and 100 year events, respectively. A riprap pad is located at the terminus of the storm sewer. Runoff bypassing the inlet continues south within the curb and gutter to downstream infrastructure.

Design Point 6

DP6 is located directly west of **DP5**, and represents the collection of flows from **DP4** and **PR654** inside the existing, 5' bottom earthen swale, from which **Basin RD-3** is comprised of. This swale consists of undeveloped land covered by sparse prairie grasses and vegetation. Future infrastructure and/or maintenance may be required at this location. Combined runoffs for the 5 year and 100 year storms at the design point are 12.3 and 29.3 cfs, respectively, which continue south to downstream infrastructure.

Design Point 7

Basin A consists of approximately 10.42 acres of Lots 4, 5, 6, and Tract A, which are proposed commercial parcels of land located to the north on-site. Runoff from this basin (Q5=43.2, Q100=78.8 cfs) collects at the south-eastern end and is conveyed south into the FSD pond (**Pond 1**) at **DP9** through a proposed 42" private RCP storm sewer (**A1**) at the design point.

Design Point 8

Basin C consists of approximately 6.38 acres of Lots 7, 8, 9, 10, and 11, which are proposed, commercial parcels of land located to the north east on-site. Runoff from this basin (Q5=26.6, Q100=48.4 cfs) collects on the eastern side, which borders **Basin D**, and is conveyed south into the FSD pond (**Pond 1**) at **DP9** through a proposed 36" private RCP storm sewer (**C1**).

Design Point 9

Basin D consists of approximately 2.70 acres of a proposed FSD pond. Runoff from this basin (Q5=1.6, Q100=8.9 cfs) combines with flows from **DP7**, **DP8**, and **DP13** at 5 yr and 100 yr rates of 101.3 and 190.5 cfs, respectively, and drains to the southern end of the pond, where it is routed through the outlet structure into a proposed private 18" RCP storm sewer (**D1**) to discharge into **Basin RD-4**. A rip rap pad is proposed at the terminus of the storm sewer. From this point the routed runoff will be directed south towards downstream infrastructure.

Design Point 10

Basin RD-3 consists of approximately 0.82 acres of existing 5' bottom earthen CDOT swale. Runoff from this basin (Q5=0.3, Q100=2.0 cfs) combines with flows from **DP6** at 5 yr and 100 yr rates of

13.9 and 34.7 cfs, respectively, and is conveyed under the road through dual proposed public 24" RCP culverts (**PR-DP10**). A rip rap pad is proposed at the terminus of the culvert.

Design Point 11

Basin 646R consists of approximately 0.75 acres of the east side of existing Marksheffel Road, located to the east of the site. This basin consists of an asphalt paved roadway surface and existing curb and gutter. Runoff from the basin ($Q_5=3.5$, $Q_{100}=6.2$ cfs) drains from the crown of the road down to the east side gutter, and then flows south until it combines with flowby from **DP5** and is collected by an existing Type R 5' inlet (**IN646**: $Q_5=3.4$, $Q_{100}=4.7$ cfs). Runoff collected through this inlet will be conveyed to the western side of the road by entering an 18" public storm sewer **PR646** where it will discharge into the existing 5' wide CDOT swale. The total combined 5 year and 100 year flows for this design point are 7.9 and 18.1 cfs, respectively. A riprap pad is located at the terminus of the storm sewer. Runoff bypassing the inlet continues south within the curb and gutter to downstream infrastructure.

Design Point 12

DP12 is located directly west of **DP11**, and represents the collection of flows from **PR646** and **PR-DP10** inside the existing, 5' bottom earthen swale in **Basin RD-4**. This swale currently consists of undeveloped land covered by sparse prairie grasses and vegetation. Combined runoffs for the 5 year and 100 year storms at this design point are 15.2 and 34.0 cfs, respectively, which continue south to downstream infrastructure.

Design Point 13

Basin 641L consists of approximately 1.58 acres of the west side of Marksheffel Road, located east of the site. This basin is mainly comprised of an asphalt paved roadway surface and existing curb and gutter. Runoff from the basin ($Q_5=5.8$, $Q_{100}=10.4$ cfs) is directed to a 5' Type R existing inlet (**IN640**: $Q_5=2.9$, $Q_{100}=3.8$ cfs) at **DP12**. Runoff collected by this inlet is conveyed to the 5' swale in **Basin RD-4** via a public 24" storm sewer, **PR640**. A riprap pad is located at the terminus of the storm sewer. Runoff bypassing the inlet continues south within the curb and gutter to downstream infrastructure.

Design Point 14

Basin B consists of approximately 8.21 acres of Lot 3 and a portion of Lot 4. These are proposed, commercial parcels of land located to the north west on-site. Runoff from this basin ($Q_5=31.6$, $Q_{100}=57.6$ cfs) collects on the eastern side and is conveyed south into the FSD pond (**Pond 1**) at **DP9** through a proposed 42" private RCP storm sewer (**B1**). A forebay is proposed at the terminus of the storm sewer.

Design Point 15

Basin F consists of approximately 10.92 acres of Lot 3 and a portion of Lot 4. These are proposed, commercial parcels of land located to the north west on-site. Runoff from this basin ($Q_5=36.2$, $Q_{100}=66.0$ cfs) collects on the eastern side and is conveyed east into the FSD pond (**Pond 2**) at **DP16** through a proposed 42" private RCP storm sewer (**F1**).

Design Point 16

Basin E consists of approximately 1.72 acres of a proposed FSD pond and associated structures. Runoff from this basin ($Q_5=0.8$, $Q_{100}=4.6$ cfs) combines with flows from **DP15** and drains to the south east end of the pond, where it collects into a proposed private 18" RCP storm sewer (**PR641**) to discharge into CDOT's existing swale. A rip rap pad is located at the terminus of the storm sewer. The combined flow for the 5 year and 100 year events at the design point are 37.0 and 70.6 cfs, respectively. From this point the routed flows will be directed south towards downstream infrastructure.

Design Point 17

Basin RD-4 consists of approximately 1.39 acres of the existing 5' earthen swale located to the east, off-site. Runoff from the basin ($Q_5=0.4$, $Q_{100}=2.9$ cfs) drains from the north to the south, while collecting with flows from **PR640**, **DP12**, **DP16** and **DP9**. An existing public 42" RCP culvert (**PR639**)

Add design point 13, Pond 2 release and Pond 1 release.

See comment on the previous page. Explain the large discrepancy between existing flow and proposed flow.

directs runoff under the Air Lane Drive entrance. The combined flow at the design point are 15.4 and 48.5 cfs, respectively. The proposed flow at this design point [Q5=36.6, Q100=138.6 cfs] at this location.. A riprap pad is located at the terminus of the storm sewer. Flow from here will continue to head south in the 5' swale into the next basin.

Design Point 18

Basin 637R consists of approximately 0.91 acres of the eastern side of Marksheffel Road, and is located to the east of the site. This basin consists of a roadway surface and curb and gutter. Runoff from the basin (Q5=3.1, Q100=5.5 cfs) drains from the median on the west side into the east side gutter, and then flows south until it combines with flowby from **DP11** at 5 yr and 100 yr rates of 5.9 and 14.5 cfs, and is collected by an existing Type R 5' inlet at the design point (**IN636**:Q5=3.0, Q100=4.3 cfs). Runoff collected through this inlet is conveyed to the western side of the road through an existing public 24" storm sewer (**PR636**) where it discharges into the existing 5' bottom swale. A riprap pad is located at the terminus of the storm sewer. Runoff bypassing the inlet continues south within the curb and gutter to downstream infrastructure.

Design Point 19

DP19 is located directly west of **DP18**, and represents the collection of flows from **DP17** and **PR636** inside the existing, 5' bottom earthen swale in CDOT's right of way. Combined runoffs for the 5 year and 100 year storms at this design point are 16.9 and 48.4 cfs, respectively. The runoff then continues south to downstream infrastructure.

Design Point 20

Basin K consists of approximately 8.52 acres of proposed parks and recreation area. Runoff from this basin (Q5=5.2, Q100=22.6 cfs) collects on the south-eastern side, which borders **Basin L**, and is conveyed south into the FSD pond (**Pond 4**) at **DP21** through a proposed 30" private RCP storm sewer (**K1**).

Design Point 21

Basin L consists of approximately 0.83 acres of a proposed FSD pond. Runoff from this basin (Q5=0.6, Q100=3.1 cfs) combines with flows from **DP20** and drains to the southern end of the pond, where it collects into a proposed private 18" RCP storm sewer (**L1**). A rip rap pad is located at the terminus of the outlet structure. The combined flow for the 5 year and 100 year events at the design point are 6.2 and 27.2 cfs, respectively. From this point the runoff will be directed south towards downstream infrastructure.

Design Point 22

Basin 631R consists of approximately 0.56 acres of the existing eastern side of Marksheffel Road, located to the southeast of the site. This basin consists of an asphalt paved roadway surface and existing curb and gutter. Runoff from the basin (Q5=2.4, Q100=4.2 cfs) drains from the median on the west side into the east side gutter, and then flows south until it combines with flowby from **DP18** at peak 5 and 100 year rates of 4.0 and 11.7 cfs, and is collected by an existing Type R 5' inlet at the design point (**IN630A**: Q5=2.5, Q100=4.1 cfs). Runoff collected through this inlet is conveyed to the western side of the road through an existing public 24" storm sewer (**PR630A**) where it discharges into another existing public 24" storm sewer (**PR630B**). Runoff bypassing the inlet continues south within the curb and gutter to downstream infrastructure.

Design Point 23

Basin 632L consists of approximately 1.21 acres of the existing western side of Marksheffel Road, located to the southeast of the site. This basin consists of an asphalt paved roadway surface and existing curb and gutter. Runoff from the basin (Q5=4.5, Q100=8.1 cfs) drains from the median on the east side into the west side gutter, and collects with flowby from **DP13** to reach peak runoffs of Q5=5.9 and Q100=11.6 cfs at **DP23**. It is collected by an existing Type R 15' inlet at the design point (**IN630B**: Q5=5.9,

Q100=10.3 cfs). Runoff collected through this inlet is conveyed west through an existing public 24" storm sewer (**PR630B**). The storm sewer system then discharges into the existing water quality pond. A riprap pad is located at the terminus of the storm sewer. Runoff bypassing the inlet continues south within the curb and gutter to downstream infrastructure.

Design Point 24

Basin RD-5 consists of approximately 1.36 acres of the existing 5' earthen swale located to the east, off-site. Runoff from the basin (Q5=0.5, Q100=3.4 cfs) drains from the north to the south, while collecting with flows from **DP19**. This flow collects in an existing Type C area inlet and is conveyed south via 24" public RCP culvert (**PRE2**) into the existing water quality pond. The combined flow for the 5 year and 100 year events at the design point are 15.1 and 44.5 cfs, respectively. The proposed flow is lower than the existing flow [Q5=35.3, Q100=131.1 cfs] at this design point. Future infrastructure and/or maintenance may be required at this design point since flows are still expected to overtop **PRE2** during the 100 year event. A riprap pad is located at the overtopping location that continues to the terminus of the storm sewer.

Design Point 25

Basin OS-2 consists of approximately 0.35 acres of the existing western side of Marksheffel Road, on the southeast side of the site, which curves and turns into U.S. Highway 94, located to the south of the site. This basin consists of an asphalt paved roadway surface with an existing curb and gutter along a portion of the road. Runoff from the basin (Q5=1.6, Q100=2.9 cfs) drains from the median on the south side into the north side gutter, and then drains east. It is then collected by an existing public 12" plastic corrugated pipe (**PRE1**) and conveyed north to a small concrete detention area, combining with flow from **PR630B and PRE2**. The combined 5 year and 100 year storm flows at the design point are 1.0 and 3.3 cfs, respectively. A riprap pad is located at the terminus of the plastic storm sewer. Runoff bypassing the inlet continues east within the curb and gutter to downstream infrastructure.

Design Point 26

DP26 represents the combination of flows from **DP23-DP25** at the outlet structure of the existing water quality pond on the western side of the pond. The inside of this pond is comprised of sparse prairie grasses and vegetation, and a concrete channel. The total flow at this design point for the 5 year and 100 year storm events is 17.4 and 26.8 cfs, respectively. Detention effects were not considered in this analysis because the pond was not designed for storage. The proposed flow reaching this pond is lower than the existing flow [Q5=42.2, Q100=149.5 cfs] at this design point. A rip rap pad is located at the terminus of the outlet structure.

Design Point 27

Basin M consists of approximately 8.02 acres of CDOT right of way, and is located on the south side of the site. This undeveloped basin is comprised primarily of sparse prairie grasses and vegetation. Runoff from the basin (Q5=2.2, Q100=16.4 cfs) drains from the western side of the basin east until it combines with flows from **DP26** at the design point. **Basin OS-3** consists of approximately 0.72 acres of the existing northern side of U.S. Highway 94, located to the south of the site. This basin consists of an asphalt paved roadway surface and existing grassy ditch on the north side of the road. Runoff from this basin (Q5=2.8, Q100=5.0 cfs) drains from the median on the south side into the aforementioned ditch to the north, and then flows east until it combines with flows from **Basin M** and **DP26**. The combined flows for the 5 year and 100 year storm events are 23.4 and 50.9 cfs, respectively, which is lower than the existing flow [Q5=47.4, Q100=177.1 cfs] at this design point. Flows collect in an existing public 42" CMP culvert and are conveyed to a directly connected storm sewer system that is proposed with the Reagan Ranch master development. In the interim condition, flows continue to be discharged onto the existing rip rap pad and broad, natural swale at rates less than historic. Upstream and downstream analyses for the existing and proposed conditions at this design point are provided in the Appendix. The headwater over depth ratio at the culvert entrance is less than 1.7 as required by CDOT. Flows are closely in accordance with anticipated interception rates at this location with the Reagan Ranch MDDP (see Appendix).

Design Point 28

Basin RD-1 consists of approximately 4.42 acres of an existing, triangular, earthen swale and paved roadway located to the west, on the east side of Highway 24, off-site. Runoff from the basin (Q5=8.2, Q100=16.6 cfs) drains from the north to the south and continues into **DP29**.

Design Point 29

Basin RD-2 consists of approximately 2.40 acres of the existing 5' earthen swale and paved roadway located to the west, on the east side of the highway, off-site. Runoff from the basin (Q5=0.7, Q100=5.3 cfs) combines with **DP27** and drains from the north to the south with 5 year and 100 year flows of 6.5 and 15.7 cfs, respectively. Flows continue into **DP33**.

Design Point 30

Basin G consists of approximately 3.97 acres of Lot 1 and CDOT Right of Way. CDOT will provide access to grading on-site. Lot 1 is a proposed commercial parcel of land. Runoff from this basin (Q5=15.9, Q100=29.0 cfs) collects on the southern side, which borders **Basin I**, and is conveyed south into the FSD pond (Pond 3) at **DP32** through a proposed 30" private RCP storm sewer (**G1**).

Design Point 31

Basin J consists of approximately 8.90 acres of developed parks and recreation area, and is located to the south-west on-site. CDOT will provide access to grading on site. Runoff from this basin (Q5=4.9, Q100=21.1 cfs) collects on the south-western side, which borders **Basin I**, and is conveyed south into the FSD pond (Pond 3) at **DP32** through a proposed 30" private RCP storm sewer (**J1**). A riprap pad is located at the terminus of the storm sewer.

Design Point 32

Basin I consists of approximately 1.62 acres of a proposed FSD pond. Runoff from this basin (Q5=0.8, Q100=4.3 cfs) combines with flows from **DP30** and **DP31** and drains to the south-western end of the pond, where it collects into a proposed public 18" RCP storm sewer to discharge into **Basin H**. A rip rap pad is located at the terminus of the outlet structure. The combined flow for the 5 year and 100 year events at the design point are 23.2 and 62.6 cfs, respectively. From this point, the runoff will be directed southwest towards downstream infrastructure.

Design Point 33

Basin H consists of approximately 7.98 acres of public right of way, and is located on the south side of the site. This undeveloped basin is comprised primarily of sparse prairie grasses and vegetation. Runoff from the basin (Q5=2.3, Q100=16.5 cfs) drains from the western side of the basin east until it combines with flows from **DP32** at the existing public 48" CMP culvert (**E4**) at the southwestern end of the site. **Basin OS-4** consists of approximately 1.41 acres of the existing northern side of U.S. Highway 94, located to the south of the site. This basin consists of an asphalt paved roadway surface and existing grassy swale on the north side of the road. Runoff from this basin (Q5=4.9, Q100=8.8 cfs) drains from the median on the south side into the aforementioned swale to the north, and then flows east until it combines with flows from **Basin H** and **DP31**. The combined flows for the 5 year and 100 year storm events at the design point are 10.2 and 34.1 cfs, respectively. These flows are lower than the existing flows [Q5=10.4, Q100=51.1 cfs] at this design point. The headwater over depth ratio is less than 1.7 as required by CDOT. An upstream and downstream analysis at this design point can be found in the Appendix.

WATER QUALITY PROVISIONS AND MAINTENANCE

There are four Full Spectrum Detention (FSD) ponds being proposed for this site in order to reduce the fully developed flows from the site to pre-development levels and address detention and water quality.

These ponds have been sized utilizing MHFD v4.03 from Urban Drainage and Flood Control District (UDFCD). These ponds are being constructed with an outlet control structure which limits the release rate of the pond through the use of orifices, weirs, and restrictor plates placed before the proposed outlet pipes. Riprap aprons will be constructed to dissipate energy and prevent local scour at the outlet. These ponds have been sized to store the WQCV, EURV, and the flood control volumes for the 2, 5, 10, 25, 50, and 100 year storm events. The WQCV will be slowly released over 40 hours. The 100 year will drain in less than 120 hours.

Pond 1 will treat approximately 27.71 acres of developed land and the maximum 100-Yr storage volume is 4.106 acre-feet. Pond 1 is being constructed with an outlet control structure and a proposed 18” RCP outlet pipe. Watershed imperviousness is 86.4%. An overflow emergency weir is proposed along the east embankment to safely convey flows to the nearby roadside swale in the event of outlet clogging. The emergency overflow weir will have a crest length of 30 feet, and a spillway design flow depth of 0.94 feet.

FSD Pond 1	WQCV	EURV	5 Year	100 Year
Maximum Volume Stored (acre-ft)	0.863	3.221	2.725	4.106
Maximum WS Elevation	6337.42	6339.61	6339.22	6340.29
Peak Inflow (cfs)(calc)			53.0	98.2
Peak Outflow (cfs)	0.4	1.3	1.2	16.6

Pond 2 will treat approximately 12.64 acres of developed land and the maximum 100-Yr storage volume is 1.739 acre-feet. Pond 2 is being constructed with an outlet control structure and a proposed 18” RCP outlet pipe. Watershed imperviousness is 83.0%. An overflow emergency weir is proposed along the south embankment to safely convey flows to the nearby swale in the event of outlet clogging. The emergency overflow weir will have a crest length of 12 feet, and a spillway design flow depth of 0.98 feet.

FSD Pond 2	WQCV	EURV	5 Year	100 Year
Maximum Volume Stored (acre-ft)	0.366	1.400	1.167	1.739
Maximum WS Elevation	6343.21	6344.79	6344.49	6345.21
Peak Inflow (cfs)(calc)			23.7	44.7
Peak Outflow (cfs)	0.1	0.6	0.5	7.8

Pond 3 will treat approximately 13.94 acres of developed land and the maximum 100-Yr storage volume is 0.772 acre-feet. Pond 3 is being constructed with an outlet control structure and a proposed 18” RCP outlet pipe. Watershed imperviousness is 34.8%. An overflow emergency weir is proposed along the south embankment to safely convey flows to the nearby swale in the event of outlet clogging. The emergency overflow weir will have a crest length of 8 feet, and a spillway design flow depth of 0.82 feet.

FSD Pond 3	WQCV	EURV	5 Year	100 Year
Maximum Volume Stored (acre-ft)	0.196	0.505	0.461	0.772
Maximum WS Elevation	6323.96	6324.66	6324.57	6325.16
Peak Inflow (cfs)(calc)			7.6	23.8
Peak Outflow (cfs)	0.1	0.2	0.2	9.3

Pond 4 will treat approximately 9.35 acres of developed land and the maximum 100-Yr storage volume is 0.203 acre-feet. Pond 4 is being constructed with an outlet control structure and a proposed 18” RCP outlet pipe. Watershed imperviousness is 12.5%. An overflow emergency weir is proposed along the east embankment to safely convey flows to the nearby swale in the event of outlet clogging. The emergency overflow weir will have a crest length of 5.0 feet, and a spillway design flow depth of 0.54 feet.

FSD Pond 4	WQCV	EURV	5 Year	100 Year
Maximum Volume Stored (acre-ft)	0.064	0.092	0.072	0.203
Maximum WS Elevation	6335.10	6335.26	6335.16	6335.73
Peak Inflow (cfs)(calc)			1.2	8.2
Peak Outflow (cfs)	0.0	0.0	0	5.6

The detention ponds are private and shall be maintained by the Crossroads Metropolitan District No. 2. It is important to note that the peak flow rate from the four ponds are less than those expected to reach the existing culverts and thus the downstream facilities.

Staff is verifying process/requirements for basin transfers and the associated drainage fee. Additional guidance will be provided on the resubmittal.

INTER-BASIN TRANSFER JIMMY CAMP CREEK TO PETERSON FIELD

It should be noted that the proposed grading (disturbance) of the development is 64.89 acres and will be comprised of 44.21 acres of Crossroads Subdivision Filing No.1, 18.6 acres of City of Colorado Springs property and 2.08 acres of ROW, and redistributes portions of the historic watershed between Jimmy Camp Creek and Peterson Field Drainage Basins. **Although this transfer occurs, proposed flows reaching the existing downstream drainage facilities are less than historic. The following is a summary of the transfer that occurs.**

Prior to development (grading) approximately 51.67 acres of the 64.89 acres fell within the Jimmy Camp Creek watershed with the remaining 13.22 acres in the Peterson Field Watershed.

After development (grading) approximately 1.80 acres (3.71 acres of Jimmy Camp Creek transferred to Peterson Field adjacent to Highway 94 and 1.91 acres of Peterson Field transferred to Jimmy Camp Creek adjacent to Highway 24; thus, a cumulative transfer of 1.80 acres to Peterson Field) will be redirected from the Jimmy Camp Creek Drainage Basin into Peterson Field Drainage Basin.

The 1.80 cumulative transferred acres to Peterson Field (Total = 15.02 acres) will be accounted for in the Drainage Fees, along with the 49.87 acres of Jimmy Camp Creek.

This modification change is driven by grading constraints associated with the lot layout and existing topography coupled with a sensible utility layout.

It should be noted that the proposed Full Spectrum Pond No. 3 and 4 provides detention and releases at or below the historic discharge rates thereby reducing any flood management impacts from the inter-basin transfer.

EROSION CONTROL

It is the policy of El Paso County that a grading and erosion control plan be submitted with the drainage report. Proposed silt fence, vehicle traffic control, reseeding and mulching, straw bale barriers, and temporary sediment basins are proposed as a few of the erosion control measures.

DRAINAGE & BRIDGE FEES

Crossroads North subdivision lays within the Jimmy Camp Creek and Peterson Field Drainage Basins. Crossroads North will be platted in one or multiple phases or final plats. Crossroads North will be a re-plat of Hillcrest Acres, originally platted in 1960. The County Drainage Fee program did not exist in 1960, therefore drainage and bridge fees will be required to be paid. The 2022 El Paso County drainage fees are as follows. Jimmy Camp Creek currently requires an added surety of \$7,285 to the drainage fee. All or a

Change to \$21,134 and add a third line for the Surety Fee. The surety is tracked separately by the County.

portion of this surety shall be reimbursed once the Jimmy Camp Creeks are based on 63.3% imperviousness.

Jimmy Camp Creek						
Drainage Fees:	49.87	x	63.3%	x	\$28,419.00	= \$ 897,122.75
Bridge Fees:	49.87	x	63.3%	x	\$989.00	= <u>\$ 31,220.47</u>
						Subtotal \$ 928,343.22
Peterson Field						
Drainage Fees:	15.02	x	63.3%	x	\$15,243.00	= \$ 144,925.26
Bridge Fees:	15.02	x	63.3%	x	\$1,156.00	= <u>\$ 10,990.85</u>
						Subtotal \$ 155,916.11
						TOTAL: \$1,084,259.33

SUMMARY

Development of Crossroads North will not adversely affect the surrounding development. The proposed drainage facilities will adequately convey, detain and route runoff from the onsite & offsite flows to existing facilities, as well as provide detention and water quality treatment. All drainage facilities described herein and shown on the included Proposed Drainage Map (See Appendix) are subject to change being dependent upon individual lot development. However, this MDDP should be used as a guideline for release of flows offsite, and final Full Spectrum Detention Pond sizing. Care will be taken to accommodate overland emergency flow routes on site and temporary drainage conditions.


and PDR

REFERENCES

- 1.) "El Paso County and City of Colorado Springs Drainage Criteria Manual".
- 2.) "Urban Storm Drainage Criteria Manual"
- 3.) Web Soil Survey, USDA NRCS Soils Map <https://websoilsurvey.sc.egov.usda.gov/App/HomePage.htm>
- 4.) FEMA flood Map Service Center, Federal Emergency Management Agency
<https://msc.fema.gov/portal/home>
- 5.) "Master Development Drainage Plan Preliminary and Final Drainage Report Hillcrest Acres Subdivision Parts Depot, El Paso County", last revised February 9, 2017, by Kiowa Engineering Corporation
- 6.) "Jimmy Camp Creek - Drainage Basin Planning Study Development of Alternatives & Design of Selected Plan Report" dated March 9, 2015 by Kiowa Engineering Corporation.
- 7.) "Marksheffel Road South, Link Road to US-24, Final Drainage Report" dated January 2017 by HDR Engineering.
- 8.) "Master Development Drainage Report for Reagan Ranch & Final Drainage Report for High Plains at Reagan Ranch" dated February 2021 by Matrix Design Group.

APPENDIX

VICINITY MAP

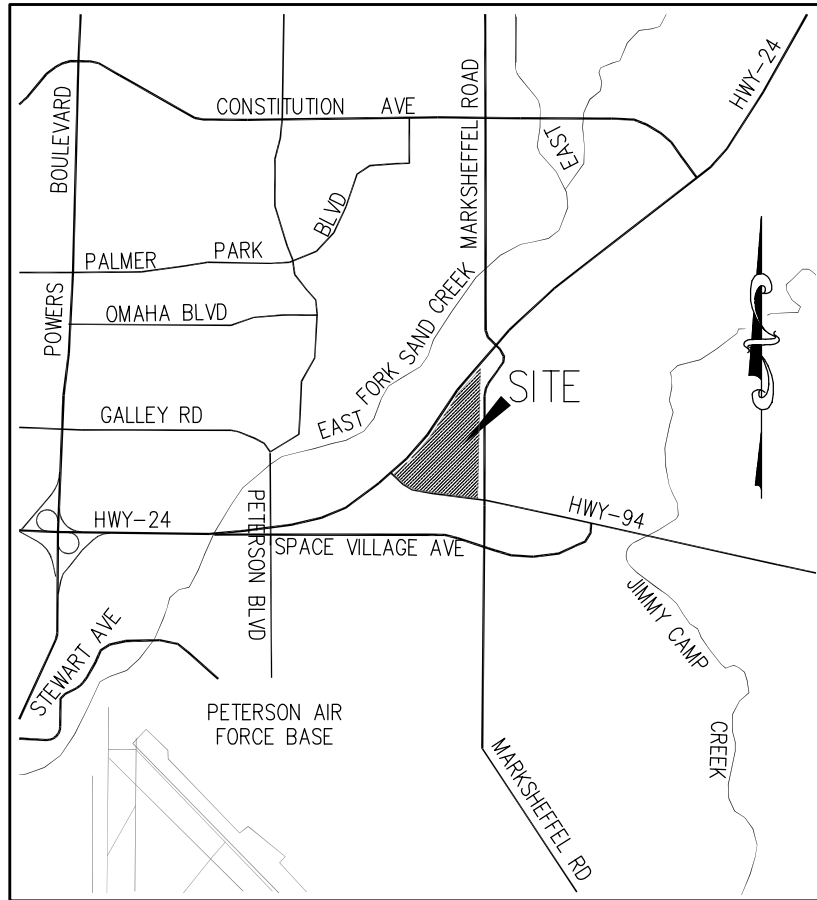


VICINITY MAP


N.T.S.

SOILS MAP

Soil Map—El Paso County Area, Colorado
(CROSSROADS)

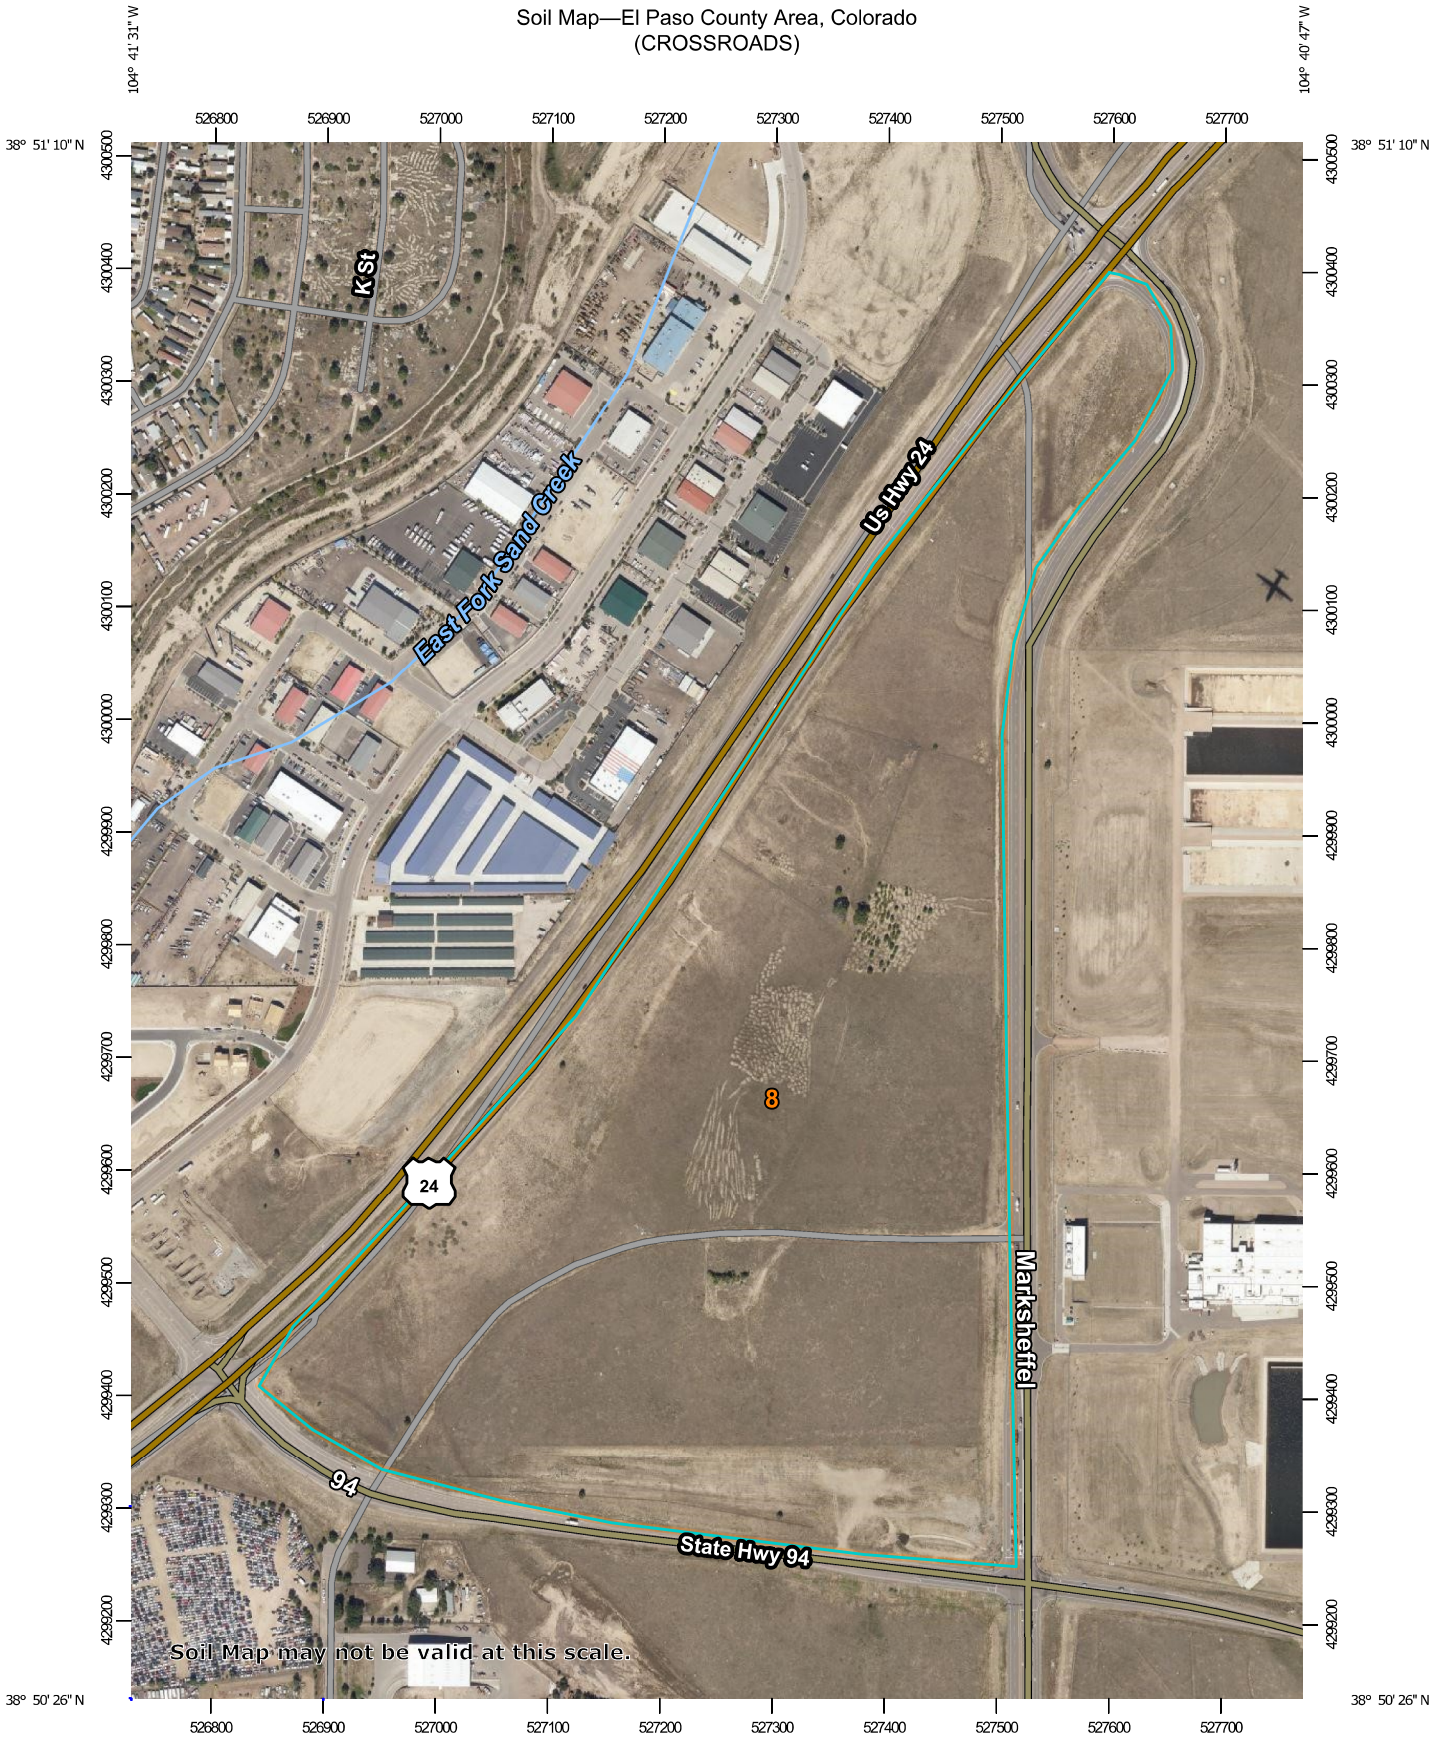



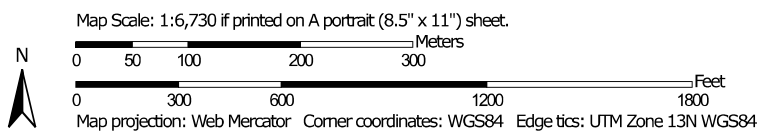

































Soil Map may not be valid at this scale.



Soil Map—El Paso County Area, Colorado
(CROSSROADS)

MAP LEGEND

Area of Interest (AOI)			Spoil Area
	Area of Interest (AOI)		Stony Spot
Soils			Very Stony Spot
	Soil Map Unit Polygons		Wet Spot
	Soil Map Unit Lines		Other
	Soil Map Unit Points		Special Line Features
Special Point Features		Water Features	
	Blowout		Streams and Canals
	Borrow Pit	Transportation	
	Clay Spot		Rails
	Closed Depression		Interstate Highways
	Gravel Pit		US Routes
	Gravelly Spot		Major Roads
	Landfill		Local Roads
	Lava Flow	Background	
	Marsh or swamp		Aerial Photography
	Mine or Quarry		
	Miscellaneous Water		
	Perennial Water		
	Rock Outcrop		
	Saline Spot		
	Sandy Spot		
	Severely Eroded Spot		
	Sinkhole		
	Slide or Slip		
	Sodic Spot		

MAP INFORMATION

The soil surveys that comprise your AOI were mapped at 1:24,000.

Warning: Soil Map may not be valid at this scale.
Enlargement of maps beyond the scale of mapping can cause misunderstanding of the detail of mapping and accuracy of soil line placement. The maps do not show the small areas of contrasting soils that could have been shown at a more detailed scale.

Please rely on the bar scale on each map sheet for map measurements.

Source of Map: Natural Resources Conservation Service
Web Soil Survey URL:
Coordinate System: Web Mercator (EPSG:3857)

Maps from the Web Soil Survey are based on the Web Mercator projection, which preserves direction and shape but distorts distance and area. A projection that preserves area, such as the Albers equal-area conic projection, should be used if more accurate calculations of distance or area are required.

This product is generated from the USDA-NRCS certified data as of the version date(s) listed below.

Soil Survey Area: El Paso County Area, Colorado
Survey Area Data: Version 18, Jun 5, 2020

Soil map units are labeled (as space allows) for map scales 1:50,000 or larger.

Date(s) aerial images were photographed: Aug 19, 2018—Sep 23, 2018

The orthophoto or other base map on which the soil lines were compiled and digitized probably differs from the background imagery displayed on these maps. As a result, some minor shifting of map unit boundaries may be evident.

Map Unit Legend

Map Unit Symbol	Map Unit Name	Acres in AOI	Percent of AOI
8	Blakeland loamy sand, 1 to 9 percent slopes	95.2	100.0%
Totals for Area of Interest		95.2	100.0%

FIRM PANELS



MAP SCALE 1" = 500'



NFP

PANEL 0756G

FIRM

FLOOD INSURANCE RATE MAP
EL PASO COUNTY,
COLORADO
AND INCORPORATED AREAS

PANEL 756 OF 1300
(SEE MAP INDEX FOR FIRM PANEL LAYOUT)

CONTAINS:

COMMUNITY	NUMBER	PANEL	SUFFIX
COLORADO SPRINGS, CITY OF	08000	0756	0
EL PASO COUNTY	08100	0756	0

Notice: This map was released on 08/16/2020. It is a preliminary map and is subject to change without notice. Please refer to the National Flood Insurance Program website for the most current information. No other-to-User Letter firm accompanied this correction for details.

Notice to User: This map is intended to be used for informational purposes only. It is not intended to be used for insurance purposes. The Department of the Interior, Federal Emergency Management Agency, is not responsible for any errors or omissions in this map. The Department of the Interior, Federal Emergency Management Agency, is not responsible for any errors or omissions in this map.



MAP NUMBER
08041C0756G

MAP REVISED
DECEMBER 7, 2018

Federal Emergency Management Agency

NATIONAL FLOOD INSURANCE PROGRAM

EL PASO COUNTY
CITY OF COLORADO

MARKSHEFFEL RD N

CITY OF
COLORADO SPRINGS
080060

8

EL PASO COUNTY
UNINCORPORATED AREAS
080059

AIR EN

WOLSEY HTS
SELIX GRV

6358
ZONE
AE
6355
6354



1370000 FT

38° 50' 37.50"
104° 41' 15.00"

This is an official copy of a portion of the above referenced flood map. It was extracted using F-MIT On-Line. This map does not reflect changes or amendments which may have been made subsequent to the date on the title block. For the latest product information about National Flood Insurance Program flood maps check the FEMA Flood Map Store at www.msc.fema.gov




MAP SCALE 1" = 500'



104° 41' 15.00"

38° 50' 37.50"

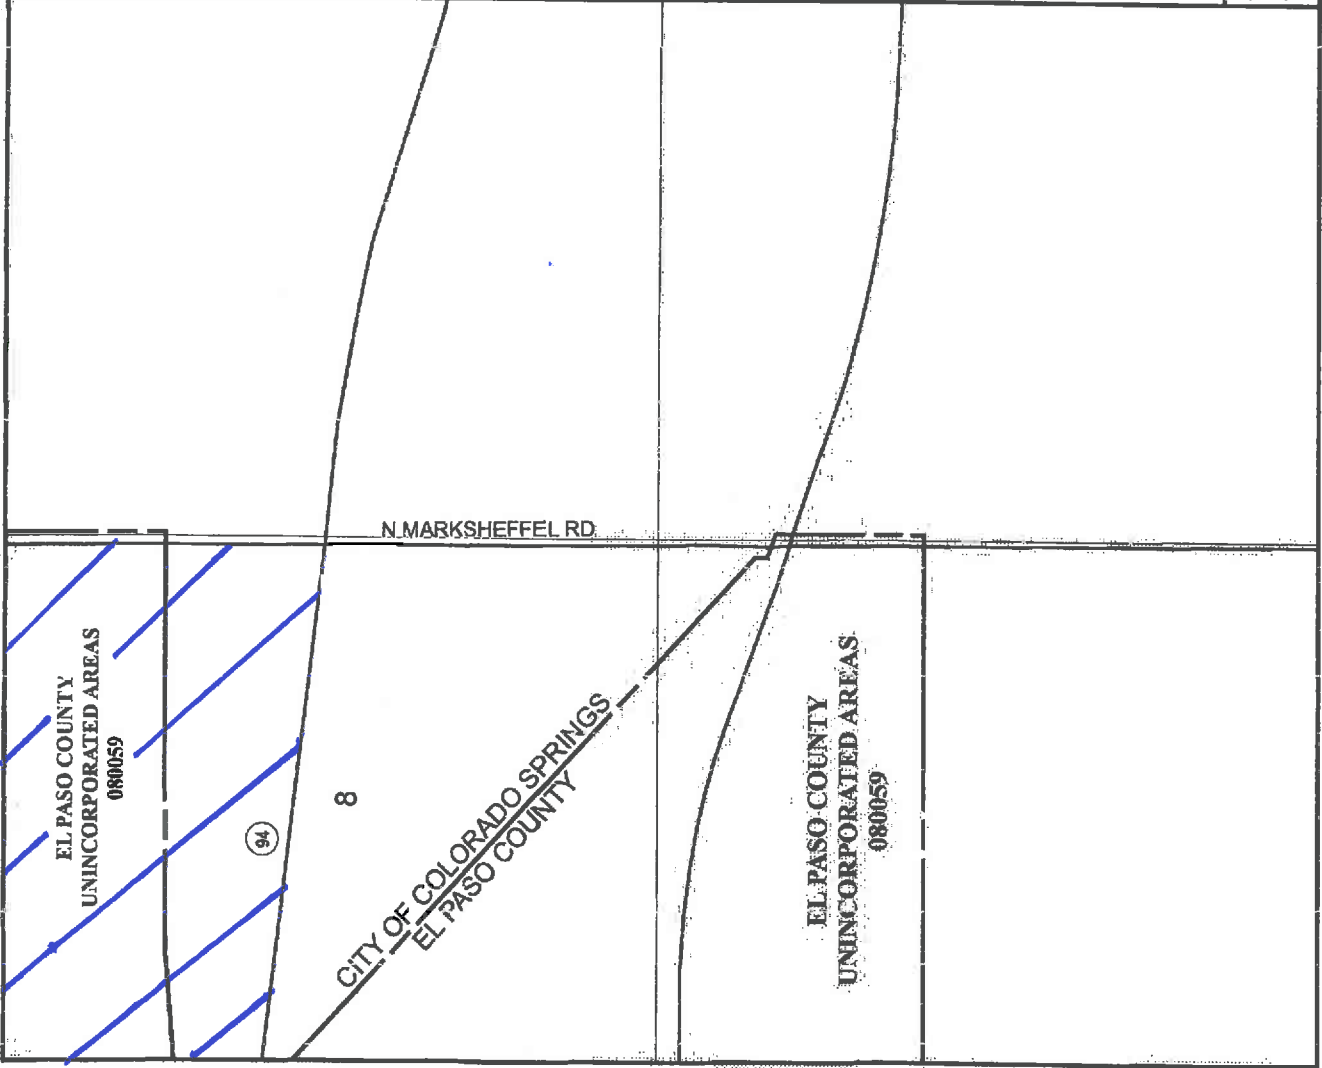

N.F.P.

PANEL 0758G

FIRM

FLOOD INSURANCE RATE MAP
EL PASO COUNTY,
COLORADO
AND INCORPORATED AREAS

PANEL 758 OF 1300
(SEE MAP INDEX FOR FIRM PANEL LAYOUT)

CONTAINS:

COMMUNITY	NUMBER	PANEL	SUFFIX
EL PASO COUNTY	0800	0758	G

Map of Issue: This map is a computer-generated map. It was prepared using the latest available data. It is subject to change without notice. For more information, contact the National Flood Insurance Program.



MAP NUMBER
08041C0758G

MAP REVISED
DECEMBER 7, 2018

Federal Emergency Management Agency

This is an official copy of a portion of the above referenced flood map. It was extracted using F-MIT CH-Line. This map does not reflect changes or amendments which may have been made subsequent to the date on the title block. For the latest product information about National Flood Insurance Program flood maps, check the FEMA Flood Map Store at www.msc.fema.gov




MAP SCALE 1" = 500'



104° 41' 15.00"
36° 50' 37.50"

3230000 FT

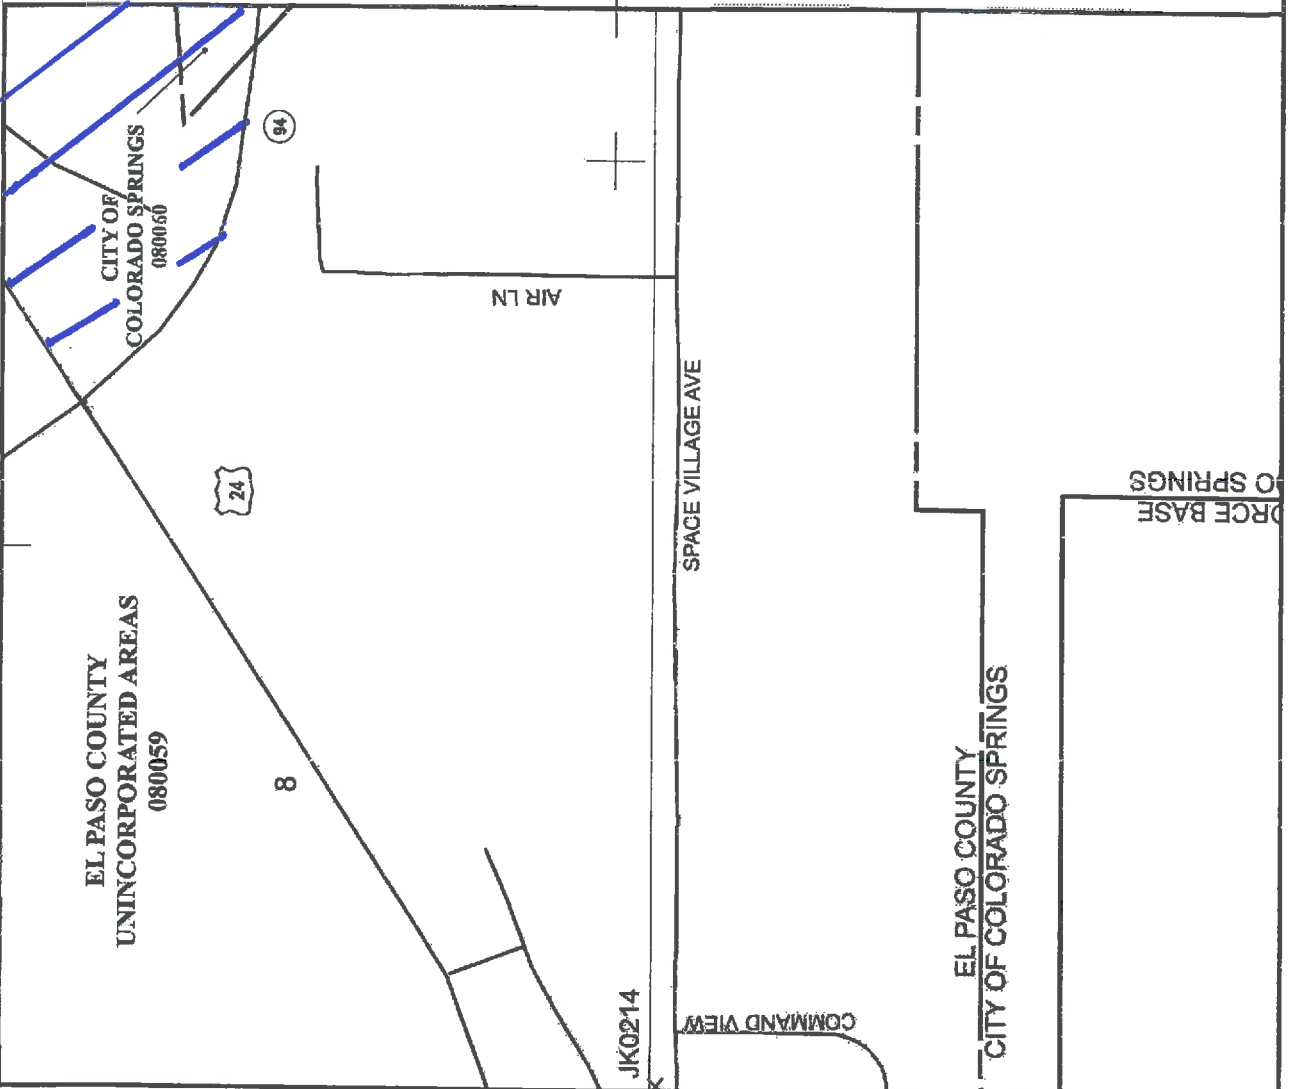

NFP

PANEL 0754G

FIRM

FLOOD INSURANCE RATE MAP
EL PASO COUNTY,
COLORADO
AND INCORPORATED AREAS

PANEL 754 OF 1300

(SEE MAP INDEX FOR FIRM PANEL LAYOUT)

CONTAINS:

COMMUNITY	NUMBER	PANEL	SUFFIX
COLORADO SPRINGS, CITY OF	080060	0754	0
EL PASO COUNTY	010059	0754	0

Notes: This map was released on 06/16/2008. It is the current map. The version number is 0754.0. The number-to-User Label that accompanied this correction for details.

Notes to User: The Map Number shown below should be used when placing map orders. The Community Number shown above should be used on insurance applications for the subject community.



MAP NUMBER
08041C0754G

MAP REVISED
DECEMBER 7, 2018

Federal Emergency Management Agency

This is an official copy of a portion of the above referenced flood map. It was extracted using F-MIT On-Line. This map does not reflect changes or amendments which may have been made subsequent to the date on the title block. For the latest product information about National Flood Insurance Program flood maps check the FEMA Flood Map Store at www.msc.fema.gov

HYDROLOGIC CALCULATIONS

CROSSROADS NORTH
EXISTING CONDITIONS DRAINAGE CALCULATIONS
(Area Runoff Coefficient Summary)

BASIN	TOTAL AREA (SF)	TOTAL AREA (Acres)	STREETS/DEVELOPED			DEVELOPED LOTS			UNDEVELOPED/LANDSCAPE			RUNOFF COEFFICIENT	
			AREA (Acres)	C ₅	C ₁₀₀	AREA (Acres)	C ₅	C ₁₀₀	AREA (Acres)	C ₅	C ₁₀₀	C ₅	C ₁₀₀
A	203381.3256	4.67	0.00	0.90	0.96	0.00	0.59	0.70	4.67	0.08	0.35	0.08	0.35
B	158516.3618	3.64	0.00	0.90	0.96	0.00	0.30	0.50	3.64	0.08	0.35	0.08	0.35
C	109239.8277	2.51	1.59	0.90	0.96	0.00	0.30	0.50	0.92	0.08	0.35	0.60	0.74
D	91440.6938	2.10	0.91	0.90	0.96	0.00	0.30	0.50	1.19	0.08	0.35	0.43	0.61
E	471391.0309	10.82	0.00	0.90	0.96	0.00	0.30	0.50	10.82	0.08	0.35	0.08	0.35
F	43435.2924	1.00	0.31	0.90	0.96	0.00	0.30	0.50	0.69	0.08	0.35	0.34	0.54
G	391802.4147	8.99	0.00	0.90	0.96	0.00	0.30	0.50	8.99	0.08	0.35	0.08	0.35
H	654546.7604	15.03	0.00	0.90	0.96	0.00	0.30	0.50	15.03	0.08	0.35	0.08	0.35
I	183810.6797	4.22	0.00	0.90	0.96	0.00	0.30	0.50	4.22	0.08	0.35	0.08	0.35
J	125261.6321	2.88	0.00	0.90	0.96	0.00	0.45	0.59	2.88	0.08	0.35	0.08	0.35
J1	116434.8196	2.67	0.00	0.90	0.96	0.00	0.45	0.59	2.67	0.08	0.35	0.08	0.35
K	145033.8974	3.33	0.00	0.90	0.96	0.00	0.45	0.59	3.33	0.08	0.35	0.08	0.35
L	15414.997	0.35	0.35	0.90	0.96	0.00	0.45	0.59	0.00	0.08	0.35	0.90	0.96
M	606580.5543	13.93	0.00	0.90	0.96	0.00	0.45	0.59	13.93	0.08	0.35	0.08	0.35
N	31084.7798	0.71	0.71	0.90	0.96	0.00	0.45	0.59	0.00	0.08	0.35	0.90	0.96
O	501674.7436	11.52	0.00	0.90	0.96	0.00	0.45	0.59	11.52	0.08	0.35	0.08	0.35
P	399360.1957	9.17	0.00	0.90	0.96	0.00	0.45	0.59	9.17	0.08	0.35	0.08	0.35
Q	61495.5769	1.41	1.41	0.90	0.96	0.00	0.45	0.59	0.00	0.08	0.35	0.90	0.96
631R	N/A	0.56	0.56	0.90	0.96	0.00	0.45	0.59	0.00	0.08	0.35	0.90	0.96
632L	N/A	1.21	1.21	0.90	0.96	0.00	0.45	0.59	0.00	0.08	0.35	0.90	0.96
637R	N/A	0.91	0.91	0.90	0.96	0.00	0.45	0.59	0.00	0.09	0.36	0.90	0.96
641L	N/A	1.58	1.58	0.90	0.96	0.00	0.45	0.59	0.00	0.09	0.36	0.90	0.96
646R	N/A	0.75	0.75	0.90	0.96	0.00	0.42	0.57	0.00	0.09	0.36	0.90	0.96
654R	N/A	1.62	1.62	0.90	0.96	0.00	0.39	0.55	0.00	0.09	0.36	0.90	0.96
661L	N/A	0.07	0.07	0.90	0.96	0.00	0.36	0.53	0.00	0.09	0.36	0.90	0.96
662L	N/A	1.21	1.21	0.90	0.96	0.00	0.33	0.51	0.00	0.09	0.36	0.90	0.96
664R	N/A	1.09	1.09	0.90	0.96	0.00	0.30	0.49	0.00	0.09	0.36	0.90	0.96

Italicized values taken from Marksheffel FDR

Calculated by: CVW
Date: 1/19/2022
Checked by: DLM

CROSSROADS NORTH

EXISTING CONDITIONS DRAINAGE CALCULATIONS

(Area Drainage Summary)

From Area Runoff Coefficient Summary				OVERLAND				STREET / CHANNEL FLOW				Time of Travel (T _t)		INTENSITY *		TOTAL FLOWS	
BASIN	AREA TOTAL (Acres)	C ₅	C ₁₀₀	C ₅	Length (ft)	Height (ft)	T _c (min)	Length (ft)	Slope (%)	Velocity (fps)	T _t (min)	TOTAL (min)	CHECK (min)	I ₅ (in/hr)	I ₁₀₀ (in/hr)	Q ₅ (c.f.s.)	Q ₁₀₀ (c.f.s.)
		From DCM Table 5-1															
A	4.67	0.08	0.35	0.08	100	16	7.4	660	7.6%	1.9	5.7	13.1	14.2	3.7	6.3	1.4	10.2
B	3.64	0.08	0.35	0.08	100	7	9.7	725	7.2%	1.9	6.4	16.1	14.6	3.4	5.7	1.0	7.3
C	2.51	0.60	0.74	0.90	100	2.5	2.7	800	2.9%	1.2	11.1	13.8	15.0	3.6	6.1	5.5	11.3
D	2.10	0.43	0.61	0.90	100	2	2.9	600	3.7%	1.3	7.5	10.3	13.9	4.1	6.8	3.7	8.8
E	10.82	0.08	0.35	0.08	100	10	8.6	1195	4.3%	1.4	13.8	22.4	17.2	3.3	5.6	2.9	21.1
F	1.00	0.34	0.54	0.90	100	2	2.9	285	1.4%	0.8	5.7	8.6	12.1	4.4	7.3	1.5	3.9
G	8.99	0.08	0.35	0.08	100	8	9.3	950	3.7%	1.3	11.8	21.1	15.8	3.0	5.1	2.2	15.9
H	15.03	0.08	0.35	0.08	100	3	12.8	700	2.6%	1.1	10.4	23.2	14.4	2.9	4.8	3.4	25.3
I	4.22	0.08	0.35	0.08	100	6	10.2	600	5.3%	1.6	6.2	16.4	13.9	3.4	5.7	1.1	8.4
J	2.88	0.08	0.35	0.08	100	4	11.7	621	6.9%	1.8	5.6	17.3	14.0	3.3	5.6	0.8	5.6
J1	2.67	0.08	0.35	0.08	100	6	10.2	900	5.1%	1.6	9.5	19.7	15.6	3.1	5.2	0.7	4.9
K	3.33	0.08	0.35	0.08	100	8	9.3	650	6.8%	1.8	5.9	15.2	14.2	3.5	5.9	0.9	6.8
L	0.35	0.90	0.96	0.90	30	0.5	1.7	900	0.0%	0.0	0.0	1.7	5.0	5.2	8.7	1.6	2.9
M	13.93	0.08	0.35	0.08	100	8	9.3	680	7.9%	2.0	5.7	15.0	14.3	3.6	5.9	4.0	28.8
N	0.71	0.90	0.96	0.90	25	0.5	1.4	0	0.0%	0.0	0.0	1.4	5.0	5.2	8.7	3.3	5.9
O	11.52	0.08	0.35	0.08	100	6	10.2	1040	4.8%	1.5	11.3	21.5	16.3	3.0	5.0	2.7	20.2
P	9.17	0.08	0.35	0.08	100	4	11.7	1195	1.1%	0.7	27.3	38.9	17.2	3.3	5.6	2.4	17.9
Q	1.41	0.90	0.96	0.90	90	1.8	2.7	0	0.0%	0.0	0.0	2.7	5.0	5.2	8.7	6.6	11.8
631R	0.56	0.90	0.96	0.90	30	0.1	3.4	200	1.8%	0.9	3.5	6.9	9.8	4.7	7.9	2.4	4.2
632L	1.21	0.90	0.96	0.90	53	3.0	1.5	1000	1.8%	0.9	17.7	19.2	9.8	4.2	7.0	4.5	8.1
637R	0.91	0.90	0.96	0.90	77	3.0	2.0	900	0.5%	1.4	10.6	12.6	16.2	3.8	6.3	3.1	5.5
641L	1.58	0.90	0.96	0.90	47	1.0	1.9	1500	2.3%	3.0	8.2	10.2	13.0	4.1	6.9	5.8	10.4
646R	0.75	0.90	0.96	0.90	41	1.0	1.7	78	1.8%	2.7	0.5	2.2	5.0	5.2	8.7	3.5	6.2
654R	1.62	0.90	0.96	0.90	91	5.0	2.0	1000	4.3%	4.1	4.0	6.0	16.1	4.9	8.2	7.1	12.8
661L	0.07	0.90	0.96	0.90	82	3.0	2.1	100	2.7%	3.3	0.5	2.6	5.0	5.2	8.7	0.3	0.6
662L	1.21	0.90	0.96	0.90	75	3.0	2.0	800	4.6%	4.3	3.1	5.1	14.9	5.1	8.6	5.6	10.0
664R	1.09	0.90	0.96	0.90	78	3.0	2.1	600	5.3%	4.6	2.2	4.2	5.0	5.2	8.7	5.1	9.1

* Intensity equations assume a minimum travel time of 5 minutes.

Italicized values taken from Marksheffel FDR

Calculated by: CVW
 Date: 1/19/2022
 Checked by: DLM

CROSSROADS NORTH
EXISTING CONDITIONS DRAINAGE CALCULATIONS
(Basin Routing Summary)

<i>From Area Runoff Coefficient Summary</i>				OVERLAND				PIPE / CHANNEL FLOW				Time of Travel (T_t)	INTENSITY *		TOTAL FLOWS		COMMENTS	
DESIGN POINT	CONTRIBUTING BASINS/PIPES	CA ₅	CA ₁₀₀	C _s	Length (ft)	Height (ft)	T _c (min)	Length (ft)	Slope (%)	Velocity (fps)	T ₁ (min)	TOTAL (min)	I ₅ (in/hr)	I ₁₀₀ (in/hr)	Q ₅ (c.f.s.)	Q ₁₀₀ (c.f.s.)		
1	664R	0.98	1.05									5.0	5.2	8.7	5.1	9.1	EX 5' CDOT TYPE R AG INLET	
					Basin 664R Tc was used													
2	662L	1.09	1.16									5.1	5.1	8.6	5.6	10.0	EX 5' CDOT TYPE R AG INLET	
					Basin 662L Tc was used													
3	FBIN662, 661L	0.57	0.79				5.1	50	2.7%	3.3	0.3	5.3	5.1	8.5	2.9	6.7	EX 5' CDOT TYPE R AG INLET	
					Basin 662L Tc was used													
4	PR664, PR662, PR661, A	1.85	2.84									9.2	4.3	7.1	7.9	20.3	EX 5' BTM EARTH TRAP CHANNEL	
					Avg DP3 and Basin A Tc was used													
5	FBIN664, 654R	2.11	2.62									6.0	4.9	8.2	10.3	21.6	EX 5' CDOT TYPE R AG INLET	
					Basin 654R Tc was used													
6	DP4, PR654, B	2.96	4.77				9.2	520	5.0%	1.6	5.5	14.8	3.5	6.0	10.5	28.4	EX 5' BTM EARTH TRAP CHANNEL	
					Design Pt 4 Tc was used													
7	FBIN654, 646R	1.97	2.69				6.0	800	2.0%	2.8	4.7	10.7	4.0	6.8	7.9	18.2	EX 5' CDOT TYPE R AG INLET	
					Basin 654R Tc was used													
8	C, D	2.42	3.13				13.8					14.4	3.6	6.0	8.6	18.8	ENTERS PROPERTY FROM CDOT ROW	
					Basin C Tc was used													
9	DP6, DP8 E, PR646	7.09	12.39									17.2	3.3	5.6	23.5	69.0	EX 5' BTM EARTH TRAP CHANNEL	
					Basin E Tc was used													
10	H	1.20	5.26									23.2	2.9	4.8	3.4	25.3	LOCALIZED LOWPOINT	
					Basin H Tc was used													
11	F, G, DP10	2.26	8.95									21.1	3.0	5.1	6.8	45.2	EX 5' BTM EARTH TRAP CHANNEL	
					Basin G Tc was used													
12	641L	1.42	1.52									10.2	4.1	6.9	5.8	10.4	EX 5' CDOT TYPE R AG INLET	
					Basin 641L Tc was used													

CROSSROADS NORTH
EXISTING CONDITIONS DRAINAGE CALCULATIONS
(Basin Routing Summary)

<i>From Area Runoff Coefficient Summary</i>				OVERLAND				PIPE / CHANNEL FLOW				Time of Travel (T_c)		INTENSITY *		TOTAL FLOWS		COMMENTS
DESIGN POINT	CONTRIBUTING BASINS/PIPES	CA ₅	CA ₁₀₀	C _s	Length (ft)	Height (ft)	T _c (min)	Length (ft)	Slope (%)	Velocity (fps)	T ₁ (min)	TOTAL (min)	I ₅ (in/hr)	I ₁₀₀ (in/hr)	Q ₅ (c.f.s.)	Q ₁₀₀ (c.f.s.)		
13	DP9, DP11, PR640, I	10.39	23.37				17.2					15.0	3.5	5.9	36.6	138.0	EX 42" CULVERT	
					Design Pt 9 Tc was used													
14	FBIN646, 637R	1.94	2.86				10.7	871	0.5%	1.4	10.3	21.0	3.0	5.1	5.9	14.5	EX 5' CDOT TYPE R AG INLET	
					Design Pt 7 Tc was used													
15	DP13, J, PR636	11.61	25.22				15.0	200	0.5%	1.4	2.4	17.4	3.3	5.5	38.3	139.7	EX 5' BTM EARTH TRAP CHANNEL	
					Design Pt 13 Tc was used													
16	DP15, J1	11.83	26.16				17.4	550	1.3%	2.3	4.1	21.4	3.0	5.0	35.3	131.1	EX CDOT TYPE C AREA INLET W/RIPRAP BYPASS RUNDOWN AND 24" RCP	
					Design Pt 15 Tc was used													
17	FBIN636, 631R	1.45	2.55				21.0	650	1.5%	2.4	4.5	25.4	2.7	4.6	4.0	11.7	EX 5' CDOT TYPE R AG INLET	
					Design Point 14 Tc was used													
18	FBIN640, 632L	1.80	2.13				10.2	986	1.1%	2.1	8.0	18.1	3.2	5.4	5.8	11.6	EX 5' CDOT TYPE R AG INLET	
					Design Pt 12 Tc was used													
19	FBIN630B, L	0.33	0.57									5.0	5.2	8.7	1.7	4.9	EX 12" PLASTIC CORR PIPE	
					Basin L Tc was used													
20	DP16, PR630B, PRE1, K	14.23	30.02				21.4	100	9.5%	6.2	0.3	21.7	3.0	5.0	42.2	149.5	EX WQ POND	
					Design Pt 16 was used													
21	DP20, M, N	15.98	35.58									21.7	3.0	5.0	47.4	177.1	EX 42" RCP	
					Design Pt 20 was used													
22	O, P, Q	2.93	8.59									14.8	3.5	5.9	10.4	51.1	EX 48" CMP	
					Weighted Tc was used													

CROSSROADS NORTH
EXISTING CONDITIONS DRAINAGE CALCULATIONS
(Storm Sewer Routing Summary)

PIPE RUN	Contributing Pipes/Design Points/Struct	Equivalent CA ₅	Equivalent CA ₁₀₀	Maximum T _C	Intensity*		Flow	
					I ₅	I ₁₀₀	Q ₅	Q ₁₀₀
664	IN664R	0.52	0.39	5.0	5.2	8.7	2.7	3.4
662	IN662L	0.58	0.44	5.1	5.1	8.6	3.0	3.8
661	IN661L	0.37	0.38	5.3	5.1	8.5	1.9	3.2
654	IN654	0.82	0.66	6.0	4.9	8.2	4.0	5.4
646	IN646	0.84	0.69	10.7	4.0	6.8	3.4	4.7
640	IN640	0.71	0.55	10.2	4.1	6.9	2.9	3.8
636	IN636	0.99	0.85	21.0	3.0	5.1	3.0	4.3
630A	IN630A	0.92	0.90	25.4	2.7	4.6	2.5	4.1
630B	IN630B	1.79	1.90	18.1	3.2	5.4	5.8	10.3
E1	DP19	0.34	0.80	5.0	5.2	8.7	1.8	6.9
E2	INDP16	3.95	3.95	21.4	3.0	5.0	11.8	19.8
E3	DP21	15.98	35.58	21.7	3.0	5.0	47.4	177.1
E4	DP22	2.93	8.59	14.8	3.5	5.9	10.4	51.1

* Intensity equations assume a minimum travel time of 5 minutes.

Calculated by: CVW

DP - Design Point

FB- Flow By from Design Point

Date: 9/23/2021

EX - Existing Design Point

IN- Inlet

Checked by: DLM

CROSSROADS NORTH
PROPOSED CONDITIONS DRAINAGE CALCULATIONS
(Area Runoff Coefficient Summary)

BASIN	TOTAL AREA (SF)	TOTAL AREA (Acres)	STREETS/DEVELOPED			DEVELOPED LOTS			UNDEVELOPED/LANDSCAPE			RUNOFF COEFFICIENT	
			AREA (Acres)	C ₅	C ₁₀₀	AREA (Acres)	C ₅	C ₁₀₀	AREA (Acres)	C ₅	C ₁₀₀	C ₅	C ₁₀₀
A	453818.1925	10.42	10.42	0.81	0.88	0.00	0.59	0.70	0.00	0.08	0.35	0.81	0.88
B	357650.2993	8.21	8.21	0.81	0.88	0.00	0.30	0.50	0.00	0.08	0.35	0.81	0.88
C	278007.7229	6.38	6.38	0.81	0.88	0.00	0.30	0.50	0.00	0.08	0.35	0.81	0.88
D	117655.1837	2.70	0.00	0.81	0.88	0.00	0.30	0.50	2.70	0.12	0.39	0.12	0.39
E	75091.6549	1.72	0.00	0.81	0.88	0.00	0.30	0.50	1.72	0.12	0.39	0.12	0.39
F	475511.6212	10.92	10.92	0.81	0.88	0.00	0.30	0.50	0.00	0.08	0.35	0.81	0.88
G	173089.0352	3.97	3.97	0.81	0.88	0.00	0.30	0.50	0.00	0.08	0.35	0.81	0.88
H	347596.4425	7.98	0.00	0.81	0.88	0.00	0.30	0.50	7.98	0.08	0.35	0.08	0.35
I	70701.6195	1.62	0.00	0.81	0.88	0.00	0.30	0.50	1.62	0.12	0.39	0.12	0.39
J	387467.3488	8.90	0.00	0.81	0.88	8.90	0.16	0.41	0.00	0.08	0.35	0.16	0.41
K	370986.6998	8.52	0.00	0.81	0.88	8.52	0.16	0.41	0.00	0.08	0.35	0.16	0.41
L	36340.4032	0.83	0.00	0.81	0.88	0.00	0.45	0.59	1.16	0.12	0.39	0.17	0.54
M	349489.1274	8.02	0.00	0.81	0.88	0.00	0.45	0.59	8.02	0.08	0.35	0.08	0.35
OS-1	255171.6725	5.86	0.00	0.81	0.88	0.00	0.45	0.59	5.86	0.08	0.35	0.08	0.35
RD-1	192546.4816	4.42	2.55	0.90	0.96	0.00	0.45	0.59	1.87	0.08	0.35	0.55	0.67
RD-2	104543.0176	2.40	0.00	0.81	0.88	0.00	0.45	0.59	2.40	0.08	0.35	0.08	0.35
RD-3	35701.018	0.82	0.00	0.81	0.88	0.00	0.45	0.59	0.82	0.08	0.35	0.08	0.35
RD-4	60542.908	1.39	0.00	0.81	0.88	0.00	0.45	0.59	1.39	0.08	0.35	0.08	0.35
RD-5	59298.0535	1.36	0.00	0.81	0.88	0.00	0.45	0.59	1.36	0.08	0.35	0.08	0.35
OS-2	15414.997	0.35	0.35	0.90	0.96	0.00	0.45	0.59	0.00	0.08	0.35	0.90	0.96
OS-3	31245.3505	0.72	0.72	0.90	0.96	0.00	0.45	0.59	0.00	0.08	0.35	0.90	0.96
OS-4	61495.5769	1.41	1.41	0.90	0.96	0.00	0.45	0.59	0.00	0.08	0.35	0.90	0.96
631R	N/A	0.56	0.56	0.90	0.96	0.00	0.45	0.59	0.00	0.08	0.35	0.90	0.96
632L	N/A	1.21	1.21	0.90	0.96	0.00	0.45	0.59	0.00	0.08	0.35	0.90	0.96
637R	N/A	0.91	0.91	0.90	0.96	0.00	0.45	0.59	0.00	0.09	0.36	0.90	0.96
641L	N/A	1.58	1.58	0.90	0.96	0.00	0.45	0.59	0.00	0.09	0.36	0.90	0.96
646R	N/A	0.75	0.75	0.90	0.96	0.00	0.42	0.57	0.00	0.09	0.36	0.90	0.96
654R	N/A	1.62	1.62	0.90	0.96	0.00	0.39	0.55	0.00	0.09	0.36	0.90	0.96
661L	N/A	0.07	0.07	0.90	0.96	0.00	0.36	0.53	0.00	0.09	0.36	0.90	0.96
662L	N/A	1.21	1.21	0.90	0.96	0.00	0.33	0.51	0.00	0.09	0.36	0.90	0.96
664R	N/A	1.09	1.09	0.90	0.96	0.00	0.30	0.49	0.00	0.09	0.36	0.90	0.96

Italized values taken from Marksheffel FDR

Calculated by: CVW

Date: 1/20/2022

Checked by: DLM

CROSSROADS NORTH PROPOSED CONDITIONS DRAINAGE CALCULATIONS (Area Drainage Summary)

From Area Runoff Coefficient Summary				OVERLAND				STREET / CHANNEL FLOW				Time of Travel (T _t)		INTENSITY *		TOTAL FLOWS	
BASIN	AREA TOTAL (Acres)	C ₅	C ₁₀₀	C _s	Length (ft)	Height (ft)	T _c (min)	Length (ft)	Slope (%)	Velocity (fps)	T _t (min)	TOTAL (min)	CHECK (min)	I ₅ (in/hr)	I ₁₀₀ (in/hr)	Q ₅ (c.f.s.)	Q ₁₀₀ (c.f.s.)
		From DCM Table 5-1															
A	10.42	0.81	0.88	0.81	50	4	1.9	900	5.2%	4.5	3.3	5.2	15.3	5.1	8.6	43.2	78.8
B	8.21	0.81	0.88	0.81	50	3	2.0	602	1.2%	2.2	4.6	6.6	13.6	4.8	8.0	31.6	57.6
C	6.38	0.81	0.88	0.81	50	1	2.9	323	1.5%	2.5	2.2	5.1	12.1	5.1	8.6	26.6	48.4
D	2.70	0.12	0.39	0.12	55	8	5.4	0	0.0%	0.0	0.0	5.4	10.3	5.0	8.5	1.6	8.9
E	1.72	0.12	0.39	0.12	40	10	3.9	0	0.0%	0.0	0.0	3.9	10.2	4.1	6.9	0.8	4.6
F	10.92	0.81	0.88	0.81	50	0.25	4.7	800	1.4%	2.4	5.6	10.2	14.7	4.1	6.9	36.2	66.0
G	3.97	0.81	0.88	0.81	50	2	2.3	668	2.5%	3.2	3.5	5.9	14.0	4.9	8.3	15.9	29.0
H	7.98	0.08	0.35	0.08	200	16	13.1	690	1.4%	1.8	6.4	19.5	14.9	3.5	5.9	2.3	16.5
I	1.62	0.12	0.39	0.12	50	3.75	6.4	0	0.0%	0.0	0.0	6.4	10.3	4.1	6.9	0.8	4.3
J	8.90	0.16	0.41	0.16	75	1	13.4	975	2.4%	3.1	5.3	18.7	15.8	3.4	5.8	4.9	21.1
K	8.52	0.16	0.41	0.16	50	2	7.6	770	2.1%	2.9	4.5	12.0	14.6	3.8	6.5	5.2	22.6
L	0.83	0.17	0.54	0.17	25	6	3.0	0	0.0%	0.0	0.0	3.0	10.1	4.1	6.9	0.6	3.1
M	8.02	0.08	0.35	0.08	195	16	12.8	780	1.0%	0.7	18.3	31.2	15.4	3.5	5.8	2.2	16.4
OS-1	5.86	0.08	0.35	0.08	50	8	5.2	955	0.8%	0.6	24.8	30.1	15.6	3.5	5.8	1.6	11.9
RD-1	4.42	0.55	0.67	0.55	100	6	5.5	1570	2.4%	2.3	11.2	16.7	19.3	3.4	5.6	8.2	16.6
RD-2	2.40	0.08	0.35	0.08	50	2	8.2	670	2.5%	2.4	4.7	12.9	14.0	3.7	6.3	0.7	5.3
RD-3	0.82	0.08	0.35	0.08	42	2	7.1	560	4.3%	3.1	3.0	10.1	13.3	4.1	6.9	0.3	2.0
RD-4	1.39	0.08	0.35	0.08	50	4	6.6	835	0.2%	0.7	19.0	25.5	14.9	3.5	5.9	0.4	2.9
RD-5	1.36	0.08	0.35	0.08	50	6	5.7	430	1.9%	2.0	3.5	9.2	12.7	4.2	7.1	0.5	3.4
OS-2	0.35	0.90	0.96	0.90	30	0.5	1.7	900	0.0%	0.0	0.0	1.7	5.0	5.2	8.7	1.6	2.9
OS-3	0.72	0.90	0.96	0.90	50	2	1.6	685	1.2%	1.6	7.0	8.7	14.1	4.3	7.3	2.8	5.0
OS-4	1.41	0.90	0.96	0.90	50	2	1.6	295	1.4%	1.7	2.8	4.4	11.9	3.9	6.5	4.9	8.8
631R	0.56	0.90	0.96	0.90	30	0.1	3.4	200	1.8%	0.9	3.5	6.9	9.8	4.7	7.9	2.4	4.2
632L	1.21	0.90	0.96	0.90	53	3.0	1.5	1000	1.8%	0.9	17.7	19.2	9.8	4.2	7.0	4.5	8.1
637R	0.91	0.90	0.96	0.90	77	3.0	2.0	900	0.5%	1.4	10.6	12.6	16.2	3.8	6.3	3.1	5.5
641L	1.58	0.90	0.96	0.90	47	1.0	1.9	1500	2.3%	3.0	8.2	10.2	13.0	4.1	6.9	5.8	10.4
646R	0.75	0.90	0.96	0.90	41	1.0	1.7	78	1.8%	2.7	0.5	2.2	5.0	5.2	8.7	3.5	6.2
654R	1.62	0.90	0.96	0.90	91	5.0	2.0	1000	4.3%	4.1	4.0	6.0	16.1	4.9	8.2	7.1	12.8
661L	0.07	0.90	0.96	0.90	82	3.0	2.1	100	2.7%	3.3	0.5	2.6	5.0	5.2	8.7	0.3	0.6
662L	1.21	0.90	0.96	0.90	75	3.0	2.0	800	4.6%	4.3	3.1	5.1	14.9	5.1	8.6	5.6	10.0
664R	1.09	0.90	0.96	0.90	78	3.0	2.1	600	5.3%	4.6	2.2	4.2	5.0	5.2	8.7	5.1	9.1

* Intensity equations assume a minimum travel time of 5 minutes.
Italized values taken from Marksheffel FDR

Calculated by: CVW _____
Date: 1/20/2022 _____
Checked by: DLM _____

CROSSROADS NORTH
PROPOSED CONDITIONS DRAINAGE CALCULATIONS
(Basin Routing Summary)

From Area Runoff Coefficient Summary				OVERLAND				PIPE / CHANNEL FLOW				Time of Travel (T _t)		INTENSITY *		TOTAL FLOWS		COMMENTS
DESIGN POINT	CONTRIBUTING BASINS/PIPES	CA _s	CA ₁₀₀	C _s	Length (ft)	Height (ft)	T _c (min)	Length (ft)	Slope (%)	Velocity (fps)	T _t (min)	TOTAL (min)	I _s (in/hr)	I ₁₀₀ (in/hr)	Q _s (c.f.s.)	Q ₁₀₀ (c.f.s.)		
1	664R	0.98	1.05									5.0	5.2	8.7	5.1	9.1	EX 5' CDOT TYPE R INLET	
					Basin 664R Tc was used													
2	662L	1.09	1.16									5.1	5.1	8.6	5.6	10.0	EX 5' CDOT TYPE R INLET	
					Basin 662L Tc was used													
3	FBIN662, 661L	0.57	0.79				5.1	50	2.7%	2.4	0.3	5.4	5.0	8.5	2.9	6.7	EX 5' CDOT TYPE R INLET	
					Basin 662L Tc was used													
4	PR664, PR662, PR661 OS-1 SUM:	1.48 0.47 1.95	1.21 2.05 3.26				5.5					5.5	5.0	8.4	9.8	27.5	EX 5' BTM EARTH TRAP CHANNEL	
					Weighted Tc was used													
5	FBIN664, FBIN661, 654R	2.11	2.62				6.0					6.0	4.9	8.2	10.3	21.6	EX 5' CDOT TYPE R INLET	
					Basin 654R Tc was used													
6	DP4, PR654	2.77	3.92				5.5	520	5.0%	3.4	2.6	8.1	4.4	7.5	12.3	29.3	EX 5' BTM EARTH TRAP CHANNEL	
					Design Pt 4 Tc was used													
7	Basin A	8.44	9.17									5.2	5.1	8.6	43.2	78.8	PROP 42" RCP STORM SEWER PRIVATE	
					Basin A Tc was used													
8	Basin C	5.17	5.62									5.1	5.1	8.6	26.6	48.4	PROP 36" RCP STORM SEWER PRIVATE	
					Basin C Tc was used													
9	Basin D, DP7, DP8, DP13	20.58	23.06									5.9	4.9	8.3	101.3	190.5	POND 1 OUTFALL: PROP 18" RCP STORM SEWER	
					Weighted Tc was used													
10	Basin RD-3, DP6	2.83	4.20				5.8					5.8	4.9	8.3	13.9	34.7	DUAL 24" PUBLIC RCP CULVERTS	
					Weighted Tc was used													
11	FBIN654, 646R	1.97	2.68				6.0	805	2.0%	2.8	4.8	10.7	4.0	6.8	7.9	18.1	EX 5' CDOT TYPE R INLET	
					Basin 654R Tc was used													
12	PR646, PR-DP10	3.68	4.90				5.8	415	1.2%	1.6	4.2	10.0	4.1	6.9	15.2	34.0	EX 5' BTM EARTH TRAP CHANNEL	
					Design Pt 10 Tc was used													
13	641L	1.42	1.52									10.2	4.1	6.9	5.8	10.4	EX 5' CDOT TYPE R INLET	
					Basin 641L Tc was used													
14	Basin B	6.65	7.23									6.6	4.8	8.0	31.6	57.6	PROP 42" RCP STORM SEWER PRIVATE	
					Basin B Tc was used													
15	Basin F	8.84	9.61									10.2	4.1	6.9	36.2	66.0	PROP 42" RCP STORM SEWER PRIVATE	
					Basin F Tc was used													
16	Basin E, F1	9.05	10.28									10.2	4.1	6.9	37.0	70.6	POND 2 PROP 18" PRIVATE RCP STORM SEWER	
					Design Point 15 Tc was used													
17	PR640, PR646, Basin RD-4 D1 PR641 SUM:	4.50 0.28 0.12 4.90	5.94 2.15 1.13 9.23				10.0	600	0.5%	1.1	9.4	19.4	3.1	5.3	15.4	48.5	EX 42" RCP CULVERT PUBLIC	
					Design Pt 12 Tc was used													
18	FBIN646, 637R	1.94	2.86				10.7	871	0.5%	1.4	10.3	21.0	3.0	5.1	5.9	14.5	EX 5' CDOT TYPE R INLET	
					Design Pt 11 Tc was used													

CROSSROADS NORTH
PROPOSED CONDITIONS DRAINAGE CALCULATIONS
(Basin Routing Summary)

<i>From Area Runoff Coefficient Summary</i>				OVERLAND				PIPE / CHANNEL FLOW				Time of Travel (T _t)	INTENSITY *		TOTAL FLOWS		COMMENTS	
DESIGN POINT	CONTRIBUTING BASINS/PIPES	CA _s	CA ₁₀₀	C _s	Length (ft)	Height (ft)	T _c (min)	Length (ft)	Slope (%)	Velocity (fps)	T _t (min)	TOTAL (min)	I _s (in/hr)	I ₁₀₀ (in/hr)	Q _s (c.f.s.)	Q ₁₀₀ (c.f.s.)		
19	PR639, PR636	5.90	10.08				19.4	230	0.4%	1.0	3.9	23.3	2.9	4.8	16.9	48.4	EX 5' BTM EARTH TRAP CHANNEL	
					Design Pt 17 Tc was used													
20	Basin K	1.36	3.49									12.0	3.8	6.5	5.2	22.6	PROP 30" RCP STORM SEWER PRIVATE	
					Basin K Tc was used													
21	Basin L, DP20	1.50	3.94									10.1	4.1	6.9	6.2	27.2	POND 4 PROP 18" PRIVATE RCP STORM SEWER	
					Basin L Tc was used													
22	FBIN636, 631R	1.45	2.55				21.0	650	1.5%	2.4	4.5	25.5	2.7	4.6	4.0	11.7	EX 5' CDOT TYPE R INLET	
					Design Pt 18 Tc was used													
23	FBIN640, 632L	1.80	2.13				10.2	986	1.1%	2.1	7.7	17.9	3.3	5.5	5.9	11.6	EX 5' CDOT TYPE R INLET	
					Design Pt 13 Tc was used													
24	DP19, Basin RD-5	6.01	10.55				23.3	545	1.0%	1.5	6.0	29.3	2.5	4.2	15.1	44.5	EX CDOT TYPE C AREA INLET W/RIPRAP BYPASS RUNDOWN AND 24" RCP OUTFALL	
					Design Pt 19 Tc was used													
25	OS-2, FBIN630B	0.31	0.62				17.9	131	1.5%	2.0	1.1	19.0	3.2	5.3	1.0	3.3	EX 12" PLASTIC CORR PIPE PUBLIC	
					Design Point 23 Tc was used													
26	E1, E2, PR630B	7.16	6.55				29.3	242	1.7%	2.6	1.6	30.9	2.4	4.1	17.4	26.8	EX WQ POND	
					Design Pt 24 Tc was used													
27	DP26, OS-3, Basin M L1 SUM:	8.12 0.00 8.12	9.69 0.81 10.50				22.9					22.9	2.9	4.8	23.4	50.9	EX 42" CMP CULVERT PUBLIC	
					Weighted Tc was used													
28	Basin RD-1	2.44	2.95				16.7					16.7	3.4	5.6	8.2	16.6	TRIANGULAR, EARTHEN CDOT DITCH	
					Basin RD-1 Tc was used													
29	Basin RD-2, DP28	2.64	3.79				16.7	1586	1.7%	2.0	13.5	30.1	2.5	4.2	6.5	15.7	TRIANGULAR, EARTHEN CDOT DITCH	
					Design Point 28 Tc was used													
30	Basin G	3.22	3.50									5.9	4.9	8.3	15.9	29.0	PROP 30" RCP STORM SEWER PRIVATE	
					Basin G Tc was used													
31	Basin J	1.42	3.65									15.8	3.4	5.8	4.9	21.1	PROP 30" RCP STORM SEWER PRIVATE	
					Basin J Tc was used													
32	Basin I, DP30, DP31	4.84	7.78				8.2					6.4	4.8	8.0	23.2	62.6	POND 3 PROP 24" PRIVATE RCP STORM SEWER	
					Weighted Tc was used													
33	Basin H, Basin OS-4, DP29 II SUM:	4.55 0.04 4.59	7.94 1.22 9.16				30.1	665	1.8%	2.0	5.5	35.6	2.2	3.7	10.2	34.1	EX 48" CMP PUBLIC	
					Weighted Tc was used													

CROSSROADS NORTH
PROPOSED CONDITIONS DRAINAGE CALCULATIONS
(Storm Sewer Routing Summary)

PIPE RUN	Contributing Pipes/Design Points/Struct	Equivalent CA ₅	Equivalent CA ₁₀₀	Maximum T _C	Intensity*		Flow		PIPE SIZE
					I ₅	I ₁₀₀	Q ₅	Q ₁₀₀	
664	DP1	0.52	0.39	5.0	5.2	8.7	2.7	3.4	24" RCP
662	DP2	0.58	0.44	5.1	5.1	8.6	3.0	3.8	24" RCP
661	DP3	0.38	0.38	5.4	5.0	8.5	1.9	3.2	18" RCP
654	DP5	0.82	0.66	6.0	4.9	8.2	4.0	5.4	18" RCP
646	DP11	0.85	0.70	10.7	4.0	6.8	3.4	4.7	18" RCP
640	DP13	0.71	0.55	10.2	4.1	6.9	2.9	3.8	24" RCP
639	DP17	4.90	9.23	19.4	3.1	5.3	15.4	48.5	42" RCP
636	DP18	0.99	0.85	21.0	3.0	5.1	3.0	4.3	24" RCP
630A	DP22	0.92	0.90	25.5	2.7	4.6	2.5	4.1	24" RCP
630B	DP23	2.06	2.15	23.3	2.9	4.8	5.9	10.3	24" RCP
E1	DP25	0.31	0.62	19.0	3.2	5.3	1.0	3.3	12" PLASTIC
E2	DP24	4.79	3.78	19.4	3.1	5.3	15.0	19.9	24" RCP
E3	DP27	8.12	10.50	22.9	2.9	4.8	23.4	50.9	42" CMP
E4	DP33	4.59	9.16	35.6	2.2	3.7	10.2	34.1	48" CMP
A1	DP7	8.44	9.17	5.2	5.1	8.6	43.2	78.8	42" RCP
B1	DP14	6.65	7.23	6.6	4.8	8.0	31.6	57.6	42" RCP
C1	DP8	5.17	5.62	5.1	5.1	8.6	26.6	48.4	36" RCP
D1	DP9	0.28	2.15	5.9	4.9	8.3	1.4	17.8	18" RCP
F1	DP15	8.84	9.61	10.2	4.1	6.9	36.2	66.0	42" RCP
641	DP16	0.12	1.13	10.2	4.1	6.9	0.5	7.8	18" RCP
G1	DP30	3.22	3.50	5.9	4.9	8.3	15.9	29.0	30" RCP
J1	DP31	1.42	3.65	15.8	3.4	5.8	4.9	21.1	30" RCP
I1	DP32	0.04	1.22	6.4	4.8	8.0	0.2	9.8	18" RCP
K1	DP20	1.36	3.49	12.0	3.8	6.5	5.2	22.6	30" RCP
L1	DP21	0.00	0.81	10.1	4.1	6.9	0.0	5.6	18" RCP
PR-DP10	DP10	2.83	4.20	5.8	4.9	8.3	13.9	34.7	DUAL 24" RCP

* Intensity equations assume a minimum travel time of 5 minutes.
 DP - Design Point
 PR - Pipe Run

Calculated by: CVW
 Date: 9/23/2021
 Checked by: DLM

<i>Weighted Percent Imperviousness of FSD Pond 1</i>				
<i>Contributing Basins</i>	<i>Area (Acres)</i>	<i>C_s</i>	<i>Impervious % (I)</i>	<i>(Acres)*(I)</i>
<i>A</i>	10.42	0.81	95	989.73
<i>B</i>	8.21	0.81	95	780.00
<i>C</i>	6.38	0.81	95	606.31
<i>D</i>	2.70	0.12	7	18.91
Totals	27.71			2394.95
Imperviousness of FSD Pond 1	86.4			

<i>Weighted Percent Imperviousness of FSD Pond 2</i>				
<i>Contributing Basins</i>	<i>Area (Acres)</i>	<i>C_s</i>	<i>Impervious % (I)</i>	<i>(Acres)*(I)</i>
<i>E</i>	1.72	0.12	7	12.07
<i>F</i>	10.92	0.81	95	1037.04
Totals	12.64			1049.11
Imperviousness of FSD Pond 2	83.0			

<i>Weighted Percent Imperviousness of FSD Pond 3</i>				
<i>Contributing Basins</i>	<i>Area (Acres)</i>	<i>C_s</i>	<i>Impervious % (I)</i>	<i>(Acres)*(I)</i>
<i>Column1</i>	<i>Column2</i>	<i>Column3</i>	<i>Column4</i>	<i>Column5</i>
<i>G</i>	3.97	0.81	95	377.49
<i>I</i>	1.62	0.12	7	11.36
<i>J</i>	8.90	0.16	13	115.64
Totals	14.49			504.49
Imperviousness of FSD Pond 3	34.8			

<i>Weighted Percent Imperviousness of FSD Pond 4</i>				
<i>Contributing Basins</i>	<i>Area (Acres)</i>	<i>C_s</i>	<i>Impervious % (I)</i>	<i>(Acres)*(I)</i>
<i>Column1</i>	<i>Column2</i>	<i>Column3</i>	<i>Column4</i>	<i>Column5</i>
<i>K</i>	8.52	0.16	13	110.72
<i>L</i>	0.83	0.17	7	5.84
Totals	9.35			116.56
Imperviousness of FSD Pond 2	12.5			

<i>Overall Weighted Site Imperviousness</i>				
<i>Contributing Basins</i>	<i>Area (Acres)</i>	<i>C_s</i>	<i>Impervious % (I)</i>	<i>(Acres)*(I)</i>
<i>Column1</i>	<i>Column2</i>	<i>Column3</i>	<i>Column4</i>	<i>Column5</i>
<i>FSD Pond 1</i>	27.71	N/A	N/A	2394.95
<i>FSD Pond 2</i>	12.64	N/A	N/A	1049.11
<i>FSD Pond 3</i>	14.49	N/A	N/A	504.49
<i>FSD Pond 4</i>	9.35	N/A	N/A	116.56
Totals	64.19			4065.10
Imperviousness of Site	63.3			


HYDRAULIC CALCULATIONS / POND CALCULATIONS

DETENTION BASIN OUTLET STRUCTURE DESIGN

MHFD-Detention, Version 4.04 (February 2021)

Project: CROSSROADS NORTH

Basin ID: POND 1

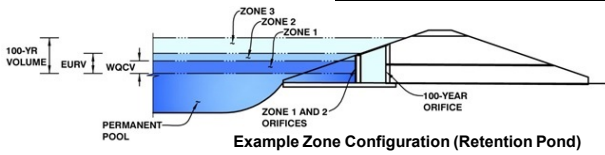

Example Zone Configuration (Retention Pond)

	Estimated Stage (ft)	Estimated Volume (ac-ft)	Outlet Type
Zone 1 (WQCV)	3.42	0.860	Orifice Plate
Zone 2 (EURV)	5.61	2.357	Orifice Plate
Zone 3 (100-year)	6.57	1.284	Weir&Pipe (Restrict)
Total (all zones)		4.502	

User Input: Orifice at Underdrain Outlet (typically used to drain WQCV in a Filtration BMP)

Underdrain Orifice Invert Depth =	N/A	ft (distance below the filtration media surface)
Underdrain Orifice Diameter =	N/A	inches

Calculated Parameters for Underdrain

Underdrain Orifice Area =	N/A	ft ²
Underdrain Orifice Centroid =	N/A	feet

User Input: Orifice Plate with one or more orifices or Elliptical Slot Weir (typically used to drain WQCV and/or EURV in a sedimentation BMP)

Invert of Lowest Orifice =	0.00	ft (relative to basin bottom at Stage = 0 ft)
Depth at top of Zone using Orifice Plate =	5.61	ft (relative to basin bottom at Stage = 0 ft)
Orifice Plate: Orifice Vertical Spacing =	22.40	inches
Orifice Plate: Orifice Area per Row =	N/A	inches

Calculated Parameters for Plate

WQ Orifice Area per Row =	N/A	ft ²
Elliptical Half-Width =	N/A	feet
Elliptical Slot Centroid =	N/A	feet
Elliptical Slot Area =	N/A	ft ²

User Input: Stage and Total Area of Each Orifice Row (numbered from lowest to highest)

	Row 1 (required)	Row 2 (optional)	Row 3 (optional)	Row 4 (optional)	Row 5 (optional)	Row 6 (optional)	Row 7 (optional)	Row 8 (optional)
Stage of Orifice Centroid (ft)	0.00	1.90	3.80					
Orifice Area (sq. inches)	2.25	7.40	15.00					

	Row 9 (optional)	Row 10 (optional)	Row 11 (optional)	Row 12 (optional)	Row 13 (optional)	Row 14 (optional)	Row 15 (optional)	Row 16 (optional)
Stage of Orifice Centroid (ft)								
Orifice Area (sq. inches)								

User Input: Vertical Orifice (Circular or Rectangular)

	Not Selected	Not Selected	
Invert of Vertical Orifice =	N/A	N/A	ft (relative to basin bottom at Stage = 0 ft)
Depth at top of Zone using Vertical Orifice =	N/A	N/A	ft (relative to basin bottom at Stage = 0 ft)
Vertical Orifice Diameter =	N/A	N/A	inches

Calculated Parameters for Vertical Orifice

	Not Selected	Not Selected	
Vertical Orifice Area =	N/A	N/A	ft ²
Vertical Orifice Centroid =	N/A	N/A	feet

User Input: Overflow Weir (Dropbox with Flat or Sloped Grate and Outlet Pipe OR Rectangular/Trapezoidal Weir (and No Outlet Pipe))

	Zone 3 Weir	Not Selected	
Overflow Weir Front Edge Height, Ho =	5.62	N/A	ft (relative to basin bottom at Stage = 0 ft)
Overflow Weir Front Edge Length =	2.90	N/A	feet
Overflow Weir Grate Slope =	0.00	N/A	H:V
Horiz. Length of Weir Sides =	5.70	N/A	feet
Overflow Grate Type =	Type C Grate	N/A	
Debris Clogging % =	50%	N/A	%

	Zone 3 Weir	Not Selected	
Height of Grate Upper Edge, H ₁ =	5.62	N/A	feet
Overflow Weir Slope Length =	5.70	N/A	feet
Grate Open Area / 100-yr Orifice Area =	7.54	N/A	
Overflow Grate Open Area w/o Debris =	11.50	N/A	ft ²
Overflow Grate Open Area w/ Debris =	5.75	N/A	ft ²

User Input: Outlet Pipe w/ Flow Restriction Plate (Circular Orifice, Restrictor Plate, or Rectangular Orifice)

	Zone 3 Restrictor	Not Selected	
Depth to Invert of Outlet Pipe =	0.25	N/A	ft (distance below basin bottom at Stage = 0 ft)
Outlet Pipe Diameter =	18.00	N/A	inches
Restrictor Plate Height Above Pipe Invert =	14.50	N/A	inches

Calculated Parameters for Outlet Pipe w/ Flow Restriction Plate

	Zone 3 Restrictor	Not Selected	
Outlet Orifice Area =	1.53	N/A	ft ²
Outlet Orifice Centroid =	0.66	N/A	feet
Half-Central Angle of Restrictor Plate on Pipe =	2.23	N/A	radians

User Input: Emergency Spillway (Rectangular or Trapezoidal)

Spillway Invert Stage =	6.35	ft (relative to basin bottom at Stage = 0 ft)
Spillway Crest Length =	30.00	feet
Spillway End Slopes =	4.00	H:V
Freeboard above Max Water Surface =	1.00	feet

Calculated Parameters for Spillway

Spillway Design Flow Depth =	0.94	feet
Stage at Top of Freeboard =	8.29	feet
Basin Area at Top of Freeboard =	1.67	acres
Basin Volume at Top of Freeboard =	7.16	acre-ft

Routed Hydrograph Results

The user can override the default CUHP hydrographs and runoff volumes by entering new values in the Inflow Hydrographs table (Columns W through AF).

	WQCV	EURV	2 Year	5 Year	10 Year	25 Year	50 Year	100 Year	500 Year
Design Storm Return Period =									
One-Hour Rainfall Depth (in) =	N/A	N/A	1.19	1.50	1.75	2.00	2.25	2.51	3.14
CUHP Runoff Volume (acre-ft) =	0.860	3.217	2.251	2.906	3.434	4.023	4.600	5.230	6.715
Inflow Hydrograph Volume (acre-ft) =	N/A	N/A	2.251	2.906	3.434	4.023	4.600	5.230	6.715
CUHP Predevelopment Peak Q (cfs) =	N/A	N/A	0.2	0.4	0.6	5.3	10.6	17.2	31.0
OPTIONAL Override Predevelopment Peak Q (cfs) =	N/A	N/A							
Predevelopment Unit Peak Flow, q (cfs/acre) =	N/A	N/A	0.01	0.01	0.02	0.19	0.38	0.62	1.12
Peak Inflow Q (cfs) =	N/A	N/A	42.2	53.0	60.9	73.4	84.3	98.2	125.8
Peak Outflow Q (cfs) =	0.4	1.3	1.0	1.2	1.3	5.6	9.4	16.6	37.2
Ratio Peak Outflow to Predevelopment Q =	N/A	N/A	N/A	3.0	2.3	1.0	0.9	1.0	1.2
Structure Controlling Flow =	Plate	Plate	Plate	Plate	Overflow Weir 1	Overflow Weir 1	Overflow Weir 1	Overflow Weir 1	Spillway
Max Velocity through Grate 1 (fps) =	N/A	N/A	N/A	N/A	0.0	0.4	0.7	1.3	1.5
Max Velocity through Grate 2 (fps) =	N/A	N/A	N/A	N/A	N/A	N/A	N/A	N/A	N/A
Time to Drain 97% of Inflow Volume (hours) =	38	62	57	61	64	64	63	62	60
Time to Drain 99% of Inflow Volume (hours) =	40	70	62	68	72	73	73	72	70
Maximum Ponding Depth (ft) =	3.42	5.61	4.68	5.22	5.62	5.90	6.06	6.29	6.69
Area at Maximum Ponding Depth (acres) =	0.78	1.27	1.12	1.21	1.27	1.31	1.34	1.37	1.43
Maximum Volume Stored (acre-ft) =	0.863	3.221	2.105	2.725	3.234	3.596	3.794	4.106	4.680


Flows exceed allowable ranges. Revise so that ratio of flows is 1.0
Unresolved. Full spectrum will require release at or below historic. Typical for all ponds.

DETENTION BASIN OUTLET STRUCTURE DESIGN

MHFD-Detention, Version 4.03 (May 2020)

Project: CROSSROADS NORTH

Basin ID: POND 2

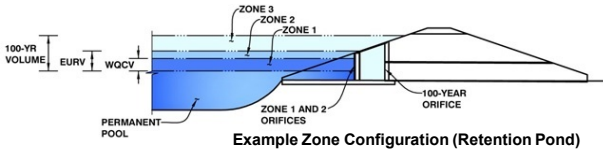

	Estimated Stage (ft)	Estimated Volume (ac-ft)	Outlet Type
Zone 1 (WQCV)	2.89	0.366	Orifice Plate
Zone 2 (EURV)	4.46	1.028	Orifice Plate
Zone 3 (100-year)	5.16	0.572	Weir&Pipe (Restrict)
Total (all zones)		1.966	

User Input: Orifice at Underdrain Outlet (typically used to drain WQCV in a Filtration BMP)

Underdrain Orifice Invert Depth =	<input type="text"/>	ft (distance below the filtration media surface)	Underdrain Orifice Area =	<input type="text"/>	ft ²
Underdrain Orifice Diameter =	<input type="text"/>	inches	Underdrain Orifice Centroid =	<input type="text"/>	feet

User Input: Orifice Plate with one or more orifices or Elliptical Slot Weir (typically used to drain WQCV and/or EURV in a sedimentation BMP)

Invert of Lowest Orifice =	<input type="text" value="0.00"/>	ft (relative to basin bottom at Stage = 0 ft)	WQ Orifice Area per Row =	<input type="text" value="1.028E-02"/>	ft ²
Depth at top of Zone using Orifice Plate =	<input type="text" value="4.46"/>	ft (relative to basin bottom at Stage = 0 ft)	Elliptical Half-Width =	<input type="text" value="N/A"/>	feet
Orifice Plate: Orifice Vertical Spacing =	<input type="text" value="17.84"/>	inches	Elliptical Slot Centroid =	<input type="text" value="N/A"/>	feet
Orifice Plate: Orifice Area per Row =	<input type="text" value="1.48"/>	sq. inches (diameter = 1-3/8 inches)	Elliptical Slot Area =	<input type="text" value="N/A"/>	ft ²

User Input: Stage and Total Area of Each Orifice Row (numbered from lowest to highest)

	Row 1 (required)	Row 2 (optional)	Row 3 (optional)	Row 4 (optional)	Row 5 (optional)	Row 6 (optional)	Row 7 (optional)	Row 8 (optional)
Stage of Orifice Centroid (ft)	<input type="text" value="0.00"/>	<input type="text" value="1.50"/>	<input type="text" value="3.00"/>	<input type="text"/>	<input type="text"/>	<input type="text"/>	<input type="text"/>	<input type="text"/>
Orifice Area (sq. inches)	<input type="text" value="1.48"/>	<input type="text" value="1.48"/>	<input type="text" value="10.00"/>	<input type="text"/>	<input type="text"/>	<input type="text"/>	<input type="text"/>	<input type="text"/>

	Row 9 (optional)	Row 10 (optional)	Row 11 (optional)	Row 12 (optional)	Row 13 (optional)	Row 14 (optional)	Row 15 (optional)	Row 16 (optional)
Stage of Orifice Centroid (ft)	<input type="text"/>	<input type="text"/>	<input type="text"/>	<input type="text"/>	<input type="text"/>	<input type="text"/>	<input type="text"/>	<input type="text"/>
Orifice Area (sq. inches)	<input type="text"/>	<input type="text"/>	<input type="text"/>	<input type="text"/>	<input type="text"/>	<input type="text"/>	<input type="text"/>	<input type="text"/>

User Input: Vertical Orifice (Circular or Rectangular)

	<input type="text" value="Not Selected"/>	<input type="text" value="Not Selected"/>			
Invert of Vertical Orifice =	<input type="text" value="N/A"/>	<input type="text" value="N/A"/>	ft (relative to basin bottom at Stage = 0 ft)	Vertical Orifice Area =	<input type="text" value="N/A"/>
Depth at top of Zone using Vertical Orifice =	<input type="text" value="N/A"/>	<input type="text" value="N/A"/>	ft (relative to basin bottom at Stage = 0 ft)	Vertical Orifice Centroid =	<input type="text" value="N/A"/>
Vertical Orifice Diameter =	<input type="text" value="N/A"/>	<input type="text" value="N/A"/>	inches		

User Input: Overflow Weir (Dropbox with Flat or Sloped Gate and Outlet Pipe OR Rectangular/Trapezoidal Weir (and No Outlet Pipe))

	<input type="text" value="Zone 3 Weir"/>	<input type="text" value="Not Selected"/>			
Overflow Weir Front Edge Height, H _o =	<input type="text" value="4.47"/>	<input type="text" value="N/A"/>	ft (relative to basin bottom at Stage = 0 ft)	Height of Gate Upper Edge, H _g =	<input type="text" value="4.47"/>
Overflow Weir Front Edge Length =	<input type="text" value="2.90"/>	<input type="text" value="N/A"/>	feet	Overflow Weir Slope Length =	<input type="text" value="5.70"/>
Overflow Weir Gate Slope =	<input type="text" value="0.00"/>	<input type="text" value="N/A"/>	H:V	Gate Open Area / 100-yr Orifice Area =	<input type="text" value="15.76"/>
Horiz. Length of Weir Sides =	<input type="text" value="5.70"/>	<input type="text" value="N/A"/>	feet	Overflow Gate Open Area w/o Debris =	<input type="text" value="11.57"/>
Overflow Gate Open Area % =	<input type="text" value="70%"/>	<input type="text" value="N/A"/>	% , grate open area/total area	Overflow Gate Open Area w/ Debris =	<input type="text" value="5.79"/>
Debris Clogging % =	<input type="text" value="50%"/>	<input type="text" value="N/A"/>	%		

User Input: Outlet Pipe w/ Flow Restriction Plate (Circular Orifice, Restrictor Plate, or Rectangular Orifice)

	<input type="text" value="Zone 3 Restrictor"/>	<input type="text" value="Not Selected"/>			
Depth to Invert of Outlet Pipe =	<input type="text" value="0.33"/>	<input type="text" value="N/A"/>	ft (distance below basin bottom at Stage = 0 ft)	Outlet Orifice Area =	<input type="text" value="0.73"/>
Outlet Pipe Diameter =	<input type="text" value="18.00"/>	<input type="text" value="N/A"/>	inches	Outlet Orifice Centroid =	<input type="text" value="0.38"/>
Restrictor Plate Height Above Pipe Invert =	<input type="text" value="7.80"/>	<input type="text" value="N/A"/>	inches	Half-Central Angle of Restrictor Plate on Pipe =	<input type="text" value="1.44"/>

User Input: Emergency Spillway (Rectangular or Trapezoidal)

Spillway Invert Stage =	<input type="text" value="4.90"/>	ft (relative to basin bottom at Stage = 0 ft)	Spillway Design Flow Depth =	<input type="text" value="0.98"/>	feet
Spillway Crest Length =	<input type="text" value="12.00"/>	feet	Stage at Top of Freeboard =	<input type="text" value="6.88"/>	feet
Spillway End Slopes =	<input type="text" value="4.00"/>	H:V	Basin Area at Top of Freeboard =	<input type="text" value="0.98"/>	acres
Freeboard above Max Water Surface =	<input type="text" value="1.00"/>	feet	Basin Volume at Top of Freeboard =	<input type="text" value="3.54"/>	acre-ft

Routed Hydrograph Results


The user can override the default CUHP hydrographs and runoff volumes by entering new values in the Inflow Hydrographs table (Columns W through AF).

	WQCV	EURV	2 Year	5 Year	10 Year	25 Year	50 Year	100 Year	500 Year
Design Storm Return Period =	N/A	N/A	1.19	1.50	1.75	2.00	2.25	2.51	3.14
One-Hour Rainfall Depth (in) =	N/A	N/A	1.19	1.50	1.75	2.00	2.25	2.51	3.14
CUHP Runoff Volume (acre-ft) =	0.366	1.394	0.963	1.246	1.473	1.733	1.987	2.269	2.928
Inflow Hydrograph Volume (acre-ft) =	N/A	N/A	0.963	1.246	1.473	1.733	1.987	2.269	2.928
CUHP Predevelopment Peak Q (cfs) =	N/A	N/A	0.1	0.2	0.3	2.7	5.3	8.6	15.6
OPTIONAL Override Predevelopment Peak Q (cfs) =	N/A	N/A							
Predevelopment Unit Peak Flow, q (cfs/acre) =	N/A	N/A	0.01	0.02	0.02	0.21	0.42	0.68	1.23
Peak Inflow Q (cfs) =	N/A	N/A	18.8	23.7	28.0	33.9	39.2	44.7	57.6
Peak Outflow Q (cfs) =	0.1	0.6	0.5	0.5	0.6	2.8	5.0	7.8	15.4
Ratio Peak Outflow to Predevelopment Q =	N/A	N/A	N/A	2.5	2.0	1.0	0.9	0.9	1.0
Structure Controlling Flow =	Plate	Plate	Plate	Plate	Plate	Overflow Weir 1	Overflow Weir 1	Outlet Plate 1	Spillway
Max Velocity through Grate 1 (fps) =	N/A	N/A	N/A	N/A	N/A	0.2	0.4	0.6	0.6
Max Velocity through Grate 2 (fps) =	N/A	N/A	N/A	N/A	N/A	N/A	N/A	N/A	N/A
Time to Drain 97% of Inflow Volume (hours) =	38	65	58	64	67	68	67	66	63
Time to Drain 99% of Inflow Volume (hours) =	40	70	62	68	72	73	73	72	71
Maximum Ponding Depth (ft) =	2.88	4.46	3.80	4.16	4.44	4.62	4.71	4.88	5.23
Area at Maximum Ponding Depth (acres) =	0.46	0.79	0.70	0.76	0.79	0.80	0.81	0.82	0.85
Maximum Volume Stored (acre-ft) =	0.366	1.400	0.894	1.167	1.384	1.527	1.600	1.739	2.023

DETENTION BASIN OUTLET STRUCTURE DESIGN

MHFD-Detention, Version 4.03 (May 2020)

Project: Crossroads North
Basin ID: Pond 3

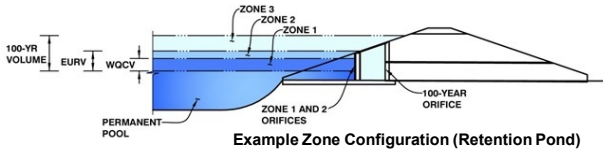

Example Zone Configuration (Retention Pond)

	Estimated Stage (ft)	Estimated Volume (ac-ft)	Outlet Type
Zone 1 (WQCV)	1.96	0.192	Orifice Plate
Zone 2 (EURV)	2.66	0.313	Orifice Plate
Zone 3 (100-year)	3.37	0.386	Weir&Pipe (Restrict)
Total (all zones)		0.892	

User Input: Orifice at Underdrain Outlet (typically used to drain WQCV in a Filtration BMP)

Underdrain Orifice Invert Depth =	<input type="text" value="0.00"/>	ft (distance below the filtration media surface)	Underdrain Orifice Area =	<input type="text" value=""/>	ft ²
Underdrain Orifice Diameter =	<input type="text" value=""/>	inches	Underdrain Orifice Centroid =	<input type="text" value=""/>	feet

User Input: Orifice Plate with one or more orifices or Elliptical Slot Weir (typically used to drain WQCV and/or EURV in a sedimentation BMP)

Invert of Lowest Orifice =	<input type="text" value="0.00"/>	ft (relative to basin bottom at Stage = 0 ft)	WQ Orifice Area per Row =	<input type="text" value="N/A"/>	ft ²
Depth at top of Zone using Orifice Plate =	<input type="text" value="2.66"/>	ft (relative to basin bottom at Stage = 0 ft)	Elliptical Half-Width =	<input type="text" value="N/A"/>	feet
Orifice Plate: Orifice Vertical Spacing =	<input type="text" value="10.84"/>	inches	Elliptical Slot Centroid =	<input type="text" value="N/A"/>	feet
Orifice Plate: Orifice Area per Row =	<input type="text" value="N/A"/>	inches	Elliptical Slot Area =	<input type="text" value="N/A"/>	ft ²

User Input: Stage and Total Area of Each Orifice Row (numbered from lowest to highest)

	Row 1 (required)	Row 2 (optional)	Row 3 (optional)	Row 4 (optional)	Row 5 (optional)	Row 6 (optional)	Row 7 (optional)	Row 8 (optional)
Stage of Orifice Centroid (ft)	0.00	0.90	1.80					
Orifice Area (sq. inches)	0.78	0.84	3.00					

	Row 9 (optional)	Row 10 (optional)	Row 11 (optional)	Row 12 (optional)	Row 13 (optional)	Row 14 (optional)	Row 15 (optional)	Row 16 (optional)
Stage of Orifice Centroid (ft)								
Orifice Area (sq. inches)								

User Input: Vertical Orifice (Circular or Rectangular)

	<input type="checkbox"/> Not Selected	<input type="checkbox"/> Not Selected			
Invert of Vertical Orifice =	<input type="text" value="N/A"/>	<input type="text" value="N/A"/>	ft (relative to basin bottom at Stage = 0 ft)	Vertical Orifice Area =	<input type="text" value="N/A"/>
Depth at top of Zone using Vertical Orifice =	<input type="text" value="N/A"/>	<input type="text" value="N/A"/>	ft (relative to basin bottom at Stage = 0 ft)	Vertical Orifice Centroid =	<input type="text" value="N/A"/>
Vertical Orifice Diameter =	<input type="text" value="N/A"/>	<input type="text" value="N/A"/>	inches		

User Input: Overflow Weir (Dropbox with Flat or Sloped Grate and Outlet Pipe OR Rectangular/Trapezoidal Weir (and No Outlet Pipe))

	<input type="checkbox"/> Zone 3 Weir	<input type="checkbox"/> Not Selected			
Overflow Weir Front Edge Height, H _o =	<input type="text" value="2.67"/>	<input type="text" value="N/A"/>	ft (relative to basin bottom at Stage = 0 ft)	Height of Grate Upper Edge, H _g =	<input type="text" value="2.67"/>
Overflow Weir Front Edge Length =	<input type="text" value="2.90"/>	<input type="text" value="N/A"/>	feet	Overflow Weir Slope Length =	<input type="text" value="5.70"/>
Overflow Weir Grate Slope =	<input type="text" value="0.00"/>	<input type="text" value="N/A"/>	H:V	Grate Open Area / 100-yr Orifice Area =	<input type="text" value="10.23"/>
Horiz. Length of Weir Sides =	<input type="text" value="5.70"/>	<input type="text" value="N/A"/>	feet	Overflow Grate Open Area w/o Debris =	<input type="text" value="11.57"/>
Overflow Grate Open Area % =	<input type="text" value="70%"/>	<input type="text" value="N/A"/>	%, grate open area/total area	Overflow Grate Open Area w/ Debris =	<input type="text" value="5.79"/>
Debris Clogging % =	<input type="text" value="50%"/>	<input type="text" value="N/A"/>	%		

User Input: Outlet Pipe w/ Flow Restriction Plate (Circular Orifice, Restrictor Plate, or Rectangular Orifice)

	<input type="checkbox"/> Zone 3 Restrictor	<input type="checkbox"/> Not Selected			
Depth to Invert of Outlet Pipe =	<input type="text" value="0.25"/>	<input type="text" value="N/A"/>	ft (distance below basin bottom at Stage = 0 ft)	Outlet Orifice Area =	<input type="text" value="1.13"/>
Outlet Pipe Diameter =	<input type="text" value="18.00"/>	<input type="text" value="N/A"/>	inches	Outlet Orifice Centroid =	<input type="text" value="0.52"/>
Restrictor Plate Height Above Pipe Invert =	<input type="text" value="11.00"/>	<input type="text" value="N/A"/>	inches	Half-Central Angle of Restrictor Plate on Pipe =	<input type="text" value="1.79"/>

User Input: Emergency Spillway (Rectangular or Trapezoidal)

Spillway Invert Stage =	<input type="text" value="3.20"/>	ft (relative to basin bottom at Stage = 0 ft)	Spillway Design Flow Depth =	<input type="text" value="0.82"/>	feet
Spillway Crest Length =	<input type="text" value="8.00"/>	feet	Stage at Top of Freeboard =	<input type="text" value="5.02"/>	feet
Spillway End Slopes =	<input type="text" value="4.00"/>	H:V	Basin Area at Top of Freeboard =	<input type="text" value="0.82"/>	acres
Freeboard above Max Water Surface =	<input type="text" value="1.00"/>	feet	Basin Volume at Top of Freeboard =	<input type="text" value="2.07"/>	acre-ft

Routed Hydrograph Results

The user can override the default CUHP hydrographs and runoff volumes by entering new values in the Inflow Hydrographs table (Columns W through AF).


	WQCV	EURV	2 Year	5 Year	10 Year	25 Year	50 Year	100 Year	500 Year
Design Storm Return Period =	N/A	N/A	1.19	1.50	1.75	2.00	2.25	2.51	3.14
One-Hour Rainfall Depth (in) =	N/A	N/A	1.19	1.50	1.75	2.00	2.25	2.51	3.14
CUHP Runoff Volume (acre-ft) =	0.192	0.505	0.360	0.490	0.594	0.825	1.044	1.325	1.959
Inflow Hydrograph Volume (acre-ft) =	N/A	N/A	0.360	0.490	0.594	0.825	1.044	1.325	1.959
CUHP Predevelopment Peak Q (cfs) =	N/A	N/A	0.1	0.3	0.4	3.3	6.5	10.6	19.1
OPTIONAL Override Predevelopment Peak Q (cfs) =	N/A	N/A							
Predevelopment Unit Peak Flow, q (cfs/acre) =	N/A	N/A	0.01	0.02	0.03	0.24	0.47	0.76	1.37
Peak Inflow Q (cfs) =	N/A	N/A	5.5	7.6	9.3	14.1	18.4	23.8	35.1
Peak Outflow Q (cfs) =	0.1	0.2	0.1	0.2	0.8	3.6	6.7	9.3	16.5
Ratio Peak Outflow to Predevelopment Q =	N/A	N/A	N/A	0.6	2.0	1.1	1.0	0.9	0.9
Structure Controlling Flow =	Plate	Plate	Plate	Plate	Overflow Weir 1	Overflow Weir 1	Overflow Weir 1	Outlet Plate 1	Spillway
Max Velocity through Grate 1 (fps) =	N/A	N/A	N/A	N/A	0.0	0.3	0.6	0.8	0.8
Max Velocity through Grate 2 (fps) =	N/A	N/A	N/A	N/A	N/A	N/A	N/A	N/A	N/A
Time to Drain 97% of Inflow Volume (hours) =	38	62	53	61	65	63	62	60	55
Time to Drain 99% of Inflow Volume (hours) =	40	65	56	65	68	68	67	66	65
Maximum Ponding Depth (ft) =	1.96	2.66	2.30	2.57	2.73	2.87	2.98	3.16	3.58
Area at Maximum Ponding Depth (acres) =	0.38	0.50	0.44	0.48	0.51	0.53	0.54	0.57	0.63
Maximum Volume Stored (acre-ft) =	0.196	0.505	0.332	0.461	0.541	0.613	0.672	0.772	1.023

DETENTION BASIN STAGE-STORAGE TABLE BUILDER

MHFD-Detention, Version 4.03 (May 2020)

Project: **Crossroads North**

Basin ID: **Pond 4**

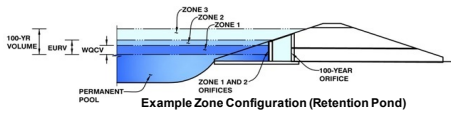

Watershed Information

Selected BMP Type =	EDB	
Watershed Area =	9.35	acres
Watershed Length =	793	ft
Watershed Length to Centroid =	449	ft
Watershed Slope =	0.034	ft/ft
Watershed Imperviousness =	12.50%	percent
Percentage Hydrologic Soil Group A =	100.0%	percent
Percentage Hydrologic Soil Group B =	0.0%	percent
Percentage Hydrologic Soil Groups C/D =	0.0%	percent
Target WQCV Drain Time =	40.0	hours
Location for 1-hr Rainfall Depths =	User Input	

After providing required inputs above including 1-hour rainfall depths, click "Run QJHP" to generate runoff hydrographs using the embedded Colorado Urban Hydrograph Procedure.

Water Quality Capture Volume (WQCV) =	0.063	acre-feet
Excess Urban Runoff Volume (EURV) =	0.091	acre-feet
2-yr Runoff Volume (P1 = 1.19 in.) =	0.049	acre-feet
5-yr Runoff Volume (P1 = 1.5 in.) =	0.078	acre-feet
10-yr Runoff Volume (P1 = 1.75 in.) =	0.103	acre-feet
25-yr Runoff Volume (P1 = 2 in.) =	0.233	acre-feet
50-yr Runoff Volume (P1 = 2.25 in.) =	0.361	acre-feet
100-yr Runoff Volume (P1 = 2.51 in.) =	0.533	acre-feet
500-yr Runoff Volume (P1 = 3.14 in.) =	0.931	acre-feet
Approximate 2-yr Detention Volume =	0.055	acre-feet
Approximate 5-yr Detention Volume =	0.075	acre-feet
Approximate 10-yr Detention Volume =	0.098	acre-feet
Approximate 25-yr Detention Volume =	0.131	acre-feet
Approximate 50-yr Detention Volume =	0.169	acre-feet
Approximate 100-yr Detention Volume =	0.255	acre-feet

Optional User Overrides

		acre-feet
		acre-feet
	1.19	inches
	1.50	inches
	1.75	inches
	2.00	inches
	2.25	inches
	2.51	inches
		inches

Define Zones and Basin Geometry


Zone 1 Volume (WQCV) =	0.063	acre-feet
Zone 2 Volume (EURV - Zone 1) =	0.029	acre-feet
Zone 3 Volume (100-year - Zones 1 & 2) =	0.164	acre-feet
Total Detention Basin Volume =	0.255	acre-feet
Initial Surcharge Volume (ISV) =	user	ft ³
Initial Surcharge Depth (ISD) =	user	ft
Total Available Detention Depth (H _{total}) =	user	ft
Depth of Trickle Channel (H _{tc}) =	user	ft
Slope of Trickle Channel (S _{tc}) =	user	ft/ft
Slopes of Main Basin Sides (S _{main}) =	user	H:V
Basin Length-to-Width Ratio (R _{LW}) =	user	
Initial Surcharge Area (A _{ISV}) =	user	ft ²
Surcharge Volume Length (L _{ISV}) =	user	ft
Surcharge Volume Width (W _{ISV}) =	user	ft
Depth of Basin Floor (H _{FLOOR}) =	user	ft
Length of Basin Floor (L _{FLOOR}) =	user	ft
Width of Basin Floor (W _{FLOOR}) =	user	ft
Area of Basin Floor (A _{FLOOR}) =	user	ft ²
Volume of Basin Floor (V _{FLOOR}) =	user	ft ³
Depth of Main Basin (H _{MAIN}) =	user	ft
Length of Main Basin (L _{MAIN}) =	user	ft
Width of Main Basin (W _{MAIN}) =	user	ft
Area of Main Basin (A _{MAIN}) =	user	ft ²
Volume of Main Basin (V _{MAIN}) =	user	ft ³
Calculated Total Basin Volume (V _{total}) =	user	acre-feet

Depth Increment =	1.00	ft							
Stage - Storage Description	Stage (ft)	Optional Override Stage (ft)	Length (ft)	Width (ft)	Area (ft ²)	Optional Override Area (ft ²)	Area (acre)	Volume (ft ³)	Volume (ac-ft)
6333.33 Top of Micropool	--	0.00	--	--	--	10	0.000		
34	--	1.00	--	--	171		0.004	90	0.002
35	--	2.00	--	--	8,828		0.203	4,590	0.105
36	--	3.00	--	--	17,653		0.405	17,830	0.409
37	--	4.00	--	--	22,323		0.512	37,818	0.868
38	--	5.00	--	--	27,052		0.621	62,506	1.435

DETENTION BASIN OUTLET STRUCTURE DESIGN

MHFD-Detention, Version 4.03 (May 2020)

Project: Crossroads North
Basin ID: Pond 4

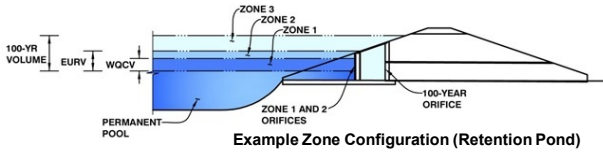

Example Zone Configuration (Retention Pond)

	Estimated Stage (ft)	Estimated Volume (ac-ft)	Outlet Type
Zone 1 (WQCV)	1.77	0.063	Orifice Plate
Zone 2 (EURV)	1.93	0.029	Orifice Plate
Zone 3 (100-year)	2.58	0.164	Weir&Pipe (Restrict)
Total (all zones)		0.255	

User Input: Orifice at Underdrain Outlet (typically used to drain WQCV in a Filtration BMP)

Underdrain Orifice Invert Depth = ft (distance below the filtration media surface)
Underdrain Orifice Diameter = inches

Calculated Parameters for Underdrain

Underdrain Orifice Area = ft²
Underdrain Orifice Centroid = feet

User Input: Orifice Plate with one or more orifices or Elliptical Slot Weir (typically used to drain WQCV and/or EURV in a sedimentation BMP)

Invert of Lowest Orifice = ft (relative to basin bottom at Stage = 0 ft)
Depth at top of Zone using Orifice Plate = ft (relative to basin bottom at Stage = 0 ft)
Orifice Plate: Orifice Vertical Spacing = inches
Orifice Plate: Orifice Area per Row = sq. inches (diameter = 1/2 inch)

Calculated Parameters for Plate

WQ Orifice Area per Row = ft²
Elliptical Half-Width = feet
Elliptical Slot Centroid = feet
Elliptical Slot Area = ft²

User Input: Stage and Total Area of Each Orifice Row (numbered from lowest to highest)

	Row 1 (required)	Row 2 (optional)	Row 3 (optional)	Row 4 (optional)	Row 5 (optional)	Row 6 (optional)	Row 7 (optional)	Row 8 (optional)
Stage of Orifice Centroid (ft)	0.00	0.48	0.96					
Orifice Area (sq. inches)	0.20	0.20	0.20					

	Row 9 (optional)	Row 10 (optional)	Row 11 (optional)	Row 12 (optional)	Row 13 (optional)	Row 14 (optional)	Row 15 (optional)	Row 16 (optional)
Stage of Orifice Centroid (ft)								
Orifice Area (sq. inches)								

User Input: Vertical Orifice (Circular or Rectangular)

Invert of Vertical Orifice = ft (relative to basin bottom at Stage = 0 ft)
Depth at top of Zone using Vertical Orifice = ft (relative to basin bottom at Stage = 0 ft)
Vertical Orifice Diameter = inches

Calculated Parameters for Vertical Orifice

Vertical Orifice Area = ft²
Vertical Orifice Centroid = feet

User Input: Overflow Weir (Dropbox with Flat or Sloped Grate and Outlet Pipe OR Rectangular/Trapezoidal Weir (and No Outlet Pipe))

Overflow Weir Front Edge Height, H_o = ft (relative to basin bottom at Stage = 0 ft)
Overflow Weir Front Edge Length = feet
Overflow Weir Grate Slope = H:V
Horiz. Length of Weir Sides = feet
Overflow Grate Open Area % = %, grate open area/total area
Debris Clogging % = %

Calculated Parameters for Overflow Weir

Height of Grate Upper Edge, H_u = feet
Overflow Weir Slope Length = feet
Grate Open Area / 100-yr Orifice Area = ft²
Overflow Grate Open Area w/o Debris = ft²
Overflow Grate Open Area w/ Debris = ft²

User Input: Outlet Pipe w/ Flow Restriction Plate (Circular Orifice, Restrictor Plate, or Rectangular Orifice)

Depth to Invert of Outlet Pipe = ft (distance below basin bottom at Stage = 0 ft)
Outlet Pipe Diameter = inches
Restrictor Plate Height Above Pipe Invert = inches

Calculated Parameters for Outlet Pipe w/ Flow Restriction Plate

Outlet Orifice Area = ft²
Outlet Orifice Centroid = feet
Half-Central Angle of Restrictor Plate on Pipe = radians

User Input: Emergency Spillway (Rectangular or Trapezoidal)

Spillway Invert Stage = ft (relative to basin bottom at Stage = 0 ft)
Spillway Crest Length = feet
Spillway End Slopes = H:V
Freeboard above Max Water Surface = feet

Calculated Parameters for Spillway

Spillway Design Flow Depth = feet
Stage at Top of Freeboard = feet
Basin Area at Top of Freeboard = acres
Basin Volume at Top of Freeboard = acre-ft

Routed Hydrograph Results


The user can override the default CUHP hydrographs and runoff volumes by entering new values in the Inflow Hydrographs table (Columns W through AF).

	WQCV	EURV	2 Year	5 Year	10 Year	25 Year	50 Year	100 Year	500 Year
Design Storm Return Period =	N/A	N/A	1.19	1.50	1.75	2.00	2.25	2.51	3.14
One-Hour Rainfall Depth (in) =	0.063	0.091	0.049	0.078	0.103	0.233	0.361	0.533	0.931
CUHP Runoff Volume (acre-ft) =	N/A	N/A	0.049	0.078	0.103	0.233	0.361	0.533	0.931
Inflow Hydrograph Volume (acre-ft) =	N/A	N/A	0.1	0.2	0.2	2.0	4.1	6.6	11.9
CUHP Predevelopment Peak Q (cfs) =	N/A	N/A							
OPTIONAL Override Predevelopment Peak Q (cfs) =	N/A	N/A							
Predevelopment Unit Peak Flow, q (cfs/acre) =	N/A	N/A	0.01	0.02	0.02	0.22	0.43	0.70	1.27
Peak Inflow Q (cfs) =	N/A	N/A	0.7	1.2	1.5	3.6	5.7	8.2	13.6
Peak Outflow Q (cfs) =	0.0	0.0	0.0	0.0	0.0	1.3	3.2	5.6	8.9
Ratio Peak Outflow to Predevelopment Q =	N/A	N/A	N/A	0.1	0.1	0.6	0.8	0.9	0.7
Structure Controlling Flow =	Plate	Plate	Plate	Plate	Plate	Overflow Weir 1	Overflow Weir 1	Overflow Weir 1	Spillway
Max Velocity through Grate 1 (fps) =	N/A	N/A	N/A	N/A	N/A	0.1	0.3	0.5	0.6
Max Velocity through Grate 2 (fps) =	N/A	N/A	N/A	N/A	N/A	N/A	N/A	N/A	N/A
Time to Drain 97% of Inflow Volume (hours) =	38	52	31	46	58	72	69	66	58
Time to Drain 99% of Inflow Volume (hours) =	40	54	33	48	60	76	75	73	70
Maximum Ponding Depth (ft) =	1.77	1.93	1.64	1.83	1.96	2.23	2.31	2.40	2.75
Area at Maximum Ponding Depth (acres) =	0.16	0.19	0.13	0.17	0.19	0.25	0.27	0.28	0.35
Maximum Volume Stored (acre-ft) =	0.064	0.092	0.044	0.072	0.097	0.155	0.178	0.203	0.311

label and reference on the drainage map. Not sure which drainage channel this is associated with.

The open channel flow calculator

Select Channel Type: Trapezoid

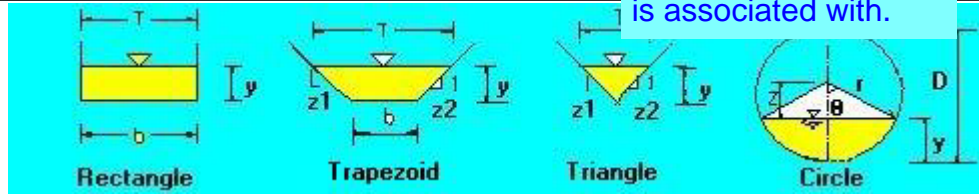

Depth from Q

Select unit system: Feet(ft)


Channel slope: .08 ft/ft	Water depth(y): 0.54 ft	Bottom width(b): 10 ft
Flow velocity: 6.647 ft/s	LeftSlope (Z1): 5 to 1 (H:V)	RightSlope (Z2): 10 to 1 (H:V)
Flow discharge: 50.9 ft ³ /s	Input n value: 0.035 or select n	
Calculate!	Status: Calculation finished	Reset
Wetted perimeter: 18.24 ft	Flow area: 7.66 ft ²	Top width(T): 18.16 ft
Specific energy: 1.23 ft	Froude number: 1.8	Flow status: Supercritical flow
Critical depth: 0.76 ft	Critical slope: 0.0217 ft/ft	Velocity head: 0.69 ft

Copyright 2000 Dr. Xing Fang, Department of Civil Engineering, Lamar University.

Hydraulic analysis will be reviewed and finalized with the Final Drainage Report that will be submitted with the subsequent application.

Upstream Capacity at Design Point 27

CHART 2B

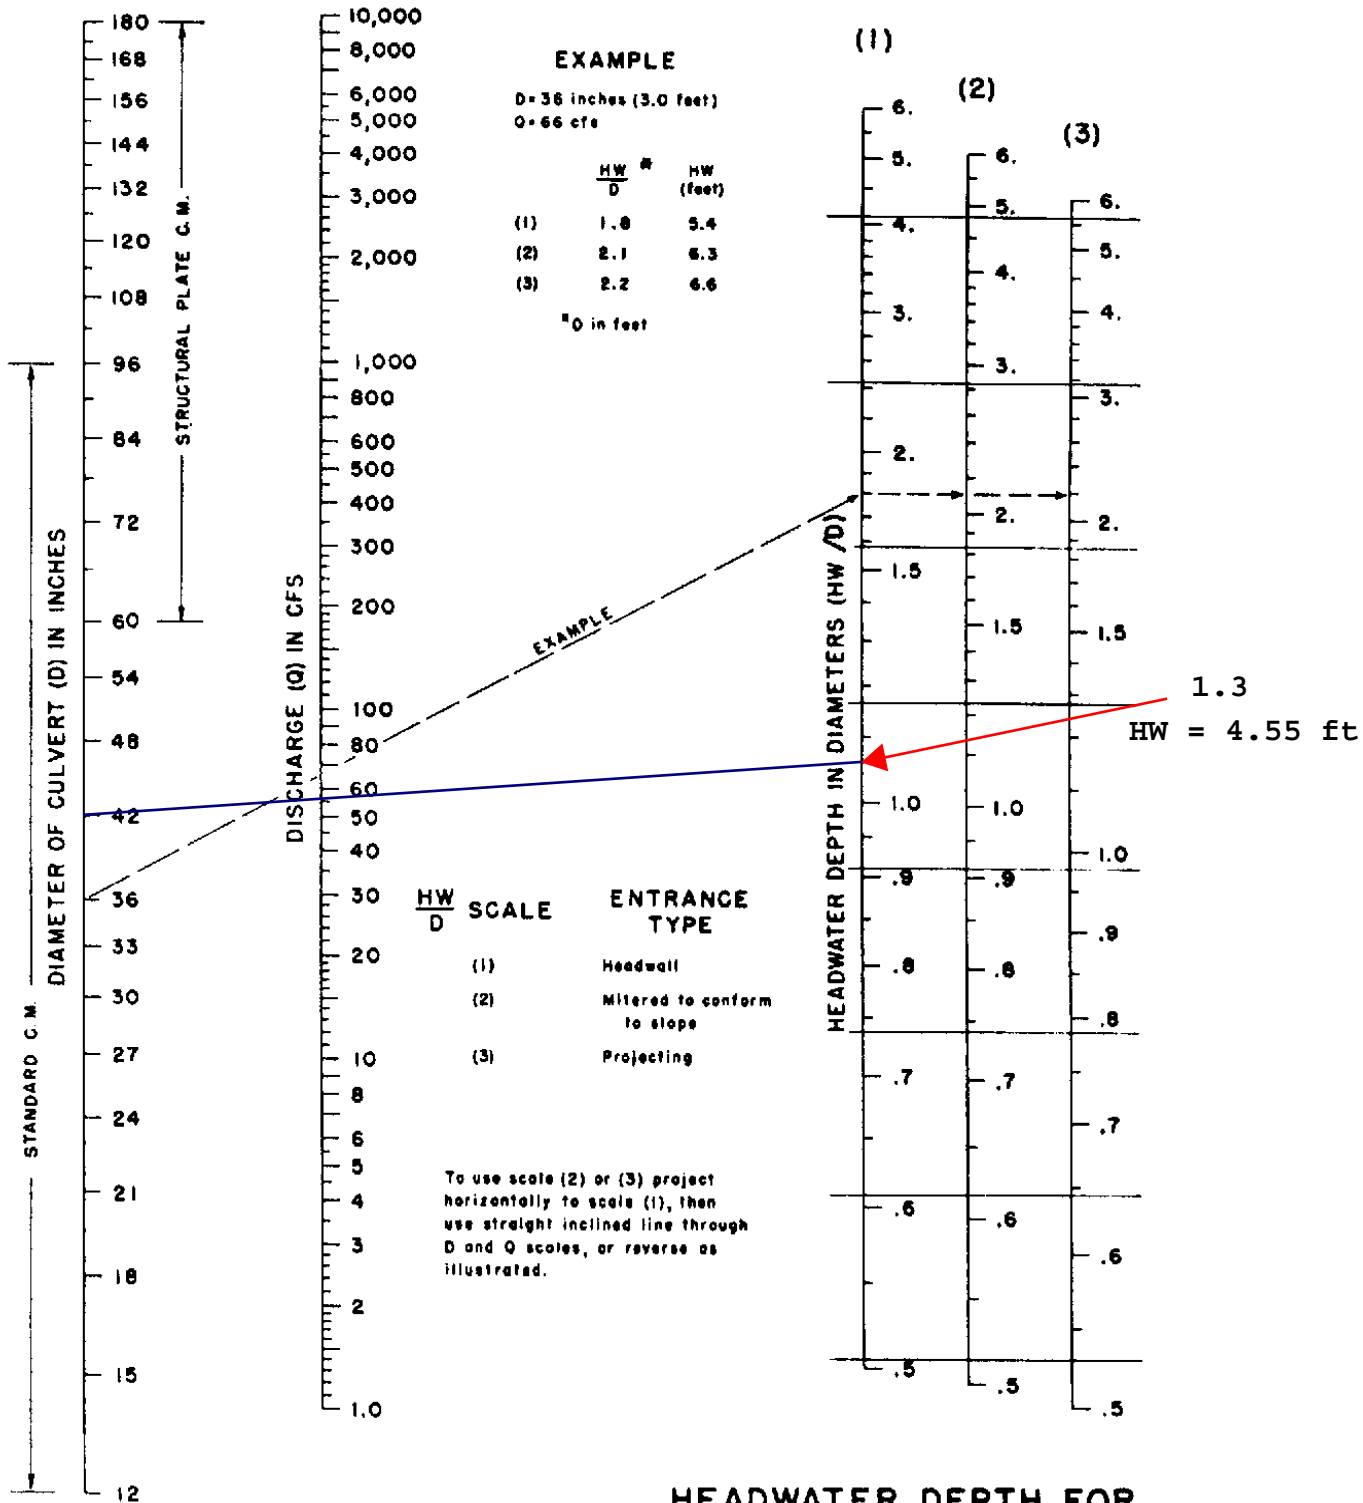


Manning Formula Uniform Pipe Flow at Given Slope and Depth

Check out our spreadsheet version of this calculator [Download Spreadsheet](#) [Open Google Sheets version](#) [View All Spreadsheets](#)

Printable Title

Printable Subtitle

Inputs			Results		
Pipe diameter, d_0	4	ft	Flow, Q (See notes)	34.4649	cfs
Manning roughness, n	0.022		Velocity, v	9.7320	ft/sec
Pressure slope (possibly \approx equal to pipe slope), S_0	0.0316	rise/run	Velocity head, h_v	1.4720	ft H2O
Percent of (or ratio to) full depth (100% or 1 if flowing full)	32.5	%	Flow area	3.5416	ft ²
			Wetted perimeter	4.8529	ft
			Hydraulic radius	0.7298	ft
			Top width, T	3.7470	ft
			Froude number, E	1.77	
			Shear stress (tractive force), τ	1.4397	psf

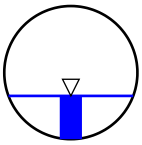

Notes:

This is the flow and depth *inside* the pipe.

Getting the flow into the pipe may require significantly higher headwater depth. Add at least 1.5 times the velocity head to get the headwater depth or [see my 2-minute tutorial](#) for standard culvert headwater calculations using HY-8.

Upstream Capacity at Design Point 33

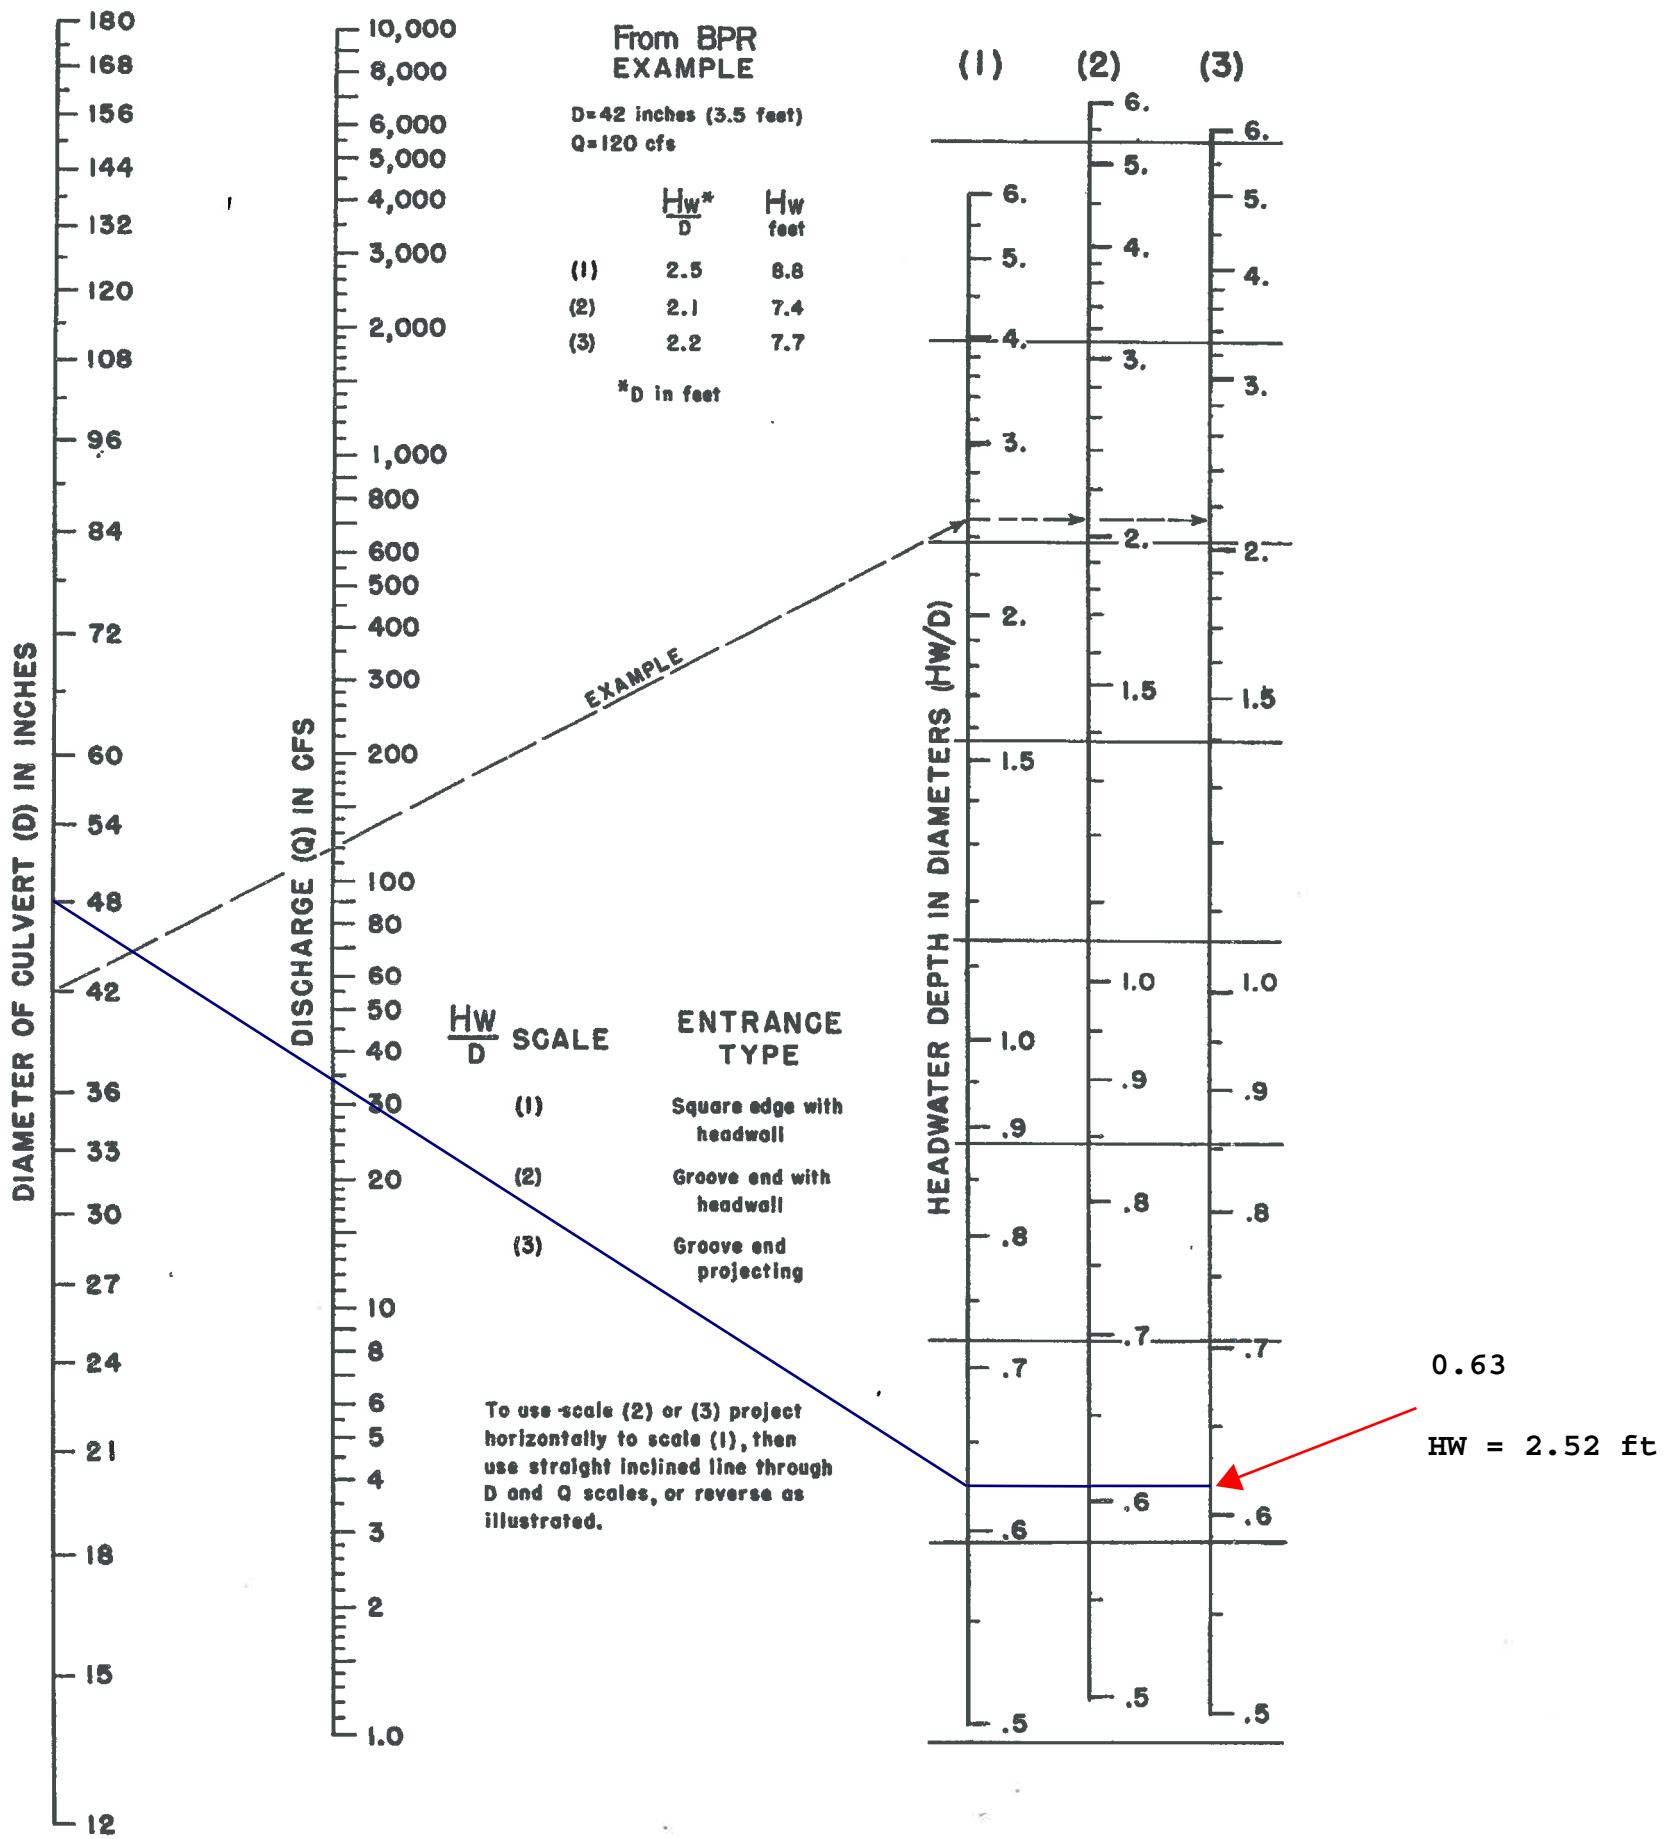


Figure CU-9—Inlet Control Nomograph—Example

MARKSHEFFEL ROAD FINAL DRAINAGE REPORT EXCERPTS



Final Drainage Report

Marksheffel Road South


Link Road to US-24

El Paso County, CO

January 2017



Figure 1 - Vicinity Map

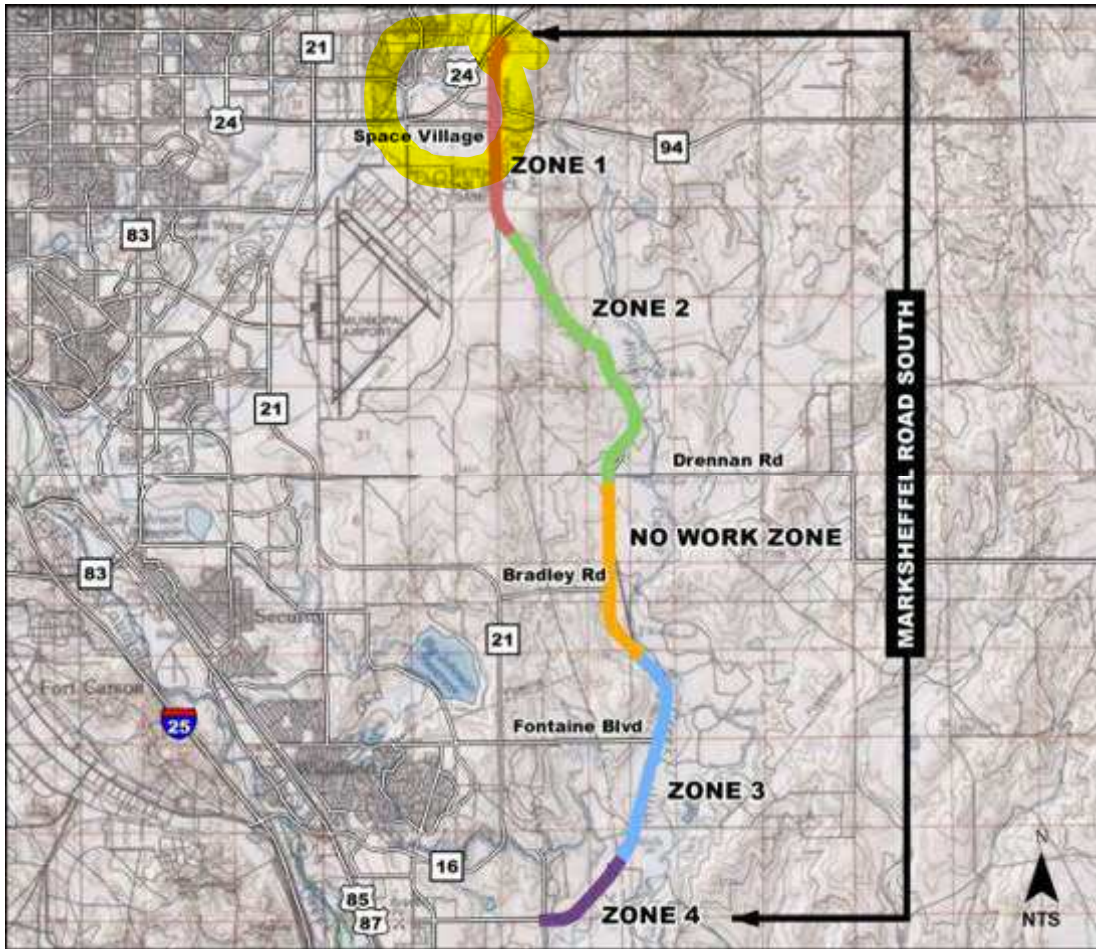

The site is located in multiple townships, ranges and sections as shown in table 1 below.

Table 1: Township Range and Section

Township	Range	Section
14 South	65 West	8, 9, 16, 17, 20, 21, 27, 28, 33, 24
15 South	65 West	10, 15, 22, 27, 28

The majority of the project is located within the Jimmy Camp Creek Drainage Basin and runoff from the surrounding area drains east towards Jimmy Camp Creek crossing Marksheffel Road through a number of culverts. The West Fork of Jimmy Camp Creek flows on the west side of Marksheffel following the roadway down to Link Road where it crosses Marksheffel and connects with the main branch of Jimmy Camp Creek. A portion of the project is also located within the Peterson Field Drainage Basin, which receives the majority of Zone 1 runoff.

The offsite topography is rolling plains with mostly undeveloped lands. Generally, the land slopes from north to south and west to east across the project roadway.



are less than the WQCV event. The overall goal of the project is to detain the WQCV along the entire roadway pavement. The required WQCV will be in areas located within the El Paso County & City of Colorado Springs MS4 Permit Boundary, which is within the City boundary and the El Paso County Urbanized Area. Treatment will be provided as possible outside of these boundaries, though it is not required.

Per the City of Colorado Springs Drainage Criteria Manual Vol 2, "Stormwater Quality Policies, Procedures and Best Management Practices," November 1, 2002 approved BMP's - Sand Filters and Extended Detention Basins will be used to provide Water Quality Capture Volume for the project to satisfy the MS4 Permit requirements.

2.4 Floodplain Criteria

See Appendix 11 for all applicable Floodplain Criteria.

3.0 HYDROLOGY

3.1 Precipitation

Design rainfall for this project was determined by using the National Oceanic and Atmospheric Administration (NOAA) Precipitation Frequency Data Server, which delivers the NOAA Atlas 14 precipitation frequency estimates. A single location along Marksheffel Road was chosen to represent the entire project. Estimated rainfall depths for the design durations were obtained from this NOAA webtool. Rainfall intensities for the 1-hour 5 and 100-year events are 1.30 and 2.76-inches per hour respectively. Design rainfall uses NOAA Atlas 14 Volume III, which provides the most up to date information available. See Appendix 3 for further design details.

3.2 Drainage Basins

This project is segmented into four zones for design. The most southern zone, Zone 4 is Sta. 70+83.78 to Sta. 128+00, Zone 3 is Sta. 128+00 to 282+30.48, Zone 2 is 376+00 to Sta. 554+00, and the most northern zone is Zone 1 and is Sta. 554+00 to 670+73.68.

On the East side of Marksheffel is Jimmy Camp Creek, which is an identified and studied floodplain (Zone AE). Jimmy Camp Creek does not cross the Marksheffel Road, but stays to the east and south of the roadway. On the west side of the road an identified unstudied floodplain (Zone A) which crosses the road at Sta. 256+00. Several tributaries to Jimmy Camp Creek do cross the road in Zone 3. At the south end of the project in Zone 4, near Link Road, on the northwest side of Marksheffel Road is the Jimmy Camp Creek West Tributary. This tributary is an identified studied floodplain (Zone AE) which crosses the roadway in multiple locations

On the north portion of this project most of the offsite drainage flows from north to south and crosses east across Marksheffel Road north of Space Village Road, then flows to the southwest through the culvert crossing at Sta. 563+20. From that point, all the off site drainage flows from west to east crossing Marksheffel and following natural drainage paths to Jimmy Camp Creek. The on-site flows will be conveyed in curb and gutter section north of Space Village Road. South of Space Village Road the runoff follows the grade of the road draining into roadside ditches.



In Zone 3, the Farmers Mutual irrigation ditch is located at Sta. 212+00 north of Fontaine Boulevard. Both irrigation and storm flows are collected on the west and piped across Marksheffel Road to the irrigation ditch that continues east.

The majority of flow from Fontaine Boulevard to the south contributes to the Jimmy Camp Creek West Tributary. This basin is 3.98 square miles and crosses Marksheffel Road at Sta. 103+00, 91+00, and 71+00. From there flows converge with the main branch of Jimmy Camp Creek. The West Tributary is a FEMA Zone AE studied floodplain with base flood elevations determined. The roadway and drainage work within this floodplain has been reduced to adding shoulders, and replacing culverts to match the existing culverts. The crown of the roadway is limited to matching the existing roadway crown in order to not impact the floodplain elevations.

Pavement basins are not discussed in the narrative, but are included within the rational method calculations.

3.2.1 ZONE 1

This northern portion of the project drains easterly across Marksheffel Road and South to a multi-cell box culvert at Station 563+20 where the runoff flows back across Marksheffel and onto Peterson Air Force Base.

Basin 640L contains 50.0-acres between Air Lane and US-24 west of Marksheffel Road. Historically the runoff in this area was conveyed west across Marksheffel at Sta. 650+26 through an 18-inch CMP and at Sta. 642+80 through an 18-inch CMP. It is proposed to drain the basin south at Air Lane through a 48-inch RCP, where the runoff enters Basin 631L.

Basin 631L contains 18.1-acres between SH-94 and Air Lane. Currently the basin drains south across SH-94 through an existing 42-inch RCP. In the proposed condition, runoff from Basin 640L and 631L will enter an extended detention basin that provides some detention and water quality. From the pond runoff will drain south to Basin 618L through the existing 42-inch RCP.

Basin 618L contains 38.4-acres between Air Lane and Space Village Road west of Marksheffel Road. This runoff flows southwest and currently crosses diagonally through the intersection with Space Village Road through an existing 18-inch CMP. It is proposed to treat this runoff in an extended detention basin that does not provide for detention and to drain it south across Space Village Road in a 5 x 2-foot CBC, then west across Marksheffel Road through double 45 x 29-inch ERCPs. From there runoff enters Basin 552R.

Basin 608L contains 21.4-acres between Sta. 608+00 and Space Village Road. This runoff flows west to east and crosses Marksheffel Road at the proposed double 45 x 29-inch ERCPs which also carries runoff from the north. From there runoff enters into Basin 552R.

Basin 575L contains 106.1-acres. This runoff flows to the south with flows staying on the west side of Marksheffel Road. Flows from this basin cross the Peterson Air Force Base Access Road near Sta. 574+00 through an existing 24-inch RCP and a proposed 60" x 38" ERCP. From there flows travel to the south into Basin 563L.



existing runoff along historic drainage patterns. Offsite runoff is not being increased as part of this project. It will be the responsibility of future developers to detain flows that result from an increase in runoff from change in land use.

Roadway basins were primarily delineated for water quality determination. Ditches capacities were primarily confirmed using offsite flows and were sized for maintenance concerns.

The results of the basin hydrology are shown in the tables below.

3.3.1 Rational Method

The Rational Basin hydrology is shown below in Table 5. This table includes both the on-site roadway basins and the offsite basins. The Basin IDs generally represent the roadway station each basin outlets to, and the L and R indicate the basin in on the left or right side of the Marksheffel centerline. The basins are listed from the north end of the project to the south generally following the drainage patterns of the project.

Table 5: Basins (Rational Method)

Basin ID	Area (ac)	5 -Year		100- Year	
		C	Q (cfs)	C	Q (cfs)
Zone 1					
664R	1.09	0.90	4.54	0.95	9.87
662L	1.21	0.90	4.79	0.95	10.4
661L	0.07	0.90	0.29	0.95	0.63
654L	1.62	0.90	6.04	0.95	13.1
646R	0.75	0.90	2.63	0.95	5.70
641L	1.58	0.90	4.48	0.95	9.72
640L	50.0	0.25	20.6	0.35	60.0
637R	0.91	0.90	2.22	0.95	4.82
631R	0.56	0.90	2.22	0.95	4.83
632L	1.21	0.90	3.96	0.95	8.61
631L	18.1	0.29	9.95	0.39	27.3
618R	1.41	0.90	4.61	0.95	10.0
618L	38.4	0.27	14.7	0.37	42.1
617R	17.53	0.25	9.55	0.35	27.55
608R	1.12	0.90	3.28	0.95	7.13
608L	21.4	0.28	10.0	0.38	28.2
575L	106	0.27	29.4	0.37	85.8
563R	4.84	0.90	8.45	0.95	18.4
563L	11.7	0.25	4.87	0.35	14.2
Zone 2					
553R	0.80	0.90	2.44	0.95	5.31
553L	0.26	0.90	1.01	0.95	2.20
552R	662	0.27	99.3	0.37	302
547R	0.33	0.90	1.17	0.95	2.53
534R	0.37	0.90	1.38	0.95	3.01
534L	15.5	0.29	7.09	0.39	19.8
498L	1.61	0.90	2.96	0.95	6.43
485L	0.33	0.90	1.38	0.95	3.01
484R	2.64	0.90	4.61	0.95	10.1
484L	142	0.26	44.0	.036	129.5
480L	0.17	0.90	0.68	0.95	1.48



calculated by either the Rational Method or the USGS Regional Regression methodology. A small number of culverts were upsized based on a need for additional capacity to meet current design criteria. Culverts that have been upsized outlet to Jimmy Camp Creek and the runoff follows historic drainage patterns, any increased conveyance through the upsized pipe is not expected to have adverse downstream impacts. The minimum 100-year velocity is 3.71 fps. See Appendix 9 for calculations.

Table 7 lists the proposed culverts through the project corridor.

Table 7: Culvert Design

Culvert ID	Existing Size	Proposed Size	100 Year Flow (cfs)	100 Year Headwater	Allowable Headwater	100 Year Velocity (fps)
Zone 1						
CV639	-	42"	75.4	6337.4	6338.3	9.41
SH-94	42"	-	77.4	6323.2	6325.0	20.51
CV617		2-24"	27.55	6282.6	6284.72	6.17
CV616	-	2-45x29	127	6284.8	8285.0	9.29
CV614	-	18"	15.21	6285.6	6285.8	8.82
CV603	-	18"	3.94	6284.7	6286.4	7.95
CV594	-	18"	8.17	6255.2	6256.8	6.57
CV592	-	18"	9.38	6256.1	6257.4	10.00
CV575	-	60" x 38"	85.75	6203.8	6204.6	17.48
CV563	2-7'x3'	2-7x3 CBC	349	6187.2	6187.7	15.13
Zone 2						
CV533	36"	36"	19.8	6159.3	6163.0	15.00
CV490	-	18"	6.06	6073.5	6075.8	7.08
CV483	36"	2-36"	129	6063.8	6064.7	13.75
CV468	36"	36"	38.0	6033.2	6038.0	12.43
CV447	72"	72"	140	5989.0	5995.9	12.29
CV404	48"	54"	134	5908.8	5909.7	10.37
Zone 3						
CV255	-	18"	6.83	5759.1	5760.0	10.06
CV233	-	24"	16.9	5738.6	5739.5	8.11
CV228	72"	7x4 CBC	75.4	5732.9	5736.7	12.73
CV195	-	18"	9.87	5700.9	5703.0	6.76
CV194	-	18"	10.1	5699.8	5701.8	6.77
CV192	-	18"	10.5	5697.8	5699.8	6.84
CV178L		2-36"	87.1	5688.9	5690.19	8.03
CV177R	24"	2-24"	28.6	5687.56	5689.14	6.27
CV177	-	2-36"	87.06	5688.43	5688.7	8.63
CV168	-	2-24"	33.60	5683.18	5683.94	6.75
CV152	18"	18"	8.68	5674.0	5675.2	6.02
CV150	-	6x2 CBC	119	5676.3	5676.3	9.90
Zone 4						
CV125	-	24"	8.55	5652.54	5654.11	6.01
CV121	-	24"	9.59	5649.44	5650.77	6.23
CV117	-	24"	11.16	5646.58	5647.78	6.36
CV112	-	18"	1.67	5640.75	5643.25	4.21
CV109	-	18"	2.31	5638.7	5641.2	4.18
CV102	24"	24"	Replaced in kind to not impact floodplain			



Culvert ID	Existing Size	Proposed Size	100 Year Flow (cfs)	100 Year Headwater	Allowable Headwater	100 Year Velocity (fps)
CV92	24"	30" x 19"	Replaced in kind to not impact floodplain			

4.1.1 Hydraulic Variance

The existing 42-inch culvert at SH-94 has a velocity greater than 18-fps. This is due to the steepness of the culvert, re-routing of the storm system, and ROW limitations that limit what can be detained at that location. A stilling basin has been designed for the outlet of this culvert to counteract the scour forces caused by such high velocities.

Utility impacts caused a set of ditch modifications that included a set of bumpouts for access to the utility manholes along the a few sections of the corridor. These bulbouts block the roadside ditch and 24-inch RCPs. These culverts do not have to convey the full 100-year event, but may overtop the bumpouts during large events.

4.2 Storm Pipes

Inlets and storm pipes are used to route water from the curb and gutter section in Zone 1 to the adjacent ditch on the left side of the roadway. In Zone 2 and 3 grate inlets are used in the ditches to route on-site flow from the ditches to crossing culverts where the runoff will follow historic drainage patterns. In Zone 2 Inlets are placed in the ditches and shall follow ditch criteria requirements. In Table 8 and 9, the inlet location and storm system information is summarized.

For the InRoads calculations located in Appendix 7 of this report the Q₅ is only provided for the inlets listed in Table 8 below. This was done because these inlets are in the only curb and gutter section of the project and the Q₅ was analyzed for spread criteria. In other locations the Q₁₀₀ criteria superseded the Q₅ HW/D criteria.

Table 8: Storm System Design

Inlet ID	Inlet Type	Inlet Size (ft)	Pipe Size	5-Year				100-Year			
				Flow (cfs)	Flow Depth (ft)	Spread (ft)	Pipe Velocity (fps)	Flow (cfs)	Flow Depth (ft)	Spread (ft)	Pipe Velocity (fps)
ZONE 1											
IN664	Type R	5	24"	4.54	0.21	14.82	4.20	9.87	0.25	20.1	4.56
IN662	Type R	5	24"	4.79	0.30	8.81	7.59	10.4	0.38	12.5	8.44
IN661	Type R	5	18"	3.11	0.26	8.95	5.05	8.22	0.33	14.4	6.35
IN654	Type R	5	24"	10.5	0.45	7.70	3.76	26.57	0.62	11.1	4.36
IN646	Type R	5	24"	10.4	0.48	17.7	4.50	27.8	0.65	26.0	5.31
IN640	Type R	5	24"	4.48	0.38	12.5	6.98	9.72	0.47	17.2	7.85
IN636	Type R	5	18"	2.22	0.23	14.8	3.45	4.68	0.27	22.1	3.72
IN630A	Type R	5	24"	2.22	0.23	4.92	4.70	4.83	0.28	7.78	5.31
IN630B	Type R	5	24"	3.96	0.27	7.03	3.24	8.61	0.33	10.3	3.54
IN620	Type R	5	18"	4.61	0.28	7.89	2.62	10.00	0.35	11.36	2.89



Table 9: Grate Inlet Table

Inlet ID	Inlet Type	Pipe Size	100-Year		
			Flow (cfs)	Ponding Depth (ft)	Pipe Velocity (fps)
IN592	Type C	18"	Nuisance Flows		
IN533	Type D	36"	3.01	0.71	15.00
IN468B	Type D	36"	5.93	0.34	12.43
IN468	Type D	36"	2.11	0.52	12.43
IN447	Type D	72"	5.01	0.75	12.29
IN403	Type D	18"	1.77	0.15	1.00
IN206	Type C	24"	5.63	0.47	3.85
IN228	Type D	7x4 CBC	2.81	0.64	12.58
IN257	Type D	18"	14.16	0.61	10.55

4.2.1 Hydraulic Variance

P403 in Zone 3 has a velocity below 2.5-fps. This pipe has been steepened as far as is advisable to help increase velocity and reduce sedimentation within the pipe. The site limitations including roadway cover and existing ground limit further steepening of this pipe.

4.3 Curb & Gutter

A curb and gutter section will be located in Zone 1 from Space Village Avenue to US-24 to minimize ROW impacts and coordination with the Colorado Springs Utilities SDS pump station site. See Appendix 8 for calculations.

Table 10: Curb & Gutter Design

Curb & Gutter ID	Slope (ft/ft)	5-yr Discharge (cfs)	Gutter Depth (ft)	Spread (ft)	100-yr Discharge (cfs)	Normal Depth (ft)	Velocity (fps)
664R	0.053	4.54	0.27	7.30	9.87	0.33	7.96
662L	0.046	4.79	0.28	7.78	10.41	0.34	9.60
661L	0.027	0.29	0.12	1.47	0.63	0.16	4.09
654R	0.043	6.04	0.30	8.86	13.136	0.37	7.76
646R	0.018	2.63	0.27	7.28	5.7	0.33	4.63
641L	0.005	4.48	0.37	12.54	9.72	0.46	3.14
637R	0.005	2.22	0.30	9.18	4.82	0.38	2.69
632L	0.005	3.96	0.36	11.89	8.61	0.45	3.06
631R	0.005	2.22	0.30	9.18	4.83	0.38	2.69
618R	0.018	4.61	0.31	9.57	10.01	0.39	5.20

4.4 Ditches

Ditches will be used to convey on-site flow for a majority of the project as they do currently. Ditches will be trapezoidal with a 5-foot flat bottom and 3:1 back slopes and 4:1 fore slopes where possible. The ditches break at cross culverts where runoff will follow historic drainage patterns. Ditch design requirements are addressed in Section 2.1 of this report.

Table 11 below summarizes the ditches and their corresponding attributes. Calculations for ditch sizes can be viewed in Appendix 8.



Table 11: Ditch Design

Ditch ID	Range	Channel Slope (ft/ft)	5-yr Discharge (cfs)	Normal Depth (ft)	Velocity (fps)	100-yr Discharge (cfs)	Normal Depth (ft)	Velocity (fps)
ZONE 1								
641L	Sta. 640+00 to 655+00	0.005	14.49	0.78	2.39	33.79	1.21	3.04
632L	Sta. 630+00 to 640+00	0.013	30.82	0.9	4.18	80.68	1.46	5.44
618L *	Sta. 630+00 to 640+00	0.044	4.61	0.23	3.52	77.42	1.06	8.39
608L	Sta. 618+00 to 631+00	0.013	4.61	0.32	2.35	28.19	0.86	4.07
608R	Sta. 608+00 to 618+00	0.013	3.28	0.26	2.1	7.13	0.41	2.7
575L	Sta. 608+00 to 618+00	0.013	29.38	0.88	4.12	85.75	1.51	5.53
563R	Sta. 575+00 to 608+00	0.026	8.45	0.37	3.61	18.44	0.57	4.6
ZONE 2								
553L	Sta. 575+00 to 608+00	0.02	1.01	0.12	1.59	2.2	0.19	2.1
C 575L	Sta. 568+50 to 573+23	0.014	-	-	-	85.75	1.37	12.48
553R	Sta. 553+00 to 559+00	0.02	2.44	0.2	2.18	5.31	0.31	2.84
547R	Sta. 552+00 to 563+00	0.024	1.17	0.12	1.78	2.53	0.19	2.35
534L	Sta. 547+00 to 552+00	0.014	7.09	0.4	2.76	19.8	0.7	3.78
534R	Sta. 533+50 to 542+00	0.019	1.38	0.14	1.75	3.01	0.23	2.31
498L	Sta. 533+50 to 550+00	0.018	2.96	0.23	2.25	6.43	0.35	2.92
485L	Sta. 498+50 to 534+00	0.033	1.38	0.12	2.09	3.01	0.19	2.76
484R	Sta. 484+00 to 491+00	0.019	4.61	0.29	2.66	10.06	0.45	3.43
480L	Sta. 480+00 to 484+00	0.007	0.68	0.13	0.99	1.48	0.2	1.3
470R	Sta. 484+00 to 534+00	0.025	2.73	0.2	2.44	5.93	0.31	3.17
470L	Sta. 470+00 to 484+00	0.025	0.97	0.11	1.68	2.11	0.17	2.23
448L	Sta. 469+00 to 474+00	0.021	47.35	1	5.6	5.01	0.29	2.83
448R	Sta. 448+00 to 455+00	0.021	2.3	0.19	2.17	5.01	0.29	2.83
438R	Sta. 447+60 to 469+00	0.019	2.68	0.21	2.22	5.83	0.33	2.88
422R	Sta. 438+00 to 448+00	0.012	0.81	0.12	1.25	1.77	0.19	1.65
405L	Sta. 422+00 to 430+00	0.023	5.59	0.3	3.02	12.15	0.47	3.88
403L	Sta. 404+00 to 444+00	0.02	1.51	0.15	1.84	3.28	0.23	2.42
403R	Sta. 398+60 to 403+00	0.02	0.81	0.1	1.47	1.77	0.16	1.95
394L	Sta. 398+60 to 404+00	0.013	0.77	0.11	1.26	1.67	0.18	1.66
377L	Sta. 394+20 to 398+60	0.017	1.98	0.18	1.92	4.3	0.29	2.51
376R	Sta. 376+40 to 381+00	0.031	5.79	0.29	3.38	14.42	0.48	4.54
ZONE 3								
A 256L	Sta 256+30 to 264+29	0.009	2.46	0.25	1.68	6.97	0.25	2.36
A 256R	Sta 256+30 to 264+30	0.009	2.46	0.25	1.68	6.97	0.25	2.36
A 247L	Sta. 246+00 to 256+30	0.019	2.41	0.51	2.67	6.83	0.51	3.46
A 246R	Sta. 246+00 to 256+30	0.019	2.54	0.52	2.7	7.19	0.52	3.5
A 226L *	Sta. 226+00 to 246+00	0.023	19.69	0.61	4.49	72.59	0.61	6.51
A 229R	Sta. 229+00 to 232+00	0.0095	0.99	0.14	1.25	2.81	0.14	1.79
A 210L *	Sta. 210+60 to 226+00	0.0258	25.06	0.65	4.82	92.09	0.65	6.89
A 212R	Sta. 212+00 to 229+00	0.0083	2.65	0.27	1.68	7.48	0.27	2.35
A 208R	Sta. 207+60 to 212+00	0.01	1.33	0.17	1.41	3.77	0.17	2.01
A 206L	Sta. 205+00 to 212+00	0.01	1.99	0.21	1.62	5.63	0.21	2.29
A 178L	Sta. 179+00 to 205+00	0.012	23.38	0.8	3.75	87.06	0.8	5.39
A 178R**	Sta. 200+00 to 205+00					12.81	1.35	3.53
A 178R	Sta. 178+00 to 207+00	0.01	4.51	0.34	2.13	12.81	0.34	2.95
A 152L	Sta. 152+00 to 178+00	0.0053	3.05	0.33	1.52	8.68	0.33	2.1
A 152R	Sta. 152+00 to 178+00	0.0052	3.1	0.33	1.51	8.82	0.33	2.1
ZONE 4								
A 125R	Sta. 124+50 to 137+50	0.01	2.06	0.22	1.64	5.82	0.22	2.31
A 103L**	Sta 130+00 to 140+00	0.0075				13.47	1.45	3.21
A 103L	Sta. 103+00 to 148+00	0.088	4.69	0.36	2.07	13.47	0.36	2.86
A 130L**	Sta 103+00 to 148+00	0.01				129.7	1.88	12.6
A 92L	Sta. 92+00 to 103+00	0.0073	1.01	0.16	1.15	2.85	0.16	1.65



Ditch ID	Range	Channel Slope (ft/ft)	5-yr Discharge (cfs)	Normal Depth (ft)	Velocity (fps)	100-yr Discharge (cfs)	Normal Depth (ft)	Velocity (fps)
A 92R	Sta. 92+00 to 103+00	0.0071	1.09	0.17	1.17	3.07	0.17	1.68

* Turf Reinforcement matt required due to high velocities.

** Ditch Section is triangular.

There is one concrete lined ditch located in Zone 2 of the project downstream of the culvert at the Peterson Air Force Base. This ditch is rectangular with a 5-foot bottom width and a depth of 1.5 feet. This was done to accommodate ROW limitation in the area and to receive the high velocities from CV575. The minimum ditch slope was used to compute capacity. See C 575L for design information.

There is also a concrete lined ditch at the south end of Zone 3 at Station 130+00 Left. The ditch has been narrowed significantly at this location for a turning lane at the future Mesa Ridge Parkway, and a utility access road.

4.2.1 Ditch Variance

Ditches 618L, 226L, and 210L shall be protected with turf reinforcement due to higher velocities for the 100-YR flow.

Utility impacts caused a set of ditch modifications that included a set of bumpouts for access to the utility manholes along the a few sections of the corridor. These bulbouts block the roadside ditch and 24-inch RCPs. These culverts do not have to convey the full 100-year event, but may overtop the bumpouts during large events.

4.5 Detention


There are two extended detention basins on the project that provide detention in addition to water quality treatment. Pond 630 provides detention to the capacity of the existing 42" CMP that crosses SH-94. Pond 380 provides detention to the capacity of the existing 24" CMP that crosses Drennan on the east side of Marksheffel. See the Water Quality section for further discussion and Appendix 11 for Extended Detention Basin calculations. Table 12 provides the detention design results for these ponds.

Table 12: Detention Design


Pond ID	10-year			100-year		
	Q _{in} (cfs)	Q _{out} (cfs)	Storage Volume (ac-ft)	Q _{in} (cfs)	Q _{out} (cfs)	Storage Volume (ac-ft)
Pond 380	9.14	6.81	0.23	27.11	6.81	1.56
Pond 630	-	-	-	90.41	77.05	0.88

5.0 WATER QUALITY

This section outlines the Treatment BMPs used to fulfill the MS4 Permit requirements on the project. Sand Filters and Extended Detention Ponds were used to provide WQCV on the project. These are approved Treatment BMP's as outlined in the El Paso County and City of Colorado Spring Drainage Design Manual which references Urban Drainage and Flood Control District Criteria.

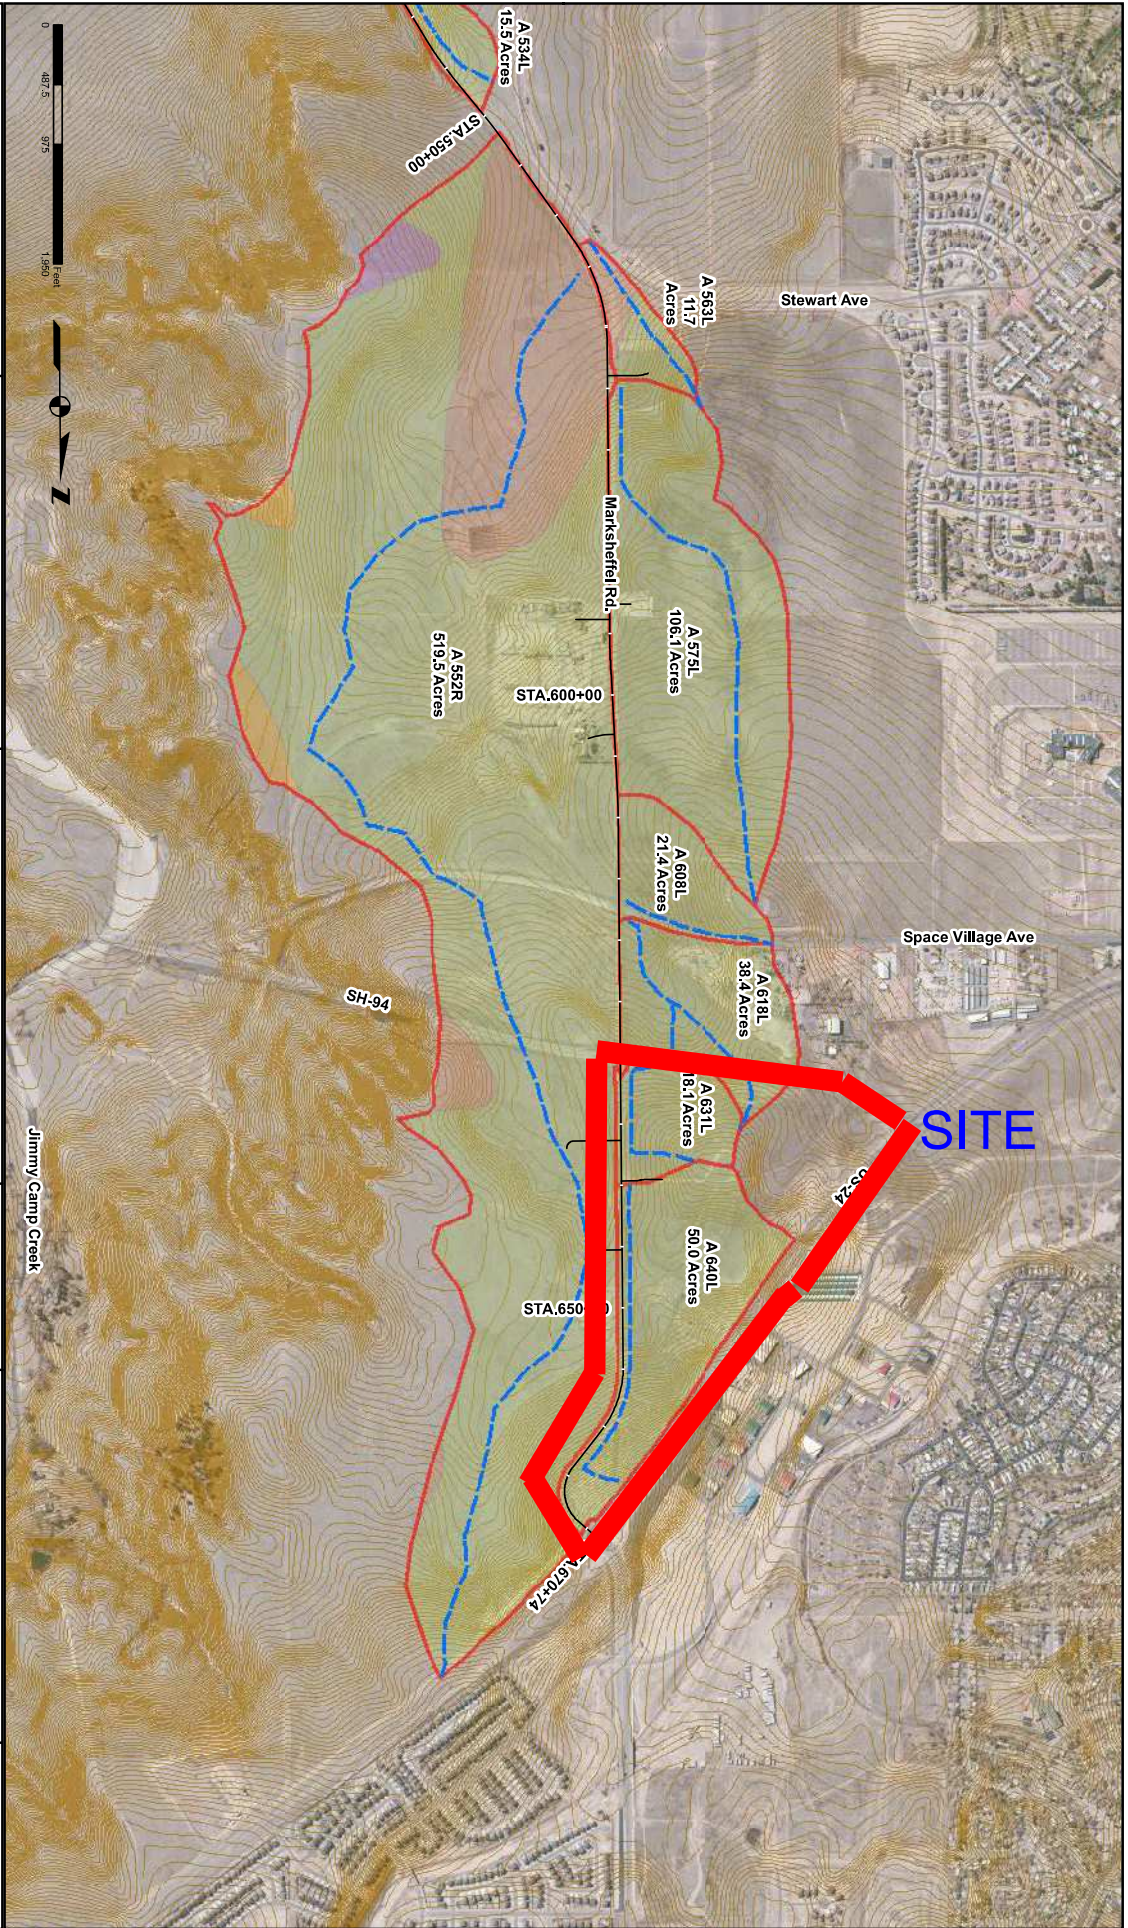

Print Date: 10/23/2014 File Name: Basins_BI_20141009.mxd Horiz. Scale: None Vert. Scale: None Unit Information: Unit Leader Initials		Scale: 0, 487.5, 975, 1,950 Feet North Arrow	
Legend: Basin Boundary (Red outline) Elevation (Blue dashed line) Water (Blue area) Hydrologic Soil Group A (Light Green) Hydrologic Soil Group B (Light Brown) Hydrologic Soil Group C (Light Purple) Hydrologic Soil Group D (Light Yellow)		Logos: EL PASO COUNTY CORRADO PPRITA	
As Constructed No Revisions: Revised: Void:		MARKSHEFFEL ROAD DRAINAGE BASIN Designer: E. Stalen Detailer: M. Johnson Sheet Subset: BASIN Subsets: Structures Subsets: Structures 3 of 3	
Project No./Code		Sheet Number: 3	

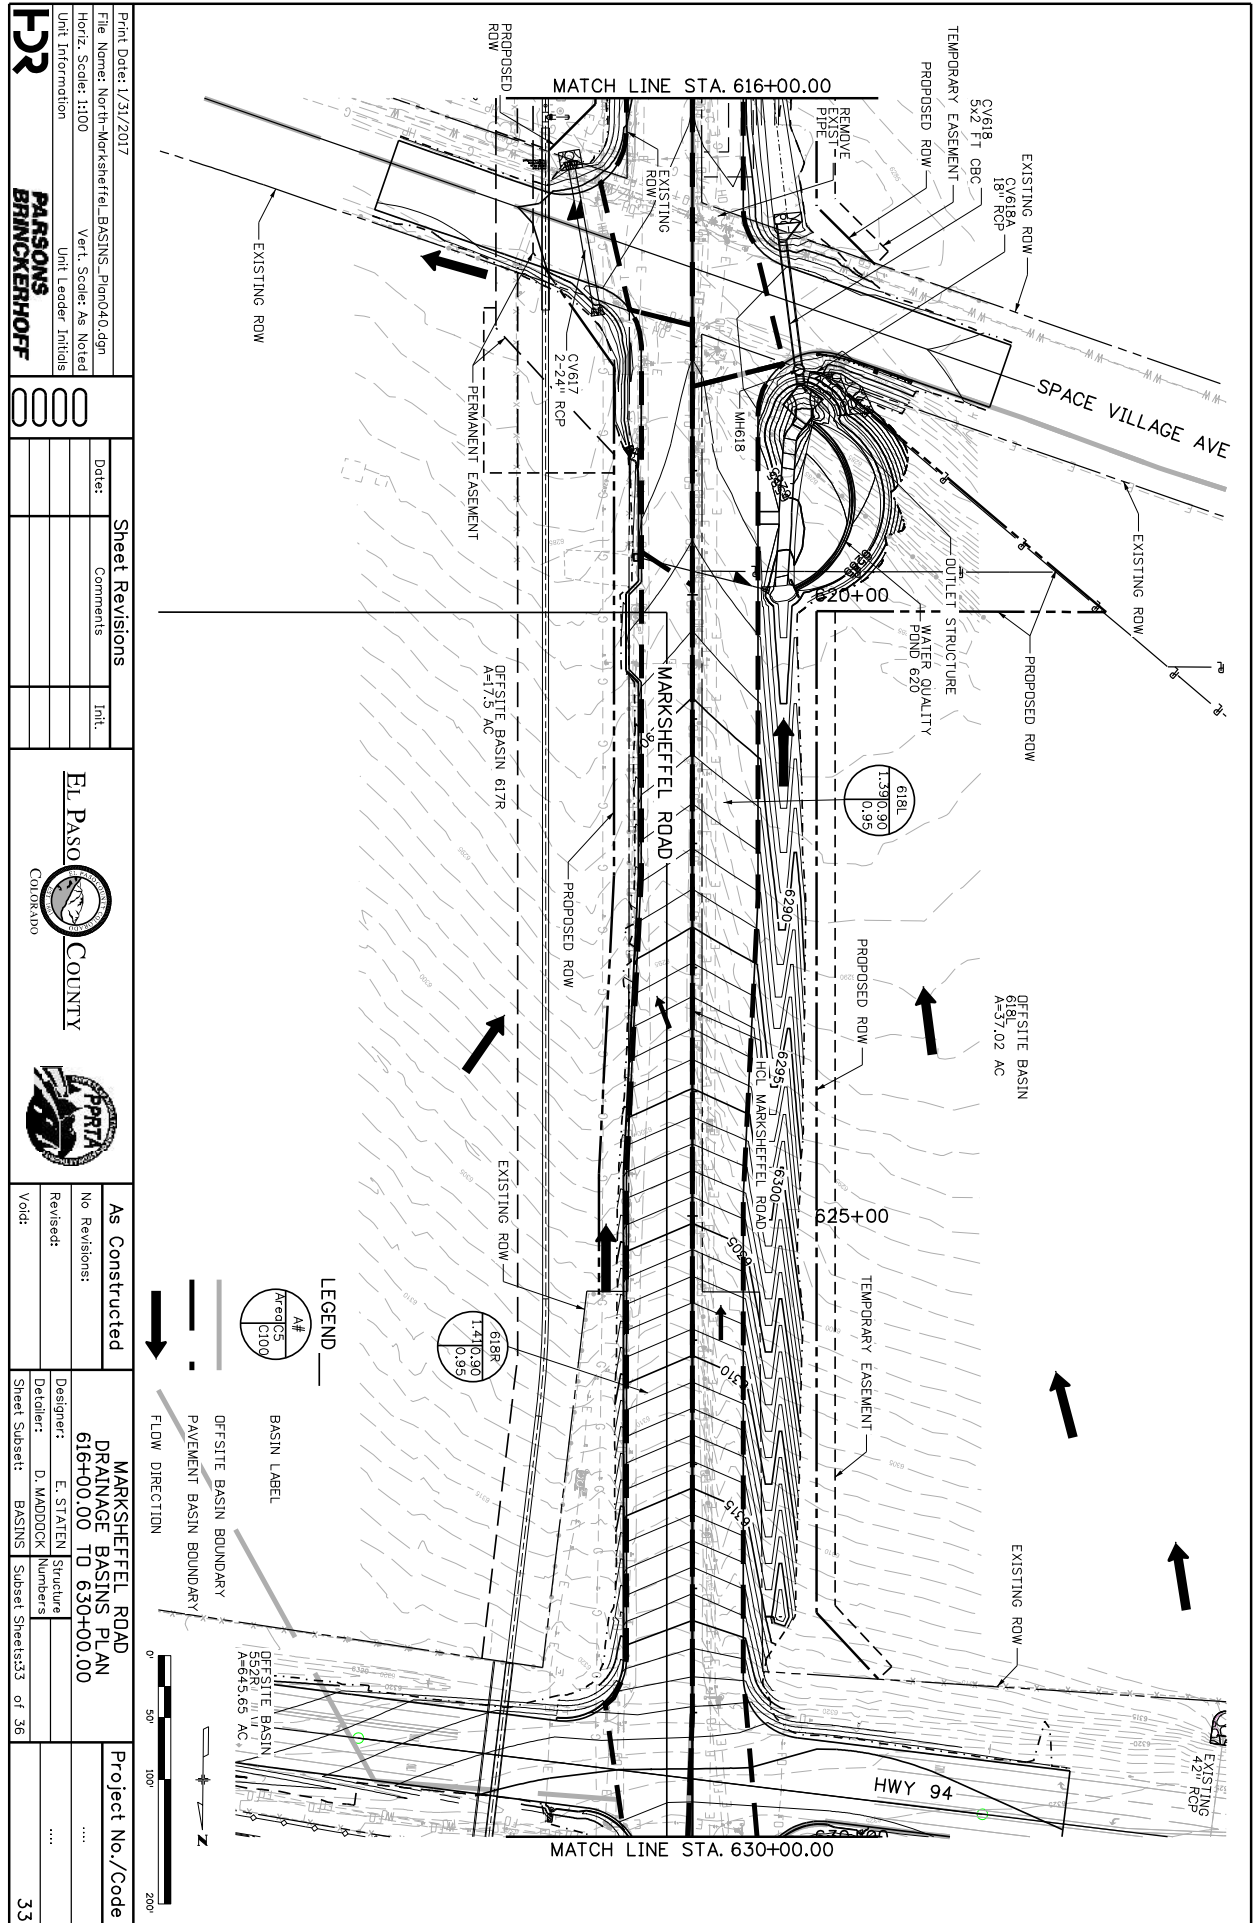

Print Date: 1/31/2017
 File Name: North-Marksheffel_BASINS_Plan040.dgn
 Horiz. Scale: 1:100
 Unit Information: Unit Leader Initials
HDR
PARSONS BRINCKERHOFF

Sheet Revisions	
Date:	Comments


EL PASO COUNTY
 COLORADO




As Constructed	
No Revisions:	
Revised:	
Void:	

MARKSHEFFEL ROAD DRAINAGE BASINS PLAN
 616+00.00 TO 630+00.00
 Designer: E. STATEN
 Detailer: D. MADDOCK
 Sheet Subject: BASINS
 Subsect Sheets: 33 of 36

Project No./Code
 33

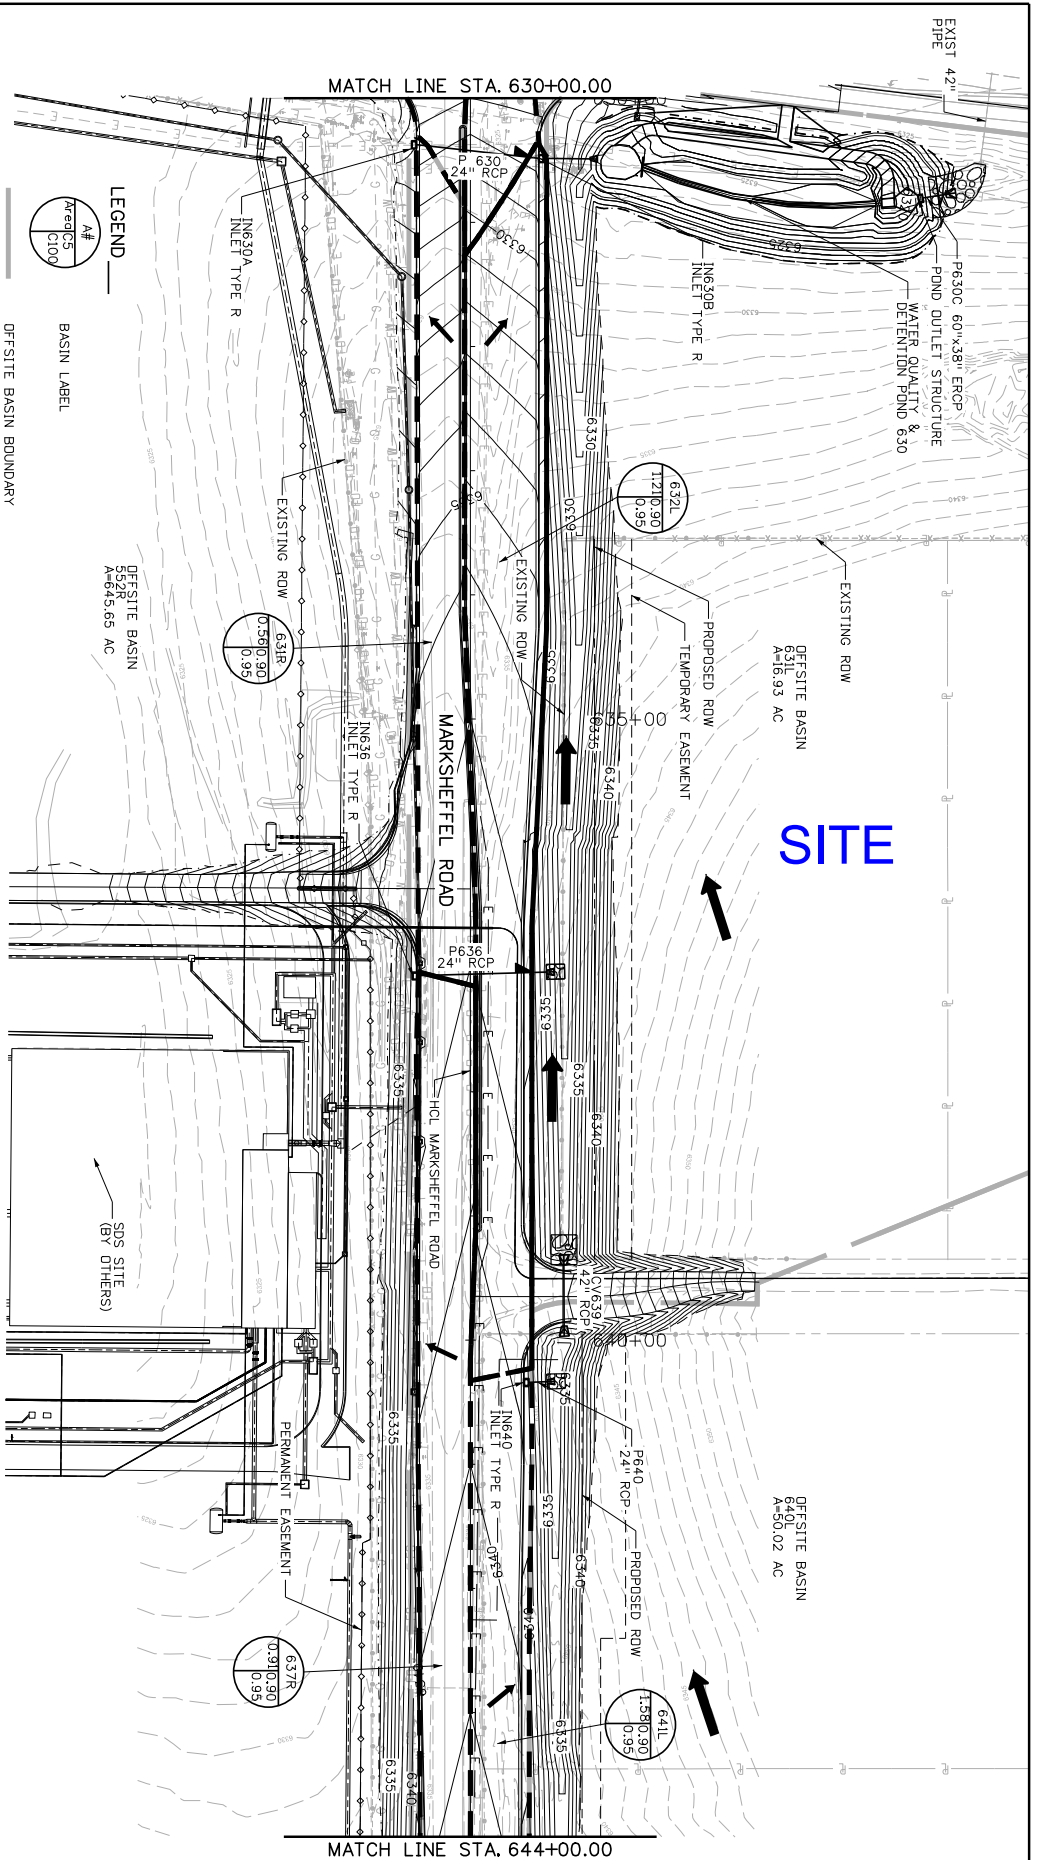

Print Date: 12/8/2016		Sheet Revisions	
File Name: North-Marksheffel_BASINS_Plan041.dgn	Date:	Comments	Int:
Horiz. Scale: 1:100	Vert. Scale: As Noted		
Unit Information	Unit Leader Initials		
HDR	PARSONS BRINCKERHOFF		
EL PASO COUNTY COLORADO		As Constructed	
No Revisions:		DRAINAGE BASINS PLAN	
Revised:		630+00.00 TO 644+00.00	
Void:		MARKSHEFFEL ROAD	
Designer: E. STATEN		Structure Numbers	
Detailer: D. MADDOCK		Sheet Subsets: BASINS	
Sheet Subsets: BASINS		Subset Sheets: 34 of 36	
Project No./Code		34	

Print Date: 12/8/2016
 File Name: North-Marksheffel_BASINS_Plan043.dgn
 Horiz. Scale: 1:100
 Unit Information: Unit Leader Initials
PARSONS BRINCKERHOFF

Sheet Revisions	
Date:	Comments


EL PASO COUNTY
 COLORADO



As Constructed	No Revisions:

MARKSHEFFEL ROAD DRAINAGE BASINS PLAN
 658+00.00 TO 670+73.68
 Designer: E. STATEN
 Checker: D. MADDOCK
 Sheet Subsets: BASINS Subsets: 36 of 36

Project No./Code
 36

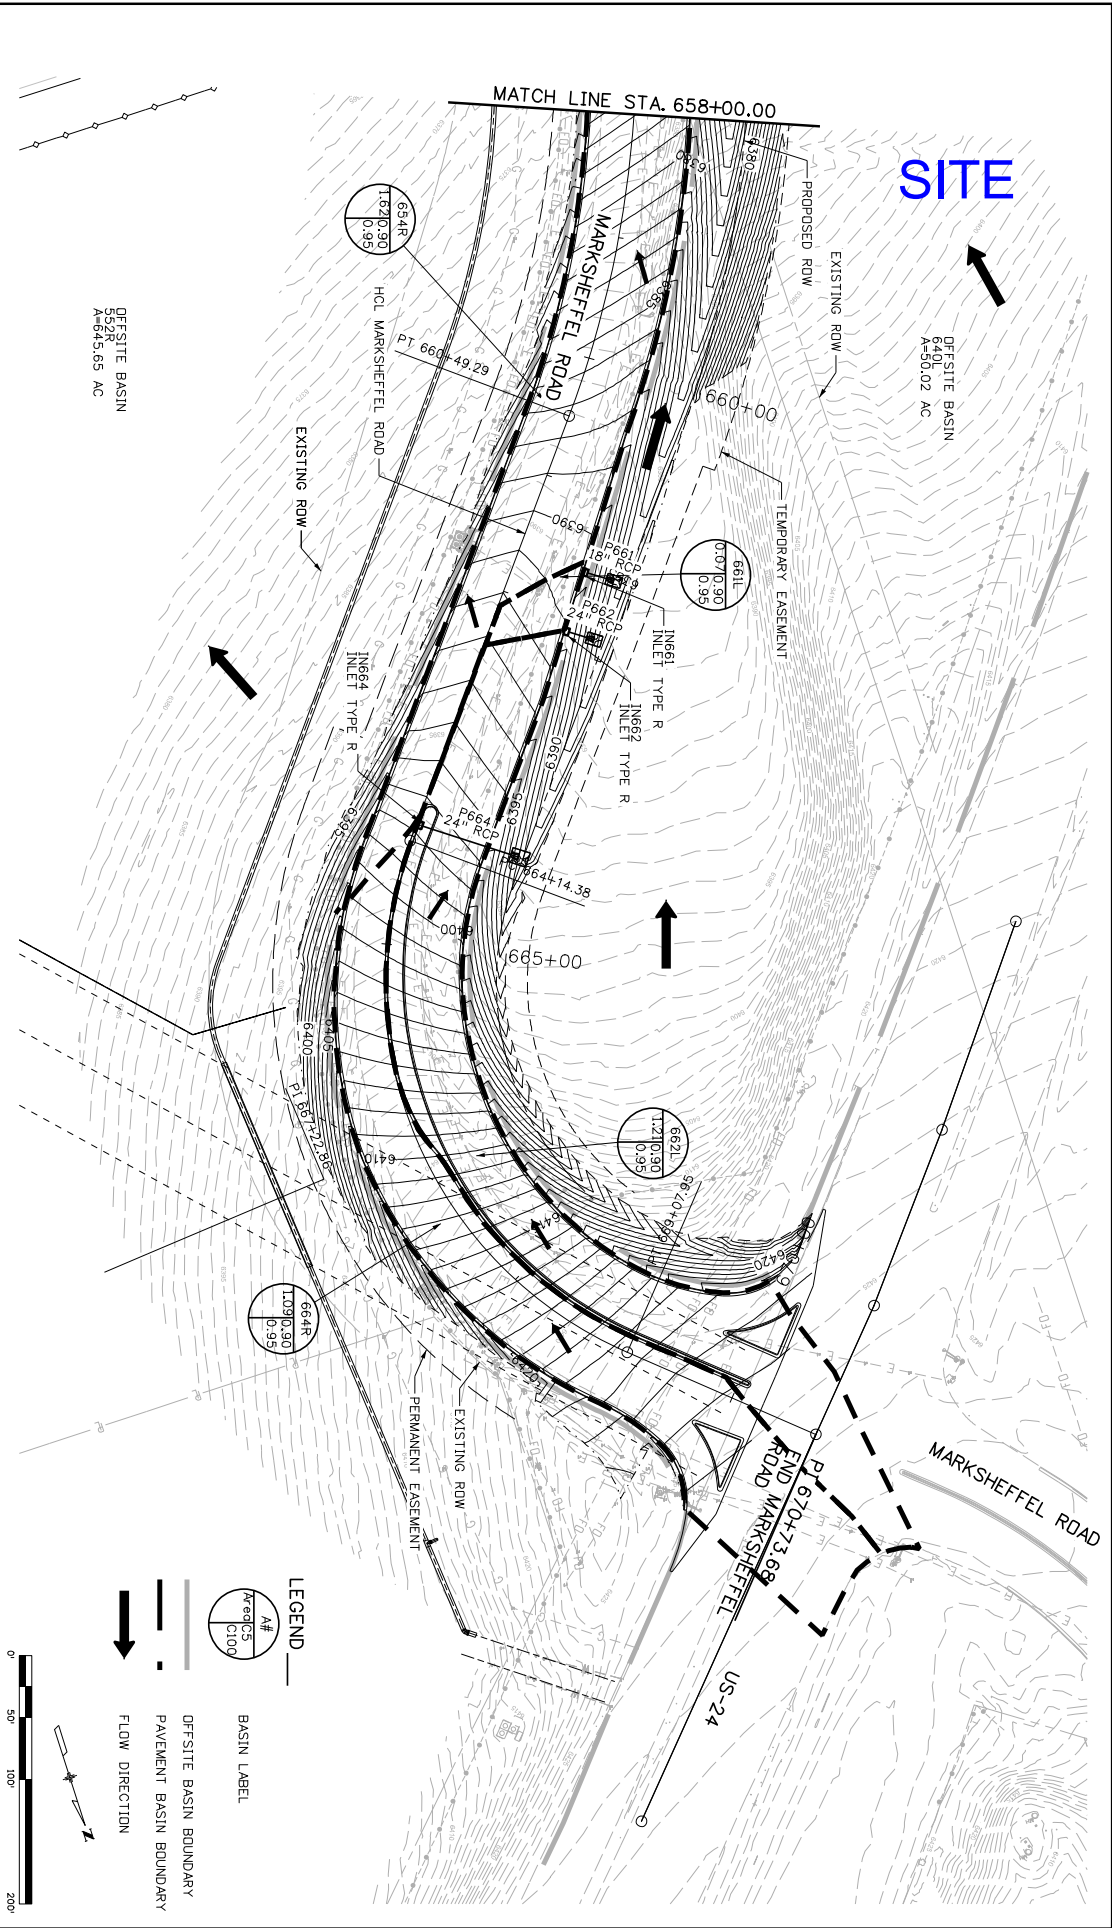

JIMMY CAMP CREEK DRAINAGE REPORT EXCERPTS

Jimmy Camp Creek

Drainage Basin Planning Study Development of Alternatives & Design of Selected Plan Report

Prepared for:


City of Colorado Springs

Prepared by:


Kiowa
Engineering Corporation

1604 South 21st Street
Colorado Springs, Colorado 80904
(719) 630-7342



March 9, 2015

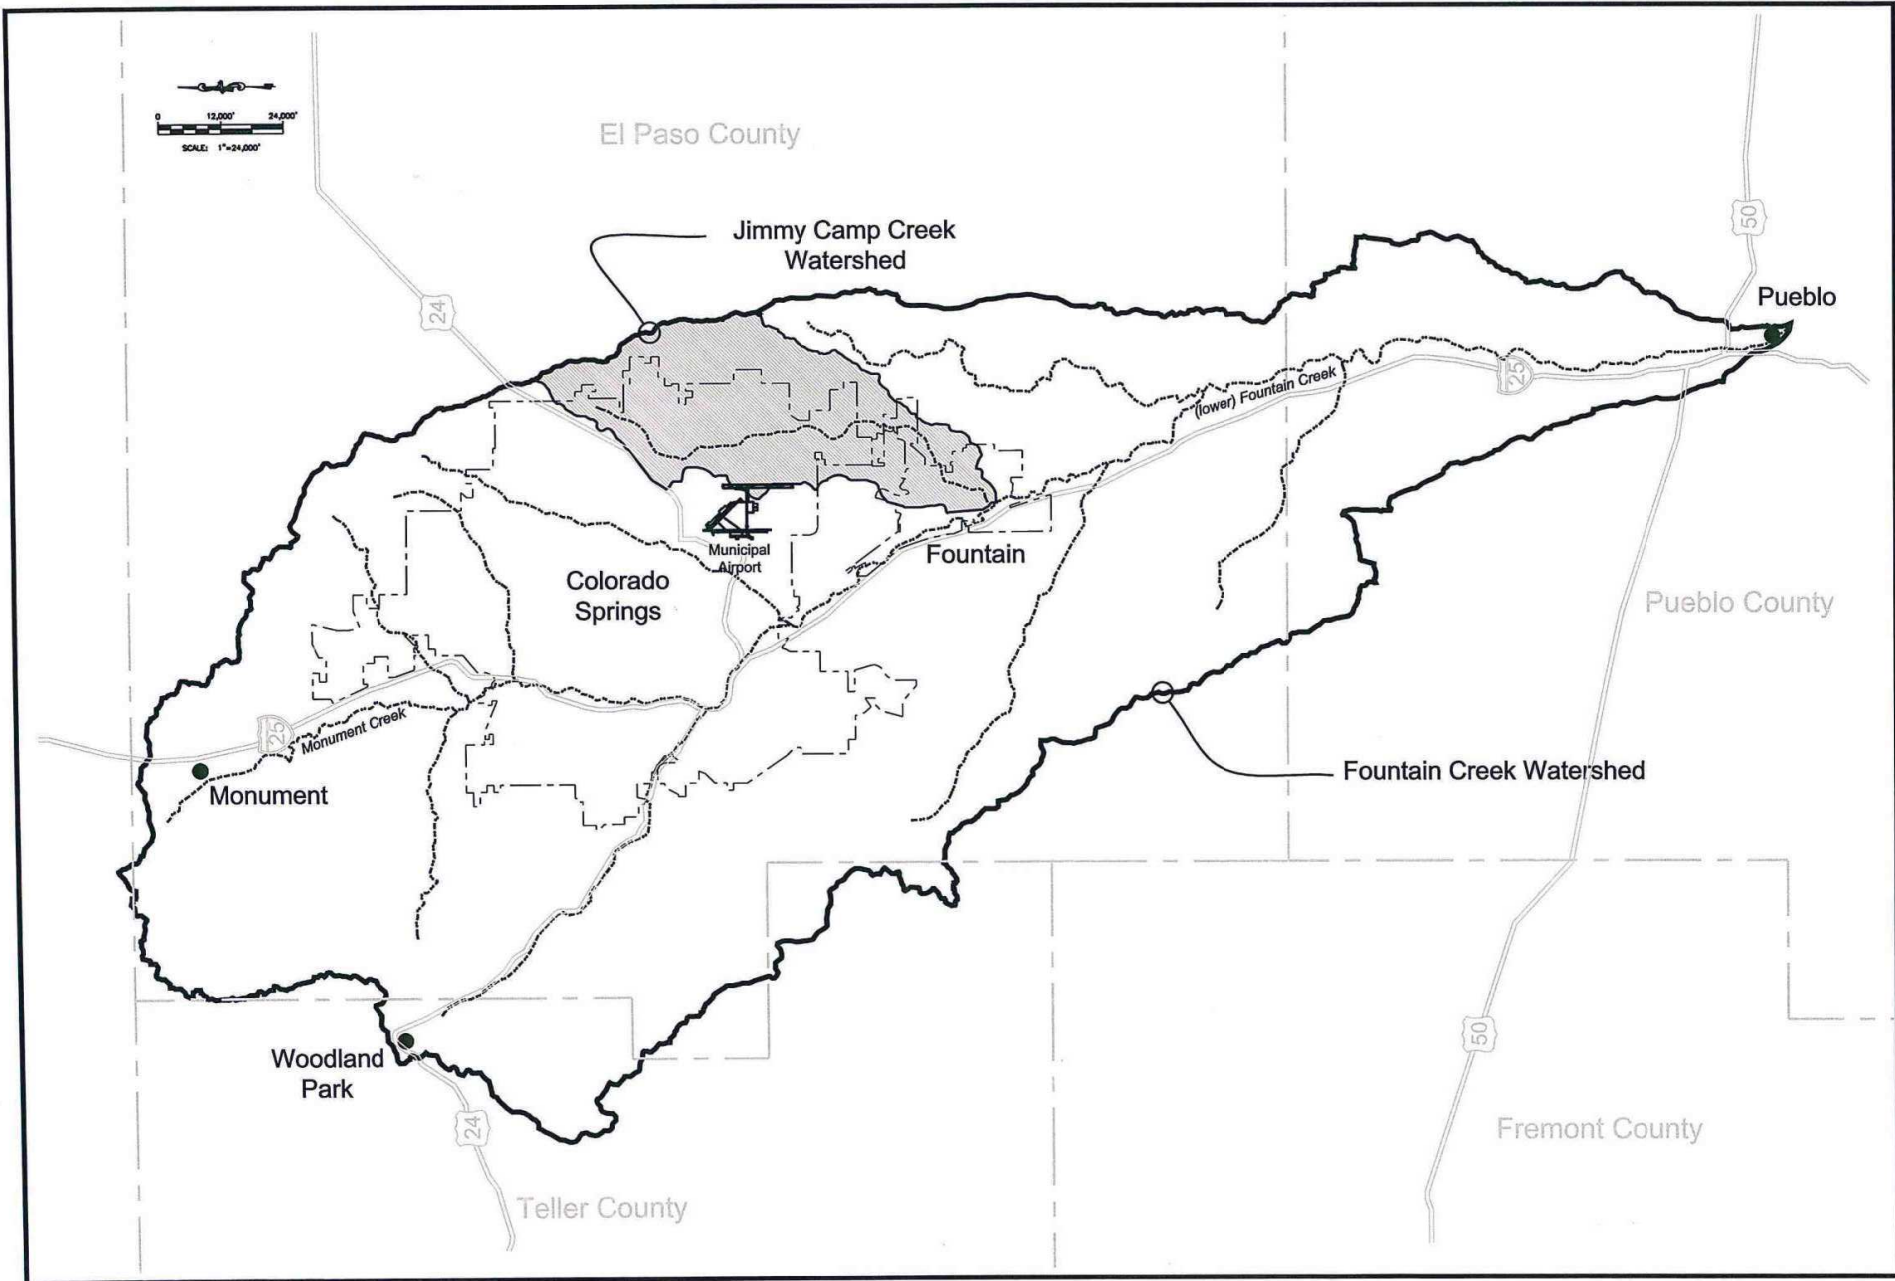

Project No.:	14008
Date:	OCT 2014
Design:	
Drawn:	BJW
Check:	
Revisions:	

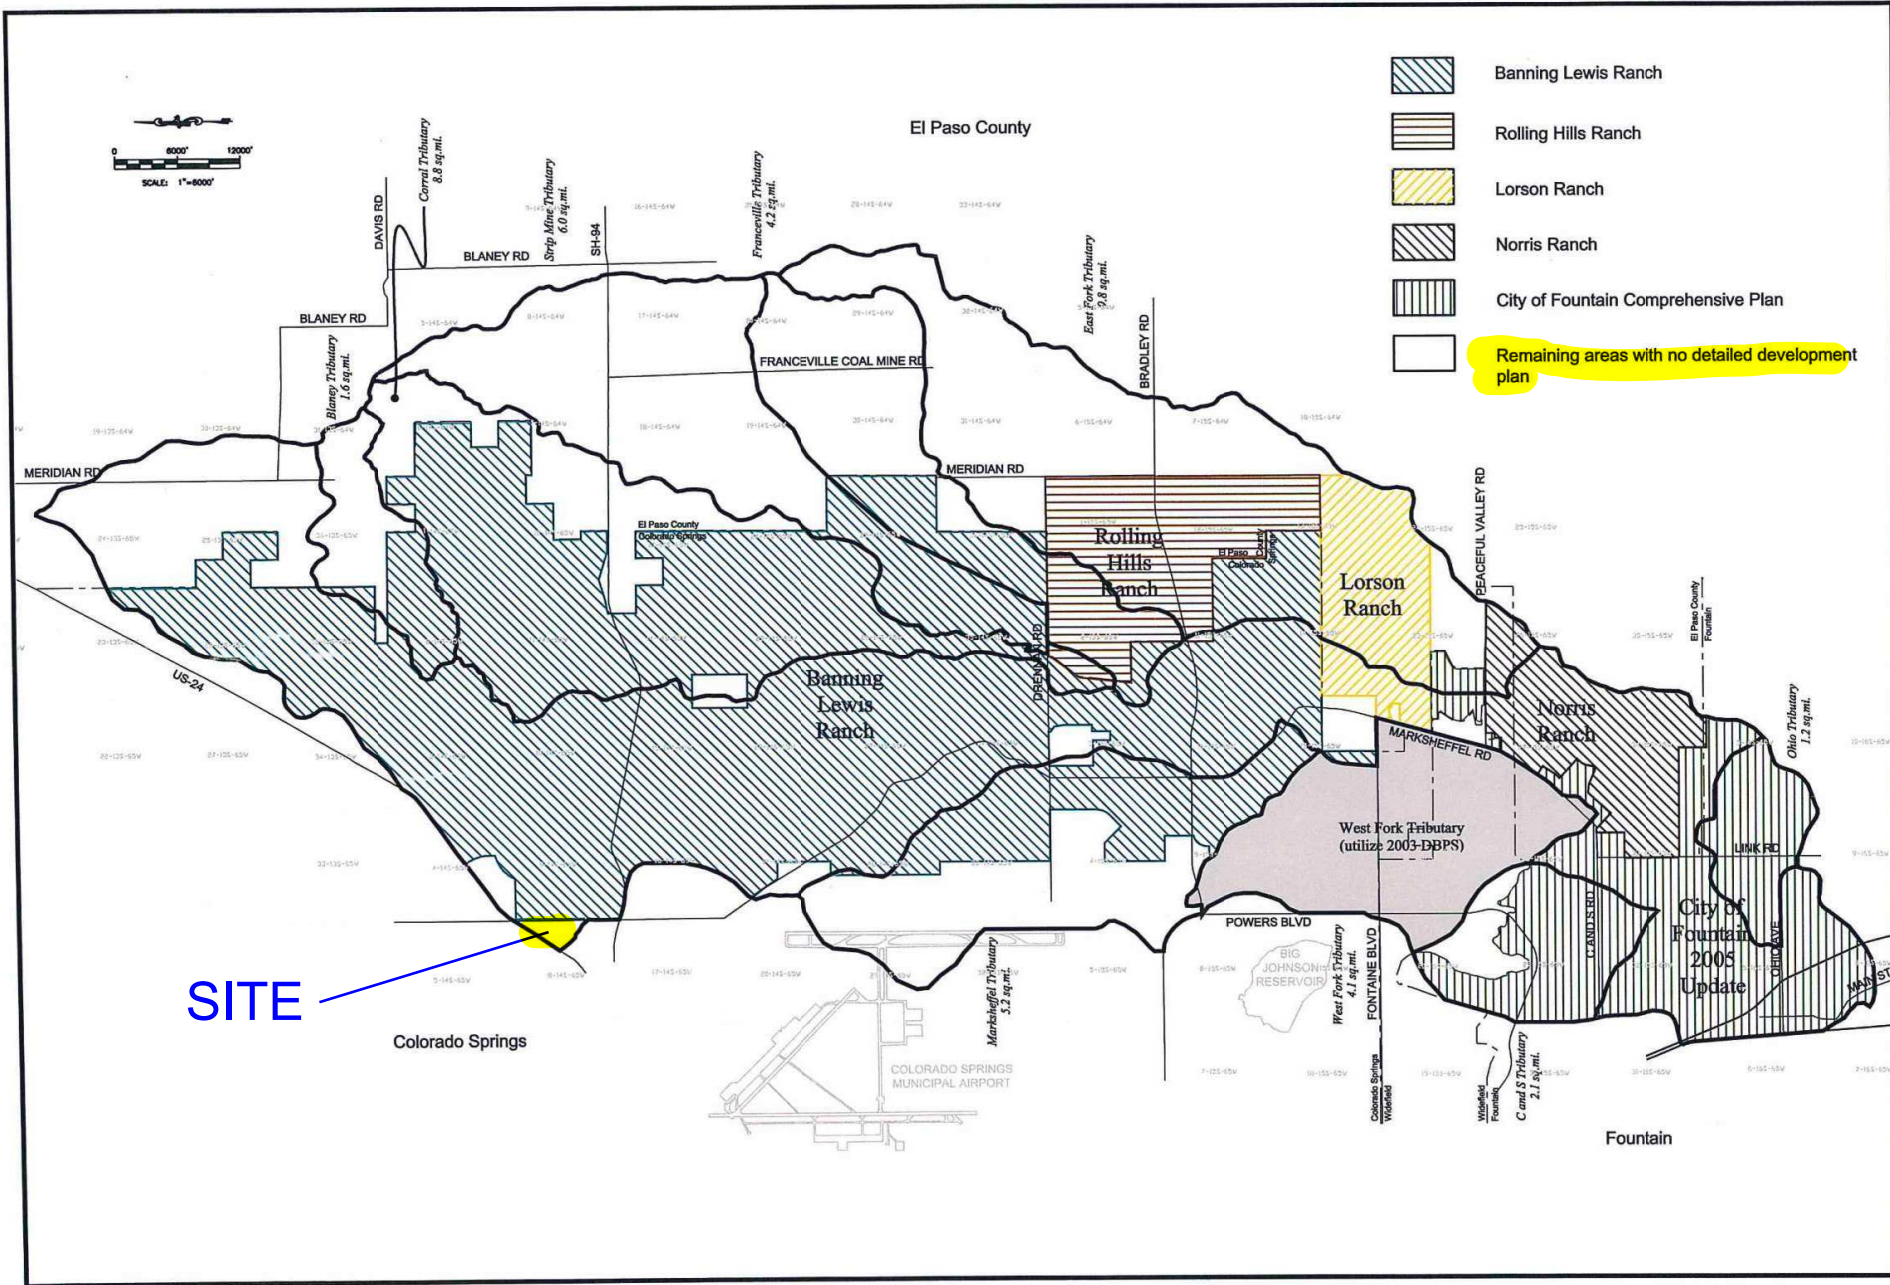

Project No.:	14008
Date:	OCT 2014
Design:	
Drawn:	BJW
Check:	
Revisions:	

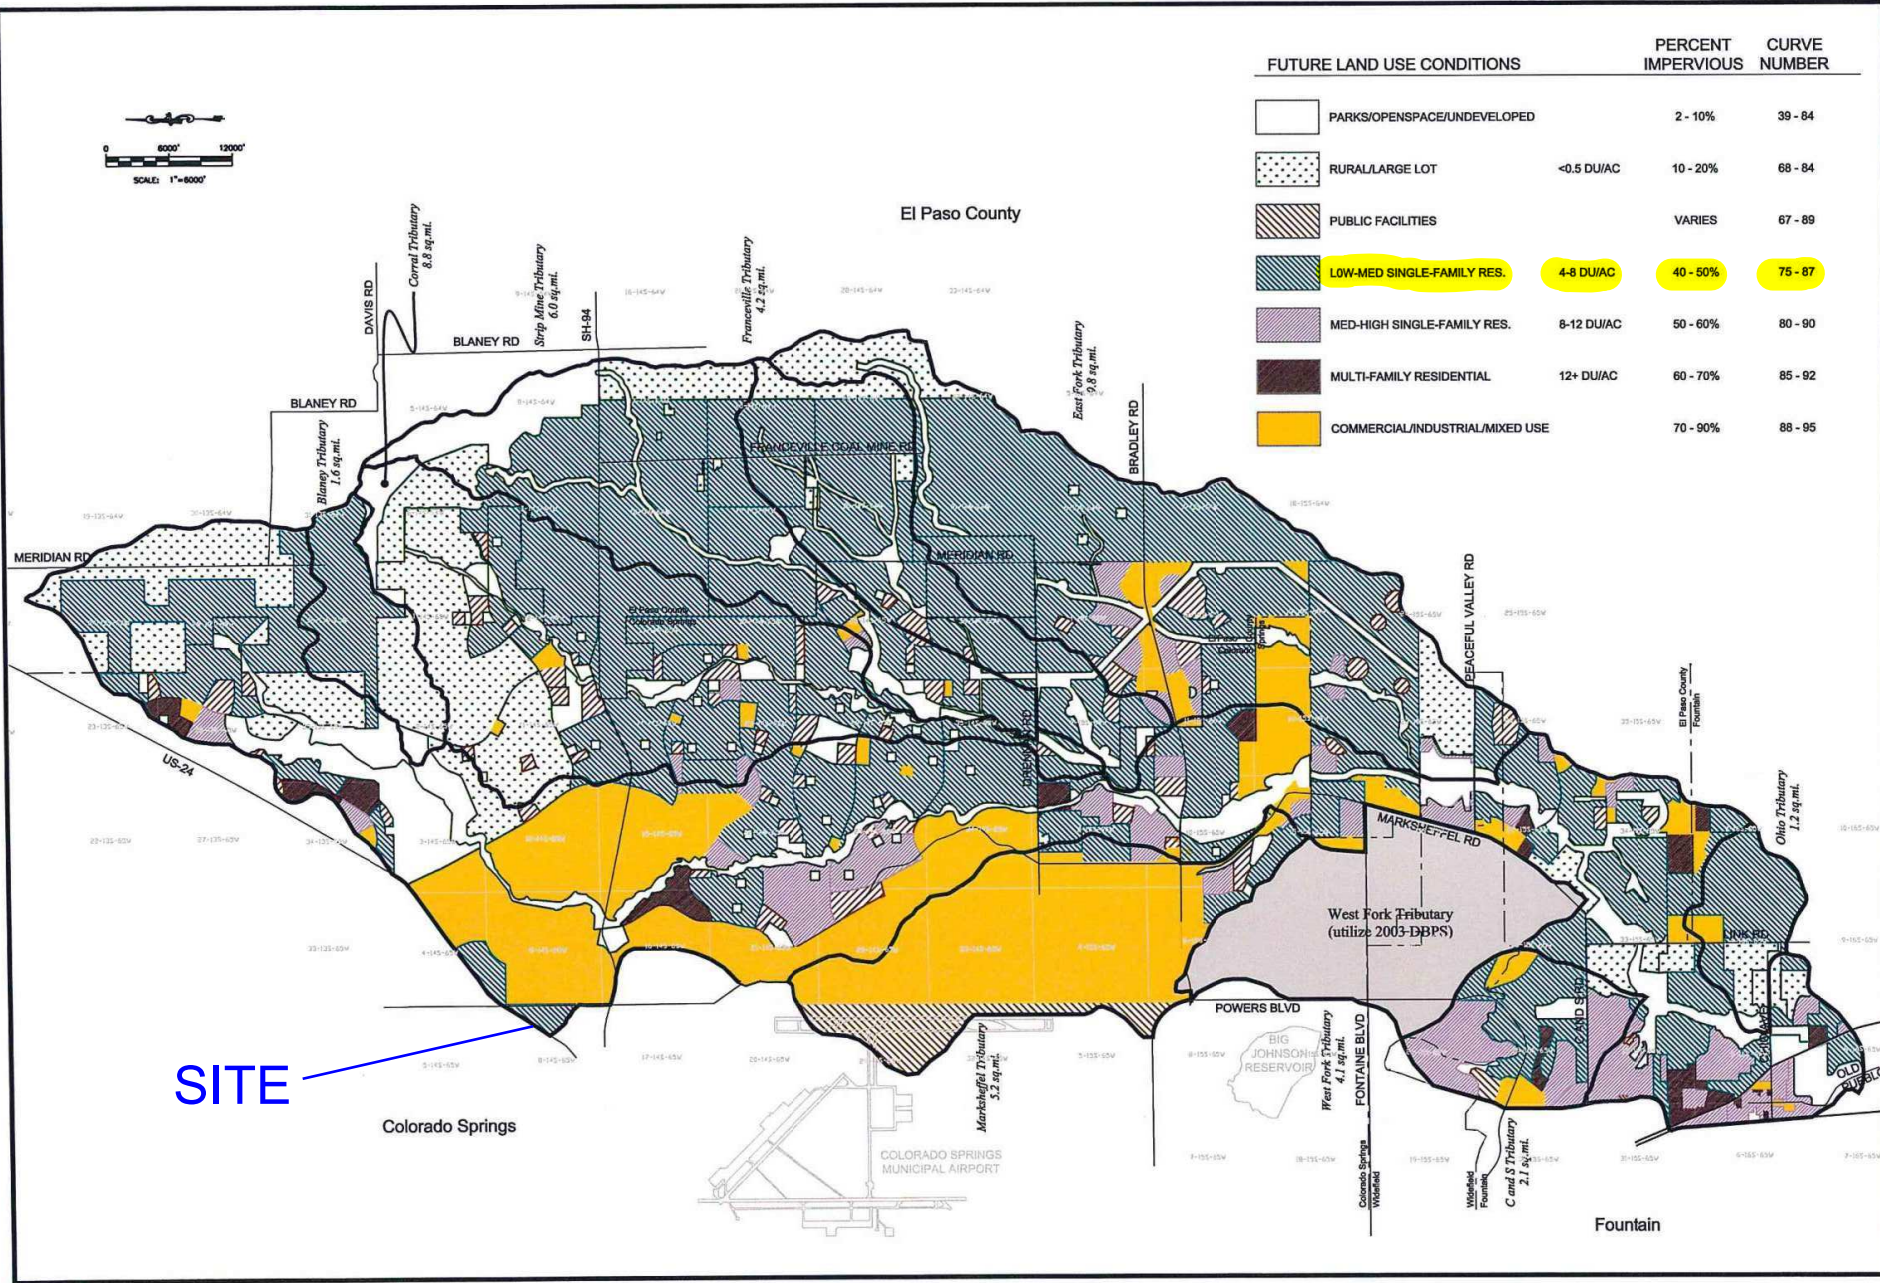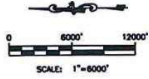



FUTURE LAND USE CONDITIONS		PERCENT IMPERVIOUS	CURVE NUMBER
	PARKS/OPENSACE/UNDEVELOPED	2 - 10%	39 - 84
	RURAL/LARGE LOT	<0.5 DU/AC	10 - 20%
	PUBLIC FACILITIES	VARIES	67 - 89
	LOW-MED SINGLE-FAMILY RES.	4-8 DU/AC	40 - 50%
	MED-HIGH SINGLE-FAMILY RES.	8-12 DU/AC	50 - 60%
	MULTI-FAMILY RESIDENTIAL	12+ DU/AC	60 - 70%
	COMMERCIAL/INDUSTRIAL/MIXED USE	70 - 90%	88 - 95

El Paso County

SITE → Colorado Springs

**JIMMY CAMP CREEK WATERSHED
DRAINAGE BASIN PLANNING STUDY
FUTURE CONDITIONS LAND USE MAP
CITY OF COLORADO SPRINGS**

Project No.: 1408
Date: OCT 2014
Design: B/W
Drawn: B/W
Check: B/W
Revisions:

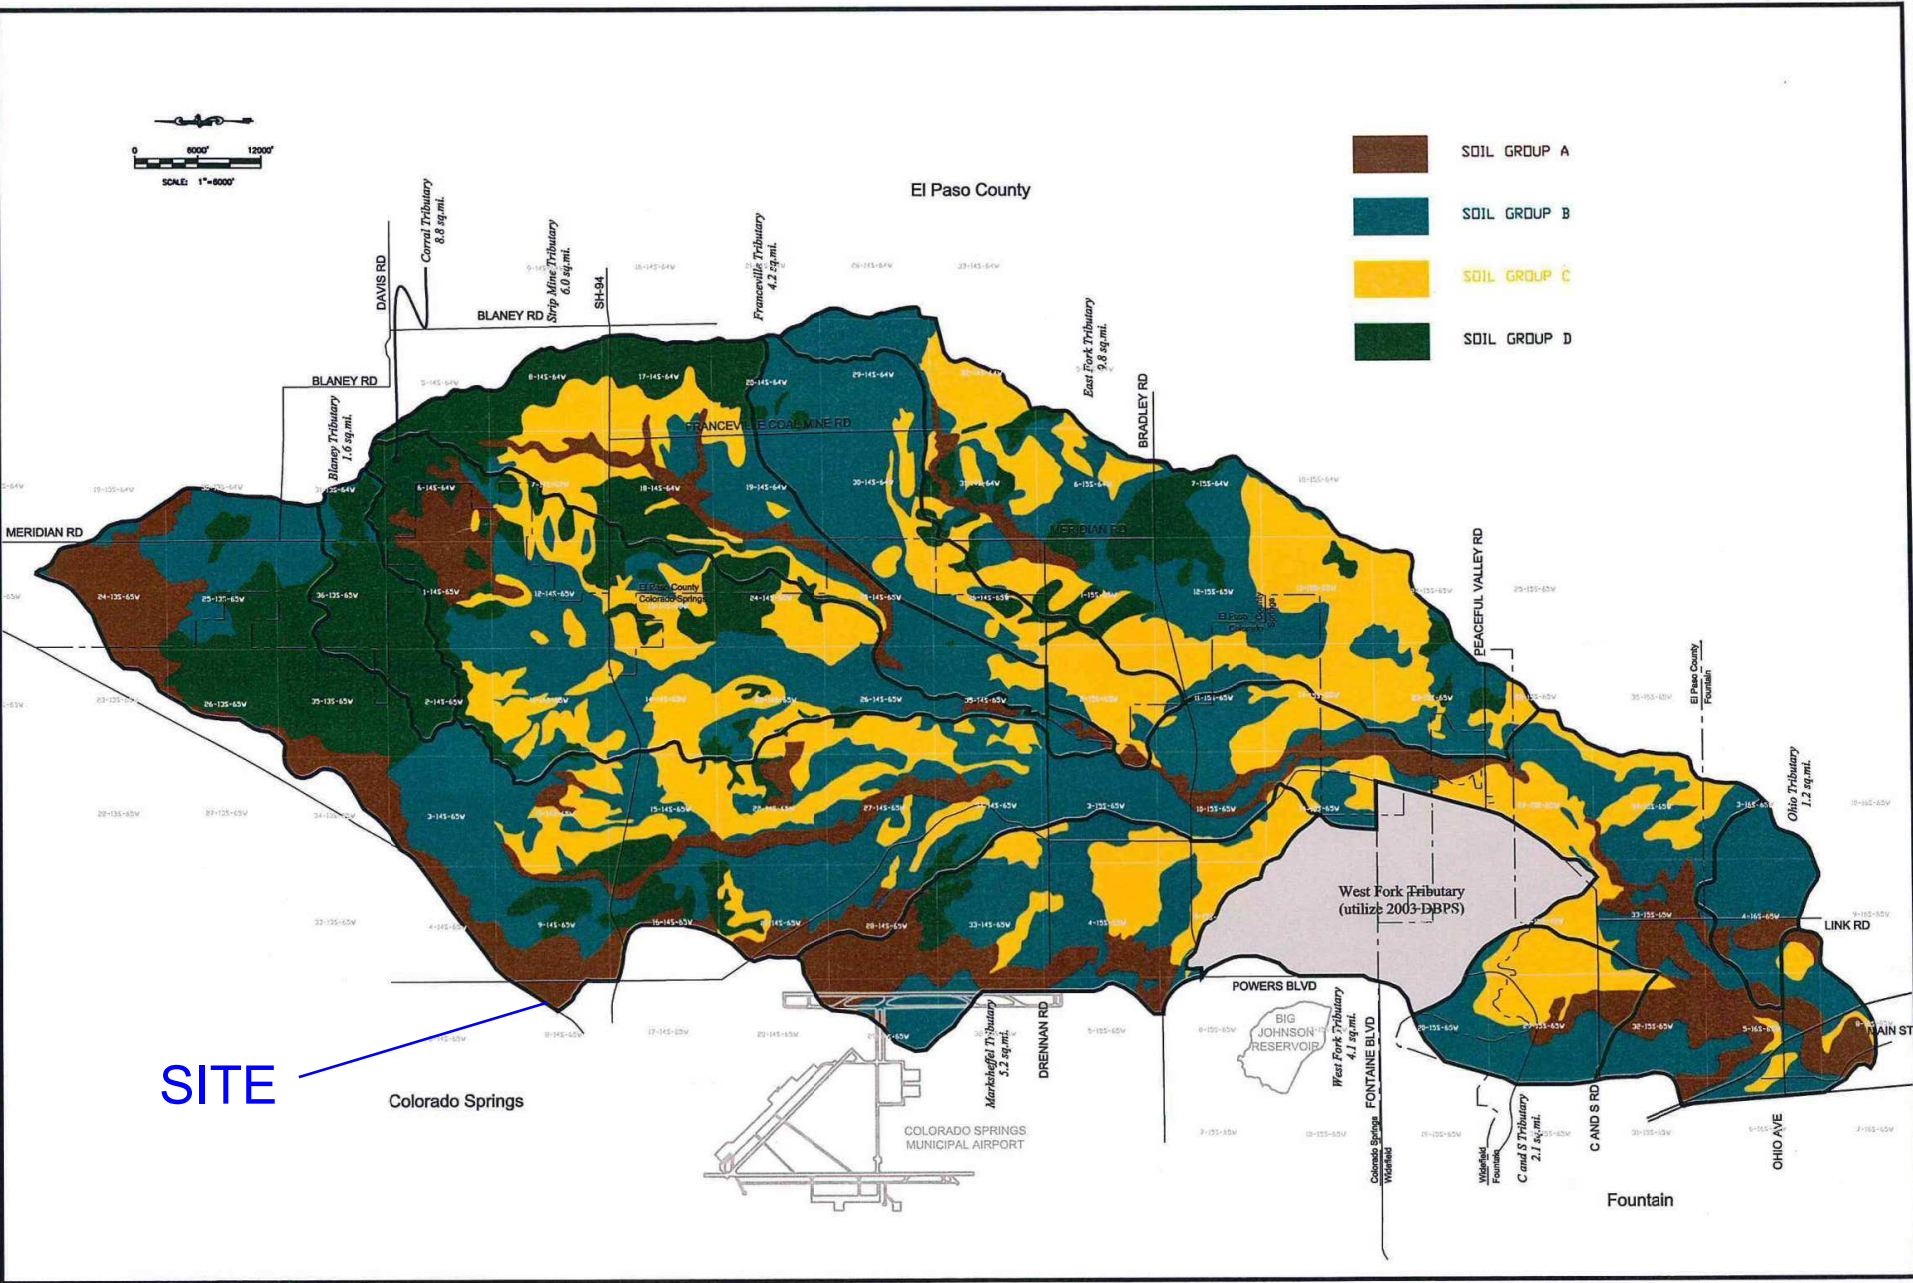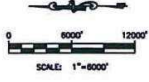


- SOIL GROUP A
- SOIL GROUP B
- SOIL GROUP C
- SOIL GROUP D

Kiowa
 Engineering Corporation
 1604 South 2nd West Street
 Colorado Springs, CO 80904
 (719) 520-7342

**JIMMY CAMP CREEK WATERSHED
 DRAINAGE BASIN PLANNING STUDY
 SOILS MAP
 CITY COLORADO SPRINGS**

Project No.:	14008
Date:	OCT 2014
Design:	BJW
Drawing:	A/E
Check:	BJW
Revisions:	

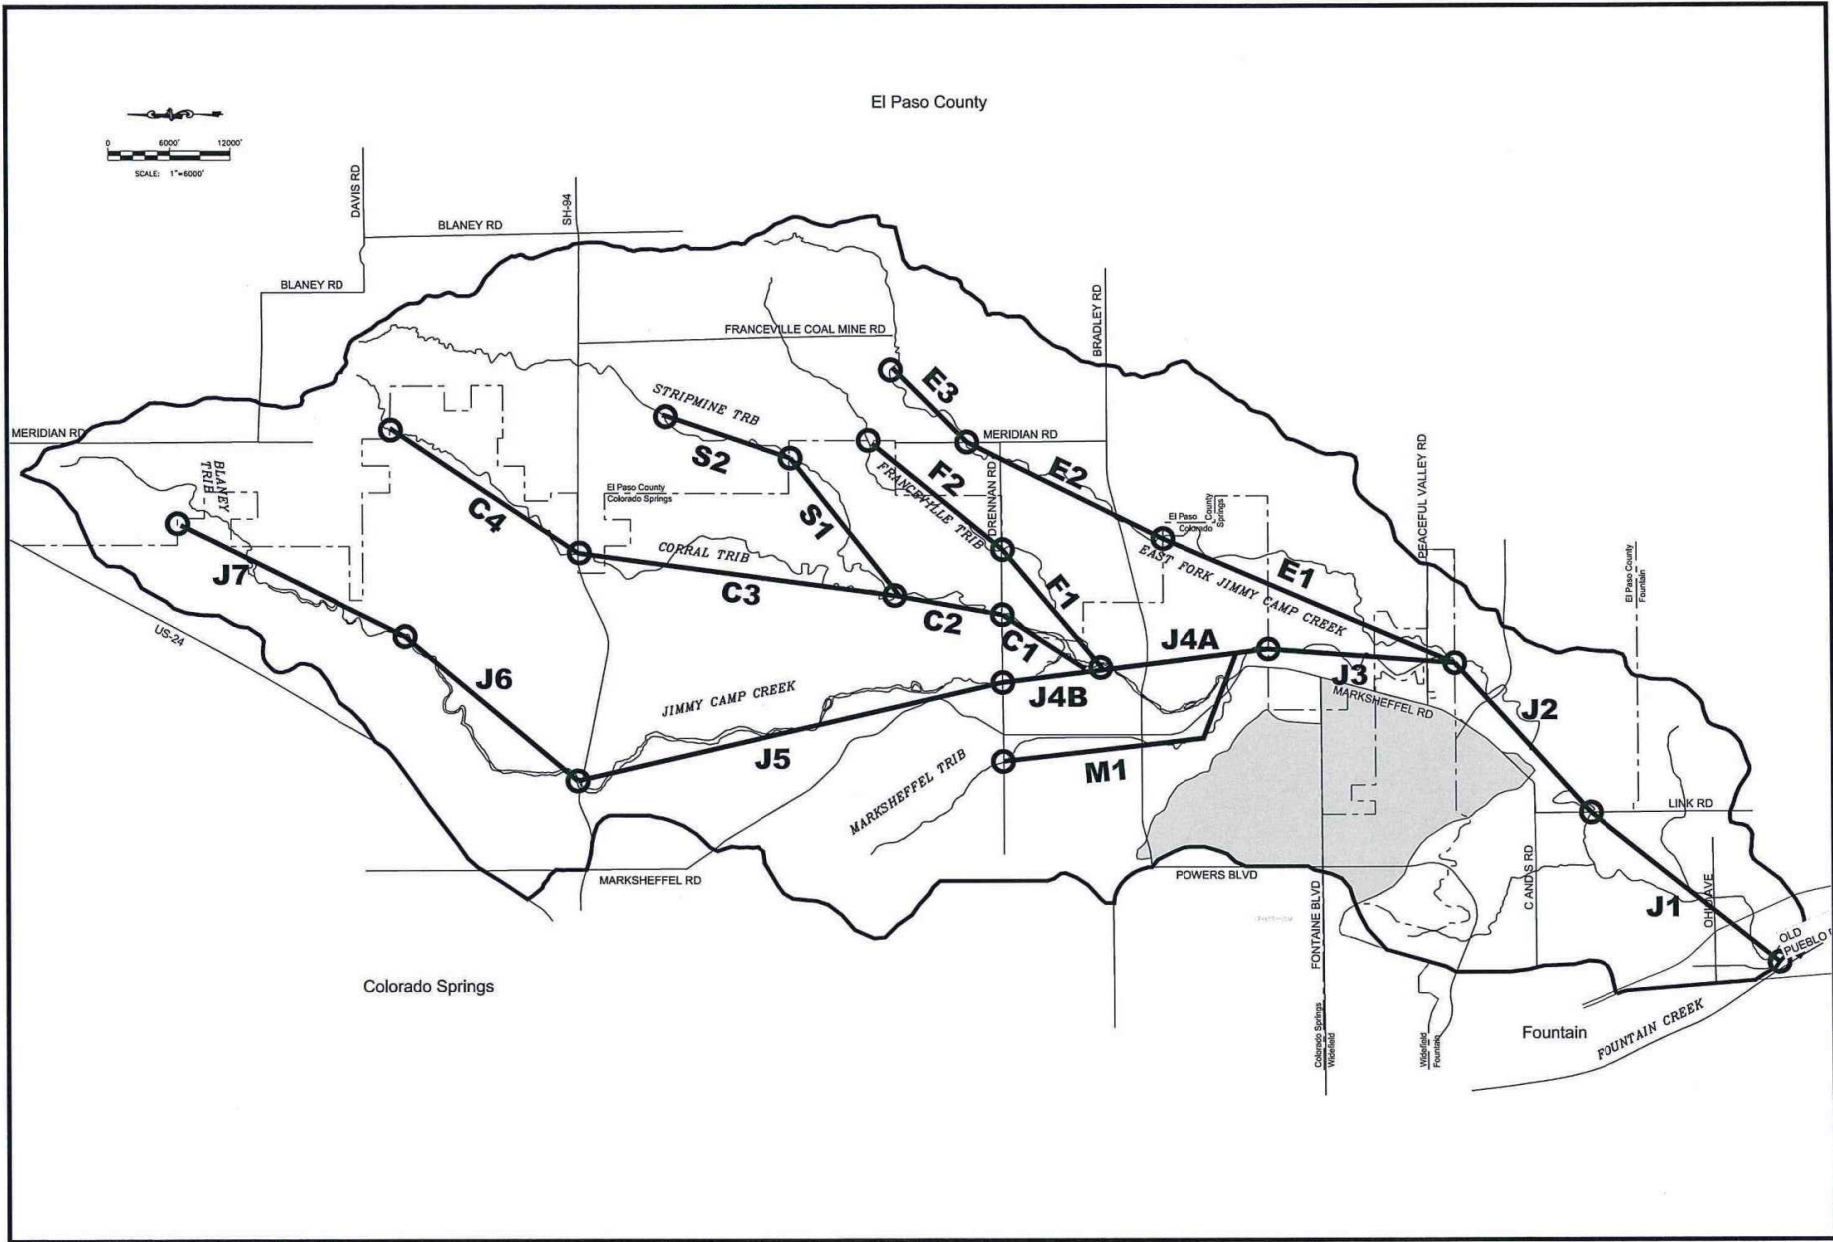


Kiowa
 Engineering Corporation
 1804 South 21st Street
 Colorado Springs, Colorado 80904
 (719) 533-7342

**JIMMY CAMP CREEK WATERSHED
 DRAINAGE BASIN PLANNING STUDY
 MAJOR DRAINAGE WAY REACH DELINEATION
 CITY OF COLORADO SPRINGS, COLORADO**

Project No.:	14008
Date:	SEPT. 2014
Design:	
Drawn:	BJW
Check:	
Revisions:	

FIGURE
IV-1

DATE: 09/11/14, 09:28 AM

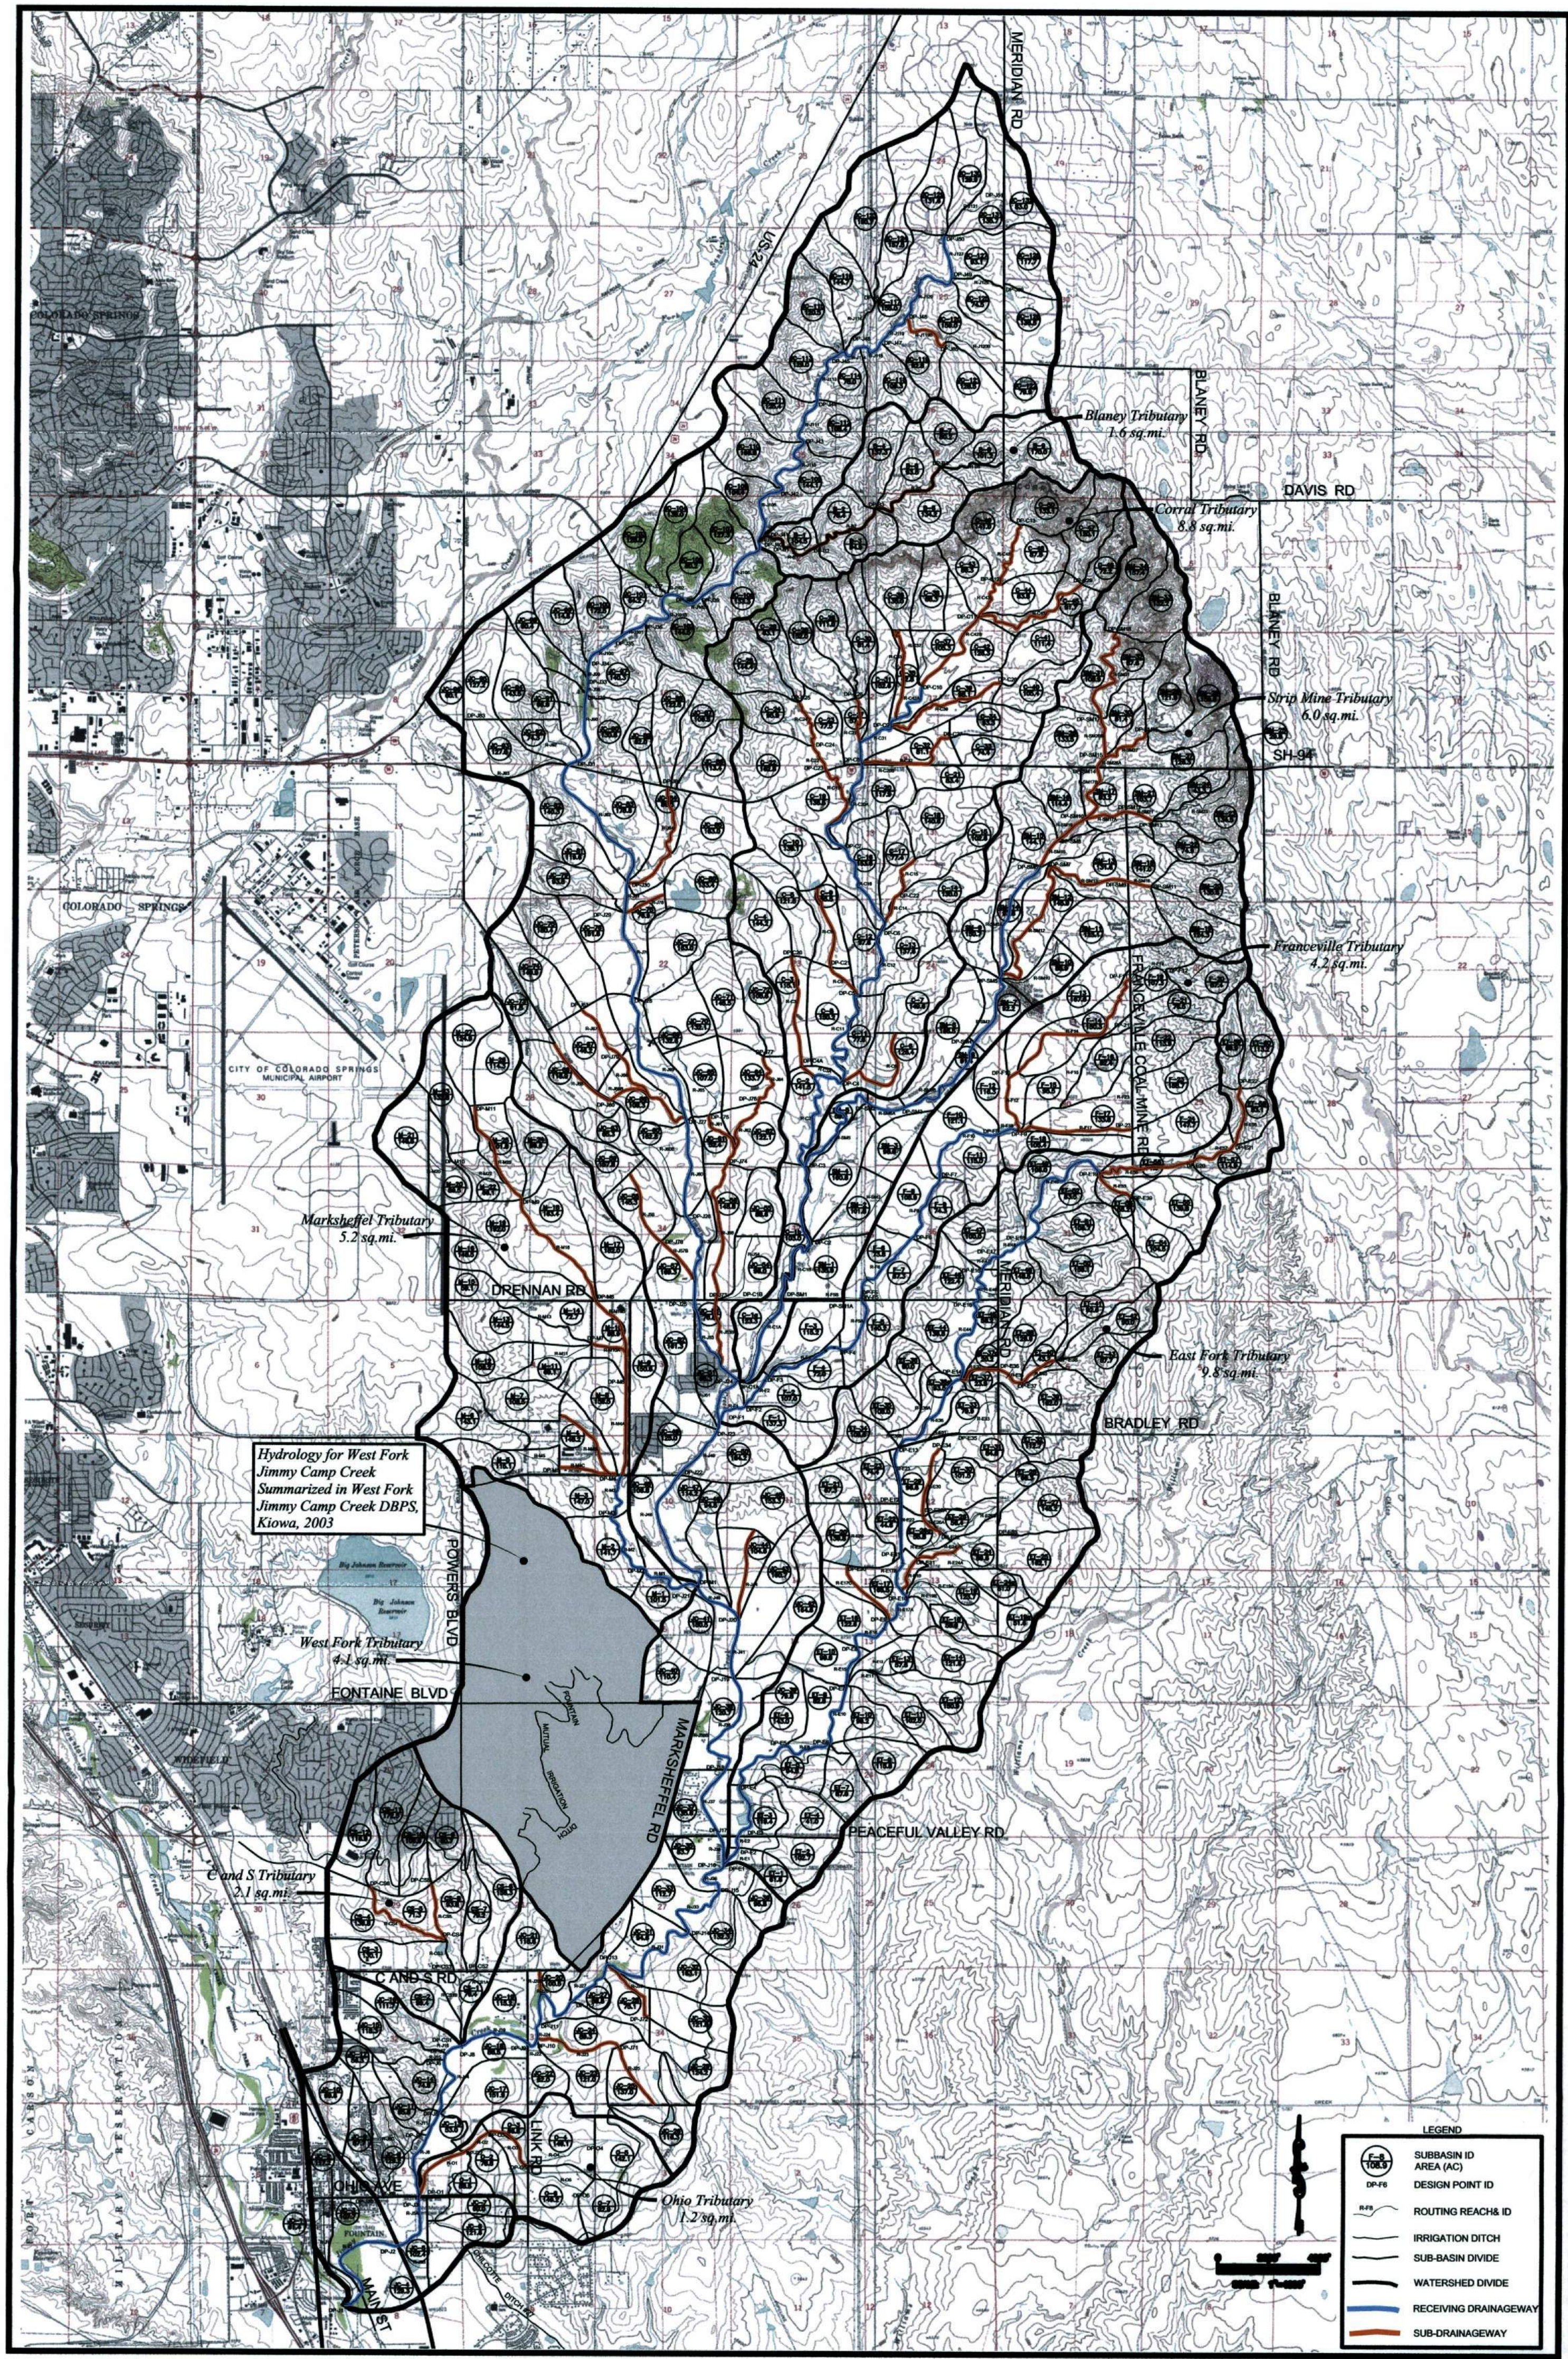



Hydrology for West Fork
Jimmy Camp Creek
Summarized in West Fork
Jimmy Camp Creek DBPS,
Kiowa, 2003

Kiowa
Engineering Corporation
1804 South 21st Street
Colorado Springs, CO 80904
(719) 530-7340

**JIMMY CAMP CREEK WATERSHED
DRAINAGE BASIN PLANNING STUDY
SUBBASIN MAP**
CITY OF COLORADO SPRINGS, COLORADO

Project No.: 14006
Date: APRIL 2015
Design: RNW
Drawn: EAK
Check:
Revisions:

EXHIBIT 1

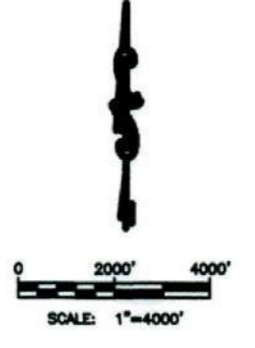
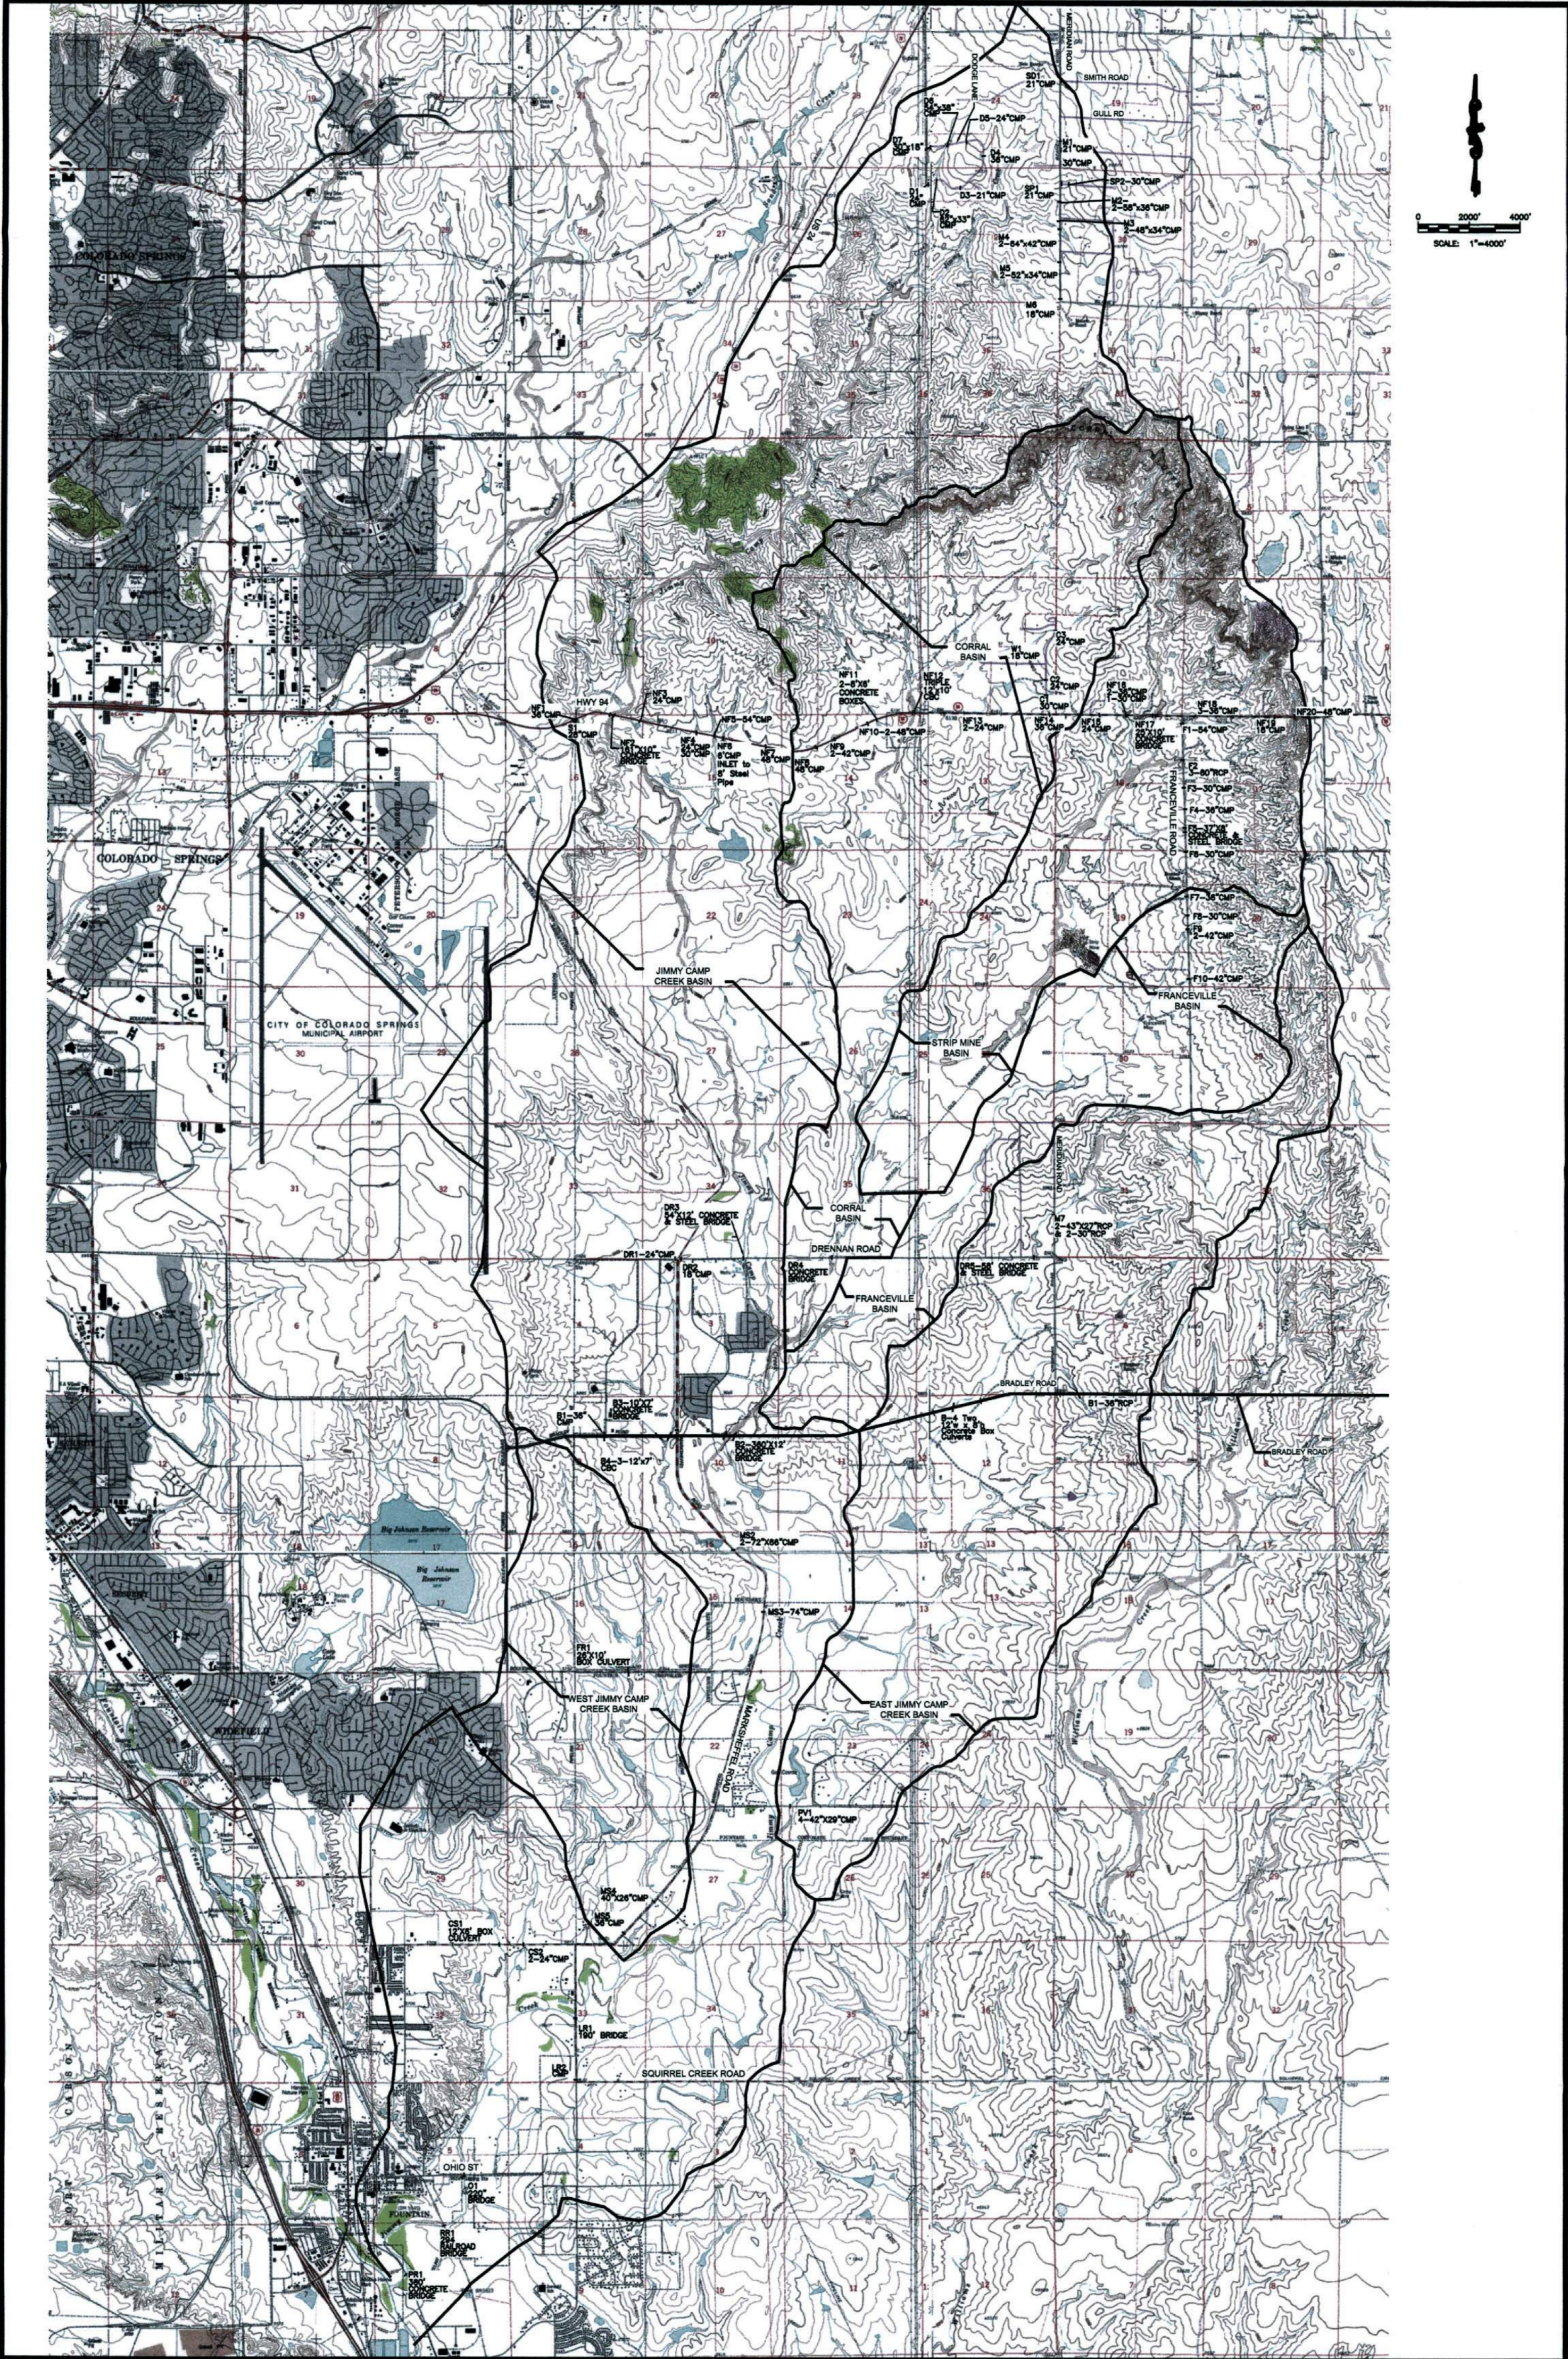


SHEET
1
 OF 4 SHEETS

Project No.:	06025
Date:	DECEMBER 2006
Design:	
Drawn:	EAK
Check:	
Revisions:	

Kiowa Engineering Corporation
 1604 South 21st Street
 Colorado Springs, Colorado 80904
 (719) 630-7342

**JIMMY CAMP CREEK WATERSHED
 DRAINAGE BASIN PLANNING STUDY
 STRUCTURE INVENTORY MAP**
 CITY OF FOUNTAIN, CITY OF COLORADO SPRINGS, EL PASO COUNTY

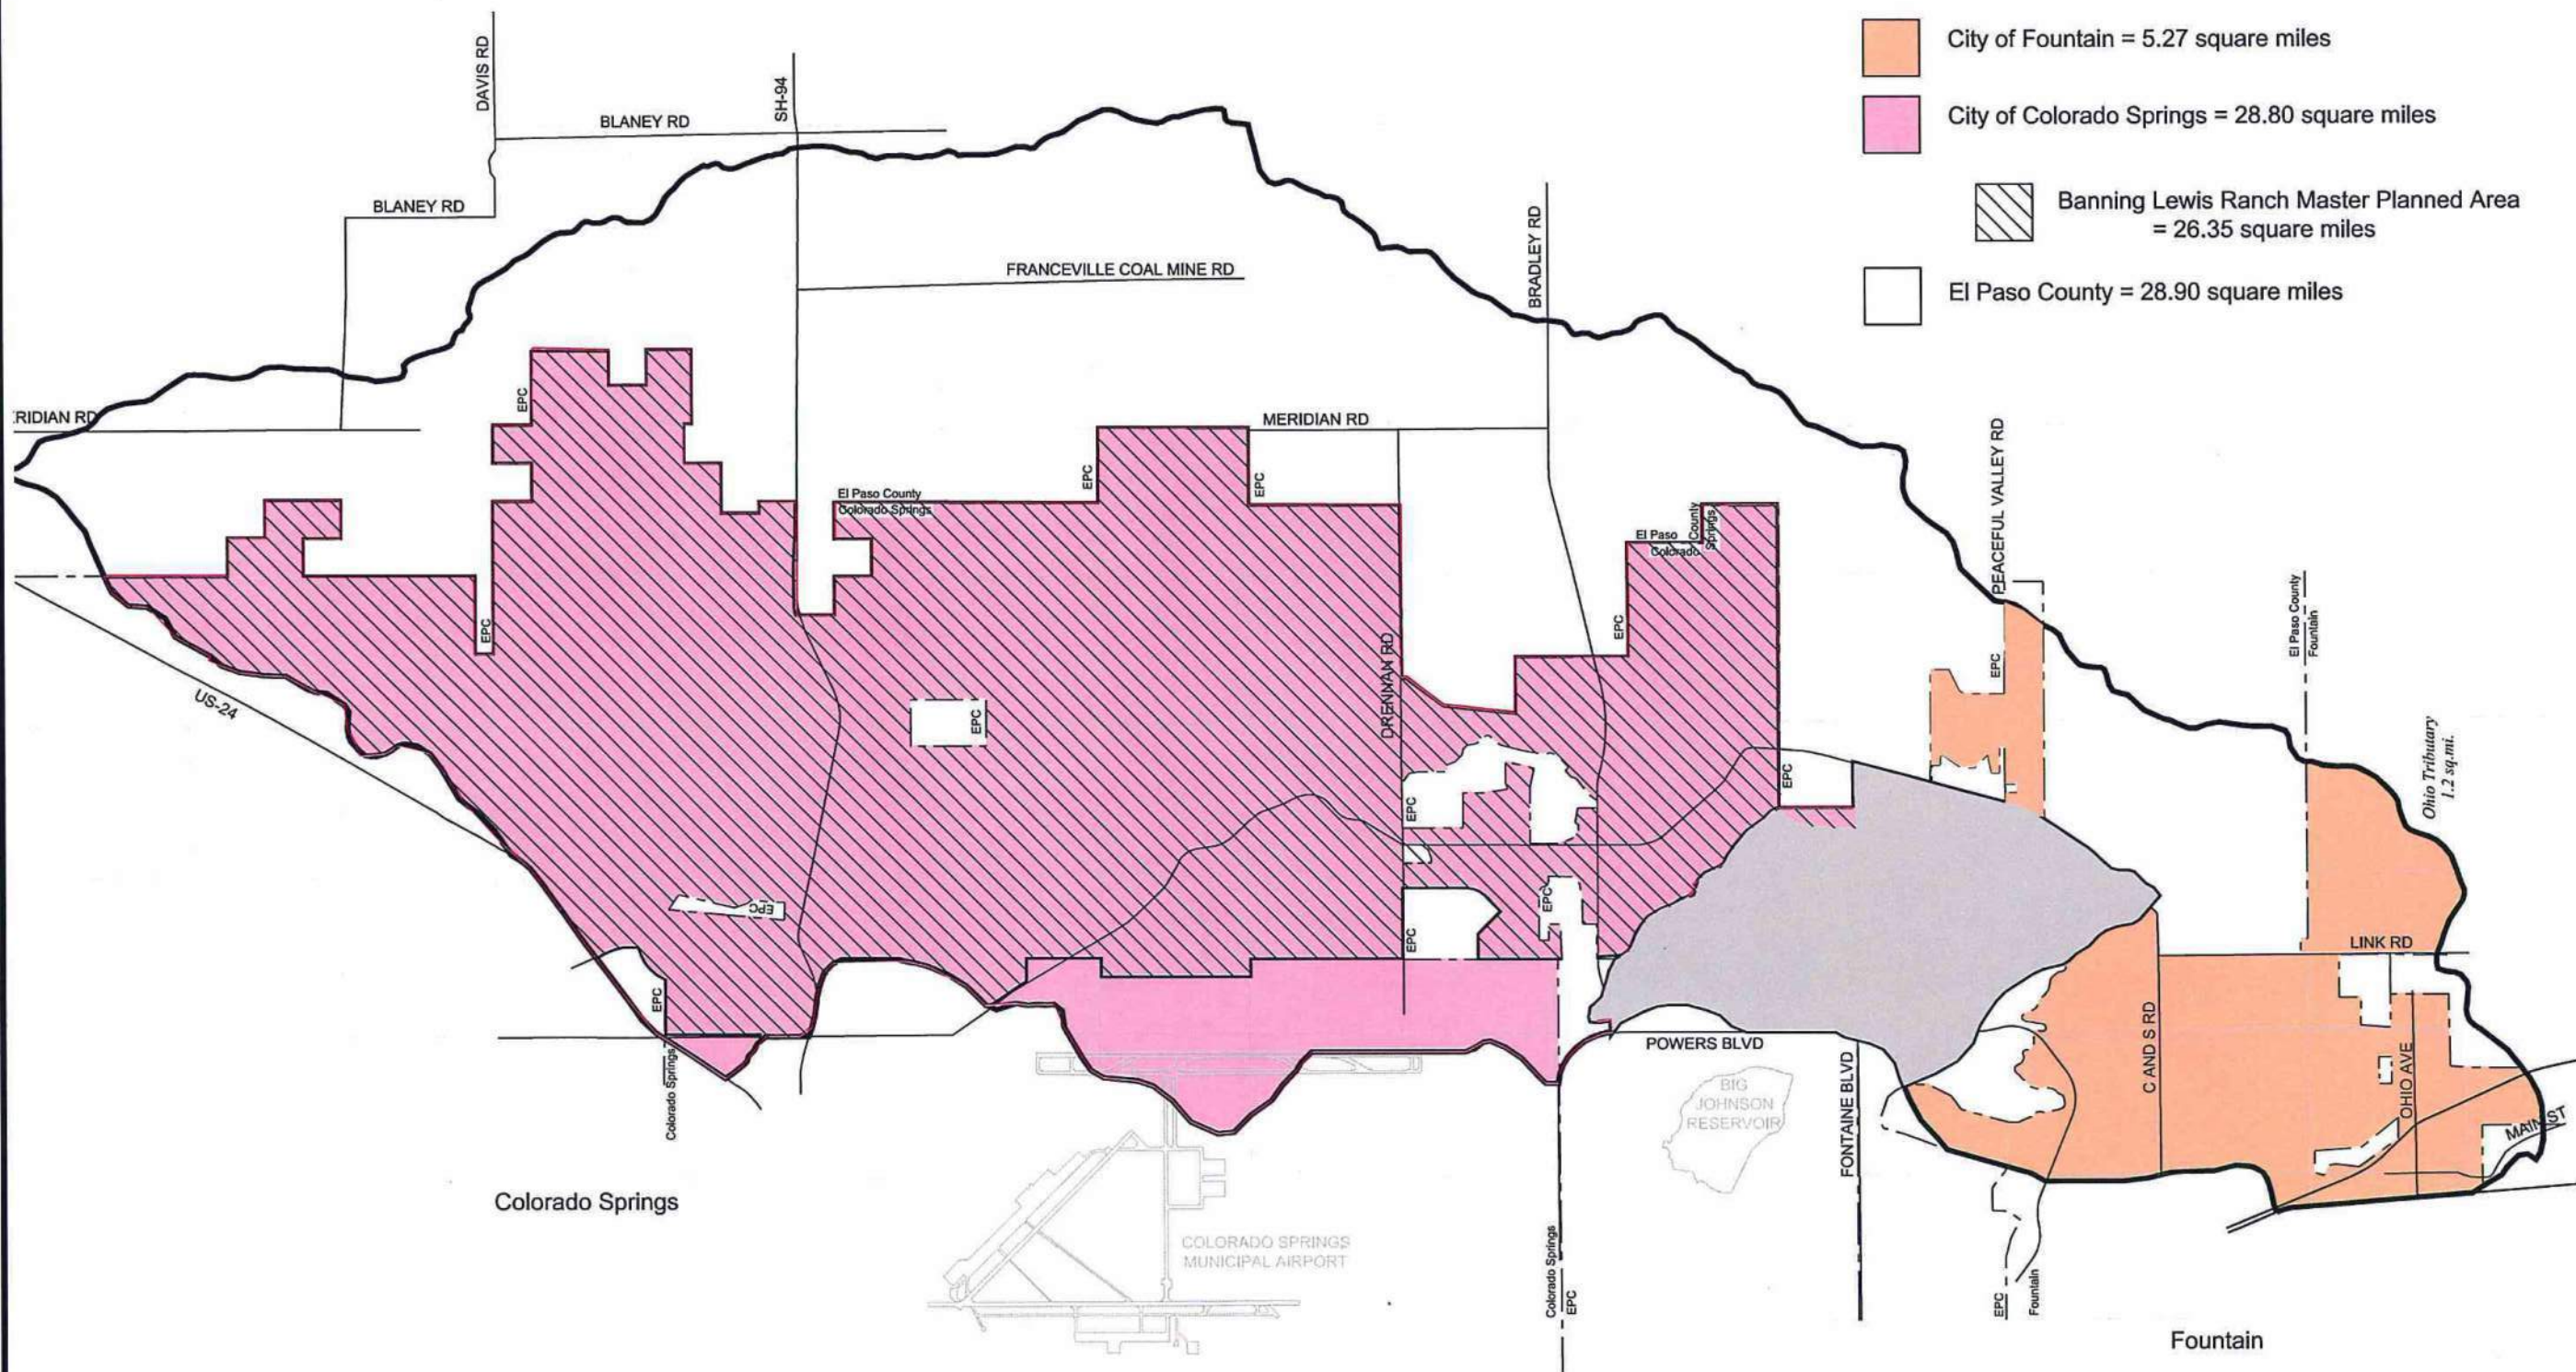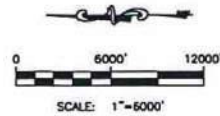



Total Basin Area = 67.11 square miles

- West Fork Basin = 4.14 square miles
- City of Fountain = 5.27 square miles
- City of Colorado Springs = 28.80 square miles
- Banning Lewis Ranch Master Planned Area = 26.35 square miles
- El Paso County = 28.90 square miles

Project No.:	14008
Date:	OCTOBER 2014
Design:	
Drawn:	EAK
Check:	
Revisions:	



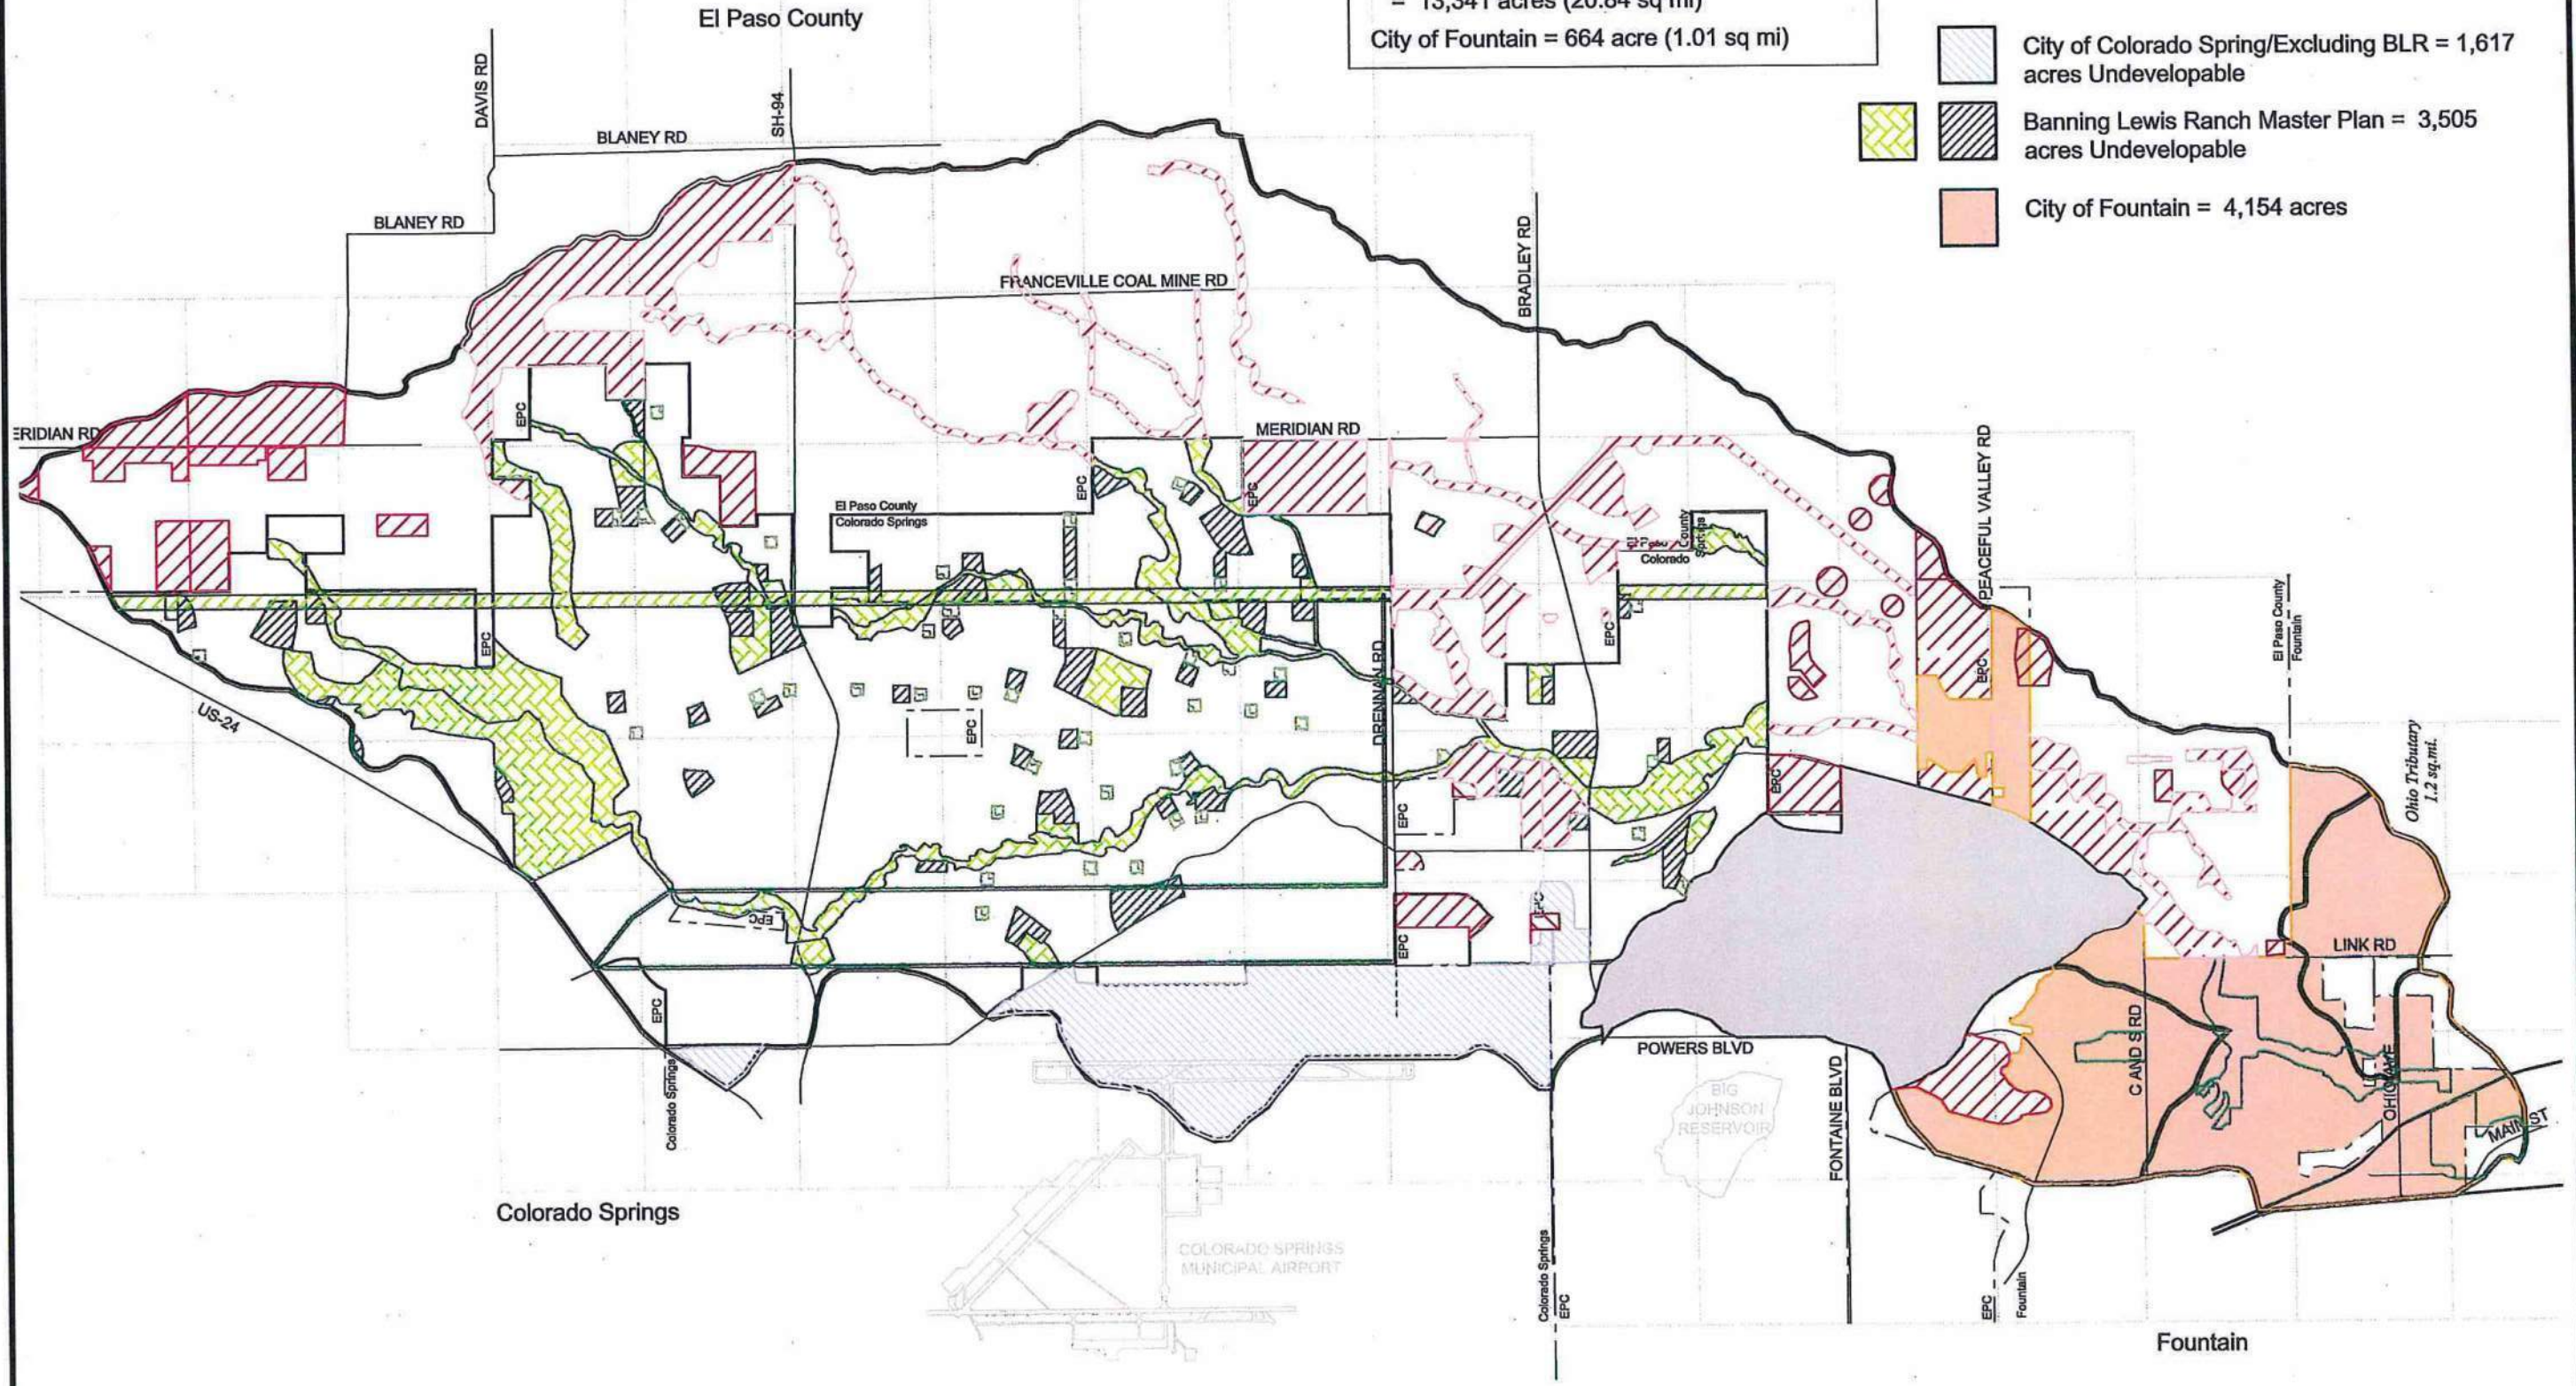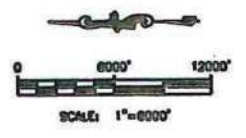

FIGURE
Fig. VII-1

14008-Fig-1-JimmyCampCreekWatershedDrainageBasinPlanningStudy.dwg Sep 03, 2014



Plattable Areas

El Paso County = 14,018 acres (21.9 sq mi)
 City of Colorado Spring/Excluding BLR Master Planned Area = 148 acres (0.23 sq mi)
 Banning Lewis Ranch Master Planned Area = 13,341 acres (20.84 sq mi)
 City of Fountain = 664 acre (1.01 sq mi)

- Platted/Undevelopable Areas**
-  El Paso County = 4,477 acres Undevelopable
 -  City of Colorado Spring/Excluding BLR = 1,617 acres Undevelopable
 -  Banning Lewis Ranch Master Plan = 3,505 acres Undevelopable
 -  City of Fountain = 4,154 acres

Project No.: 14008
Date: OCTOBER 2014
Design:
Drawn: EAC
Check:
Revisions:

FIGURE
 Fig VII-2

REAGAN RANCH MDDP EXCERPTS



CROSSROADS NORTH SITE



LEGEND

- EXISTING BASIN BOUNDARY
- EXISTING EASEMENT
- PROPOSED BASIN BOUNDARY
- EXISTING CONTOUR
- PROPOSED CONTOUR
- PROPOSED STORM DRAIN PIPE
- EXISTING STORM DRAIN PIPE
- FLOWLINE
- PROPOSED PROPERTY LINE
- PROPOSED HIGH PLAINS AT REAGAN RANCH
- PROPOSED FLOW DIRECTION
- PROPOSED INTERIM DRAINAGE SWALE

DESIGN POINT

- DESIGN POINT
- SUB BASIN DESIGNATION
- 5-YEAR STORM EVENT PEAK FLOW (CFS)
- 100-YEAR STORM EVENT PEAK FLOW (CFS)
- SUB BASIN AREA (AC.)

NOTE: SUB-BASINS B1-B6 WILL BE DEVELOPED IN A FUTURE PHASE.

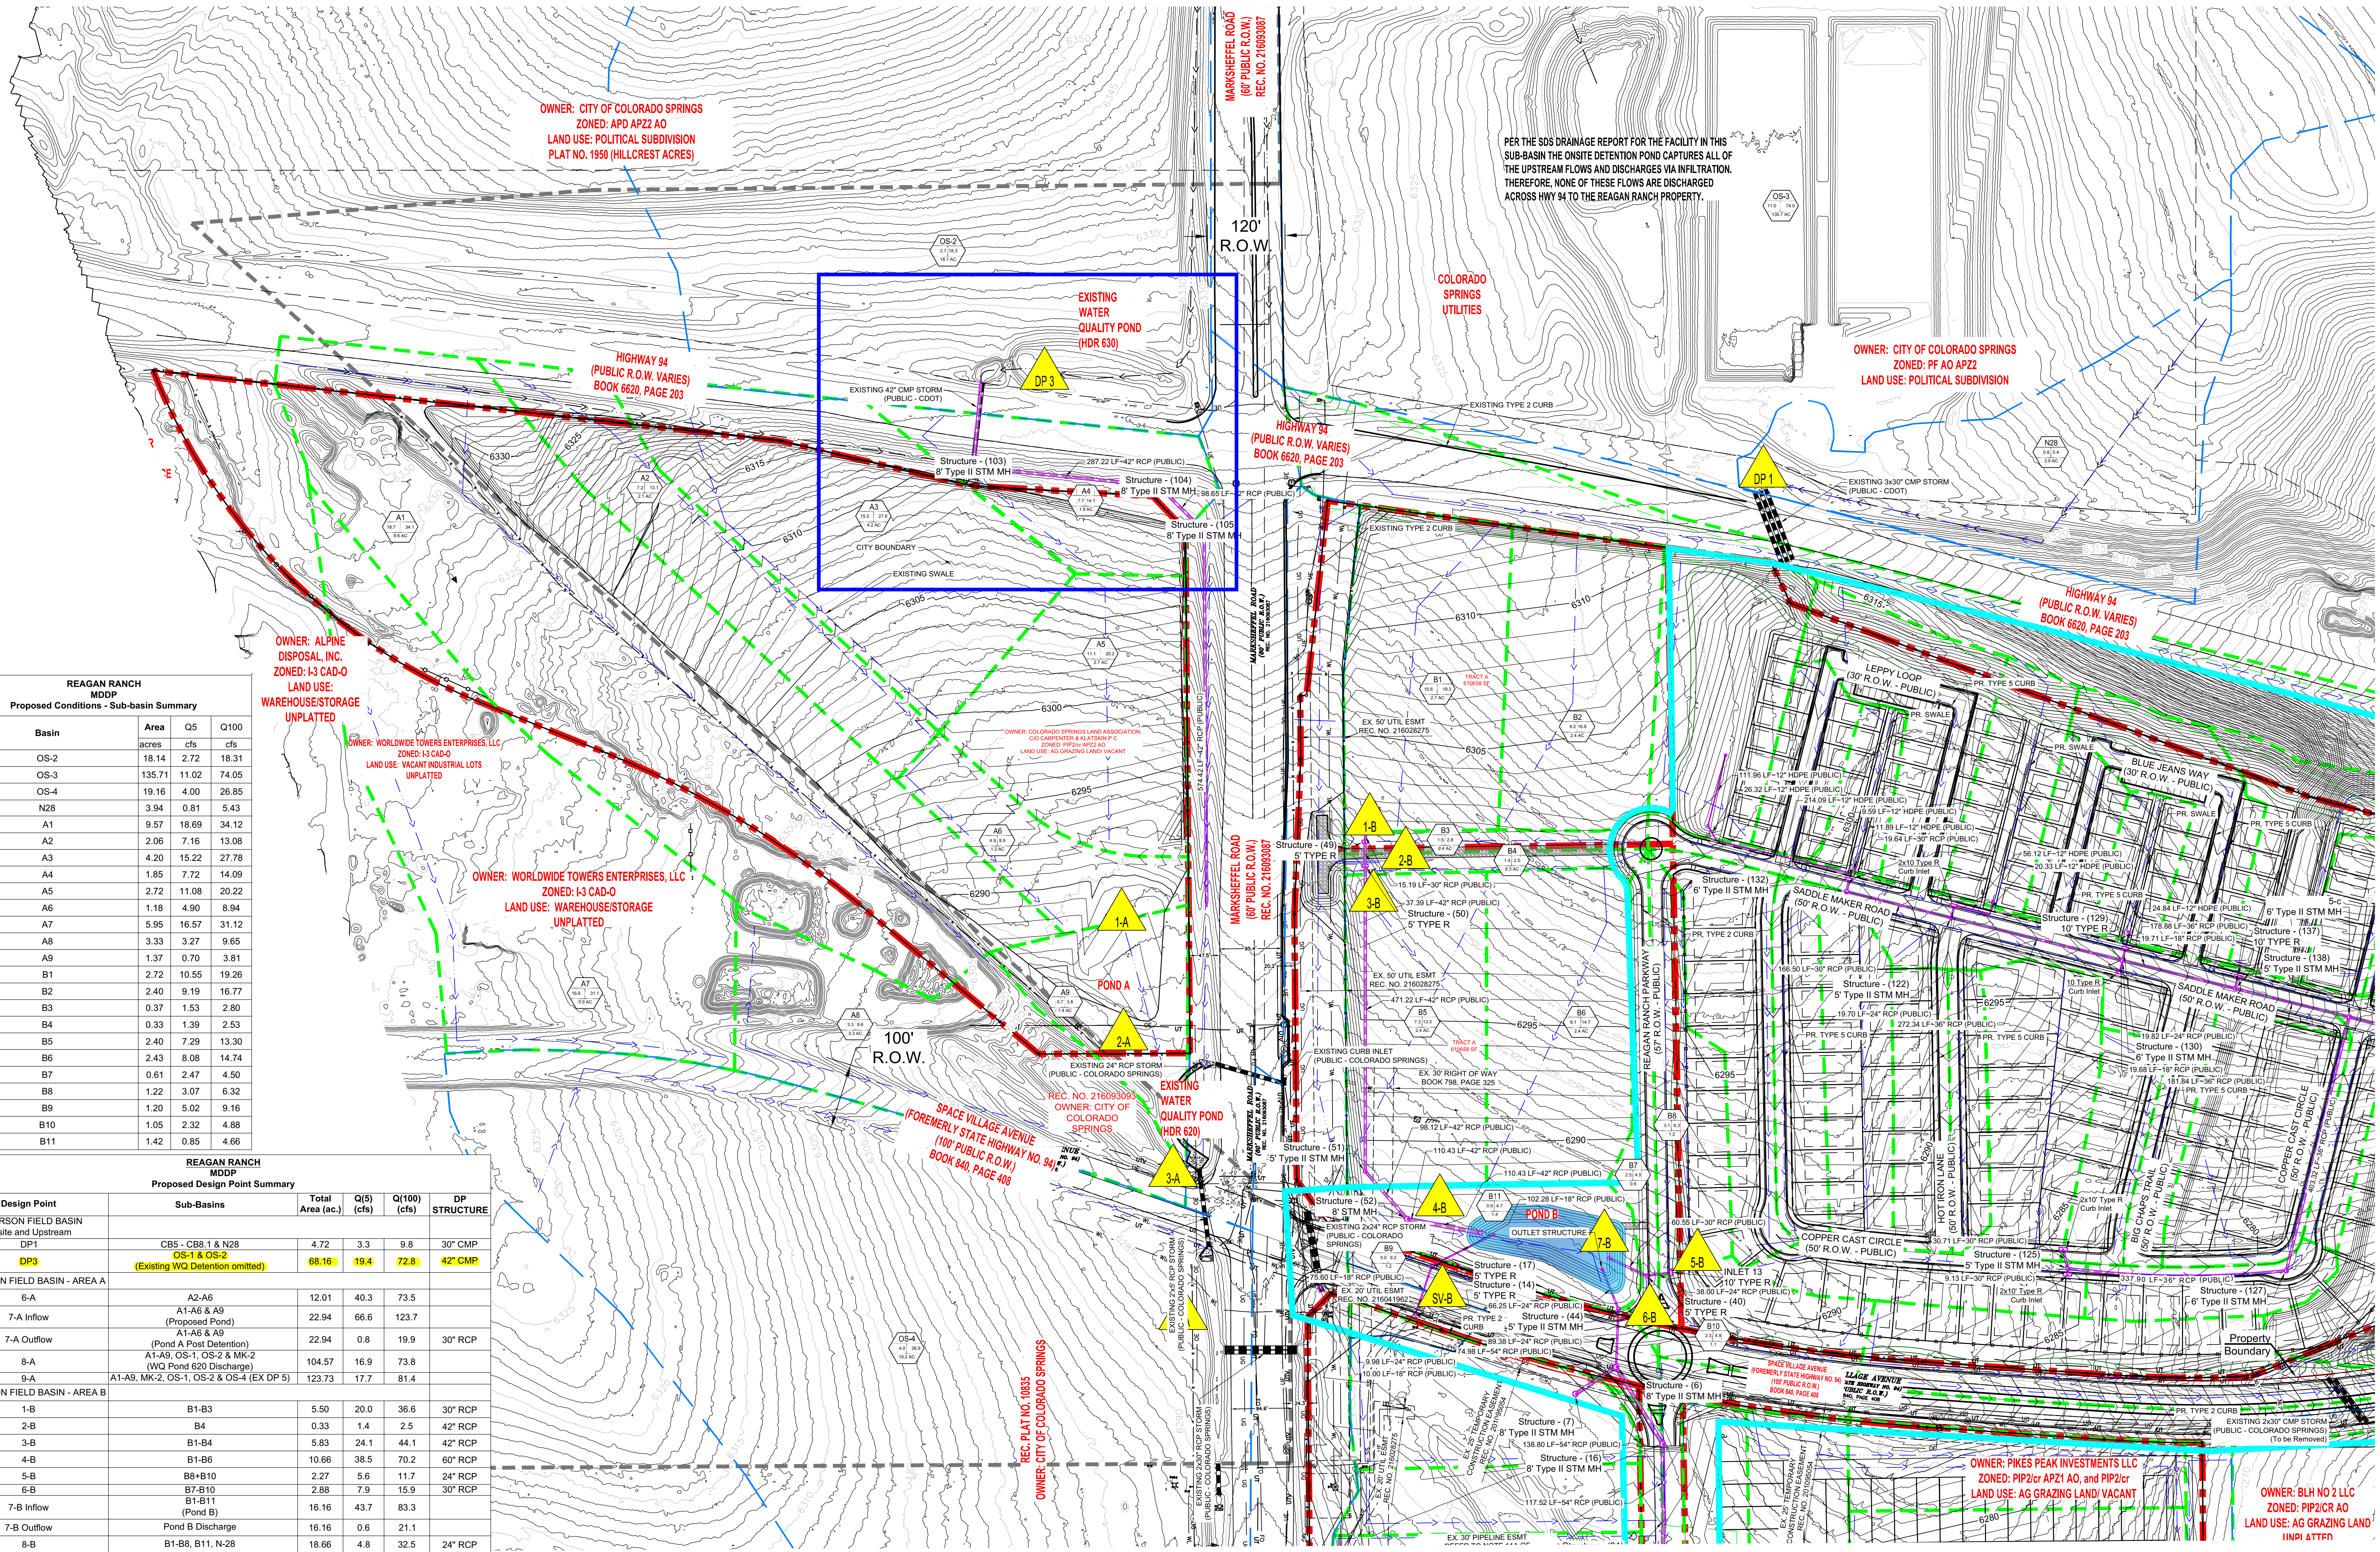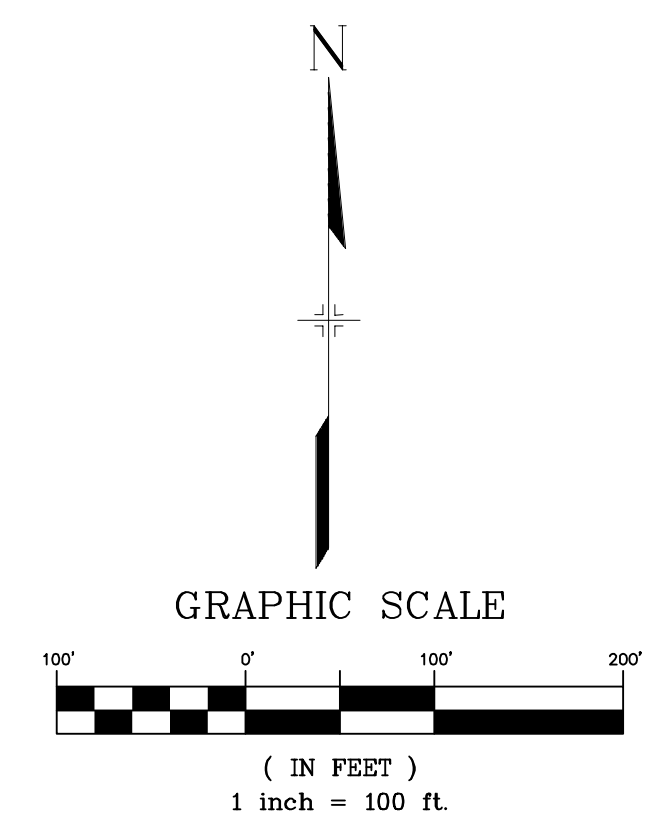

REAGAN RANCH MDDP Proposed Conditions - Sub-basin Summary

Basin	Area	Q5	Q100
	acres	cfs	cfs
OS-2	18.14	2.72	18.31
OS-3	135.71	11.02	74.05
OS-4	19.16	4.00	26.85
N28	3.94	0.81	5.43
A1	9.57	18.69	34.12
A2	2.06	7.16	13.08
A3	4.20	15.22	27.78
A4	1.85	7.72	14.09
A5	2.72	11.08	20.22
A6	1.18	4.90	8.94
A7	5.95	16.57	31.12
A8	3.33	3.27	9.65
A9	1.37	0.70	3.81
B1	2.72	10.55	19.26
B2	2.40	9.19	16.77
B3	0.37	1.53	2.80
B4	0.33	1.39	2.53
B5	2.40	7.29	13.30
B6	2.43	8.08	14.74
B7	0.61	2.47	4.50
B8	1.22	3.07	6.32
B9	1.20	5.02	9.16
B10	1.05	2.32	4.88
B11	1.42	0.85	4.66

REAGAN RANCH MDDP Proposed Design Point Summary

Design Point	Sub-Basins	Total Area (ac.)	Q(5) (cfs)	Q(100) (cfs)	DP STRUCTURE
PETERSON FIELD BASIN Offsite and Upstream					
DP1	CB5 - CB8.1 & N28	4.72	3.3	9.8	30" CMP
	OS1 & OS2 (Existing WC Detention omitted)	88.16	19.4	72.8	42" CMP
PETERSON FIELD BASIN - AREA A					
6-A	A2-A6	12.01	40.3	73.5	
7-A Inflow	A1-A6 & A9 (Proposed Pond)	22.94	66.6	123.7	
7-A Outflow	(Pond A Post Detention)	22.94	0.8	19.9	30" RCP
8-A	A1-A9, OS-1, OS-2 & MK-2 (WG Pond 620 Discharge)	104.57	16.9	73.8	
9-A	A1-A9, MK-2, OS-1, OS-2 & OS-4 (EX DP 5)	123.73	17.7	81.4	
PETERSON FIELD BASIN - AREA B					
1-B	B1-B3	5.50	20.0	36.6	30" RCP
2-B	B4	0.33	1.4	2.5	42" RCP
3-B	B1-B4	5.83	24.1	44.1	42" RCP
4-B	B1-B6	10.66	38.5	70.2	60" RCP
5-B	B8-B10	2.27	5.6	11.7	24" RCP
6-B	B7-B10	2.88	7.9	15.9	30" RCP
7-B Inflow	B1-B11 (Pond B)	16.16	43.7	83.3	
7-B Outflow	Pond B Discharge	16.16	0.6	21.1	
8-B	B1-B8, B11, N-28	18.66	4.8	32.5	24" RCP

PIKES PEAK INVESTMENTS, LLC
 COLORADO SPRINGS, COLORADO
 REAGAN RANCH MDDP/DR

PRELIMINARY DRAINAGE MAP

FOR AND ON BEHALF OF PIKES PEAK INVESTMENTS, LLC
 PROJECT NO. 19-224-038

DESIGNED BY: JRE
 CHECKED BY: GSE

DATE ISSUED: FEBRUARY 2021
 SHEET: 3 OF 11
 DRAWING NO.: DR03

PRELIMINARY
 THIS DRAWING HAS NOT BEEN APPROVED BY AND IS SUBJECT TO CHANGE

FOR AND ON BEHALF OF PIKES PEAK INVESTMENTS, LLC
 PROJECT NO. 19-224-038

Matrix

COMPUTER FILE MANAGEMENT
 FILE NAME: S:\19-224-038 Reagan Ranch\200 Drainage\Reports\MDDP\DWG\Reagan_Ranch - DR-current.dwg
 CFB FILE: S:\19-224-038 Reagan Ranch\200 Drainage\Reports\MDDP\DWG\Reagan_Ranch - DR-current.dwg
 DATE: 2/23/21 3:26:57 PM
 THIS DRAWING IS CURRENT AS OF DATE AND MAY BE SUBJECT TO CHANGE.

No.	DATE	DESCRIPTION	BY

- c. The ***fully developed conditions*** for the site are as follows:

At this Master Development stage of design for the drainage, general locations of Design Points have been defined in order to size the trunk mains of the proposed storm system (see Appendix D for Storm Exhibit). Each of the proposed sub-basins will have their own internal storm systems that convey the flows to the Design Points mentioned in this report and will be outlined in each parcel's respective Final Drainage Report.

Design Point 1 ($Q_5 = 3.3$ cfs, $Q_{100} = 9.8$ cfs) (Sub-basins CB-5-CB8.1 and N-28 (SDS), Tributary Area: 4.72 Acres) represents the offsite runoff crossing Highway 94 at the existing triple 30" CMP culverts (Public CDOT). This drainage point has a tributary area of approximately 4.7 acres. The drainage area includes a portion of Marksheffel Road north of Highway 94 and the portion of the SDS property which is not captured by the existing SDS detention pond (private) (which provides 100 percent infiltration for its tributary drainage area and does not discharge to the Reagan Ranch development). After crossing Highway 94 this sub-basin drains eastward along the Highway 94 road ditch eventually entering Jimmy Camp Creek. This sub-basin and design point remain unchanged from predevelopment conditions.

Design Point 3 ($Q_5 = 19.4$ cfs, $Q_{100} = 72.8$ cfs) (Sub-basins OS-1 and OS-2, Tributary Area: 68.2 Acres) represents the offsite flows conveyed across Highway 94 towards the west side of the proposed project. These flows are conveyed across Highway 94 via a 42-inch CMP (Public CDOT). These flows appear to go through the Marksheffel Water Quality Pond (Public-Colorado Springs) located in the NW quadrant of the Marksheffel Road and Highway 94 intersection. This sub-basin and design point remain unchanged from predevelopment conditions.

Notes:

- **Analysis of the Proposed Basin areas is conceptual in nature. Greater detail than typical (including some preliminary storm sewer design) is provided in this MDDP in order to accommodate SWMM analysis of the various regions within the development for use in the City of Colorado Springs PCM Preliminary Detention Spreadsheet. Future FDRs for each phase of the site must define the specific storm sewer and drainage patterns. Basin Lettering (i.e. A, B, C, etc.) can be considered to indicate a rough idea of future phases and/or regions which would require on-site detention. Future FDRs must define the drainage within each phase/region.**
- **The first phase of the Reagan Ranch development which is planned for construction has been named "High Plains at Reagan Ranch" and consists of a small portion of region B and all of regions C and J. Street and inlet calculations for these three regions are included in the report. Similar calculations for the remaining regions will be submitted with future Final Drainage Reports as development progresses. An FDR will be submitted with the High Plains at Reagan Ranch Final Plat.**
- **For sub-basins within the single-family residential areas, runoff will sheet flow towards the adjacent streets. Once reaching the street these flows will be channelized into gutter flow for conveyance to downstream inlets.**

DRAINAGE MAPS

CROSSROADS NORTH MDDP


COUNTY OF EL PASO, STATE OF COLORADO

EXISTING DRAINAGE MAP

JANUARY 2022

LEGEND

- EXISTING FLOW DIRECTION ARROW
- EMERGENCY OVERTFLOW DIRECTION
- EXISTING RIPRAP TYP.
- EXISTING UTILITY POLE
- EX. IRRIGATION VALVE
- EX. STORM INLET
- EX. GAS TEST NODE
- EX. TRAFFIC SIGNAL CONTROL BOX
- EX. ELECTRIC VAULT
- EX. SANITARY MANHOLE
- EX. WATER VALVE
- EXISTING WATER WELL
- EXISTING MONITORING WELL
- EX. TELEPHONE VAULT
- EX. ELECTRIC PEDESTAL
- EX. ELECTRIC METER
- EX. ELECTRIC TRANSFORMER
- EX. TELEPHONE PEDESTAL
- EX. FIBER OPTIC MANHOLE
- EX. ELECTRIC PEDESTAL
- EX. WATER MARKER
- EX. GAS MARKER
- EX. FIBER OPTIC MARKER
- EX. ELECTRIC MANHOLE
- EX. CABLE TV MARKER
- EX. SHRUB/TREE
- EX. WATER YARD HYDRANT
- EX. STORM INLET
- EX. ELECTRIC BOX
- EX. FIRE HYDRANT
- EX. ELECTRIC MARKER
- EX. TRAFFIC SIGNAL

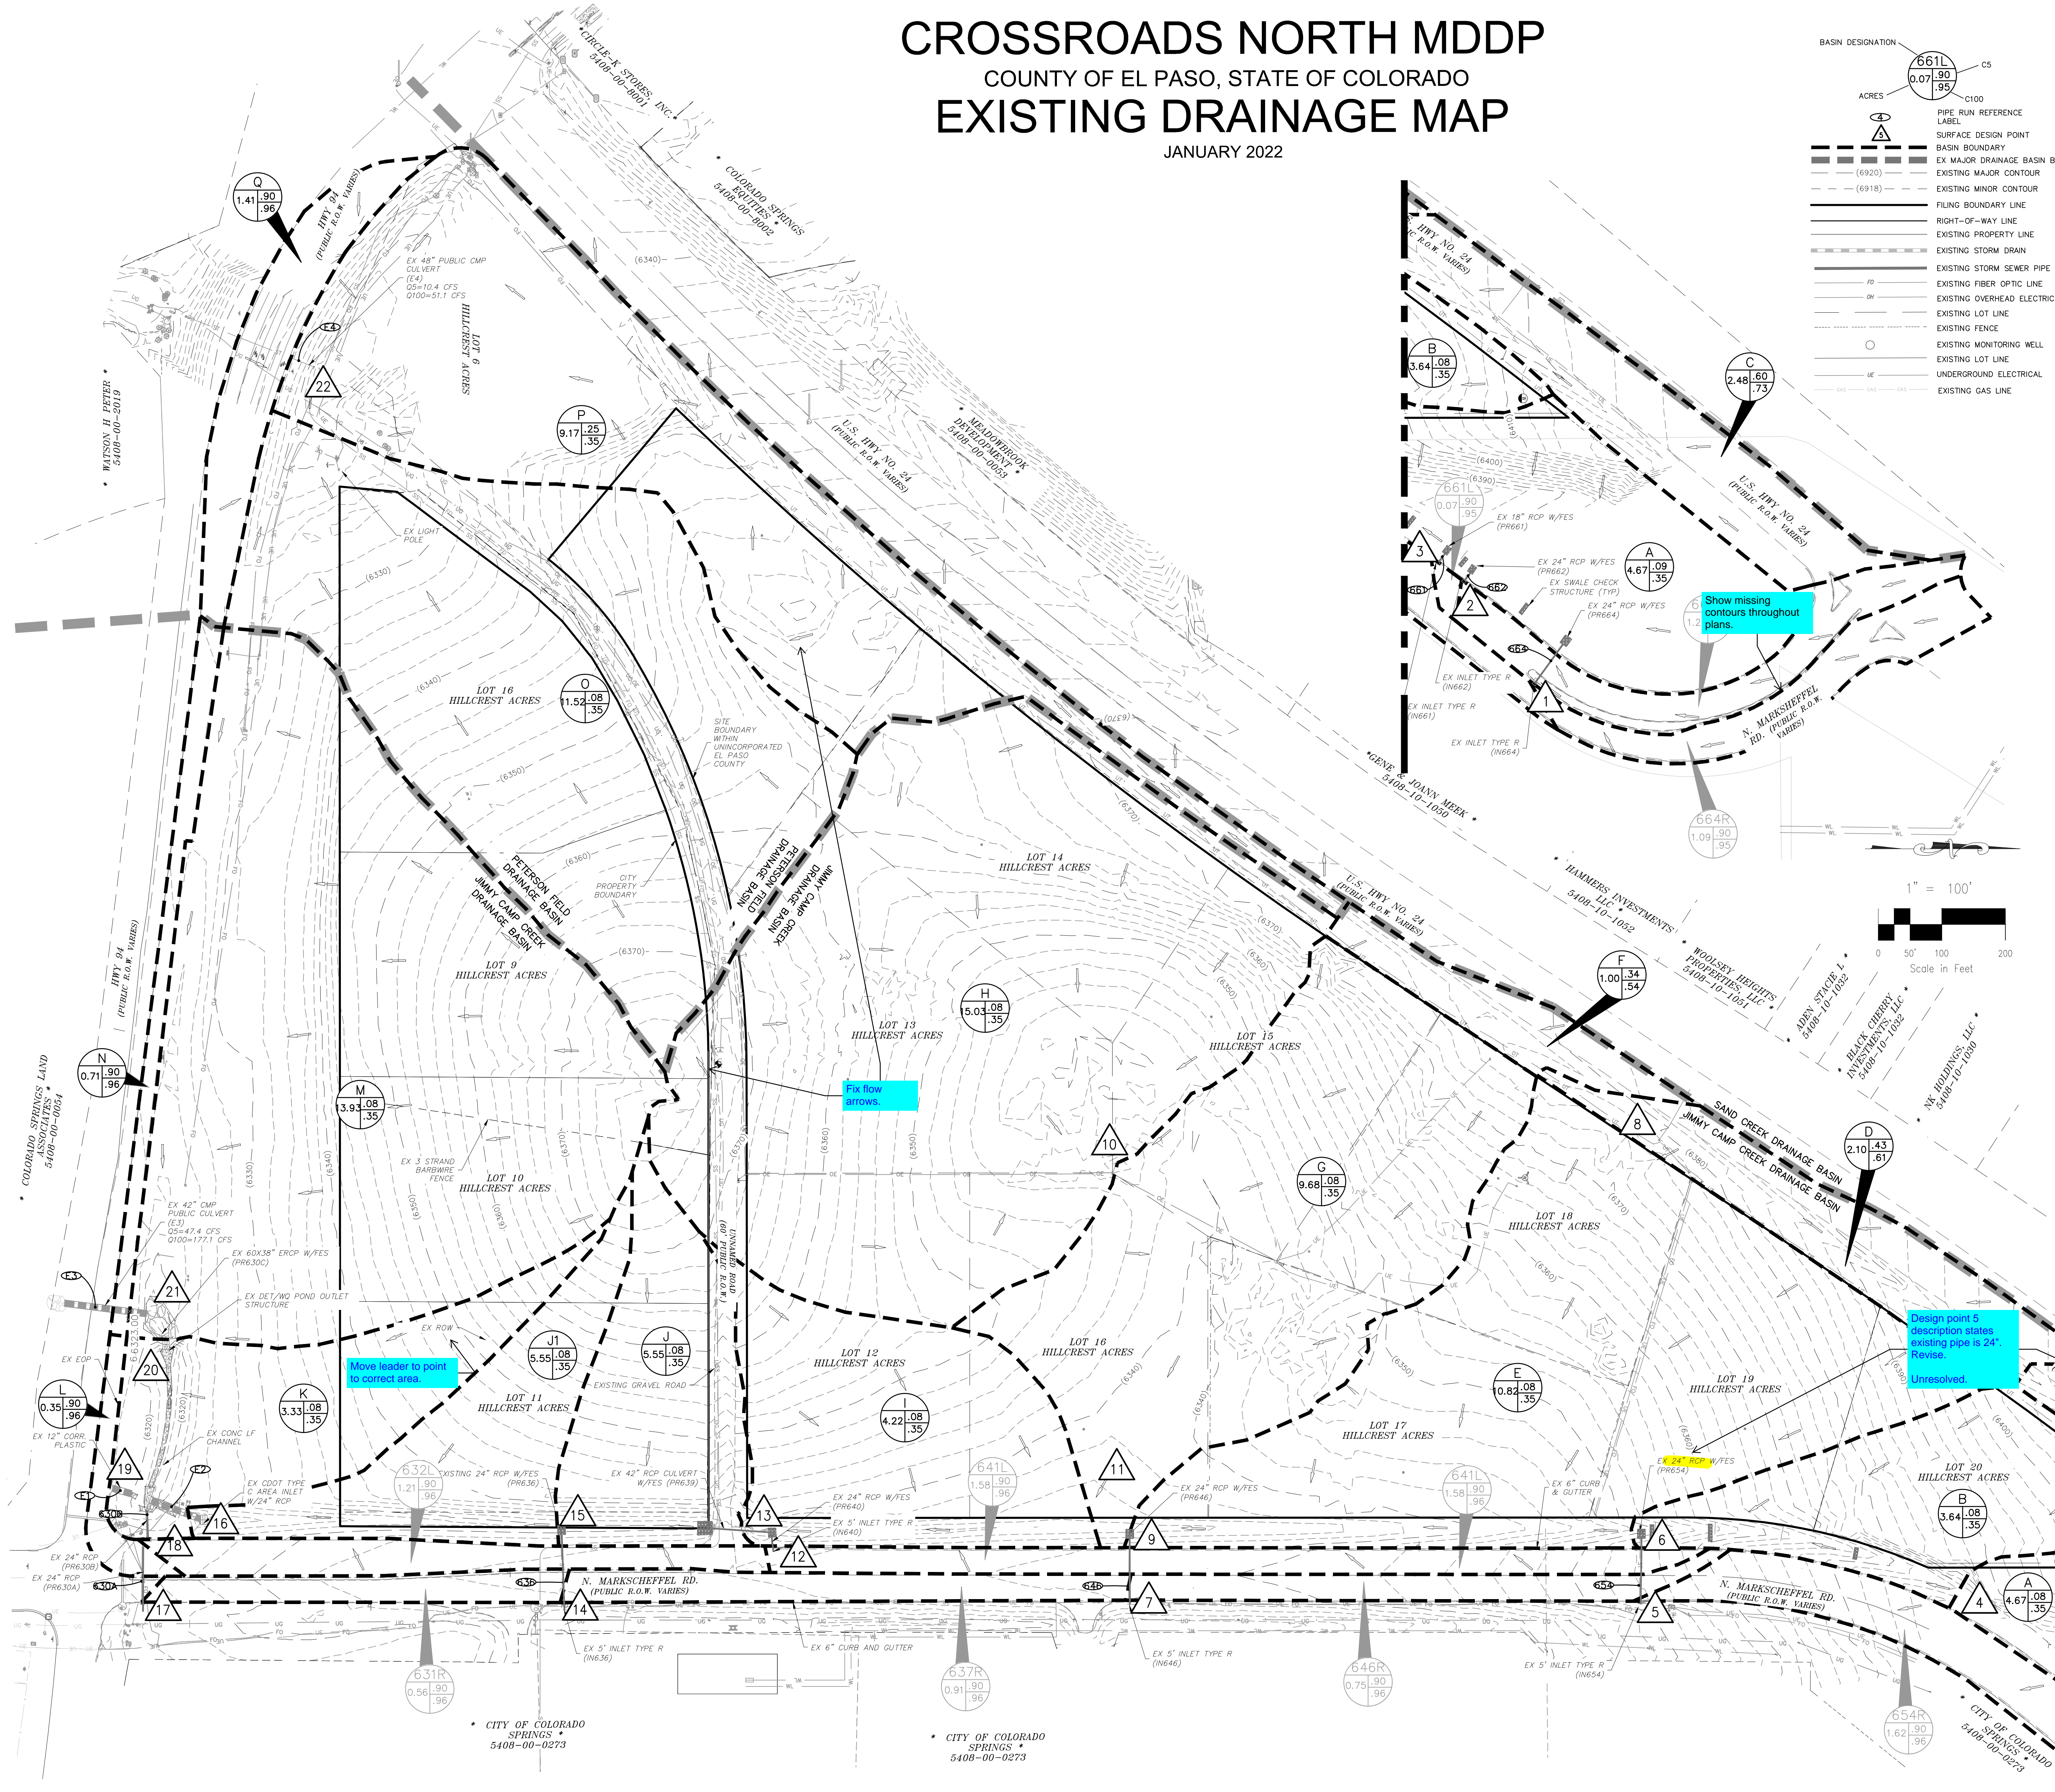

BASIN SUMMARY			
BASIN	AREA (ACRES)	Q _s	Q ₁₀₀
A	4.67	1.4	10.2
B	3.64	1.0	7.3
C	2.51	5.5	11.3
D	2.10	3.7	8.9
E	10.82	2.9	21.1
F	1.00	1.5	3.9
G	8.99	2.2	15.9
H	15.03	3.4	25.3
I	4.22	1.1	8.4
J	2.88	0.8	5.6
J1	2.87	0.7	4.9
K	3.33	0.9	6.8
L	0.35	1.6	2.9
M	13.93	4.0	28.8
N	0.71	3.3	5.9
O	11.52	2.7	20.2
P	9.17	2.4	17.9
Q	1.41	6.6	11.8
Q1*	0.56	2.5	4.2
Q2*	1.21	4.5	8.1
Q3*	0.91	3.1	5.5
Q4*	1.58	5.8	10.4
Q5*	0.75	3.5	6.2
Q6*	1.62	7.1	12.8
Q7*	0.07	0.3	0.6
Q8*	1.21	5.6	10.0
Q9*	1.09	5.1	9.1

DESIGN POINT SUMMARY			
DESIGN POINT	Q _s	Q ₁₀₀	BASIN STRUCTURE
1	5.1	9.1	EX 5" CDDT TYPE R AG INLET
2	5.6	10.0	EX 5" CDDT TYPE R INLET
3	2.9	6.7	FBR662, EX 5" CDDT TYPE R INLET
4	7.9	20.3	PR665, EX 5" BTM EARTH TRAP CHANNEL
5	10.3	21.6	PR662, EX 5" CDDT TYPE R INLET
6	10.5	28.4	DP4, DP5 EX 5" BTM EARTH TRAP CHANNEL
7	7.9	18.2	FBR654, EX 5" CDDT TYPE R INLET
8	8.6	18.8	C, D ENTERS PROPERTY FROM CDDT ROW
9	23.5	69.0	DP6, DP8 EX 5" BTM EARTH TRAP CHANNEL
10	3.4	25.3	H LOCALIZED LOWPOINT
11	6.8	45.2	F, G, DP10 EX 5" BTM EARTH TRAP CHANNEL
12	5.8	10.4	641L EX 5" CDDT TYPE R INLET
13	36.8	138.0	DP9, EX 42" CULVERT
14	5.9	14.5	FBR640, EX 5" CDDT TYPE R INLET
15	38.3	139.7	DP13, J, EX 5" BTM EARTH TRAP CHANNEL
16	35.3	131.7	DP15, J1 EX CDDT TYPE C AREA INLET W/ RIPRAP BYPASS ROUNDWALL
17	4.0	11.7	FBR636, EX 5" CDDT TYPE R INLET
18	5.8	11.6	FBR640, EX 5" CDDT TYPE R INLET
19	1.7	4.9	FBR630B, EX 12" PLASTIC CORRUGATED PIPE
20	42.2	149.5	DP16, EX W.Q. POND
21	47.4	177.1	DP20, M, EX 42" CMP
22	10.4	51.1	O, P, Q EX 48" CMP

STORM SEWER SUMMARY					
PIPE RUN	Q _s	Q ₁₀₀	PIPE SIZE	CONTRIBUTING PIPES/DP	TYPE
664	2.7	3.4	EX 24" RCP	IN648R	PUBLIC
665	3.0	3.8	EX 24" RCP	IN662L	PUBLIC
661	3.2	4.0	EX 18" RCP	IN661L	PUBLIC
654	4.0	5.2	EX 24" RCP	IN654	PUBLIC
646	3.4	4.7	EX 24" RCP	IN646	PUBLIC
640	2.9	3.8	EX 24" RCP	IN640	PUBLIC
636	3.0	4.3	EX 24" RCP	IN636	PUBLIC
630A	2.5	4.1	EX 24" RCP	IN630A	PUBLIC
630B	5.8	10.3	EX 24" RCP	IN630B	PUBLIC
E1	1.8	6.9	EX 12" CORR. PLASTIC	DP19	PUBLIC
E2	11.8	19.8	EX 24" RCP	DP16	PUBLIC
E3	47.4	177.1	EX 42" OR	DP21	PUBLIC
E4	10.4	51.1	EX 48" CDF	DP22	PUBLIC

Include PR639 in storm sewer summary. Unresolved.



File: C:\18001A-Crossroads\Colorado Springs Equities LLC\Drainage\EXISTING MDDP Map.dwg PlotDate: 1/20/2022 4:08 PM

CROSSROADS NORTH MDDP

COUNTY OF EL PASO, STATE OF COLORADO

PROPOSED DRAINAGE MAP

MARCH 2022

LEGEND

- PROPOSED SWALE
- PROPOSED FLOW DIRECTION ARROW
- EXISTING FLOW DIRECTION ARROW
- EMERGENCY OVERTFLOW DIRECTION
- EXISTING RIPRAP TYP.
- EXISTING UTILITY POLE
- EX. IRRIGATION VALVE
- EX. STORM INLET
- EX. GAS TEST NODE
- EX. TRAFFIC SIGNAL CONTROL BOX
- EX. ELECTRIC VAULT
- EX. SANITARY MANHOLE
- EX. WATER VALVE
- EXISTING WATER WELL
- EXISTING TELEPHONY WELL
- EX. MONITORING VAULT
- EX. ELECTRIC VAULT
- EX. FIBER OPTIC MANHOLE
- EX. ELECTRIC PEDESTAL
- EX. WATER MARKER
- EX. GAS MARKER
- EX. FIBER OPTIC MARKER
- EX. CABLE TV MARKER
- EX. SHRUB/TREE
- EX. WATER YARD HYDRANT
- EX. STORM INLET
- EX. ELECTRIC BOX
- EX. FIRE HYDRANT
- EX. ELECTRIC MARKER
- EX. TRAFFIC SIGNAL
- EX. ELECTRIC PEDESTAL
- EX. ELECTRIC METER
- EX. ELECTRIC TRANSFORMER
- EX. TELEPHONE PEDESTAL

Provide an exhibit or show the City/County limits on the drainage map. County approval is only for the portion located within the unincorporated El Paso County jurisdictional boundary. The other portion of the drainage report is approved by the City.

Contact the City regarding how they want to approve the drainage/improvements located within their City limits. Will their signature block be included in this report for the City portion or is a separate drainage report being prepared and approved by the City? Add a section in the narrative to explain how different areas shown on the drainage map will be processed/approved by the City of Colorado Springs.


BASIN	AREA (ACRES)	Q ₅	Q ₁₀₀
A	10.42	43.2	78.8
B	8.21	31.6	57.6
C	6.38	26.6	48.4
D	2.70	1.6	8.9
E	1.72	0.8	4.6
F	10.92	36.2	66.0
G	3.97	15.9	29.0
H	7.98	2.3	16.5
I	1.62	0.8	4.3
J	8.90	4.9	21.1
K	8.52	5.2	22.6
L	0.83	0.6	3.1
M	8.02	2.2	16.4
OS-1	5.86	1.6	11.9
RD-1	4.42	8.2	16.6
RD-2	2.40	0.7	5.3
RD-3	0.82	0.3	2.0
RD-4	1.39	0.4	2.9
RD-5	1.36	0.5	3.4
OS-2	0.35	1.6	2.9
OS-3	0.72	2.8	5.0
OS-4	1.41	4.9	8.8
631R*	0.56	2.4	4.2
632L*	1.21	4.5	8.1
637R*	0.91	3.1	5.5
641L*	1.58	5.8	10.4
646R*	0.75	3.5	6.2
654R*	1.62	7.1	12.8
661L*	0.07	0.3	0.6
662L*	1.21	5.6	10.0
664R*	1.09	5.1	9.1

DESIGN POINT	Q ₅	Q ₁₀₀	BASIN/DP/PR	STRUCTURE
1	5.1	9.1	664R	EX 5' CDDOT TYPE R INLET
2	5.6	10.0	662L	EX 5' CDDOT TYPE R INLET
3	2.9	6.7	FR664, PR662, PR661	EX 5' CDDOT TYPE R INLET
4	9.8	27.5	FR664, PR662, PR661	EX 5' BTM EARTH TRAP CHANNEL
5	10.3	21.6	FR664, PR662, PR661	EX 5' CDDOT TYPE R INLET
6	12.3	29.3	DP4, PR654	EX 5' BTM EARTH TRAP CHANNEL
7	43.2	78.8	BASIN A	PROP PRIVATE 42" RCP STORM SEWER
8	26.6	48.4	BASIN C	PROP PRIVATE 18" RCP STORM SEWER
9	101.3	190.5	Basin D, DP7, DP8, DP13	PROP PRIVATE 18" RCP STORM SEWER
10	13.9	34.7	BASIN RD-3, DP6	DUAL 24" PUBLIC RCP CULVERTS
11	7.9	18.1	FR664, PR654	EX 5' CDDOT TYPE R INLET
12	15.2	34.0	PR646, PR-DP10	EX 5' BTM EARTH TRAP CHANNEL
13	5.8	10.4	641L	EX 5' CDDOT TYPE R INLET
14	31.6	57.6	BASIN B	PROP PRIVATE 42" RCP STORM SEWER
15	36.2	66.0	BASIN F	PROP PRIVATE 42" RCP STORM SEWER
16	37.0	70.6	BASIN E, F1	PROP PRIVATE 18" RCP STORM SEWER
17	15.4	48.5	PR640, DP12, DP16, DP9	EX PUBLIC 42" CULVERT
18	5.9	14.5	FR664, 637R	EX 5' CDDOT TYPE R INLET
19	16.9	48.4	PR639, PR636	EX 5' BTM EARTH TRAP CHANNEL
20	5.2	22.6	BASIN K	PROP PRIVATE 30" RCP STORM SEWER
21	6.2	27.2	DP20, BASIN L	PROP PRIVATE 18" RCP STORM SEWER (POND 4)
22	4.0	11.7	FR636, 631R	EX 5' CDDOT TYPE R INLET
23	5.9	11.6	FR640, 632L	EX 5' CDDOT TYPE R INLET
24	15.1	44.5	DP19, RD-5	EX CDDOT TYPE C AREA INLET W/RRRAP BYPASS RUNDOWN AND PUBLIC 24" RCP CULVERT
25	1.0	3.3	OS-2, FR630B	EX 12" PUBLIC PLASTIC CDDOT PIPE
26	17.4	26.8	E1, E2, PR630B	EX WQ POND
27	23.4	50.9	DP26, OS-3, M, LI	EX 42" PUBLIC CMP CULVERT
28	8.2	16.6	RD-1	TRIANGULAR, EARTHEN CDDOT DITCH
29	6.5	15.7	RD-2, DP28	TRIANGULAR, EARTHEN CDDOT DITCH
30	15.9	29.0	G	PROP PRIVATE 30" RCP STORM SEWER
31	4.9	21.1	J	PROP PRIVATE 30" RCP STORM SEWER
32	23.2	62.6	L, DP30, DP31	PROP PRIVATE 18" RCP STORM SEWER (POND 3)
33	10.2	34.1	H, OS-4, I, DP29	EX PUBLIC 48" CMP CULVERT

*BASIN GEOMETRY AND RUNOFF COEFFICIENTS TAKEN FROM MARKSHEFFEL ROAD SOUTH FDR

PIPE RUN	Q ₅	Q ₁₀₀	PIPE SIZE	CONTRIBUTING PIPES/DP
664	2.7	3.4	EX 24" RCP	DP1
662	3.0	3.8	EX 24" RCP	DP2
661	1.9	3.2	EX 18" RCP	DP3
654	4.0	5.4	EX 18" RCP	DP5
646	3.4	4.7	EX 18" RCP	DP11
640	2.9	3.8	EX 24" RCP	DP13
638	3.0	4.3	EX 24" RCP	DP18
630A	2.5	4.1	EX 24" RCP	DP22
630B	5.9	10.3	EX 24" RCP	DP23
E1	1.0	3.3	EX 12" CORR. PLASTIC	DP25
E2	15.0	19.9	EX 24" RCP	DP24
E3	23.4	50.9	EX 42" CMP	DP27
E4	10.2	34.1	EX 48" CMP	DP33
A1	43.2	78.8	PROP 42" RCP	DP7
B1	31.6	57.6	PROP 42" RCP	DP14
C1	25.2	45.9	PROP 36" RCP	DP8
D1	1.4	17.8	PROP 18" RCP	DP9
F1	36.2	66.0	PROP 42" RCP	DP15
641	0.5	7.8	PROP 18" RCP	DP16
G1	15.9	29.0	PROP 30" RCP	DP30
J1	4.9	21.1	PROP 30" RCP	DP31
I1	0.2	9.8	PROP 24" RCP	DP32
K1	5.2	22.6	PROP 30" RCP	DP20
LI	0.0	5.6	PROP 18" RCP	DP21
PR-DP10	13.9	34.7	DUAL 24" RCP	DP10

CROSSROADS NORTH PROPOSED DRAINAGE MAP
DATE SUBMITTED: 03/24/2022
SHEET 1 OF 1

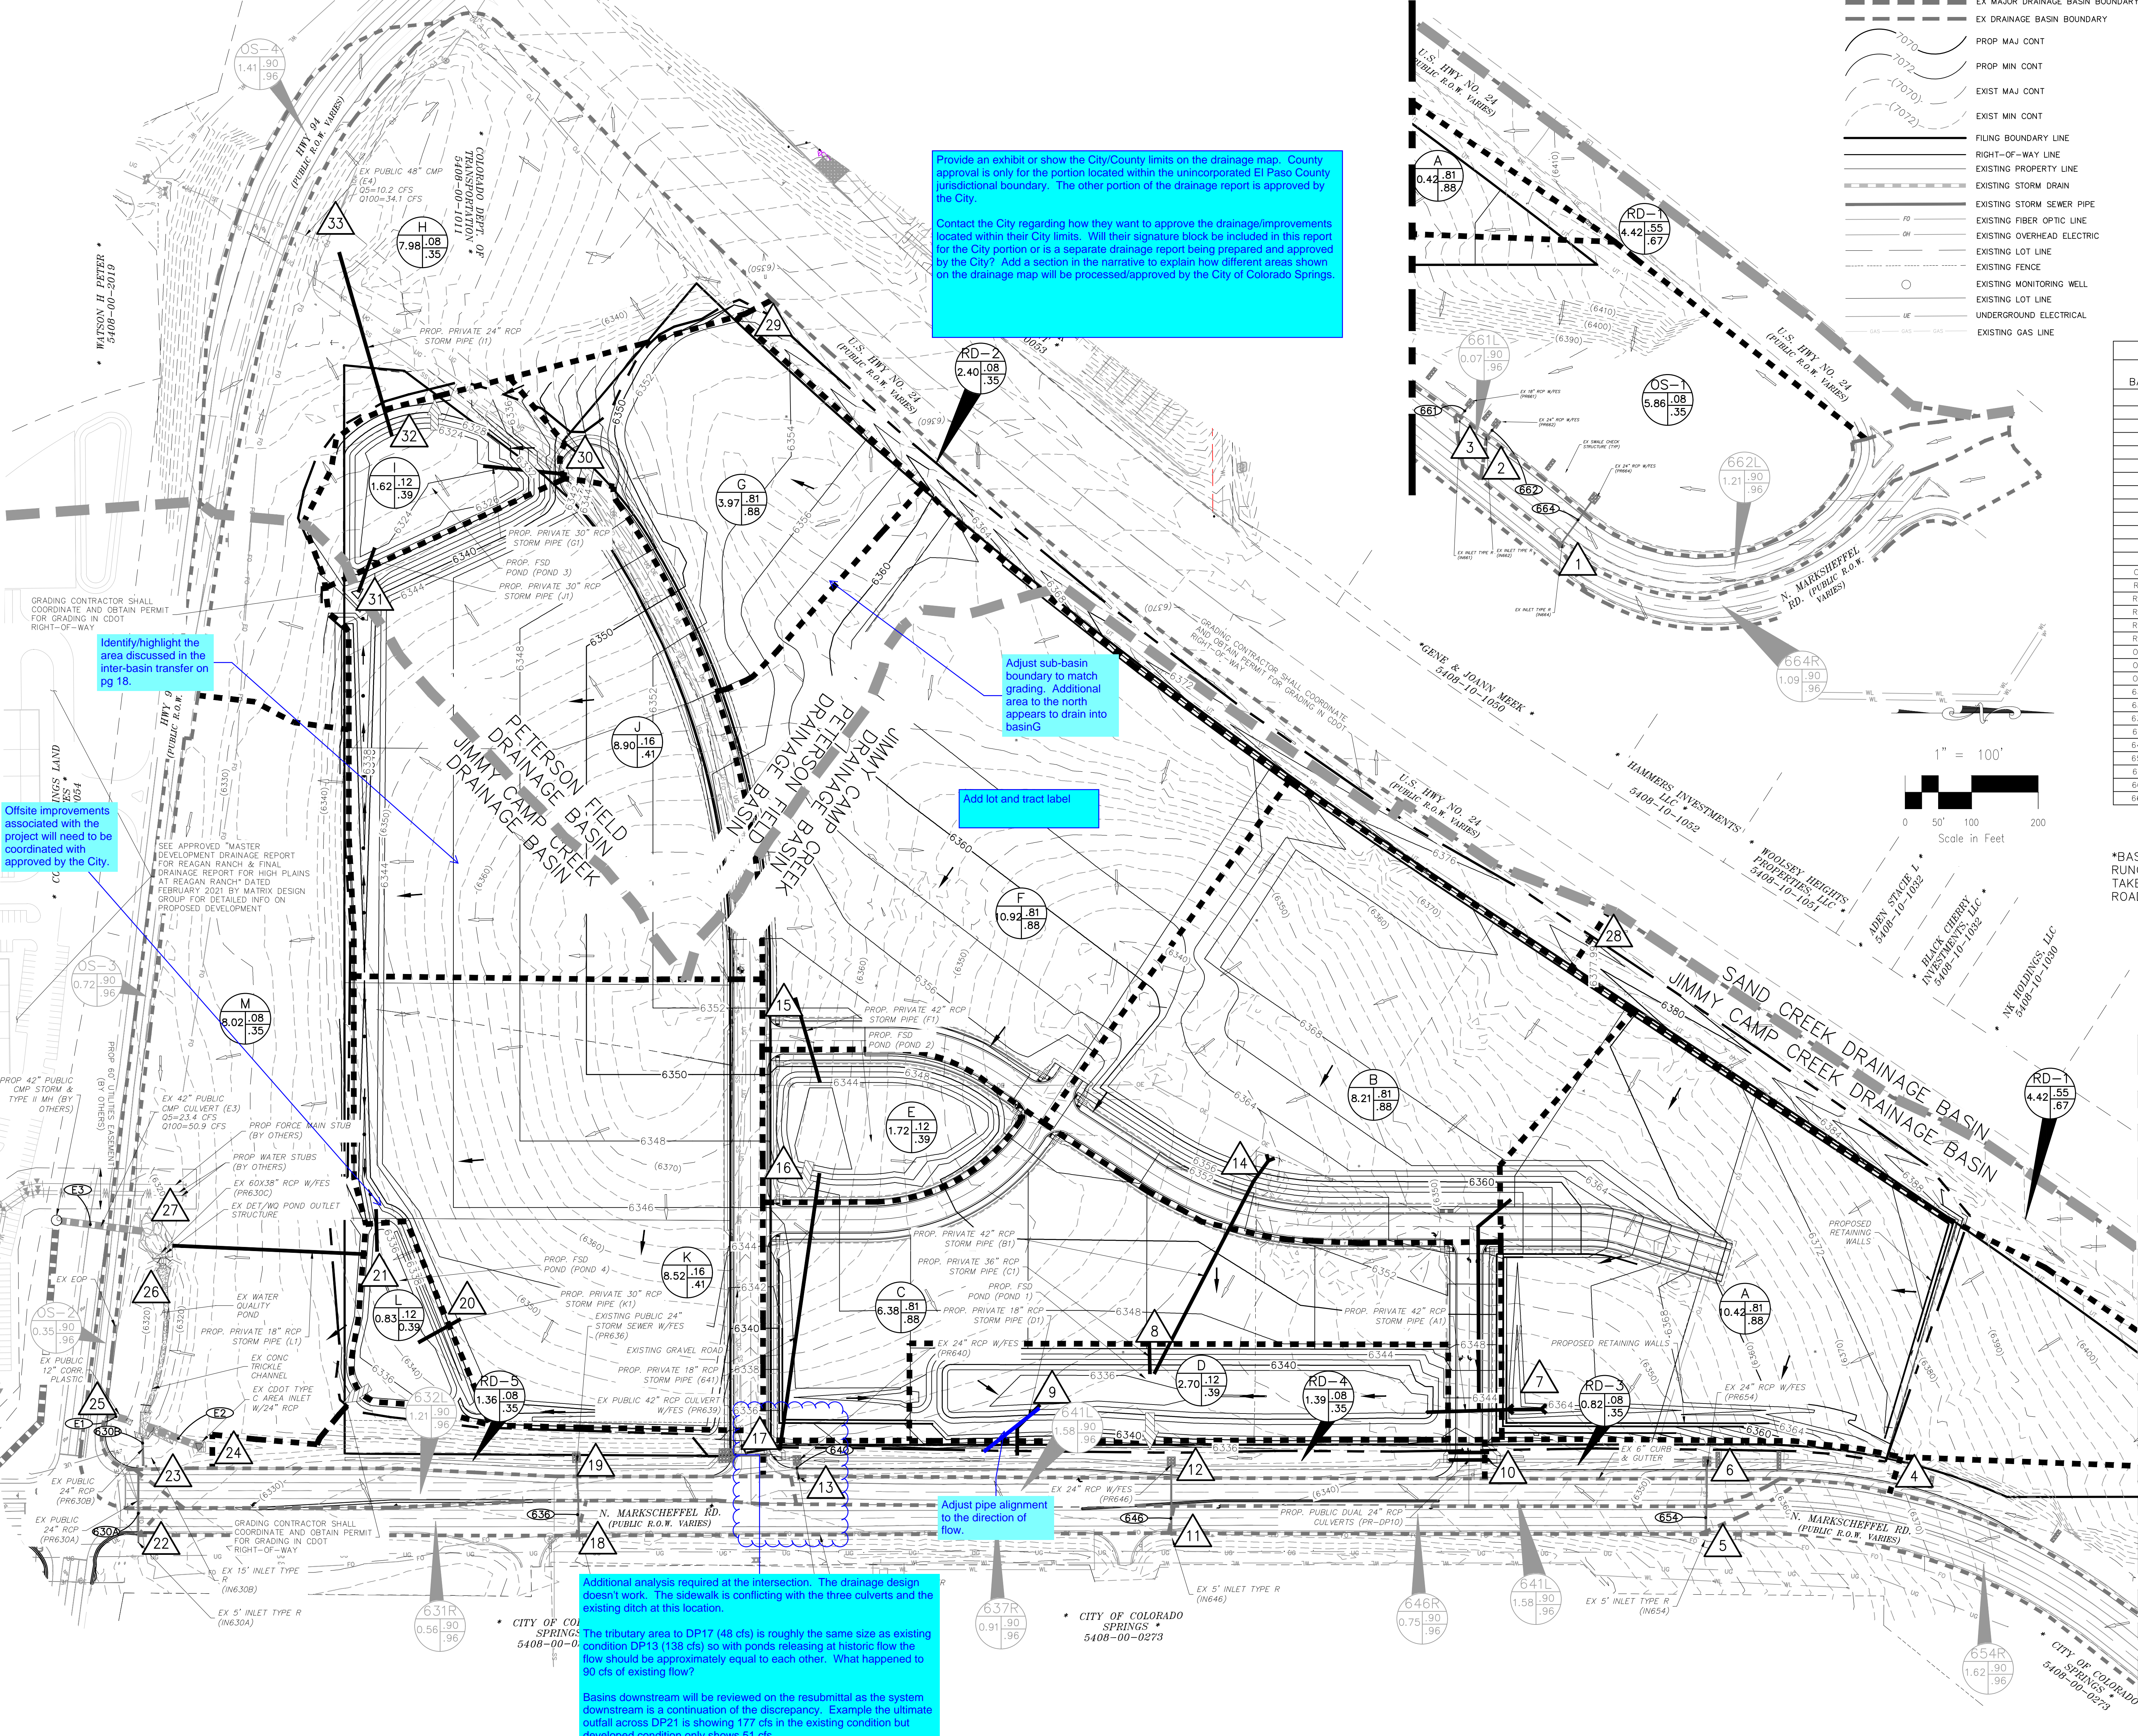

Identify/highlight the area discussed in the inter-basin transfer on pg 18.

Offsite improvements associated with the project will need to be coordinated with approved by the City.

Adjust sub-basin boundary to match grading. Additional area to the north appears to drain into basin G.

Add lot and tract label.

Adjust pipe alignment to the direction of flow.


Additional analysis required at the intersection. The drainage design doesn't work. The sidewalk is conflicting with the three culverts and the existing ditch at this location.

The tributary area to DP17 (48 cfs) is roughly the same size as existing condition DP13 (438 cfs) so with ponds releasing at historic flow the flow should be approximately equal to each other. What happened to 90 cfs of existing flow?

Basins downstream will be reviewed on the resubmittal as the system downstream is a continuation of the discrepancy. Example the ultimate outfall across DP21 is showing 177 cfs in the existing condition but developed condition only shows 51 cfs.


Drainage Report - Preliminary_v2 redline.pdf Markup Summary

dsdlaforce (27)

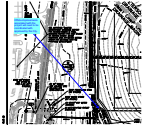


Subject: Callout
Page Label: [1] PCM (3)
Author: dsdlaforce
Date: 6/23/2022 1:01:05 PM
Status:
Color: ■
Layer:
Space:

Offsite improvements associated with the project will need to be coordinated with approved by the City.

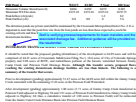

Subject: Callout
Page Label: 18
Author: dsdlaforce
Date: 6/23/2022 1:24:01 PM
Status:
Color: ■
Layer:
Space:

Staff is verifying process/requirements for basin transfers and the associated drainage fee. Additional guidance will be provided on the resubmittal.

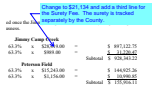


Subject: Callout
Page Label: 19
Author: dsdlaforce
Date: 6/23/2022 1:30:27 PM
Status:
Color: ■
Layer:
Space:

Change to \$21,134 and add a third line for the Surety Fee. The surety is tracked separately by the County.




Subject: Callout
Page Label: 1
Author: dsdlaforce
Date: 6/23/2022 10:56:36 AM
Status:
Color: ■
Layer:
Space:

and Preliminary Drainage Report
Unresolved.

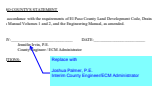


Subject: Callout
Page Label: 2
Author: dsdlaforce
Date: 6/23/2022 10:57:25 AM
Status:
Color: ■
Layer:
Space:

Replace with
Joshua Palmer, P.E.
Interim County Engineer/ECM Administrator

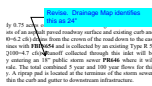


Subject: Callout
Page Label: 8
Author: dsdlaforce
Date: 6/23/2022 11:09:09 AM
Status:
Color: ■
Layer:
Space:


Revise. Drainage Map identifies this as 24"

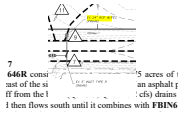

Subject: Image
Page Label: 8
Author: dsdlaforce
Date: 6/23/2022 11:09:36 AM
Status:
Color: ■
Layer:
Space:

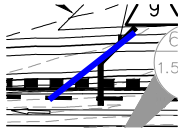

Subject: Line
Page Label: [1] PCM (3)
Author: dsdlaforce
Date: 6/23/2022 11:14:01 AM
Status:
Color: ■
Layer:
Space:

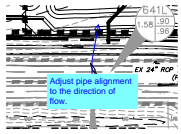

Subject: Callout
Page Label: [1] PCM (3)
Author: dsdlaforce
Date: 6/23/2022 11:14:47 AM
Status:
Color: ■
Layer:
Space:

Adjust pipe alignment to the direction of flow.



Subject: Text Box
Page Label: [1] PCM (3)
Author: dsdlaforce
Date: 6/23/2022 2:13:28 PM
Status:
Color: ■
Layer:
Space:

Provide an exhibit or show the City/County limits on the drainage map. County approval is only for the portion located within the unincorporated El Paso County jurisdictional boundary. The other portion of the drainage report is approved by the City.

Contact the City regarding how they want to approve the drainage/improvements located within their City limits. Will their signature block be included in this report for the City portion or is a separate drainage report being prepared and approved by the City? Add a section in the narrative to explain how different areas shown on the drainage map will be processed/approved by the City of Colorado Springs.

ge Map (See Appendix) are subject to
wever, this MDDP should be used as a
ention Pond sizing. Care will be taken
potary drainage conditions.

and PDR

Subject: Callout
Page Label: 19
Author: dsdlaforce
Date: 6/23/2022 2:16:11 PM
Status:
Color: ■
Layer:
Space:

and PDR




Subject: Callout
Page Label: 46
Author: dsdlaforce
Date: 6/23/2022 2:19:44 PM
Status:
Color: ■
Layer:
Space:

Flows exceed allowable ranges. Revise so that ratio of flows is 1.0
Unresolved. Full spectrum will require release at or below historic. Typical for all ponds.



Subject: Text Box
Page Label: 53
Author: dsdlaforce
Date: 6/23/2022 2:22:43 PM
Status:
Color: ■
Layer:
Space:

Hydraulic analysis will be reviewed and finalized with the Final Drainage Report that will be submitted with the subsequent application.

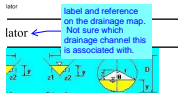


Subject: Callout
Page Label: 53
Author: dsdlaforce
Date: 6/23/2022 2:23:56 PM
Status:
Color: ■
Layer:
Space:

label and reference on the drainage map. Not sure which drainage channel this is associated with.



Subject: Callout
Page Label: [1] ECM
Author: dsdlaforce
Date: 6/23/2022 2:28:25 PM
Status:
Color: ■
Layer:
Space:

Fix flow arrows.

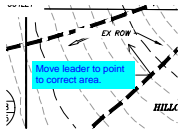


Subject: Callout
Page Label: [1] ECM
Author: dsdlaforce
Date: 6/23/2022 2:28:42 PM
Status:
Color: ■
Layer:
Space:

Move leader to point to correct area.



Subject: Callout
Page Label: [1] ECM
Author: dsdlaforce
Date: 6/23/2022 2:29:52 PM
Status:
Color: ■
Layer:
Space:


Show missing contours throughout plans.

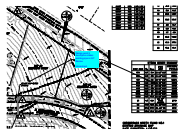

Subject: Callout
Page Label: [1] ECM
Author: dsdlaforce
Date: 6/23/2022 2:31:27 PM
Status:
Color: ■
Layer:
Space:

Design point 5 description states existing pipe is 24". Revise.


Unresolved.

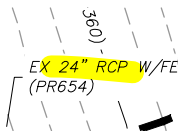

Subject: Highlight
Page Label: [1] ECM
Author: dsdlaforce
Date: 6/23/2022 2:31:32 PM
Status:
Color: ■
Layer:
Space:

EX 18" RCP
EX 18" RCP
EX 24" RCP

Subject: Highlight
Page Label: [1] ECM
Author: dsdlaforce
Date: 6/23/2022 2:31:34 PM
Status:
Color: ■
Layer:
Space:

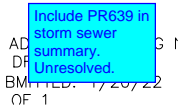


Subject: Text Box
Page Label: [1] ECM
Author: dsdlaforce
Date: 6/23/2022 2:31:50 PM
Status:
Color: ■
Layer:
Space:

Include PR639 in storm sewer summary.
Unresolved.



Subject: Text Box
Page Label: [1] PCM (3)
Author: dsdlaforce
Date: 6/23/2022 2:33:33 PM
Status:
Color: ■
Layer:
Space:

Add lot and tract label

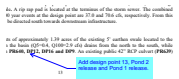


Subject: Callout
Page Label: 13
Author: dsdlaforce
Date: 6/23/2022 2:58:47 PM
Status:
Color: ■
Layer:
Space:

Add design point 13, Pond 2 release and Pond 1 release.



Subject: Callout
Page Label: [1] PCM (3)
Author: dsdlaforce
Date: 6/23/2022 3:03:03 PM
Status:
Color: ■
Layer:
Space:

Identify/highlight the area discussed in the inter-basin transfer on pg 18.

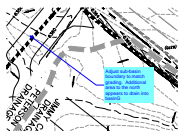

Subject: Callout
Page Label: [1] PCM (3)
Author: dsdlaforce
Date: 6/23/2022 3:04:31 PM
Status:
Color: ■
Layer:
Space:

Adjust sub-basin boundary to match grading. Additional area to the north appears to drain into basinG



Subject: Callout
Page Label: 14
Author: dsdlaforce
Date: 6/23/2022 3:09:26 PM
Status:
Color: ■
Layer:
Space:

See comment on the previous page. Explain the large discrepancy between existing flow and proposed flow.



Subject: Cloud+
Page Label: [1] PCM (3)
Author: dsdlaforce
Date: 6/23/2022 3:18:08 PM
Status:
Color: ■
Layer:
Space:

Additional analysis required at the intersection. The drainage design doesn't work. The sidewalk is conflicting with the three culverts and the existing ditch at this location.

The tributary area to DP17 (48 cfs) is roughly the same size as existing condition DP13 (138 cfs) so with ponds releasing at historic flow the flow should be approximately equal to each other. What happened to 90 cfs of existing flow?

Basins downstream will be reviewed on the resubmittal as the system downstream is a continuation of the discrepancy. Example the ultimate outfall across DP21 is showing 177 cfs in the existing condition but developed condition only shows 51 cfs.