


MARKSHEFFEL ROAD

CL

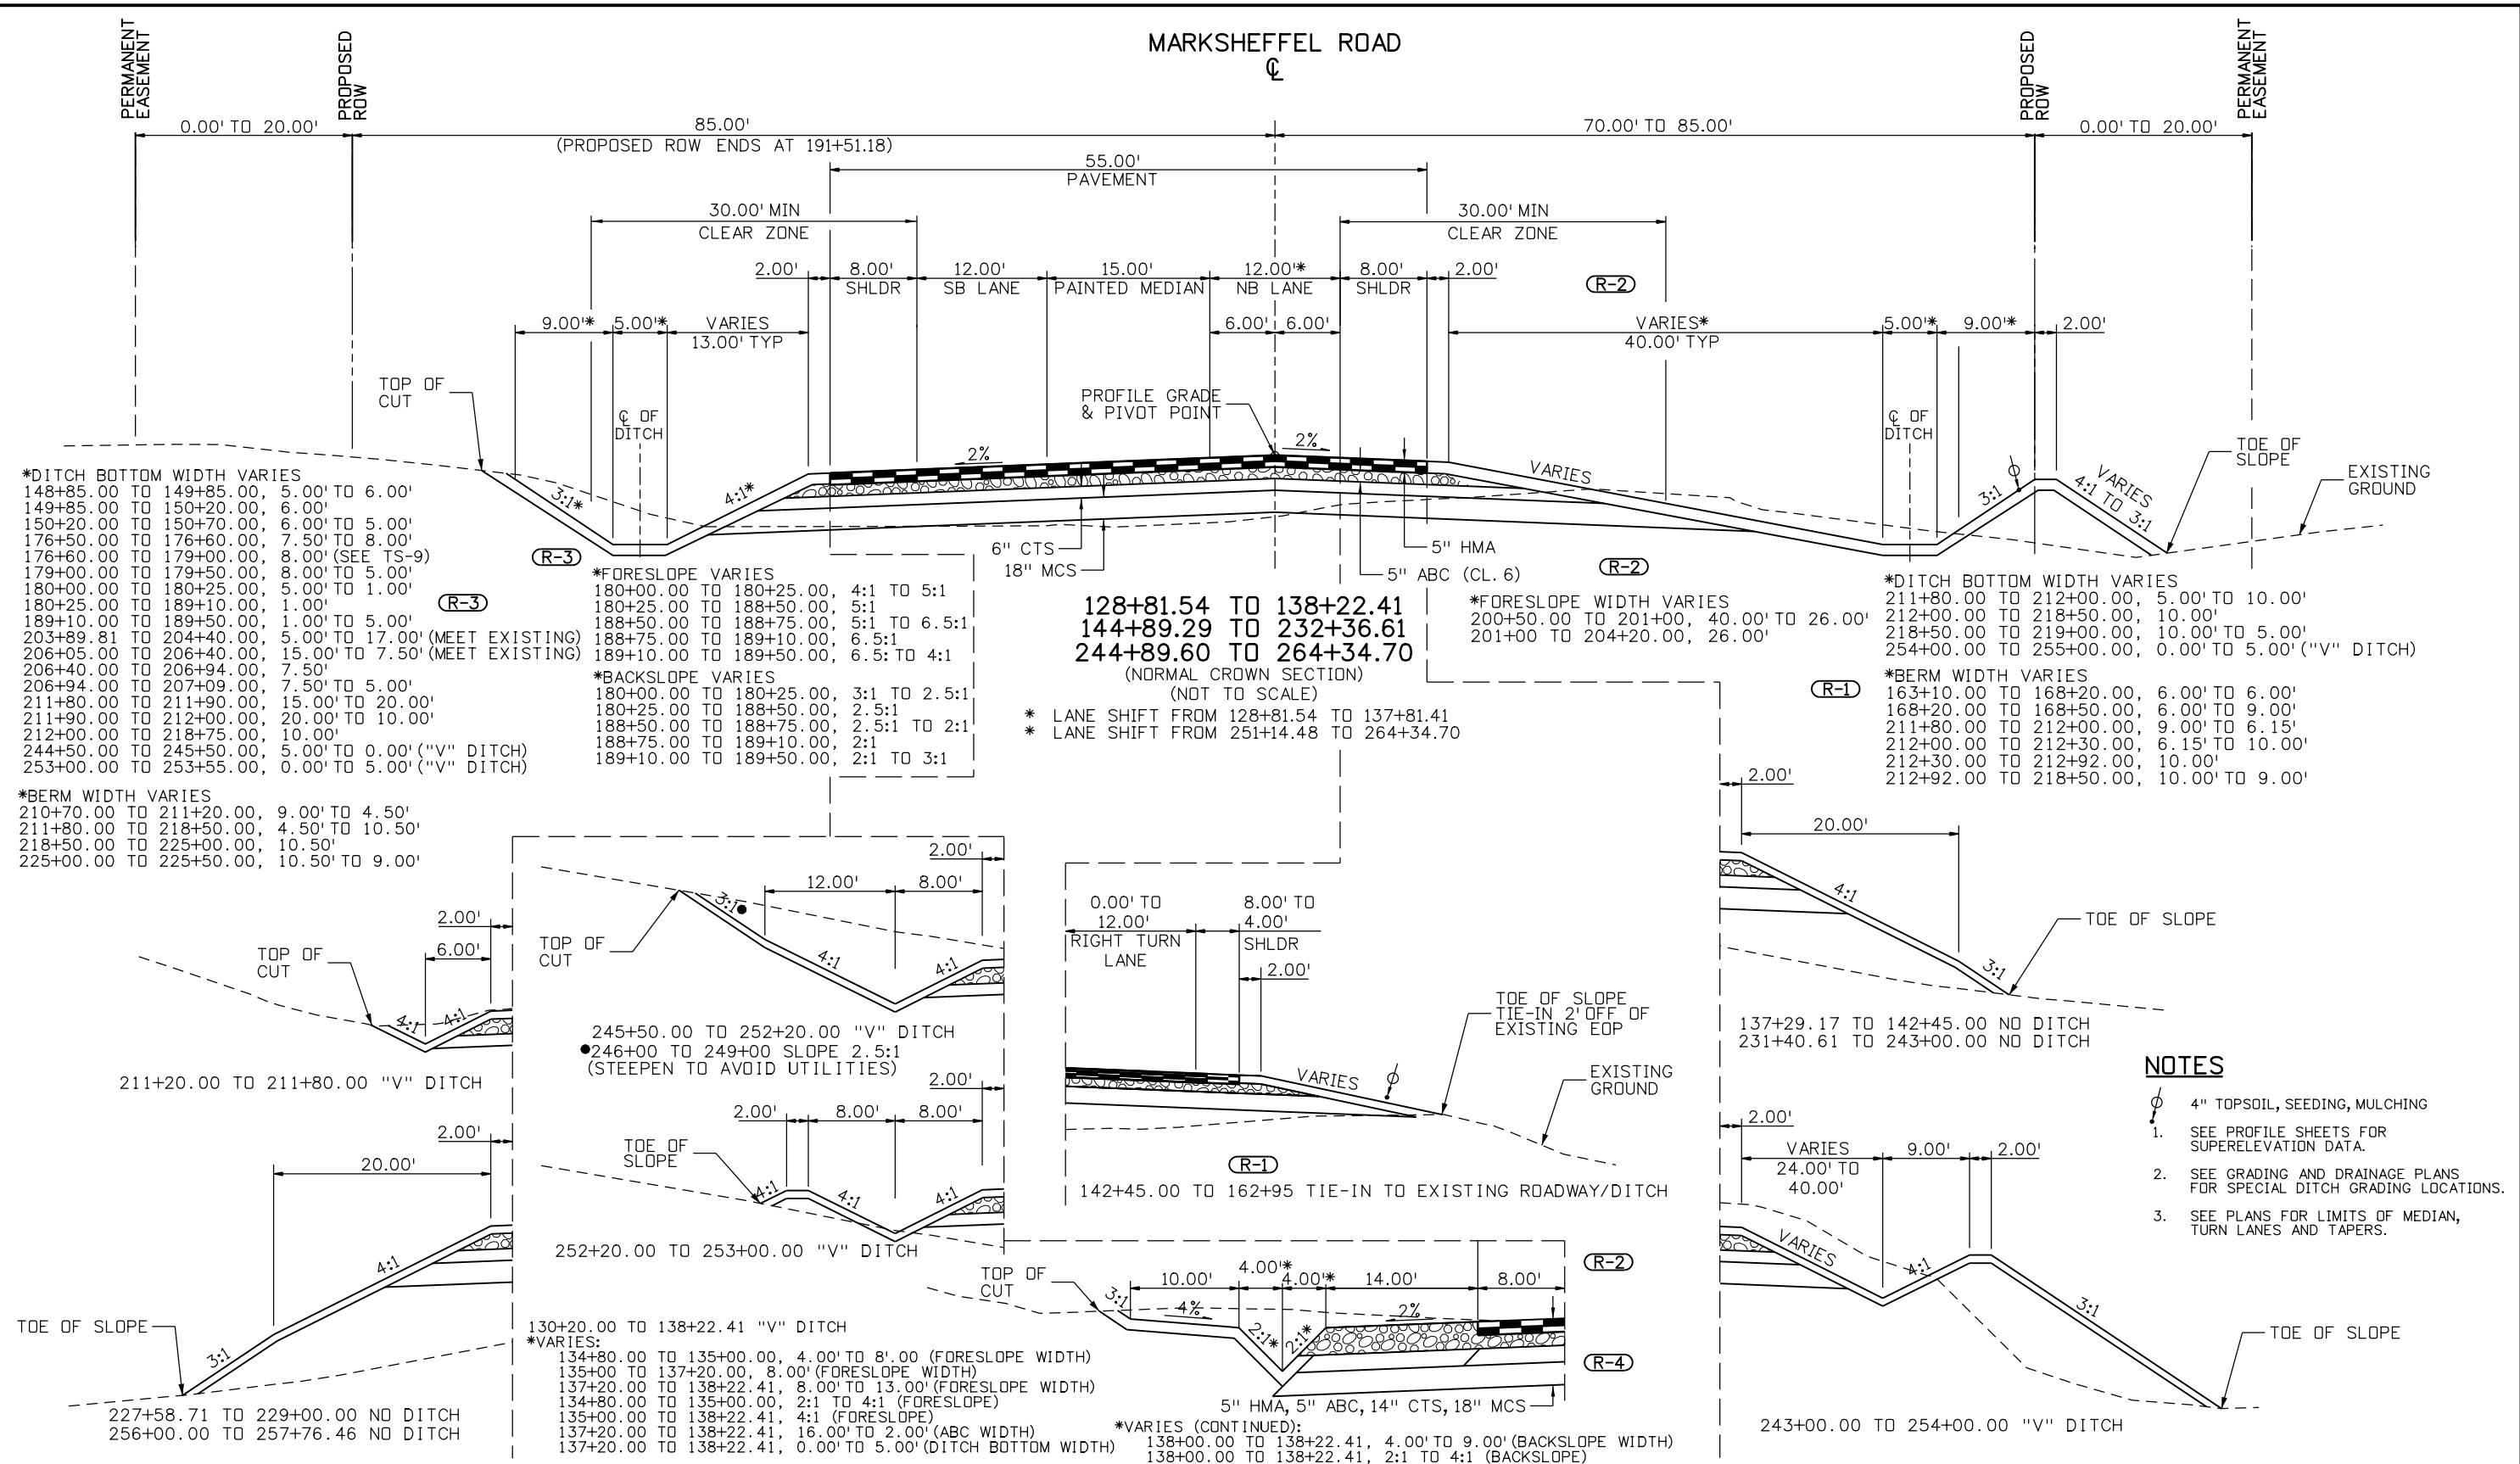

NOTES

- 1. SEE PROFILE SHEETS FOR SUPERELEVATION DATA.
- 2. SEE GRADING AND DRAINAGE PLANS FOR SPECIAL DITCH GRADING LOCATIONS.
- 3. SEE PLANS FOR LIMITS OF MEDIAN, TURN LANES AND TAPERS.

Print Date: 12/4/2017

File Name: South-Marksheffel_DES_Typ005.dgn

Horiz. Scale: 1:15 Vert. Scale: As Noted

Unit Information Unit Leader Initials

PARSONS BRINCKERHOFF

Sheet Revisions			
Date:	Comments	Init.	
12/18/15	Slope line adjusted to eliminate tree removal	CEM	(R-1)
3/16/16	Ditch modifications	CEM	(R-2)
4/18/16	Ditch modifications	CEM	(R-3)
11/14/16	Full depth right-turn lane	CEM	(R-4)

EL PASO COUNTY COLORADO

PPRTA

As Constructed

No Revisions: 07/24/2017

Revised:

Void:

MARKSHEFFEL ROAD TYPICAL SECTION 128+81.54 TO 264+34.70

Designer: BM Structure

Detailer: CM Numbers

Sheet Subset: TYPICALS Subset Sheets: of

Project No./Code

Sheet Number TS-5