

SF 01005
2645



SUNSET VILLAGE FILING NO. 4

CONSTRUCTION PLANS

1

Contacts List:

El Paso County Planning and Community Development
Gilbert LaForce, PE
719-520-7945
gilbertlaforce@elpasoco.com

Ryan Howser
719-520-6049; ryanhowser@elpasoco.com

Owner/Developer
Scott Van Whye
Sunset Village View, LLC.
303-519-5100

Civil Engineer
Richard Lyon, PE
Atwell, LLC.
rlyon@atwell-group.com

Per the County Attorney's Office, a Condition of Approval will be included with the Construction Plans.


Approval will be limited to Phase 1 improvements only.

The Construction Plans will need to be resubmitted for review/approval once the Developer intends to proceed with Phase 2.

Financial Assurances for Phase 2 improvements will be required at that time.

2

**CONSTRUCTION DRAWINGS AMENDMENT,
DATED APRIL 4, 2026 BY ENGINEERING LOCAL
XPRTS, LLC.**

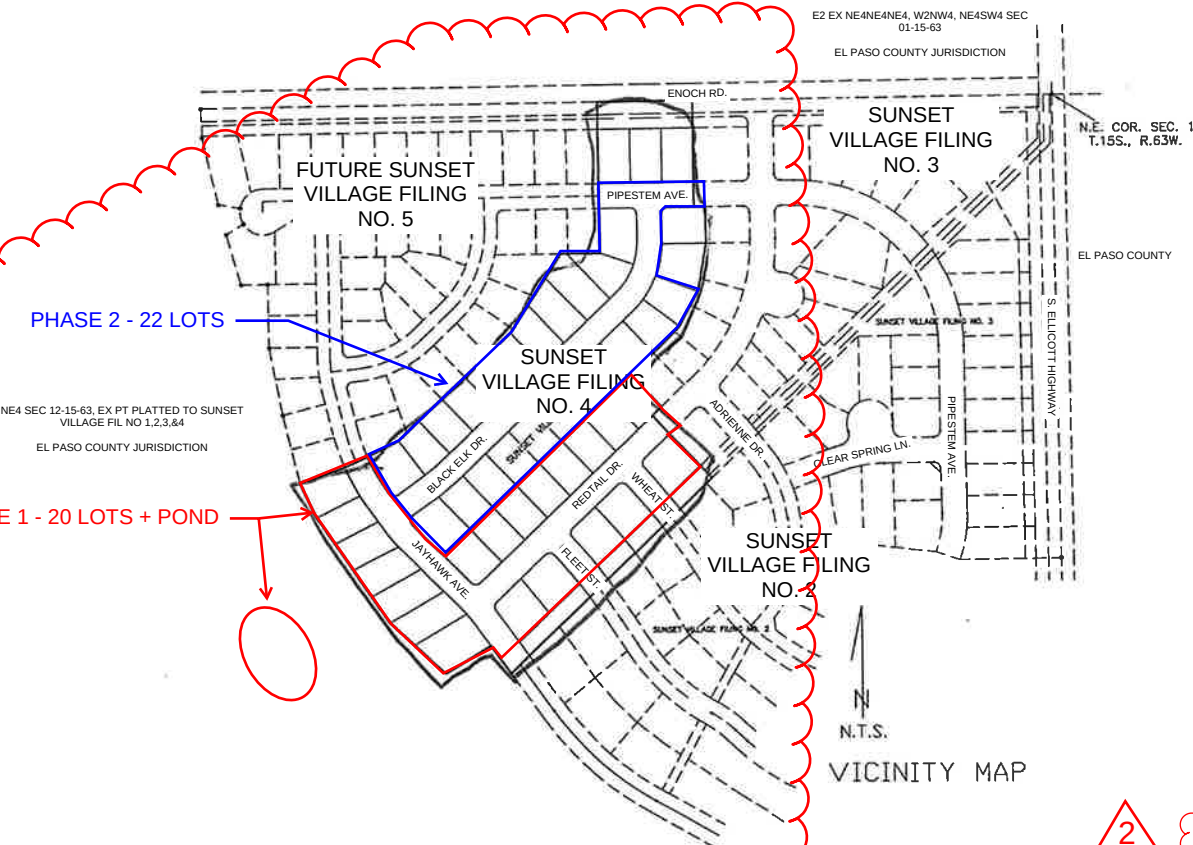

INDEX

- 1) COVER SHEET
- 2) GENERAL NOTES AND DETAILS
- 3) STREET & SANITARY SEWER PLAN (PIPESTEM)
- 4) STREET & SANITARY SEWER PLAN (REDTAIL DRIVE)
- 5) STREET & SANITARY SEWER PLAN (BLACK ELK DRIVE)
- 6) STREET & SANITARY SEWER PLAN (JAYHAWK AVE.)
- 7) STREET PLAN (WHEAT DRIVE)
- 8) STREET PLAN (FLEET STREET)
- 9) STREET PLAN (ENOCH ROAD)
- 10) UTILITY PLAN
- D-1) DEVELOPED DRAINAGE AND EROSION CONTROL PLAN
- D-2) STORM DRAIN PLAN AND PROFILE
- D-3) DETENTION POND PLAN AND DETAILS
- HW-1) ELLICOTT HIGHWAY IMPROVEMENT PLAN AND PROFILE

- 15) SIGNAGE AND STRIPING PLAN
- 16) CDOT S-614-1 DETAILS
- 17) POND PLAN
- 18) POND DETAILS
- 19) POND DETAILS
- 20) REVISED FOREBAY DETAILS
- 21) REVISED OUTLET STRUCTURE DETAILS
- 22) REVISED OUTLET STRUCTURE DETAILS
- 23) DETAILS
- 24) DETAILS
- 25) DETAILS

THE FOLLOWING STANDARD DETAILS ARE INCLUDED IN THIS PLAN SET:

- EL PASO COUNTY DETAILS:
- EPC DETAIL SD_2-20 TYPICAL CURB AND GUTTER
 - EPC DETAIL SD_2-26 TYPICAL CROSS PAN LAYOUT
 - EPC DETAIL SD_2-41 PEDESTRIAN INTERSECTION RAMP
 - EPC DETAIL SD_2-42 DETECTABLE WARNING SURFACE
 - EPC DETAIL SD_2-50 PARALLEL PEDESTRIAN CURB RAMP

EROSION CONTROL MEASURES:

- CONCRETE WASHOUT AREA
- VEHICLE TRACKING CONTROL
- ROCK SOCKS
- INLET PROTECTION
- SEEDING AND MULCHING
- STRAW BALE BARRIER / CHECK DAM
- SILT FENCE

UNITED

ENGINEERING

PLANNING

4575 GALLEY ROAD SUITE 200
COLORADO SPRINGS COLORADO
(719) 597-9900 80915

PROJECT 00-0908 DATE 10-08-01 DRAWN J.L.K.

SHEET 1 OF 22

MODIFIED FOR S.I.A. CD SET
RICHARD D. LYON, PE
ATWELL, LLC
DECEMBER, 2021
EPC PROJ.: CDR-21-008

REVISION 1: 01/07/2022
COR218 REVISION 2 (ELX
JULY 2026)

ENGINEER'S STATEMENT:

THESE DETAILED PLANS AND SPECIFICATIONS WERE PREPARED UNDER MY DIRECTION AND SUPERVISION. SAID DETAILED PLANS AND SPECIFICATIONS HAVE BEEN PREPARED ACCORDING TO THE CRITERIA ESTABLISHED BY THE COUNTY FOR DETAILED DRAINAGE PLANS AND SPECIFICATIONS, AND SAID DETAILED PLANS AND SPECIFICATIONS ARE IN CONFORMITY WITH THE MASTER PLAN OF THE DRAINAGE BASIN. SAID DETAILED PLANS AND SPECIFICATIONS MEET THE PURPOSE FOR WHICH THE PARTICULAR DRAINAGE FACILITIES ARE DESIGNED. I ACCEPT RESPONSIBILITY FOR ANY LIABILITY CAUSED BY ANY NEGLIGENT ACTS, ERRORS OR OMISSIONS ON MY PART IN PREPARATION OF THE DETAILED DRAINAGE PLANS AND SPECIFICATIONS.

JOHN P. SCHWAB, P.E. NO. 29891



DISCLAIMER:

COUNTY PLAN REVIEW IS PROVIDED ONLY FOR GENERAL CONFORMANCE WITH THE COUNTY DESIGN CRITERIA. THE COUNTY IS NOT RESPONSIBLE FOR THE ACCURACY AND ADEQUACY OF THE DESIGN, DIMENSIONS, AND/OR ELEVATIONS WHICH SHALL BE CONFIRMED AT THE JOB SITE. THE COUNTY THROUGH THE APPROVAL OF THIS DOCUMENT ASSUMES NO RESPONSIBILITY FOR COMPLETENESS AND/OR ACCURACY OF THIS DOCUMENT.

Engineer's Statement:

These detailed plans and specifications were prepared under my direction and supervision. Said plans and specifications have been prepared according to the criteria established by the County for detailed roadway, drainage, grading and erosion control plans and specifications, and said plans and specifications are in conformity with applicable master drainage plans and master transportation plans. Said plans and specifications meet the purposes for which the particular roadway and drainage facilities are designed and are correct to the best of my knowledge and belief. I accept responsibility for any liability caused by any negligent acts, errors or omissions on my part in preparation of these detailed plans and specifications.

Richard Lyon, P.E. 01-07-2022
Richard Lyon, P.E. 165921 Date

Owner/Developer's Statement:

I, the owner/developer have read and will comply with all of the requirements of the grading and erosion control plan and all of the requirements specified in these detailed plans and specifications.

Scott Van Whye 01-07-2022
Scott Van Whye, President Date
Sunset Village View, LLC.
300 Windchime Pl #301 Colorado Springs, CO

El Paso County:

County plan review is provided only for general conformance with County Design Criteria. The County is not responsible for the accuracy and adequacy of the design, dimensions, and/or elevations which shall be confirmed at the job site. The County through the approval of this document assumes no responsibility for completeness and/or accuracy of this document.

Filed in accordance with the requirements of the El Paso County Land Development Code, Drainage Criteria Manual, Volumes 1 and 2, and Engineering Criteria Manual as amended.

In accordance with ECM Section 1.12, these construction documents will be valid for construction for a period of 2 years from the date signed by the El Paso County Engineer. If construction has not started within those 2 years, the plans will need to be resubmitted for approval, including payment of review fees at the Planning and Community Development Directors discretion.

Jennifer Irvine, P.E.
County Engineer / ECM Administrator Date

DEVELOPER'S STATEMENT:

I, RODNEY PRIESSER, THE DEVELOPER HAS READ AND WILL COMPLY WITH ALL OF THE REQUIREMENTS SPECIFIED IN THIS DRAINAGE REPORT AND PLAN.

BY: *[Signature]*





TITLE: OWNER
ADDRESS: 90 S. CASCADE AVE. # 950
COLORADO SPRINGS, CO. 80903

EL PASO COUNTY:


FILED IN ACCORDANCE WITH SECTION 51.1 OF THE EL PASO COUNTY LAND DEVELOPMENT CODE, AS AMENDED.

12-19-01
DATE

CONDITIONS:

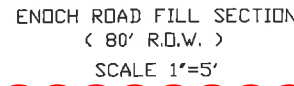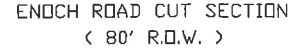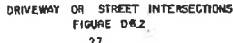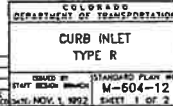

26. THE PARTIES RESPONSIBLE FOR THIS PLAN HAVE FAMILIARIZED THEMSELVES WITH ALL CURRENT ACCESSIBILITY CRITERIA AND SPECIFICATIONS AND THE PROPOSED PLAN REFLECTS ALL SITE ELEMENTS REQUIRED BY THE APPLICABLE ADA DESIGN STANDARDS AND GUIDELINES AS PUBLISHED BY THE UNITED STATES DEPARTMENT OF JUSTICE. APPROVAL OF THIS PLAN BY THE COUNTY DOES NOT ASSURE COMPLIANCE WITH THE ADA OR ANY OTHER FEDERAL OR STATE ACCESSIBILITY LAWS OR ANY REGULATIONS OR GUIDELINES ENACTED OR UNDER OR WITH RESPECT TO SUCH LAWS. SOLE RESPONSIBILITY FOR COMPLIANCE WITH FEDERAL AND STATE ACCESSIBILITY LAW LIES WITH THE PROPERTY OWNER.

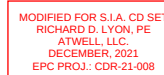

2 OF 22 PAGES


PHASE 2 (BLACK ELK DRIVE AND PIPESTEM DRIVE)

NOTES:

1. ROUGH CUT ROAD AND CONSTRUCT SANITARY SEWER TO STATION 6+65.70
2. ALL CURB RETURN RADII ARE 15.00'
3. SEE GENERAL NOTES & DETAILS ON SHEET 2 OF 14

* CURB AND GUTTER
MARKED IN THE FIELD TO
BE REPLACED IN-KIND.
ESTIMATED TO BE
APPROXIMATELY 900 LF IN
TOTAL.

SCALES:
1" = 50' HOR
1" = 5' VER

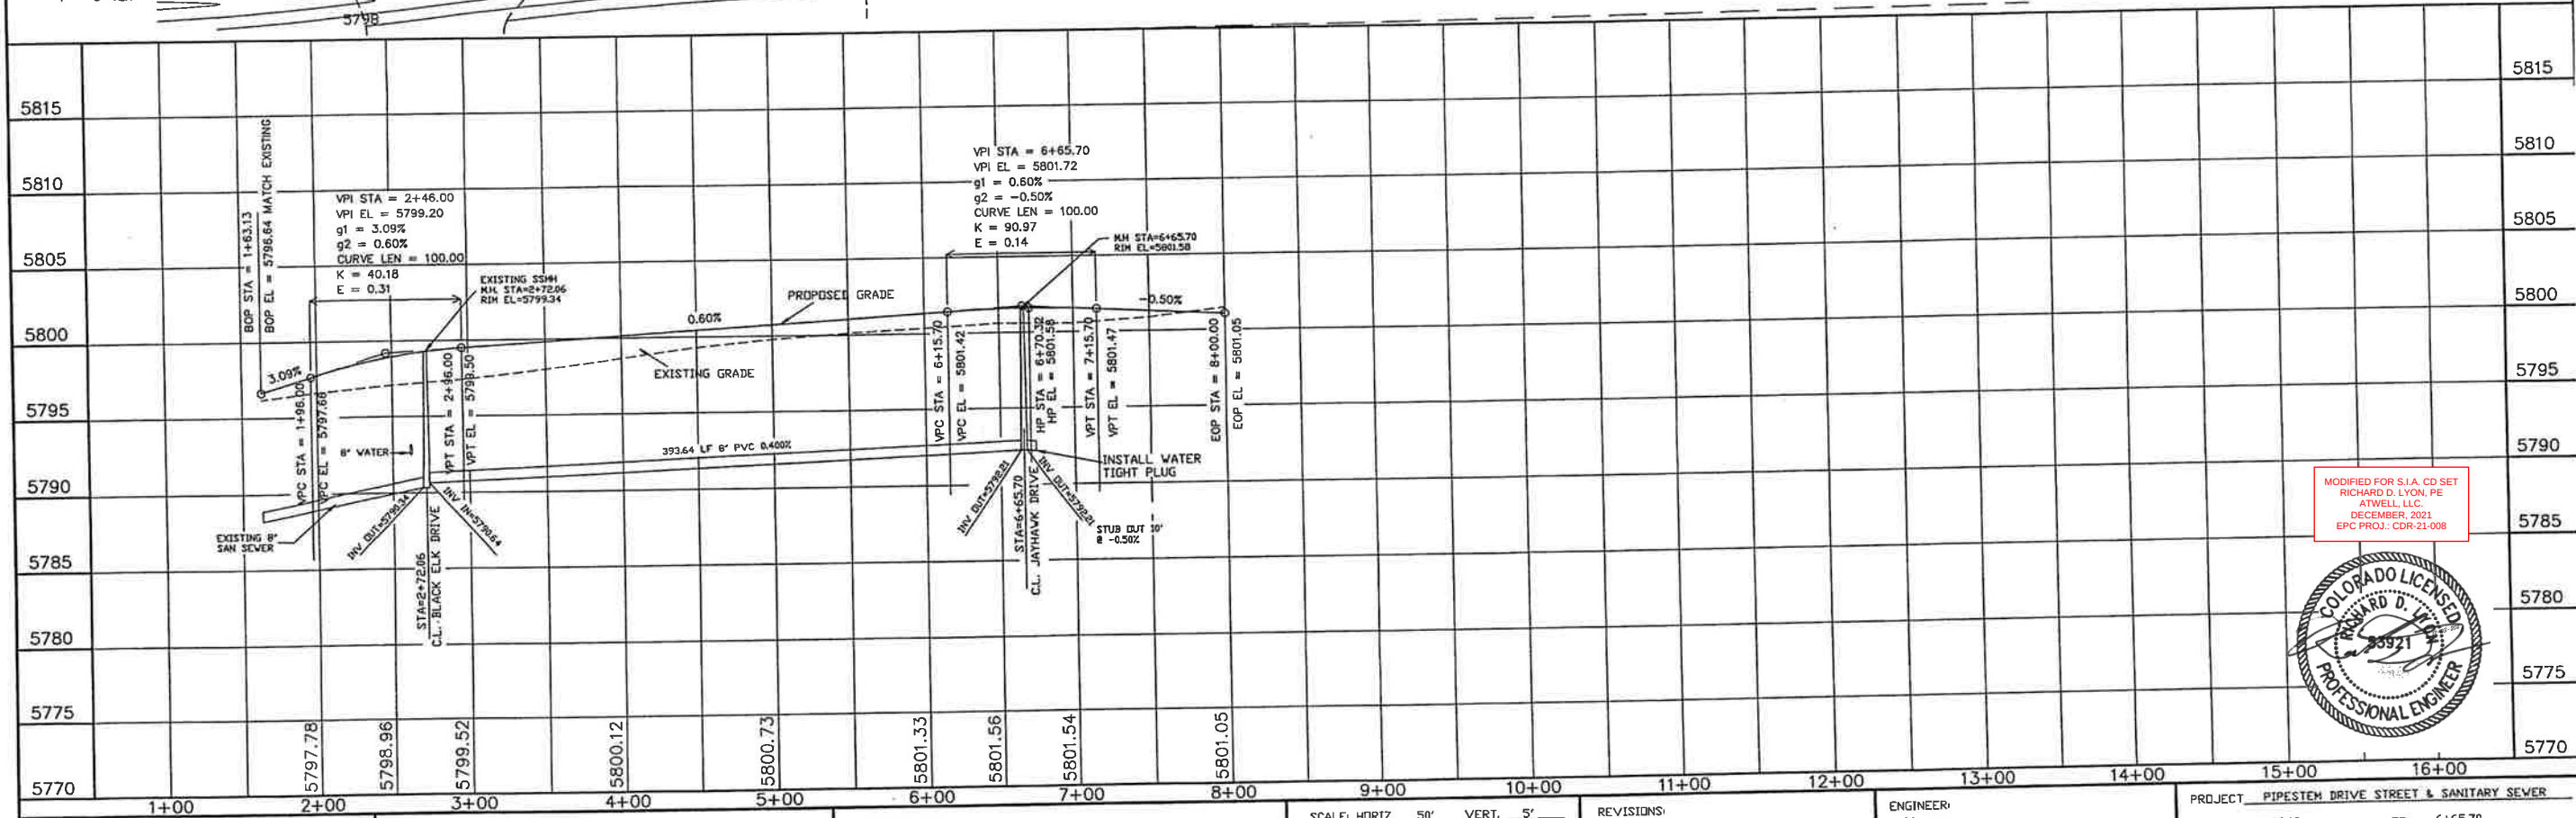

MODIFIED FOR S.I.A. CD SET
RICHARD D. LYON, PE
ATWELL, LLC.
DECEMBER, 2021
EPC PROJ.: CDR-21-008



STATEMENT:

THE COUNTY OF EL PASO, RECOGNIZES THE DESIGN ENGINEER AS HAVING RESPONSIBILITY FOR THE DESIGN. THE COUNTY HAS LIMITED ITS SCOPE OF REVIEW ACCORDINGLY.

REVIEW:
STREET DESIGN:
ROUGH CUT REVIEW _____ DATE _____
FINAL REVIEW _____ DATE _____
DRAINAGE BASIN:

DESIGN DATA:

SIDEWALKS: WIDTH 5'
LOCATION: Attached ☒
Detached, 6' from P/L ☐
CURB TYPE 102030
R/W WIDTH 60' B/C-B/
STREET TYPE HVL

ASPHALT THICKNESS:
AC Surface TBD
AC Base _____
AGG. BASE THICKNESS:
Class 6 _____
Class 5 _____
Class 2 _____

SCALE: HORIZ. 50' VERT. 5'
BENCHMARK: U.S.G.S. BRASS CAP
114 JK (1953) ELEV=5752.00
LOCATED AT THE SOUTHEAST CORNE
OF SECTION 12, T.15S., R.63W.


NO.	DESCRIPTION	DATE
1	SIA CD UPDATES	01/07/2022

ENGINEER:
UNITED
PLANNING
ENGINEERING
(719) 597-9900
4575 GALLEY ROAD SUITE 200
COLORADO SPRINGS, COLORADO 80915

DESIGNED BY: JK DATE: 1
DRAWN BY: JK DATE: 1
CHECKED BY: TLK DATE: 1


PROJECT PIPESTEM DRIVE STREET & SANITARY SEWER
FROM 1+63.13 TO 6+65.70
SUBDIVISION SUNSET VILLAGE FILING NO. 4
DRAINAGE BASIN TELEPHONE EXCHANGE
JOB NO. D:\PROJ\00-0908\RCPO001.DWG SHEET 3 OF 3

PHASE 1 (REDTAIL DRIVE, WHEAT DRIVE, FLEET STREET, JAYHAWK AVENUE)

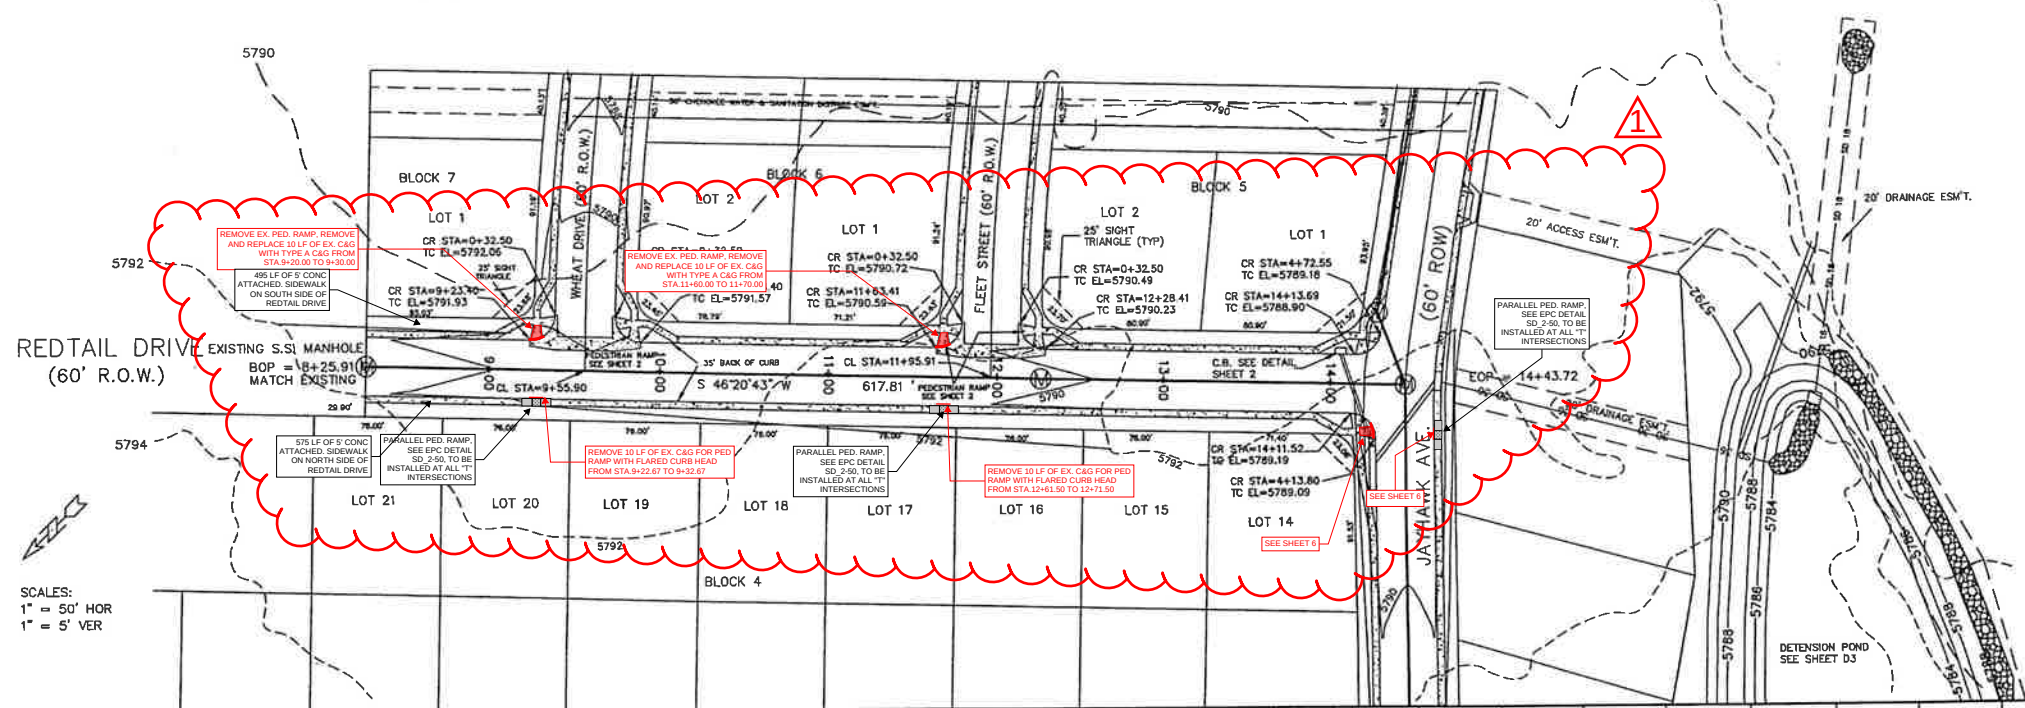


* CURB AND GUTTER MARKED IN THE FIELD TO BE REPLACED IN-KIND. ESTIMATED TO BE APPROXIMATELY 900 LF IN TOTAL.

DETAIL
MANHOLE STATION 14+43.72
INTERSECTION REDTAIL DRIVE AND JAYHAWK AVE.

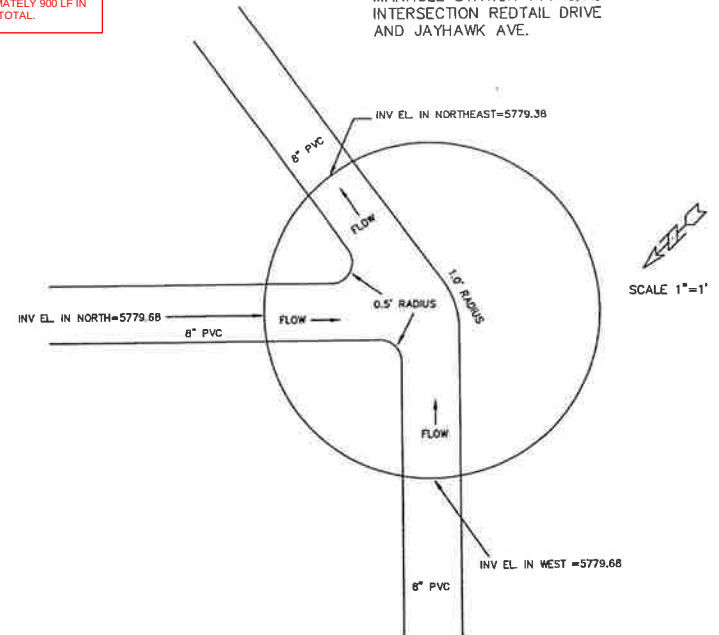

SCALES:
1" = 50' HOR
1" = 5' VER



- NOTES:
1. ALL CURB RETURNS HAVE A RADIUS OF 15.00'
2. SEE GENERAL NOTES & DETAILS ON SHEET 2 OF 14

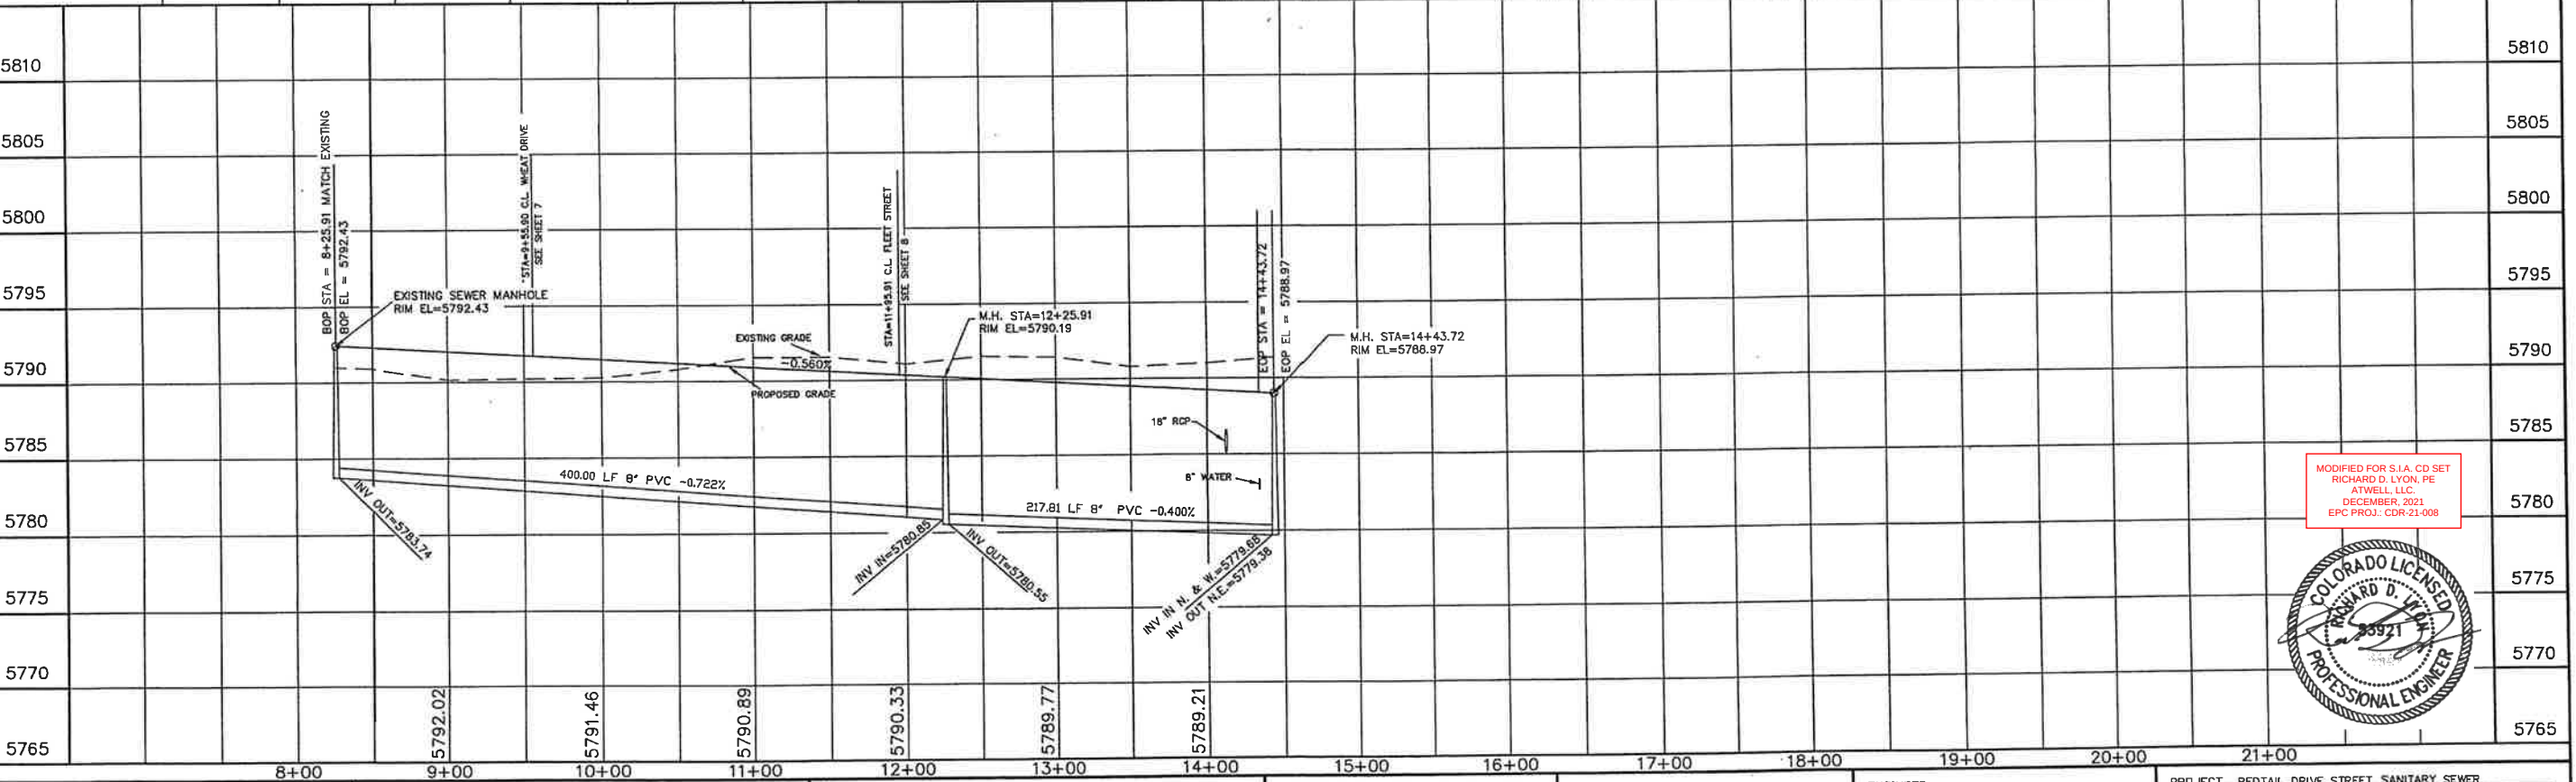



MODIFIED FOR S.I.A. CD SET
RICHARD D. LYON, PE
ATWELL, LLC
DECEMBER, 2021
EPC PROJ.: CDR-21-008



STATEMENT: THE COUNTY OF EL PASO, RECOGNIZES THE DESIGN ENGINEER AS HAVING RESPONSIBILITY FOR THE DESIGN. THE COUNTY HAS LIMITED ITS SCOPE OF REVIEW ACCORDINGLY.	REVIEW: STREET DESIGN _____ DATE _____ ROUGH CUT REVIEW _____ DATE _____ FINAL REVIEW _____ DATE _____ DRAINAGE BASIN _____	DESIGN DATA: SIDEWALKS WIDTH 5' LOCATION: Attached ☒ Detached, 6' from P/L ☐ CURB TYPE 102030 R/W WIDTH 60' B/C-B/C 35' STREET TYPE _____ ASPHALT THICKNESS: AC Surface 1BD AC Base _____ AGG. BASE THICKNESS: Class 6 _____ Class 5 _____ Class 2 _____	SCALE: HORIZ. 50' VERT. 5' BENCHMARK: U.S.G.S. BRASS CAP 114 JK (1953) ELEV=5752.00 LOCATED AT THE SOUTHEAST CORNER OF SECTION 12, T15S, R63W.	REVISIONS: NO. DESCRIPTION DATE 1 SIA CD UPDATES 01/07/2022	ENGINEER: UNITED PLANNING ENGINEERING 4575 GALLEY ROAD SUITE 200 COLORADO SPRINGS, COLORADO 80915 DESIGNED BY: JLK DATE: 10-09-01 DRAWN BY: JLK DATE: 10-09-01 CHECKED BY: TLK DATE: 10-09-01	PROJECT: REDTAIL DRIVE STREET, SANITARY SEWER FROM: 8+25.91 TO: 14+43.72 SUBDIVISION: SUNSET VILLAGE FILING NO. 4 DRAINAGE BASIN: TELEPHONE EXCHANGE JOB NO. D:\PROJ\A00-0908\RCP01002.DWG SHEET 4 OF 22
--	---	---	---	---	---	--

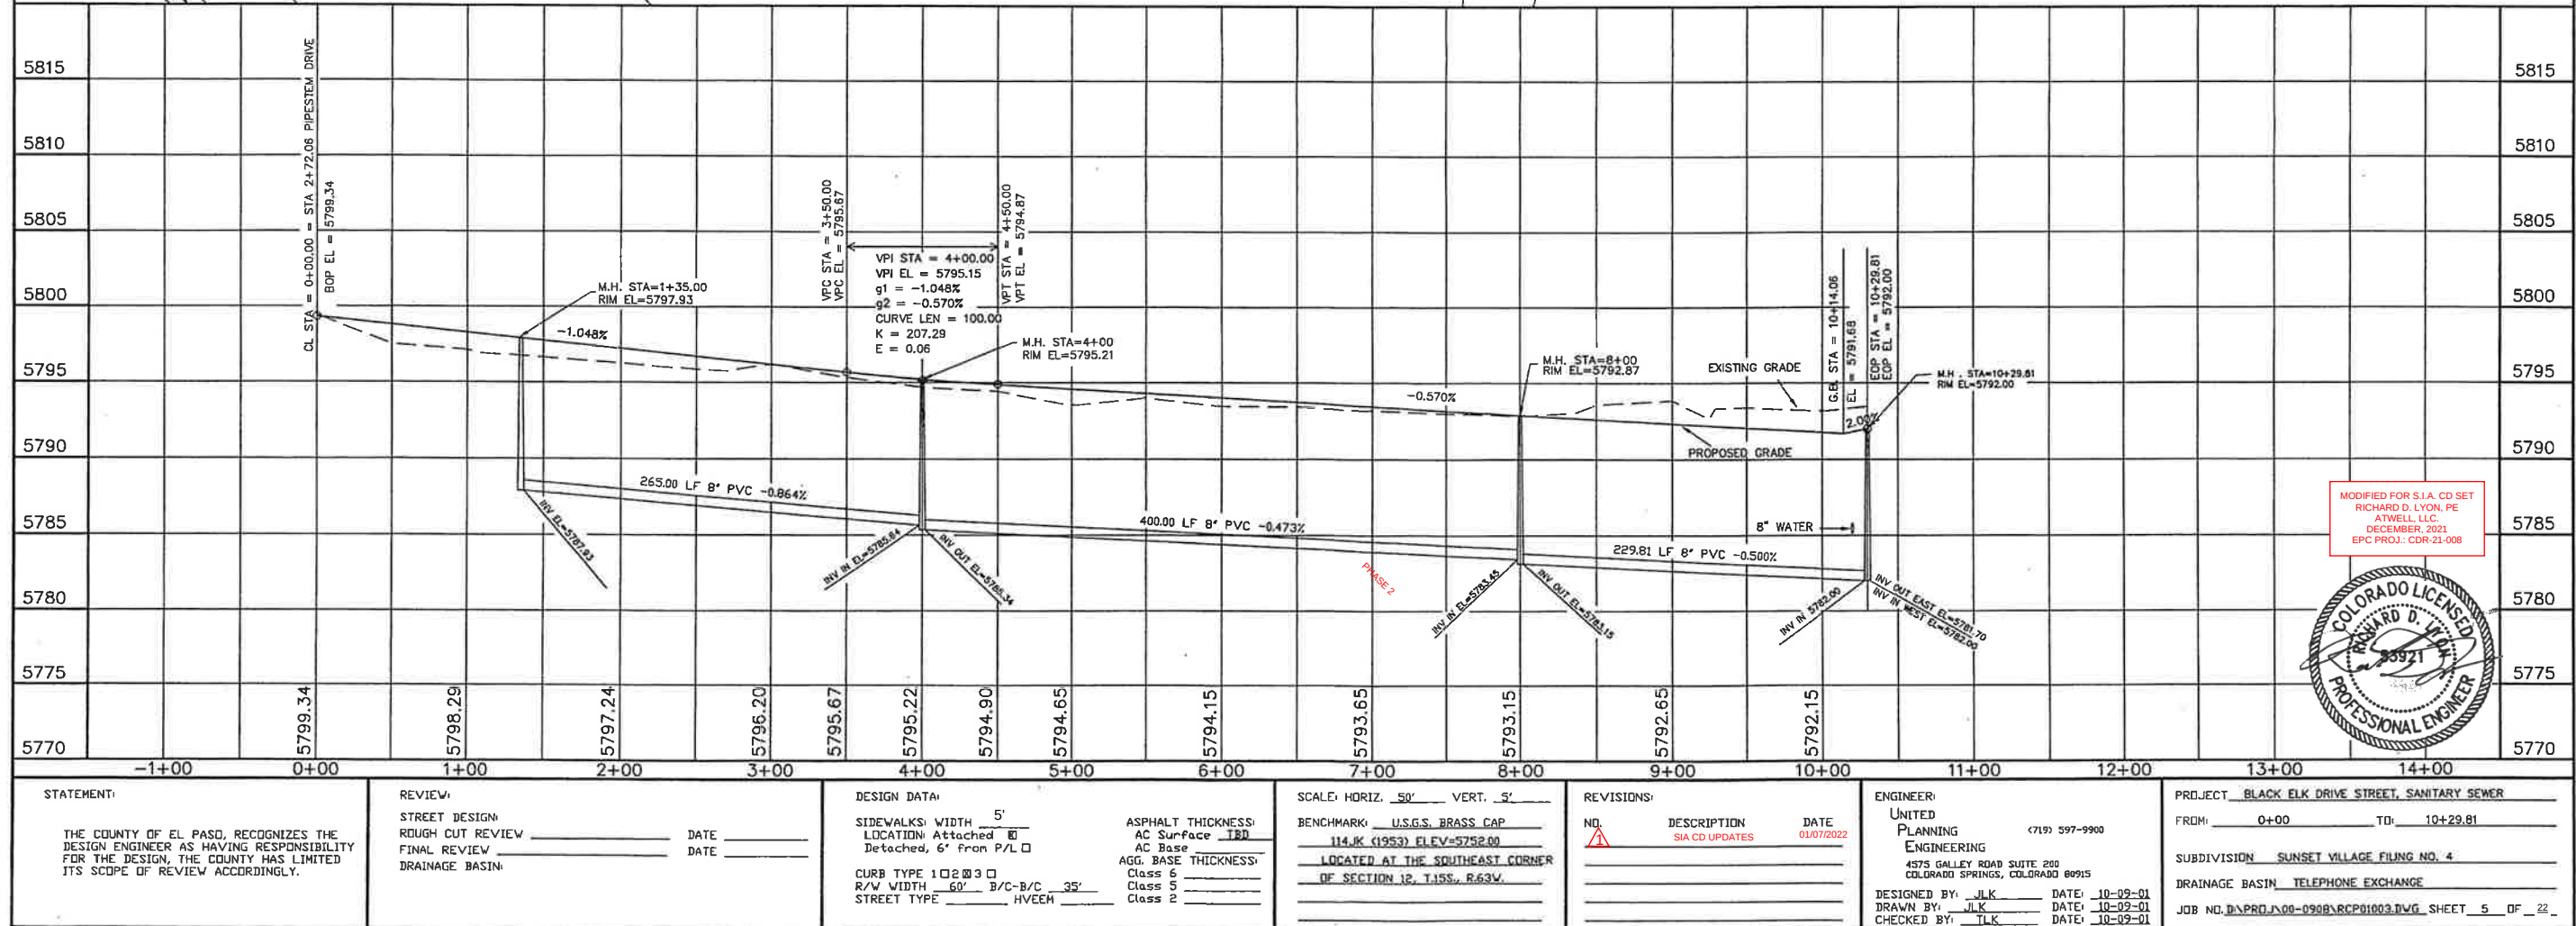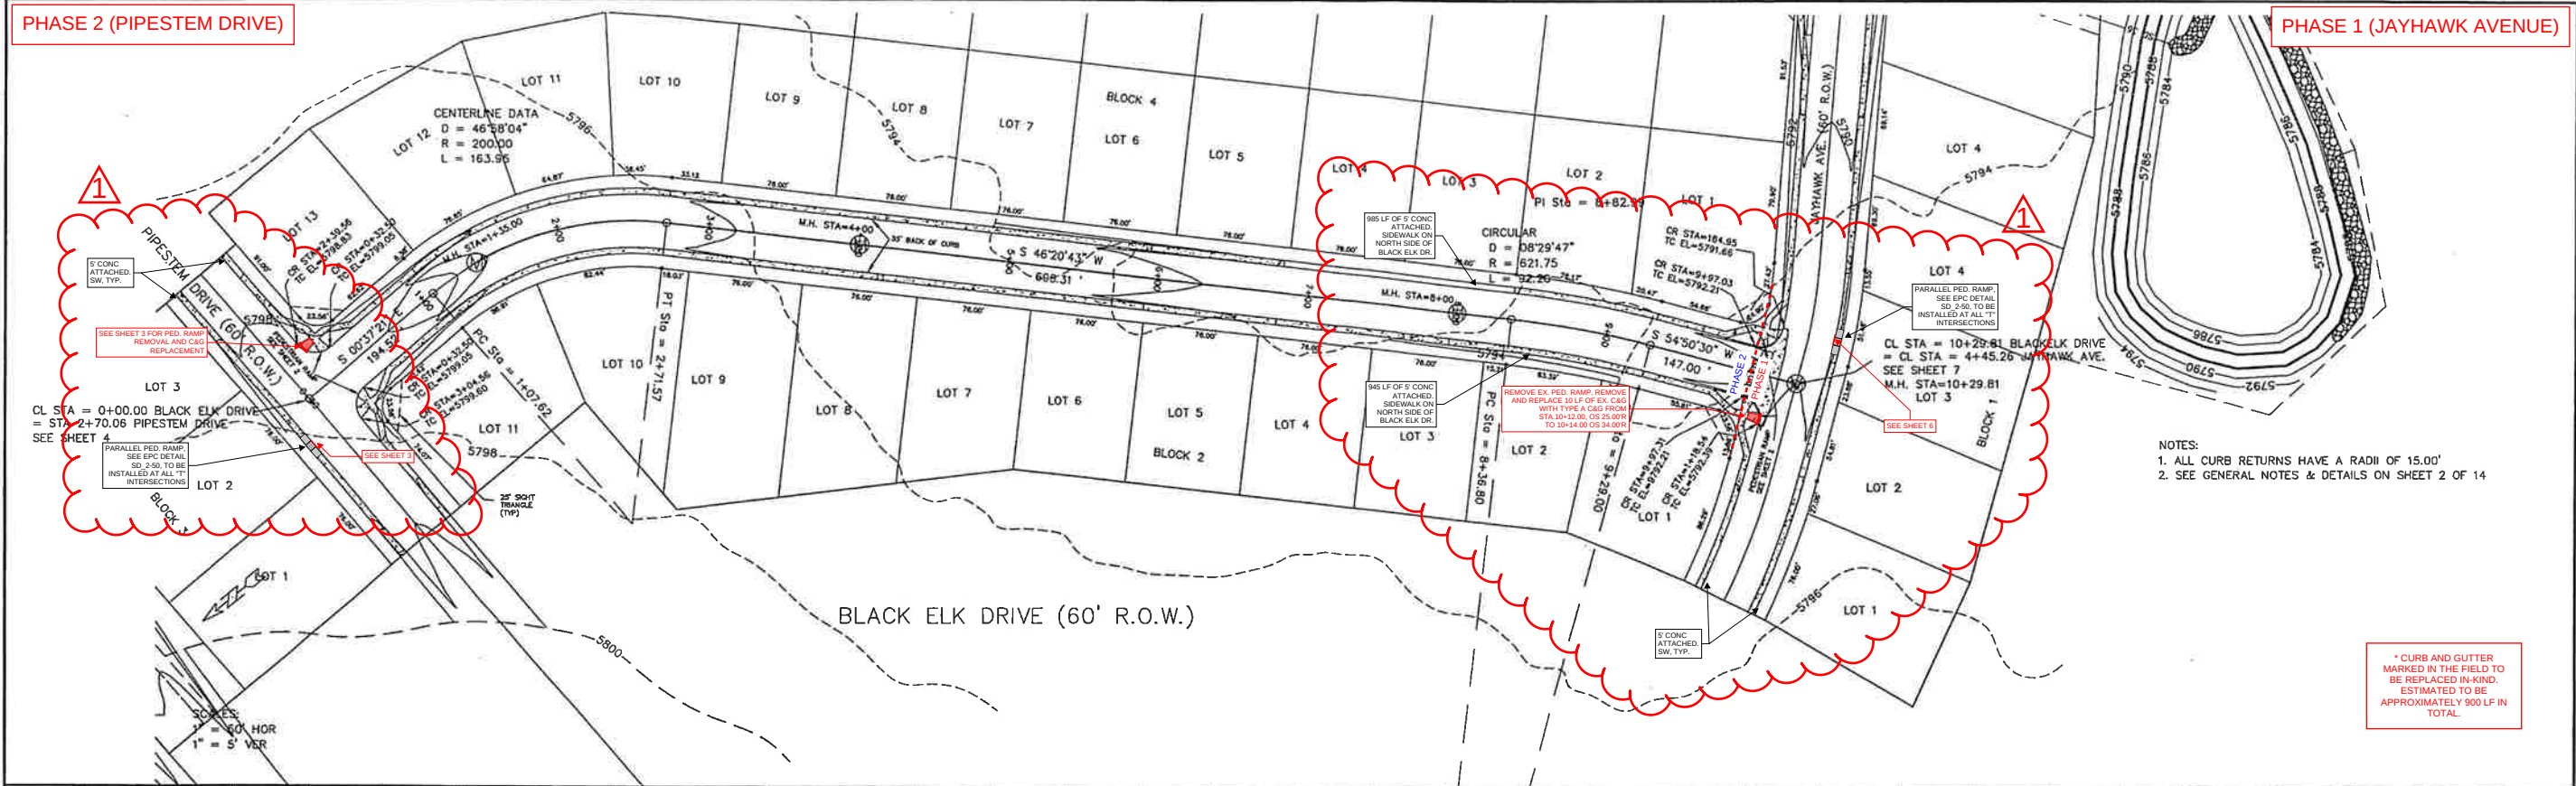


PHASE 1 (JAYHAWK AVENUE)

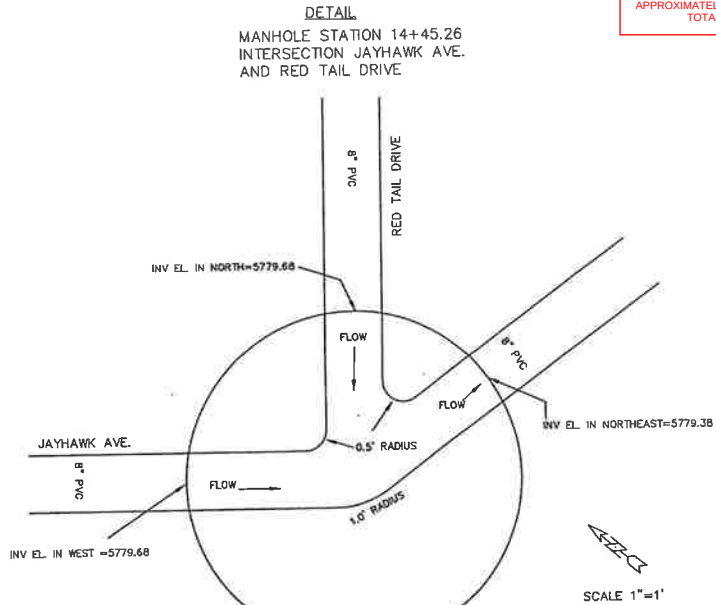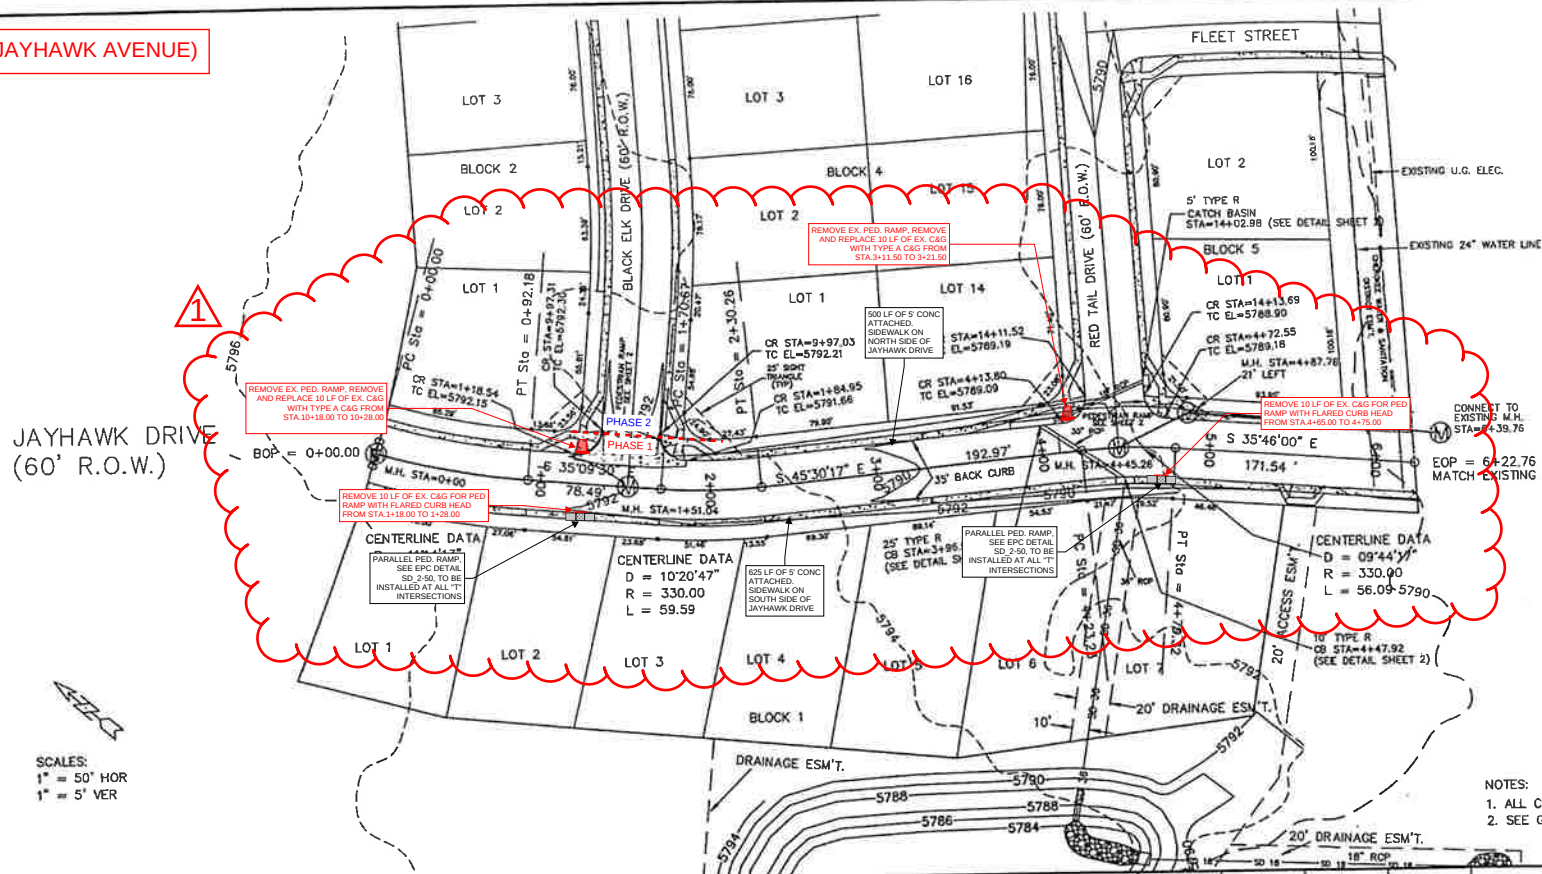

* CURB AND GUTTER
MARKED IN THE FIELD TO
BE REPLACED IN-KIND.
ESTIMATED TO BE
APPROXIMATELY 900 LF IN
TOTAL.

- NOTES:
1. ALL CURB RETURNS HAVE A RADIUS OF 15.00'
 2. SEE GENERAL NOTES & DETAILS ON SHEET 2 OF 14

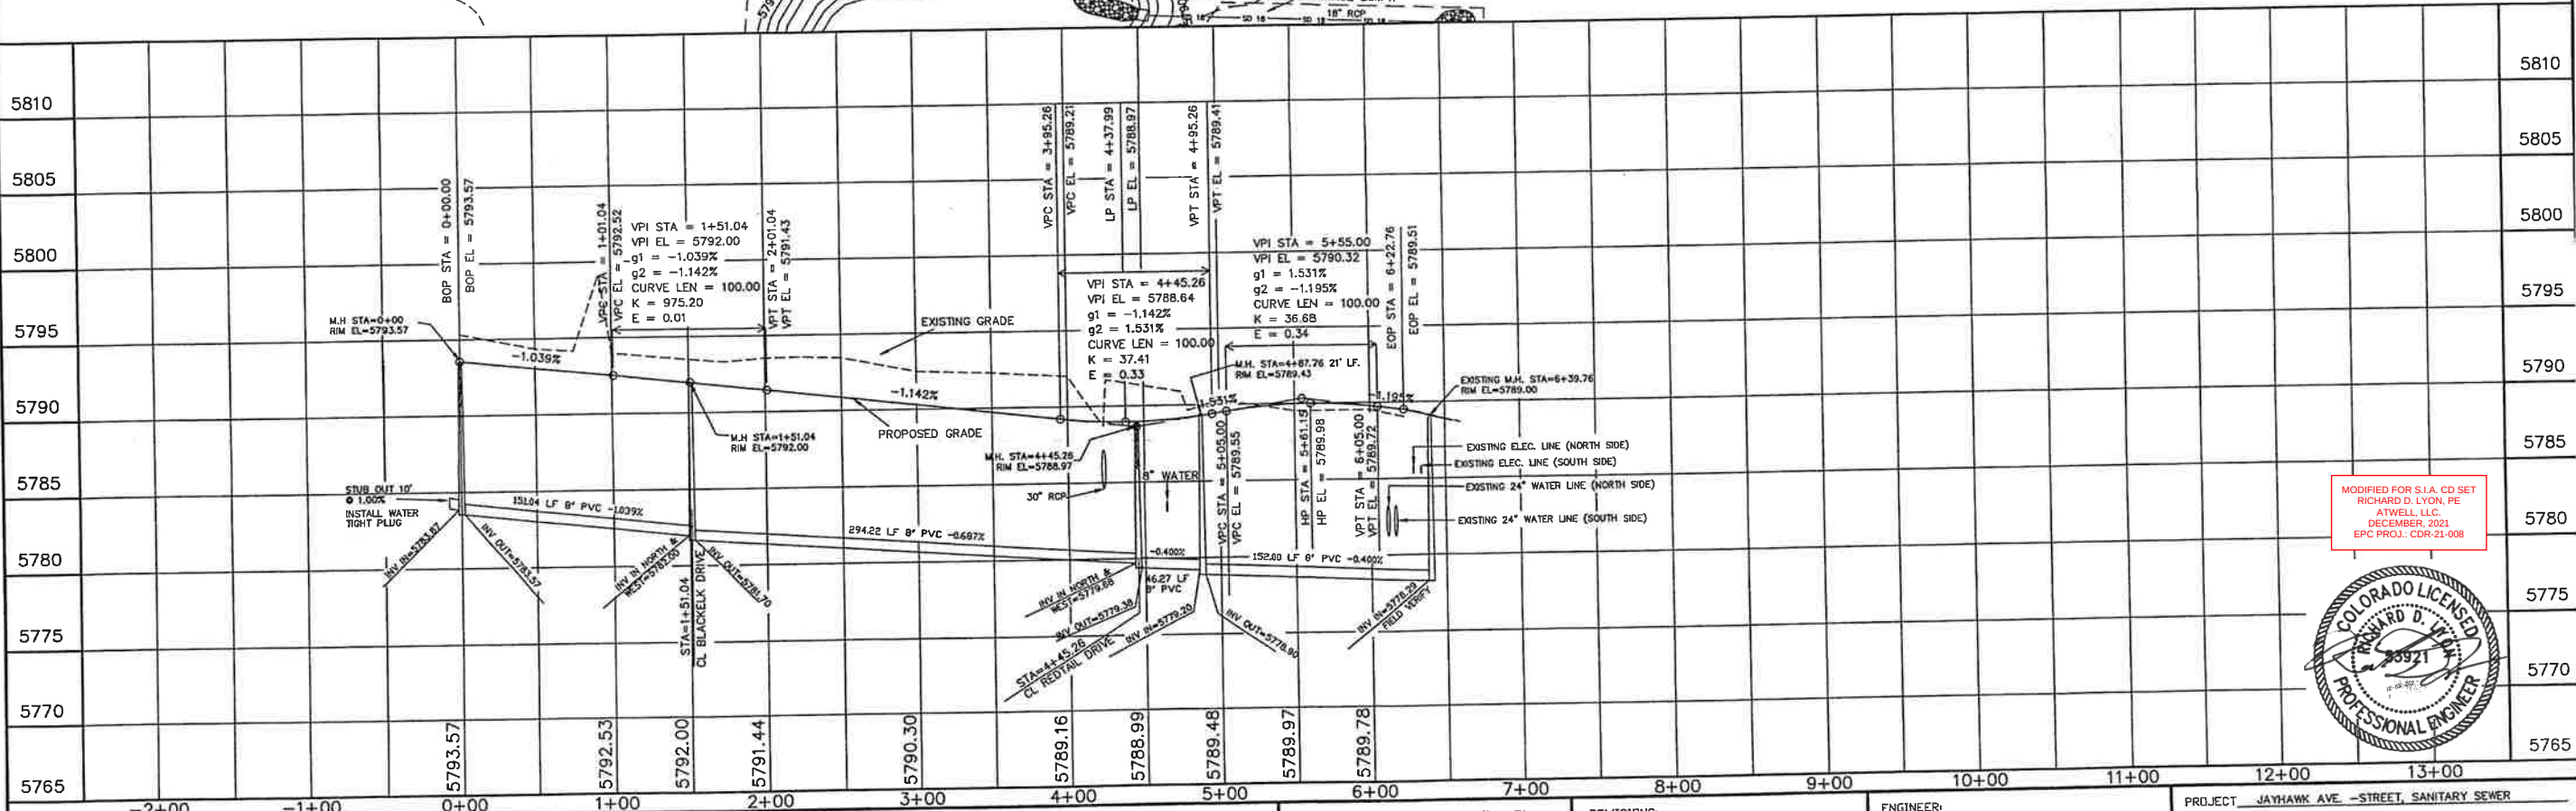



MODIFIED FOR S.I.A. CD SET
RICHARD D. LYON, PE
ATWELL, LLC
DECEMBER, 2021
EPC PROJ.: CDR-21-008



STATEMENT: THE COUNTY OF EL PASO, RECOGNIZES THE DESIGN ENGINEER AS HAVING RESPONSIBILITY FOR THE DESIGN. THE COUNTY HAS LIMITED ITS SCOPE OF REVIEW ACCORDINGLY.		REVIEW: STREET DESIGN _____ DATE _____ ROUGH CUT REVIEW _____ DATE _____ FINAL REVIEW _____ DATE _____		DESIGN DATA: SIDEWALKS WIDTH 5' LOCATION Attached to Detached, 6' from P/L/D CURB TYPE 10 200 30 R/W WIDTH 60' B/C-B/C 35' STREET TYPE HVEEM ASPHALT THICKNESS: AC Surface 18D AC Base AGG. BASE THICKNESS: Class 6 Class 5 Class 2		SCALE: HORIZ. 50' VERT. 5' BENCHMARK: U.S.G.S. BRASS CAP 114JK (1953) ELEV=5752.00 LOCATED AT THE SOUTHEAST CORNER OF SECTION 12, T15S, R63W.		REVISIONS: NO. DESCRIPTION DATE 1 SIA CD UPDATES 01/07/2022		ENGINEER: UNITED PLANNING ENGINEERING (719) 597-9900 4575 GALLEY ROAD SUITE 200 COLORADO SPRINGS, COLORADO 80915 DESIGNED BY: J.L.K. DATE: 10-09-01 DRAWN BY: J.L.K. DATE: 10-09-01 CHECKED BY: J.L.K. DATE: 10-09-01		PROJECT: JAYHAWK AVE. - STREET, SANITARY SEWER FROM: 0+00 TO: 6+22.76 SUBDIVISION: SUNSET VILLAGE FILING NO. 4 DRAINAGE BASIN: TELEPHONE EXCHANGE JOB NO. D:\PROJ\100-0908\RCD\01004.DWG SHEET 6 OF 22	
---	--	--	--	--	--	--	--	--	--	--	--	---	--

PHASE 1 (REDTAIL DRIVE, WHEAT DRIVE, FLEET STREET, JAYHAWK AVENUE)

* CURB AND GUTTER MARKED IN THE FIELD TO BE REPLACED IN-KIND. ESTIMATED TO BE APPROXIMATELY 900 LF IN TOTAL.

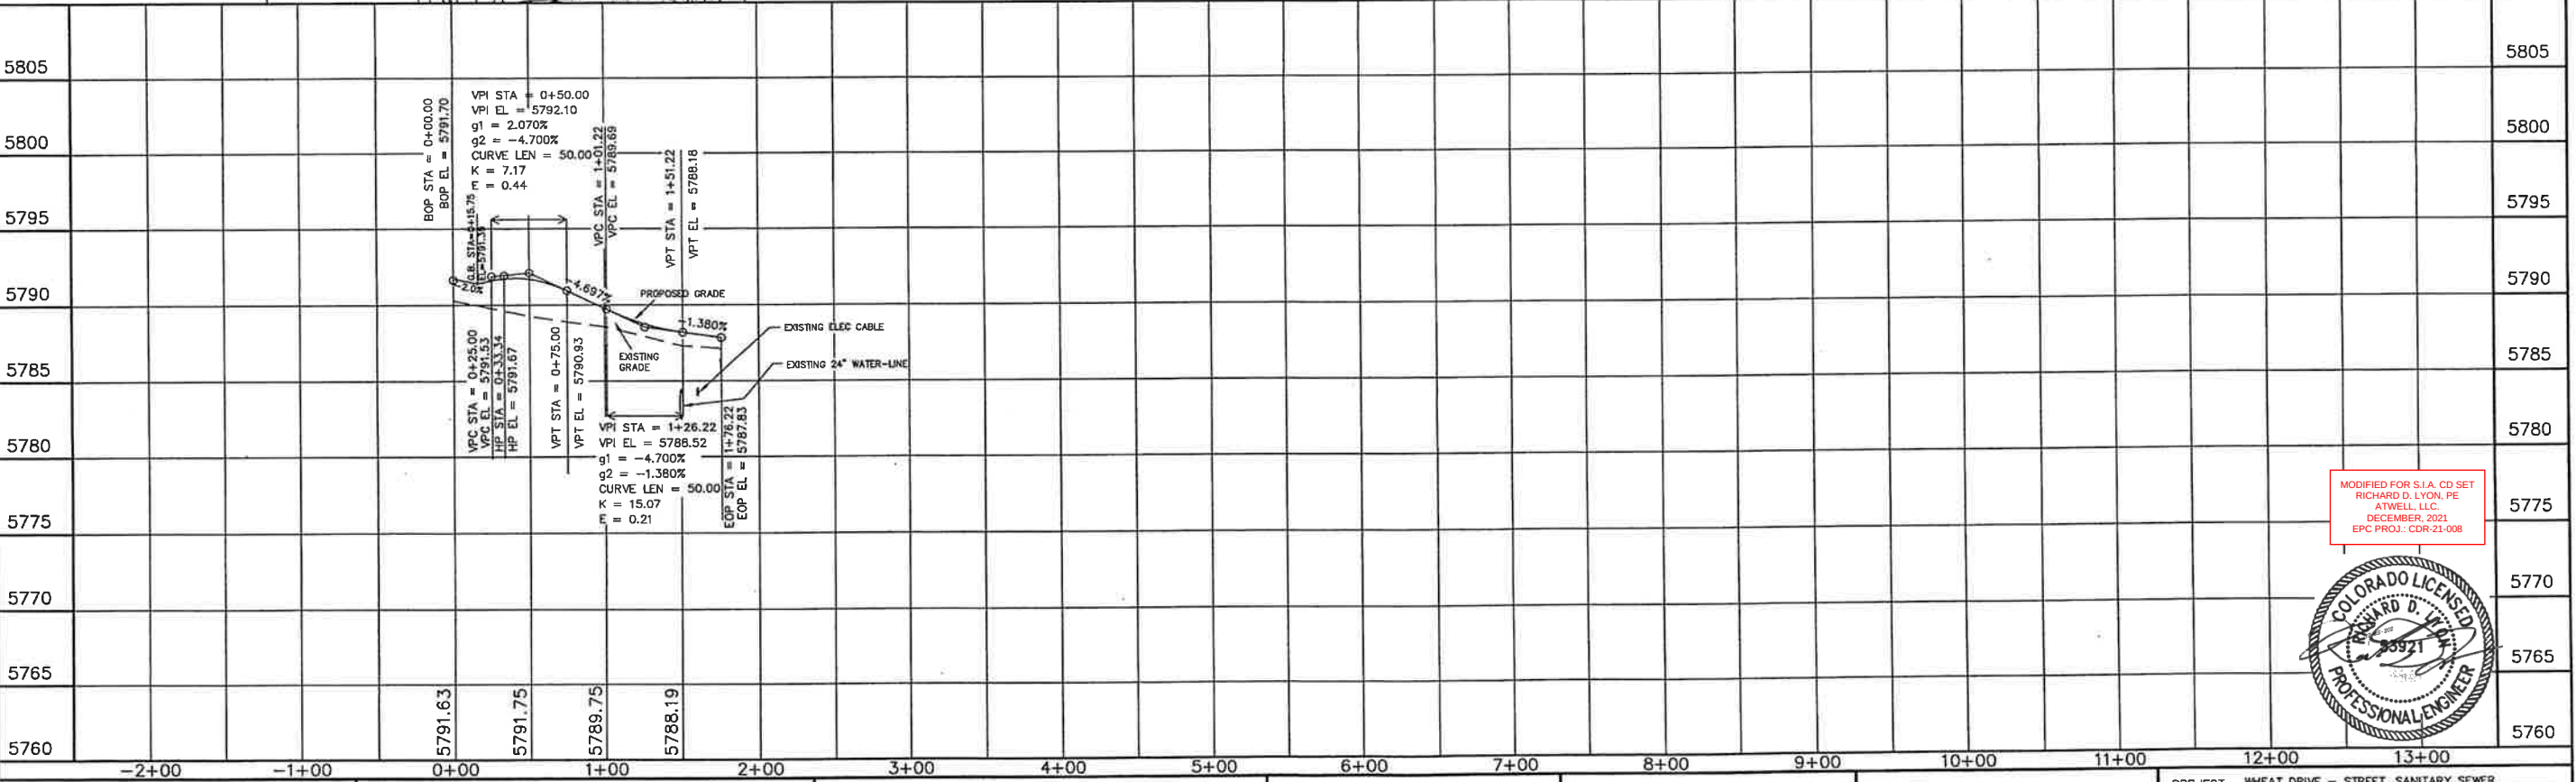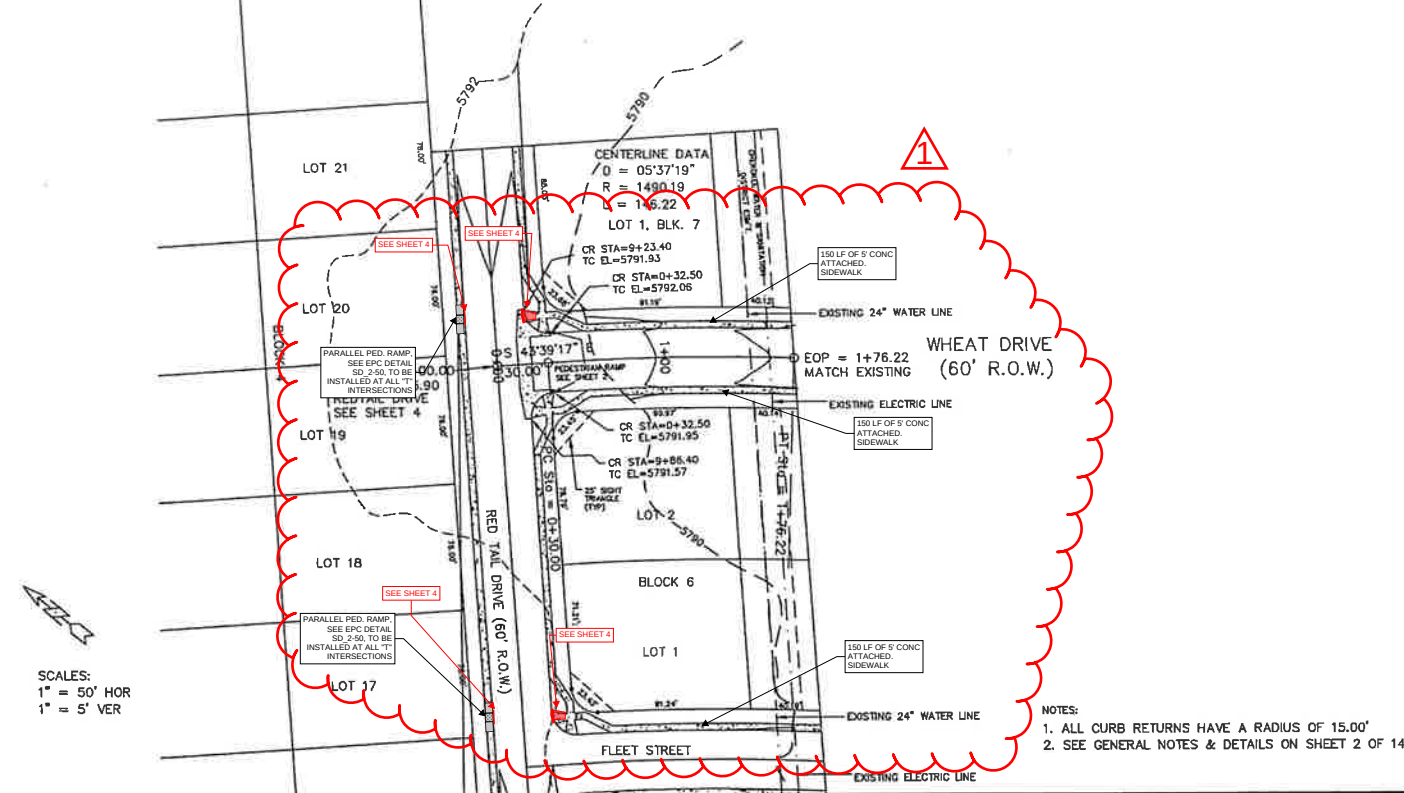


MODIFIED FOR S.I.A. CD SET
RICHARD D. LYON, PE
ATWELL, LLC
DECEMBER, 2021
EPC PROJ.: CDR-21-008



STATEMENT: THE COUNTY OF EL PASO, RECOGNIZES THE DESIGN ENGINEER AS HAVING RESPONSIBILITY FOR THE DESIGN. THE COUNTY HAS LIMITED ITS SCOPE OF REVIEW ACCORDINGLY.	REVIEW: STREET DESIGN _____ DATE _____ ROUGH CUT REVIEW _____ DATE _____ FINAL REVIEW _____ DATE _____ DRAINAGE BASIN _____	DESIGN DATA: SIDEWALKS: WIDTH 5' LOCATION: Attached to Detached, 6' from P/LD CURB TYPE 102030 R/W WIDTH 60' B/C-B/C 35' STREET TYPE _____ HVEEM _____ ASPHALT THICKNESS: AC Surface 180 AC Base _____ AGG. BASE THICKNESS: Class 6 _____ Class 5 _____ Class 2 _____	SCALE: HORIZ. 50' VERT. 5' BENCHMARK: U.S.G.S. BRASS CAP 114JK (1953) ELEV=5752.00 LOCATED AT THE SOUTHEAST CORNER OF SECTION 12, T.15S., R.63W.	REVISIONS: NO. DESCRIPTION DATE 1 SIA CD UPDATES 01/07/2022	ENGINEER: UNITED PLANNING ENGINEERING 4575 GALLEY ROAD SUITE 200 COLORADO SPRINGS, COLORADO 80915 DESIGNED BY: JLK DATE: 10-02-01 DRAWN BY: JLK DATE: 10-02-01 CHECKED BY: TLK DATE: 10-02-01	PROJECT: WHEAT DRIVE - STREET, SANITARY SEWER FROM: 0+00 TO: 1+76.22 SUBDIVISION: SUNSET VILLAGE FILING NO. 4 DRAINAGE BASIN: TELEPHONE EXCHANGE JOB NO. B:\PROJ\A00-0908\RCP01005.DWG SHEET 7 OF 15
--	---	---	---	---	---	--

* CURB AND GUTTER
MARKED IN THE FIELD TO
BE REPLACED IN-KIND.
ESTIMATED TO BE
APPROXIMATELY 900 LF IN
TOTAL.


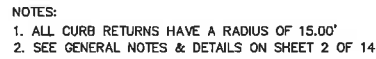


MODIFIED FOR S.I.A. CD SET
RICHARD D. LYON, PE
ATWELL, LLC.
DECEMBER, 2021
EPC PROJ.: CDR-21-008



JOB NO. D:\PROJ\00-0908\RCPO1006.DWG SHEET 8 OF 15

THIS SHEET IS NOT WITHIN SCOPE OF WORK FOR SUNSET VILLAGE FIL. 4
SUBDIVISION IMPROVEMENT AGREEMENT

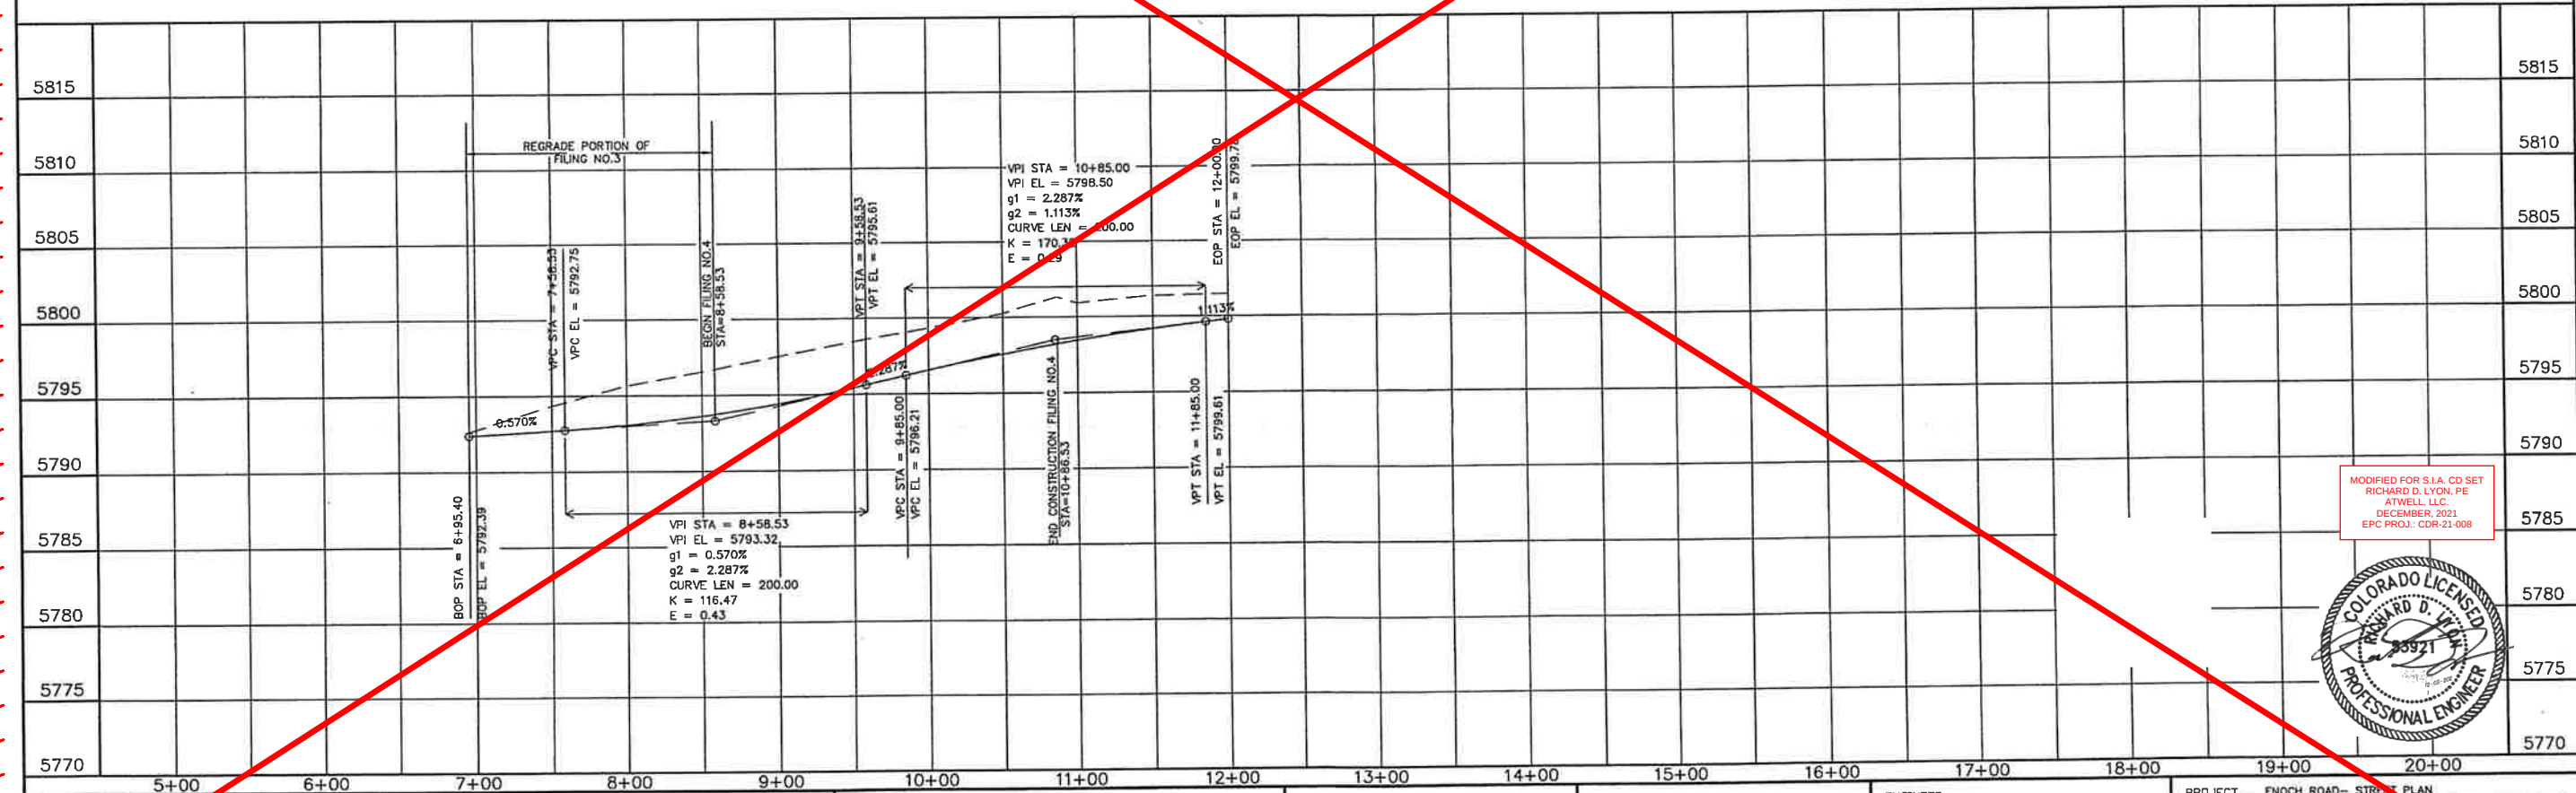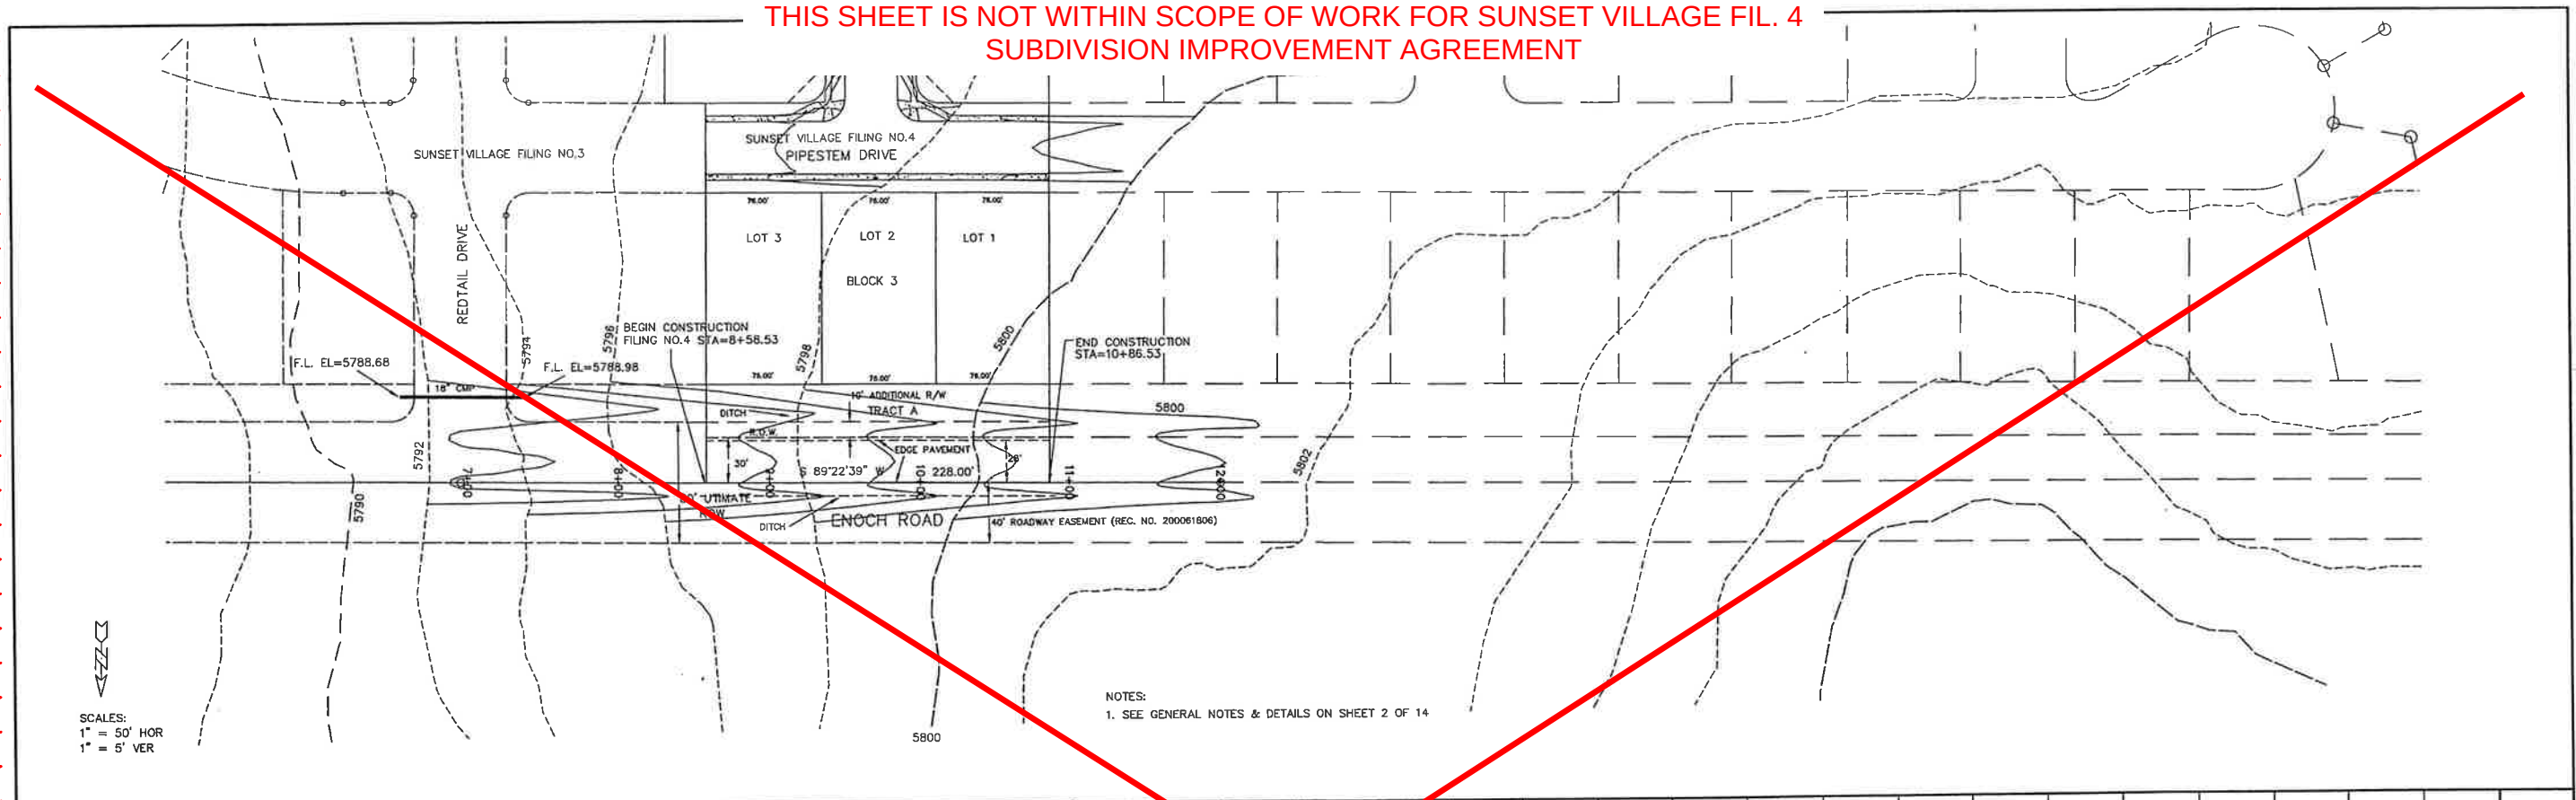

MODIFIED FOR S.I.A. CD SET
RICHARD D. LYON, PE
ATWELL, LLC
DECEMBER, 2021
EPC PROJ.: CDR-21-008



STATEMENT:

THE COUNTY OF EL PASO, RECOGNIZES THE DESIGN ENGINEER AS HAVING RESPONSIBILITY FOR THE DESIGN. THE COUNTY HAS LIMITED ITS SCOPE OF REVIEW ACCORDINGLY.

REVIEW:

STREET DESIGN _____ DATE _____
ROUGH CUT REVIEW _____ DATE _____
FINAL REVIEW _____ DATE _____

DESIGN DATA:

SIDEWALKS: WIDTH _____
LOCATION: Attached ☐ Detached, 6' from P/L ☐
CURB TYPE 10 20 30 _____
R/W WIDTH 80' PROP. F/C-F/C _____
STREET TYPE _____ HVECH _____

ASPHALT THICKNESS:
AC Surface _____
AC Base _____
AGG. BASE THICKNESS:
Class 6 _____
Class 5 _____
Class 2 _____

SCALE: HORIZ. 50' VERT. 5'

BENCHMARK: U.S.G.S. BRASS CAP
114JK (1953) ELEV=5752.00
LOCATED AT THE SOUTHEAST CORNER
OF SECTION 12, T.15S., R.63W.

REVISIONS:

NO.	DESCRIPTION	DATE
1	SIA CD UPDATES	01/07/2022

ENGINEER:
UNITED
PLANNING
ENGINEERING
(719) 597-9900

DESIGNED BY: JLK DATE: 10-09-01
DRAWN BY: JLK DATE: 10-09-01
CHECKED BY: TLK DATE: 10-09-01



PROJECT: ENOCH ROAD - STREET PLAN

FROM: 6+95.40 TO: 12+00

SUBDIVISION: SUNSET VILLAGE FILING NO. 4

DRAINAGE BASIN: TELEPHONE EXCHANGE

JOB NO.: \PROJ\100-0908\RCP01007.DWG SHEET 9 OF 15

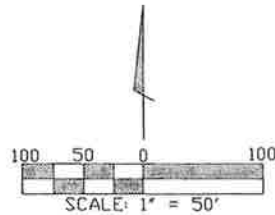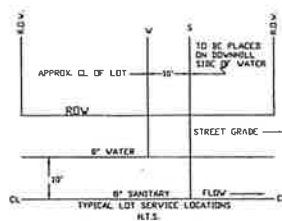

PUBLIC MAIN EXTENSIONS

WATER STATEMENT:
THE UNDERSIGNED OWNER/DEVELOPER AGREES THAT THE INSTALLATION OF THESE PROPOSED WATER FACILITIES WILL BE MADE IN ACCORDANCE WITH CHEROKEE METROPOLITAN DISTRICT SPECIFICATIONS AND SHALL PROVIDE A MINIMUM OF FIVE (5) FEET AND A MAXIMUM OF SIX (6) FEET OF COVER OVER THE WATER MAINS. ANY CHANGES REQUIRED TO MEET THE ABOVE STIPULATION SHALL BE AT THE EXPENSE OF THE OWNER/DEVELOPER COVER IN EXCESS OF SIX(6) FEET SHALL BE SUPPORTED BY PLAN AND PROFILE DRAWINGS APPROVED BY THE CHEROKEE METROPOLITAN DISTRICT.

SIGNED: *[Signature]* DATE: 12-14-01

OWNER/DEVELOPER: RODNEY PREISSER
PIKES PEAK WATER COMPANY

ALL FIRE HYDRANTS SHALL BE INSTALLED ACCORDING TO THE CHEROKEE METROPOLITAN DISTRICT WATER SPECIFICATIONS. THE NUMBER OF HYDRANTS AND HYDRANT LOCATIONS AS SHOWN ON THIS WATER INSTALLATION PLAN ARE CORRECT AND ADEQUATE TO SATISFY THE FIRE PROTECTION REQUIREMENTS AS SPECIFIED BY THE ELICOTT FIRE PROTECTION DISTRICT.

SIGNED: _____ DATE: _____
ELICOTT FIRE PROTECTION DISTRICT

WATER INSTALLATION CORROSION CONTROL REQUIREMENTS:
NONE REQUIRED

ALL FIRE HYDRANTS AND FUTURE SERVICE STUBS HAVE BEEN LOCATED BY THE DEVELOPER OR HIS ENGINEER. ANY REQUIRED REALIGNMENT, EITHER HORIZONTAL OR VERTICAL, SHALL BE AT THE EXPENSE OF THE DEVELOPER. ALSO, ANY STUBS AND APPURTENANCES NOT USED AS PROVIDED SHALL BE REMOVED AND REPLACED WITH AN ACCEPTABLE SECTION OF PIPE AT THE EXPENSE OF THE DEVELOPER. THE CONTRACTOR IS REQUIRED TO NOTIFY CHEROKEE METROPOLITAN DISTRICT (719-597-5800) TWO (2) WORKING DAYS PRIOR TO BEGINNING CONSTRUCTION. IF THIS PROJECT INVOLVES A TAP, DO NOT CALL TO SCHEDULE THE TAP UNTIL THE ENGINEERING INSPECTION NOTIFICATION HAS BEEN MADE.

NOTES:

1. ALL DIMENSIONS ARE TO FACE OF CURB
2. ALL SPOT ELEVATIONS ARE FACE OF CURB AT FLOWLINE
3. ALL BENDS SHALL BE FIELD STATED PRIOR TO CONSTRUCTION
4. FIRE HYDRANT ASSEMBLY SHALL INCLUDE LATERAL PIPING, GATE VALVE, CONCRETE THRUST REACTION BLOCK AND ANY REQUIRED FITTINGS
5. MAINTAIN TEN (10) FOOT MINIMUM HORIZONTAL DISTANCE BETWEEN WATER MAIN AND SANITARY SEWER MAIN


PRE-EXCAVATION CHECK LIST


- GAS AND OTHER UTILITY LINES SHOWN ON CONSTRUCTION PLANS
- UTILITIES UNDERGROUND LOCATING-CALL AT LEAST TWO (2) BUSINESS DAYS AHEAD 1-800-922-1987
- UTILITIES MARKED AND LOCATED ON THE GROUND
- EMPLOYEES BRIEFED ON MARKING AND COLOR CODES
- EMPLOYEES TRAINED ON EXCAVATION AND SAFETY PROCEDURES FOR NATURAL GAS LINES
- WHEN EXCAVATION APPROACHES GAS LINES, EMPLOYEES MUST EXPOSE LINES BY CAREFUL PROBING AND HAND DIGGING

UTILITY	MARKING COLOR	PIPE SIZE	DEPTH
WATER	RED	8\"	12\"
SANITARY	BLUE	8\"	12\"
SEWER	ORANGE	8\"	12\"
TELEPHONE	WHITE	4\"	12\"
CABLE	PURPLE	4\"	12\"
POWER	YELLOW	4\"	12\"
STORM	GREEN	18\"	12\"

WATER PLAN APPROVAL

CHEROKEE METROPOLITAN DISTRICT DATE: _____






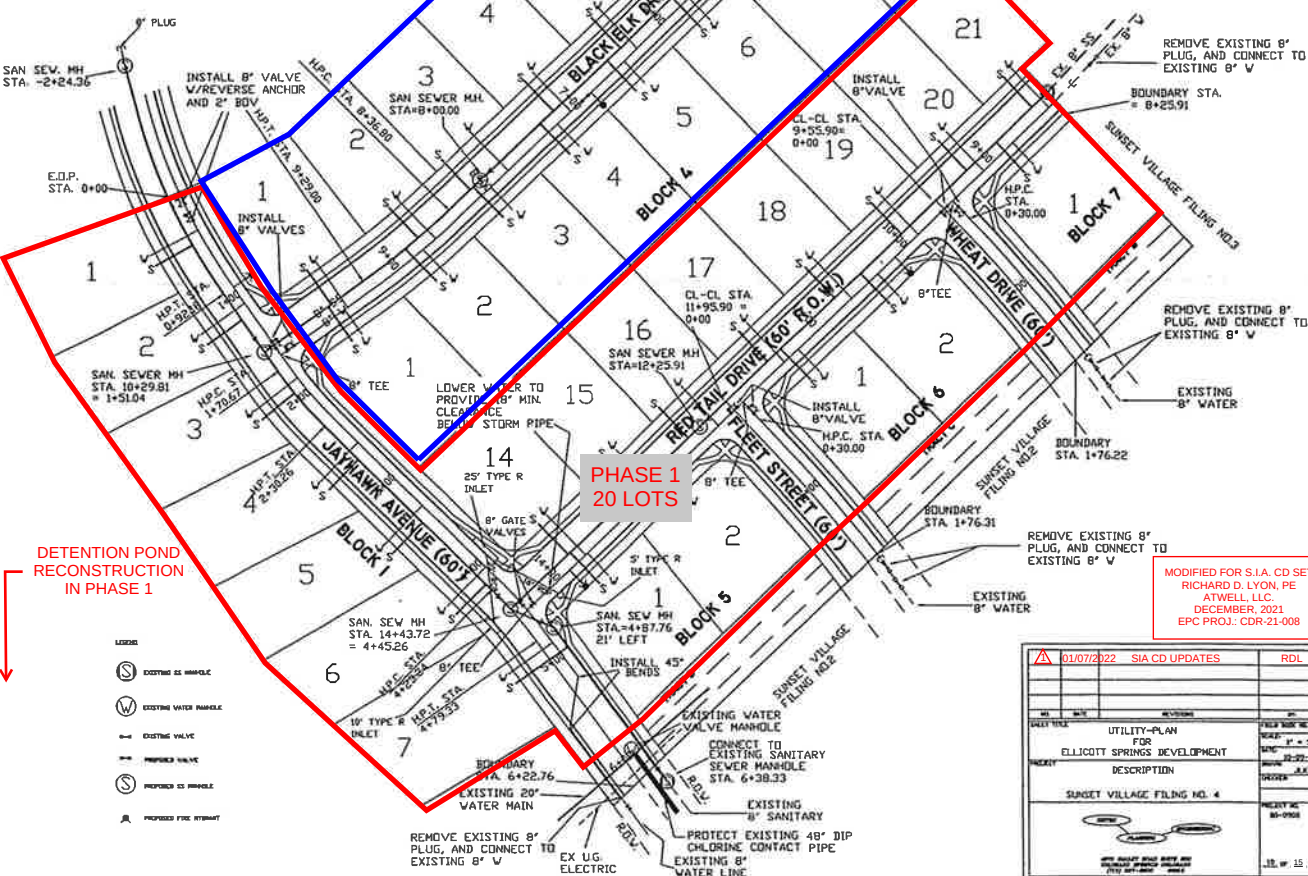





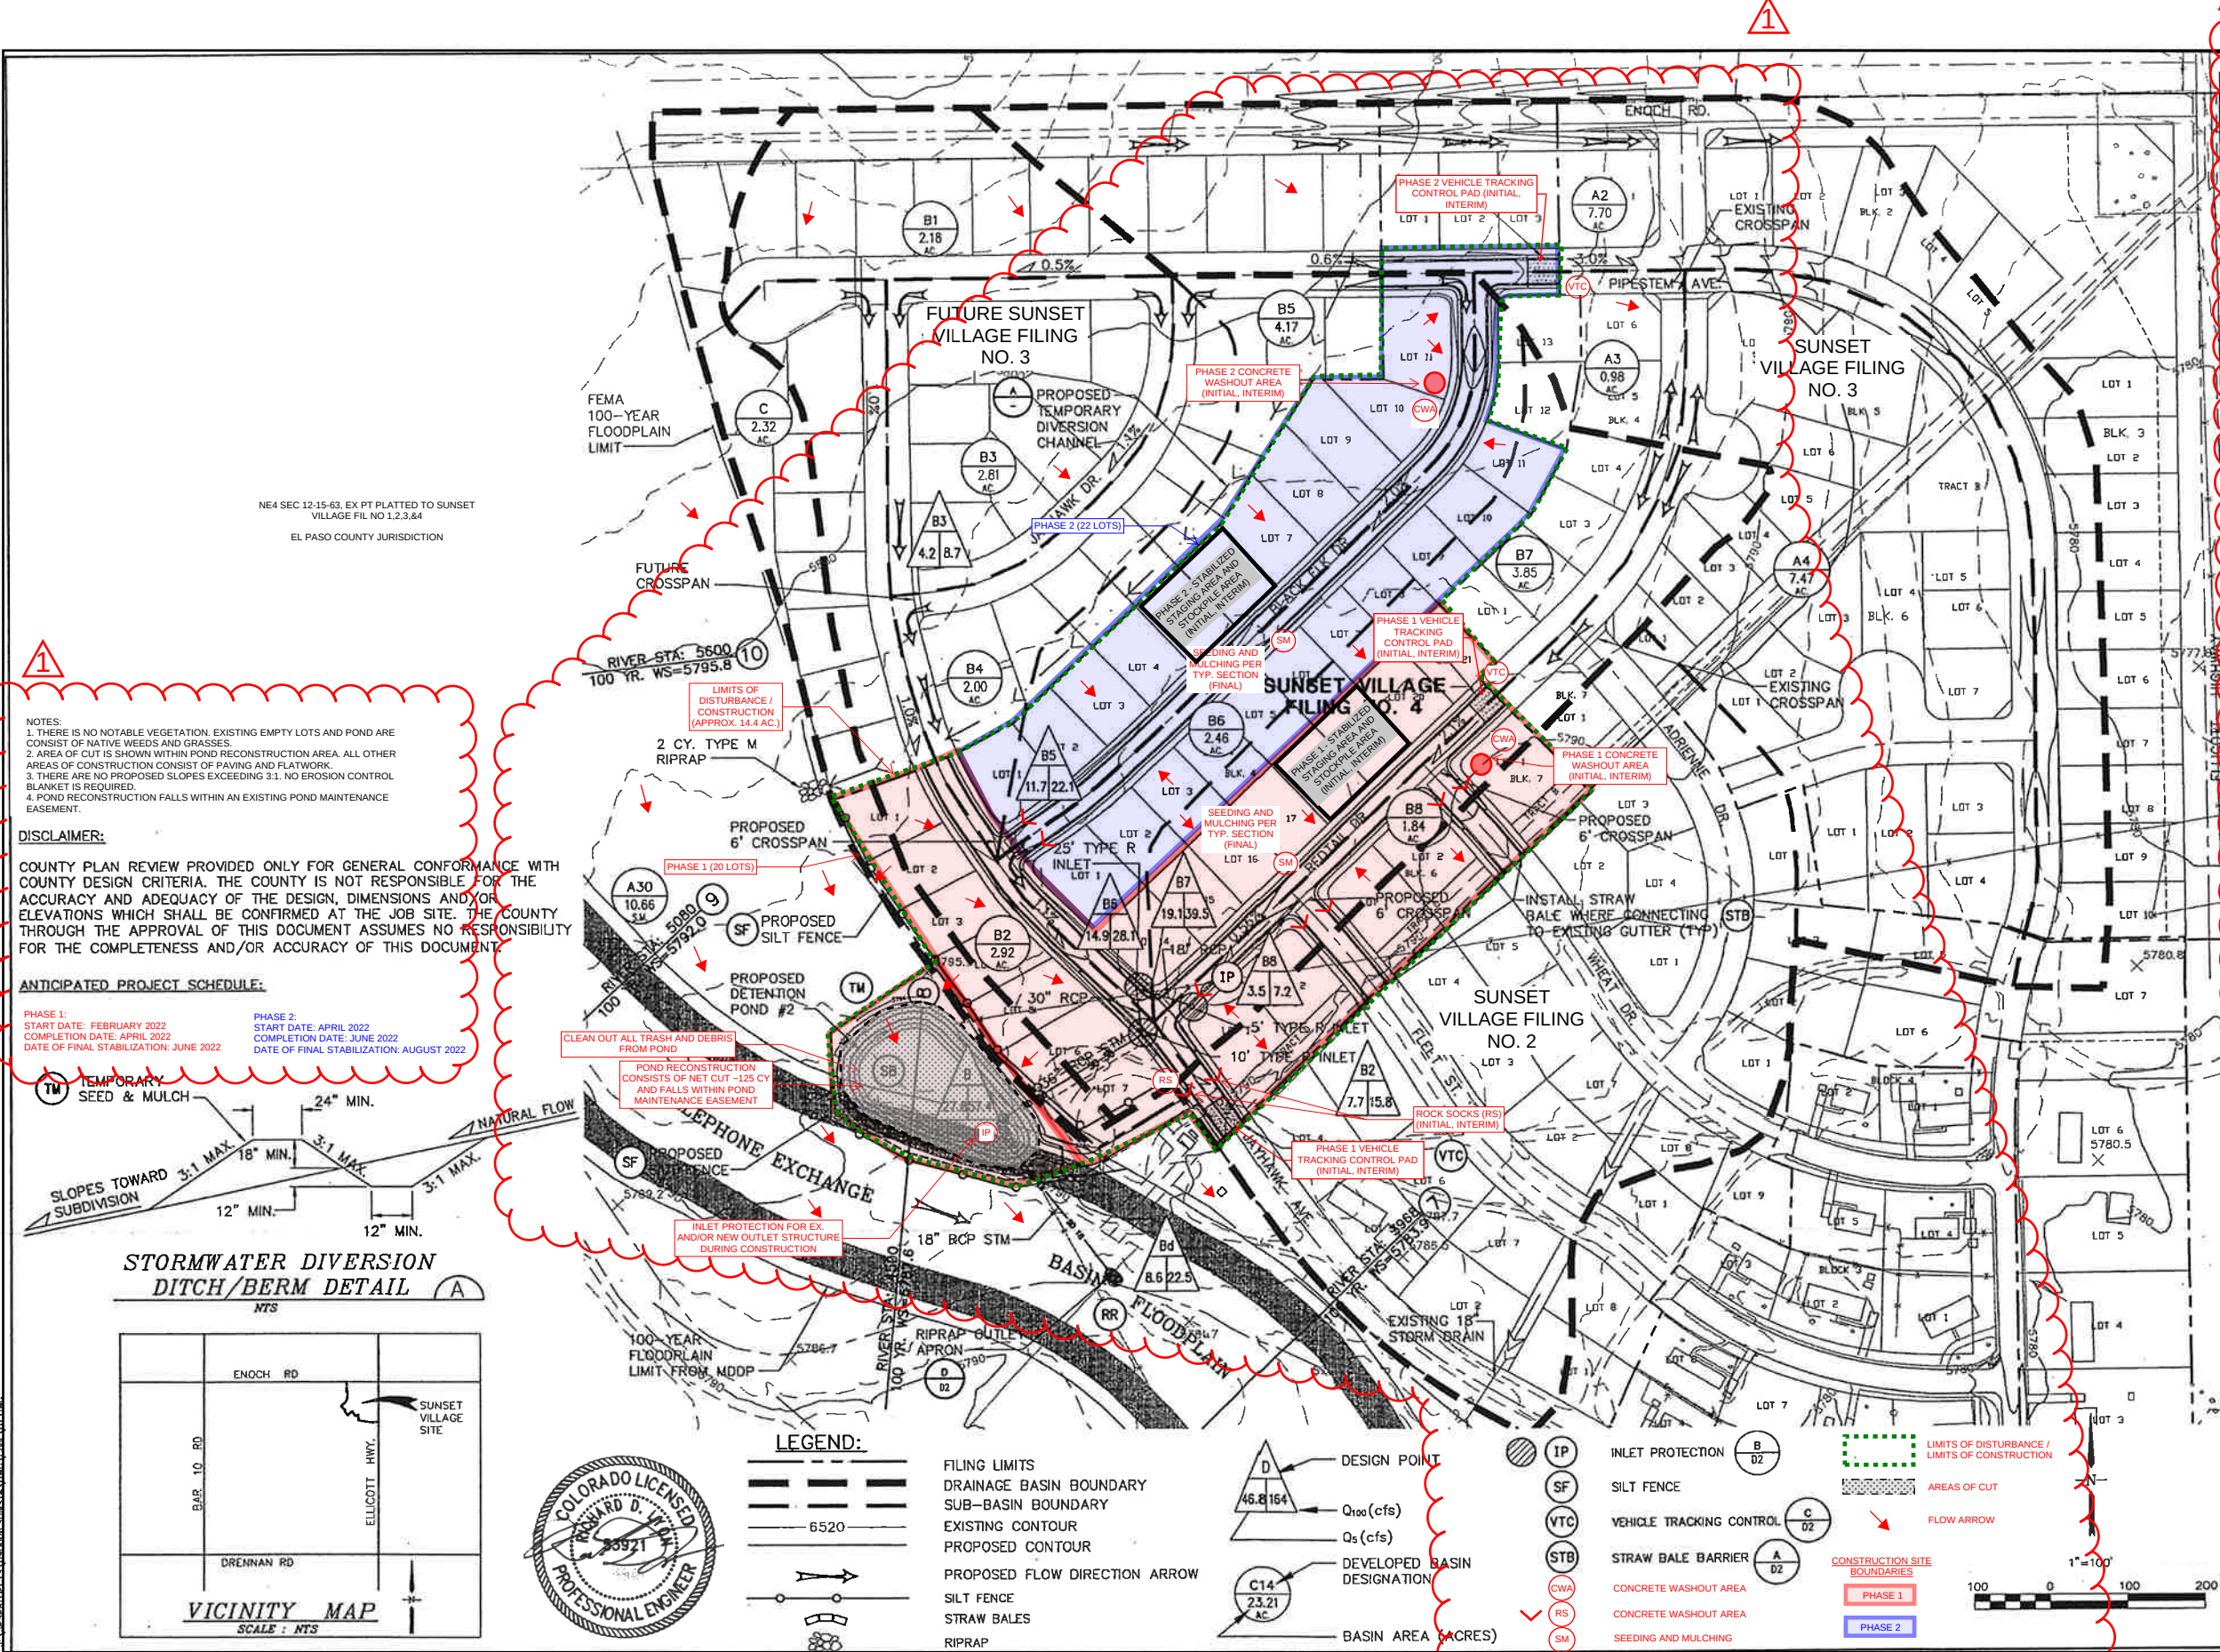



NOTES:
1. THERE IS NO NOTABLE VEGETATION. EXISTING EMPTY LOTS AND POND ARE CONSIST OF NATIVE WEEDS AND GRASSES.
2. AREA OF CUT IS SHOWN WITHIN POND RECONSTRUCTION AREA. ALL OTHER AREAS OF CONSTRUCTION CONSIST OF PAVING AND FLATWORK.
3. THERE ARE NO PROPOSED SLOPES EXCEEDING 3:1. NO EROSION CONTROL BLANKET IS REQUIRED.
4. POND RECONSTRUCTION FALLS WITHIN AN EXISTING POND MAINTENANCE EASEMENT.

DISCLAIMER:
COUNTY PLAN REVIEW PROVIDED ONLY FOR GENERAL CONFORMANCE WITH COUNTY DESIGN CRITERIA. THE COUNTY IS NOT RESPONSIBLE FOR THE ACCURACY AND ADEQUACY OF THE DESIGN, DIMENSIONS AND/OR ELEVATIONS WHICH SHALL BE CONFIRMED AT THE JOB SITE. THE COUNTY THROUGH THE APPROVAL OF THIS DOCUMENT ASSUMES NO RESPONSIBILITY FOR THE COMPLETENESS AND/OR ACCURACY OF THIS DOCUMENT.


ANTICIPATED PROJECT SCHEDULE:
PHASE 1:
START DATE: FEBRUARY 2022
COMPLETION DATE: APRIL 2022
DATE OF FINAL STABILIZATION: JUNE 2022
PHASE 2:
START DATE: APRIL 2022
COMPLETION DATE: JUNE 2022
DATE OF FINAL STABILIZATION: AUGUST 2022

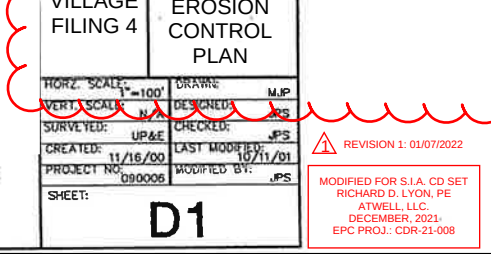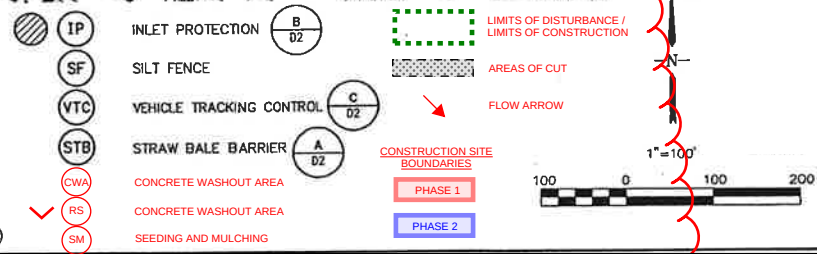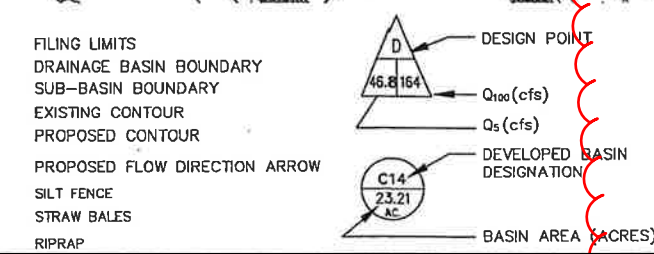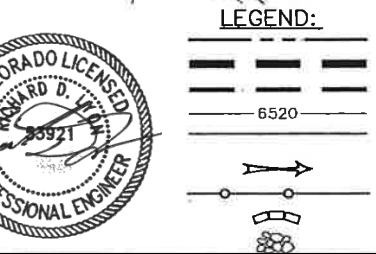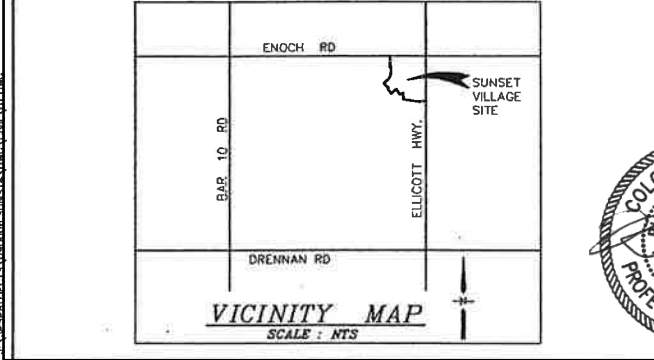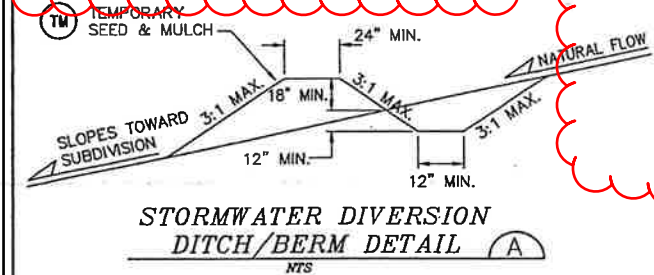

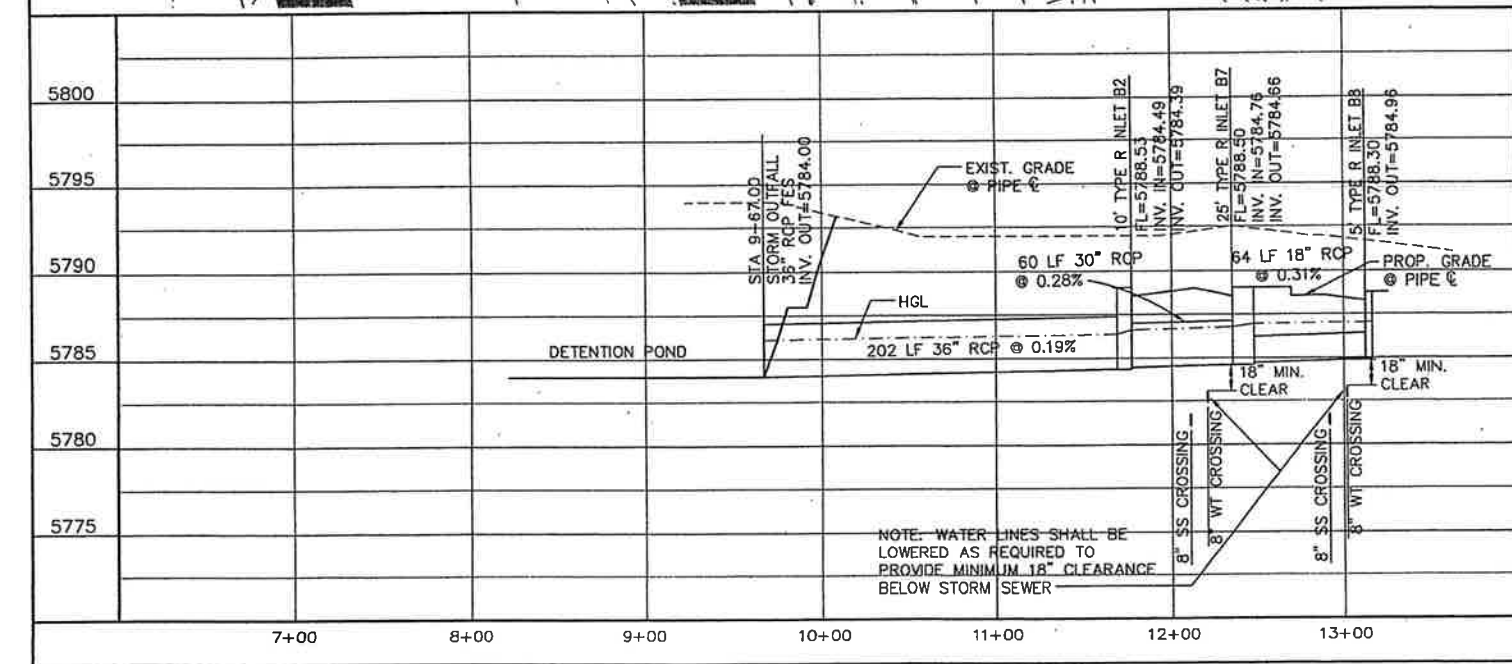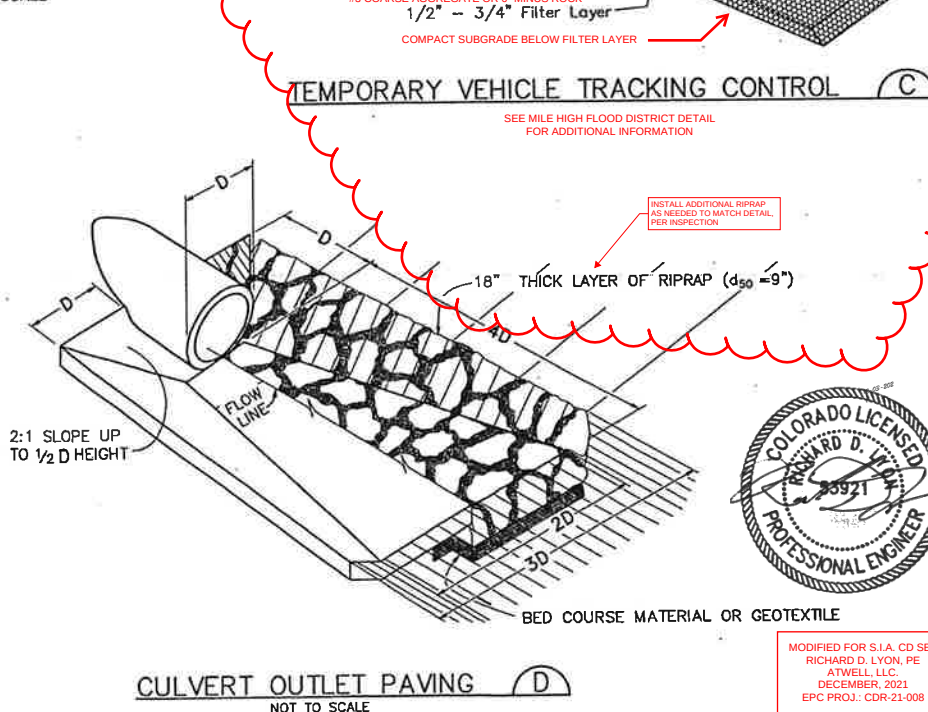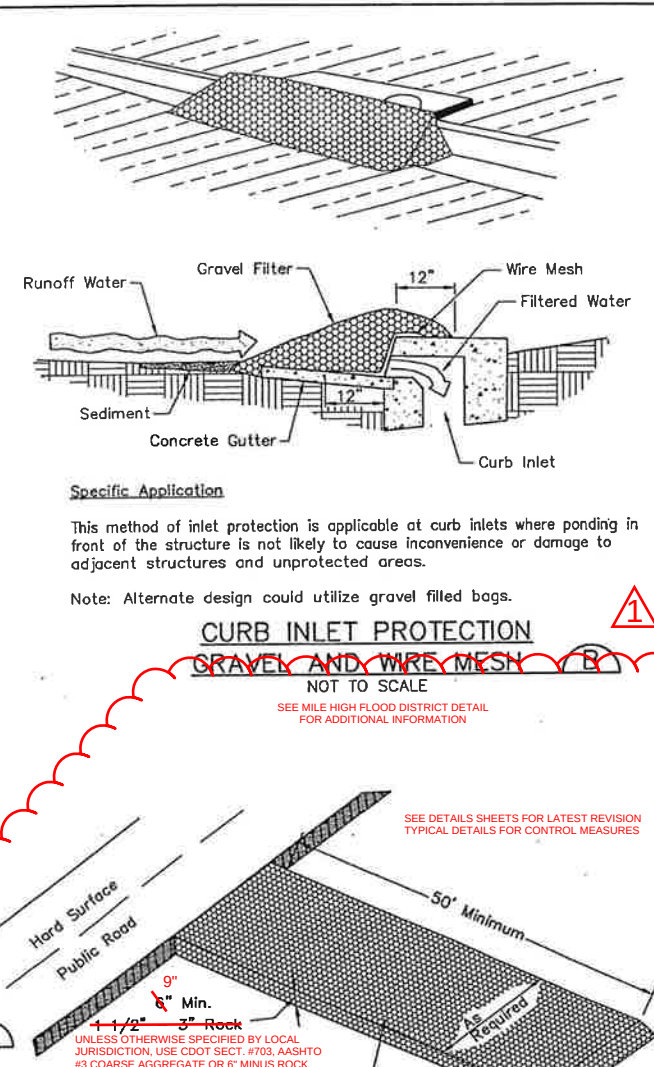
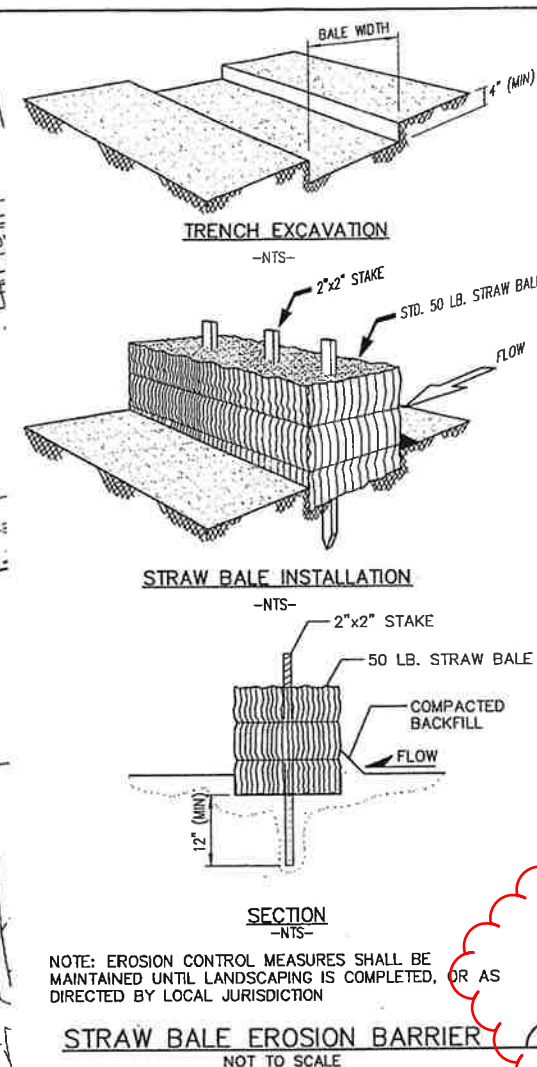


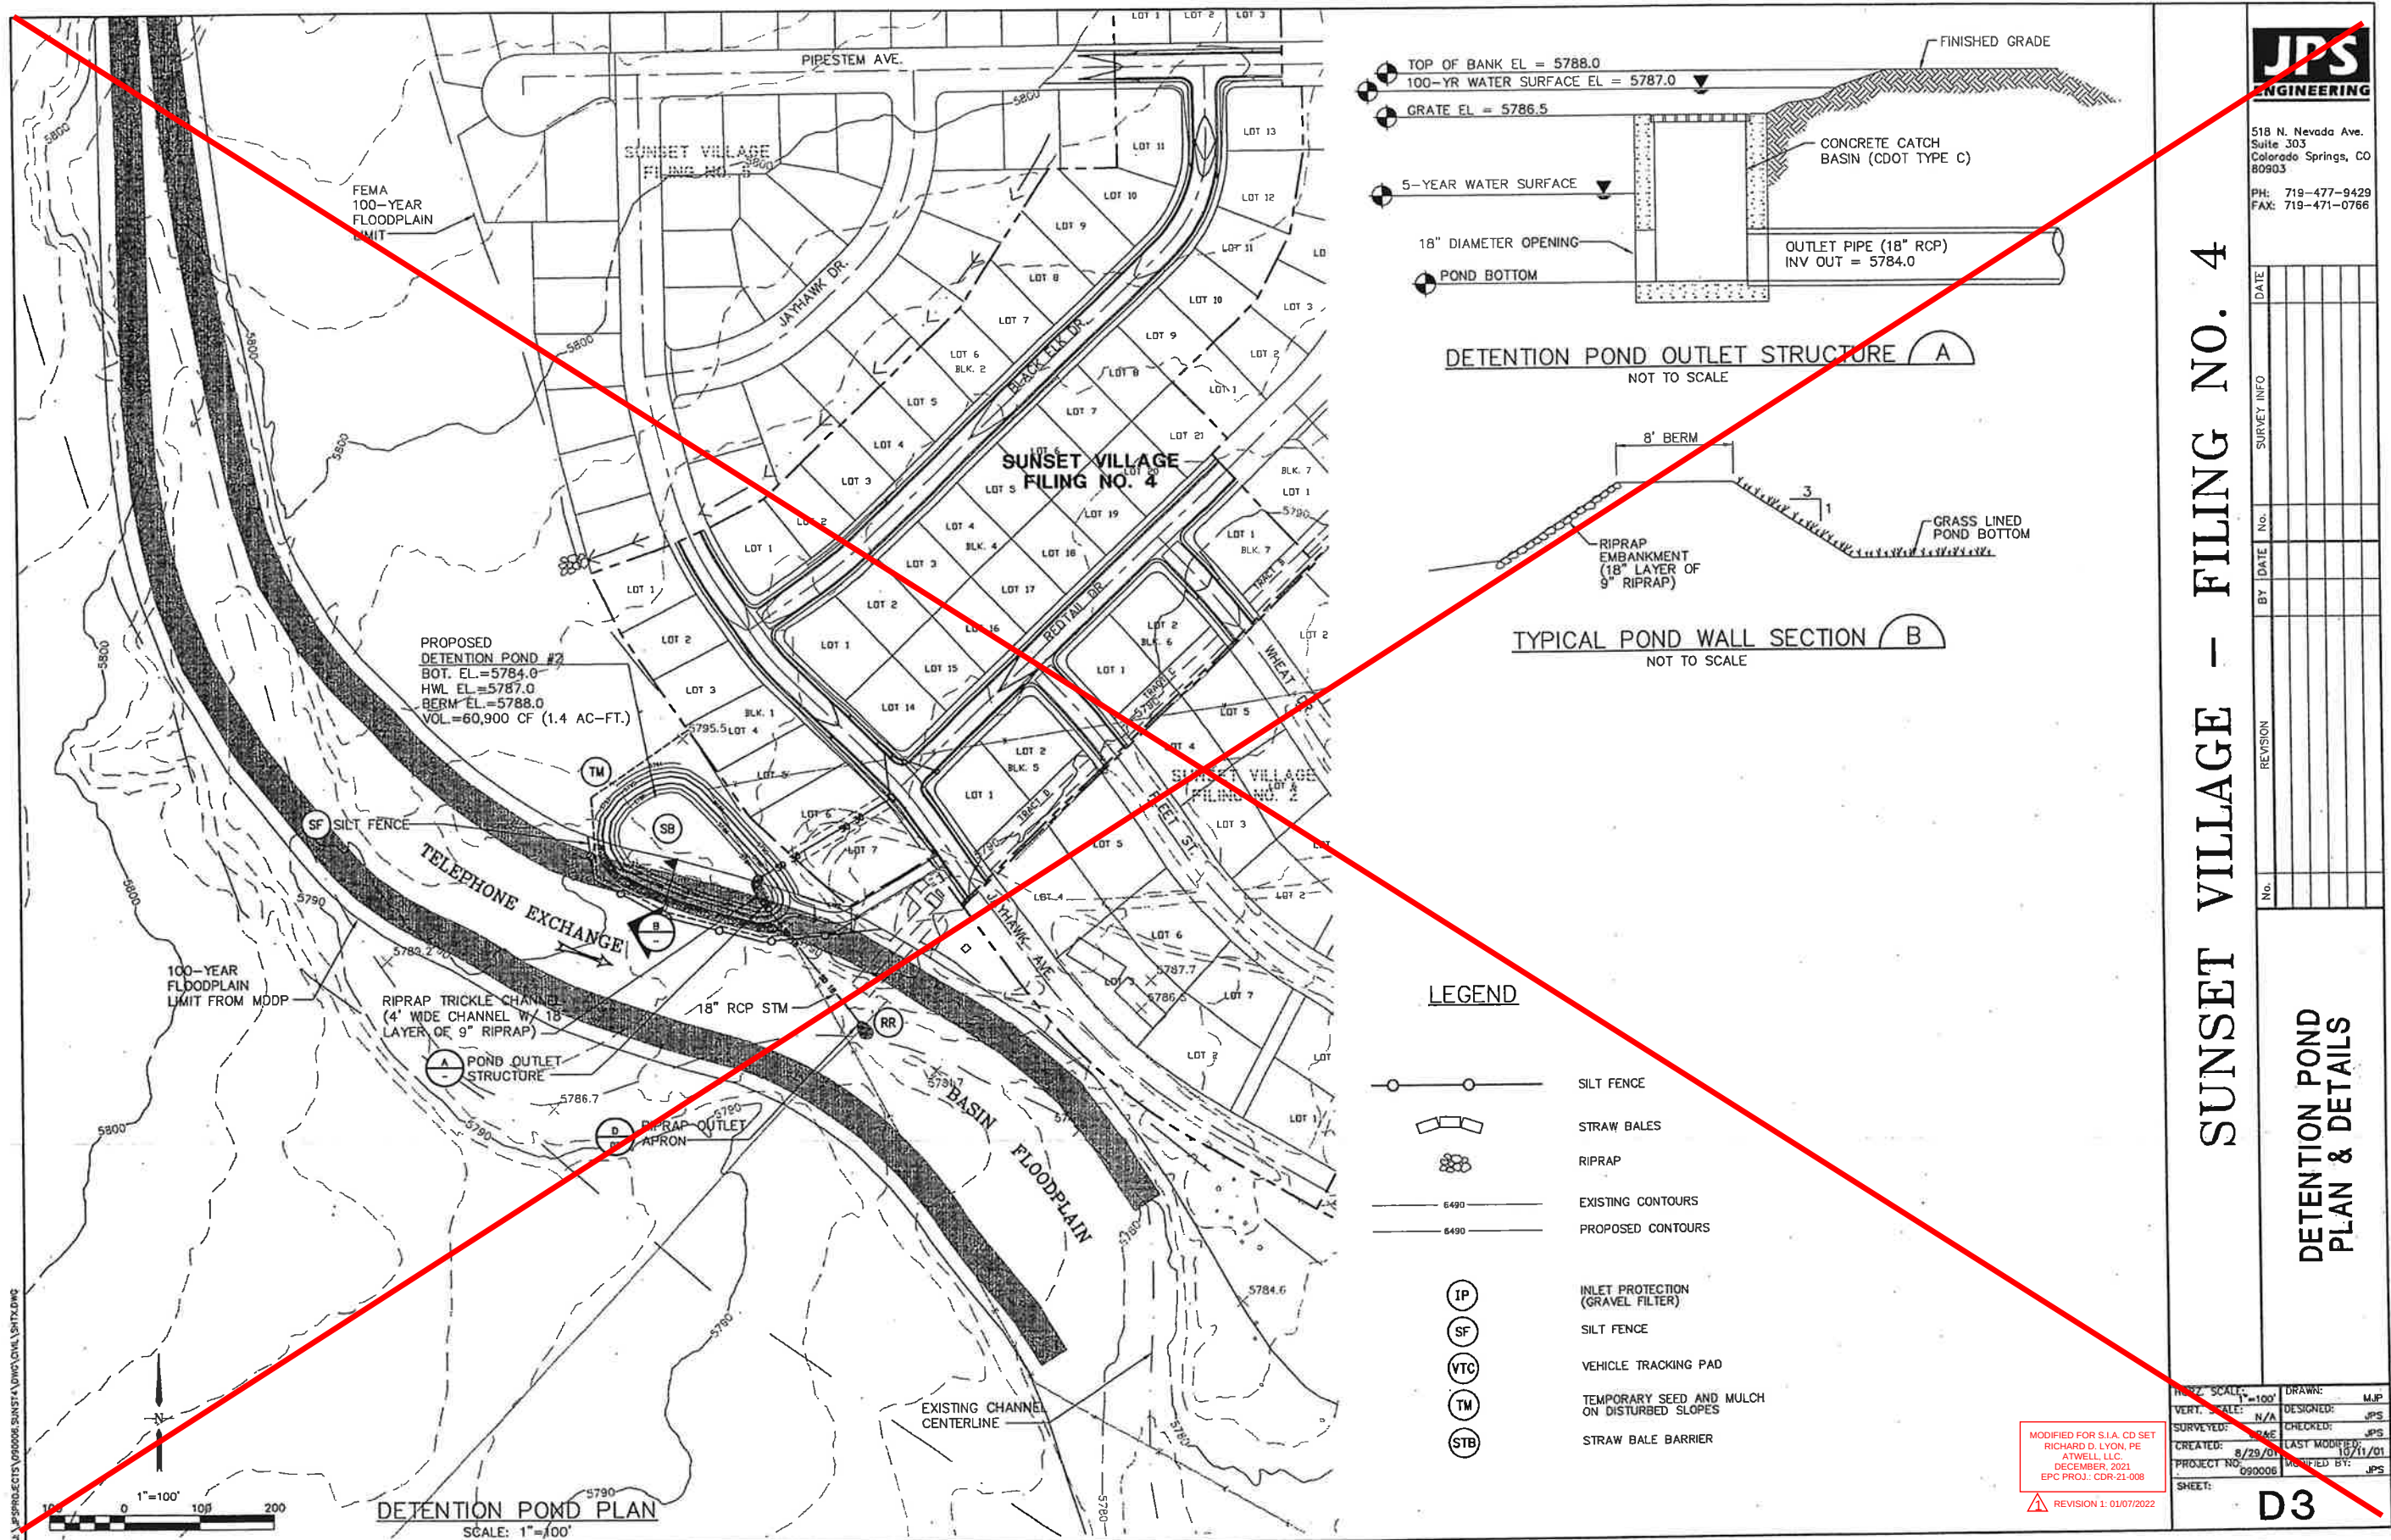

THIS SHEET IS NOT WITHIN SCOPE OF WORK FOR SUNSET VILLAGE FIL. 4
SUBDIVISION IMPROVEMENT AGREEMENT


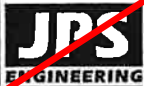


518 N. Nevada Ave.
Suite 303
Colorado Springs, CO
80903
PH: 719-477-9429
FAX: 719-471-0766

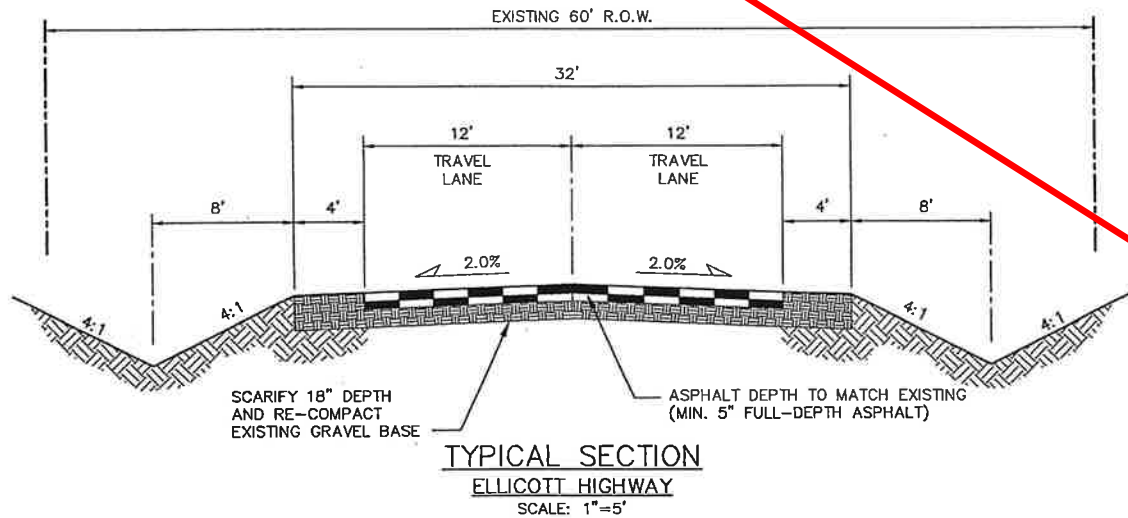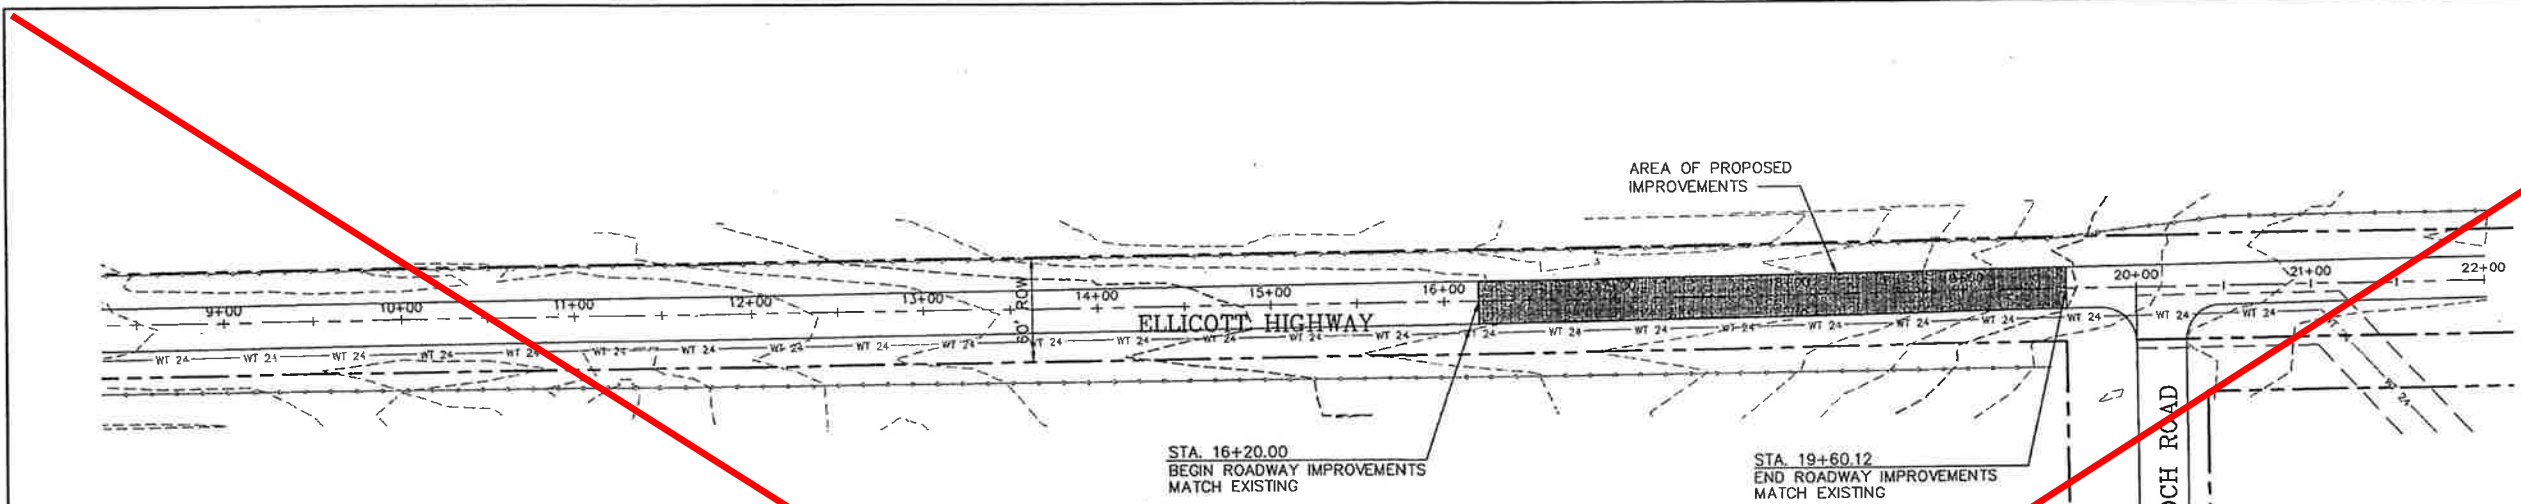

GENERAL NOTES

1. CONFORM TO EL PASO COUNTY DEPARTMENT OF TRANSPORTATION STANDARD SPECIFICATIONS.
2. THE CONTRACTOR SHALL CONTACT ALL UTILITIES FOR LOCATIONS TWO (2) WORKING DAYS PRIOR TO ANY EXCAVATION.
3. THE CONTRACTOR IS RESPONSIBLE FOR ANY DAMAGE TO UTILITIES AS A RESULT OF HIS ACTIONS. THE CONTRACTOR SHALL MAKE ALL THE REQUIRED REPAIRS IMMEDIATELY TO THE SATISFACTION OF THE UTILITY.
4. CONTRACTOR SHALL SUBMIT DETAILED TRAFFIC CONTROL PLANS AND OBTAIN PERMITS AS REQUIRED BY EL PASO COUNTY.
5. PROVIDE REQUIRED SIGNING AND TRAFFIC CONTROL DEVICES MEETING MUTCD, CDOT, AND EL PASO COUNTY STANDARDS.
6. CONTRACTOR SHALL FIELD VERIFY GRADES TO ENSURE POSITIVE DRAINAGE TRANSITION TO ADJACENT PAVEMENT.
7. REMOVE & DISPOSE OF EXISTING ASPHALT WITHIN LIMITS OF PROPOSED WORK.
8. ROADSIDE DITCHES SHALL BE RESTORED TO THE ORIGINAL CONDITION. DITCH RESTORATION SHALL BE THE RESPONSIBILITY OF THE CONTRACTOR.
9. NEW PAVEMENT ON ELLICOTT HIGHWAY SHALL BE TAPERED INTO EXISTING PAVEMENT WITH FINE MIX ASPHALT.
10. CONTRACTOR SHALL TAKE CORE SAMPLES ON AN UNDISTURBED SECTION OF ELLICOTT HIGHWAY TO DETERMINE EXISTING ASPHALT AND GRAVEL BASE THICKNESS.

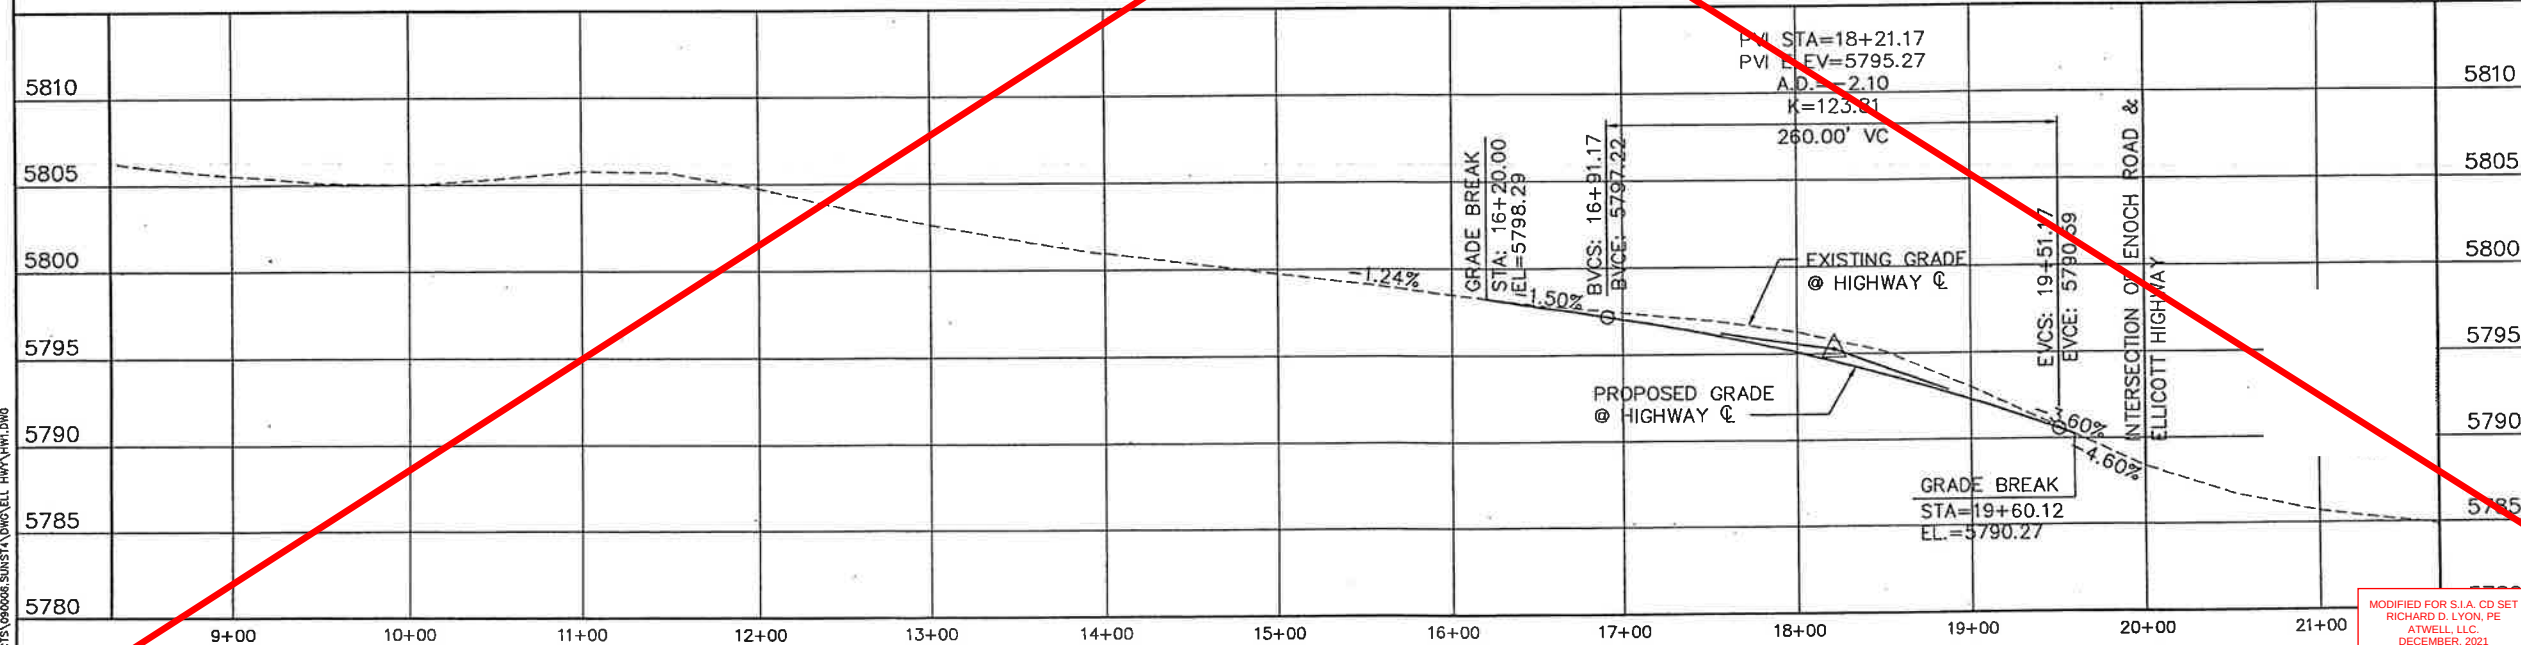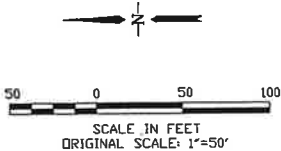

ELLICOTT HIGHWAY

HIGHWAY
IMPROVEMENT PLAN

PROJECT NO.	090006	DATE	7/10/01
PROJECT NAME	SUNSET VILLAGE	DESIGNED BY	MJP
PROJECT LOCATION	CDR-21-008	CHECKED BY	JPS
PROJECT SCALE	1"=50'	LAST MODIFIED BY	MJP
VERT. SCALE	1"=5'	DATE	7/11/01
SURVEYED BY	ATWELL, LLC	MODIFIED BY	MJP

SHEET: **HW1**

MODIFIED FOR S.I.A. CD SET
RICHARD D. LYON, PE
ATWELL, LLC
DECEMBER, 2021
EPC PROJ.: CDR-21-008
REVISION 1: 01/07/2022

PROJECT DESCRIPTION
STRIPING AND SIGNAGE MODIFICATIONS WITHIN SUNSET VILLAGE FILING NO. 4.

GENERAL NOTES
1. THE CONTRACTOR SHALL HAVE A COPY OF ALL APPLICABLE STANDARDS ON SITE FO TEH DURATION OF THE PROJECT.
2. THE CONTRACTOR SHALL ACQUIRE ALL NECESSARY PERMITS AND INSPECTIONS REQUIRED TO COMPLETE THE SCOPE OF WORK PRESENTED HEREIN.

TRAFFIC CONTROL
1. ALL SIGNAGE AND STRIPING SHALL FOLLOW THE "MANUAL ON UNIFORM TRAFFIC CONTROL DEVICES", MUTCD, CURRENT EDITION, AND ALL APPLICABLE CDOT M&S STANDARDS.
2. THE CONTRACTOR SHALL FURNISH, INSTALL, AND MAINTAIN TEMPORARY TRAFFIC CONTROL DEVICES NECESSARY THROUGHOUT THE DURATION OF CONSTRUCTION IN CONFORMANCE WITH TRAFFIC CONTROL PLANS AND/OR APPROVED MHT.
3. THE TRAFFIC CONTROL SUPERVISOR SHALL COORDINATE CONSTRUCTION ZONE TRAFFIC CONTROL ACTIVITIES WITH ALL APPROPRIATE OFFICIALS.
4. THE CONTRACTOR SHALL MAINTAIN FULL COMPLIANCE PAVEMENT MARKINGS OR APPROVED DECIVES ON THE ROADWAYS DURING ALL PHASES OF THE CONSTRUCTION PERIOD.

EL PASO COUNTY SIGNING AND STRIPING NOTES:
1. ALL SIGNS AND PAVEMENT MARKINGS SHALL BE IN COMPLIANCE WITH THE CURRENT MANUAL ON UNIFORM TRAFFIC CONTROL DEVICES (MUTCD).

2. REMOVAL OF EXISTING PAVEMENT MARKINGS SHALL BE ACCOMPLISHED BY A METHOD THAT DOES NOT MATERIALLY DAMAGE THE PAVEMENT. THE PAVEMENT MARKINGS SHALL BE REMOVED TO THE EXTENT THAT THEY WILL NOT BE VISIBLE UNDER DAY OR NIGHT CONDITIONS. AT NO TIME WILL IT BE ACCEPTABLE TO PAINT OVER EXISTING PAVEMENT MARKINGS.

3. ANY DEVIATION FROM THE STRIPING AND SIGNING PLAN SHALL BE APPROVED BY EL PASO COUNTY PLANNING AND COMMUNITY DEVELOPMENT.

4. ALL SIGNS SHOWN ON THE SIGNING AND STRIPING PLAN SHALL BE NEW SIGNS. EXISTING SIGNS MAY REMAIN OR BE REUSED IF THEY MEET CURRENT EL PASO COUNTY AND MUTCD STANDARDS.

5. STREET NAME AND REGULATORY STOP SIGNS SHALL BE ON THE SAME POST AT INTERSECTIONS.

6. ALL REMOVED SIGNS SHALL BE DISPOSED OF IN A PROPER MANNER BY THE CONTRACTOR.

7. ALL STREET NAME SIGNS SHALL HAVE "D" SERIES LETTERS, WITH LOCAL ROADWAY SIGNS BEING 4" UPPER-LOWER CASE LETTERING ON 8" BLANK AND NON-LOCAL ROADWAY SIGNS BEING 6" LETTERING, UPPER-LOWER CASE ON 12" BLANK, WITH A WHITE BORDER THAT IS NOT RECESSED. MULTI-LANE ROADWAYS WITH SPEED LIMITS OF 40 MPH OR HIGHER SHALL HAVE 8" UPPER-LOWER CASE LETTERING ON 18" BLANK WITH A WHITE BORDER THAT IS NOT RECESSED. THE WIDTH OF THE NON-RECESSED WHITE BORDERS SHALL MATCH PAGE 255 OF THE 2012 MUTCD "STANDARD HIGHWAY SIGNS"

8. ALL TRAFFIC SIGNS SHALL HAVE A MINIMUM HIGH INTENSITY PRISMATIC GRADE SHEETING.

9. ALL LOCAL RESIDENTIAL STREET SIGNS SHALL BE MOUNTED ON A 1.75" X 1.75" SQUARE TUBE SIGN POST AND STUB POST BASE. FOR OTHER APPLICATIONS, REFER TO THE CDOT STANDARD S-614-8 REGARDING USE OF THE P2 TUBULAR STEEL POST SLIPBASE DESIGN.


10. ALL SIGNS SHALL BE SINGLE SHEET ALUMINUM WITH 0.100" MINIMUM THICKNESS.

11. ALL LIMIT LINES/STOP LINES, CROSSWALK LINES, PAVEMENT LEGENDS, AND ARROWS SHALL BE A MINIMUM 125 MIL THICKNESS PREFORMED THERMOPLASTIC PAVEMENT MARKINGS WITH TAPERED LEADING EDGES PER CDOT STANDARD S-627-1. WORD AND SYMBOL MARKINGS SHALL BE THE NARROW TYPE. STOP BARS SHALL BE 24" IN WIDTH. CROSSWALKS LINES SHALL BE 12" WIDE AND 8' LONG PER CDOT S-627-1.

12. ALL LONGITUDINAL LINES SHALL BE A MINIMUM 15MIL THICKNESS EPOXY PAINT. ALL NON-LOCAL RESIDENTIAL ROADWAYS SHALL INCLUDE BOTH RIGHT AND LEFT EDGE LINE STRIPING AND ANY ADDITIONAL STRIPING AS REQUIRED BY CDOT S-627-1.

13. THE CONTRACTOR SHALL NOTIFY EL PASO COUNTY PLANNING AND COMMUNITY DEVELOPMENT (719) 520-6819 PRIOR TO AND UPON COMPLETION OF SIGNING AND STRIPING.

14. THE CONTRACTOR SHALL OBTAIN A WORK IN THE RIGHT OF WAY PERMIT FROM THE EL PASO COUNTY DEPARTMENT OF PUBLIC WORKS (DPW) PRIOR TO ANY SIGNAGE OR STRIPING WORK WITHIN AN EXISTING EL PASO COUNTY ROADWAY.


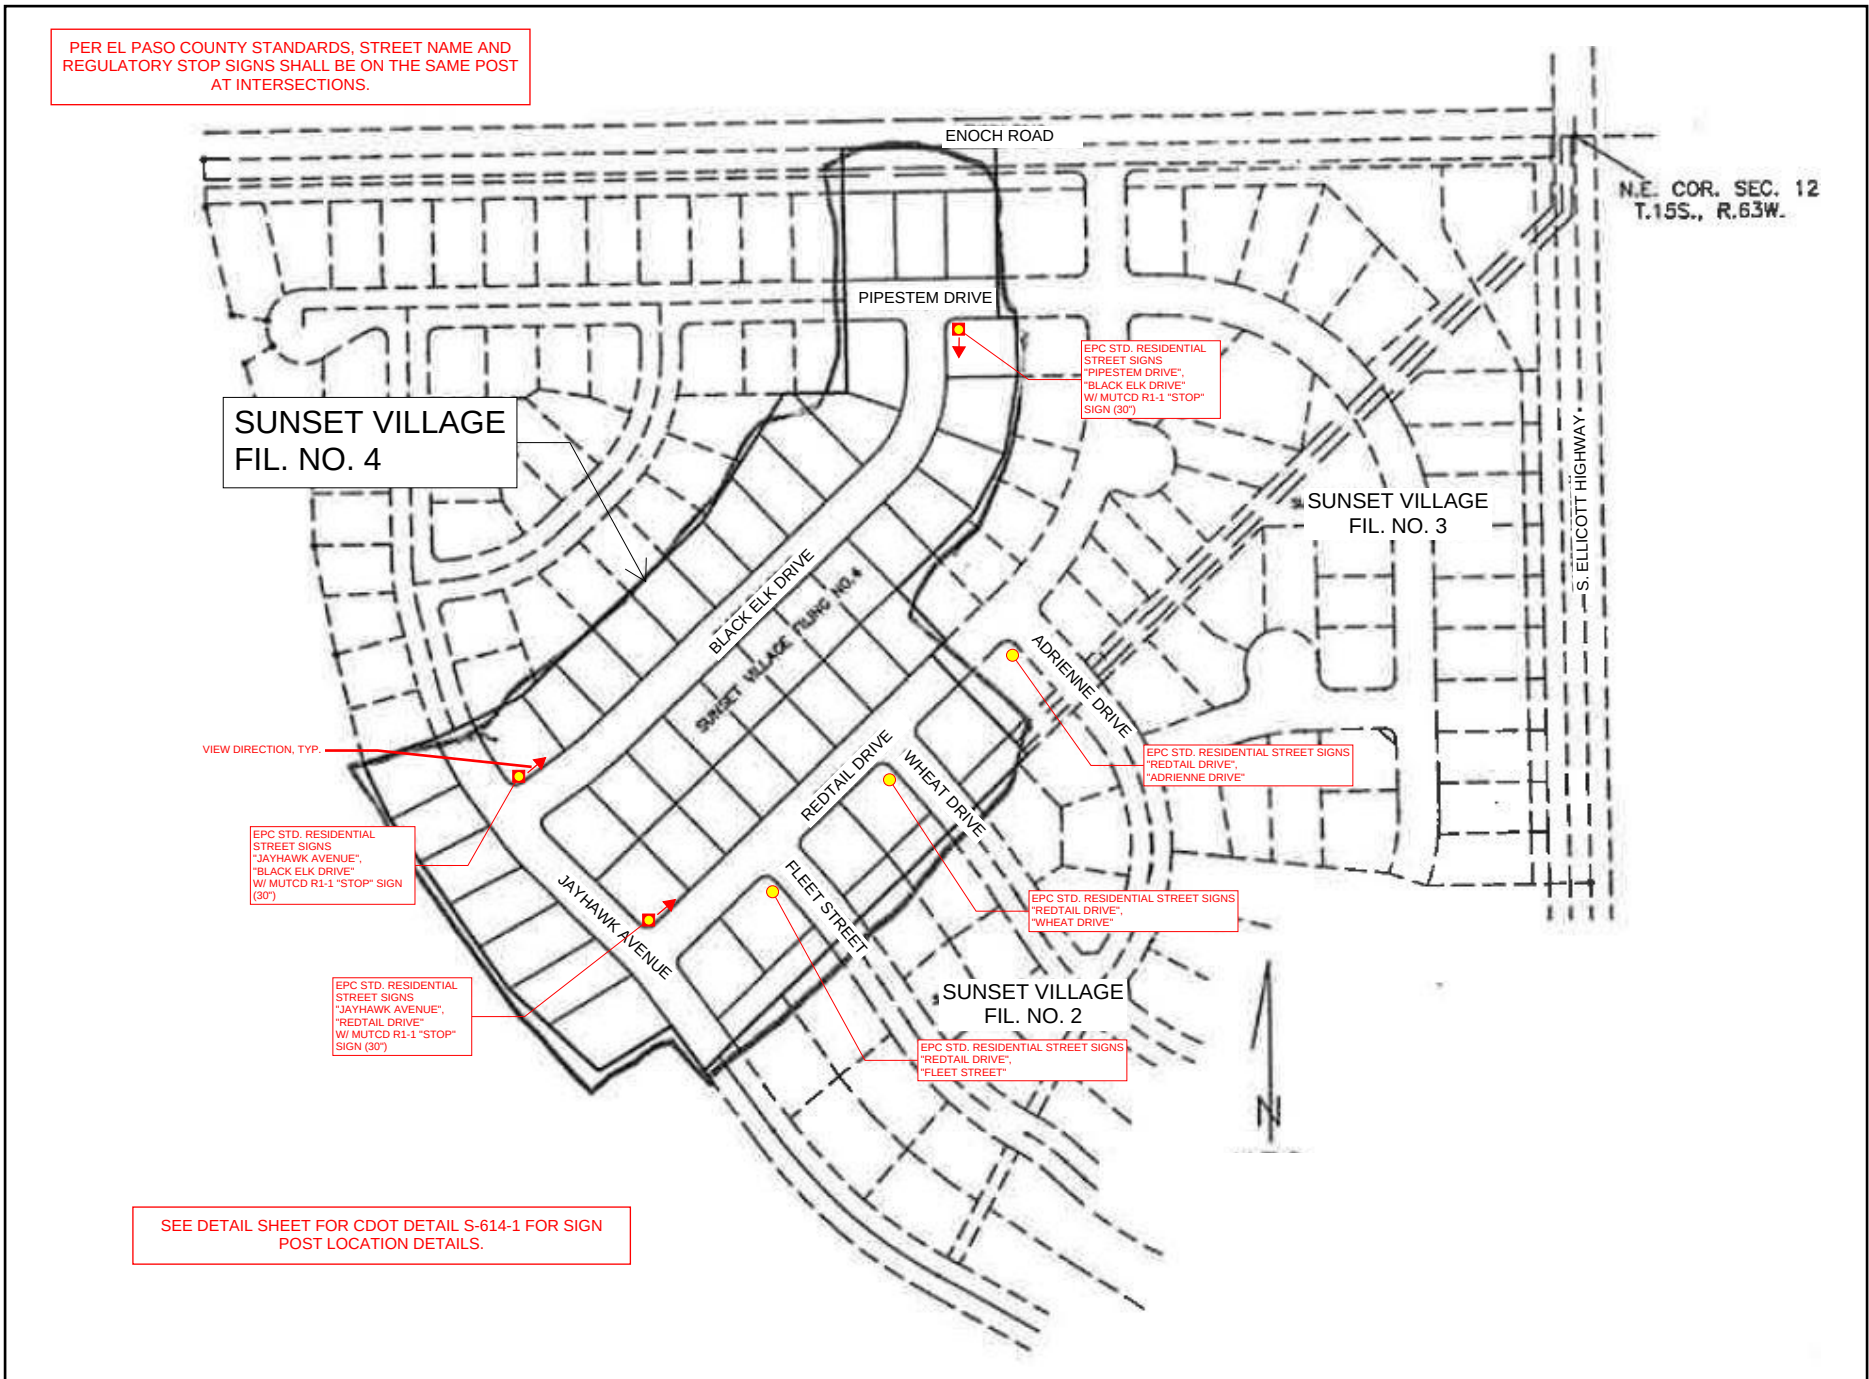





MODIFIED FOR S.I.A. CD SET
RICHARD D. LYON, PE
ATWELL, LLC
DECEMBER, 2021
EPC PROJ.: CDR-21-008

REVISION 1: 01/07/2022



SUBDIVISION: SUNSET VILLAGE FIL. NO. 4
SHEET: 15
STRIPING AND SIGNAGE PLAN
EPC PLAN NO. CDR-21-008

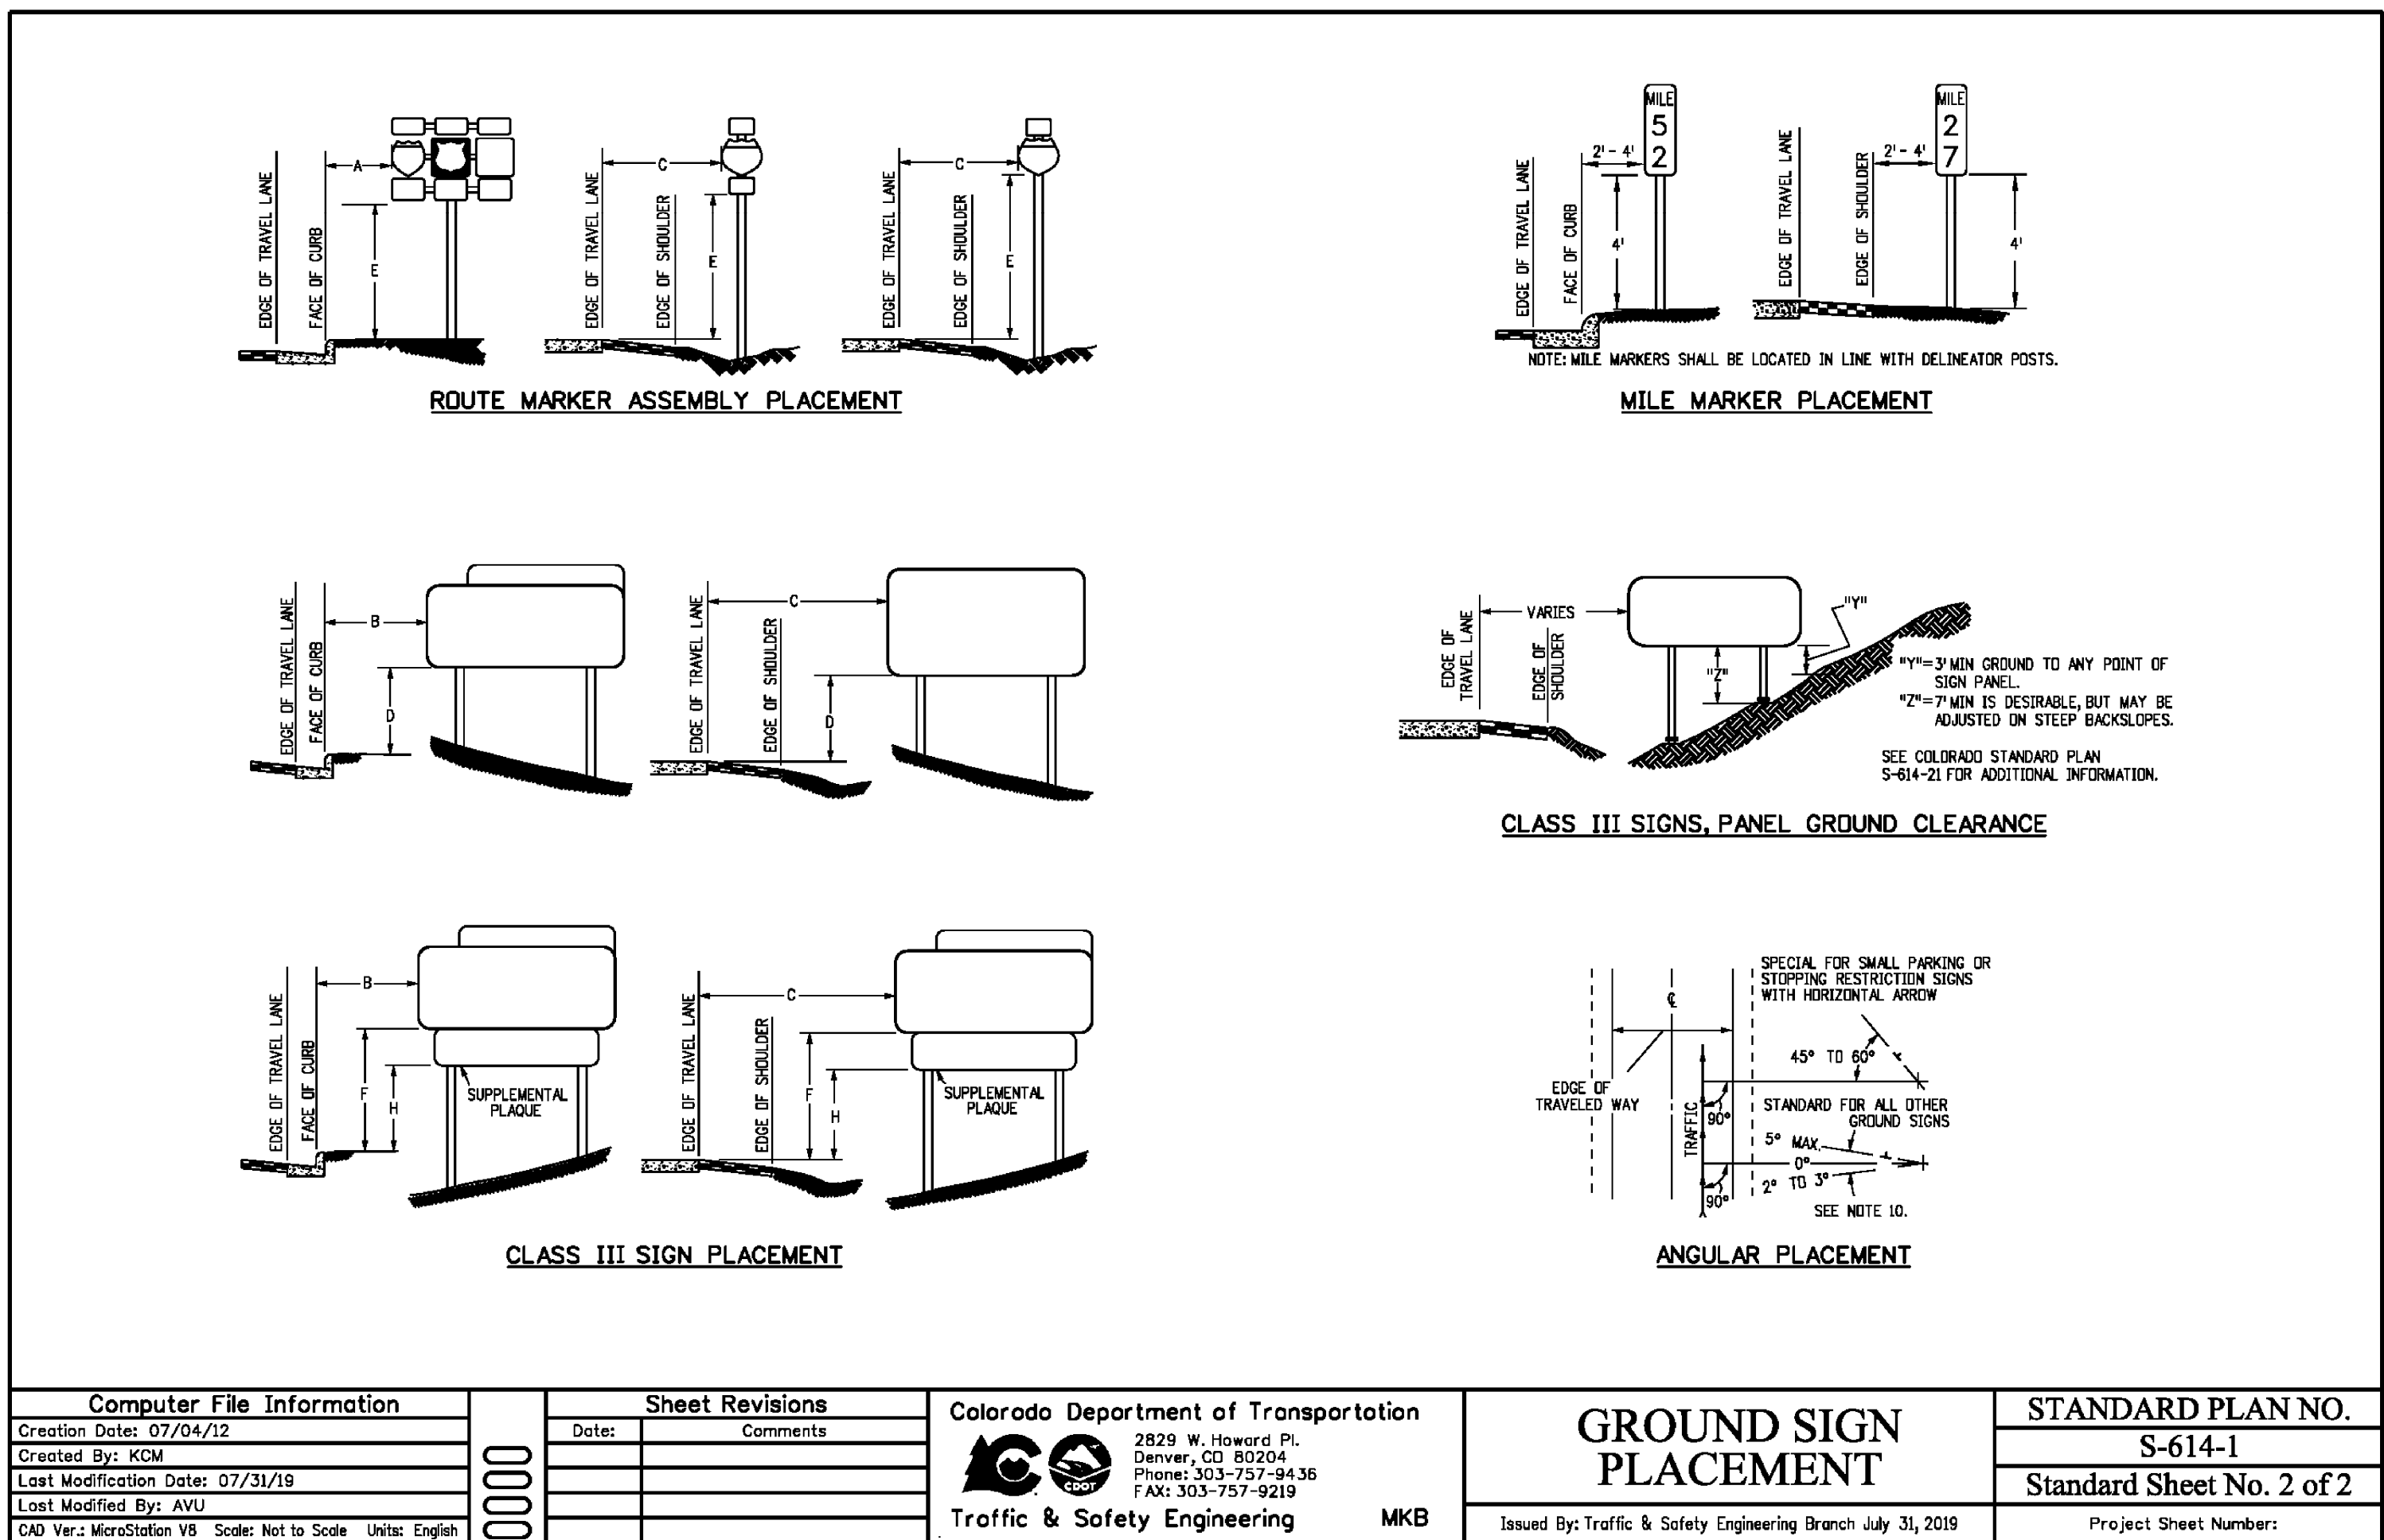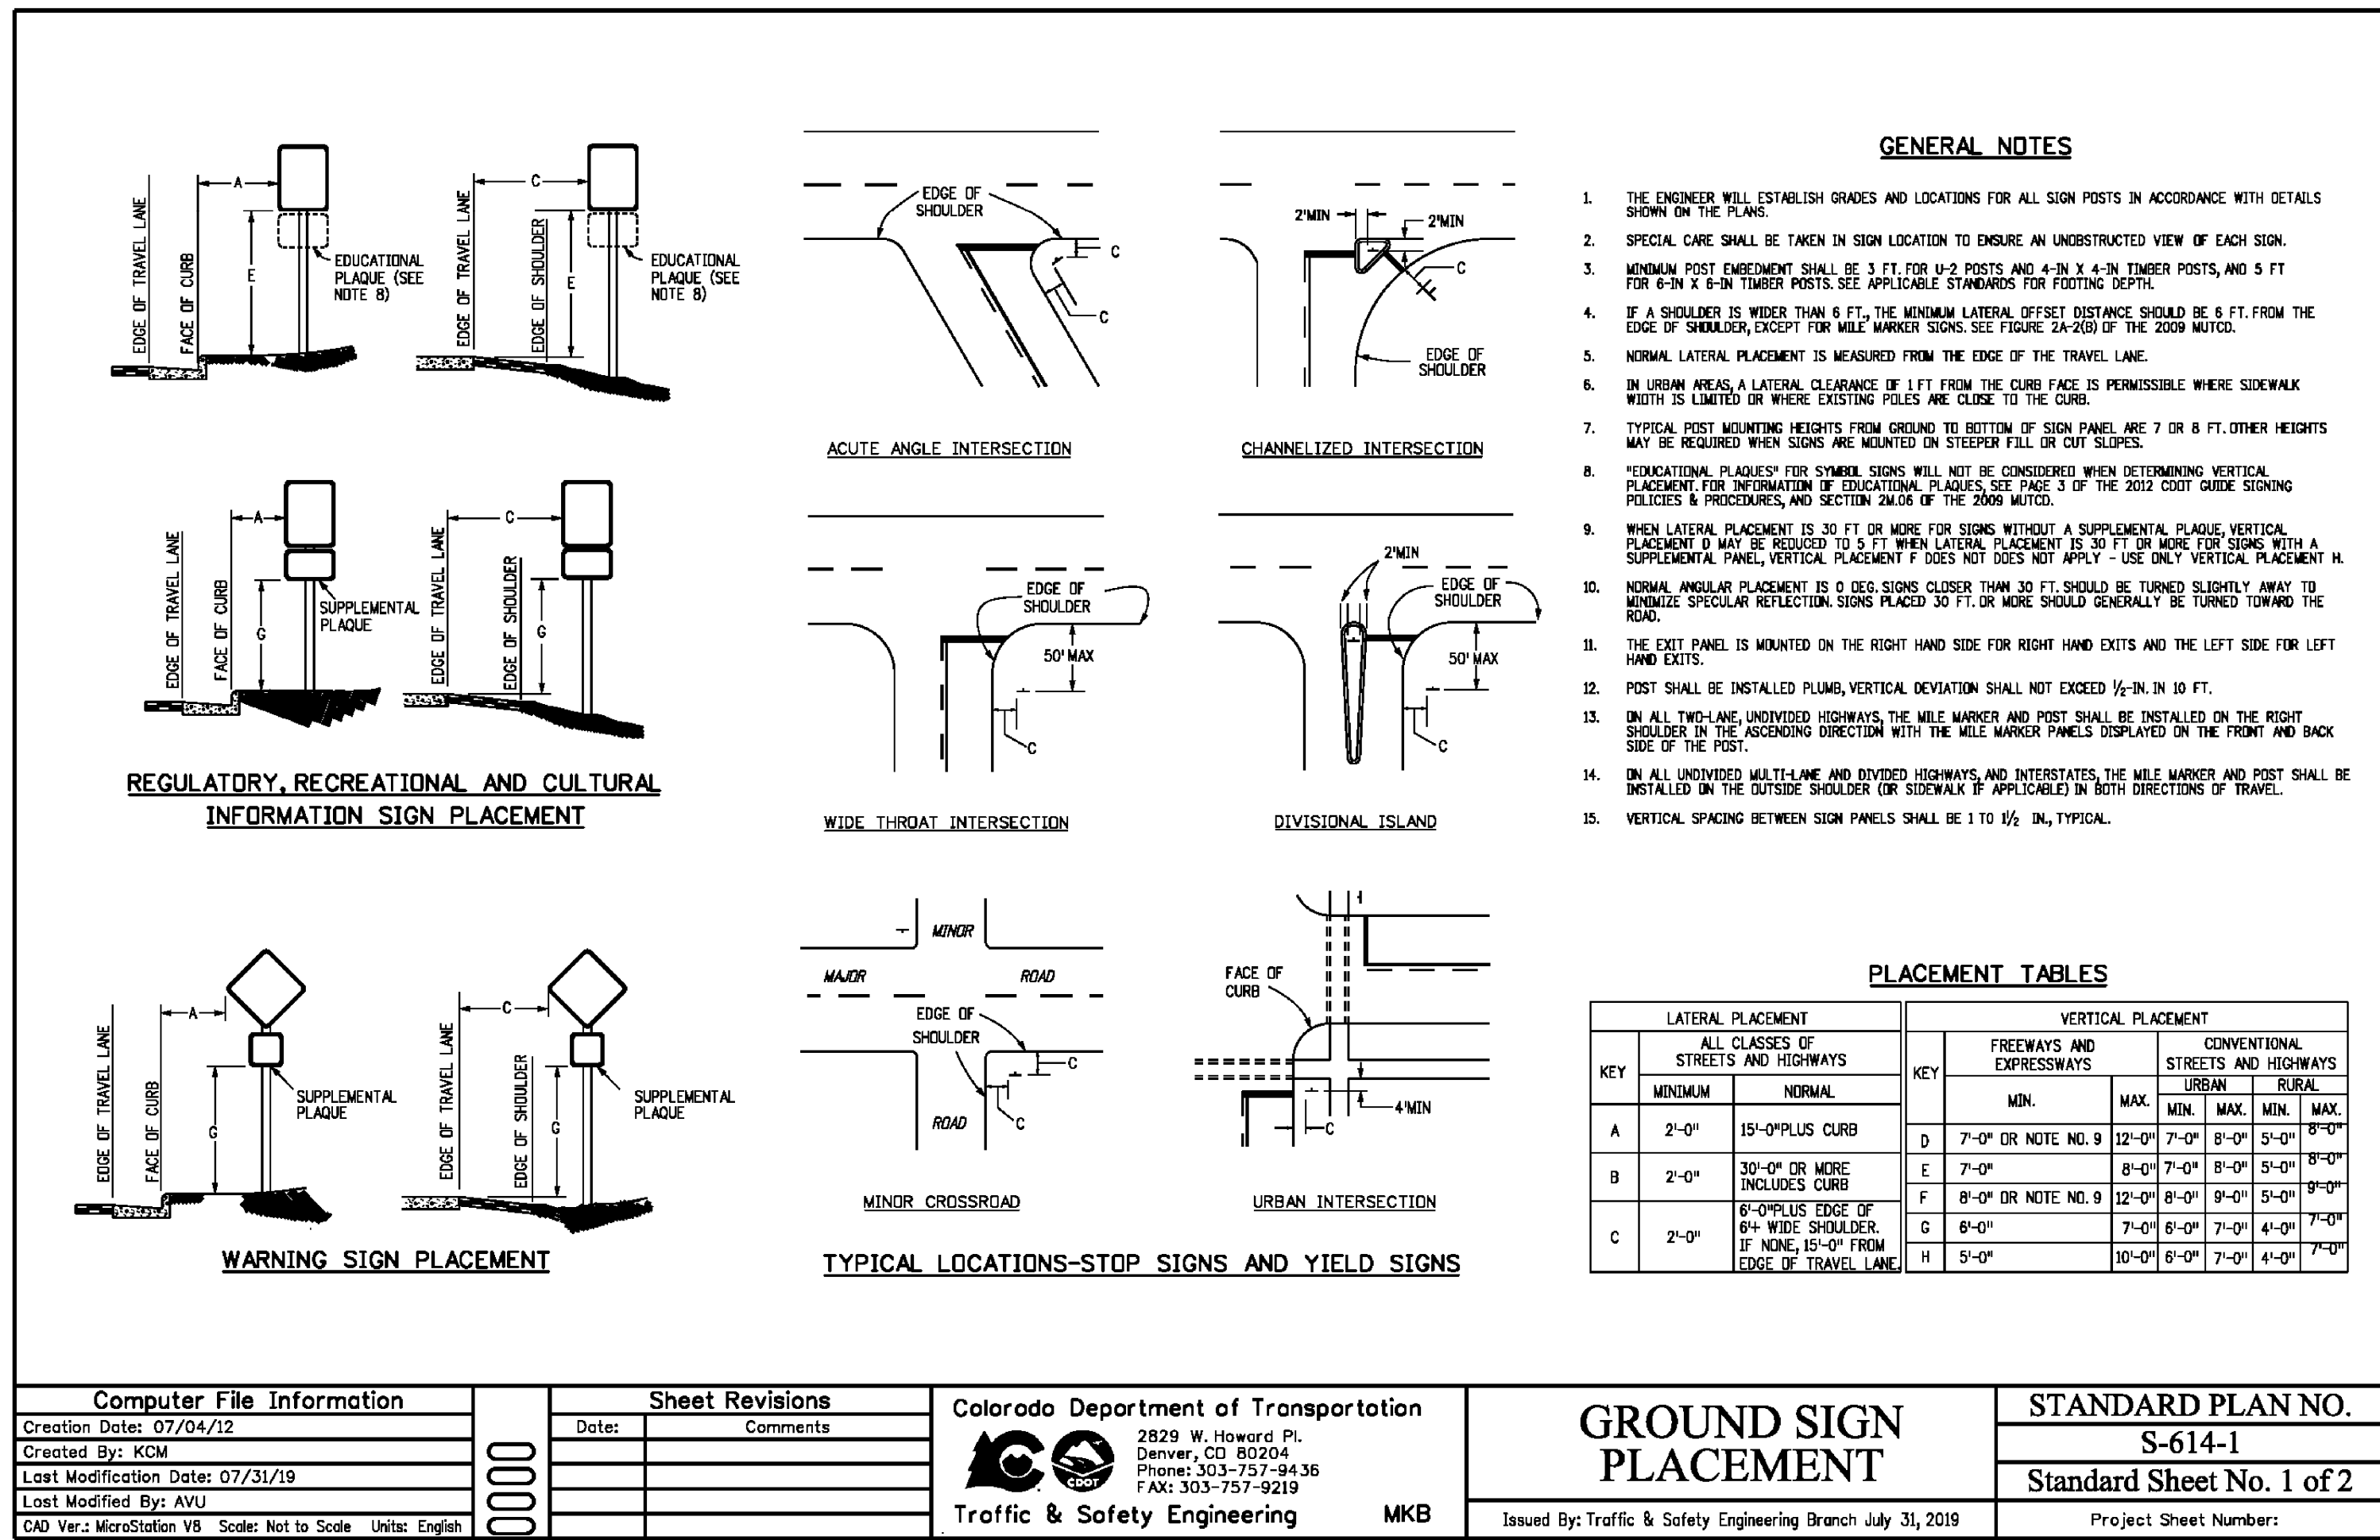

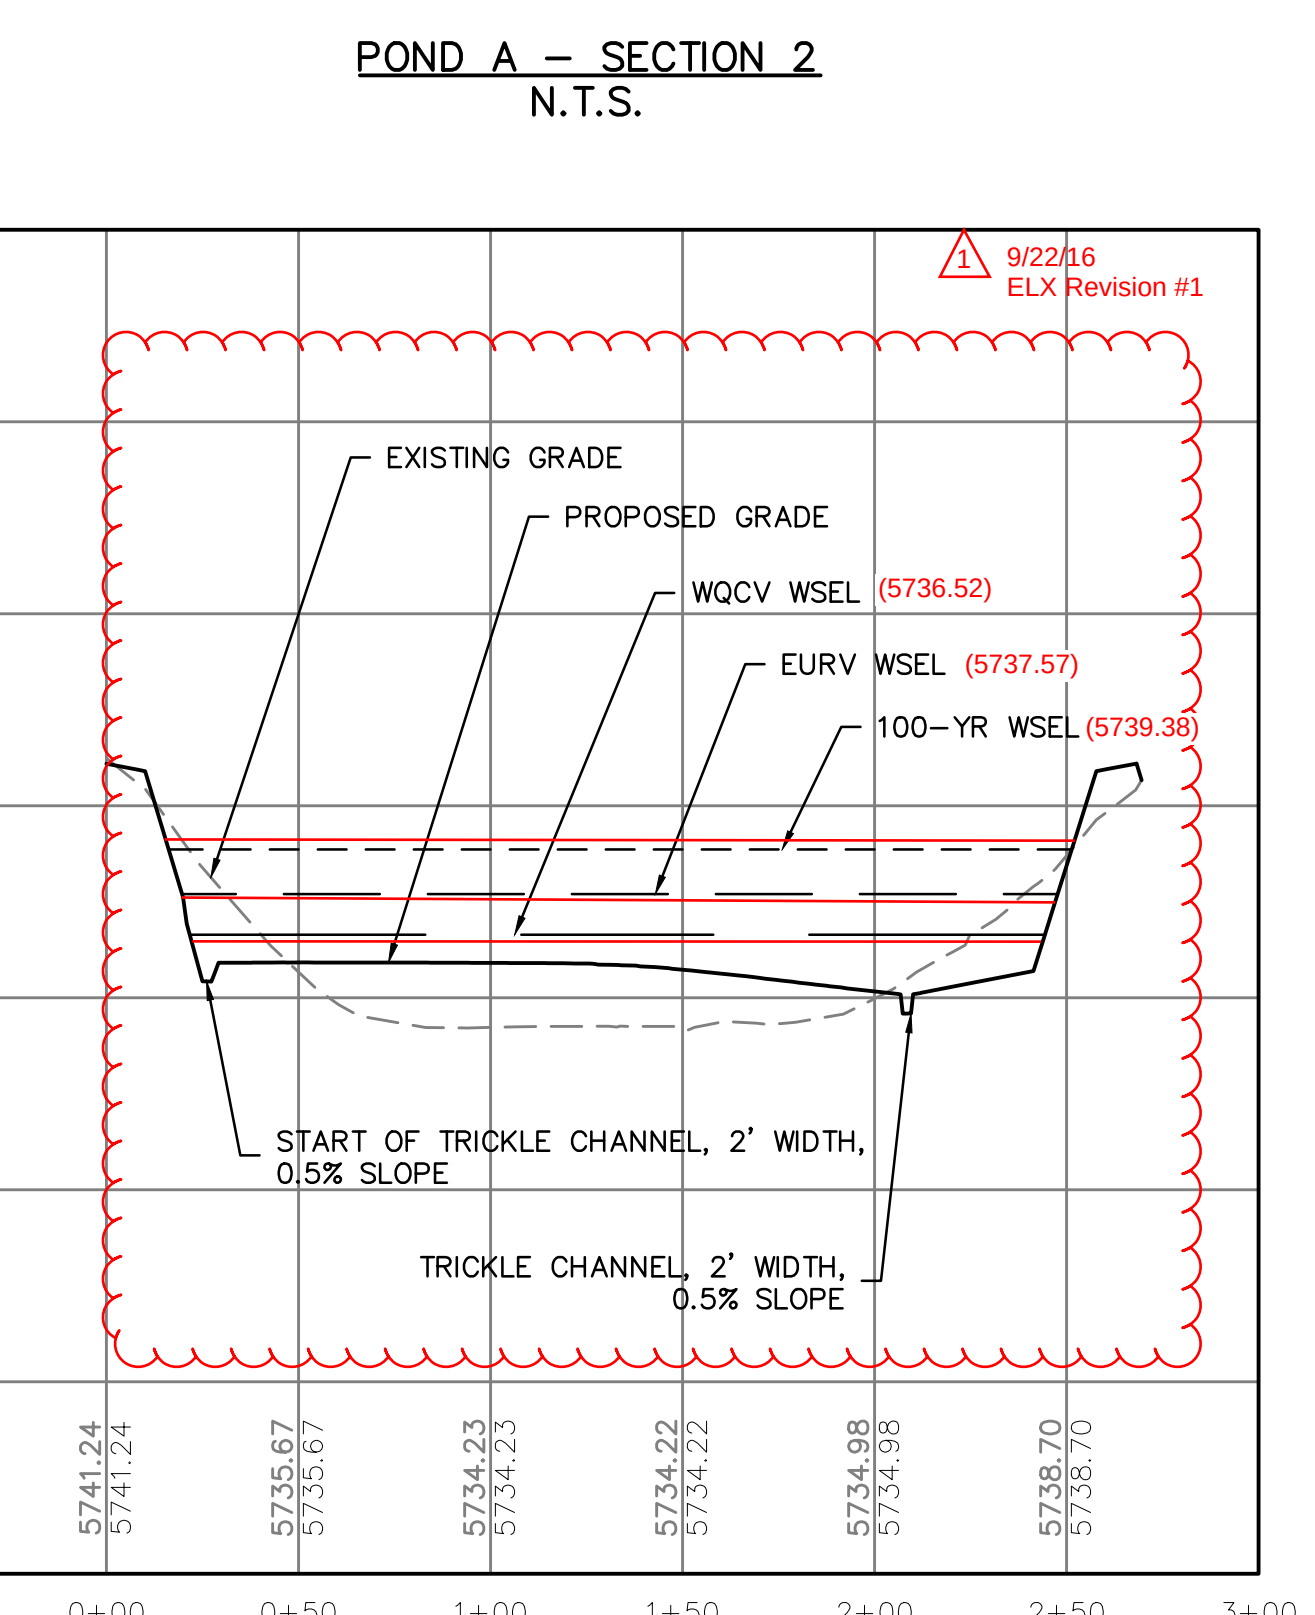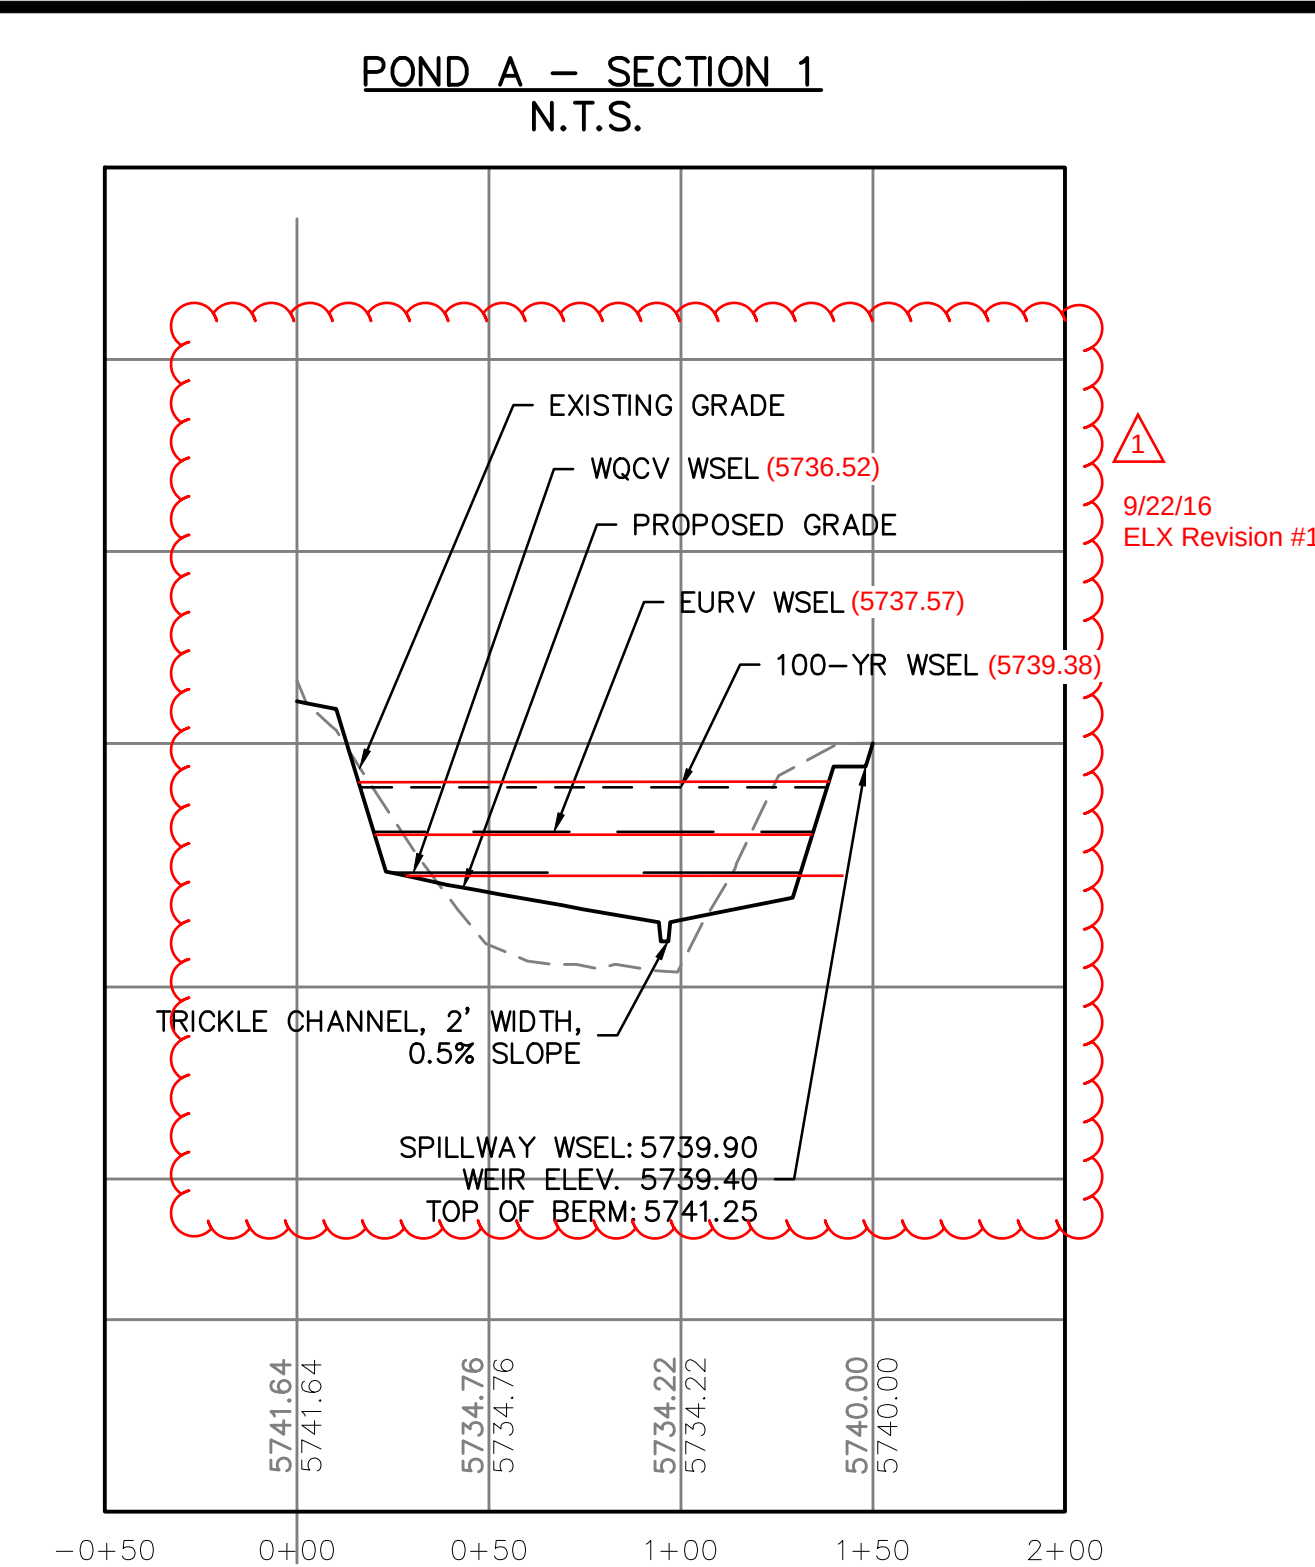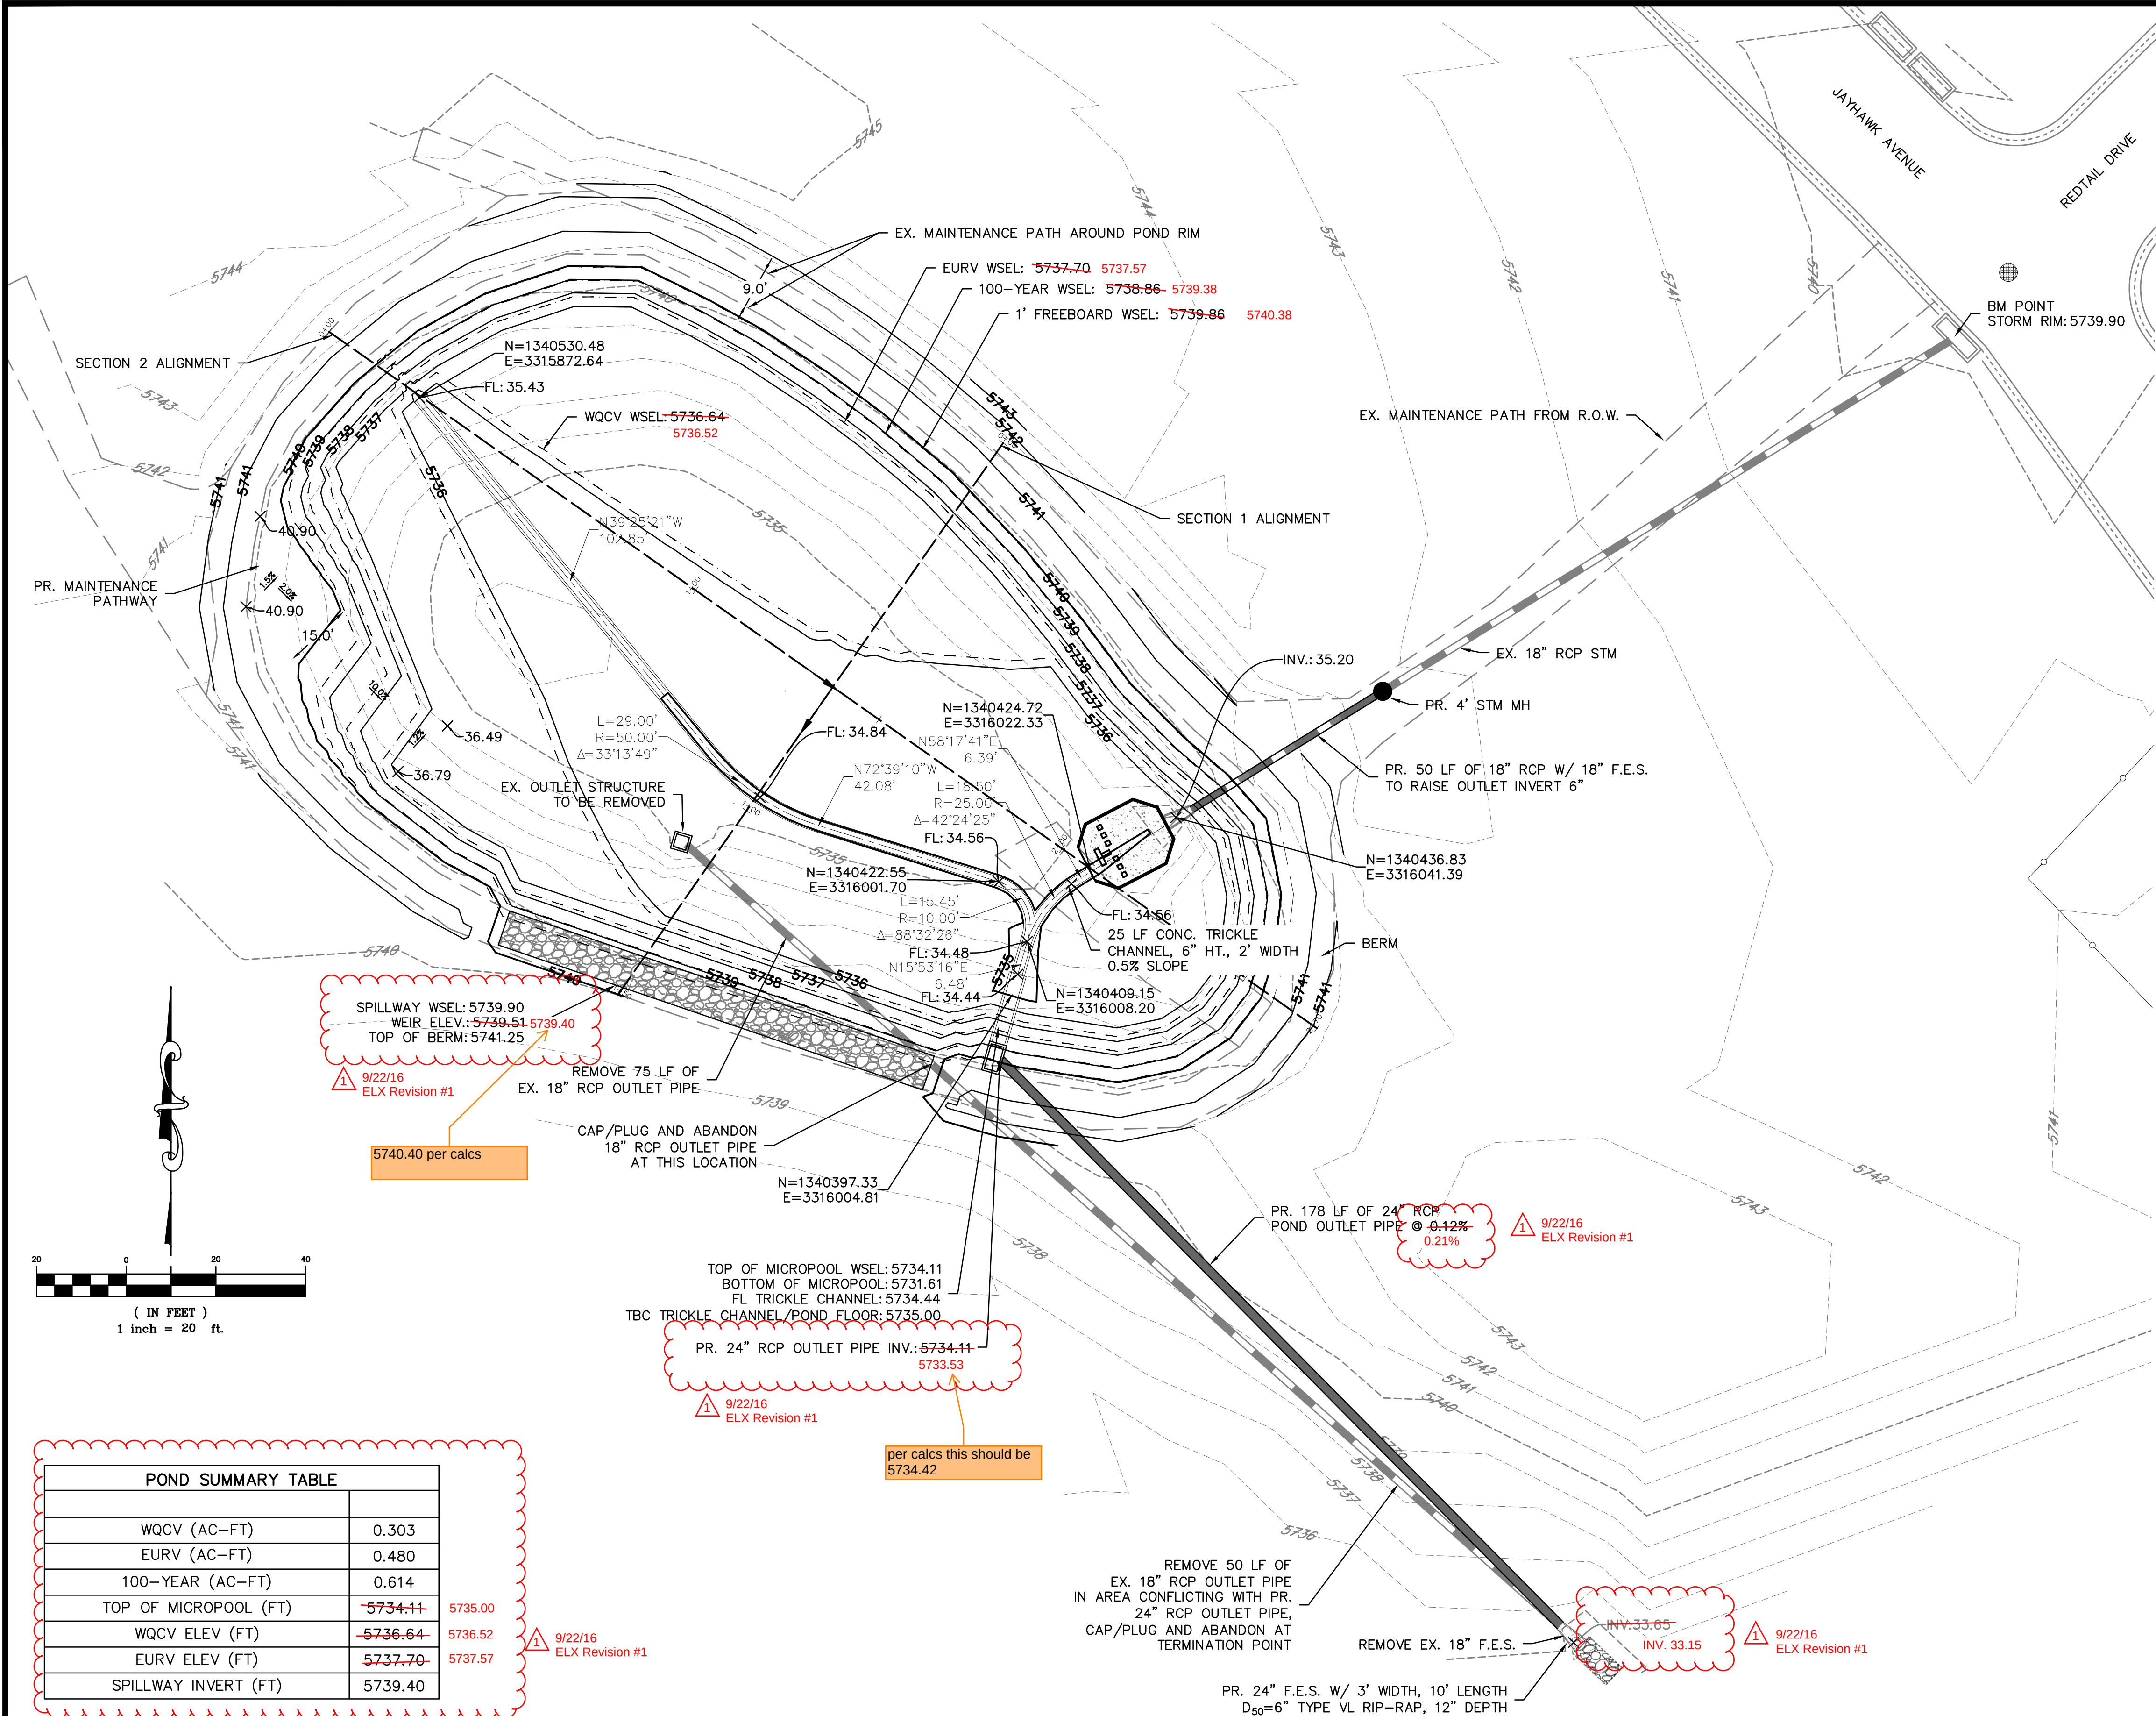

POND SUMMARY TABLE	
WQCV (AC-FT)	0.303
EURV (AC-FT)	0.480
100-YEAR (AC-FT)	0.614
TOP OF MICROPOOL (FT)	5734.11
WQCV ELEV (FT)	5736.52
EURV ELEV (FT)	5737.57
SPILLWAY INVERT (FT)	5739.40

NOTE:

1. THE DEVELOPER SHALL HAVE A LICENSED PROFESSIONAL ENGINEER CERTIFY EACH STORMWATER DETENTION POND AND/OR WATER QUALITY BMP IS BUILT ACCORDING TO THE APPROVED PLANS AND SPECIFICATIONS AND THE REQUIRED DETENTION VOLUME, INCLUDING THE WQCV WHEN USED, IS MET. THE CERTIFICATION SHALL ALSO VERIFY ALL PERTINENT DIMENSIONS, ELEVATIONS, REQUIRED OUTLET ORIFICE PLATES FOR DETENTION AND WQCV AND OTHER PERMANENT BMPS REQUIREMENTS ARE INSTALLED PER THE APPROVED PLANS AND SPECIFICATIONS, AND SHALL SHOW THE AS-BUILT DESIGN VOLUMES (WQCV, 10-YEAR, 100-YEAR, EURV) AND OTHER PERTINENT DIMENSIONS, ELEVATIONS AND CAPACITY REQUIREMENTS ASSOCIATED WITH THE WQ BMP USED. THE CERTIFICATION SHALL BE PROVIDED TO EL PASO COUNTY ENGINEERING. AN APPROVED POND CERTIFICATE SHALL BE REQUIRED PRIOR TO THE RETURN OF ANY FISCAL SECURITY DEPOSIT (AS WELL AS SATISFYING OTHER CONDITIONS OF THE STORMWATER PERMIT) FOR SITES THAT DO NOT REQUIRE A CERTIFICATE OF OCCUPANCY. EXAMPLES OF THESE SITES INCLUDE BUT ARE NOT LIMITED TO: SITES WITHOUT VERTICAL CONSTRUCTION, OIL AND GAS WELL PADS, OUTDOOR STORAGE, AND TOW YARDS. AN APPROVED POND CERTIFICATE SHALL BE REQUIRED PRIOR TO COMMENCEMENT OF BUSINESS OPERATIONS. IN NO CASE SHALL A CERTIFICATE OF OCCUPANCY OR TEMPORARY CERTIFICATE OF OCCUPANCY BE ISSUED WITHOUT AN APPROVED POND CERTIFICATE.

Know what's below.
Call before you dig.

THE LOCATIONS OF EXISTING UNDERGROUND UTILITIES ARE SHOWN IN AN APPROXIMATE WAY ONLY AND HAVE NOT BEEN INDEPENDENTLY VERIFIED BY THE OWNER OR ITS REPRESENTATIVE. THE CONTRACTOR SHALL DETERMINE THE EXACT LOCATION OF ALL EXISTING UTILITIES BEFORE COMMENCING WORK, AND AGREES TO BE FULLY RESPONSIBLE FOR ANY AND ALL DAMAGES WHICH MIGHT BE OCCASIONED BY THE CONTRACTOR'S FAILURE TO EXACTLY LOCATE AND PRESERVE ANY AND ALL UNDERGROUND UTILITIES.

NOTICE:
CONSTRUCTION SITE SAFETY IS THE SOLE RESPONSIBILITY OF THE CONTRACTOR. NEITHER THE OWNER NOR THE ENGINEER SHALL BE EXPECTED TO ASSUME ANY RESPONSIBILITY FOR SAFETY OF THE WORK, OF PERSONS ENGAGED IN THE WORK, OF ANY NEARBY STRUCTURES, OR OF ANY OTHER PERSONS.

COPYRIGHT © 2022 ATWELL, LLC

866.850.4200 www.atwell-group.com
143 UNION BOULEVARD, SUITE 700
LAKEWOOD, CO 80228
303.462.1100

PUNCHLIST CONNECTIONS LLC

300 WINDCHIME PLACE #301
COLORADO SPRINGS, COLORADO 80919

303.519.5100
SCOTT VAN WYHE

PUNCHLIST CONNECTIONS LLC

SUNSET VILLAGE FILING 4 - DRAINAGE
EL PASO COUNTY, COLORADO

CONSTRUCTION DRAWINGS
POND 2



CLIENT

DATE 1/7/2022








REVISIONS

DR. RDL	CH. RDL
P.M. RDL	
JOB # 21004166	
SHEET NO.	17

CAD FILE: 21004166-POND PLANS.DWG

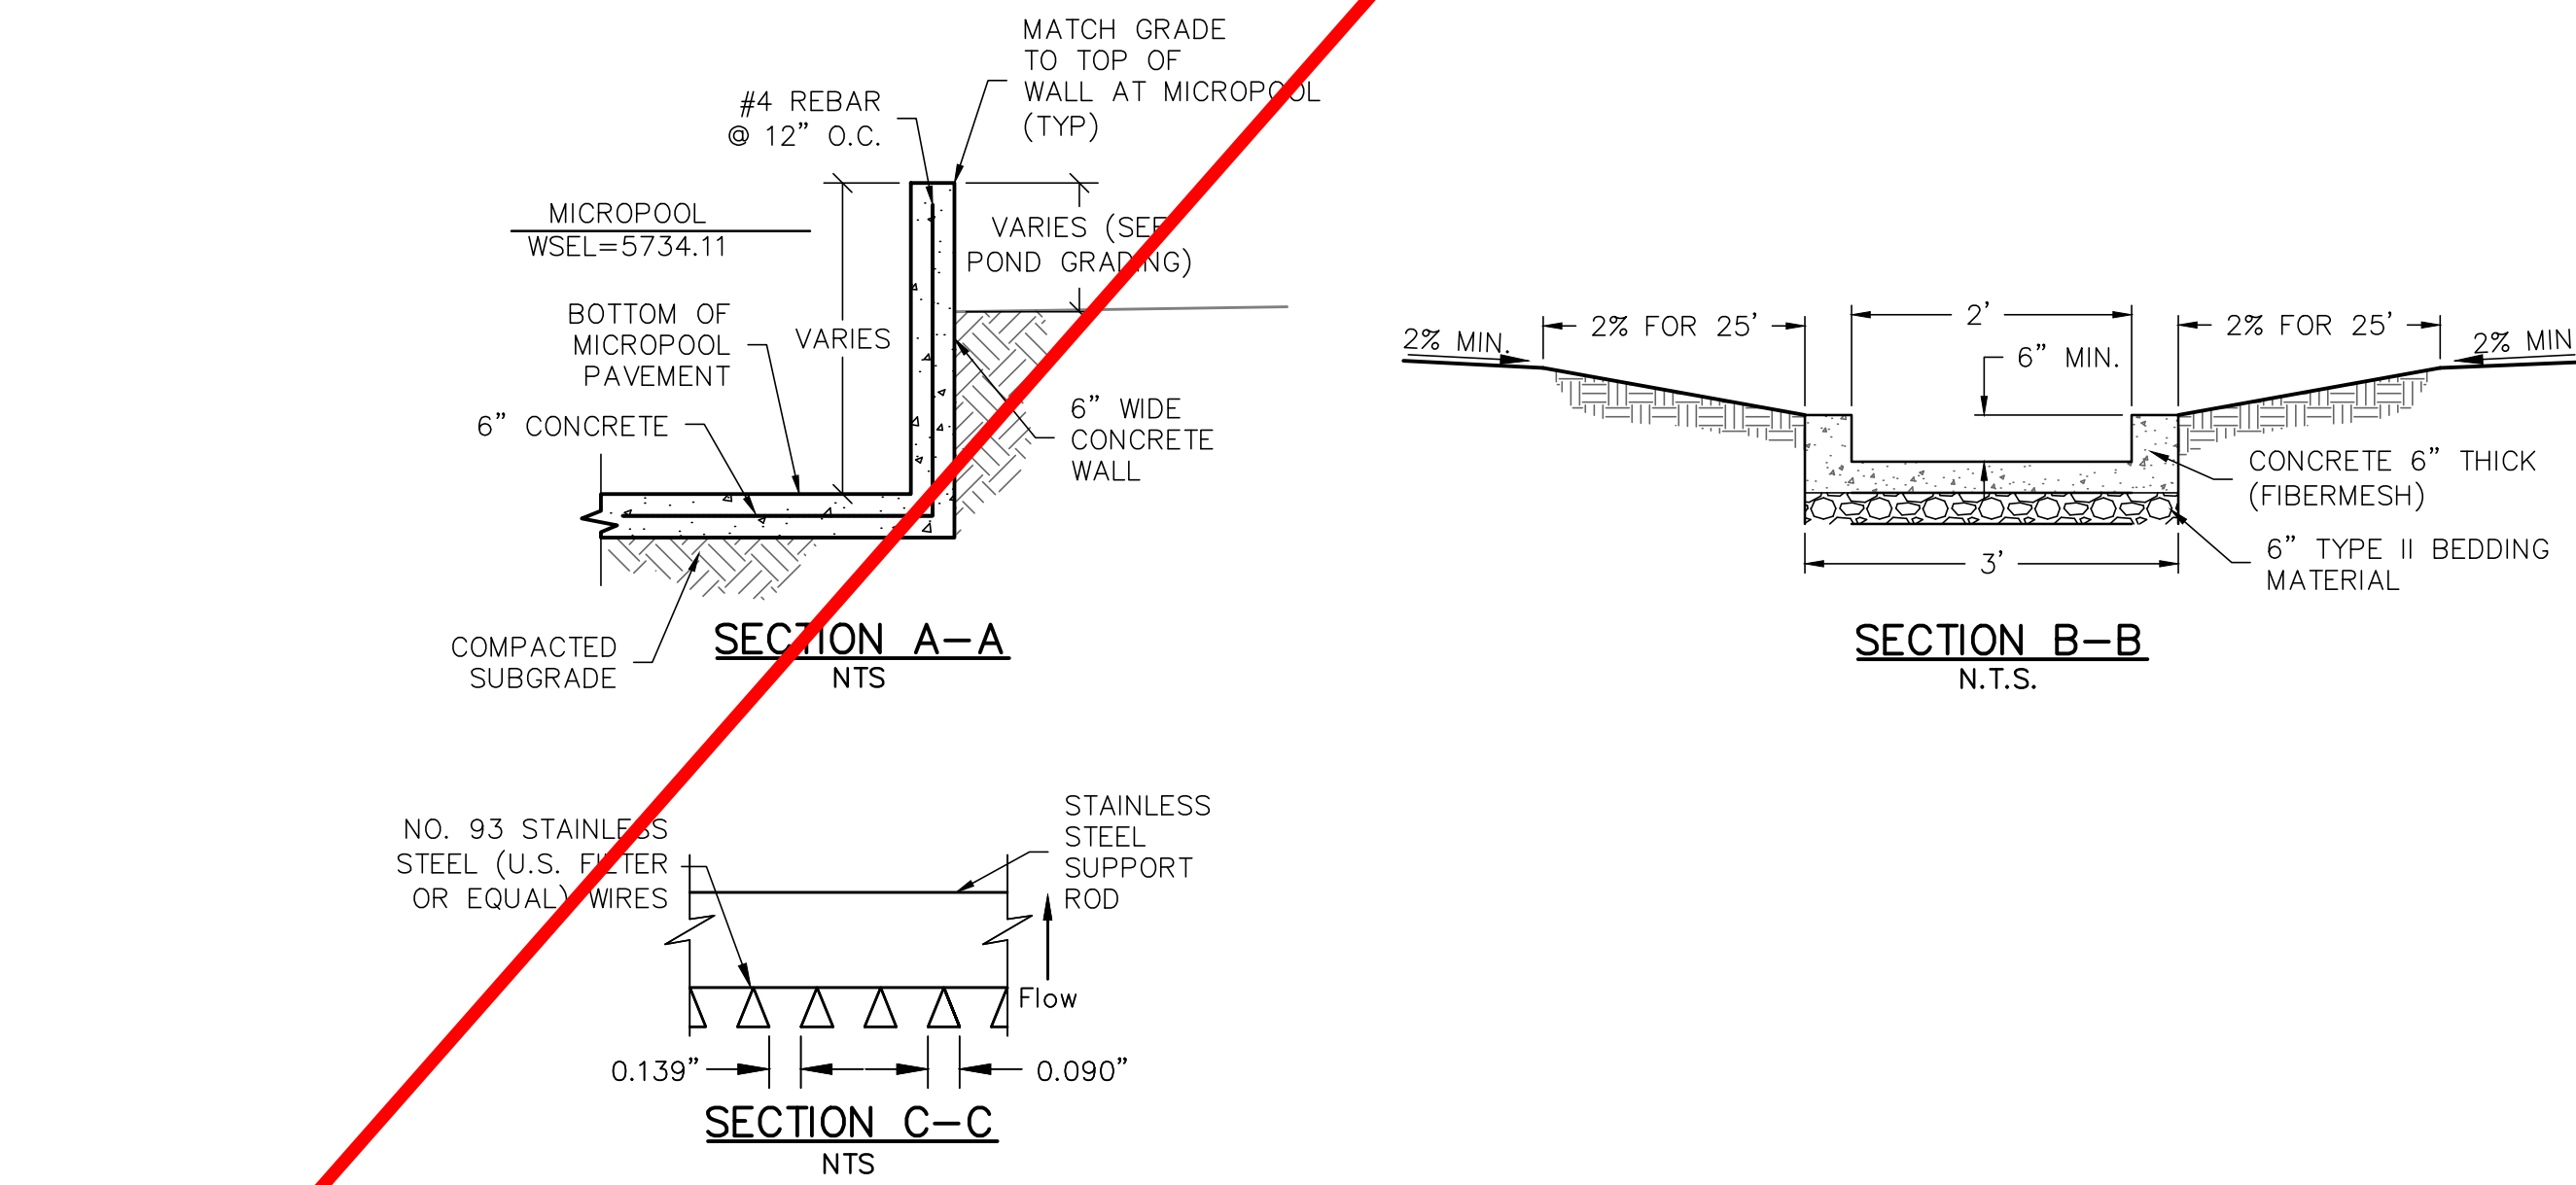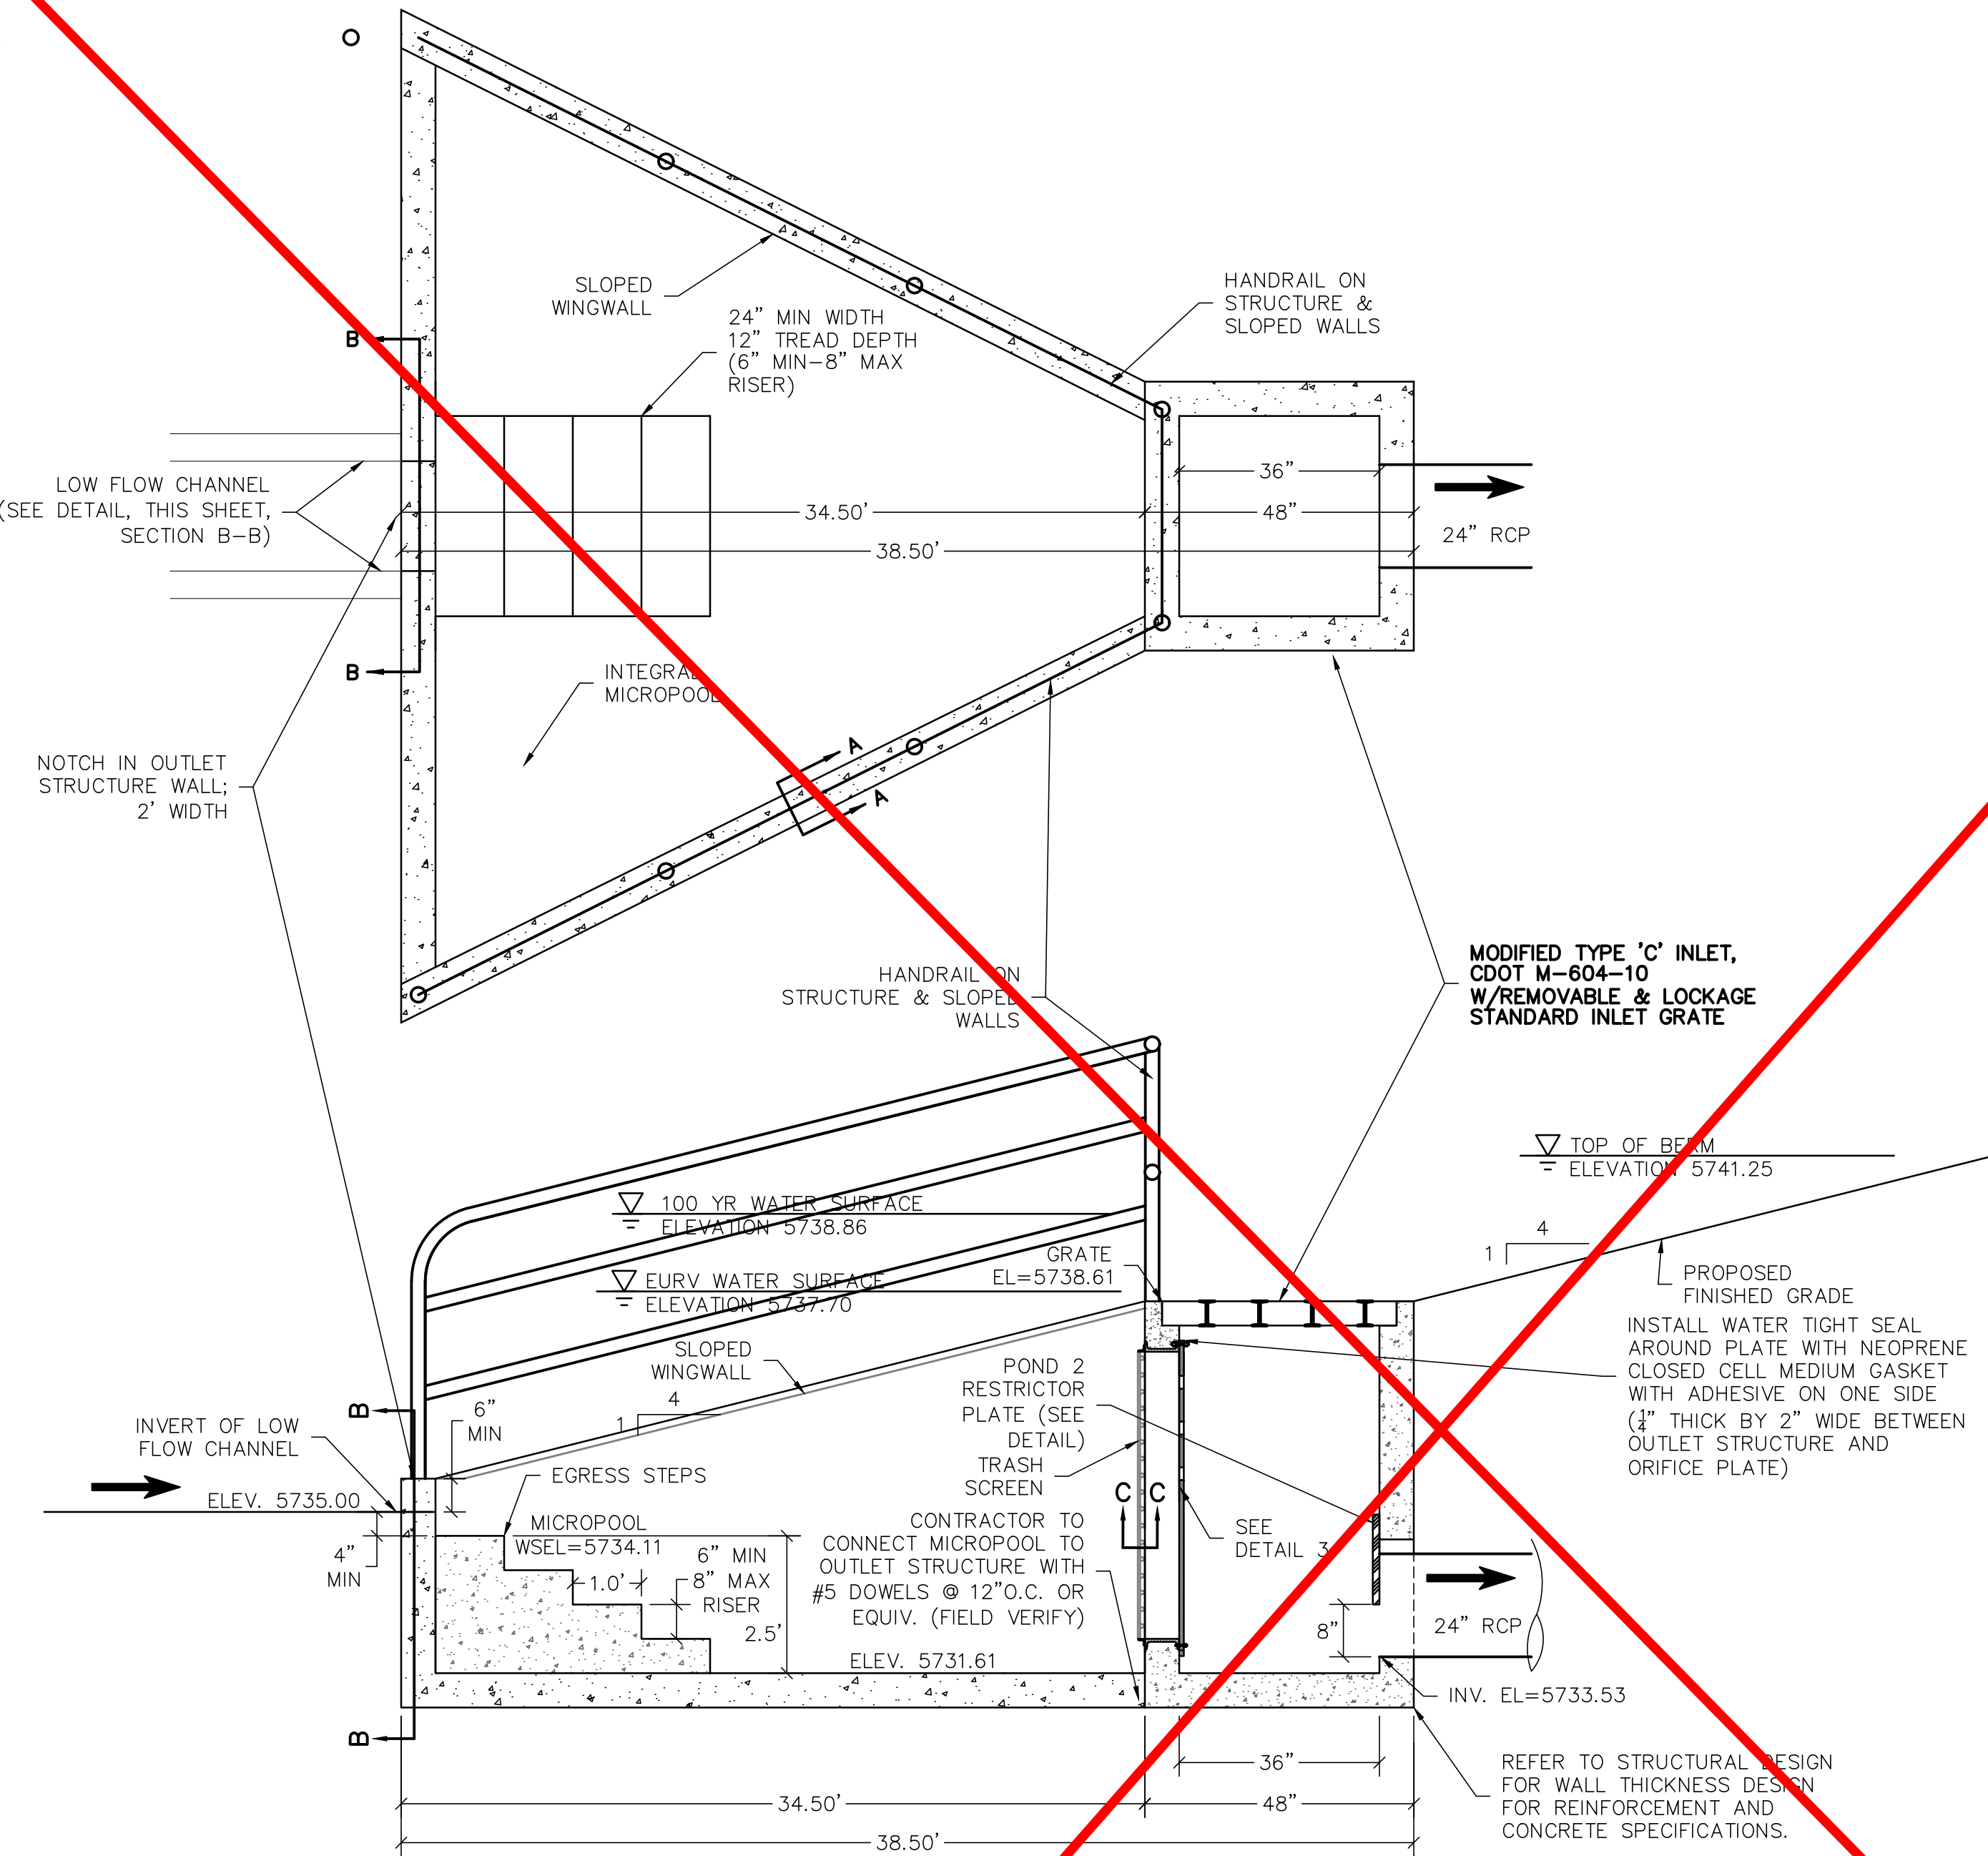

POND SUMMARY TABLE							
DESIGN POINT	POND	TRIBUTARY AREA (AC)	WQCV WSEL	WQCV VOLUME (AC-FT)	EURV	EURV VOLUME (AC-FT)	Qs (CFS)
B	2	22.23	5736.64	0.303	5737.70	0.480	27.8
							57.4

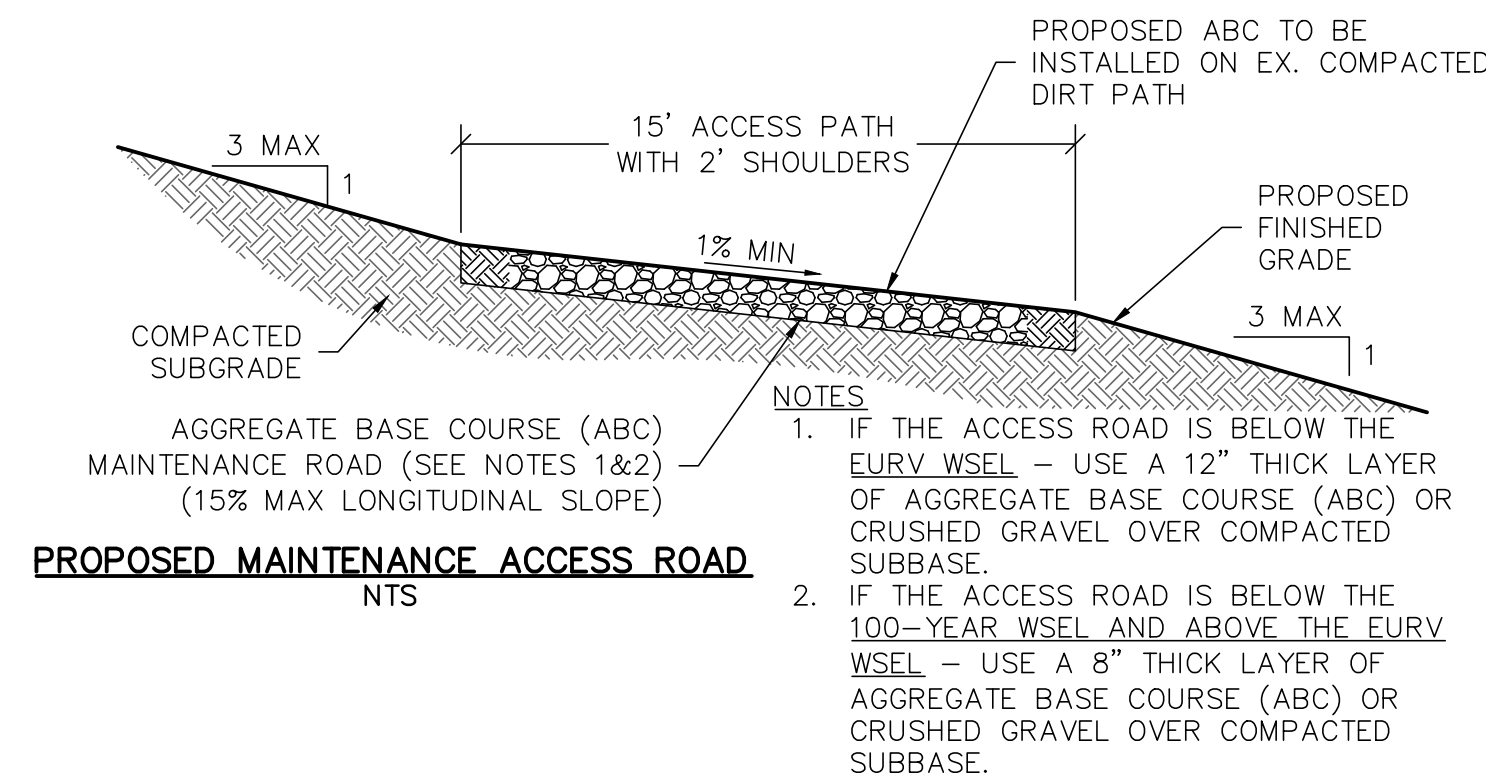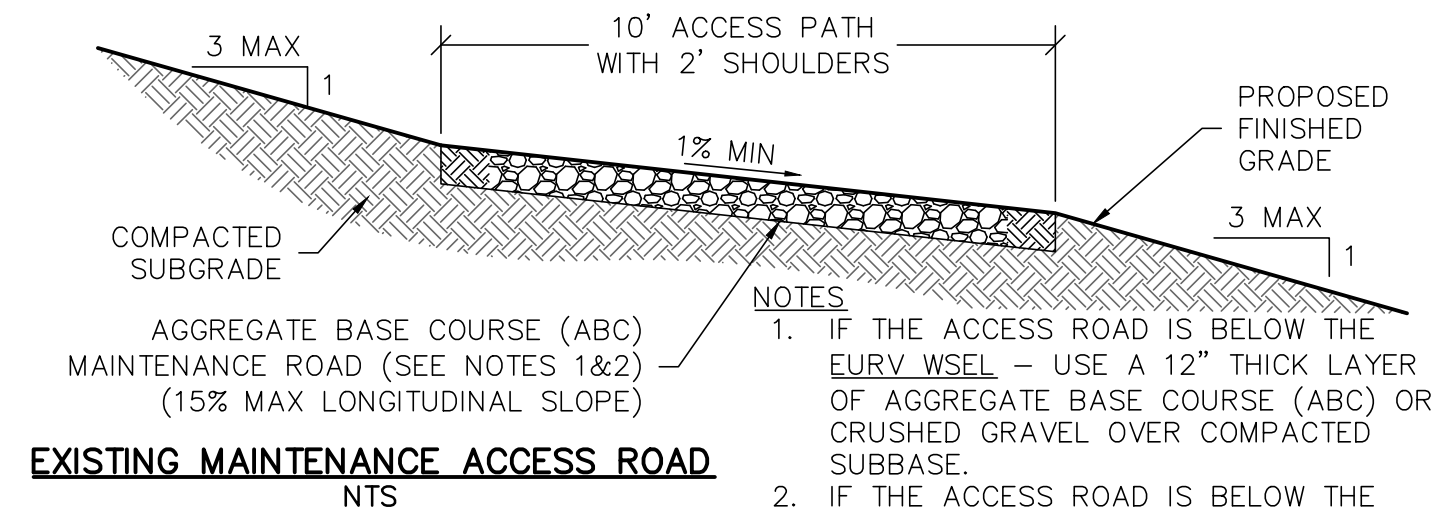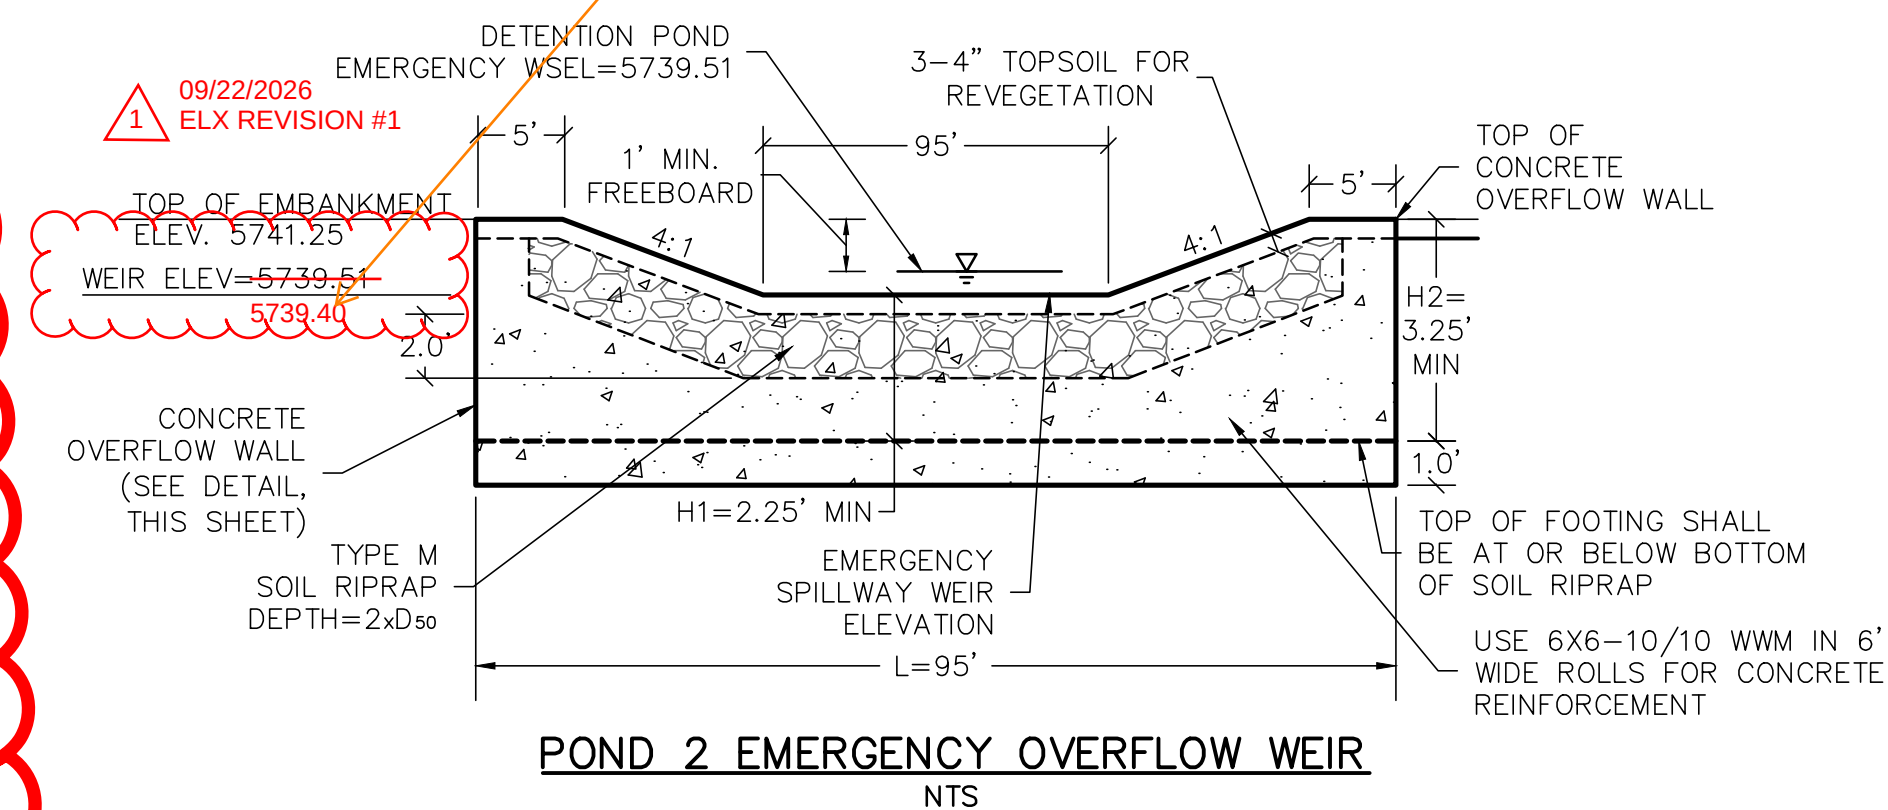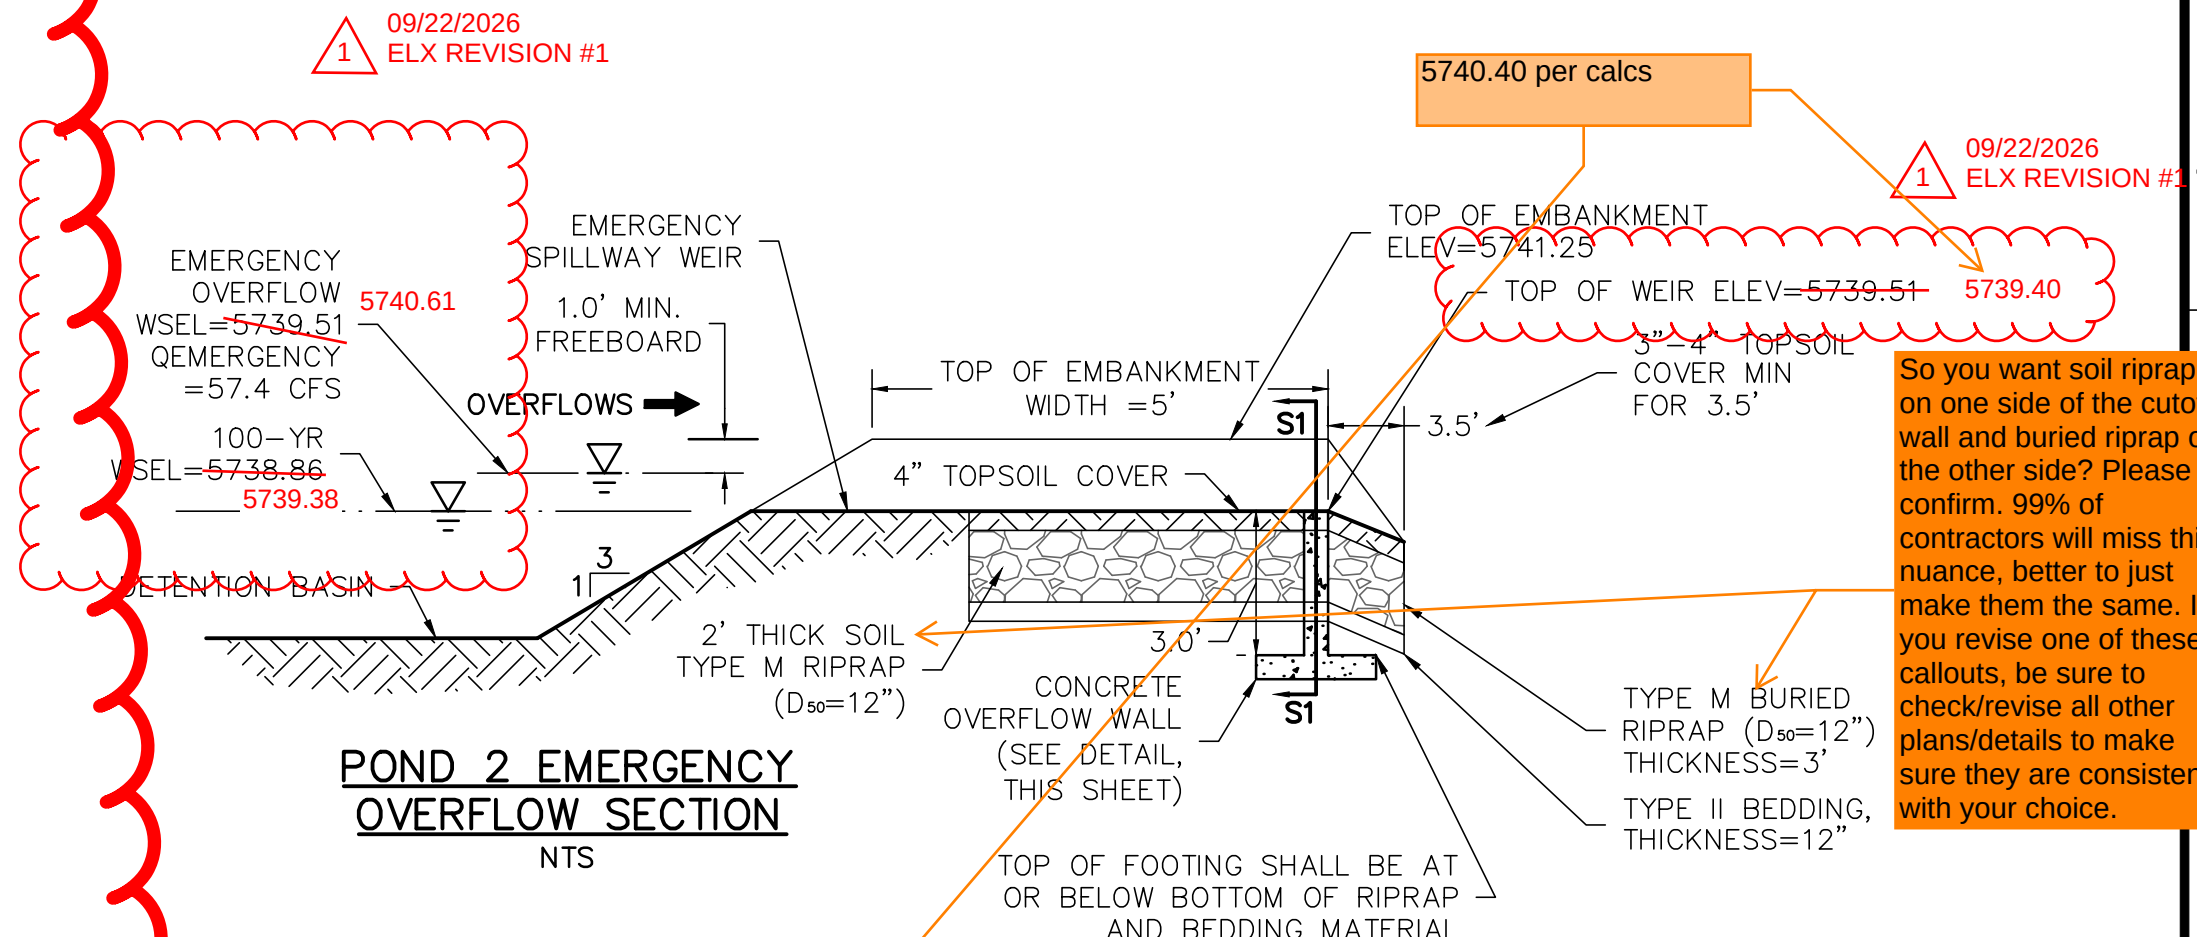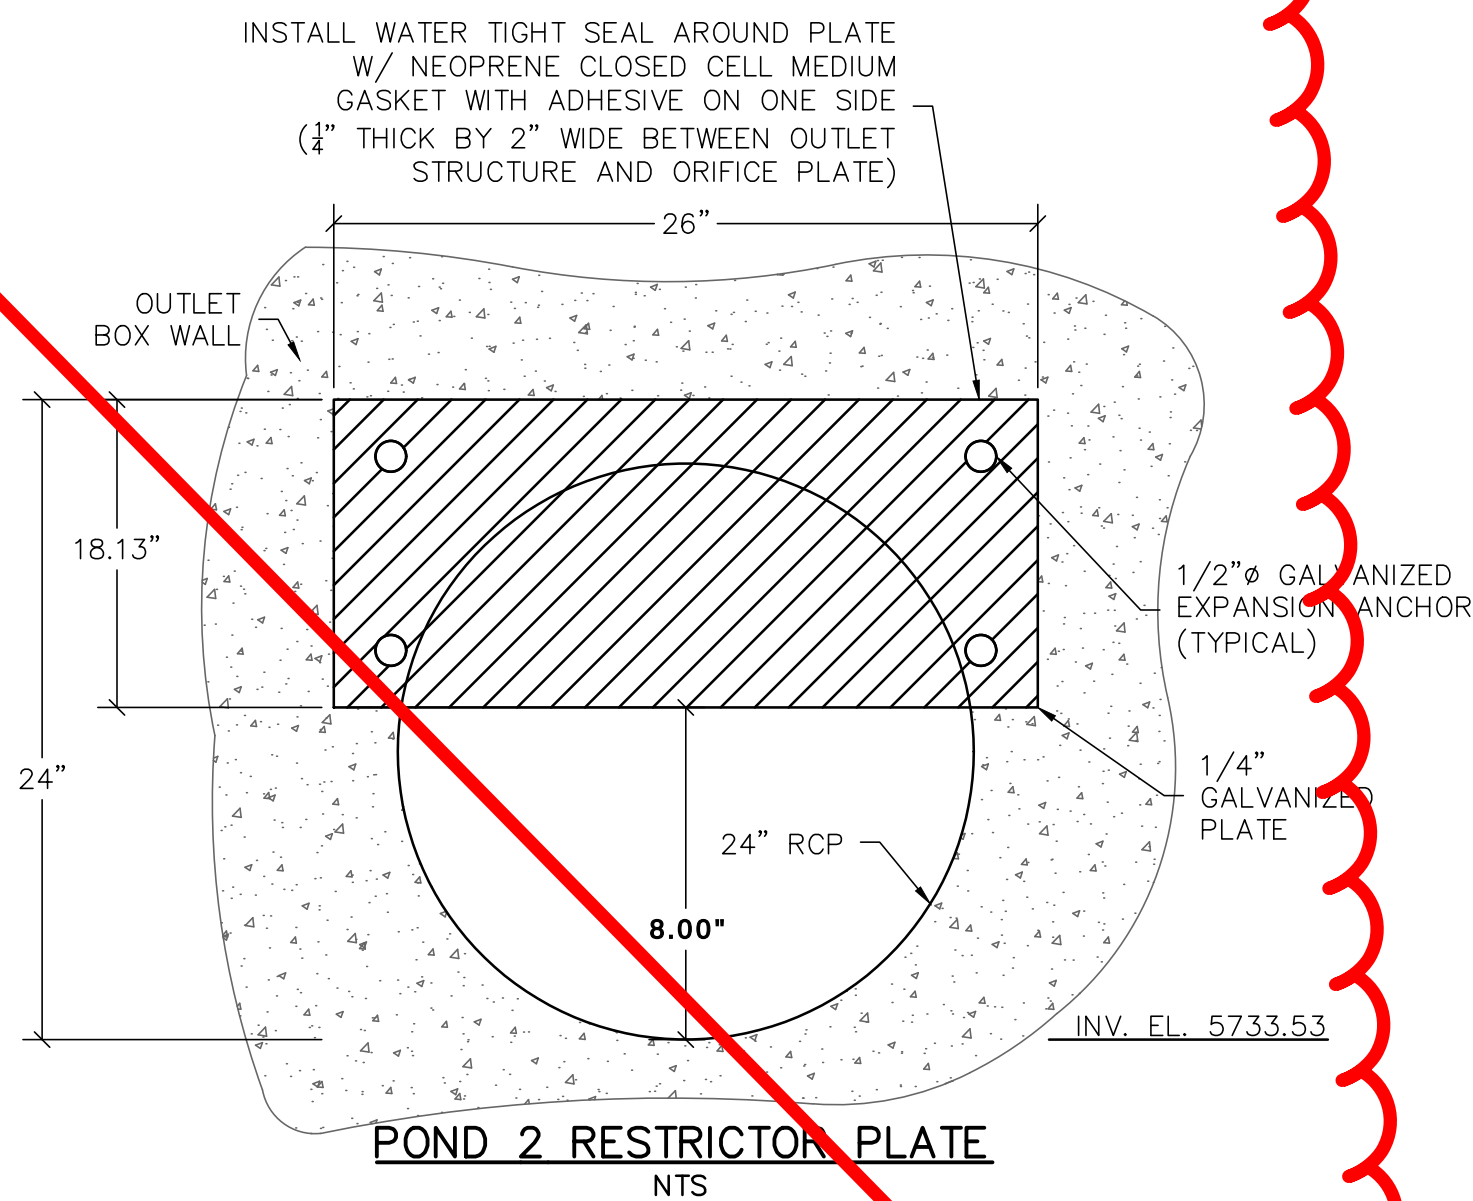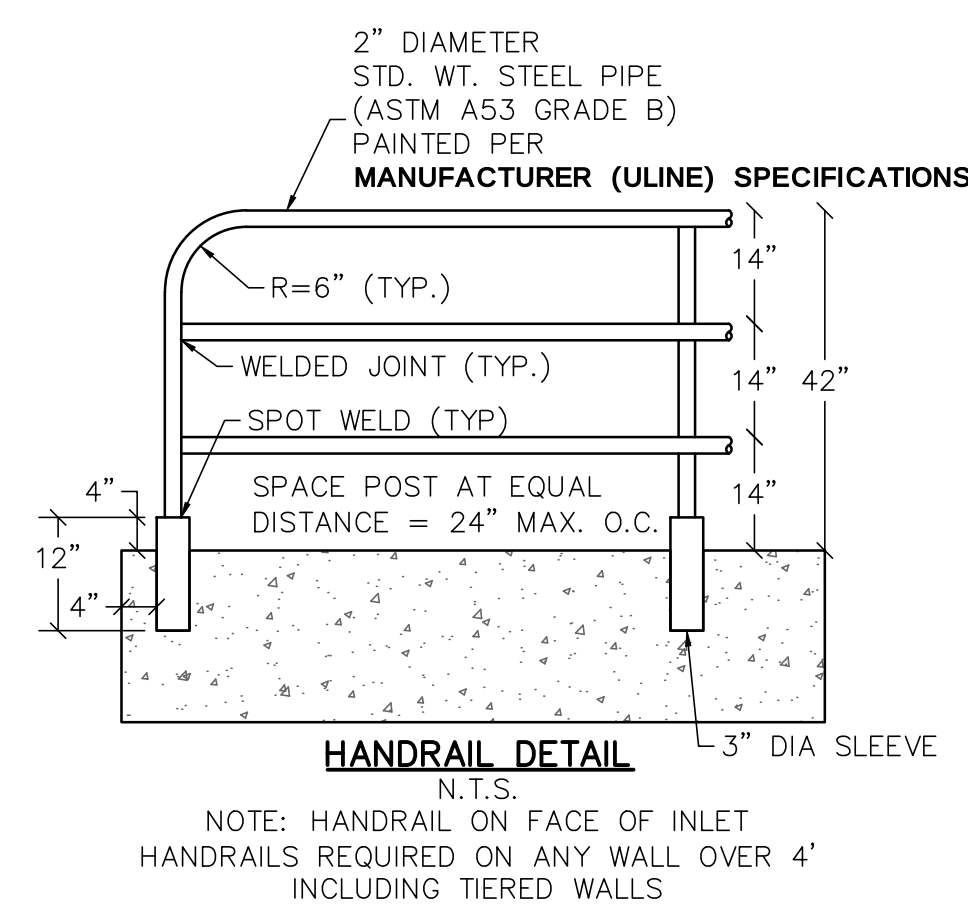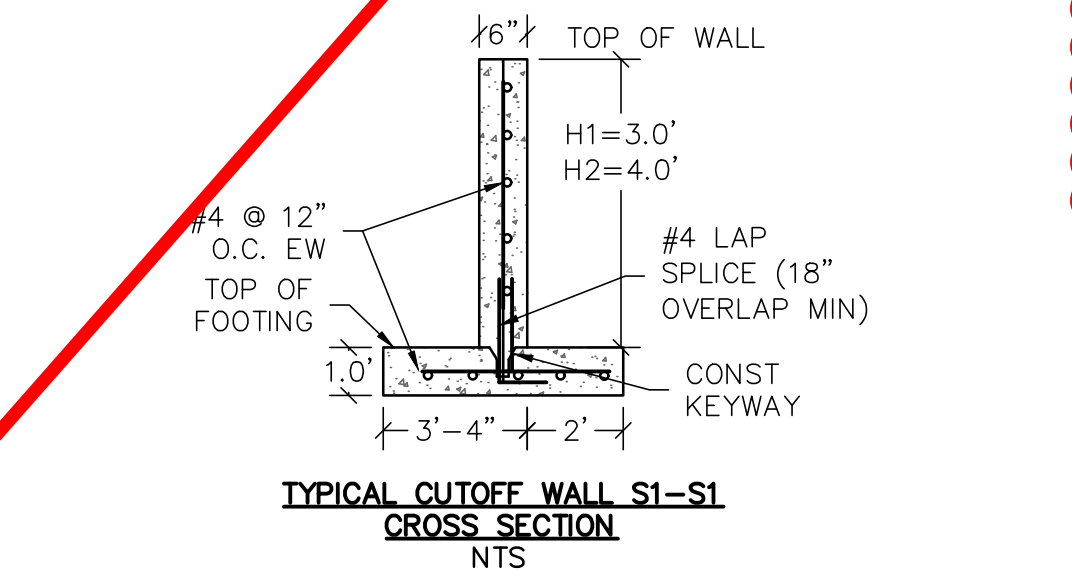

Know what's below.
Call before you dig.

THE LOCATIONS OF EXISTING UNDERGROUND UTILITIES ARE SHOWN IN AN APPROXIMATE WAY ONLY AND HAVE NOT BEEN INDEPENDENTLY VERIFIED BY THE OWNER OR ITS REPRESENTATIVE. THE CONTRACTOR SHALL DETERMINE THE EXACT LOCATION OF ALL EXISTING UTILITIES BEFORE COMMENCING WORK, AND AGREES TO BE FULLY RESPONSIBLE FOR ANY AND ALL DAMAGES WHICH MIGHT BE OCCASIONED BY THE CONTRACTOR'S FAILURE TO EXACTLY LOCATE AND PRESERVE ANY AND ALL UNDERGROUND UTILITIES.

NOTICE:
THE CONTRACTOR SHALL BE THE SOLE RESPONSIBILITY OF THE CONTRACTOR. NEITHER THE OWNER NOR THE ENGINEER SHALL BE EXPECTED TO ASSUME ANY RESPONSIBILITY FOR SAFETY OF WORK OF PERSONS ENGAGED IN THE WORK, OF ANY NEARBY UTILITIES, OR OF ANY OTHER PERSONS.

RIGHT © 2022 ATWELL LLC

866.850.4200 www.atwell-group.com
143 UNION BOULEVARD, SUITE 700
LAKEWOOD, CO 80228
303.462.1100

PUNCHLIST CONNECTIONS LLC
300 WINDHOLM PLACE #301
COLORADO SPRINGS, COLORADO 80919
303.519.5100
SCOTT VAN WYHE

PUNCHLIST CONNECTIONS LLC
SUNSET VILLAGE FILING 4 - DRAINAGE
EL PASO COUNTY, COLORADO 80921
CONSTRUCTION DRAWINGS
POND 2




CLIENT
DATE 1/7/2022

REVISIONS


DR.	RDL	CH.	RDL
P.M.	RDL		

JOB # 21004166
SHEET NO. 18


CAD FILE: 21004166-POND DETAILS.DWG

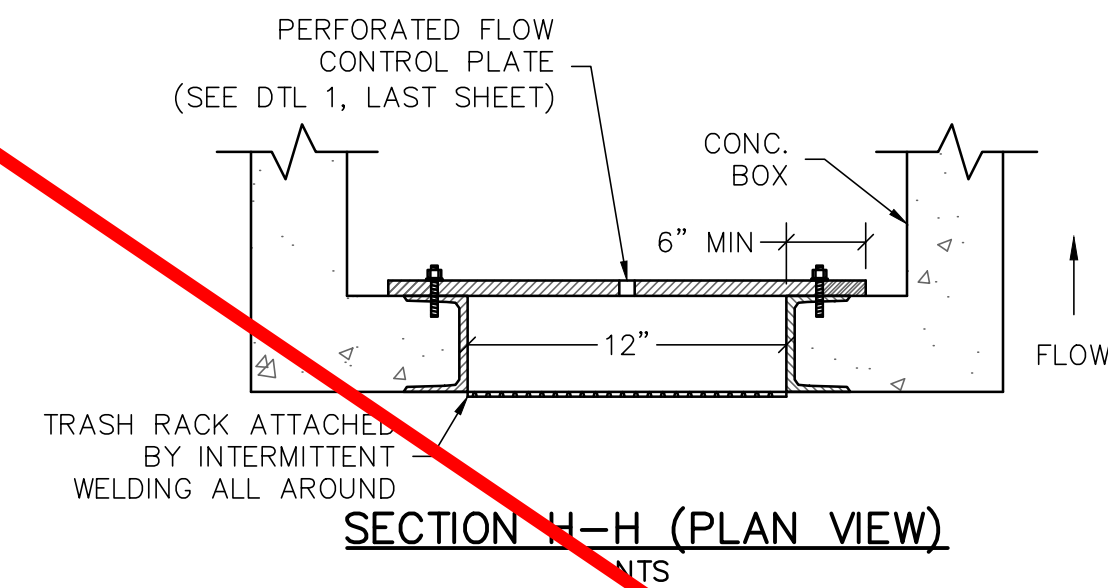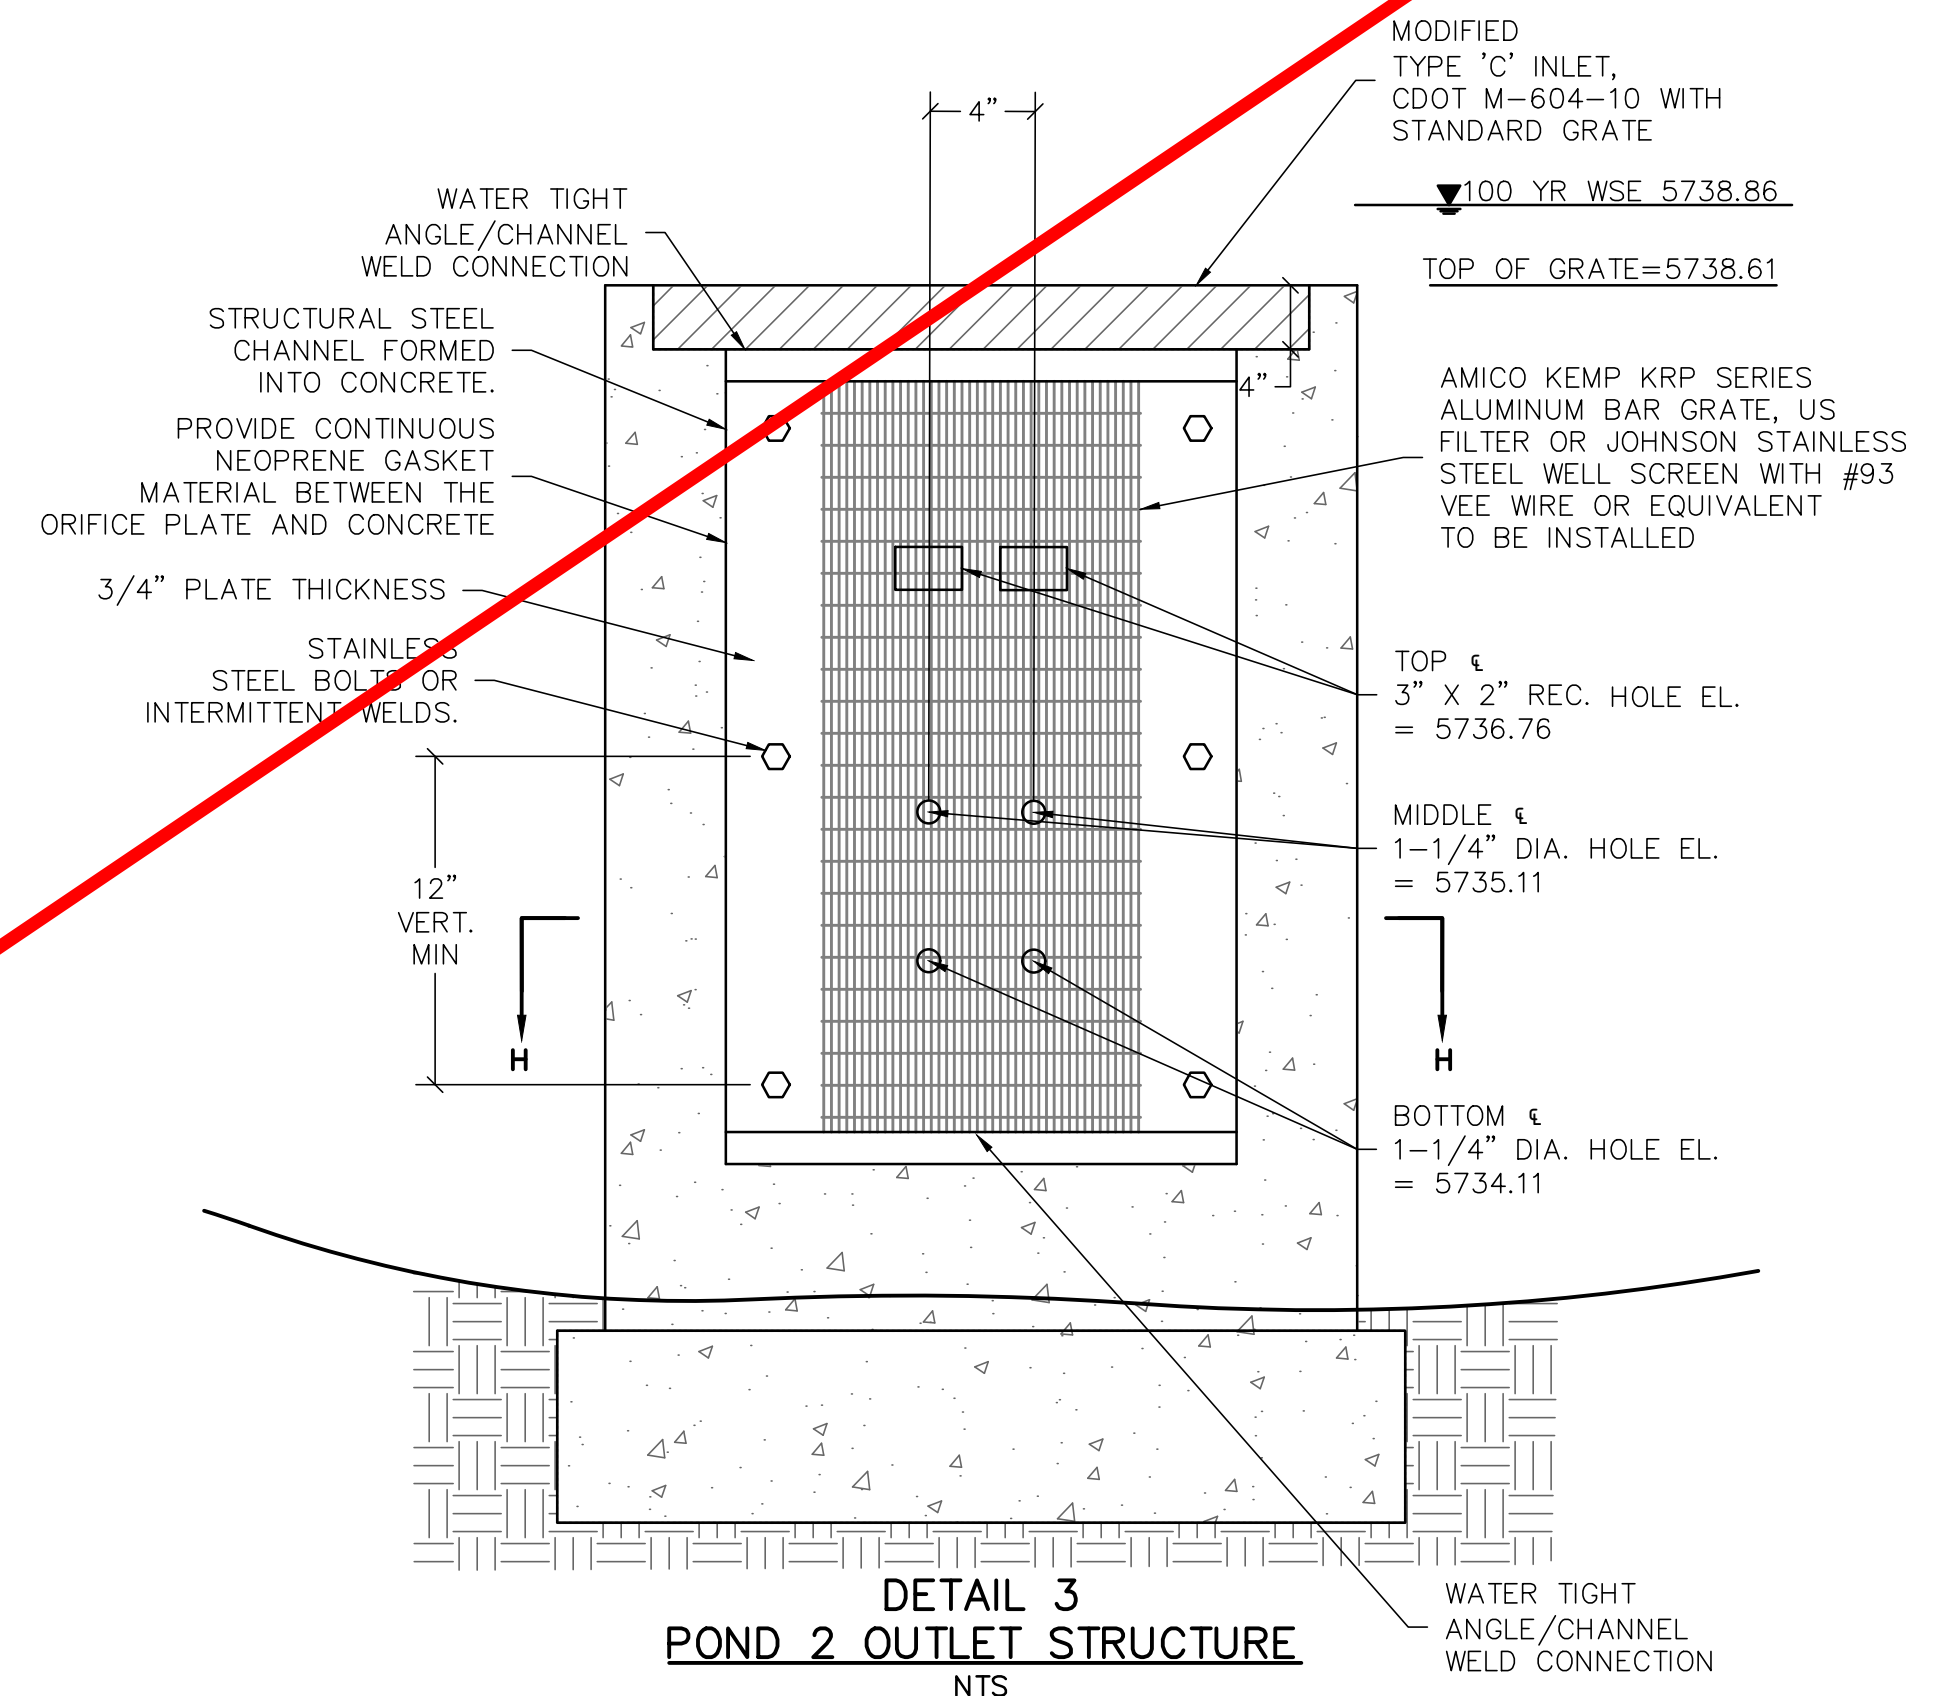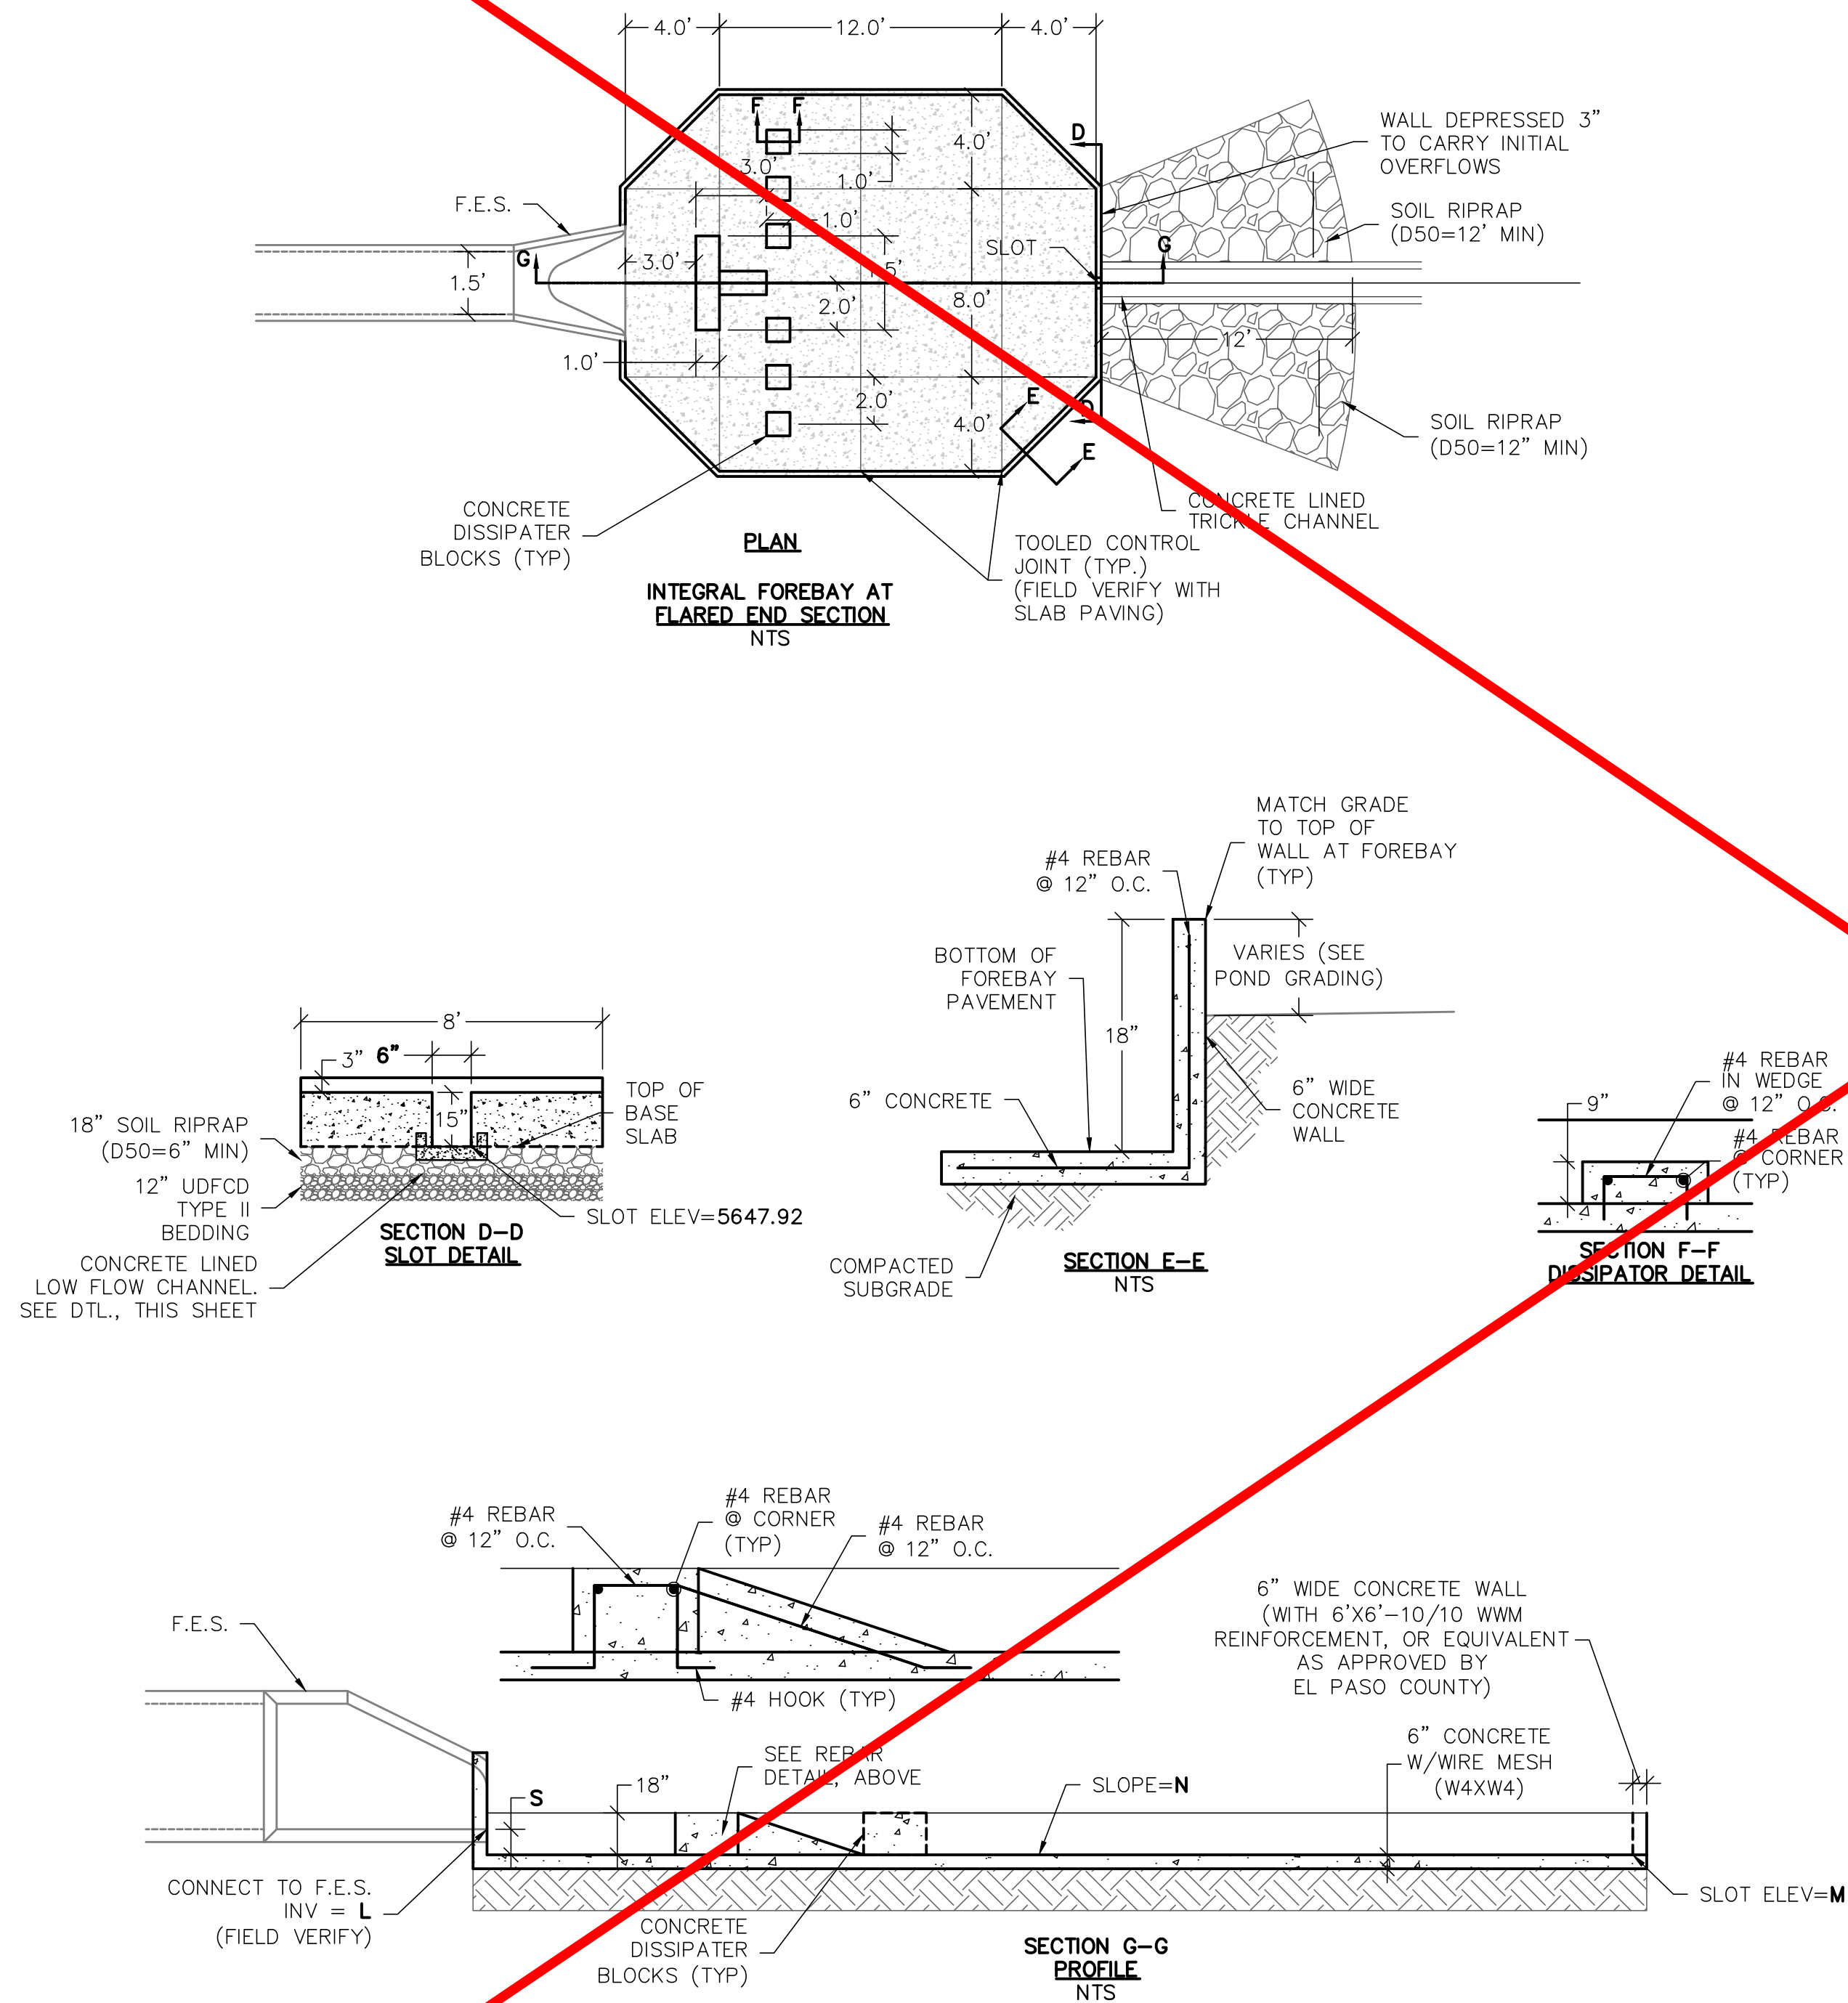


FOREBAY SIZE TABLE						
FOREBAY NAME	PIPE SIZE	L	M	N	S	T
A1	18"	5648.22	5647.92	0.50%	2.5"	6"

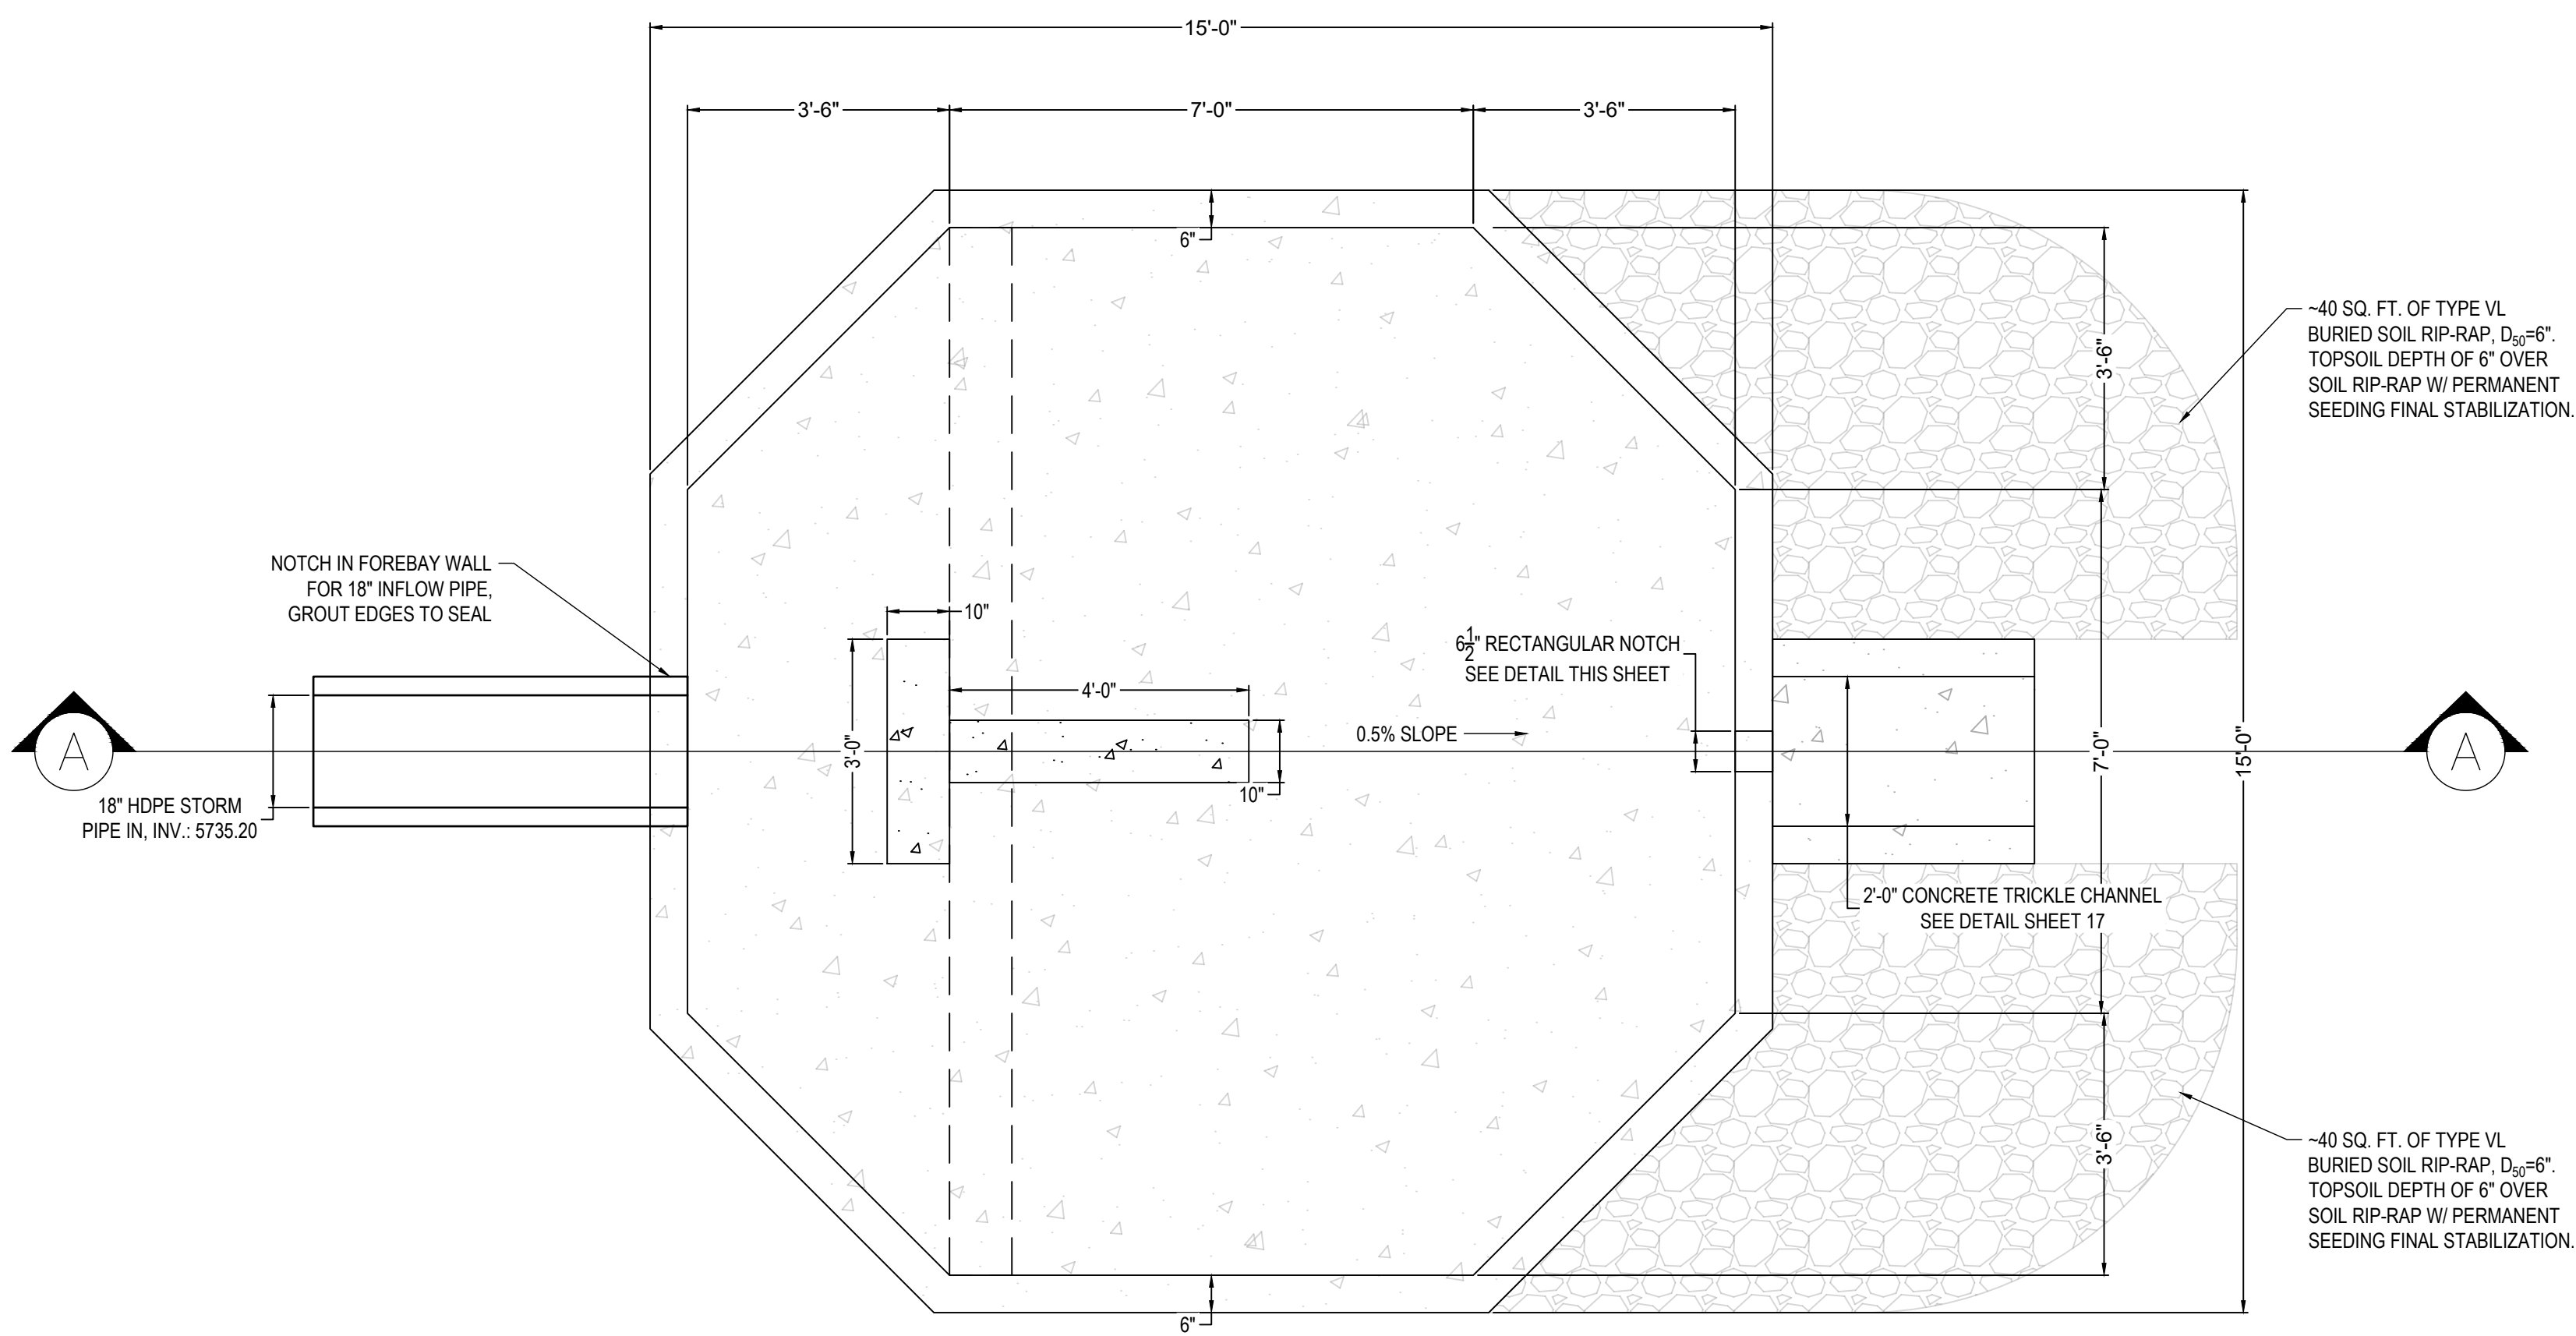


FOREBAY PLAN VIEW
SCALE: 1" = 2'

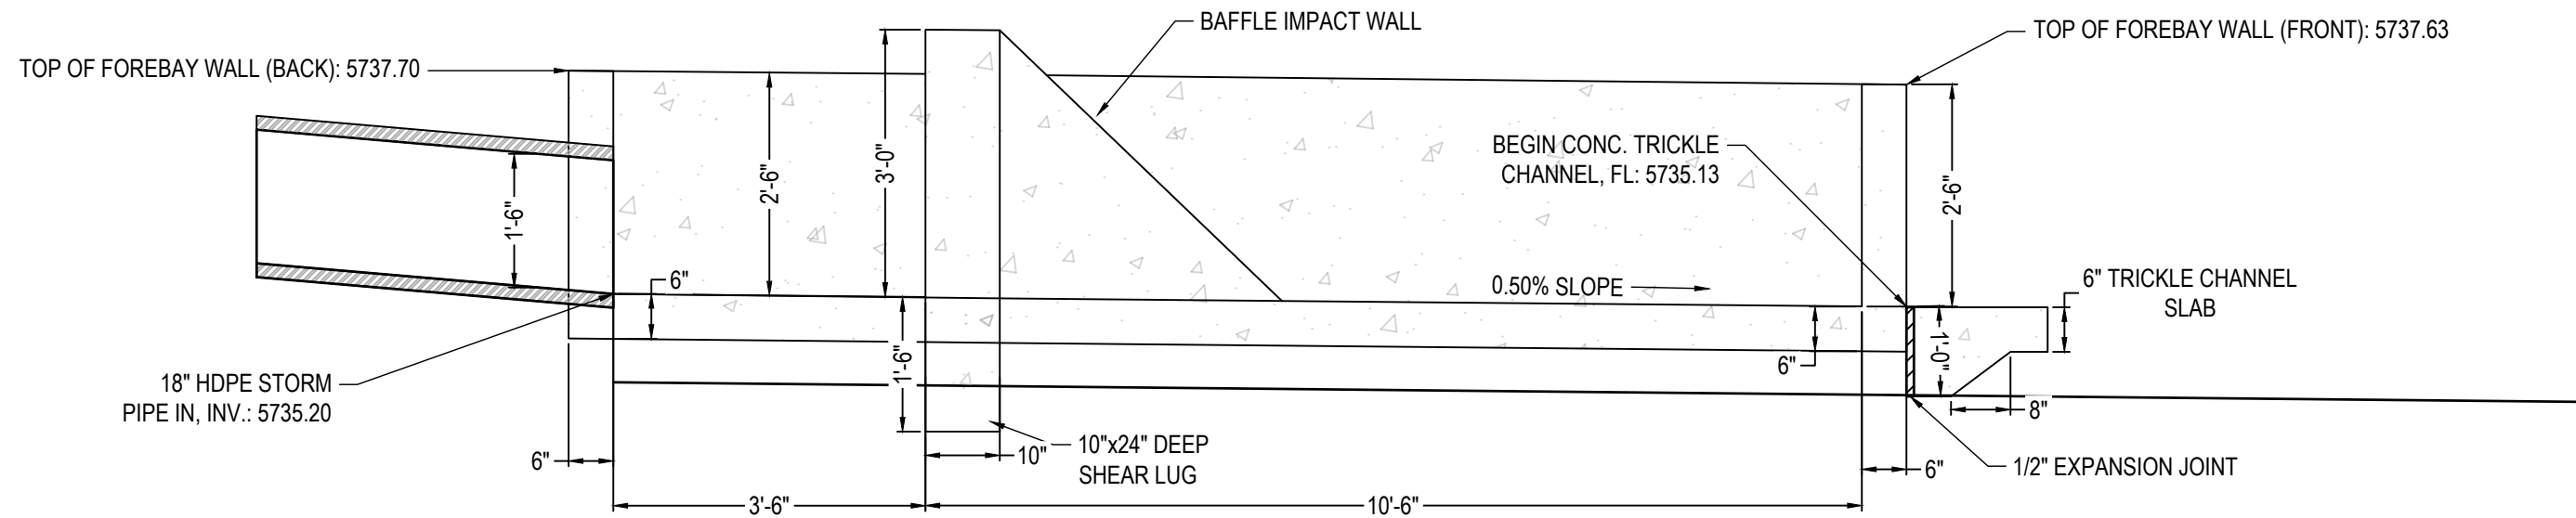

FOREBAY ELEVATION VIEW
(SECTION A-A)
SCALE: 1" = 2'

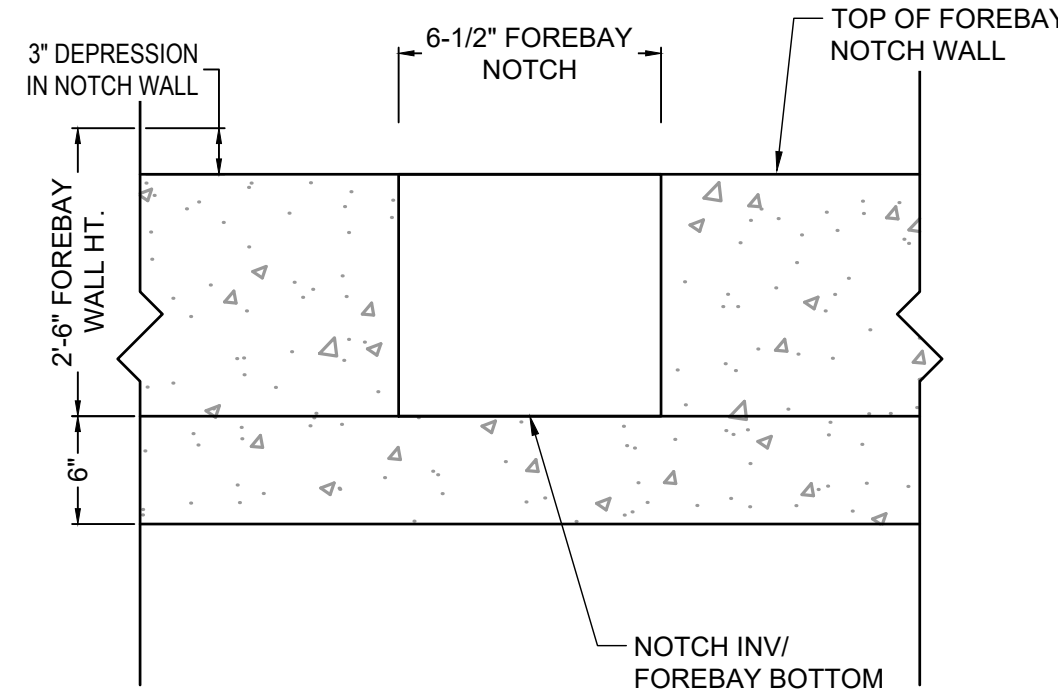

FOREBAY NOTCH DETAIL
SCALE: N.T.S.

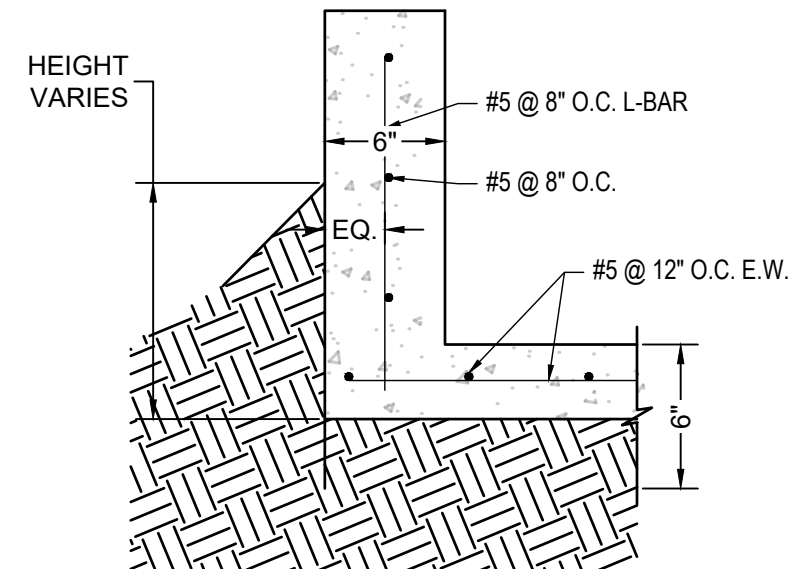

FOREBAY REINFORCING DETAIL
SCALE: N.T.S.

ELX

Phone: 719.308.9146
Habitat, Inc.
Habitat, Inc.

COPYRIGHT

© 2026 ENGINEERING LOCAL XPERTS, LLC.

ALL RIGHTS RESERVED. THE INFORMATION DEPICTED ON THIS SHEET IS THE SOLE PROPERTY OF ENGINEERING LOCAL XPERTS, LLC AND NO PART OF THIS INFORMATION MAY BE REPRODUCED IN ANY FORM WITHOUT THE WRITTEN PERMISSION OF ENGINEERING LOCAL XPERTS, LLC.

PROJECT NAME:

SUNSET VILLAGE
FILING NO. 4

PROJECT LOCATION:

SUNSET VILLAGE
FILING NO. 4
EL PASO COUNTY, COLORADO

CLIENT:

SCOTT ALLEN HOMES

CONTACT INFO:

SCOTT VAN WYHE
SCOTT ALLEN HOMES
scott@punchlistconnection.com

PROFESSIONAL SEAL:

DATE:	DESCRIPTION:
04/04/26	CDR218 REV. 1
09/22/26	CDR218 REV. 2

JOB #: 101544

DRAWN BY: CDS
REVIEWED BY: CDS
PROJ. MNGR.: CDS

PLAN SET:


SUNSET VILLAGE
FILING NO. 4
PERMANENT CONTROL MEASURE
INFRASTRUCTURE DETAILS

SHEET TITLE:

FOREBAY DETAILS


SHEET NO.:
20

09/22/2026
ELX REVISION #2

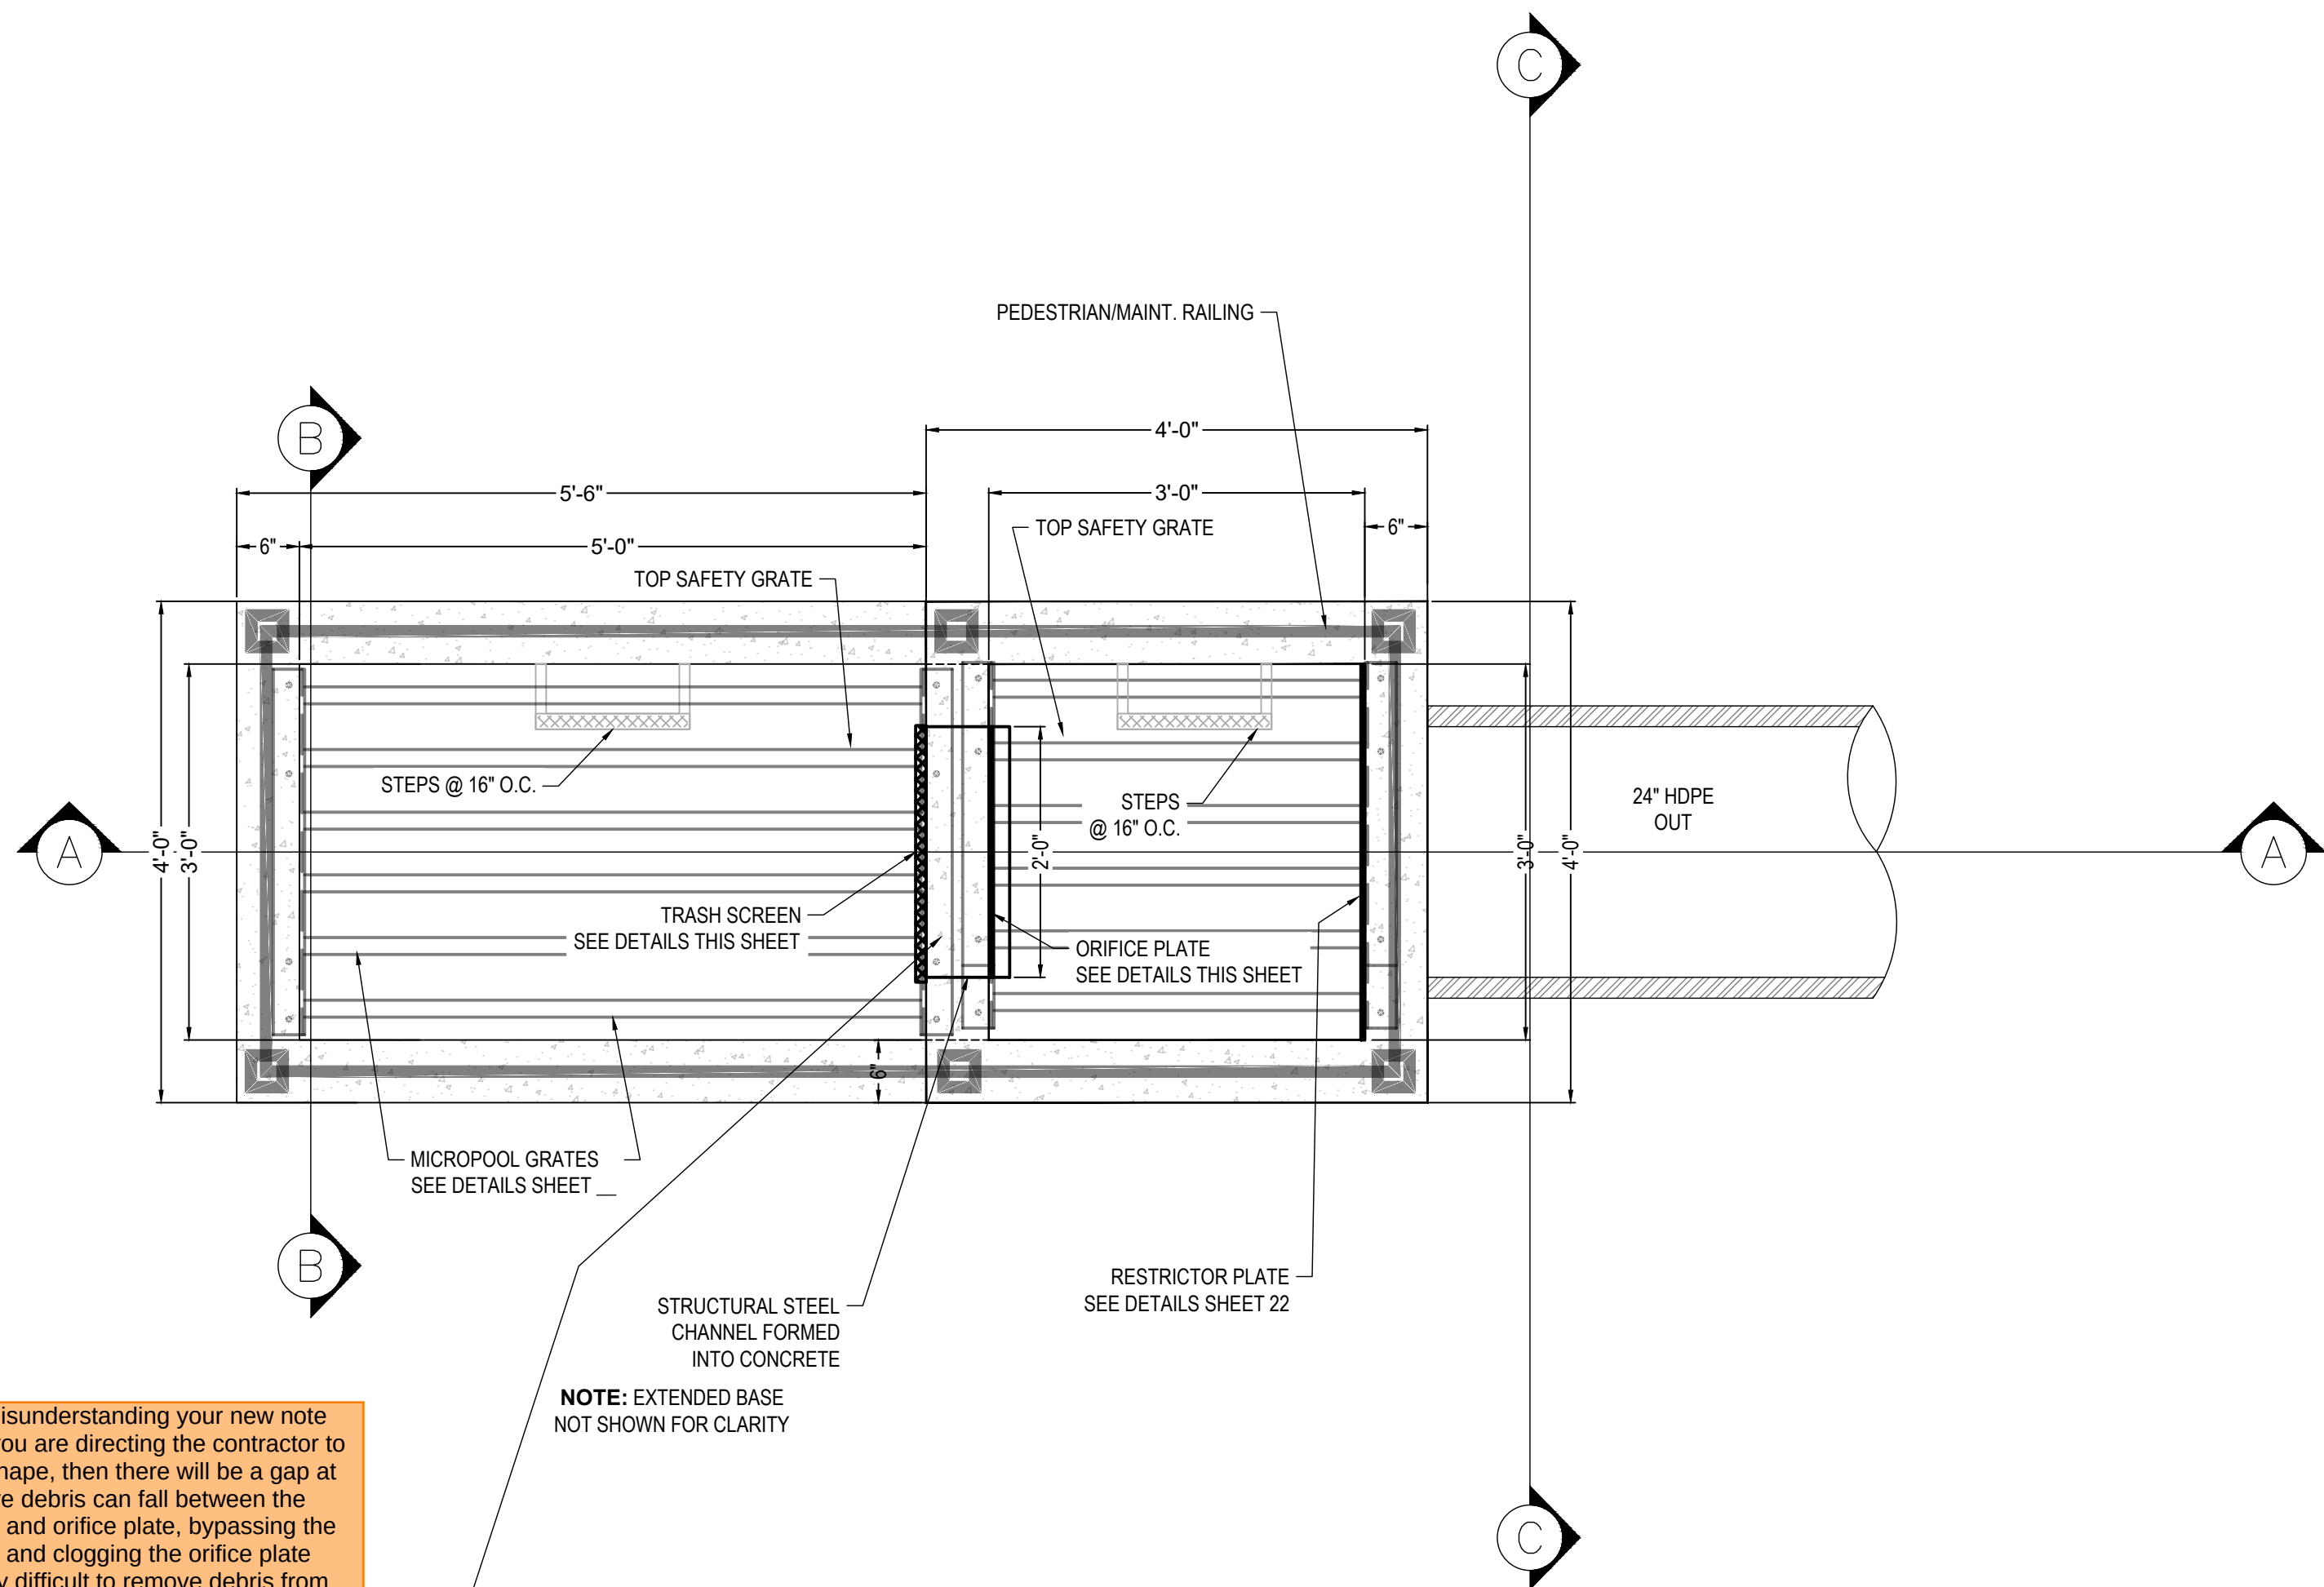


**POND OUTLET STRUCTURE
(PLAN VIEW)**
SCALE: 1" = 1-1/4'


I might be misunderstanding your new note here, but if you are directing the contractor to create a u-shape, then there will be a gap at the top where debris can fall between the microscreen and orifice plate, bypassing the microscreen and clogging the orifice plate (plus it's very difficult to remove debris from that small area), which is obviously not desirable. So if you want the u-shape, you'll need to add that a metal plate should be added to the top to "close the U."

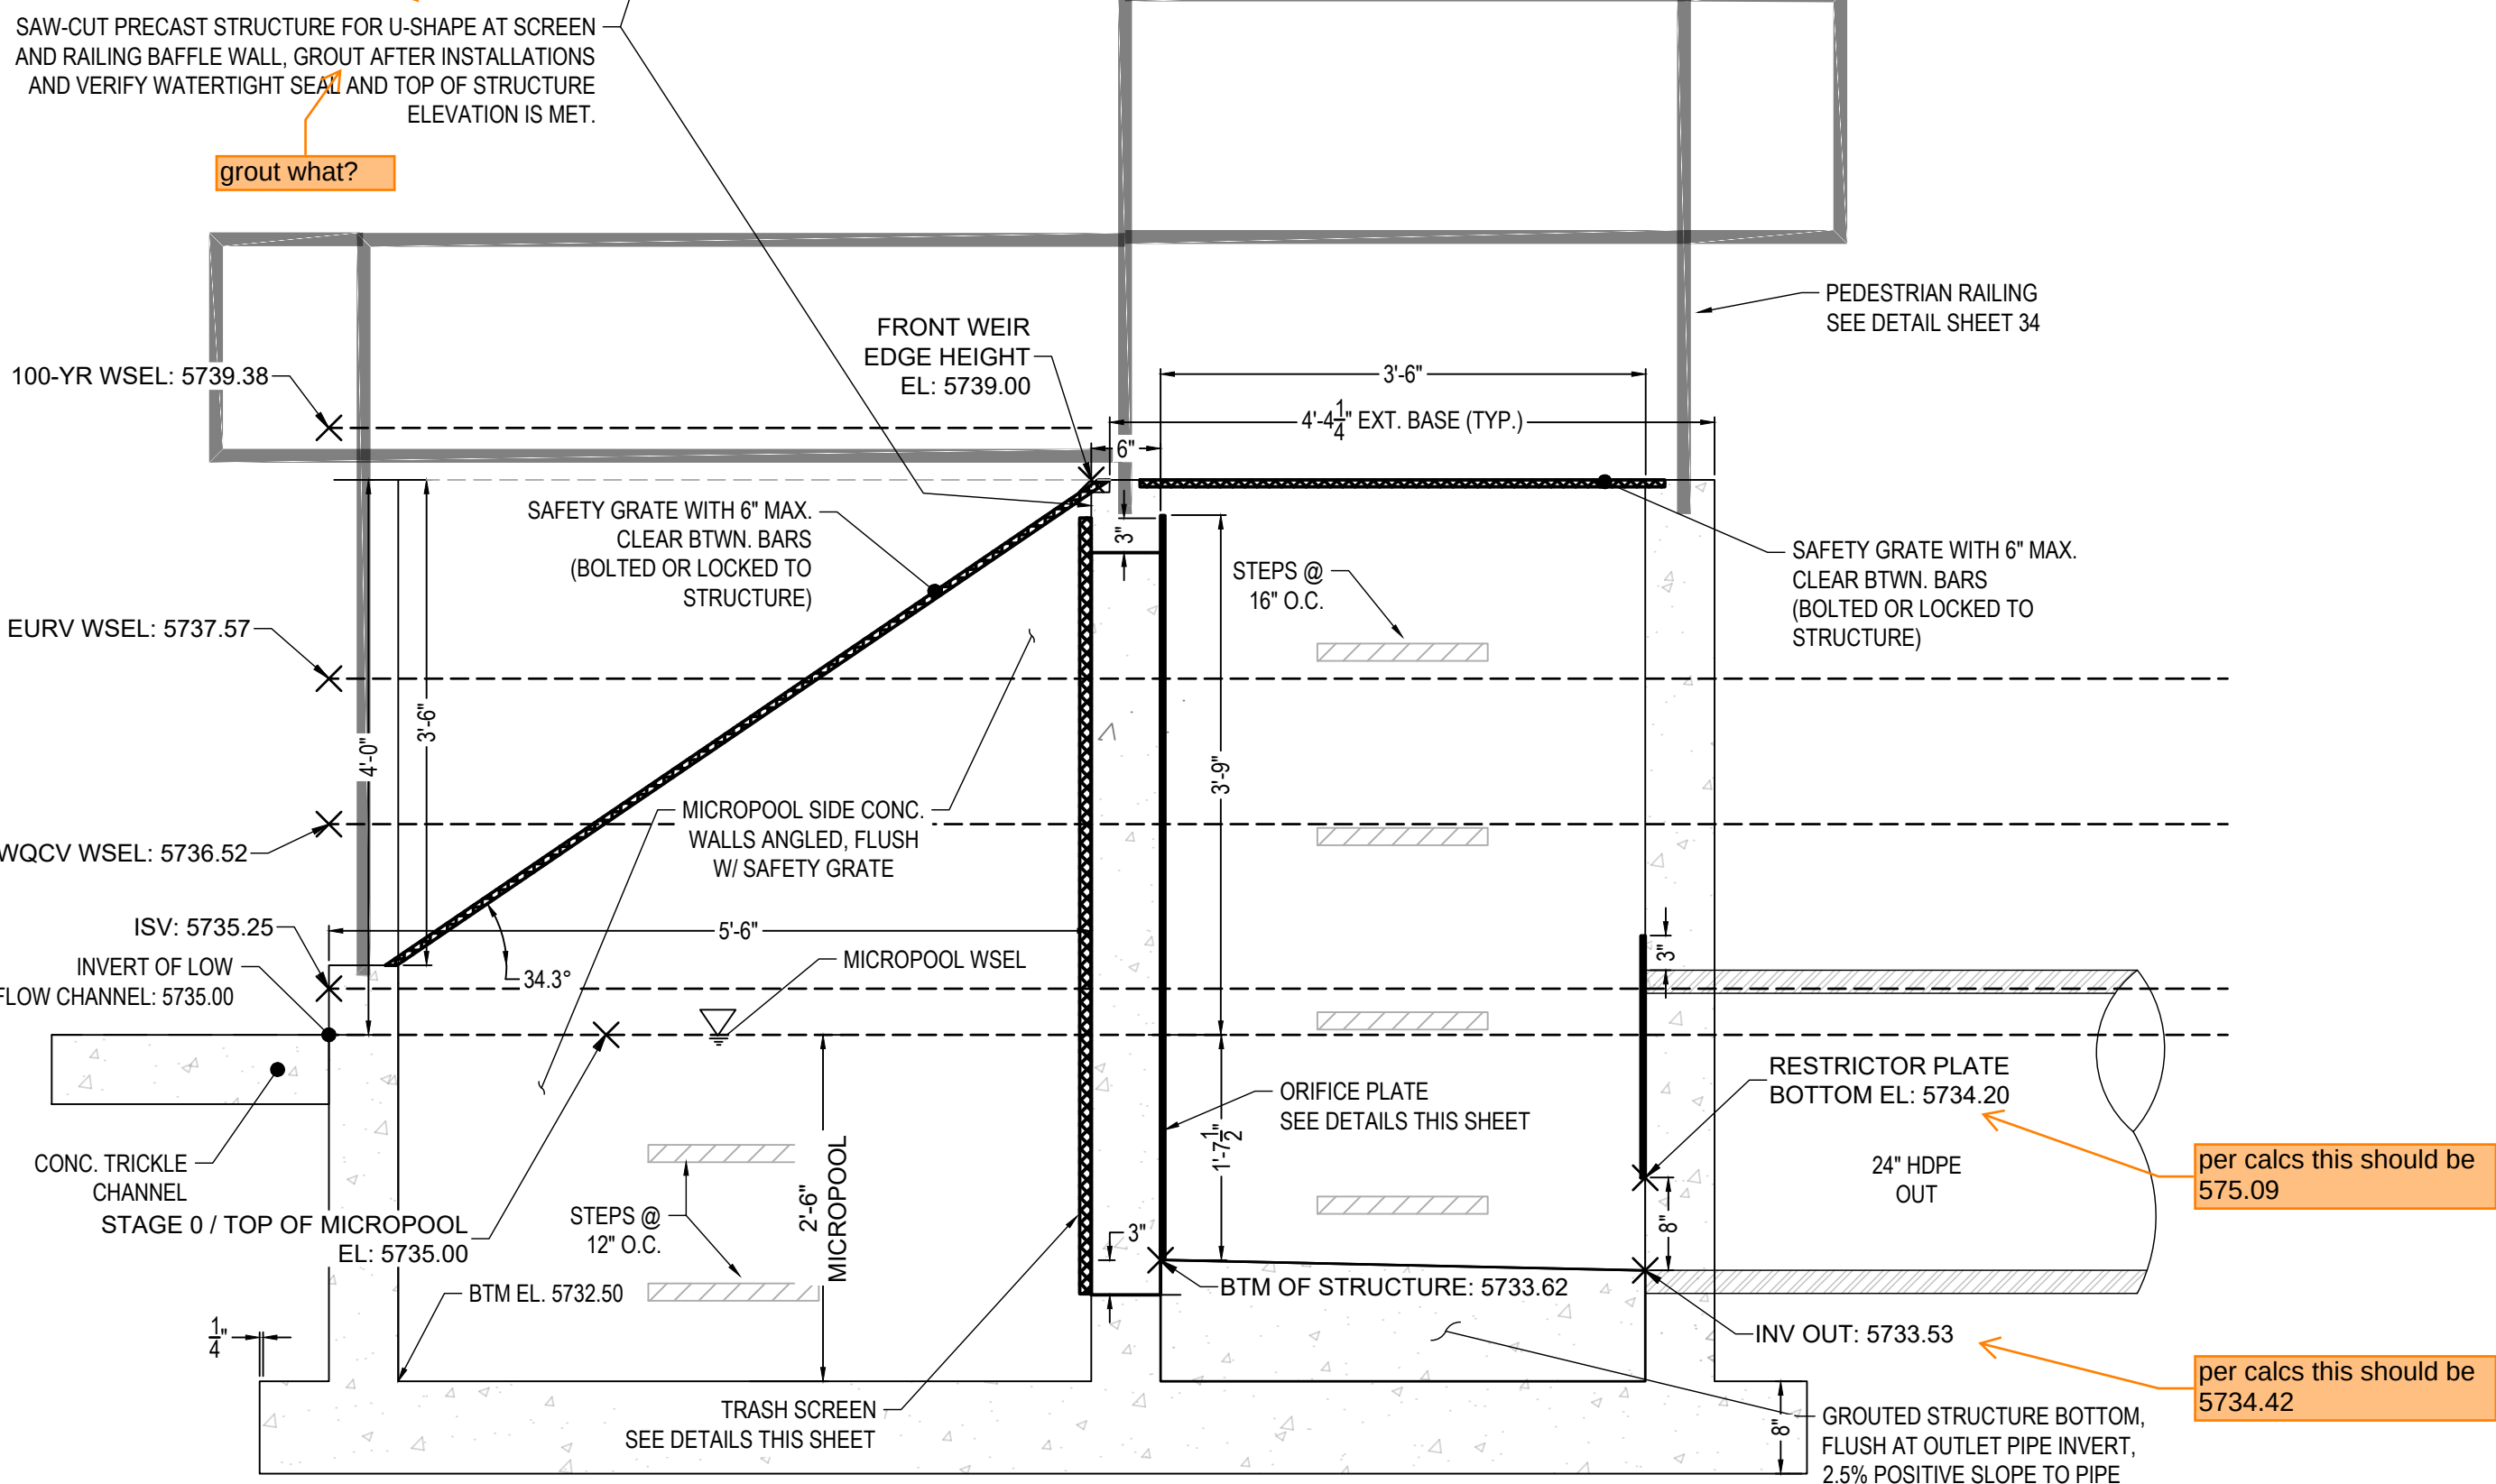

**POND OUTLET STRUCTURE
(ELEVATION VIEW, SECTION A-A)**
SCALE: 1" = 1-1/4'

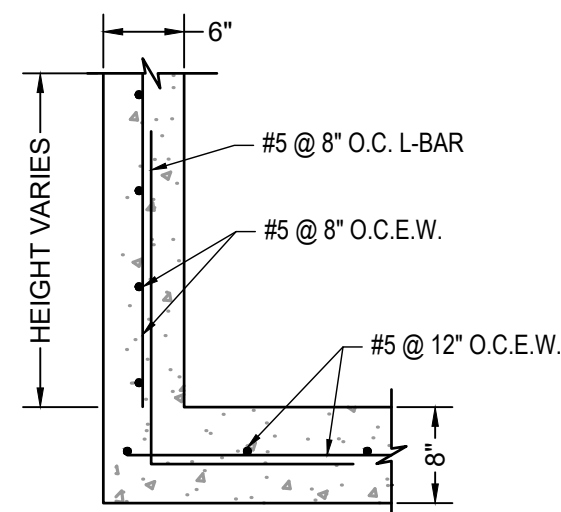

**OUTLET STRUCTURE
REINFORCEMENT DETAIL**
SCALE: NTS

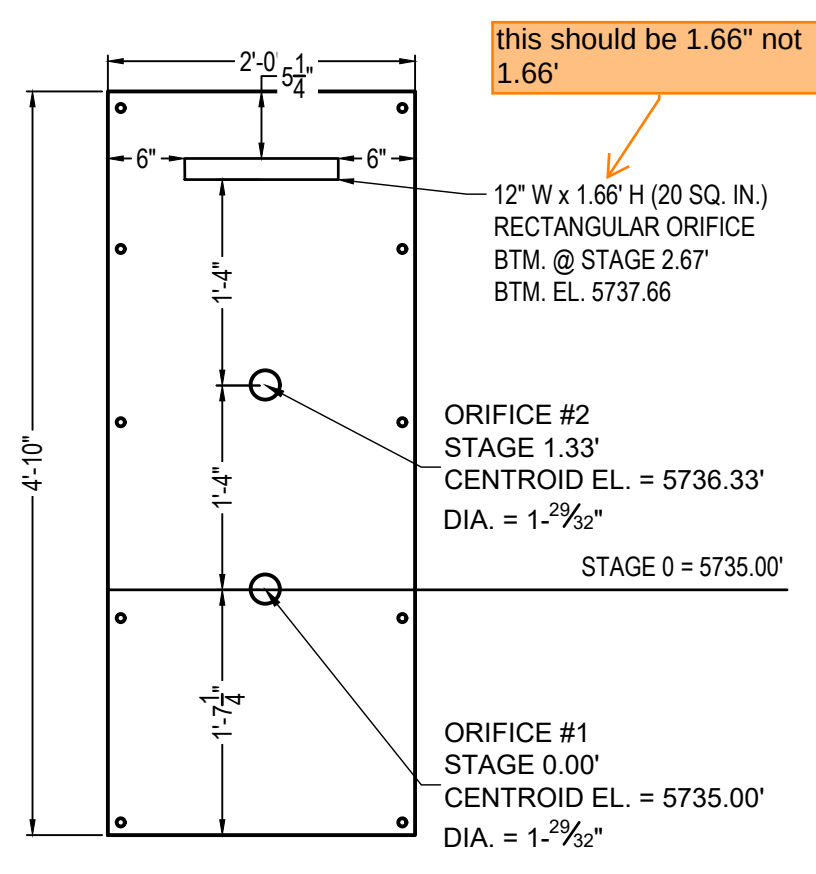


**ORIFICE PLATE DETAIL
(ELEVATION VIEW)**
SCALE: 1" = 1-1/4'

TRASH SCREEN NOTES:


1. TRASH SCREEN SHALL BE CONSTRUCTED OF 1" THICK 19-W-4 GRATING WITH 1"x1/4" BANDING BARS ON EACH SIDE AND GALVANIZED OR APPROVED EQUIVALENT AND SHALL BE ATTACHED BY INTERMITTENT WELDS.
2. TRASH SCREEN OPEN AREAS ARE FOR SPECIFIED TRASH RACK MATERIALS. TOTAL TRASH RACK SIZE MAY NEED TO BE ADJUSTED FOR MATERIALS HAVING DIFFERENT OPEN AREA/GROSS AREA RATIO (R VALUE).
3. STRUCTURAL DESIGN OF TRASH RACKS SHALL BE BASED ON FULL HYDROSTATIC HEAD WITH ZERO HEAD DOWNSTREAM OF THE RACK.
4. CONTRACTOR SHALL SUBMIT SHOP DRAWINGS FOR TRASH SCREEN FOR ENGINEER'S APPROVAL PRIOR TO CONSTRUCTION.

ORIFICE PLATE NOTES:


1. PLATE TO BE 3/8" THICK GALVANIZED STEEL.
2. BOLT PLATE TO CONCRETE 16" O.C. MAX.
3. CONTRACTOR SHALL SUBMIT SHOP DRAWINGS FOR ORIFICE PLATE FOR ENGINEER'S APPROVAL PRIOR TO CONSTRUCTION.
4. PROVIDE GASKET MATERIAL BETWEEN THE ORIFICE PLATE AND CONCRETE. GASKET SHALL BE MADE OF 1/4-INCH THICK, 60 DUROMETER EPDM RUBBER (OR EQUIVALENT GASKET APPROVED BY EPC) IN A CONTINUOUS SHEET THE SIZE OF THE ORIFICE PLATE. THE SHEET SHALL BE PLACED BETWEEN THE ORIFICE PLATE AND CONCRETE WALL, WITH THE WIDTH OF THE OVERLAP BETWEEN THE PLATE AND THE CONCRETE. OPENINGS SHALL BE CUT INTO THE SHEET CORRESPONDING TO THE PLATE BOLT HOLES AND THE CONCRETE WALL OPENING. CUTS MADE EITHER BY THE CONTRACTOR IN THE FIELD OR BY THE MANUFACTURER.

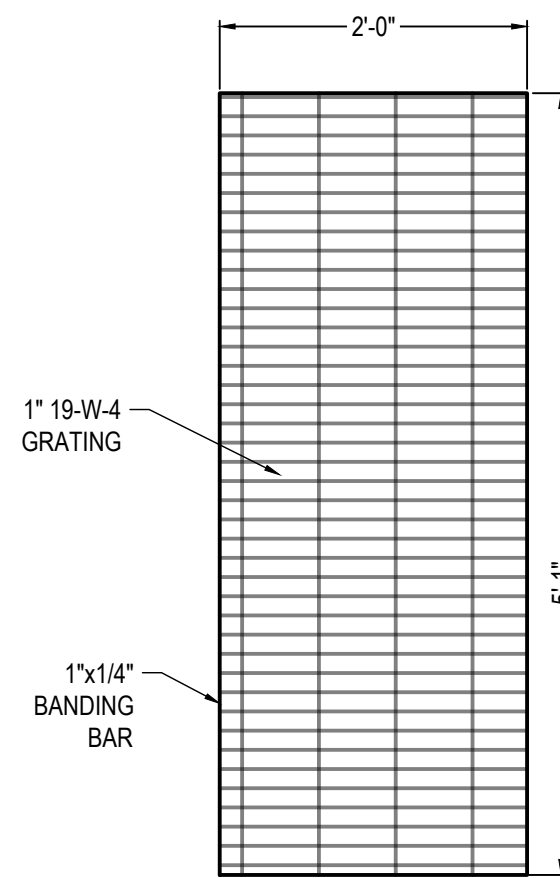


**TRASH SCREEN DETAIL
(ELEVATION VIEW)**
SCALE: 1" = 1-1/4'

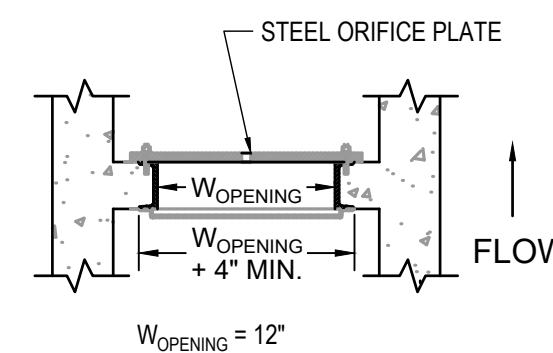

**TRASH SCREEN & ORIFICE
PLATE**
SCALE: NTS

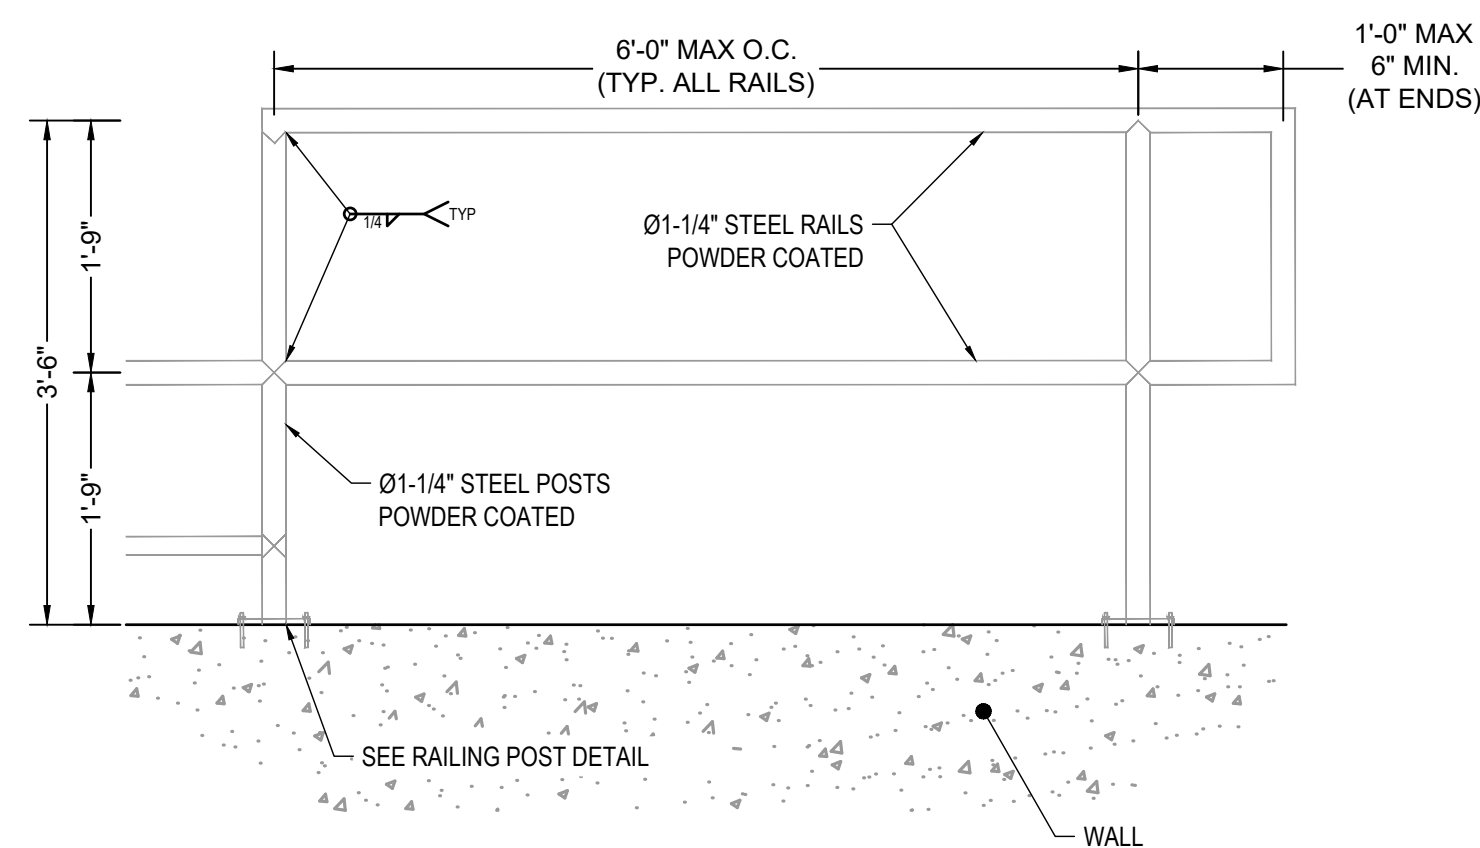

**PEDESTRIAN / MAINTENANCE RAILING
(ELEVATION VIEW)**
SCALE: 3/4" = 1'

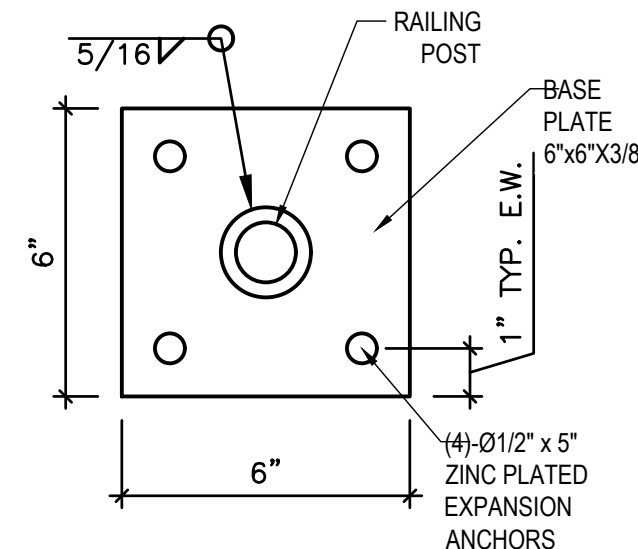

**PEDESTRIAN / MAINTENANCE
RAILING POST
(PLAN VIEW)**
SCALE: 3/4" = 1'

TWO SIGNS SHALL BE INSTALLED AROUND THE POND PERIMETER. THE SIGNS SHALL BE CONSTRUCTED OF A DURABLE MATERIAL SUCH AS METAL OR PLASTIC AND HAVE RED LETTERING ON A WHITE BACKGROUND WITH THE BELOW MESSAGE.


**WARNING:
THIS AREA IS A
STORMWATER
FACILITY AND
IS SUBJECT TO
PERIODIC
FLOODING**

MIN. SIGN AREA: 3 SQ. FT.

**POND WARNING SIGN
DETAIL**
SCALE: N.T.S.

09/22/2026
ELX REVISION #2

PCD FILE NO.: CDR-218

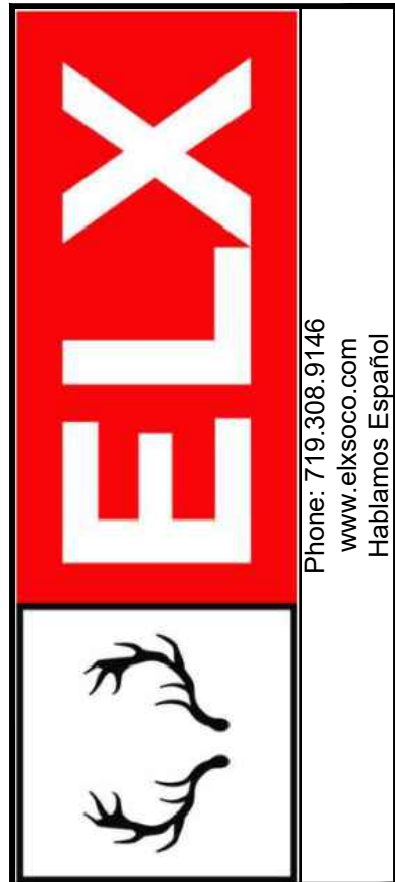

**COPYRIGHT
© 2026 ENGINEERING
LOCAL XPERTS, LLC.**

ALL RIGHTS RESERVED. THE INFORMATION DEPICTED ON THIS SHEET IS THE SOLE PROPERTY OF ENGINEERING LOCAL XPERTS, LLC AND NO PART OF THIS INFORMATION MAY BE REPRODUCED IN ANY FORM WITHOUT THE WRITTEN PERMISSION OF ENGINEERING LOCAL XPERTS, LLC.

PROJECT NAME:

SUNSET VILLAGE
FILING NO. 4

PROJECT LOCATION:

SUNSET VILLAGE
FILING NO. 4
EL PASO COUNTY, COLORADO


CLIENT:

SCOTT ALLEN HOMES

CONTACT INFO:

SCOTT VAN WYHE
SCOTT ALLEN HOMES
scott@punchlistconnection.com

PROFESSIONAL SEAL:

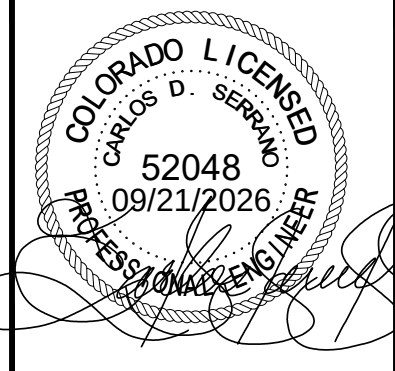

DATE: DESCRIPTION:

04/04/26 CDR218 REV. 1
09/22/26 CDR218 REV. 2

JOB #: 101544

DRAWN BY: CDS
REVIEWED BY: CDS
PROJ. MNGR.: CDS

PLAN SET:

SUNSET VILLAGE
FILING NO. 4
PERMANENT CONTROL MEASURE
INFRASTRUCTURE DETAILS

SHEET TITLE:


OUTLET STRUCTURE DETAILS

SHEET NO.:

21


- SAFETY GRATES/TRASH RACK NOTES:**
1. TRASH RACKS AND SAFETY GRATES SHALL BE 1- $\frac{1}{2}$ " SCH. 40 STEEL PIPE, @ 6" CENTERS BOUNDED BY 3"x3"x1/4" ANGLE IRON. ALL GRATES SHALL BE MOUNTED USING ZINC PLATED STEEL HARDWARE.
 2. REMOVABLE GRATE SECTIONS SHALL BE MOUNTED USING ZINC PLATED STEEL HARDWARE AND PROVIDED WITH HINGED & LOCKABLE OR BOLTABLE ACCESS PANELS AS SHOWN ON THE PLANS.
 3. STEEL GRATES SHALL BE HOT DIP GALVANIZED AND MAY BE HOT POWDER COATED AFTER GALVANIZING.
 4. STRUCTURAL STEEL FOR GRATES SHALL BE GALVANIZED AND SHALL BE IN ACCORDANCE WITH CDOT STANDARD SPECIFICATIONS, SUBSECTION 712.06.
 5. CONTRACTOR SHALL SUBMIT SHOP DRAWINGS FOR GRATING FOR ENGINEER'S APPROVAL PRIOR TO CONSTRUCTION.

- RESTRICTOR PLATE NOTES:**
1. $\frac{3}{8}$ " THICK RESTRICTOR PLATE, GALVANIZED STEEL.
 2. BOLT PLATE TO CONCRETE @ 12" O.C. MAX.
 3. PROVIDE CONTINUOUS NEOPRENE GASKET MATERIAL BETWEEN PLATE AND CONCRETE.
 5. CONTRACTOR SHALL SUBMIT SHOP DRAWINGS FOR RESTRICTOR PLATE FOR ENGINEER'S APPROVAL PRIOR TO CONSTRUCTION.

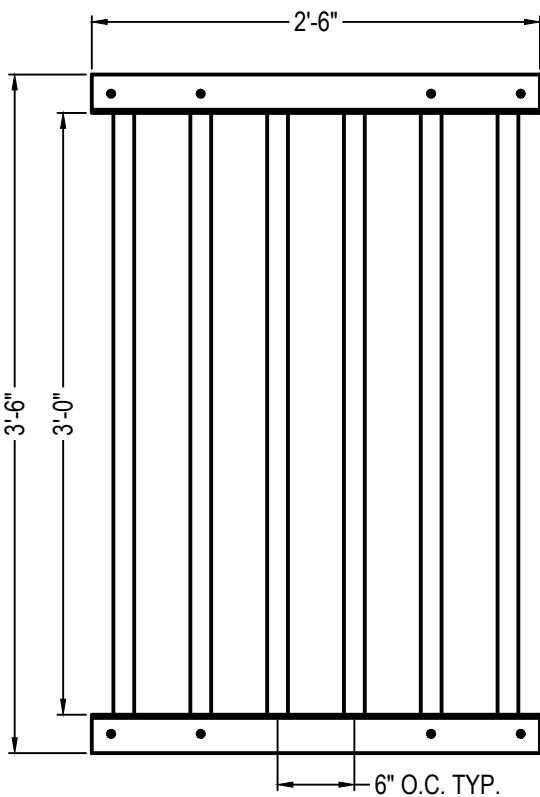


MICROPOOL FRONT/TOP
ANGLED GRATE
(ELEVATION VIEW)
SCALE: NTS


NOTE: TOTAL LENGTH OF FRONT/TOP MICROPOOL SAFETY GRATE IS 46'23" ACCOUNTING FOR ANGLED.

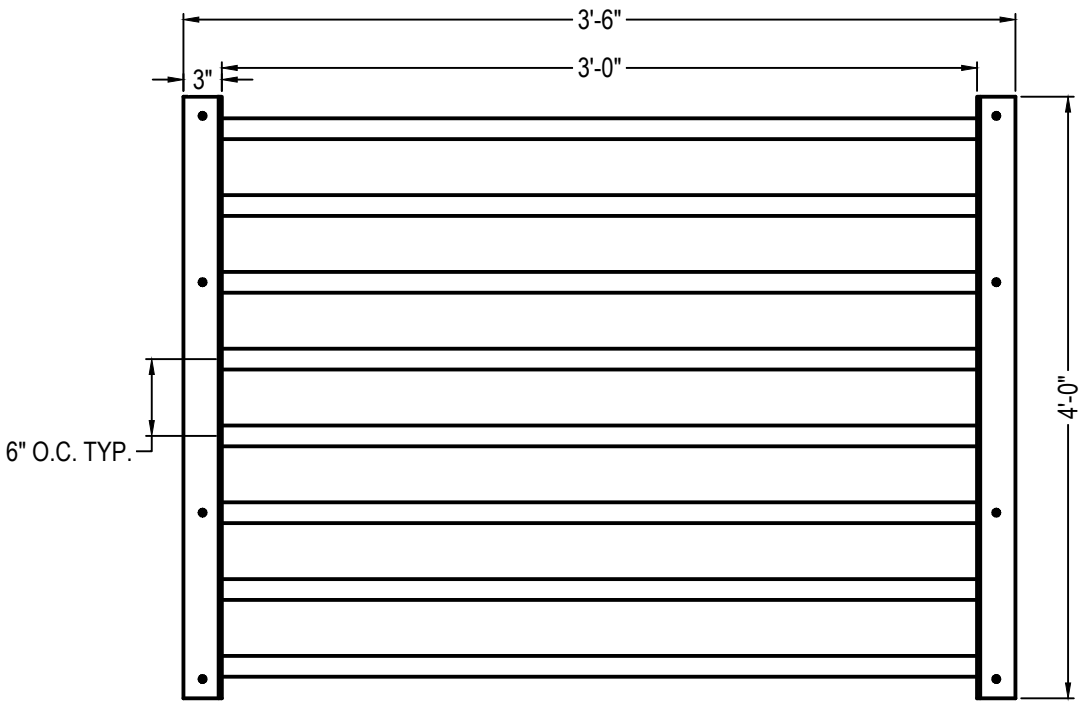


SAFETY GRATE (PLAN VIEW)
SCALE: NTS

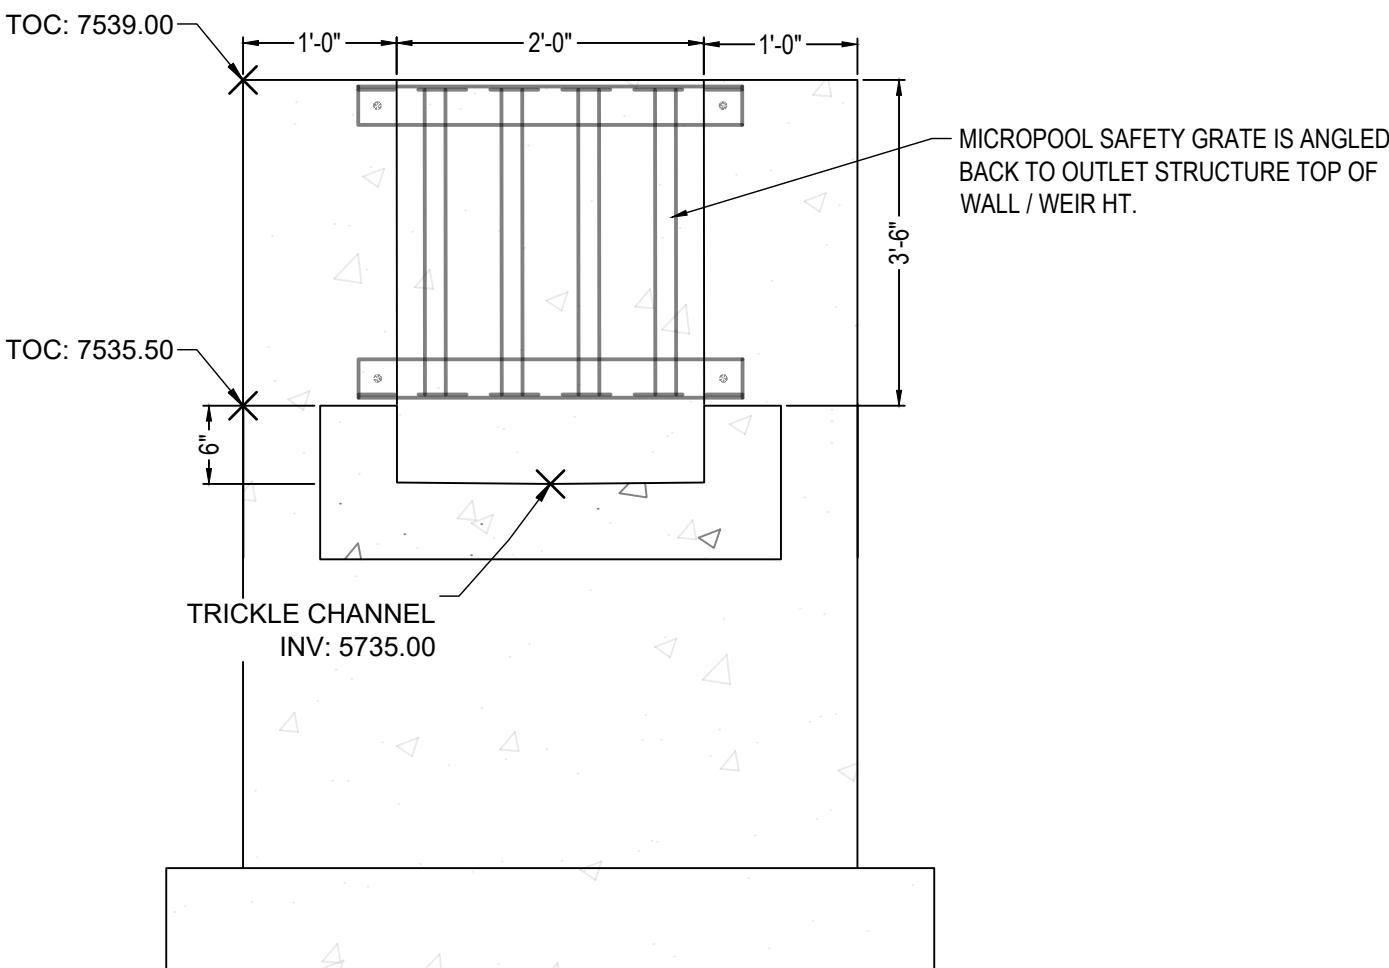

FRONT FACE OF STRUCTURE
(SECTION VIEW B-B)
SCALE: NTS

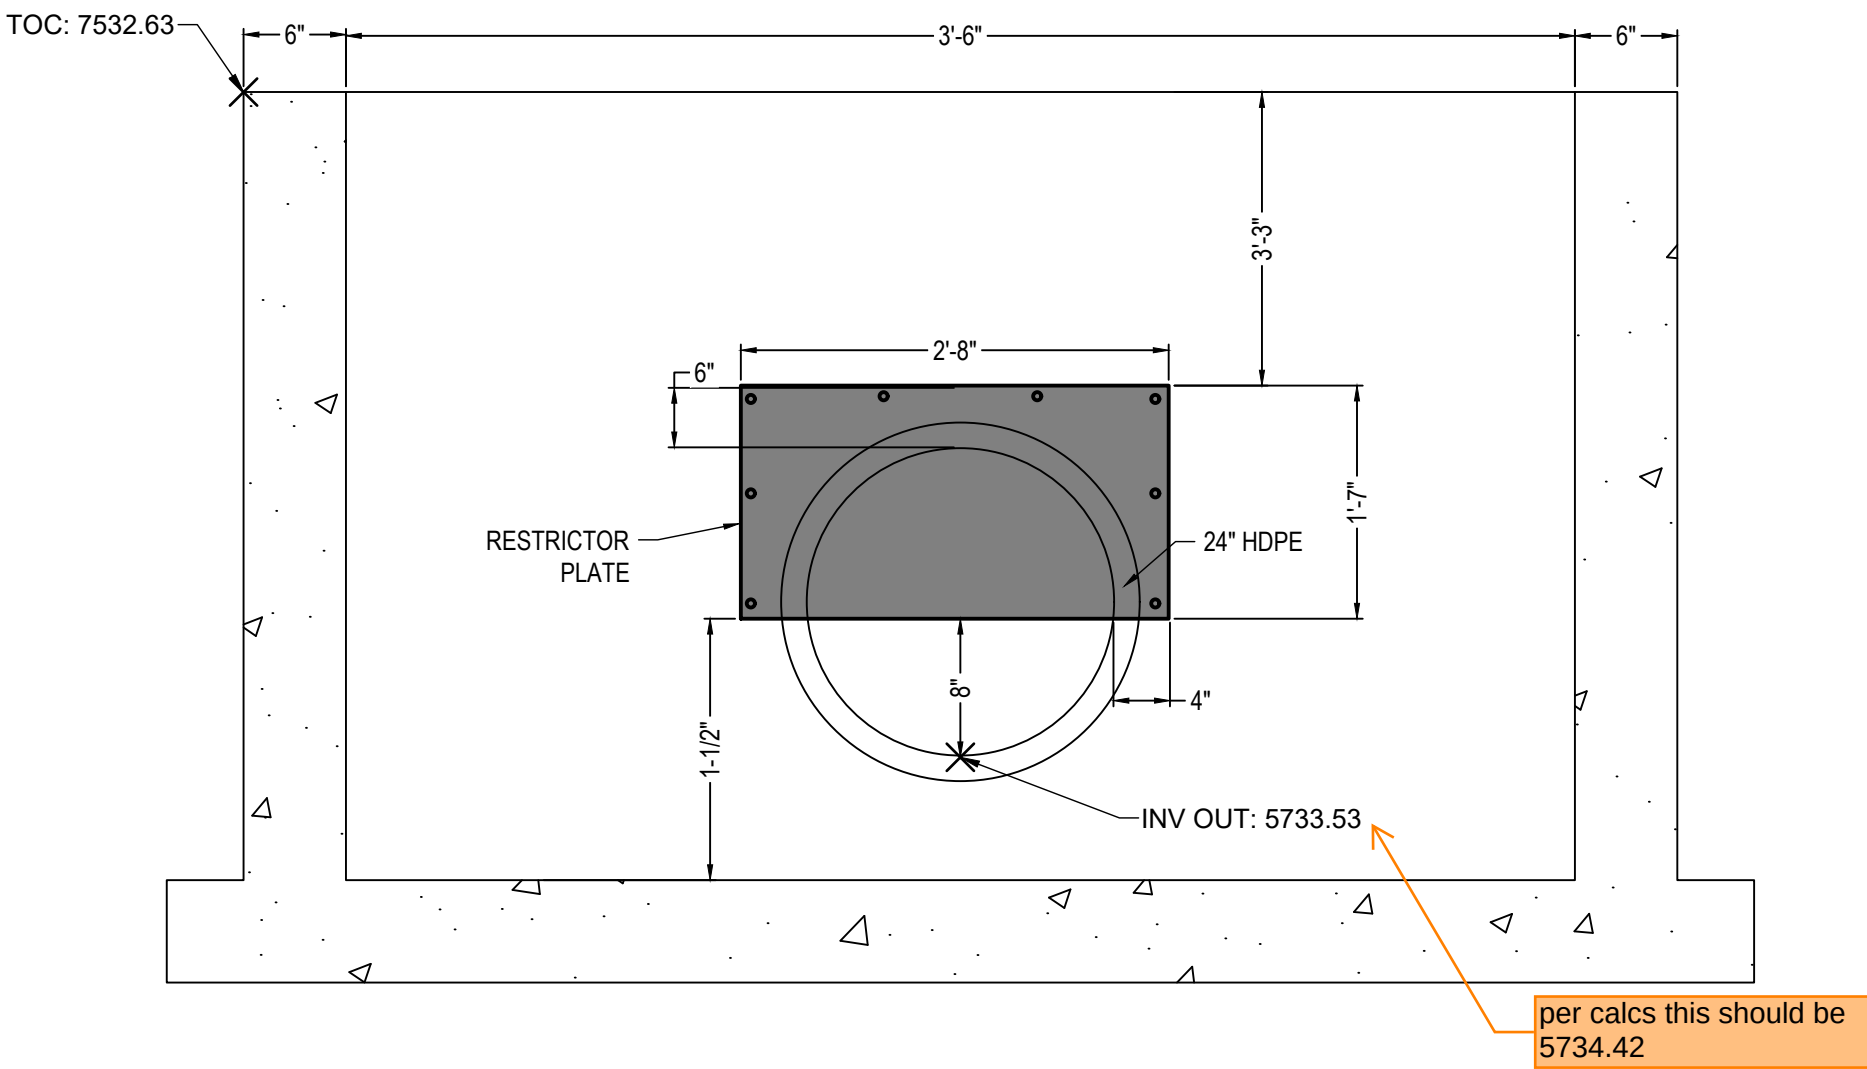

RESTRICTOR PLATE
(SECTION VIEW C-C)
SCALE: 1" = 1'-1/4"

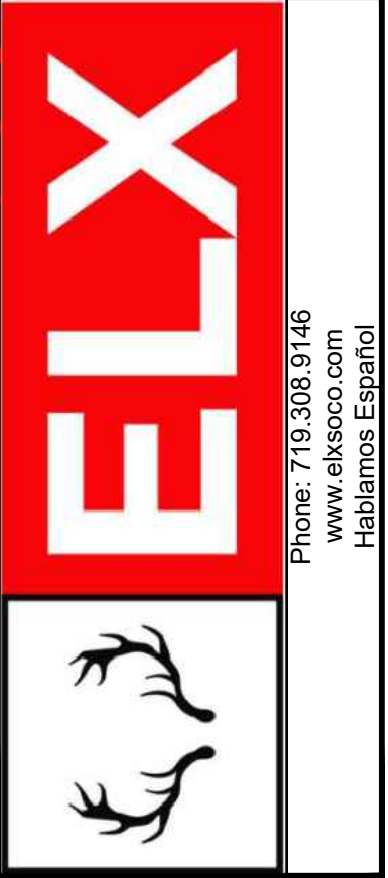

COPYRIGHT
© 2026 ENGINEERING
LOCAL XPERTS, LLC.

ALL RIGHTS RESERVED. THE
INFORMATION DEPICTED ON THIS
SHEET IS THE SOLE PROPERTY OF
ENGINEERING LOCAL XPERTS, LLC AND
NO PART OF THIS INFORMATION MAY
BE REPRODUCED IN ANY FORM
WITHOUT THE WRITTEN PERMISSION
OF ENGINEERING LOCAL XPERTS, LLC.

PROJECT NAME:

SUNSET VILLAGE
FILING NO. 4

PROJECT LOCATION:

SUNSET VILLAGE
FILING NO. 4
EL PASO COUNTY, COLORADO

CLIENT:

SCOTT ALLEN HOMES

CONTACT INFO:

SCOTT VAN WYHE
SCOTT ALLEN HOMES
scott@punchlistconnection.com

PROFESSIONAL SEAL:



DATE:	DESCRIPTION:
04/04/26	CDR218 REV. 1

JOB #: 101544

DRAWN BY: CDS
REVIEWED BY: CDS
PROJ. MNGR.: CDS

PLAN SET:









SUNSET VILLAGE
FILING NO. 4
PERMANENT CONTROL MEASURE
INFRASTRUCTURE DETAILS









SHEET TITLE:

OUTLET STRUCTURE DETAILS

SHEET NO.:

22

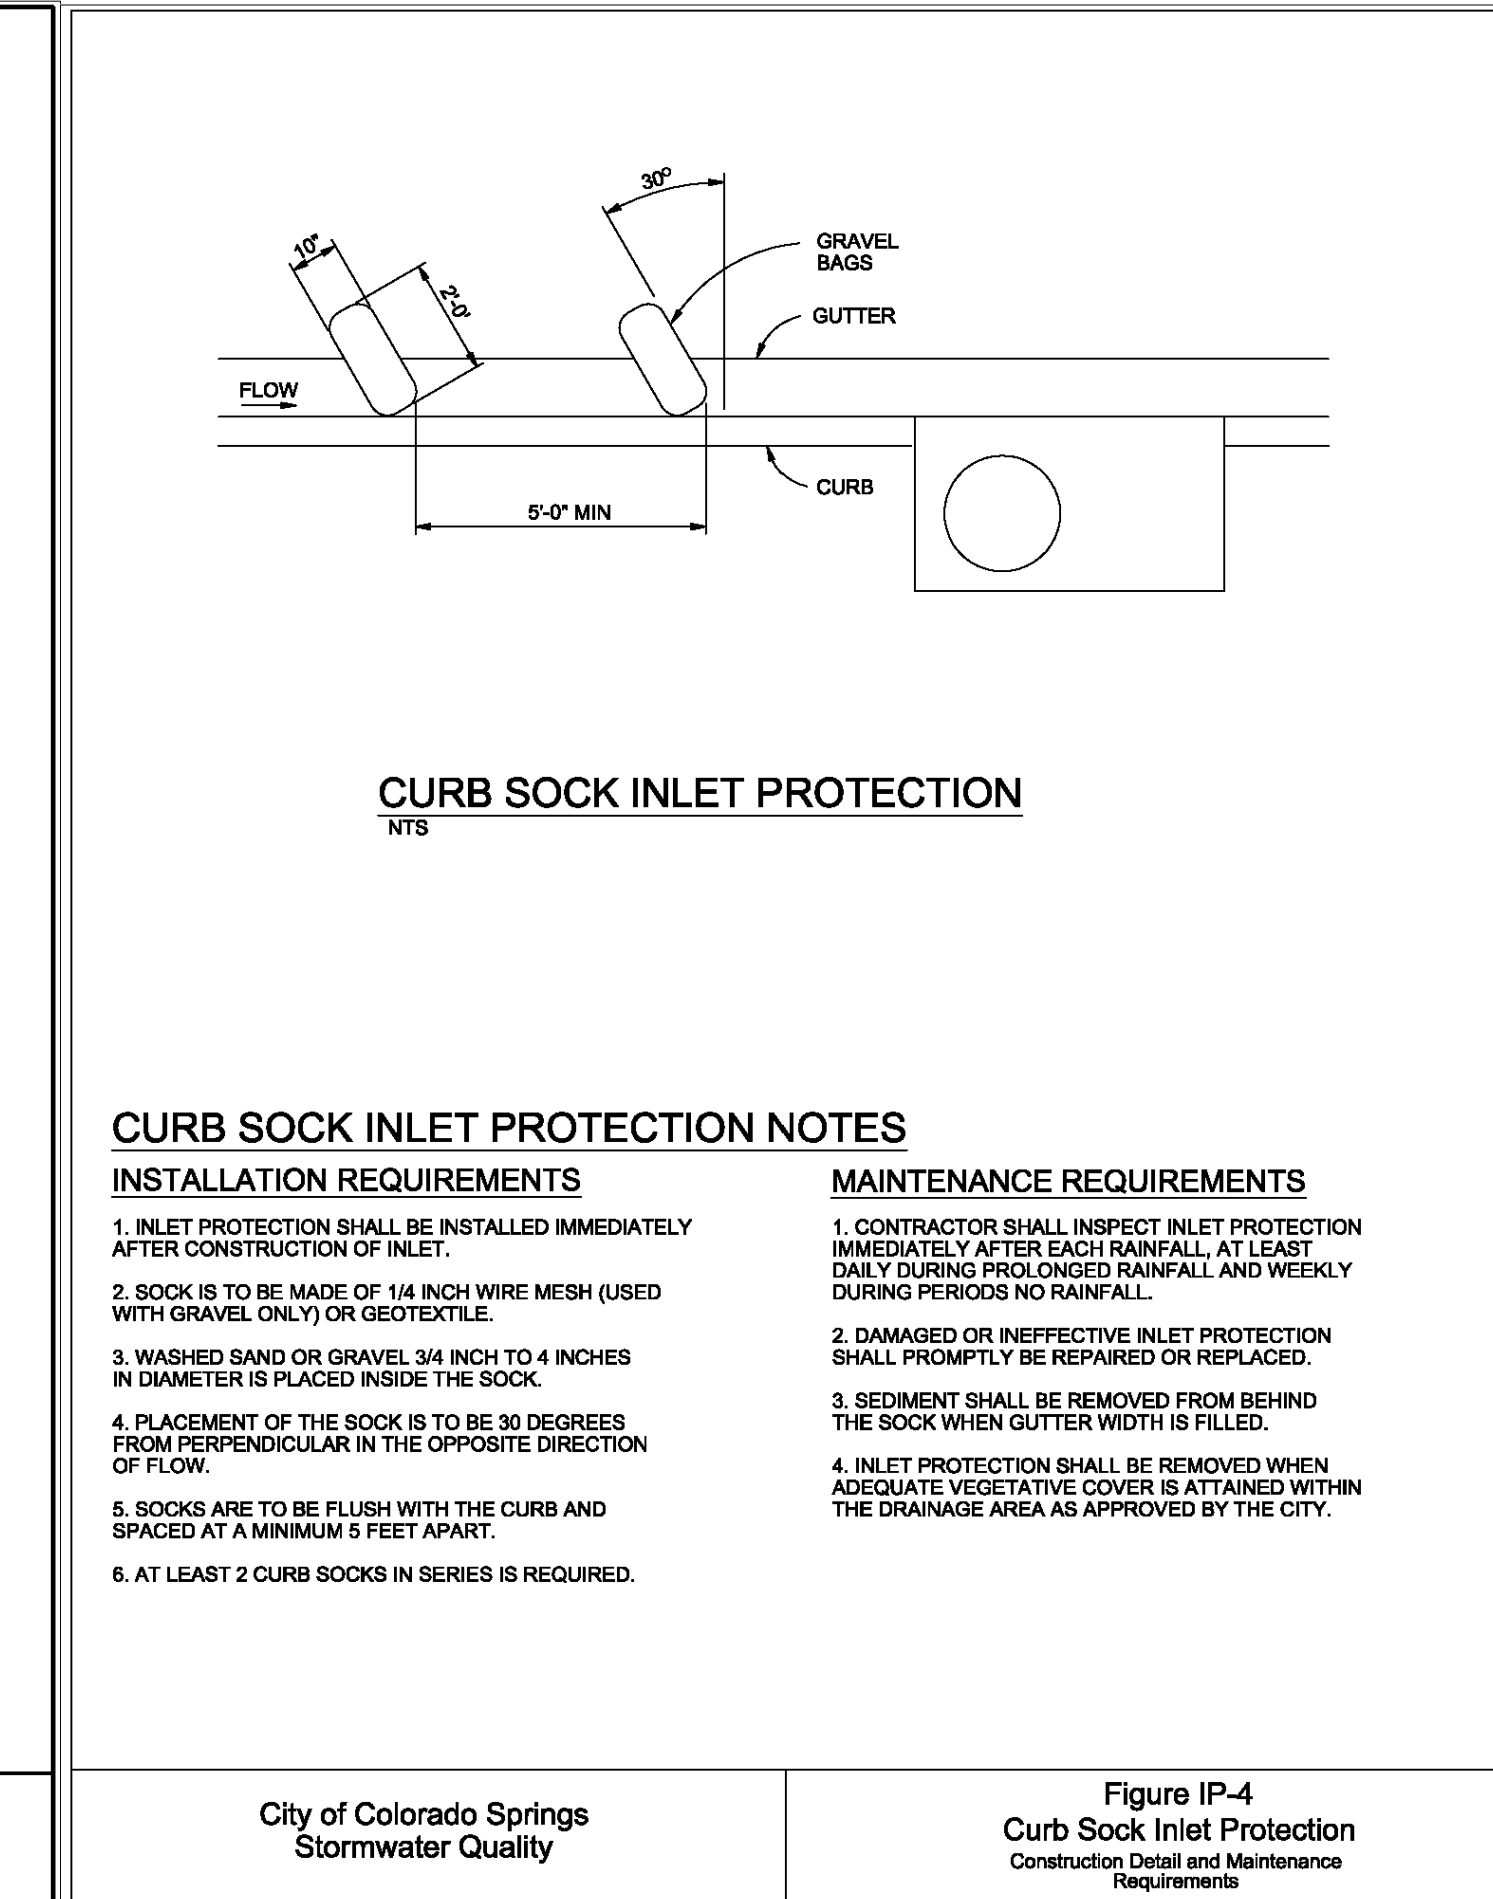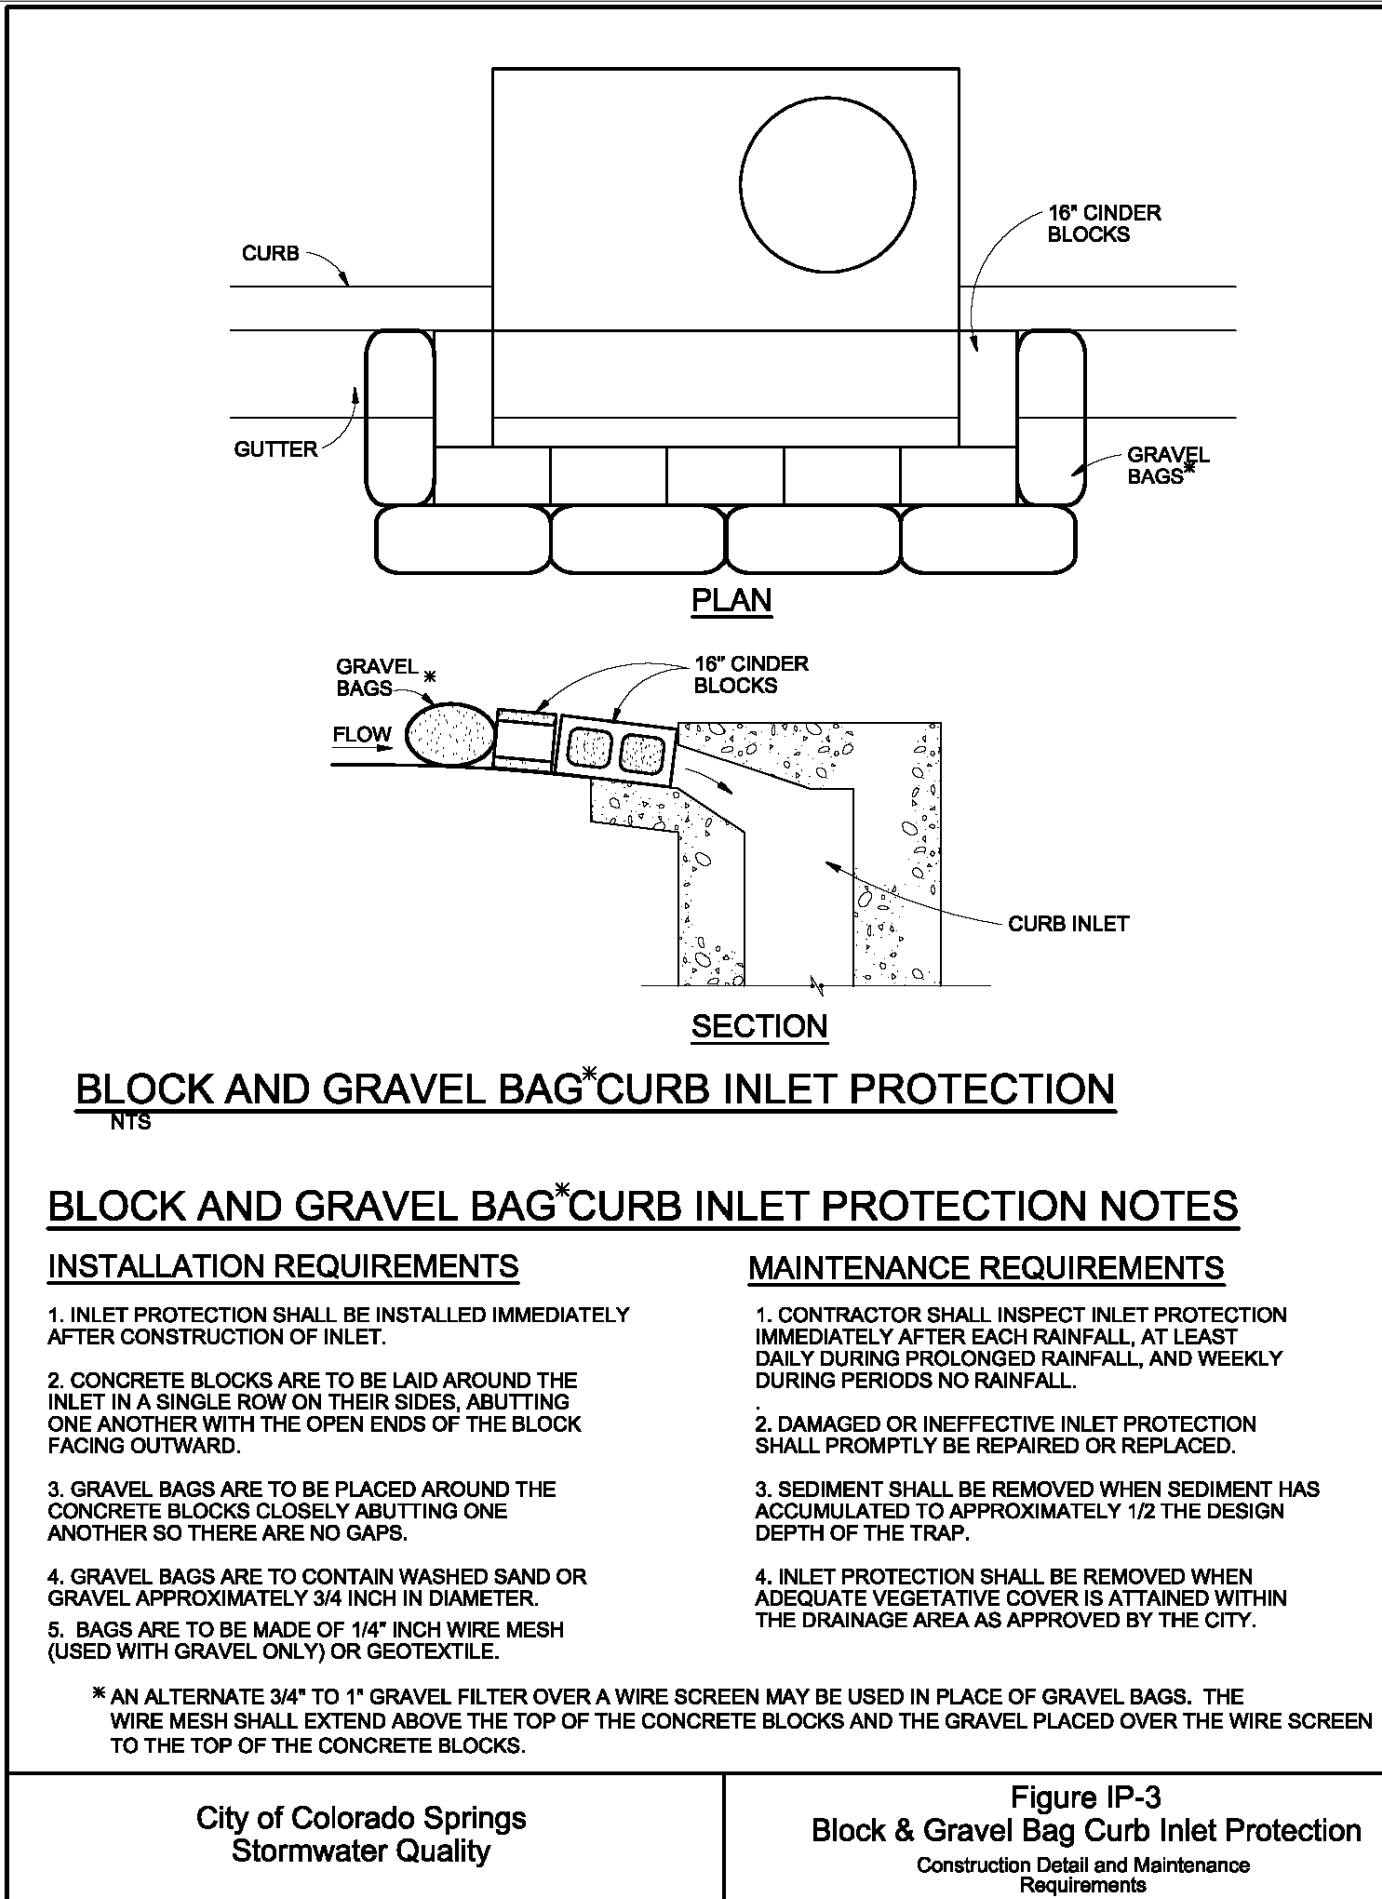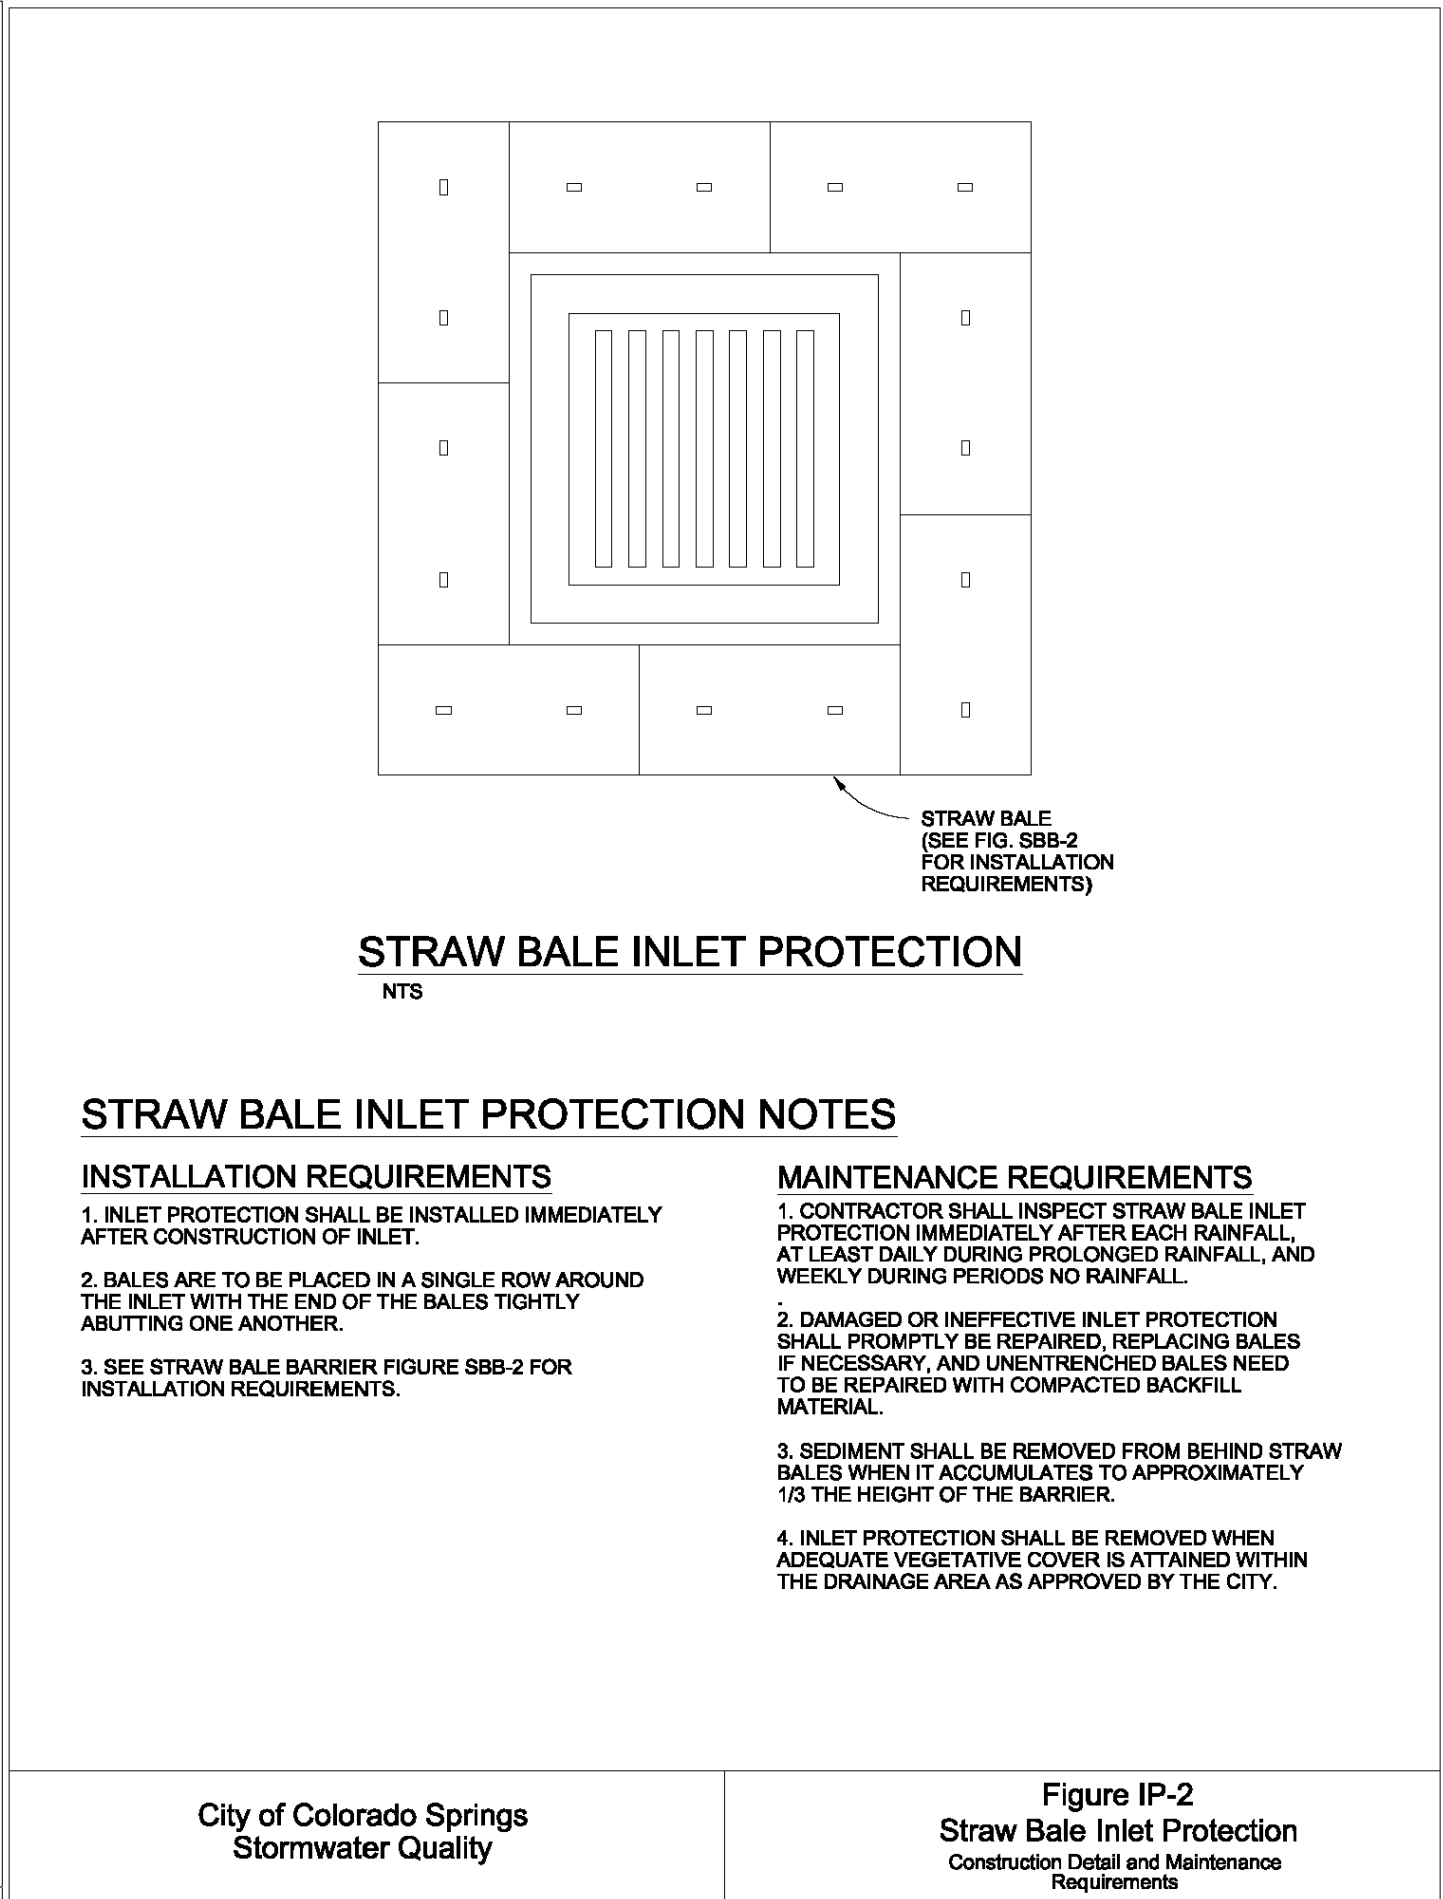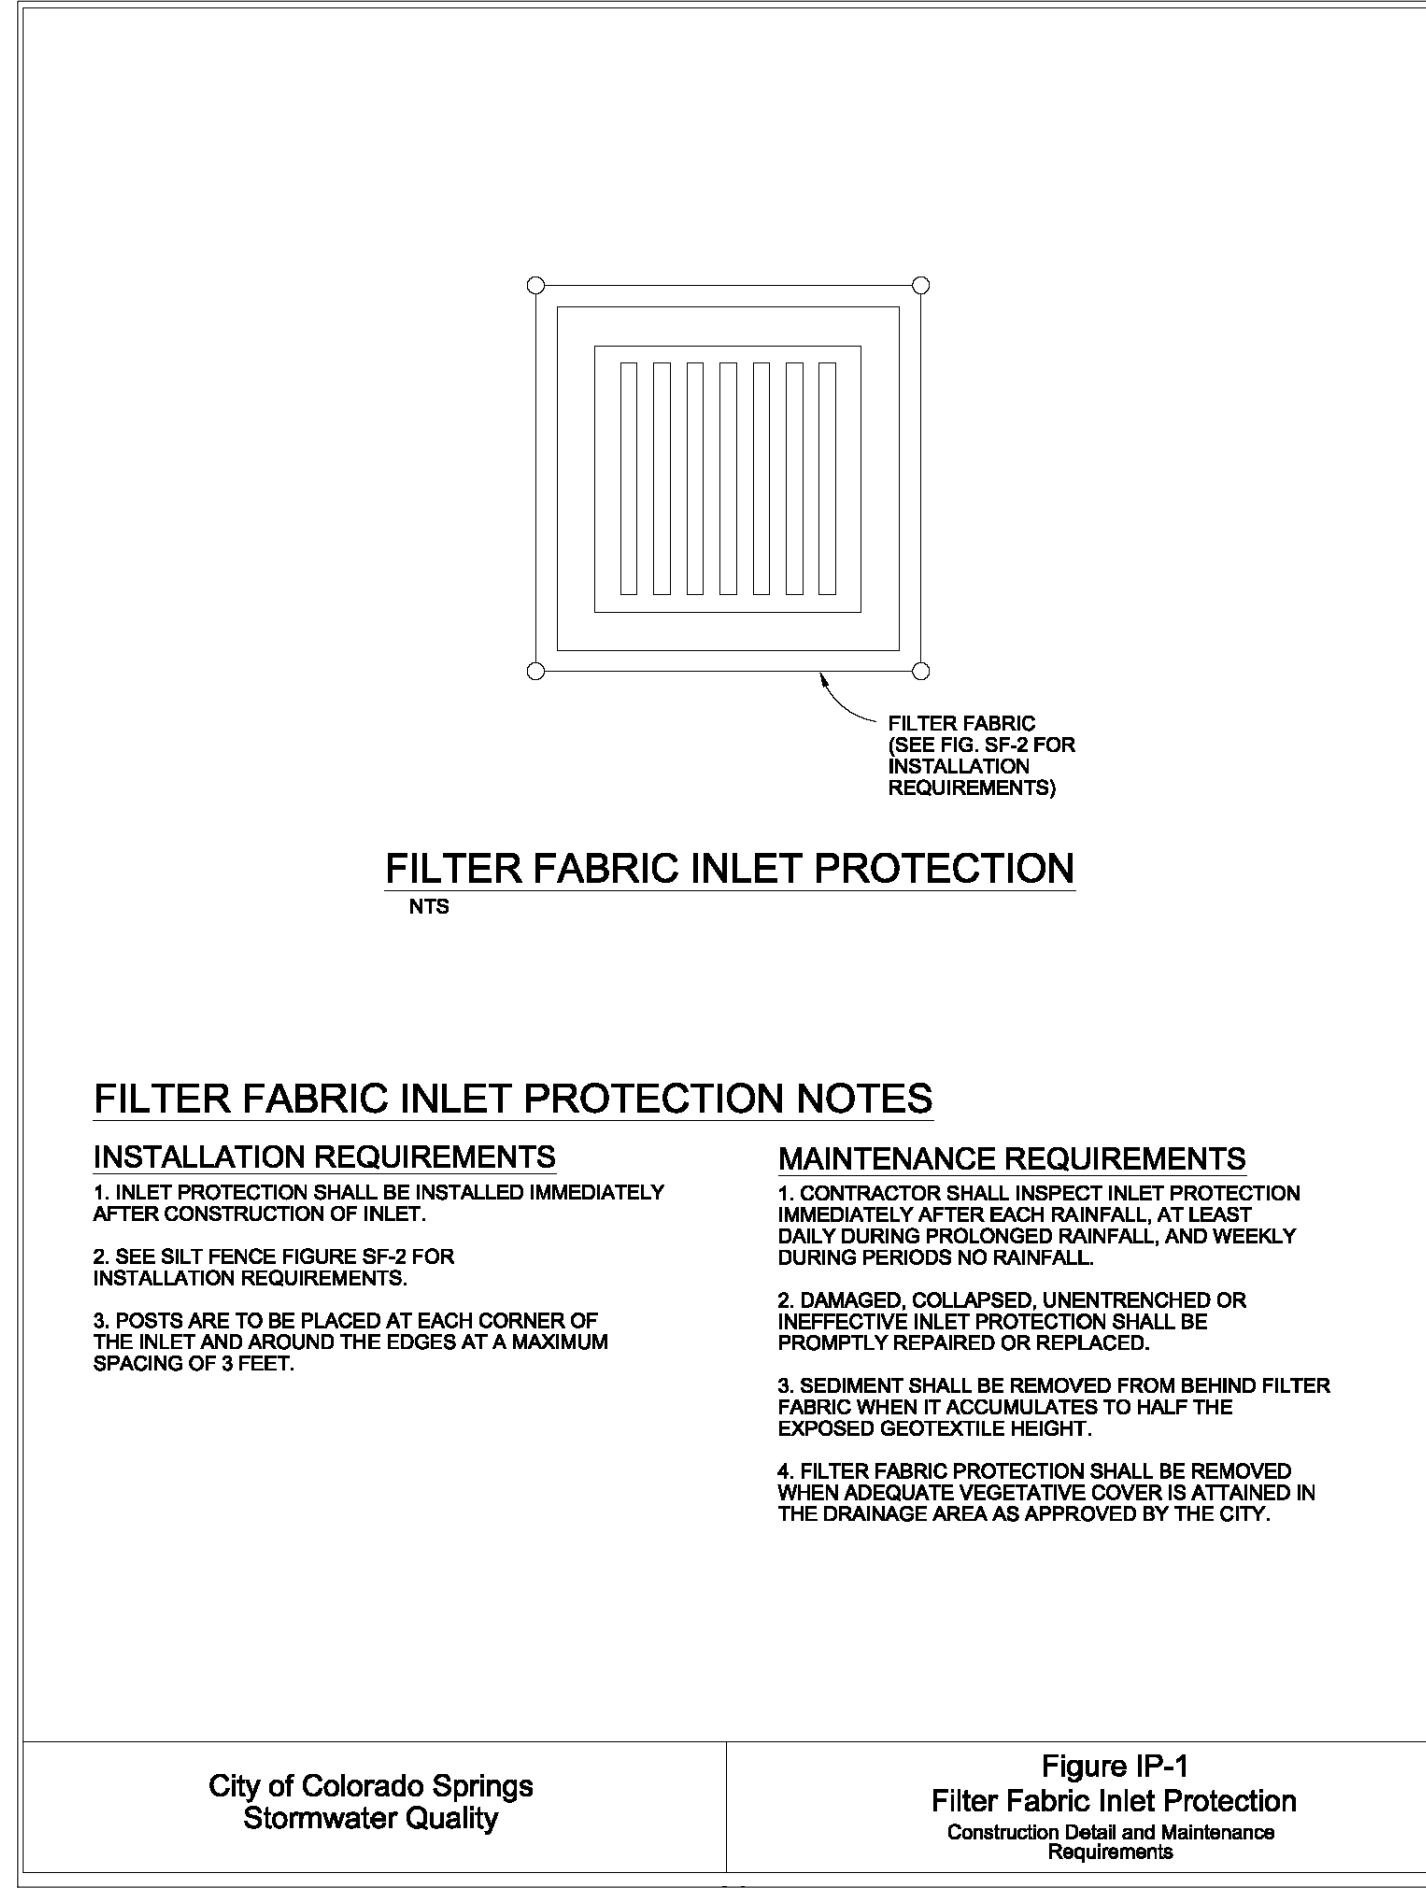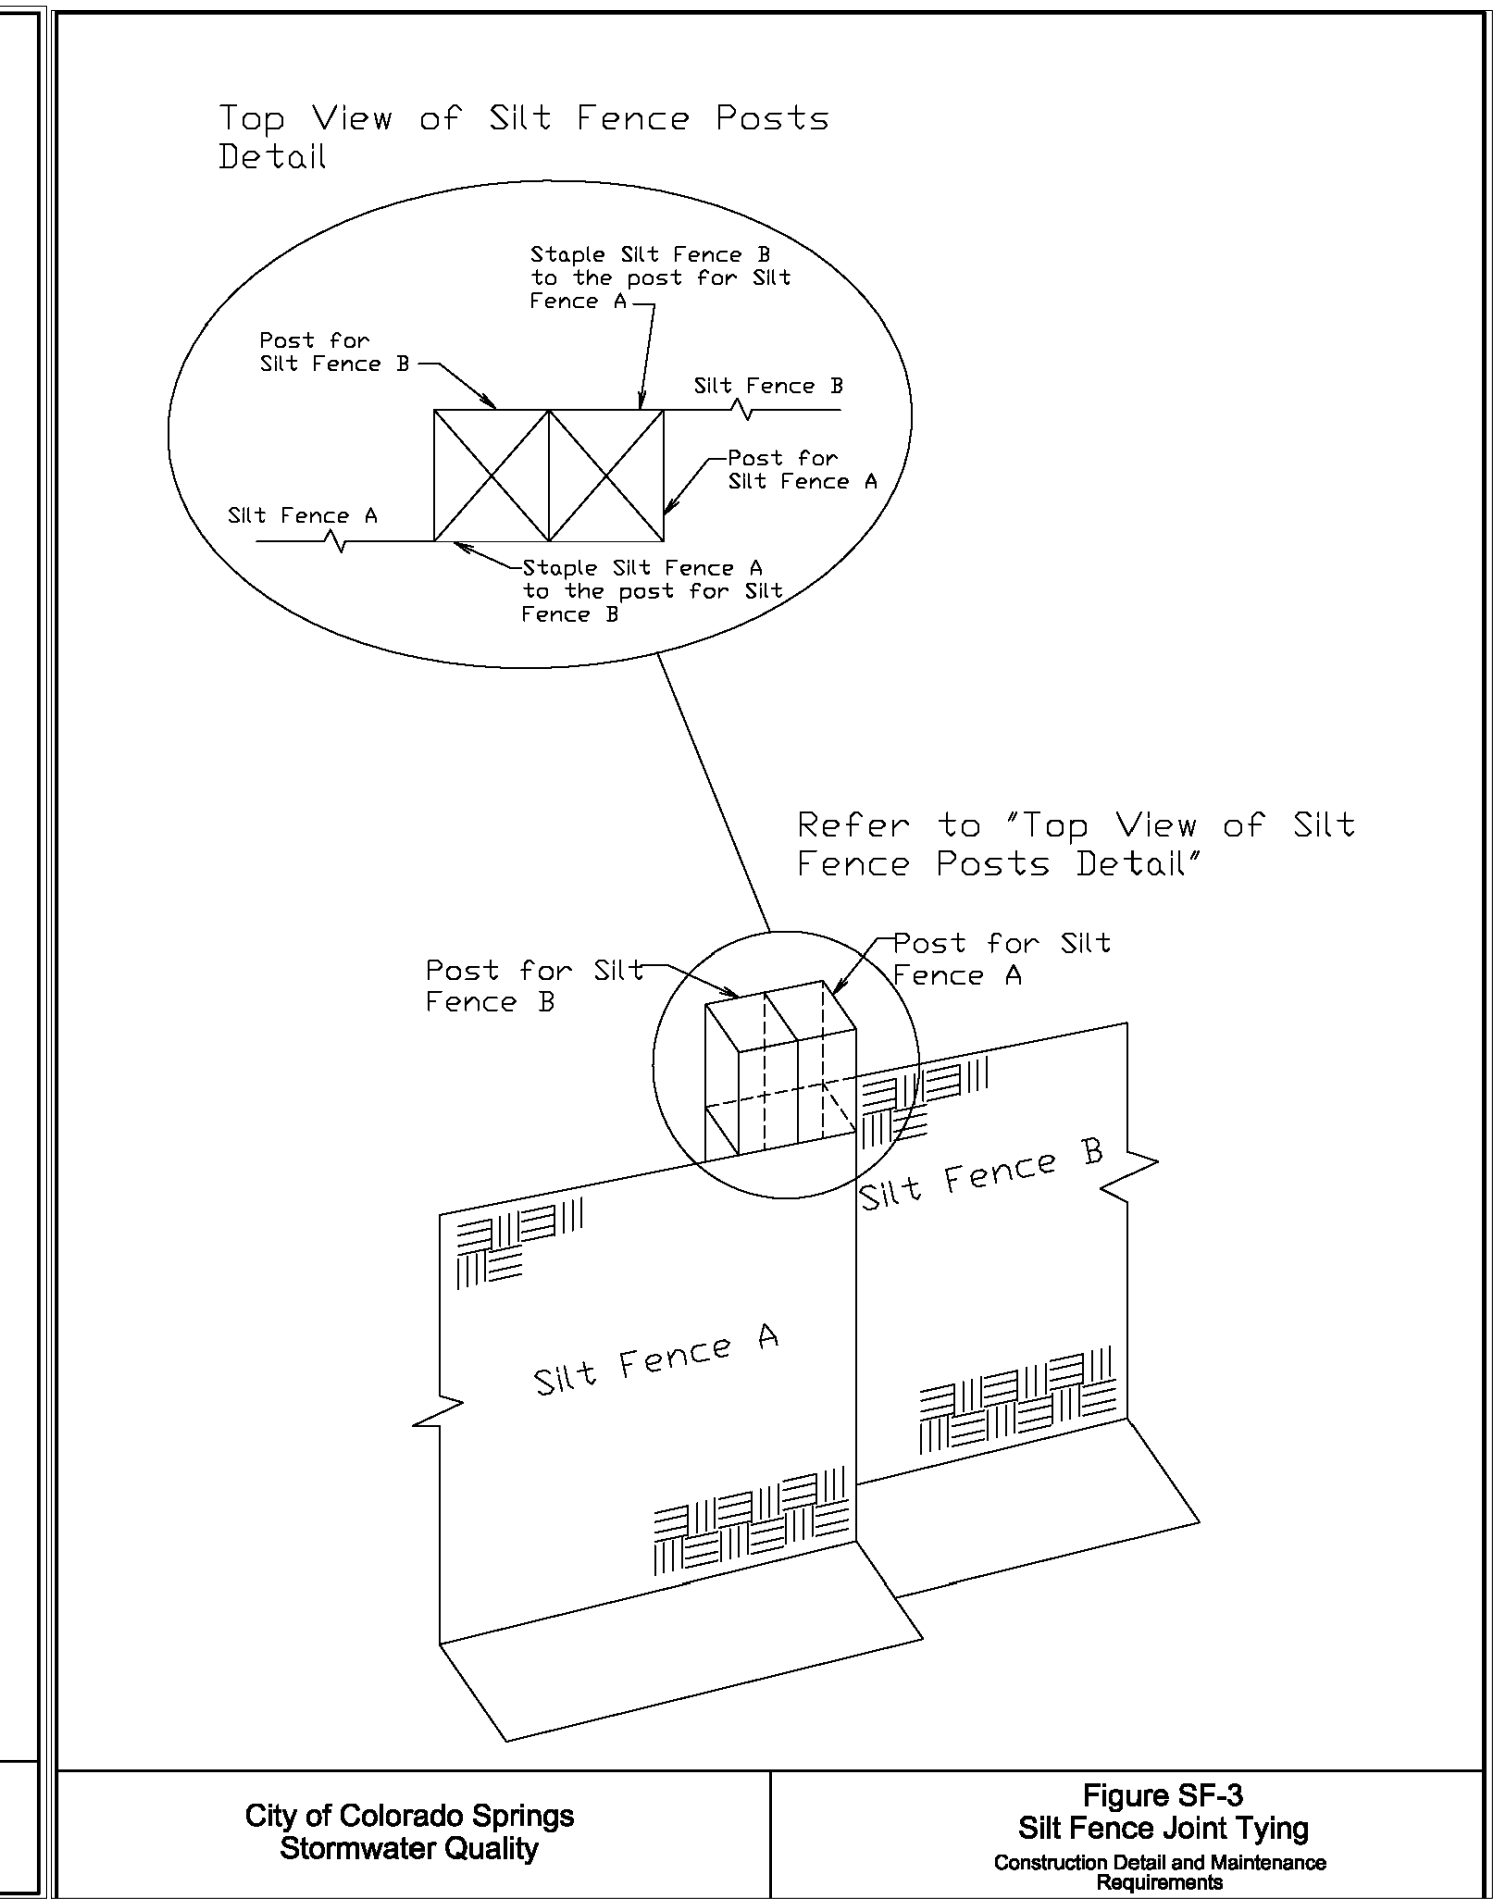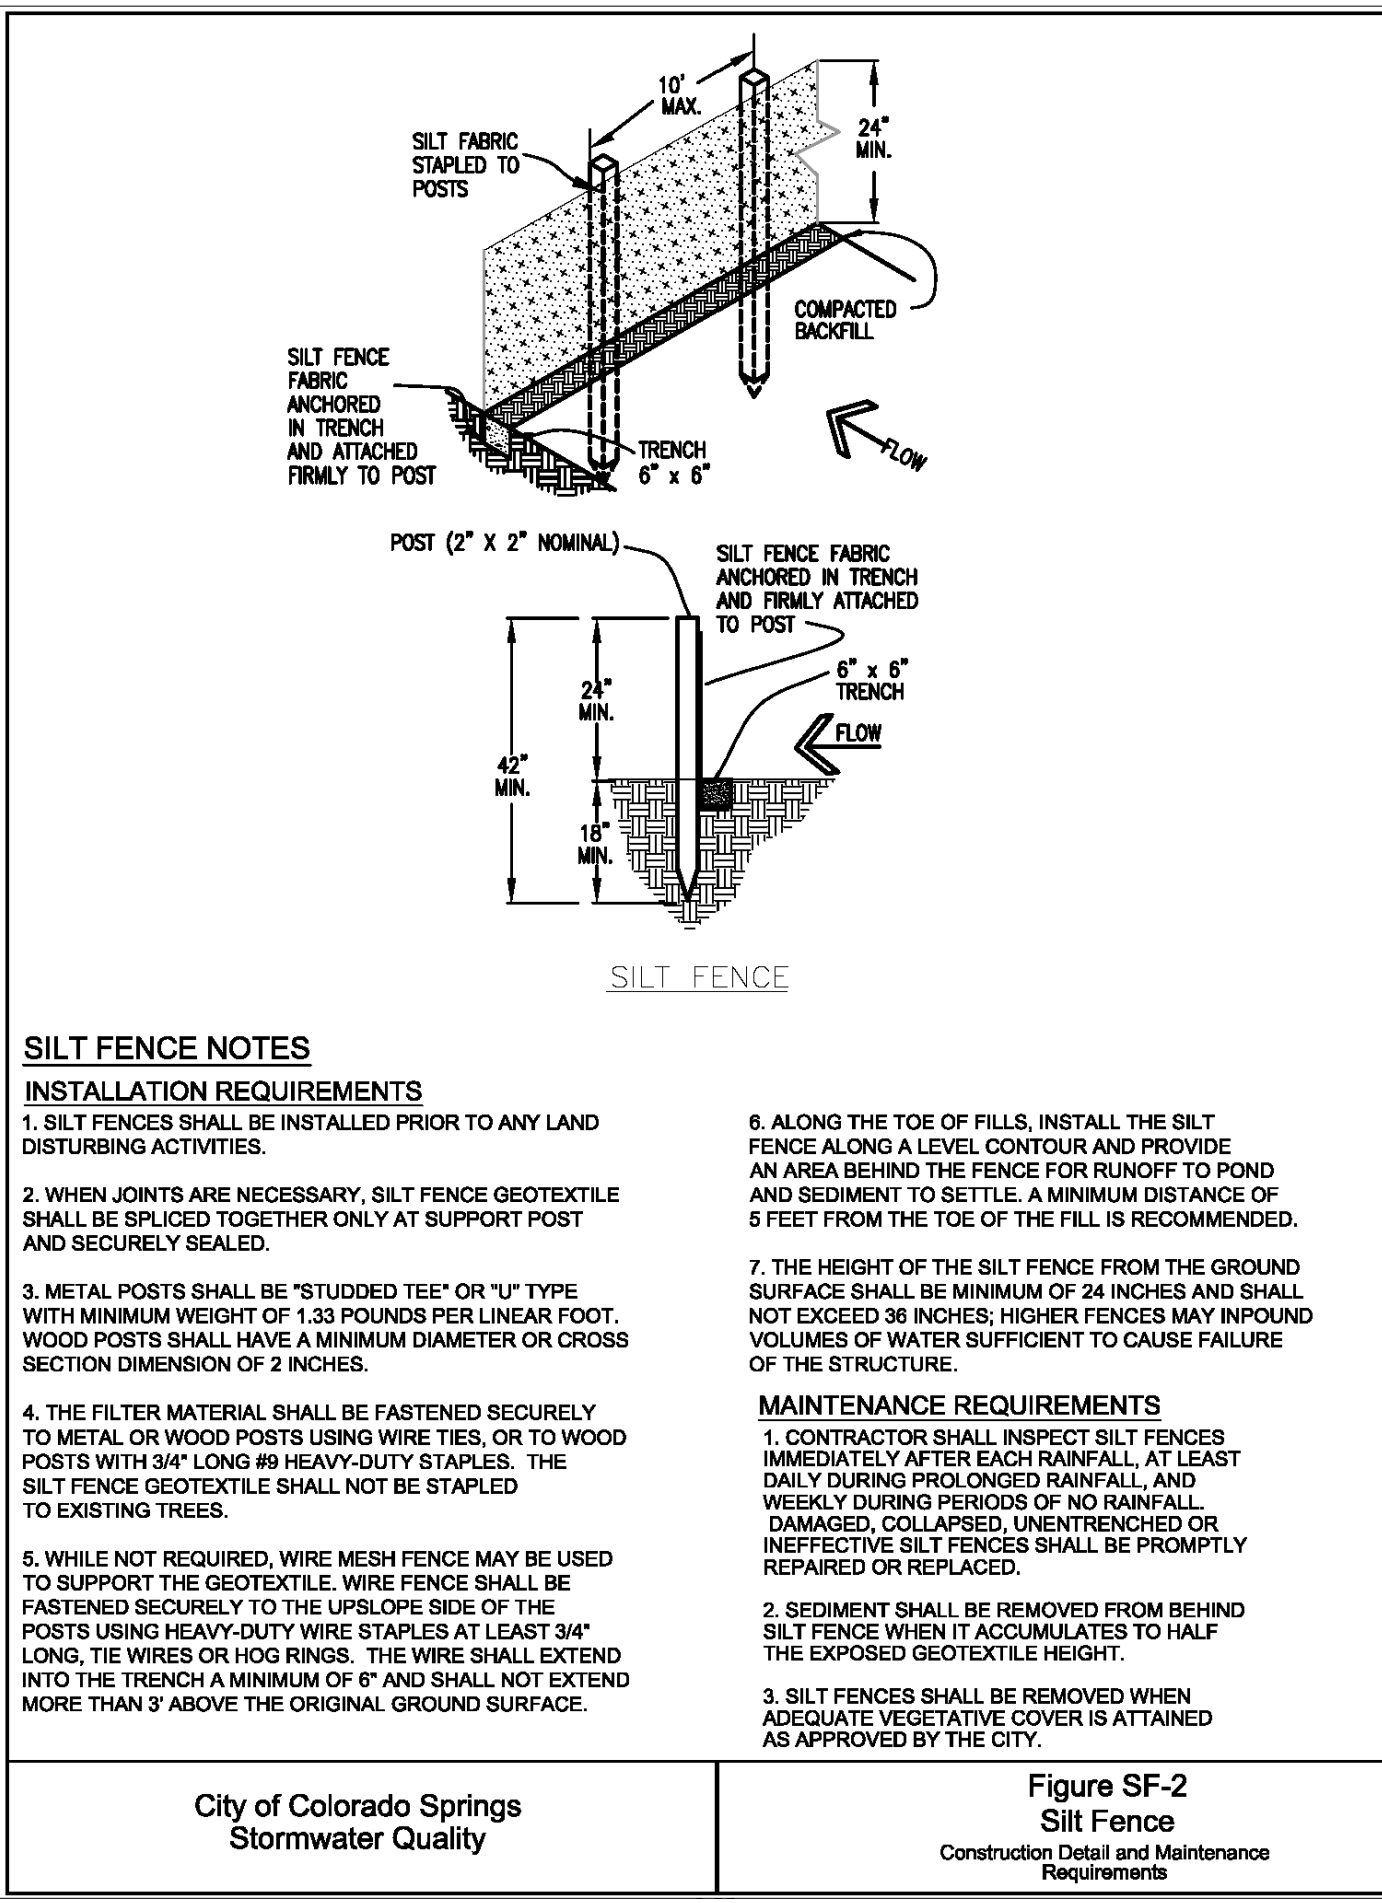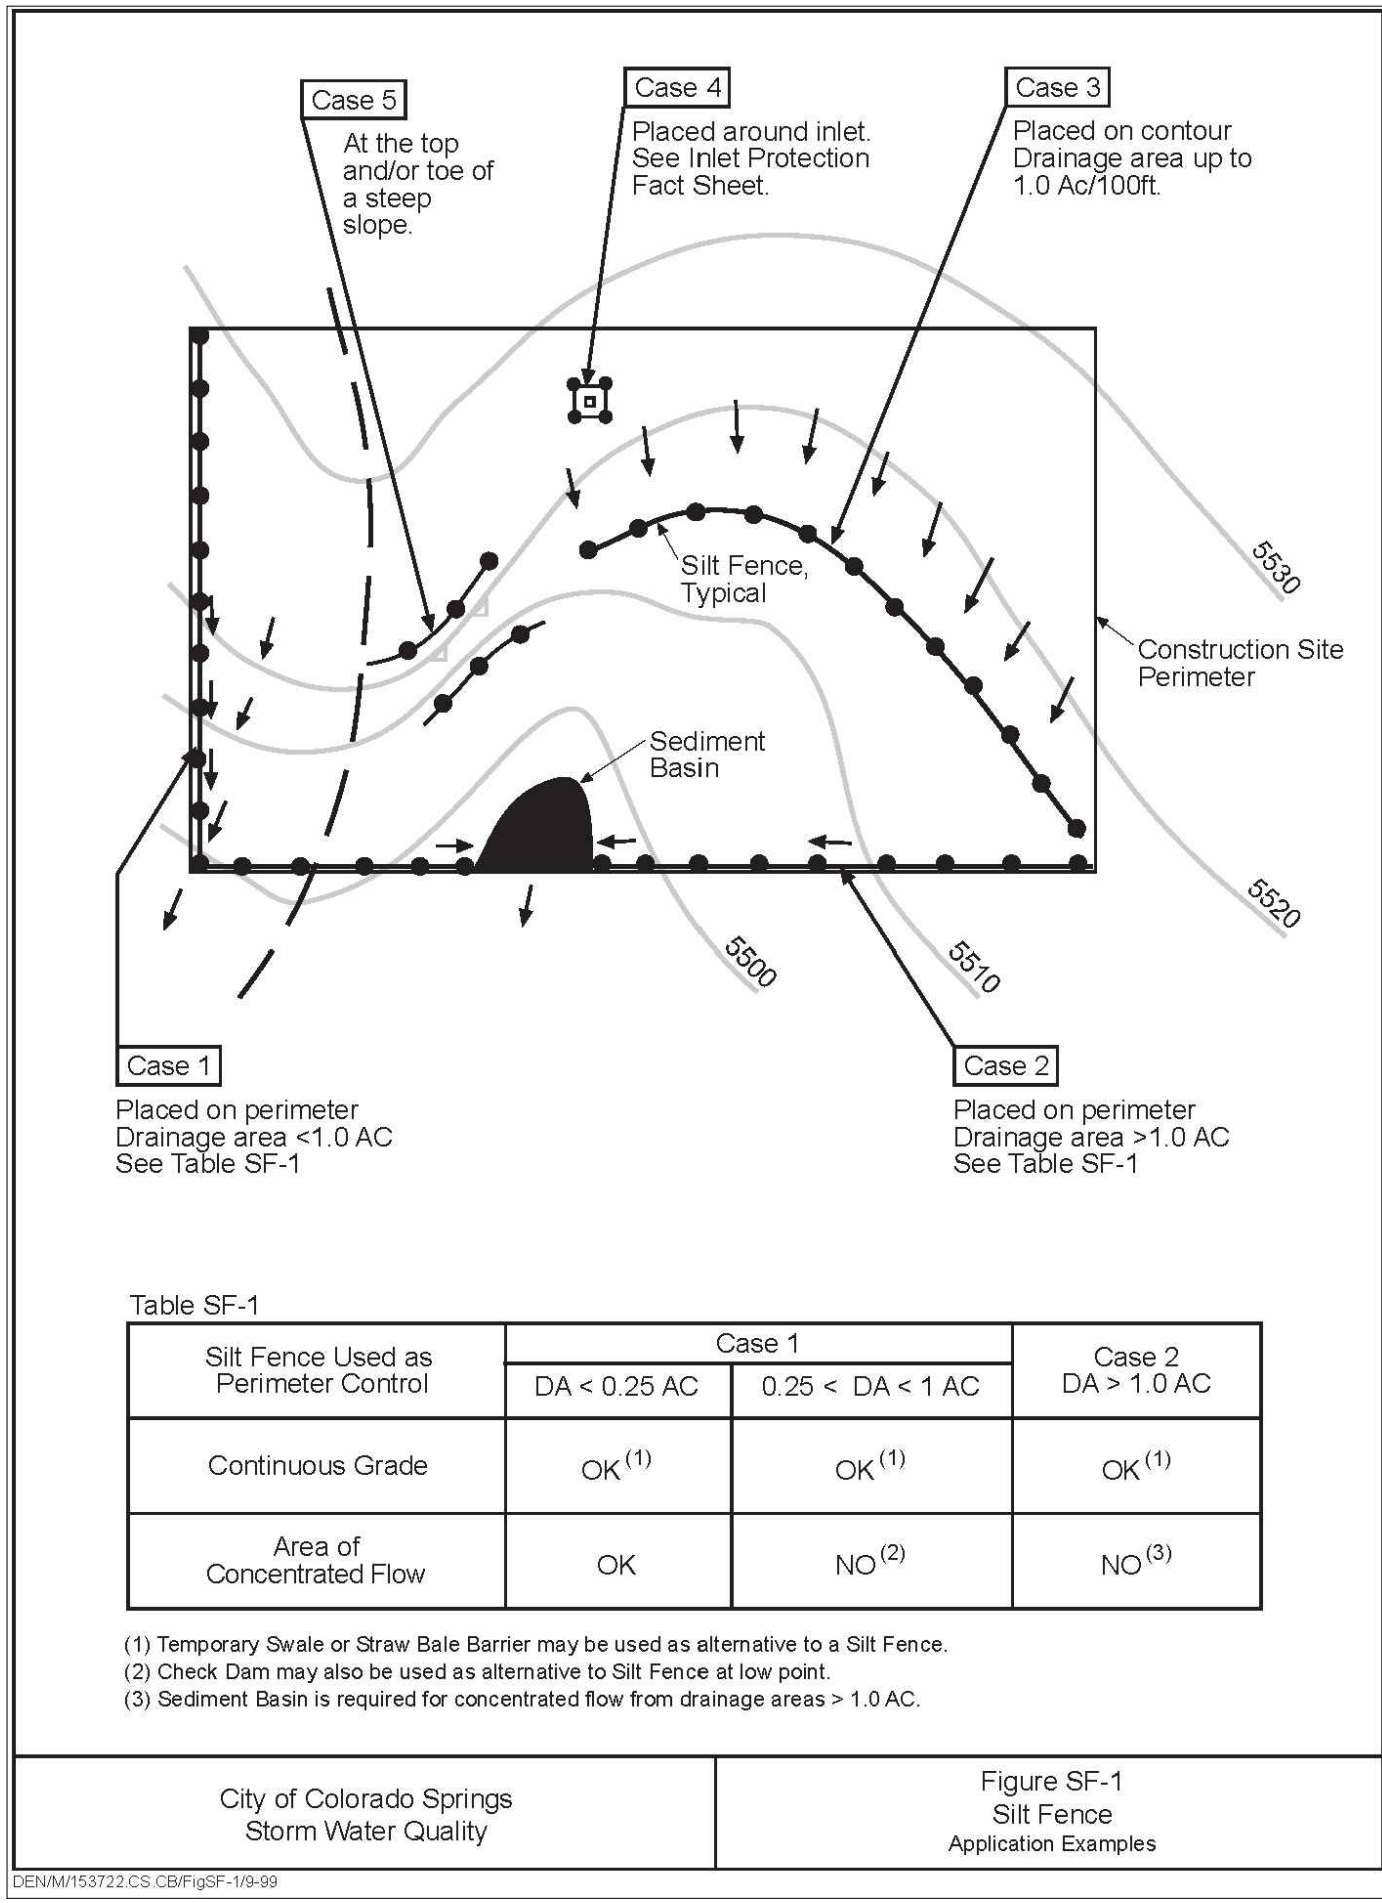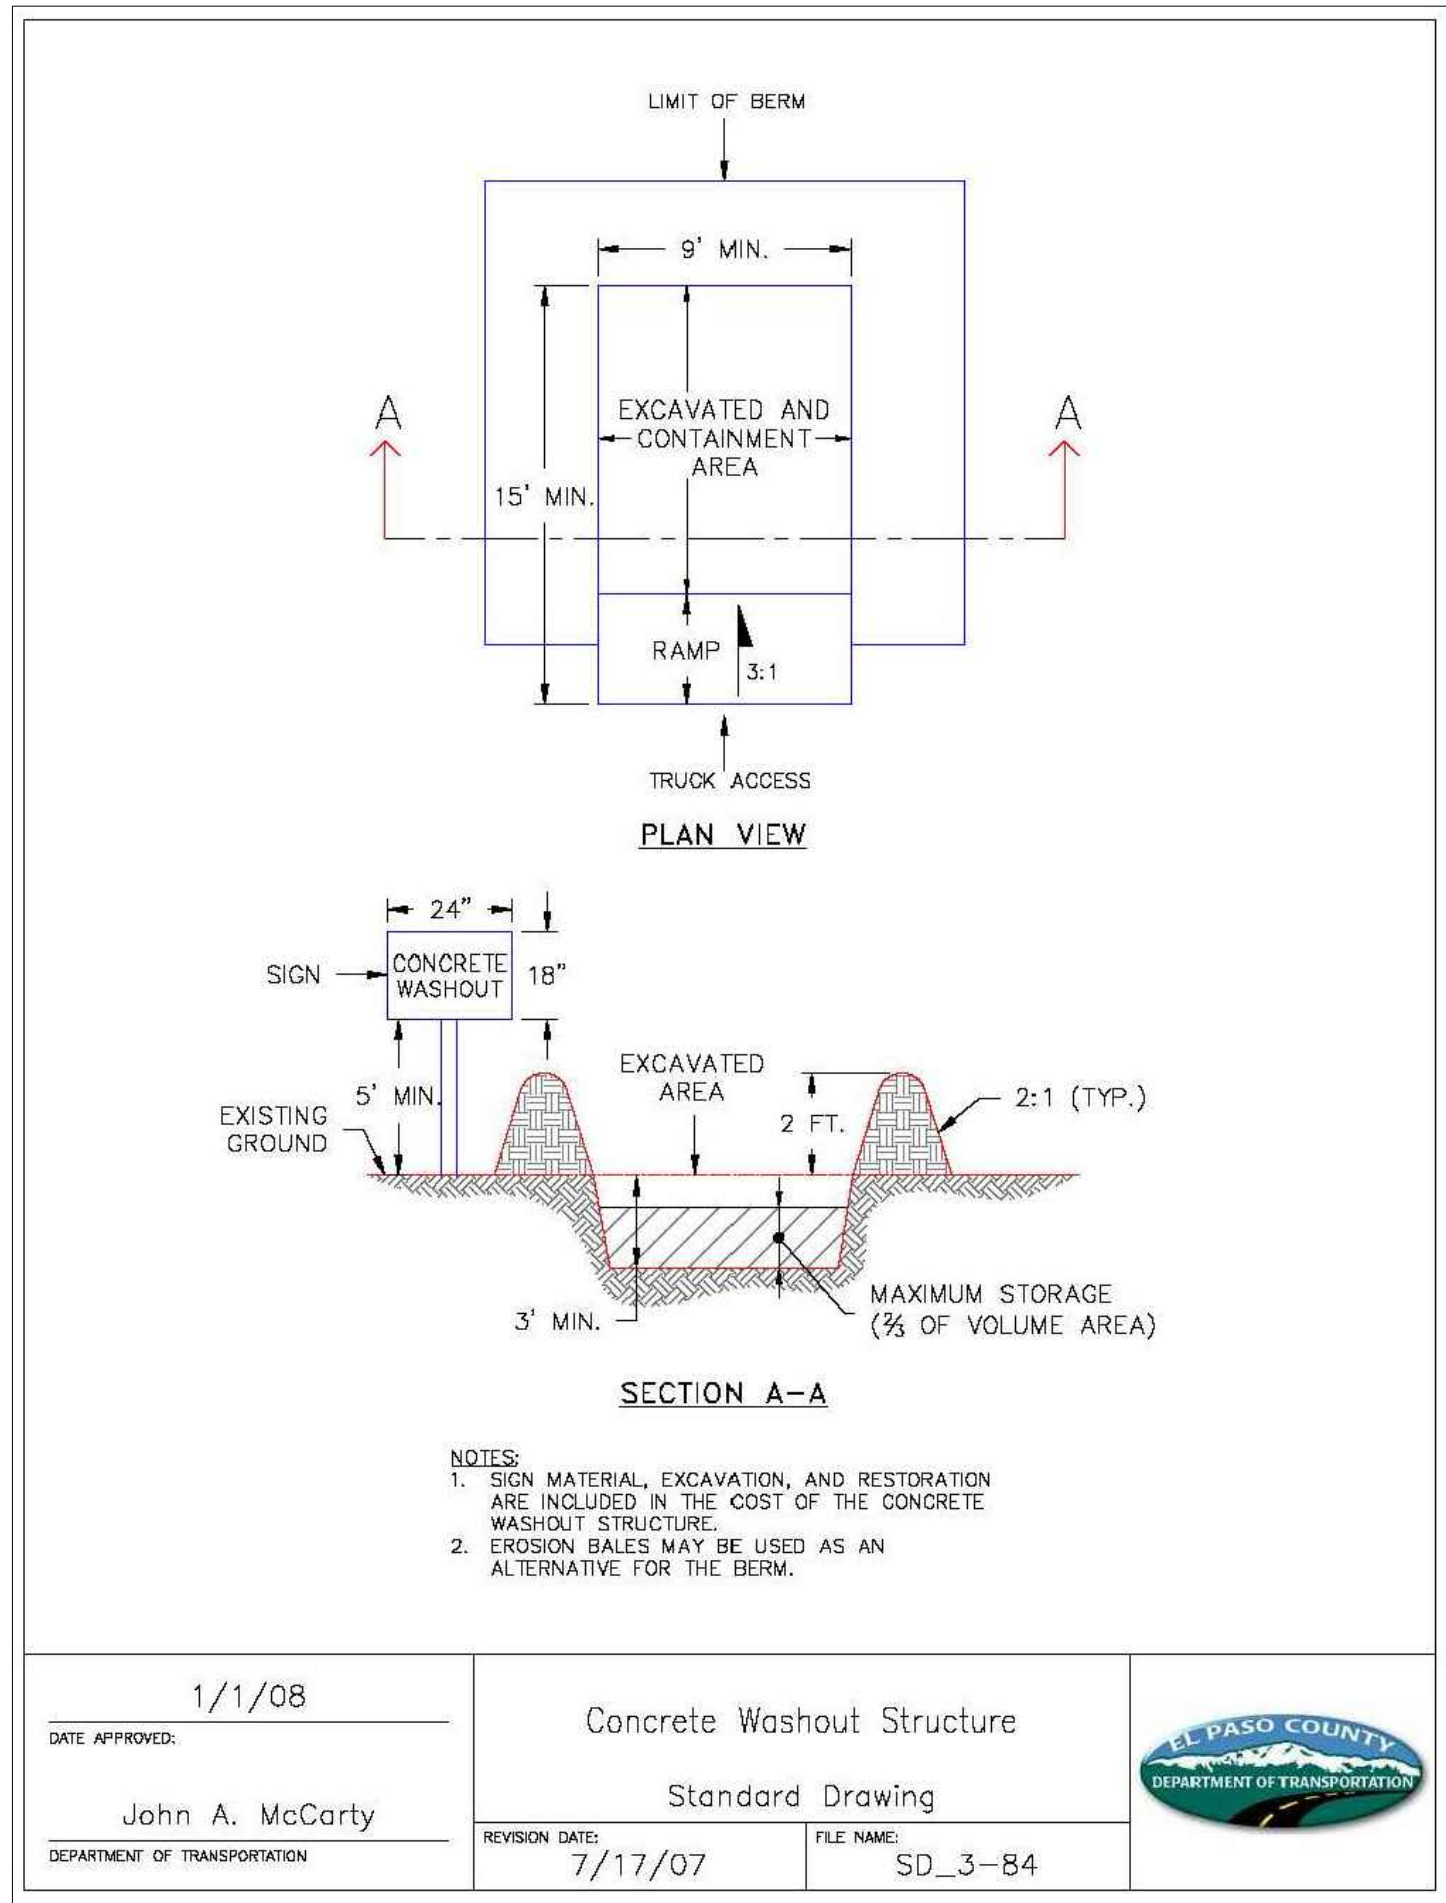

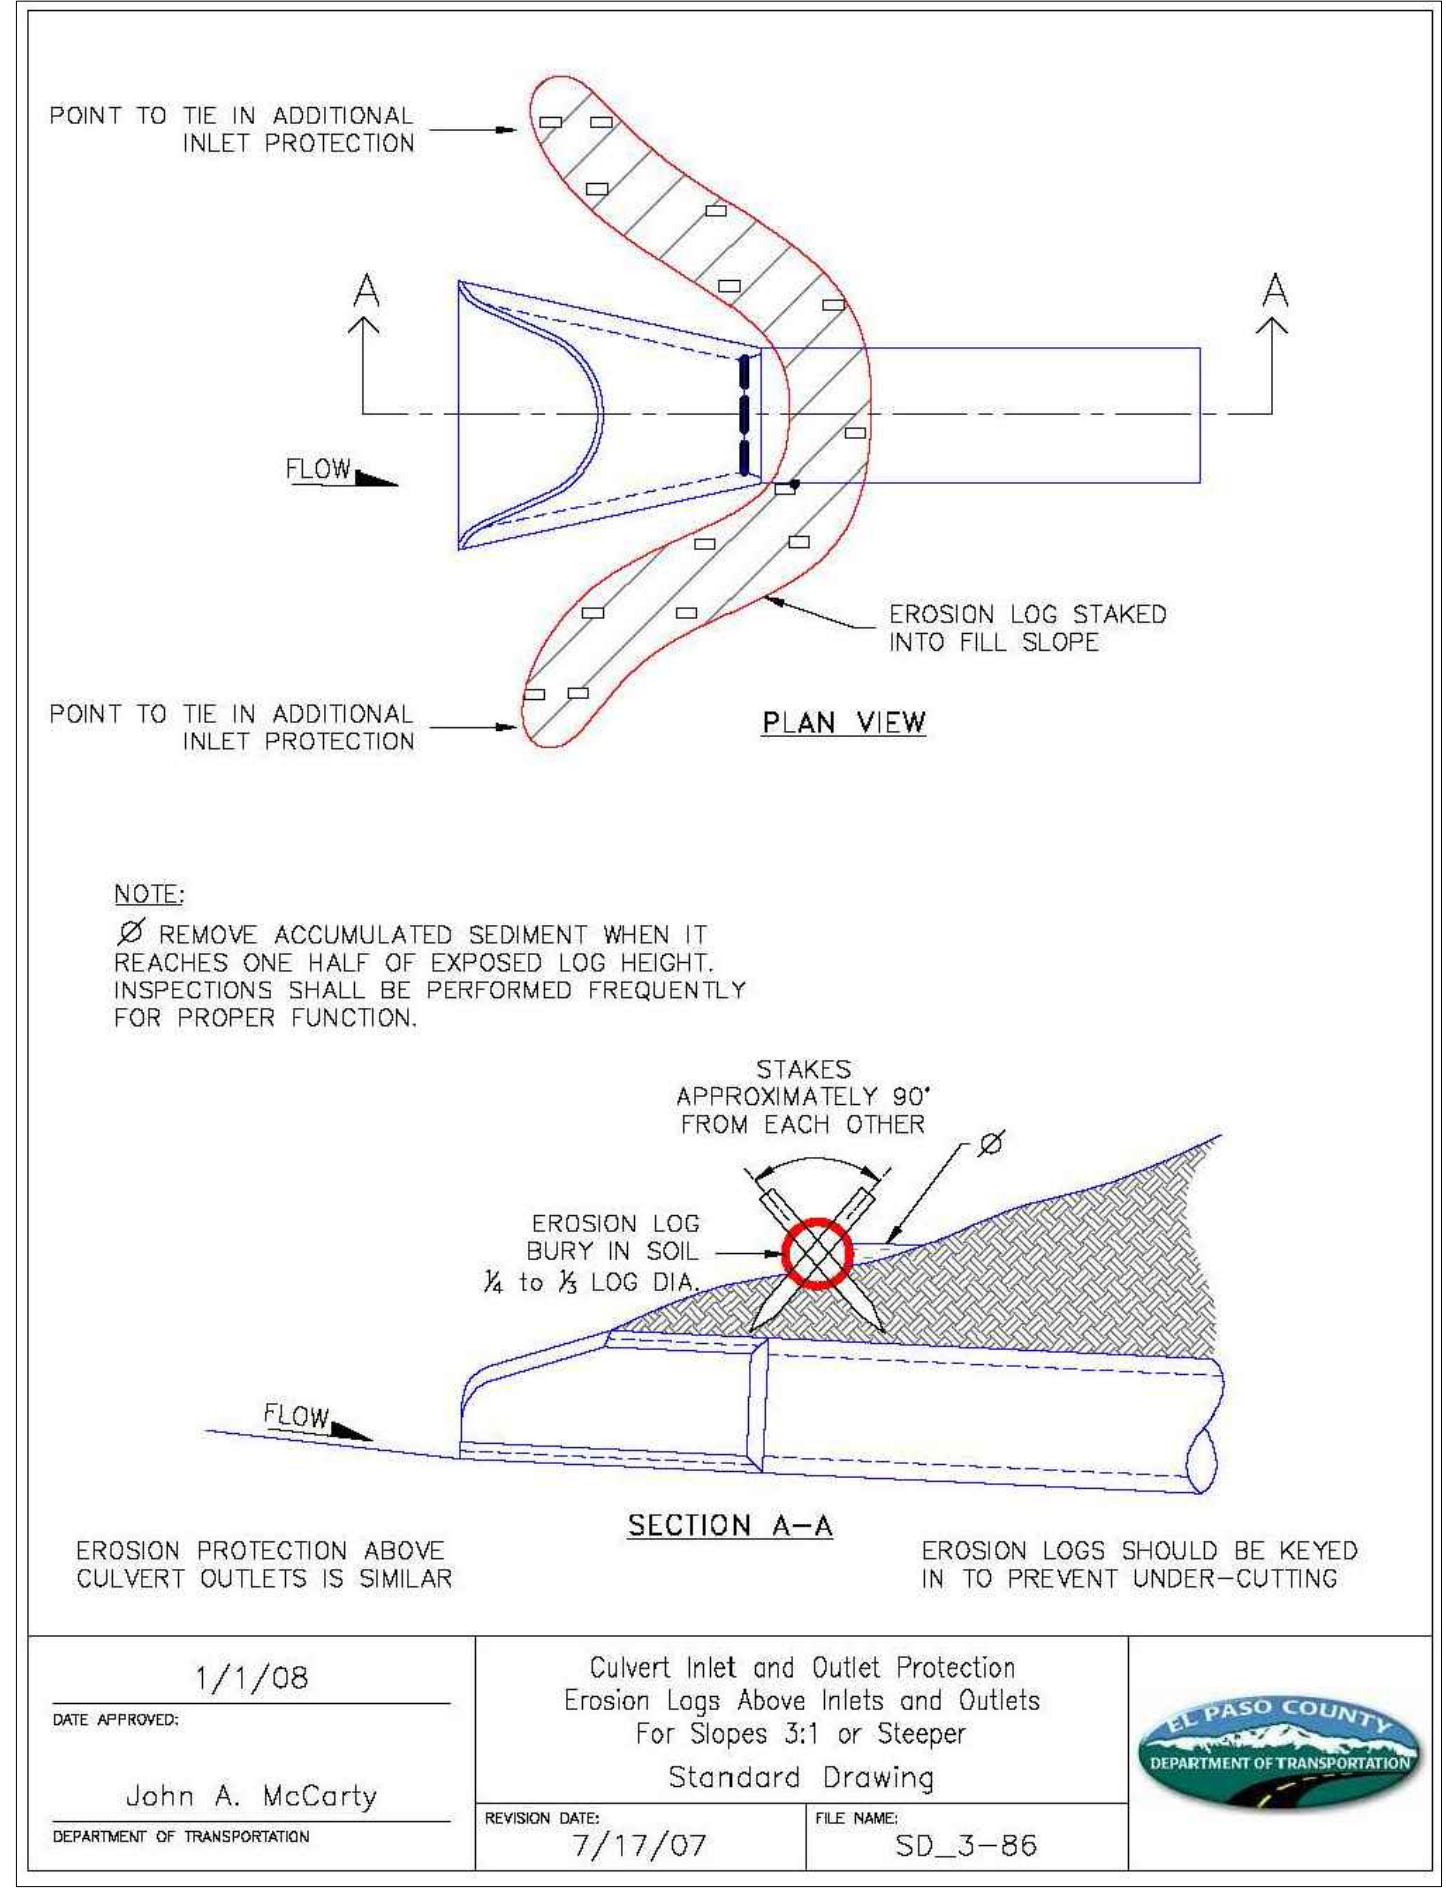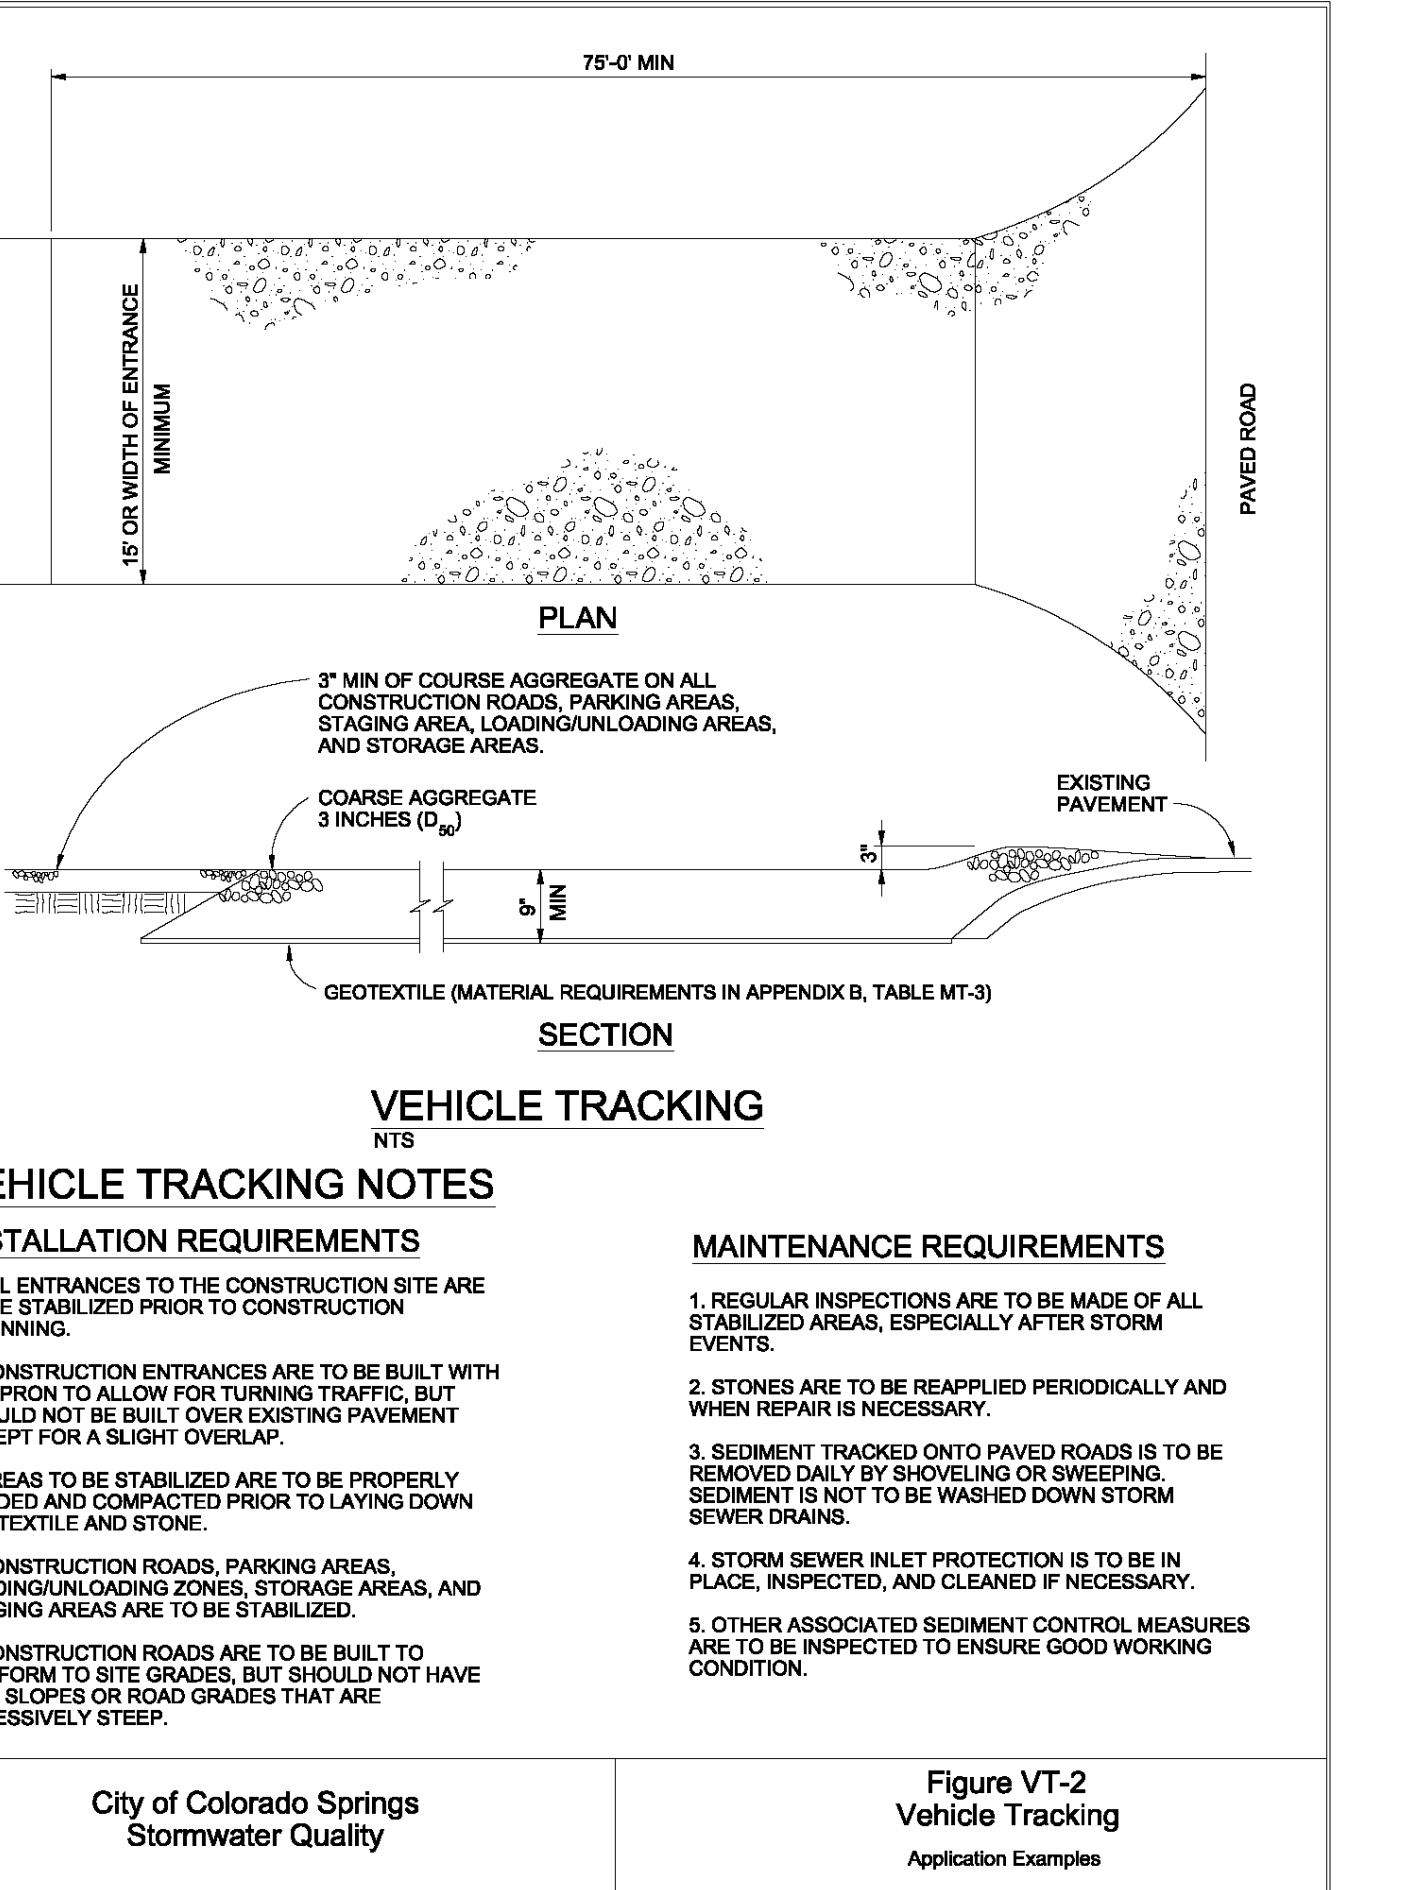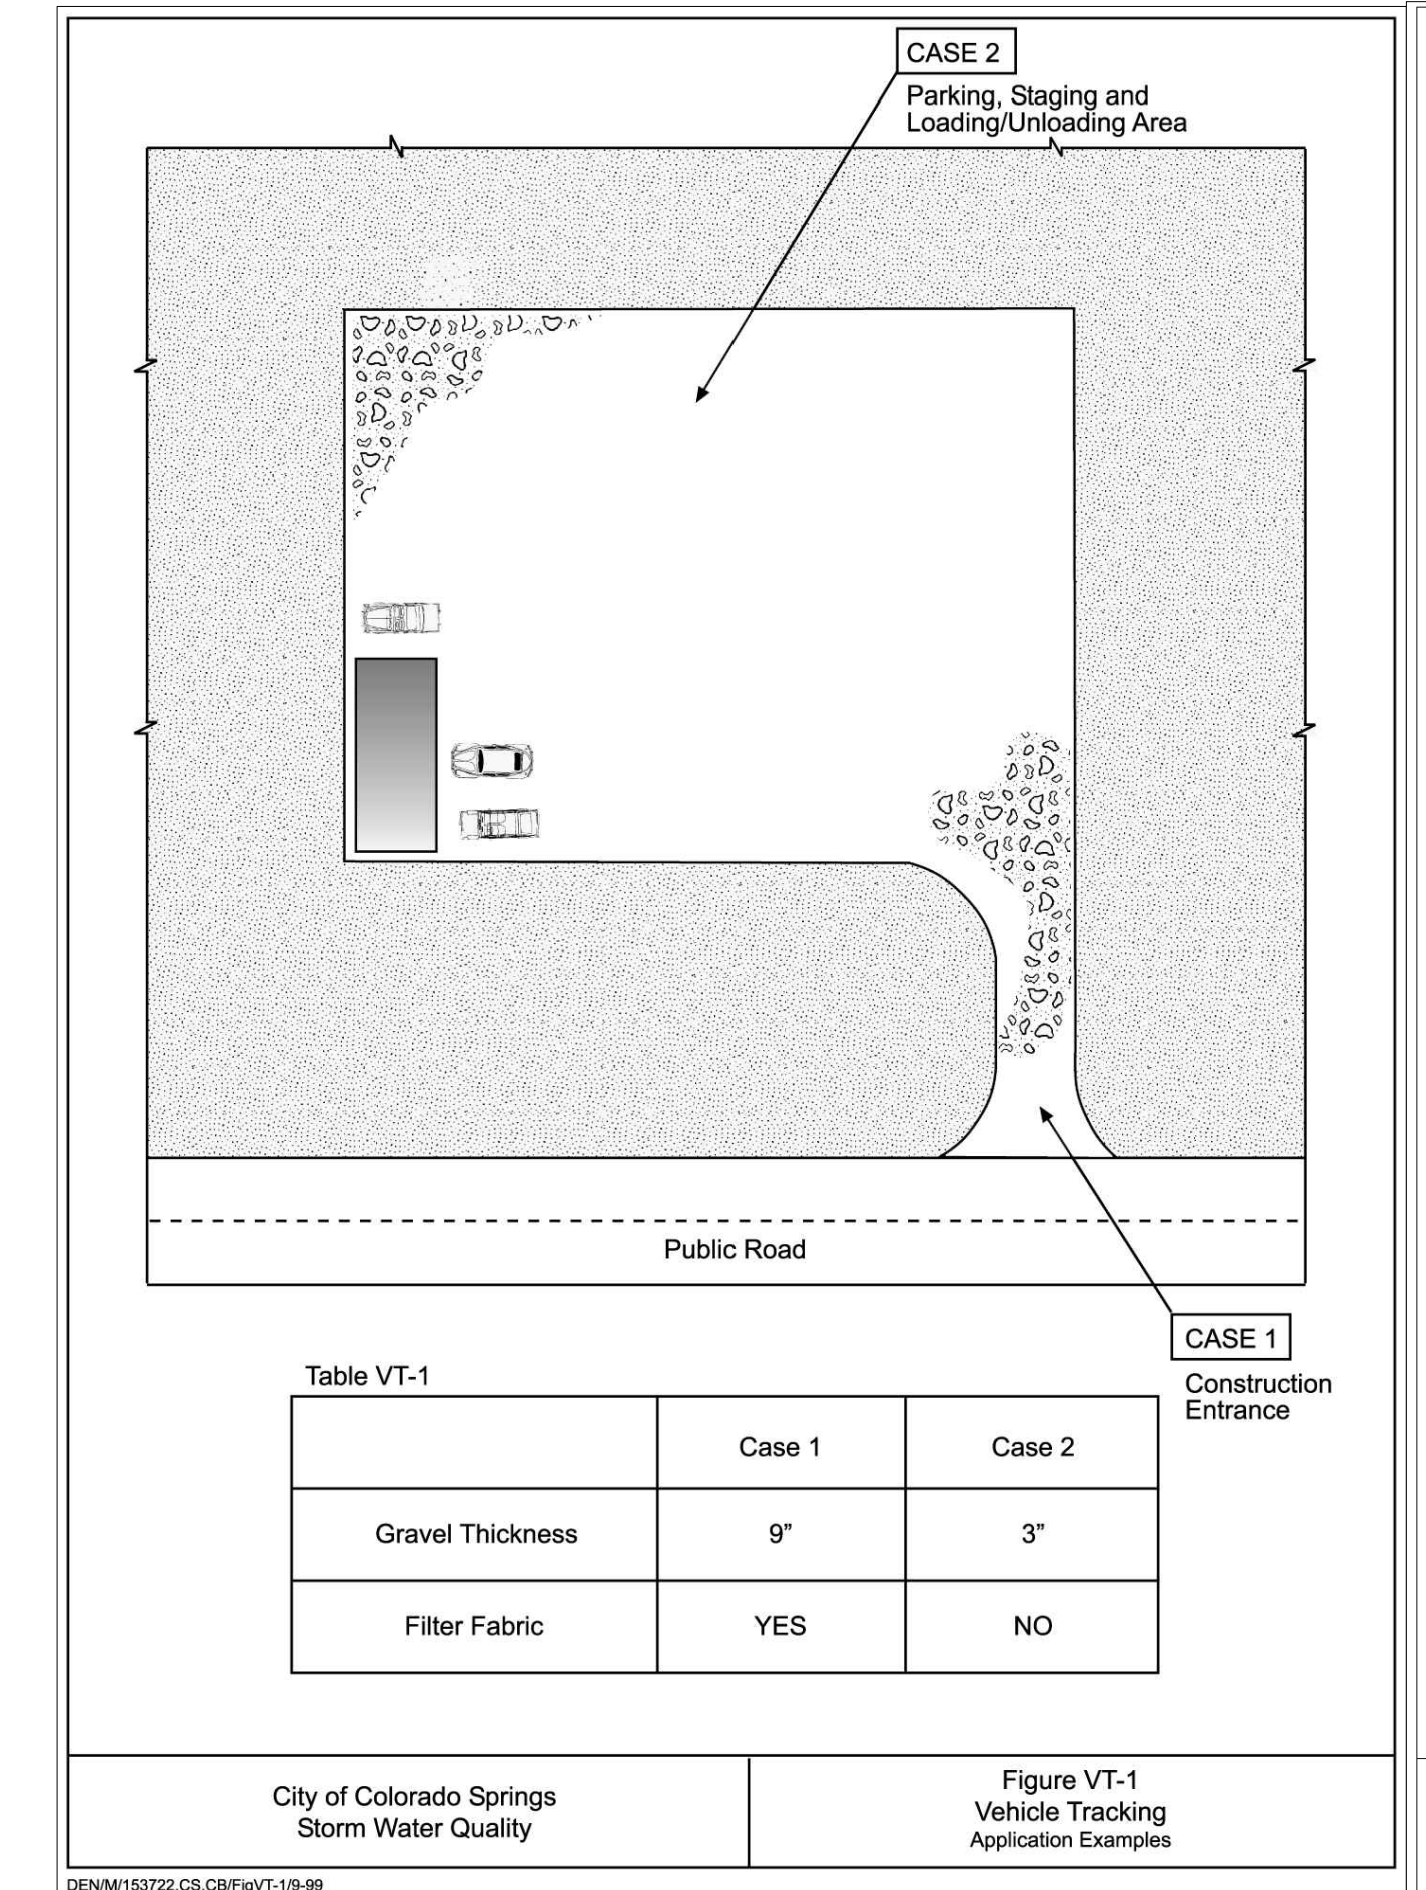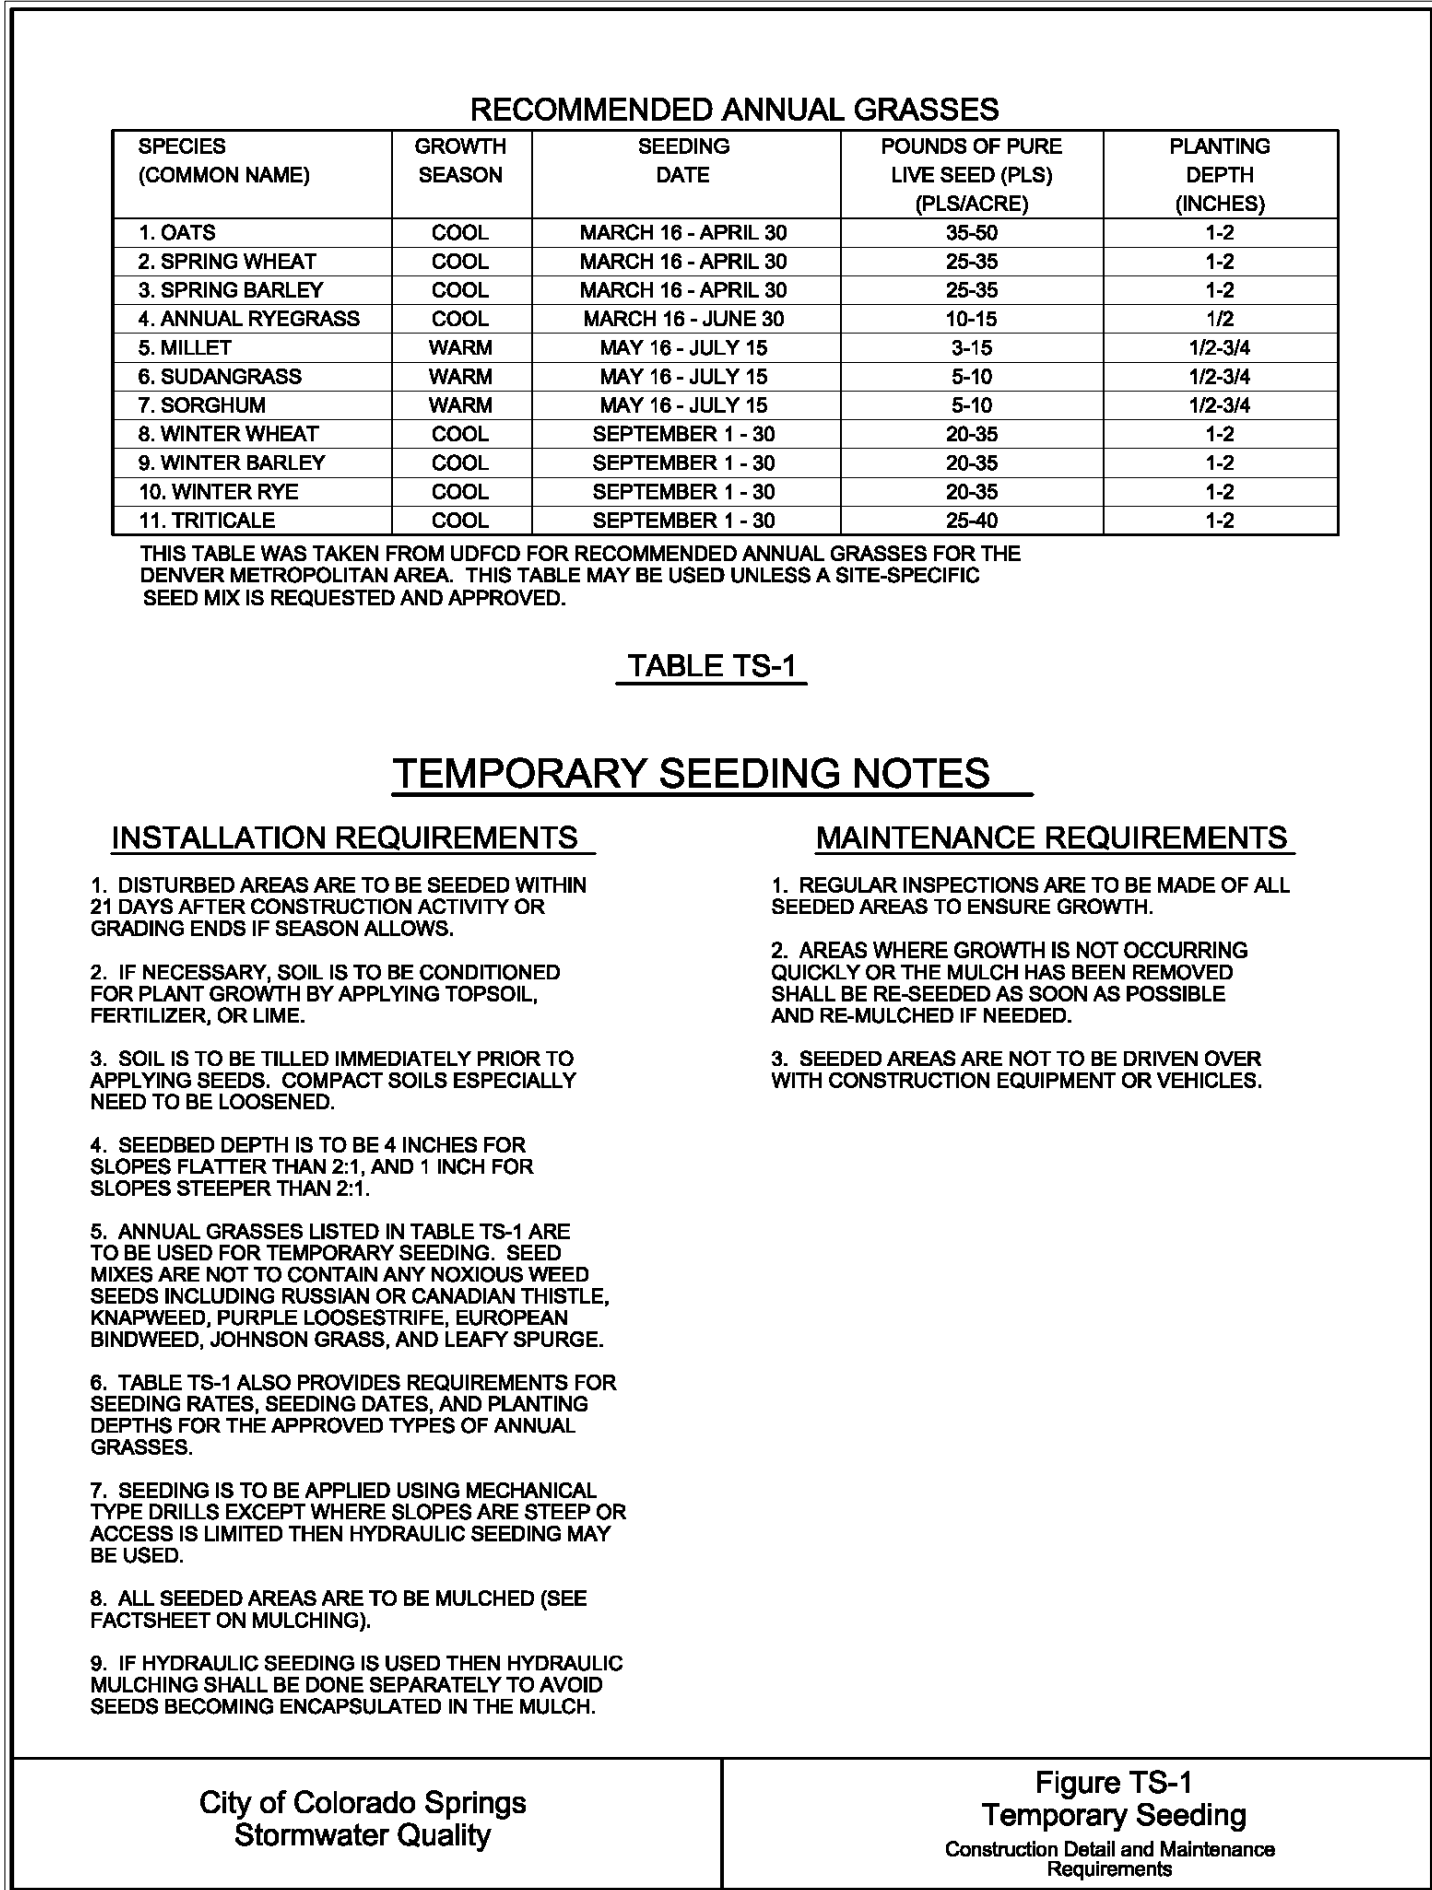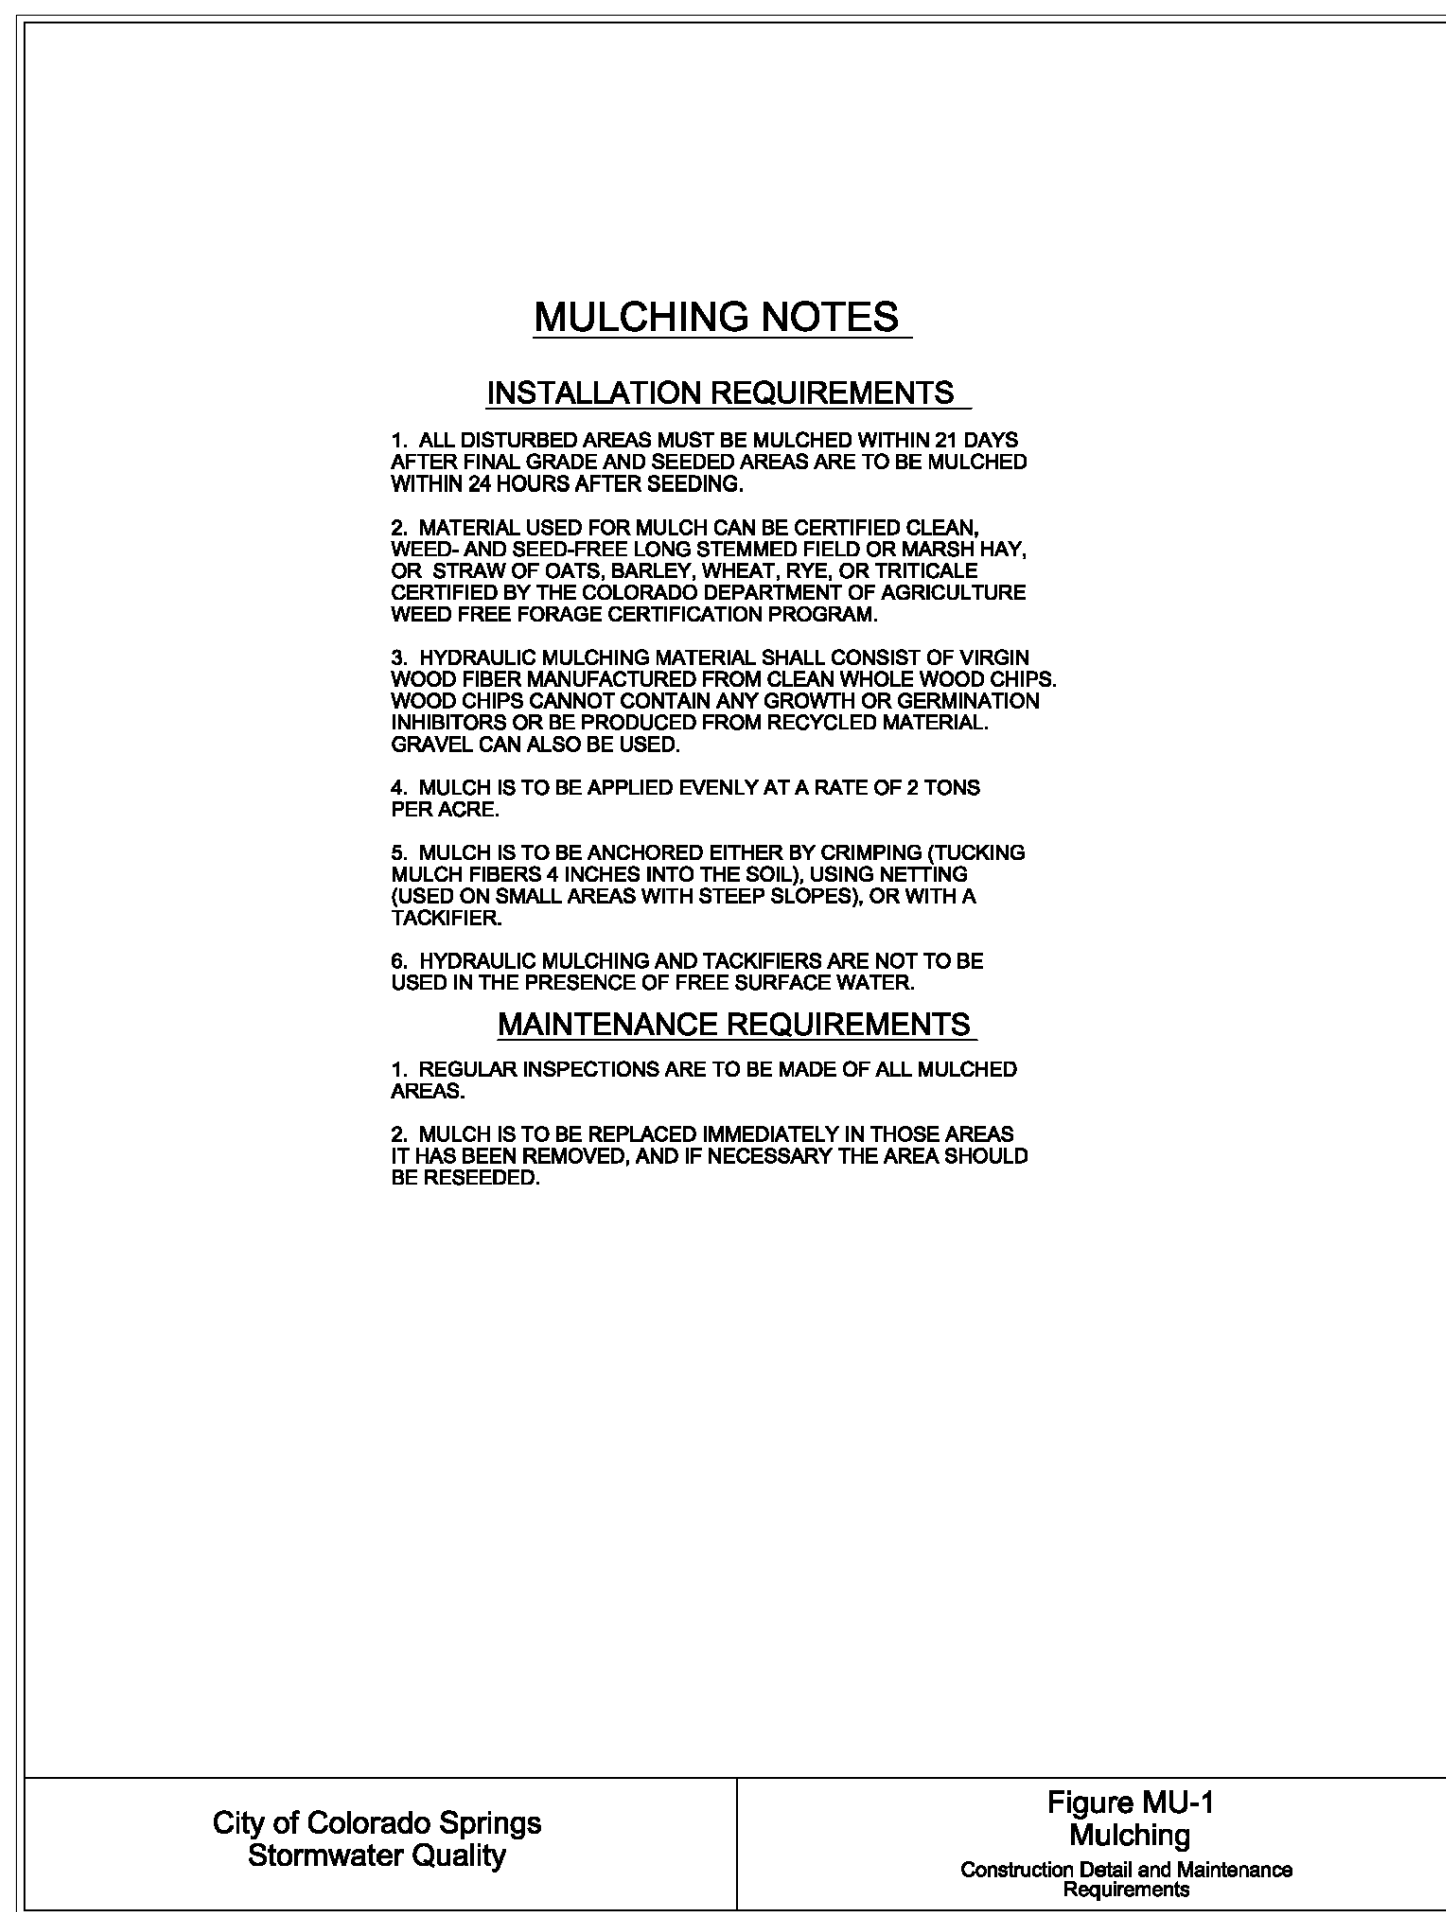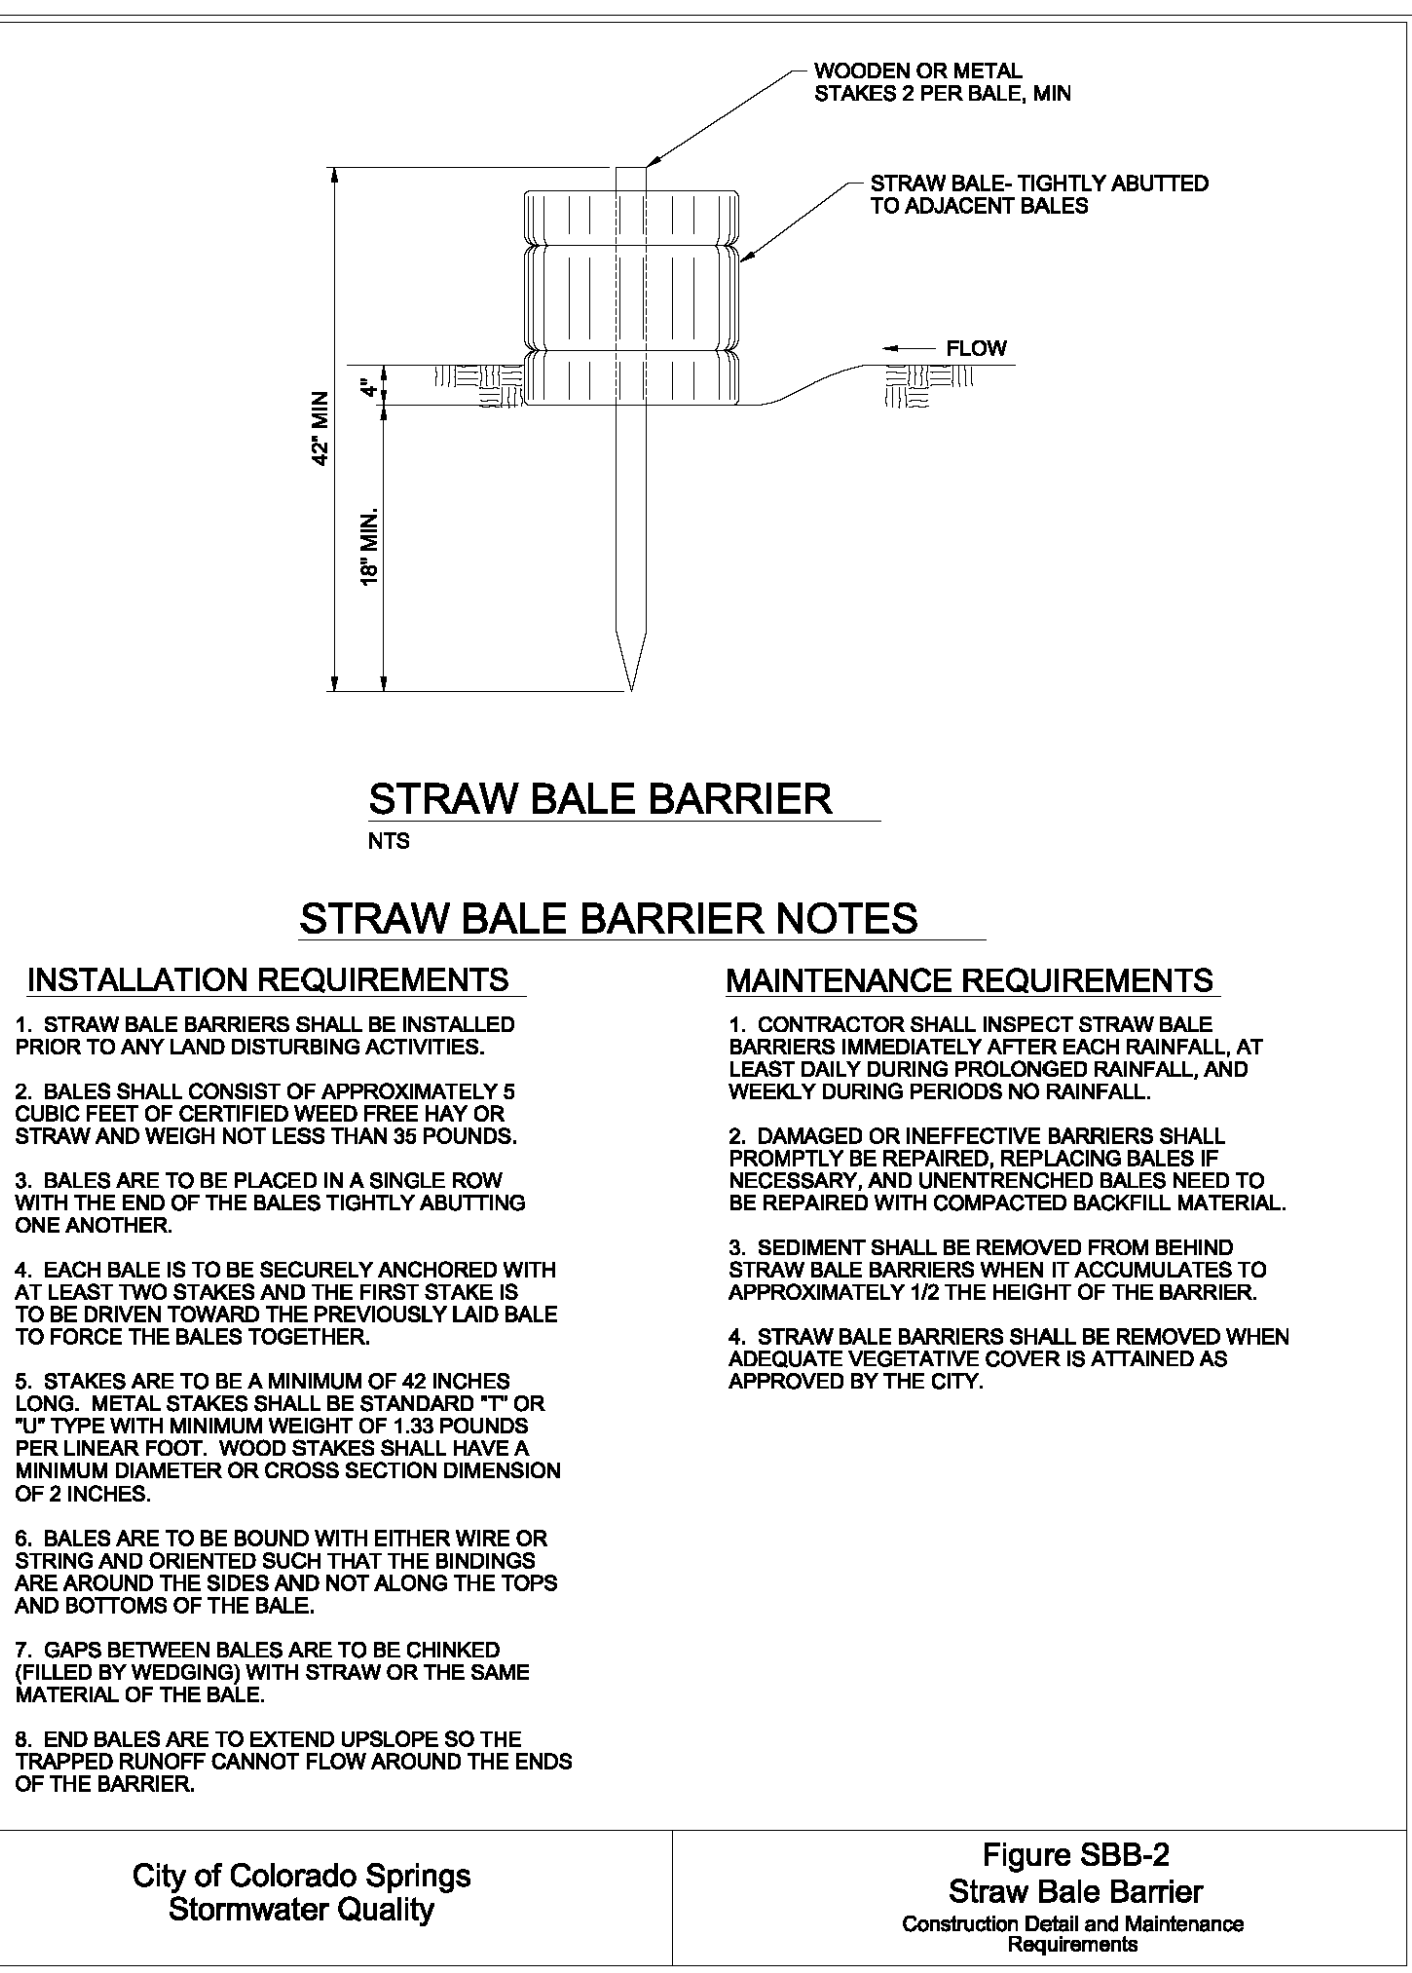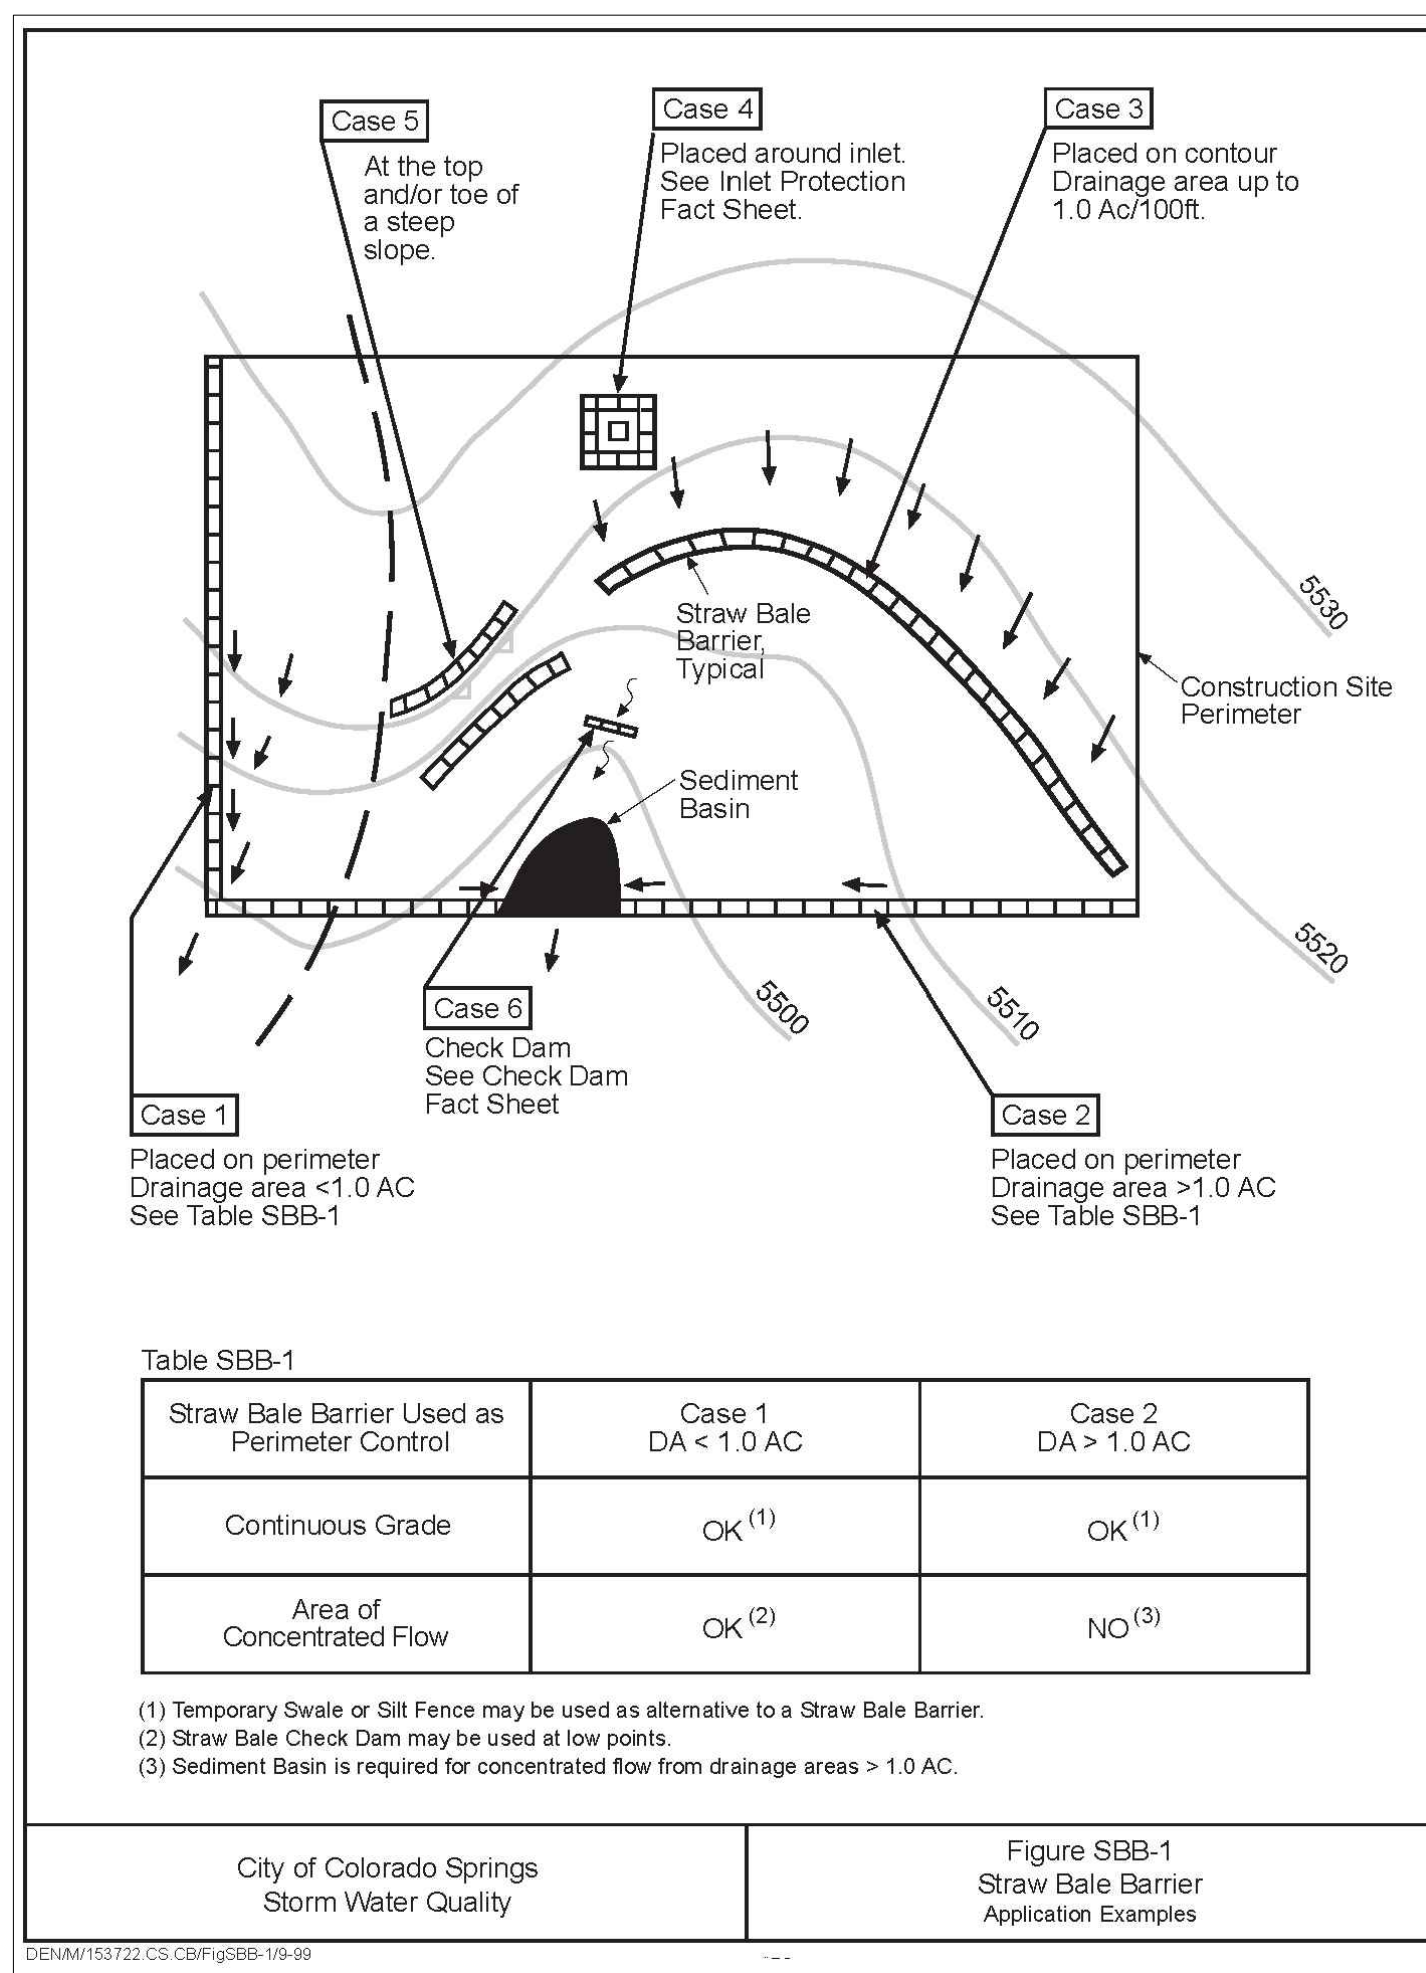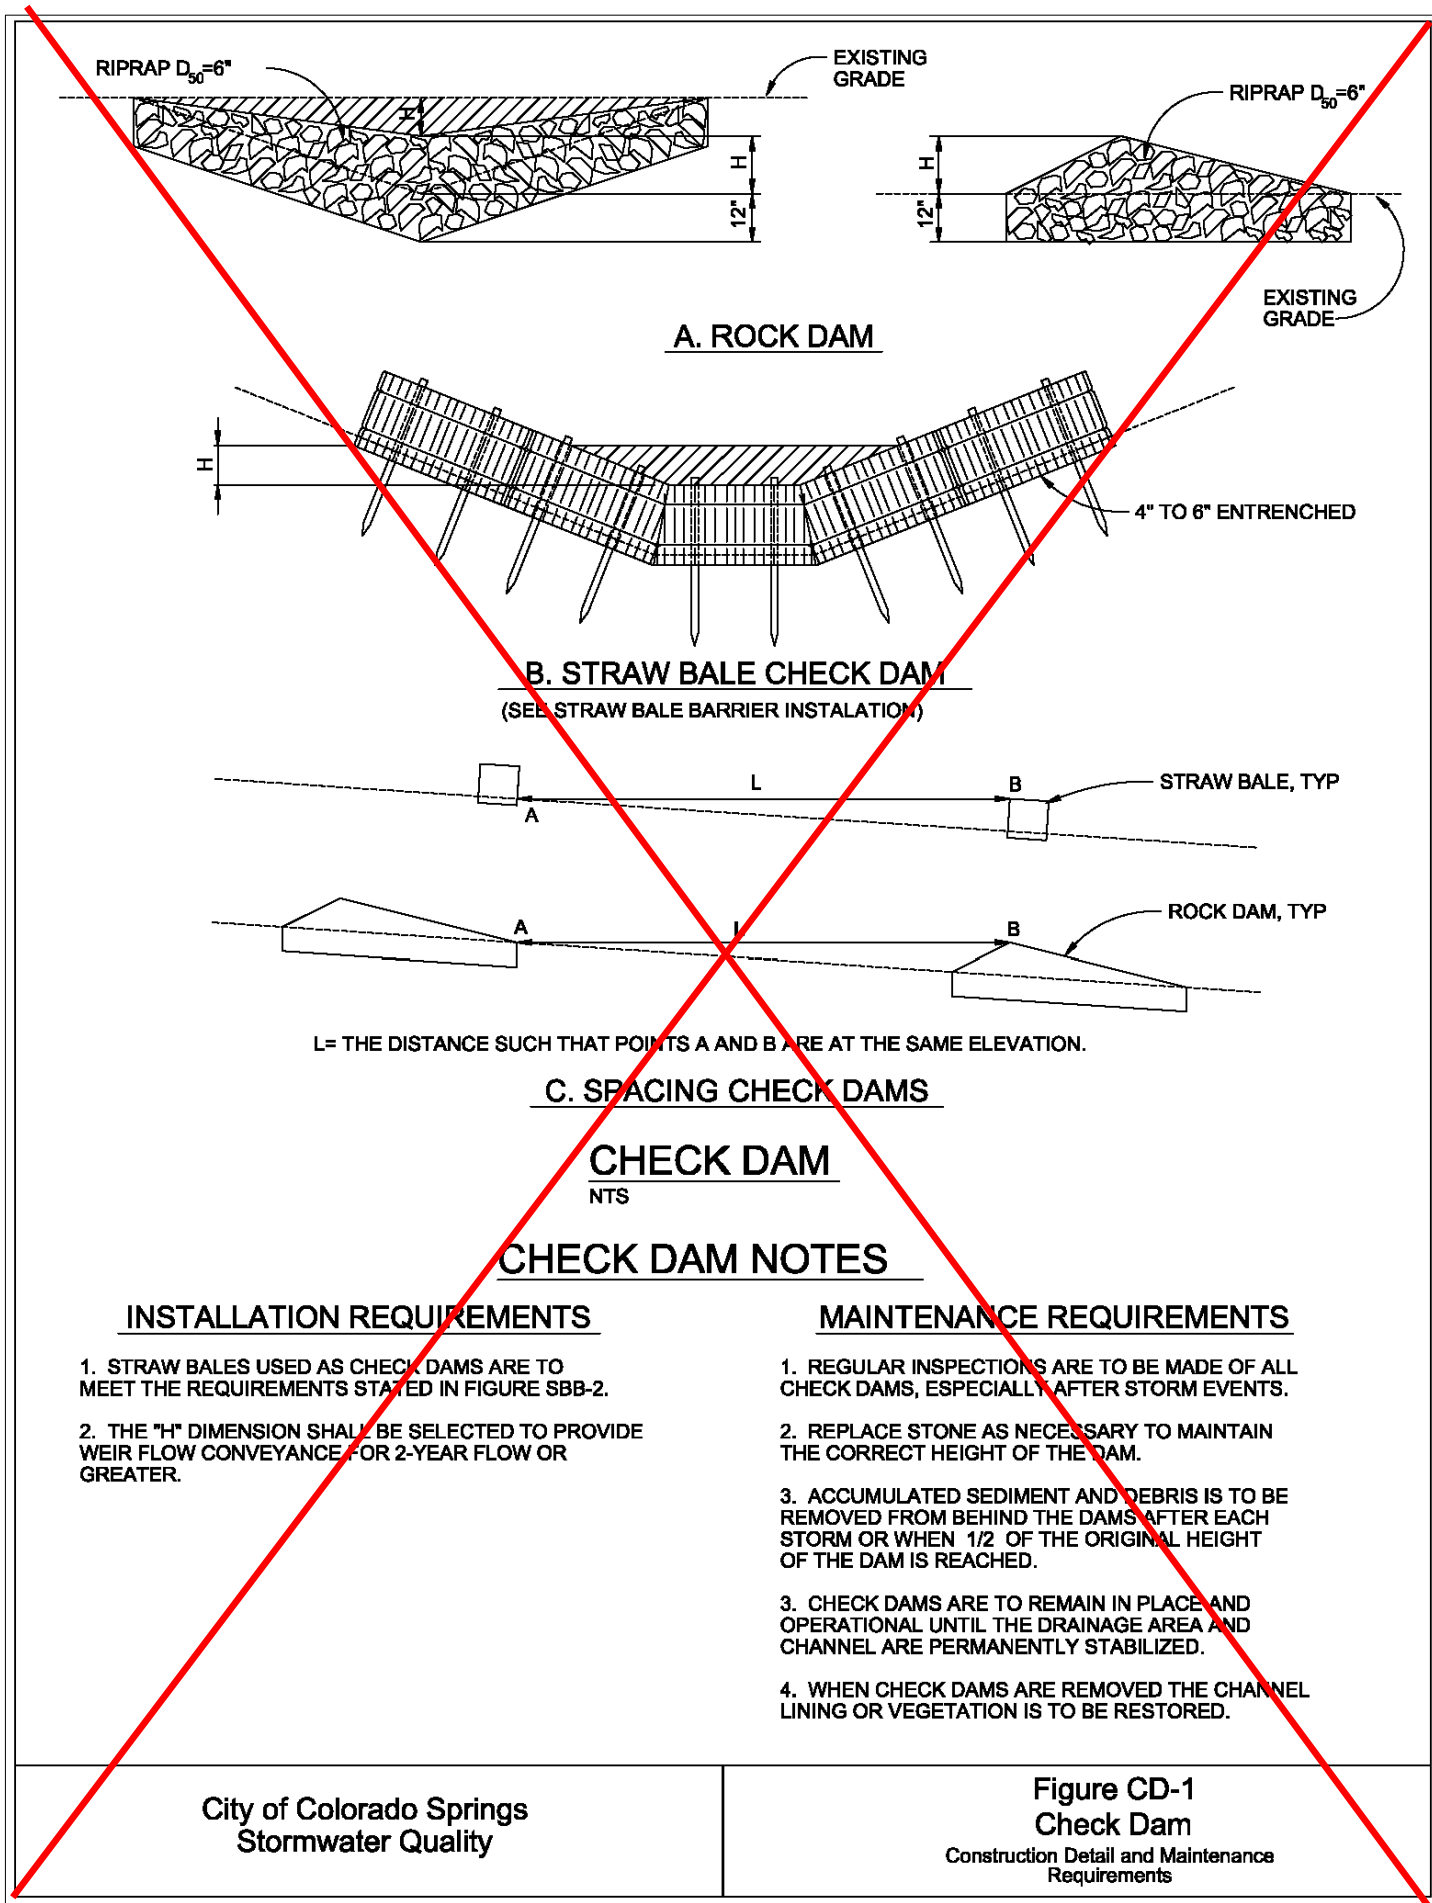

811
Know what's below.
Call before you dig.

THE LOCATIONS OF EXISTING UNDERGROUND UTILITIES ARE SHOWN IN AN APPROXIMATE WAY ONLY AND HAVE NOT BEEN INDEPENDENTLY VERIFIED BY THE OWNER OR ITS REPRESENTATIVE. THE CONTRACTOR SHALL DETERMINE THE EXACT LOCATION OF ALL EXISTING UTILITIES BEFORE COMMENCING WORK, AND AGREES TO BE FULLY RESPONSIBLE FOR ANY AND ALL DAMAGES WHICH MIGHT BE OCCASIONED BY THE CONTRACTOR'S FAILURE TO EXACTLY LOCATE AND PRESERVE ANY AND ALL UNDERGROUND UTILITIES.

NOTICE:
CONSTRUCTION SITE SAFETY IS THE SOLE RESPONSIBILITY OF THE CONTRACTOR. NEITHER THE OWNER NOR THE ENGINEER SHALL BE EXPECTED TO ASSUME ANY RESPONSIBILITY FOR SAFETY OF THE WORK OF PERSONS ENGAGED IN THE WORK, OF ANY NEARBY STRUCTURES, OR OF ANY OTHER PERSONS.

COPYRIGHT © 2021 ATWELL LLC. NO REPRODUCTION SHALL BE MADE WITHOUT THE PRIOR WRITTEN CONSENT OF ATWELL LLC.

ATWELL
866.850.4200 www.atwell-group.com
143 UNION SQUARE, SUITE 700
LAKEWOOD, CO 80228
303.462.1100

SUNSET VILLAGE VIEW, LLC.
CLIENT
SUNSET VILLAGE VIEW, LLC.
SUNSET VILLAGE FIL. NO. 4
JAYHAWK AVENUE AND REDTAIL DRIVE
EL PASO COUNTY, COLORADO
DETAILS

DATE 12/03/2021

REVISIONS

COLORADO LICENSED PROFESSIONAL ENGINEER
39874


DR. RDL CH. RDL
P.M. RDL

JOB 21004166
SHEET NO. 24

CAD FILE: 21004166-DETAILS.DWG

SC-5

Rock Sock (RS)

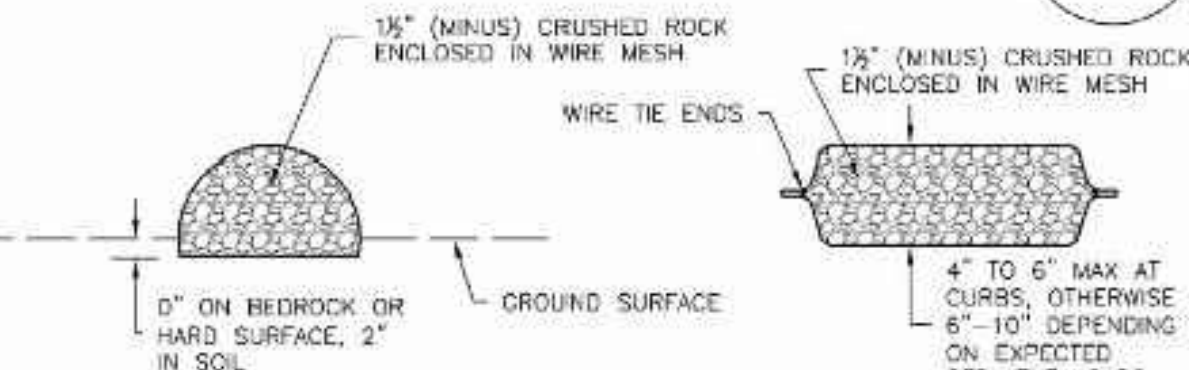

ROCK SOCK SECTION

ROCK SOCK PLAN



ROCK SOCK JOINTING

ROCK SOCK INSTALLATION NOTES

- SEE PLAN VIEW FOR:
-LOCATION(S) OF ROCK SOCKS.
- CRUSHED ROCK SHALL BE 1 1/2" (MINUS) IN SIZE WITH A FRACTURED FACE (ALL SIDES) AND SHALL COMPLY WITH GRADATION SHOWN ON THIS SHEET (1/2" MINUS).
- WIRE MESH SHALL BE FABRICATED OF 10 GAGE POULTRY MESH, OR EQUIVALENT, WITH A MAXIMUM OPENING OF 1/2", RECOMMENDED MINIMUM ROLL WIDTH OF 48"
- WIRE MESH SHALL BE SECURED USING "HOC RINGS" OR WIRE TIES AT 6" CENTERS ALONG ALL JOINTS AND AT 2" CENTERS ON ENDS OF SOCKS.
- SOME MUNICIPALITIES MAY ALLOW THE USE OF FILTER FABRIC AS AN ALTERNATIVE TO WIRE MESH FOR THE ROCK ENCLOSURE.

RS-1. ROCK SOCK PERIMETER CONTROL


ROCK SOCK MAINTENANCE NOTES

- INSPECT BMPs EACH WORKDAY, AND MAINTAIN THEM IN EFFECTIVE OPERATING CONDITION. MAINTENANCE OF BMPs SHOULD BE PROACTIVE, NOT REACTIVE. INSPECT BMPs AS SOON AS POSSIBLE (AND ALWAYS WITHIN 24 HOURS) FOLLOWING A STORM THAT CAUSES SURFACE EROSION, AND PERFORM NECESSARY MAINTENANCE.
- FREQUENT OBSERVATIONS AND MAINTENANCE ARE NECESSARY TO MAINTAIN BMPs IN EFFECTIVE OPERATING CONDITION. INSPECTIONS AND CORRECTIVE MEASURES SHOULD BE DOCUMENTED THOROUGHLY.
- WHERE BMPs HAVE FAILED, REPAIR OR REPLACEMENT SHOULD BE INITIATED UPON DISCOVERY OF THE FAILURE.
- ROCK SOCKS SHALL BE REPLACED IF THEY BECOME HEAVILY SOILED, OR DAMAGED BEYOND REPAIR.
- SEDIMENT ACCUMULATED UPSTREAM OF ROCK SOCKS SHALL BE REMOVED AS NEEDED TO MAINTAIN FUNCTIONALITY OF THE BMP. TYPICALLY WHEN DEPTH OF ACCUMULATED SEDIMENT IS APPROXIMATELY 1/2 OF THE HEIGHT OF THE ROCK SOCK.
- ROCK SOCKS ARE TO REMAIN IN PLACE UNTIL THE UPSTREAM DISTURBED AREA IS STABILIZED AND APPROVED BY THE LOCAL JURISDICTION.
- WHEN ROCK SOCKS ARE REMOVED, ALL DISTURBED AREAS SHALL BE COVERED WITH TOPSOIL, SEEDED AND MULCHED OR OTHERWISE STABILIZED AS APPROVED BY LOCAL JURISDICTION.



(DETAIL ADAPTED FROM TOWN OF PARKER, COLORADO AND CITY OF AURORA, COLORADO, NOT AVAILABLE IN AUTOCAD)

NOTE: MANY JURISDICTIONS HAVE BMP DETAILS THAT VARY FROM UDFCD STANDARD DETAILS. CONSULT WITH LOCAL JURISDICTIONS AS TO WHICH DETAIL SHOULD BE USED WHEN DIFFERENCES ARE NOTED.



NOTE: THE DETAILS INCLUDED WITH THIS FACT SHEET SHOW COMMONLY USED, CONVENTIONAL METHODS OF ROCK SOCK INSTALLATION IN THE DENVER METROPOLITAN AREA. THERE ARE MANY OTHER SIMILAR PROPRIETARY PRODUCTS ON THE MARKET. UDFCD NEITHER ENDORSES NOR DISCOURAGES USE OF PROPRIETARY PROTECTION PRODUCTS; HOWEVER, IN THE EVENT PROPRIETARY METHODS ARE USED, THE APPROPRIATE DETAIL FROM THE MANUFACTURER MUST BE INCLUDED IN THE SWMP AND THE BMP MUST BE INSTALLED AND MAINTAINED AS SHOWN IN THE MANUFACTURER'S DETAILS.

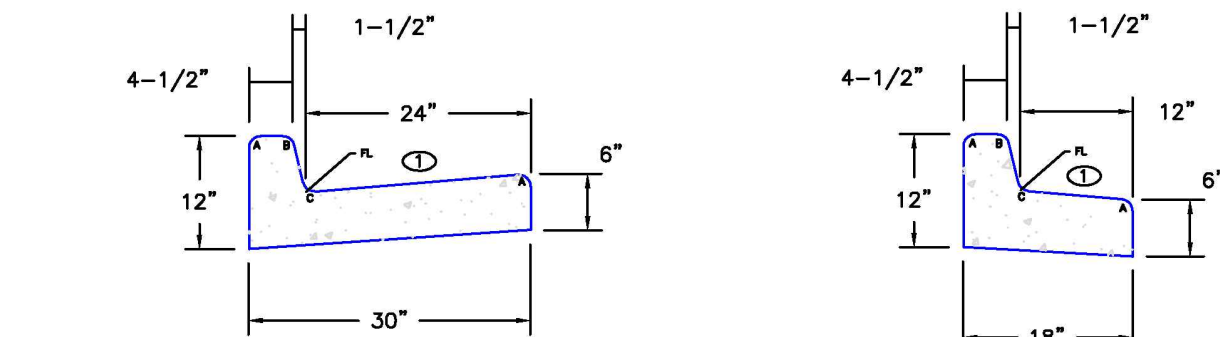EPC TYPE A
(REVERSE SLOPE OF PAN FOR SPILL CURB)

EPC TYPE B

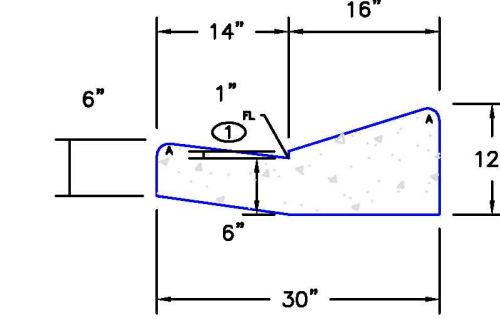
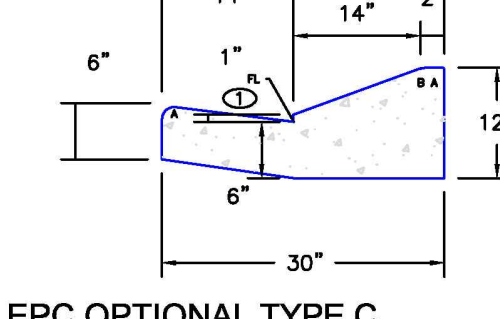
EPC TYPE C
(REVERSE SLOPE OF PAN FOR SPILL CURB)

EPC OPTIONAL TYPE C

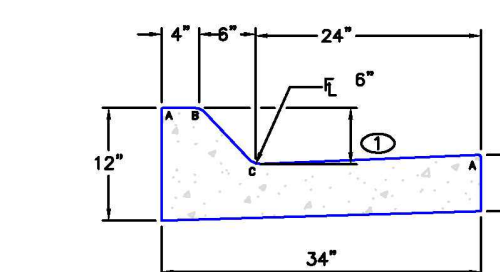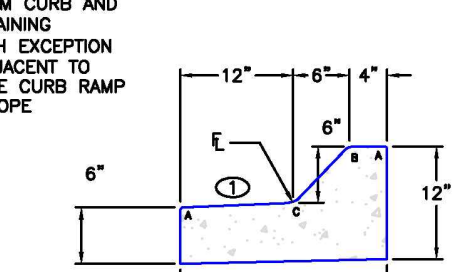EPC TYPE D
(6" RAMP CURB)EPC TYPE E
(6" RAMP CURB)

SCALE: NOT TO SCALE

6/23/20	Typical Curb and Gutter Details Standard Drawing	
DATE APPROVED: Jennifer E. Irvine	REVISION DATE: 6/23/20	FILE NAME: SD_2-20
DEPARTMENT OF PUBLIC WORKS		

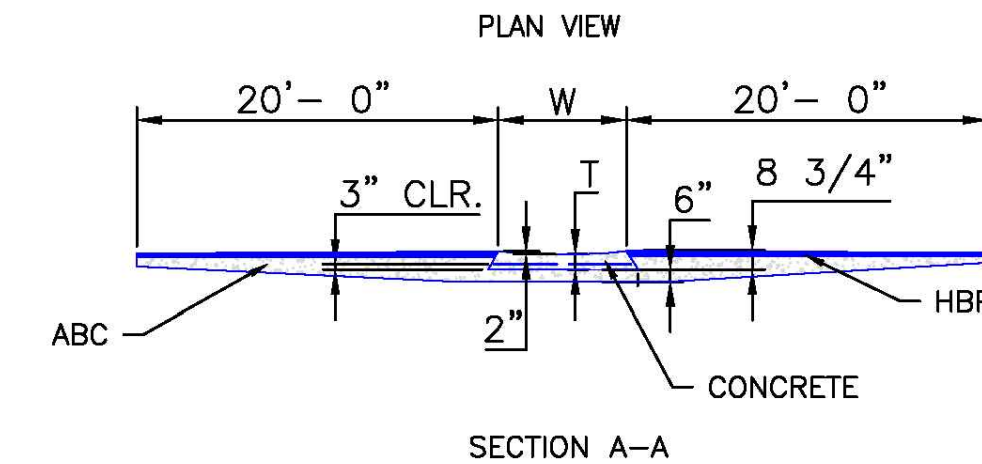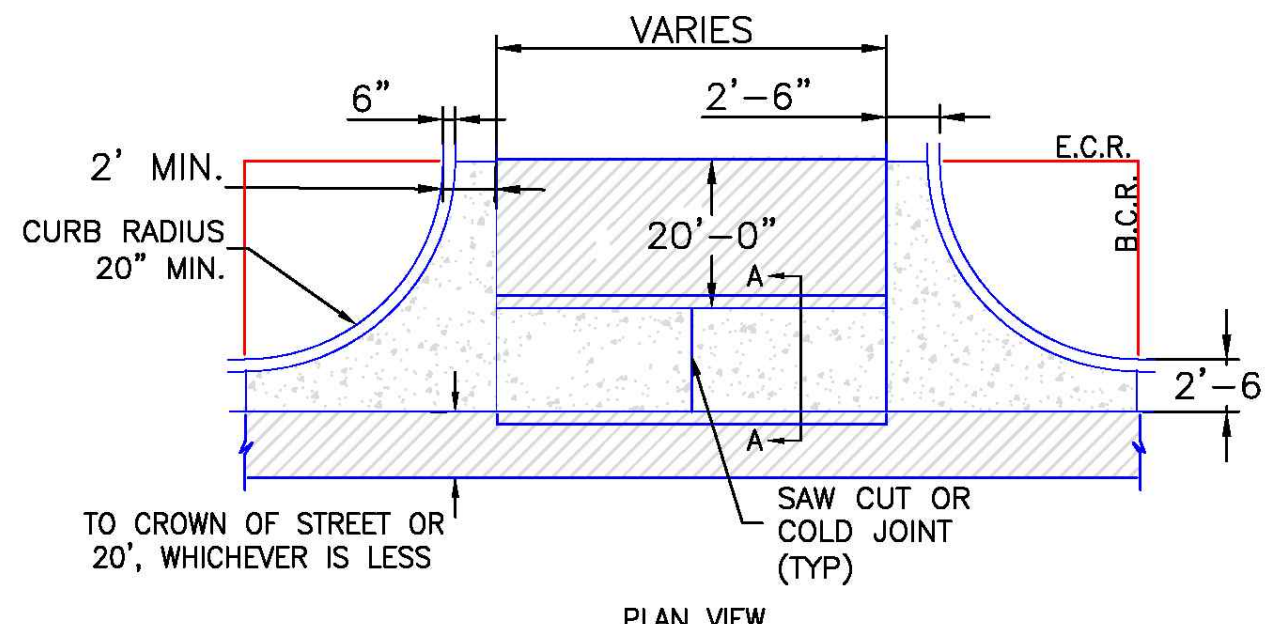


NOTES

- W - WIDTH SHALL BE 6' FOR LOCAL, 8' FOR COLLECTORS, AND 10' FOR ARTERIAL ROADS.
- T - SLOPED-OFF RETURN TO BE POURED MONOLITHICALLY, 8" PCC FOR LOCAL ROADS, 9" FOR COLLECTORS WITH 6x6 - 4.4 W.W.F. OR #4 REINFORCING BAR @ 18" EACH WAY.
- 3" MINIMUM ASPHALT DEPTH (2 LIFTS).
- DESIGN TO SPECIFY ELEVATIONS AT PI AND PCR.

SCALE: NOT TO SCALE

8/11/11	Typical Cross Plan Layout Detail Standard Drawing	
DATE APPROVED: André P. Brackin	REVISION DATE: 12/8/15	FILE NAME: SD_2-26
DEPARTMENT OF TRANSPORTATION		

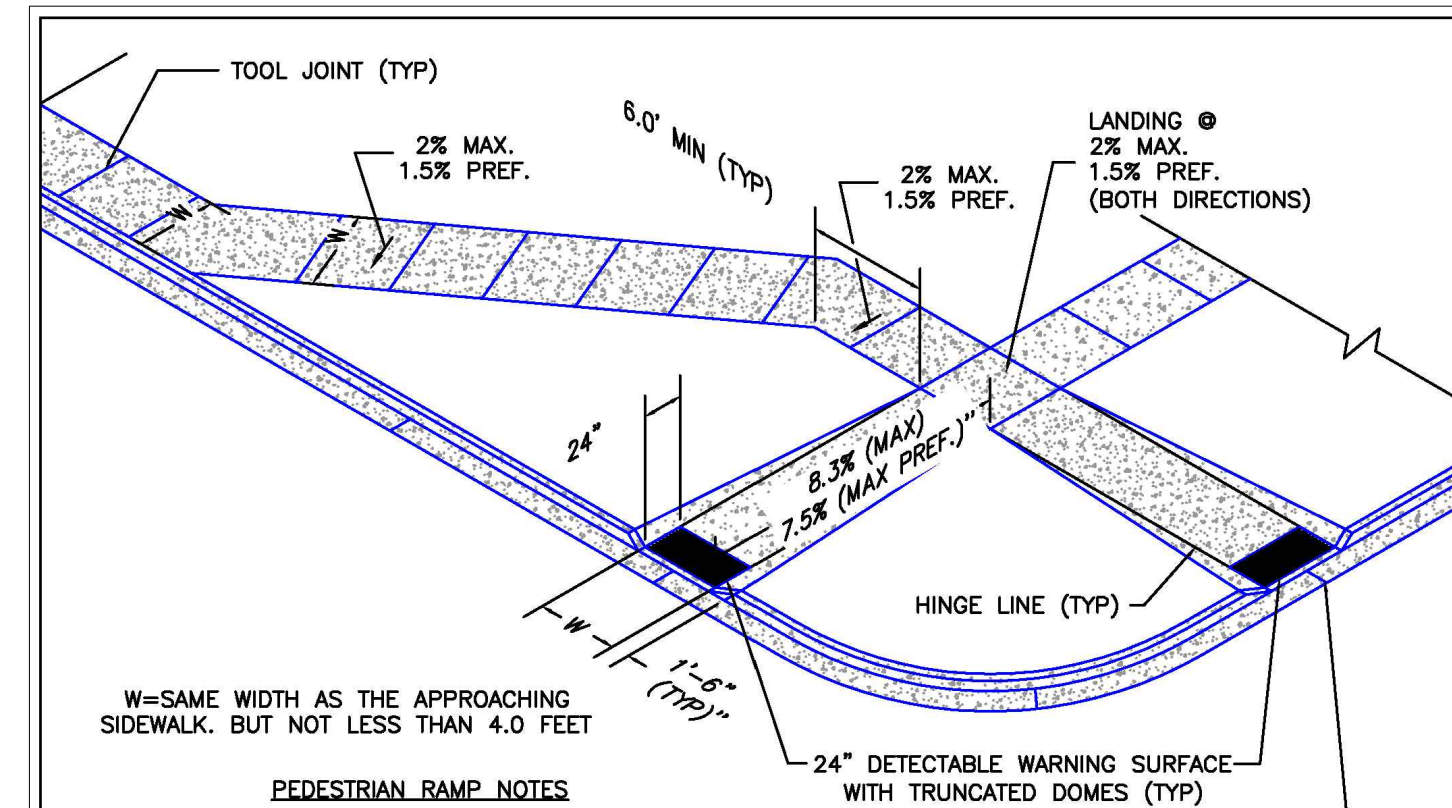

W= SAME WIDTH AS THE APPROACHING SIDEWALK, BUT NOT LESS THAN 4.0 FEET

PEDESTRIAN RAMP NOTES

- ALL WORK SHALL BE DONE IN ACCORDANCE WITH THE CURRENT ENGINEERING CRITERIA MANUAL AND ADA REQUIREMENTS.
- CONTRACTOR TO NOTIFY ENGINEERING DIVISION INSPECTION STAFF 48 HOURS PRIOR TO CONCRETE PLACEMENT.
- PEDESTRIAN CURB RAMP CONSTRUCTION SHALL BE A MINIMUM 4,500 PSI CONCRETE, MINIMUM 4" THICK, NON-COLORED, NON-SCORED, COARSE BROOM FINISH.
- PEDESTRIAN CURB RAMP LOCATION AND LENGTH MAY REQUIRE MODIFICATION TO MAINTAIN THE 8.3% MAXIMUM RUNNING RAMP SLOPE DUE TO STREET INTERSECTION GRADES AND/OR ALIGNMENTS. SEE EGM SECTION 6.3.5 FOR PEDESTRIAN PUSHBUTTON LOCATION REQUIREMENTS.
- DETECTABLE WARNING SURFACE SHALL START A MINIMUM OF 6" BUT NOT MORE THAN 8" FROM THE FLOWLINE OF THE CURB AT ANY POINT.
- DETECTABLE WARNING SURFACE SHALL BE PREFABRICATED, CAST IRON (OPTIMA NATURAL FINISH) AND IN ACCORDANCE WITH EGM CHAPTER 8 AND SD-2-42. THERMOPLASTIC TRUNCATED DOMES AND PAVERS WILL NOT BE ACCEPTED.
- THE DETECTABLE WARNING SURFACE SHALL BE 24" IN LENGTH AND THE FULL WIDTH OF THE FLARE AREA.
- PEDESTRIAN CURB RAMP WIDTH REQUIRED IS SAME AS APPROACHING SIDEWALK, 4" MINIMUM.
- ALL PEDESTRIAN CURB RAMPs WILL BE PERPENDICULAR TO TRAFFIC WITH THE EXCEPTION OF MID-BLOCK OR TERMINAL RAMPs WHICH MAY BE PARALLEL, SUBJECT TO APPROVAL.
- DRAINAGE STRUCTURES, TRAFFIC SIGNAL/BOXES, UTILITIES/JUNCTION BOXES, OR OTHER OBSTRUCTIONS WITHIN PROPOSED PEDESTRIAN CURB RAMP AREAS AND LANDINGS ARE PROHIBITED.
- THE COUNTER SLOPE OF THE GUTTER OR ROAD AT THE FOOT OF A RAMP SHALL NOT EXCEED 3%.


GENERAL NOTES

- WHERE THE 1'-6" FLARED SIDE(S) OF A PERPENDICULAR CURB RAMP IS (ARE) CONTIGUOUS WITH A PEDESTRIAN OR HARD SURFACE AREA (PEDESTRIAN CIRCULATION PATH), THE MAXIMUM FLARE SLOPE SHALL NOT EXCEED 10:1.
- PEDESTRIAN WALKWAY (PEDESTRIAN ACCESS ROUTE) AND/OR LOCATION OF EXISTING OR FUTURE PEDESTRIAN RAMPs ON OPPOSITE CORNERS SHALL BE REVIEWED BEFORE CONSTRUCTING NEW RAMPs.
- AT MARKED PEDESTRIAN CROSSINGS, THE BOTTOM OF THE RAMPs, EXCLUSIVE OF THE FLARE SIDES, SHALL BE TOTALLY CONTAINED WITHIN THE MARKINGS.


6/23/20	Pedestrian Curb Ramp Detail Standard Drawing	
DATE APPROVED: Jennifer E. Irvine	REVISION DATE: 6/23/20	FILE NAME: SD_2-41
DEPARTMENT OF PUBLIC WORKS		




TRUNCATED DOME DETAILS

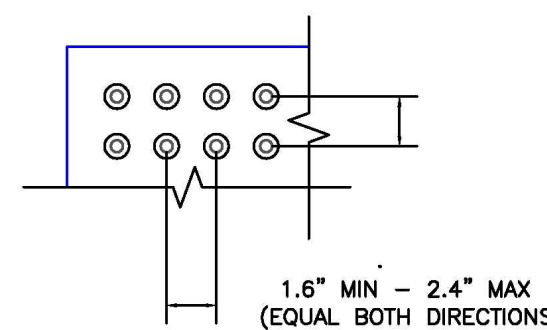



DOME SPACING

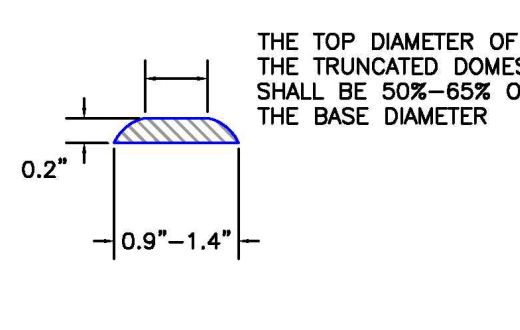

ELEVATION VIEW

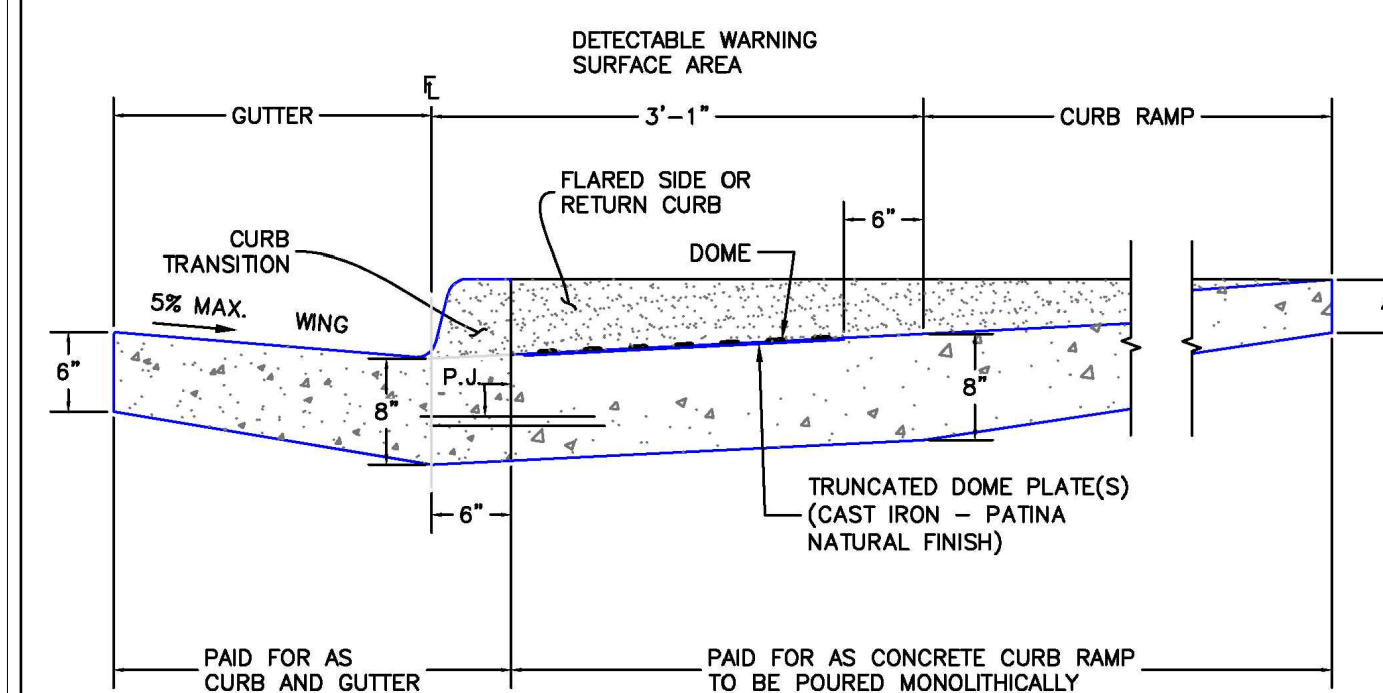SIDE CROSS SECTION VIEW OF
DETECTABLE WARNING SURFACE, CURB AND GUTTER

6/23/20	Detectable Warning Surface Details Standard Drawing	
DATE APPROVED: Jennifer E. Irvine	REVISION DATE: 6/23/20	FILE NAME: SD_2-42
DEPARTMENT OF PUBLIC WORKS		

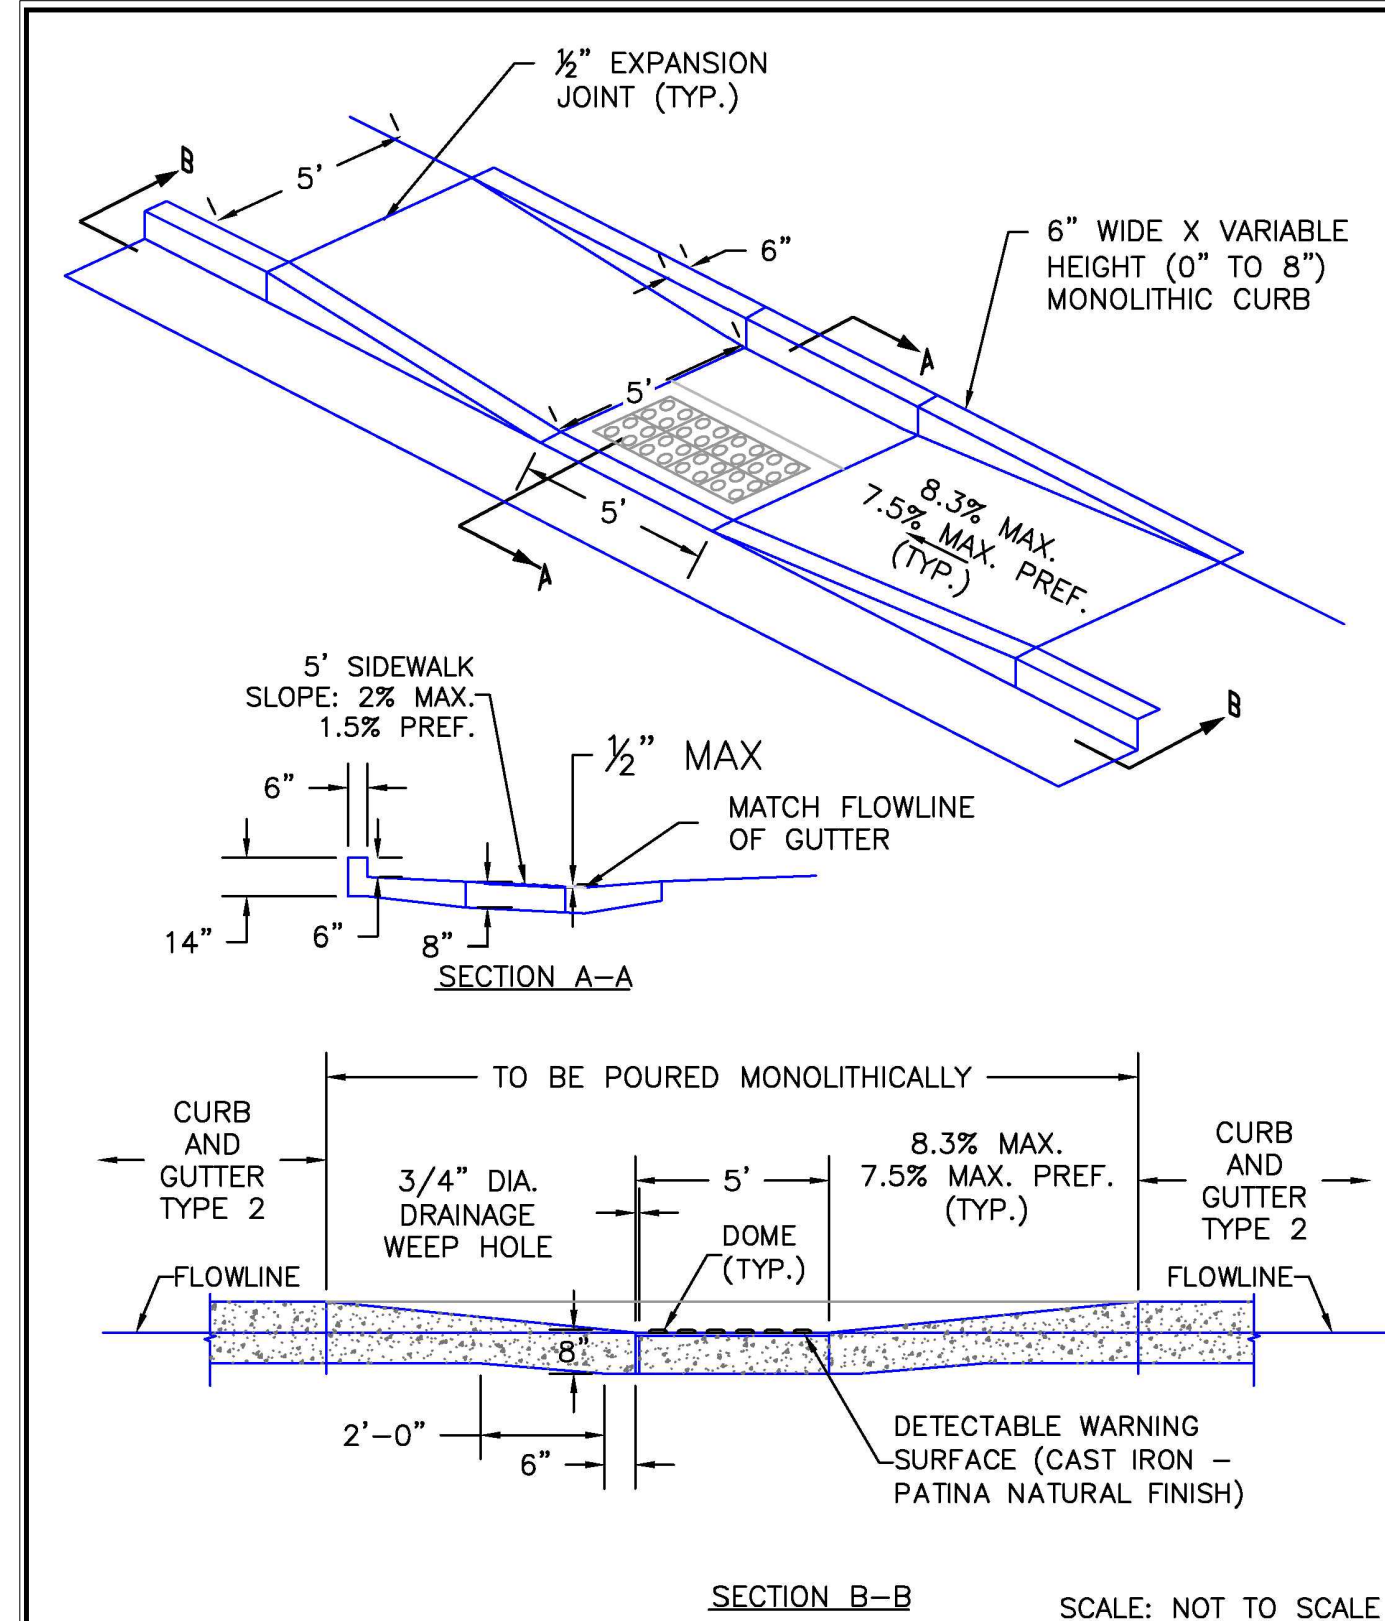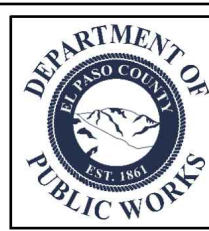

SECTION B-B SCALE: NOT TO SCALE


6/23/20	Parallel Pedestrian Curb Ramp Detail Standard Drawing	
DATE APPROVED: Jennifer E. Irvine	REVISION DATE: 6/23/20	FILE NAME: SD_2-50
DEPARTMENT OF PUBLIC WORKS		

Know what's below.
Call before you dig.

THE LOCATIONS OF EXISTING UNDERGROUND UTILITIES ARE SHOWN IN AN APPROXIMATE WAY ONLY AND HAVE NOT BEEN INDEPENDENTLY VERIFIED BY THE OWNER OR ITS REPRESENTATIVE. THE CONTRACTOR SHALL DETERMINE THE EXACT LOCATION OF ALL EXISTING UTILITIES BEFORE COMMENCING WORK, AND AGREES TO BE FULLY RESPONSIBLE FOR ANY AND ALL DAMAGES WHICH MIGHT BE OCCASIONED BY THE CONTRACTOR'S FAILURE TO EXACTLY LOCATE AND PRESERVE ANY AND ALL UNDERGROUND UTILITIES.

NOTICE: CONSTRUCTION SITE SAFETY IS THE SOLE RESPONSIBILITY OF THE CONTRACTOR. NEITHER THE OWNER NOR THE ENGINEER SHALL BE EXPECTED TO ASSUME ANY RESPONSIBILITY FOR SAFETY OF THE WORK OF PERSONS ENGAGED IN THE WORK, OF ANY NEARBY STRUCTURES, OR OF ANY OTHER PERSONS.

COPYRIGHT © 2021 ATWELL LLC. NO REPRODUCTION SHALL BE MADE WITHOUT THE PRIOR WRITTEN CONSENT OF ATWELL LLC.

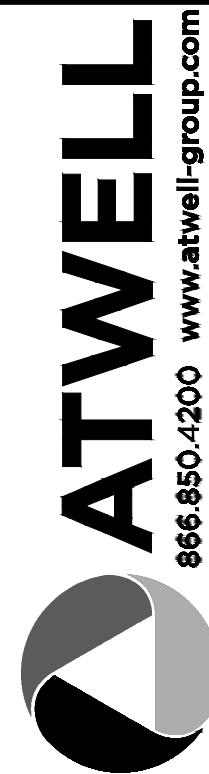

SUNSET VILLAGE VIEW, LLC.
487 WINDCHIME PL. STE. #300
303-519-5100
SCOTT VAN WHYE

SUNSET VILLAGE VIEW, LLC.
SUNSET VILLAGE FIL. NO. 4
JAYHAWK AVENUE AND REDTAIL DRIVE
EL PASO COUNTY, COLORADO
DETAILS

CLIENT
SUNSET VILLAGE VIEW, LLC.

DATE
12/03/2021

REVISIONS
A 1st SUBMITTAL TO EPC
B 2nd SUBMITTAL TO EPC

10/27/2021 - RDL
12/03/2021 - RDL

REVISIONS

REVISIONS

