

Info Only: EPC Engineering comments  
are indicated in blue text.

# DRAINAGE LETTER

## 7280 N. NEVADA LANE

AN UNPLATTED PARCEL IN THE NW1/4 NE1/4, SECTION 8, T. 13 S., R. 65 W. 6<sup>TH</sup> P.M.  
EL PASO COUNTY, COLORADO

PCD File: [PPR2411](#)

November 3, 2003

prepared for

GREENER PASTURES LLC  
Jeff Weisburg  
4450 Mark Dabling Blvd  
Colorado Springs, CO 80907

Oliver E. Watts, Consulting Engineer, Inc.  
Colorado Springs, Colorado

**OLIVER E. WATTS, PE-LS**  
OLIVER E. WATTS, CONSULTING ENGINEER, INC.  
CIVIL ENGINEERING AND SURVEYING  
614 ELKTON DRIVE  
COLORADO SPRINGS, COLORADO 80907  
(719) 593-0173  
fax (719) 265-9660  
[olliewatts@aol.com](mailto:olliewatts@aol.com)  
*Celebrating over 44 years in business*

November 3, 2023

El Paso County Planning and Community Development  
2880 International Circle  
Colorado Springs, CO 80910

ATTN: *Joshua Palmer, P.E.*

SUBJECT: Drainage Letter, 7280 N. Nevada Lane

Transmitted herewith for your review and approval is the drainage letter for 7280 N. Nevada Lane, to accompany the zone change submittal on subject property.

**There will be no construction involved and no change in the runoff** as a result of this zone change request, so this letter reflects current conditions. Please contact our office if we may provide any further information.

Oliver E. Watts, Consulting Engineer, Inc.

BY: \_\_\_\_\_  
Oliver E. Watts, President

Encl:

Drainage Letter 2 pages  
Computations 2 pages  
Soils Map and Interpretation Sheet  
Backup Information, 4 pages  
FEMA Flood Panel 08041C0529 G, December 7, 2018  
Sand Creek Drainage Basin (1977) Sheet 44  
Offsite Drainage Map  
Drainage Plan Dwg 23-5924-04

Since 2008, there has been a decent amount of development on this site, possibly more than 1 ac of non-excluded disturbances.

Please address post-2008 development on this site as it pertains to the need for water quality treatment and stormwater detention. All non-excluded disturbances due to development since March 10, 2008 counts cumulatively towards the need for a PBMP once the total exceeds 1ac.

Also, in regards to an ESQCP, much of the site is unvegetated bare soil from the past development. These areas will need to be stabilized.

**1. ENGINEER'S STATEMENT:**

The attached drainage plan and report were prepared under my direction and supervision and are correct to the best of my knowledge and belief. Said drainage report has been prepared according to the criteria established by the County for drainage reports and said report is in conformity with the applicable master plan of the drainage basin. I accept responsibility for any liability caused by any negligent acts, errors or omissions on my part in preparing this report.

Oliver E. Watts, Consulting Engineer, Inc.

---

Oliver E. Watts      Colo. PE-LS No. 9853

**2. OWNERS / DEVELOPER'S STATEMENT:**

I the owner / developer have read and will comply with all of the requirements specified in this drainage report and plan.

Greener Pastures, LLC

By: \_\_\_\_\_  
Jeff Weisburg  
4450 Mark Dabling Blvd  
Colorado Springs, CO 80907  
(719) 291-0291

**3. EL PASO COUNTY:**

Filed in accordance with the requirements of the El Paso Land Development Code, Drainage Criteria Manual Volumes 1 and 2, and the Engineering Criteria Manual, as amended.

---

Joshua Palmer, P.E.  
County Engineer / ECM Administrator

---

Date

Conditions:

Please include information of all adjacent roadways or properties (including Plat name if applicable) border the project.

#### 4. LOCATION AND DESCRIPTION:

7280 N. Nevada Lane is located south of Woodmen Road, East of Black Forest Road and West of Sand Creek, as shown on the enclosed vicinity map. It occupies 4.984 acres in the Sand Creek Drainage basin in part of the Northwest quarter of the Northeast Quarter of Section 8, Township 13 South, Range 65 West of the 6<sup>th</sup> P.M. in El Paso County. The Assessor's Parcel No. is 5308000074. It is an unplatted parcel for which a zone change is being processed, which is the reason for this drainage letter.

Please use the current El Paso Criteria: City of Colorado Springs "Drainage Criteria Manual, Volumes 1 and 2," Revised October 31, 2028 El Paso County "Engineering Criteria Manual." Revised December 13, 2016.

#### 5. FLOOD PLAIN STATEMENT:

This subdivision is not within the limits of a designated flood plain or flood hazard area, as identified on FEMA panel no. 08041C0533 G, dated December 7, 2018, a copy of which is enclosed for reference.

#### 6. CRITERIA AND METHOD:

All computations are based on the rational method described in Volume 1 of the City – County drainage criteria. Computations are enclosed, along with pertinent criteria backup information. All soils in the area are of the Blakeland Complex, hydrologic group "A", and a soils map and interpretation sheet are enclosed.

Please include the type of runoff (sheet flow or concentrated flow) and how the offsite runoff could impact the project area.

#### 6. DESCRIPTION OF RUNOFF:

As shown on the enclosed offsite drainage map, 1.89 acres of the adjacent northerly lot will drain into subject property. No other inflows exist. The routing across the property is delineated on the enclosed drainage plan. Basin D in the southeast corner is isolated from the remainder of the parcel by a dike and area grading and the 0.63 acre parcel drains 0.1 cfs / 0.3 cfs (5-year / 100- year runoffs) in concentrated form into California Drive. The remainder of the property is graded around a number of shop buildings to drain into California Drive over the westerly 360 feet of the South boundary with no specific outfall structure, total flow 3.8 cfs/12.2 cfs. The streets in this area are unpaved or lightly graveled and further routing may be seen in a southerly direction, primarily on Wyoming Lane, some 3800 feet to the Sand Creek channel. No specific routing has been addressed in the Sand Creek study. Sheet 44 of the study is enclosed for reference.

#### 7. FEES:

This site is unplatted and no construction is proposed in subject zone change request. Drainage fees are not applicable until the site is subdivided.

Please provide excerpt of this study. Please highlight all relevant information to the subject project.

How to prevent erosion from the concentrated flows from basin D to California Dr.?

Please discuss the existing drainage and proposed drainage conditions. A comparison of the flows leaving the site for both conditions is needed.

Please provide engineering cost estimate if applicable.

Please include a summary section. Will this proposed project have adversely impact adjacent properties or stormwater runoff. if not, please state.

Please include reference section.

Please discuss grading erosion, water quality, and water detention within this project. Note that If/when the site disturbs >1ac of soil, a stormwater quality treatment facility (PBMP) will be needed for the runoff from the non-excluded areas. Exclusions can be found in our PBMP Applicability Form and ECM Appendix I.7

MAJOR BASIN	SUB BASIN	AREA		BASIN		T <sub>c</sub> MIN	I in./hr.		SOIL GRP	DEV. TYPE	C		FLOW		RETURN PERIOD -years-	
		1"=30'	ACRES	LENGTH -FT.-	HEIGHT -FT.-								5-ry	100-yr		
		PLANIM READ											qp -CFS-	qp -CFS-		
SAND CREEK	O-1	5.93	0.49	100	7.5	7.8			A	BARE	0.30	0.50	C=7		5	100
		1.25	0.10	+254	14.5	+1.8				R/L	0.08	0.35	C=10	V=2.4		
		TOTAL	0.59			9.6	4.2	7.0		MIX	0.265	0.475	0.65	2.0	5	100
	O-2	4.62	0.38	100	8	8.7				BARE	0.30	0.50	C=7			
		11.15	0.962	+314	22	+2.0				R/L	0.08	0.35	C=10	V=2.6		
		TOTAL	1.30			10.7	4.3	6.8		MIX	0.144	0.39	0.80	3.5	5	100
	A	COGO	0.018	100	6.5	8.7			A	ROOF	0.73	0.81				
		0.010	+180	11	+2.4					CONC	0.89	0.96	C=5	V=1.24		
		0.700								R/L	0.08	0.35				
		0.680								BARE	0.30	0.50				
		TOTAL	1.41			11.1	4.0	6.7		MIX	0.200	0.422				
	O-1 +A			+280	17.5	+2.7							C=7	V=1.7		
	DP1	TOTAL	2.00			12.3	3.0	6.4		MIX	0.218	0.438	1.3	5.6	5	100
	B	COGO	0.227	100	2.5	9.7			A	ROOF	0.73	0.81				
		0.028	+290	6.5	+4.6					CONC.	0.90	0.96	C=7	V=1.05		
		1.285				14.3	3.6	6.0		BARE	0.30	0.50				
		TOTAL	1.54							MIX	0.374	0.554	2.1	5.1	5	100
	DP2		2.84	+390	9	+8.6							C=7	V=0.76		
	B+O2					19.2	3.2	5.3	A	MOX	0.318	0.588	2.8	8.5	5	100
<b>HYDROLOGICAL COMPUTATION – BASIC DATA</b>														PAGE 1		
PROJ: 7280 N. NEVADA LANE BY: O.E. WATTS							<b>OLIVER E. WATTS, CONSULTING ENGINEER, INC.</b>							OF		
RATIONAL METHOD DATE: 11-3-23							614 ELKTON DRIVE COLORADO SPRINGS, CO 80907							2		

MAJOR BASIN	SUB BASIN	AREA		BASIN		T <sub>c</sub> MIN	I in./hr.		SOIL GRP	DEV. TYPE	C		FLOW		RETURN PERIOD -years-		
		PLANIM READ	ACRES	LENGTH -FT.-	HEIGHT -FT.-								5-ry	100-yr			
													qp -CFS-	qp -CFS-			
SAND CREEK	C	COGO	0.068	100	2	12.7			A	BARE	0.30	0.50			5	100	
			0.035	+100	2	+1.9				CONC	0.90	0.96	C=5	V=0.87			
			0.043							ROOF	0.73	0.81					
			1.264							R/L	0.08	0.35					
		TOTAL	1.41			14.6	3.4	6.0		MIX	0.130	0.386	0.6	3.5	5	100	
01+02+A-C	DP3			+200	5	+4.2							C=5	V=0.79			
		TOTAL	4.95			18.5	3.2	5.4			0.242	0.459	3.8	12.2	5	100	
	D	COGO	0.033	100	3	13.1			A	ROOF	0.73	0.81					
			0.017	+155	4	+3.2				CONC	0.90	0.96	C=5	V=0.80			
			0.096							A.C.	0.90	0.96					
			0.058							L/S	0.08	0.35					
			0.426							BARE	0.30	0.50					
		TOTAL	0.63			16.3	3.4	5.7		MIX	0.052	0.074	0.1	0.3	5	100	
<b>HYDROLOGICAL COMPUTATION – BASIC DATA</b>																PAGE 2	
PROJ: 7280 N NEVADA LN BY: O.E. WATTS RATIONAL METHOD DATE: 11-3-23						OLIVER E. WATTS, CONSULTING ENGINEER, INC. 614 ELKTON DRIVE COLORADO SPRINGS, CO 80907										OF 2	


EL PASO COUNTY AREA, COLORADO

TABLE 16.--SOIL AND WATER FEATURES

[Absence of an entry indicates the feature is not a concern. See "flooding" in Glossary for definition of terms as "rare," "brief," and "very brief." The symbol > means greater than]

Soil name and map symbol	Hydro-logic group	Flooding			Bedrock		Potential frost action
		Frequency	Duration	Months	Depth In	Hardness	
Alamosa: 1-----	C	Frequent-----	Brief-----	May-Jun	>60	---	High.
Ascalon: 2, 3-----	B	None-----	---	---	>60	---	Moderate.
Badland: 4-----	D	---	---	---	---	---	---
Bijou: 5, 6, 7-----	B	None-----	---	---	>60	---	Low.
Blakeland: 8-----	A	None-----	---	---	>60	---	Low.
19: Blakeland part-	A	None-----	---	---	>60	---	Low.
Fluvaquentic Haplaquolls part-----	D	Common-----	Very brief----	Mar-Aug	>60	---	High.
Blendon: 10-----	B	None-----	---	---	>60	---	Moderate.
Bresser: 11, 12, 13-----	B	None-----	---	---	>60	---	Low.
Brussett: 14, 15-----	B	None-----	---	---	>60	---	Moderate.
Chaseville: 16, 17-----	A	None-----	---	---	>60	---	Low.
118: Chaseville part	A	None-----	---	---	>60	---	Low.
Midway part----	D	None-----	---	---	10-20	Rippable	Moderate.
Columbine: 19-----	A	None to rare	---	---	>60	---	Low.
Connerton: 120: Connerton part-	B	None-----	---	---	>60	---	High.
Rock outcrop part-----	D	---	---	---	---	---	---
Cruckton: 21-----	B	None-----	---	---	>60	---	Moderate.
Cushman: 22, 23-----	C	None-----	---	---	20-40	Rippable	Moderate.
124: Cushman part----	C	None-----	---	---	20-40	Rippable	Moderate.
Kutch part-----	C	None-----	---	---	20-40	Rippable	Moderate.
Elbeth: 25, 26-----	B	None-----	---	---	>60	---	Moderate.
127: Elbeth part----	B	None-----	---	---	>60	---	Moderate.

See footnote at end of table.

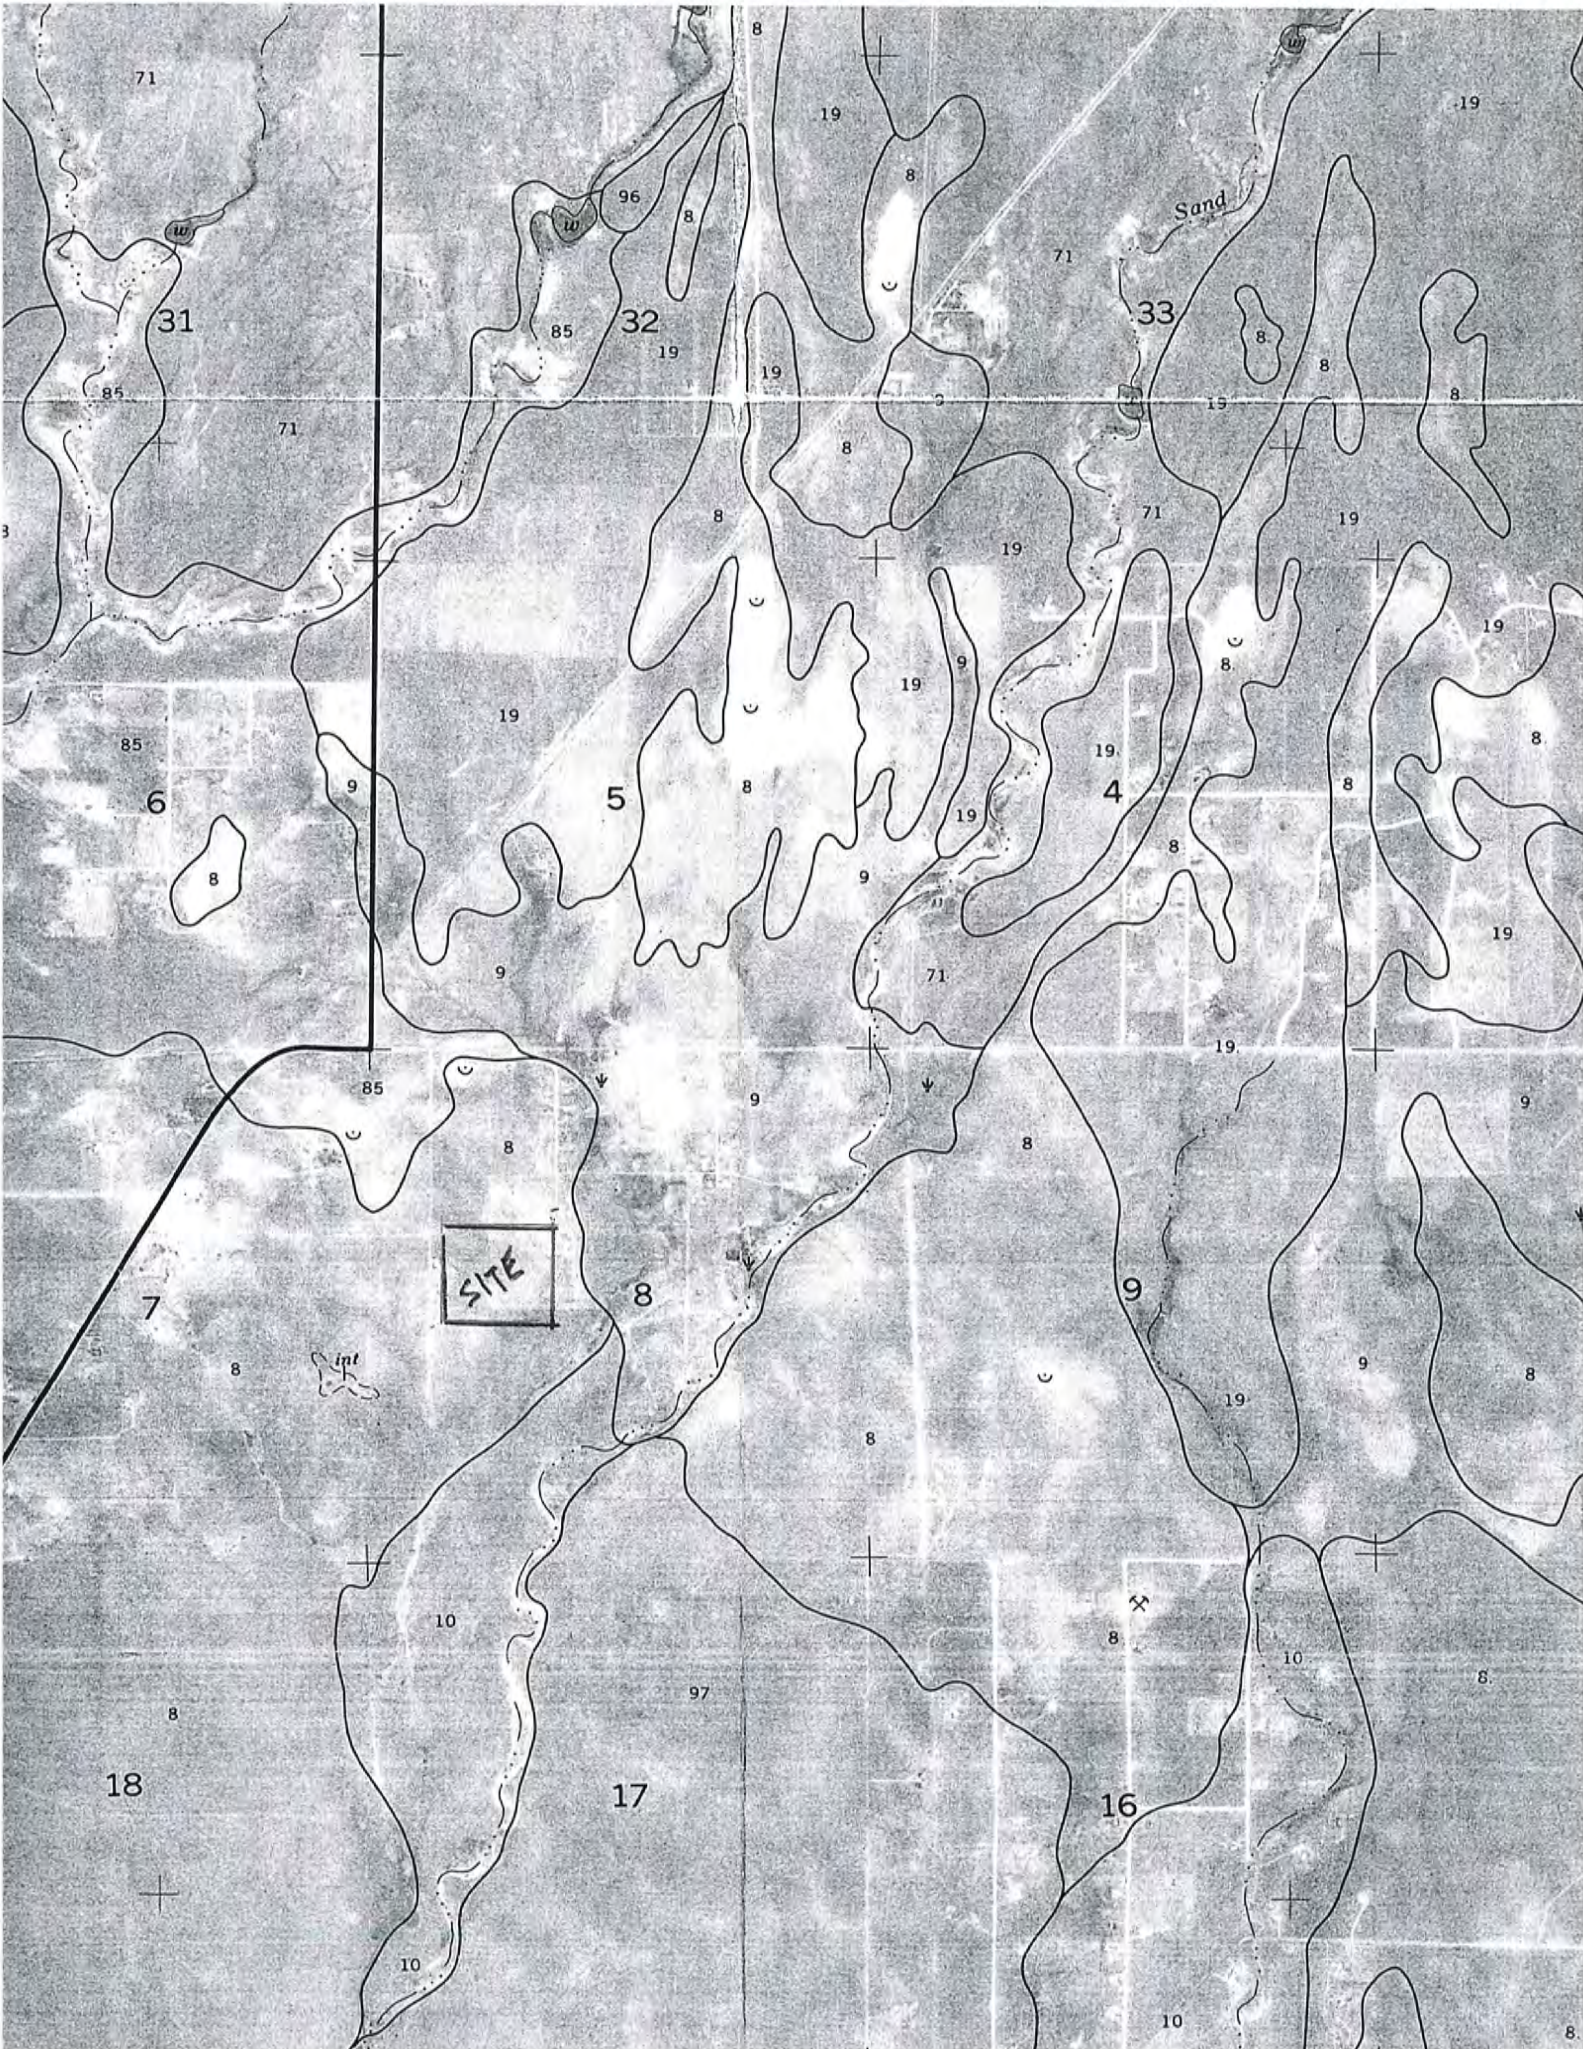

71

19

19

Sand

31

32

33

71

5

4

6

SITE

7

18

17

16

10

97

10

10

8



**Table 6-6. Runoff Coefficients for Rational Method**

(Source: UDFCD 2001)

Land Use or Surface Characteristics	Percent Impervious	Runoff Coefficients											
		2-year		5-year		10-year		25-year		50-year		100-year	
		HSG A&B	HSG C&D	HSG A&B	HSG C&D	HSG A&B	HSG C&D	HSG A&B	HSG C&D	HSG A&B	HSG C&D	HSG A&B	HSG C&D
<b>Business</b>													
Commercial Areas	95	0.79	0.80	0.81	0.82	0.83	0.84	0.85	0.87	0.87	0.88	0.88	0.89
Neighborhood Areas	70	0.45	0.49	0.49	0.53	0.53	0.57	0.58	0.62	0.60	0.65	0.62	0.68
<b>Residential</b>													
1/8 Acre or less	65	0.41	0.45	0.45	0.49	0.49	0.54	0.54	0.59	0.57	0.62	0.59	0.65
1/4 Acre	40	0.23	0.28	0.30	0.35	0.36	0.42	0.42	0.50	0.46	0.54	0.50	0.58
1/3 Acre	30	0.18	0.22	0.25	0.30	0.32	0.38	0.39	0.47	0.43	0.52	0.47	0.57
1/2 Acre	25	0.15	0.20	0.22	0.28	0.30	0.36	0.37	0.46	0.41	0.51	0.46	0.56
1 Acre	20	0.12	0.17	0.20	0.26	0.27	0.34	0.35	0.44	0.40	0.50	0.44	0.55
<b>Industrial</b>													
Light Areas	80	0.57	0.60	0.59	0.63	0.63	0.66	0.66	0.70	0.68	0.72	0.70	0.74
Heavy Areas	90	0.71	0.73	0.73	0.75	0.75	0.77	0.78	0.80	0.80	0.82	0.81	0.83
<b>Parks and Cemeteries</b>	7	0.05	0.09	0.12	0.19	0.20	0.29	0.30	0.40	0.34	0.46	0.39	0.52
Playgrounds	13	0.07	0.13	0.16	0.23	0.24	0.31	0.32	0.42	0.37	0.48	0.41	0.54
Railroad Yard Areas	40	0.23	0.28	0.30	0.35	0.36	0.42	0.42	0.50	0.46	0.54	0.50	0.58
<b>Undeveloped Areas</b>													
Historic Flow Analysis-- Greenbelts, Agriculture	2	0.03	0.05	0.09	0.16	0.17	0.26	0.26	0.38	0.31	0.45	0.36	0.51
Pasture/Meadow	0	0.02	0.04	0.08	0.15	0.15	0.25	0.25	0.37	0.30	0.44	0.35	0.50
Forest	0	0.02	0.04	0.08	0.15	0.15	0.25	0.25	0.37	0.30	0.44	0.35	0.50
Exposed Rock	100	0.89	0.89	0.90	0.90	0.92	0.92	0.94	0.94	0.95	0.95	0.96	0.96
Offsite Flow Analysis (when landuse is undefined)	45	0.26	0.31	0.32	0.37	0.38	0.44	0.44	0.51	0.48	0.55	0.51	0.59
<b>Streets</b>													
Paved	100	0.89	0.89	0.90	0.90	0.92	0.92	0.94	0.94	0.95	0.95	0.96	0.96
Gravel	80	0.57	0.60	0.59	0.63	0.63	0.66	0.66	0.70	0.68	0.72	0.70	0.74
<b>Drive and Walks</b>	100	0.89	0.89	0.90	0.90	0.92	0.92	0.94	0.94	0.95	0.95	0.96	0.96
Roofs	90	0.71	0.73	0.73	0.75	0.75	0.77	0.78	0.80	0.80	0.82	0.81	0.83
Lawns	0	0.02	0.04	0.08	0.15	0.15	0.25	0.25	0.37	0.30	0.44	0.35	0.50

### 3.2 Time of Concentration

One of the basic assumptions underlying the Rational Method is that runoff is a function of the average rainfall rate during the time required for water to flow from the hydraulically most remote part of the drainage area under consideration to the design point. However, in practice, the time of concentration can be an empirical value that results in reasonable and acceptable peak flow calculations.

For urban areas, the time of concentration ( $t_c$ ) consists of an initial time or overland flow time ( $t_i$ ) plus the travel time ( $t_t$ ) in the storm sewer, paved gutter, roadside drainage ditch, or drainage channel. For non-urban areas, the time of concentration consists of an overland flow time ( $t_i$ ) plus the time of travel in a concentrated form, such as a swale or drainageway. The travel portion ( $t_t$ ) of the time of concentration can be estimated from the hydraulic properties of the storm sewer, gutter, swale, ditch, or drainageway. Initial time, on the other hand, will vary with surface slope, depression storage, surface cover, antecedent rainfall, and infiltration capacity of the soil, as well as distance of surface flow. The time of concentration is represented by Equation 6-7 for both urban and non-urban areas.

$$t_c = t_i + t_f \quad (\text{Eq. 6-7})$$

Where:

$t_c$  = time of concentration (min)

$t_i$  = overland (initial) flow time (min)

$t_f$  = travel time in the ditch, channel, gutter, storm sewer, etc. (min)

### 3.2.1 Overland (Initial) Flow Time

The overland flow time,  $t_i$ , may be calculated using Equation 6-8.

$$t_i = \frac{0.395(1.1 - C_5)\sqrt{L}}{S^{0.33}} \quad (\text{Eq. 6-8})$$

Where:

$t_i$  = overland (initial) flow time (min)

$C_5$  = runoff coefficient for 5-year frequency (see Table 6-6)

$L$  = length of overland flow (300 ft maximum for non-urban land uses, 100 ft maximum for urban land uses)

$S$  = average basin slope (ft/ft)

Note that in some urban watersheds, the overland flow time may be very small because flows quickly concentrate and channelize.

### 3.2.2 Travel Time

For catchments with overland and channelized flow, the time of concentration needs to be considered in combination with the travel time,  $t_f$ , which is calculated using the hydraulic properties of the swale, ditch, or channel. For preliminary work, the overland travel time,  $t_f$ , can be estimated with the help of Figure 6-25 or Equation 6-9 (Guo 1999).

$$V = C_v S_w^{0.5} \quad (\text{Eq. 6-9})$$

Where:

$V$  = velocity (ft/s)

$C_v$  = conveyance coefficient (from Table 6-7)

$S_w$  = watercourse slope (ft/ft)

**Table 6-7. Conveyance Coefficient,  $C_v$** 

Type of Land Surface	$C_v$
Heavy meadow	2.5
Tillage/field	5
Riprap (not buried)*	6.5
Short pasture and lawns	7
Nearly bare ground	10
Grassed waterway	15
Paved areas and shallow paved swales	20

\*For buried riprap, select  $C_v$  value based on type of vegetative cover.

The travel time is calculated by dividing the flow distance (in feet) by the velocity calculated using Equation 6-9 and converting units to minutes.

The time of concentration ( $t_c$ ) is then the sum of the overland flow time ( $t_t$ ) and the travel time ( $t_r$ ) per Equation 6-7.

### 3.2.3 First Design Point Time of Concentration in Urban Catchments

Using this procedure, the time of concentration at the first design point (typically the first inlet in the system) in an urbanized catchment should not exceed the time of concentration calculated using Equation 6-10. The first design point is defined as the point where runoff first enters the storm sewer system.

$$t_c = \frac{L}{180} + 10 \quad (\text{Eq. 6-10})$$

Where:

$t_c$  = maximum time of concentration at the first design point in an urban watershed (min)

$L$  = waterway length (ft)

Equation 6-10 was developed using the rainfall-runoff data collected in the Denver region and, in essence, represents regional "calibration" of the Rational Method. Normally, Equation 6-10 will result in a lesser time of concentration at the first design point and will govern in an urbanized watershed. For subsequent design points, the time of concentration is calculated by accumulating the travel times in downstream drainageway reaches.


### 3.2.4 Minimum Time of Concentration

If the calculations result in a  $t_c$  of less than 10 minutes for undeveloped conditions, it is recommended that a minimum value of 10 minutes be used. The minimum  $t_c$  for urbanized areas is 5 minutes.

### 3.2.5 Post-Development Time of Concentration

As Equation 6-8 indicates, the time of concentration is a function of the 5-year runoff coefficient for a drainage basin. Typically, higher levels of imperviousness (higher 5-year runoff coefficients) correspond to shorter times of concentration, and lower levels of imperviousness correspond to longer times of

Figure 6-5. Colorado Springs Rainfall Intensity Duration Frequency

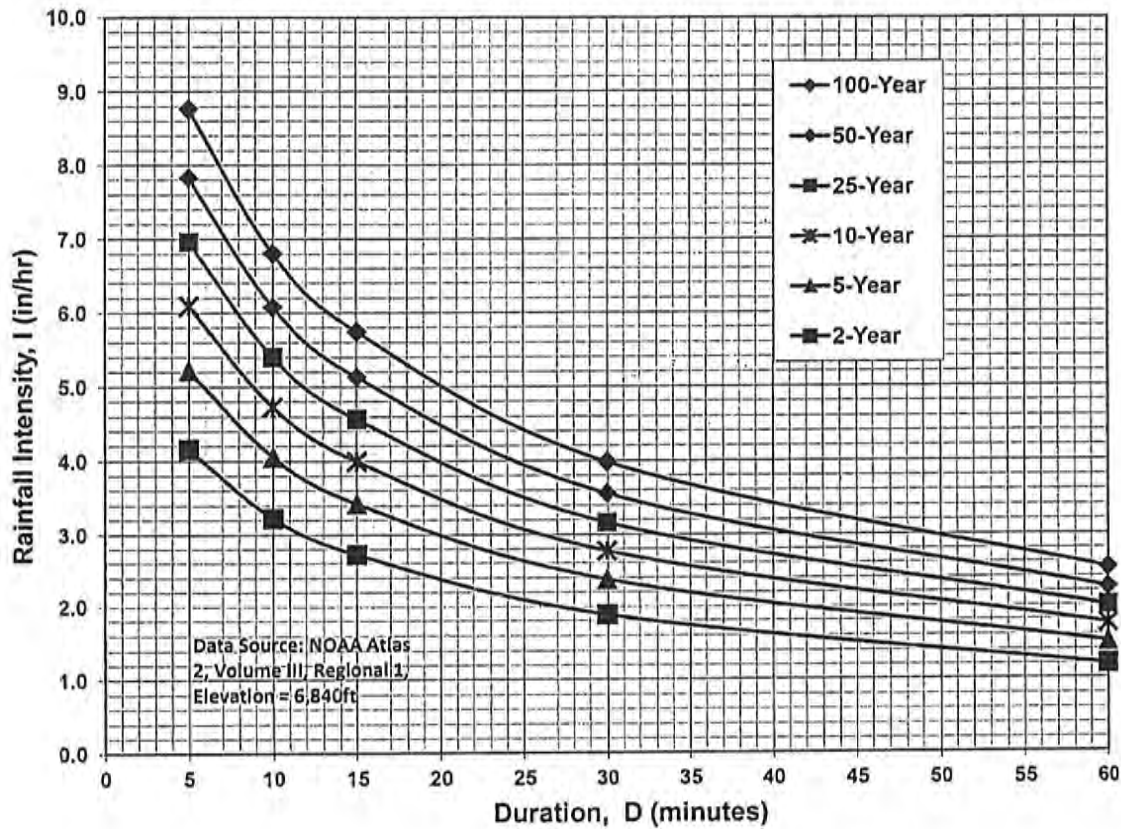

**IDF Equations**

$$I_{100} = -2.52 \ln(D) + 12.735$$

$$I_{50} = -2.25 \ln(D) + 11.375$$

$$I_{25} = -2.00 \ln(D) + 10.111$$

$$I_{10} = -1.75 \ln(D) + 8.847$$

$$I_5 = -1.50 \ln(D) + 7.583$$

$$I_2 = -1.19 \ln(D) + 6.035$$

Note: Values calculated by equations may not precisely duplicate values read from figure.

# National Flood Hazard Layer FIRMette




104°41'38"W 38°56'29"N



## Legend

SEE FIS REPORT FOR DETAILED LEGEND AND INDEX MAP FOR FIRM PANEL LAYOUT

- |                                    |  |   |
|------------------------------------|--|---|
| <b>SPECIAL FLOOD HAZARD AREAS</b>  |  | Without Base Flood Elevation (BFE)<br>Zone A, V, A99  |
|                                    |  | With BFE or Depth Zone AE, AO, AH, VE, AR   |
|                                    |  | Regulatory Floodway   |
| <b>OTHER AREAS OF FLOOD HAZARD</b> |  | 0.2% Annual Chance Flood Hazard, Areas of 1% annual chance flood with average depth less than one foot or with drainage areas of less than one square mile Zone X |
|                                    |  | Future Conditions 1% Annual Chance Flood Hazard Zone X  |
|                                    |  | Area with Reduced Flood Risk due to Levee. See Notes. Zone X  |
|                                    |  | Area with Flood Risk due to Levee Zone D  |
| <b>OTHER AREAS</b>                 |  | NO SCREEN Area of Minimal Flood Hazard Zone X   |
|                                    |  | Effective LOMRs   |
| <b>GENERAL STRUCTURES</b>          |  | Area of Undetermined Flood Hazard Zone D  |
|                                    |  | Channel, Culvert, or Storm Sewer  |
| <b>OTHER FEATURES</b>              |  | Levee, Dike, or Floodwall   |
|                                    |  | Cross Sections with 1% Annual Chance Water Surface Elevation  |
|                                    |  | Coastal Transect  |
|                                    |  | Base Flood Elevation Line (BFE)   |
|                                    |  | Limit of Study  |
|                                    |  | Jurisdiction Boundary   |
|                                    |  | Coastal Transect Baseline   |
|                                    |  | Profile Baseline  |
|                                    |  | Hydrographic Feature  |
| <b>MAP PANELS</b>                  |  | Digital Data Available  |
|                                    |  | No Digital Data Available   |
|                                    |  | Unmapped  |
- The pin displayed on the map is an approximate point selected by the user and does not represent an authoritative property location.

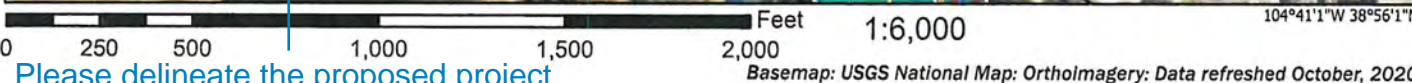

Please delineate the proposed project on FEMA map.


Basemap: USGS National Map: Orthoimagery; Data refreshed October, 2020

This map complies with FEMA's standards for the use of digital flood maps if it is not void as described below. The basemap shown complies with FEMA's basemap accuracy standards

The flood hazard information is derived directly from the authoritative NFHL web services provided by FEMA. This map was exported on 3/30/2023 at 4:55 PM and does not reflect changes or amendments subsequent to this date and time. The NFHL and effective information may change or become superseded by new data over time.

This map image is void if the one or more of the following map elements do not appear: basemap imagery, flood zone labels, legend, scale bar, map creation date, community identifiers, FIRM panel number, and FIRM effective date. Map images for unmapped and unmodernized areas cannot be used for regulatory purposes.



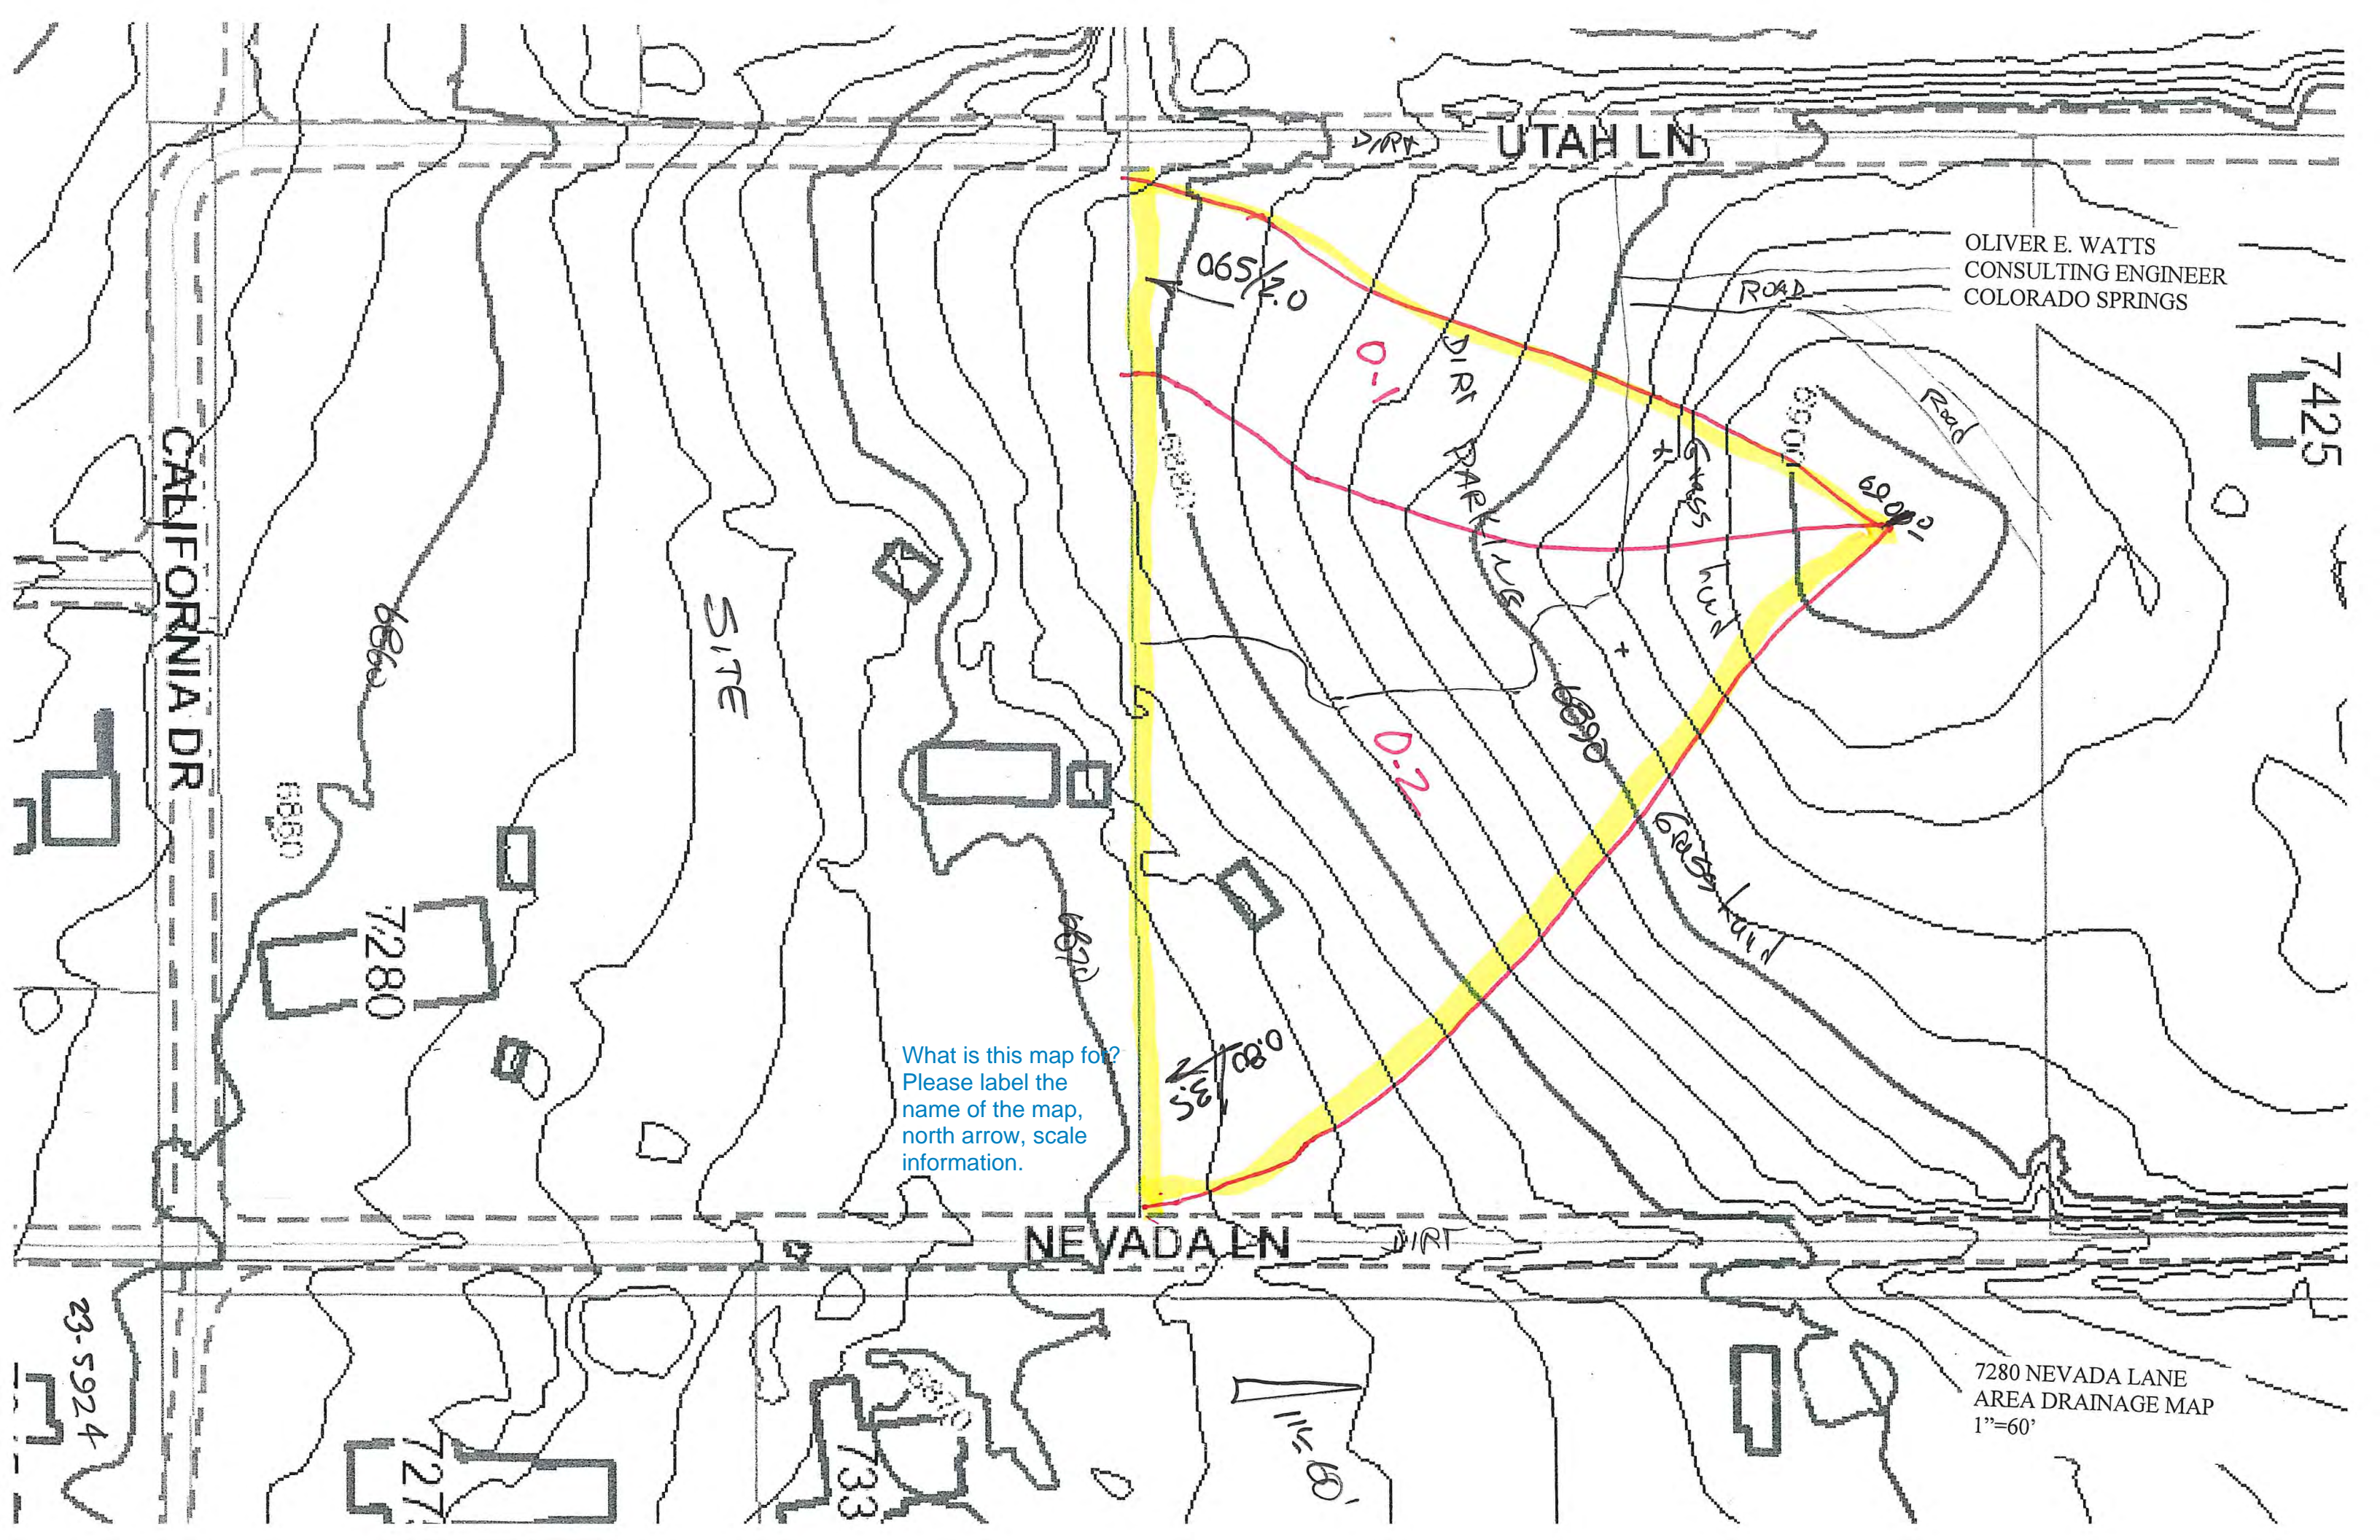

OLIVER E. WATTS  
CONSULTING ENGINEER  
COLORADO SPRINGS

7425

CALIFORNIA DR

UTAH LN

SITE

7280

NEVADA LN

What is this map for?  
Please label the  
name of the map,  
north arrow, scale  
information.

7280 NEVADA LANE  
AREA DRAINAGE MAP  
1"=60'

23-5924

727

733

7311

0.35/35'

0.65/2.0

0-1

0-2

DIRT PARKING

Grass knolls

Grass knoll

ROAD

Road

6800'

6800'

6890

6860

6850

6870

0

1

2

3

4

5

6

7

8

9

10

11


12

13

An existing drainage map is required.

FOR DETAILS IN THIS AREA, SEE OFFSITE DRAINAGE PLAN

From recent aerial imagery, the northwest corner of Basins B appears to be gravel, not bare soil. Please review and revise this map and calculations above where appropriate.

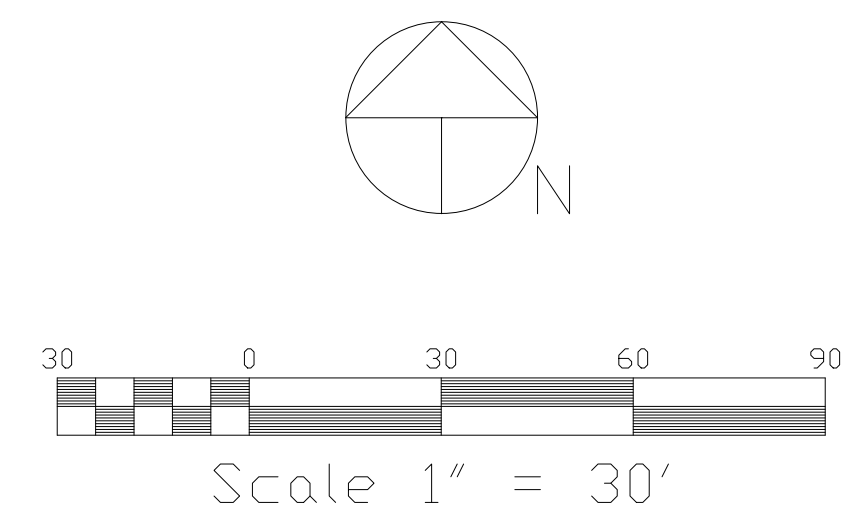

**LEGEND:**

- RUNOFF IN CFS 5-YEAR/100-YEAR
- LIMIT OF DRAINAGE BASIN AND DESIGNATION
- EXISTING STORM SEWER AS LABELED
- PROPOSED STORM SEWER AS LABELED
- LIMIT OF SOILS TYPE AND GROUP
- GROUND COVER
- DIRECTION OF RUNOFF

Please display and label the curb and gutter.

Please discuss proposed storm sewer in the text.



It appears that there is no proposed storm on the proposed drainage map. Please verify.

Please show ROW.

All proposed drainage basins, and design points need to be discussed in the text.

DRAINAGE BASIN SUMMARY			
BASIN	AREA - AC.	RUNOFF IN CFS	
		5-YEAR	100-YEAR
D-1	0.59	0.65	2.0
D-2	1.30	0.80	3.5
A	1.41	1.1	4.0
B	1.54	2.1	5.1
C	1.41	0.6	3.2
D	0.63	0.1	0.3
DESIGN POINTS			
	2.00	1.3	5.6
	2.84	2.8	8.5
	4.95	3.8	12.2

Please show all design points on the maps.

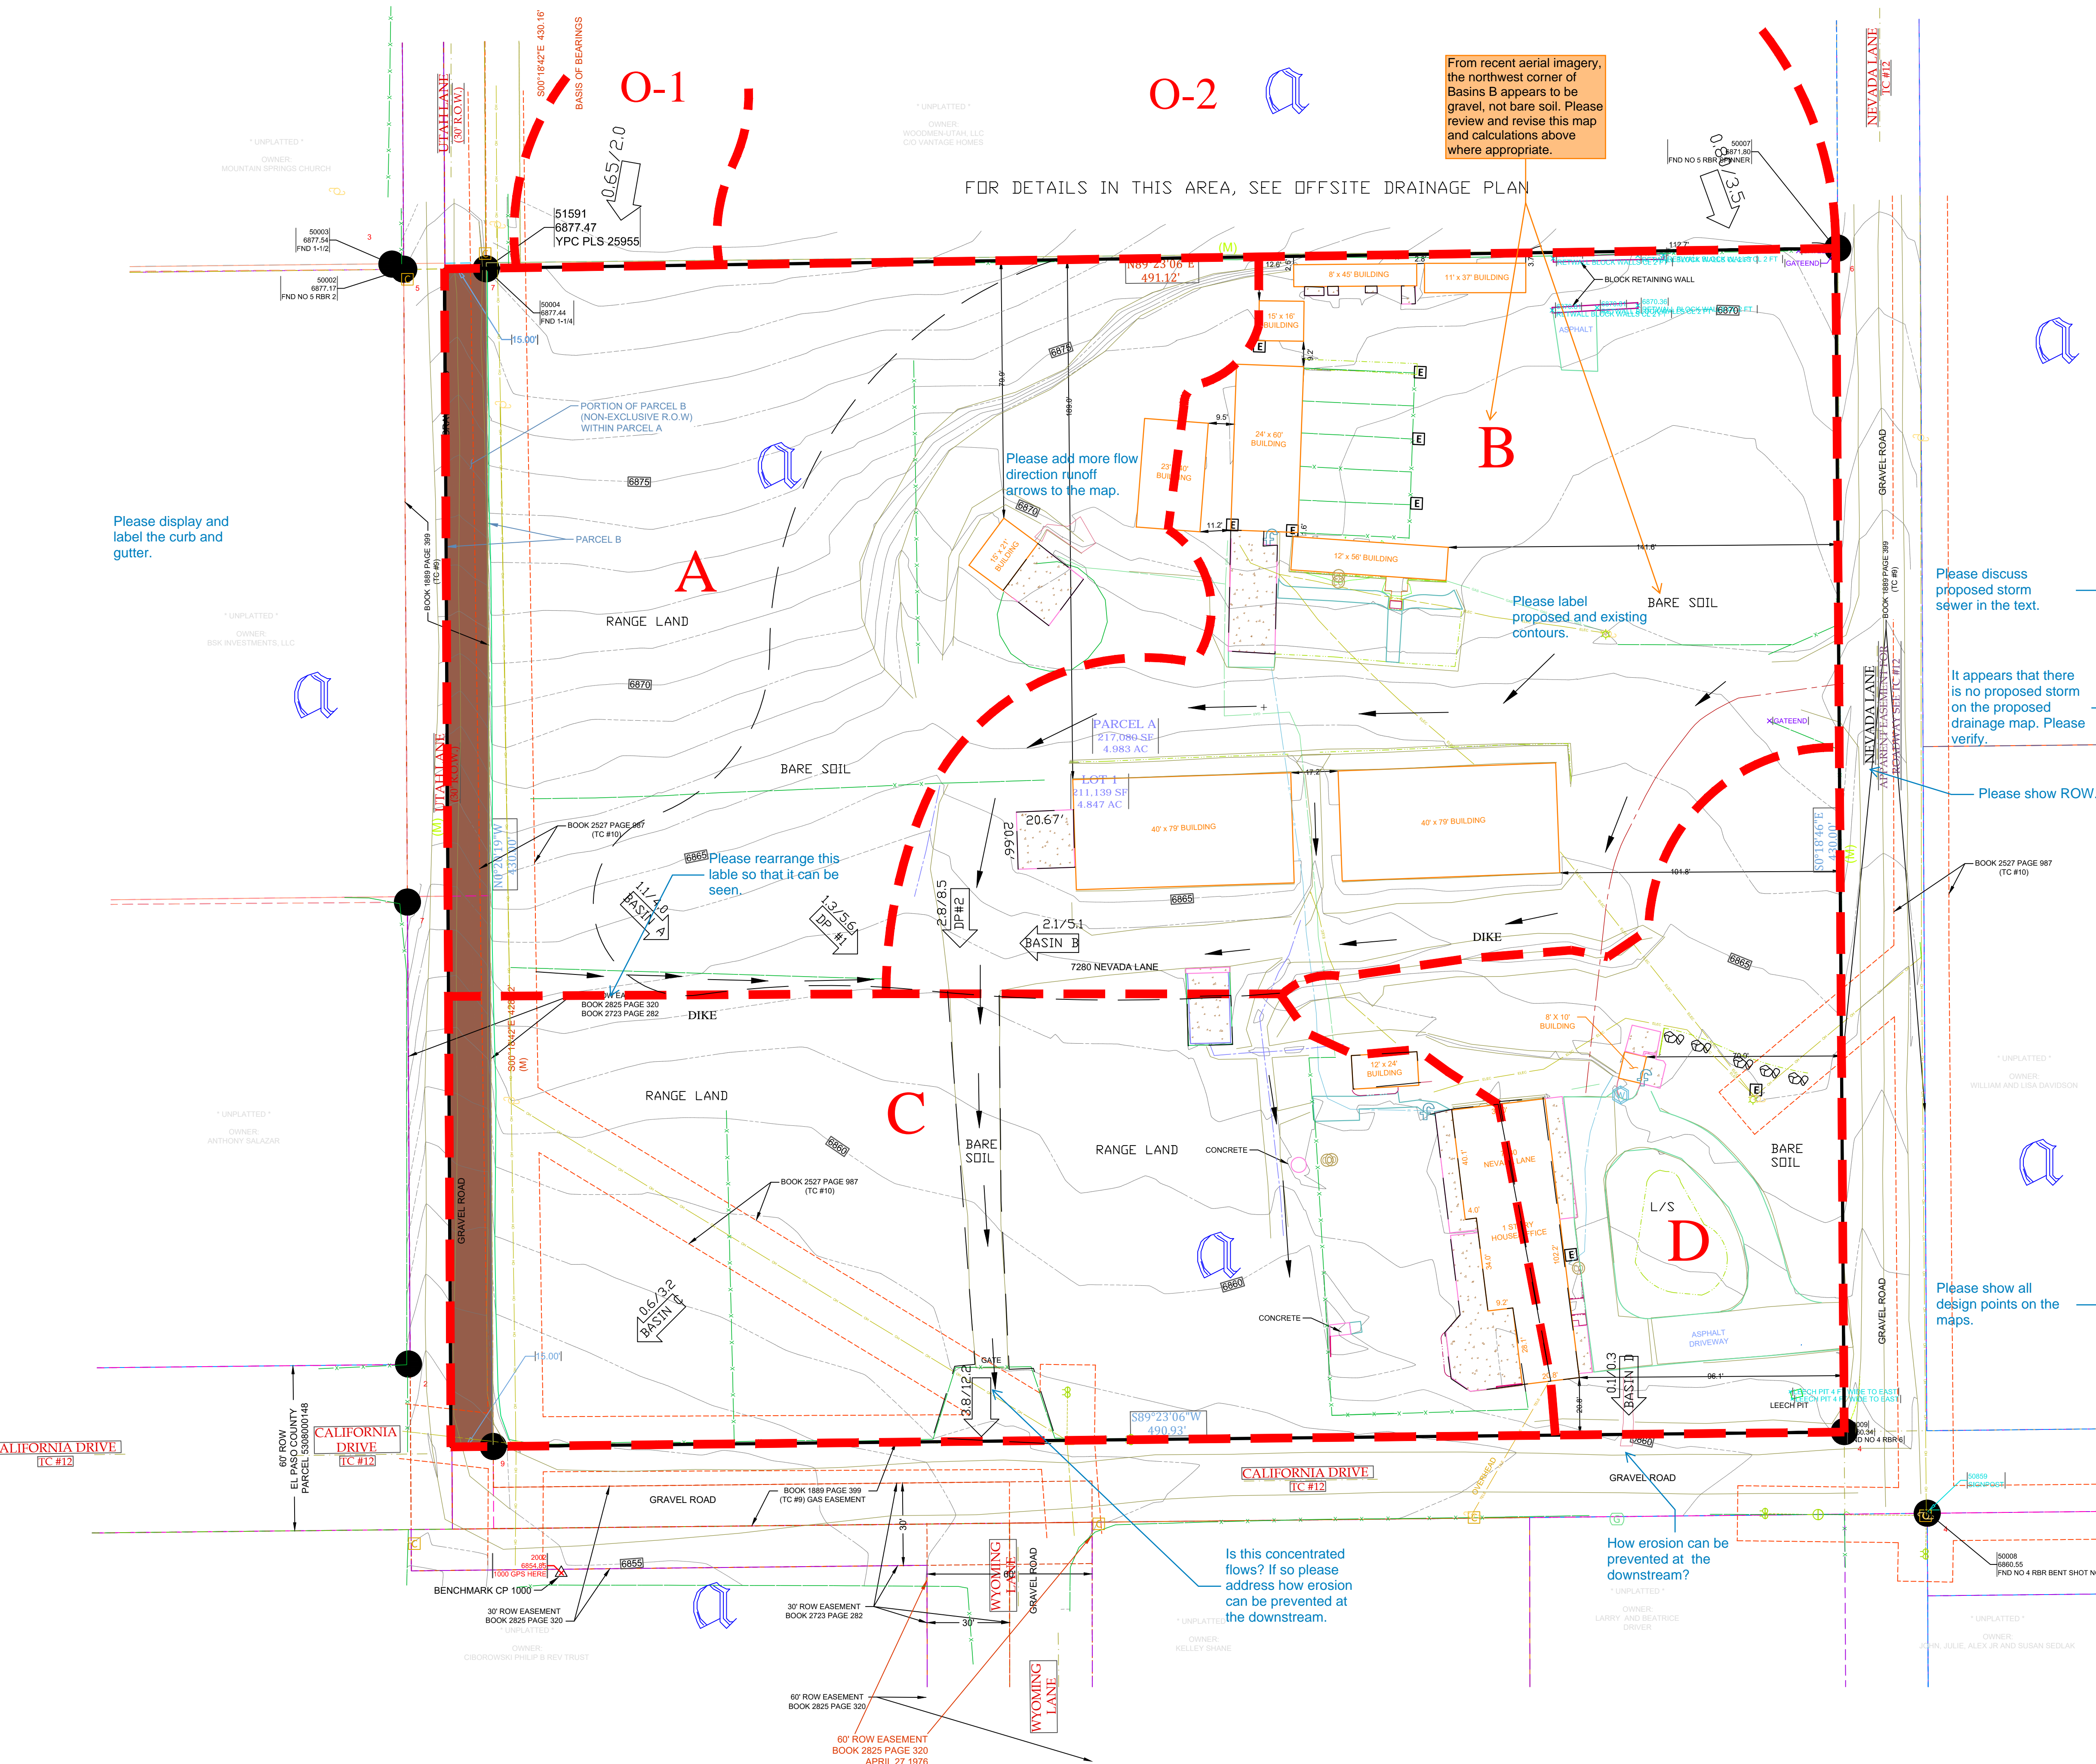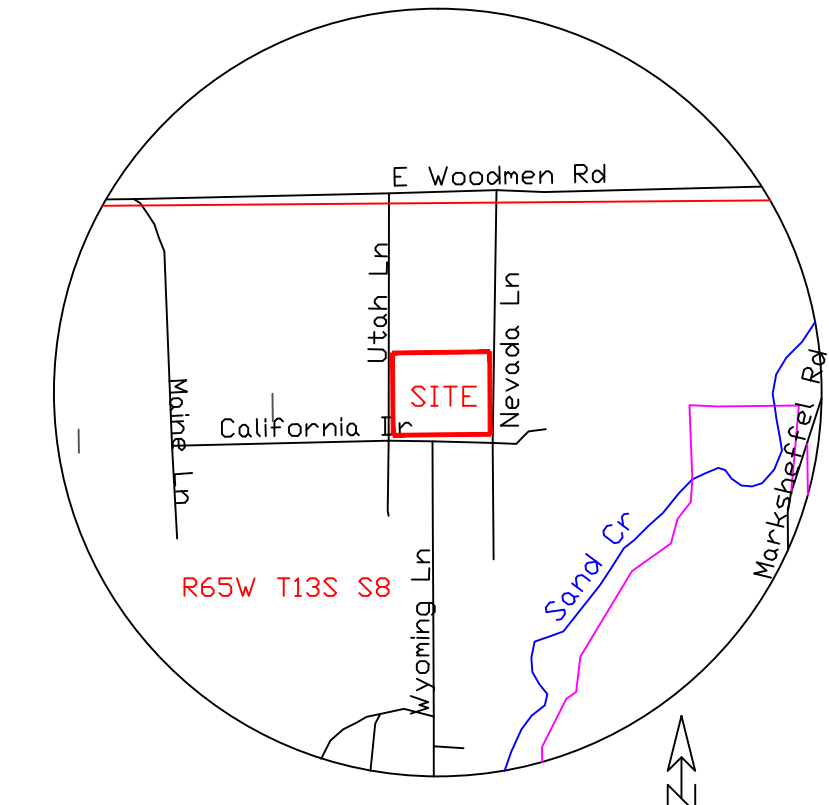

Is this concentrated flows? If so please address how erosion can be prevented at the downstream.

How erosion can be prevented at the downstream?

DRAWN BY: D.E. WATTS  
DATE: 11-2-23  
DWG. NO.: 23-5924-04

APPROVED BY:  
PROJ. NO.:  
DWG.:

REVISIONS

OLIVER E. WATTS  
CONSULTING ENGINEER  
COLORADO SPRINGS

PROJECT: 7280 NEVADA LANE  
P NW1/4, NE1/4 S.8, T.13S., R.65W. 6TH P.M.  
EL PASO COUNTY

SHT. NAME:

**DRAINAGE PLAN**

SHT. NO. 1 OF 1