

PRE-DEVELOPMENT GRADING AND EROSION CONTROL PLAN
WINSOME FILING NO 1
 A TRACT OF LAND BEING A PORTION OF SECTION 24, TOWNSHIP 11 SOUTH, RANGE 65 WEST,
 OF THE 6TH PRINCIPAL MERIDIAN, COUNTY OF EL PASO, STATE OF COLORADO



GENERAL CONSTRUCTION NOTES

- ALL DRAINAGE AND ROADWAY CONSTRUCTION SHALL MEET THE STANDARDS AND SPECIFICATIONS OF THE CITY OF COLORADO SPRINGS/EL PASO COUNTY DRAINAGE CRITERIA MANUAL, VOLUMES 1 AND 2, AND THE EL PASO COUNTY ENGINEERING CRITERIA MANUAL.
- CONTRACTOR SHALL BE RESPONSIBLE FOR THE NOTIFICATION AND FIELD NOTIFICATION OF ALL EXISTING UTILITIES, WHETHER SHOWN ON THE PLANS OR NOT, BEFORE BEGINNING CONSTRUCTION. LOCATION OF EXISTING UTILITIES SHALL BE VERIFIED BY THE CONTRACTOR PRIOR TO CONSTRUCTION. CALL 811 TO CONTACT THE UTILITY NOTIFICATION CENTER OF COLORADO (UNCC).
- CONTRACTOR SHALL KEEP A COPY OF THESE APPROVED PLANS, THE GRADING AND EROSION CONTROL PLAN, THE STORMWATER MANAGEMENT PLAN (SWMP), THE SOILS AND GEOTECHNICAL REPORT, AND THE APPROPRIATE DESIGN AND CONSTRUCTION STANDARDS AND SPECIFICATIONS AT THE JOB SITE AT ALL TIMES, INCLUDING THE FOLLOWING:
 - EL PASO COUNTY ENGINEERING CRITERIA MANUAL (ECM)
 - CITY OF COLORADO SPRINGS/EL PASO COUNTY DRAINAGE CRITERIA MANUAL, VOLUMES 1 AND 2
 - COLORADO DEPARTMENT OF TRANSPORTATION (CDOT) STANDARD SPECIFICATIONS FOR ROAD AND BRIDGE CONSTRUCTION CDOT M & S STANDARDS
- NOTWITHSTANDING ANYTHING DEPICTED IN THESE PLANS IN WORDS OR GRAPHIC REPRESENTATION, ALL DESIGN AND CONSTRUCTION RELATED TO ROADS, STORM DRAINAGE AND EROSION CONTROL SHALL CONFORM TO THE STANDARDS AND REQUIREMENTS OF THE MOST RECENT VERSION OF THE RELEVANT ADOPTED EL PASO COUNTY STANDARDS, INCLUDING THE LAND DEVELOPMENT CODE, THE ENGINEERING CRITERIA MANUAL, THE DRAINAGE CRITERIA MANUAL, AND THE DRAINAGE CRITERIA MANUAL VOLUME 2. ANY DEVIATIONS FROM REGULATIONS AND STANDARDS MUST BE REQUESTED, AND APPROVED, IN WRITING. ANY MODIFICATIONS NECESSARY TO MEET CRITERIA AFTER-THE-FACT WILL BE ENTIRELY THE DEVELOPER'S RESPONSIBILITY TO RECTIFY.
- IT IS THE DESIGN ENGINEER'S RESPONSIBILITY TO ACCURATELY SHOW EXISTING CONDITIONS, BOTH ONSITE AND OFFSITE, ON THE CONSTRUCTION PLANS. ANY MODIFICATIONS NECESSARY DUE TO CONFLICTS, OMISSIONS, OR CHANGED CONDITIONS WILL BE ENTIRELY THE DEVELOPER'S RESPONSIBILITY TO RECTIFY.
- CONTRACTOR SHALL SCHEDULE A PRE-CONSTRUCTION MEETING WITH EL PASO COUNTY PLANNING AND COMMUNITY DEVELOPMENT (PCD) - INSPECTIONS, PRIOR TO STARTING CONSTRUCTION.
- IT IS THE CONTRACTOR'S RESPONSIBILITY TO UNDERSTAND THE REQUIREMENTS OF ALL JURISDICTIONAL AGENCIES AND TO OBTAIN ALL REQUIRED PERMITS, INCLUDING BUT NOT LIMITED TO EL PASO COUNTY EROSION AND STORMWATER QUALITY CONTROL PERMIT (ESQCP), REGIONAL BUILDING FLOODPLAIN DEVELOPMENT PERMIT, U.S. ARMY CORPS OF ENGINEERS-ISSUED 401 AND/OR 404 PERMITS, AND COUNTY AND STATE FUGITIVE DUST PERMITS.
- CONTRACTOR SHALL NOT DEVIATE FROM THE PLANS WITHOUT FIRST OBTAINING WRITTEN APPROVAL FROM THE DESIGN ENGINEER AND PCD. CONTRACTOR SHALL NOTIFY THE DESIGN ENGINEER IMMEDIATELY UPON DISCOVERY OF ANY ERRORS OR INCONSISTENCIES.
- ALL STORM DRAIN PIPE SHALL BE CLASS III RCP UNLESS OTHERWISE NOTED AND APPROVED BY PCD.
- CONTRACTOR SHALL COORDINATE GEOTECHNICAL TESTING PER ECM STANDARDS. PAVEMENT DESIGN SHALL BE APPROVED BY EL PASO COUNTY PCD PAVEMENT.
- ALL CONSTRUCTION TRAFFIC MUST ENTER/EXIT THE SITE AT APPROVED CONSTRUCTION ACCESS POINTS.
- SIGHT VISIBILITY TRIANGLES AS IDENTIFIED IN THE PLANS SHALL BE PROVIDED AT ALL INTERSECTIONS. OBSTRUCTIONS GREATER THAN 18 INCHES ABOVE FLOWLINE ARE NOT ALLOWED WITHIN SIGHT TRIANGLES.
- SIGNING AND STRIPING SHALL COMPLY WITH EL PASO COUNTY DOT AND MUTCD CRITERIA.
- CONTRACTOR SHALL OBTAIN ANY PERMITS REQUIRED BY EL PASO COUNTY DOT, INCLUDING WORK WITHIN THE RIGHT-OF-WAY AND SPECIAL TRANSPORT PERMITS.
- THE LIMITS OF CONSTRUCTION SHALL REMAIN WITHIN THE PROPERTY LINE UNLESS OTHERWISE NOTED. THE OWNER/DEVELOPER SHALL OBTAIN WRITTEN PERMISSION AND EASEMENTS, WHERE REQUIRED, FROM ADJOINING PROPERTY OWNER(S) PRIOR TO ANY OFF-SITE DISTURBANCE, GRADING, OR CONSTRUCTION.
- THE CONTRACTOR SHALL BE RESPONSIBLE FOR CONDITIONS AT AND ADJACENT TO THE JOB SITE, INCLUDING SAFETY OF ALL PERSONS AND PROPERTY DURING PERFORMANCE OF THE WORK. THIS REQUIREMENT SHALL APPLY CONTINUOUSLY AND NOT BE LIMITED TO NORMAL WORKING HOURS.
- THE CONTRACTOR SHALL BE RESPONSIBLE FOR PROTECTING ALL ADJACENT IMPROVEMENTS FROM DAMAGE DURING CONSTRUCTION. ALL DISTURBED AREAS SHALL BE RESTORED TO THEIR ORIGINAL CONDITION UNLESS NOTED ON THE PLANS.
- THE CONTRACTOR SHALL PROTECT ALL EXISTING UTILITIES. CONTRACTOR SHALL CONTACT UTILITY NOTIFICATION CENTER OF COLORADO (1-800-922-1987) FOR LOCATION OF UNDERGROUND UTILITIES AT LEAST 48 HOURS PRIOR TO COMMENCEMENT OF CONSTRUCTION.
- CONSTRUCTION DEBRIS OR MUD TRACKING IN THE PUBLIC RIGHT OF WAY RESULTING FROM THIS DEVELOPMENT SHALL BE REMOVED IMMEDIATELY BY THE CONTRACTOR.
- THE EXISTING CONDITIONS AND PROPOSED IMPROVEMENTS AS SHOWN ON THESE CONSTRUCTION DOCUMENTS ARE BASED ON:
 - EXISTING TOPOGRAPHIC INFORMATION OBTAINED FROM EL PASO COUNTY LICENSED GIS DATA SERVICE. LIDAR DATA DATED 2011
 - ADDITIONAL SURVEY INFORMATION COMPILED BY EDWARD JAMES SURVEYING 8/2018
 - PRELIMINARY PLAN PREPARED BY NES DATED 5/10/2018
 - SUBDIVISION PLAT PREPARED BY EDWARD JAMES SURVEYING DATED XX/XX/XXXX
 - NATURAL FEATURES AND WETLAND REPORT PREPARED BY ECOSYSTEM SERVICES DATED 10/1/2018
 - SOILS INVESTIGATION PREPARED BY ENTECH DATED 1/11/2019
 - TRAFFIC IMPACT STUDY PREPARED BY KELLAR ENGINEERING DATED 1/9/2020
- ONLY USE CONSTRUCTION PLANS THAT ARE APPROVED FOR CONSTRUCTION. THE APPROVED PLANS WILL BE SIGNED AND SEALED BY THE ENGINEER OF RECORD, THE WORDS "FOR CONSTRUCTION" WILL APPEAR IN THE REVISION BLOCK AND WILL BE SIGNED BY THE APPROPRIATE GOVERNING AGENCY.

Add a note about existing vegetation or show existing vegetation on the plans.

Unresolved.

GRADING AND EROSION CONTROL PLANS

- STORMWATER DISCHARGES FROM CONSTRUCTION SITES SHALL NOT CAUSE OR THREATEN TO CAUSE POLLUTION, CONTAMINATION, OR DEGRADATION OF STATE WATERS. ALL WORK AND EARTH DISTURBANCE SHALL BE DONE IN A MANNER THAT MINIMIZES POLLUTION OF ANY ON-SITE OR OFF-SITE WATERS, INCLUDING WETLANDS.
- NOTWITHSTANDING ANYTHING DEPICTED IN THESE PLANS IN WORDS OR GRAPHIC REPRESENTATION, ALL DESIGN AND CONSTRUCTION RELATED TO ROADS, STORM DRAINAGE AND EROSION CONTROL SHALL CONFORM TO THE STANDARDS AND REQUIREMENTS OF THE MOST RECENT VERSION OF THE RELEVANT ADOPTED EL PASO COUNTY STANDARDS, INCLUDING THE LAND DEVELOPMENT CODE, THE ENGINEERING CRITERIA MANUAL, THE DRAINAGE CRITERIA MANUAL, AND THE DRAINAGE CRITERIA MANUAL VOLUME 2. ANY DEVIATIONS FROM REGULATIONS AND STANDARDS MUST BE REQUESTED, AND APPROVED, IN WRITING.
- A SEPARATE STORMWATER MANAGEMENT PLAN (SMWP) FOR THIS PROJECT SHALL BE COMPLETED AND AN EROSION AND STORMWATER QUALITY CONTROL PERMIT (ESQCP) ISSUED PRIOR TO COMMENCING CONSTRUCTION. MANAGEMENT OF THE SWMP DURING CONSTRUCTION IS THE RESPONSIBILITY OF THE DESIGNATED QUALIFIED STORMWATER MANAGER OR CERTIFIED EROSION CONTROL INSPECTOR. THE SWMP SHALL BE LOCATED ON SITE AT ALL TIMES DURING CONSTRUCTION AND SHALL BE KEPT UP TO DATE WITH WORK PROGRESS AND CHANGES IN THE FIELD.
- ONCE THE ESQCP IS APPROVED AND A "NOTICE TO PROCEED" HAS BEEN ISSUED, THE CONTRACTOR MAY INSTALL THE INITIAL STAGE EROSION AND SEDIMENT CONTROL MEASURES AS INDICATED ON THE APPROVED GEC. A PRECONSTRUCTION MEETING BETWEEN THE CONTRACTOR, ENGINEER, AND EL PASO COUNTY WILL BE HELD PRIOR TO ANY CONSTRUCTION. IT IS THE RESPONSIBILITY OF THE APPLICANT TO COORDINATE THE MEETING TIME AND PLACE WITH COUNTY STAFF.
- CONTROL MEASURES MUST BE INSTALLED PRIOR TO COMMENCEMENT OF ACTIVITIES THAT COULD CONTRIBUTE POLLUTANTS TO STORMWATER. CONTROL MEASURES FOR ALL SLOPES, CHANNELS, DITCHES, AND DISTURBED LAND AREAS SHALL BE INSTALLED IMMEDIATELY UPON COMPLETION OF THE DISTURBANCE.
- ALL TEMPORARY SEDIMENT AND EROSION CONTROL MEASURES SHALL BE MAINTAINED AND REMAIN IN EFFECTIVE OPERATING CONDITION UNTIL PERMANENT SOIL EROSION CONTROL MEASURES ARE IMPLEMENTED AND FINAL STABILIZATION IS ESTABLISHED. ALL PERSONS ENGAGED IN LAND DISTURBANCE ACTIVITIES SHALL ASSESS THE ADEQUACY OF CONTROL MEASURES AT THE SITE AND IDENTIFY IF CHANGES TO THOSE CONTROL MEASURES ARE NEEDED TO ENSURE THE CONTINUED EFFECTIVE PERFORMANCE OF THE CONTROL MEASURES. ALL CHANGES TO TEMPORARY SEDIMENT AND EROSION CONTROL MEASURES MUST BE INCORPORATED INTO THE STORMWATER MANAGEMENT PLAN.
- TEMPORARY STABILIZATION SHALL BE IMPLEMENTED ON DISTURBED AREAS AND STOCKPILES WHERE GROUND DISTURBING CONSTRUCTION ACTIVITY HAS PERMANENTLY CEASED OR TEMPORARILY CEASED FOR LONGER THAN 14 DAYS.
- FINAL STABILIZATION MUST BE IMPLEMENTED AT ALL APPLICABLE CONSTRUCTION SITES. FINAL STABILIZATION IS ACHIEVED WHEN ALL GROUND DISTURBING ACTIVITIES ARE COMPLETE AND ALL DISTURBED AREAS EITHER HAVE A UNIFORM VEGETATIVE COVER WITH INDIVIDUAL PLANT DENSITY OF 70 PERCENT OF PRE-DISTURBANCE LEVELS ESTABLISHED OR EQUIVALENT PERMANENT ALTERNATIVE STABILIZATION METHOD IS IMPLEMENTED. ALL TEMPORARY SEDIMENT AND EROSION CONTROL MEASURES SHALL BE REMOVED UPON FINAL STABILIZATION AND BEFORE PERMIT CLOSURE.
- ALL PERMANENT STORMWATER MANAGEMENT FACILITIES SHALL BE INSTALLED AS DESIGNED IN THE APPROVED PLANS. ANY PROPOSED CHANGES THAT AFFECT THE DESIGN OR FUNCTION OF PERMANENT STORMWATER MANAGEMENT STRUCTURES MUST BE APPROVED BY THE ECM ADMINISTRATOR PRIOR TO IMPLEMENTATION.
- EARTH DISTURBANCES SHALL BE CONDUCTED IN SUCH A MANNER SO AS TO EFFECTIVELY MINIMIZE ACCELERATED SOIL EROSION AND RESULTING SEDIMENTATION. ALL DISTURBANCES SHALL BE DESIGNED, CONSTRUCTED, AND COMPLETED SO THAT THE EXPOSED AREA OF ANY DISTURBED LAND SHALL BE LIMITED TO THE SHORTEST PRACTICAL PERIOD OF TIME. PRE-EXISTING VEGETATION SHALL BE PROTECTED AND MAINTAINED WITHIN 50 HORIZONTAL FEET OF A WATERS OF THE STATE UNLESS SHOWN TO BE INFEASIBLE AND SPECIFICALLY REQUESTED AND APPROVED.
- COMPACTION OF SOIL MUST BE PREVENTED IN AREAS DESIGNATED FOR INFILTRATION CONTROL MEASURES OR WHERE FINAL STABILIZATION WILL BE ACHIEVED BY VEGETATIVE COVER. AREAS DESIGNATED FOR INFILTRATION CONTROL MEASURES SHALL ALSO BE PROTECTED FROM SEDIMENTATION DURING CONSTRUCTION UNTIL FINAL STABILIZATION IS ACHIEVED. IF COMPACTION PREVENTION IS NOT FEASIBLE DUE TO SITE CONSTRAINTS, ALL AREAS DESIGNATED FOR INFILTRATION AND VEGETATION CONTROL MEASURES MUST BE LOOSENEED PRIOR TO INSTALLATION OF THE CONTROL MEASURE(S).
- ANY TEMPORARY OR PERMANENT FACILITY DESIGNED AND CONSTRUCTED FOR THE CONVEYANCE OF STORMWATER AROUND, THROUGH, OR FROM THE EARTH DISTURBANCE AREA SHALL BE A STABILIZED CONVEYANCE DESIGNED TO MINIMIZE EROSION AND THE DISCHARGE OF SEDIMENT OFF SITE.
- CONCRETE WASH WATER SHALL BE CONTAINED AND DISPOSED OF IN ACCORDANCE WITH THE SWMP. NO WASH WATER SHALL BE DISCHARGED TO OR ALLOWED TO ENTER STATE WATERS, INCLUDING ANY SURFACE OR SUBSURFACE STORM DRAINAGE SYSTEM OR FACILITIES. CONCRETE WASHOUTS SHALL NOT BE LOCATED IN AN AREA WHERE SHALLOW GROUNDWATER MAY BE PRESENT, OR WITHIN 50 FEET OF A SURFACE WATER BODY, CREEK OR STREAM.
- DURING DEWATERING OPERATIONS OF UNCONTAMINATED GROUND WATER MAY BE DISCHARGED ON SITE, BUT SHALL NOT LEAVE THE SITE IN THE FORM OF SURFACE RUNOFF UNLESS AN APPROVED STATE DEWATERING PERMIT IS IN PLACE.
- EROSION CONTROL BLANKETING OR OTHER PROTECTIVE COVERING SHALL BE USED ON SLOPES STEEPER THAN 3:1.
- CONTRACTOR SHALL BE RESPONSIBLE FOR THE REMOVAL OF ALL WASTES FROM THE CONSTRUCTION SITE FOR DISPOSAL IN ACCORDANCE WITH LOCAL AND STATE REGULATORY REQUIREMENTS. NO CONSTRUCTION DEBRIS, TREE SLASH, BUILDING MATERIAL WASTES OR UNUSED BUILDING MATERIALS SHALL BE BURIED, DUMPED, OR DISCHARGED AT THE SITE.
- WASTE MATERIALS SHALL NOT BE TEMPORARILY PLACED OR STORED IN THE STREET, ALLEY, OR OTHER PUBLIC WAY, UNLESS IN ACCORDANCE WITH AN APPROVED TRAFFIC CONTROL PLAN. CONTROL MEASURES MAY BE REQUIRED BY EL PASO COUNTY ENGINEERING IF DEEMED NECESSARY, BASED ON SPECIFIC CONDITIONS AND CIRCUMSTANCES.
- TRACKING OF SOILS AND CONSTRUCTION DEBRIS OFF-SITE SHALL BE MINIMIZED. MATERIALS TRACKED OFF-SITE SHALL BE CLEANED UP AND PROPERLY DISPOSED OF IMMEDIATELY.
- THE OWNER/DEVELOPER SHALL BE RESPONSIBLE FOR THE REMOVAL OF ALL CONSTRUCTION DEBRIS, DIRT, TRASH, ROCK, SEDIMENT, SOIL, AND SAND THAT MAY ACCUMULATE IN ROADS, STORM DRAINS AND OTHER DRAINAGE CONVEYANCE SYSTEMS AND STORMWATER APURTANCES AS A RESULT OF SITE DEVELOPMENT.
- THE QUANTITY OF MATERIALS STORED ON THE PROJECT SITE SHALL BE LIMITED, AS MUCH AS PRACTICAL, TO THAT QUANTITY REQUIRED TO PERFORM THE WORK IN AN ORDERLY SEQUENCE. ALL MATERIALS STORED ON-SITE SHALL BE STORED IN A NEAT, ORDERLY MANNER, IN THEIR ORIGINAL CONTAINERS, WITH ORIGINAL MANUFACTURER'S LABELS.
- NO CHEMICAL(S) HAVING THE POTENTIAL TO BE RELEASED IN STORMWATER ARE TO BE STORED OR USED ONSITE UNLESS PERMISSION FOR THE USE OF SUCH CHEMICAL(S) IS GRANTED IN WRITING BY THE ECM ADMINISTRATOR. IN GRANTING APPROVAL FOR THE USE OF SUCH CHEMICAL(S), SPECIAL CONDITIONS AND MONITORING MAY BE REQUIRED.
- BULK STORAGE OF ALLOWED PETROLEUM PRODUCTS OR OTHER ALLOWED LIQUID CHEMICALS IN EXCESS OF 55 GALLONS SHALL REQUIRE ADEQUATE SECONDARY CONTAINMENT PROTECTION TO CONTAIN ALL SPILLS ONSITE AND TO PREVENT ANY SPILLED MATERIALS FROM ENTERING STATE WATERS, ANY SURFACE OR SUBSURFACE STORM DRAINAGE SYSTEM OR OTHER FACILITIES.
- NO PERSON SHALL CAUSE THE IMPEDIMENT OF STORMWATER FLOW IN THE CURB AND GUTTER OR DITCH EXCEPT WITH APPROVED SEDIMENT CONTROL MEASURES.
- OWNER/DEVELOPER AND THEIR AGENTS SHALL COMPLY WITH THE "COLORADO WATER QUALITY CONTROL ACT" (TITLE 25, ARTICLE 8, CRS), AND THE "CLEAN WATER ACT" (33 USC 1344), IN ADDITION TO THE REQUIREMENTS OF THE LAND DEVELOPMENT CODE, DCM VOLUME II AND THE ECM APPENDIX I. ALL APPROPRIATE PERMITS MUST BE OBTAINED BY THE CONTRACTOR PRIOR TO CONSTRUCTION (1041, NPDES, FLOODPLAIN, 404, FUGITIVE DUST, ETC.). IN THE EVENT OF CONFLICTS BETWEEN THESE REQUIREMENTS AND OTHER LAWS, RULES, OR REGULATIONS OF OTHER FEDERAL, STATE, LOCAL, OR COUNTY AGENCIES, THE MOST RESTRICTIVE LAWS, RULES, OR REGULATIONS SHALL APPLY.
- ALL CONSTRUCTION TRAFFIC MUST ENTER/EXIT THE SITE ONLY AT APPROVED CONSTRUCTION ACCESS POINTS.
- PRIOR TO CONSTRUCTION THE PERMITTEE SHALL VERIFY THE LOCATION OF EXISTING UTILITIES.
- A WATER SOURCE SHALL BE AVAILABLE ON SITE DURING EARTHWORK OPERATIONS AND SHALL BE UTILIZED AS REQUIRED TO MINIMIZE DUST FROM EARTHWORK EQUIPMENT AND WIND.
- THE SOILS REPORT FOR THIS SITE HAS BEEN PREPARED BY ENTECH DATED 1/11/2019, AND SHALL BE CONSIDERED A PART OF THESE PLANS.
- AT LEAST TEN (10) DAYS PRIOR TO THE ANTICIPATED START OF CONSTRUCTION, FOR PROJECTS THAT WILL DISTURB ONE (1) ACRE OR MORE, THE OWNER OR OPERATOR OF CONSTRUCTION ACTIVITY SHALL SUBMIT A PERMIT APPLICATION FOR STORMWATER DISCHARGE TO THE COLORADO DEPARTMENT OF PUBLIC HEALTH AND ENVIRONMENT, WATER QUALITY DIVISION. THE APPLICATION CONTAINS CERTIFICATION OF COMPLETION OF A STORMWATER MANAGEMENT PLAN (SWMP), OF WHICH THIS GRADING AND EROSION CONTROL PLAN MAY BE A PART. FOR INFORMATION OR APPLICATION MATERIALS CONTACT:
 COLORADO DEPARTMENT OF PUBLIC HEALTH AND ENVIRONMENT
 WATER QUALITY CONTROL DIVISION
 WQCD - PERMITS
 4300 CHERRY CREEK DRIVE SOUTH
 DENVER, CO 80246-1530
 ATTN: PERMITS UNIT

GRADING AND EROSION CONTROL PLANS

- GRADING PLAN IS FOR ROUGH GRADING ONLY. CHANGES MAY BE NECESSARY TO BRING PLAN INTO CONFORMANCE WITH APPROVED FINAL DRAINAGE PLAN AND SITE PLAN.
- ANY SETTLEMENT OR SOIL ACCUMULATIONS BEYOND THE PROPERTY LIMITS DUE TO GRADING OR EROSION SHALL BE REPAIRED IMMEDIATELY BY THE CONTRACTOR.
- AREAS BEING DISTURBED BY THE GRADING SHALL BE RE-SEEDED WITH NATIVE VEGETATION OR AS APPROVED ON THE EROSION CONTROL PLAN.
- THE CONTRACTOR SHALL BE SOLELY AND COMPLETELY RESPONSIBLE FOR CONDITIONS AT AND ADJACENT TO THE JOB SITE, INCLUDING SAFETY OF ALL PERSONS AND PROPERTY DURING PERFORMANCE OF THE WORK. THIS REQUIREMENT SHALL APPLY CONTINUOUSLY AND NOT BE LIMITED TO NORMAL WORKING HOURS. THE DUTY OF THE COUNTY TO CONDUCT CONSTRUCTION REVIEW OF THE CONTRACTOR'S PERFORMANCE IS NOT INTENDED TO INCLUDE REVIEW OF THE ADEQUACY OF THE CONTRACTOR'S SAFETY MEASURES IN, ON, OR NEAR THE CONSTRUCTION SITE.
- DITCH SECTIONS WITH VELOCITIES OVER 4 CFS WILL BE LINED WITH EROSION CONTROL FABRIC. SEE TABLE BELOW FOR DETAILS.

ROADSIDE DITCH Q 100Y VALUES															
DITCH SECTION DESIGNATOR	START STATION	END STATION	LENGTH	GRADE	WATER SHED FROM ROAD	FRACTION OF BASIN FLOW	BASIN DESIGNATOR	BASIN 100Y Q	DITCH FRACTION OF Q	DITCH 100Y Q FROM BASIN	ROAD WATERSHED 100Y Q	CONNECTING DITCH 100Y Q	TOTAL 100Y Q IN DITCH SECTION	AVERAGE VELOCITY	MAX SHEER
	(FT)	(FT)	(FT)	%				(CFS)	%	(CFS)	(CFS)	(CFS)	(CFS)	(FPS)	(LB/FT2)
WINSOME WAY															
B2-3	+32	5+14	482'	4.83%	X		B2				1.69		1.69	3.00	1.13
B4-3.1	5+14	6+60	146'	3.85%	X		B4				0.51		0.51	3.52	1.36
B4-3.2	6+60	9+50	290'	7.89%	X		B5				1.01	0.51	1.52	3.51	1.62
B4-3.3	9+50	18+00	850'	3.22%	X		B6				2.97	1.52	4.50	3.29	1.18
B4-4	18+00	20+96	296'	1.00%	X		B4				1.03		1.03	1.47	0.26
C2-1.1	+32	6+10	578'	3.85%	X		C2				2.02		2.02	2.65	1.01
C2-1.2	6+10	10+17	407'	7.89%	X		C2				1.42	2.02	3.44	4.30	2.90
C3-3	10+17	18+00	783'	3.22%	X		C3				2.74	6.45	9.19	3.93	1.54
C3-4	18+00	20+96	296'	1.00%	X		C4				1.03		1.03	1.47	0.26
ALAMAR WAY															
C3-5	70+00	78+93	893'	1.43%	X	X	C3	22.1	10%	2.21	3.12		5.33	2.42	0.60
D2-1	78+93	84+31	538'	3.72%	X	X	D2	81.3	2%	1.63	1.88		3.51	3.39	1.27
D5-1	78+93	84+31	538'	3.72%	X		D5				1.88		1.88	2.79	0.95
C4-1	70+00	78+93	893'	1.43%	X		C4				3.12		3.12	2.21	0.53
BISON MEADOWS CT															
D2-3.1	+8	5+50	542'	1.37%	X	X		81.3	1%	0.81	1.90	7.29	10.00	2.92	0.79
D2-3.2	5+50	24+02	1852'	3.47%	X	X		81.3	1%	0.81	6.48		7.29	3.82	1.50
D3.4.6-1.1	5+50	24+02	1852'	3.47%	X						6.48		6.48	3.71	1.43
D3.4.6-2.2	+8	5+50	542'	1.37%	X						1.90	6.48	8.37	2.79	0.74
CLOVE HITCH CT															
B2-1	+14	5+80	566'	5.34%			B2	19.9	10%	1.99	1.98		3.97	3.85	1.69
B2-2	5+80	7+82	202'	1.13%			B2	19.9	20%	3.98	0.71		4.69	2.37	0.57
B4-1	5+80	7+82	202'	1.13%			B4	53.1			0.71		0.71	1.48	0.28
B4-2	+14	5+80	566'	5.34%			B4	53.1			1.98		1.98	3.24	1.30
MOSEY TRAIL															
C2-2.1	+14	2+74	260'	1.43%	X	X	C2	23.7	5%	1.19	0.91		2.09	2.00	0.46
C2-2.2	2+74	5+25	251'	1.03%	X	X	C2	23.7	10%	2.37	0.88		3.25	2.16	0.50
C2-3	5+25	14+60	935'	7.03%	X	X	C2	23.7	40%	9.48	3.27		12.75	3.34	0.45
C3-1	5+25	14+60	935'	7.03%	X		C3	22.1			3.27		3.27	2.38	0.67
C3-2.1	2+74	5+25	251'	1.03%	X		C3	22.1			0.88		0.88	1.56	0.31
C3-2.2	+14	2+74	260'	1.43%	X		C3	22.1			0.91		0.91	2.26	0.33

Q PER FOOT FOR 1' X 20' (HALF OF ROAD SECTION TO DITCH X 1' WIDE) = 0.00349671716220391 CFS

EGP-20-001



NOTES
 SITE: 17480 MERIDIAN ROAD
 ELBERT, COLORADO 80106
 FOR: WINSOME, LLC
 1864 WOODMORE DR, SUITE 100
 MONUMENT, COLORADO 80132

NO.	REVISIONS
1	SUBMITTAL 1
2	03.11.2020 REVISED PER COMMENTS
3	
4	
5	
6	
7	
8	
9	
10	

DATE: 01.22.20
 DRAWN BY: JCP
 CHECKED BY: LPV
 JOB #: 49388.01

Z:\Shared\Projects\49000-49999\49300-49399\49388-MCC-Une Ranch\06-Engineering\Vertex Drawings\Early Grading\Filing 1\49388_GFC_E1_Cover_Notes.dwg Sunday, March 29, 2020 9:56:57 PM
 Copyright © 2020 The Vertex Companies, Inc.

PRE-DEVELOPMENT GRADING AND EROSION CONTROL PLAN
WINSOME FILING NO 1
 A TRACT OF LAND BEING A PORTION OF SECTION 24, TOWNSHIP 11 SOUTH, RANGE 65 WEST,
 OF THE 6TH PRINCIPAL MERIDIAN, COUNTY OF EL PASO, STATE OF COLORADO




VERTIX
 2420 W. 26th Avenue, Suite 100-D | Denver, CO 80211
 Main: 303.623.9116 | VERTEXENG.COM




SITE PLAN
 SITE: 17480 MERIDIAN ROAD
 ELBERT, COLORADO 80106
 FOR: WINSOME, LLC
 1864 WOODMORE DR, SUITE 100
 MONUMENT, COLORADO 80132

NO.	REVISIONS
1	SUBMITTAL 1
2	03.11.2020 REVISED PER COMMENTS
3	
4	
5	
6	
7	
8	
9	
10	

DATE: 01.22.20
 DRAWN BY: JCP
 CHECKED BY: LPV
 JOB #: 49388.01

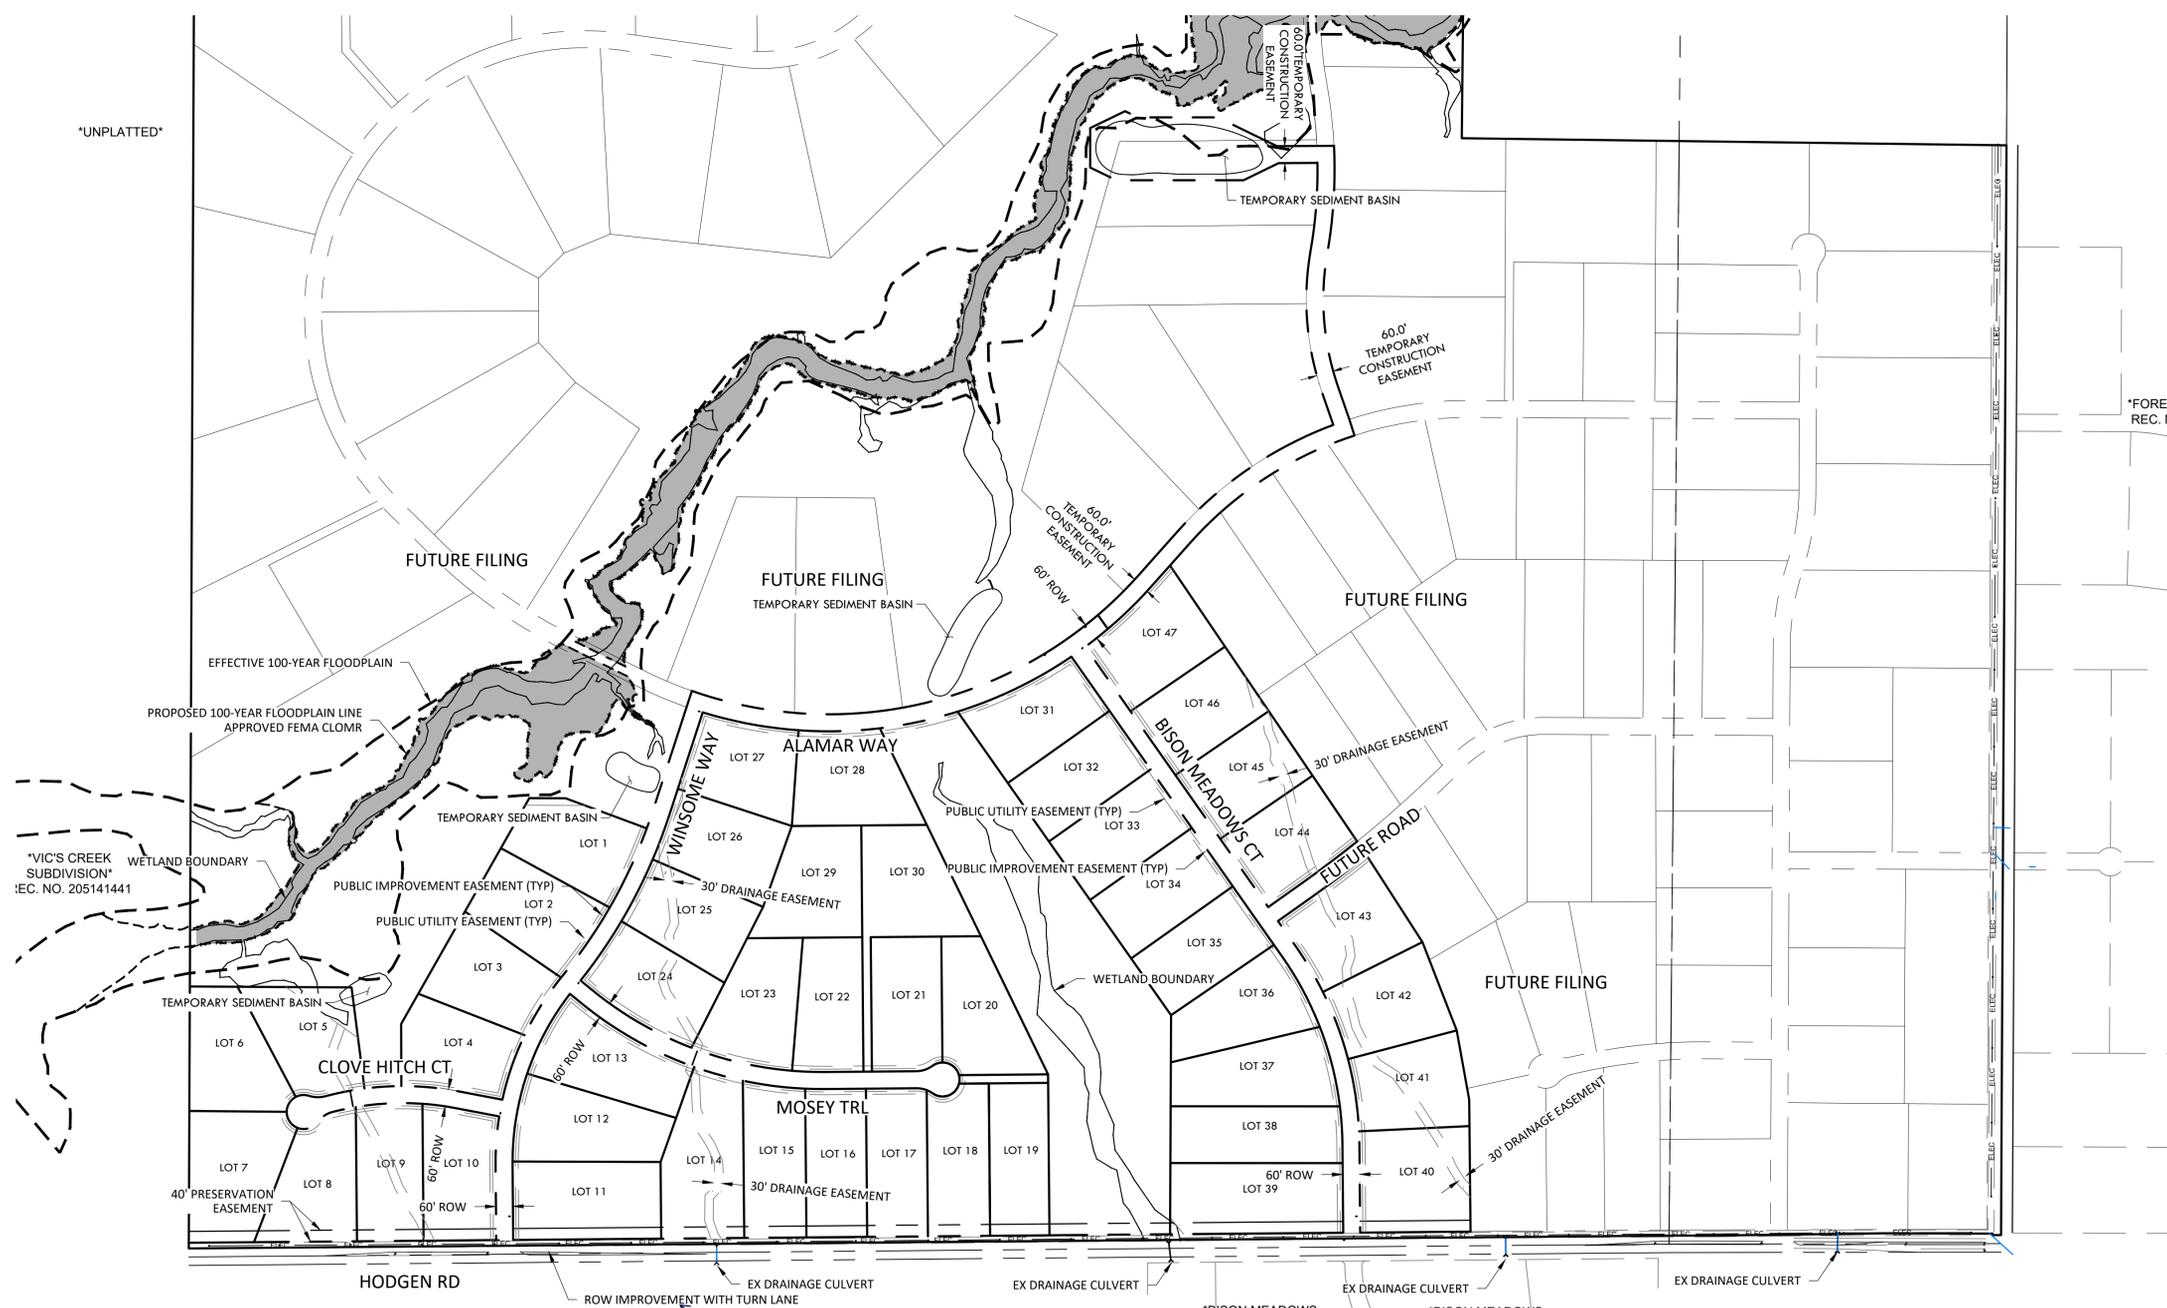

Remove callouts for proposed permanent infrastructure improvements with this application.
 Unresolved. Not part of early grading. This will be included with the final plat improvements.

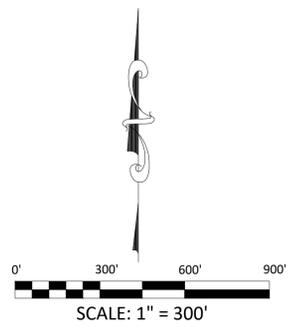


Z:\Shared\Projects\49000-49999\49300-49399\49388-McCune Ranch\06-Engineering\Vertex Drawings\Early Grading\Vertex\49388-GEC_F1_Site Plan.dwg Sunday, March 29, 2020 5:57:10 PM
 Copyright © 2020 The Vertix Companies, Inc.

PRE-DEVELOPMENT GRADING AND EROSION CONTROL PLAN
WINSOME FILING NO 1
 A TRACT OF LAND BEING A PORTION OF SECTION 24, TOWNSHIP 11 SOUTH, RANGE 65 WEST,
 OF THE 6TH PRINCIPAL MERIDIAN, COUNTY OF EL PASO, STATE OF COLORADO



VERTeX
 2420 W. 26th Avenue, Suite 100-D | Denver, CO 80211
 Main: 303.623.9116 | VERTEXENG.COM

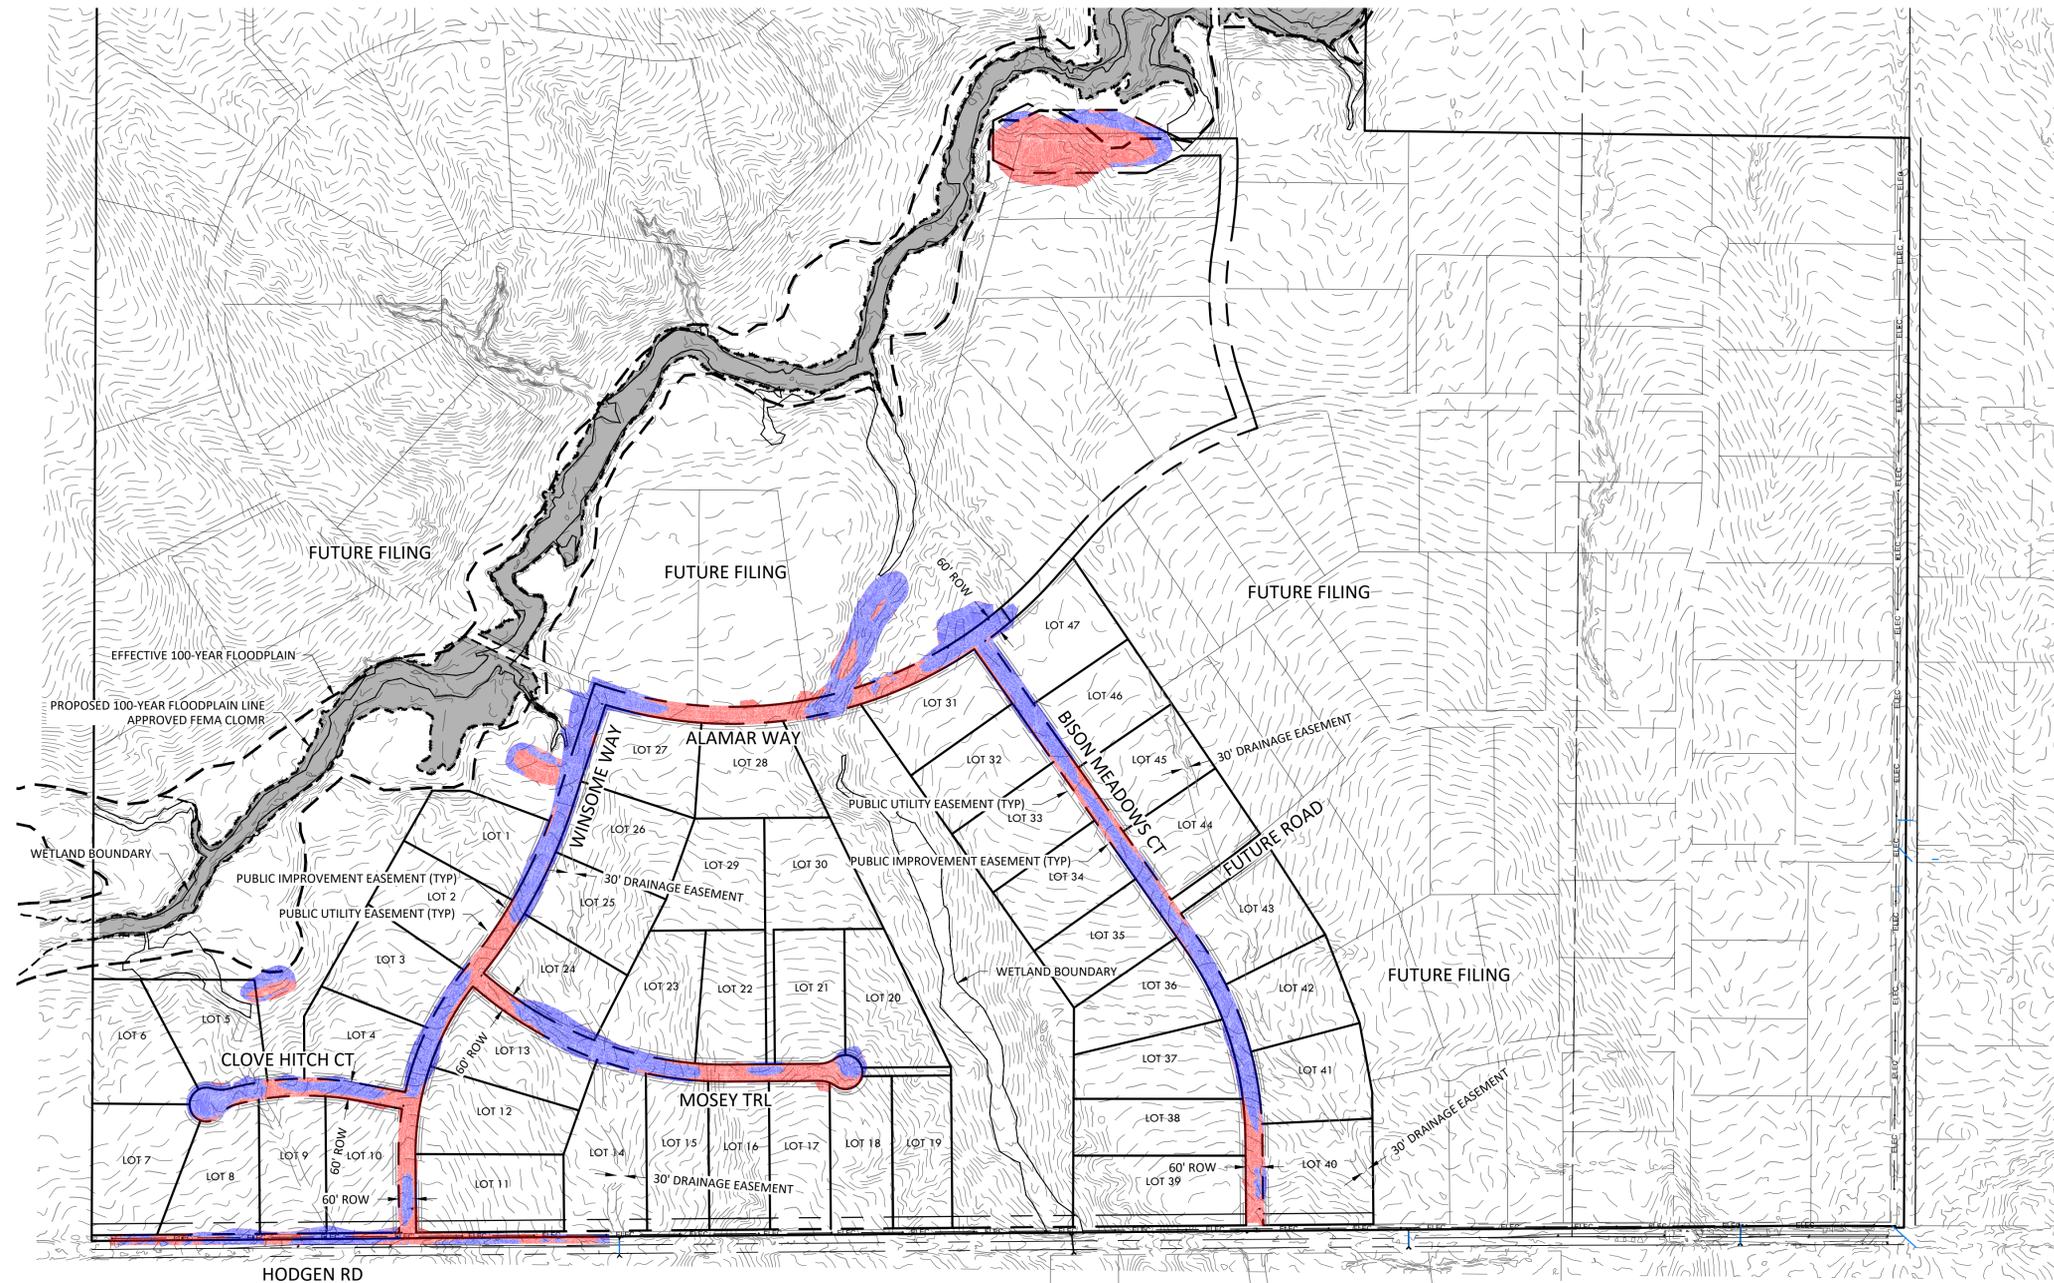


EARTH WORK QUANTITIES

CLEAR AND GRUB	6,800 SY
RAW CUT	51,000 CY
RAW FILL	49,000 CY
10% COMPACTION	5,000 CY
IMPORT	3,000 CY

KEY

CUT	
FILL	

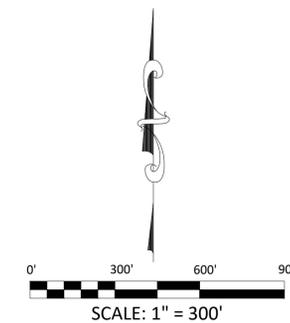

CUT FILL PLAN

SITE: 17480 MERIDIAN ROAD
 ELBERT, COLORADO 80106

FOR: WINSOME, LLC
 1864 WOODMORE DR, SUITE 100
 MONUMENT, COLORADO 80132

NO.	REVISIONS
1	SUBMITTAL 1
2	03.11.2020 REVISED PER COMMENTS
3	
4	
5	
6	
7	
8	
9	
10	


DATE: 01.22.20	4
DRAWN BY: JCP	
CHECKED BY: LPV	
JOB #: 49388.01	

EGP-20-001


PRE-DEVELOPMENT GRADING AND EROSION CONTROL PLAN
WINSOME FILING NO 1
 A TRACT OF LAND BEING A PORTION OF SECTION 24, TOWNSHIP 11 SOUTH, RANGE 65 WEST,
 OF THE 6TH PRINCIPAL MERIDIAN, COUNTY OF EL PASO, STATE OF COLORADO



VERTIX
 2420 W. 26th Avenue, Suite 100-D | Denver, CO 80211
 Main: 303.623.9116 | VERTIXENG.COM

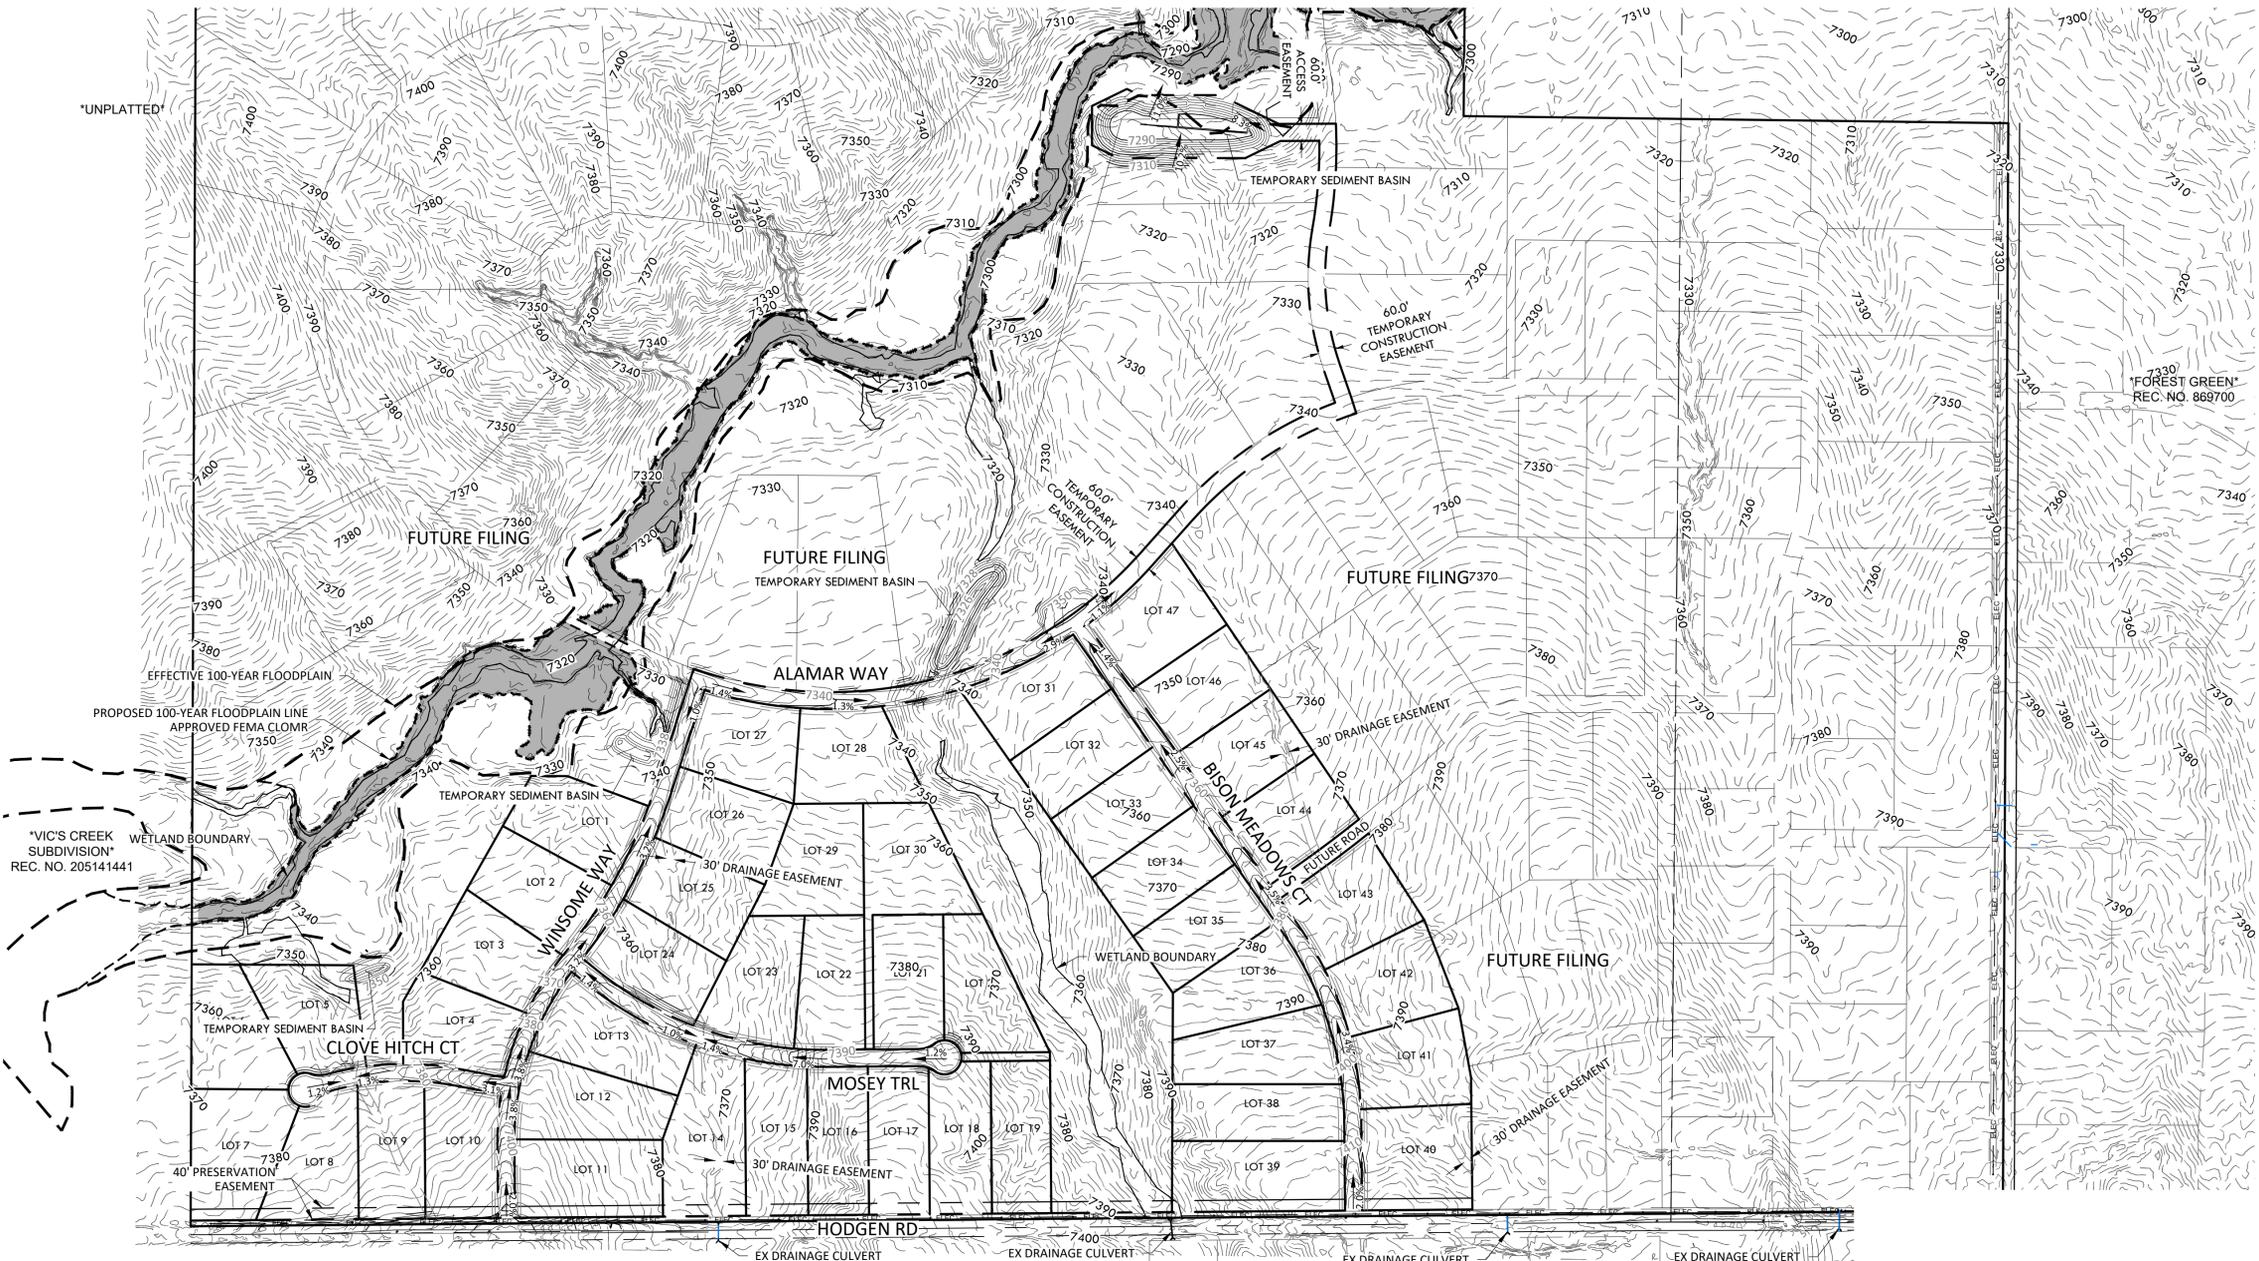

Z:\Shared\Projects\49000-49999\49300-49388\49388-MCC-one Ranch\06-Engineering\VerteX Drawings\Early Grading\Filing_1\49388-GE_C_F1_Grading.dwg Sunday, March 29, 2020 9:58:02 PM Copyright © 2020 The VerteX Companies, Inc.


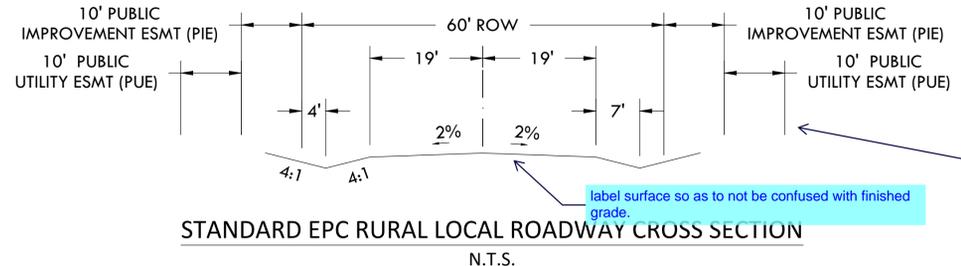


- NOTES:
- EXISTING FLOODPLAIN AS SHOWN BASED ON FIRM MAP #08041C0350G PANEL 350 REVISED 12/7/2018
 - REPLANT ALL DISTURBED AREAS WITH COUNTY APPROVED SEED MIX.

Revise to only identify the rough grading.
 Two options for the grading shown:
 Option 1: Revise contours to show the rough grading elevation
 Option 2: Update the detail to show the rough grading relative to the finished grade contours depicted on the plan.

Example to the right.

Unresolved. It appears plans are showing option 1. Therefore, label to identify as subgrade or rough grading surface.

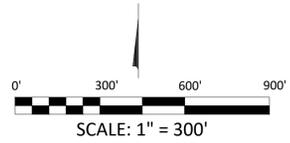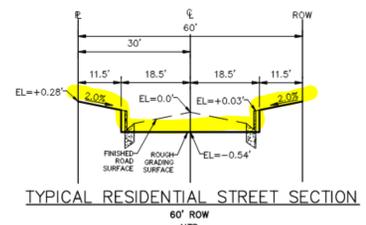

OVERALL GRADING PLAN


SITE: 17480 MERIDIAN ROAD
 ELBERT, COLORADO 80106

FOR: WINSOME, LLC
 1864 WOODMORE DR, SUITE 100
 MONUMENT, COLORADO 80132

NO.	REVISIONS
1	SUBMITTAL 1
2	03.11.2020 REVISED PER COMMENTS
3	
4	
5	
6	
7	
8	
9	
10	

DATE: 01.22.20	5
DRAWN BY: JCP	
CHECKED BY: LPV	
JOB #: 49388.01	


EGP-20-001

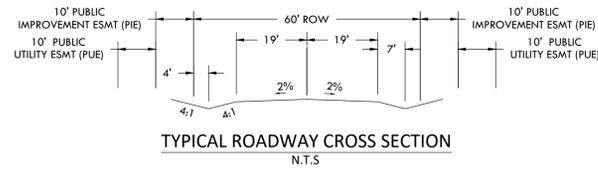



PRE-DEVELOPMENT GRADING AND EROSION CONTROL PLAN
WINSOME FILING NO 1
 A TRACT OF LAND BEING A PORTION OF SECTION 24, TOWNSHIP 11 SOUTH, RANGE 65 WEST,
 OF THE 6TH PRINCIPAL MERIDIAN, COUNTY OF EL PASO, STATE OF COLORADO



VERTIX
 2420 W. 26th Avenue, Suite 100-D | Denver, CO 80211
 Main: 303.623.9116 | VERTEXENG.COM

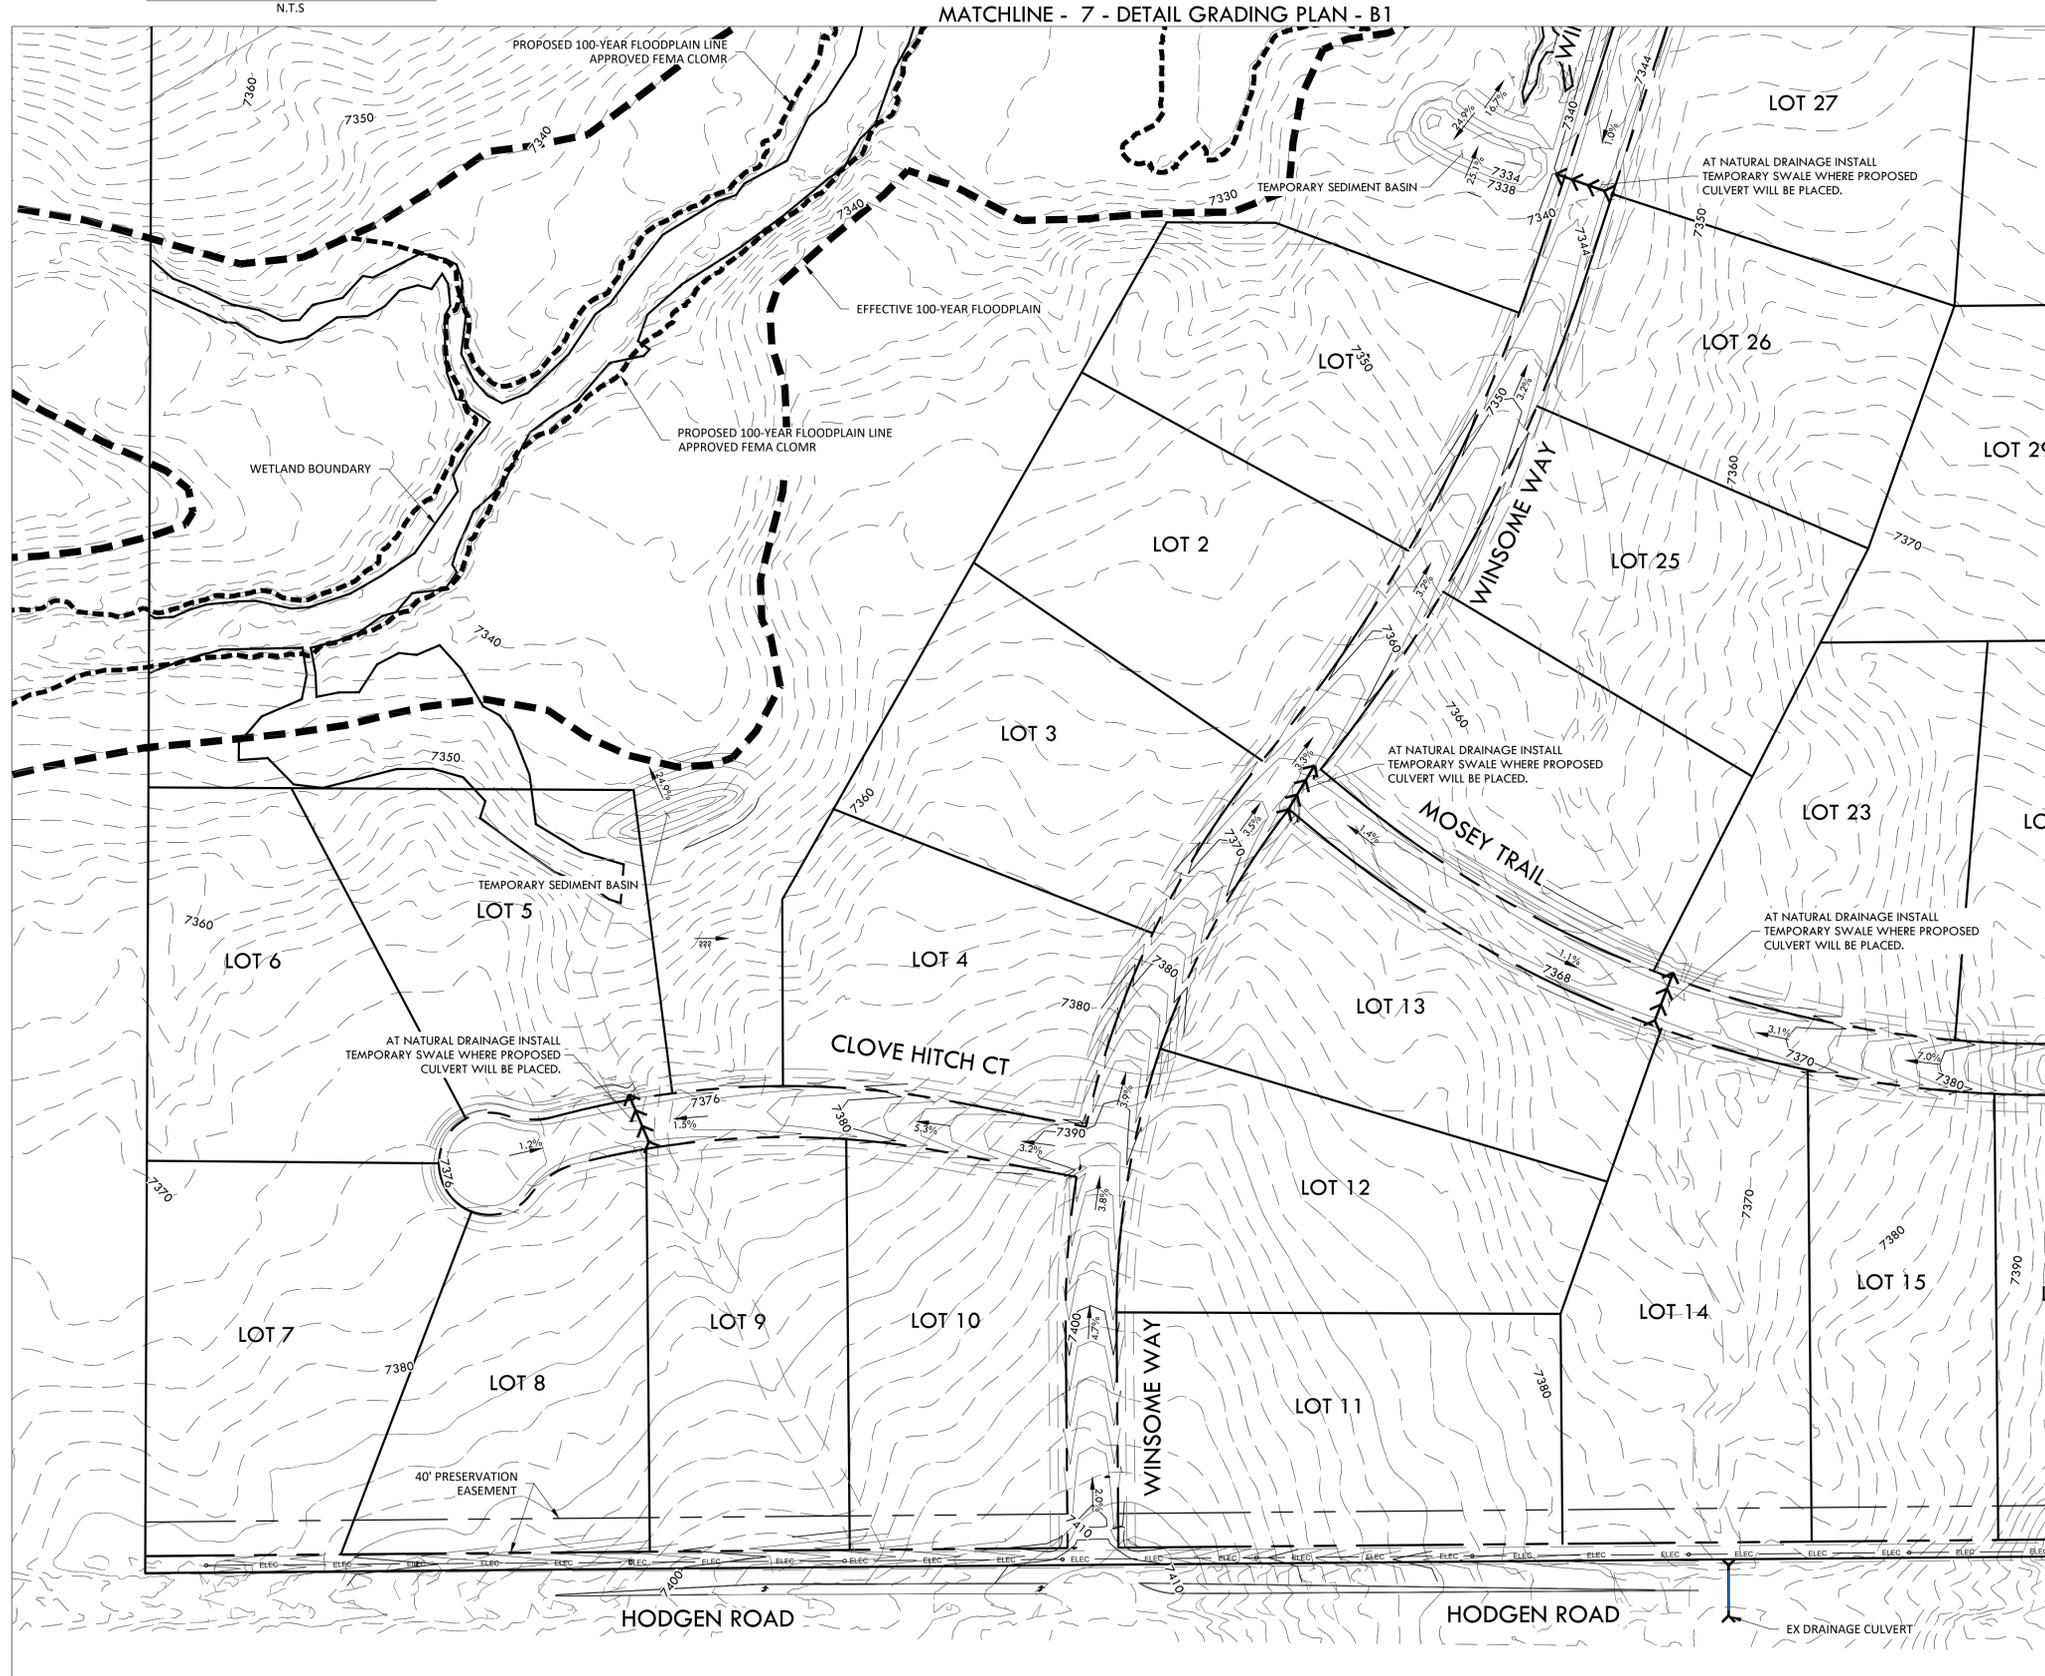

MATCHLINE - 6 - DETAIL GRADING PLAN - A2

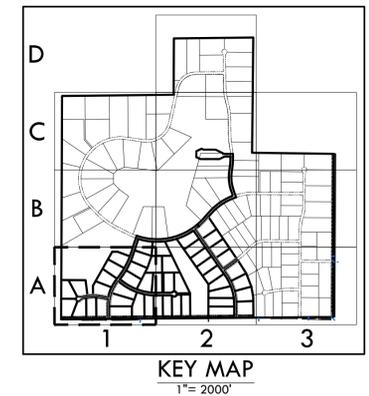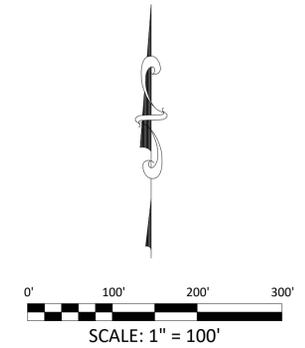


DETAIL GRADING PLAN - A1

SITE: 17480 MERIDIAN ROAD
 ELBERT, COLORADO 80106

FOR: WINSOME, LLC
 1864 WOODMORE DR, SUITE 100
 MONUMENT, COLORADO 80132

NO.	REVISIONS
1	SUBMITTAL 1
2	03.11.2020 REVISED PER COMMENTS
3	
4	
5	
6	
7	
8	
9	
10	

DATE: 01.22.20
 DRAWN BY: JCP
 CHECKED BY: LPV
 JOB #: 49388.01

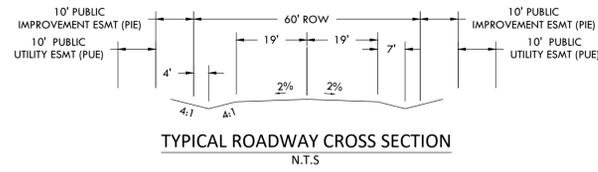

PRE-DEVELOPMENT GRADING AND EROSION CONTROL PLAN WINSOME FILING NO 1

A TRACT OF LAND BEING A PORTION OF SECTION 24, TOWNSHIP 11 SOUTH, RANGE 65 WEST,
OF THE 6TH PRINCIPAL MERIDIAN, COUNTY OF EL PASO, STATE OF COLORADO





VERTIX[®]
2420 W. 26th Avenue, Suite 100-D | Denver, CO 80211
Main: 303-623-9116 | VERTEXENG.COM

MATCHLINE - 8 - DETAIL GRADING PLAN - B2



AT NATURAL DRAINAGE INSTALL
TEMPORARY SWALE WHERE PROPOSED
CULVERT WILL BE PLACED.

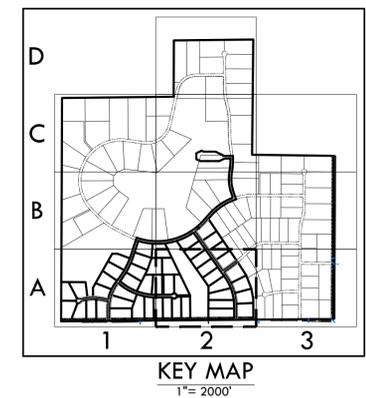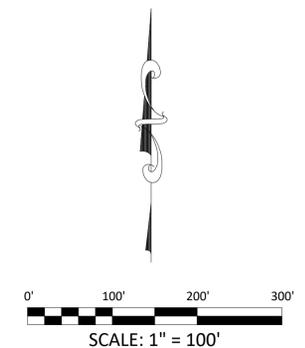


DETAIL GRADING PLAN - A2
SITE: 17480 MERIDIAN ROAD
ELBERT, COLORADO 80106
FOR: WINSOME, LLC
1864 WOODMORE DR, SUITE 100
MONUMENT, COLORADO 80132

NO.	REVISIONS
1	SUBMITTAL 1
2	03.11.2020 REVISED PER COMMENTS
3	
4	
5	
6	
7	
8	
9	
10	

DATE: 01.22.20
DRAWN BY: JCP
CHECKED BY: LPV
JOB #: 49388.01

7

Z:\Shared\Projects\49000-49999\49300-49399\49388\MCCune Ranch\05-Engineering\Vertex Drawings\Vertex Detail.dwg Sunday, March 29, 2020 9:58:41 PM
Copyright © 2020 The Vertex Companies, Inc.

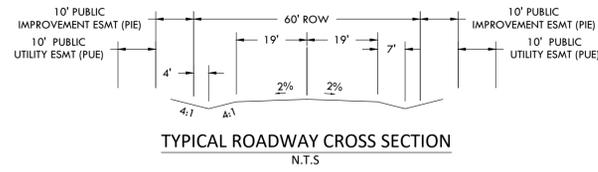

PRE-DEVELOPMENT GRADING AND EROSION CONTROL PLAN WINSOME FILING NO 1



A TRACT OF LAND BEING A PORTION OF SECTION 24, TOWNSHIP 11 SOUTH, RANGE 65 WEST,
OF THE 6TH PRINCIPAL MERIDIAN, COUNTY OF EL PASO, STATE OF COLORADO



VERTIX
2420 W. 26th Avenue, Suite 100-D | Denver, CO 80211
Main: 303.623.9116 | VERTEXENG.COM



MATCHLINE - 8 - DETAIL GRADING PLAN - B2

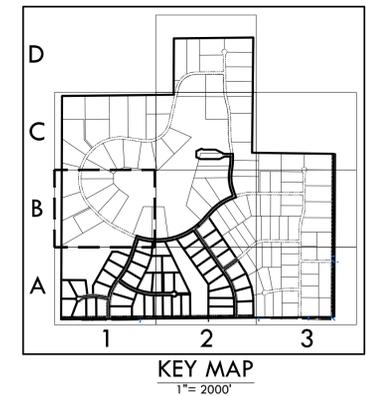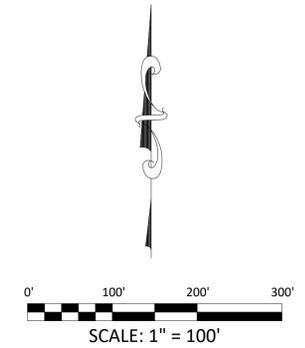

DETAIL GRADING PLAN - B1

SITE: 17480 MERIDIAN ROAD
ELBERT, COLORADO 80106

FOR: WINSOME, LLC
1864 WOODMORE DR, SUITE 100
MONUMENT, COLORADO 80132


NO.	REVISIONS
1	SUBMITTAL 1
2	03.11.2020 REVISED PER COMMENTS
3	
4	
5	
6	
7	
8	
9	
10	

DATE: 01.22.20
DRAWN BY: JCP
CHECKED BY: LPV
JOB #: 49388.01

8

EGP-20-001

MATCHLINE - 5 - DETAIL GRADING PLAN - A1

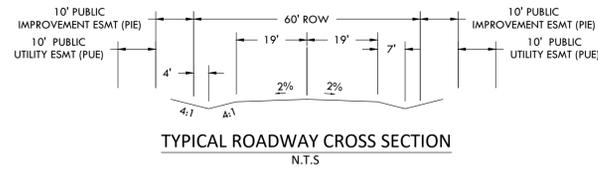

PRE-DEVELOPMENT GRADING AND EROSION CONTROL PLAN WINSOME FILING NO 1



A TRACT OF LAND BEING A PORTION OF SECTION 24, TOWNSHIP 11 SOUTH, RANGE 65 WEST,
OF THE 6TH PRINCIPAL MERIDIAN, COUNTY OF EL PASO, STATE OF COLORADO



VERTIX
2420 W. 26th Avenue, Suite 100-D | Denver, CO 80211
Main: 303-623-9116 | VERTEXENG.COM



MATCHLINE - 7 - DETAIL GRADING PLAN - B1

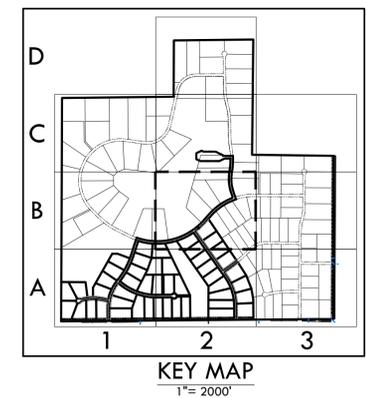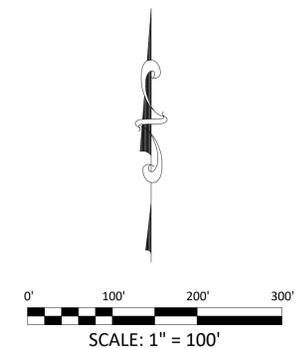

DETAIL GRADING PLAN - B2

SITE: 17480 MERIDIAN ROAD
ELBERT, COLORADO 80106

FOR: WINSOME, LLC
1864 WOODMORE DR, SUITE 100
MONUMENT, COLORADO 80132


NO.	REVISIONS
1	SUBMITTAL 1
2	03.11.2020 REVISED PER COMMENTS
3	
4	
5	
6	
7	
8	
9	
10	

DATE: 01.22.20	9
DRAWN BY: JCP	
CHECKED BY: LPV	
JOB #: 49388.01	

EGP-20-001

Z:\Shared\Projects\49000-49999\49300-49399\49388-McCune Ranch\05-Engineering\Vertex Drawings\Early Grading\Filing_1\49388-GEC_F1_GradingDetail.dwg Sunday, March 29, 2020 9:59:01 PM
Copyright © 2020 The Vertex Companies, Inc.

MATCHLINE - 6 - DETAIL GRADING PLAN - A2


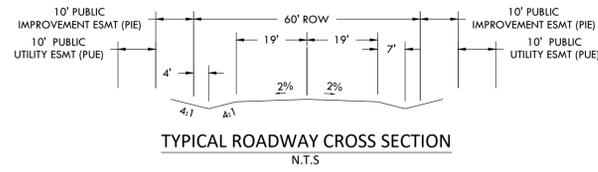


PRE-DEVELOPMENT GRADING AND EROSION CONTROL PLAN WINSOME FILING NO 1

A TRACT OF LAND BEING A PORTION OF SECTION 24, TOWNSHIP 11 SOUTH, RANGE 65 WEST,
OF THE 6TH PRINCIPAL MERIDIAN, COUNTY OF EL PASO, STATE OF COLORADO



VERTIX
2420 W. 26th Avenue, Suite 100-D | Denver, CO 80211
Main: 303.623.9116 | VERTEXENG.COM

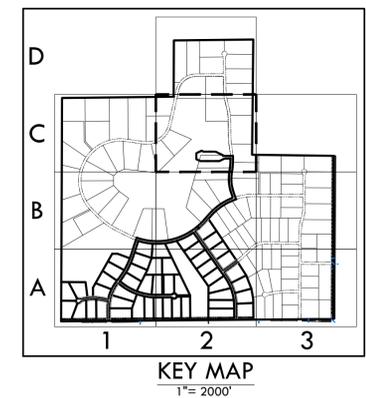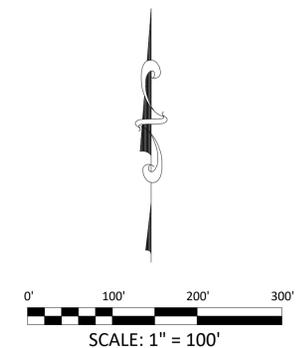

DETAIL GRADING PLAN - C2

SITE: 17480 MERIDIAN ROAD
ELBERT, COLORADO 80106

FOR: WINSOME, LLC
1864 WOODMORE DR, SUITE 100
MONUMENT, COLORADO 80132

NO.	REVISIONS
1	SUBMITTAL 1
2	03.11.2020 REVISED PER COMMENTS
3	
4	
5	
6	
7	
8	
9	
10	

DATE: 01.22.20
DRAWN BY: JCP
CHECKED BY: LPV
JOB #: 49388.01

10

MATCHLINE - 8 - DETAIL GRADING PLAN - B2

EGP-20-001

Z:\Shared\Projects\49000-49999\49300-49399\49388-McCune Ranch\05-Engineering\Vertex Drawings\Early Grading\Vertex\EGP-F1_GradingDetail.dwg Sunday, March 29, 2020 9:59:08 PM
Copyright © 2020 The Vertex Companies, Inc.

PRE-DEVELOPMENT GRADING AND EROSION CONTROL PLAN
WINSOME FILING NO 1
 A TRACT OF LAND BEING A PORTION OF SECTION 24, TOWNSHIP 11 SOUTH, RANGE 65 WEST,
 OF THE 6TH PRINCIPAL MERIDIAN, COUNTY OF EL PASO, STATE OF COLORADO

MATCHLINE - 12 - EROSION CONTROL B1




VERTEX
 2420 W. 26th Avenue, Suite 100-D | Denver, CO 80211
 Main: 303.623.9116 | VERTXENG.COM



NOTE:



1. ALL BMPs ARE REPRESENTED GRAPHICALLY AND ARE INTENDED TO GENERALLY DEPICT APPLICABLE LOCATIONS. IT IS EXPECTED THAT SITE CONDITIONS AND DEVELOPMENT PHASING WILL DETERMINE BEST LOCATIONS OF ACTUAL BMPs WHILE CONFORMING TO INTENDED LOCATIONS PER THIS PLAN.
2. SEED MIX MUST BE EL PASO COUNTY APPROVED.

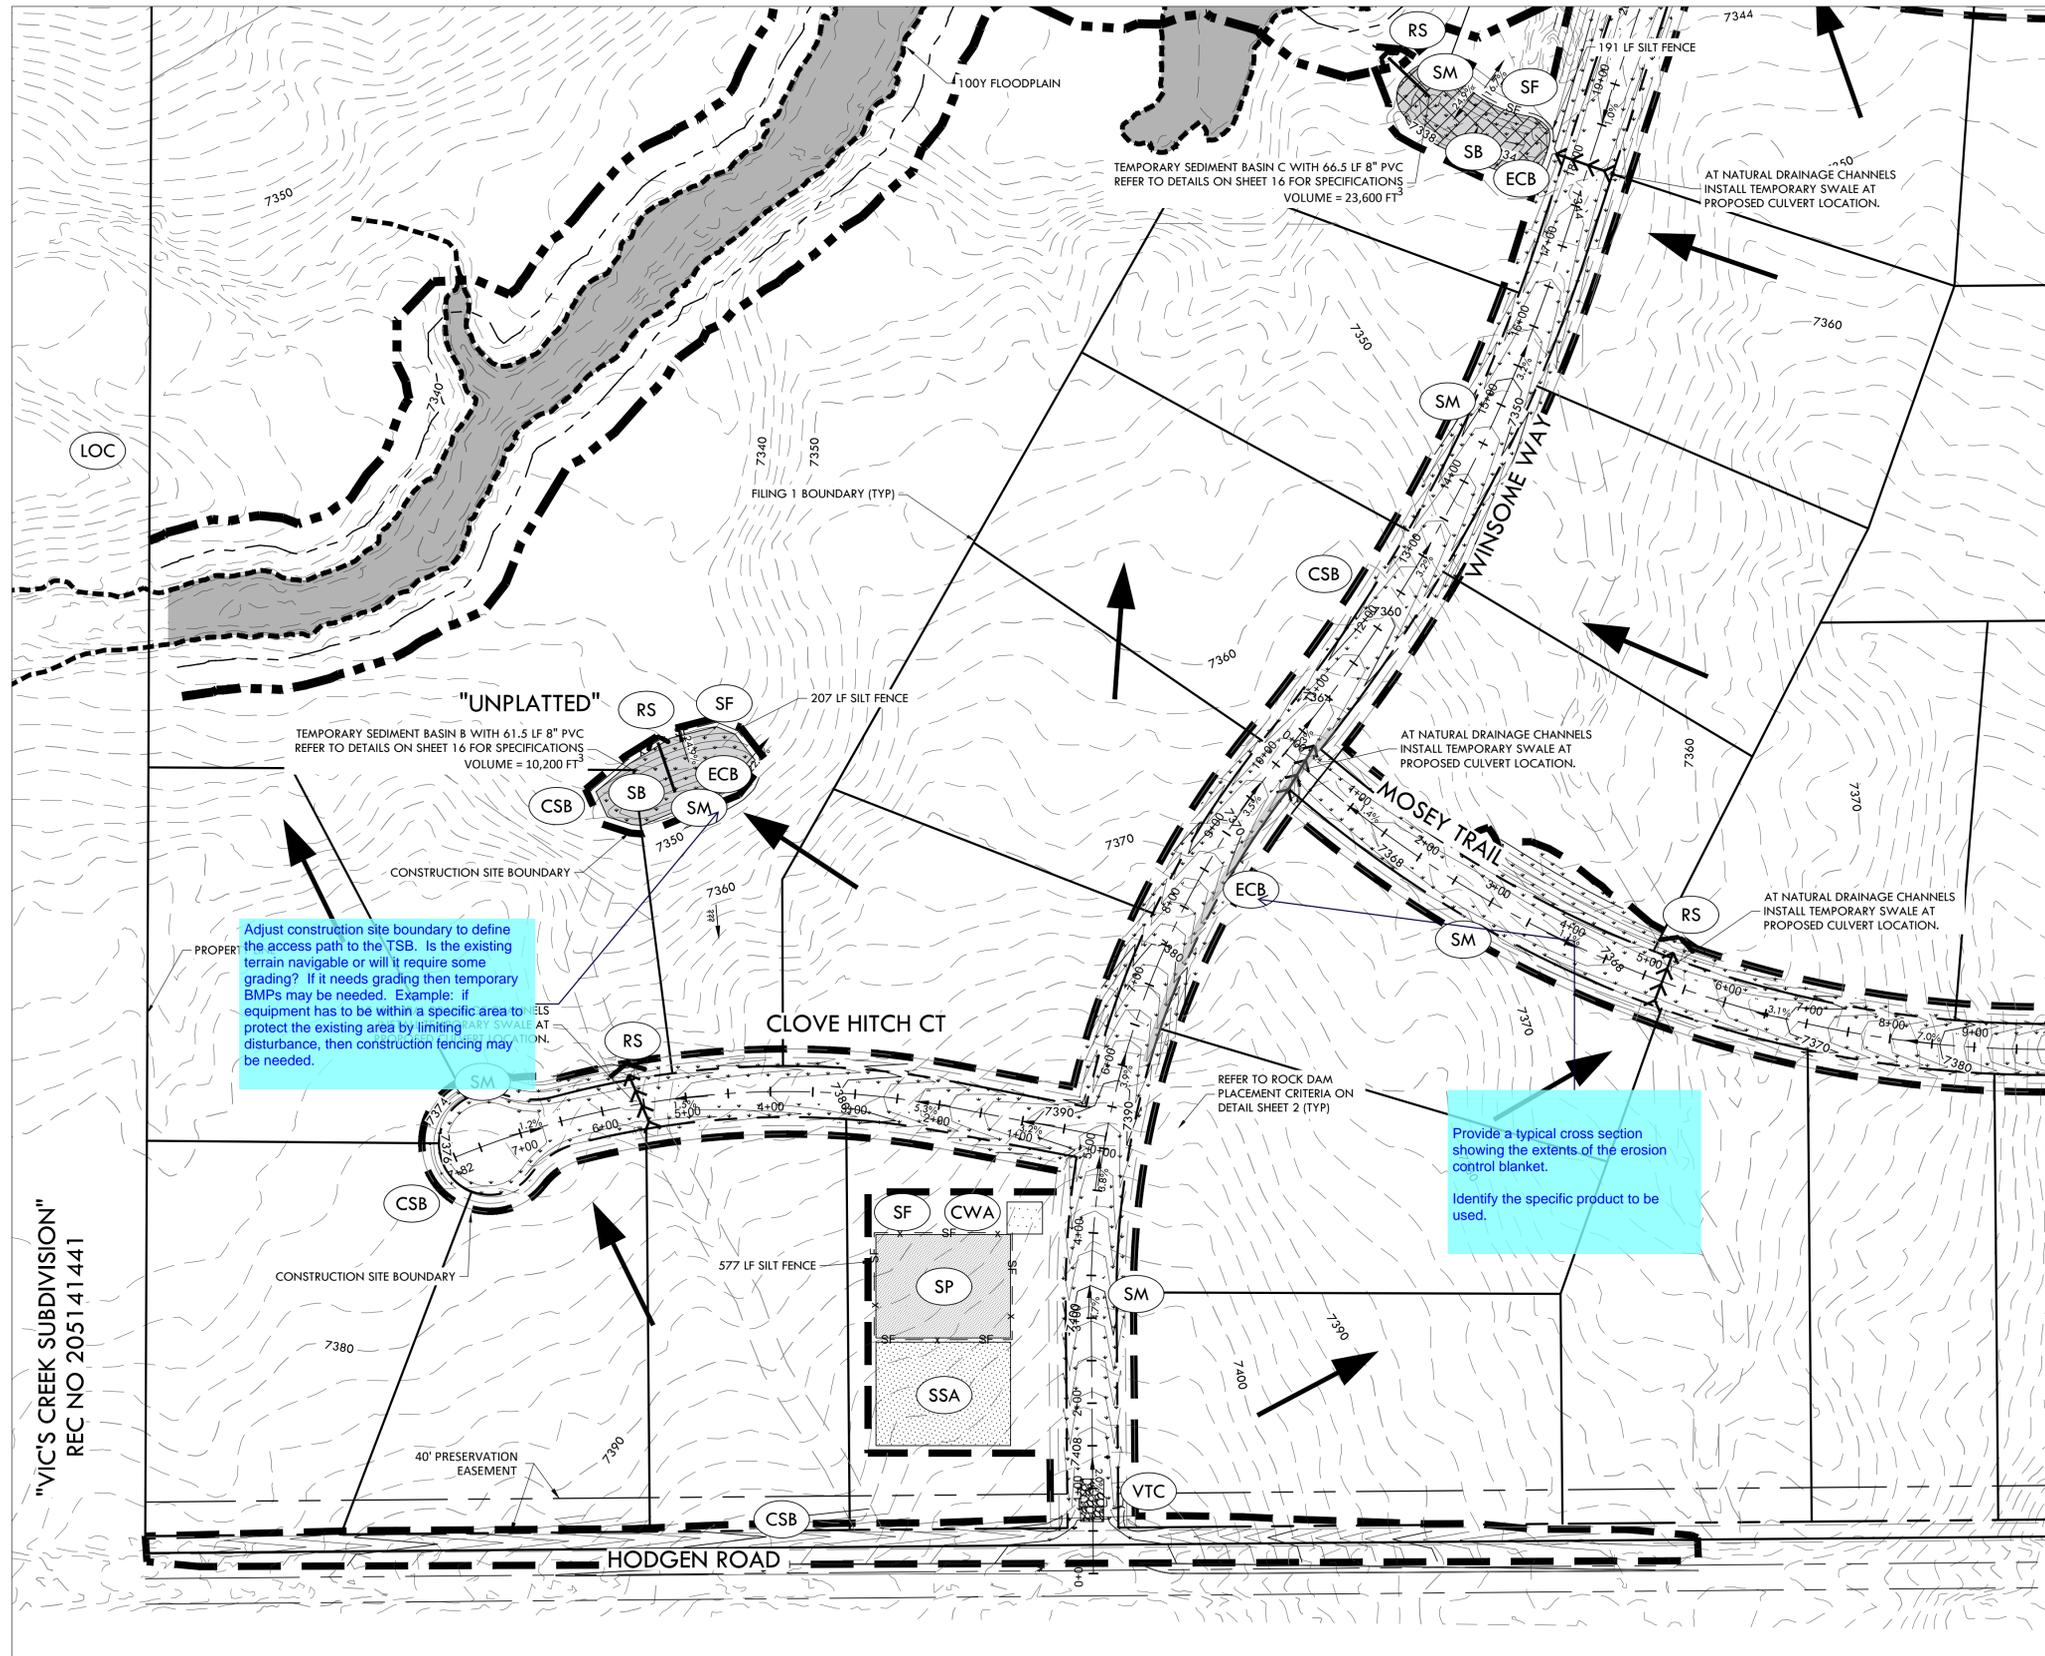

Adjust construction site boundary to define the access path to the TSB. Is the existing terrain navigable or will it require some grading? If it needs grading then temporary BMPs may be needed. Example: if equipment has to be within a specific area to protect the existing area by limiting disturbance, then construction fencing may be needed.

Provide a typical cross section showing the extents of the erosion control blanket.
 Identify the specific product to be used.

MATCHLINE - 11 - EROSION CONTROL A2

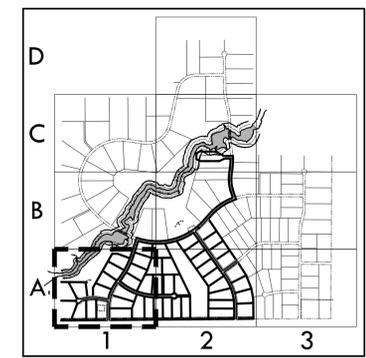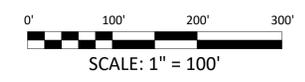

KEY MAP
 1" = 2000'

EROSION CONTROL A1

SITE: 17480 MERIDIAN ROAD
 ELBERT, COLORADO 80106

FOR: WINSOME, LLC
 1864 WOODMORE DR, SUITE 100
 MONUMENT, COLORADO 80132

NO.	REVISIONS
1	SUBMITTAL 1
2	03.11.2020 REVISED PER COMMENTS
3	
4	
5	
6	
7	
8	
9	
10	

DATE: 01.22.20

DRAWN BY: JCP

CHECKED BY: LPV

JOB #: 49388.01

11

PRE-DEVELOPMENT GRADING AND EROSION CONTROL PLAN
WINSOME FILING NO 1
 A TRACT OF LAND BEING A PORTION OF SECTION 24, TOWNSHIP 11 SOUTH, RANGE 65 WEST,
 OF THE 6TH PRINCIPAL MERIDIAN, COUNTY OF EL PASO, STATE OF COLORADO




VERTIX
 2420 W. 26th Avenue, Suite 100-D | Denver, CO 80211
 Main: 303.623.9116 | VERTIXENG.COM



NOTE:

1. ALL BMPs ARE REPRESENTED GRAPHICALLY AND ARE INTENDED TO GENERALLY DEPICT APPLICABLE LOCATIONS. IT IS EXPECTED THAT SITE CONDITIONS AND DEVELOPMENT PHASING WILL DETERMINE BEST LOCATIONS OF ACTUAL BMPs WHILE CONFORMING TO INTENDED LOCATIONS PER THIS PLAN.
2. SEED MIX MUST BE EL PASO COUNTY APPROVED.


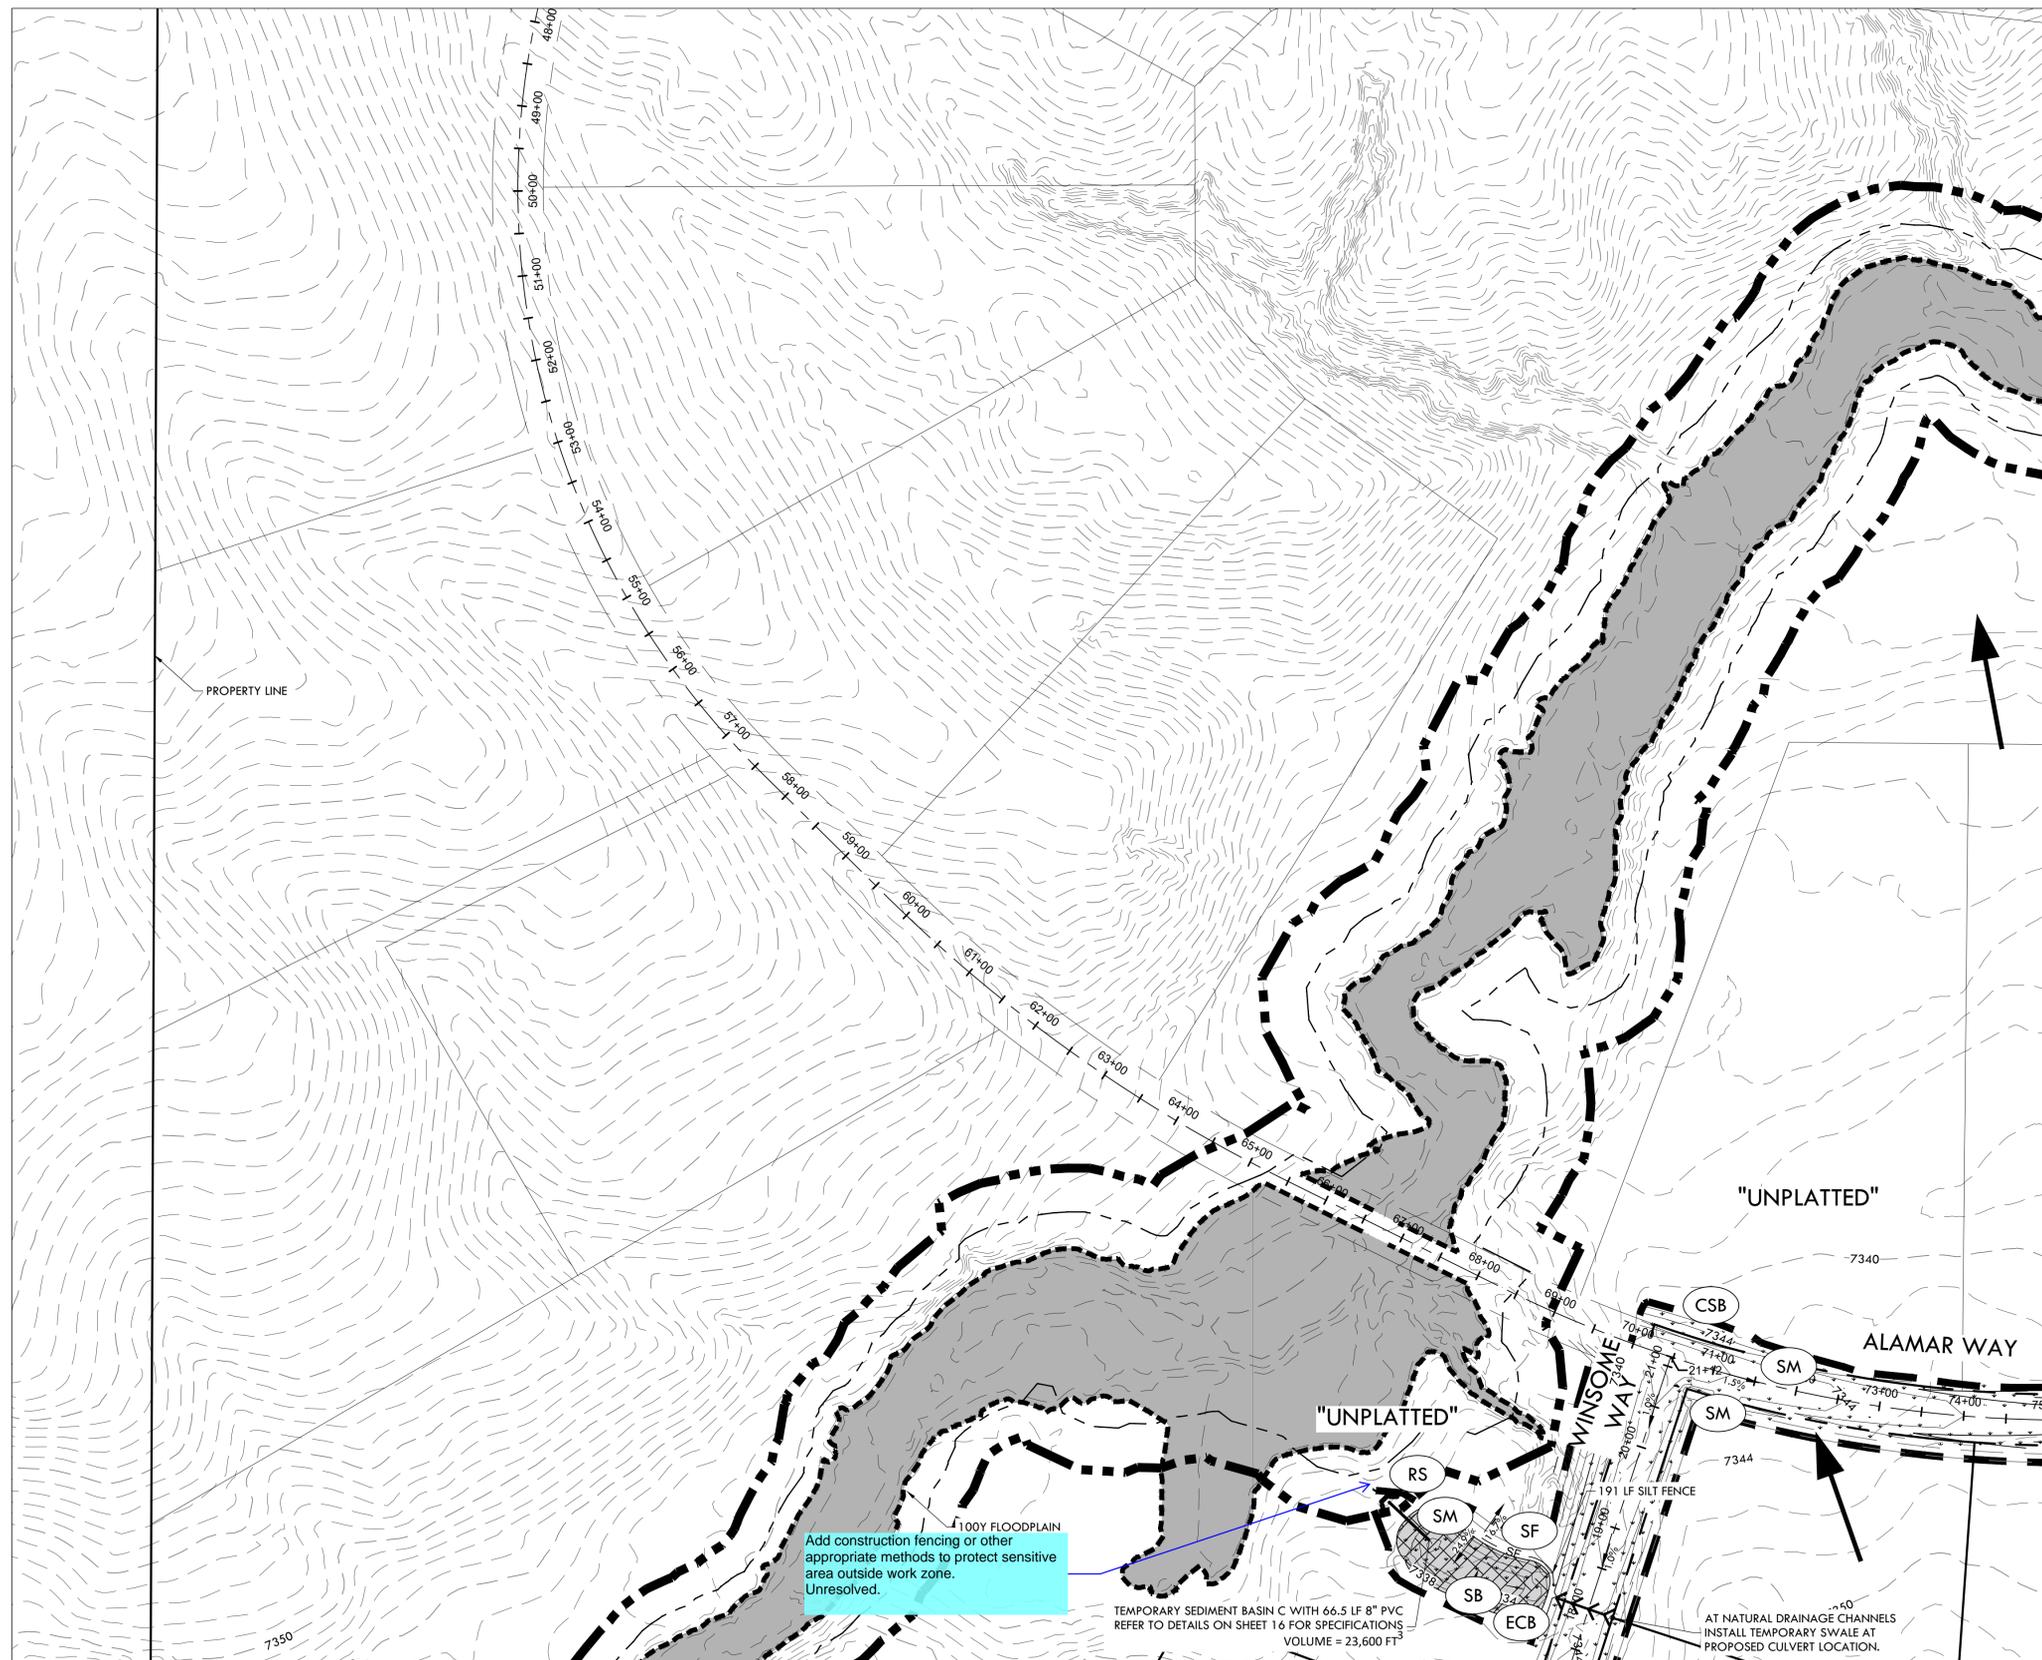


100Y FLOODPLAIN
 Add construction fencing or other appropriate methods to protect sensitive area outside work zone.
 Unresolved.

TEMPORARY SEDIMENT BASIN C WITH 66.5 LF 8" PVC REFER TO DETAILS ON SHEET 16 FOR SPECIFICATIONS VOLUME = 23,600 FT³

AT NATURAL DRAINAGE CHANNELS INSTALL TEMPORARY SWALE AT PROPOSED CULVERT LOCATION.

MATCHLINE - 13 - EROSION CONTROL B2

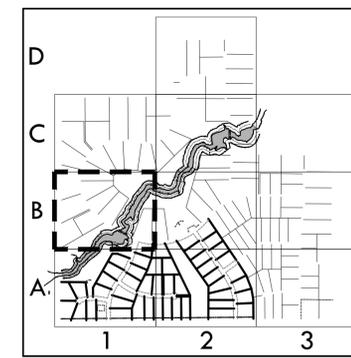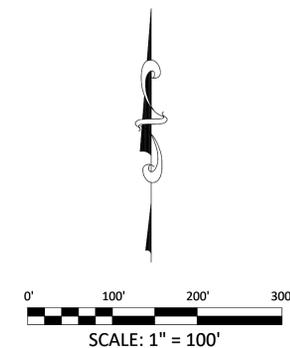

KEY MAP
 1" = 2000'

MATCHLINE - 10 - EROSION CONTROL A1

EGP-20-001

EROSION CONTROL B1

SITE: 17480 MERIDIAN ROAD
 ELBERT, COLORADO 80106

FOR: WINSOME, LLC
 1864 WOODMORE DR, SUITE 100
 MONUMENT, COLORADO 80132

NO.	REVISIONS
1	SUBMITTAL 1
2	03.11.2020 REVISED PER COMMENTS
3	
4	
5	
6	
7	
8	
9	
10	

DATE: 01.22.20

DRAWN BY: JCP

CHECKED BY: LPV

JOB #: 49388.01

Z:\Shared\Projects\49000-49999\49300-49399\49388-McCune Ranch\05-Engineering\VerteX Drawings\Early Grading\WerteX\05-Engineering\VerteX\05-Engineering\WerteX\05-Engineering\WerteX.dwg_Sunday, March 29, 2020 10:00:06 PM
 Copyright © 2020 The VerteX Companies, Inc.

PRE-DEVELOPMENT GRADING AND EROSION CONTROL PLAN
WINSOME FILING NO 1
 A TRACT OF LAND BEING A PORTION OF SECTION 24, TOWNSHIP 11 SOUTH, RANGE 65 WEST,
 OF THE 6TH PRINCIPAL MERIDIAN, COUNTY OF EL PASO, STATE OF COLORADO



VERTEX
 2420 W. 26th Avenue, Suite 100-D | Denver, CO 80211
 Main: 303.623.9116 | VERTEXENG.COM



EROSION CONTROL B2
 SITE: 17480 MERIDIAN ROAD
 ELBERT, COLORADO 80106
 FOR: WINSOME, LLC
 1864 WOODMORE DR, SUITE 100
 MONUMENT, COLORADO 80132




NO.	REVISIONS
1	SUBMITTAL 1
2	03.11.2020 REVISED PER COMMENTS
3	
4	
5	
6	
7	
8	
9	
10	

DATE: 01.22.20
 DRAWN BY: JCP
 CHECKED BY: LPV
 JOB #: 49388.01

MATCHLINE - 14 - EROSION CONTROL C2

NOTE:

- ALL BMPs ARE REPRESENTED GRAPHICALLY AND ARE INTENDED TO GENERALLY DEPICT APPLICABLE LOCATIONS. IT IS EXPECTED THAT SITE CONDITIONS AND DEVELOPMENT PHASING WILL DETERMINE BEST LOCATIONS OF ACTUAL BMPs WHILE CONFORMING TO INTENDED LOCATIONS PER THIS PLAN.
- SEED MIX MUST BE EL PASO COUNTY APPROVED.

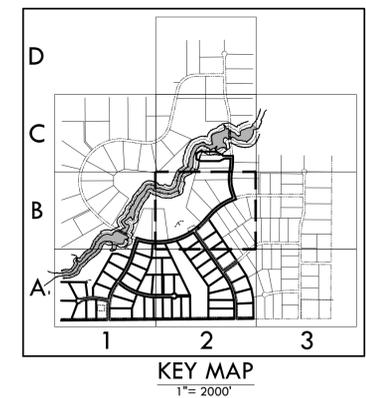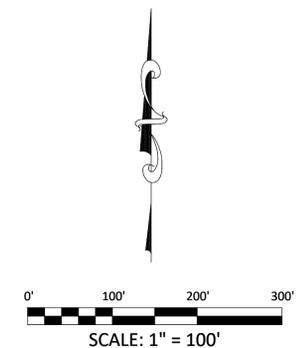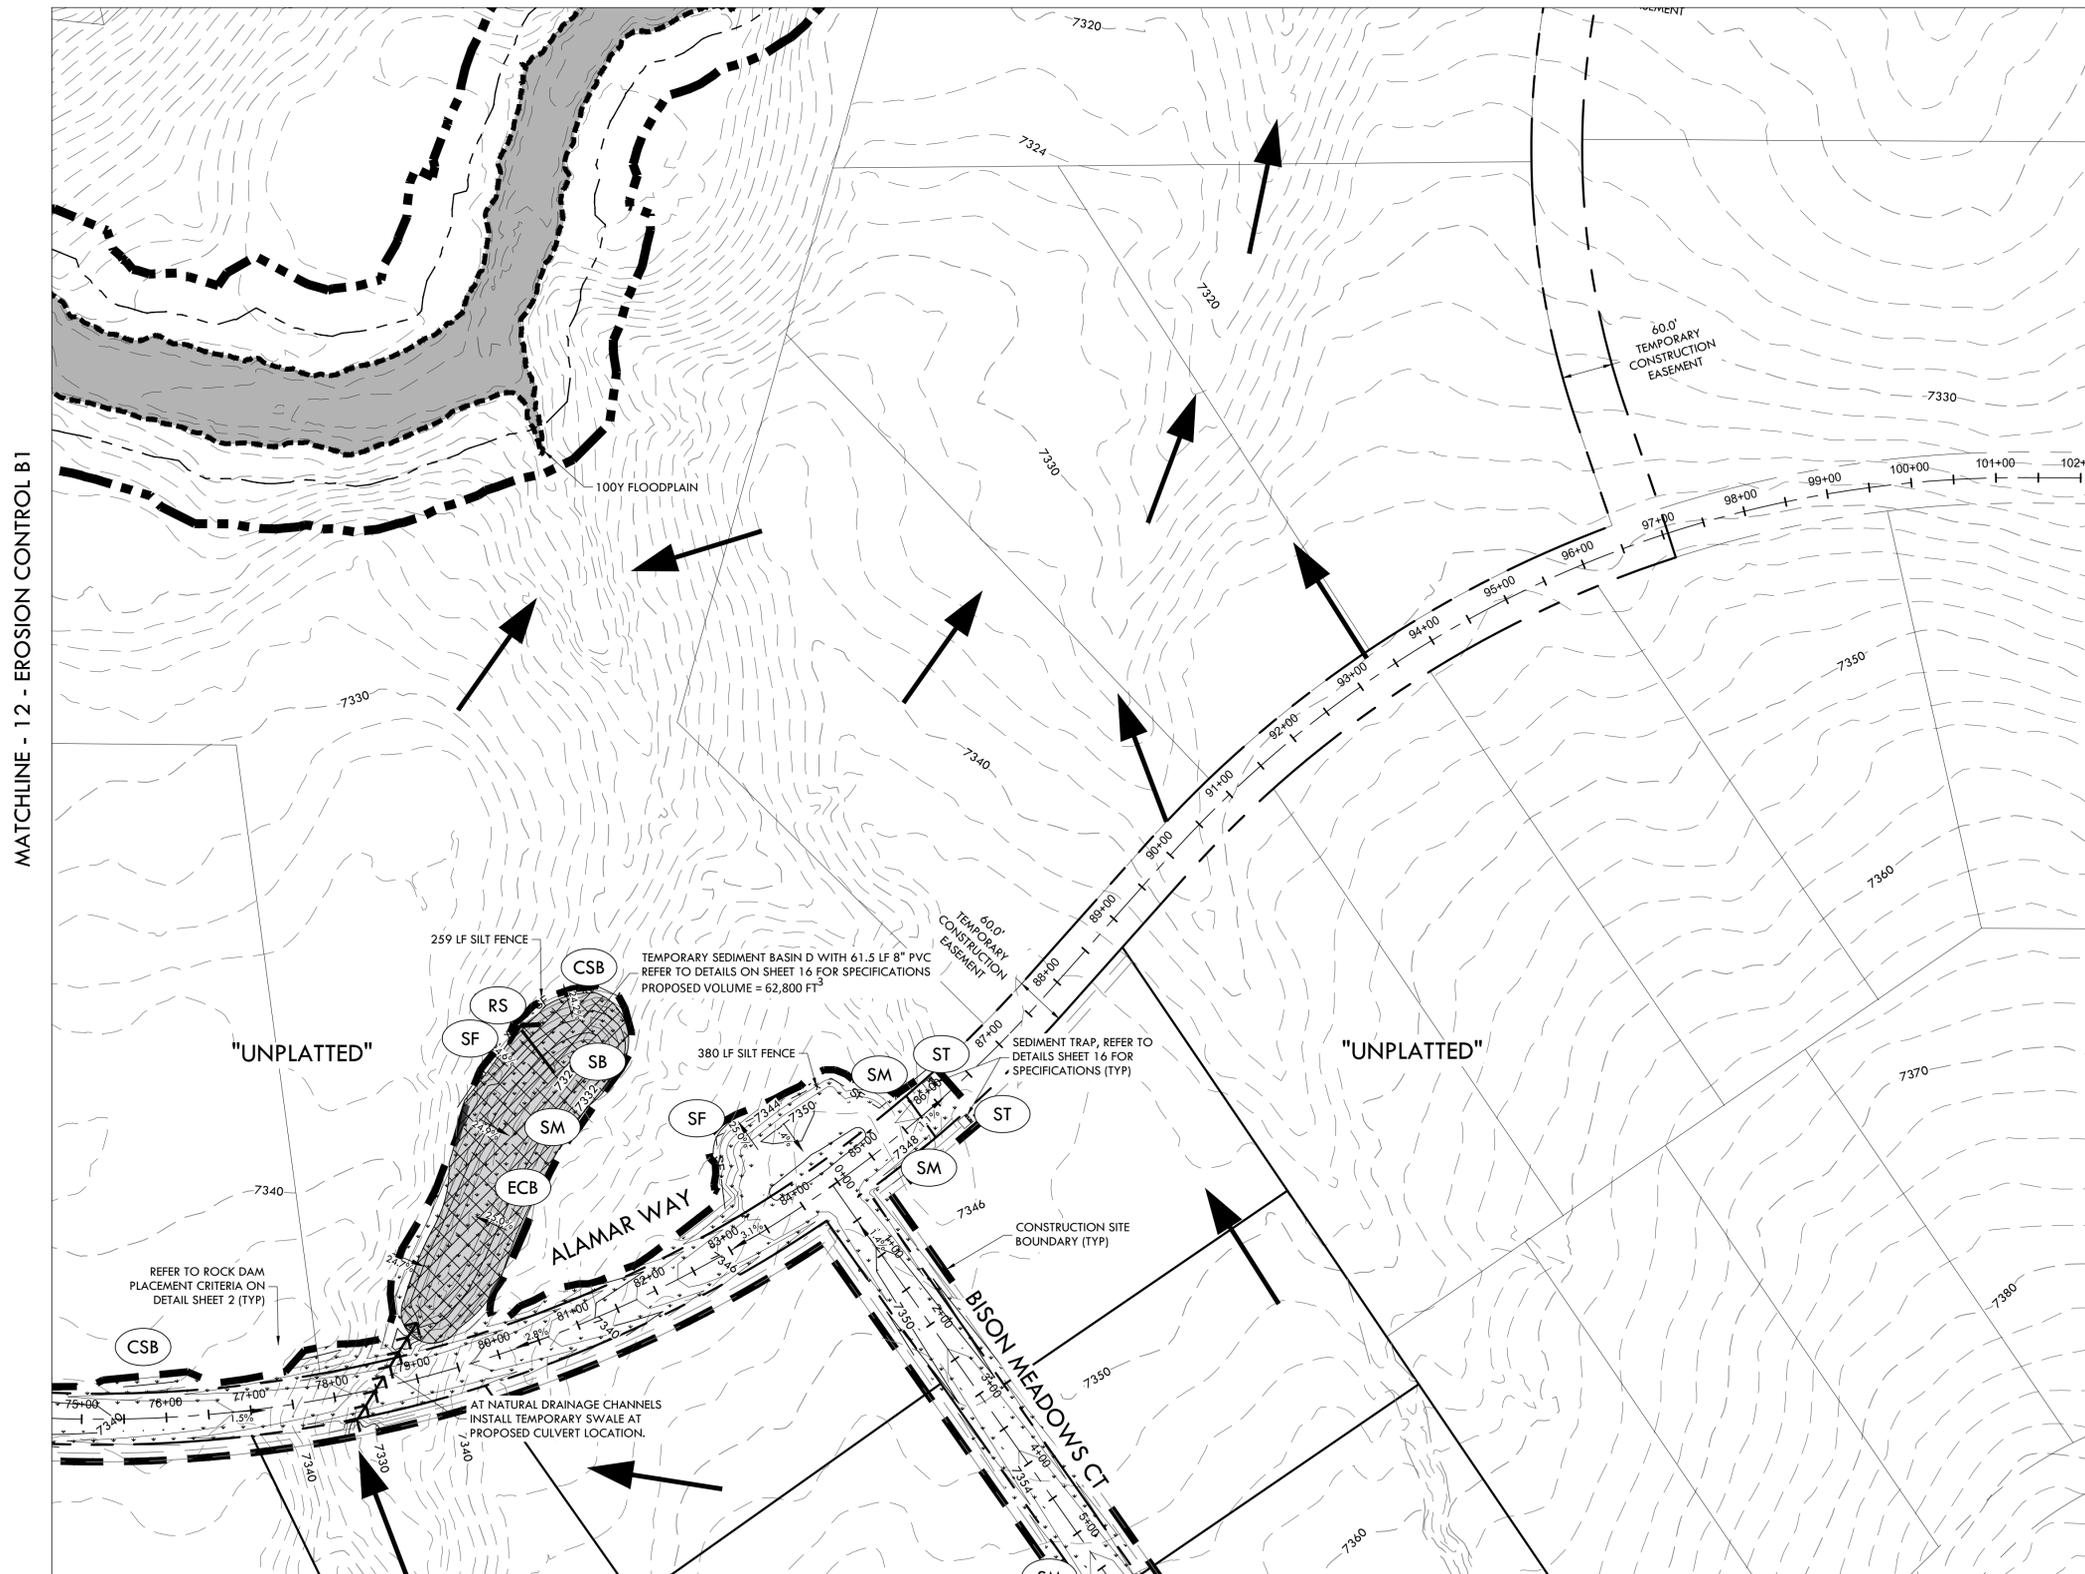

MATCHLINE - 11 - EROSION CONTROL A2

EGP-20-001

Z:\Shared\Projects\49000-49999\49388-McCune Ranch\05-Engineering\Vertex Drawings\Early Grading\Vertex Control.dwg_Sunday, March 29, 2020 10:00:17 PM
 Copyright © 2020 The Vertex Companies, Inc.

PRE-DEVELOPMENT GRADING AND EROSION CONTROL PLAN
WINSOME FILING NO 1
 A TRACT OF LAND BEING A PORTION OF SECTION 24, TOWNSHIP 11 SOUTH, RANGE 65 WEST,
 OF THE 6TH PRINCIPAL MERIDIAN, COUNTY OF EL PASO, STATE OF COLORADO






VERTEX
 2420 W. 26th Avenue, Suite 100-D | Denver, CO 80211
 Main: 303.623.9116 | VERTEXENG.COM



NOTE:

1. ALL BMPs ARE REPRESENTED GRAPHICALLY AND ARE INTENDED TO GENERALLY DEPICT APPLICABLE LOCATIONS. IT IS EXPECTED THAT SITE CONDITIONS AND DEVELOPMENT PHASING WILL DETERMINE BEST LOCATIONS OF ACTUAL BMPs WHILE CONFORMING TO INTENDED LOCATIONS PER THIS PLAN.
2. SEED MIX MUST BE EL PASO COUNTY APPROVED.

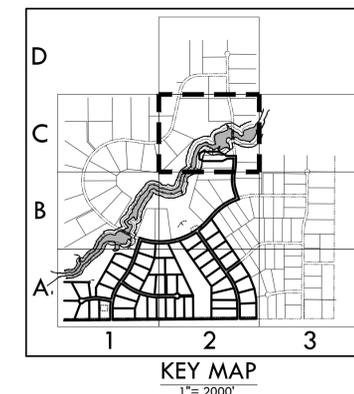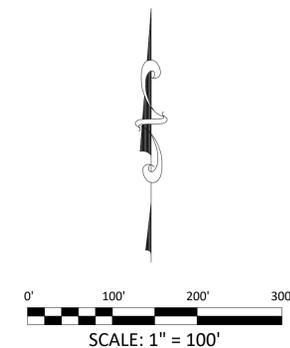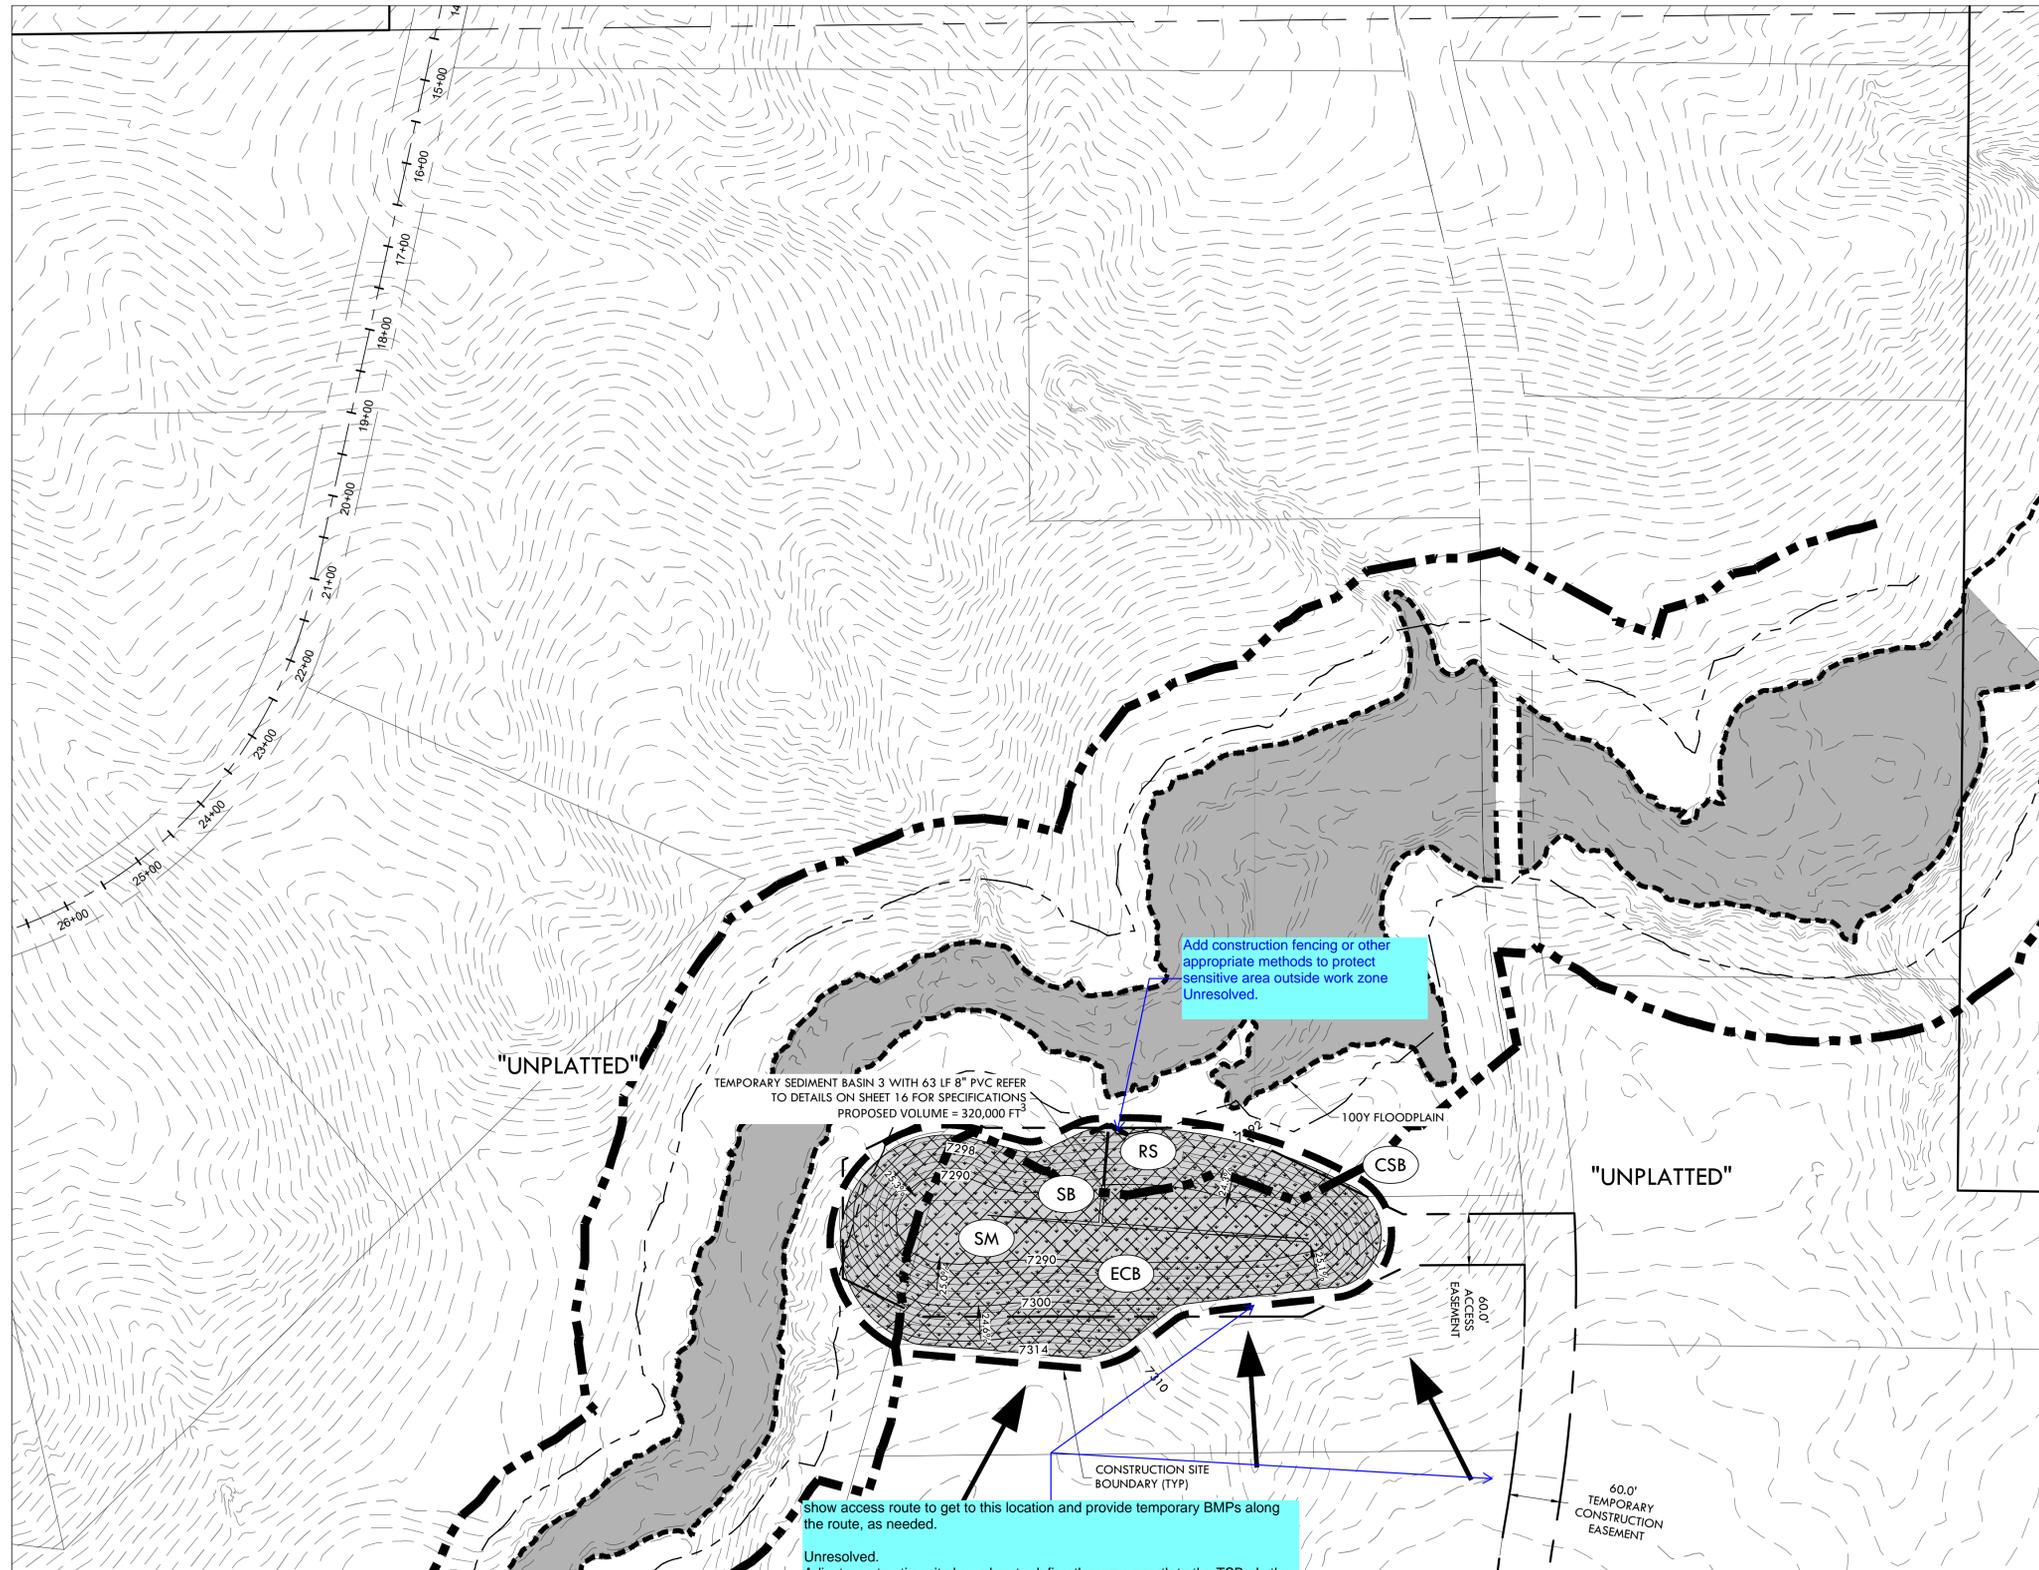

EROSION CONTROL C2

SITE: 17480 MERIDIAN ROAD
 ELBERT, COLORADO 80106

FOR: WINSOME, LLC
 1864 WOODMORE DR, SUITE 100
 MONUMENT, COLORADO 80132

NO.	REVISIONS
1	SUBMITTAL 1
2	03.11.2020 REVISED PER COMMENTS
3	
4	
5	
6	
7	
8	
9	
10	

DATE: 01.22.20	15
DRAWN BY: JCP	
CHECKED BY: LPV	
JOB #: 49388.01	

Z:\Shared\Projects\49000-49999\49300-49399\49388\MCCune Ranch\05-Engineering\Vertex Drawings\Early Grading\Filing_149388_GEC_F1_ErosionControl.dwg_Sunday, March 29, 2020 10:00:29 PM Copyright © 2020 The Vertex Companies, Inc.

PRE-DEVELOPMENT GRADING AND EROSION CONTROL PLAN WINSOME FILING NO 1

A TRACT OF LAND BEING A PORTION OF SECTION 24, TOWNSHIP 11 SOUTH, RANGE 65 WEST,
OF THE 6TH PRINCIPAL MERIDIAN, COUNTY OF EL PASO, STATE OF COLORADO



VERTIX
2420 W. 26th Avenue, Suite 100-D | Denver, CO 80211
Main: 303.623.9116 | VERTEXENG.COM



EROSION CONTROL DETAILS
SITE: 17480 MERIDIAN ROAD
ELBERT, COLORADO 80106
FOR: WINSOME, LLC
1864 WOODMORE DR, SUITE 100
MONUMENT, COLORADO 80132

NO.	REVISIONS
1	SUBMITTAL 1
2	03.11.2020 REVISED PER COMMENTS
3	
4	
5	
6	
7	
8	
9	
10	

DATE: 01.22.20
DRAWN BY: JCP
CHECKED BY: LPV
JOB #: 49388.01

EGP-20-001

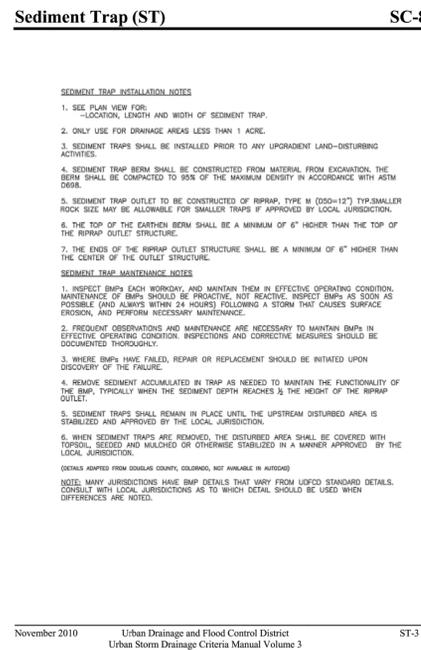
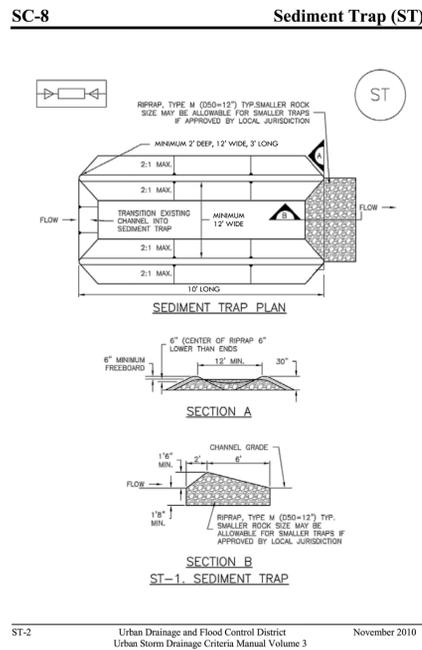
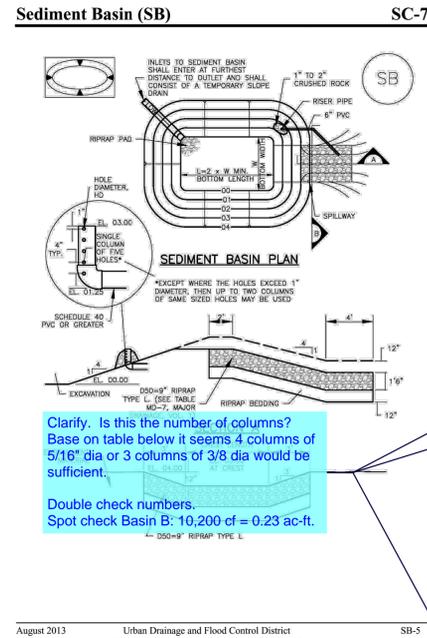
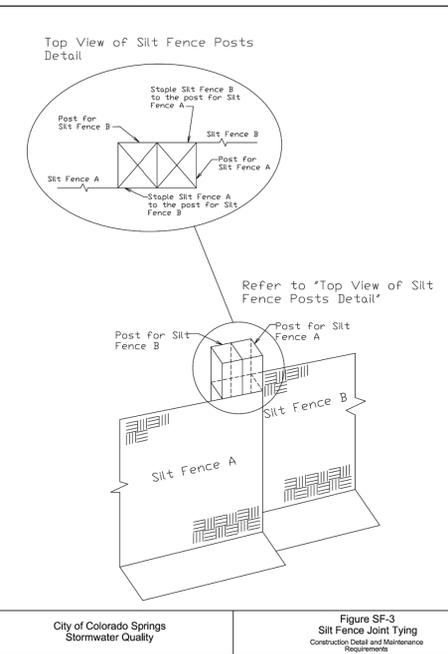
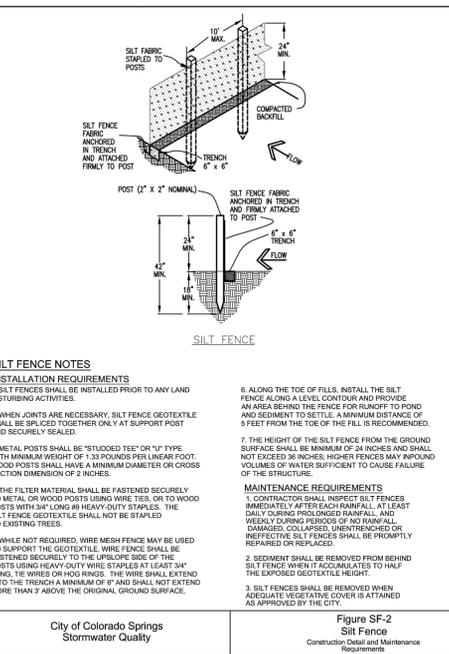
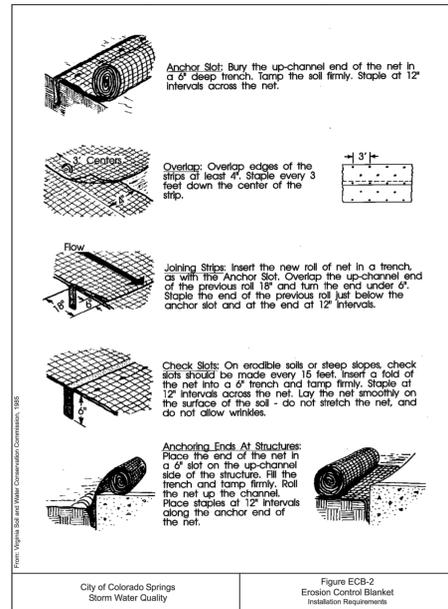
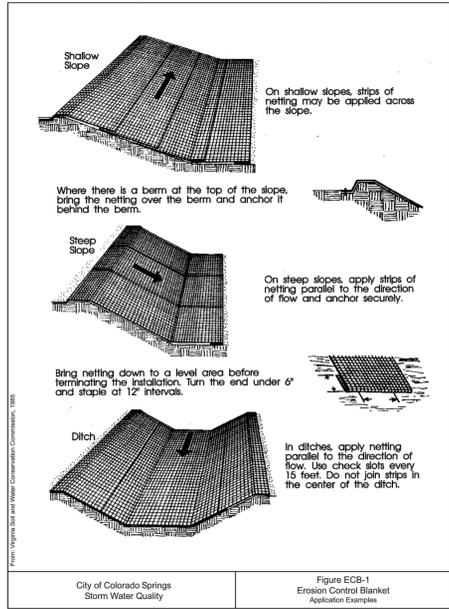


TABLE SB-1

Design Volume (acre-ft)	Required Area per Row (ft ²)							
	1.0	1.5	2.0	2.5	3.0	3.5	4.0	4.5
2	15.04	7.71	5.10	3.76	2.98	2.41	2.02	1.75
1	7.52	3.86	2.55	1.88	1.49	1.21	1.01	0.87
0.8	4.81	2.31	1.53	1.13	0.89	0.72	0.61	0.52
0.4	3.01	1.54	1.02	0.75	0.59	0.48	0.40	0.35
0.2	1.50	0.77	0.51	0.37	0.29	0.24	0.20	0.17
0.1	0.75	0.38	0.26	0.19	0.15	0.12	0.10	0.09
0.08	0.45	0.23	0.15	0.11	0.09	0.07	0.06	0.05
0.04	0.30	0.15	0.10	0.08	0.06	0.05	0.04	0.03
0.02	0.15	0.08	0.05	0.04	0.03	0.02	0.02	0.02
0.01	0.08	0.04	0.03	0.02	0.01	0.01	0.01	0.01

TABLE SB-2

Hole Diameter (in)	Hole Diameter (ft)	Area per Row (ft ²)		
		n=1	n=2	n=3
1/4	0.250	0.05	0.10	0.15
3/8	0.375	0.08	0.15	0.22
1/2	0.500	0.25	0.38	0.50
5/8	0.625	0.51	0.77	1.01
3/4	0.750	0.77	1.15	1.53
7/8	0.875	1.02	1.53	2.02
1	1.000	1.27	1.94	2.55
1 1/4	1.250	2.25	3.38	4.51
1 1/2	1.500	3.38	5.10	6.75
1 3/4	1.750	4.51	6.75	9.00
2	2.000	6.75	10.13	13.50

City of Colorado Springs Stormwater Quality
Figure SB-2 Outlet Sizing Application Techniques and Maintenance Requirements
3-33

PRE-DEVELOPMENT GRADING AND EROSION CONTROL PLAN WINSOME FILING NO 1

A TRACT OF LAND BEING A PORTION OF SECTION 24, TOWNSHIP 11 SOUTH, RANGE 65 WEST,
OF THE 6TH PRINCIPAL MERIDIAN, COUNTY OF EL PASO, STATE OF COLORADO



VERTEX
2420 W. 26th Avenue, Suite 100-D | Denver, CO 80211
Main: 303.623.9116 | VERTEXENG.COM



EROSION CONTROL DETAILS
SITE: 17480 MERIDIAN ROAD
ELBERT, COLORADO 80106
FOR: WINSOME, LLC
1864 WOODMORE DR, SUITE 100
MONUMENT, COLORADO 80132

NO.	REVISIONS
1	SUBMITTAL 1
2	03.11.2020 REVISED PER COMMENTS
3	
4	
5	
6	
7	
8	
9	
10	

DATE: 01.22.20	17
DRAWN BY: JCP	
CHECKED BY: LPV	
JOB #: 49388.01	

EGP-20-001

Rock Sock (RS) SC-5

Description

A rock sock is constructed of gravel that has been wrapped by wire mesh or a geotextile to form an elongated cylindrical filter. Rock socks are typically used either as a perimeter control or as part of inlet protection. When placed at angles in the curb line, rock socks are typically referred to as curb socks. Rock socks are intended to trap sediment from stormwater runoff that flows onto roadways as a result of construction activities.



Photograph RS-1. Rock socks placed at regular intervals in a curb line can help reduce sediment loading to storm sewer inlets. Rock socks can also be used as perimeter controls.

Appropriate Uses

Rock socks can be used at the perimeter of a disturbed area to control localized sediment loading. A benefit of rock socks as opposed to other perimeter controls is that they do not have to be trenched or staked into the ground; therefore, they are often used on roadway construction projects where paved surfaces are present. Use rock socks in inlet protection applications when the construction of a roadway is substantially complete and the roadway has been directly connected to a receiving storm system.

Design and Installation

When rock socks are used as perimeter controls, the maximum recommended tributary drainage area per 100 linear feet of rock socks is approximately 0.25 acres with disturbed slope length of up to 150 feet and a tributary slope gradient no steeper than 3:1. A rock sock design detail and notes are provided in Detail RS-1. Also see the Inlet Protection Fact Sheet for design and installation guidance when rock socks are used for inlet protection and in the curb line.

When placed in the gutter adjacent to a curb, rock socks should protrude no more than two feet from the curb in order for traffic to pass safely. If located in a high traffic area, place construction markers to alert drivers and street maintenance workers of their presence.

Maintenance and Removal



Rock socks are susceptible to displacement and breaking due to vehicle traffic. Inspect rock socks for damage and repair or replace as necessary. Remove sediment by sweeping or vacuuming as needed to maintain the functionality of the BMP. Typically when sediment has accumulated behind the rock sock to one-half of the sock's height.

Rock Sock	
Functions	
Erosion Control	No
Sediment Control	Yes
Site/Material Management	No

Once upstream stabilization is complete, rock socks and accumulated sediment should be removed and properly disposed.

November 2010 Urban Drainage and Flood Control District Urban Storm Drainage Criteria Manual Volume 3 RS-1

Rock Sock (RS) SC-5

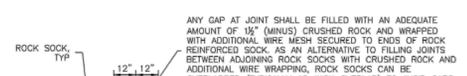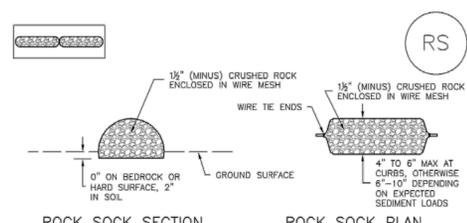

ROCK SOCK INSTALLATION NOTES

- SEE PLAN VIEW FOR LOCATIONS OF ROCK SOCKS.
- CRUSHED ROCK SHALL BE 1/2" (MINUS) IN SIZE WITH A FRACTURED FACE (ALL SIDES) AND SHALL COMPLY WITH GRADATION SHOWN ON THIS SHEET (1/2" MINUS).
- WIRE MESH SHALL BE FABRICATED OF 10 GAUGE POULTRY MESH, OR EQUIVALENT, WITH A MAXIMUM OPENING OF 3/8", RECOMMENDED MINIMUM ROLL WIDTH OF 48"
- WIRE MESH SHALL BE SECURED USING "HOG RINGS" OR WIRE TIES AT 6" CENTERS ALONG ALL JOINTS AND AT 2" CENTERS ON ENDS OF SOCKS.
- SOME MUNICIPALITIES MAY ALLOW THE USE OF FILTER FABRIC AS AN ALTERNATIVE TO WIRE MESH FOR THE ROCK ENCLOSURE.

RS-1. ROCK SOCK PERIMETER CONTROL

GRADATION TABLE	
ROCK SOCK	ROCK SOCK
GRAVEL	ROCK SOCK
NO. 4	NO. 4
2"	100
1 1/2"	90 - 100
1"	20 - 55
3/4"	0 - 15
3/8"	0 - 5

MATCHES SPECIFICATIONS FOR NO. 4 COARSE AGGREGATE FOR CONCRETE PER MSHTO M43. ALL ROCK SHALL BE FRACTURED FACE, ALL SIDES.


RS-2 Urban Drainage and Flood Control District Urban Storm Drainage Criteria Manual Volume 3 November 2010

Rock Sock (RS) SC-5

ROCK SOCK MAINTENANCE NOTES

- INSPECT BMPs EACH WORKDAY, AND MAINTAIN THEM IN EFFECTIVE OPERATING CONDITION. MAINTENANCE OF BMPs SHOULD BE PROACTIVE, NOT REACTIVE. INSPECT BMPs AS SOON AS POSSIBLE (AND ALWAYS WITHIN 24 HOURS) FOLLOWING A STORM THAT CAUSES SURFACE EROSION, AND PERFORM NECESSARY MAINTENANCE.
 - FREQUENT OBSERVATIONS AND MAINTENANCE ARE NECESSARY TO MAINTAIN BMPs IN EFFECTIVE OPERATING CONDITION. INSPECTIONS AND CORRECTIVE MEASURES SHOULD BE DOCUMENTED THOROUGHLY.
 - WHERE BMPs HAVE FAILED, REPAIR OR REPLACEMENT SHOULD BE INITIATED UPON DISCOVERY OF THE FAILURE.
 - ROCK SOCKS SHALL BE REPLACED IF THEY BECOME HEAVILY SOILED, OR DAMAGED BEYOND REPAIR.
 - SEDIMENT ACCUMULATED UPSTREAM OF ROCK SOCKS SHALL BE REMOVED AS NEEDED TO MAINTAIN FUNCTIONALITY OF THE BMP. TYPICALLY WHEN DEPTH OF ACCUMULATED SEDIMENTS IS APPROXIMATELY 1/2 OF THE HEIGHT OF THE ROCK SOCK.
 - ROCK SOCKS ARE TO REMAIN IN PLACE UNTIL THE UPSTREAM DISTURBED AREA IS STABILIZED AND APPROVED BY THE LOCAL JURISDICTION.
 - WHEN ROCK SOCKS ARE REMOVED, ALL DISTURBED AREAS SHALL BE COVERED WITH TOPSOIL, SEED AND MULCH OR OTHERWISE STABILIZED AS APPROVED BY LOCAL JURISDICTION.
- (DETAIL ADAPTED FROM TOWN OF PARKER, COLORADO AND CITY OF AURORA, COLORADO, NOT AVAILABLE IN AUTOCAD)
- NOTE: MANY JURISDICTIONS HAVE BMP DETAILS THAT VARY FROM UDFCD STANDARD DETAILS. CONSULT WITH LOCAL JURISDICTIONS AS TO WHICH DETAIL SHOULD BE USED WHEN DIFFERENCES ARE NOTED.
- NOTE: THE DETAILS INCLUDED WITH THIS FACT SHEET SHOW COMMONLY USED, CONVENTIONAL METHODS OF ROCK SOCK INSTALLATION IN THE DENVER METROPOLITAN AREA. THERE ARE MANY OTHER SIMILAR PROPRIETARY PRODUCTS ON THE MARKET. UDFCD NEITHER ENDORSES NOR DISCOURAGES USE OF PROPRIETARY PROTECTION PRODUCTS. HOWEVER, IN THE EVENT PROPRIETARY METHODS ARE USED, THE APPROPRIATE DETAIL FROM THE MANUFACTURER MUST BE INCLUDED IN THE SWMP AND THE BMP MUST BE INSTALLED AND MAINTAINED AS SHOWN IN THE MANUFACTURER'S DETAILS.

November 2010 Urban Drainage and Flood Control District Urban Storm Drainage Criteria Manual Volume 3 RS-3

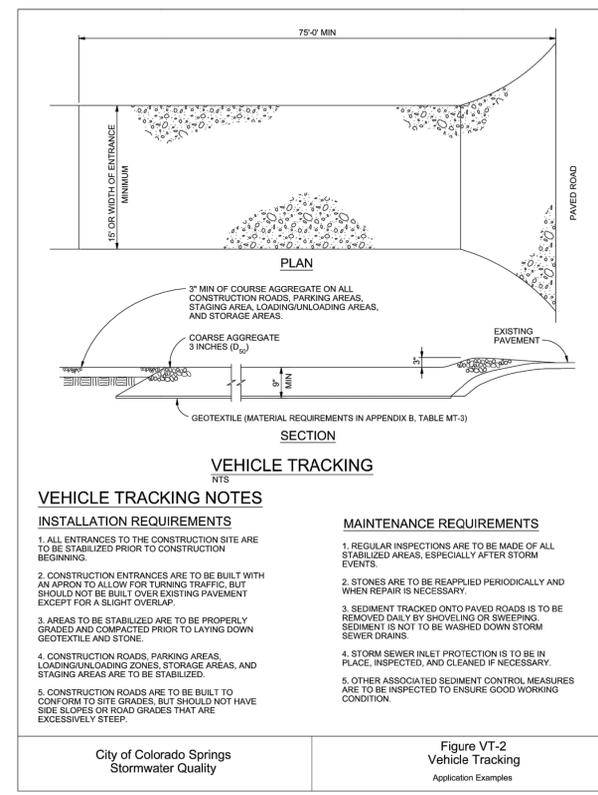

November 2010 Urban Drainage and Flood Control District Urban Storm Drainage Criteria Manual Volume 3 CWA-4

Concrete Washout Area (CWA) MM-1

Description

Concrete waste management involves designating and properly managing a specific area of the construction site as a concrete washout area. A concrete washout area can be created using one of several approaches designed to receive wash water from washing of tools and concrete mixer chutes, liquid concrete waste from dump trucks, mobile batch mixers, or pump trucks. Three basic approaches are available: excavation of a pit in the ground, use of an above ground storage area, or use of prefabricated haul-away concrete washout containers. Surface discharges of concrete washout water from construction sites are prohibited.



Photograph CWA-1. Example of concrete washout area. Note gravel tracking pad for access and sign.

Appropriate Uses

Concrete washout areas must be designated on all sites that will generate concrete wash water or liquid concrete waste from onsite concrete mixing or concrete delivery.

Because pH is a pollutant of concern for washout activities, when unlined pits are used for concrete washout, the soil must have adequate buffering capacity to result in protection of state groundwater standards; otherwise, a liner/containment must be used. The following management practices are recommended to prevent an impact from unlined pits to groundwater:

- The use of the washout site should be temporary (less than 1 year), and
- The washout site should be not be located in an area where shallow groundwater may be present, such as near natural drainages, springs, or wetlands.

Design and Installation

Concrete washout activities must be conducted in a manner that does not contribute pollutants to surface waters or stormwater runoff. Concrete washout areas may be lined or unlined excavated pits in the ground, commercially manufactured prefabricated washout containers, or aboveground holding areas constructed of berms, sandbags or straw bales with a plastic liner.

Although unlined washout areas may be used, lined pits may be required to protect groundwater under certain conditions.

Do not locate an unlined washout area within 400 feet of any natural drainage pathway or waterbody or within 1,000 feet of any wells or drinking water sources. Even for lined concrete washouts, it is advisable to locate the facility away from waterbodies and drainage paths. If site constraints make these

Concrete Washout Area	
Functions	
Erosion Control	No
Sediment Control	No
Site/Material Management	Yes

November 2010 Urban Drainage and Flood Control District Urban Storm Drainage Criteria Manual Volume 3 CWA-1

Concrete Washout Area (CWA) MM-1

setbacks infeasible or if highly permeable soils exist in the area, then the pit must be installed with an impermeable liner (16 mil minimum thickness) or surface storage alternatives using prefabricated concrete washout devices or a lined aboveground storage area should be used.

Design details with notes are provided in Detail CWA-1 for pits and CWA-2 for aboveground storage areas. Pre-fabricated concrete washout container information can be obtained from vendors.

Maintenance and Removal

A key consideration for concrete washout areas is to ensure that adequate signage is in place identifying the location of the washout area. Part of inspecting and maintaining washout areas is ensuring that adequate signage is provided and in good repair and that the washout area is being used, as opposed to washout in non-designated areas of the site.

Remove concrete waste in the washout area, as needed to maintain BMP function (typically when filled to about two-thirds of its capacity). Collect concrete waste and deliver offsite to a designated disposal location.

Upon termination of use of the washout site, accumulated solid waste, including concrete waste and any contaminated soils, must be removed from the site to prevent on-site disposal of solid waste. If the wash water is allowed to evaporate and the concrete hardens, it may be recycled.




Photograph CWA-2. Prefabricated concrete washout. Photo courtesy of CDOT.



Photograph CWA-3. Earthen concrete washout. Photo courtesy of CDOT.

CWA-2 Urban Drainage and Flood Control District Urban Storm Drainage Criteria Manual Volume 3 November 2010

Concrete Washout Area (CWA) MM-1

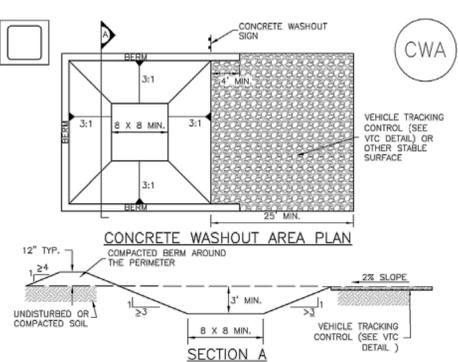

CWA-1. CONCRETE WASHOUT AREA

- CWA INSTALLATION NOTES**
- SEE PLAN VIEW FOR -CWA INSTALLATION LOCATION.
 - DO NOT LOCATE AN UNLINED CWA WITHIN 400' OF ANY NATURAL DRAINAGE PATHWAY OR WATERBODY. DO NOT LOCATE WITHIN 1,000' OF ANY WELLS OR DRINKING WATER SOURCES. IF SITE CONSTRAINTS MAKE THIS INFEASIBLE, OR IF HIGHLY PERMEABLE SOILS EXIST ON SITE, THE CWA MUST BE INSTALLED WITH AN IMPERMEABLE LINER (16 MIL MIN. THICKNESS) OR SURFACE STORAGE ALTERNATIVES USING PREFABRICATED CONCRETE WASHOUT DEVICES OR A LINED ABOVE GROUND STORAGE AREA SHOULD BE USED.
 - THE CWA SHALL BE INSTALLED PRIOR TO CONCRETE PLACEMENT ON SITE.
 - CWA SHALL INCLUDE A FLAT SUBSURFACE PIT THAT IS AT LEAST 8' BY 8' SLOPES LEADING OUT OF THE SUBSURFACE PIT SHALL BE 3:1 OR FLATTER. THE PIT SHALL BE AT LEAST 3' DEEP.
 - BERM SURROUNDING SIDES AND BACK OF THE CWA SHALL HAVE MINIMUM HEIGHT OF 1'.
 - VEHICLE TRACKING PAD SHALL BE SLOPED 2% TOWARDS THE CWA.
 - SIGNS SHALL BE PLACED AT THE CONSTRUCTION ENTRANCE, AT THE CWA, AND ELSEWHERE AS NECESSARY TO CLEARLY INDICATE THE LOCATION OF THE CWA TO OPERATORS OF CONCRETE TRUCKS AND PUMP TRIGS.
 - USE EXCAVATED MATERIAL FOR PERIMETER BERM CONSTRUCTION.

November 2010 Urban Drainage and Flood Control District Urban Storm Drainage Criteria Manual Volume 3 CWA-3

Z:\Shared\Projects\49000-49999\49300-49399\49388-McCune Ranch\06-Engineering\Vertex Drawings\Vertex ErosionControl.dwg_Sunday, March 29, 2020 10:00:41 PM Copyright: 2020, The Vertex Companies, Inc.

GEC_v2.pdf Markup Summary

CFurchak (2)



Subject: Engineer
Page Label: [1] 1 COVER SHEET
Author: CFurchak
Date: 4/27/2020 10:16:44 AM
Status:
Color: ■
Layer:
Space:

Label all proposed temporary construction control measures by phase of implementation

Unresolved.




Subject: Engineer
Page Label: [2] 2 NOTES
Author: CFurchak
Date: 4/27/2020 10:20:05 AM
Status:
Color: ■
Layer:
Space:

Add a note about existing vegetation or show existing vegetation on the plans.

Unresolved.


dsdlaforce (21)

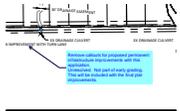


Subject: Callout
Page Label: [3] 3 SITE PLAN
Author: dsdlaforce
Date: 4/23/2020 6:55:43 AM
Status:
Color: ■
Layer:
Space:

Remove callouts for proposed permanent infrastructure improvements with this application.

Unresolved. Not part of early grading. This will be included with the final plat improvements.

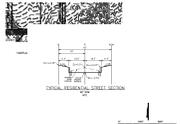

Subject: Image
Page Label: [5] 5 OVERALL GRADING PLAN
Author: dsdlaforce
Date: 4/23/2020 7:01:59 AM
Status:
Color: ■
Layer:
Space:

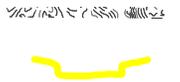

Subject: Highlight
Page Label: [5] 5 OVERALL GRADING PLAN
Author: dsdlaforce
Date: 4/23/2020 7:02:03 AM
Status:
Color: ■
Layer:
Space:




Subject: Callout
Page Label: [5] 5 OVERALL GRADING PLAN
Author: dsdlaforce
Date: 4/23/2020 7:06:23 AM
Status:
Color: ■
Layer:
Space:

Revise to only identify the rough grading.
 Two options for the grading shown:
 Option 1. Revise contours to show the rough grading elevation
 Option 2. Update the detail to show the rough grading relative to the finished grade contours depicted on the plan.

Example to the right.

Unresolved. It appears plans are showing option 1. Therefore, label to identify as subgrade or rough grading surface.

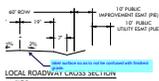

Subject: Callout
Page Label: [5] 5 OVERALL GRADING PLAN
Author: dsdlaforce
Date: 4/23/2020 7:07:15 AM
Status:
Color: ■
Layer:
Space:

label surface so as to not be confused with finished grade.

$$E = 320,000$$

$$IN^2, 5 - 1/2$$

Subject: Highlight
Page Label: [16] 16 EROSION CONTROL DETAILS
Author: dsdlaforce
Date: 4/23/2020 7:30:20 AM
Status:
Color: ■
Layer:
Space:

$$IME = 62,80$$

$$IN^2, 5 - 9/2$$

Subject: Highlight
Page Label: [16] 16 EROSION CONTROL DETAILS
Author: dsdlaforce
Date: 4/23/2020 7:30:22 AM
Status:
Color: ■
Layer:
Space:

$$IME = 23,60$$

$$IN^2, 5 - 11,$$

Subject: Highlight
Page Label: [16] 16 EROSION CONTROL DETAILS
Author: dsdlaforce
Date: 4/23/2020 7:30:23 AM
Status:
Color: ■
Layer:
Space:

$$ME = 10,200$$

$$IN^2, 5 - 5/8$$

Subject: Highlight
Page Label: [16] 16 EROSION CONTROL DETAILS
Author: dsdlaforce
Date: 4/23/2020 7:30:24 AM
Status:
Color: ■
Layer:
Space:

13	0.89	0.1
75	0.59	0.4
38	0.30	0.1
19	0.15	0.1
44	0.00	0.1

Subject: Highlight
Page Label: [16] 16 EROSION CONTROL DETAILS
Author: dsdlaforce
Date: 4/23/2020 8:15:28 AM
Status:
Color: 
Layer:
Space:

1.0	1.5	2.0	2.5	3.0	
2	18.04	7.71	5.10	3.70	2.86
1	7.52	3.86	2.55	1.88	1.48
0.6	4.81	2.31	1.53	1.13	0.88
0.4	3.01	1.54	1.02	0.75	0.58
0.2	1.50	0.77	0.51	0.38	0.30
0.1	0.75	0.38	0.26	0.19	0.15
0.08	0.45	0.23	0.16	0.11	0.08
0.04	0.30	0.15	0.10	0.08	0.06
0.02	0.15	0.08	0.06	0.04	0.03
0.01	0.08	0.04	0.03	0.02	0.01

Subject: Arrow
Page Label: [16] 16 EROSION CONTROL DETAILS
Author: dsdlaforce
Date: 4/23/2020 8:16:22 AM
Status:
Color: 
Layer:
Space:

2.5	3.0	3.5
3.76	2.95	2.41
1.88	1.48	1.21
1.13	0.89	0.72
0.75	0.59	0.48
0.38	0.30	0.24

Subject: Arrow
Page Label: [16] 16 EROSION CONTROL DETAILS
Author: dsdlaforce
Date: 4/23/2020 8:16:31 AM
Status:
Color: 
Layer:
Space:


0.15	0.23	0.33
0.45	0.59	0.72
0.89	1.13	1.48
1.88	2.41	3.0
3.76	4.81	6.0
7.52	9.62	12.0
15.04	19.24	24.0
30.08	38.48	48.0
60.16	76.96	96.0
120.32	153.92	192.0
35512195951179732006993.92	45429165565205986955755.52	56668397794435952904352.0
71024391902359464013987.84	90858331130411973911511.04	113336795588871905808704.0
142048783804718928027975.68	181716662260823947823022.08	226673591177743811617408.0
284097567609437856055951.36	363433324521647895646044.16	453347182355487623234816.0
568195135218875712111902.72	726866649043295791292088.32	906694364710975246469632.0
1136390270437751424223805.44	1453733298086591582584176.64	1813388729421950492939264.0
2272780540775502848447610.88	2907466596173183165168353.28	3626777458843900985878528.0
4545561081551005696895221.76	5814933192346366330336706.56	7253554917687801971757056.0
9091122163102011393790443.52	11629866384692732660673413.12	14507109835375603943514112.0
18182244326204022787580887.04	23259732769385465321346826.24	2901421967075120788702824.0
36364488652408045575161774.48	46519465538770930642693652.48	5802843934150241577405648.0
72728977304816091150323548.96	93038931077541861285387304.96	11605687868300483154811296.0
145457954609632182300647089.92	186077862155083722570774609.92	23211375736600966309622592.0
290915909219264364601294179.84	372155724310167445141549219.84	46422751473201932618245184.0
581831818438528729202588359.68	744311448620334890283098439.68	92845502946403864036490368.0
1163663636877057458405176719.36	1488622897240669780566196879.36	185691005892807728072980736.0
2327327273754114916810353438.72	2977245794481339561132393758.72	371382011785615456145961472.0
4654654547508229833620706877.44	5954491588962679122264787517.44	742764023571230912291922944.0
9309309095016459667241413754.88	11908983177925358244529575034.88	1485528047142461844583845888.0
18618618190032919334482827509.76	23817966355850716489059150069.76	2971056094284923689167691776.0
37237236380065838668965655019.52	47635932711701432978118300139.52	5942112188569847378335383552.0
74474472760131677337931310039.04	95271865423402865956236600279.04	11884224377139695156670767104.0
148948945520263354675862620078.08	190543730846805731912473200558.08	23768448754279390313341534208.0
297897891040526709351725240156.16	381087461693611463824946401116.16	47536897508558780726683068416.0
595795782081053418703450480312.32	762174923387222927649892802232.32	95073794517117561453366136832.0
1191591564162106837406900960624.64	1524349846774445855299785604464.64	190147589034235122906732273664.0
2383183128324213674813801921249.28	3048699693548891710599571208929.28	380295178068470245813464547328.0
4766366256648427349627603842498.56	6097399387097783421199142417858.56	760590356136940491626929094656.0
9532732513296854699255207684997.12	12194798774195566842398284835717.12	1521180712273880983253858189312.0
19065465026593709398510415369994.24	24389597548391133684796569671434.24	3042361424547761966507716376224.0
38130930053187418797020830739988.48	48779195096782267369593139342868.48	6084722849095523933015432752448.0
76261860106374837594041661479976.96	97558390193564534739186278685737.96	12169445698191047866030865504896.0
152523720212749675188083322959953.92	195116780387129069478372557371475.92	24338891396382095732061731009792.0
305047440425499350376166645919907.84	390233560774258138956745114742951.84	48677782792764191564122822019584.0
61009488085099870075233329183915.68	780467121548516277913490229485903.68	97355565585528383518245644039168.0
122018976170199740150466658367831.36	1560934243097032555826980558971807.36	194711131171056761036491288078336.0
244037952340399480300933316735662.72	3121868486194065111653961117943614.72	389422262342113522072982576156672.0
4880759046807989606018666334713231.44	6243736972388130223307922235887229.44	778844524684227044045965152313344.0
9761518093615979212037332669426462.88	12487473944776260446615844471774458.88	1557689049368454088131930304626688.0
19523036187231958424074665338852925.76	24974947889552520893231688943548917.76	3115378098736908176263860609253376.0
39046072374463916848149330677705851.52	49949895779105041786463377887097835.52	6230756197473808352527721378506752.0
78092144748927833696298661355411711.04	99899791558210083572926755774195671.04	1246151239494761670505544275701344.0
156184289497855667392597322710823422.08	199799583116420167145853511548391422.08	2492302478989523341011088551402688.0
312368578995711334785194645421646844.16	399599166232840334291707022996782844.16	4984604957879046682022177102805376.0
62473715799142266957038929084329368.32	79919833246568066858341404599356568.32	9969209915758093371644354205610752.0
124947431598284533914077858168587136.64	159839666493136133716682809198713136.64	19938419231516186743288708411221504.0
249894863196569067828155716337174273.28	319679332986272267433365618397426273.28	398768384630323734865774168224422546.0
499789726393138135656311432674344546.56	639358665972544534866731236794852454.56	797536769260647469731548336448845092.0
99957945278627627131262286534970911.12	127871733194508906973346247358970911.12	159511352452129493946309673689741822.0
199915890573255254262524573069941822.24	255743466389017813946692494717941822.24	319022704904258987892619347379483644.0
399831781146510508525049146139883644.48	511486932778035627893384989435883644.48	638045409808517955786738694759767288.0
7996635		



Subject: Callout
Page Label: [16] 16 EROSION CONTROL DETAILS
Author: dsdlaforce
Date: 4/23/2020 8:23:18 AM
Status:
Color: ■
Layer:
Space:

Clarify. Is this the number of columns?
Base on table below it seems 4 columns of 5/16"
dia or 3 columns of 3/8 dia would be sufficient.

Double check numbers.
Spot check Basin B: 10,200 cf = 0.23 ac-ft.

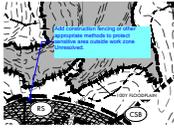

Subject: Engineer
Page Label: [15] 15 EROSION CONTROL C2
Author: dsdlaforce
Date: 4/23/2020 9:06:21 AM
Status:
Color: ■
Layer:
Space:

Add construction fencing or other appropriate
methods to protect sensitive area outside work
zone
Unresolved.



Subject: Engineer
Page Label: [13] 13 EROSION CONTROL B1
Author: dsdlaforce
Date: 4/23/2020 9:08:20 AM
Status:
Color: ■
Layer:
Space:

Add construction fencing or other appropriate
methods to protect sensitive area outside work
zone.
Unresolved.



Subject: Engineer
Page Label: [15] 15 EROSION CONTROL C2
Author: dsdlaforce
Date: 4/23/2020 9:11:03 AM
Status:
Color: ■
Layer:
Space:


show access route to get to this location and
provide temporary BMPs along the route, as
needed.

Unresolved.
Adjust construction site boundary to define the
access path to the TSB. Is the existing terrain
navigable or will it require some grading? If it
needs grading then temporary BMPs may be
needed. Temporary construction easement is not
required as this is owned by the developer.



Subject: Callout
Page Label: [11] 11 EROSION CONTROL A1
Author: dsdlaforce
Date: 4/23/2020 9:25:43 AM
Status:
Color: ■
Layer:
Space:

Adjust construction site boundary to define the
access path to the TSB. Is the existing terrain
navigable or will it require some grading? If it
needs grading then temporary BMPs may be
needed. Example: if equipment has to be within
a specific area to protect the existing area by
limiting disturbance, then construction fencing may
be needed.

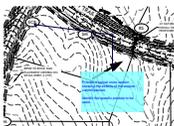

Subject: Callout
Page Label: [11] 11 EROSION CONTROL A1
Author: dsdlaforce
Date: 4/23/2020 9:51:25 AM
Status:
Color: ■
Layer:
Space:

Provide a typical cross section showing the extents
of the erosion control blanket.

Identify the specific product to be used.