


Big Spings Rd



scale: 1" = 200'
detail: 1" = 30'

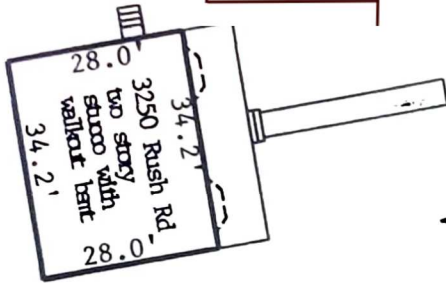

Note: property dimensions are based on a typical section

Released for Permit
02/05/2024 9:30:40 AM
EPC
ENUMERATION

SFD24106
UNPLATTED
ZONE A-35

2ND HOUSE

PREV PLAN
CANCELLED
SFD211809

3000-00-290

**APPROVED
Plan Review**

02/12/2024 1:38:50 PM
dsdarchuleta

EPC Planning & Community
Development Department

**Not Required
BESQCP**

02/12/2024 1:39:03 PM
dsdarchuleta

EPC Planning & Community
Development Department




ANY APPROVAL GIVEN BY
EL PASO COUNTY
DOES NOT OBLIVATE THE NEED
TO COMPLY WITH APPLICABLE
FEDERAL, STATE, OR LOCAL
LAWS AND/OR REGULATION

An access permit must be granted by the
Planning & Community Development Department
prior to the establishment of any driveway onto a
County road.

Diversion of blockage of any drainage way
is not permitted without approval of the
Planning & Community Development Department

LEGAL DESCRIPTION

The East 1/2 of the East 1/2 of the
Northwest 1/4 of Section 34, Township
13 South, Range 60 West of the
6th P.M., County of El Paso, State of
Colorado.

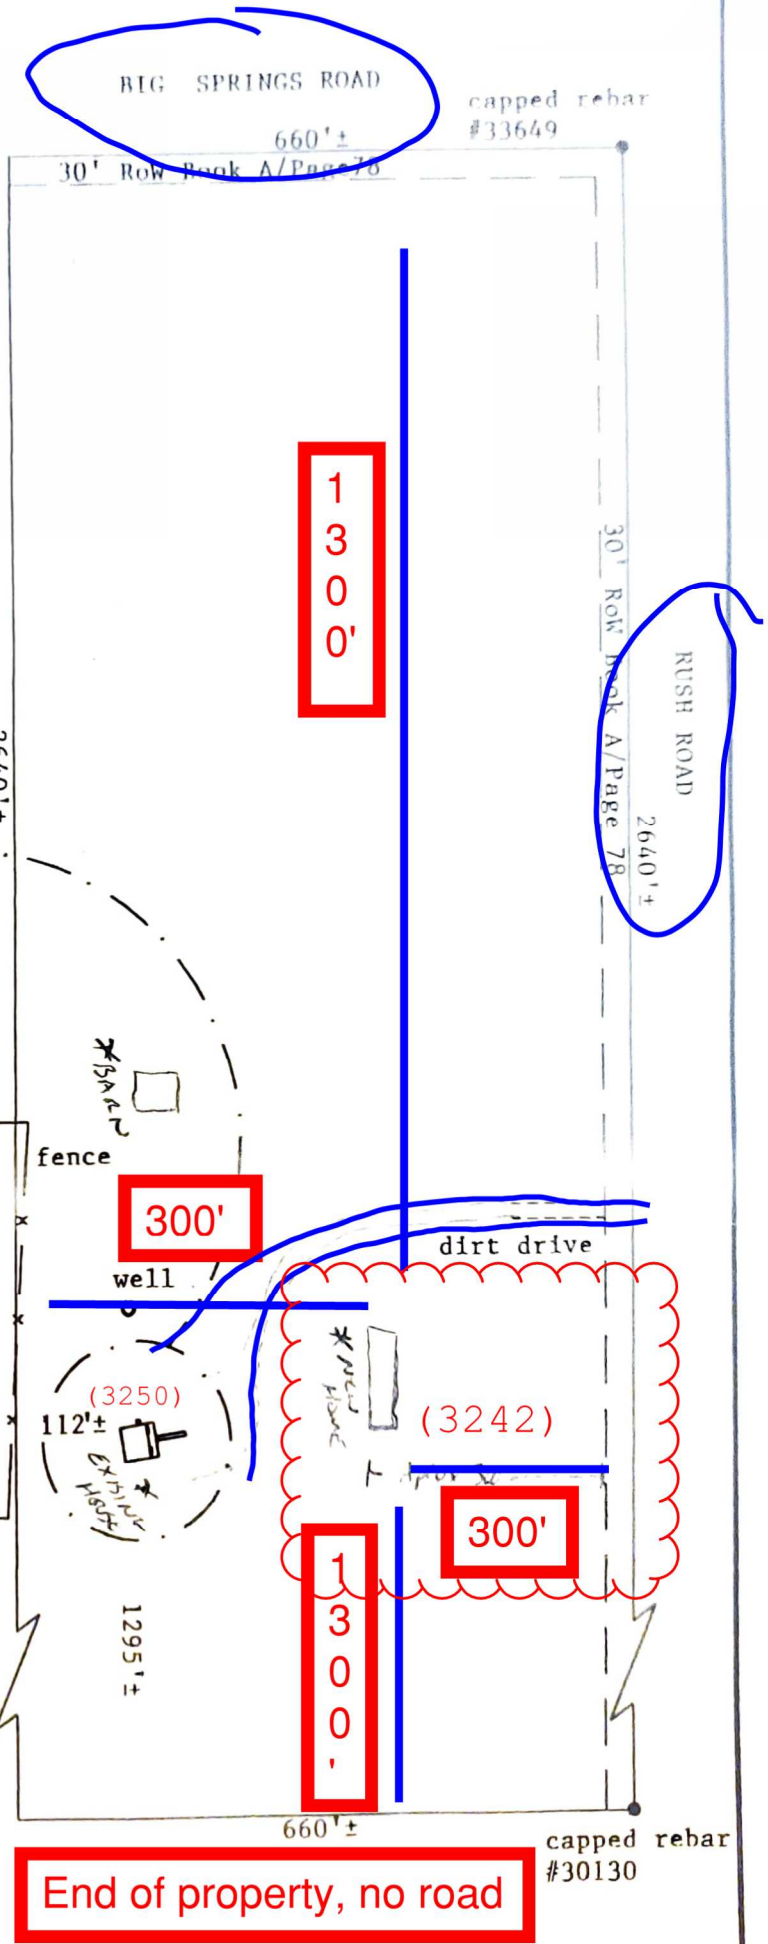

End of property, no road

RESIDENTIAL

2023 PPRBC
IECC: N/A



Parcel: 300000290

Address: ~~3250~~³²⁴² N RUSH RD, RUSH

Plan Track #: 185956 

Received: 05-Feb-2024 (BRIANNAM)

Description:

Required PPRBD Departments (4)

RES MFG HSG-HUD TEMP SET

Contractor: PAIR-A-DICE LLC

Type of Unit:

Enumeration

Released for Permit
02/06/2024 9:50:27 AM



brent
ENUMERATION

Floodplain


N/A
02/06/2024 9:50:22 AM



brent
FLOODPLAIN

Construction

Released for Permit
02/07/2024 3:24:31 PM



Shelley
CONSTRUCTION

Mechanical

Required Outside Departments (1)

County Zoning

APPROVED
Plan Review
02/12/2024 1:40:25 PM



dsdarchuleta
EPC Planning & Community
Development Department

Release of this plan does not preclude compliance with all applicable codes, ordinances and other pertinent regulations. This plan set must be present on the job site for every inspection.