



Please depict the following on this site plan:

1. Legal description of property
2. If trees are being removed, please include a note and depict them.
3. Depict all drainage ways that may impact this site and ensure that no structures are within 25 ft.
4. Existing well and septic locations, include drain field
5. Height of structures

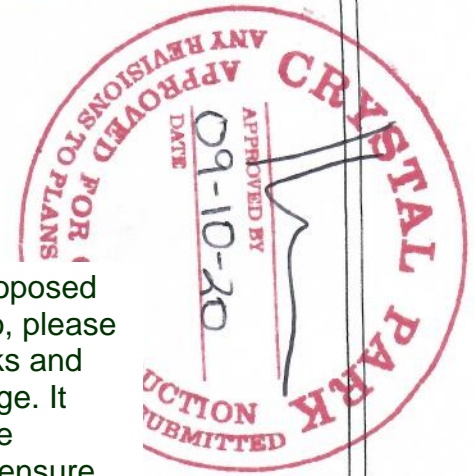

Is this the proposed garage? If so, please label setbacks and square footage. It would also be beneficial to ensure this is more clearly depicted.

Please label this as existing building, include use and square footage.

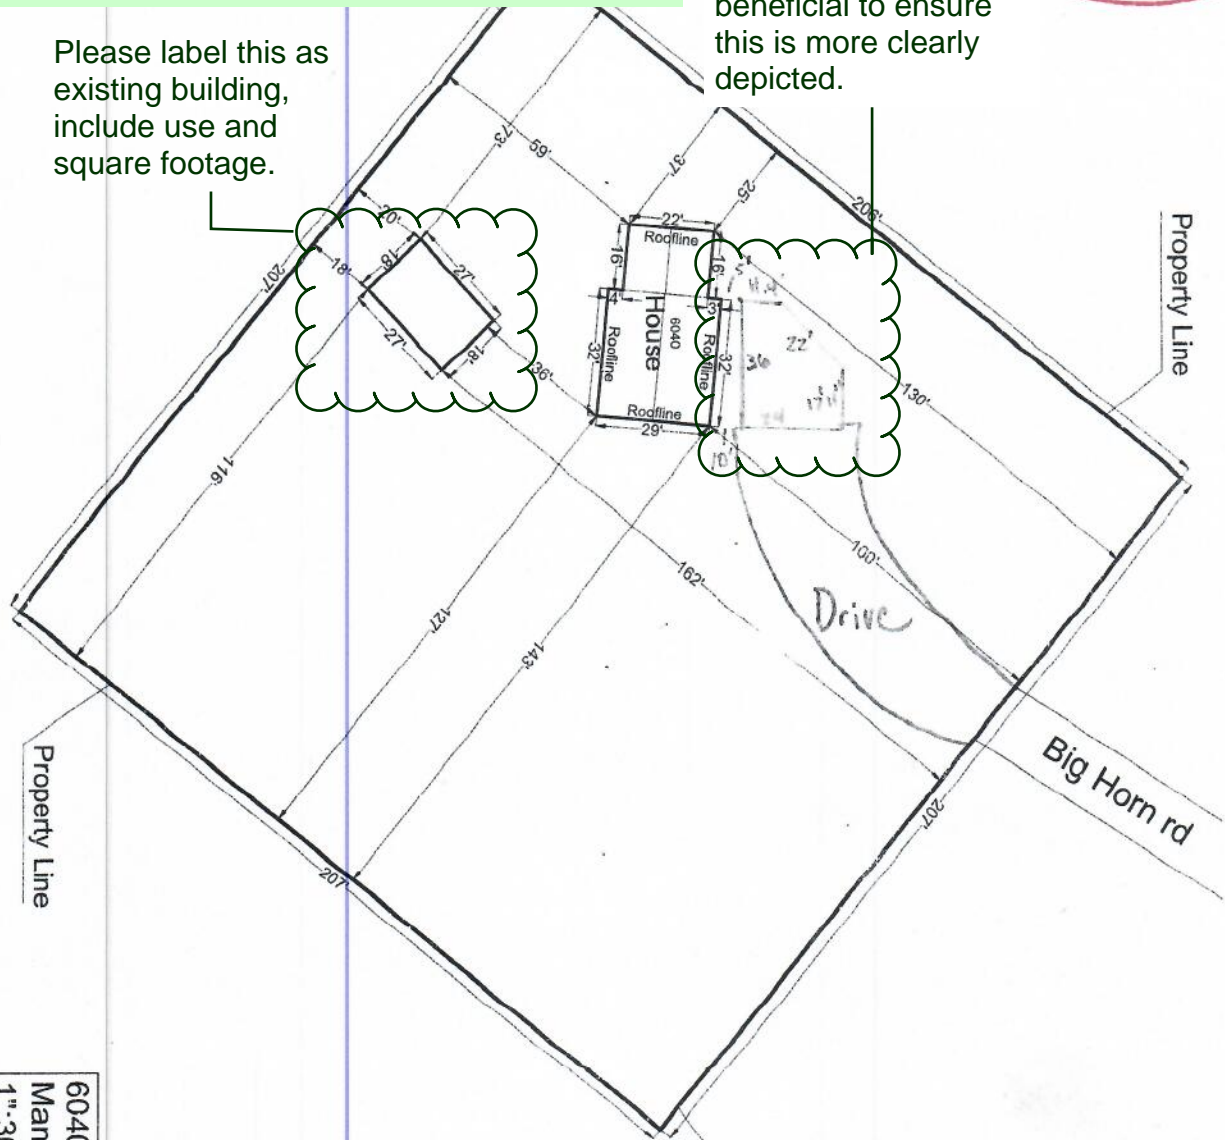

6040 Big Horn rd
Manitou Springs, CO, 80829
1"=30'

