


指向特性
Directivity

- Please include owner/applicants name and contact information
- Please provide property address
- Please provide a detailed description for lights being used, such as specifications, catalog sheets, and drawings

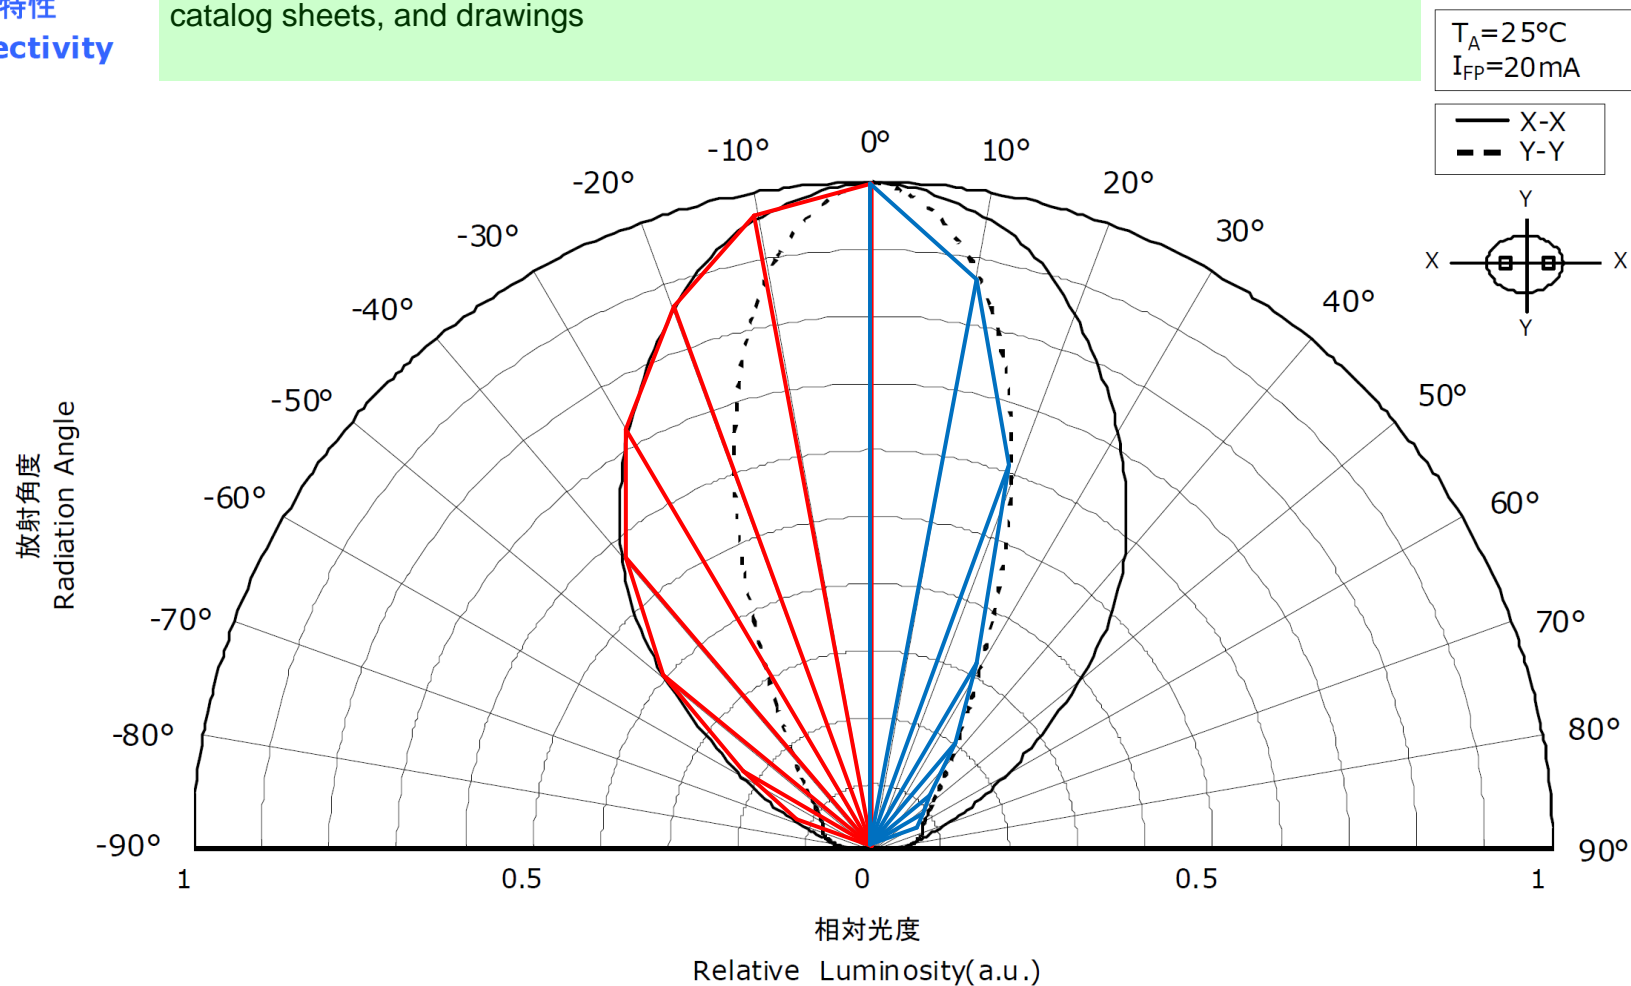

Use Nichia NSPX336 FOV
90 degree horizontal
45 degree vertical diodes
with more narrow light
broadcast dispersion.



Horizontal dispersion mapped in red

Vertical dispersion mapped in blue

10.5' x 36 Horizontal Dispersion (Plan View)


Display Height in ft	10.5	feet	
Display Width in ft	36	feet	
Display brightness nit	300	nit	
Total Square Meters	35.1174	sq meters	
Total candela output	10535.2	cd	
foot-candle threshold	0.3	foot candles	
Distance to Residential	187.396	feet	

Math for threshold distance

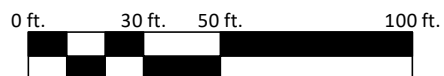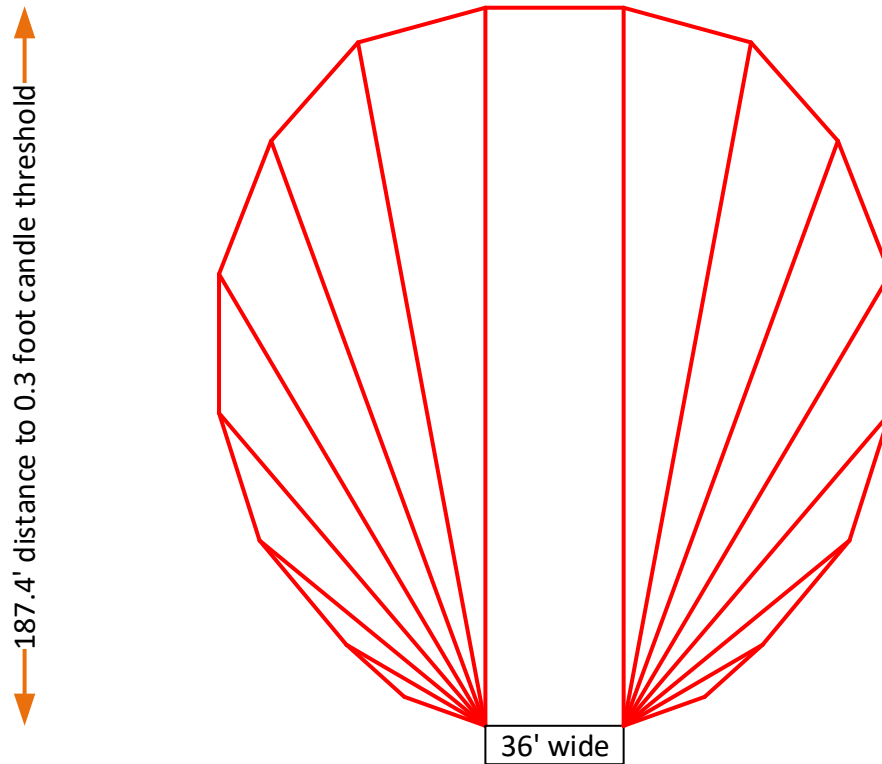

-Please provide a north arrow and preparation date on map
-Please provide a legend as well


Monument Hill

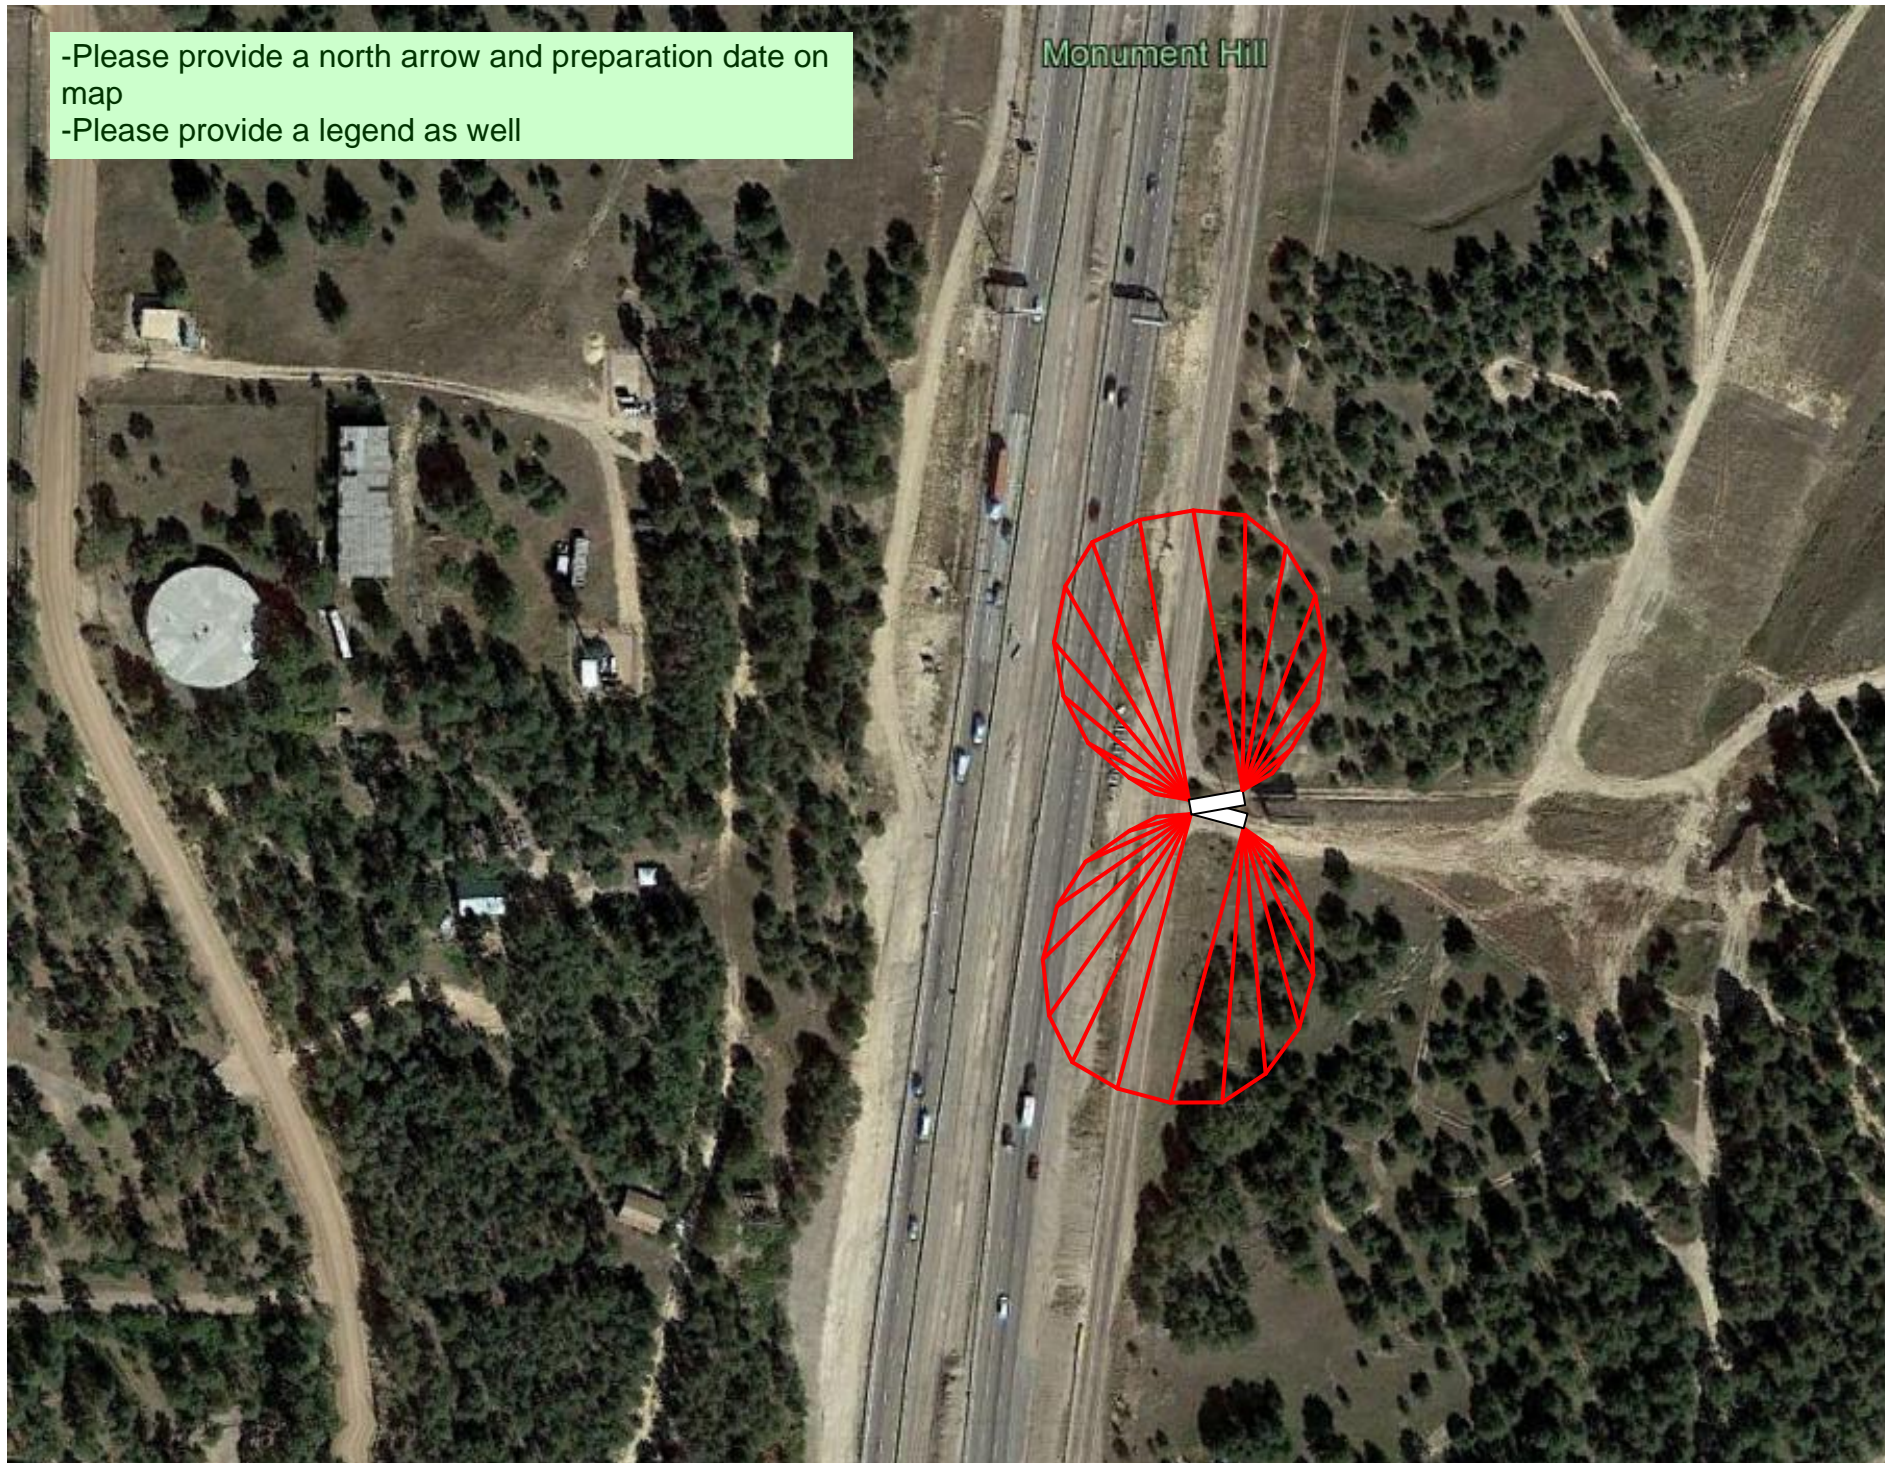

Lighting Plan_v1.pdf Markup Summary

-Please include owner/applicants name and contact information -Please provide property address -Please provide a detailed description of the project

Author: ashmathy

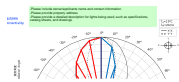

- Please include owner/applicants name and contact information
- Please provide property address
- Please provide a detailed description for lights being used, such as specifications, catalog sheets, and drawings

-Please provide a north arrow and preparation date on map -Please provide a legend as well (1)

Author: ashmathy



- Please provide a north arrow and preparation date on map
- Please provide a legend as well