



WOODMEN ROAD

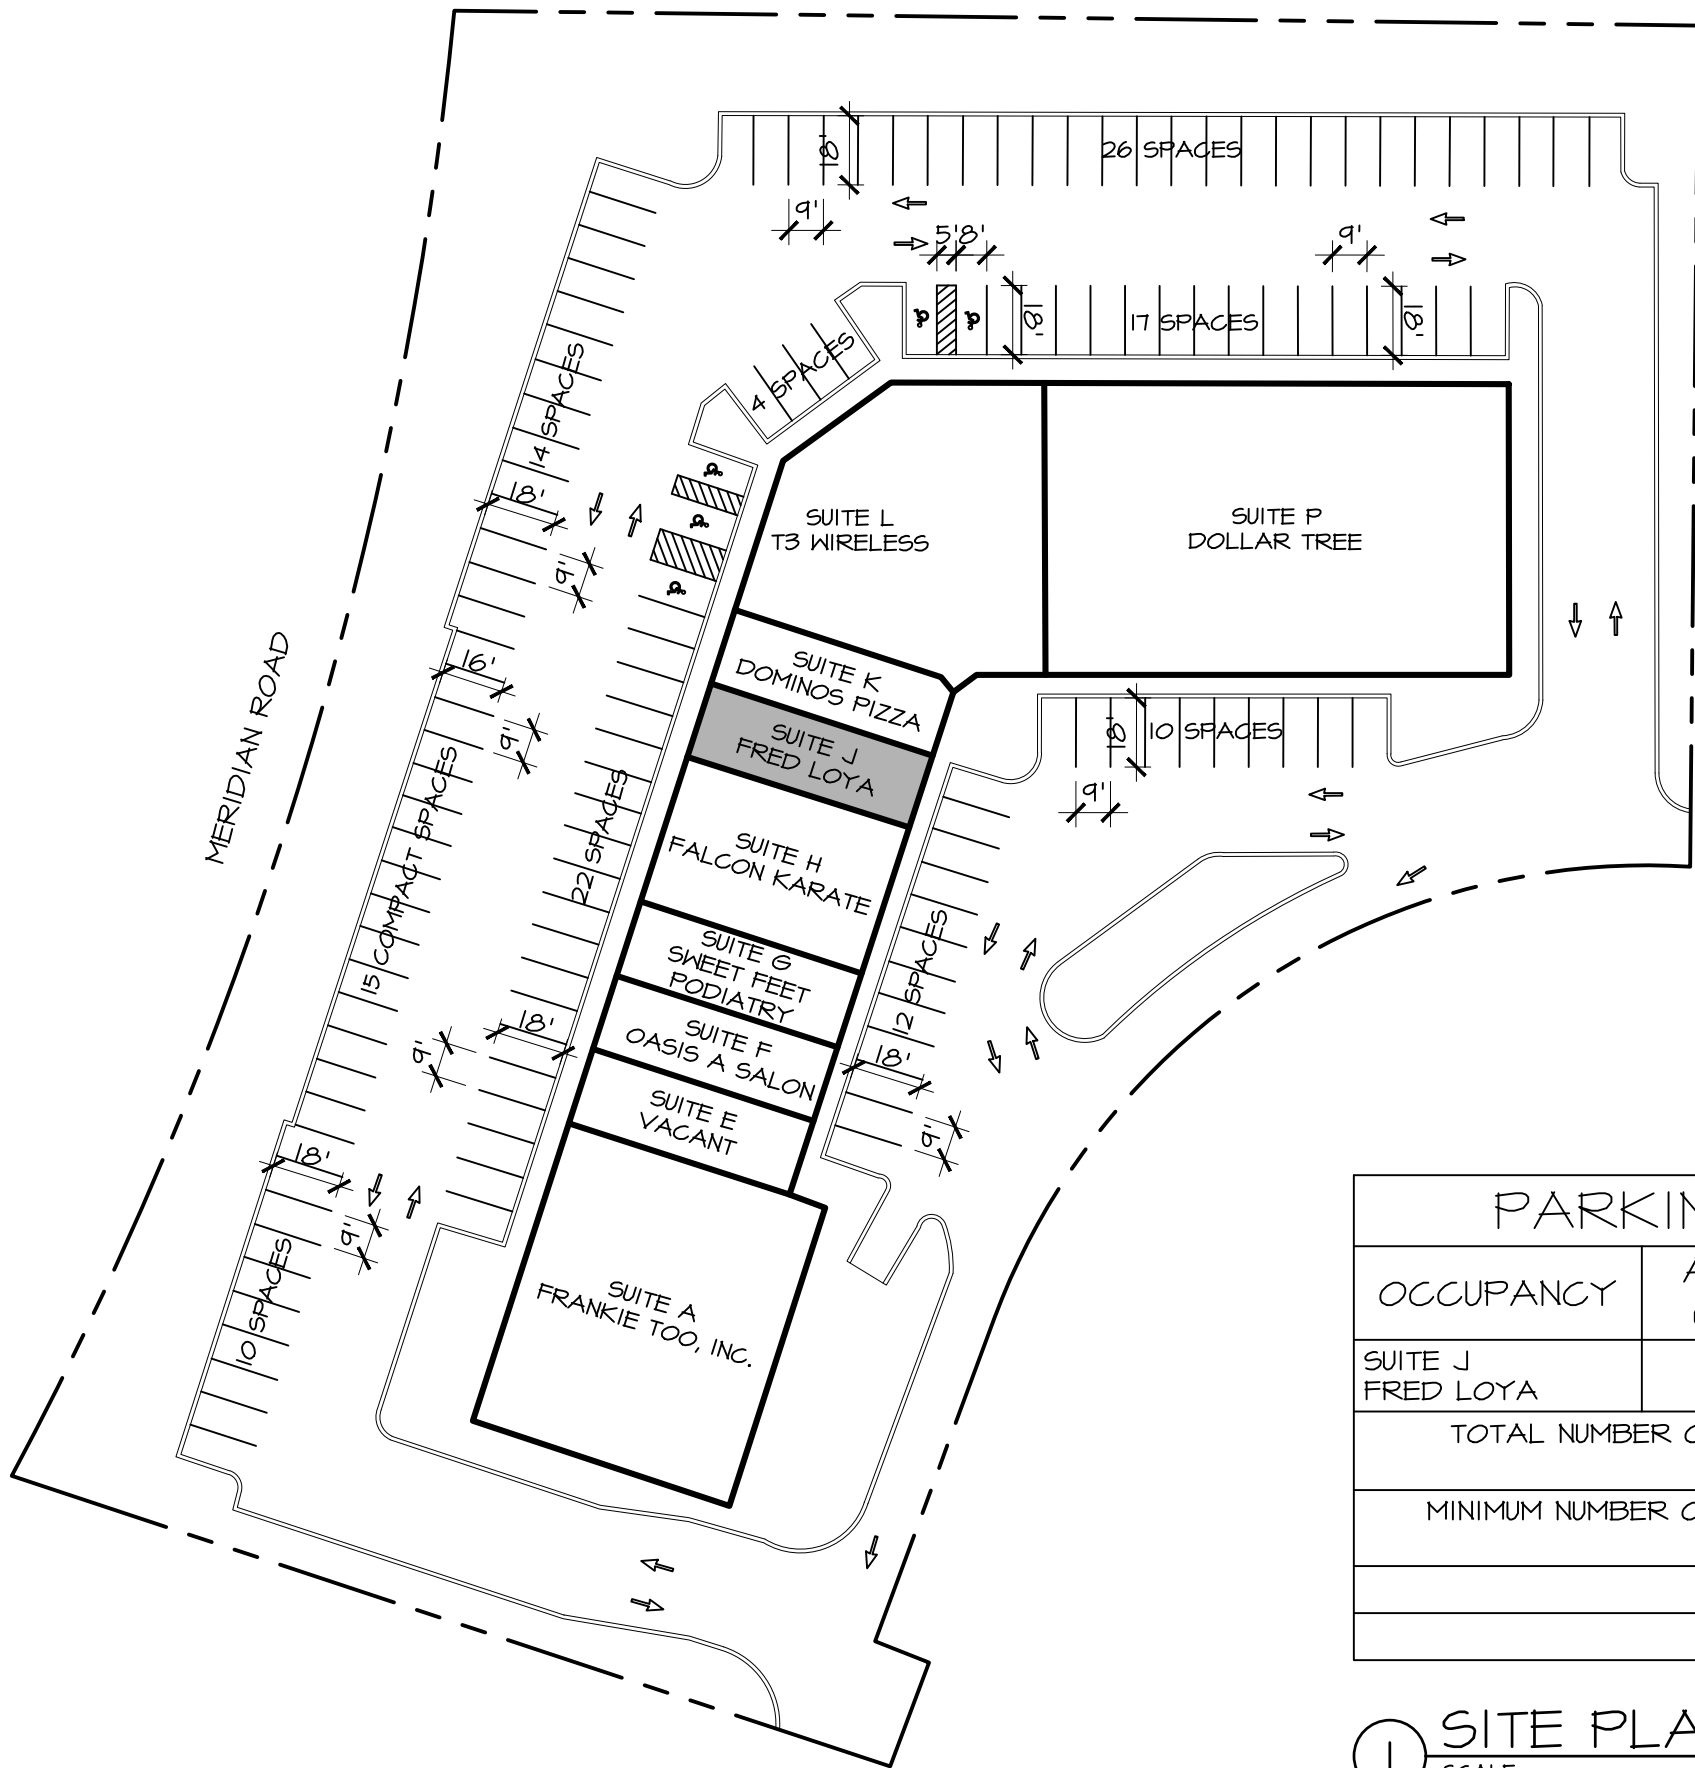

please provide exact number and not a range

PARKING CALCULATIONS			
OCCUPANCY	AREA (S.F.)	PARKING RATIO (S.F.)	SPACE REQUIRED
SUITE J FRED LOYA	1200	1 / 250	5
TOTAL NUMBER OF PARKING SPACES PROVIDED IN PARKING FACILITY			101 TO 150
MINIMUM NUMBER OF REQUIRED ACCESSIBLE PARKING SPACES			(5)
			(5 ACCESSIBLE SPACES INCLUDED)
			TOTAL PARKING 131

1 SITE PLAN
SCALE: 1" = 50'-0"

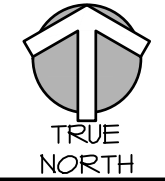

FILE NUMBER: COM2121

Project Name and Address		Project	County Comments	Sheet
FRED LOYA 7376 McLAUGHLIN ROAD SUITE J PEYTON, CO		21-067		SPI
		Date		
		3/18/21		
		Scale		
		1" = 50'-0"		
		No.	Revision/Issue	Date

EKR Drafting and Design, ph: 210-527-7096 email: joserford@outlook.com