




William MierKey  
9025 Chicago Ave  
Plan track 175293

Your letter of Intent says there will be no lighting. Please confirm whether there will be lighting or not. If the site is lighted, a photometric plan will be required.

Best Outdoor Solar Garden Lights  
Best Outside Solar Lights  
Solar Patio Lights

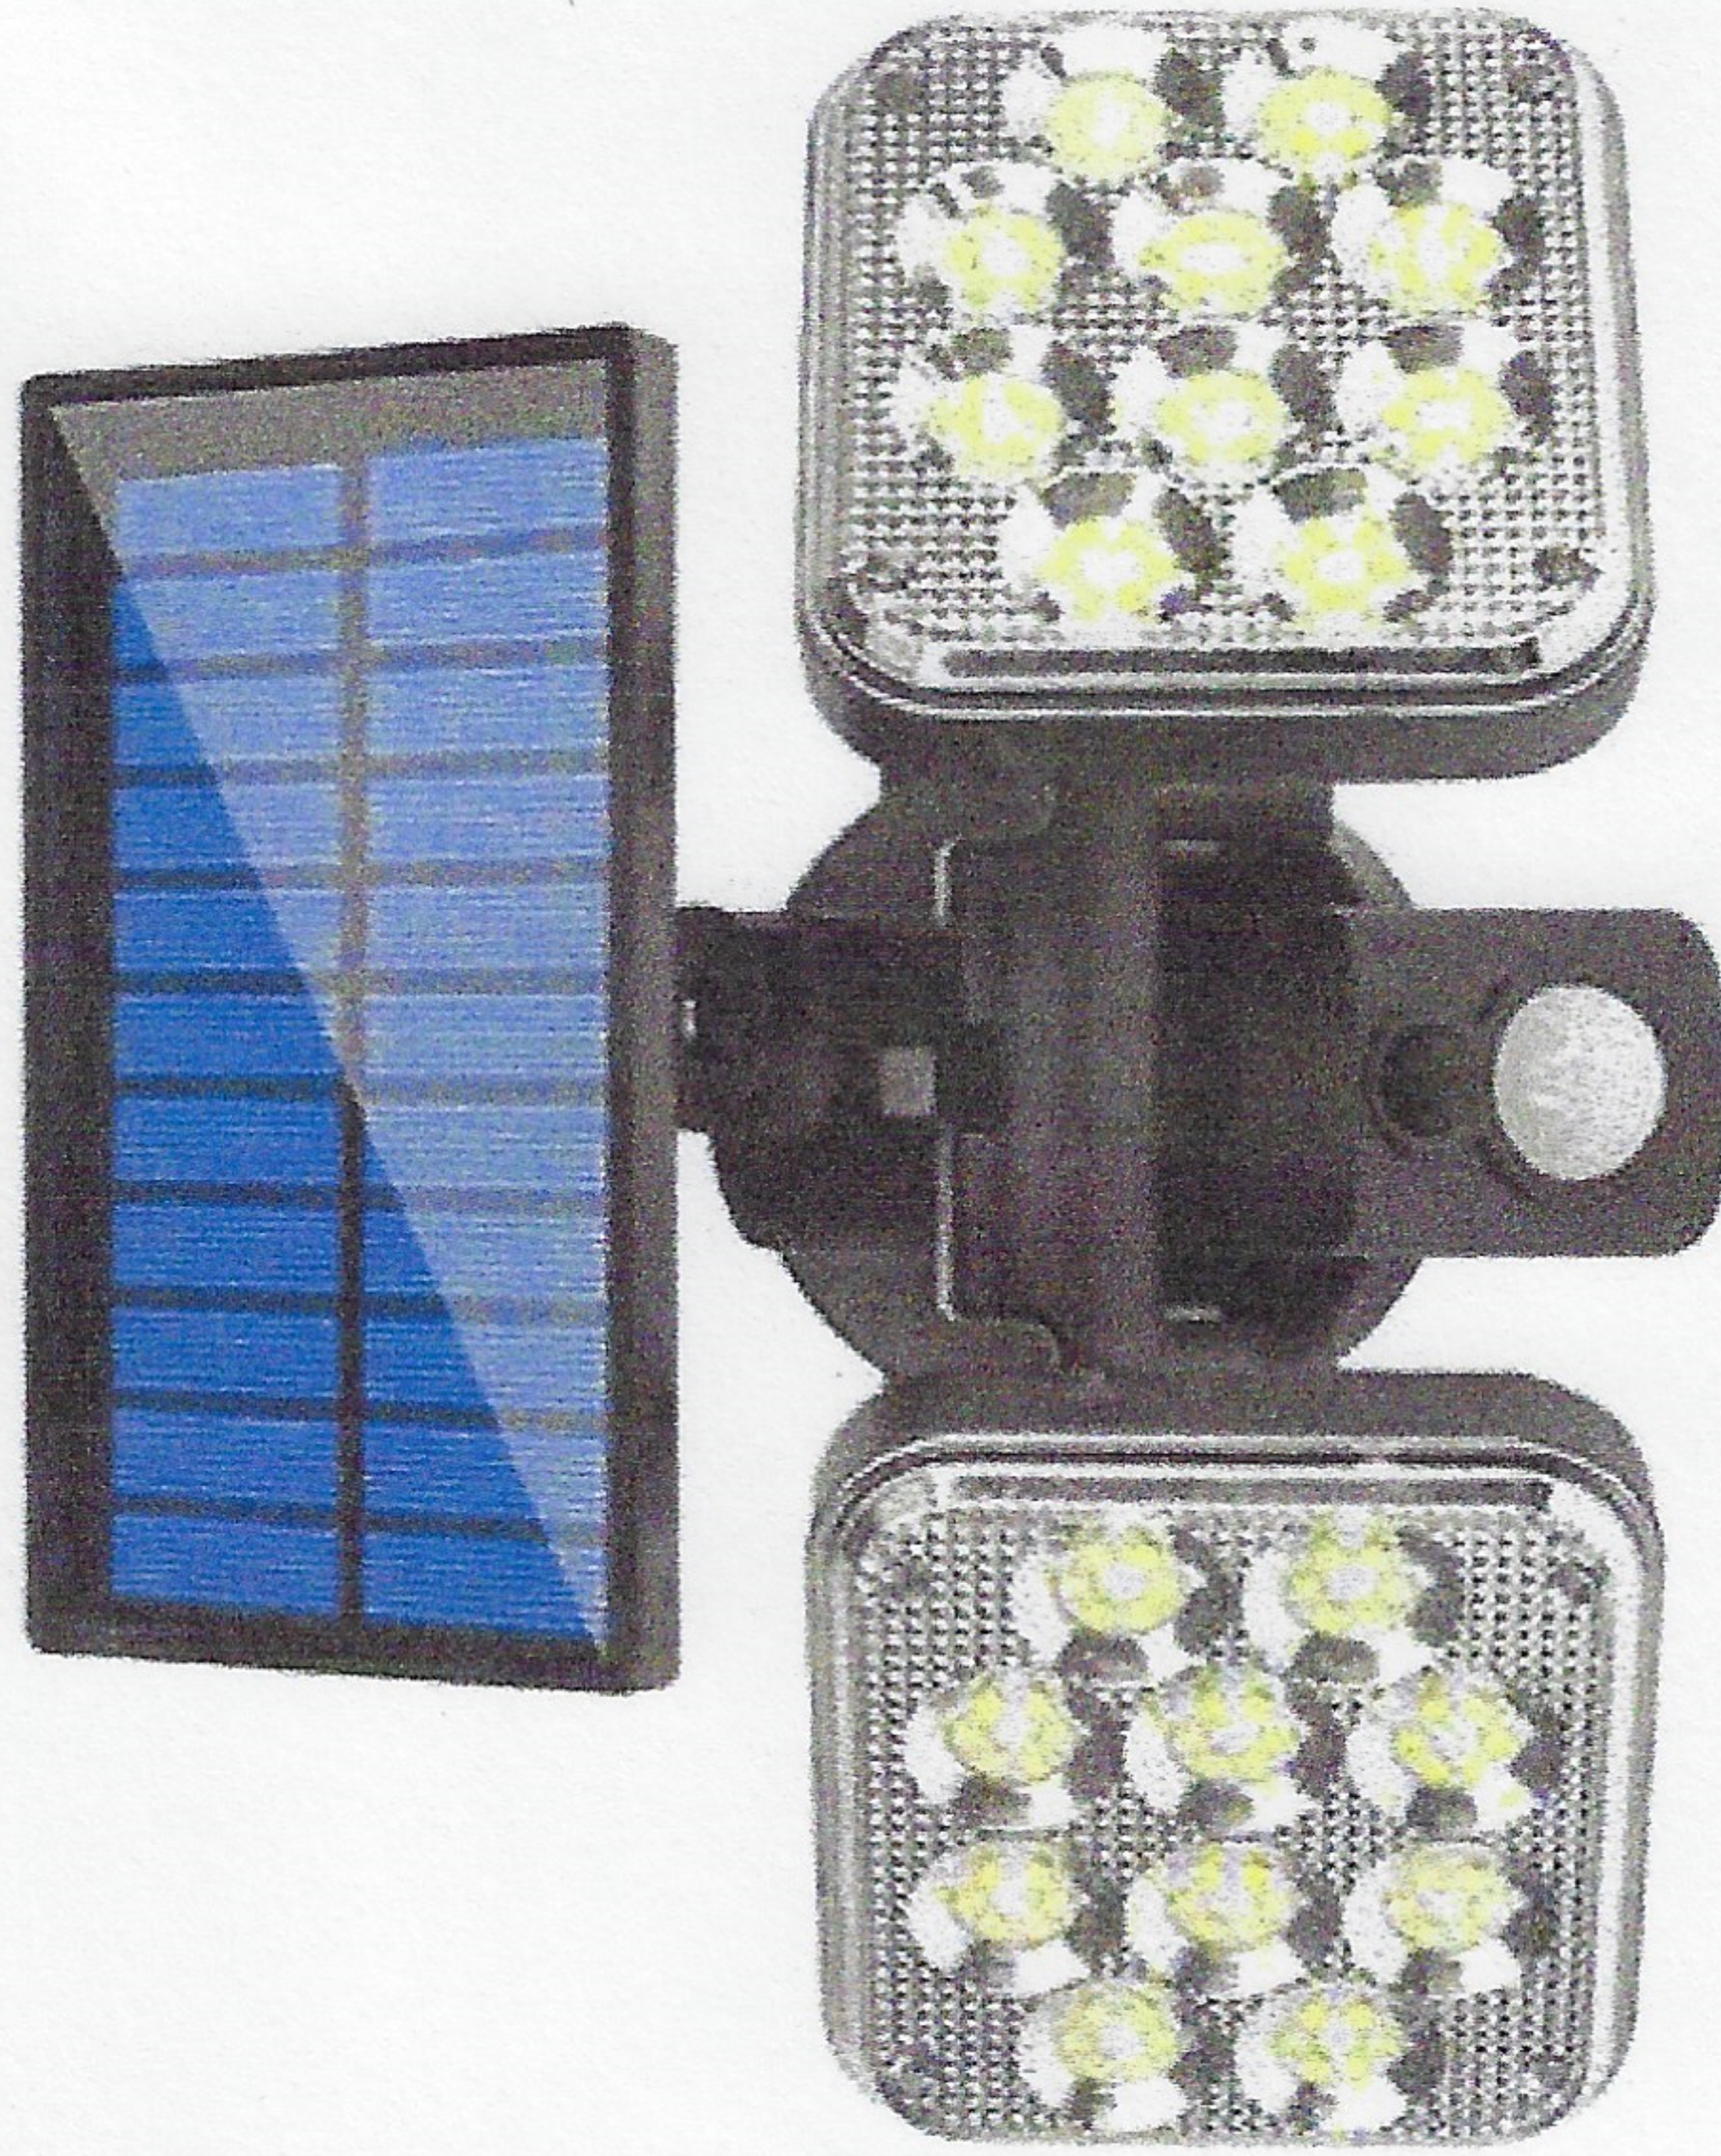

Dawn to Dusk  
Motion Sensor  
LED Light

Visual Search Save View Image More

LED Dual Head Solar Motion Sensor Detector Home Security Light Flood Spotlight | eBay



# v1\_light fixtures - REDLINES.pdf Markup Summary

---

## Text Box (1)

---



**Subject:** Text Box  
**Page Label:** 1  
**Author:** Lisa Elgin  
**Date:** 8/30/2024 2:27:26 PM  
**Status:**  
**Color:** ■  
**Layer:**  
**Space:**

Your letter of Intent says there will be no lighting. Please confirm whether there will be lighting or not. If the site is lighted, a photometric plan will be required.