

BRIAN G & JULIE A BRAATEN
 ZONED: RR-5
 REC. NO. 6111000018

YOUNGER FAMILY PARTNERSHIP
 ZONED: RR-5
 REC. NO. 6100000420

NO BUILD AREA

EXISTING 30' RIGHT OF WAY AND ROADWAY EASEMENT BOOK 2753, PAGE 97

EXISTING 20' PUBLIC UTILITY & DRAINAGE EASEMENT

EXISTING 5' PUBLIC UTILITY & DRAINAGE EASEMENT

JAMES AND KATIE SPENCE
 ZONED: RR-5
 REC. NO. 6111005001

NO BUILD AREA

ANTHONY J FELTMAN
 ZONED: RR-5
 REC. NO. 6111005002

EXISTING 30' RIGHT OF WAY AND ROADWAY EASEMENT BOOK 2469, PAGE 771

SEE SITE PLAN FOR MORE INFO

SEE SITE PLAN FOR MORE INFO

ALBERTO JIMENEZ REYNOSO
 ZONED: RR-5
 REC. NO. 6111000020

STEEP SLOPES

PROJECT INFORMATION

PCD NO: PPR2350

SITE INFORMATION:

TAX SCHEDULE NO: 6111005003
 SITE AREA: 28.52 ACRES
 ZONING: RR-5 (RESIDENTIAL-RURAL)
 LEGAL DESCRIPTION: LOT 3, WALKER RESERVE

PROPOSED LAND USE: RESIDENTIAL-RURAL
 PROPOSED BUILDING USE: RELIGIOUS INSTITUTION

PROPOSED PARKING LOT: 16,700 S.F.
 PROPOSED SIDEWALK: 1,540 S.F.
 PROPOSED MODULAR BUILDING: 11,124 S.F.
 PROPOSED DRIVEWAY WIDENING: 11,100 S.F.

PARKING REQUIRED: 1 SPACE PER 4 SEATS
 SEATS PROPOSED: 95 SEATS
 PARKING SPACES REQUIRED: 24 SPACES
 PARKING SPACES PROVIDED: 38 SPACES

PROPOSED SITE IMPERVIOUSNESS:
 IMPERVIOUS AREA = 79,267 SF (6.38%)

NOTES:

1. THE OWNER AGREES ON BEHALF OF HIM/HERSELF AND ANY DEVELOPER OR BUILDER SUCCESSORS AND ASSIGNEES THAT SUBDIVIDER AND/OR SAID SUCCESSORS AND ASSIGNS SHALL BE REQUIRED TO PAY TRAFFIC IMPACT FEES IN ACCORDANCE WITH THE EL PASO COUNTY ROAD IMPACT FEE PROGRAM RESOLUTION (RESOLUTION NO. 19-471), OR ANY AMENDMENTS THERETO, AT PRIOR TO THE TIME OF BUILDING PERMIT SUBMITTALS. THE FEE OBLIGATION, IF NOT PAID AT FINAL PLAT RECORDING, SHALL BE DOCUMENTED ON ALL SALES DOCUMENTS AND ON PLAT NOTES TO ENSURE THAT A TITLE SEARCH WOULD FIND THE FEE OBLIGATION BEFORE SALE OF THE PROPERTY.

2. THE PARTIES RESPONSIBLE FOR THIS PLAN HAVE FAMILIARIZED THEMSELVES WITH ALL CURRENT ACCESSIBILITY CRITERIA AND SPECIFICATIONS AND THE PROPOSED PLAN REFLECTS ALL SITE ELEMENTS REQUIRED BY THE APPLICABLE ADA DESIGN STANDARDS AND GUIDELINES AS PUBLISHED BY THE UNITED STATES DEPARTMENT OF JUSTICE.

APPROVAL OF THIS PLAN BY EL PASO COUNTY DOES NOT ASSURE COMPLIANCE WITH THE ADA OR ANY REGULATIONS OR GUIDELINES ENACTED OR PROMULGATED UNDER OR WITH RESPECT TO SUCH LAWS.

3. ACCESS TO THIS SITE FROM THE SOUTH IS THROUGH 3980 WALKER ROAD. THE ACCESS ROAD FOR 3980 WALKER ROAD WILL BE IMPROVED TO MEET THE CURRENT INTERNATIONAL FIRE CODE 2015 LOCAL AMENDMENTS SECTION D102. TRI-LAKES MONUMENT FIRE PROTECTION DISTRICT REQUESTS FOR MODIFICATIONS WILL BE COMPLETED POST APPROVAL PRIOR TO USE.

4. NO PORTION OF THE SITE IS LOCATED WITHIN A 100-YEAR FLOODPLAIN AS DETERMINED BY THE FLOOD INSURANCE RATE MAPS (FIRM) NUMBER 08041C0305G AND 08041C0285G EFFECTIVE DATE DECEMBER 7, 2018.

5. NO CURB AND GUTTER IS PROPOSED.

OWNER/DEVELOPER:

VALENS CAPITAL, LLC
 3980 WALKER ROAD
 COLORADO SPRINGS, CO 80908
 (719) 355-7695

CIVIL ENGINEER:

BRETT LOUK
 SMH CONSULTANTS, P.A.
 620 N TEJON STREET, SUITE 201
 COLORADO SPRINGS, CO 80903
 (719) 465-2145

SURVEYOR:

TIM SLOAN
 SMH CONSULTANTS, P.A.
 620 N TEJON STREET, SUITE 201
 COLORADO SPRINGS, CO 80903
 (719) 465-2145

PLANNING AND COMMUNITY DEVELOPMENT

DIRECTOR APPROVAL:

DIRECTOR _____ DATE _____

SMH
 CONSULTANTS

www.smhconsultants.com
 Civil Engineering • Land Surveying
 Landscape Architecture
 Manhattan, KS - HQ
 (785) 776-0541
 Dodge City, KS
 (620) 255-1952
 Kansas City
 (913) 444-9615
 Colorado Springs, CO
 (719) 465-2145

3980 WALKER ROAD
 SITE PLAN DOCUMENTS
 EL PASO COUNTY, COLORADO

REVISION DESCRIPTION
 (DESCRIPTION)

△

REVISION DATE

000000

REVISION DATE

000000

NORTH

▲

SCALE: NTS

PROJECT #: 2310-0398

CHECKED BY: BML

DRAWN BY: EDM

DATE: 6/17/2024

SHEET #

1

TOTAL SHEETS




2

SITE PLAN KEYMAP


3980 WALKER ROAD

SITE PLAN DOCUMENTS
 EL PASO COUNTY, COLORADO

please show all proposed contours and grading that was recently done to the property. Please show the limits of disturbance

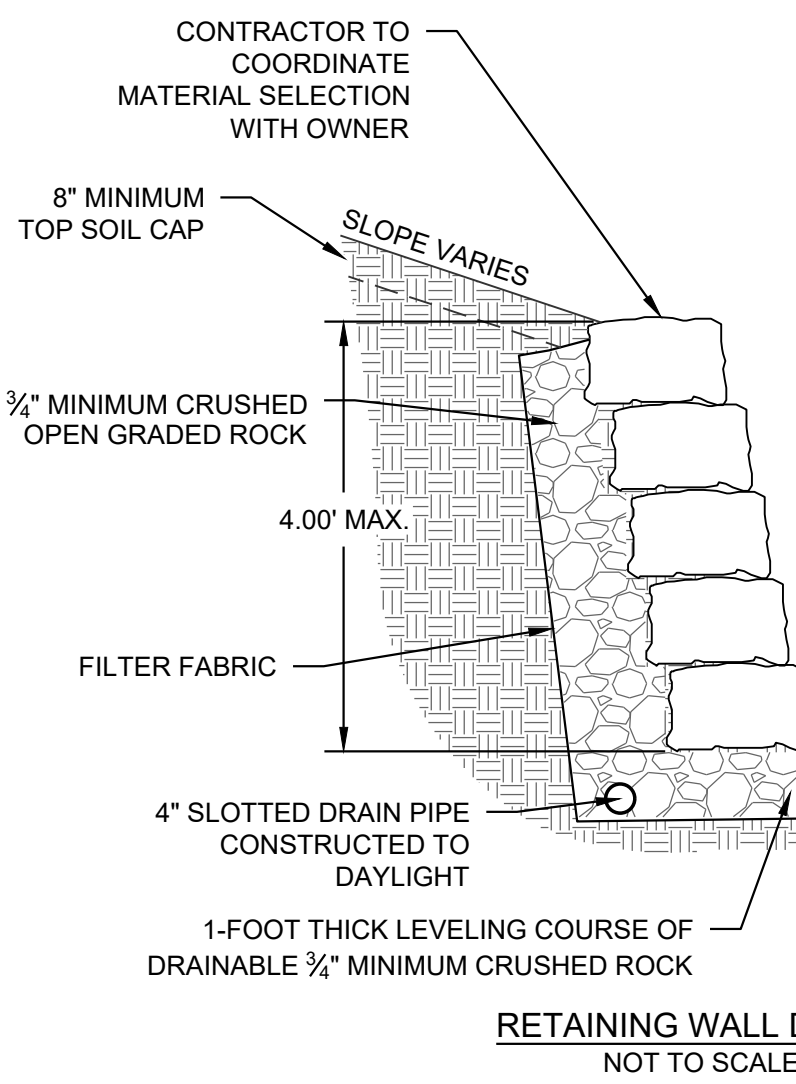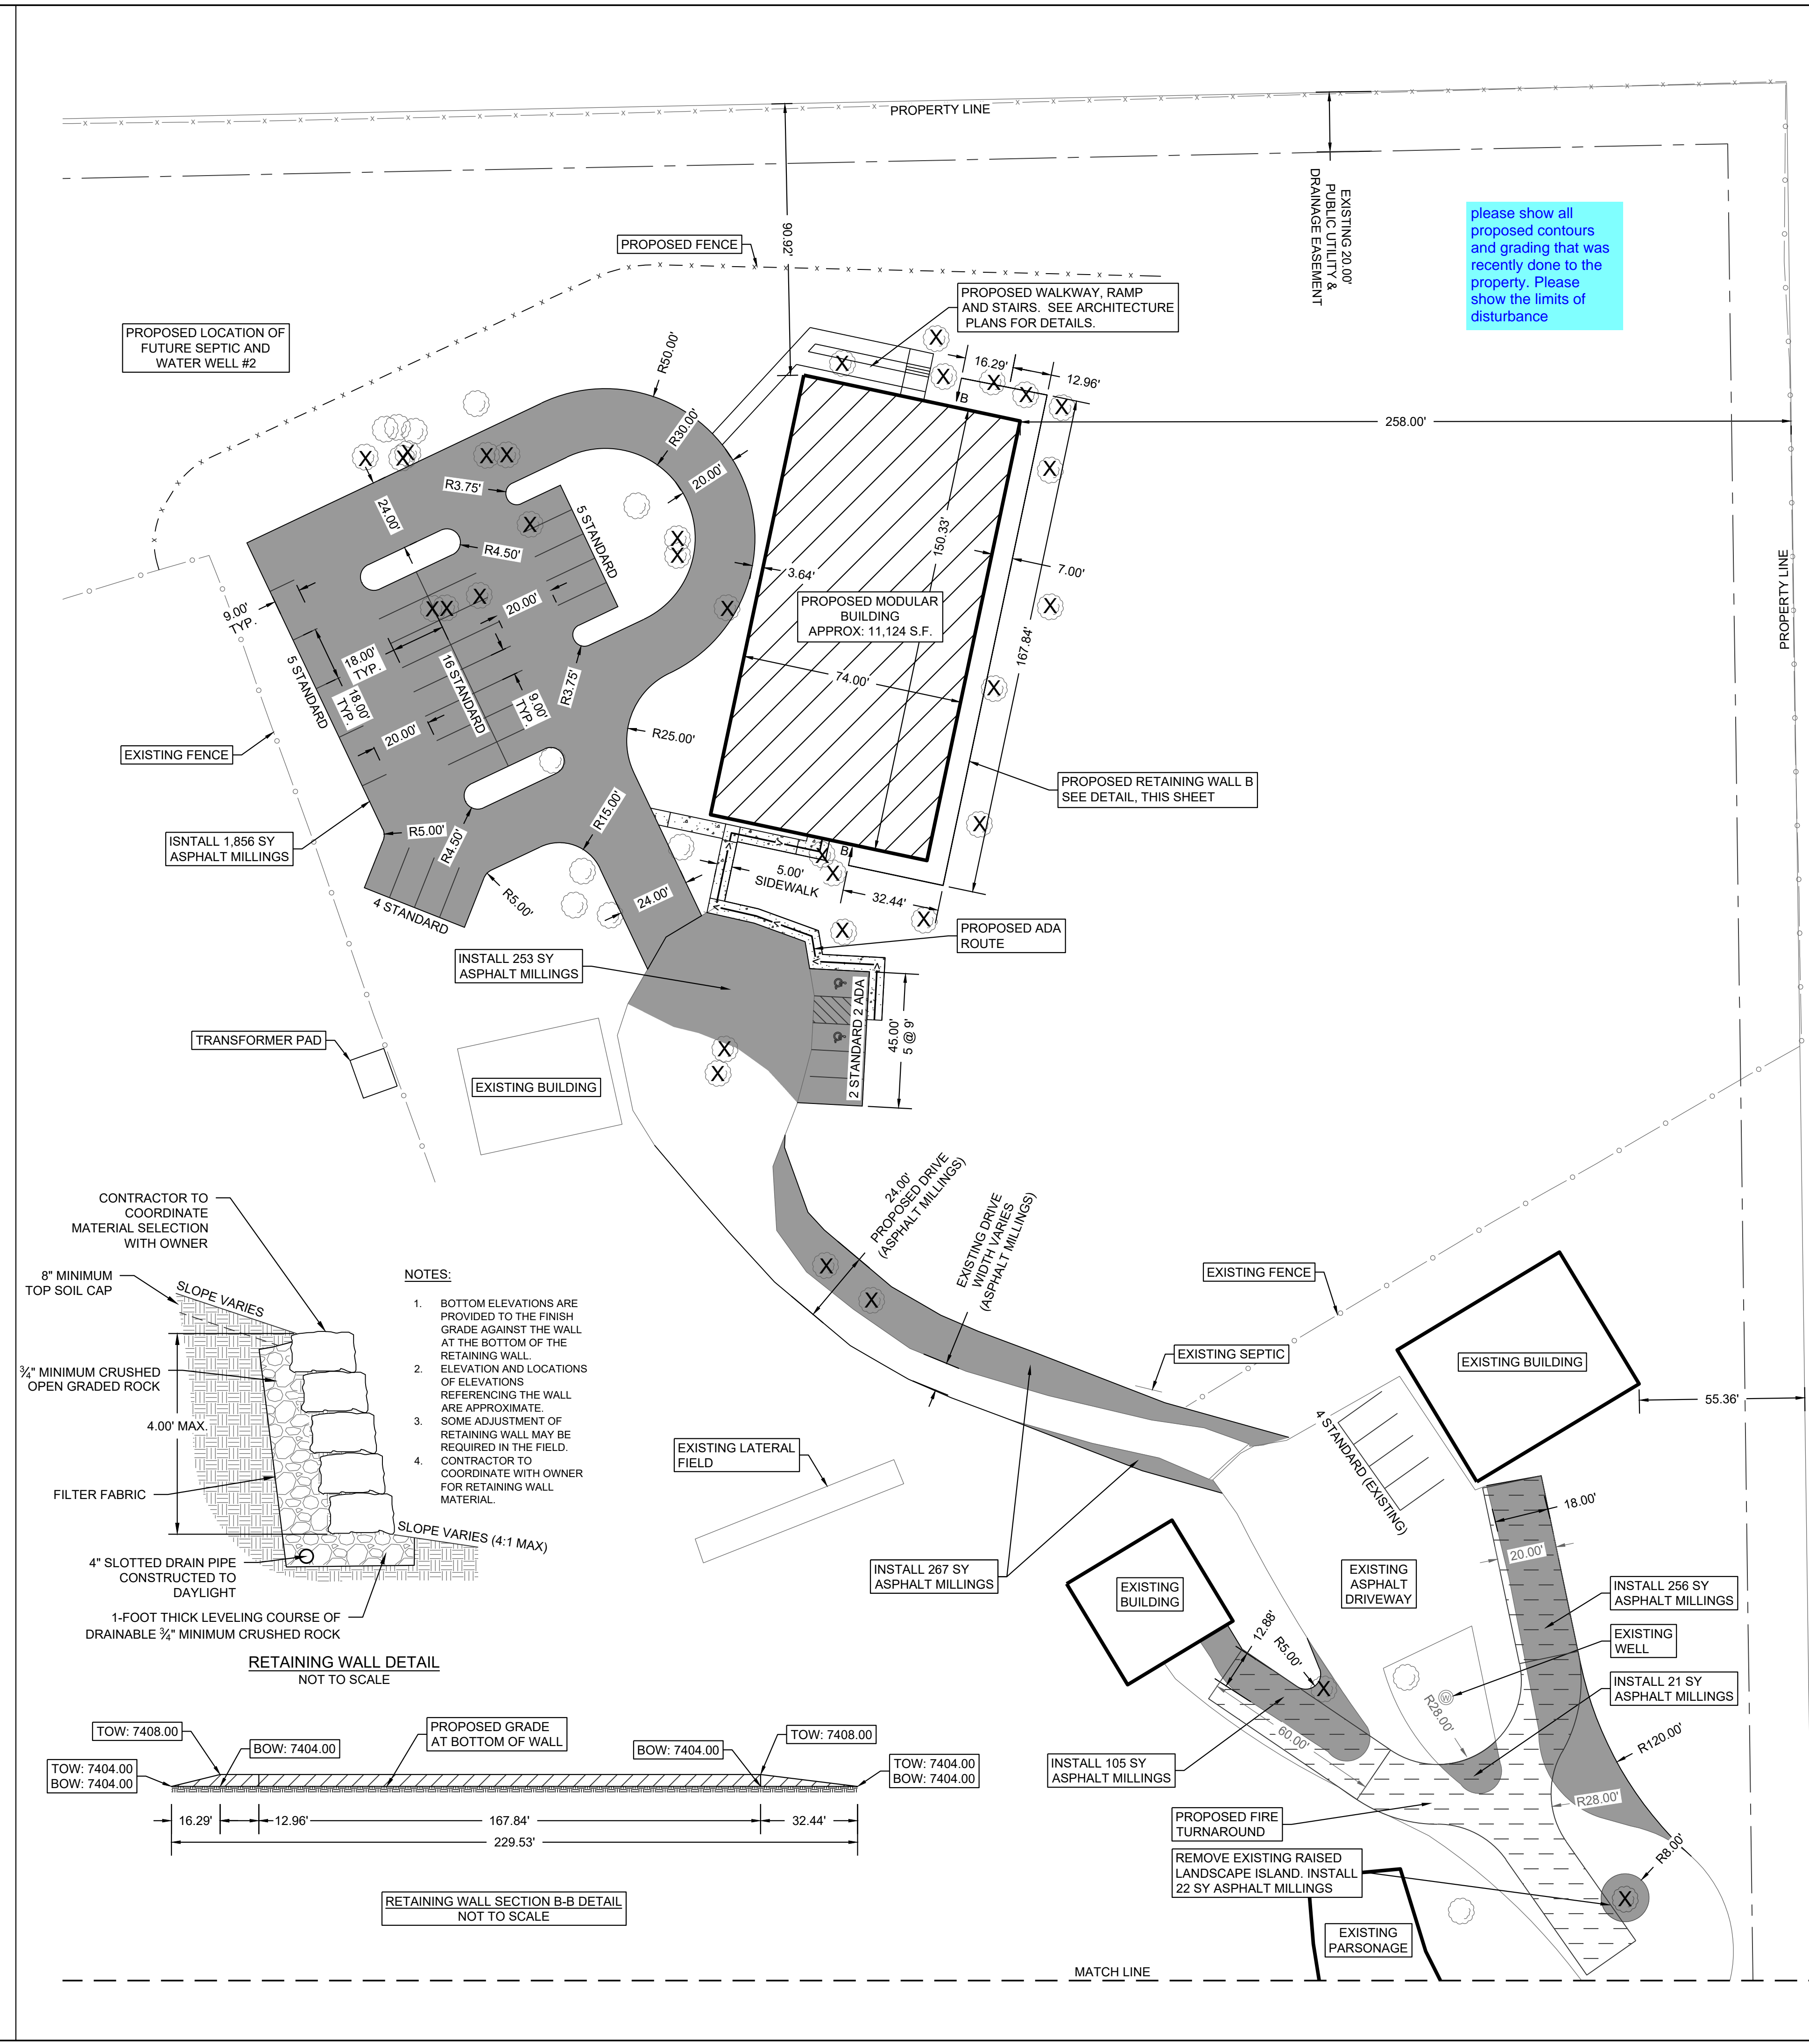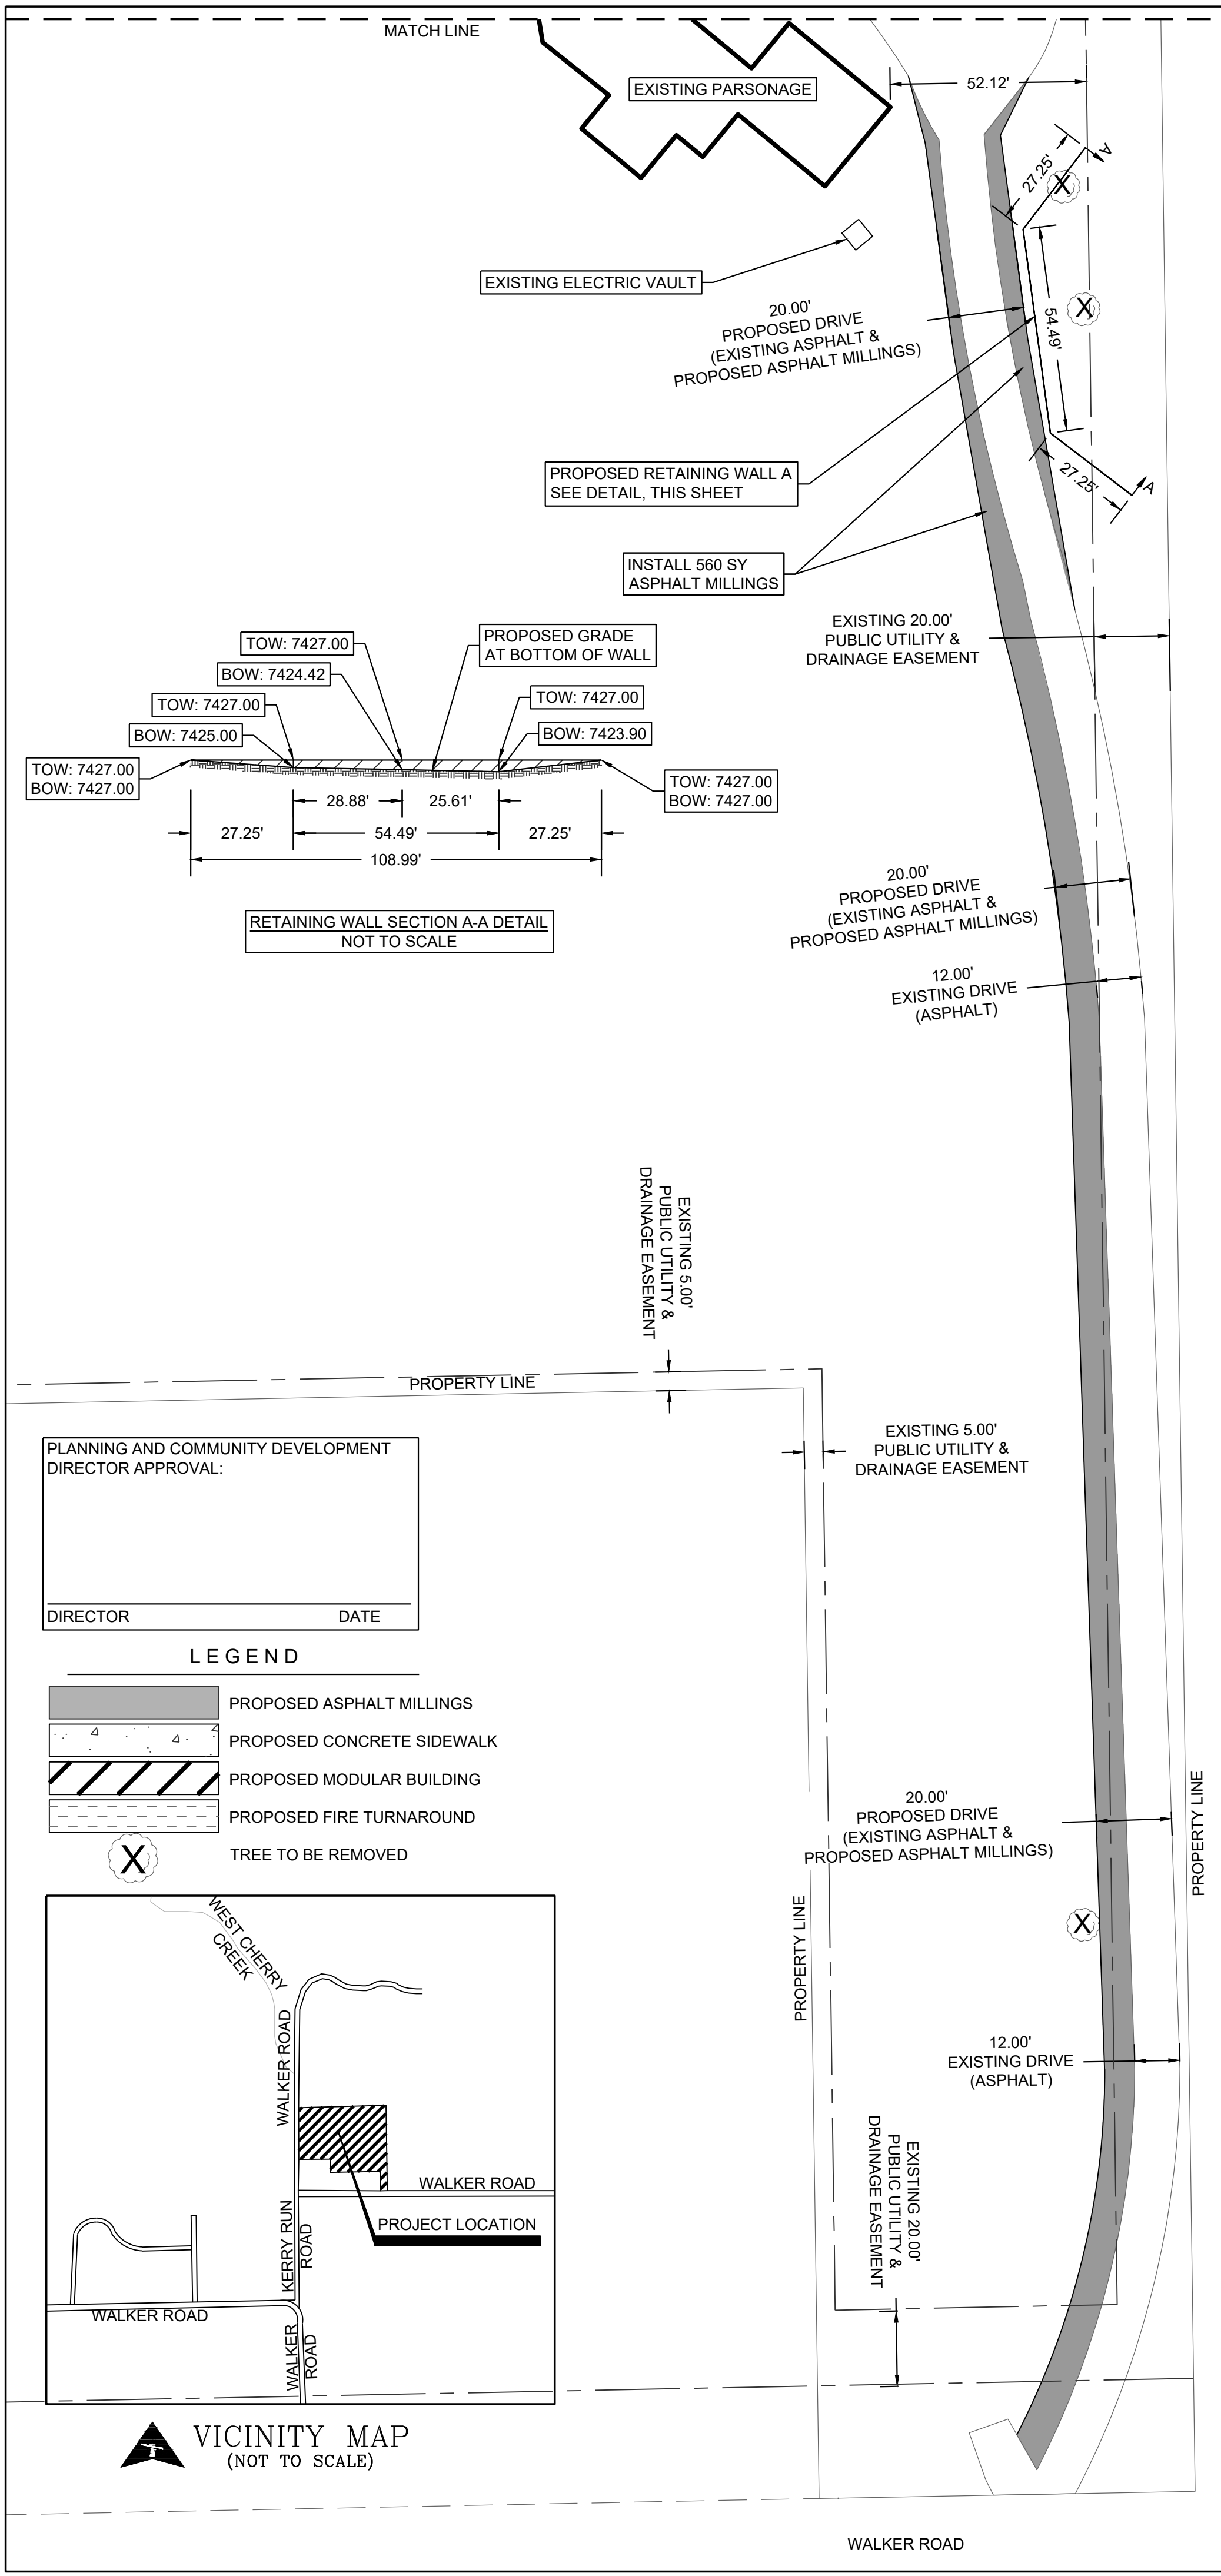

- NOTES:**
1. BOTTOM ELEVATIONS ARE PROVIDED TO THE FINISH GRADE AGAINST THE WALL AT THE BOTTOM OF THE RETAINING WALL.
 2. ELEVATION AND LOCATIONS OF ELEVATIONS REFERENCING THE WALL ARE APPROXIMATE.
 3. SOME ADJUSTMENT OF RETAINING WALL MAY BE REQUIRED IN THE FIELD. CONTRACTOR TO COORDINATE WITH OWNER FOR RETAINING WALL MATERIAL.
 - 4.

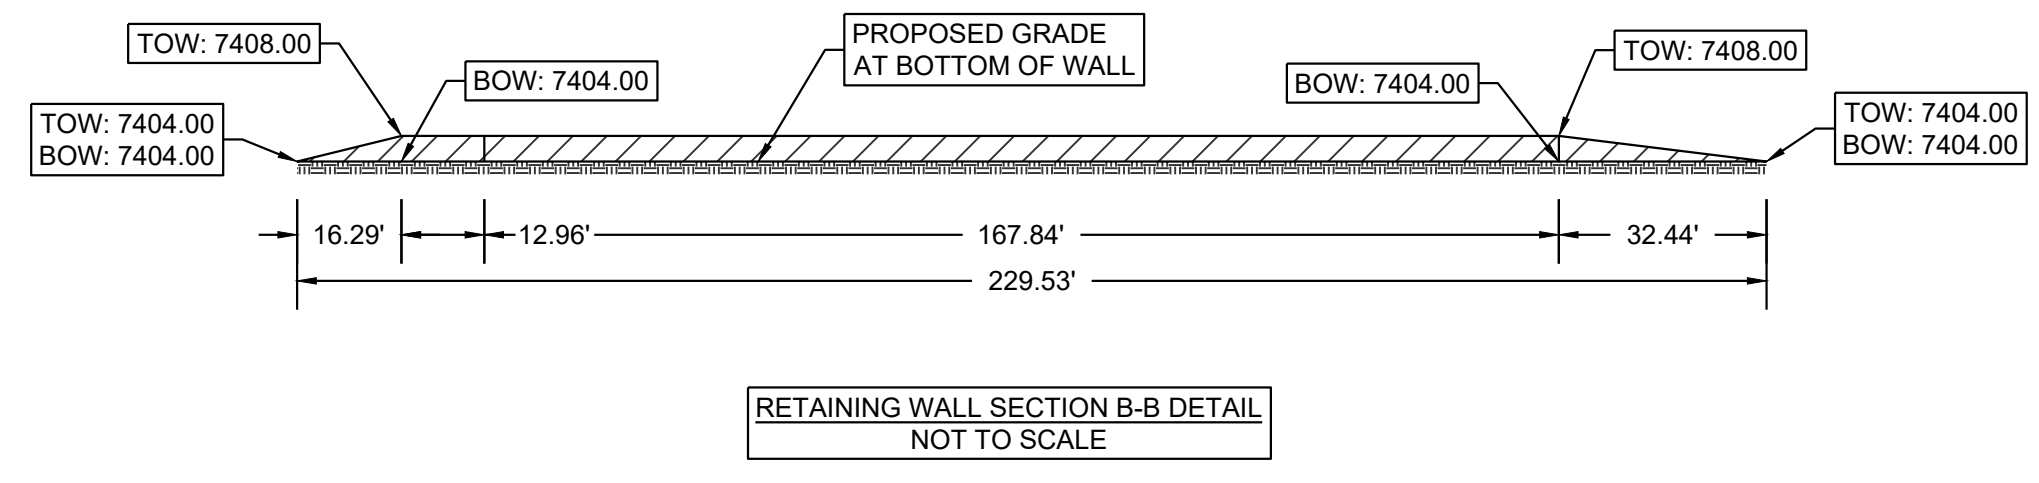

REVISION	DATE	DESCRIPTION
1	06/17/2024	ISSUE FOR PERMIT
2		
3		
4		

PROJECT #: 2310-0398
 CHECKED BY: BML
 DRAWN BY: EDM
 DATE: 06/17/2024
 SHEET # 2
 TOTAL SHEETS 2

V3_Site Development Plan with Contours.pdf Markup Summary


Callout (1)

please show all proposed contours and grading that was recently done to the property. Please show the limits of disturbance

Subject: Callout
Page Label: 2
Author: Bret
Date: 7/17/2024 12:07:48 PM
Status:
Color: ■
Layer:
Space:


please show all proposed contours and grading that was recently done to the property. Please show the limits of disturbance

(2)

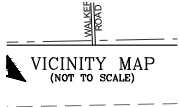

Subject:
Page Label: 2
Author: AutoCAD SHX Text
Date:
Status:
Color: □
Layer:
Space:

VICINITY MAP

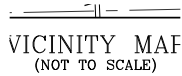

Subject:
Page Label: 2
Author: AutoCAD SHX Text
Date:
Status:
Color: □
Layer:
Space:

(NOT TO SCALE)