NABULSI-ABUSHABAN SUBDIVISION

BE IT KNOWN BY THESE PRESENTS:

That NABULSI-ABUSHABAN FAMILY TRUST, being the owner of the following described tract of land to wit:

The East 990 feet of the South 1155 feet of the Southeast Quarter of Section 19 in Township 12 South, Range 65 West of the 6th P.M., El Paso County, Colorado, EXCEPT the South 30 feet and the East 30 feet thereof;

Containing 24.796 acres, more or less.

OWNERS CERTIFICATE:

The undersigned, being all the owners, mortgagees, beneficiaries of deeds of trust and holders of other interests in the land described herein, have laid out, subdivided, and platted said land into lots, public right-of-way additions and easements as shown hereon under the name and subdivision of NABULSI-ABUSHABAN SUBDIVISION. All public improvements, and public right-of-way additions so platted, are hereby dedicated to public use and said owner does hereby covenant and agree that any public improvements will be constructed to El Paso County standards and that proper drainage and erosion control for same will be provided at said owner's expense, all to the satisfaction of the Board of County Commissioners of El Paso County, Colorado. Upon acceptance by resolution, all public improvements so dedicated will become matters of maintenance by El Paso County, Colorado. The utility easements shown hereon are hereby dedicated for public utilities and communication systems and other purposes as shown hereon. The entities responsible for providing the services for which the easements are established are hereby granted the perpetual right of ingress and egress from and to adjacent properties for installation, maintenance, and replacement of utility lines and related facilities. NABULSI-ABUSHABAN FAMILY TRUST _____ _____ Taher Nabulsi. Co-Trustee Rola Abushaban. Co-Trustee **NOTARIAL:** STATE OF CALIFORNIA COUNTY OF SAN DIEGO) Acknowledged before me this _____ day of _____, 20____, 20____ by Taher Nabulsi and Rola Abushaban, Co-Trustees for NABULSI-ABUSHABAN FAMILY TRUST. My commission expires _____ Witness my hand and seal Notary Public MORTGAGEE/LIENHOLDER: Dedication acknowledged and consent executed this _____ day of _____, 20____, 20____A.D. NEW HOME LENDING, its Successors and/or Assigns _____ _____ Signer

NOTARIAL: STATE OF _____ } SS The above and aforementioned was acknowledged before me this _____ day of _____, 20____, 20____, A.D. by _____ for NEW HOME LENDING, its Successors and/or Assians. Witness my hand and seal

My commission expires _____

_____ Notary Public

NOTES:

- 1. This survey does not constitute a title search by LDC, Inc. to determine ownership or easements of record. For all information regarding easements, rights-of-way and title of record, LDC, Inc. relied upon a Commitment for Title Insurance, prepared by FIRST AMERICAN, Commitment No. 5516-4108826 dated October 28, 2023 at 8:00 a.m.
- 2. Individual lot purchasers are responsible for constructing driveways, including necessary drainage culverts from Old Ranch Road per Land Development Code Section 6.3.3.C.2 and 6.3.3.C.3 Due to their length, some of the driveways will need to be specifically approved by the Black Forest Fire and Rescue District.
- No driveway shall be established unless an access permit has been granted by El Paso County. Driveway culverts within the indicated Common Private Access Easement must be installed prior to building permit authorization for all lots within the subdivision.
- 4. Each individual property owner is responsible for the construction and operation of a non-evaporative wastewater disposal system approved by the El Paso County Health Department. The Health Department may require a specially designed or "engineered" system prior to permit approval. Engineered systems may cost more to design, install and maintain than systems which are not engineered
- 5. Basis of Bearings: All bearings are based on the most Southerly line of this "net" tract line, monumented as shown and assumed to bear S89°58'40"W, a distance of 960.09 feet.

Add a note documenting that the 6' RPA water quality treatment facility is located within the private road easement. Identify maintenance responsibility and the parties responsible for maintenance. Add a statement clarifying that the RPAs cannot be modified without El Paso County review and approval.

A PORTION OF THE SOUTHEAST QUARTER OF SECTION 19, TOWNSHIP 12 SOUTH, RANGE 65 WEST OF THE 6TH P.M.

EL PASO COUNTY. COLORADO

NOTES (CONT.):

- 6. All structural foundations shall be located and designed by a Professional Engineer, currently registered in the State of Colorado.
- 7. All lots will have individual wells. For all individual wells, the augmentation plan/decree will allow for pumping from four (4) individual Dawson aquifer wells on four (4) residential lots. Each of the four (4) wells may withdraw up to 0.57 acre-feet annually (based on a 300-year augmentation plan/aquifer life) for a maximum of 2.28 acre feet being withdrawn by the four (4) wells/lots annually (0.26 acre feet/year/residence, with remaining amounts available for other permitted uses on the lots). Post-pumping depletions will be made by pumping water from the Laramie-Fox Hills aguifer, and all lots must participate in that.

Permits for such wells must be obtained from the Colorado Division of Water Resources. Ground water rights and an associated augmentation plan associated with the subdivision were decreed in Case No. 22CW3020, Water Division 2 (as consolidated with Case No. 22CW3036, Water Division 1, pursuant to Order of Panel on Multi-District Litiaation 22MDL12. Applicant, it successors and assigns at the time of lot sales, shall transfer rights to underlying ground water and well rights to the initial purchaser of each lot in an amount at least sufficient to satisfy the 300 year water supply requirement of El Paso County for each lot. This provision is included only to be consistent with the provisions of the augmentation plan, and does not imply the future approval by El Paso County of further subdivision of either of the four lots. Such conveyance may be accomplished either by separate quit claim deed, by other appropriate deed of the water rights associated with the lot, or by specifically identifying and transferring the water rights in the warranty deed which transfers the real property to the individual lot purchaser.

- 8. FEDERAL EMERGENCY MANAGEMENT AGENCY. Flood Insurance Rate Map Number 08041C0530 F. effective date March 17, 1997 indicates the area in the vicinity of this parcel of land to be a Zone X (area determined to be out of the 500 year flood plain).
- 9. The addresses exhibited on this plat are for informational purposes only. They are not the legal description and are subject to change.
- 10. Fire protection to be provided by the Black Forest Fire and Rescue District.
- 11. Unless otherwise indicated, side, front and rear lot lines are hereby platted on each side with a ten foot Public Utility and Drainage Easement, as shown heron. All exterior subdivision boundaries shall have a twenty foot Public Utility and Drainage Easement, except along road rights-of-way. The sole responsibility for maintenance of these easements is hereby vested with the individual property owners. \sim
- 12. The following reports and/or documentation have been submitted in association with the Preliminary Plan or Final Plat for this subdivision and are on file at the County Planning and Community Development Department, which includes, but not necessarily limited to: Letter of Intent (Deviation Request); Traffic Impact Study; Drainage Letter; Storm Water Management Plan; Detention Maintenance Agreement; Soils and Geology Report; Grading and Erosion Control Plan; PDB/BMP Operations and Maintenance Manual; Fire Protection Report; Water Resources Report; Wastewater Disposal Report; Wildfire Mitigation Plan; Construction Drawings.
- 13. All property owners are responsible for maintaining proper storm water drainage in and through their property. Public drainage easements as specifically noted on the plat shall be maintained by the individual lot owners unless otherwise indicated. Structures, fences, materials or landscaping that could impede the flow of runoff shall not be placed in drainage easements.
- 14. Developer shall comply with federal and state laws, regulations, ordinances, review and permit requirements, and other agency requirements, if any, of applicable agencies including, but not limited to, the Colorado Division of Wildlife. Colorado Department of Transportation, U.S. Army Corps of Engineers and/or the U.S. Fish and Wildlife Service regarding the Endangered Species Act, particularly as it relates to the listed species, if applicable.

Please be aware that any additional improvements may interfere with Abert's Squirrel, Black Bear, Elk, Mountain Lion, and Mule Deer habitat (species of concern to the State of Colorado) during and/or following construction. Information regarding wildlife protection measures should be provided to construction personnel and future residents, including fencing requirements, garbage containment, pets, enhancement/maintenance of natural vegetation, weed control and riparian/wetland protection/buffer zones as appropriate. Information can be obtained from the Colorado Division of Wildlife.

- 15. Mailboxes shall be installed in accordance with all El Paso County and United States Postal Service regulations.
- 16. Any person who knowingly removes, alters or defaces any public land survey monument or land boundary monument or accessory commits a Class Two (2) misdemeanor pursuant to C.R.S. 18-4-508.
- 17. The subdivider(s) agrees on behalf of him/herself and any developer or builder successors and assignees that subdivider and/or said successors and assigns shall be required to pay traffic impact fees in accordance with El Paso County Road Impact Fee Program Resolution (Resolution No. 19-471), or any amendments thereto, at or prior to the time of building permit submittals. The fee obligation, if not paid at final plat recording, shall be documented on all sales documents and n plat notes to ensure that a title search would find the fee obligation before sale of the property.
- 18. All property within this subdivision is subject to a Common Private Access Agreement as recorded under Reception No. _____, of the records of the El Paso County Clerk and Recorder.
- 19. The site has been found to be impacted by the following geologic constraints/hazards: artificial fill, downslope creep (No-Build Area Easement), expansive soils, potentially seasonal wet (No-Build Area Easement), and seasonal shallow groundwater areas (No-Build Area Easement), and shallow bedrock. The geologic constraints/hazards and mitigation measures can be found as mapped in the Soils and Geology Study completed by Entech Engineering, Inc., revised date May 22, 2023, available at the El Paso County Planning and Community Development Department. Downslope Creep: was identified on Lots 2 and 3; Potentially Seasonal and Seasonal high groundwater: were identified on each lot, and should be avoided by planned structures or on-site wastewater treatment systems; Expansive Soils and Bedrock: potential exists for each lot; Shallow Bedrock: potential exists for each lot.
- 20. The Private Road Easement (Serenity Ridge View) as shown on this Plat will not be maintained by El Paso County until and unless the streets are constructed in conformance with El Paso County standards in effect at the date of the request for dedication and maintenance.
- 21. There shall be no direct lot access to Black Forest Road. There shall be no direct lot access to Old Ranch Road, except via Serenity Ridge View Private Road Easement (60' width).
- 22. Public and Common Subdivision Improvements: No lot or interest therein, shall be sold, conveyed, or transferred whether by deed or by contract, nor shall building permits be issued, until and unless either the required public and common development improvements have been constructed and completed and preliminary accepted in accordance with the Subdivision Improvements Agreement between the applicant/owner and El Paso County as recorded under

Reception Number ______ in the Office of the Clerk and Recorder of El Paso County, Colorado or, in the alternative, other collateral is provided to make provisions for the completion of said Improvements in accordance with the El Paso County Land Development Code and Engineering Criteria Manual. Any such alternative collateral must be approved by the Board of County Commissioners or, if permitted by the Subdivision Improvements Agreement, by the Planning and Community Development Department Director and meet the policy and procedure requirements of El Paso County prior to the release by the County of any lots for sale, conveyance or transfer. This plat restriction may be removed or rescinded by the Board of County Commissioners or, if permitted by the Subdivision Improvements Agreement, by the Planning and Community Development Department Director upon either approval of an alternative form of collateral or completion and preliminary acceptance by the El Paso Board of County Commissioners of all improvements required to be constructed and completed in accordance with said Subdivision Improvements Agreement. The partial release of lots for sale, conveyance or transfer may only be granted in accordance with any planned partial release of lots authorized by the Subdivision Improvements Agreement.

FEES:

Park Fee: _____ Drainage Fee: _____

School Fee: _____ Bridge Fee: _____

Please remove Preliminary Plan and leave "Final Plat"

SURVEYOR'S CERTIFICATION:

David V. Hostetler

BOARD OF COUNTY COMMISSIONERS CERTIFICATE:

This plat for NABULSI-ABUSHABAN SUBDIVISION was approved for filing by the El Paso County, Colorado Board of County Commissioners on the ____ day of _____, 20___, subject to any notes specified hereon and any conditions included in the resolution of approval. The dedications of land


to the public streets and easements are accepted, but the public improvements thereon will not become the maintenance responsibility of El Paso County until preliminary acceptance of the public improvements in accordance with the requirements of the Land Development Code and Engineering Criteria Manual, and the Subdivision Improvements Agreement.

Chair, Board of County Com	missioners	Date	
			Please remove
APPROVALS:			
This subdivision was approve	d by the El Paso Cour	ity Development Services Dep	partment this
day of	, 20 A.D.		3
······	······	······	mmm
		Development	t Services Director)
RECORDING:	Planning and	uu	
STATE OF COLORADO } SS	Community Development Director		
COUNTY OF EL PASO >			
hereby certify that this ins	trument was filed for r	ecord in my office at	_ o'clockM.,
his day of		, 20 A.D., and is c	duly recorded under
Reception No		of the records of El Paso (County, Colorado.
		Steve Schleiker, Reco	rder
SURCHARGE:			
 -EE:		BY:Deputy	
		Deputy	
		PCI	D FILE NO.: MS2211

Chair, Board of County Commissioners		Date	
			Please remove
APPROVALS:			
This subdivision was approve	d by the El Paso C	ounty Development Services Dep	partment this
day of	, 20 A.D.		3
······	······	uuuuu	uuuu
		Development	t Services Director
RECORDING:	Planning and		
STATE OF COLORADO } SS	Community Development Direct	tor	
COUNTY OF EL PASO			
I hereby certify that this ins	trument was filed fo	or record in my office at	_ o'clockM.,
this day of		, 20 A.D., and is c	duly recorded under
Reception No		of the records of El Paso (County, Colorado.
		Steve Schleiker, Reco	rder
SURCHARGE:		BY	
FEE:		BY: Deputy	
			II


EPC STORMWATER REVIEW COMMENTS IN ORANGE BOXES WITH BLACK TEXT


.....

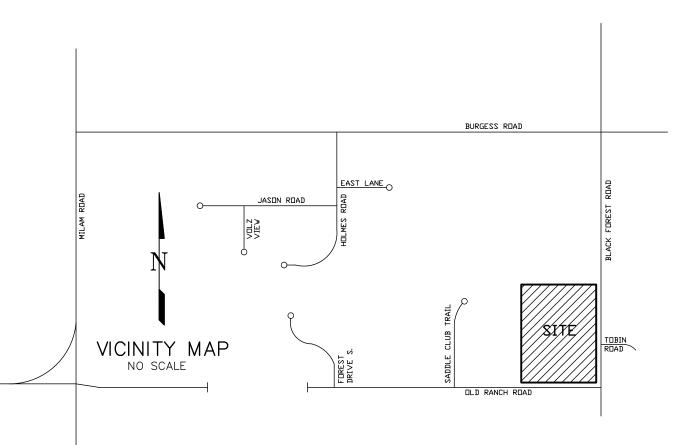

I David Hostetler, a duly registered Professional Land Surveyor in the State of Colorado, do hereby certify that this plat truly and correctly represents the results of a survey made on date of survey, by me or under my direct supervision and that all monuments exist as shown hereon; that mathematical closure errors are less than 1:10,000 ; and that said plat has been prepared in full compliance with all applicable laws of the State of Colorado dealing with monuments, subdivision, or surveying of land and all applicable provisions of the El Paso County Land Development Code.

Colorado Professional Land Surveyor No. 20681

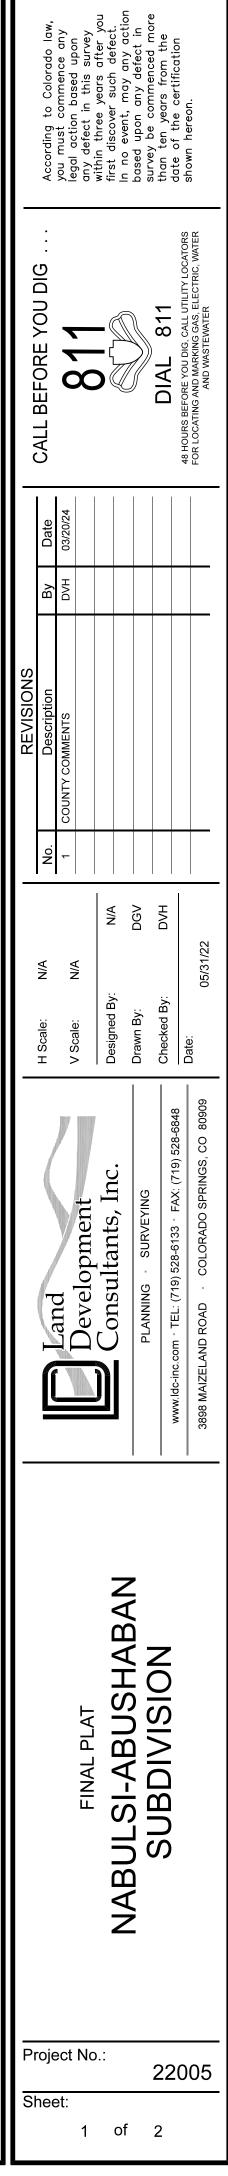

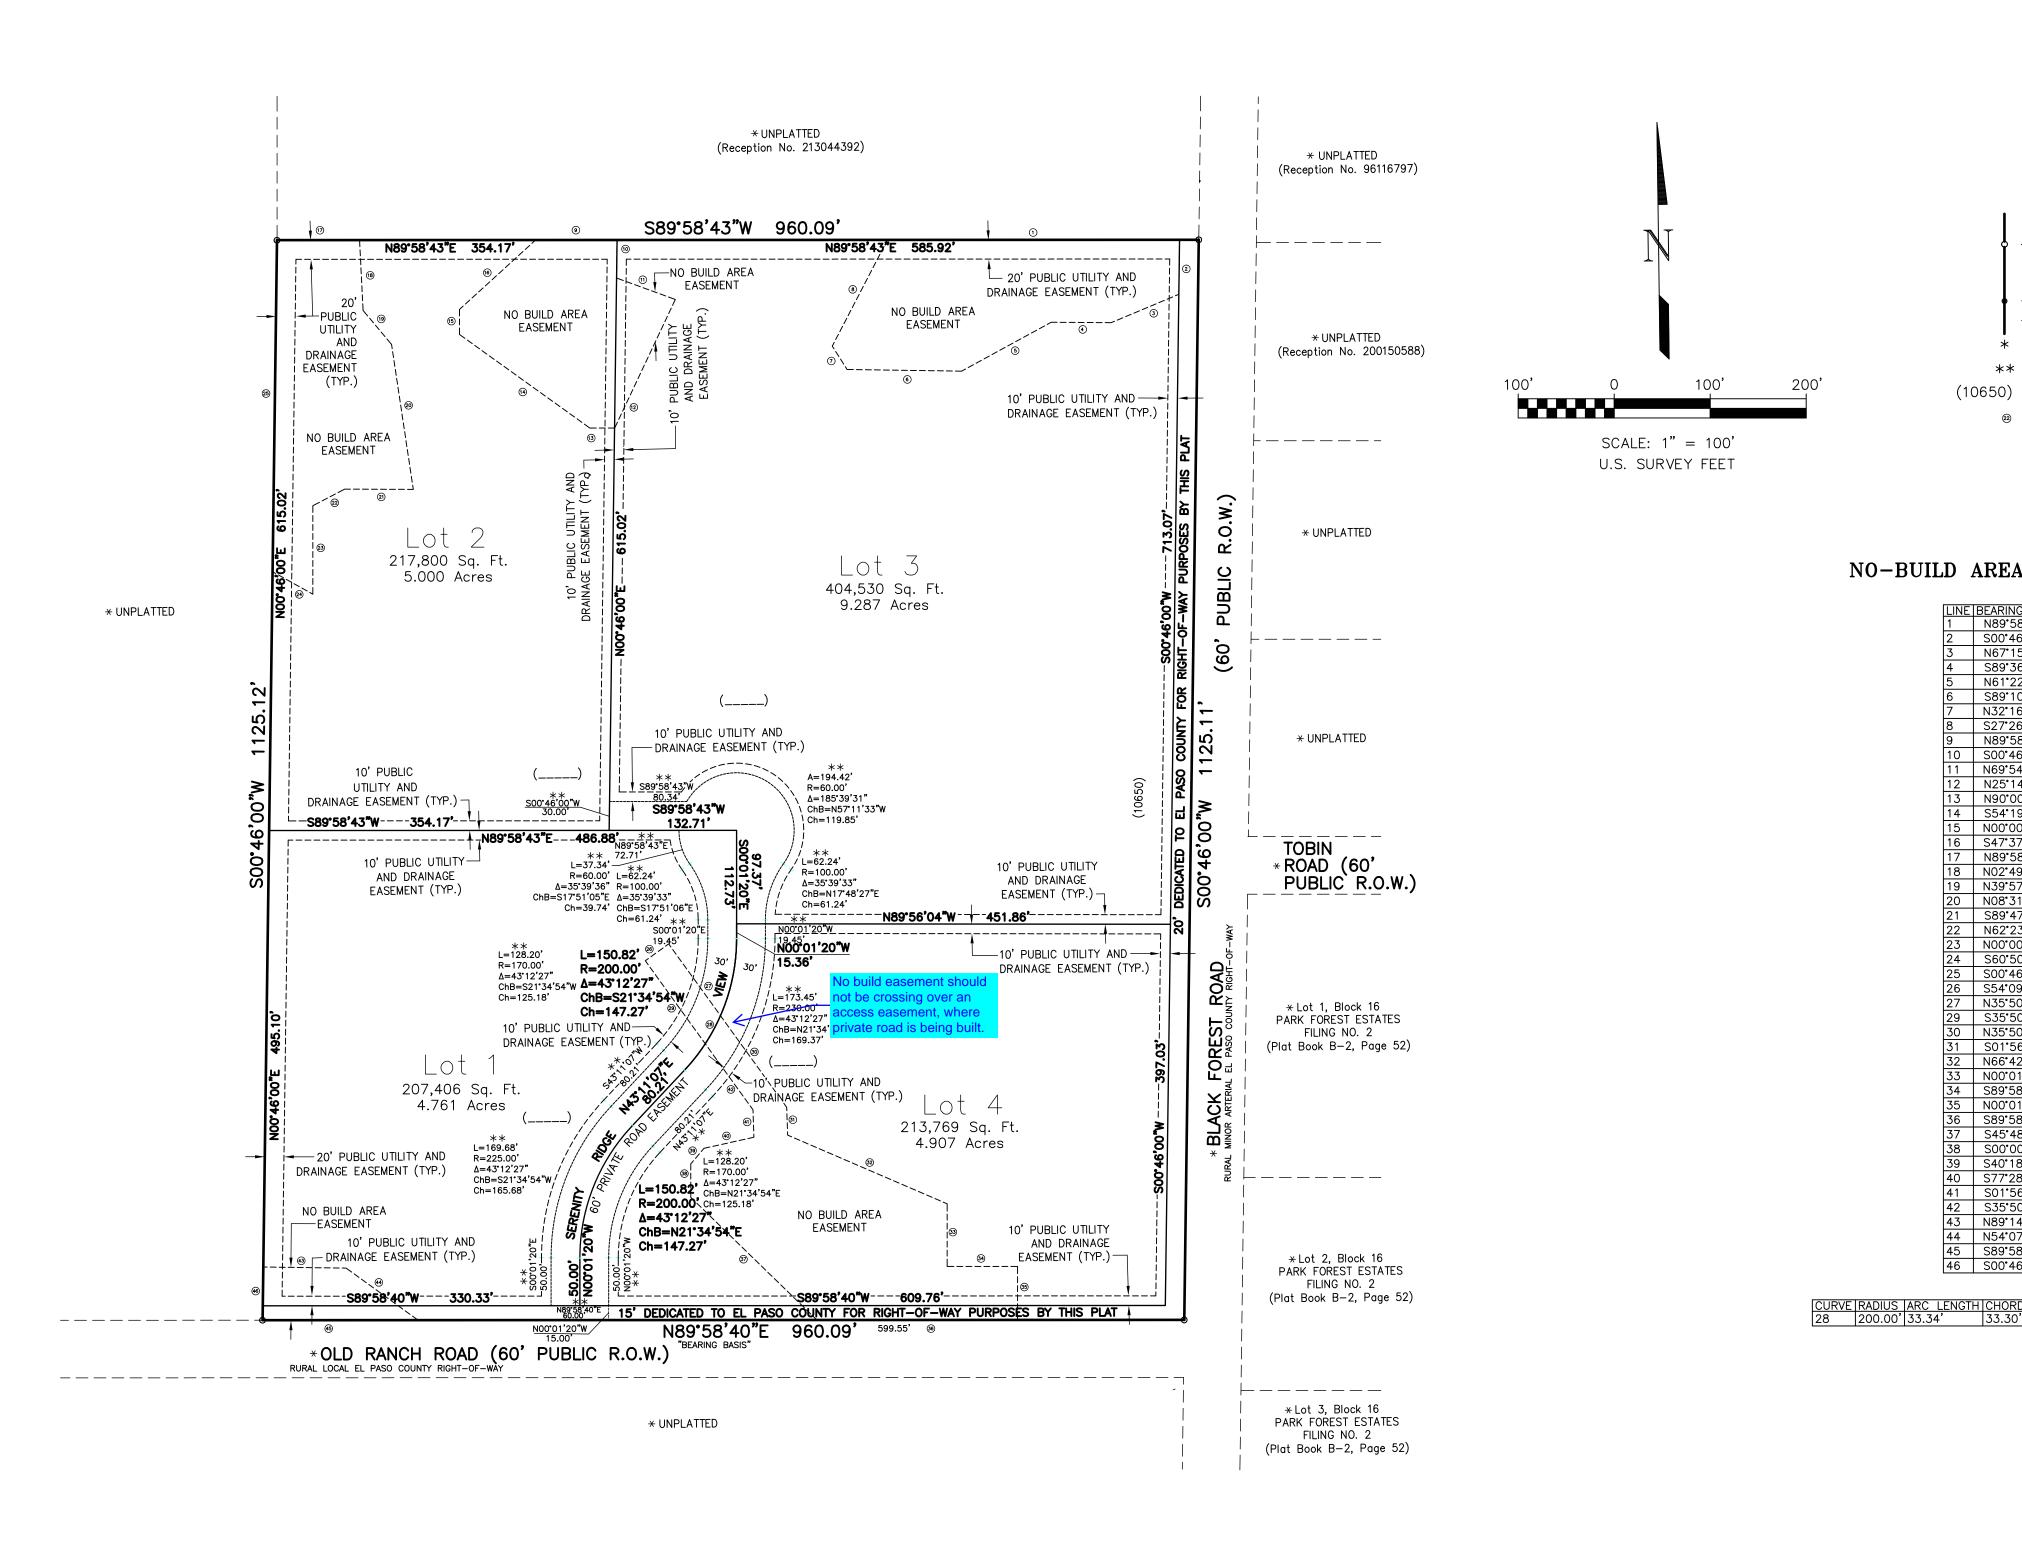

NABULSI-ABUSHABAN SUBDIVISION

A PORTION OF THE SOUTHEAST QUARTER OF SECTION 19, TOWNSHIP 12 SOUTH, RANGE 65 WEST OF THE 6TH P.M., EL PASO COUNTY, COLORADO

OWNER INFORMATION:

NABULSI-ABUSHABAN FAMILY TRUST 14384 Whispering Ridge Road San Diego, CA 92131-4268 Phone: (858) 245-4927

	According to Colorado law, you must commence any legal action based upon any defect in this survey within three years after you first discover such defect. In no event, may any action based upon any defect in survey be commenced more than ten years from the date of the certification
	CALL BEFORE YOU DIG 81 81 18 HOURS BEFORE YOU DIG. CALLUTITY LOCATORS
 Indicates survey monument set with #4 rebar and red plastic cap, PLS No. 20681 flush w/ground, except where noted otherwise Indicates survey monument found as noted Property Line Lot Line Indicates not a part of this subdivision ** - Indicates Private Road Easement data D650) - Indicates Iot address Indicates No-Build Area Easement Data line/curve number 	REVISIONS No. Description By Date 1 COUNTY COMMENTS DVH 03/19/24 1 COUNTY COMMENTS DVH 03/19/24
BEARING DISTANCE N89'58'43"E 304.29' S00'46'00"W 56.78' N67'15'19"E 76.46' S89'36'27"E 62.45' N61'22'16"E 106.24' S89'10'43"E 119.36' N32'16'32"W 28.84' S27'26'24"W 124.63' N89'58'45"E 84.84'	H Scale: 1" = 100' V Scale: N/A Designed By: N/A Drawn By: WCS Checked By: DVH
S00'46'00"W 39.59' N69'54'07"W 65.18' N25'14'51"E 148.00' N90'00'00"E 25.95' S54'19'14"E 167.09' N00'00'00"W 26.06' S47'37'56"W 107.29' N89'58'43"E 85.99' N02'49'46"W 73.35' N39'57'27"W 46.21' N08'31'38"W 152.67' S89'47'15"E 71.52' N62'23'13"E 37.34' N00'00'00"W 92.12' S60'50'14"E 48.04' S00'46'00"W 345.41' S54'09'17"W 30.00' N35'50'43"W 92.19' S35'50'43"W 92.19' S35'50'43"W 92.19' S35'50'43"W 92.19' S35'50'43"W 92.19' S35'50'43"W 92.19' S35'50'43"W 192.19' S35'50'43"W 192.19' S35'50'43"W 192.19' S35'50'43"W 192.19' S35'50'43"W 193.90' <	Development Consultants, Inc. PLANNING & SURVEYING www.ldc-inc.com • TEL: (719) 528-6133 • FAX: (719) 528-6848
S89'58'40'W 208.88' S45'48'00'E 183.27' S00'00'00'E 34.83' S40'18'51'W 21.23' S77'28'16'W 53.28' S05'50'43'E 84.88' N89'14'00'W 86.29' N54'07'29'W 92.48' S00'6'00'W 55.42'	FINAL PLAT ULSI-ABUSHABAN SUBDIVISION

N00*

N62

N00*

S54°(

N35*

N00*

N89*

PCD FILE NO.: MS2211

NABULSI-ABUSHABAN SUBDIVISION

22005

2 of 2

Project No.:

Sheet: