


Please include the following as noted on the Lighting Plan checklist:

- Detailed description of illuminating devices, fixtures, lamps, supports, reflectors, installation, and electrical details and other devices to include an elevation drawing. The description may include, but is not limited to, manufacturers specifications and catalog cuts sheets, and drawings.
- The location and height of all existing and proposed illuminating devices, including but not limited to, all parking area lights and external structural lights.

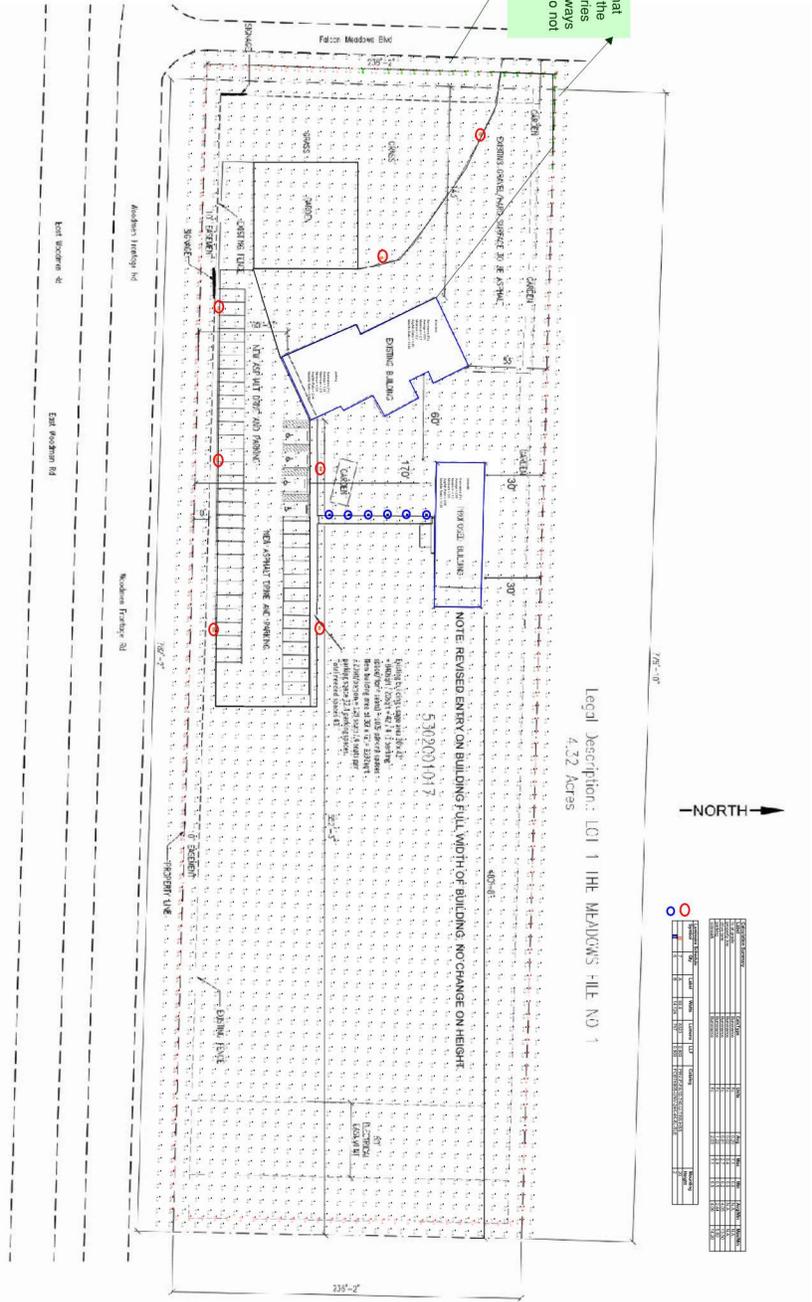

PCD File No: PPR2416

<p>ILLUMINATION SYSTEMS</p> <p>5 SOUTH KALAMATH STREET DENVER, CO 80223 PHONE: 303.283.2800 FAX: 303.283.2800 WWW.ILLUMSYS.COM</p> <p>FOR PRICING AND AVAILABILITY CONTACT ILLUMINATION SYSTEMS AT 303.283.2800</p> <p>PHOTOMETRICS ARE NOT TO SCALE DRAWINGS ARE FOR ESTIMATING PURPOSES ONLY.</p> <p>FOOT CANDLE VALUES ARE PRESENTED AT HORIZONTAL CALCULATIONS UNLESS SPECIFIED OTHERWISE. ACTUAL FOOT CANDLES MAY VARY.</p> <p>FINAL CONSTRUCTION DRAWINGS & CALCULATIONS FOR THE RESPONSIBILITY OF A LICENSED ARCHITECT OR ENGINEER.</p> <p>REFLECTANCES: DIRECT CALCULATIONS ONLY.</p> <p>MOUNTING HEIGHT: AS NOTED ON SCHEDULE CALCULATION SPACING: 10' - 0" x 10' - 0"</p> <p>FOOTCANDLE CALC HEIGHT: 0' - 0" A.F.6.</p> <p>ADDITIONAL NOTES:</p>	<p>WAT BUDDHANIMIT revision</p> <p>photometric plan</p> <p>Drawn By: Kendra Paschall Date: 11/3/2023</p> <p>DSC</p>
--	--