

EAGLEVIEW

A PORTION OF THE NORTHWEST QUARTER OF SECTION 26, TOWNSHIP 12 SOUTH, RANGE 65 WEST OF THE 6th P.M., EL PASO COUNTY, COLORADO

KNOW ALL MEN BY THESE PRESENTS:


THAT PT EAGLEVIEW, LLC, A COLORADO LIMITED LIABILITY COMPANY, BEING THE OWNER OF THE FOLLOWING DESCRIBED TRACT OF LAND:

TO WIT:

A PORTION OF THE NORTHWEST QUARTER OF SECTION 26, TOWNSHIP 12 SOUTH, RANGE 65 WEST OF THE 6th P.M., EL PASO COUNTY, COLORADO, MORE PARTICULARLY DESCRIBED AS FOLLOWS:

BEGINNING AT THE NORTHEAST CORNER OF SAID NORTHWEST QUARTER OF SECTION 26, AS ACCEPTED AND USED IN THE PLATS OF MFLY FARM SUBDIVISION AND PAINT BRUSH HILLS FILING NO. 3, RECORDED IN PLAT BOOK T-3 AT PAGE 93 AND IN PLAT BOOK U-3 AT PAGE 79, RESPECTIVELY, OF THE RECORDS OF SAID EL PASO COUNTY; THENCE S00°02'11"E, ALONG THE EAST LINE OF SAID NORTHWEST QUARTER OF SECTION 26, A DISTANCE OF 2557.22 FEET TO THE CENTER QUARTER CORNER OF SAID SECTION 26; THENCE N89°28'49"W, A DISTANCE OF 978.75 FEET TO THE NORTHEAST CORNER OF LOT 30 OF STAPLETON ESTATES FILING NO. 1, AS RECORDED IN PLAT BOOK R-3 AT PAGE 76 OF THE RECORDS OF SAID EL PASO COUNTY; THENCE N89°31'16"W, ALONG THE BOUNDARY LINE OF SAID STAPLETON ESTATES FILING NO. 1, A DISTANCE OF 1063.31 FEET TO THE NORTHWEST CORNER OF LOT 8 OF SAID STAPLETON ESTATES FILING NO. 1; THENCE N00°26'14"W ALONG THE EAST LINE OF SAID STAPLETON ESTATES FILING NO. 1, A DISTANCE OF 2561.60 FEET TO A POINT ON THE NORTH LINE OF SAID NORTHWEST QUARTER OF SECTION 26; THENCE N89°46'46"E, ALONG SAID NORTH LINE AND ALONG THE SOUTHERLY BOUNDARY LINE OF SAID MFLY FARM SUBDIVISION, A DISTANCE OF 2059.89 FEET TO THE POINT OF BEGINNING.

SAID TRACT CONTAINS 121.20 ACRES OF LAND, MORE OR LESS.

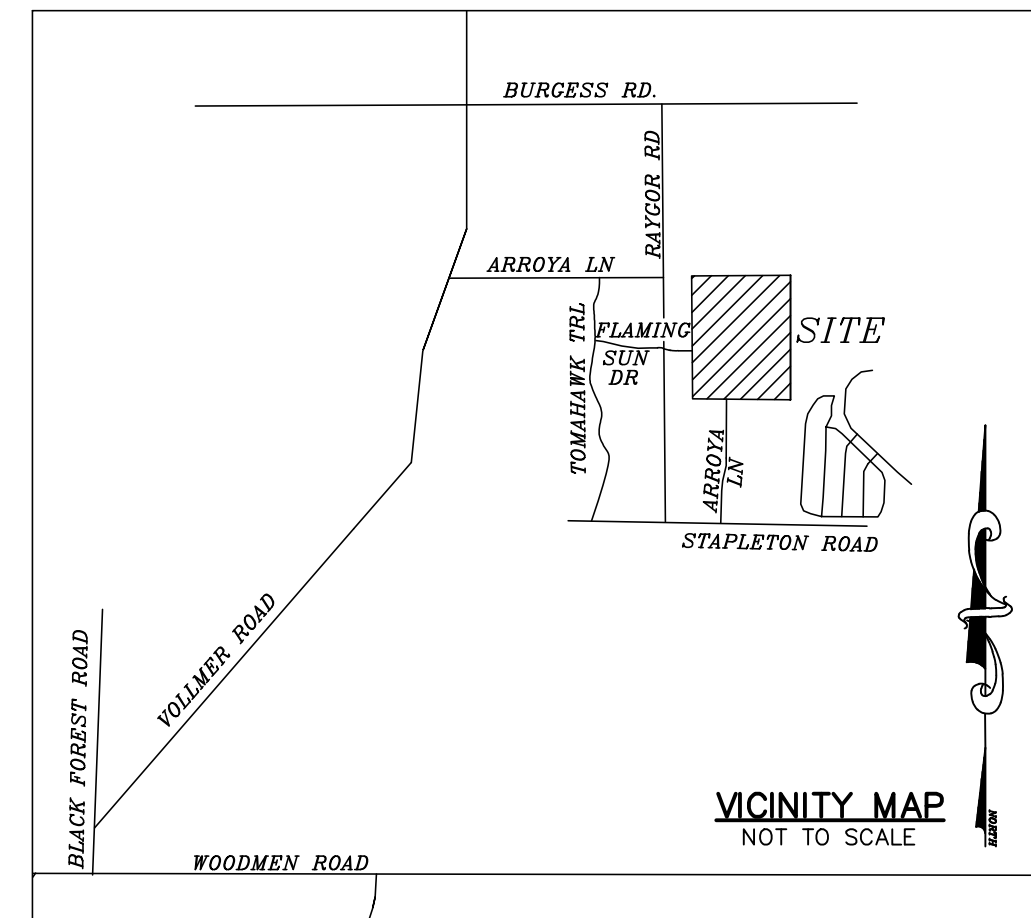

EASEMENTS:

UNLESS OTHERWISE INDICATED, ALL SIDE LOT LINES ARE HEREBY PLATTED ON EITHER SIDE WITH A TEN FOOT (10') PUBLIC UTILITY AND DRAINAGE EASEMENT, ALL REAR LOT LINES ARE HEREBY PLATTED WITH A TEN FOOT (10') PUBLIC UTILITY AND DRAINAGE EASEMENT, ALL FRONT LOT LINES ARE HEREBY PLATTED WITH A TEN FOOT (10') PUBLIC UTILITY AND DRAINAGE EASEMENT AND AN ADDITIONAL TEN FOOT (10') PUBLIC UTILITY ONLY EASEMENT, ALL EXTERIOR SUBDIVISION BOUNDARIES ARE HEREBY PLATTED WITH A TWENTY FOOT (20') PUBLIC UTILITY AND DRAINAGE EASEMENT. THE SOLE RESPONSIBILITY FOR MAINTENANCE OF ALL HEREIN DESCRIBED EASEMENTS IS VESTED WITH THE INDIVIDUAL PROPERTY OWNERS.

DRAINAGE EASEMENTS:

- DRAINAGE EASEMENT TO BE MAINTAINED BY THE METRO DISTRICT MAINTENANCE AND NO BUILD ZONE.
- DRAINAGE EASEMENT TO BE MAINTAINED BY COUNTY MAINTENANCE AND NO BUILD ZONE.

FLOOD PLAIN CERTIFICATION:

ACCORDING TO NATIONAL FLOOD INSURANCE PROGRAM FLOOD INSURANCE RATE MAP NUMBER 08041C0535G (MAP REVISED DECEMBER 7, 2018), THE SUBJECT PROPERTY IS LOCATED IN OTHER AREAS, ZONE X, AREAS DETERMINED TO BE OUTSIDE THE 0.2% ANNUAL CHANCE FLOODPLAIN.

SURVEYOR'S CERTIFICATION:

I, ERIC R. SIMONSON, A DULY REGISTERED PROFESSIONAL LAND SURVEYOR IN THE STATE OF COLORADO, DO HEREBY CERTIFY THAT THIS PLAT TRULY AND CORRECTLY REPRESENTS THE RESULTS OF A SURVEY MADE ON DATE OF SURVEY, BY ME OR UNDER MY DIRECT SUPERVISION AND THAT ALL MONUMENTS EXIST AS SHOWN HEREON, THAT MATHEMATICAL CLOSURE ERRORS ARE LESS THAN 1:10,000, AND THAT SAID PLAT HAS BEEN PREPARED IN FULL COMPLIANCE WITH ALL APPLICABLE PROVISIONS OF THE EL PASO COUNTY LAND DEVELOPMENT CODE, AND THAT THE REQUIREMENTS OF TITLE 38 OF THE COLORADO REVISED STATUTES, 1972 AS AMENDED, HAVE BEEN MET TO THE BEST OF MY KNOWLEDGE AND BELIEF.

I ATTEST THE ABOVE ON THIS _____ DAY OF _____, 2024.



ERIC R. SIMONSON, COLORADO PLS NO. 38560
FOR AND ON BEHALF OF:
RAMPART SURVEYS, LLC.
P.O. BOX 5101
WOODLAND PARK, CO 80866
(719) 687-0920

DATE _____

NOTICE: ACCORDING TO COLORADO LAW YOU MUST COMMENCE ANY LEGAL ACTION BASED UPON ANY DEFECT IN THIS SURVEY WITHIN THREE YEARS AFTER YOU FIRST DISCOVER SUCH DEFECT. IN NO EVENT, MAY ANY ACTION BASED UPON ANY DEFECT IN THIS SURVEY BE COMMENCED MORE THAN TEN YEARS FROM THE DATE OF THE CERTIFICATION SHOWN HEREON.

OWNER'S CERTIFICATION:

THE UNDERSIGNED, BEING THE OWNER OF THE LAND DESCRIBED HEREIN, HAVE LAID OUT, SUBDIVIDED, AND PLATTED SAID LANDS INTO LOTS, STREETS, AND EASEMENTS AS SHOWN HEREON UNDER THE NAME AND SUBDIVISION OF "EAGLEVIEW". ALL PUBLIC IMPROVEMENTS SO PLATTED ARE HEREBY DEDICATED TO PUBLIC USE AND SAID OWNER DOES HEREBY COVENANT AND AGREE THAT THE PUBLIC IMPROVEMENTS WILL BE CONSTRUCTED TO EL PASO COUNTY STANDARDS AND THAT PROPERTY DRAINAGE AND EROSION CONTROL FOR SAME WILL BE PROVIDED AT SAID OWNER'S EXPENSE, ALL TO THE SATISFACTION OF THE BOARD OF COUNTY COMMISSIONERS OF EL PASO COUNTY, COLORADO. UPON ACCEPTANCE BY RESOLUTION, ALL PUBLIC IMPROVEMENTS SO DEDICATED WILL BECOME MATTERS OF MAINTENANCE BY EL PASO COUNTY, COLORADO. THE UTILITY EASEMENTS SHOWN HEREON ARE HEREBY DEDICATED FOR PUBLIC UTILITIES AND COMMUNICATION SYSTEMS AND OTHER PURPOSES AS SHOWN HEREON. THE ENTITIES RESPONSIBLE FOR PROVIDING THE SERVICES FOR WHICH THE EASEMENTS ARE ESTABLISHED ARE HEREBY GRANTED THE PERPETUAL RIGHT OF INGRESS AND EGRESS FROM AND TO ADJACENT PROPERTIES FOR INSTALLATION, MAINTENANCE, AND REPLACEMENT OF UTILITY LINES AND RELATED FACILITIES.

ANDREW J. BIGGS, MANAGER, PT EAGLEVIEW, LLC

STATE OF COLORADO)
) SS
COUNTY OF EL PASO)

ACKNOWLEDGED BEFORE ME THIS _____ DAY OF _____, 2024, BY ANDREW J. BIGGS, PT EAGLEVIEW, LLC, A COLORADO LIMITED LIABILITY COMPANY AS OWNER.

MY COMMISSION EXPIRES: _____

WITNESS MY HAND AND OFFICIAL SEAL

NOTARY PUBLIC

BOARD OF COUNTY COMMISSIONERS CERTIFICATE:

A water finding was made with the preliminary plan. Therefore, this is an administrative final plat. COUNTY, COLORADO BOARD OF COUNTY COMMISSIONERS ON TH approval - delete the BoCC certificate. NOTES SPECIFIED HEREON AND ANY CONDITIONS INCLUDED IN THE RESOLUTION OF APPROVAL. THE DELINEATIONS OF LAND TO THE PUBLIC, BEING STREETS AND EASEMENTS, ARE ACCEPTED, BUT PUBLIC IMPROVEMENTS THEREON WILL NOT BECOME THE MAINTENANCE RESPONSIBILITY OF EL PASO COUNTY UNTIL PRELIMINARY ACCEPTANCE OF THE PUBLIC IMPROVEMENTS IN ACCORDANCE WITH THE REQUIREMENTS OF THE LAND DEVELOPMENT CODE AND ENGINEERING CRITERIA MANUAL, AND THE SUBDIVISION IMPROVEMENTS AGREEMENT.

CHAIR, BOARD OF COUNTY COMMISSIONERS

DATE _____

CLERK AND RECORDER:

STATE OF COLORADO)
) SS
COUNTY OF EL PASO)

I HEREBY CERTIFY THAT THIS INSTRUMENT WAS FILED IN MY OFFICE ON THIS _____ DAY OF _____, 2024, A.D., AND WAS RECORDED AT RECEPTION NUMBER _____ OF THE RECORDS OF EL PASO COUNTY, COLORADO.

EL PASO COUNTY CLERK AND RECORDER

FEES:

DRAINAGE FEE: _____	38 LOTS	113.33 ACRES	94%
BRIDGE FEE: _____	RIGHT-OF-WAY	7.47 ACRES	6%
SCHOOL FEE: _____	TOTAL	121.40 ACRES	100%
PARK FEE: N/A			

SUMMARY:

Include the density calculation

Parks Department comments indicate regional park fees applicable in the amount of \$17,480 for this plat.

PLANNING AND COMMUNITY DEVELOPMENT DEPARTMENT CERTIFICATE

THIS PLAT FOR "EAGLEVIEW" WAS APPROVED FOR FILING BY THE EL PASO COUNTY, COLORADO PLANNING AND COMMUNITY DEVELOPMENT DEPARTMENT DIRECTOR ON THE _____ DAY OF _____, 2024, SUBJECT TO ANY NOTES OR CONDITIONS SPECIFIED HEREON.

PCD DIRECTOR

DATE _____

PCD FILE NO. SF-22-42 DATE OF PREPARATION: DECEMBER 20, 2022

EAGLEVIEW, A PORTION OF SEC. 26, TOWNSHIP 12 SOUTH, RANGE 65 WEST OF THE 6th P.M., EL PASO COUNTY, COLORADO

RAMPART SURVEYS, LLC

P.O. Box 5101 Woodland Park, CO. 80866 (719) 687-0920

DRAWING: 21468 SUB_T.DWG

PAGE 1 OF 5

EAGLEVIEW

A PORTION OF THE NORTHWEST QUARTER OF SECTION 26, TOWNSHIP 12 SOUTH, RANGE 65 WEST OF THE 6th P.M., EL PASO COUNTY, COLORADO

lot 11, 35, 36, & 38 are not within the regional pond drainage easement nor the channel that will be maintained by the County. Revise

NOTES:


- 1). ALL DISTANCES AND BEARINGS SHOWN BETWEEN EXISTING MONUMENTS REFLECT ACTUAL DIMENSIONS AS MEASURED. IF THE ACTUAL DIMENSION DIFFERS FROM THE RECORDED DEEDED DIMENSION, THE DEEDED DIMENSION IS DENOTED WITH A "D=". IF THE ACTUAL DIMENSION DIFFERS FROM THE RECORDED PLAT DIMENSION, THE PLATTED DIMENSION IS DENOTED WITH A "P=".
- 2). ALL BEARINGS USED ON THIS PLAT ARE BASED ON AN ASSUMED BEARING OF S00°02'11"E (S00°04'34"E PER THE RECORDED DEED), A DISTANCE OF 2587.22 FEET (2587.32 FEET OF RECORD) BETWEEN A 2-1/2" ALUMINUM CAP STAMPED "PLS 4842" AT THE NORTHEAST CORNER OF THE NORTHWEST ONE-QUARTER OF SECTION 26 AND A 2" ALUMINUM CAP STAMPED "PLS 25968" AT THE CENTER ONE-QUARTER CORNER OF SAID SECTION 26.
- 3). THIS PLAT DOES NOT CONSTITUTE A TITLE SEARCH BY RAMPART SURVEYS FOR EITHER OWNERSHIP OR EASEMENTS OF RECORD. FOR EASEMENTS OF RECORD SHOWN HEREON, RAMPART SURVEYS RELIED ON AN TITLE COMMITMENT ISSUED BY LAND TITLE GUARANTEE COMPANY, ORDER NUMBER: SC55096073 (POLICY DATE: 12/07/2022 AT 5:00 P.M.) AS PROVIDED TO RAMPART SURVEYS BY THE CLIENT, FOR ALL MATTERS OF RECORD. NO OTHER EASEMENTS OF RECORD ARE SHOWN EXCEPT AS FOUND THEREIN. **THE NUMBERS USED BELOW CORRESPOND WITH THE NUMBERS USED ON (SCHEDULE B PART II), IN THE ABOVE REFERENCED COMMITMENT.**
- 4). THRU 8. RAMPART SURVEYS DID NOT ADDRESS THESE ITEMS.
9. THE PROPERTY IS SUBJECT TO ANY INTEREST WHICH MAY HAVE BEEN ACQUIRED BY THE PUBLIC IN AND TO 30 FEET OF SUBJECT PROPERTY BY REASON OF RESOLUTION OF BOARD OF COUNTY COMMISSIONERS DATED AND RECORDED OCTOBER 3, 1887, IN ROAD BOOK A AT PAGE 78 WHICH PROVIDED FOR PUBLIC ROADS 60 FEET IN WIDTH BEING 30 FEET ON EITHER SIDE OF SECTION LINES ON THE PUBLIC DOMAIN. (AS SHOWN HEREON)
10. THE PROPERTY IS SUBJECT TO RESERVATIONS AS CONTAINED IN PATENT OF THE UNITED STATES RECORDED DECEMBER 05, 1884 IN BOOK 35 AT PAGE 364. (BLANKET IN NATURE. NOT SHOWN)
11. THE PROPERTY IS SUBJECT TO THE EFFECT OF INCLUSION OF SUBJECT PROPERTY IN THE BLACK SQUIRREL SOIL CONSERVATION DISTRICT, RECORDED JULY 03, 1946, IN BOOK 957 AT PAGE 321. (BLANKET IN NATURE. NOT SHOWN)
12. THE PROPERTY IS SUBJECT TO AN OIL AND GAS LEASE BETWEEN RALPH BENNETT AND OPAL BENNETT AND W.H. HOGAN, RECORDED FEBRUARY 09, 1954 IN BOOK 1416 AT PAGE 221 AND ANY AND ALL ASSIGNMENTS THEREOF, OR INTEREST THEREIN. (BLANKET IN NATURE. NOT SHOWN)
13. THE PROPERTY IS SUBJECT TO MINERAL RESERVATIONS CONTAINED IN DEED RECORDED FEBRUARY 24, 1954 IN BOOK 1419 AT PAGE 198. (BLANKET IN NATURE. NOT SHOWN)
14. THE PROPERTY IS SUBJECT TO THE EFFECT OF MINERAL DEED, RECORDED MAY 27, 1959, IN BOOK 1745 AT PAGE 336. (BLANKET IN NATURE. NOT SHOWN)
15. THE PROPERTY IS SUBJECT TO TERMS, CONDITIONS, PROVISIONS, BURDENS AND OBLIGATIONS AS SET FORTH IN MINERAL DEED RECORDED MAY 09, 1988 UNDER RECEPTION NO. 1699723. (BLANKET IN NATURE. NOT SHOWN)
16. THE PROPERTY IS SUBJECT TO THE EFFECT OF AFFIDAVIT REGARDING KNOWN AGGREGATE VALUE, RECORDED JULY 12, 2000, UNDER RECEPTION NO. 2000081217. (BLANKET IN NATURE. NOT SHOWN)
17. THE PROPERTY IS SUBJECT TO TERMS, CONDITIONS, PROVISIONS, BURDENS AND OBLIGATIONS AS SET FORTH IN AGGREGATE LEASE RECORDED JULY 12, 2000 UNDER RECEPTION NO. 2000081216. (BLANKET IN NATURE. NOT SHOWN)
18. THE PROPERTY IS SUBJECT TO THE EFFECT OF TRUSTEE'S DEED (WATER RIGHTS), RECORDED OCTOBER 31, 2002, UNDER RECEPTION NO. 202190198. (BLANKET IN NATURE. NOT SHOWN)
19. THE PROPERTY IS SUBJECT TO TERMS, CONDITIONS, PROVISIONS, BURDENS AND OBLIGATIONS AS SET FORTH IN EASEMENT RECORDED APRIL 14, 2004 UNDER RECEPTION NO. 204060338.
20. THE PROPERTY IS SUBJECT TO THE EFFECT OF RESOLUTION NO. 04-159, RECORDED APRIL 30, 2004, UNDER RECEPTION NO. 204070341. (20' STRIP, LOCATION NOT SPECIFIED. NOT SHOWN)
21. THE PROPERTY IS SUBJECT TO TERMS, CONDITIONS, PROVISIONS, BURDENS AND OBLIGATIONS AS SET FORTH IN COLORADO GROUND WATER COMMISSION FINDINGS AND ORDER RECORDED AUGUST 02, 2005 UNDER RECEPTION NO. 205117858. (ZONING CHANGE. NOT SHOWN)
22. THE PROPERTY IS SUBJECT TO TERMS, CONDITIONS, PROVISIONS, BURDENS AND OBLIGATIONS AS SET FORTH IN COLORADO GROUND WATER COMMISSION FINDINGS AND ORDER RECORDED AUGUST 02, 2005 UNDER RECEPTION NO. 205117859. (BLANKET IN NATURE. NOT SHOWN)
23. THE PROPERTY IS SUBJECT TO TERMS, CONDITIONS, PROVISIONS, BURDENS AND OBLIGATIONS AS SET FORTH IN COLORADO GROUND WATER COMMISSION FINDINGS AND ORDER RECORDED AUGUST 02, 2005 UNDER RECEPTION NO. 205117860. (BLANKET IN NATURE. NOT SHOWN)
24. THE PROPERTY IS SUBJECT TO TERMS, CONDITIONS, PROVISIONS, BURDENS AND OBLIGATIONS AS SET FORTH IN COLORADO GROUND WATER COMMISSION FINDINGS AND ORDER RECORDED AUGUST 02, 2005 UNDER RECEPTION NO. 205117861. (BLANKET IN NATURE. NOT SHOWN)
25. THE PROPERTY IS SUBJECT TO TERMS, CONDITIONS, PROVISIONS, BURDENS AND OBLIGATIONS AS SET FORTH IN COLORADO GROUND WATER COMMISSION FINDINGS AND ORDER RECORDED AUGUST 16, 2005 UNDER RECEPTION NO. 205127098. (BLANKET IN NATURE. NOT SHOWN)
26. THE PROPERTY IS SUBJECT TO TERMS, CONDITIONS, PROVISIONS, BURDENS AND OBLIGATIONS AS SET FORTH IN COLORADO GROUND WATER COMMISSION FINDINGS AND ORDER RECORDED OCTOBER 05, 2005 UNDER RECEPTION NO. 205157500. (BLANKET IN NATURE. NOT SHOWN)
27. THE PROPERTY IS SUBJECT TO THE EFFECT OF RESOLUTION NO. 08-77, RECORDED JULY 02, 2008, UNDER RECEPTION NO. 208075839. (ZONING CHANGE. NOT SHOWN)
28. THE PROPERTY IS SUBJECT TO THE EFFECT OF RESOLUTION NO. 08-78, RECORDED JULY 07, 2008, UNDER RECEPTION NO. 208077033. (BLANKET IN NATURE. NOT SHOWN)
29. THE PROPERTY IS SUBJECT TO THE EFFECT OF MEMORANDUM OF OIL AND GAS LEASE, RECORDED APRIL 27, 2011, UNDER RECEPTION NO. 211041825. (BLANKET IN NATURE. NOT SHOWN)
30. THE PROPERTY IS SUBJECT TO TERMS, CONDITIONS, PROVISIONS, BURDENS AND OBLIGATIONS AS SET FORTH IN MEMORANDUM OF OPTION RECORDED AUGUST 26, 2019 UNDER RECEPTION NO. 219100322. (BLANKET IN NATURE. NOT SHOWN)
31. THE PROPERTY IS SUBJECT TO TERMS, CONDITIONS, PROVISIONS, BURDENS AND OBLIGATIONS AS SET FORTH IN EASEMENT AND AGREEMENT RECORDED DECEMBER 08, 2020 UNDER RECEPTION NO. 220136338, AND 220136339. (EASEMENT EXPIRED SEPTEMBER 3, 2022)
32. THE PROPERTY IS SUBJECT TO TERMS, CONDITIONS, PROVISIONS, BURDENS AND OBLIGATIONS AS SET FORTH IN NOTICE REQUEST RECORDED FEBRUARY 22, 2021 UNDER RECEPTION NO. 22134156. (BLANKET IN NATURE. NOT SHOWN)
- 4). ALL LINEAL UNITS DEPICTED ON THIS SUBDIVISION PLAT ARE U.S. SURVEY FEET.
- 5). WATER TO BE PROVIDED VIA INDIVIDUAL ON SITE WELLS. INDIVIDUAL WELLS ARE THE RESPONSIBILITY OF EACH PROPERTY OWNER. PERMITS FOR INDIVIDUAL WELLS MUST BE OBTAINED FROM THE STATE ENGINEER WHO BY LAW HAS THE AUTHORITY TO SET CONDITIONS FOR THE ISSUANCE OF THESE PERMITS.
- 6). SEWAGE TREATMENT IS THE RESPONSIBILITY OF EACH INDIVIDUAL PROPERTY OWNER. WASTE WATER TO BE INDIVIDUAL ON SITE SEPTIC SYSTEMS. THE EL PASO COUNTY DEPARTMENT OF HEALTH AND ENVIRONMENT MUST APPROVE EACH SYSTEM AND, IN SOME CASES, THE DEPARTMENT MAY REQUIRE AN ENGINEER DESIGNED SYSTEM PRIOR TO PERMIT APPROVAL. THESE SYSTEMS MAY COST MORE TO DESIGN, INSTALL AND MAINTAIN.
- 7). THIS PROPERTY IS LOCATED WITHIN AND SERVICED BY MOUNTAIN VIEW ELECTRIC ASSOCIATION DISTRICT, BLACK HILLS ENERGY GAS SERVICE DISTRICT, FALCON FIRE PROTECTION DISTRICT, AND THE FALCON SCHOOL DISTRICT.
- 8). MOUNTAIN VIEW ELECTRIC ASSOCIATION REQUIRES THAT THEIR EASEMENTS BE EXCLUSIVE OF GRADING AND DRAINAGE EASEMENTS.
- 9). WATER IN THE DENVER BASIN AQUIFERS IS ALLOCATED BASED ON A 100-YEAR AQUIFER LIFE; HOWEVER, FOR EL PASO COUNTY PLANNING PURPOSES, WATER IN THE DENVER BASIN AQUIFERS IS EVALUATED BASED ON A 300-YEAR AQUIFER LIFE. APPLICANTS AND ALL FUTURE OWNERS IN THE SUBDIVISION SHOULD BE AWARE THAT THE ECONOMIC LIFE OF A WATER SUPPLY BASED ON WELLS IN A GIVEN DENVER BASIN AQUIFER MAY BE LESS THAN EITHER THE 100 YEARS OR 300 YEARS INDICATED DUE TO ANTICIPATED WATER LEVEL DECLINES. FURTHERMORE, THE WATER SUPPLY PLAN SHOULD NOT RELY SOLELY UPON NON-RENEWABLE AQUIFERS. ALTERNATIVE RENEWABLE WATER RESOURCES SHOULD BE ACQUIRED AND INCORPORATED IN A PERMANENT WATER SUPPLY PLAN THAT PROVIDES FUTURE GENERATIONS WITH A WATER SUPPLY.

Assumed basis of bearing shall not be used.

Update this part of the note to reflect the removal of the information from the plat.

All of this is unnecessary information on the plat. The title commitment is referenced by number in the note (and will need to be updated when the new title commitment is updated when the plat gets recorded). If you delete all this, you might be able to fit all the notes on the first page and eliminate an extra page.

Add to this note: The subdivider/developer is responsible for extending utilities to each lot, tract or building site.

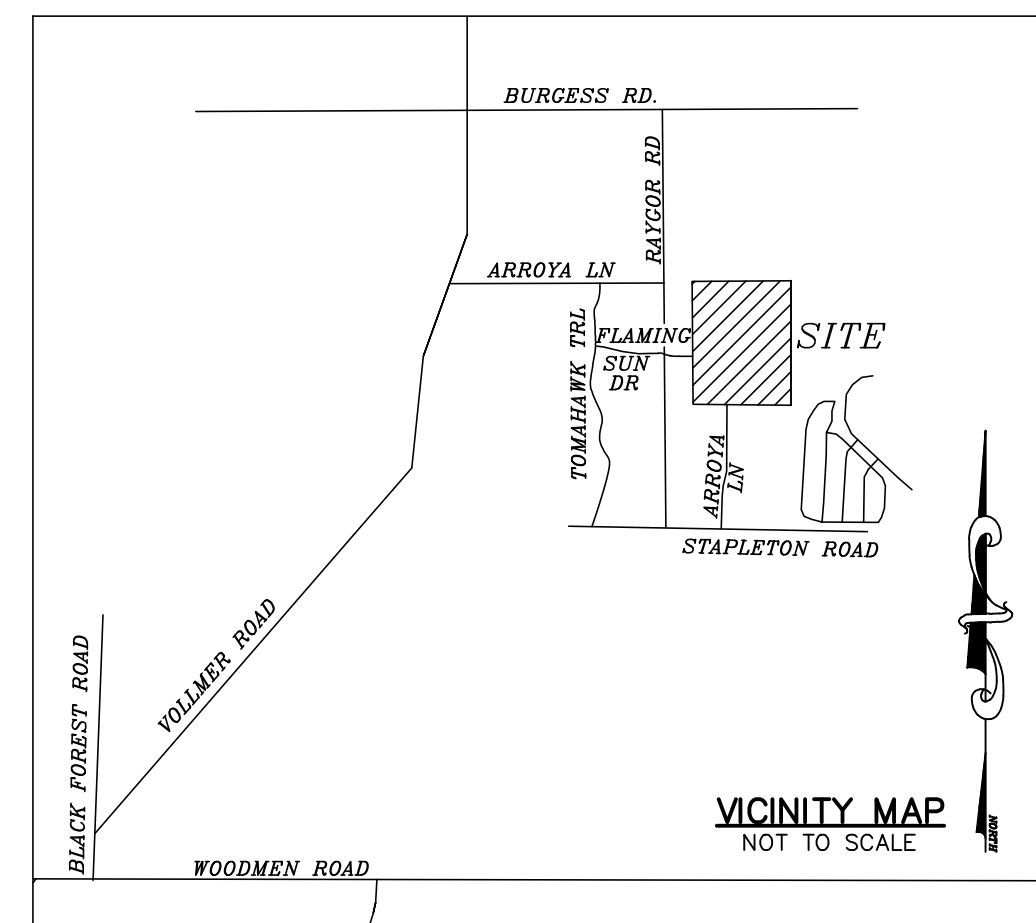

Delete this unnecessary note.

Identify the maintenance responsibilities of the underground drainage system.

This is duplicate of a portion of Note 20. Delete.

"Drainage easement and maintenance access road"

Update this note. Metro district has been formed. Indicate the purpose of this district.

Delete this note. Setbacks are governed by the RR-2.5 zoning district; not by the plat.

Delete this unnecessary note.

Update the highlighted portions of this note.

NOTES:

- 10). ALL ROADWAYS AND DRAINAGE FACILITIES WITHIN DEDICATED RIGHT-OF-WAYS AND DRAINAGE EASEMENTS AS SHOWN ON LOTS 11, 12, 13, 14, 15, 16, 17, 18, 21, 22, 23, 24, 31, 32, 34, 35, 36, 37, 38 SHALL BE CONSTRUCTED TO EL PASO COUNTY STANDARDS, AND ARE TO BE OWNED AND MAINTAINED BY THE COUNTY UPON ACCEPTANCE.
- 11). PROPOSED METHOD OF GUARANTEEING FUNDS WILL BE ONE OF ANY APPROVED ACCEPTABLE TO THE EL PASO COUNTY ATTORNEYS OFFICE.
- 12). NO LOT OR INTEREST THEREIN, SHALL BE SOLD, CONVEYED OR TRANSFERRED WHETHER BY DEED OR BY CONTRACT, NOR SHALL BUILDING PERMITS BE ISSUED, UNTIL AND UNLESS EITHER THE REQUIRED PUBLIC AND COMMON DEVELOPMENT IMPROVEMENTS HAVE BEEN CONSTRUCTED AND COMPLETED AND PRELIMINARILY ACCEPTED IN ACCORDANCE WITH THE SUBDIVISION IMPROVEMENTS AGREEMENT BETWEEN THE APPLICANT/OWNER AND EL PASO COUNTY AS RECORDED UNDER RECEPTION NO. _____ IN THE OFFICE OF THE CLERK AND RECORDER OF EL PASO COUNTY, COLORADO, OR, IN THE ALTERNATIVE, OTHER COLLATERAL IS PROVIDED TO MAKE PROVISION FOR THE COMPLETION OF SAID IMPROVEMENTS IN ACCORDANCE WITH EL PASO COUNTY LAND DEVELOPMENT CODE AND ENGINEERING CRITERIA MANUAL. ANY SUCH ALTERNATIVE COLLATERAL MUST BE APPROVED BY THE BOARD OF COUNTY COMMISSIONERS OR, IF PERMITTED BY THE SUBDIVISION IMPROVEMENTS AGREEMENT, BY THE PLANNING AND COMMUNITY DEVELOPMENT DEPARTMENT DIRECTOR AND MEET THE POLICY AND PROCEDURE REQUIREMENTS OF EL PASO COUNTY PRIOR TO THE RELEASE BY THE COUNTY OF ANY LOTS FOR SALE, CONVEYANCE OR TRANSFER.
- 13). THIS SITE IS NOT WITHIN A DESIGNATED F.E.M.A. FLOODPLAIN AS DETERMINED BY THE FLOOD INSURANCE RATE MAP, COMMUNITY PANEL NUMBER 0804100356, EFFECTIVE DECEMBER 7, 2018.
- 14). THE FOLLOWING LOTS HAVE BEEN FOUND TO BE IMPACTED BY GEOLOGIC HAZARDS. MITIGATION MEASURES AND MAP OF THE HAZARD AREA CAN BE FOUND IN SOIL, GEOLOGY, AND GEOLOGIC HAZARD STUDY PREPARED BY ENTECH ENGINEERING, INC. NOVEMBER 19, 2021, REVISED AUGUST 22, 2022, IN FILE SP-2106 AVAILABLE AT THE EL PASO COUNTY PLANNING AND COMMUNITY DEVELOPMENT DEPARTMENT:
 1. POTENTIALLY SEASONAL SHALLOW GROUNDWATER: LOTS 21-23, 32
 2. SEASONAL SHALLOW GROUNDWATER: LOTS 4, 5, 9-32, 34-38
 3. POTENTIALLY UNSTABLE SLOPES: LOTS 12-18, 21, 23, 24, 31, 32, 34, 36-38
 4. ARTIFICIAL FILL: LOTS 4, 5, AND 35
 5. EXPANSIVE SOILS ARE SPORADIC AND HAVE NOT BEEN MAPPED. IF ENCOUNTERED, OVER EXCAVATION AND REPLACEMENT IS RECOMMENDED.
 IN AREAS OF HIGH GROUNDWATER, DUE TO HIGH GROUNDWATER IN THE AREA, ALL FOUNDATION SHALL INCORPORATE AN UNDERGROUND DRAINAGE SYSTEM.
- 15). STRUCTURE, FENCES, MATERIALS OR LANDSCAPING THAT COULD IMPEDE THE FLOW OF RUNOFF SHALL NOT BE PLACED IN DRAINAGE EASEMENTS.
- 16). CERTIFIED ENGINEER OWS ARE REQUIRED WHERE THIS IS **SHALLOW BEDROCK GROUNDWATER**. OWS SHALL NOT BE LOCATED WITHIN 25 FEET OF DRAINAGE AREAS AND EASEMENTS.
- 17). DRAINAGE EASEMENTS AS SHOWN ON LOTS 4, 5, 6, 9, 10, 11, 12, 17, 18, 19, 20, 25, 26, 27, 28, 29, 30, 34, 35, 36, 37, 38 ARE NO BUILD AREAS. NO CONSTRUCTION OR ACCESSORY STRUCTURES ARE PERMITTED IN THESE EASEMENTS.
- 18). **FUTURE PROPERTY OWNERS SHALL NOT CONSTRUCT FENCING THAT WOULD BLOCK/IMPEDE THE USE OF MAINTENANCE ACCESS ROADS.**
- 19). THE FOLLOWING REPORTS HAVE BEEN SUBMITTED IN ASSOCIATION WITH THE PRELIMINARY PLAN OR FINAL PLAT FOR THIS SUBDIVISION AND ARE ON FILE AT THE COUNTY PLANNING AND COMMUNITY DEVELOPMENT DEPARTMENT: TRANSPORTATION IMPACT STUDY; DRAINAGE REPORT; WATER RESOURCES REPORT; WASTEWATER DISPOSAL REPORT; GEOLOGY AND SOILS REPORT; FIRE PROTECTION REPORT; WILDFIRE HAZARD REPORT; NATURAL FEATURES REPORT.
- 20). ALL PROPERTY OWNERS ARE RESPONSIBLE FOR MAINTAINING PROPER STORM WATER DRAINAGE IN AND THROUGH THEIR PROPERTY. PUBLIC DRAINAGE EASEMENTS AS SPECIFICALLY NOTED ON THE PLAT SHALL BE MAINTAINED BY THE INDIVIDUAL LOT OWNERS UNLESS OTHERWISE INDICATED. HOMEBUILDERS ARE RESPONSIBLE TO ENSURE PROPER DRAINAGE AROUND STRUCTURES, INCLUDING ELEVATIONS OF FOUNDATIONS AND WINDOW WELLS IN RELATION TO SIDE-LOT DRAINAGE EASEMENTS AND SWALES. HOMEOWNERS SHALL NOT CHANGE THE GRADE OF THE LOT OR DRAINAGE SWALES AS CONSTRUCTED BY THE BUILDER IN A MANNER THAT WOULD CAUSE ADVERSE DRAINAGE IMPACT TO ADJACENT PROPERTIES. STRUCTURES, FENCES, MATERIALS OR LANDSCAPING THAT COULD IMPEDE THE FLOW OF RUNOFF SHALL NOT BE PLACED IN DRAINAGE EASEMENTS.
- 21). DEVELOPER SHALL COMPLY WITH FEDERAL AND STATE LAWS, REGULATIONS, ORDINANCES, REVIEW AND PERMIT REQUIREMENTS, AND OTHER AGENCY REQUIREMENTS, IF ANY, OF APPLICABLE AGENCIES INCLUDING, BUT NOT LIMITED TO, COLORADO PARKS AND WILDLIFE, COLORADO DEPARTMENT OF TRANSPORTATION, U.S. ARMY CORPS OF ENGINEERS AND THE U.S. FISH AND WILDLIFE SERVICE REGARDING THE ENDANGERED SPECIES ACT, PARTICULARLY AS IT RELATES TO THE LISTED SPECIES (e.g., PREBLE'S MEADOW JUMPING MOUSE).
- 22). NO DRIVEWAYS SHALL BE ESTABLISHED UNLESS AN ACCESS PERMIT OR WAIVER HAS BEEN GRANTED BY EL PASO COUNTY.
- 23). MAILBOXES SHALL BE INSTALLED IN ACCORDANCE WITH ALL EL PASO COUNTY AND UNITED STATES POSTAL SERVICE REGULATIONS.
- 24). INDIVIDUAL LOT PURCHASERS ARE RESPONSIBLE FOR CONSTRUCTING DRIVEWAYS, INCLUDING NECESSARY DRAINAGE CULVERTS PER LAND DEVELOPMENT CODE SECTION 6.3.3.C.2 AND 6.3.3.C.3. DUE TO THEIR LENGTH, SOME DRIVEWAYS WILL NEED TO BE SPECIFICALLY APPROVED BY THE FALCON FIRE DISTRICT.
- 25). THE FOLLOWING LOTS WILL REQUIRE ENGINEERED SITE PLANS FOR THE CONSTRUCTION DESIGN OF DRIVEWAY CULVERTS IS THE EVENT DRIVEWAYS ARE PROPOSED TO CROSS THE DRAINAGE EASEMENTS: LOTS 4, 5, 9, 19, 20, 25-30, 34-36 AND 38.
- 26). A NEW METROPOLITAN DISTRICT WILL BE FORMED TO SERVE THIS DEVELOPMENT.
- 27). BUILDING SETBACKS TO BE: FRONT YARD - 25', SIDE YARD - 15', AND REAR YARD - 25'.
- 28). THERE ARE 38 LOTS IN THIS SUBDIVISION.
- 29). THE SUBDIVIDER(S) AGREE ON BEHALF OF HIM/HERSELF AND ANY DEVELOPER OR BUILDER SUCCESSORS AND ASSIGNS THAT SUBDIVIDER AND/OR SAID SUCCESSORS AND ASSIGNS SHALL BE REQUIRED TO PAY TRAFFIC IMPACT FEES IN ACCORDANCE WITH THE EL PASO COUNTY ROAD IMPACT FEE PROGRAM (RESOLUTION NO. 19-471), OR ANY AMENDMENTS THEREIN, AT OR PRIOR TO THE TIME OF BUILDING PERMIT SUBMITTALS. THE FEE OBLIGATION, IF NOT PAID AT FINAL PLAT RECORDING, SHALL BE DOCUMENTED ON ALL SALES DOCUMENTS AND IN PLAT NOTES TO ENSURE THAT A TITLE SEARCH WOULD FIND THE FEE OBLIGATION BEFORE SALE OF THE PROPERTY.
- 30). AN EMERGENCY FIRE ACCESS EASEMENT IS RECORDED UNDER RECEPTION NO. _____ THIS EMERGENCY EASEMENT WILL BE MAINTAINED THROUGH LOT 11 PAINT BRUSH HILLS FIL NO. 14 CONNECTING ACEQUILA COURT CUL-DE-SAC TO KEYNES DRIVE. THIS ACCESS WILL SERVE AS A SECONDARY POINT OF ACCESS UNTIL RAYGORD ROAD IS EXTENDED TO STAPLETON DRIVE OR ANOTHER ROAD CONNECTION IS MADE THAT MEETS THE FIRE DISTRICT AND ECM ADMINISTRATOR REQUIREMENTS FOR SECONDARY ACCESS.
- 31). LOT _____ (OR TRACT) OF THIS PROPERTY IS SUBJECT TO A PRIVATE DETENTION BASIN/STORMWATER QUALITY BMP MAINTENANCE AGREEMENT AND EASEMENT AS RECORDED AT RECEPTION NO. _____ OF THE RECORDS OF EL PASO COUNTY. THE _____ METRO DISTRICT (OR OWNER OR DISTRICT) IS RESPONSIBLE FOR MAINTENANCE OF THE SUBJECT DRAINAGE FACILITIES.
- 32). ANY PERSON WHO KNOWINGLY REMOVES, ALTERS OR DEFACTS ANY PUBLIC LAND SURVEY MONUMENT OR LAND BOUNDARY MONUMENT OR ACCESSORY COMMITTS A CLASS TWO (2) MISDEMEANOR PURSUANT TO C.R.S. 18-4-508.
- 33). THE PARTIES RESPONSIBLE FOR THIS PLAN HAVE FAMILIARIZED THEMSELVES WITH ALL CURRENT ACCESSIBILITY CRITERIA AND SPECIFICATIONS AND THE PROPOSED PLAN REFLECTS ALL SITE ELEMENTS REQUIRED BY THE APPLICABLE ADA DESIGN STANDARDS AND GUIDELINES AS PUBLISHED BY THE UNITED STATES DEPARTMENT OF JUSTICE. APPROVAL OF THIS PLAN BY EL PASO COUNTY DOES NOT ASSURE COMPLIANCE WITH THE APPLICABLE ADA OR ANY REGULATIONS OR GUIDELINES ENACTED OR PROMULGATED UNDER OR WITH RESPECT TO SUCH LAWS.

Please reference the channel maintenance agreement

Is this the same as nos. 1 and 2 under note 14? Please clean up the language so it is clear which lots will have this requirement.

If this has been recorded, please fill in the reception number. If it has not been recorded, and it is something you would like to record alongside the plat, please provide a copy of the draft easement with the next submittal for review.

Include note related to Addresses: The addresses exhibited on this plat are for informational purposes only. They are not the legal description and are subject to change.

Pursuant to County Attorney water finding from preliminary plan, include the following note:

Water withdrawal and wells are subject to limitations, restrictions and augmentation requirements and responsibilities as found within the Covenants for this subdivision recorded in Reception No. _____ of the Office of the El Paso County Clerk and Recorder and the terms of the water court approved water augmentation plan.

PCD FILE NO. SF-22-42 DATE OF PREPARATION: DECEMBER 20, 2022

EAGLEVIEW, A PORTION OF SEC. 26, TOWNSHIP 12 SOUTH, RANGE 65 WEST OF THE 6th P.M., EL PASO COUNTY, COLORADO

RAMPART SURVEYS, LLC

P.O. Box 5101 Woodland Park, CO. 80866 (719) 687-9920

DRAWING: 21468 SUB_T.DWG PAGE 2 OF 5


C:\Users\Rampart\Bureau\Rampart\Bureau\Drawings\DWG\21468\21468_SUB_T.DWG 4/12/2024 1:50:46 AM

EAGLEVIEW

A PORTION OF THE NORTHWEST QUARTER OF SECTION 26, TOWNSHIP 12 SOUTH,
RANGE 65 WEST OF THE 6th P.M., EL PASO COUNTY, COLORADO

CURVE TABLE					
CURVE #	ARC LENGTH	RADIUS	DELTA ANGLE	CHORD BEARING	CHORD LENGTH
C1	194.56'	480.00'	231°3'28"	S12°05'28"W	193.23'
C2	22.20'	15.00'	84°47'02"	S18°41'19"E	20.23'
C3	39.49'	100.55'	22°30'00"	S72°19'50"E	39.23'
C4	24.11'	60.00'	23°01'26"	S72°04'07"E	23.95'
C5	54.44'	60.00'	51°59'05"	S34°33'52"E	52.59'
C6	61.73'	60.00'	58°57'03"	S20°54'12"W	59.05'
C7	69.54'	60.00'	66°24'37"	S83°35'02"W	65.72'
C8	25.79'	60.00'	24°37'49"	N50°53'45"W	25.59'
C10	39.49'	100.55'	22°30'00"	N49°49'50"W	39.23'
C11	22.20'	15.00'	84°47'03"	S76°31'33"W	20.23'
C12	186.79'	480.00'	221°7'47"	S45°17'00"W	185.61'
C13	45.93'	470.00'	5°35'56"	S53°37'55"W	45.91'
C14	364.85'	470.00'	44°28'39"	S28°35'37"W	355.76'
C15	190.30'	363.00'	30°02'10"	S21°22'23"W	188.12'
C16	410.15'	420.00'	55°57'09"	N28°27'19"E	394.05'
C17	34.22'	530.00'	3°41'57"	N54°34'54"E	34.21'
C18	196.33'	530.00'	211°3'27"	N42°07'12"E	195.21'
C19	22.32'	15.00'	85°15'48"	N74°08'23"E	20.32'
C20	89.89'	100.55'	51°13'24"	S37°37'01"E	86.93'
C21	82.52'	60.00'	78°48'05"	S51°24'21"E	76.17'
C22	31.82'	60.00'	30°22'57"	N74°00'08"E	31.45'
C23	127.80'	60.00'	122°02'22"	N02°12'32"W	104.97'
C24	22.32'	15.00'	85°15'51"	N20°35'48"W	20.32'
C25	145.05'	530.00'	15°40'50"	N14°11'43"E	144.60'
C26	277.36'	303.00'	52°26'50"	N32°34'43"E	267.78'
C27	76.66'	530.00'	8°17'16"	N54°39'30"E	76.60'
C28	258.31'	530.00'	27°55'29"	N36°33'08"E	255.76'
C29	22.32'	15.00'	85°15'48"	N65°13'17"E	20.32'
C30	77.85'	330.00'	13°31'03"	S78°54'20"E	77.67'
C31	25.41'	330.00'	4°24'42"	S87°52'13"E	25.40'
C32	39.48'	100.55'	22°29'55"	S78°49'36"E	39.23'
C33	24.36'	60.00'	23°15'36"	S79°12'27"E	24.19'
C34	31.55'	60.00'	30°07'42"	N74°05'53"E	31.19'
C35	61.13'	60.00'	58°22'29"	N29°50'49"E	58.52'
C36	118.58'	60.00'	113°14'13"	N55°57'32"W	100.20'
C37	39.49'	100.55'	22°30'05"	S78°40'24"W	39.24'
C38	84.49'	270.00'	17°55'45"	N81°06'41"W	84.14'

CURVE TABLE					
CURVE #	ARC LENGTH	RADIUS	DELTA ANGLE	CHORD BEARING	CHORD LENGTH
C39	22.32'	15.00'	85°15'51"	N29°30'53"W	20.32'
C40	166.60'	530.00'	18°00'38"	N04°06'43"E	165.92'
C41	150.66'	530.00'	16°17'12"	N13°02'12"W	150.15'
C42	72.31'	470.00'	8°48'56"	N16°46'20"W	72.24'
C43	75.58'	470.00'	9°12'50"	N07°45'27"W	75.50'
C44	39.49'	100.55'	22°30'00"	N08°05'58"E	39.23'
C45	26.73'	60.00'	25°31'25"	N06°35'16"E	26.51'
C46	35.30'	60.00'	33°42'28"	N23°01'41"W	34.79'
C47	31.41'	60.00'	29°59'56"	N54°52'53"W	31.06'
C48	55.01'	60.00'	52°31'33"	S83°51'22"W	53.10'
C49	50.41'	60.00'	48°08'20"	S33°31'25"W	48.94'
C50	36.76'	60.00'	35°06'17"	S08°05'53"E	36.19'
C52	39.49'	100.55'	22°30'00"	S14°24'02"E	39.23'
C53	166.78'	530.00'	18°01'46"	S12°09'55"E	166.09'
C54	64.76'	470.00'	7°53'40"	S17°13'58"E	64.71'
C55	591.34'	470.00'	72°05'16"	S22°45'30"W	553.10'
C56	55.35'	363.00'	8°44'12"	S54°26'02"W	55.30'
C57	47.32'	530.00'	5°06'57"	N49°17'57"W	47.31'
C58	214.40'	530.00'	23°10'41"	N63°26'46"W	212.94'
C59	311.05'	530.00'	33°37'33"	S88°09'08"W	306.60'
C60	30.20'	530.00'	3°15'53"	S69°42'25"W	30.19'
C61	30.05'	530.00'	3°14'56"	S66°27'01"W	30.05'
C62	229.26'	530.00'	24°47'05"	S52°26'01"W	227.48'
C63	270.12'	312.52'	49°31'17"	S64°48'07"W	261.79'
C64	321.97'	372.52'	49°31'18"	N64°48'07"E	312.05'
C65	106.75'	470.00'	13°00'50"	N46°32'53"E	106.52'
C66	597.93'	470.00'	72°53'30"	N89°30'03"E	558.42'
C67	59.98'	470.00'	7°18'44"	S50°23'50"E	59.94'
C68	89.83'	100.55'	51°11'07"	S64°37'40"E	86.87'
C69	69.78'	60.00'	66°38'00"	S72°21'07"E	65.91'
C70	30.85'	60.00'	29°27'42"	N59°36'02"E	30.51'
C71	32.23'	60.00'	30°46'38"	N29°28'52"E	31.84'
C72	46.31'	60.00'	44°13'16"	N08°01'06"W	45.17'
C73	28.68'	85.00'	19°20'05"	N11°16'47"E	28.55'
C74	90.87'	150.00'	34°42'33"	S18°58'01"W	89.49'
C75	21.78'	15.00'	83°11'37"	S88°20'16"E	19.92'
C76	21.76'	15.00'	83°07'56"	S05°10'30"E	19.90'

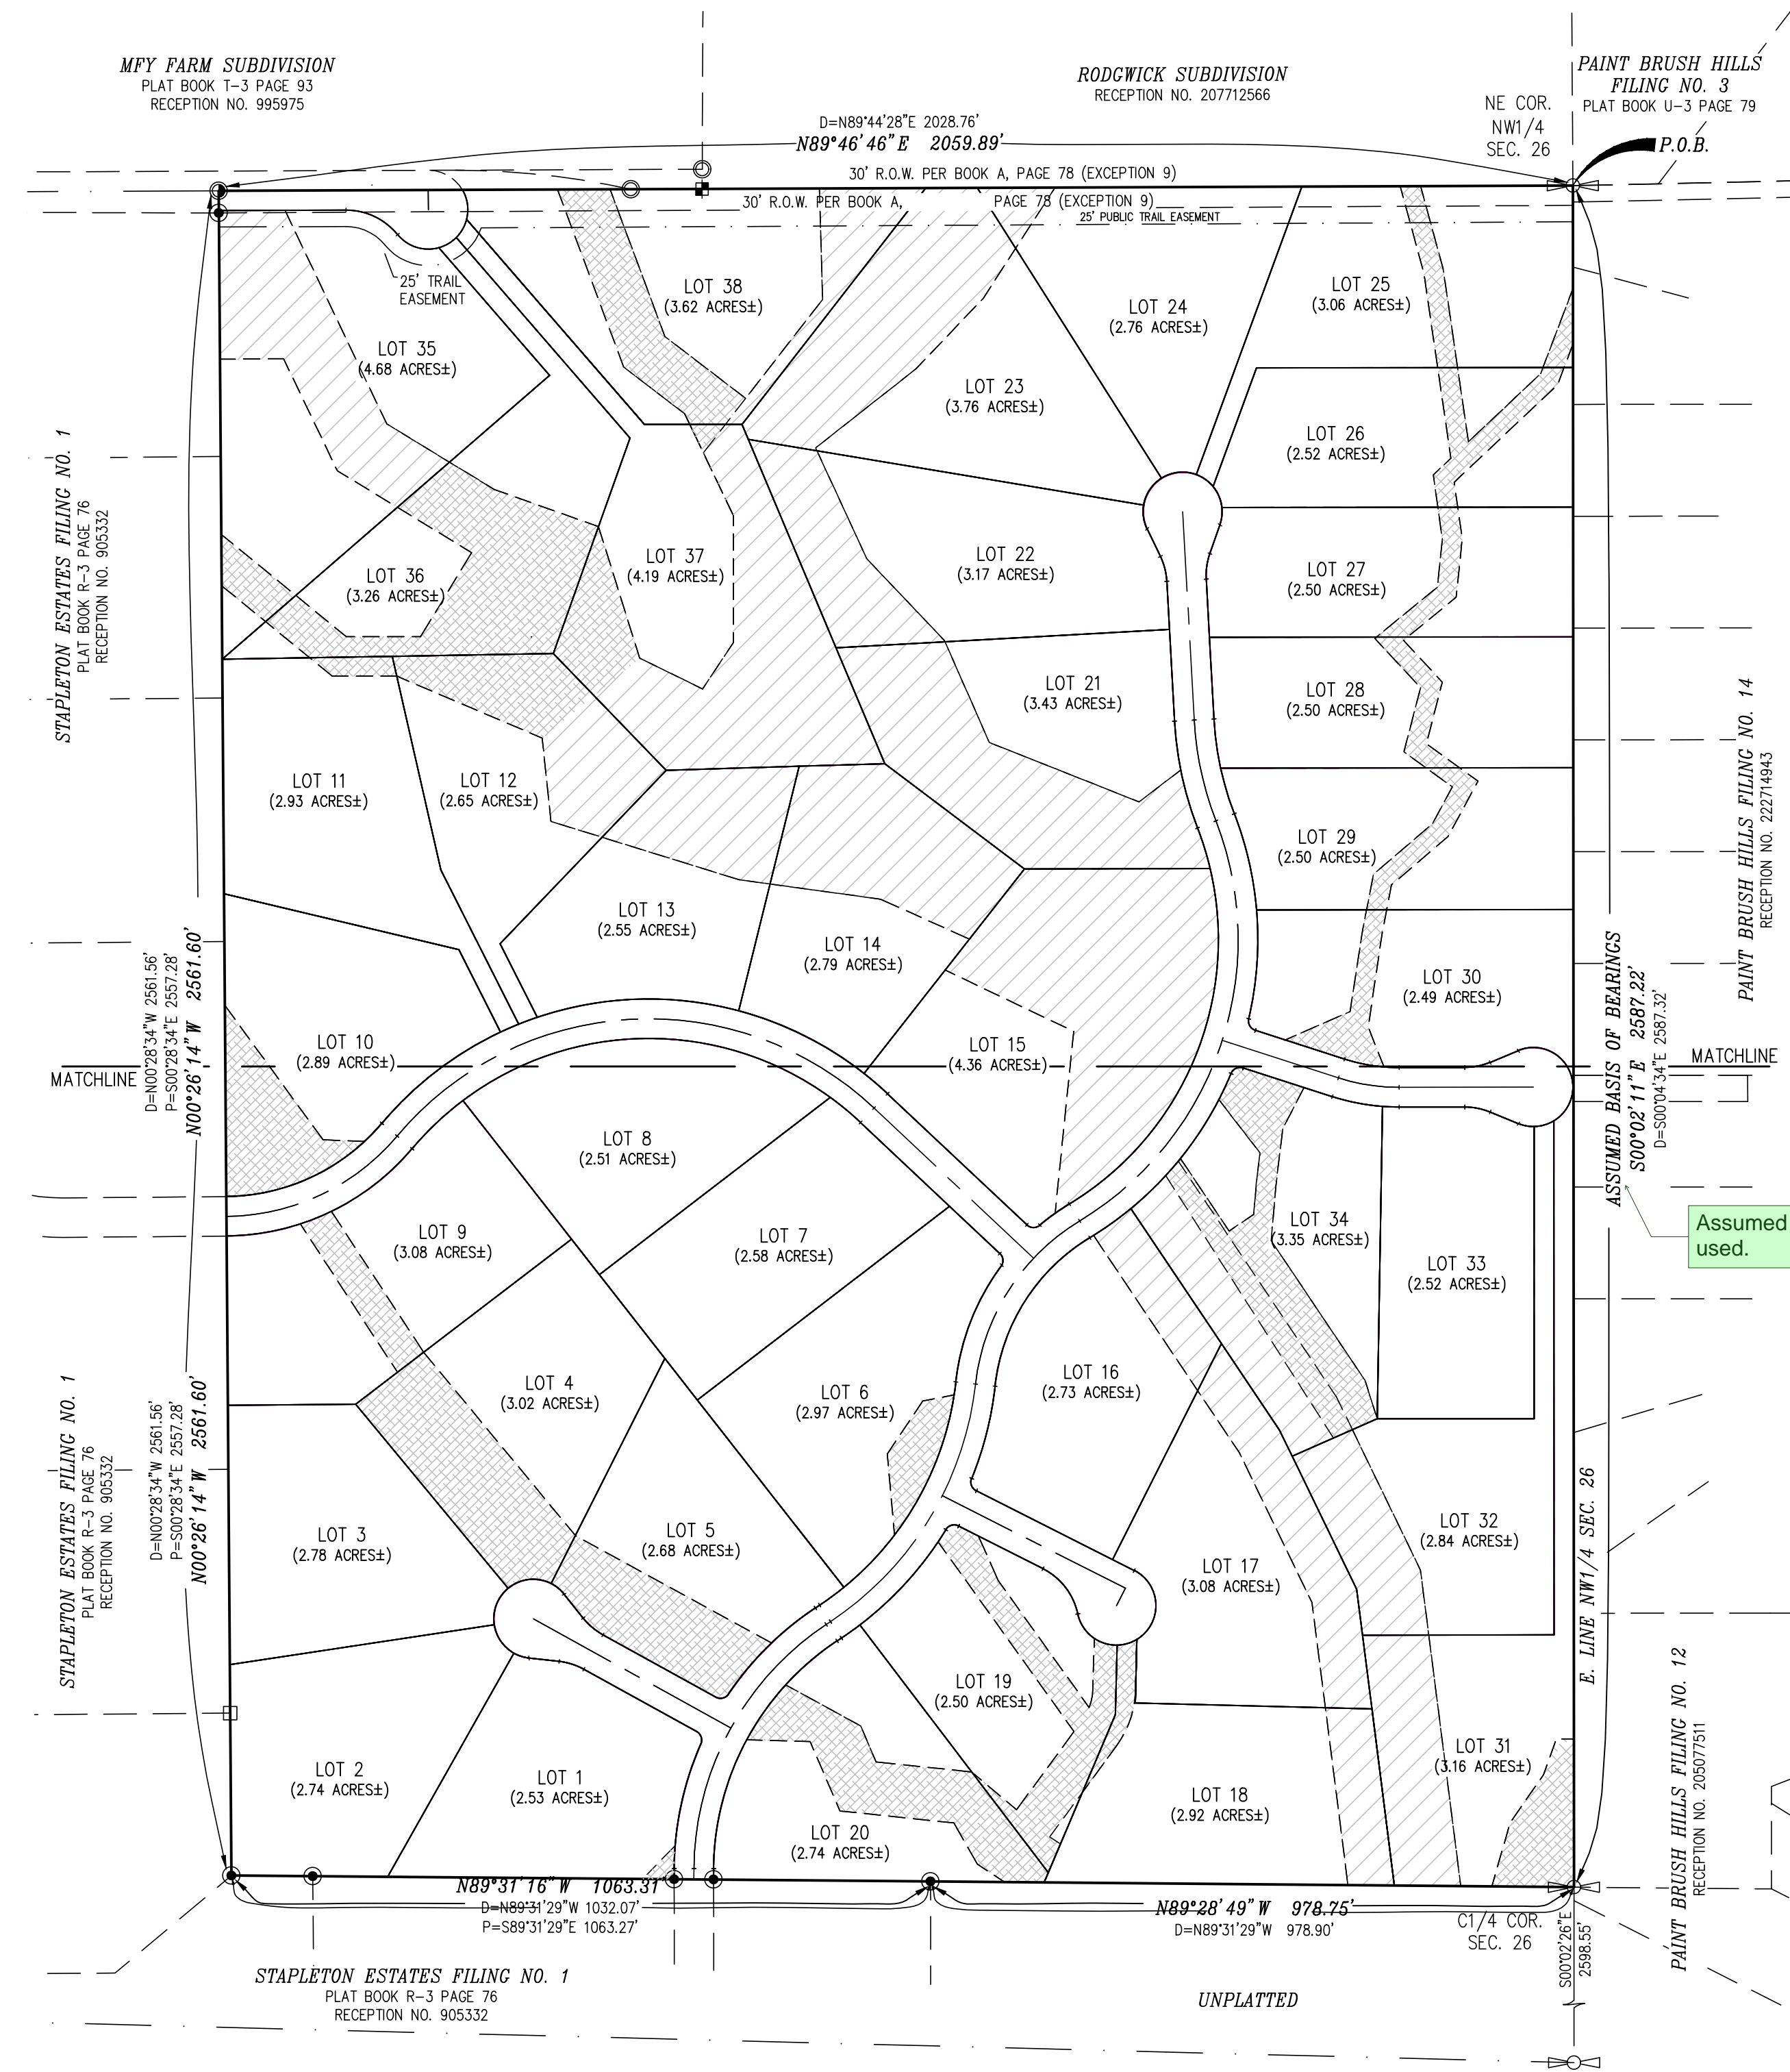

PCD FILE NO. SF-22-42 DATE OF PREPARATION: NOVEMBER 8 2022

EAGLEVIEW, A PORTION OF SEC. 26, TOWNSHIP 12 SOUTH,
RANGE 65 WEST OF THE 6th P.M., EL PASO COUNTY, CO


RAMPART
SURVEYS, LLC

P.O. Box 5101 Woodland Park, CO. 80866 (719) 687-0920

DRAWING: 21468 SUB_T.DWG PAGE 3 OF 5

EAGLEVIEW

A PORTION OF THE NORTHWEST QUARTER OF SECTION 26, TOWNSHIP 12 SOUTH, RANGE 65 WEST OF THE 6th P.M., EL PASO COUNTY, COLORADO

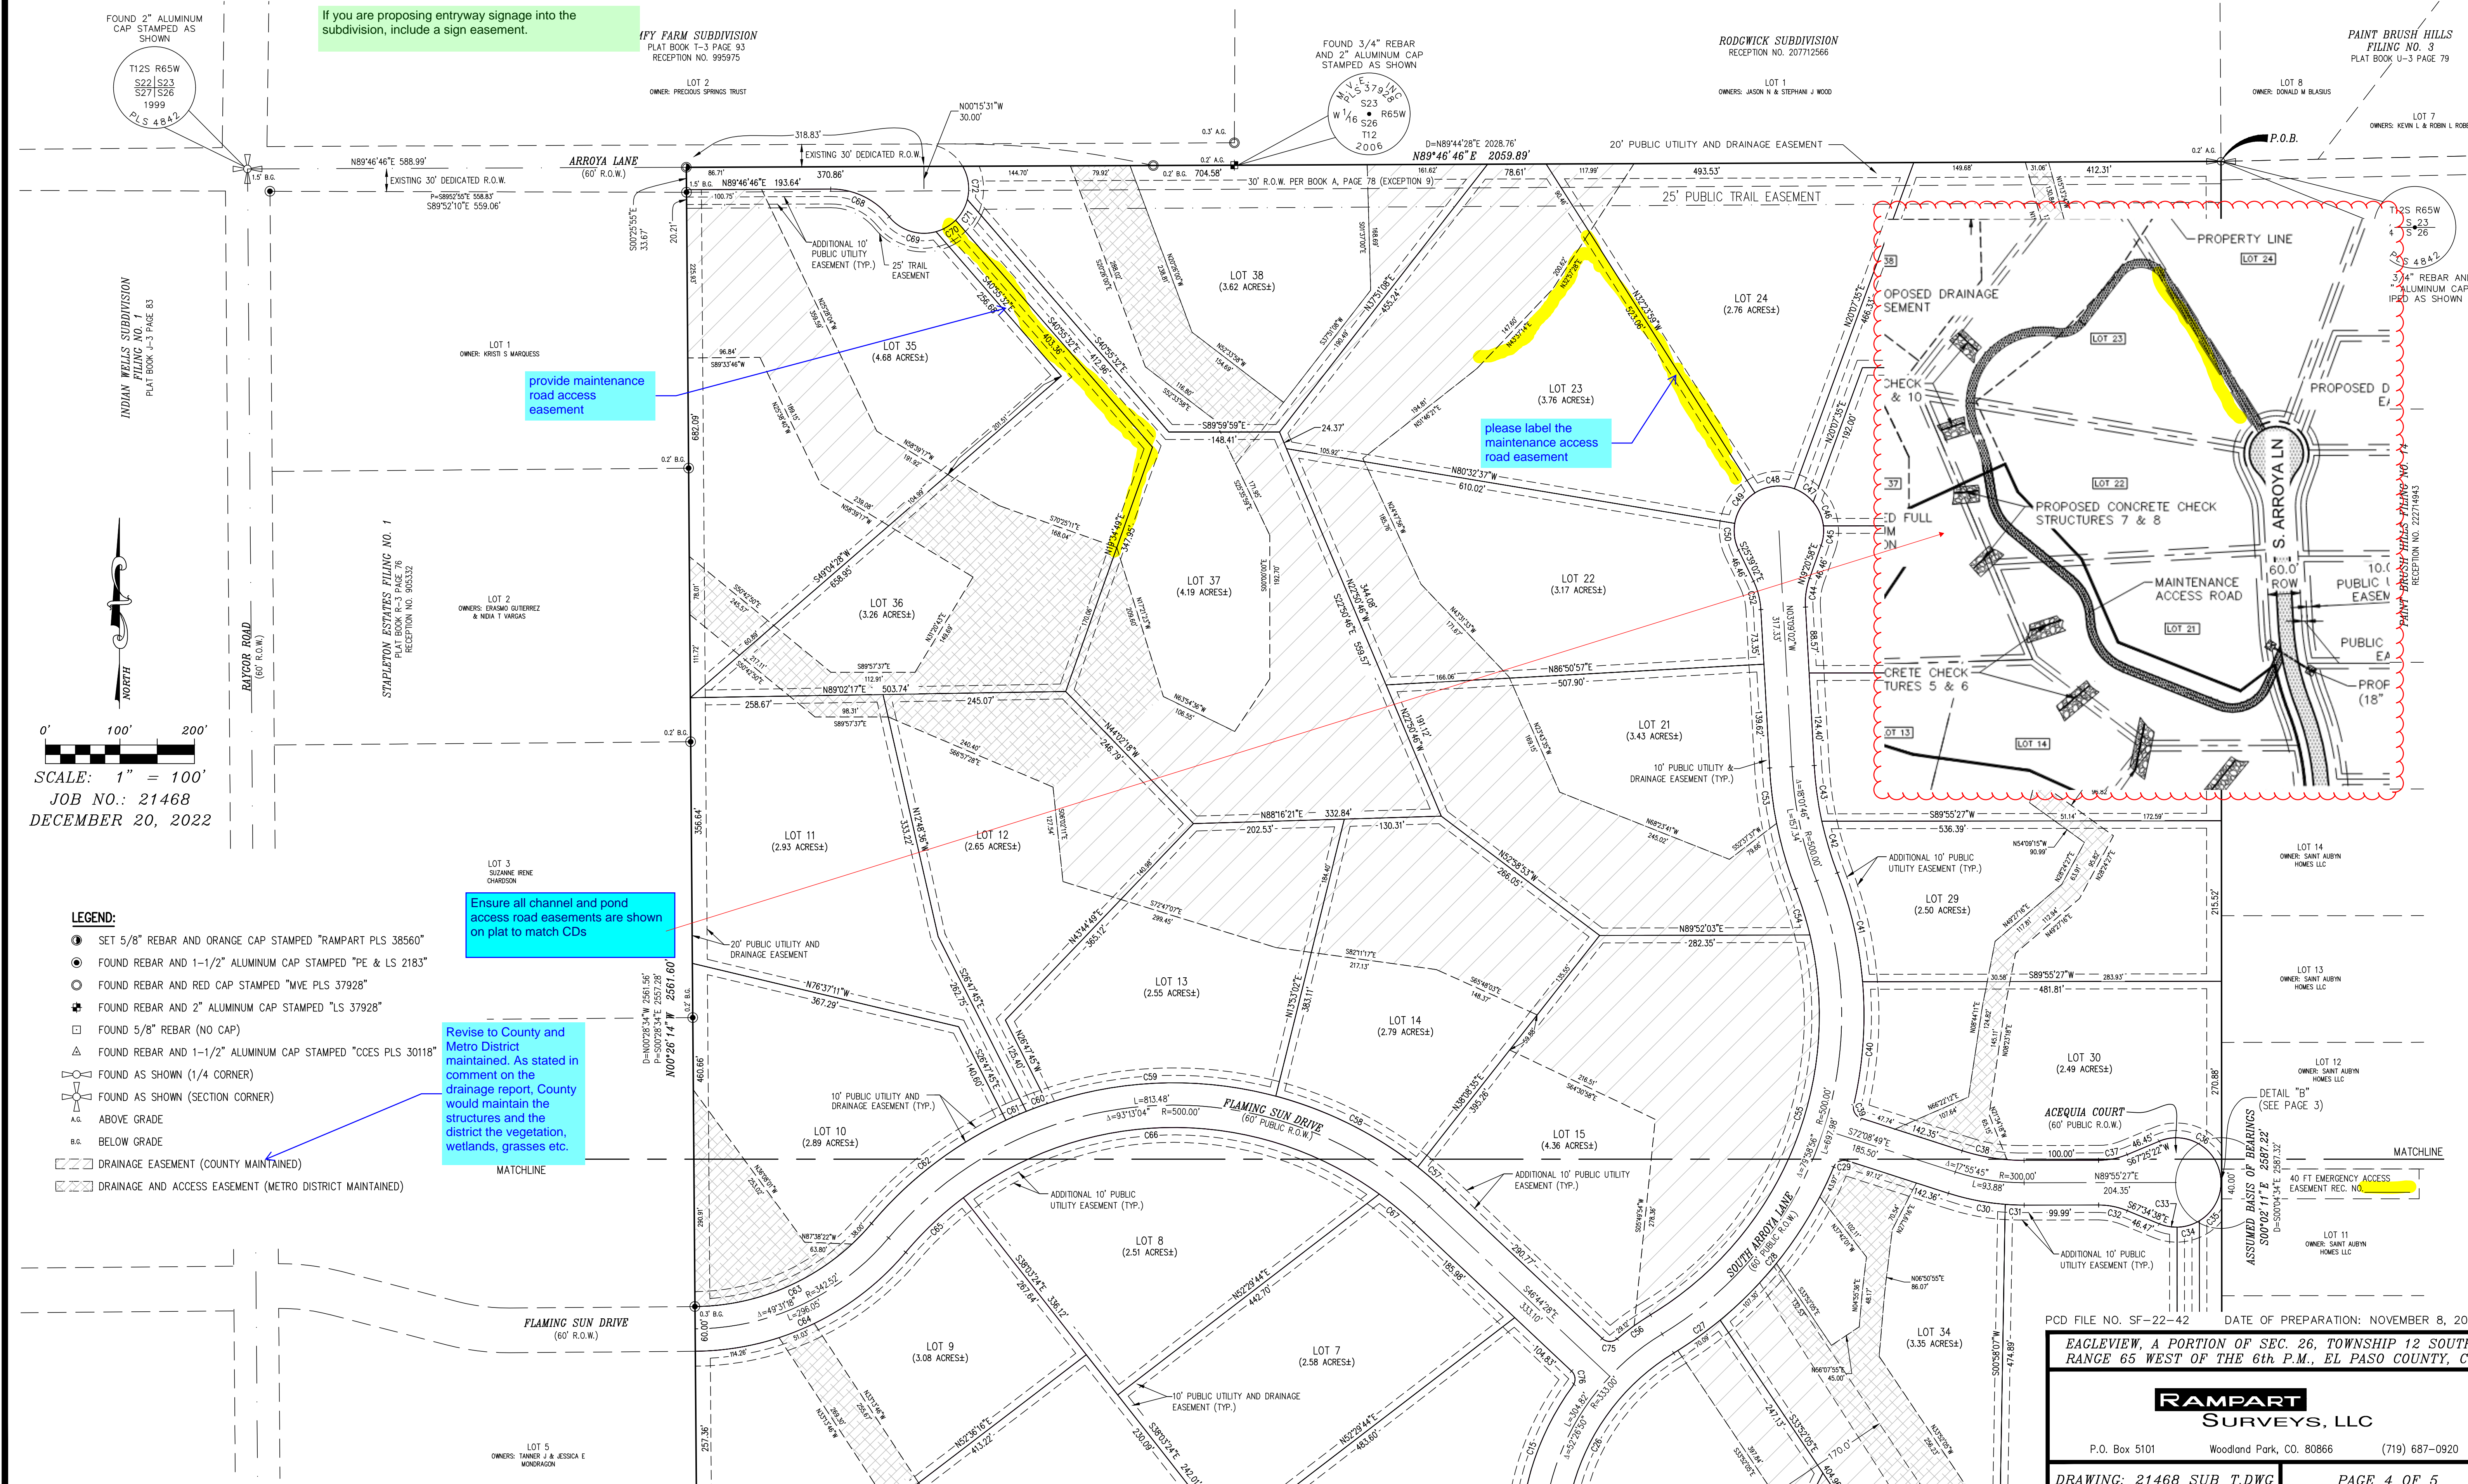

If you are proposing entryway signage into the subdivision, include a sign easement.

provide maintenance road access easement

please label the maintenance access road easement

Ensure all channel and pond access road easements are shown on plat to match CDs

Revise to County and Metro District maintained. As stated in comment on the drainage report, County would maintain the structures and the district the vegetation, wetlands, grasses etc.


- LEGEND:**
- SET 5/8" REBAR AND ORANGE CAP STAMPED "RAMPART PLS 38560"
 - FOUND REBAR AND 1-1/2" ALUMINUM CAP STAMPED "PE & LS 2183"
 - FOUND REBAR AND RED CAP STAMPED "MVE PLS 37928"
 - ⊕ FOUND REBAR AND 2" ALUMINUM CAP STAMPED "LS 37928"
 - FOUND 5/8" REBAR (NO CAP)
 - △ FOUND REBAR AND 1-1/2" ALUMINUM CAP STAMPED "CCES PLS 30118"
 - FOUND AS SHOWN (1/4 CORNER)
 - FOUND AS SHOWN (SECTION CORNER)
 - A.G. ABOVE GRADE
 - B.G. BELOW GRADE
 - ▨ DRAINAGE EASEMENT (COUNTY MAINTAINED)
 - ▩ DRAINAGE AND ACCESS EASEMENT (METRO DISTRICT MAINTAINED)

PCD FILE NO. SF-22-42 DATE OF PREPARATION: NOVEMBER 8, 2022
 EAGLEVIEW, A PORTION OF SEC. 26, TOWNSHIP 12 SOUTH, RANGE 65 WEST OF THE 6th P.M., EL PASO COUNTY, CO

RAMPART SURVEYS, LLC
 P.O. Box 5101 Woodland Park, CO, 80866 (719) 687-0920
 DRAWING: 21468 SUB_T.DWG PAGE 4 OF 5



EAGLEVIEW

A PORTION OF THE NORTHWEST QUARTER OF SECTION 26, TOWNSHIP 12 SOUTH, RANGE 65 WEST OF THE 6th P.M., EL PASO COUNTY, COLORADO

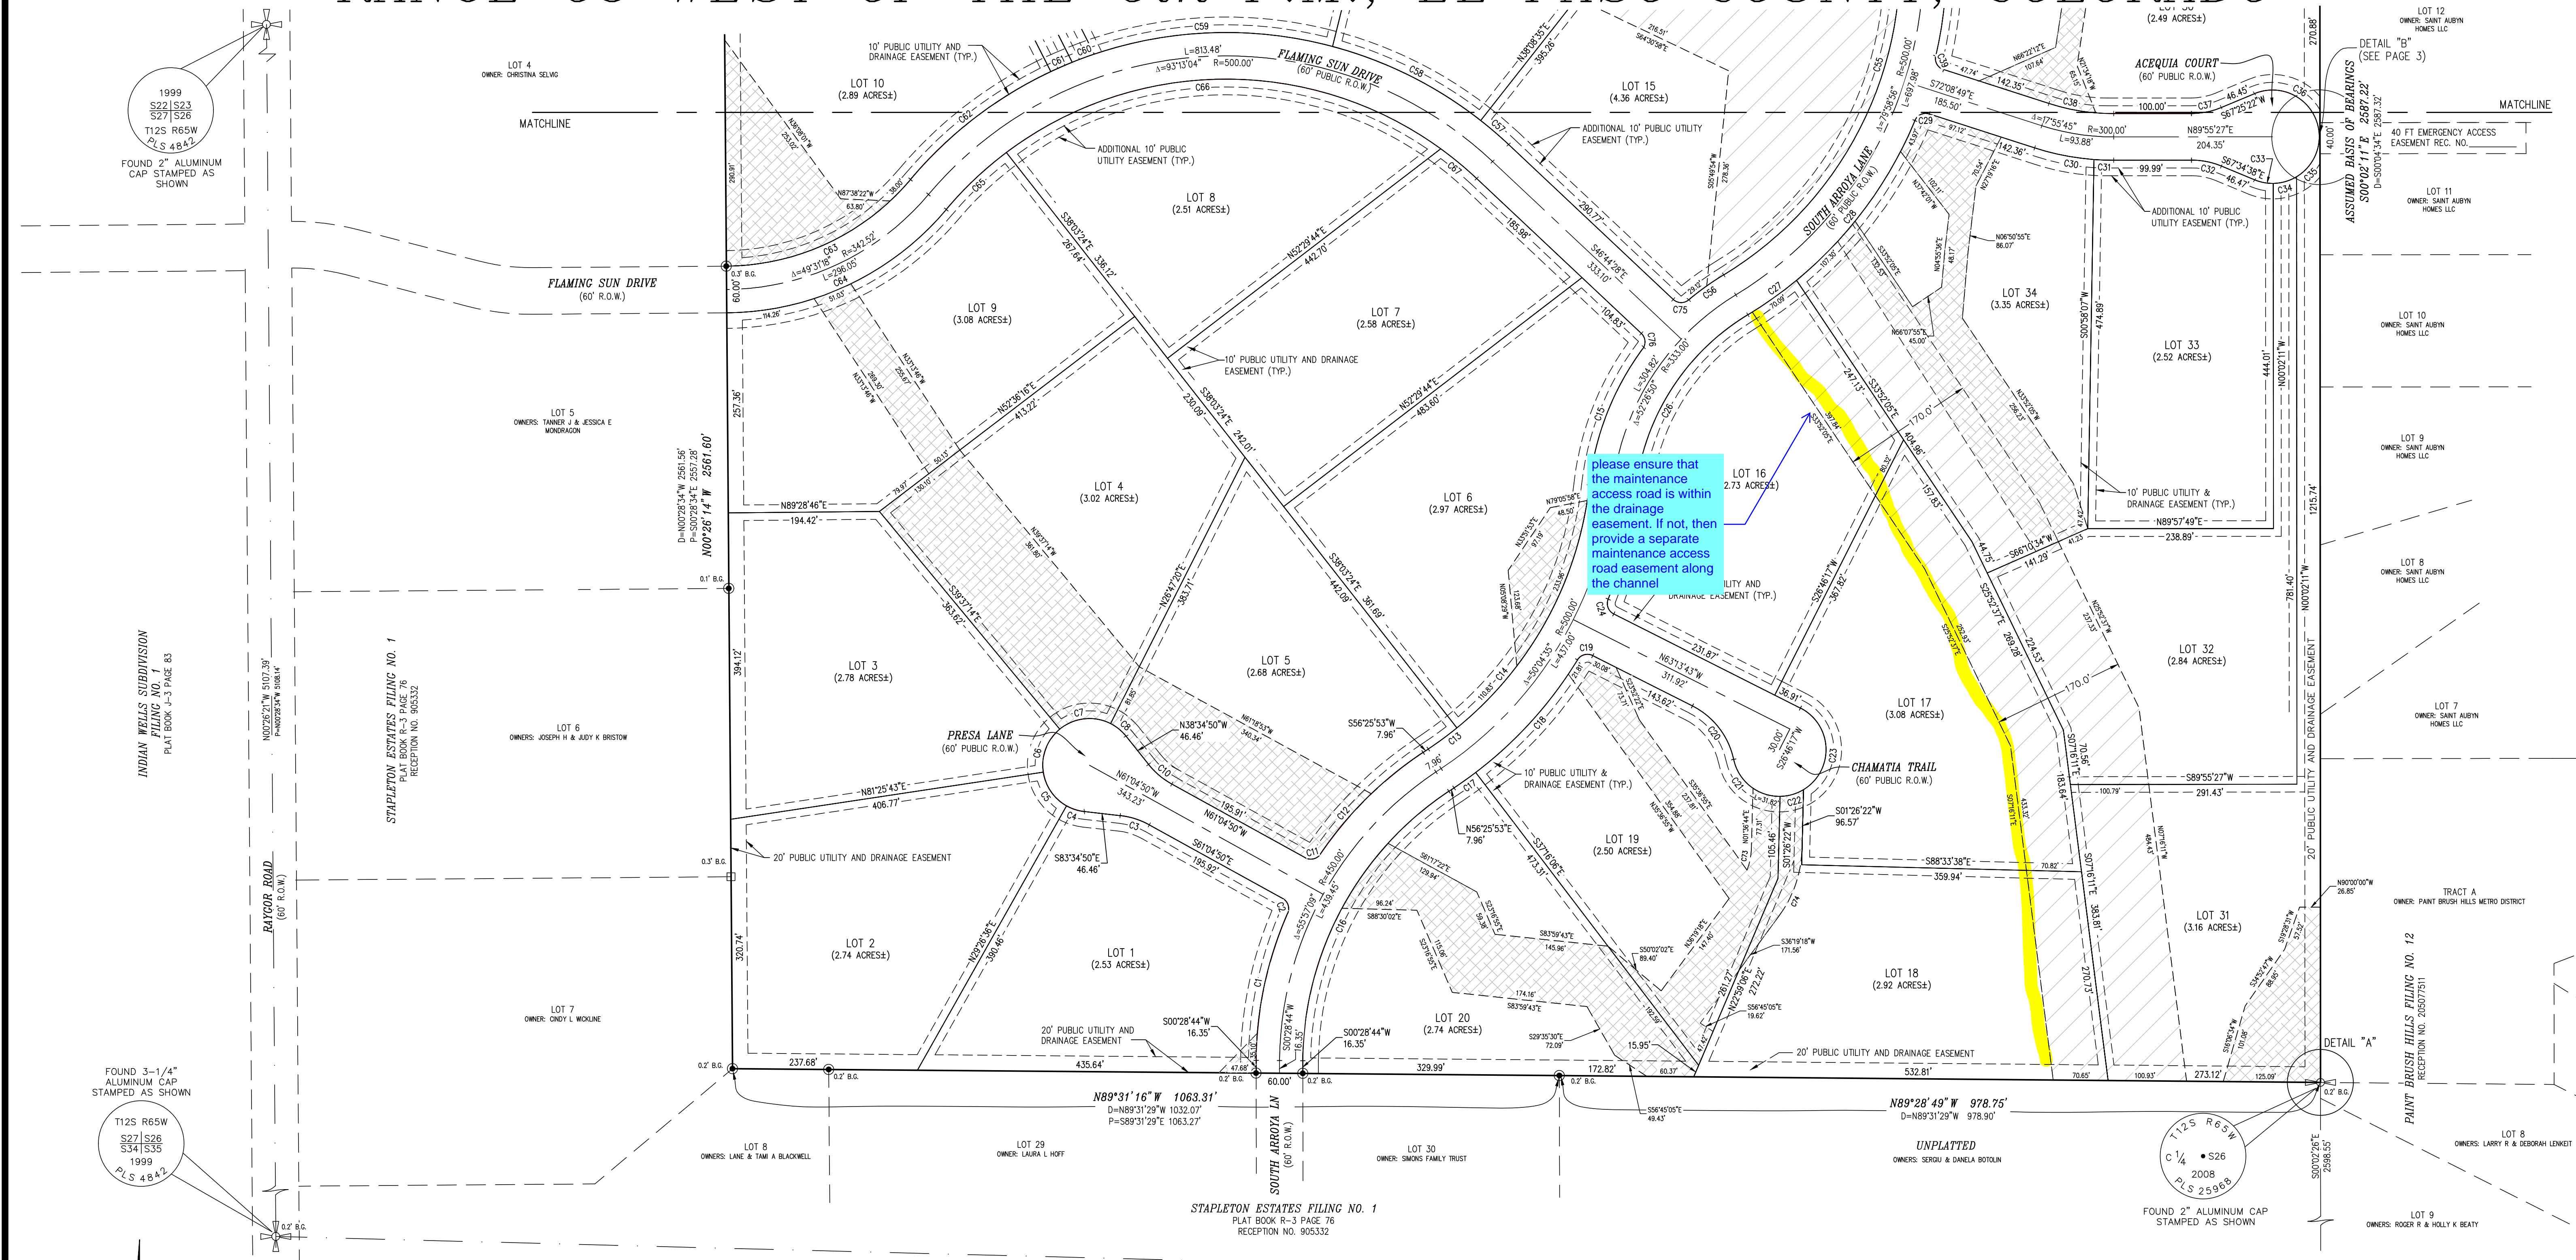

please ensure that the maintenance access road is within the drainage easement. If not, then provide a separate maintenance access road easement along the channel

- LEGEND:**
- SET 5/8" REBAR AND ORANGE CAP STAMPED "RAMPART PLS 38560"
 - FOUND REBAR AND 1-1/2" ALUMINUM CAP STAMPED "PE & LS 2183"
 - FOUND REBAR AND RED CAP STAMPED "MVE PLS 37928"
 - FOUND REBAR AND 2" ALUMINUM CAP STAMPED "LS 37928"
 - FOUND 5/8" REBAR (NO CAP)
 - △ FOUND REBAR AND 1-1/2" ALUMINUM CAP STAMPED "CCES PLS 30118"
 - FOUND AS SHOWN (1/4 CORNER)
 - FOUND AS SHOWN (SECTION CORNER)
 - A.G. ABOVE GRADE
 - B.G. BELOW GRADE
 - ▨ DRAINAGE EASEMENT (COUNTY MAINTAINED)
 - ▨ DRAINAGE AND ACCESS EASEMENT (METRO DISTRICT MAINTAINED)

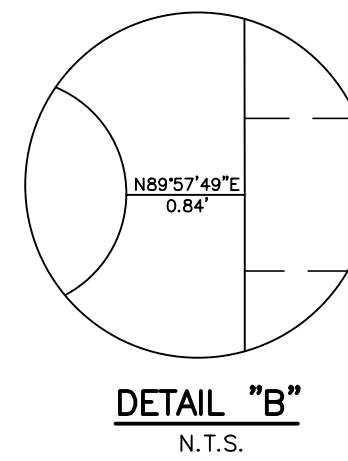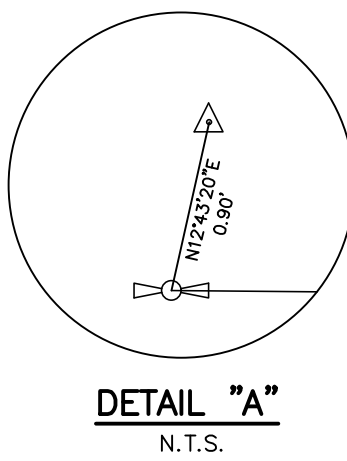

SCALE: 1" = 100'
JOB NO.: 21468
DECEMBER 20, 2022

PCD FILE NO. SF-22-42 DATE OF PREPARATION: NOVEMBER 8 2022

EAGLEVIEW, A PORTION OF SEC. 26, TOWNSHIP 12 SOUTH, RANGE 65 WEST OF THE 6th P.M., EL PASO COUNTY, CO

RAMPART SURVEYS, LLC

P.O. Box 5101 Woodland Park, CO, 80866 (719) 687-0920

DRAWING: 21468 SUB_T.DWG PAGE 5 OF 5

C:\Users\jramsey\OneDrive\Documents\Eagleview\Drawings\21468\21468_SUB_T.DWG - 11/22/2022 4:47:54 AM