


Kubit / Stirlins HOME A1

TALLENT HOME A1

290.0' TWILIGHT CANYON TRAIL

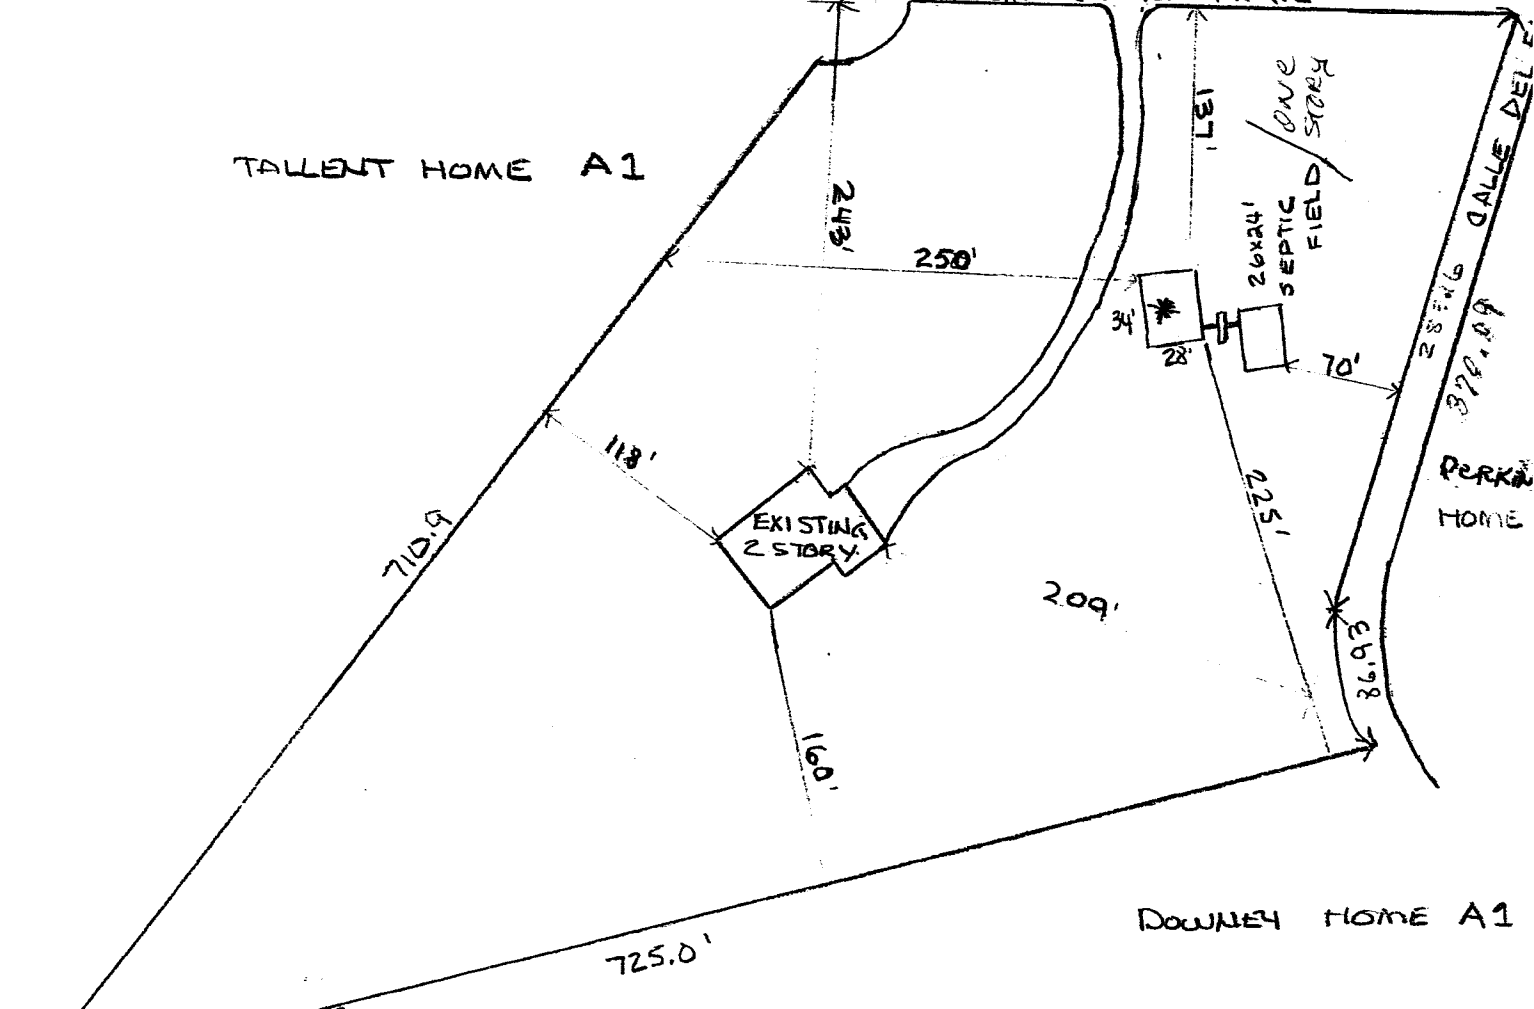


PERKIN HOME
379.09' CALLE DEL...

DOWNEY HOME A1

BENJAMIN HOME A1

* STRUCTURE

Change this to say guest house or guest house structure.

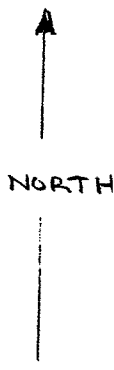

Markup Summary

dsdkendall (1)

☞ U R E

Change this to say
guest house or guest
house structure.

Subject: Callout
Page Label: 1
Lock: Locked
Author: dsdkendall
Date: 12/31/2018 2:10:56 PM
Color: ■

Change this to say guest house or guest house structure.