


Include a note stating that if and when the future expansion of a high school occurs the necessary parking required for a high school will be added to meet the parking regulations.

NOTE: THE PARTIES RESPONSIBLE FOR THIS PLAN HAVE FAMILIARIZED THEMSELVES WITH ALL CURRENT ACCESSIBILITY CRITERIA AND SPECIFICATIONS AND THE PROPOSED PLAN REFLECTS ALL SITE ELEMENTS REQUIRED BY THE APPLICABLE ADA DESIGN STANDARDS AND GUIDELINES AS PUBLISHED BY THE UNITED STATES DEPARTMENT OF JUSTICE. APPROVAL OF THIS PLAN BY EL PASO COUNTY DOES NOT ASSURE COMPLIANCE WITH THE ADA OR ANY REGULATIONS OR GUIDELINES ENACTED OR PROMULGATED UNDER OR WITH RESPECT TO SUCH LAWS.

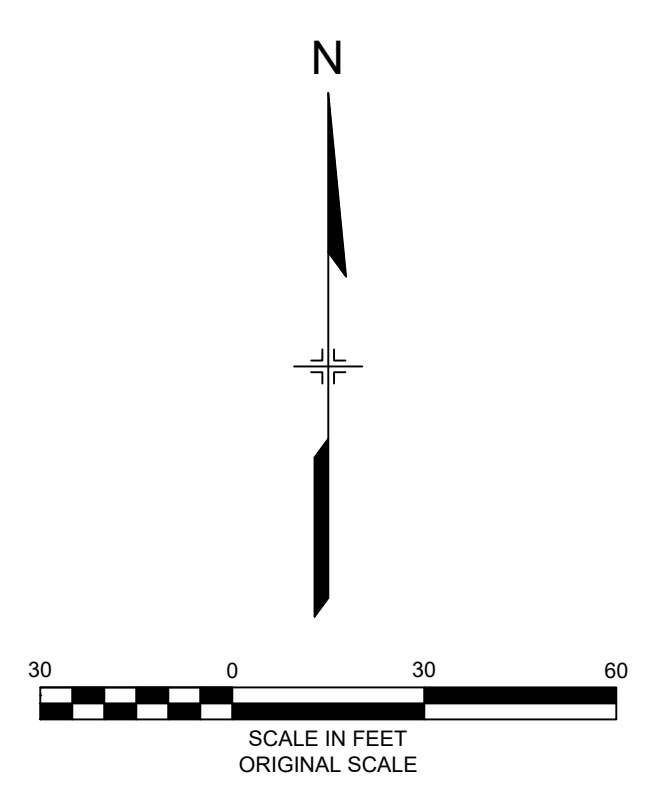

REFERENCE DRAWINGS	NO.	DATE	DESCRIPTION	BY
X:995-MD-022x34				
X:995-PR-BASE				
X:995-EX-BASE				
X:995-EX-MAP				
X:995-PR-UTIL				
LTA OVERALL FIRST FLOOR PLAN				

COMPUTER FILE MANAGEMENT	
FILE NAME:	R:118.995.001 (Liberty Tree Academy)\Dwg\Site Development Plan\SP01_SDP.dwg
CTB FILE:	---
PLOT DATE:	7/2/2018 5:31 PM
THIS DRAWING IS CURRENT AS OF PLOT DATE AND MAY BE SUBJECT TO CHANGE.	

SHEET KEY

PREPARED FOR:
LIBERTY TREE ACADEMY

PREPARED BY:
Matrix DESIGN GROUP
AN EMPLOYEE-OWNED COMPANY

SEAL



FOR AND ON BEHALF OF
MATRIX DESIGN GROUP, INC.
PROJECT No. 18.995.001

LIBERTY TREE ACADEMY

TOWN OF PEYTON, EL PASO COUNTY
SITE DEVELOPMENT PLAN

SITE PLAN

DESIGNED BY:	ACR	SCALE:	DATE ISSUED:	JUNE 2018	DRAWING No.
DRAWN BY:	ACR	HORIZ.	SHEET	2 OF 11	SP01
CHECKED BY:	DRK	VERT.			

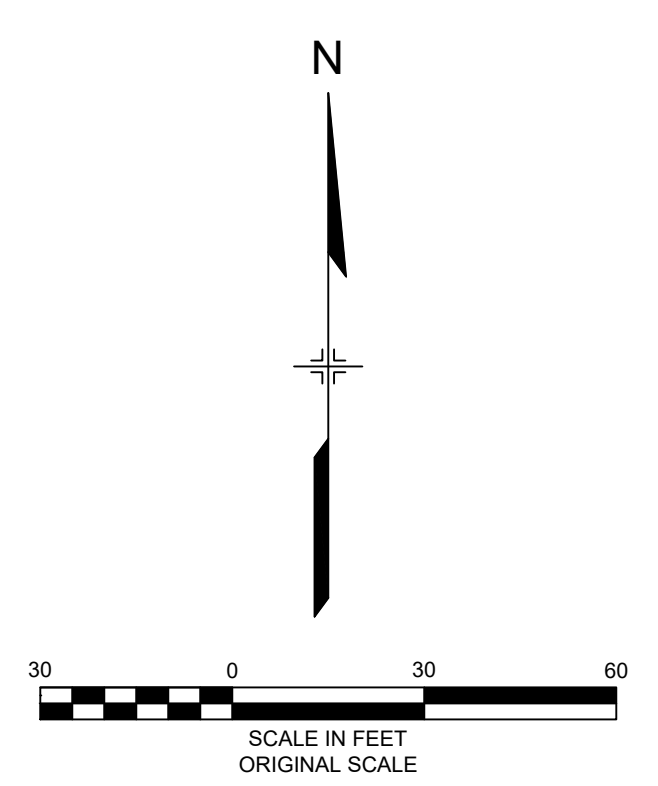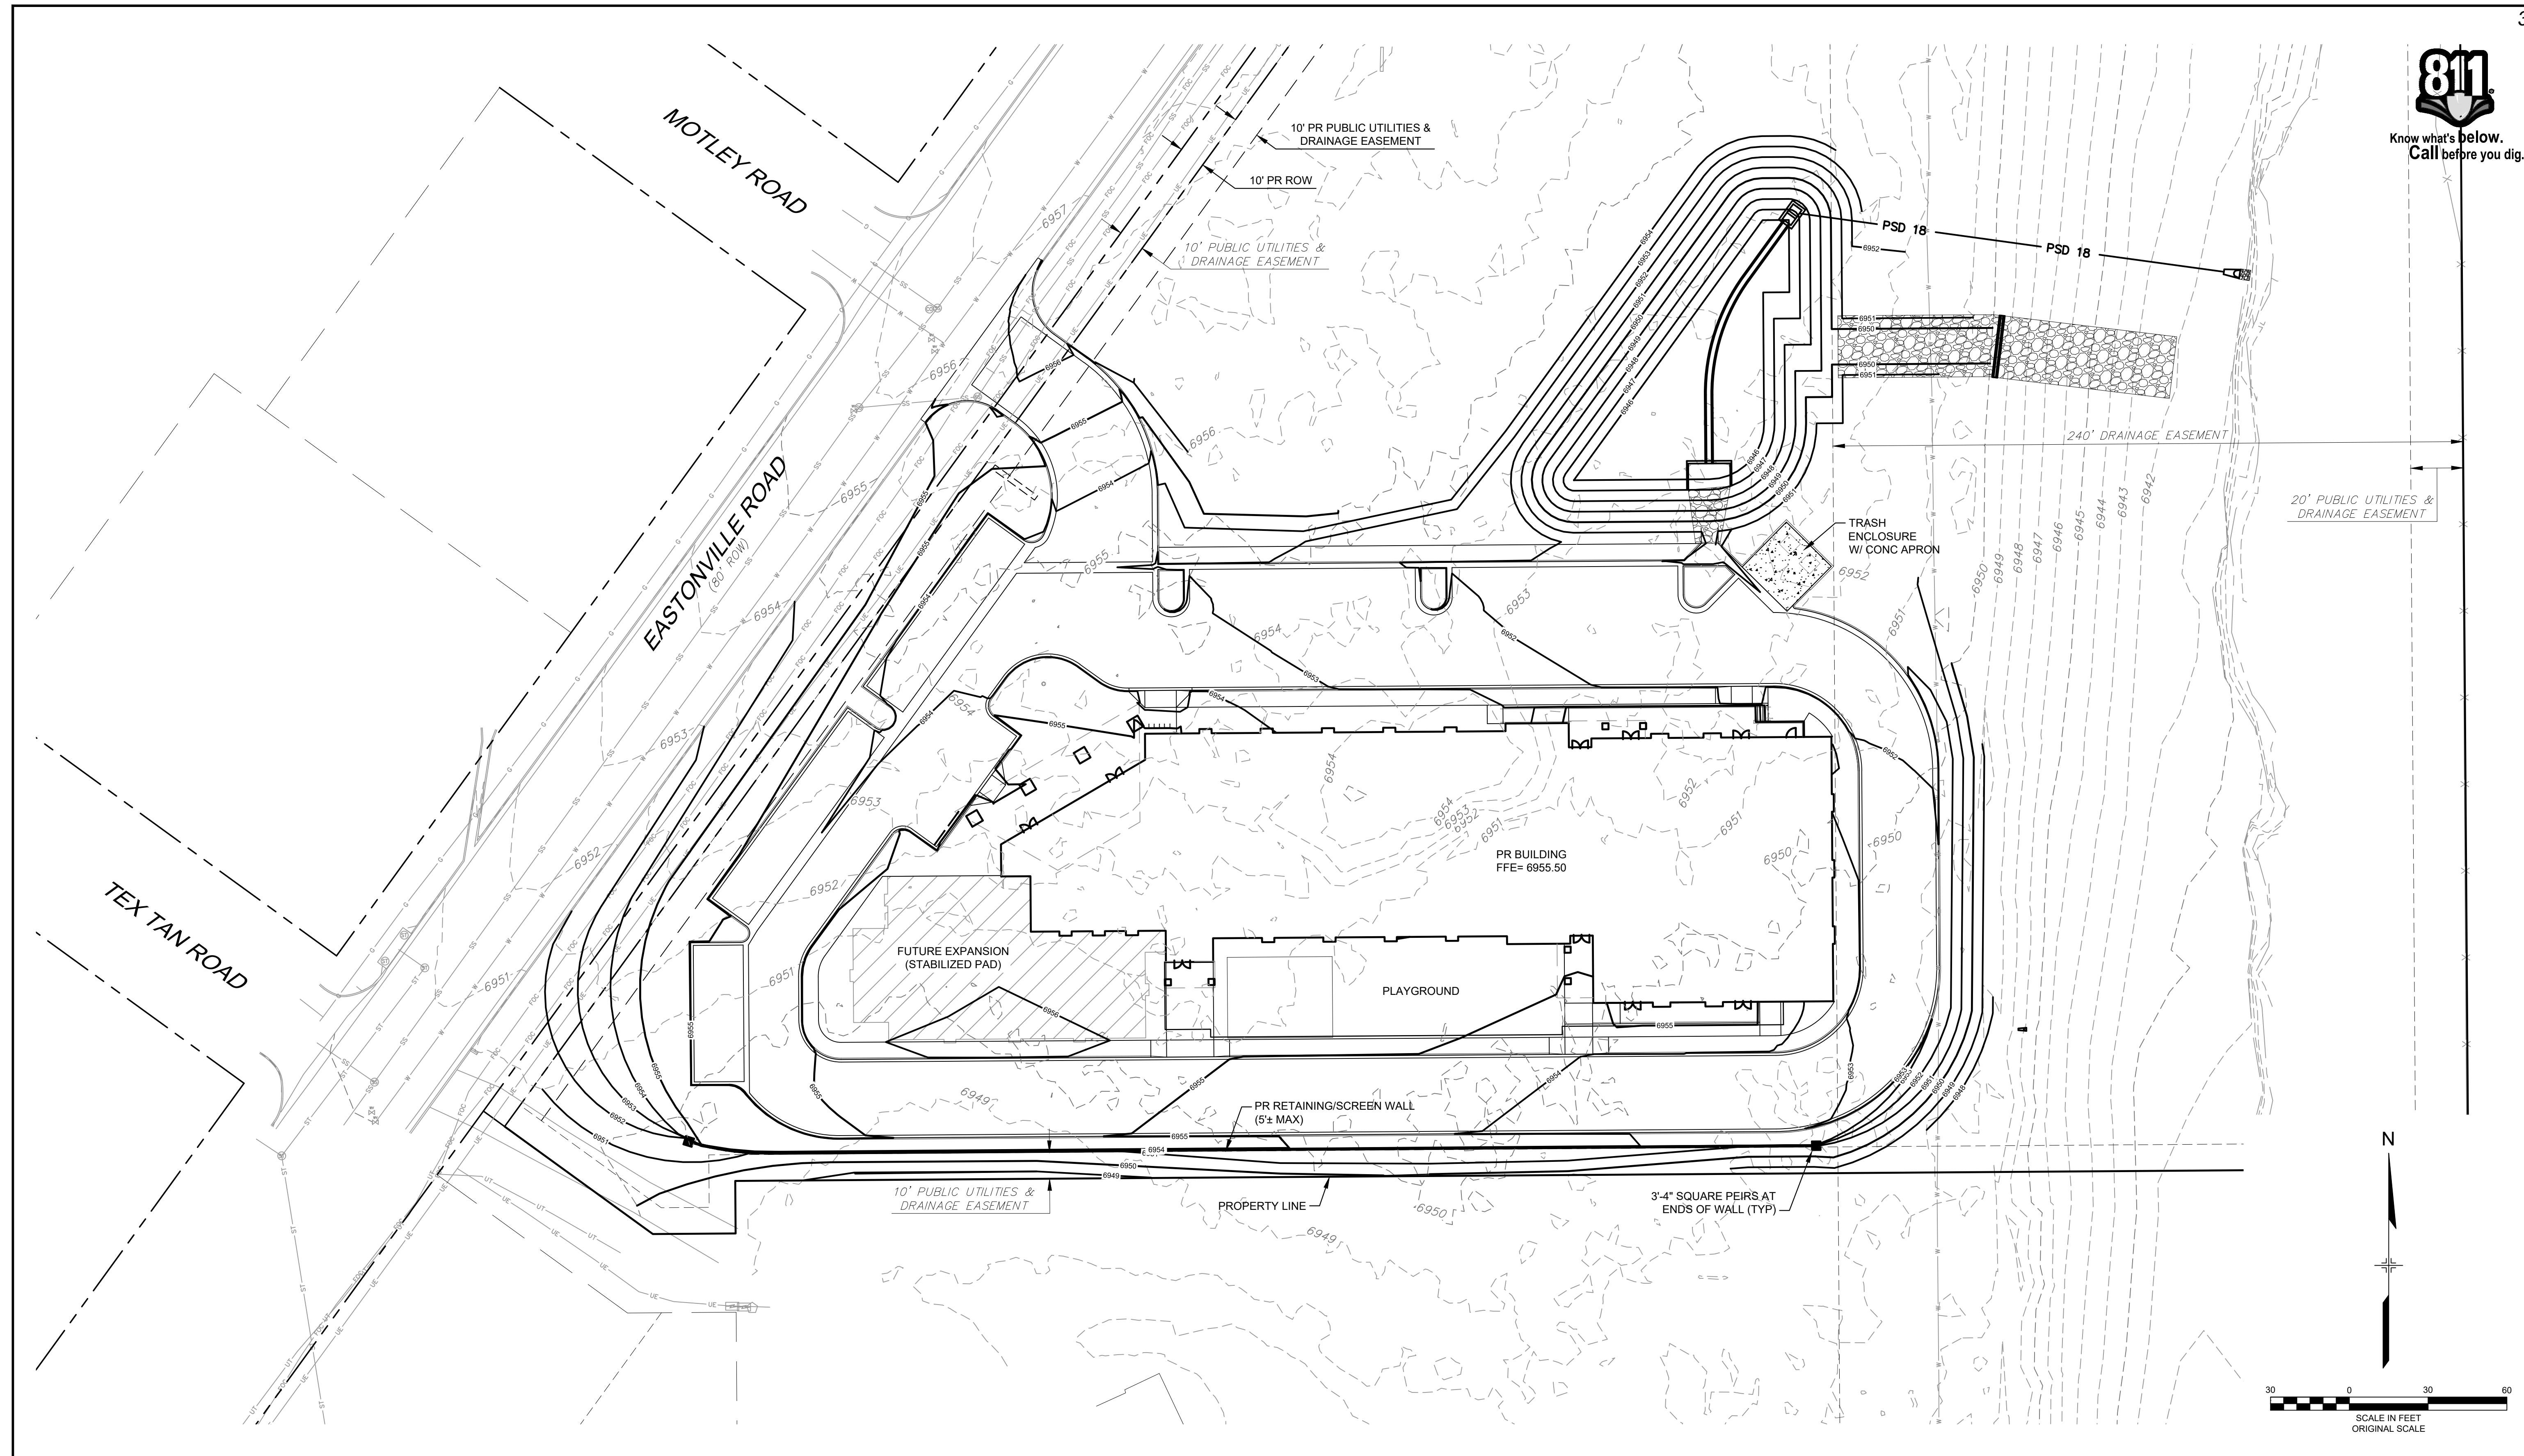

REF. NO.	DATE	DESCRIPTION	BY
COMPUTER FILE MANAGEMENT			
FILE NAME: R:118.995.001 (Liberty Tree Academy)\Dwg\Site Development Plan\GR01_SDP.dwg			
CTB FILE: ----			
PLOT DATE: 7/2/2018 5:32 PM			
THIS DRAWING IS CURRENT AS OF PLOT DATE AND MAY BE SUBJECT TO CHANGE.			

SHEET NO.	TOTAL SHEETS
1	1

LIBERTY TREE ACADEMY

TOWN OF PEYTON, EL PASO COUNTY

SITE DEVELOPMENT PLAN

GRADING PLAN

PREPARED FOR:

LIBERTY TREE ACADEMY

PREPARED BY:



Matrix DESIGN GROUP

AN EMPLOYEE-OWNED COMPANY

SEAL

FOR AND ON BEHALF OF
MATRIX DESIGN GROUP, INC.
PROJECT No. 18.995.001

DESIGNED BY: ACR	SCALE: HORIZ.	DATE ISSUED: JUNE 2018	DRAWING No. GR01
DRAWN BY: ACR	SCALE: VERT.	SHEET: 3 OF 11	
CHECKED BY: DRK			

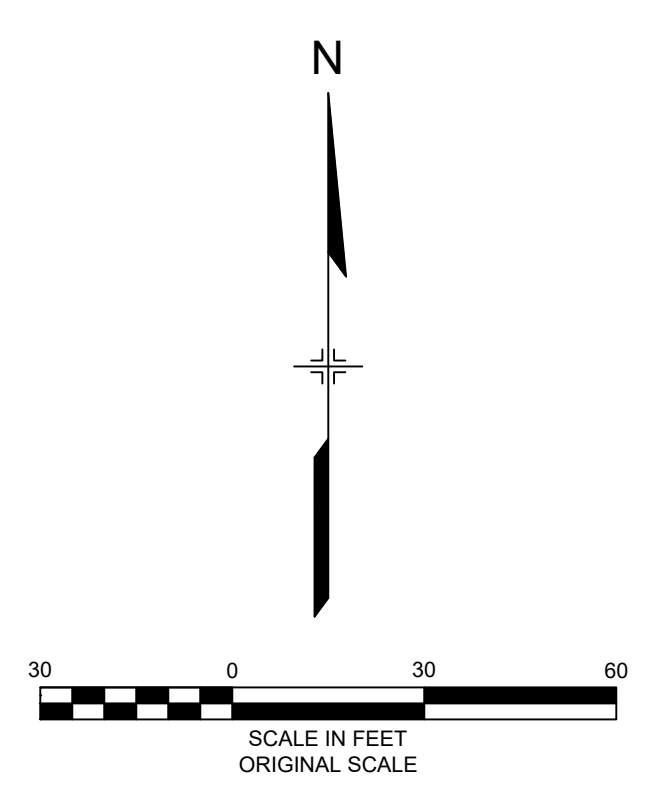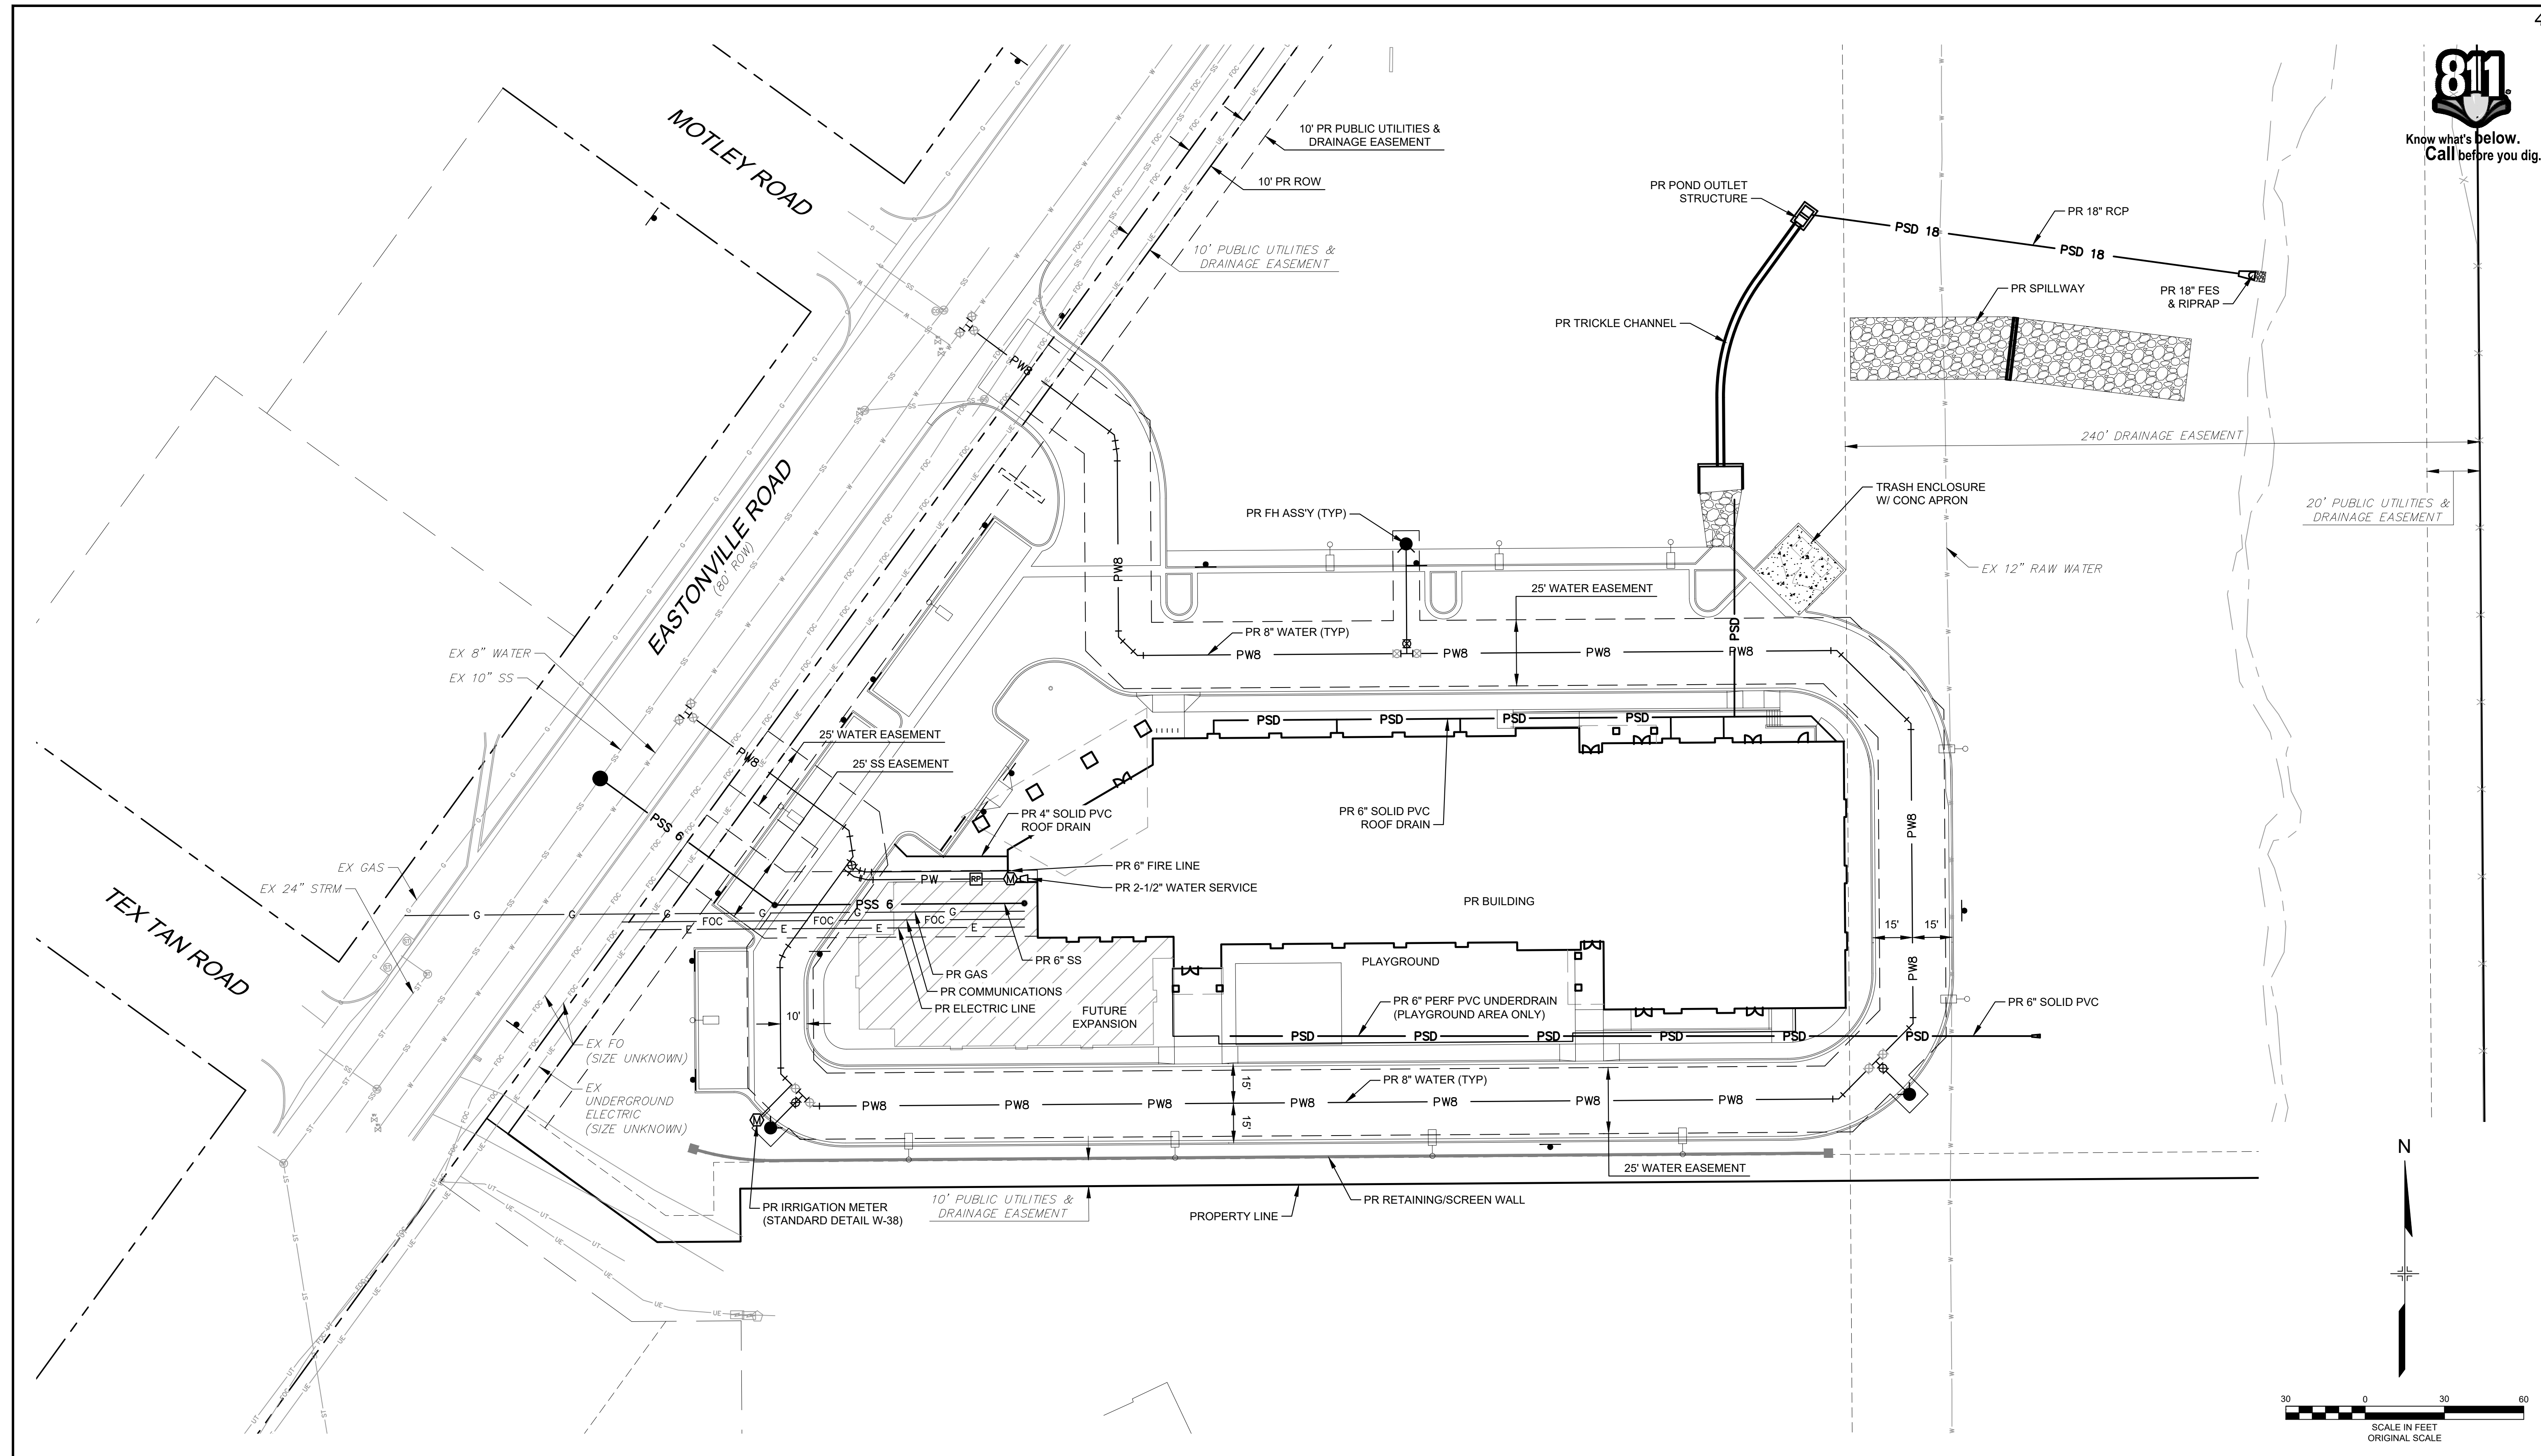

REFERENCE DRAWINGS	NO.	DATE	DESCRIPTION	BY
X:995-MDQ22x34				
X:995-PR-BASE				
X:995-EX-BASE				
X:995-EX-MAP				
X:995-PR-UTIL				
LTA OVERALL FIRST FLOOR PLAN				

COMPUTER FILE MANAGEMENT	
FILE NAME:	R:118.995.001 (Liberty Tree Academy)\Dwg\Site Development Plan\UT01_SDP.dwg
CTB FILE:	---
PLOT DATE:	7/2/2018 5:32 PM
THIS DRAWING IS CURRENT AS OF PLOT DATE AND MAY BE SUBJECT TO CHANGE.	

SHEET KEY	

PREPARED FOR:
LIBERTY TREE ACADEMY

PREPARED BY:
Matrix DESIGN GROUP
 AN EMPLOYEE-OWNED COMPANY

SEAL

FOR AND ON BEHALF OF
 MATRIX DESIGN GROUP, INC.
 PROJECT No. 18.995.001

LIBERTY TREE ACADEMY

TOWN OF PEYTON, EL PASO COUNTY
 SITE DEVELOPMENT PLAN



OVERALL UTILITY PLAN

DESIGNED BY:	ACR	SCALE:	DATE ISSUED:	JUNE 2018	DRAWING No.
DRAWN BY:	ACR	HORIZ.	SHEET	4 OF 11	UT01
CHECKED BY:	DRK	VERT.			



- LANDSCAPE LEGEND**
- DECIDUOUS SHADE TREE
 - DECIDUOUS MULTI-STEM TREE
 - ORNAMENTAL TREE
 - EVERGREEN TREE
 - UPRIGHT JUNIPER
 - DECIDUOUS SHRUBS, 5 GAL.
 - EVERGREEN SHRUBS, 5 GAL.
 - ORNAMENTAL GRASS, 5 GAL.
 - STEEL LANDSCAPE EDGER
 - 3" DEPTH RIVER GRAVEL MULCH OVER WEED BARRIER FABRIC
 - NATIVE GRASS SEEDING
 - PROJECT LIMIT OF WORK

PLEASE REFER TO SHEET LS02 FOR PROJECT DATA, PLANT LEGEND, AND LANDSCAPE NOTES

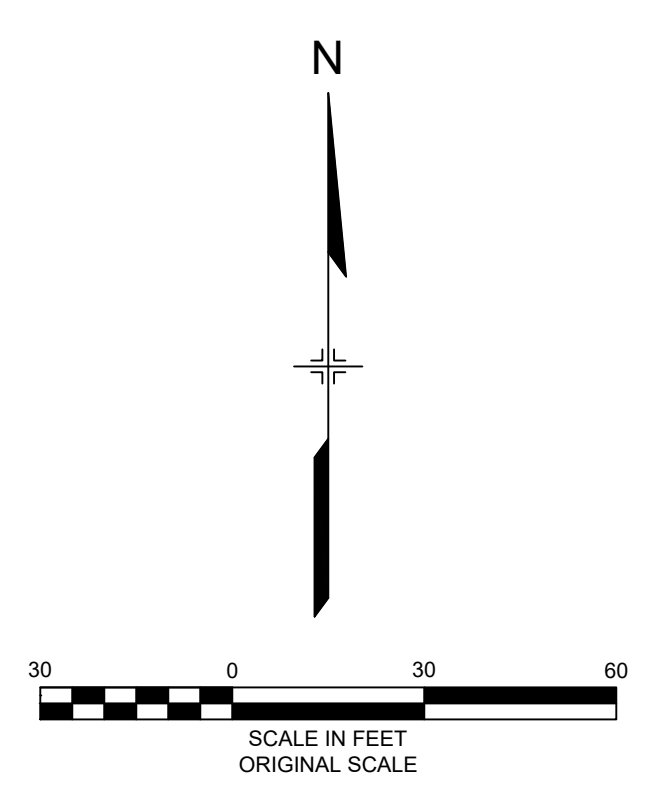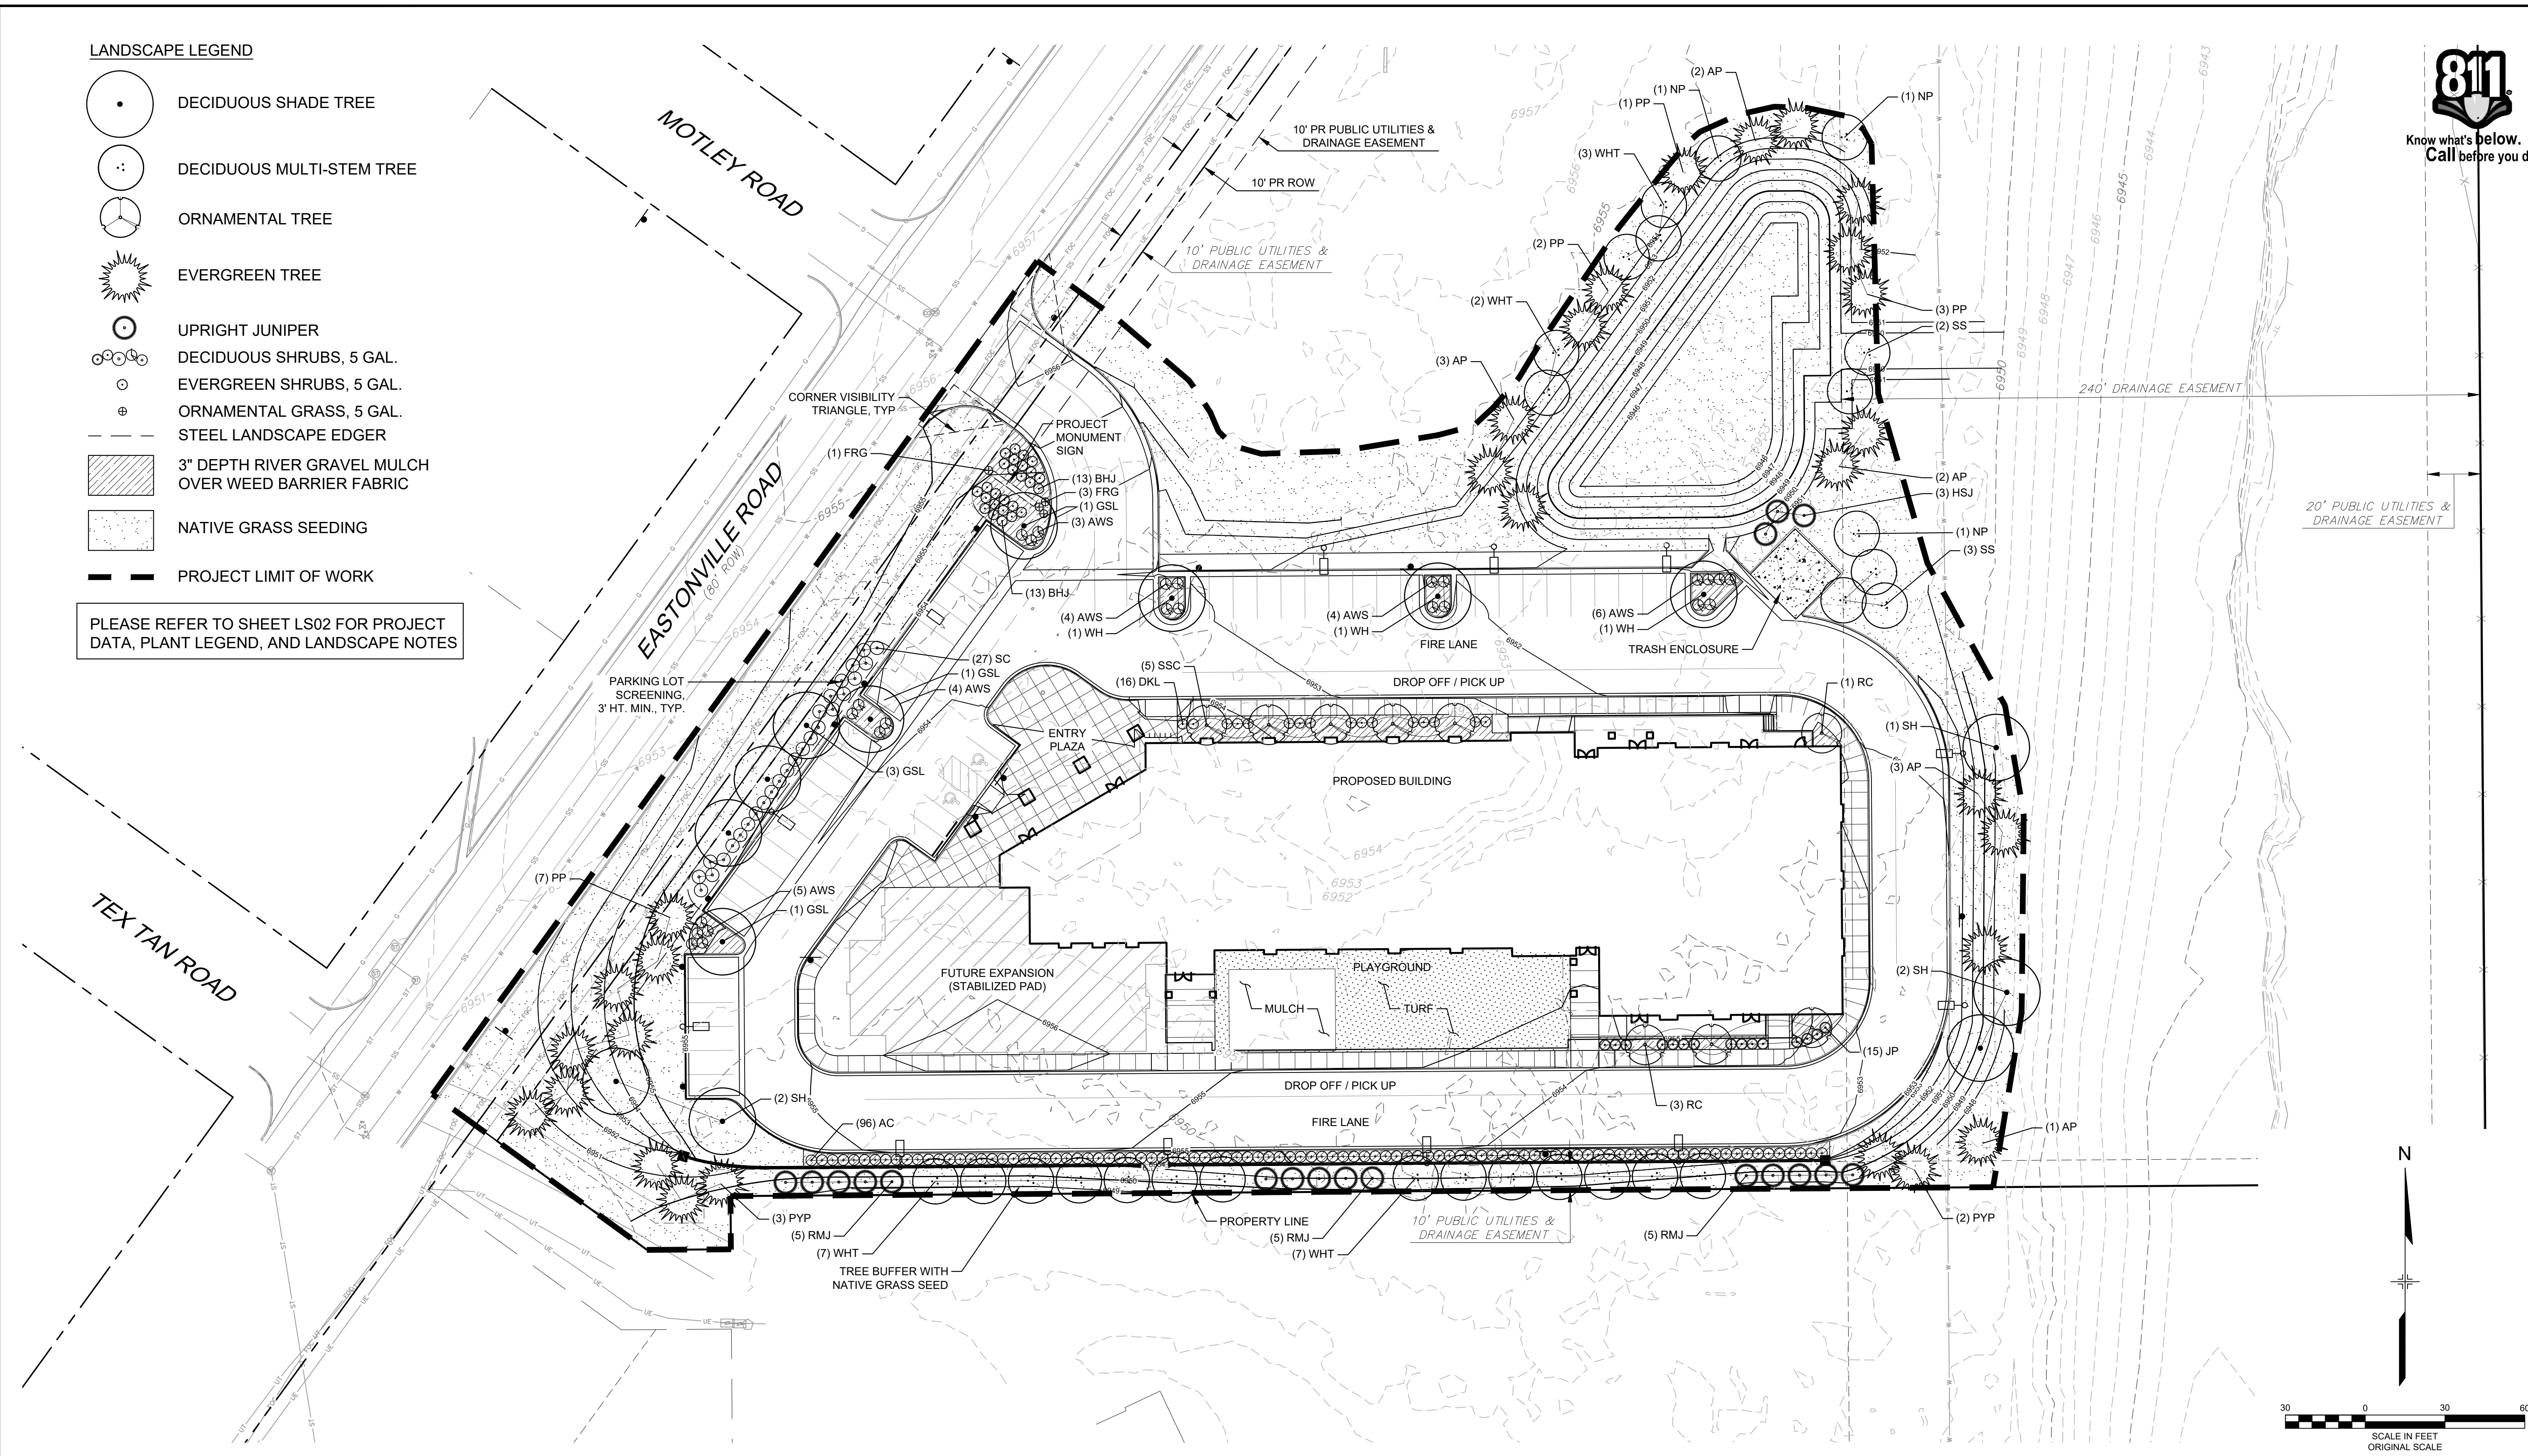

No.	DATE	DESCRIPTION	BY
REVISIONS			
COMPUTER FILE MANAGEMENT			
FILE NAME: R:\18.995.001 (Liberty Tree Academy)\Dwg\Site Development Plan\LS01_SDP.dwg			
CTB FILE: ---			
PLOT DATE: 7/2/2018 1:23 PM			
THIS DRAWING IS CURRENT AS OF PLOT DATE AND MAY BE SUBJECT TO CHANGE.			

SHEET KEY

PREPARED FOR:
LIBERTY TREE ACADEMY

PREPARED BY:
Matrix DESIGN GROUP
AN EMPLOYEE-OWNED COMPANY


FOR AND ON BEHALF OF
MATRIX DESIGN GROUP, INC.
PROJECT No. 18.995.001

LIBERTY TREE ACADEMY

TOWN OF PEYTON, EL PASO COUNTY
SITE DEVELOPMENT PLAN

LANDSCAPE PLAN

DESIGNED BY: ACR	SCALE:	DATE ISSUED: JUNE 2018	DRAWING No.:
DRAWN BY: ACR	HORIZ.	SHEET: 5 OF 11	LS01
CHECKED BY: DRK	VERT.		

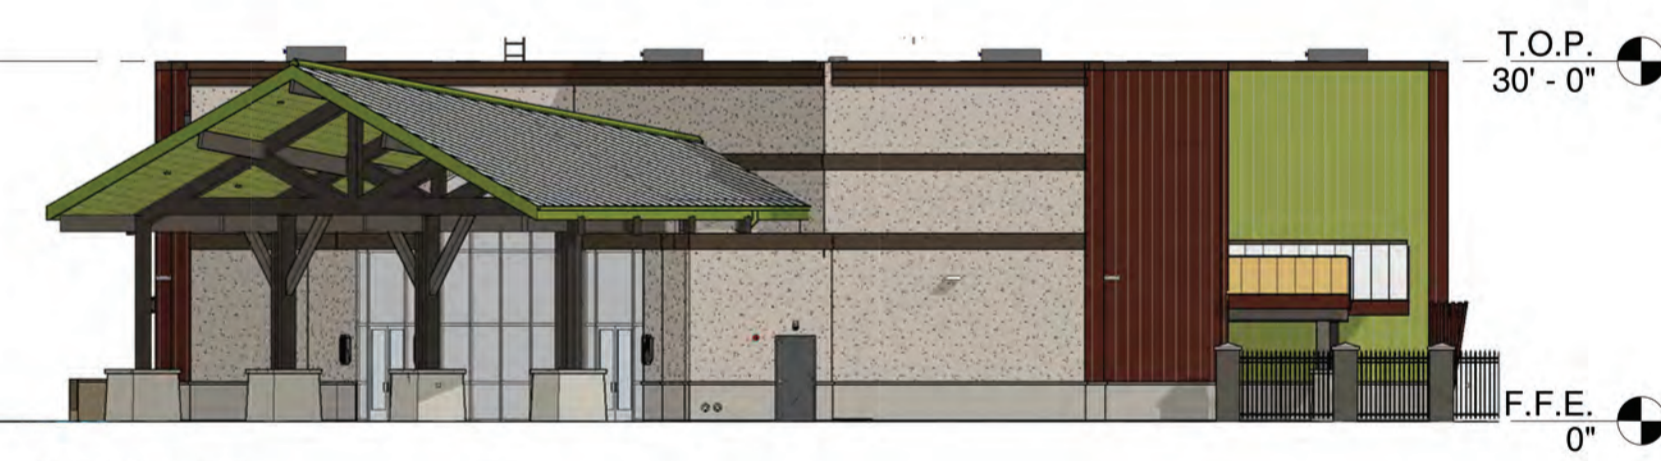

2 WEST. EL.
SK2.0 1/16" = 1'-0"

3 EAST. EL.
SK2.0 1/16" = 1'-0"



1 NORTH EL.
SK2.0 1/16" = 1'-0"



4 SOUTH EL.
SK2.0 1/16" = 1'-0"




LIBERTY TREE
ACADEMY



RKAA
ARCHITECTS, INC

DESIGN APPROVAL DATE APPROVED:

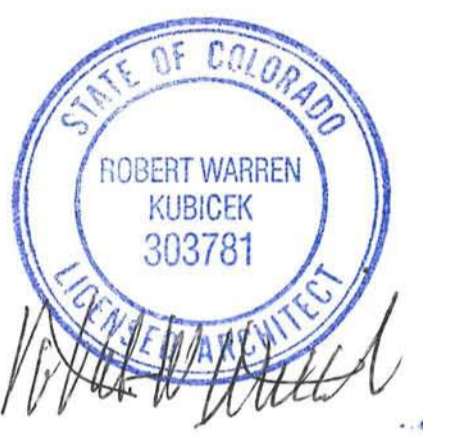

carhuff+cueva
architects, llc

3149 e prince rd #151
tucson, arizona 85716
phone 520.577.4560
www.cca-az.com

NEW SCHOOL CAMPUS FOR:

LIBERTY TREE ACADEMY

8579 EASTONVILLE RD,
PEYTON, CO 80831

CONSTRUCTION DOCUMENTS

REVISION	DATE	DESCRIPTION	BY

PROJECT NO. P18-8579


DATE MAY 8, 2018

SCALE 1/16" = 1'-0" DRAWN BY PD


DRAWING TITLE PRESENTATION ELEVATIONS

DRAWING NUMBER SK2.0


PROJECT BY: PEYTON, CO

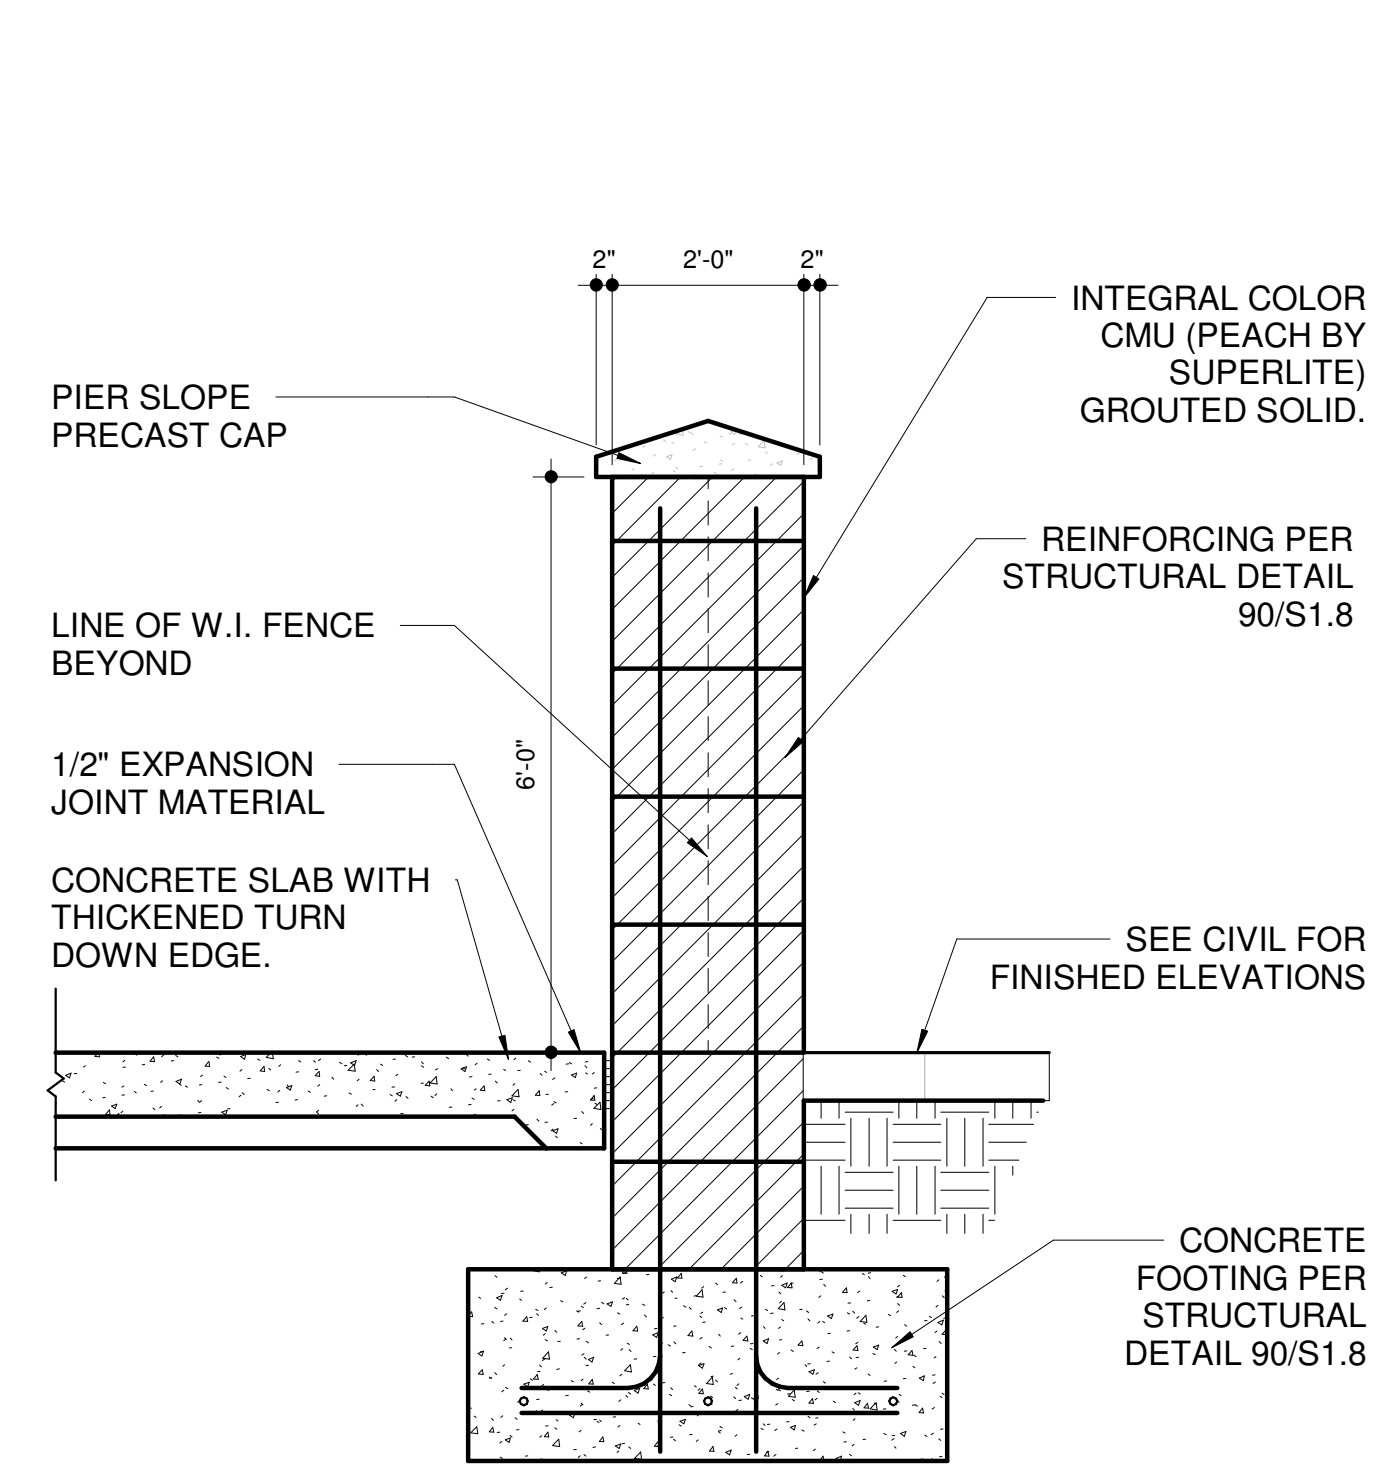

4 TYP. MASONRY COLUMN DETAIL
SP1.0 1/2" = 1'-0"

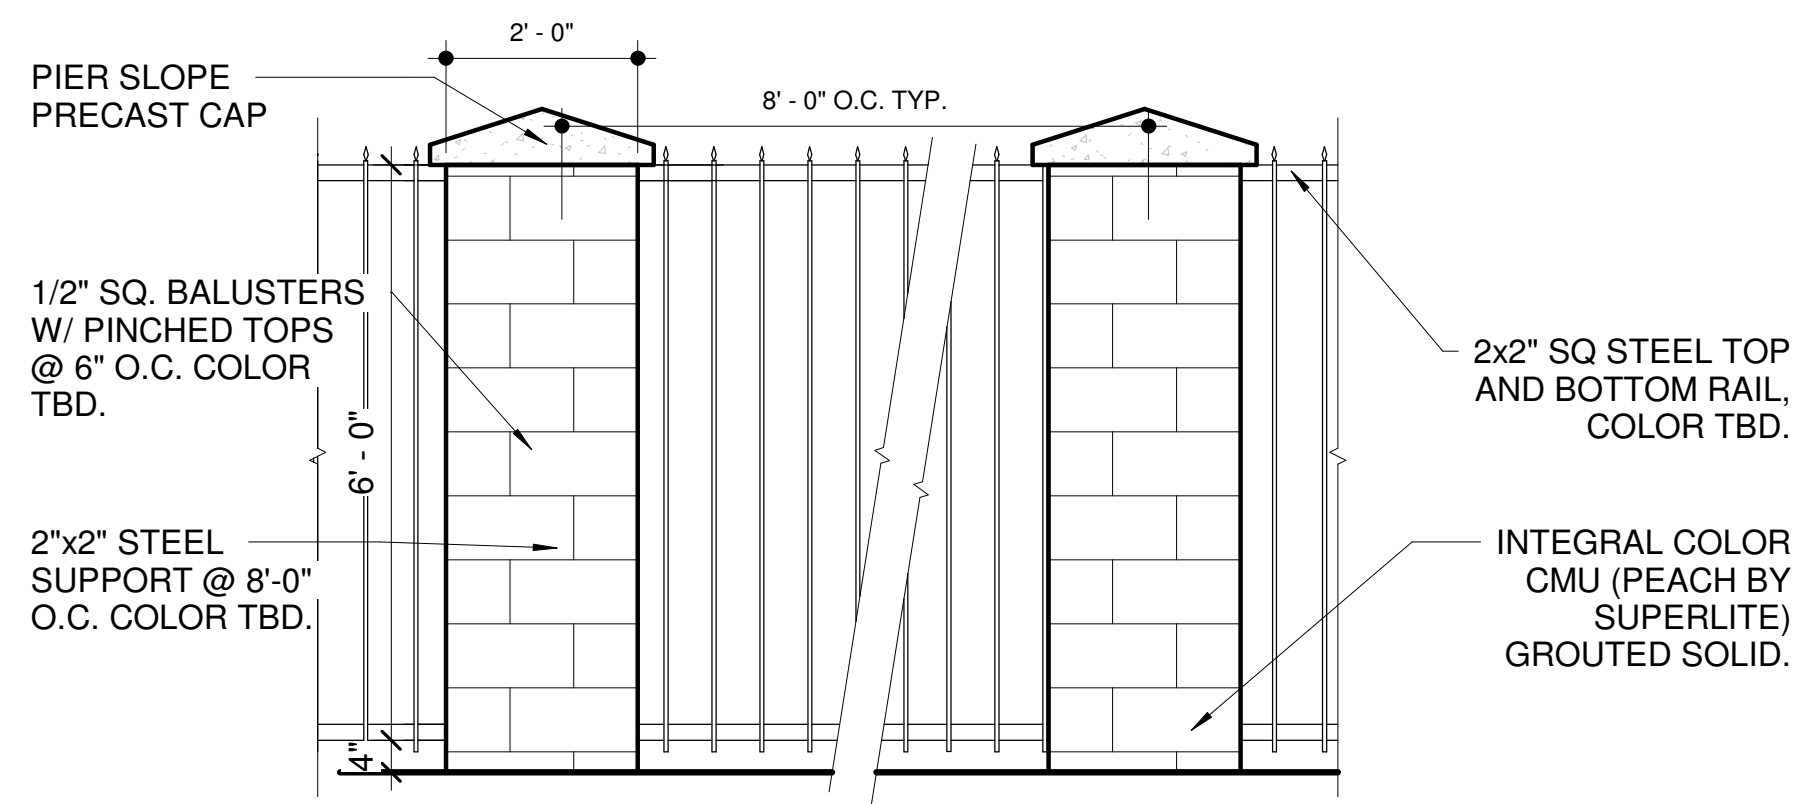

3 PERIMETER SITE WALL TYPICAL ELEVATION
SP1.0 1/4" = 1'-0"

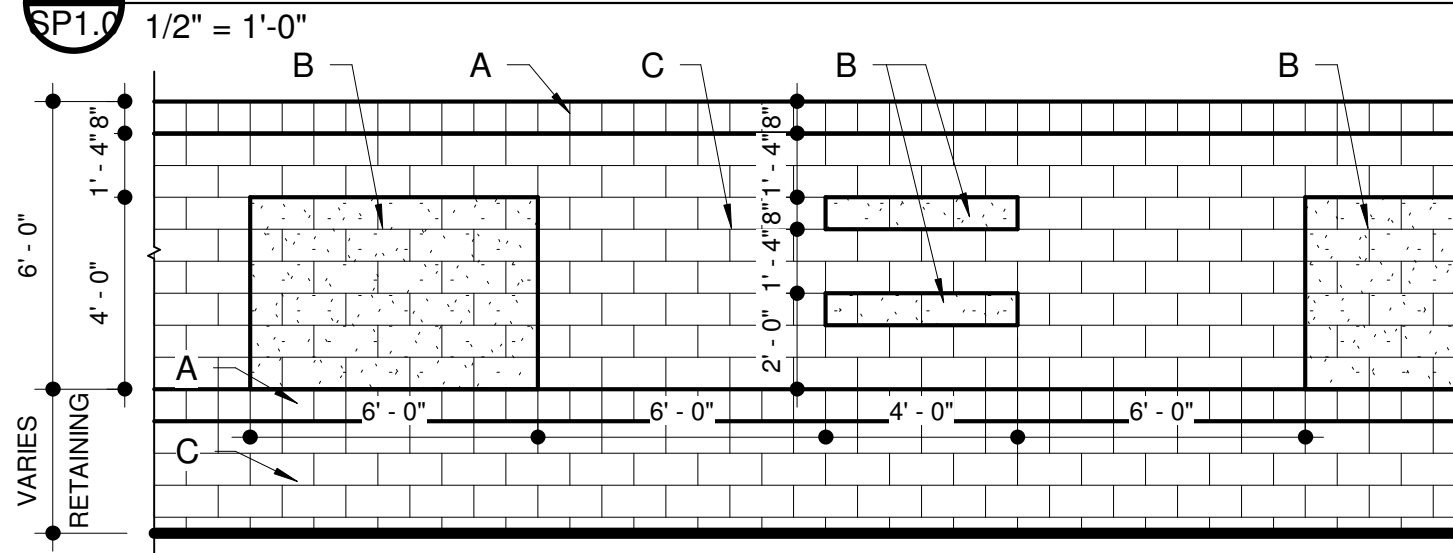


5 WROUGHT IRON FENCE DETAIL
SP1.0 1/2" = 1'-0"


NOTE:
ALL CMU IS 8"X16"X8",
COLORS AND FINISH BY
SUPERLITE.

LEGEND
A. CMU SINGLE SCORE, COLOR: BONE
B. CMU SPLIT FACE, COLOR: COCOA BROWN
C. CMU STANDARD, COLOR: PEACH

REFERENCE DETAIL 89 AND 81/S1.8
FOR STRUCTURAL REQUIREMENTS.

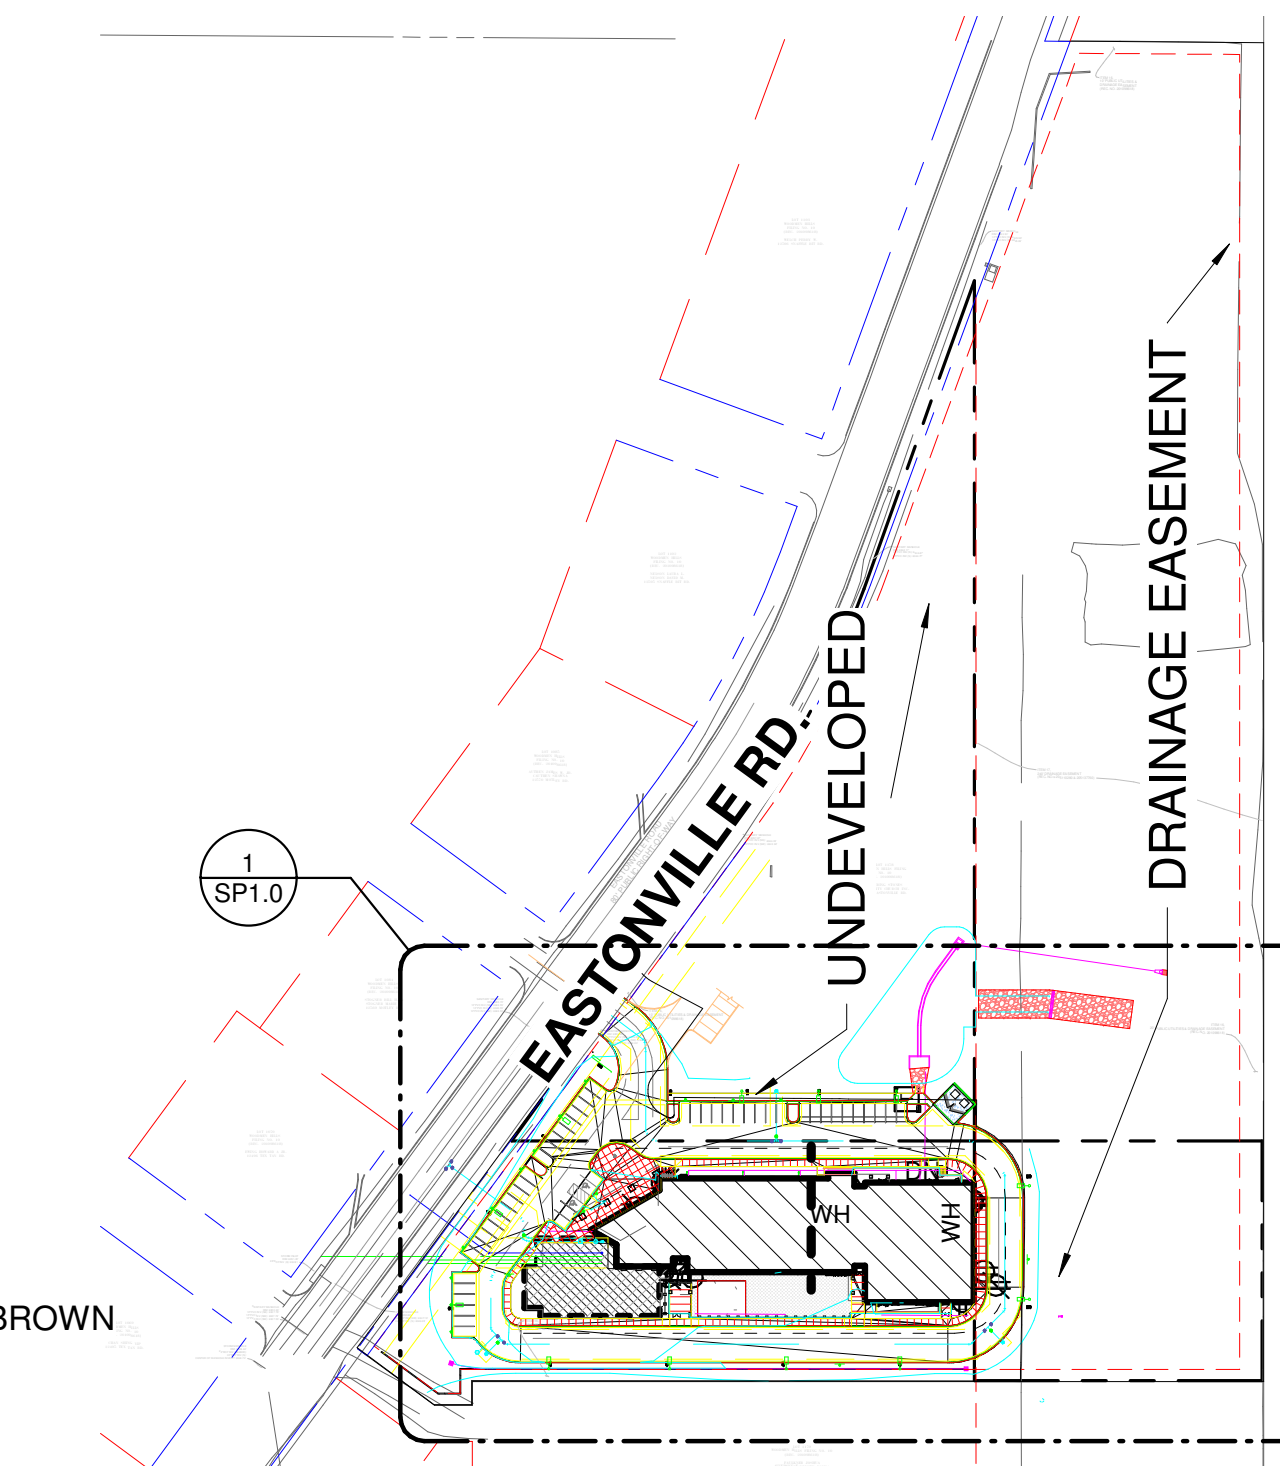

2 REFERENCE SITE PLAN
SP1.0 1" = 160'-0"

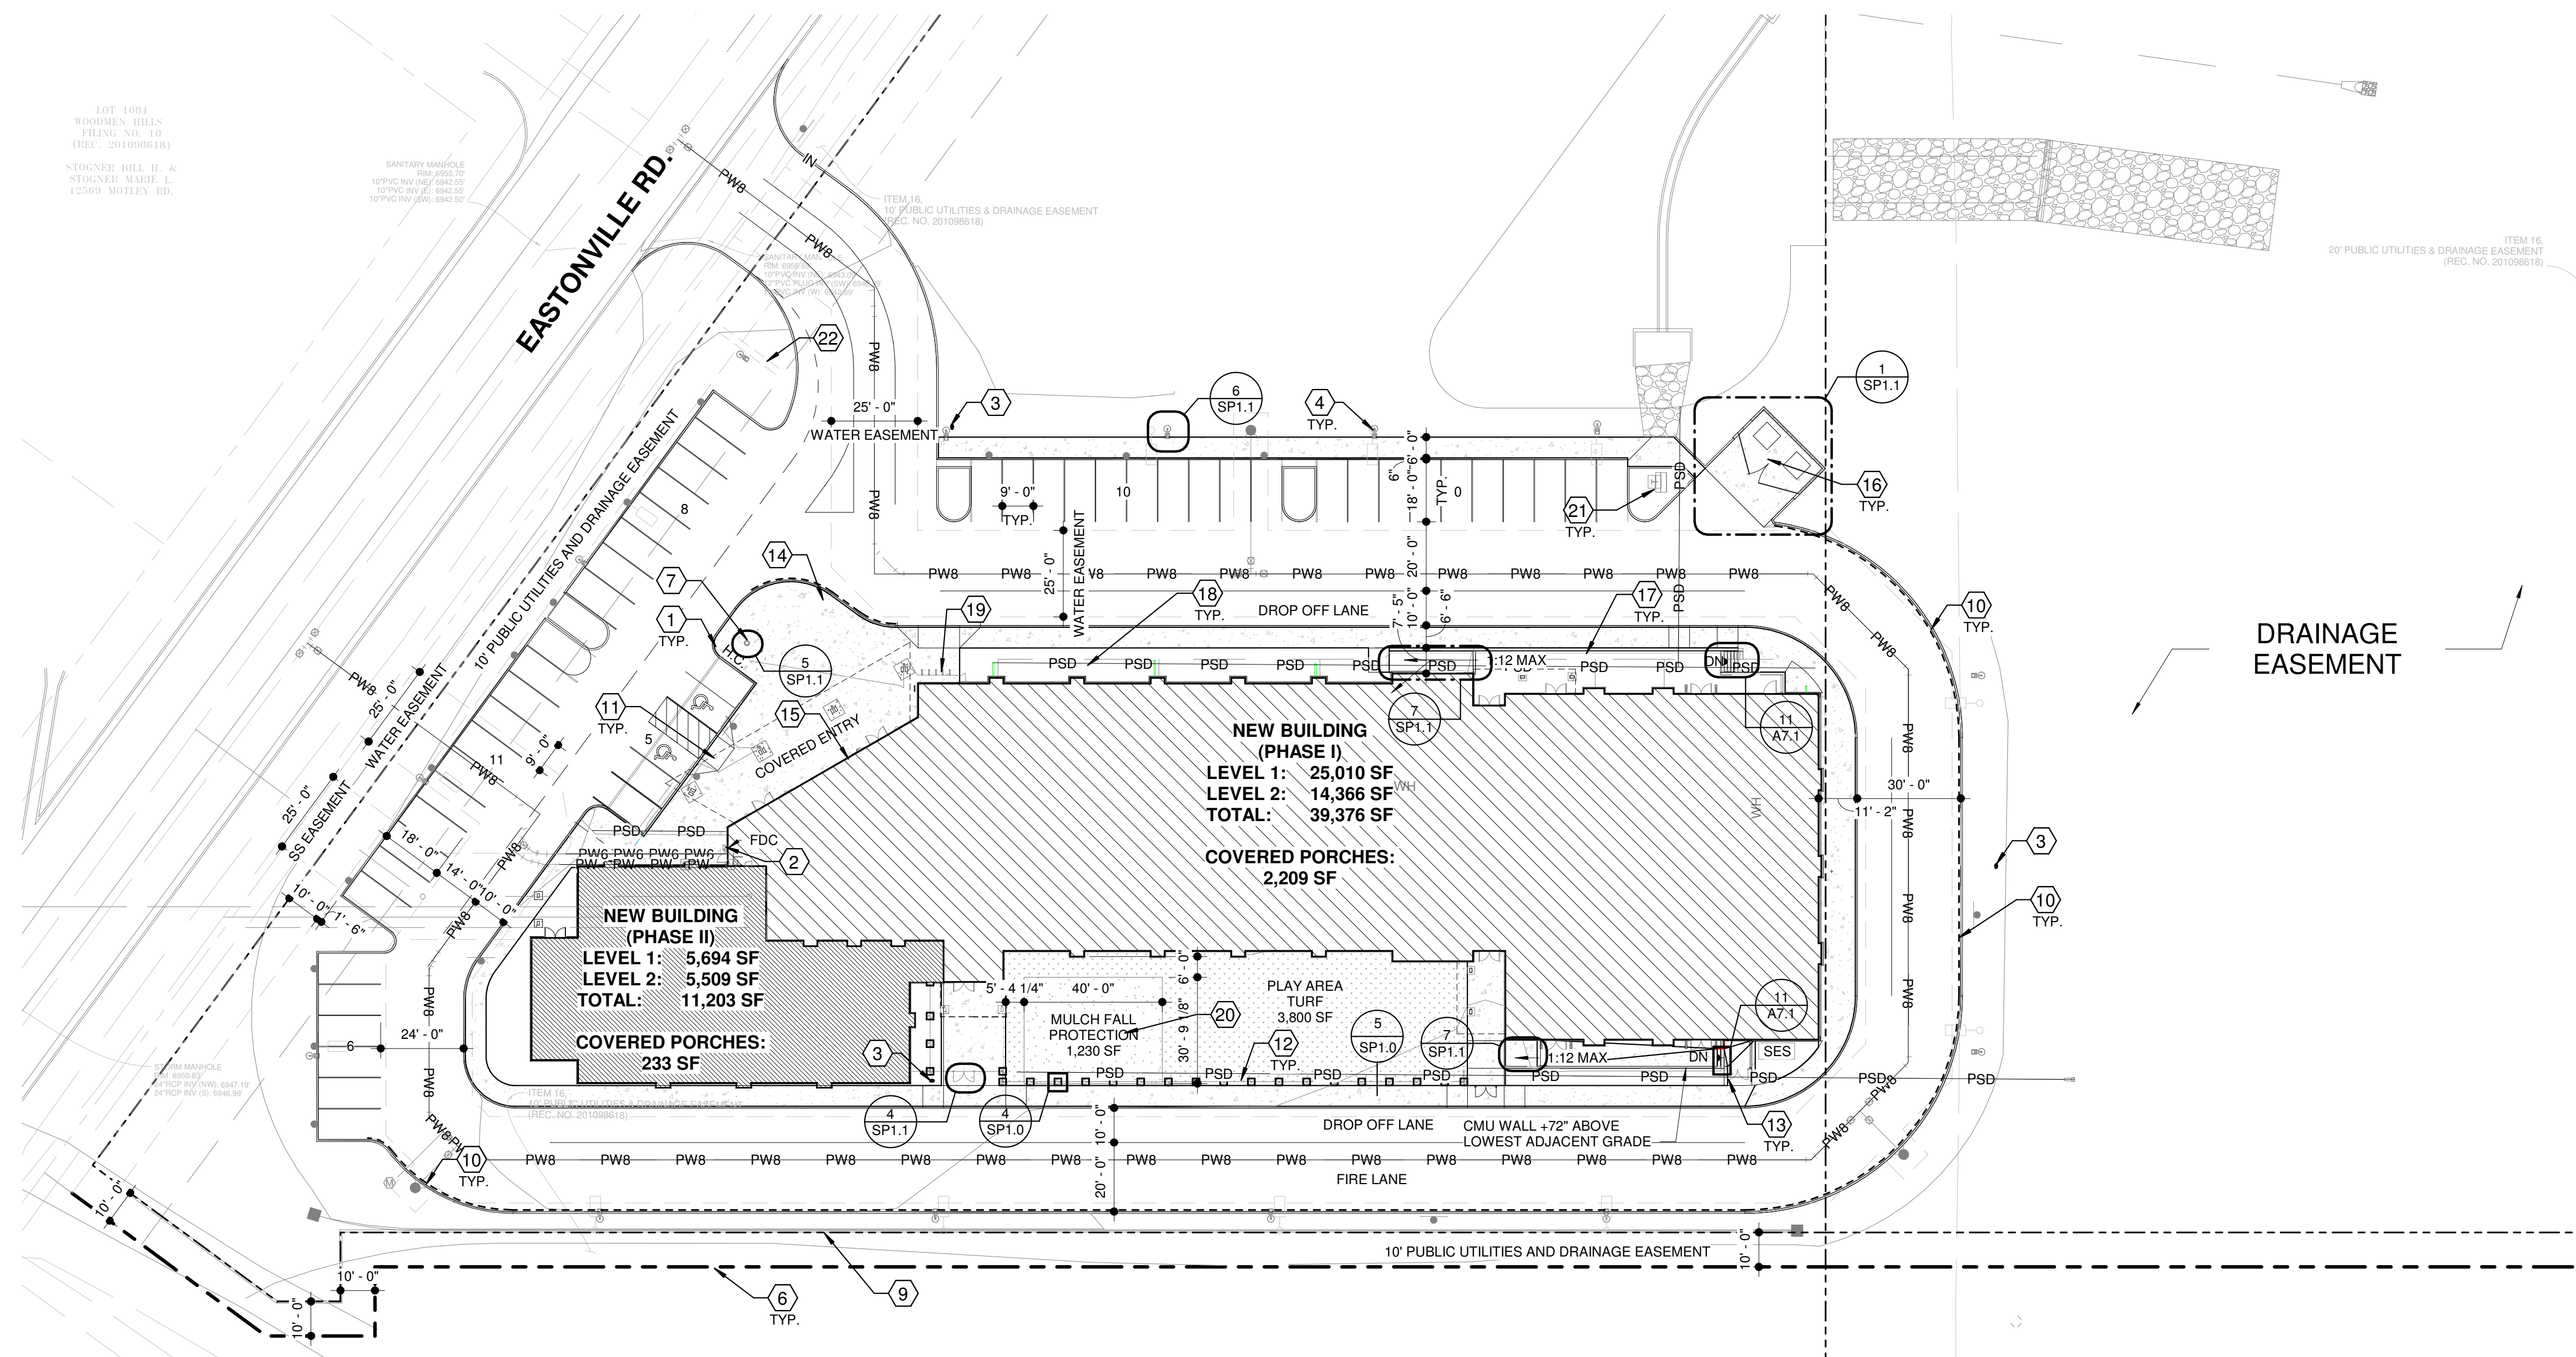

1 PROPOSED SITE PLAN
SP1.0 1" = 30'-0"

PROJECT DATA

PARCEL #: 4232302001
ZONING: RR-5

MAXIMUM LOT COVERAGE 25%
MAXIMUM HEIGHT 30'
SETBACKS 25' FRONT, REAR, SIDE.

BUILDING INFORMATION
GROSS FLOOR AREA: 39,376 S.F.
NUMBER OF STORIES: 2
MAXIMUM HEIGHT: 30'-0"

PARKING DATA

PARKING REQUIRED PER TABLE 6-2
ELEMENTARY OR JR HIGH:
2 SPACES PER CLASSROOM

REQUIRED PARKING SIZE 9X18 2' OVERHANG

NEW PARKING REQUIRED PER TABLE 6-2:
(2 SPACES/CLASS ROOM) 22 C.R. X 2 = 44 STALLS
NEW PARKING PROVIDED: 50 STALLS
REQUIRED ADA PARKING SPACES: 2 STALLS
ADA PARKING SPACES PROVIDED: 2 STALLS

ON SITE QUEUE LENGTH: 1,240 L.F.

BIKE PARKING

REQUIRED BIKE PARKING 5% OF VEHICLE
PARKING SPACES (49 X .05): 3 SPACES
PROVIDED BIKE PARKING: 5 SPACES

- SITE PLAN KEYNOTES:**
1. ACCESSIBLE PARKING SPACE PER CIVIL DRAWINGS.
 2. FIRE RISER ENTRANCE. PROVIDE FIRE RISER ROOM SIGNAGE.
 3. FIRE HYDRANT PER CIVIL DRAWINGS.
 4. SITE LIGHTING FIXTURES, SEE ELECTRICAL DRAWINGS.
 5. WATER METER PER CIVIL PLANS.
 6. PROPERTY LINE.
 7. 25' HIGH FLAG POLE.
 8. BACKFLOW PREVENTER PER CIVIL PLANS.
 9. INTEGRAL COLOR CMU SCREEN WALL OVER RETAINING WALL. SEE TYPICAL SITE WALL DETAIL.
 10. CONCRETE CURB PER DETAILS. PAINTED RED CURB WITH "NO PARKING FIRE LANE" IN 4" WHITE LETTERS ON FACE OF THE CURB SPACED 80" ON CENTER FOR FIRE LANE DESIGNATION AS INDICATED WITH DASHED LINE.
 11. CONCRETE RAMP PER CIVIL DRAWINGS
 12. CMU PILLAR AND WROUGHT IRON FENCE PER DETAIL.
 13. W.I. GATE WITH KEY F.O.B. AND PANIC HARDWARE PER DETAIL.
 14. SCORED CONCRETE WITH CONTROL JOINTS 6'-0" O.C., PATTERN PER PLAN.
 15. PROVIDE FLUSH-MOUNTED KNOX BOX, MODEL NO. 3200 SERIES @ +6'-0" A.F.F. ORDER AND INSTALL PER LOCAL FIRE DEPARTMENT REQUIREMENTS
 16. TRASH ENCLOSURE GATE PER DETAIL. PROVIDE 6.33" STEEL BOLLARDS 60" ABOVE GRADE, SPACED PER DETAIL. FULL GROUT AND CROWN TOP PRIMED AND PAINTED LIGHT TAN.
 17. DECOMPOSED GRANITE PER LANDSCAPE PLANS.
 18. UNDERGROUND STORM DRAIN PER CIVIL DRAWINGS.
 19. CYCLOOPS 2170-5 BICYCLE PARKING
 20. PLAY STRUCTURE BY OWNER GC TO COORDINATE INSTALLATION.
 21. ELECTRICAL TRANSFORMER.
 22. MONUMENT SIGN LOCATION, (UNDER SEPARATE PERMIT AND SUBMITTAL)

LIBERTY TREE ACADEMY

DESIGN APPROVAL

STATE OF COLORADO
ROBERT WARREN KUBICEK
303781
LICENSED PROFESSIONAL ARCHITECT

carhuff+cueva architects, llc

3149 e prince rd #151
tucson, arizona 85716
phone 520.577.4560
www.cca-az.com

NEW SCHOOL CAMPUS FOR:
LIBERTY TREE ACADEMY

8579 EASTONVILLE RD,
PEYTON, CO 80831


CONSTRUCTION DOCUMENTS

REVISION	DATE	DESCRIPTION	BY


PROJECT NO. P18-8579
DATE MAY 8, 2018
SCALE As indicated DRAWN BY PD
DRAWING TITLE ARCHITECTURAL SITE PLAN
DRAWING NUMBER SP1.0

RAMP NOTES:


1. ALL HANDRAILS MUST MEET HANDRAIL AND CURB REQUIREMENTS.
2. MAXIMUM HORIZONTAL DISTANCE OF EACH RAMP AND RUN VARY.
3. SLOPE OF RAMP SHALL NOT EXCEED 1:12.

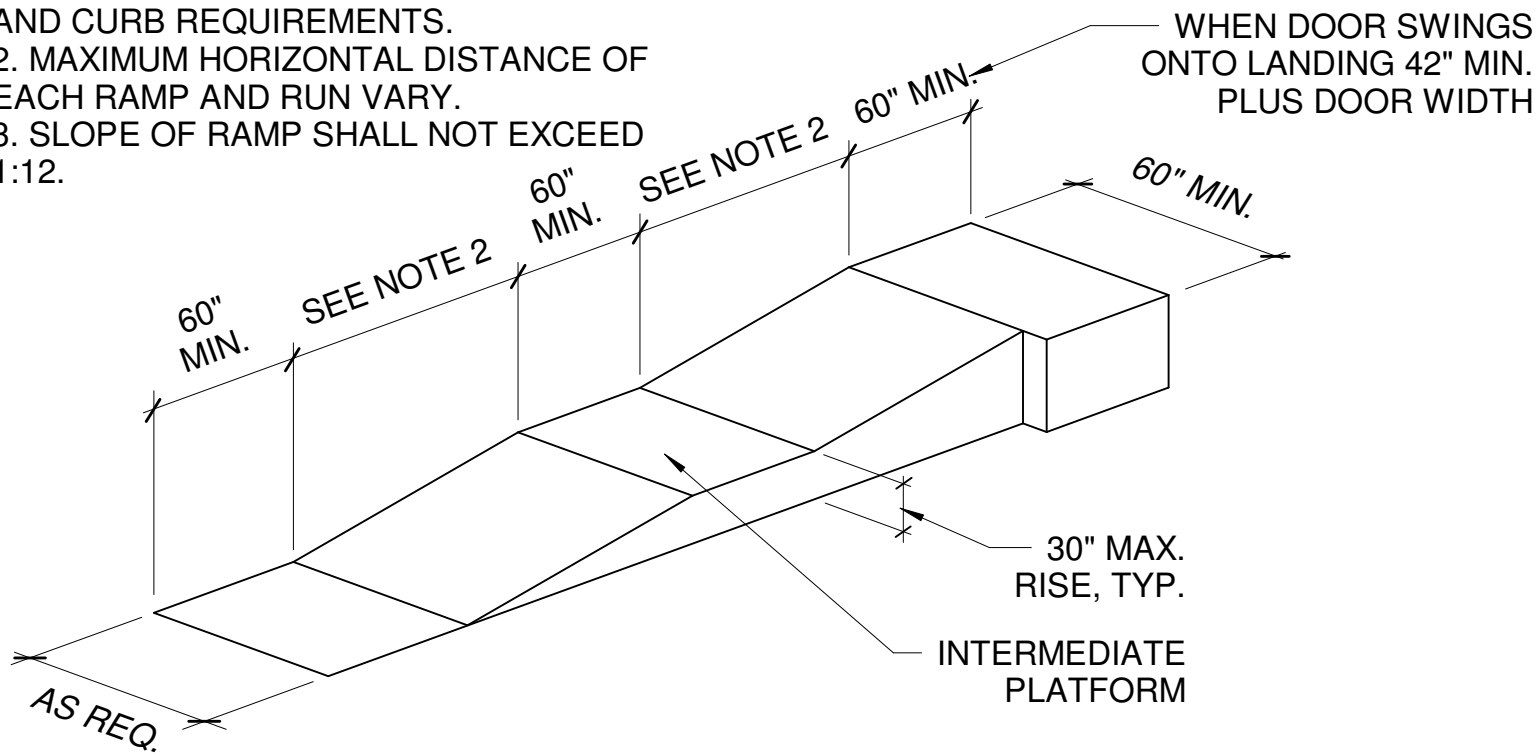


(A) RAMP WITH STRAIGHT RUN

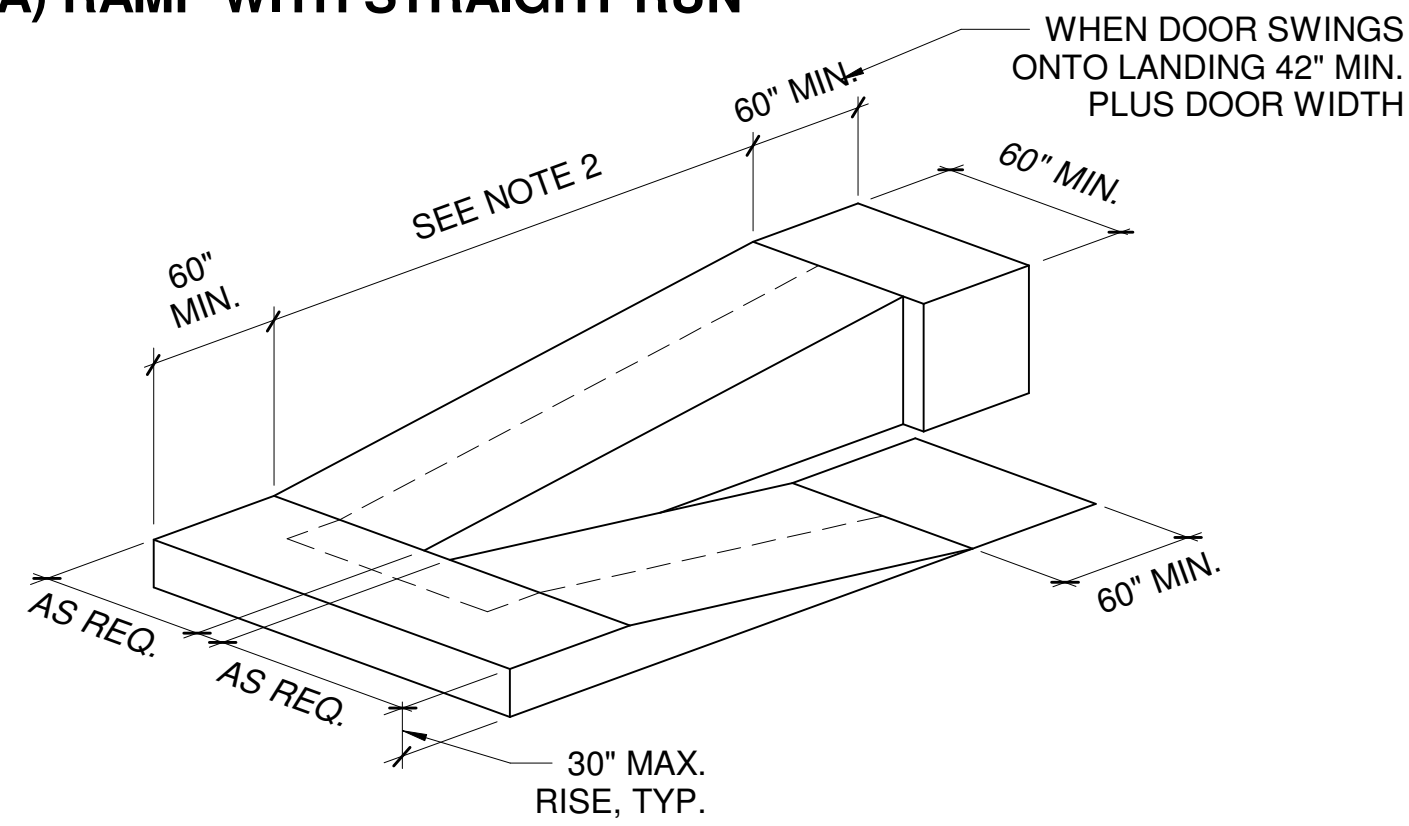


(B) RAMP WITH INTERMEDIATE SWITCHBACK PLATFORM

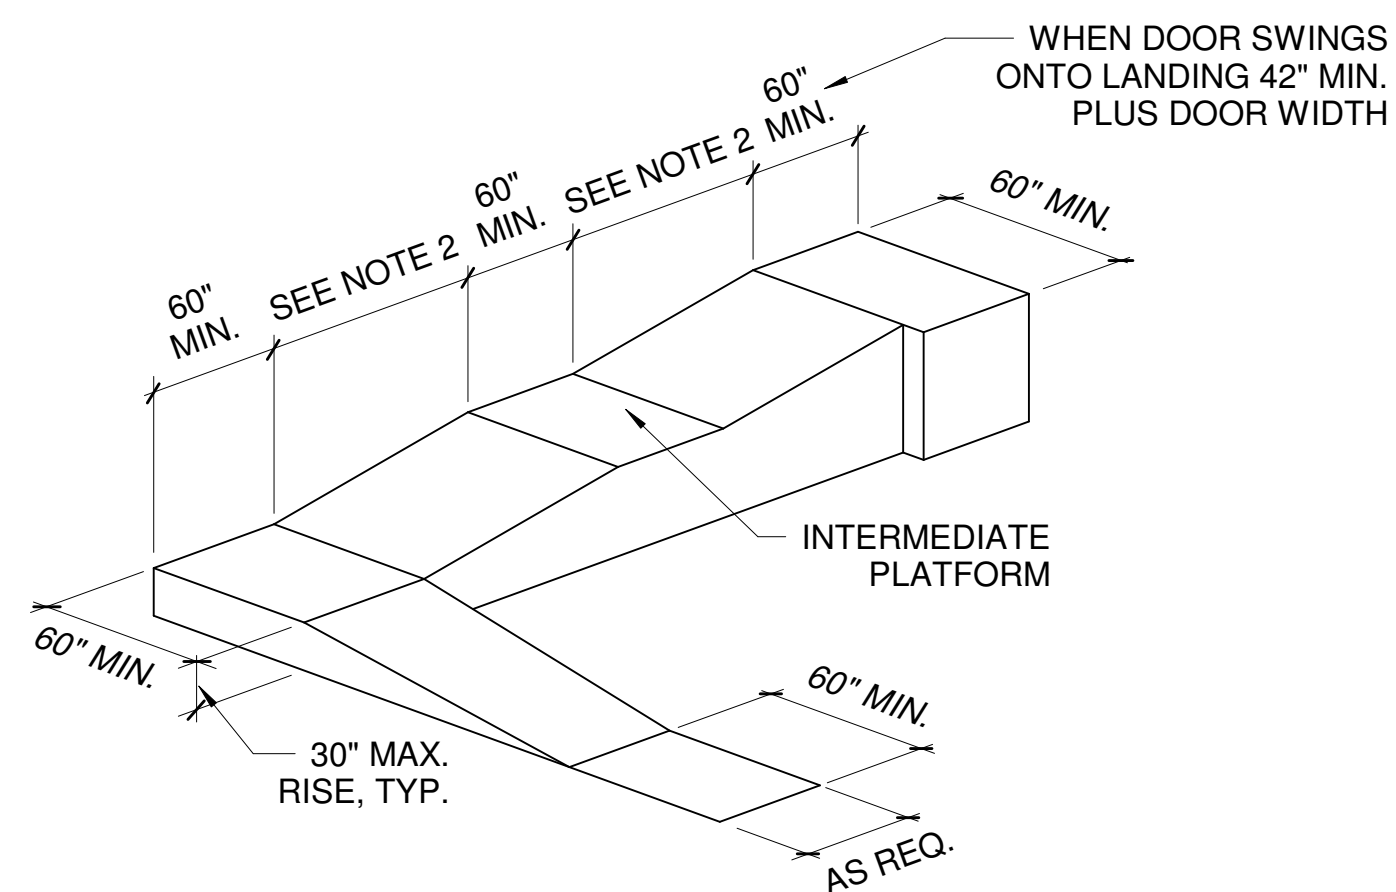

(C) RAMP WITH TURNING PLATFORM

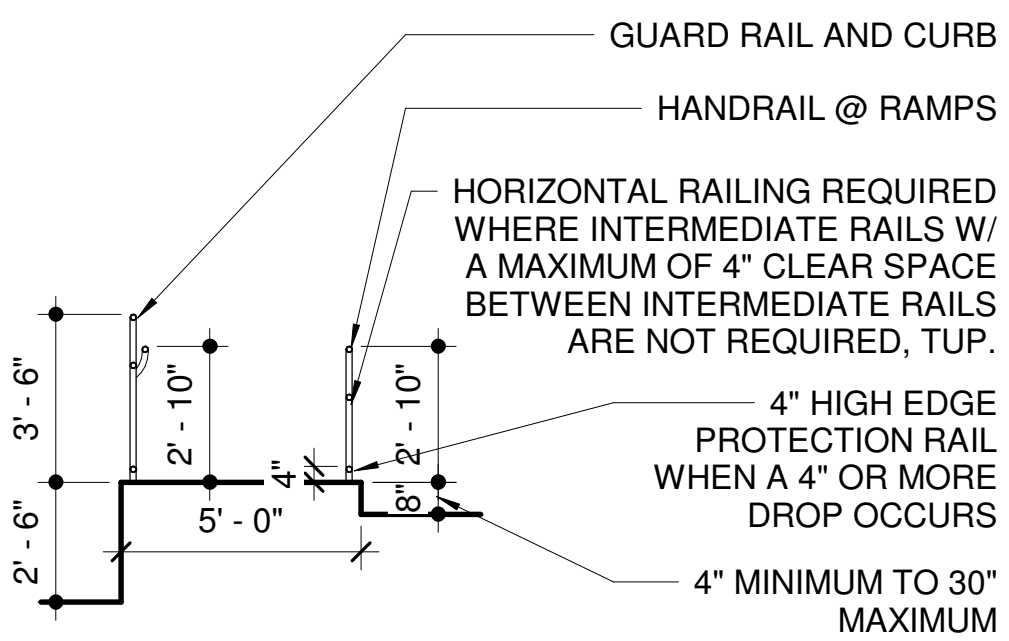


(E) RAMP SECTION

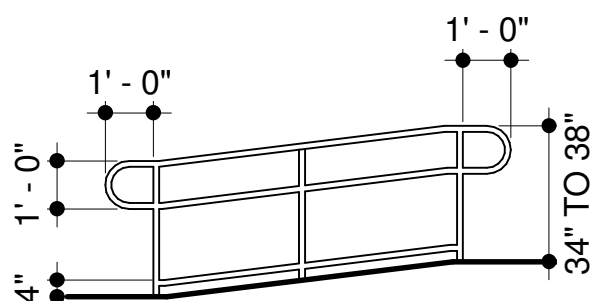

(D) RAMP ELEVATION

7 TYP. PEDESTRIAN RAMP
1/4" = 1'-0"

CONTINENTAL (SINGLE HALYARD)

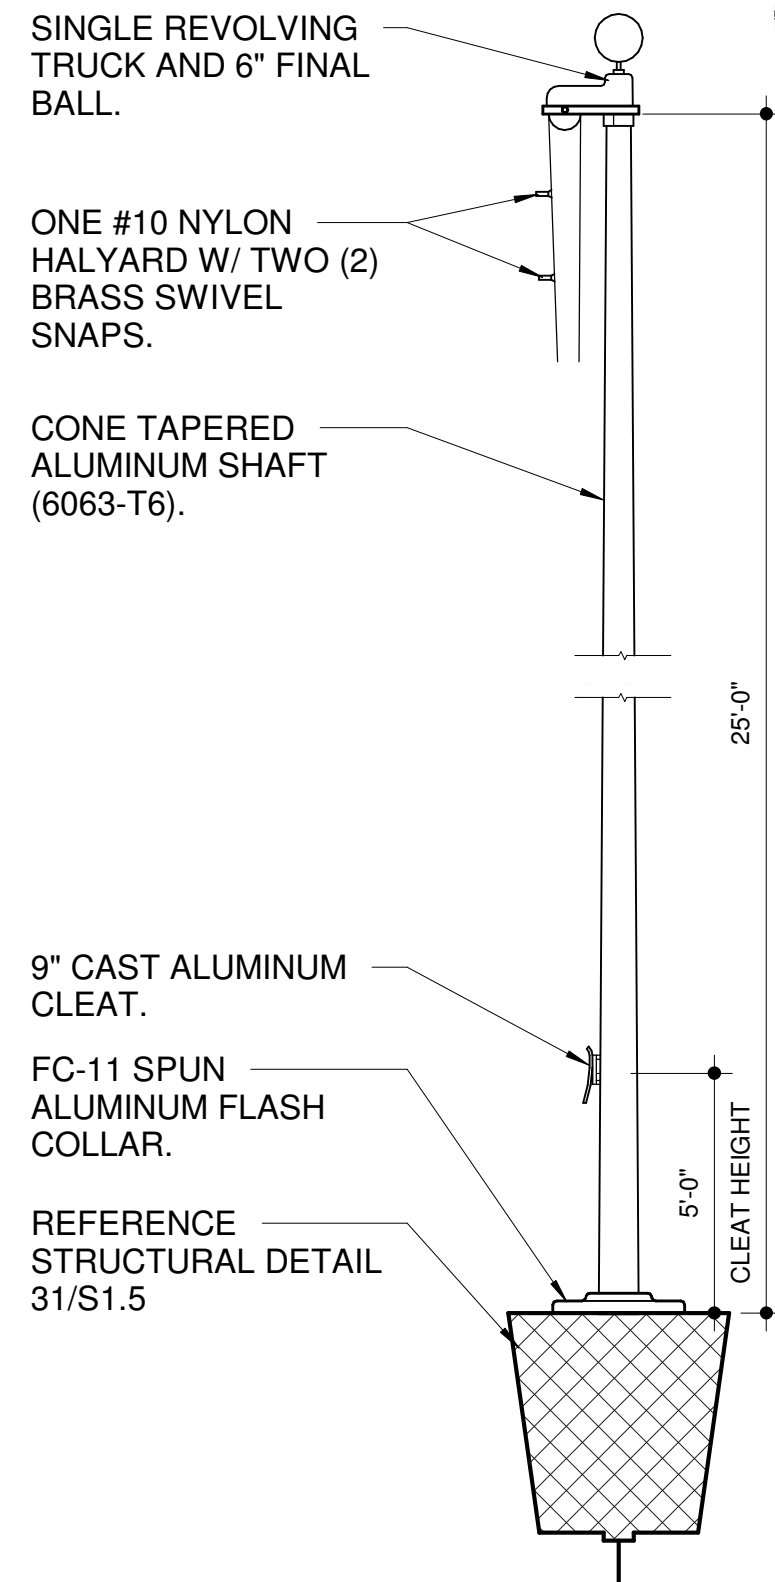

5 FLAG POLE DETAIL
1/4" = 1'-0"

GATE HARDWARE SET
EACH TO HAVE:

- 1 EA GATE CLOSER
- 1 EA IC CYLINDER
- 1 EA PANIC HARDWARE


PFGCS 1-(714)-994-0276
AS REQUIRED 99-L X 374L X POOL

626 FAL
626 VON

- 1 EA FLOOR MOUNTED DOOR STOP



FS18L IVES

Operational Description
Free Egress at all times. Pressing Push Bar retracts latchbolts. Latchbolt retracted by lever unless locked by key. Key locks and unlocks lever. Dogging by hex key, locks down the pushbar or crossbar so the latchbolt remains retracted.

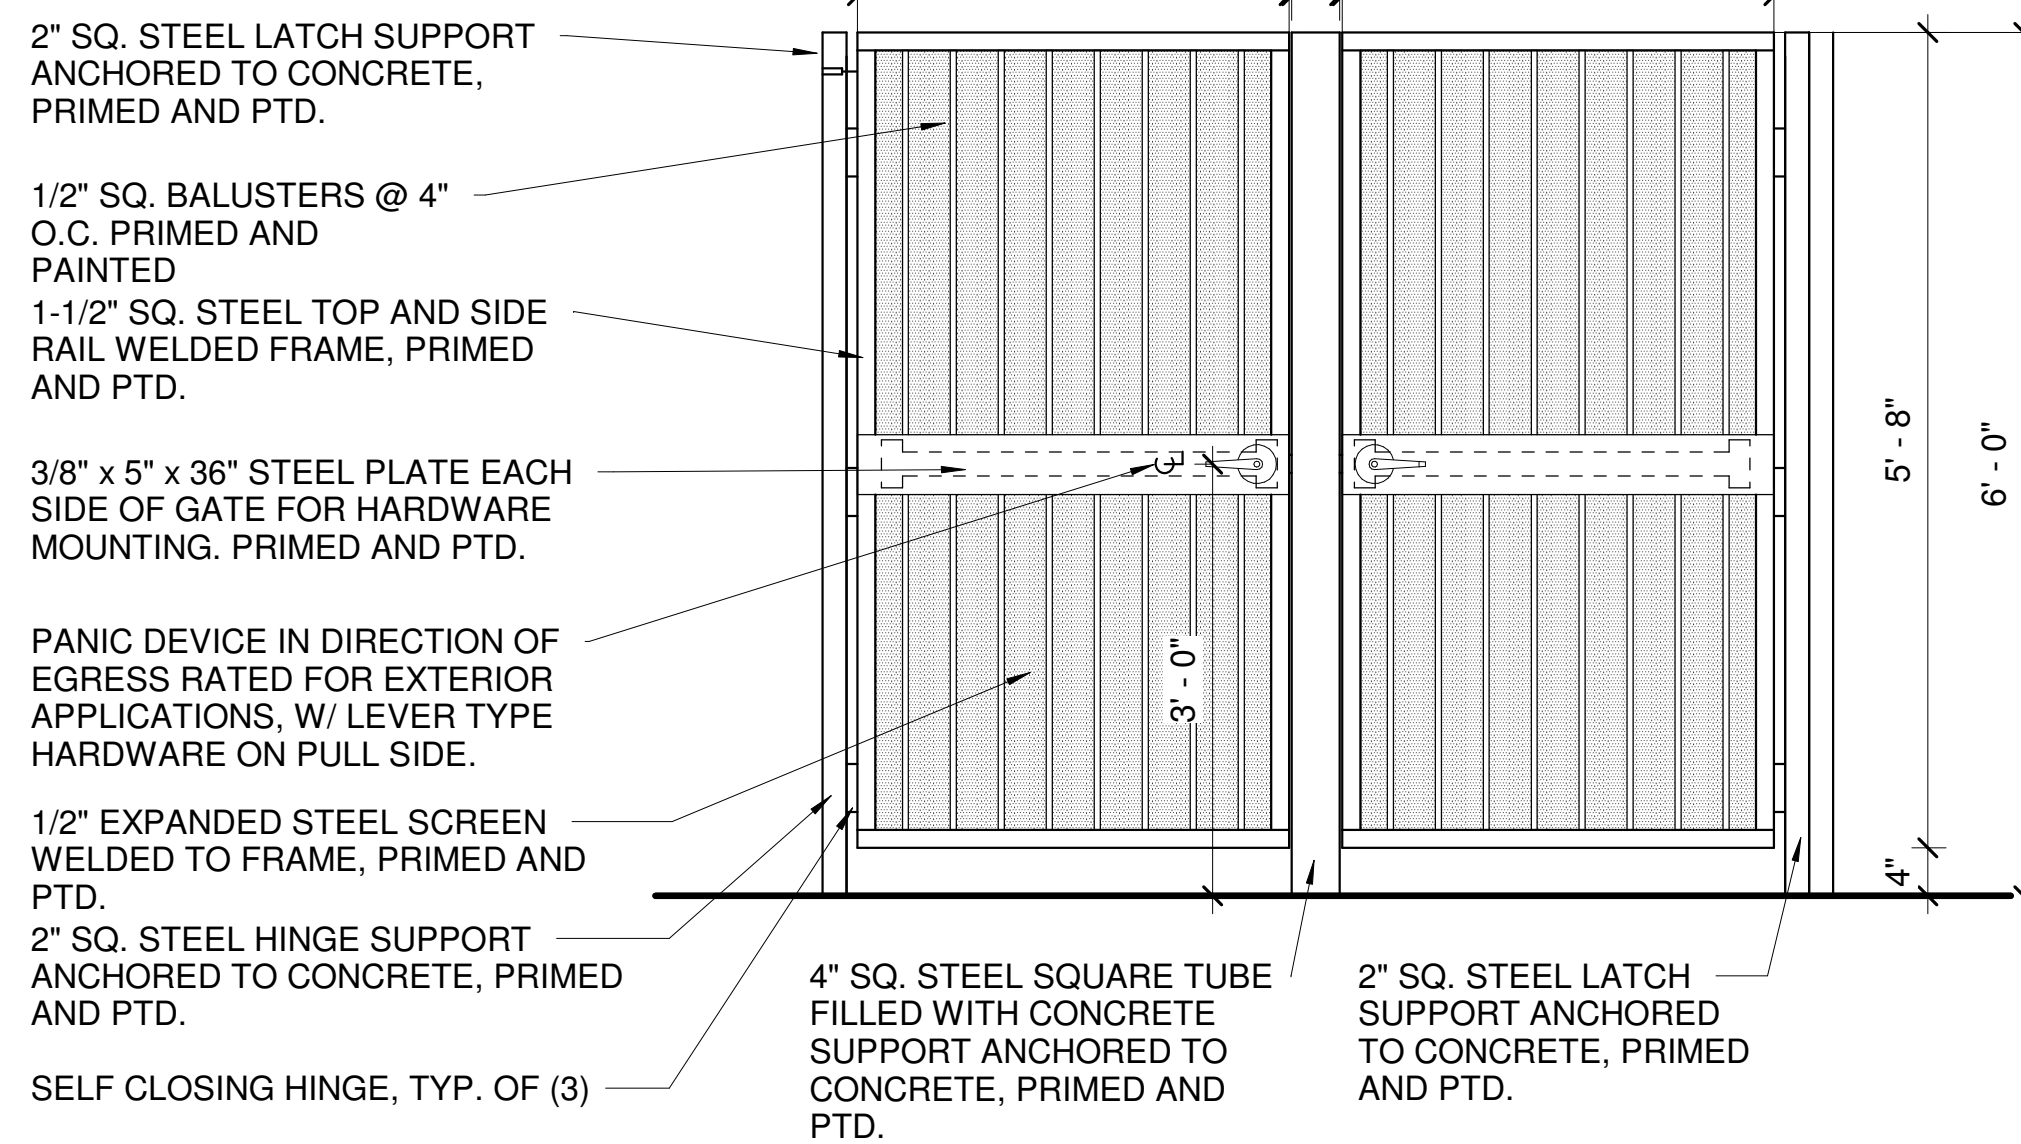


4 DOUBLE GATE DETAIL
3/4" = 1'-0"

Concord Industries, Inc.
4150-A Kellway Circle, Addison, TX 75001

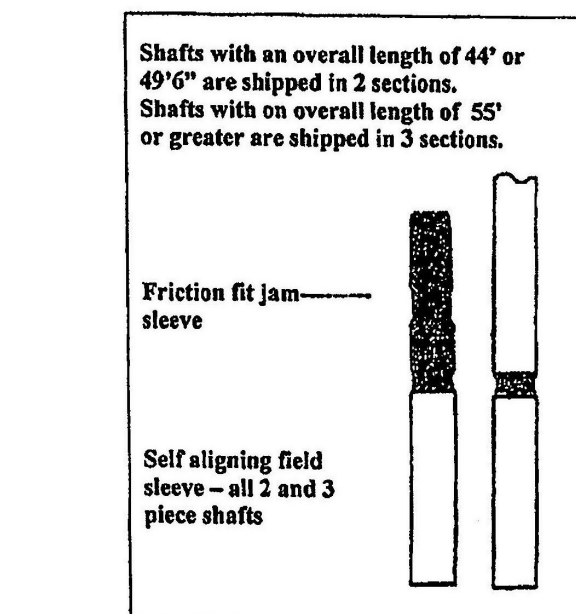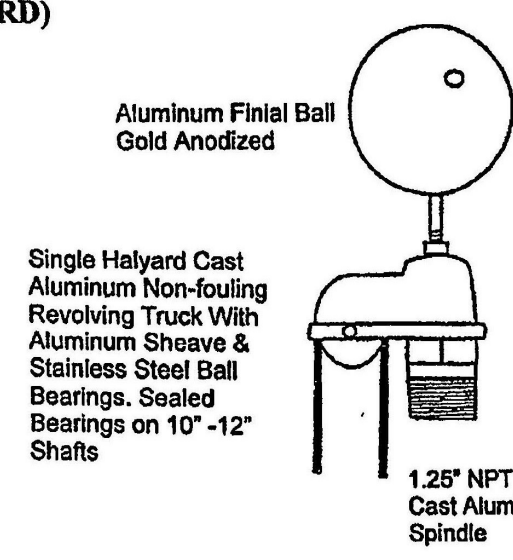

Ground Set Tapered Alum. Flagpole 6063-T6
Exp. Ht. 25' Overall Ht. 28' Ship in 1 Sections
Butt Dia. 5.5" Top Dia. 3.3" Wall Thickness .188
Finish: 150 Grit High Polish

NOTE:
THE POLE MANUFACTURER SHALL PROVIDE A POLE BASE DESIGN FOR 100MPH WIND LOADING w/ A 1.3 GUST FACTOR.

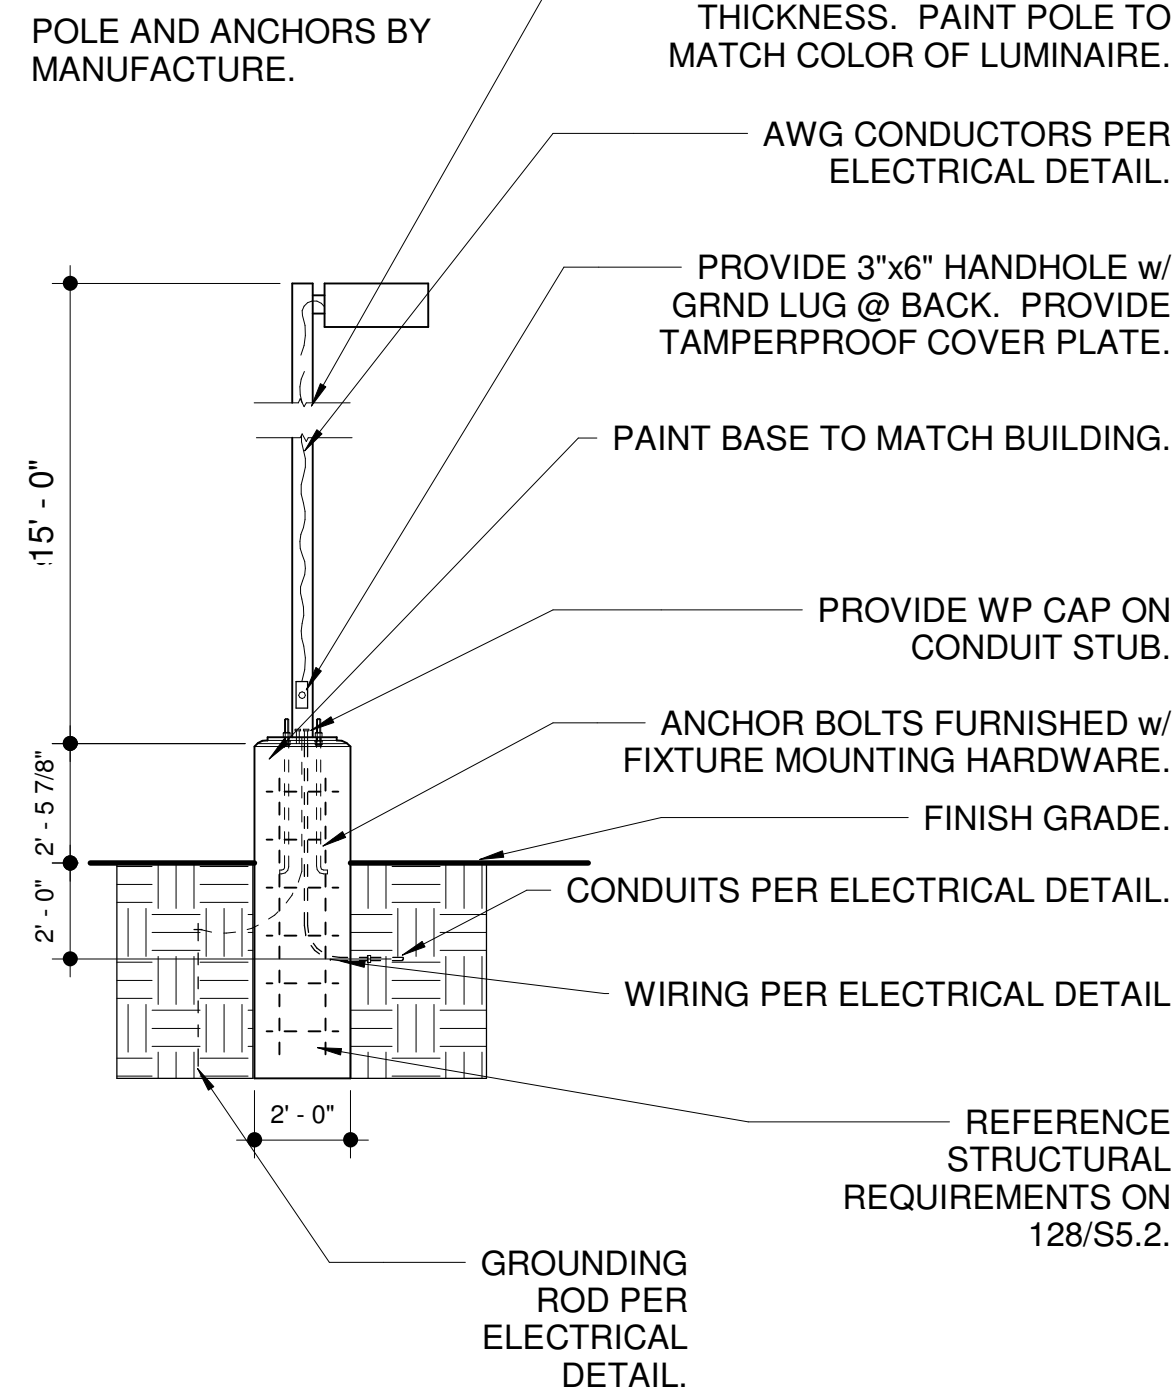

6 LIGHT POLE DETAIL
1/4" = 1'-0"

DUMPSTER ENCLOSURE GENERAL NOTES:

1. SOIL BELOW THE WALL FOOTER AND CONCRETE PAD SHALL BE COMPACTED TO A DEPTH OF 6 INCHES AND TO A MINIMUM DRY DENSITY OF 90% IN ACCORDANCE WITH ASTM D-2922 AND D-3017, AFTER ADJUSTMENT FOR ROCK CORRECTION.

2. STEEL REINFORCEMENT SHALL BE GRADE 40.

PEDESTRIAN GATE WITH B-DECKING OVER 2x2 STEEL FRAME, PRIMED AND PTD TO MATCH BUILDING. PROVIDE LOCKING HASP AND LATCH

PIN HOLE STOP

1/2" BITUMINOUS TYPE EXPANSION JOINT FILLER ASTM D-1751

6" THICK CONCRETE APPROACH SLAB w/ THICKENED EDGES, CLASS 'A' CONC. w/ 6"x6", 1.4x1.4 W/WF ON COMPACTED SUBGRADE.

(2) 6" DOORS - REQUIRED WITH 2" CLEARANCE UNDER. PROVIDE 1/2" DROP PINS AND PIN HOLES IN CONCRETE SLAB.


PIN HOLE STOP

8"x8"x16" CMU ENCLOSURE 6'-0" HIGH. STUCCO TO MATCH BUILDING COLOR.


B-DECKING OVER HSS 2x2x1/4" STEEL FRAME, PRIMED AND PTD TO MATCH BUILDING.

HSS6.25X.250 CONC. FILLED BOLLARD


1 DUMPSTER ENCLOSURE
3/16" = 1'-0"

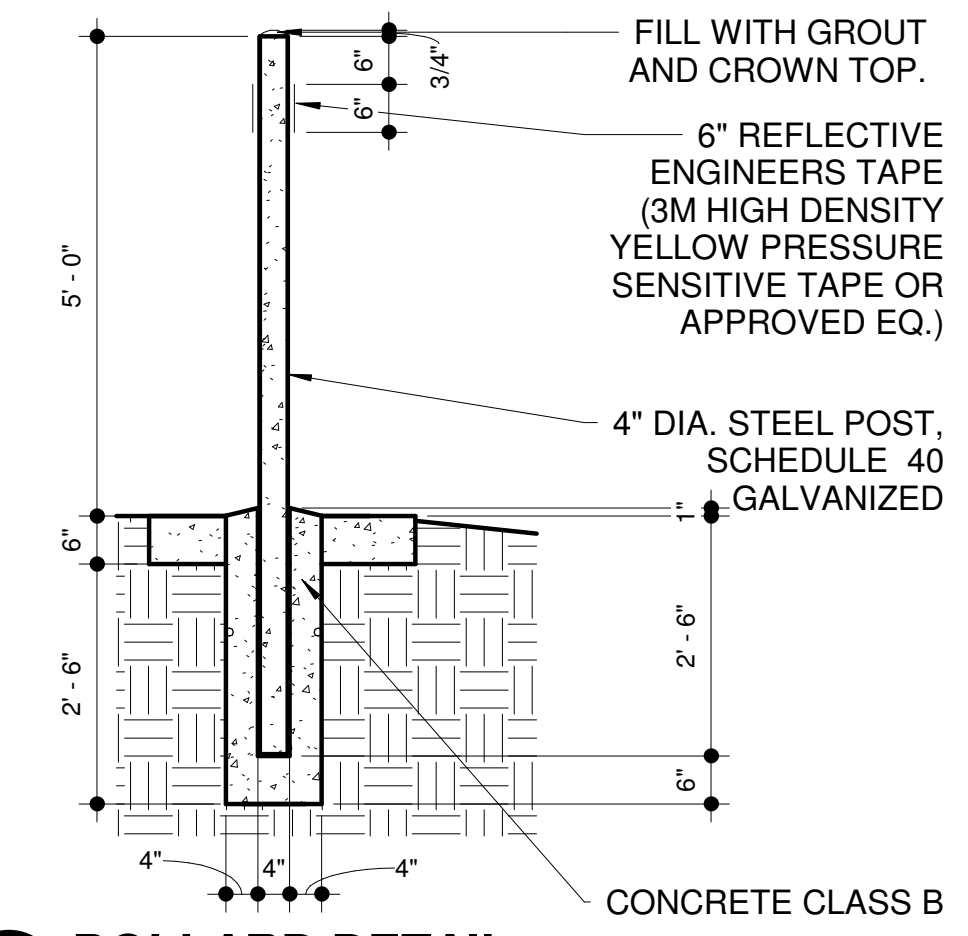

3 BOLLARD DETAIL
1/2" = 1'-0"

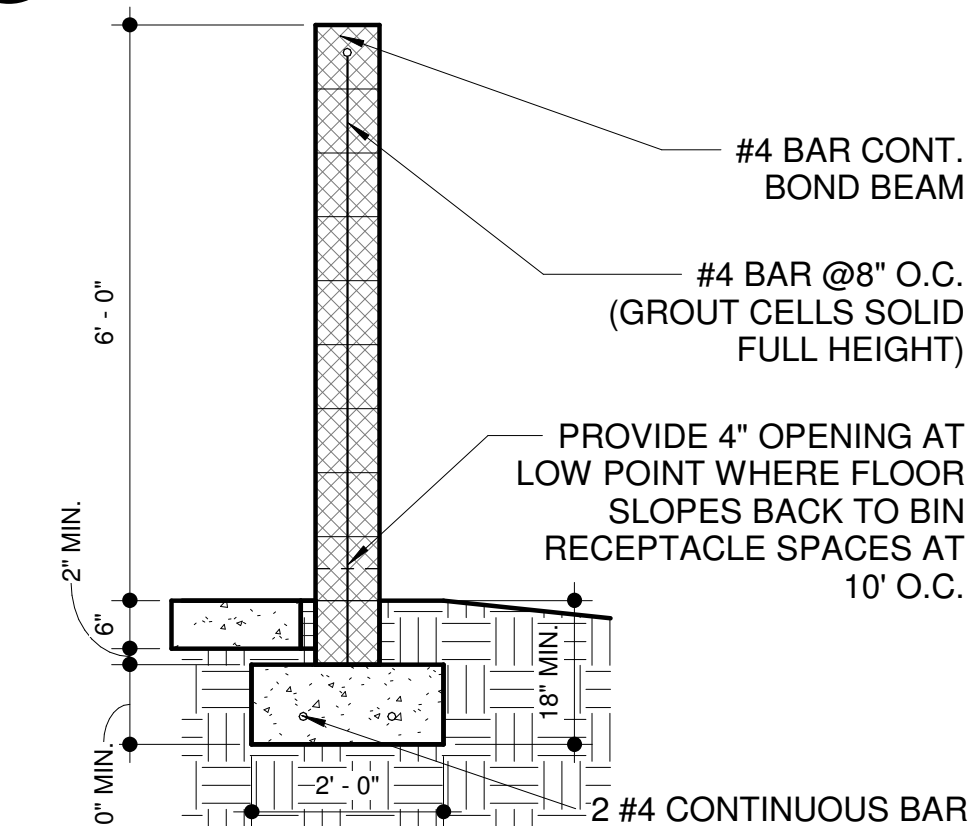

2 TRASH ENCLOSURE WALL DETAIL
1/2" = 1'-0"

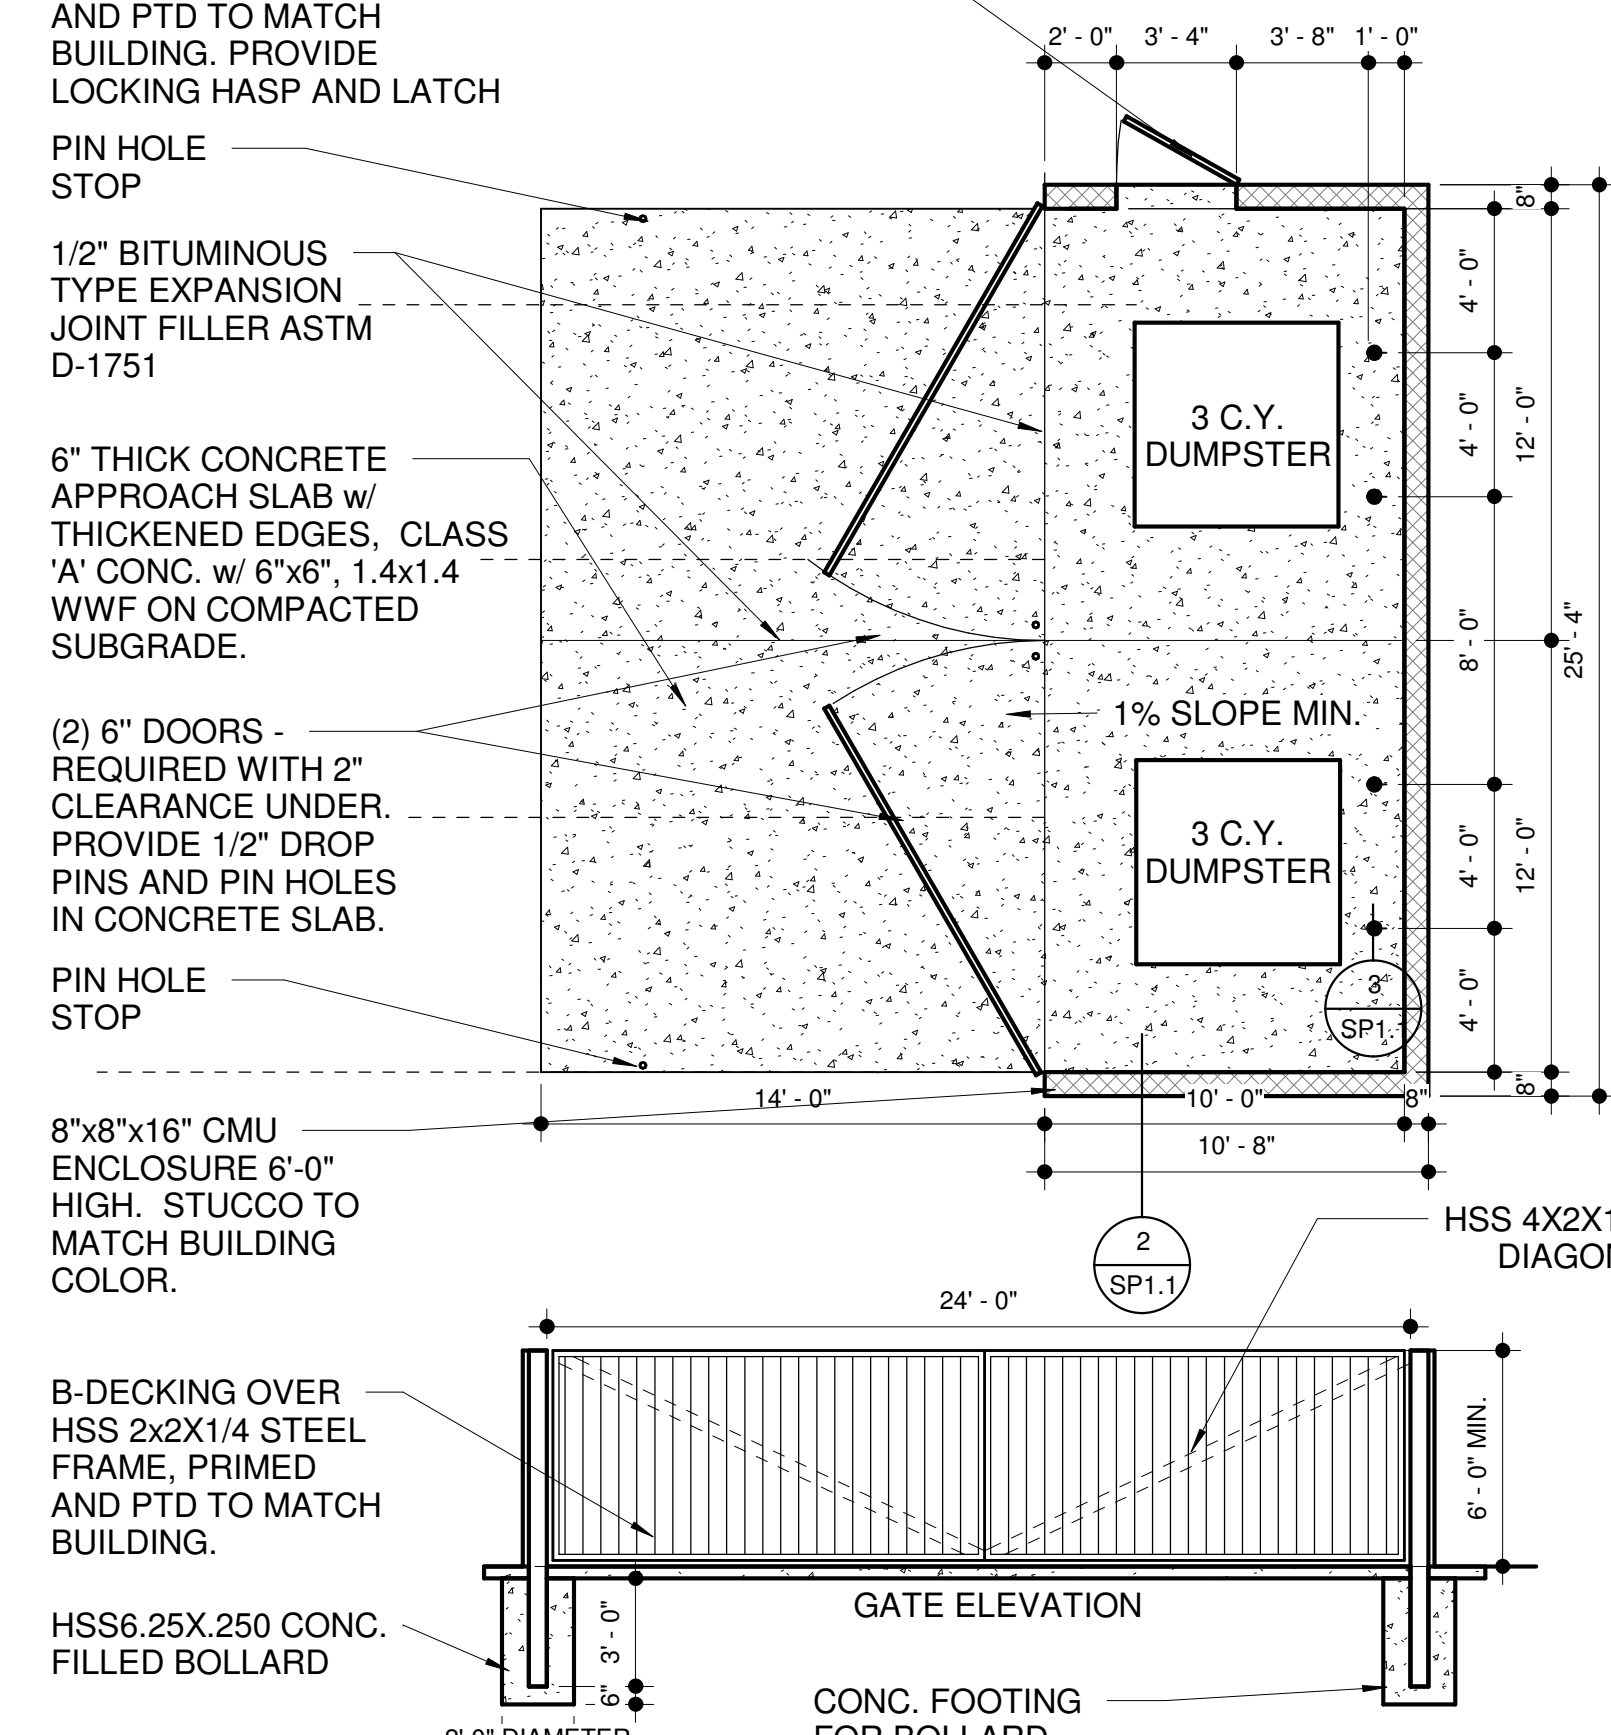

LIBERTY TREE ACADEMY

RKAA ARCHITECTS, INC

DESIGN APPROVAL

DATE APPROVED:

STATE OF COLORADO

ROBERT WARREN KUBICEK 303781

LIBERTY TREE ACADEMY

carhuff+cueva architects, llc


3149 e prince rd #151
tucson, arizona 85716
phone 520.577.4560
www.cca-az.com

NEW SCHOOL CAMPUS FOR:
LIBERTY TREE ACADEMY
8579 EASTONVILLE RD,
PEYTON, CO 80831


CONSTRUCTION DOCUMENTS

REVISION	DATE	DESCRIPTION	BY
1	03-17-16	COORDINATION / REVIEW COMMENTS	


PROJECT NO.	P18-8579
DATE	MAY 8, 2018
SCALE	As indicated
DRAWING TITLE	SITE DETAILS
DRAWING NUMBER	SP1.1

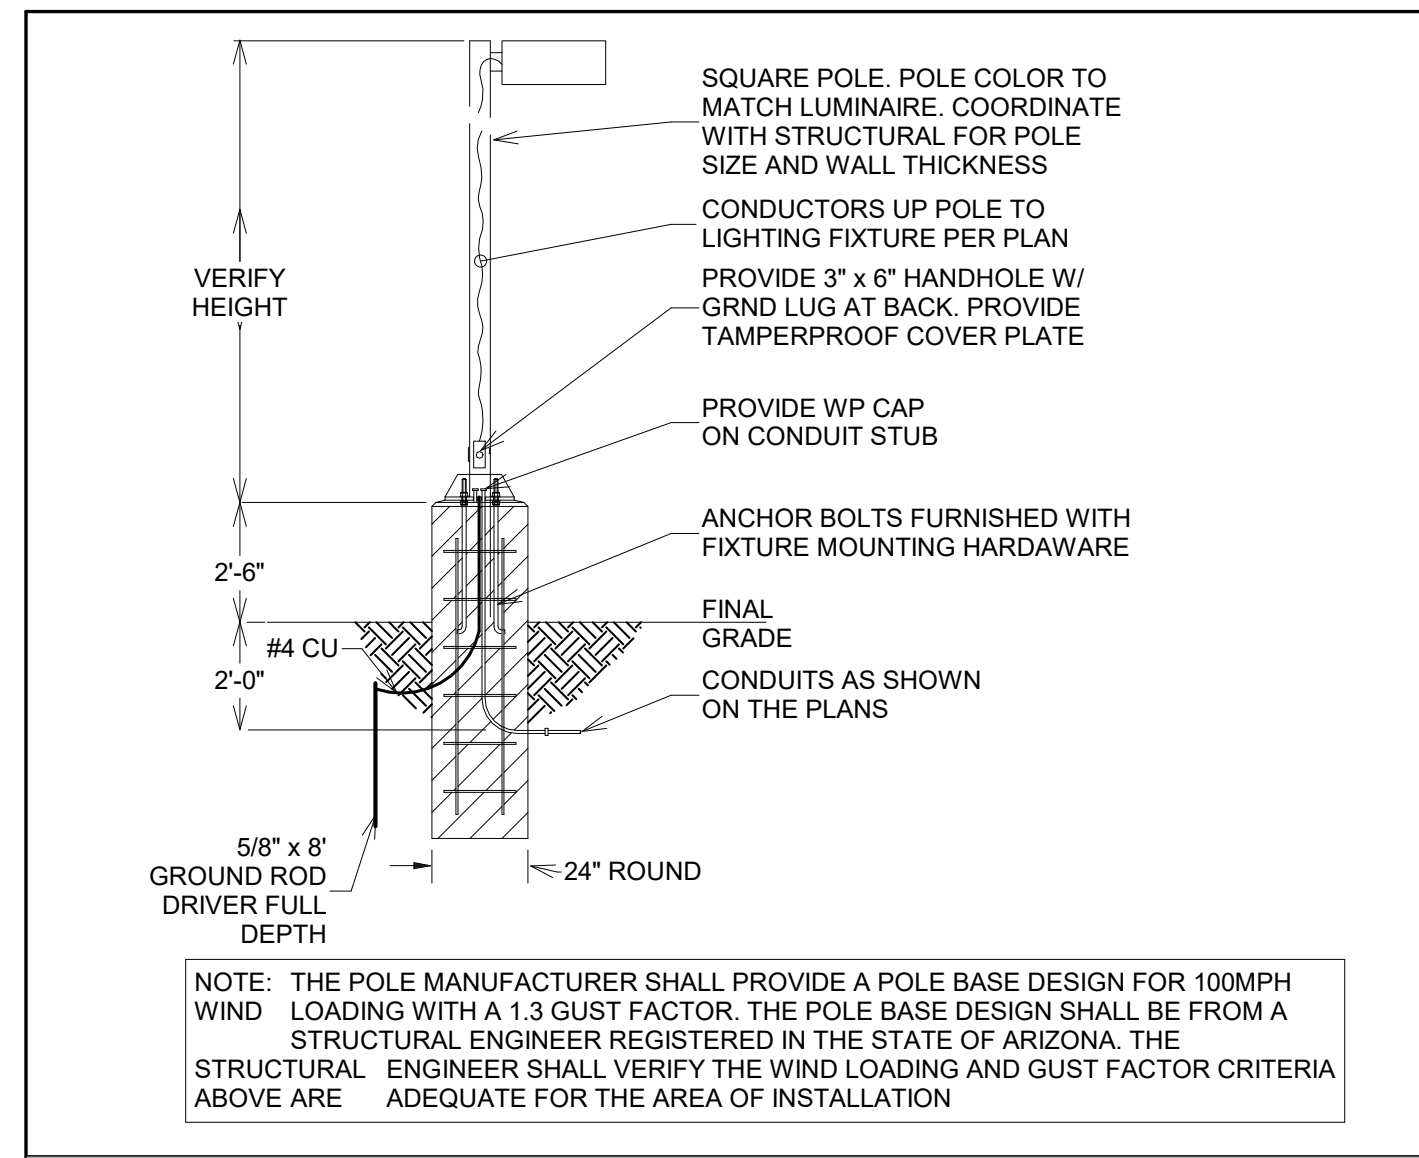

1 POLE MOUNTED DETAIL

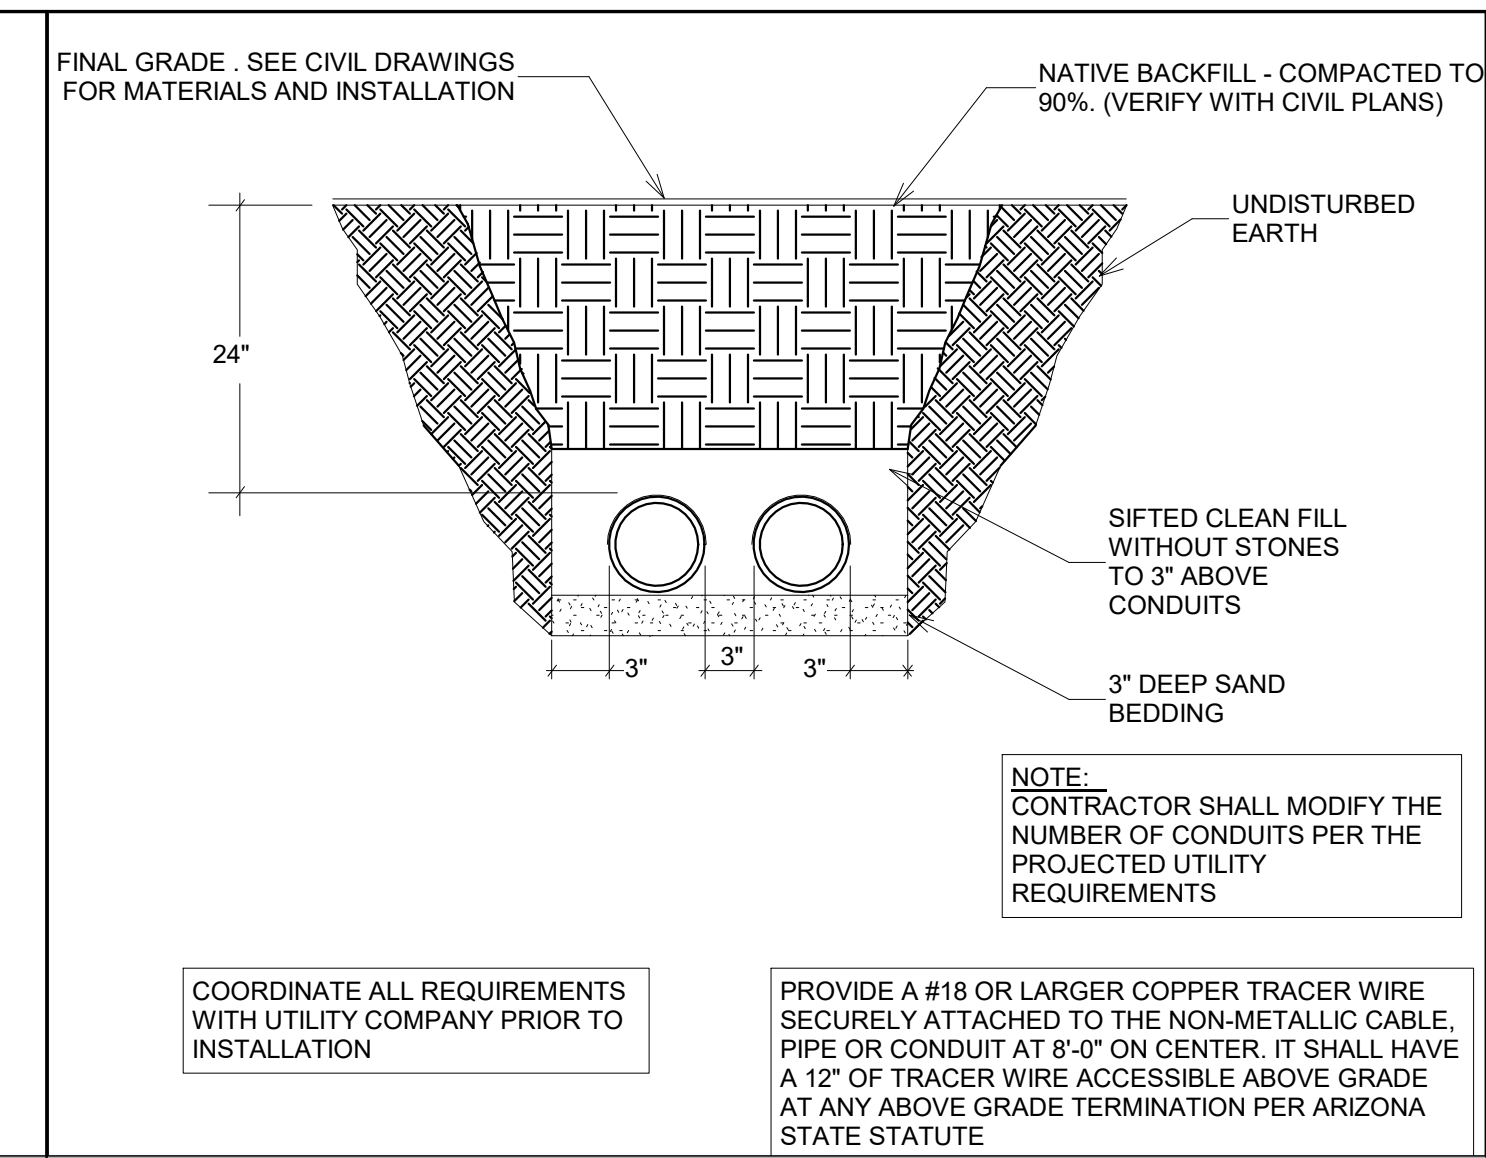

2 GENERAL TRENCH SECTION

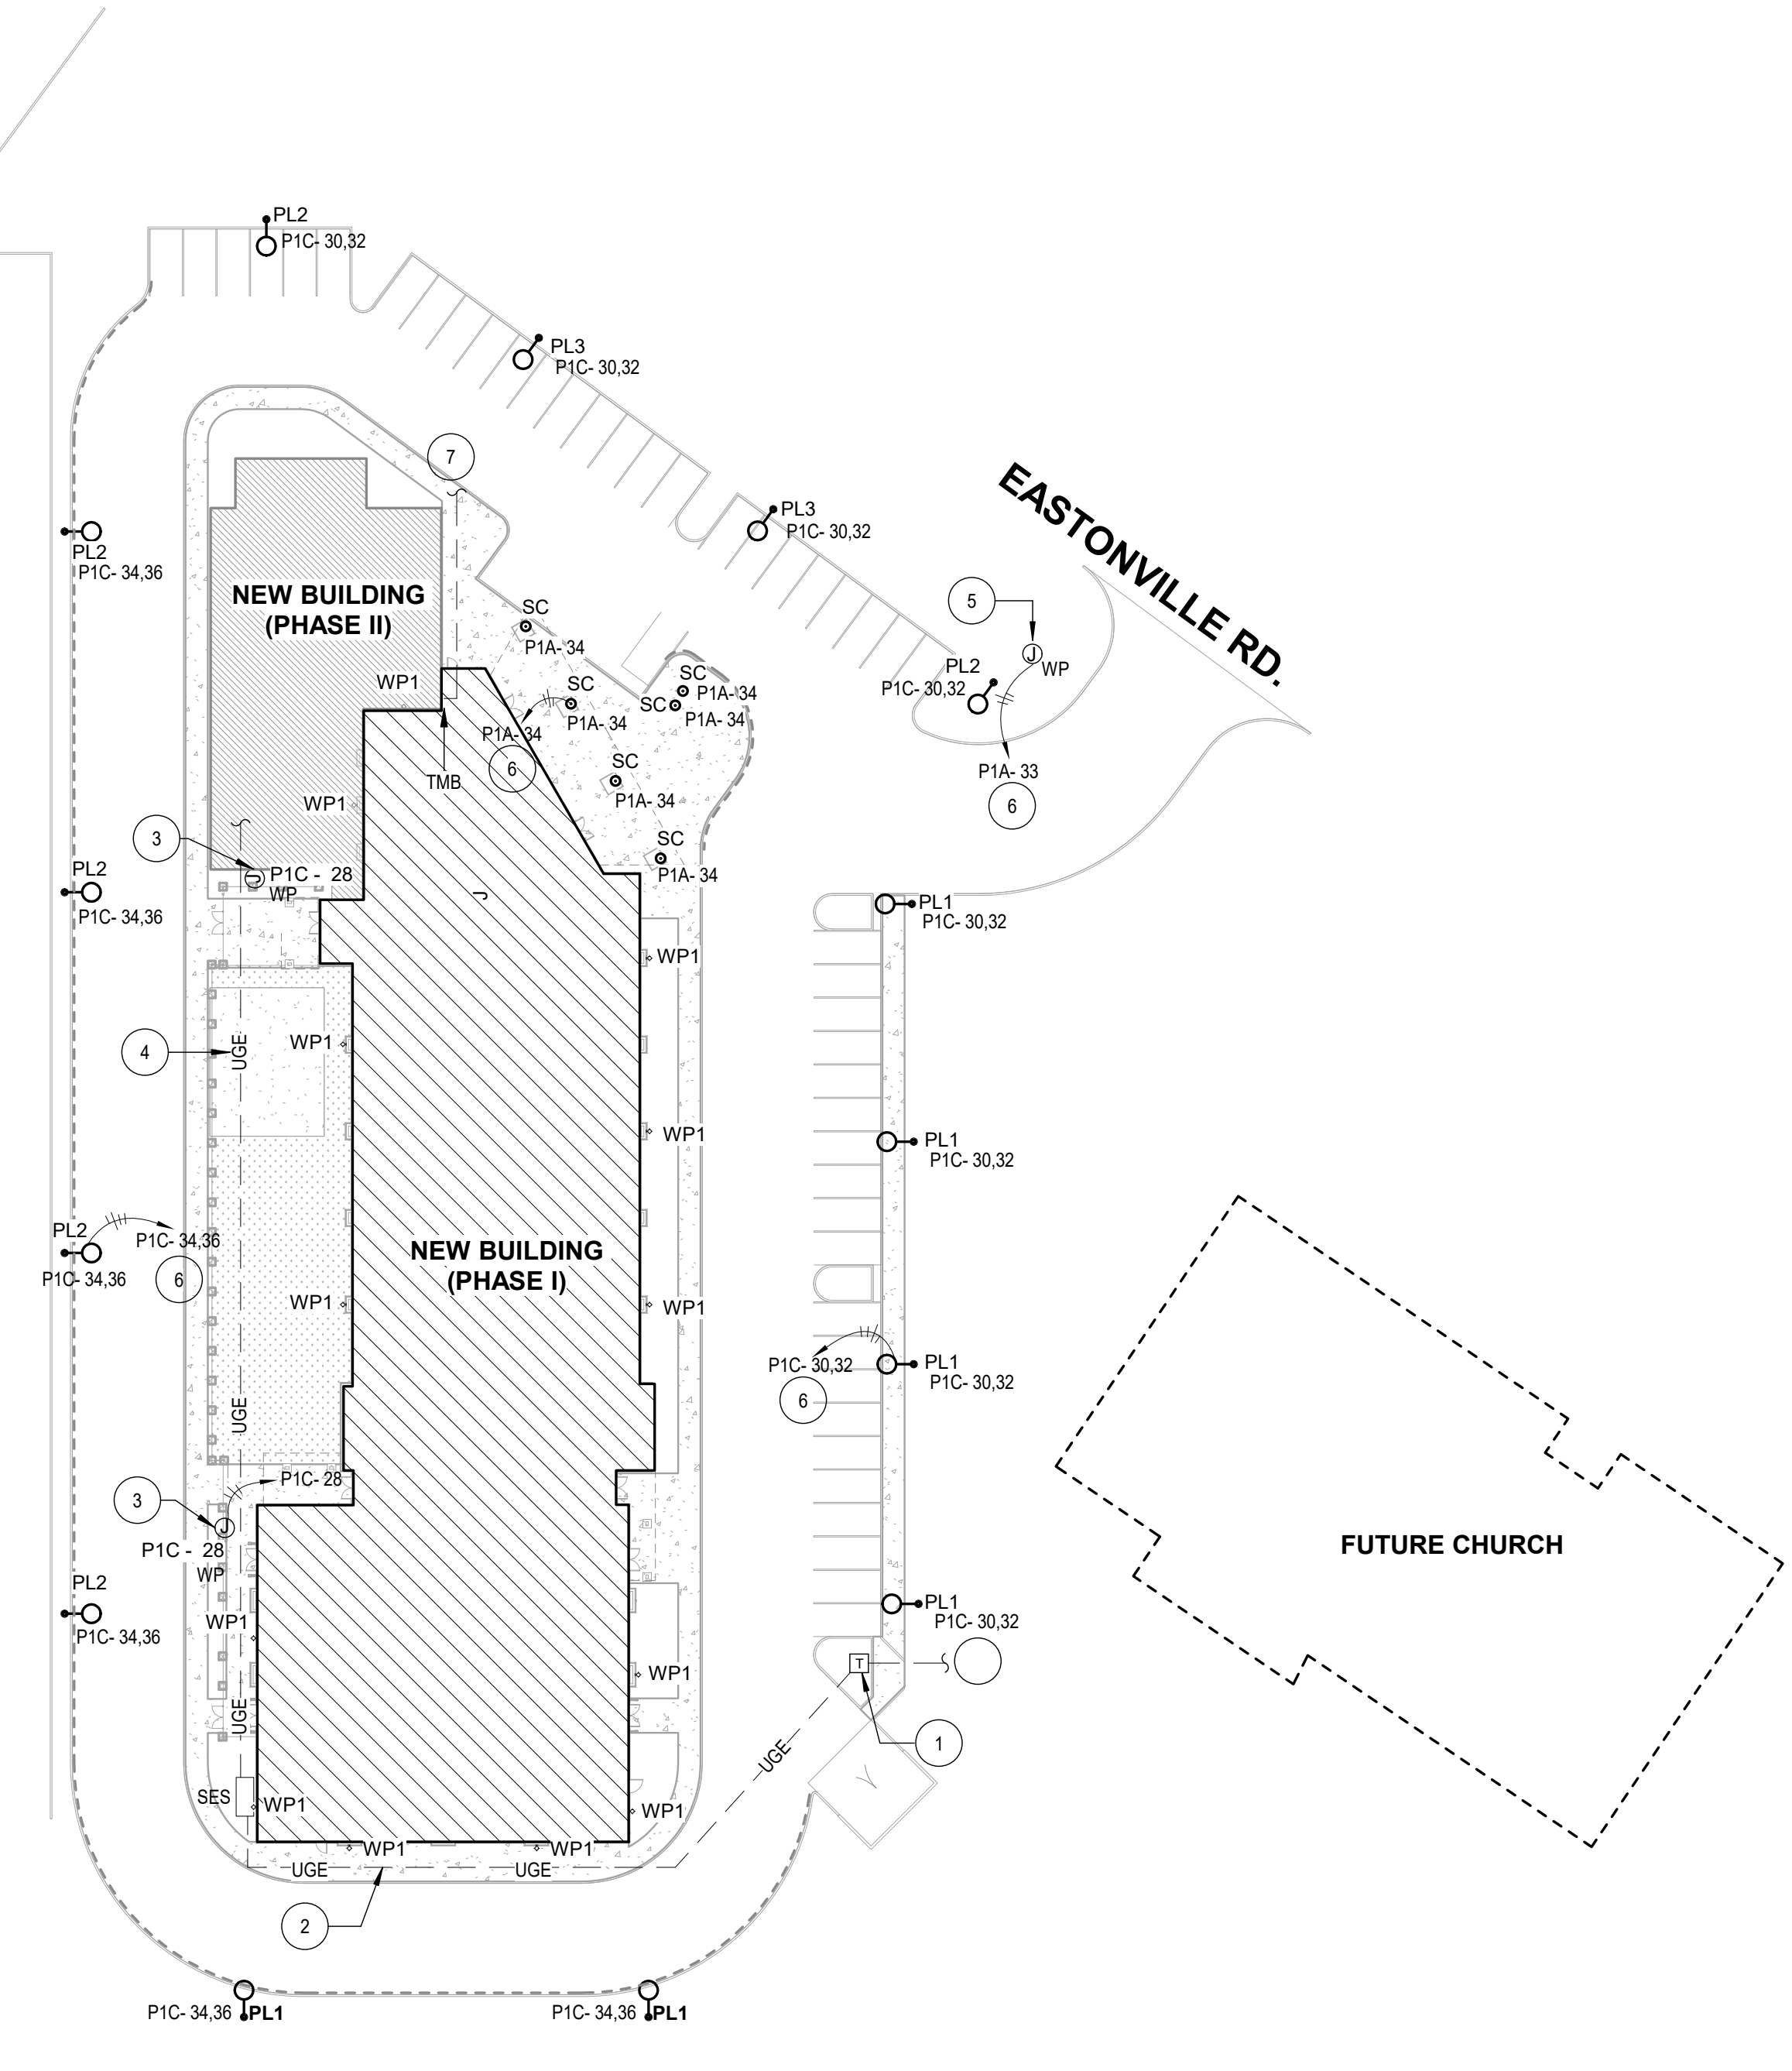


6 ELECTRICAL SITE PLAN
SCALE: 1" = 40'-0"

GENERAL NOTES

- A THIS ELECTRICAL UTILITIES SITE PLAN IS FOR REFERENCE ONLY. NO CONSTRUCTION IS TO BEGIN UNTIL FINAL UTILITY COMPANY PLANS ARE RECEIVED. UTILITY COMPANY DESIGN IS NOT AVAILABLE AT THIS TIME. ADDITIONAL WORK WILL BE REQUIRED.
- B ALL WORK SHALL BE PER UTILITY COMPANY CONSTRUCTION STANDARDS AND SPECIFICATIONS. PROVIDE CONDUIT SPACERS THROUGHOUT AND CONCRETE ENCASEMENT WHERE FEEDERS PASS UNDER DRIVEWAYS AND OR PARKING LOTS.
- C ALL TRANSFORMER BOXES, METER PANELS, ELECTRICAL EQUIPMENT AND MISCELLANEOUS UTILITY EQUIPMENT SHALL BE PAINTED TO MATCH ADJACENT BUILDING COLORS WHERE SCREENING IS NOT APPLICABLE. COORDINATE WITH UTILITY PRIOR TO PAINTING.
- D SEE SHEET E0.1 GENERAL NOTES FOR ADDITIONAL UTILITY COORDINATION NOTES.
- E ALL EXTERNAL LIGHTING SHALL BE LOCATED AND DESIGNED TO PREVENT RAYS FROM BEING DIRECTED OFF OF THE PROPERTY UPON WHICH THE LIGHTING IS LOCATED.
- F THE CONTRACTOR SHALL PROGRAM THE LIGHTING CONTROLLER AS PER THE LIGHTING DIAGRAM PRIOR TO CALLING THE CITY FOR THE INSPECTION.
- G THE CONTRACTOR IS TO SCHEDULE A NIGHT TIME INSPECTION OF THE ENERGIZED LIGHTING, TO ATTEND THIS INSPECTION AND TO CORRECT ALL ITEMS IDENTIFIED DURING INSPECTION PRIOR TO ISSUING THE FINAL CERTIFICATE OF OCCUPANCY.

KEYED NOTES

- 1 PROPOSED LOCATION OF UTILITY TRANSFORMER. ELECTRICAL CONTRACTOR SHALL PROVIDE CONCRETE PAD PER UTILITY COMPANY REQUIREMENTS. COORDINATE WITH UTILITY COMPANY FOR EXACT REQUIREMENTS AND LOCATION. MAINTAIN MINIMUM CLEARANCE IN FRONT, SIDES AND BACK OF UTILITY TRANSFORMER PER UTILITY REQUIREMENTS.
- 2 PROVIDE SECONDARY CONDUIT WITH MULETAPE FROM NEW UTILITY COMPANY TRANSFORMER TO S.E.S. UTILITY PULL SECTION. COORDINATE WITH UTILITY COMPANY FOR EXACT QUANTITY, ROUTING AND REQUIREMENTS. TRENCHING AND BACKFILL BY ELECTRICAL CONTRACTOR AS REQUIRED BY THE UTILITY. VERIFY EXACT ROUTING, DISTANCE AND P.O.C. WITH UTILITY PRIOR TO DIGGING.
- 3 PROVIDE WEATHER PROOF J-BOX AT GATE FOR CARD READER. VERIFY MOUNTING AND LOCATION WITH OWNER PRIOR TO INSTALLATION.
- 4 PROVIDE (2) 4" UG CONDUITS STUB-UPS WITH PULL STRING FOR FUTURE PHASE 2 ADDITION, FROM SES TO FUTURE BUILDING ELECTRICAL ROOM LOCATION. VERIFY EXACT ROUTING, DISTANCE, AND STUB-UP WITH OWNER PRIOR TO DIGGING.
- 5 PROVIDE WP J-BOX FOR MONUMENT SIGN LIGHTING. COORDINATE EXACT LOCATION PRIOR TO ROUGH-IN.
- 6 PROVIDE (2) 4" CONDUIT WITH PULL WIRE TO TEL/CO/CATV POINT OF CONNECTION. COORDINATE WITH UTILITY COMPANY FOR EXACT ROUTING AND REQUIREMENTS. PROVIDE PULL BOXES AS REQUIRED.
- 7

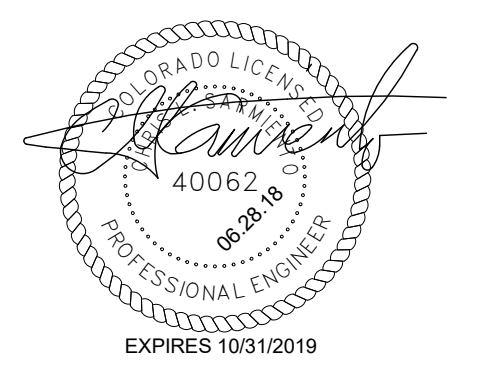

carhuff+cueva
architects, llc

3149 e prince rd #151
tucson, arizona 85716
phone 520.577.4560
www.cca-az.com

NEW SCHOOL CAMPUS FOR:
LIBERTY TREE ACADEMY
8579 EASTONVILLE RD,
PEYTON, CO 80831

CONSTRUCTION DOCUMENTS

REVISION	DATE	DESCRIPTION	BY

PROJECT NO. **18001**

DATE **JUNE 27, 2018**

SCALE **As indicated** DRAWN BY **Author**

DRAWING TITLE **ELECTRICAL SITE PLAN**

DRAWING NUMBER **E1.1**



GENERAL NOTES

1 ALL EXTERNAL LIGHTING SHALL BE LOCATED AND DESIGNED TO PREVENT RAYS FROM BEING DIRECTED OFF OF THE PROPERTY UPON WHICH THE LIGHTING IS LOCATED.

**LIBERTY TREE
ACADEMY**

WWL Calculation Summary							
Label	CalcType	Units	Avg	Max	Min	Avg/Min	Max/Min
Grade	Illuminance	Fc	2.03	9.4	0.0	N.A.	N.A.
Spill at property line	Illuminance	Fc	0.00	0.2	0.0	N.A.	N.A.

WWL Luminaire Schedule							
Symbol	Qty	Label	Arrangement	Total Lamp Lumens	LLF	Description	
○	3	C2	SINGLE	N.A.	0.940	IHOL-6DR-M1-40-D101-VOLTS-40/ IRD602-HZ-SF-SL Mounted at 10 ft-3 inches aff. Dimmed to 70%	
○	12	C3	SINGLE	N.A.	1.040	IHOL-8SR-M1-40-D101-VOLTS-40/ IRS-XX-HZ-SF Mounting height varies. See elevation for heights	
○→	4	PL1	SINGLE	12425	0.980	ARE-EDG-4M-DA-06-E-UL-BK-700-40K Mounted at 18 ft afg	
○→	6	PL2	SINGLE	8714	0.980	ARE-EDG-3MB-DA-06-E-UL-BK-700-40K Mounted at 18 ft afg	
○→	2	PL3	SINGLE	10573	0.980	ARE-EDG-4MB-DA-08-E-UL-BK-525-40K Mounted at 18 ft afg	
○→	3	PL4	SINGLE	11779	0.980	ARE-EDG-3M-DA-06-E-UL-BK-700-40K Mounted at 18 ft afg	
○→	13	WP1	SINGLE	N.A.	0.970	SEC-EDG-4M-WM-04-E-UL-BK-525-40K Mounted at 12 ft afg	

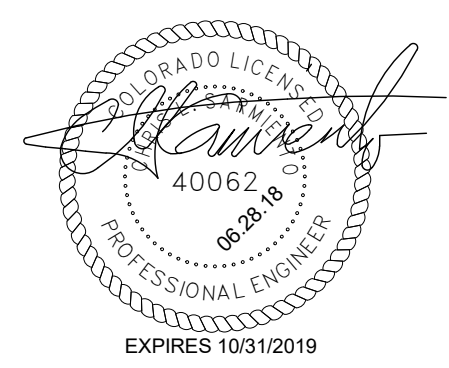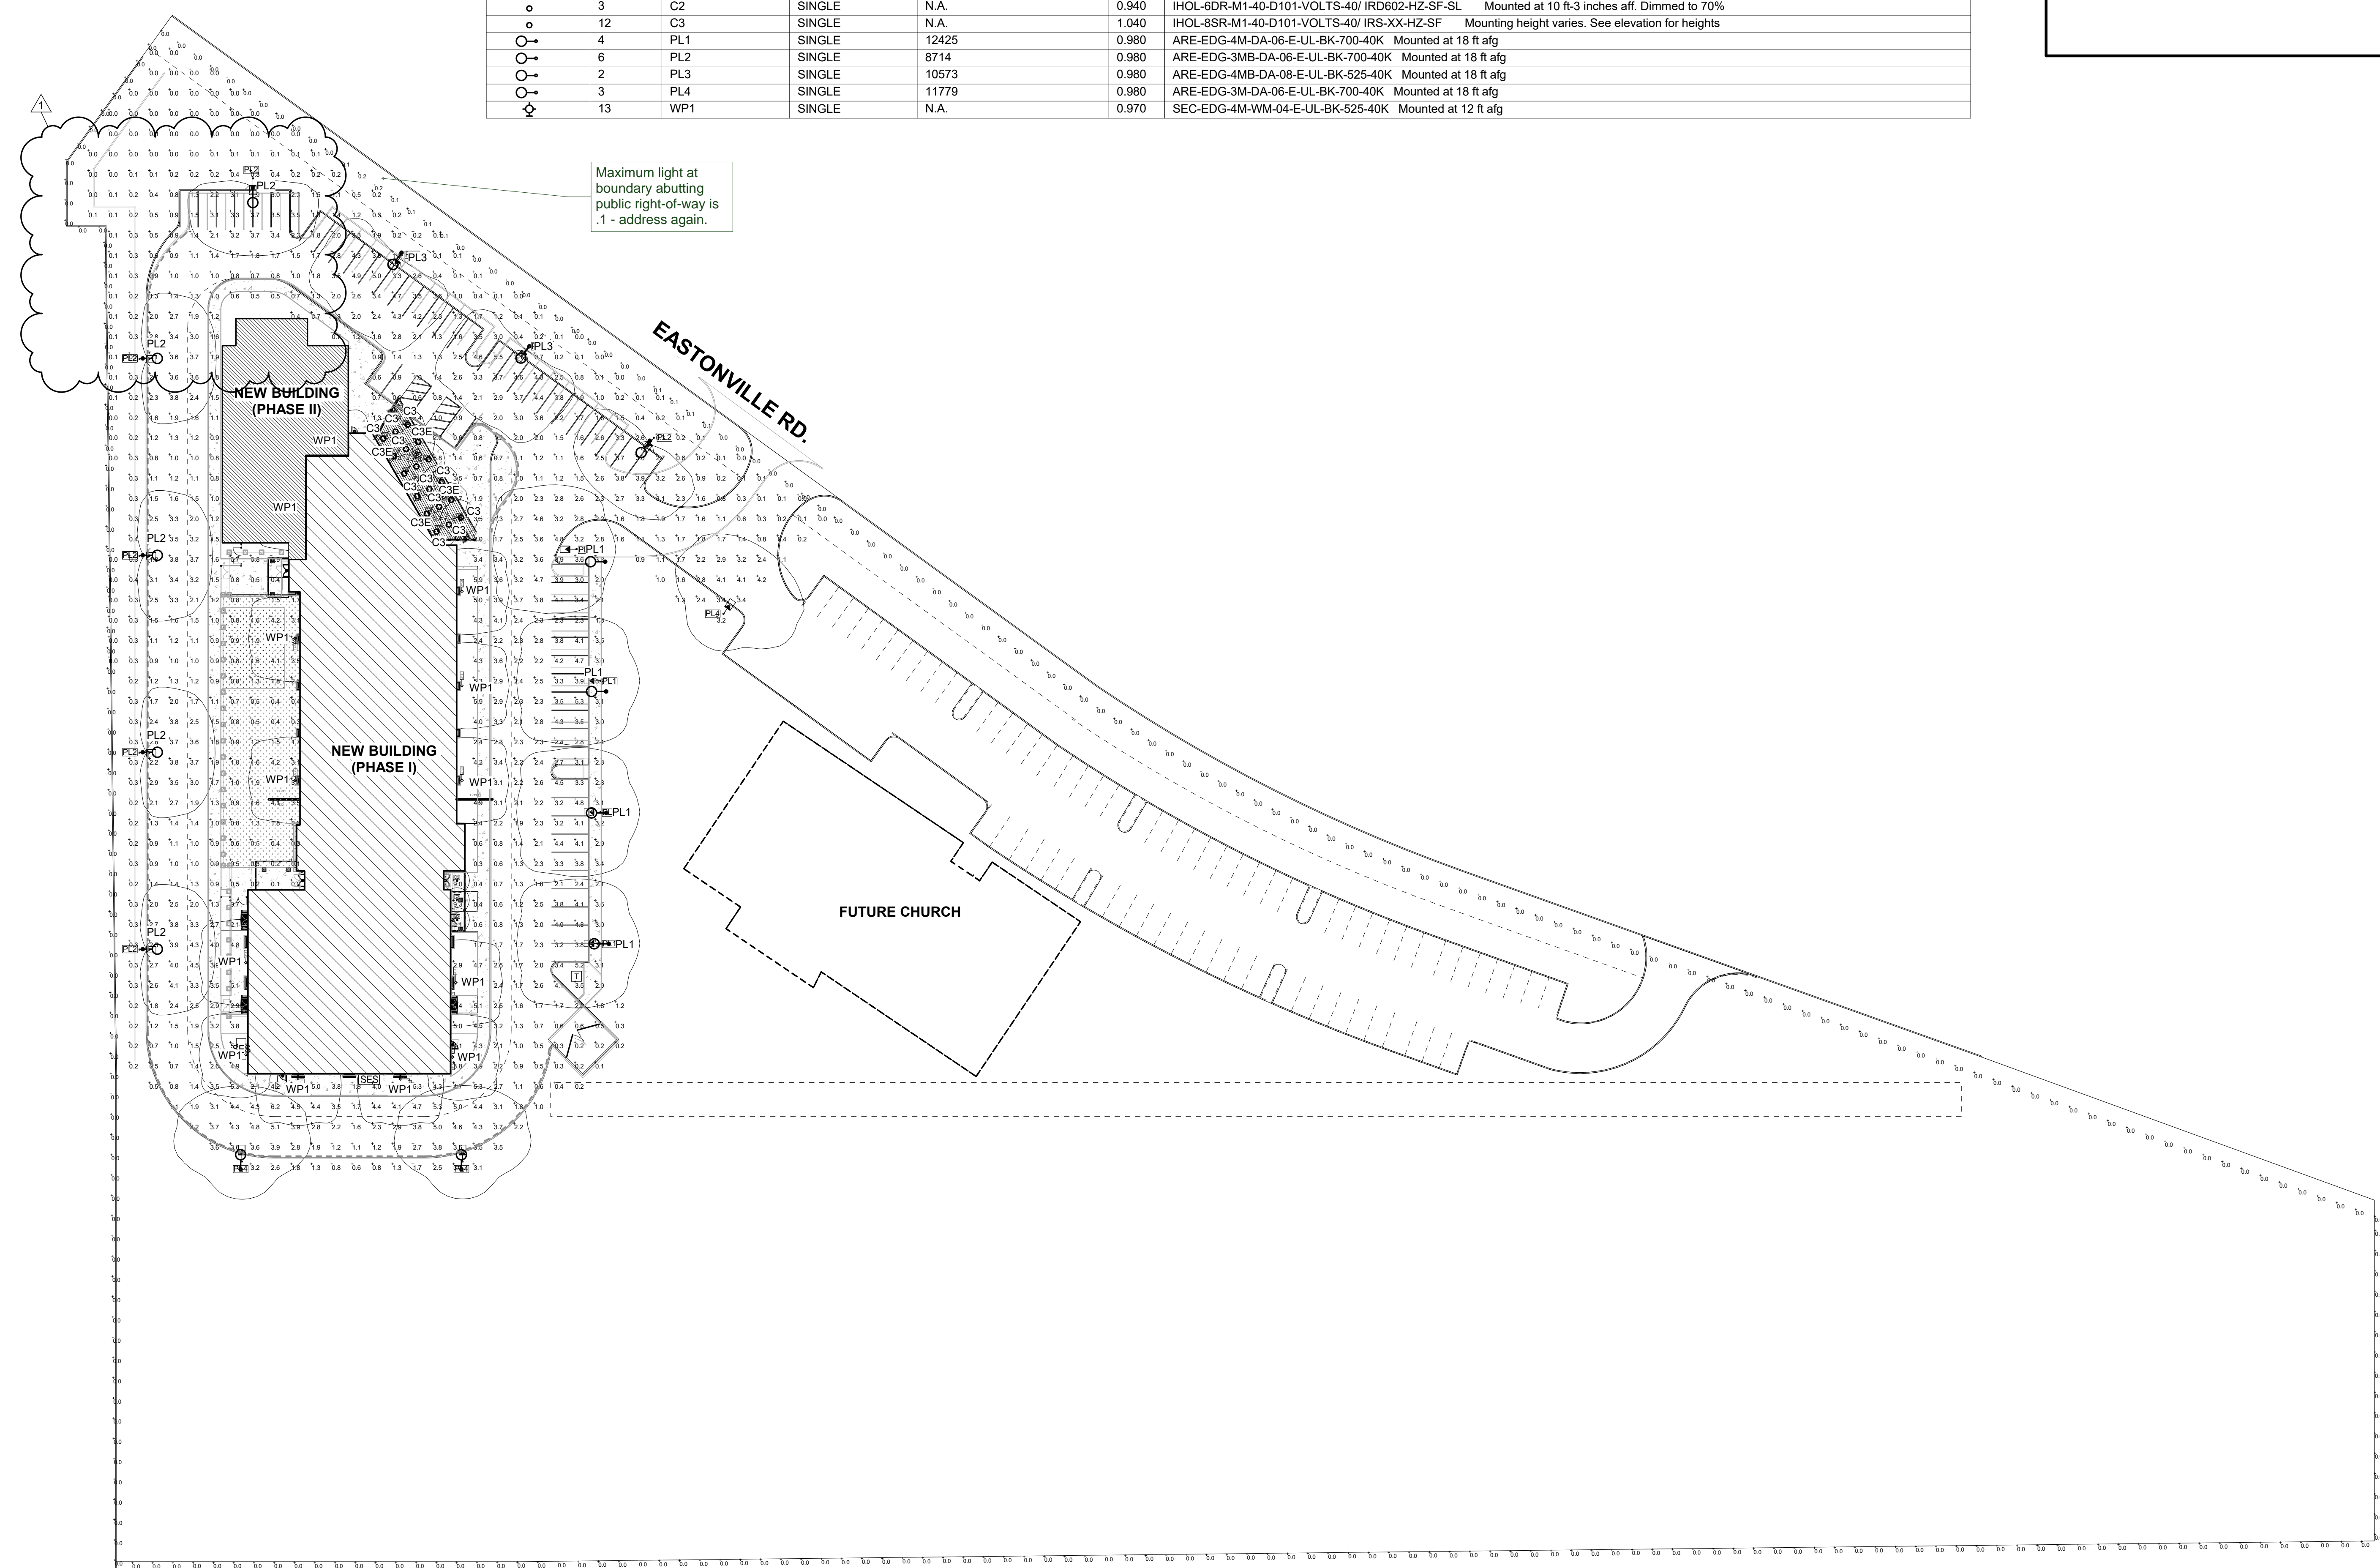

**carhuff+cueva
architects, llc**

3149 e prince rd #151
tucson, arizona 85716
phone 520.577.4560
www.cca-az.com

**NEW SCHOOL CAMPUS FOR:
LIBERTY TREE ACADEMY**

8579 EASTONVILLE RD,
PEYTON, CO 80831

CONSTRUCTION DOCUMENTS

REVISION	DATE	DESCRIPTION	BY
1	06.27.18	City Comments	

PROJECT NO. **18001**

DATE **JUNE 27, 2018**

SCALE **1" = 40'-0"** DRAWN BY **Author**

DRAWING TITLE
ELECTRICAL SITE PHOTOMETRIC CALCULATIONS

DRAWING NUMBER
E1.2

Cree Edge™ Series LED Area/Flood Luminaire

The Cree Edge™ Series has a slim, low profile design. Its rugged cast aluminum housing minimizes wind load requirements and features an integral, weatheright LED driver compartment and high performance aluminum heat sink. Luminaire is available in multiple configurations. Adjustable Arm, Direct Arm, Long or Side Arm (details on page 2). Includes a leaf/dieback guard.
Applications: Parking lots, walkways, campuses, car dealerships, office complexes, and interior walkways.

Performance Summary

- Patented NanoOptic® Product Technology
- Made in the U.S.A. of U.S. and imported parts
- CRI: Minimum 70 CRI
- CCT: 4000K (+/-300K), 5700K (+/-500K) standard
- Limited Warranty¹, 10 years on luminaires/70 years on Colorfast DetaGuard® finish

¹ See <http://lighting.cree.com/warranty> for warranty terms.

Accessories

Item Name	Weight (lbs.)
Field-Installed	
AA-5855PM	24 lbs. (11kg)
AA-5855SM	24 lbs. (11kg)
AA-5855SM	27 lbs. (12kg)
AA-5855SM	29 lbs. (13kg)
AA-5855SM	32 lbs. (15kg)
AA-5855SM	34 lbs. (15kg)
AA-5855SM	37 lbs. (17kg)
AA-5855SM	41 lbs. (19kg)

Ordering Information

Example: AEE-EDG-2M-AA-12-E-UL-SH-320

Product	Optic	Mounting	LED Count (x10)	E	Series	Voltage	Color Options	Drive Current	Options
AEE-EDG	2M Type II Medium Type III Medium Type IV Medium Type V Medium Type VI Medium Type VII Medium Type VIII Medium Type IX Medium Type X Medium Type XI Medium Type XII Medium Type XIII Medium Type XIV Medium Type XV Medium Type XVI Medium Type XVII Medium Type XVIII Medium Type XIX Medium Type XX Medium Type XXI Medium Type XXII Medium Type XXIII Medium Type XXIV Medium Type XXV Medium Type XXVI Medium Type XXVII Medium Type XXVIII Medium Type XXIX Medium Type XXX Medium	2M Type II Medium Type III Medium Type IV Medium Type V Medium Type VI Medium Type VII Medium Type VIII Medium Type IX Medium Type X Medium Type XI Medium Type XII Medium Type XIII Medium Type XIV Medium Type XV Medium Type XVI Medium Type XVII Medium Type XVIII Medium Type XIX Medium Type XX Medium Type XXI Medium Type XXII Medium Type XXIII Medium Type XXIV Medium Type XXV Medium Type XXVI Medium Type XXVII Medium Type XXVIII Medium Type XXIX Medium Type XXX Medium	02 04 06 1000	02 04 06 1000	02 04 06 1000	02 04 06 1000	02 04 06 470		

Markup Summary

dsdkendall (4)


Do not include lighting plan and other documents in this submittal, upload lighting plan to the lighting plan spot, etc

Subject: Text Box
Page Label: [1] TS01 TS01
Author: dsdkendall
Date: 7/26/2018 11:53:19 AM
Color: ■

Do not include lighting plan and other documents in this submittal, upload lighting plan to the lighting plan spot, etc


INDEX OF SHEETS

NO.	DATE	DESCRIPTION
1	1/2	1.01
2	4	1.01
3	8	1.01
4	2	1.01
5	8	1.01
6	13	1.01

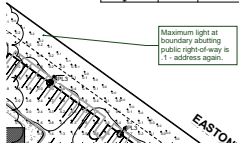


Subject: Callout
Page Label: [10] E1.2
Author: dsdkendall
Date: 7/26/2018 11:53:22 AM
Color: ■

Maximum light at boundary abutting public right-of-way is .1 - address again.

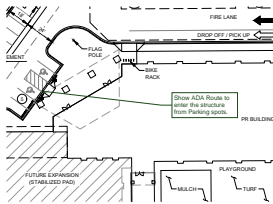

Subject: Callout
Page Label: [2] SP01 SP01
Author: dsdkendall
Date: 7/26/2018 11:53:23 AM
Color: ■

Show ADA Route to enter the structure from Parking spots.

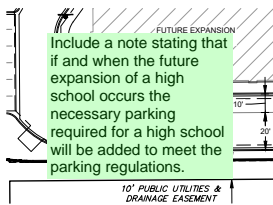

Subject: Text Box
Page Label: [2] SP01 SP01
Author: dsdkendall
Date: 7/26/2018 12:36:48 PM
Color: ■

Include a note stating that if and when the future expansion of a high school occurs the necessary parking required for a high school will be added to meet the parking regulations.