



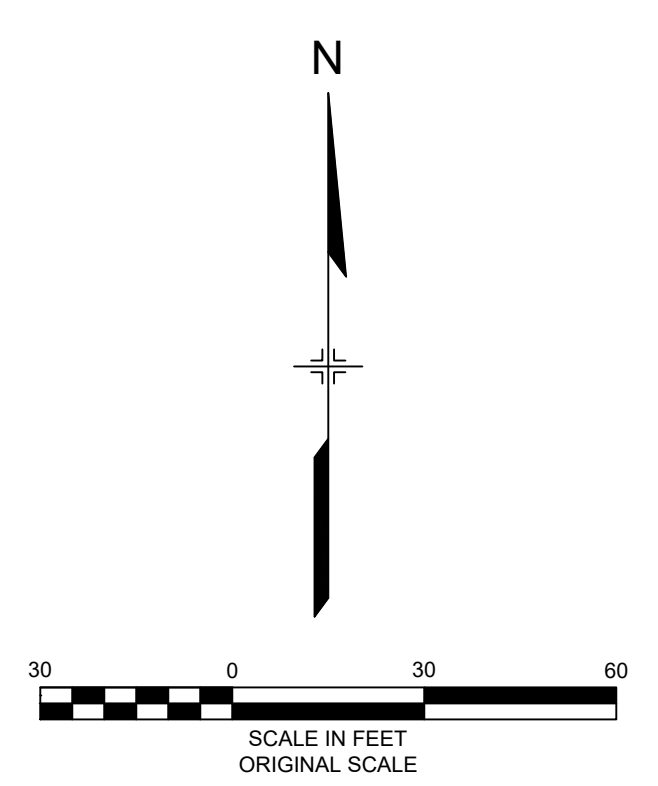

**LANDSCAPE LEGEND**

- DECIDUOUS SHADE TREE
- DECIDUOUS MULTI-STEM TREE
- ORNAMENTAL TREE
- EVERGREEN TREE
- UPRIGHT JUNIPER
- SHRUB PLANTING BED
- NATIVE GRASS SEEDING

Ensure that MVEA and WHMD will allow trees where proposed.

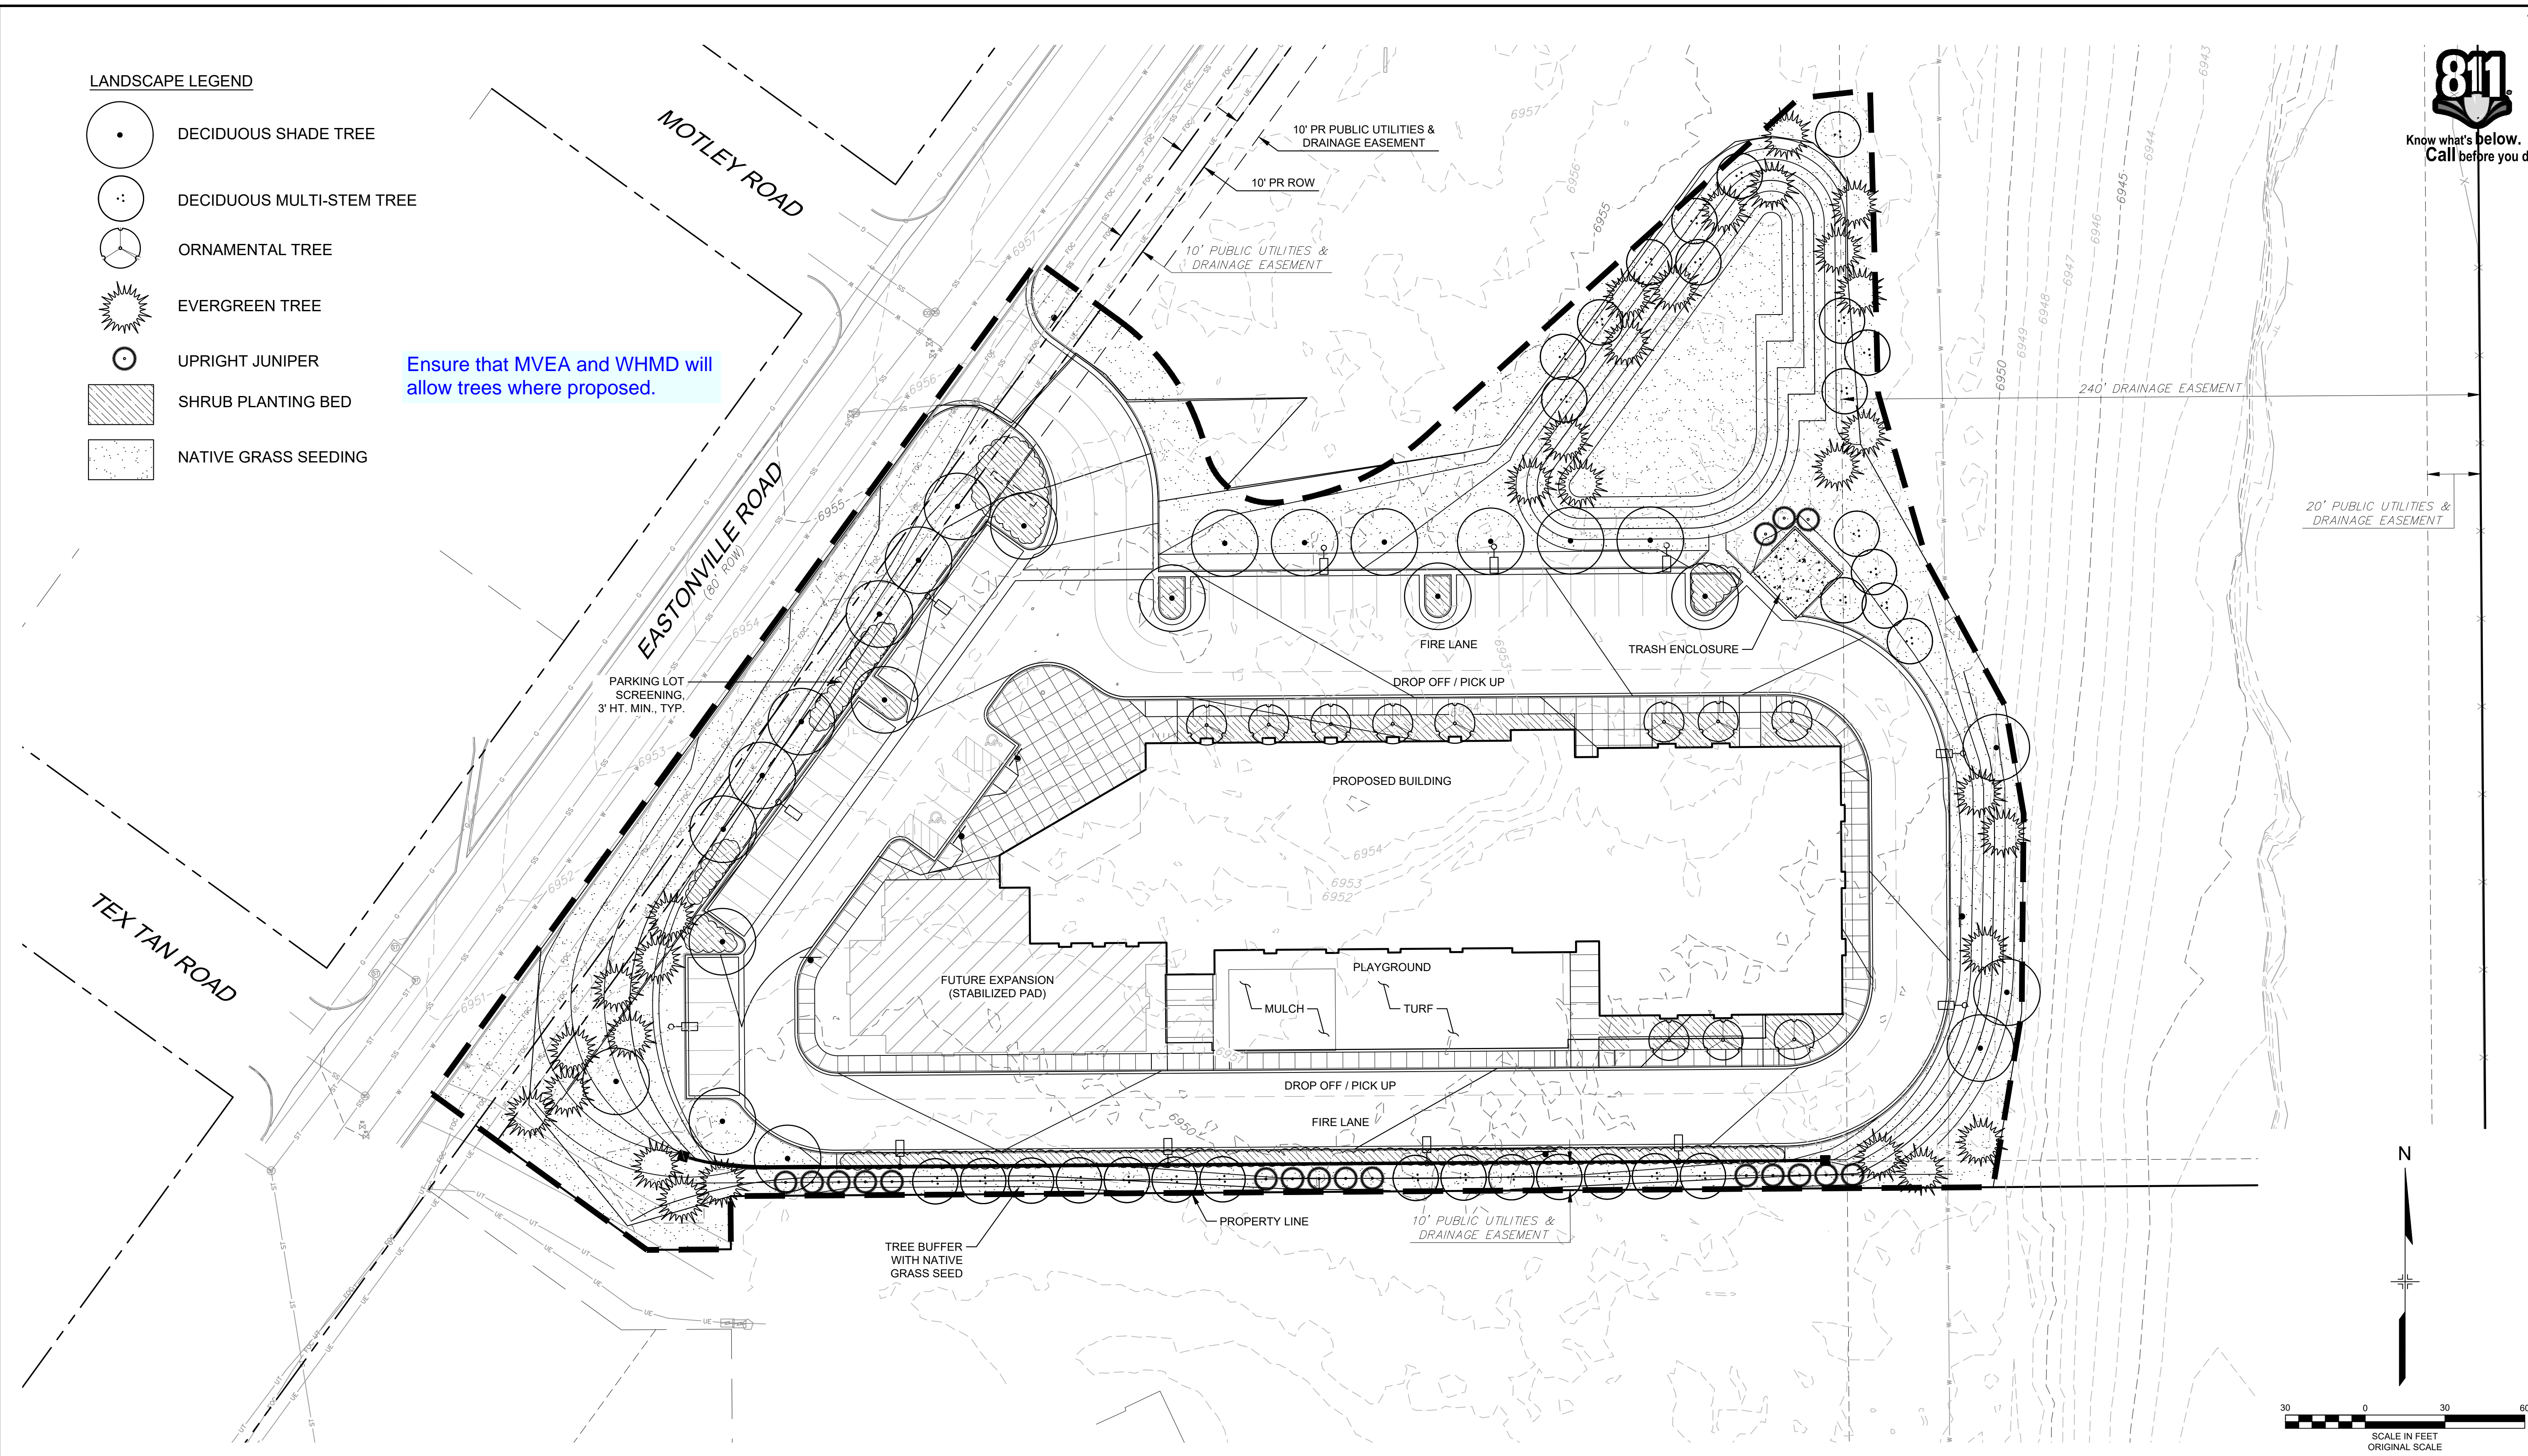

REFERENCE DRAWINGS			
No.	DATE	DESCRIPTION	BY
X:995-MD-G22x34 X:995-PR-BASE X:995-EX-BASE X:995-EX-MAP X:995-PR-GRAD X:995-PR-LANDSCAPE			
COMPUTER FILE MANAGEMENT			
FILE NAME: R:118.995.001 (Liberty Tree Academy)\Dwg\Construction Plans\Landscapel\LS01.dwg			
CTB FILE: ---			
PLOT DATE: 5/4/2018 11:17 AM			
THIS DRAWING IS CURRENT AS OF PLOT DATE AND MAY BE SUBJECT TO CHANGE.			

SHEET KEY	



PREPARED BY:  
**Matrix**  
 DESIGN GROUP  
 AN EMPLOYEE-OWNED COMPANY

SEAL  
**PRELIMINARY**  
 THIS DRAWING HAS NOT BEEN APPROVED BY GOVERNING AGENCIES AND IS SUBJECT TO CHANGE

**LIBERTY TREE ACADEMY**  
 TOWN OF PEYTON, EL PASO COUNTY  
 CONSTRUCTION DOCUMENTS

**LANDSCAPE PLAN**

DESIGNED BY: ACR	SCALE:	DATE ISSUED: MAY 2018	DRAWING No.
DRAWN BY: ACR	HORIZ.	SHEET 19 OF 19	LS01
CHECKED BY: DRK	VERT.		

FOR AND ON BEHALF OF  
 MATRIX DESIGN GROUP, INC.  
 PROJECT No. 18.995.001



# Markup Summary

---

dsdrice (1)

---



**Subject:** Text Box  
**Page Label:** 1  
**Author:** dsdrice  
**Date:** 6/14/2018 10:00:34 AM  
**Color:** ■

Ensure that MVEA and WHMD will allow trees where proposed.