


# TERRA RIDGE NORTH CIVIL CONSTRUCTION PLANS El Paso County, Colorado



VICINITY MAP  
SCALE 1"=1/2 MILE

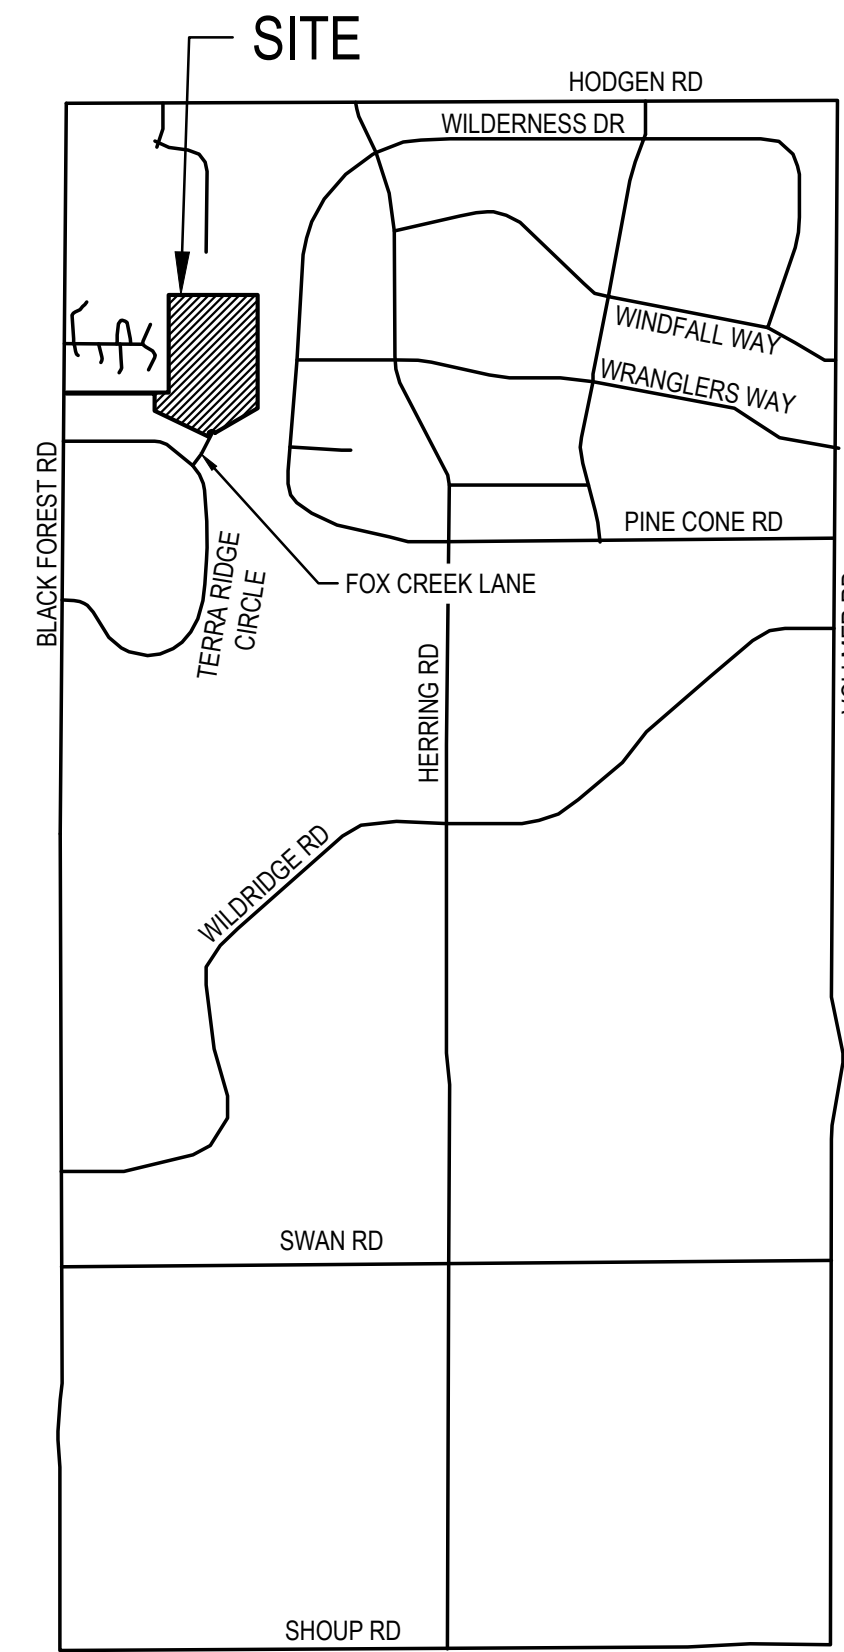

Prepared For:  
**Phillip S. & Jennifer Miles**  
15630 Fox Creek Lane  
Colorado Springs, CO 80908


Prepared By:  
**Lodestar Engineering, LLC**  
P.O. Box 88461  
Colorado Springs, CO 80908  
**SEPTEMBER, 2022**

Legal Description:  
Portion of the Southwest Quarter of Section 29, Township 11 South, Range 65 West of the 6th P.M., County of El Paso, State of Colorado, more particularly described as follows:

Beginning at the Northwest corner of the Southwest Quarter of said Southwest Quarter; thence S89°46'29"E along the South line of Whispering Hills Estates as recorded in Plat Book Z-2 at Page 2 of said county records, 1407.75 feet to the Southeast corner thereof; thence N00°58'34"E, 1327.96 feet to the Northeast corner thereof; thence S89°47'26"E, 1245.16 feet to the Northeast corner of said Southwest Quarter, said Northeast corner also being on the West line of Wildwood Village Unit 3 as recorded in Plat Book H-3 at Page 57 of said county records; thence S00°59'16"W along the East line of said Southwest Quarter and the West Line of said Wildwood Village Unit 3 and Wildwood Village Unit 4 as recorded in Plat Book M-3 at Page 46 of said county records, 1366.91 feet; thence N89°46'29"W, 945.48 feet; thence N00°58'34"E, 8.50 feet; thence N89°46'29"W, 1708.14 feet to a point on the west line of said Southwest Quarter; thence N00°58'34"E, 30.00 feet to the point of beginning, County of El Paso, State of Colorado., said described tract contains 39.72 Acres +/-



KEYMAP  
SCALE NTS

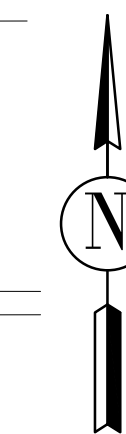

Revise to Lupe Packman, E.I.

Revise to Joshua Palmer, P.E.

### AGENCIES/CONTACTS

<b>DEVELOPER:</b>	SHAY MILES 15630 FOX CREEK LANE COLORADO SPRINGS, CO 80908 (719) 352-8886	<b>GAS DEPARTMENT:</b>	BLACK HILLS ENERGY MR. SEBASTIAN SCHWENDER (719) 359-3716
<b>SURVEYOR:</b>	JOHN KEILERS & ASSOCIATES, LLC 9920 OTERO AVENUE COLORADO SPRINGS, CO 80920 (719) 649-9243	<b>ELECTRIC DEPARTMENT:</b>	MOUNTAIN VIEW ELECTRIC ASSOCIATION' 11140 E. WOODMEN ROAD COLORADO SPRINGS, CO 80908MR. DAVE WALDNER (719) 495-2283
<b>CIVIL ENGINEER:</b>	LODESTAR ENGINEERING, LLC P.O. BOX 88461 COLORADO SPRINGS, CO 80908 (719) 352-8886	<b>TELEPHONE COMPANY:</b>	N/A
<b>LOCAL ROADS &amp; DRAINAGE:</b>	EL PASO COUNTY PCD 2880 INTERNATIONAL CIRCLE COLORADO SPRINGS, CO 80910 MR. LUPE PACKMAN, P.E. (719) 520-7945	<b>FIRE DEPARTMENT:</b>	BLACK FOREST FIRE PROTECTION DISTRICT (719) 650-2276

INDEX OF SHEETS	
SHEET NUMBER	SHEET DESCRIPTION
C1	COVER
C2	NOTES
C3	GENERAL NOTES AND ROADWAY SECTIONS
C4	ROADWAY KEY MAP SHEET
C5	PLAN AND PROFILE
C6	STORM PLAN AND PROFILE
C7	DETENTION POND STRUCTURE AND EMERGENCY OVERFLOW SECTION

### CONSTRUCTION DRAWINGS

#### DESIGN ENGINEER'S STATEMENT:

THESE DETAILED PLANS AND SPECIFICATIONS WERE PREPARED UNDER MY DIRECTION AND SUPERVISION. SAID PLANS AND SPECIFICATIONS HAVE BEEN PREPARED ACCORDING TO THE CRITERIA ESTABLISHED BY THE COUNTY FOR DETAILED ROADWAY, DRAINAGE, GRADING AND EROSION CONTROL PLANS AND SPECIFICATIONS, AND SAID PLANS AND SPECIFICATIONS ARE IN CONFORMITY WITH APPLICABLE MASTER DRAINAGE PLANS AND MASTER TRANSPORTATION PLANS. SAID PLANS AND SPECIFICATIONS MEET THE PURPOSES FOR WHICH THE PARTICULAR ROADWAY AND DRAINAGE FACILITIES ARE DESIGNED AND ARE CORRECT TO THE BEST OF MY KNOWLEDGE AND BELIEF. I ACCEPT RESPONSIBILITY FOR ANY LIABILITY CAUSED BY ANY NEGLIGENT ACTS, ERRORS OR OMISSIONS ON MY PART IN PREPARATION OF THESE DETAILED PLANS AND SPECIFICATIONS.

PHILLIP SHAY MILES, P.E. #40462      DATE

#### OWNER/DEVELOPER'S STATEMENT:

I, THE OWNER/DEVELOPER HAVE READ AND WILL COMPLY WITH ALL OF THE REQUIREMENTS SPECIFIED IN THESE DETAILED PLANS AND SPECIFICATIONS.

SHAY MILES      DATE  
15630 FOX CREEK LANE  
COLORADO SPRINGS, CO 80908

#### EL PASO COUNTY:

COUNTY PLAN REVIEW IS PROVIDED ONLY FOR GENERAL CONFORMANCE WITH COUNTY DESIGN CRITERIA. THE COUNTY IS NOT RESPONSIBLE FOR THE ACCURACY AND ADEQUACY OF THE DESIGN, DIMENSIONS, AND/OR ELEVATIONS WHICH SHALL BE CONFIRMED AT THE JOB SITE. THE COUNTY THROUGH THE APPROVAL OF THIS DOCUMENT ASSUMES NO RESPONSIBILITY FOR COMPLETENESS AND/OR ACCURACY OF THIS DOCUMENT.

FILED IN ACCORDANCE WITH THE REQUIREMENTS OF THE EL PASO COUNTY LAND DEVELOPMENT CODE, DRAINAGE CRITERIA MANUAL, VOLUMES 1 AND 2, AND ENGINEERING CRITERIA MANUAL AS AMENDED.

IN ACCORDANCE WITH ECM SECTION 1.12, THESE CONSTRUCTION DOCUMENTS WILL BE VALID FOR CONSTRUCTION FOR A PERIOD OF 2 YEARS FROM THE DATE SIGNED BY THE EL PASO COUNTY ENGINEER. IF CONSTRUCTION HAS NOT STARTED WITHIN THOSE 2 YEARS, THE PLANS WILL NEED TO BE RESUBMITTED FOR APPROVAL, INCLUDING PAYMENT OF REVIEW FEES AT THE PLANNING AND COMMUNITY DEVELOPMENT DIRECTORS DISCRETION.

JENNIFER IRVINE, P.E.      DATE  
COUNTY ENGINEER / ECM  
ADMINISTRATOR

NOTE: NOTWITHSTANDING ANYTHING DEPICTED IN THESE PLANS IN WORDS OR GRAPHIC REPRESENTATION, ALL DESIGN AND CONSTRUCTION RELATED TO ROADS, STORM DRAINAGE AND EROSION CONTROL SHALL CONFORM TO THE STANDARDS AND REQUIREMENTS OF THE MOST RECENT VERSION OF THE RELEVANT ADOPTED EL PASO COUNTY STANDARDS, INCLUDING THE LAND DEVELOPMENT CODE, THE ENGINEERING CRITERIA MANUAL, THE DRAINAGE CRITERIA MANUAL, AND THE DRAINAGE CRITERIA MANUAL VOLUME 2. ANY DEVIATIONS FROM REGULATIONS AND STANDARDS MUST BE REQUESTED AND APPROVED IN WRITING TO BE ACCEPTABLE.

BASIS OF BEARINGS:  
AS MONUMENTED AND SHOWN, AND WAS ASSUMED 500°12'10"E.

BENCHMARK:  
THE MONUMENT AT THE NORTHWEST PROPERTY CORNER, HAVING AN ELEVATION OF 7441.73'. DATUM IS NAVD '88

Add "PCD File No. SF2239"



ISSUED	
REVISIONS	

TERRA RIDGE NORTH  
15630 FOX CREEK LANE  
COLORADO SPRINGS, COLORADO

EL PASO COUNTY DEVELOPMENT  
REPLAT TERRA RIDGE LOTS 5 & 6 W/ 11 LOTS IN  
TERRA RIDGE NORTH  
COVER SHEET

C1  
SHEET NO.

**PROJECT GENERAL NOTES**

1. ALL WORK SHALL BE DONE IN ACCORDANCE WITH THE EL PASO COUNTY ENGINEERING CRITERIA MANUAL, REVISED 12-13-2016 AND CDOT STANDARD SPECIFICATIONS, LATEST REVISION.
2. IT SHALL BE THE CONTRACTOR'S RESPONSIBILITY TO ENSURE THAT ALL WORK IS PERFORMED IN ACCORDANCE WITH APPLICABLE STANDARDS AND REGULATIONS AS SET FORTH BY THE OCCUPATIONAL SAFETY AND HEALTH ADMINISTRATION (O.S.H.A.).
3. NO FIELD CHANGES SHALL BE MADE WITHOUT PRIOR WRITTEN APPROVAL OF THE FIELD ENGINEER.
4. UTILITY LINES AS SHOWN ON THE PLAN SHEETS ARE PLOTTED FROM THE BEST AVAILABLE INFORMATION. THE CONTRACTOR SHALL BE RESPONSIBLE FOR THE VERIFICATION AND PROTECTION OF ALL UTILITIES IN PLACE.
5. THE CONTRACTOR SHALL CONTACT THE UTILITY NOTIFICATION CENTER OF COLORADO AT 1-800-922-1987 3 BUSINESS DAYS IN ADVANCE OF ANY EXCAVATION OR GRADING.
6. ALL WORK SHALL BE DONE TO THE LINES, GRADES, SECTIONS, AND ELEVATIONS SHOWN ON THE PLANS UNLESS OTHERWISE NOTED OR APPROVED BY THE FIELD ENGINEER.
7. ALL MATERIALS AND WORKMANSHIP SHALL BE SUBJECT TO INSPECTION AND APPROVAL BY EL PASO COUNTY AND THE FIELD ENGINEER.
8. THE CONTRACTOR SHALL LIMIT CONSTRUCTION ACTIVITIES TO THOSE AREAS WITHIN THE LIMITS OF DISTURBANCE AND/OR TO OF SLOPE AS SHOWN ON THE PLANS. ANY DISTURBANCE BEYOND THESE LIMITS SHALL BE RESTORED TO ORIGINAL CONDITIONS BY THE CONTRACTOR AT HIS SLASH HER OWN EXPENSE.
9. WHERE PAVEMENT IS TO ABUT EXISTING PAVEMENT, THE EXISTING PAVEMENT SHALL BE REMOVED TO A NEAT VERTICAL LINE BY FULL DEPTH SAWING. SAWING WILL NOT BE PAID FOR SEPARATELY BUT SHALL BE INCIDENTAL TO PAVING OPERATION. THE CONTRACTOR WILL BE REQUIRED TO PAINT THE EDGE OF CUT PAVEMENT WITH DILUTED EMULSIFIED ASPHALT (SLOW SETTING) PRIOR TO PAVING OPERATIONS. VERTICAL EDGES SHALL NOT REMAIN OVERNIGHT. DILUTED EMULSIFIED ASPHALT FOUR TACK COAT SHALL CONSIST OF ONE PART EMULSIFIED ASPHALT AND ONE PART WATER.
10. WATER SHALL BE USED AS A DUST PALLIATIVE WHERE REQUIRED. LOCATIONS SHALL BE AS ORDERED. THE COST OF WATER SHALL BE INCIDENTAL TO OTHER BID ITEMS.
11. THE CONTRACTOR SHALL HAVE A COPY OF ALL APPLICABLE STANDARDS AND PLANS ON SITE FOR THE DURATION OF THE PROJECT.
12. ANY LAYER OF BITUMINISED PAVEMENT THAT IS TO HAVE SUCCEEDING LAYER PLACED THERE ON SHALL BE COMPLETED FULL WIDTH BEFORE SUCCEEDING LAYER IS PLACED.
13. BEFORE PLACEMENT OF THE TACK COAT, THE CONTRACTOR SHALL CLEAN THE PRESENT ROADWAY AS DIRECTED. CLEANING WILL NOT BE PAID FOR SEPARATELY BUT SHALL BE INCLUDED IN THE COST OF THE PROJECT.
14. A TACK COAT OF EMULSIFIED ASPHALT (SLOW SETTING) IS TO BE APPLIED BETWEEN PAVEMENT COURSES TO IMPROVE BOND. DILUTED EMULSIFIED ASPHALT FOR TACK COAT SHALL CONSIST OF 1 PART EMULSIFIED ASPHALT AND 1 PART WATER.
15. EXISTING CONTOUR DATA PROVIDED BY OWNER CONSISTS OF AERIAL TOPOGRAPHIC SURVEY DATA PROVIDED BY LODESTAR ENGINEERING, LLC.
16. STATIONING IS AT CENTER LINE UNLESS OTHERWISE NOTED. ALL ELEVATIONS ARE AT EDGE OF ASPHALT (EOA) UNLESS OTHERWISE NOTED. ALL DIMENSIONS ARE FROM EDGE OF ASPHALT TO EDGE OF ASPHALT UNLESS OTHERWISE NOTED.
17. PROPOSED CONTOURS SHOWN ARE TO FINISH GRADE.
18. CONTRACTOR SHALL REMOVE AND DISPOSE OF ALL EXISTING STRUCTURES, DEBRIS, WASTE AND OTHER UNSUITABLE FILL MATERIAL FOUND WITHIN THE LIMITS OF EXCAVATION.
19. MATCH INTO EXISTING GRADES AT 3:1 MAX CUT AND FILL SLOPES.
20. REVEGETATION OF ALL DISTURBED AREAS SHALL BE DONE WITH SPECIFIED SEED MIX WITHIN 60 DAYS AFTER FINE GRADING IS COMPLETE.
21. EROSION CONTROL SHALL CONSIST OF SILT FENCE AND HAY BALES AS SHOWN ON THE DRAWING AND TOPSOIL WAS GRASS SEED, WHICH SHALL BE WATERED UNTIL VEGETATION HAS BEEN REESTABLISHED.
22. THE EROSION CONTROL MEASURES OUTLINED ON THIS PLAN ARE THE RESPONSIBILITY OF THE DEVELOPER TO MONITOR AN REPLACE, RE GRADE, AND REBUILD AS NECESSARY UNTIL VEGETATION IS REESTABLISHED.
23. EROSION CONTROL MEASURES SHALL BE IMPLEMENTED IN A MANNER THAT WILL PROTECT ADJACENT PROPERTIES IN PUBLIC FACILITIES FROM THE ADVERSE EFFECTS OF EROSION AND SEDIMENT AS A RESULT OF CONSTRUCTION IN EARTHWORK ACTIVITIES WITHIN THE PROJECT SITE.
24. ADDITIONAL EROSION CONTROL MEASURES MAY BE REQUIRED AS DETERMINED BY SITE CONDITIONS.
25. THE CONTRACTOR WILL TAKE THE NECESSARY PRECAUTIONS TO PROTECT EXISTING UTILITIES FROM DAMAGE DUE TO THIS OPERATION. ANY DAMAGE TO THE UTILITIES WILL BE REPAIRED AT THE CONTRACTOR'S EXPENSE, AND ANY SERVICE DISRUPTION WILL BE SETTLED BY THE CONTRACTOR.
26. ALL BACKFILL, SUBBASE, AND OR BASE COURSE MATERIALS SHALL BE COMPACTED PER EL PASO COUNTY AND CDOT STANDARDS AND SPECIFICATIONS.
27. ALL FINISHED GRADES SHALL HAVE A MINIMUM OF 1.0% SLOPE TO PROVIDE POSITIVE DRAINAGE.
28. WHERE PROPOSED SLOPES CONFLICT WITH PROPOSED SPOT ELEVATIONS, SPOT ELEVATIONS SHALL GOVERN.
29. CONTRACTOR SHALL OBTAIN ALL REQUIRED PERMITS PRIOR TO BEGINNING WORK.
30. ELECTRONIC FILE OF SITE DRAWING IS AVAILABLE FROM ENGINEER FOR CONSTRUCTION STAKING PURPOSES.

**BENCHMARK AND SURVEY CONTROL**

1. THE CONTRACTOR SHALL BE RESPONSIBLE FOR CONSTRUCTION STAKING OF BOTH HORIZONTAL AND VERTICAL LAYOUT ON THIS PROJECT. COORDINATES ARE REFERENCED IN THE COORDINATE LIST SHOWN ON THESE PLANS THE CONTRACTOR SHALL COORDINATE WITH THE PROJECT ENGINEER FOR INTERPRETATION AND INFORMATION IN STAKING OF THE PROJECT BEFORE CONSTRUCTION.

**CONSTRUCTION NOTES**

1. ALL DRAINAGE AND ROADWAY CONSTRUCTION SHALL MEET THE STANDARDS AND SPECIFICATIONS OF THE CITY OF COLORADO SPRINGS SLASH EL PASO COUNTY DRAINAGE CRITERIA MANUAL, VOLUMES 1 AND 2, AND THE EL PASO COUNTY ENGINEERING CRITERIA MANUAL.
2. CONTRACTOR SHALL BE RESPONSIBLE FOR THE NOTIFICATION AND FIELD NOTIFICATION OF ALL EXISTING UTILITIES, WEATHER SHOWN ON THE PLANS OR NOT, BEFORE BEGINNING CONSTRUCTION. LOCATION OF EXISTING UTILITIES SHALL BE VERIFIED BY THE CONTRACTOR PRIOR TO CONSTRUCTION. CALL 811 TO CONTACT THE UTILITY NOTIFICATION CENTER OF COLORADO (UNCC).
3. CONTRACTOR SHALL KEEP A COPY OF THESE APPROVED PLANS, THE GRADING AND EROSION CONTROL PLAN, THE STORMWATER MANAGEMENT PLAN, THE SOILS AND GEOTECHNICAL REPORT, AND THE APPROPRIATE DESIGN AND CONSTRUCTION STANDARDS AND SPECIFICATIONS AT THE JOB SITE AT ALL TIMES, INCLUDING THE FOLLOWING:
  - a. EL PASO COUNTY ENGINEERING CRITERIA MANUAL (ECM)
  - b. EL PASO COUNTY DRAINAGE CRITERIA MANUAL, VOLUMES 1 AND 2
  - c. COLORADO DEPARTMENT OF TRANSPORTATION STANDARDS SPECIFICATIONS FOR ROAD AND BRIDGE CONSTRUCTION
  - d. CDOT M&S STANDARDS
4. NOTWITHSTANDING ANYTHING DEPICTED IN THESE PLANS IN WORDS OR GRAPHIC PRESENTATION, ALL DESIGN AND CONSTRUCTION RELATED TO ROADS, STORM DRAINAGE AND EROSION CONTROL SHALL CONFORM TO THE STANDARDS AND REQUIREMENTS OF THE MOST RECENT VERSION OF THE RELEVANT ADOPTED EL PASO COUNTY STANDARDS, INCLUDING THE LAND DEVELOPMENT CODE, THE ENGINEERING CRITERIA MANUAL, THE DRAINAGE CRITERIA MANUAL, AND THE DRAINAGE CRITERIA MANUAL VOLUME TO. ANY DEVIATIONS FROM REGULATIONS AND STANDARDS MUST BE REQUESTED, AND APPROVE, IN WRITING. ANY MODIFICATIONS NECESSARY TO MEET CRITERIA AFTER THE FACT WILL BE ENTIRELY TO THE DEVELOPER'S RESPONSIBILITY TO RECTIFY.
5. IT IS THE DESIGN ENGINEER'S RESPONSIBILITY TO ACCURATELY SHOW EXISTING CONDITIONS, BOTH ONSITE AND OFFSITE, ON THE CONSTRUCTION PLANS. ANY MODIFICATIONS NECESSARY DUE TO CONFLICTS, OMISSIONS, OR CHANGED CONDITIONS WILL BE ENTIRELY THE DEVELOPER'S RESPONSIBILITY TO RECTIFY.
6. CONTRACTOR SHALL SCHEDULE A PRE-CONSTRUCTION MEETING WITH EL PASO COUNTY PLANNING AND COMMUNITY DEVELOPMENT (PCD) - INSPECTIONS, PRIOR TO STARTING CONSTRUCTION.
7. IT IS THE CONTRACTOR'S RESPONSIBILITY TO UNDERSTAND THE REQUIREMENTS OF ALL JURISDICTIONAL AGENCIES AND TO OBTAIN ALL REQUIRED PERMITS, INCLUDING BUT NOT LIMITED TO EL PASO COUNTY EROSION AND STORMWATER QUALITY CONTROL PERMITS, REGIONAL BUILDING FLOODPLAIN DEVELOPMENT PERMIT, U.S. ARMY CORPS OF ENGINEERS NWP 29 RESIDENTIAL DEVELOPMENTS PERMIT, AND COUNTY AND STATE FUGITIVE DUST PERMITS.
8. CONTRACTORS SHALL NOT DEVIATE FROM THE PLANS WITHOUT FIRST OBTAINING WRITTEN APPROVAL FROM THE DESIGN ENGINEER AND PCD. CONTRACTOR SHALL NOTIFY THE DESIGN ENGINEER IMMEDIATELY UPON DISCOVERY OF ANY ERRORS OR INCONSISTENCIES.
9. ALL STORM DRAIN PIPE SHALL BE CLASSED III RCP UNLESS OTHERWISE NOTED AND APPROVED BY PCD.
10. CONTRACTOR SHALL COORDINATE GEOTECHNICAL TESTING PER ECM STANDARDS. PAYMENT DESIGN SHALL BE APPROVED BY EL PASO COUNTY PCD PRIOR TO PLACEMENT OF ASPHALT.
11. ALL CONSTRUCTION TRAFFIC MUST ENTER/EXIT THE SITE AT APPROVED CONSTRUCTION ACCESS POINTS.

Add the following to the EPC Standard Notes:

13. Signing and striping shall comply with El Paso County DOT and MUTCD criteria. [If applicable, additional signing and striping notes will be provided.]

14. Contractor shall obtain any permits required by El Paso County DOT, including Work Within the Right-of-Way and Special Transport permits.

15. The limits of construction shall remain within the property line unless otherwise noted. The owner/developer shall obtain written permission and easements, where required, from adjoining property owner(s) prior to any off-site disturbance, grading, or construction

**GENERAL LOT DRAINAGE NOTES**

1. FINAL LOT IN HOME SITE GRADING IS THE RESPONSIBILITY OF THE INDIVIDUAL LOT OWNERS AND BUILDERS.
2. INDIVIDUAL BUILDERS SHALL PROVIDE POSITIVE DRAINAGE AWAY FROM STRUCTURES AN ACCOUNT FOR POTENTIAL CROSS SLOT DRAINAGE IMPACTS WITHIN EACH LOT.
3. BUILDERS AND PROPERTY OWNERS SHALL IMPLEMENT AND MAINTAIN EROSION CONTROL BEST MANAGEMENT PRACTICES FOR PROTECTION OF DOWNSTREAM PROPERTIES AND FACILITIES INCLUDING PROTECTION OF EXISTING GRASS BUFFER STRIPS ALONG THE DOWNSTREAM PROPERTY BOUNDARIES.

update: "Lot"

**COUNTY SIGNING AND STRIPING NOTES:**

1. ALL SIGNS AND PAVEMENT MARKINGS SHALL BE IN COMPLIANCE WITH THE CURRENT MANUAL ON UNIFORM TRAFFIC CONTROL DEVICES (MUTCD).
2. REMOVAL OF EXISTING PAVEMENT MARKINGS SHALL BE ACCOMPLISHED BY A METHOD THAT DOES NOT MATERIALLY DAMAGE THE PAVEMENT. THE PAVEMENT MARKINGS SHALL BE REMOVED TO THE EXTENT THAT THEY WILL NOT BE VISIBLE UNDER DAY OR NIGHT CONDITIONS. AT NO TIME WILL IT BE ACCEPTABLE TO PAINT OVER EXISTING PAVEMENT MARKINGS.
3. ANY DEVIATION FROM THE STRIPING AND SIGNING PLAN SHALL BE APPROVED BY EL PASO COUNTY DEVELOPMENT SERVICES.
4. ALL SIGNS SHOWN ON THE SIDING AND STRIPING PLAN SHALL BE NEW SIGNS. EXISTING SIGNS MAY REMAIN OR BE REUSED IF THEY MEET CURRENT EL PASO COUNTY AND IMMUNE TCD STANDARDS.
5. STREET NAME AND REGULATORY STOP SIGNS SHALL BE ON THE SAME POST AT INTERSECTIONS.
6. ALL REMOVED SIGNS SHALL BE DISPOSED OF IN A PROPER MANNER BY THE CONTRACTOR.
7. ALL STREET NAME SIGN SHALL HAVE "D" SERIES LETTERS, WITH LOCAL ROADWAY SIGNS BEING 4" UPPER-LOWER CASE LETTERING ON 8" BLANK AND NON-LOCAL ROADWAY SIGNS BEING 6" LETTERING, UPPER-LOWER CASE ON 12" BLANK, WITH A WHITE BORDER THAT IS NOT RECESSED. MULTI-LANE ROADWAYS WITH SPEED LIMITS OF 40 MPH OR HIGHER SHALL HAVE 8 INCH UPPER-LOWER CASE LETTERING ON 18" BLANK WITH WHITE BORDER THAT IS NOT RECESSED. THE WIDTH OF THE NON-RECESSED WHITE BORDERS SHALL MATCH PAGE 255 OF THE 2012 MUTCD "STANDARD HIGHWAY SIGNS."
8. ALL TRAFFIC SIGNS SHALL HAVE A MINIMUM HIGH INTENSITY PRISMATIC GRADE SHEETING.
9. ALL LOCAL RESIDENTIAL STREET SIGNS SHALL BE MOUNTED ON A 1.75" X 1.75" SQUARE TUBE SIGNPOST AND STUB POST BASE. FOR OTHER APPLICATIONS, REFER TO THE CDOT STANDARDS S-614-8 REGARDING USE OF THE P2 TUBULAR STEEL POST SUBBASE DESIGN.
10. ALL SIGNS SHALL BE SINGLE SHEET ALUMINUM WITH 0.100" MINIMUM THICKNESS.
11. ALL LIMIT LINES/STOP LINES, CROSSWALK LINES, PAVEMENT LEGENDS AND ARROWS SHALL BE A MINIMUM 125 MIL THICKNESS PREFORMED THERMAL PLASTIC PAVEMENT MARKINGS WITH TAPERED LEADING EDGES PER CDOT STANDARD S-627-1. WORD AND SYMBOL MARKINGS SHALL BE THE NARROW TYPE. STOP BARS SHALL BE 24" WIDTH. CROSSWALK LINE SHALL BE 12" WIDE AND 8' LONG PER CDOT S-627-1.
12. ALL LONGITUDINAL LINES SHALL BE A MINIMUM 15 MIL THICKNESS EPOXY PAINT. ALL NON LOCAL RESIDENTIAL ROADWAYS SHALL INCLUDE BOTH RIGHT AND LEFT EDGE LINE STRIPING AND ANY ADDITIONAL STRIPING AS REQUIRED BY CDOT S-627-1 .
13. THE CONTRACTOR SHALL NOTIFY EL PASO COUNTY PLANNING AND COMMUNITY DEVELOPMENT SERVICES (719) 520-6819 PRIOR TO AND UPON COMPLETION OF SIGNING AND STRIPING.
14. THE CONTRACTOR SHALL OBTAIN A WORK IN THE RIGHT OF WAY PERMIT FROM THE EL PASO COUNTY DEPARTMENT OF TRANSPORTATION PRIOR TO ANY SIGNAGE FOR STRIPING WORK WITHIN AN EXISTING EL PASO COUNTY ROADWAY.

**DESIGN DATA**

ROAD CLASSIFICATION:	RURAL LOCAL RESIDENTIAL
DESIGN SPEED:	30 MPH
POSTED SPEED:	30 MPH
ROADWAY WIDTH (ASPHALT)	28' EOA-EOA
MIN HORIZONTAL RADIUS:	300'
MIN GRADE:	1.0%
MAX GRADE:	6.66%
MIN K-VALUE (CREST):	19
MIN K-VALUE (SAG):	37

Update to "EL"



ISSUED	
REVISIONS	

**TERRA RIDGE NORTH**  
15630 FOX CREEK LANE  
COLORADO SPRINGS, COLORADO


EL PASO COUNTY DEVELOPMENT  
REPLAT TERRA RIDGE LOTS 5 & 6 W/ 11 LOTS IN  
TERRA RIDGE NORTH

**NOTES**

**C2**  
SHEET NO.



Update to 10' or revise the plat to 10' for consistency

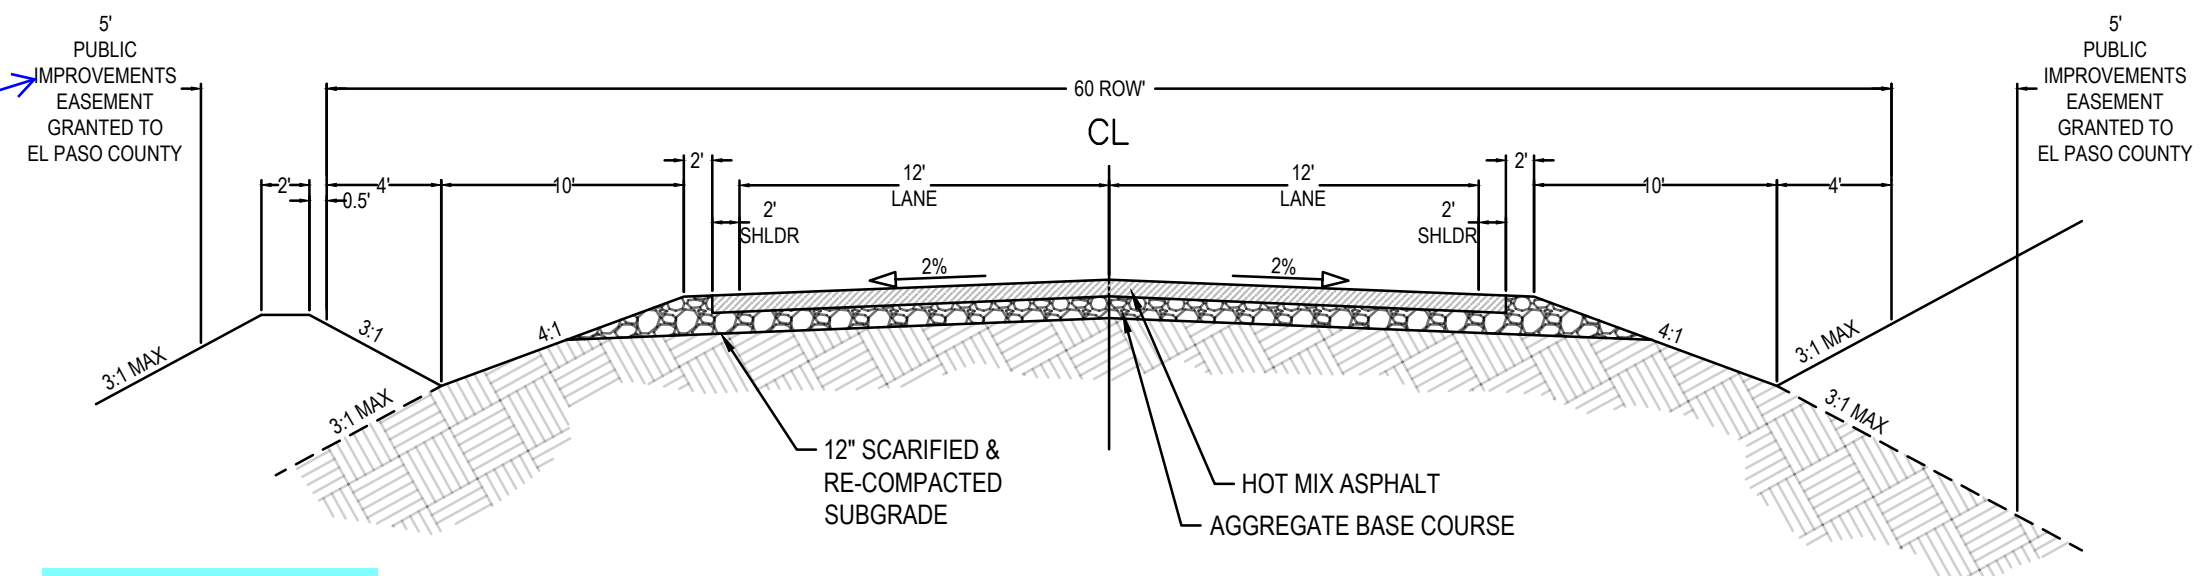


Delete note

NOTE: SUBGRADE UNDERCUT GRADING ONLY IS PERMITTED WITH THIS PREDEVELOPMENT CONSTRUCTION PLAN. ASPHALT AND AGGREGATE BASE COARSE SHALL NOT BE CONSTRUCTED WITH THE PREDEVELOPMENT GRADING.

RURAL LOCAL – PAVED  
TYPICAL SECTION  
SCALE N.T.S.


List proposed speed limit for road.

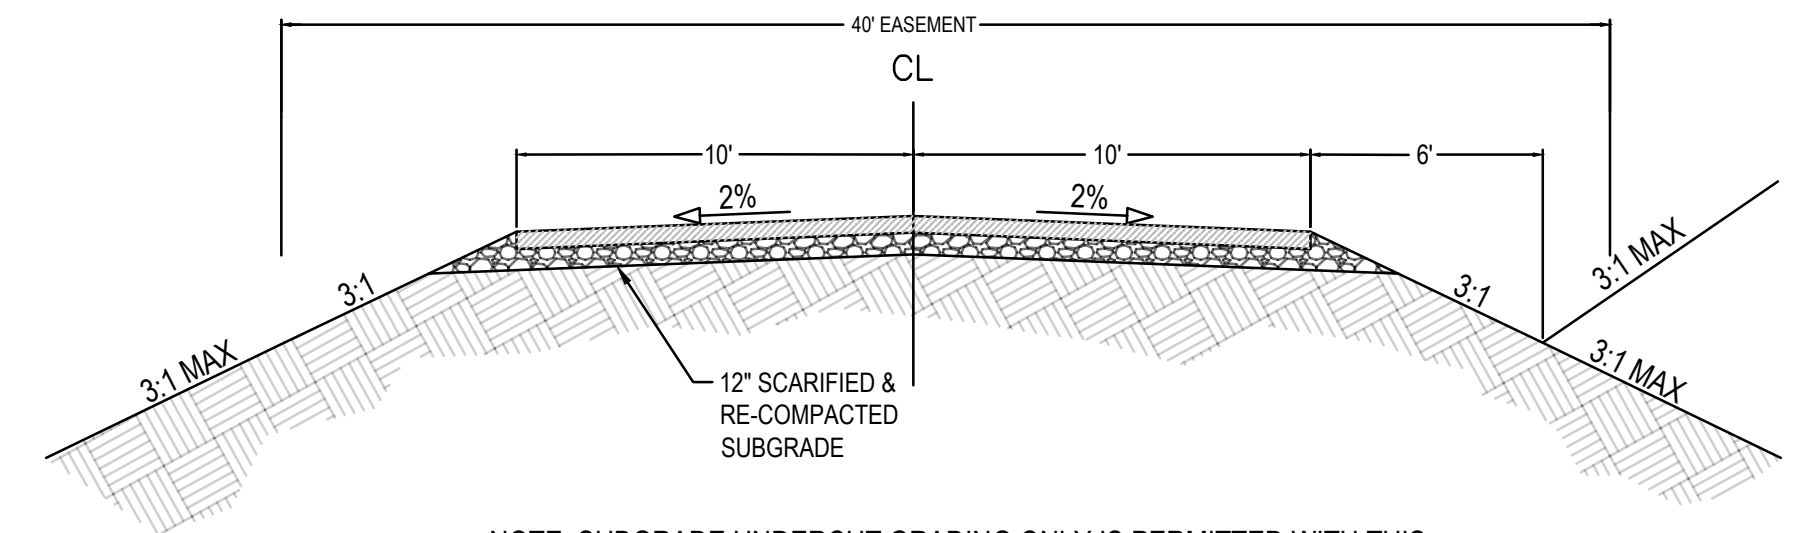

Delete note

NOTE: SUBGRADE UNDERCUT GRADING ONLY IS PERMITTED WITH THIS PREDEVELOPMENT CONSTRUCTION PLAN. ASPHALT AND AGGREGATE BASE COARSE SHALL NOT BE CONSTRUCTED WITH THE PREDEVELOPMENT GRADING.




PRIVATE DRIVEWAY – PAVED  
TYPICAL SECTION  
SCALE: NTS

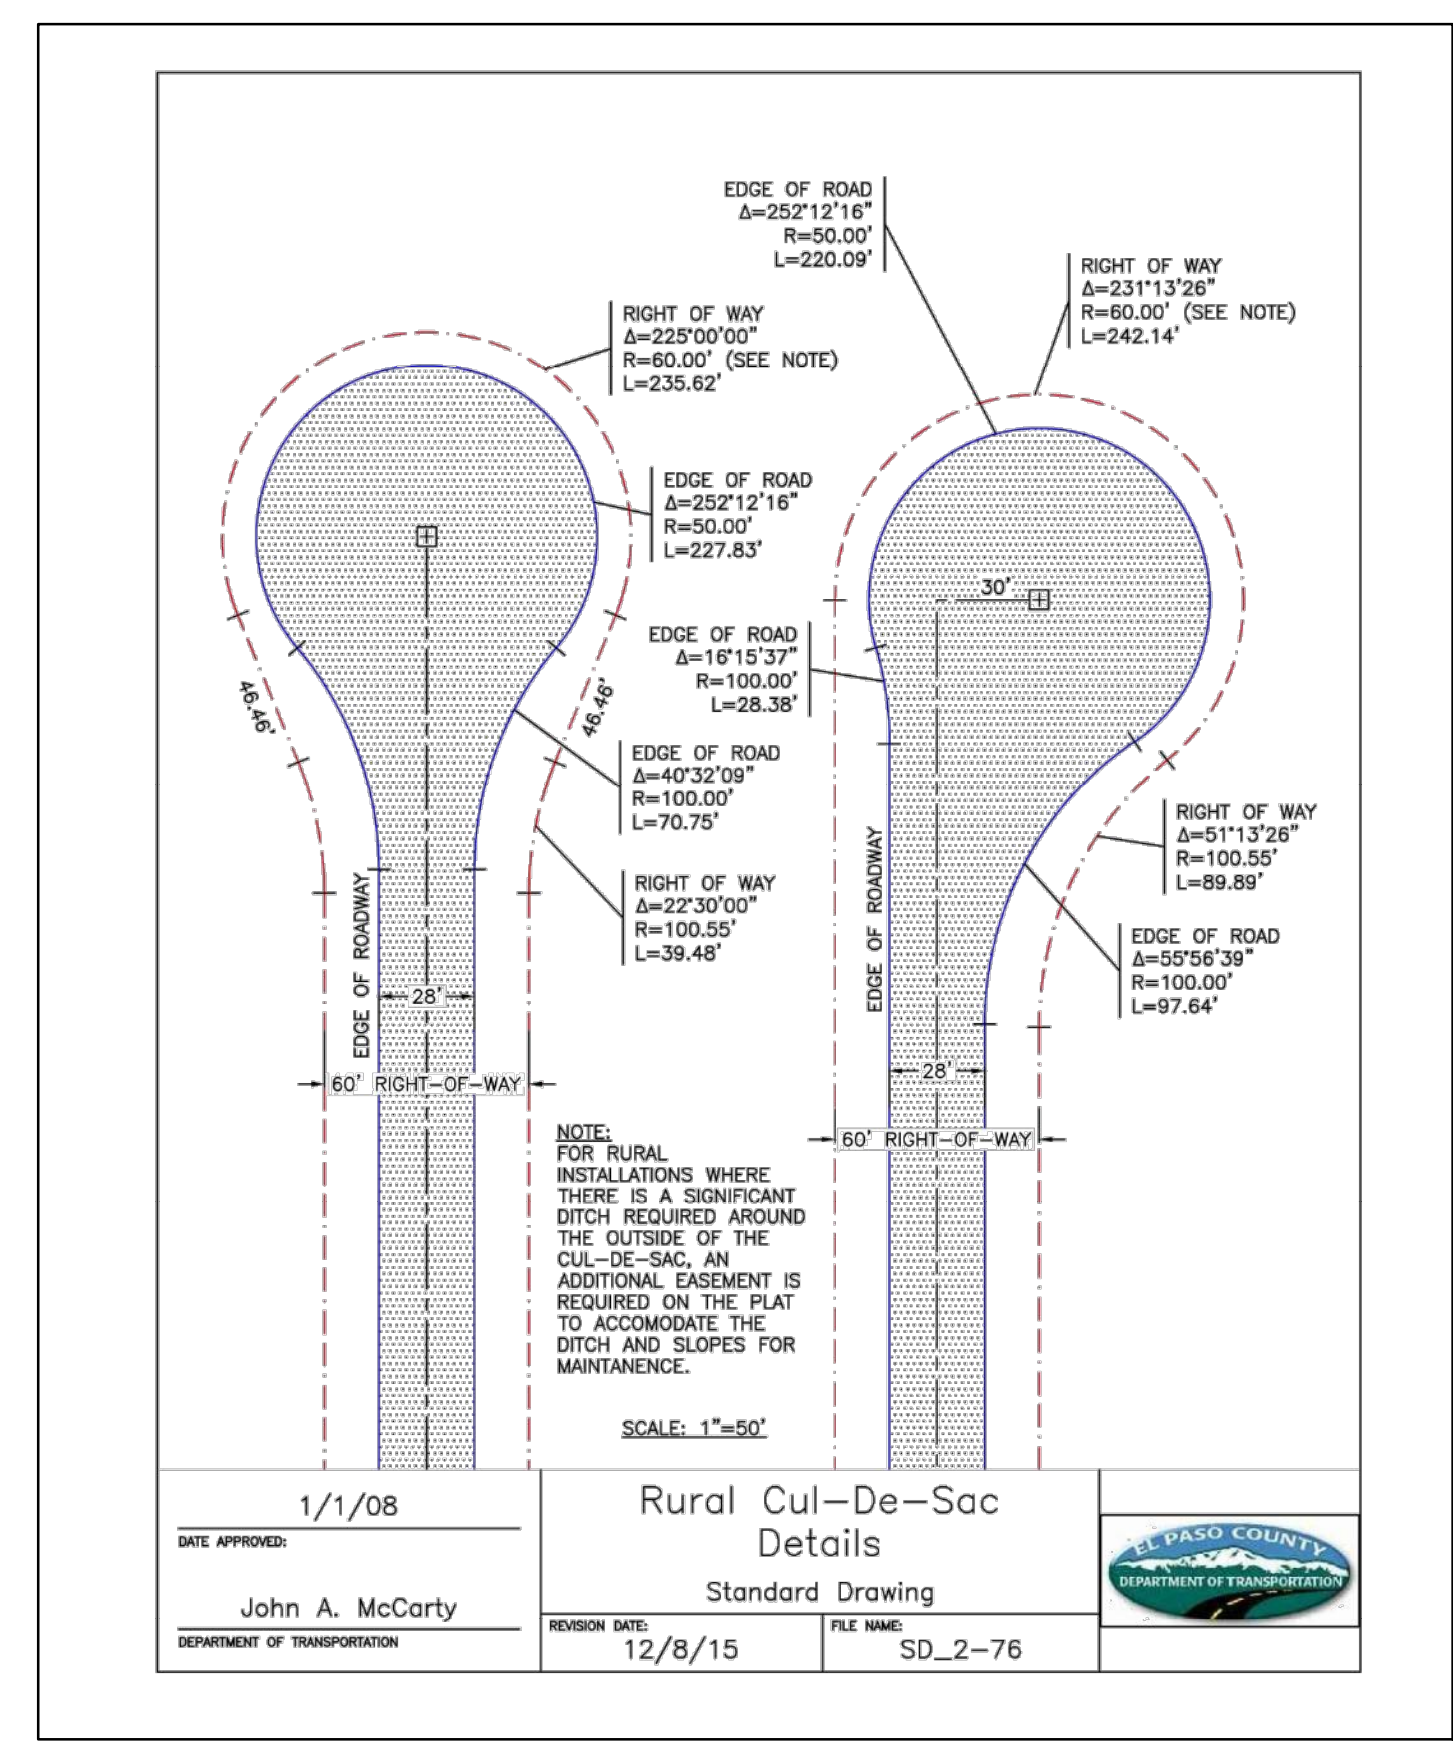

ISSUED	REVISIONS

TERRA RIDGE NORTH  
15630 FOX CREEK LANE  
COLORADO SPRINGS, COLORADO

EL PASO COUNTY DEVELOPMENT  
REPLAT TERRA RIDGE LOTS 5 & 6 W/ 11 LOTS IN  
TERRA RIDGE NORTH  
NOTES AND SECTIONS

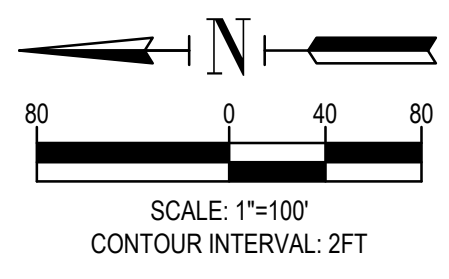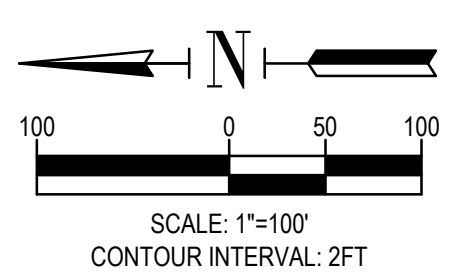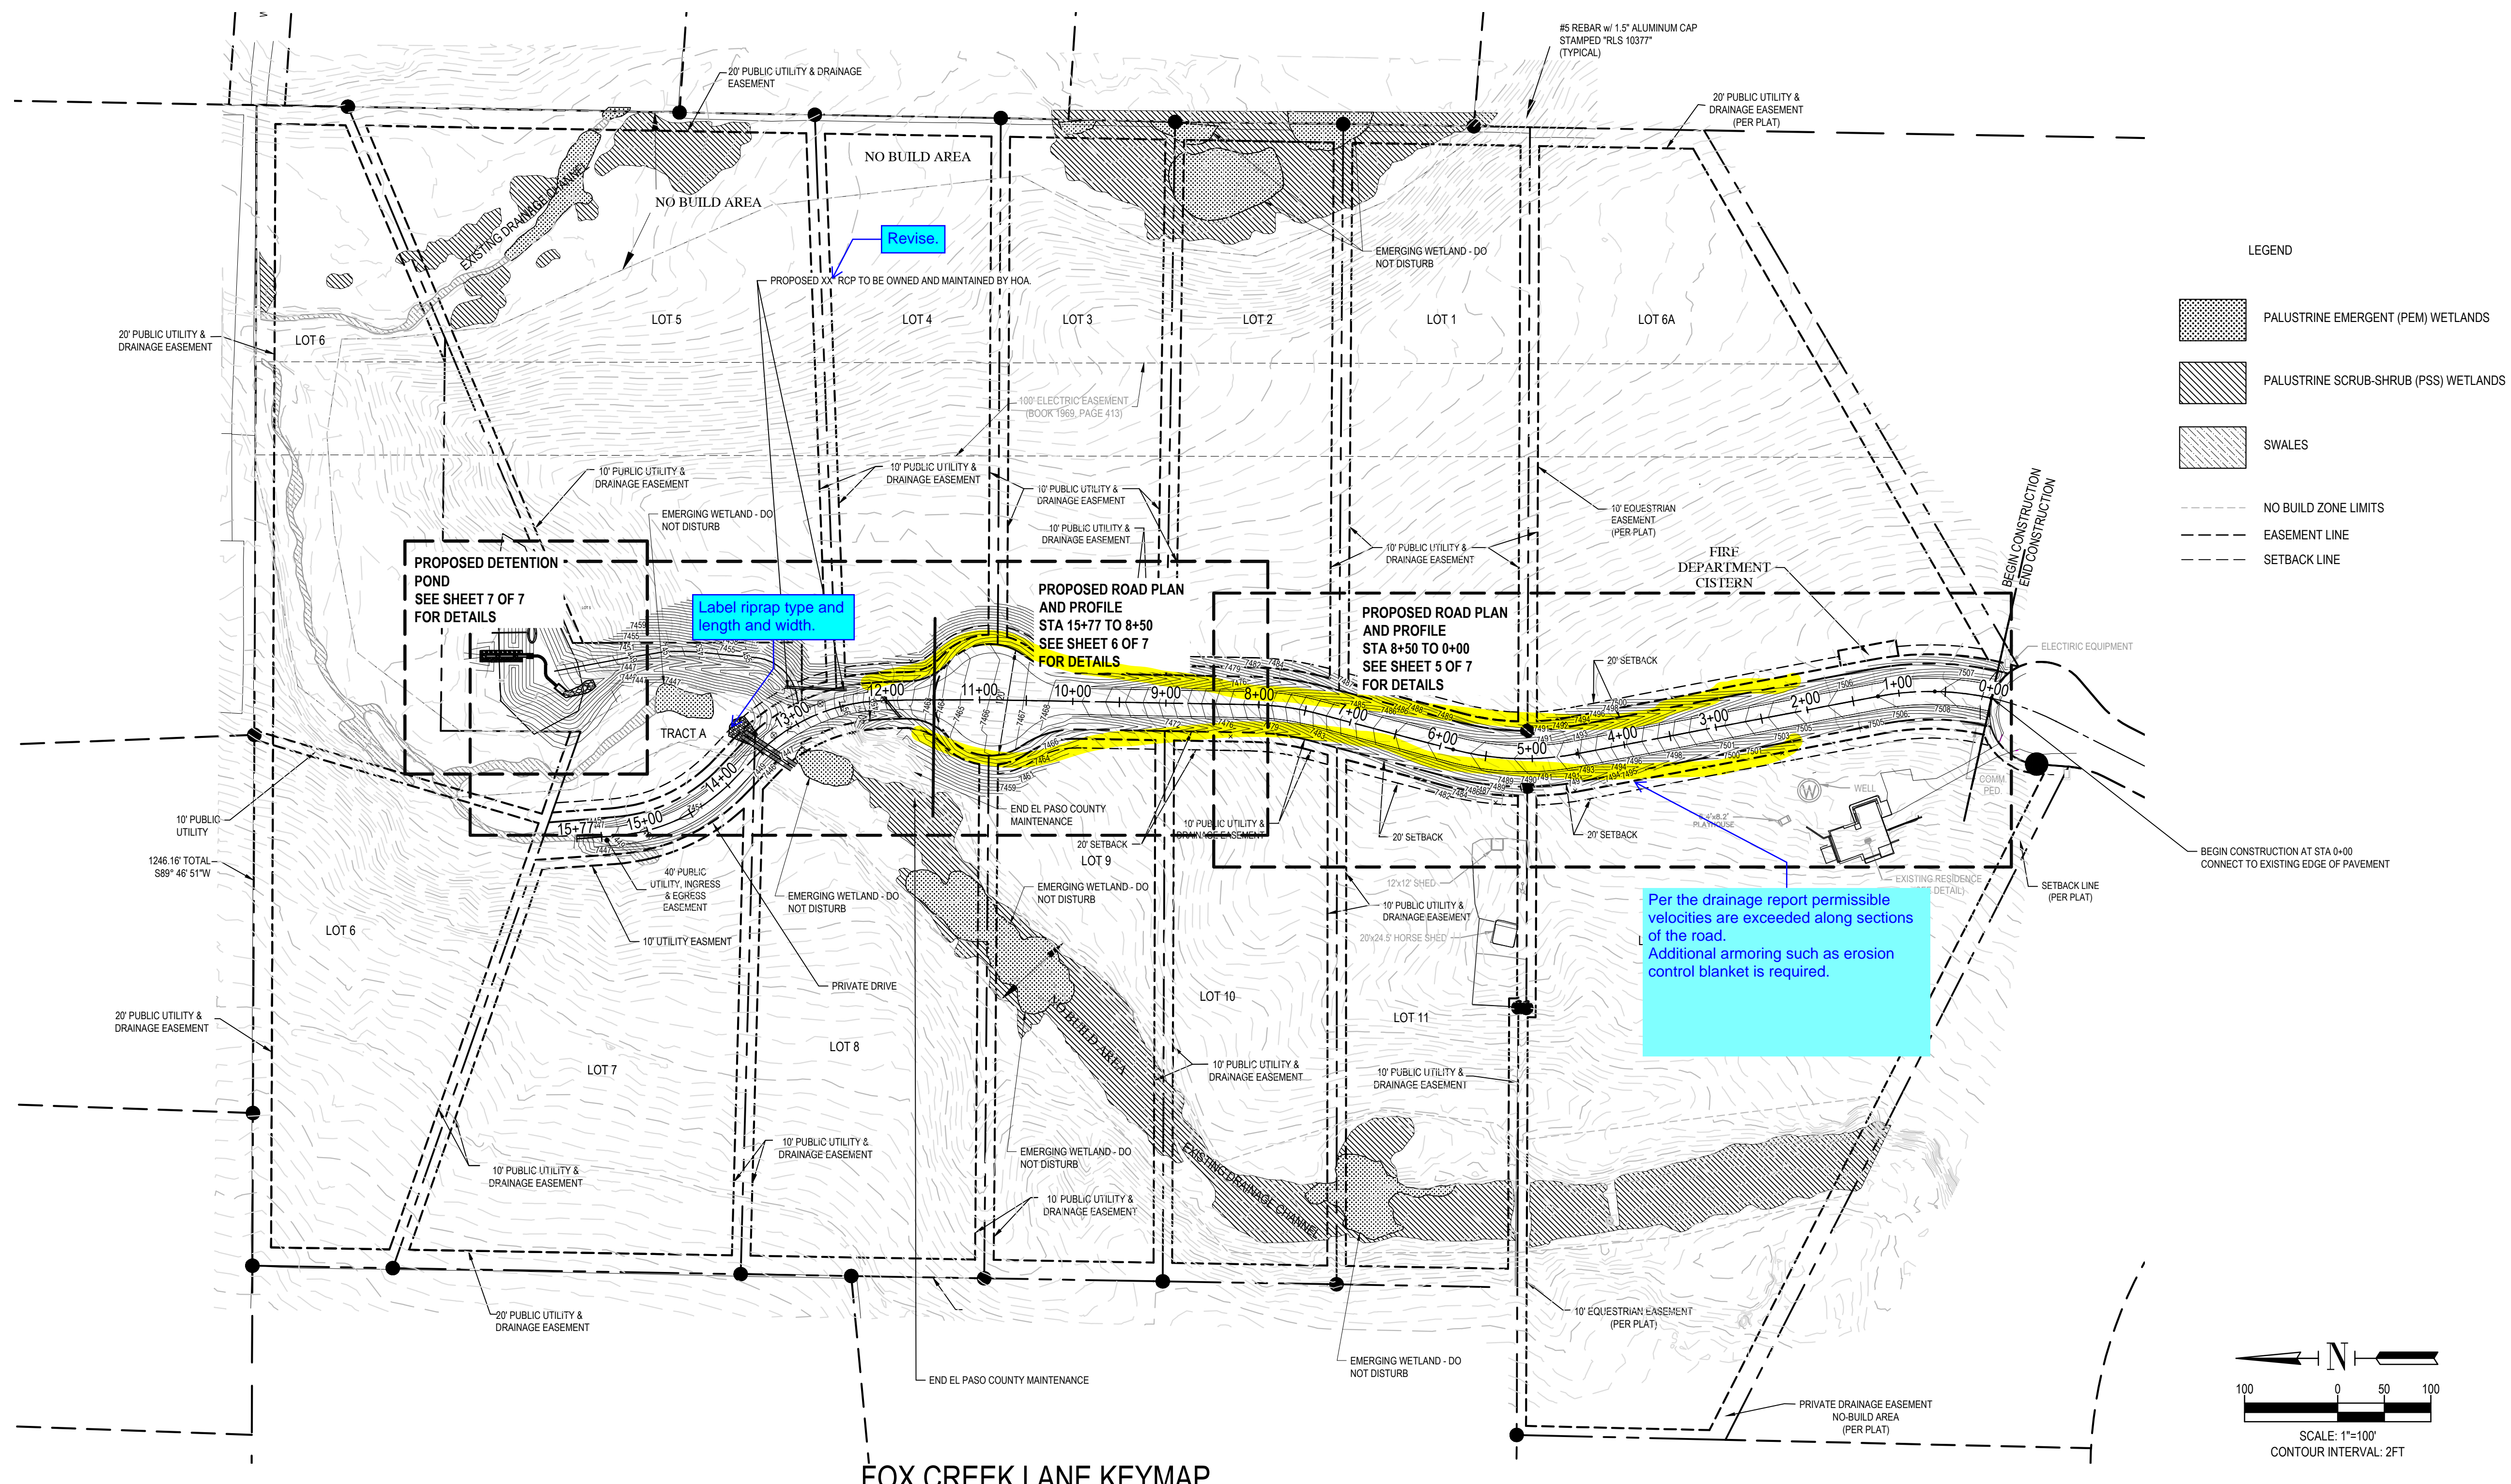


ISSUED	
REVISIONS	

**TERRA RIDGE NORTH**  
15630 FOX CREEK LANE  
COLORADO SPRINGS, COLORADO

EL PASO COUNTY DEVELOPMENT  
REPLAT TERRA RIDGE LOTS 5 & 6 W/ 11 LOTS IN  
TERRA RIDGE NORTH  
KEY MAP

**C4**  
SHEET NO.

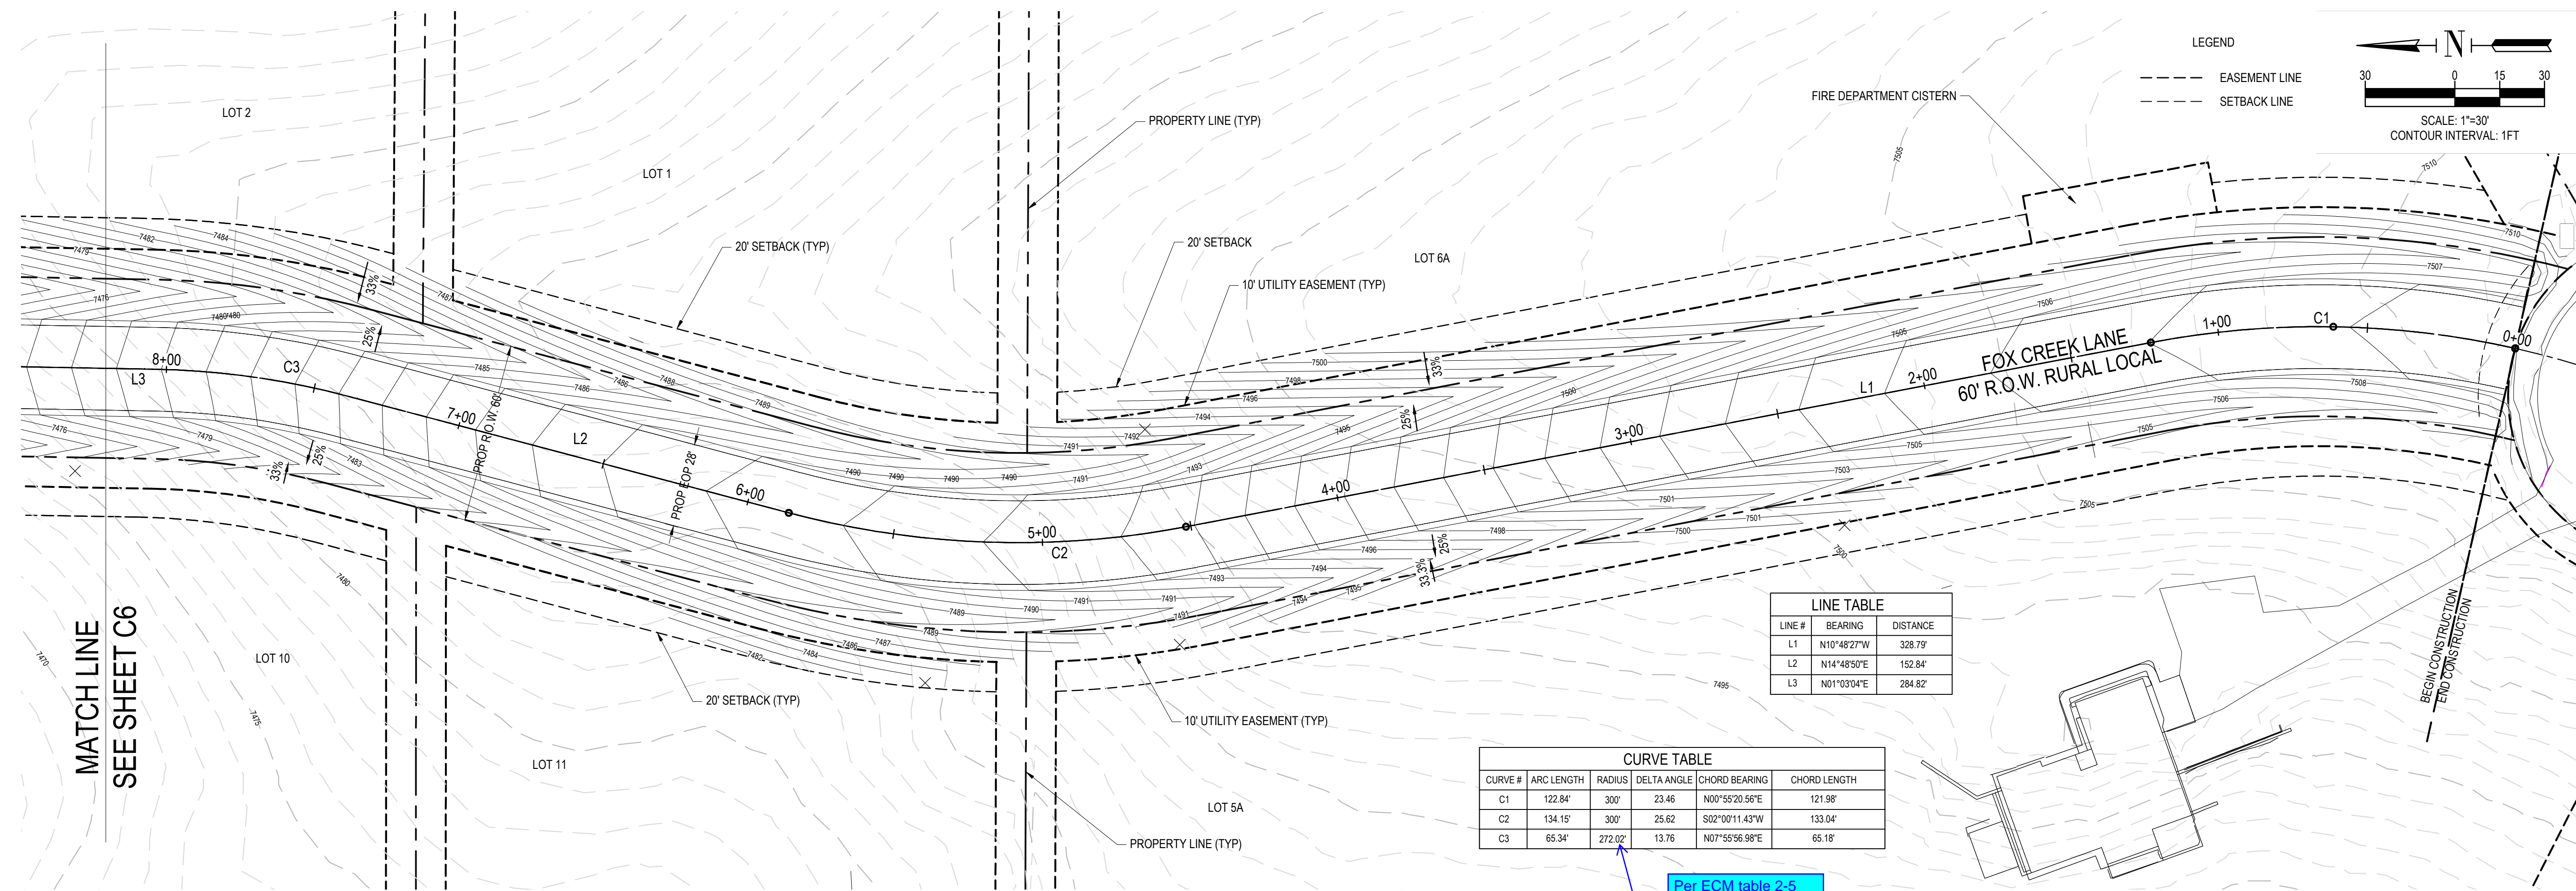


LINE #	BEARING	DISTANCE
L1	N10°48'27"W	328.79'
L2	N14°48'50"E	152.84'
L3	N01°03'04"E	284.82'

CURVE #	ARC LENGTH	RADIUS	DELTA ANGLE	CHORD BEARING	CHORD LENGTH
C1	122.84'	300'	23.46°	N00°55'20.56"E	121.98'
C2	134.15'	300'	25.62°	S02°00'11.43"W	133.04'
C3	65.34'	272.02'	13.76°	N07°55'56.98"E	65.18'

FOX CREEK LANE STATION 0+00 TO 8+00

Per ECM table 2-5 minimum curve radius for a rural local road is 300'. Revise to meet criteria.


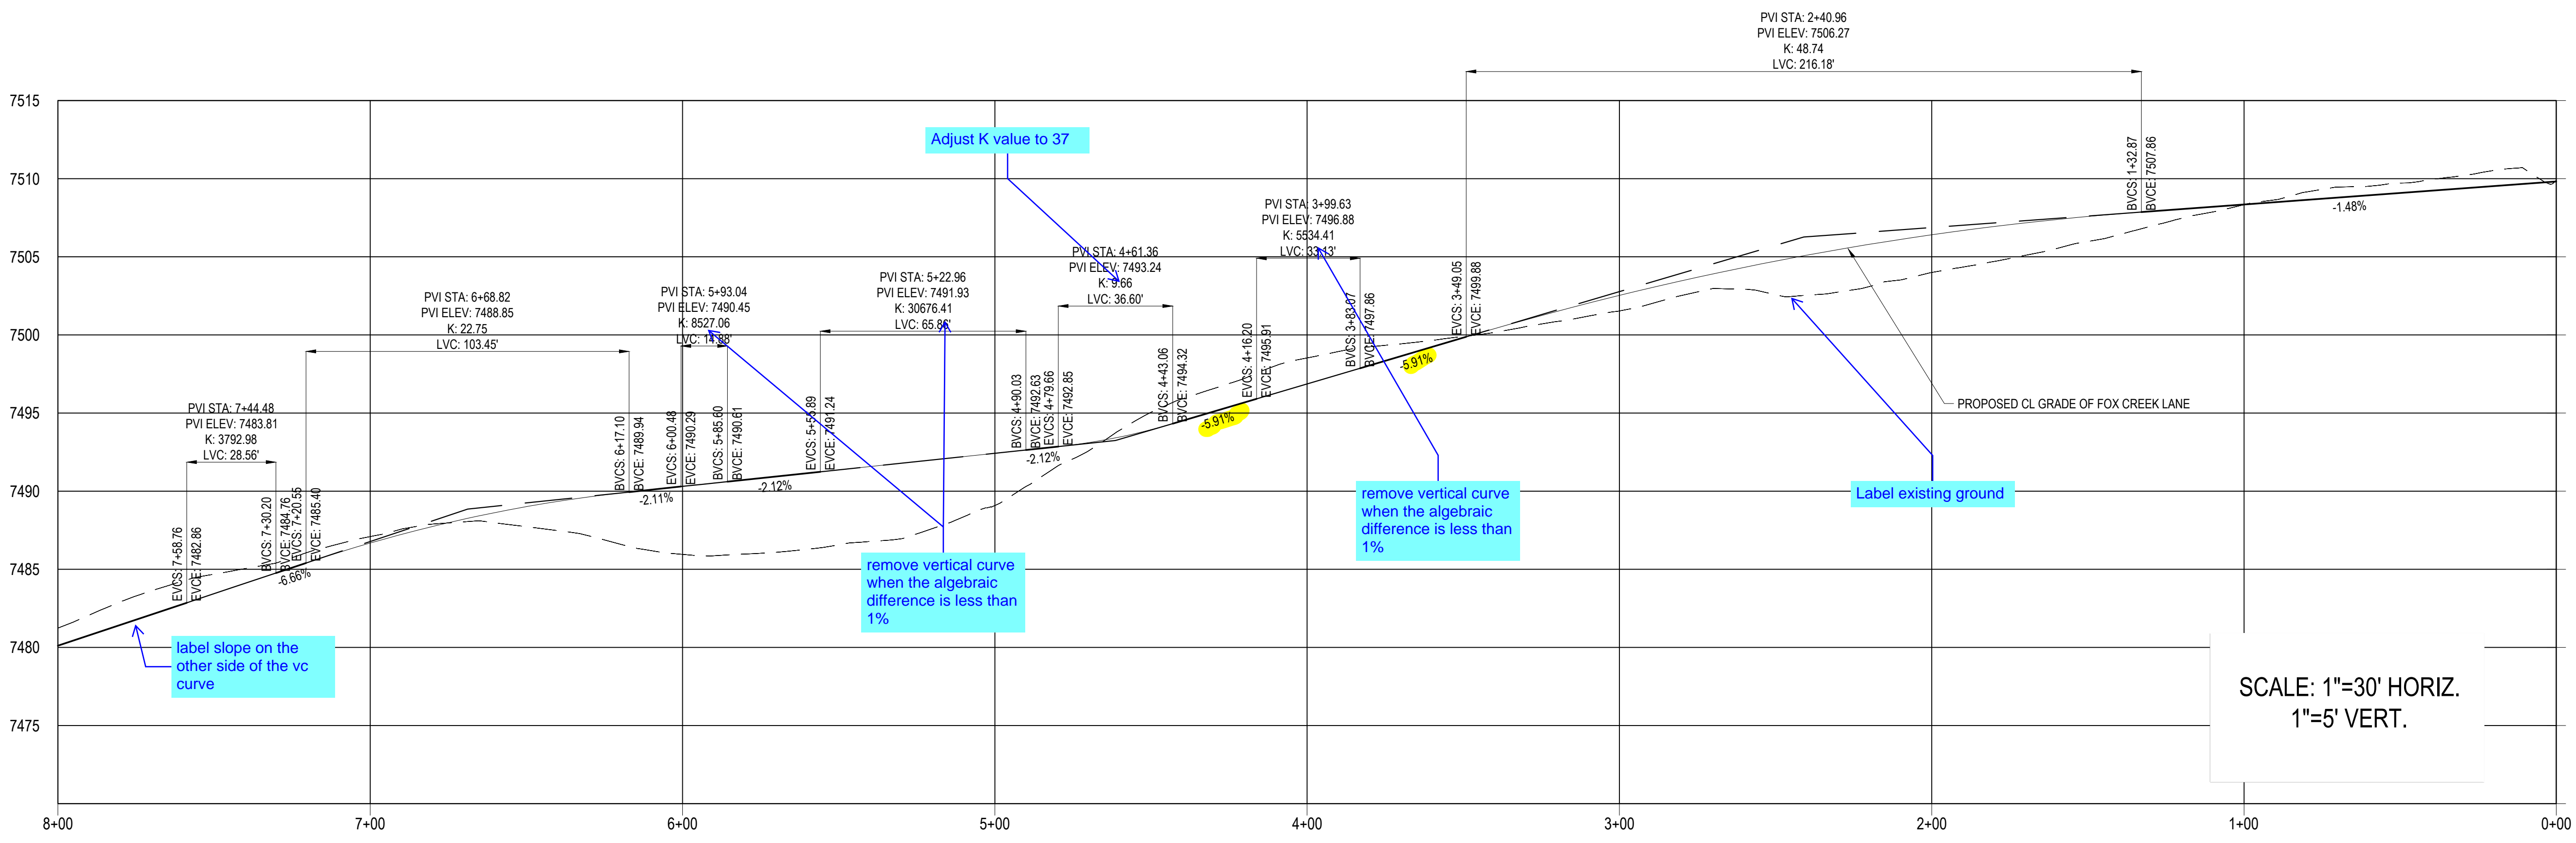


SCALE: 1"=30' HORIZ.  
1"=5' VERT.

ISSUED	REVISIONS

TERRA RIDGE NORTH  
15630 FOX CREEK LANE  
COLORADO SPRINGS, COLORADO

EL PASO COUNTY DEVELOPMENT  
REPLAT TERRA RIDGE LOTS 5 & 6 W/ 11 LOTS IN  
TERRA RIDGE NORTH  
PLAN AND PROFILE

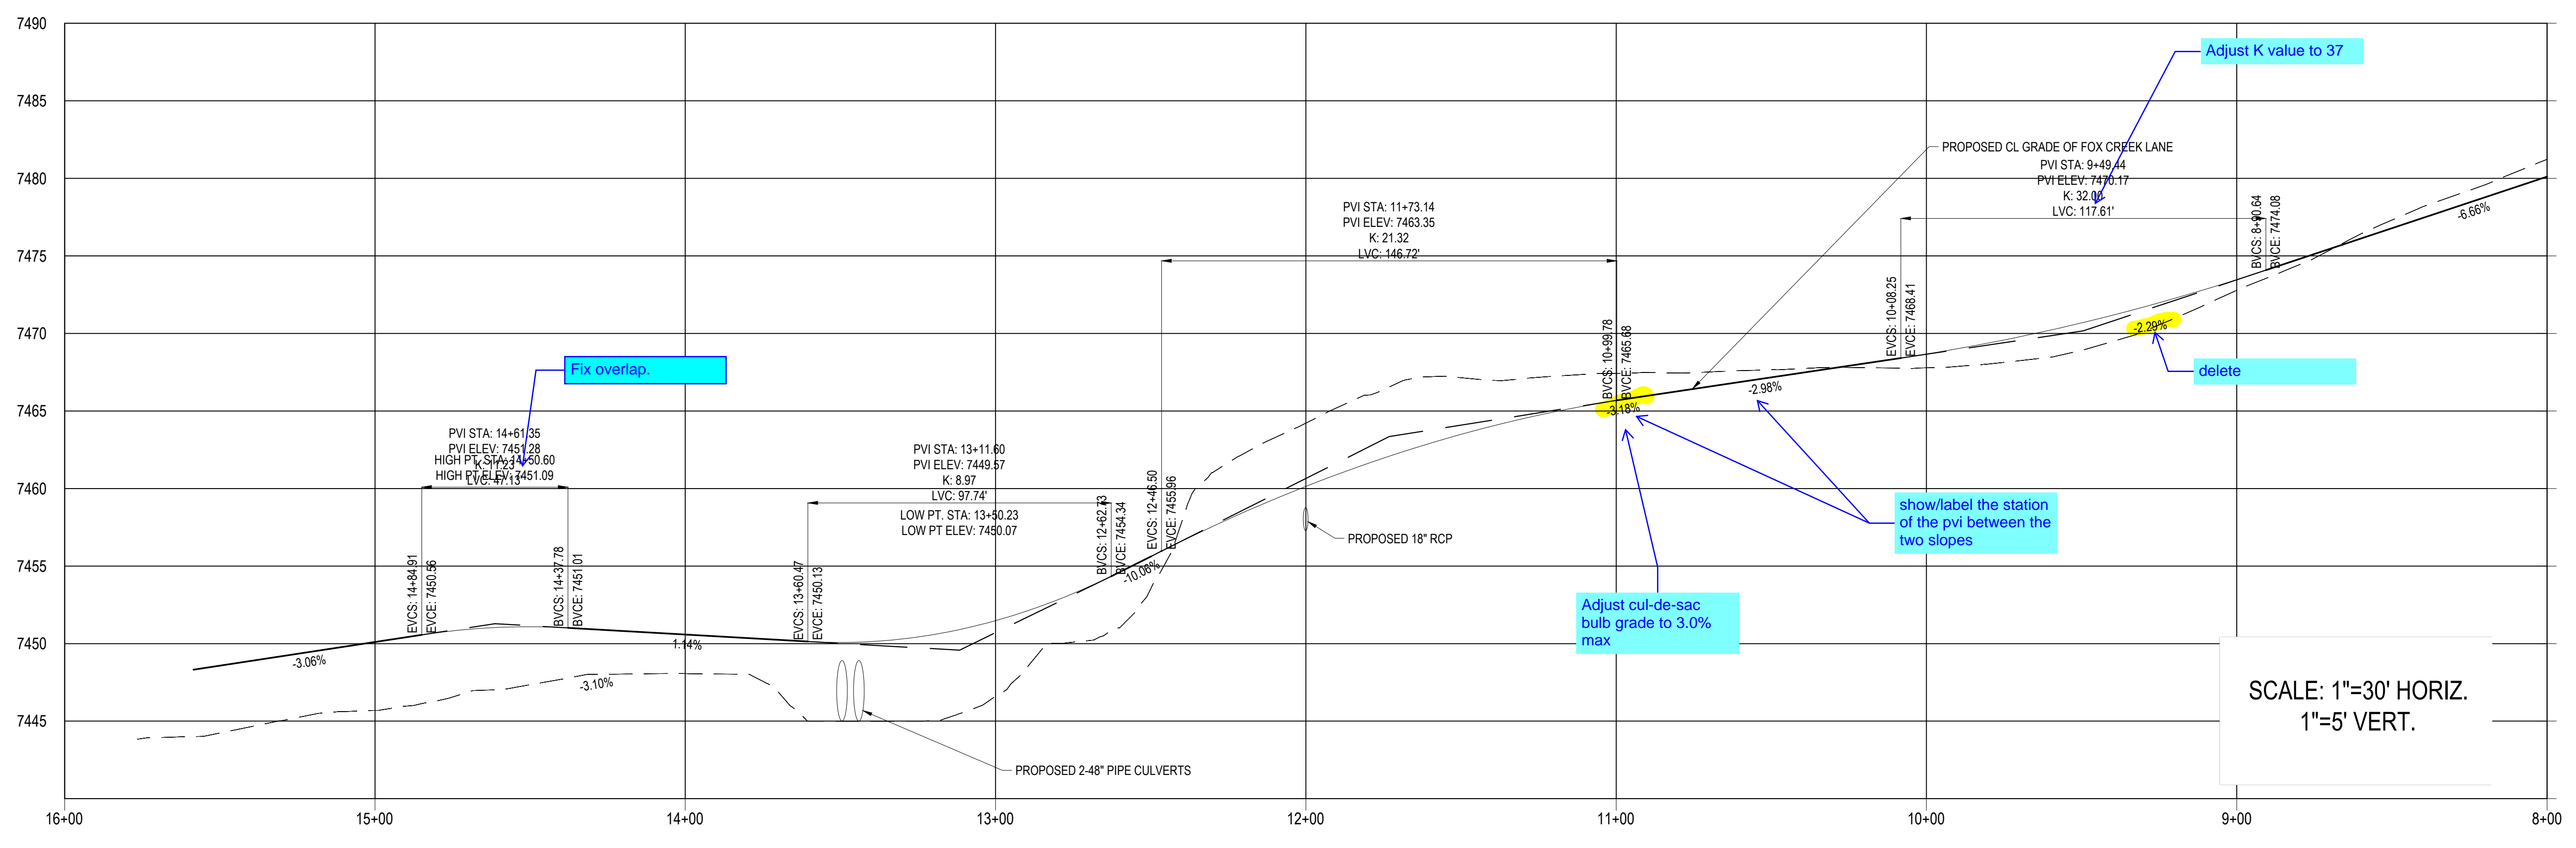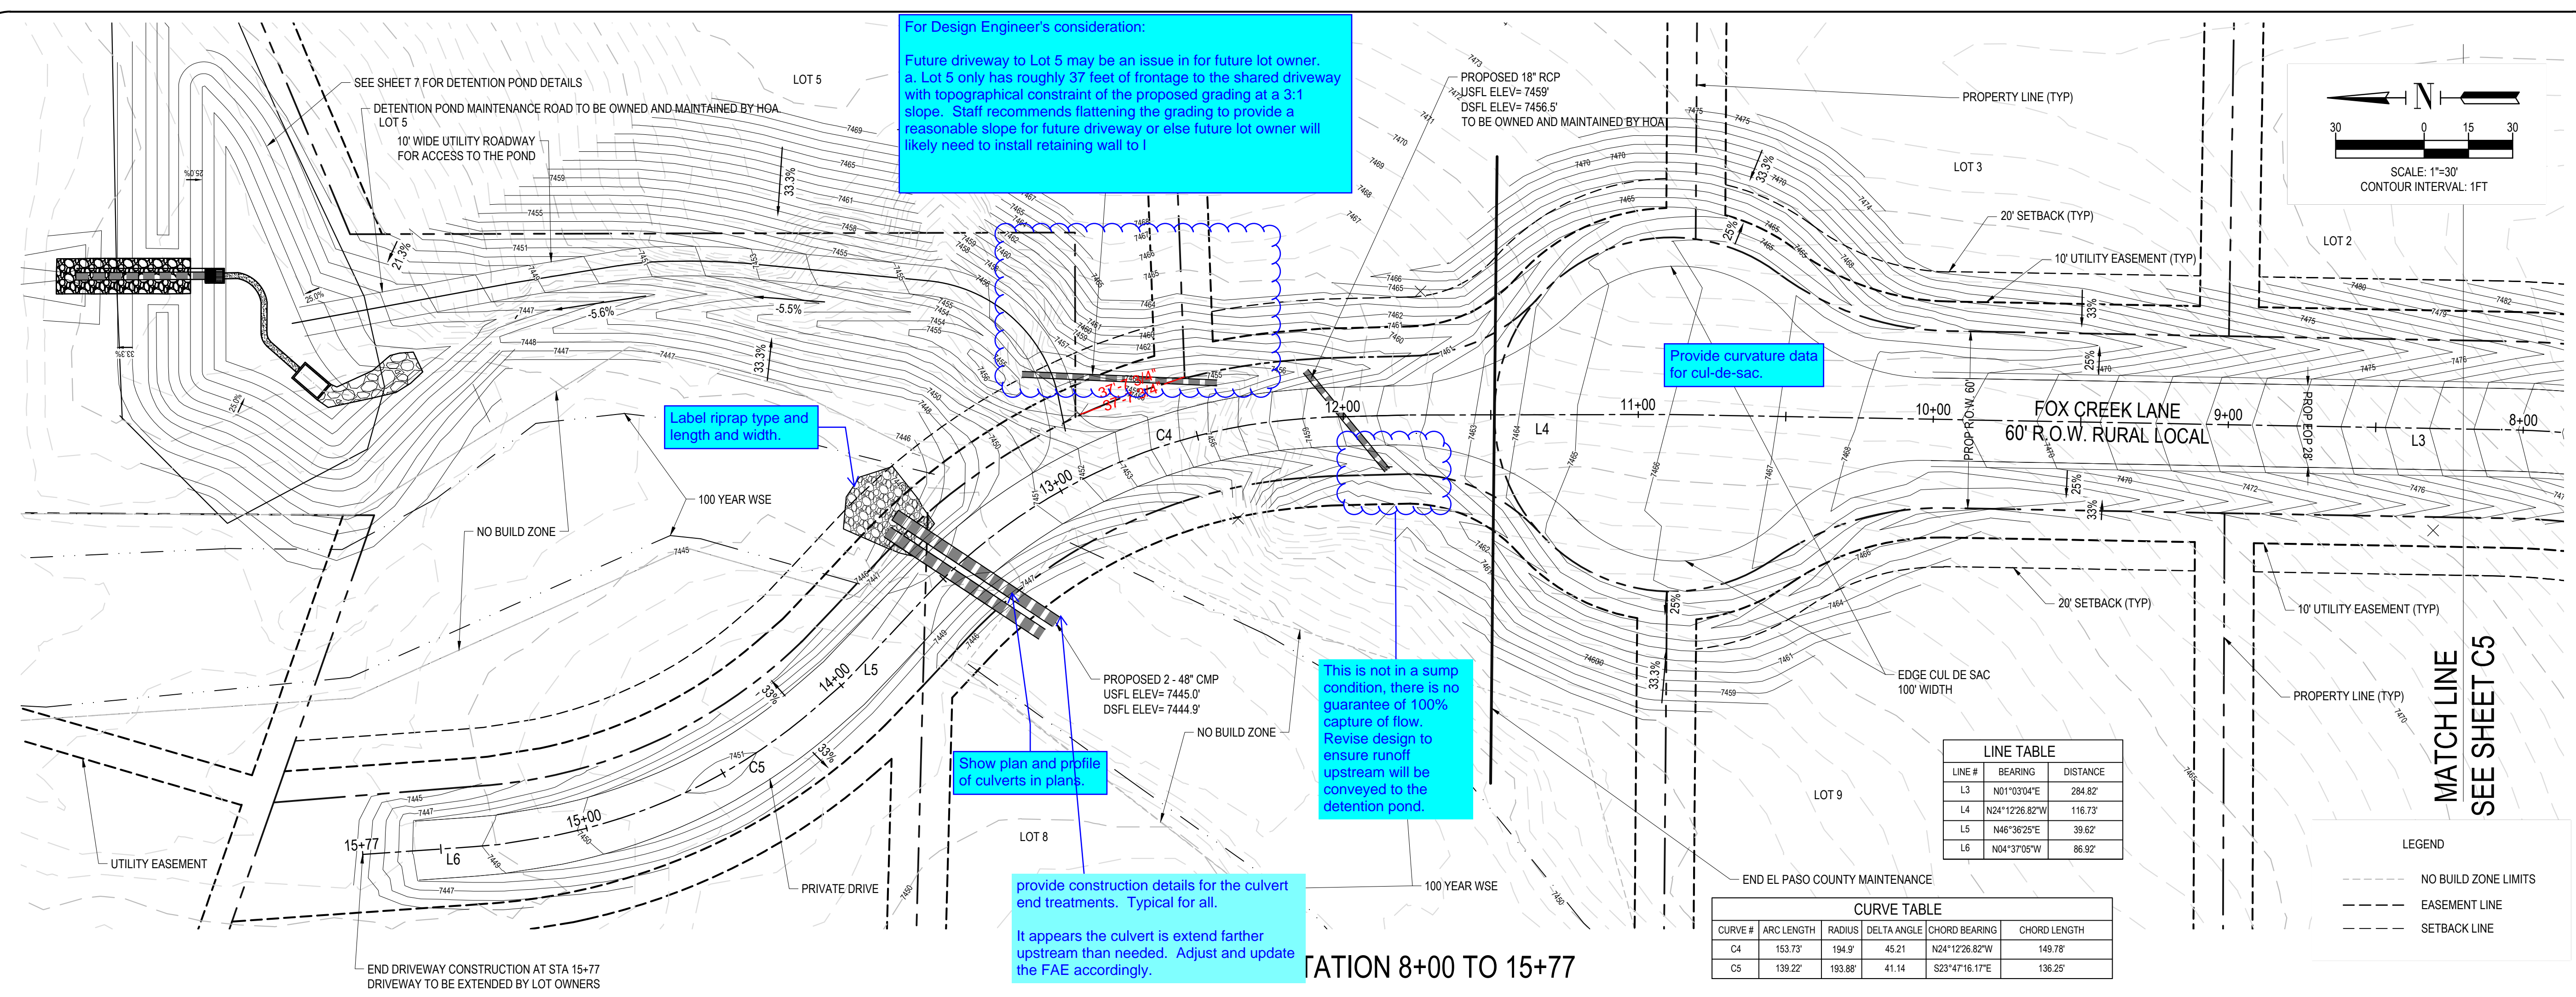

ISSUED	REVISIONS

TERRA RIDGE NORTH  
 15630 FOX CREEK LANE  
 COLORADO SPRINGS, COLORADO

EL PASO COUNTY DEVELOPMENT  
 REPLAT TERRA RIDGE LOTS 5 & 6 W/ 11 LOTS IN  
 TERRA RIDGE NORTH  
 PLAN AND PROFILE

C6  
 SHEET NO.


ISSUED	
REVISIONS	

**NORTH**  
EK LANE  
3, COLORADO

Calculated Parameters for Spillway	
Spillway Design Flow Depth =	0.60 feet
Stage at Top of Freeboard =	4.70 feet
Spillway Crest Length =	4.00 feet
Spillway End Slopes =	3.00 H:V
Basin Area at Top of Freeboard =	0.20 acres
Basin Volume at Top of Freeboard =	0.53 acre-ft

T CC

EL PASO COUNTY DEVELOPMENT  
REPLAT TERRA RIDGE LOTS 5 & 6 W/ 11 LOTS IN  
TERRA RIDGE NORTH  
POOL PLAN

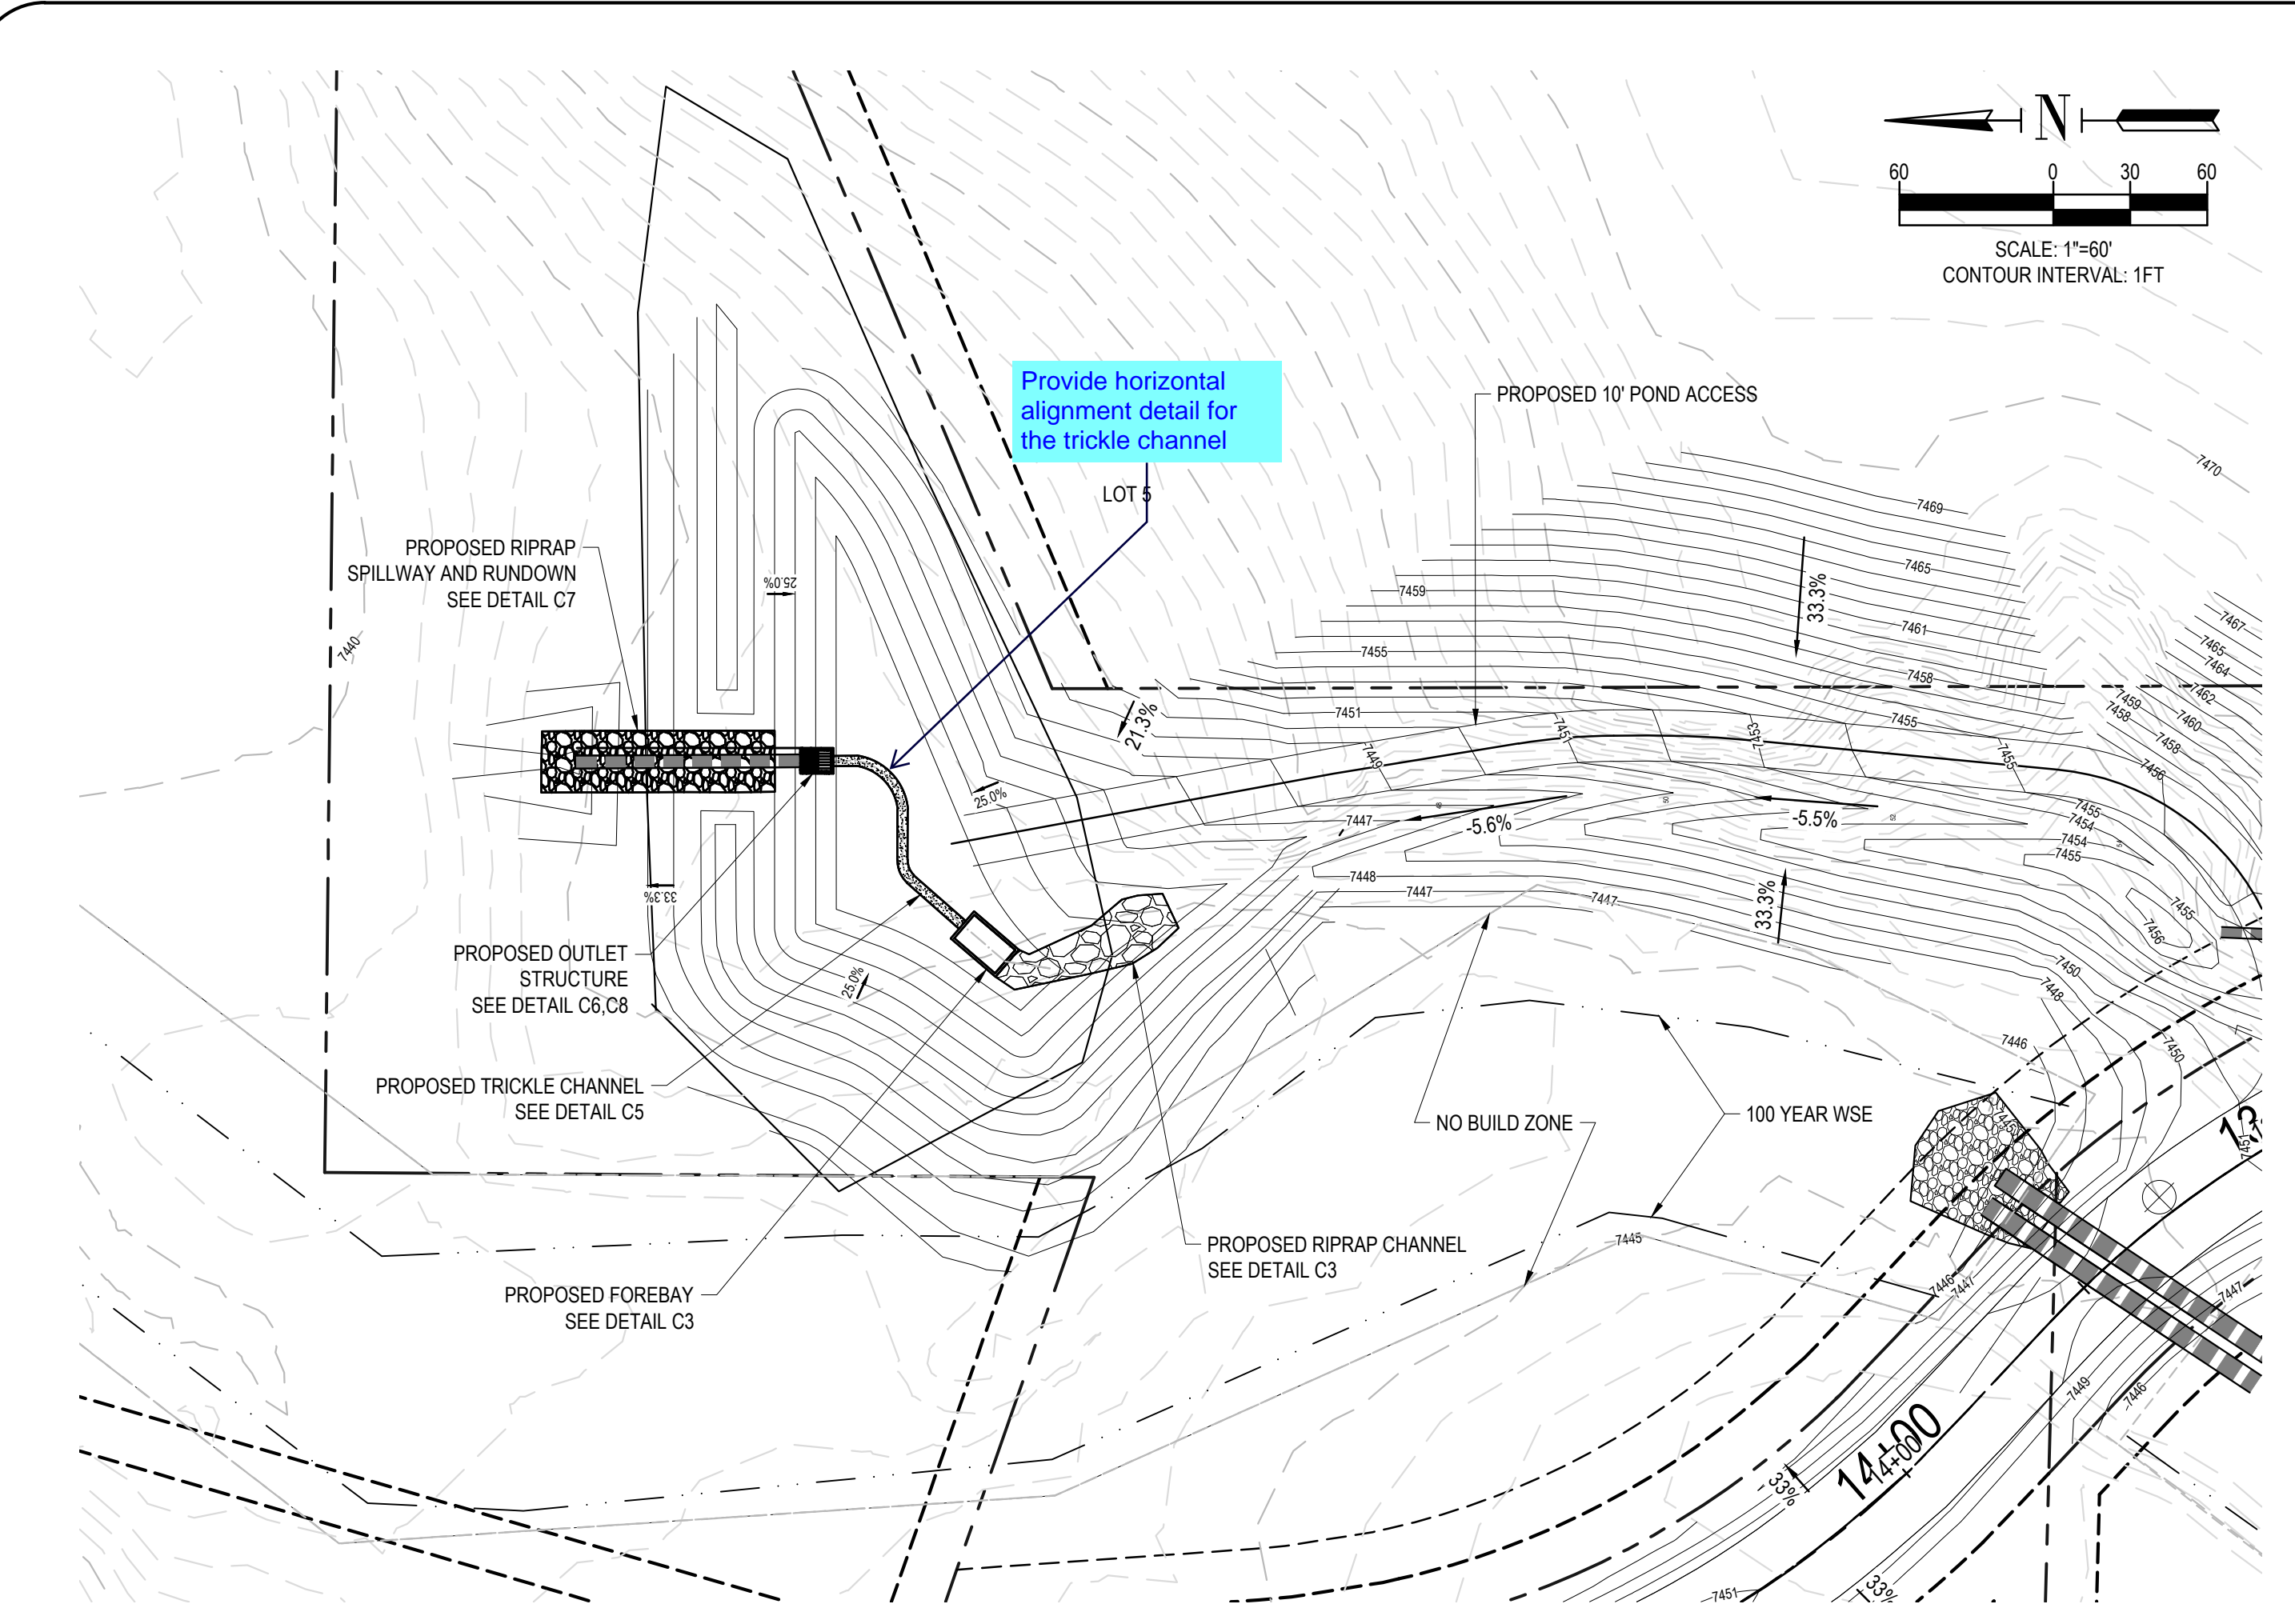

Provide orifice plate detail showing dimension and orifice dimension and elevation.  
provide elevations  
Provide restrictor plate detail.


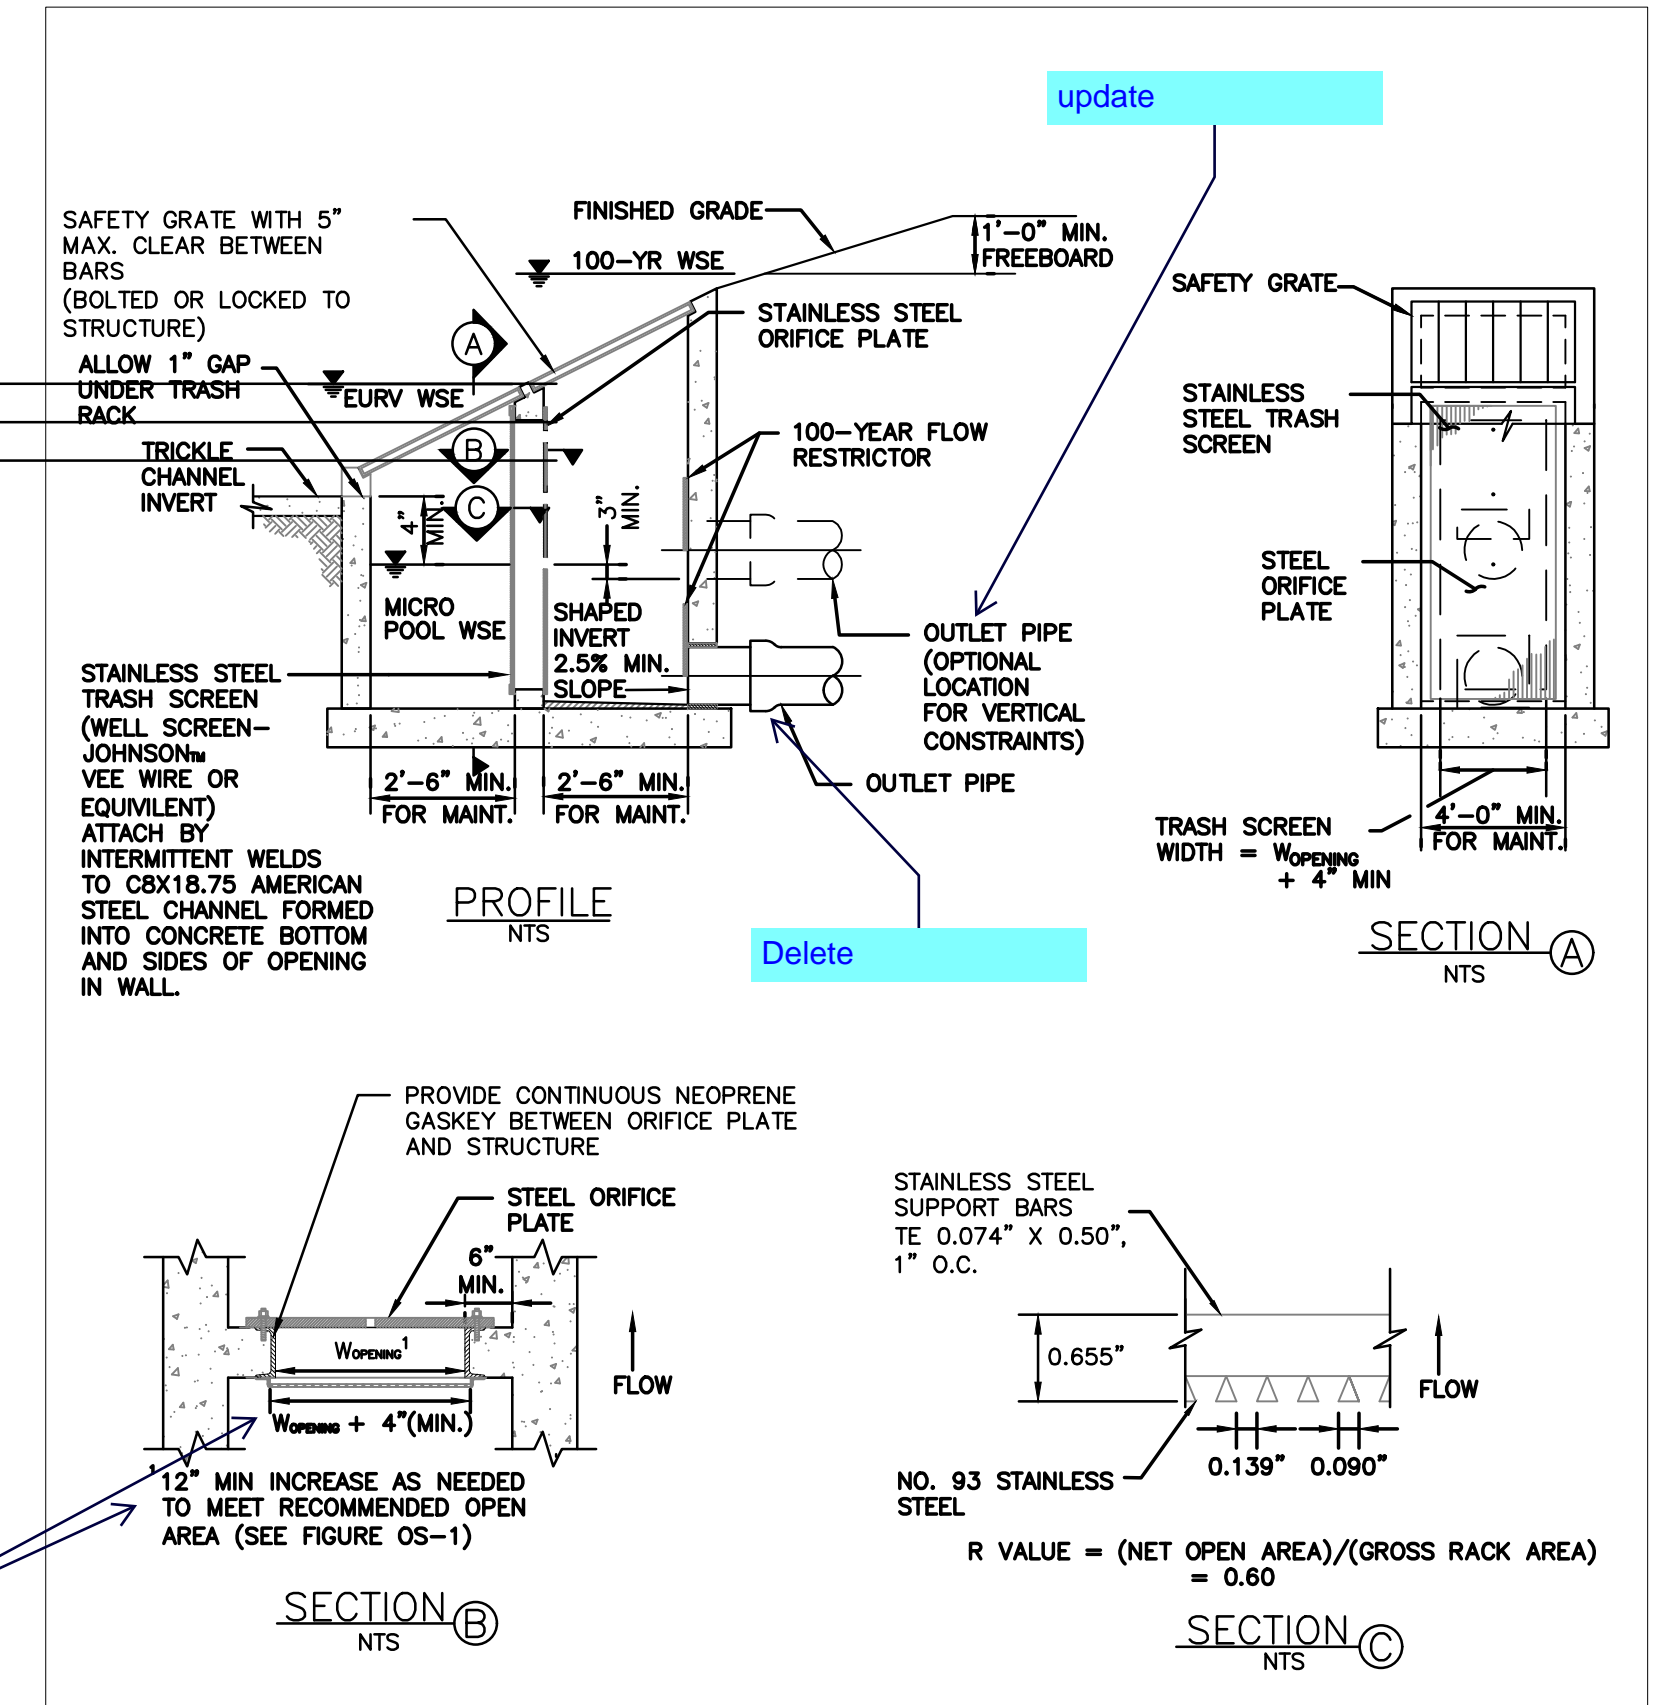


FIGURE OS-7  
FULL SPECTRUM DETENTION  
OUTLET STRUCTURE FOR 5 ACRE  
IMPERVIOUS AREA OR LESS


C-8 OUTLET STRUCTURE DETAILS  
NTS

User Input: Emergency Spillway (Rectangular or Trapezoidal)	
Spillway Invert Stage =	3.10 ft (relative to basin bottom at Stage = 0 ft)
Spillway Crest Length =	4.00 feet
Spillway End Slopes =	3.00 H:V
Freeboard above Max Water Surface =	1.00 feet

adjust. per MHFD-Detention calculation the height needs to be 1.60 ft in order to provide a 1' freeboard above the overflow depth.

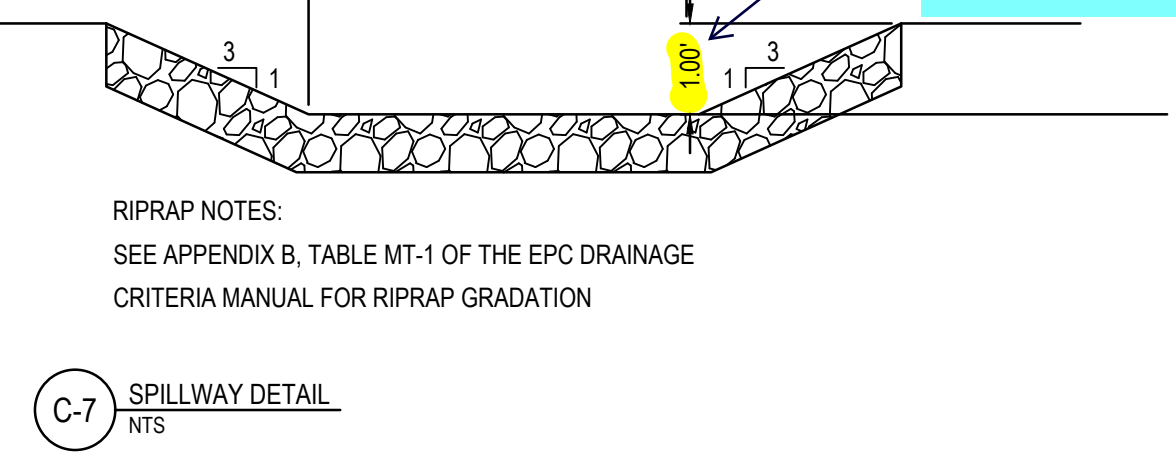

C-7 SPILLWAY DETAIL  
NTS

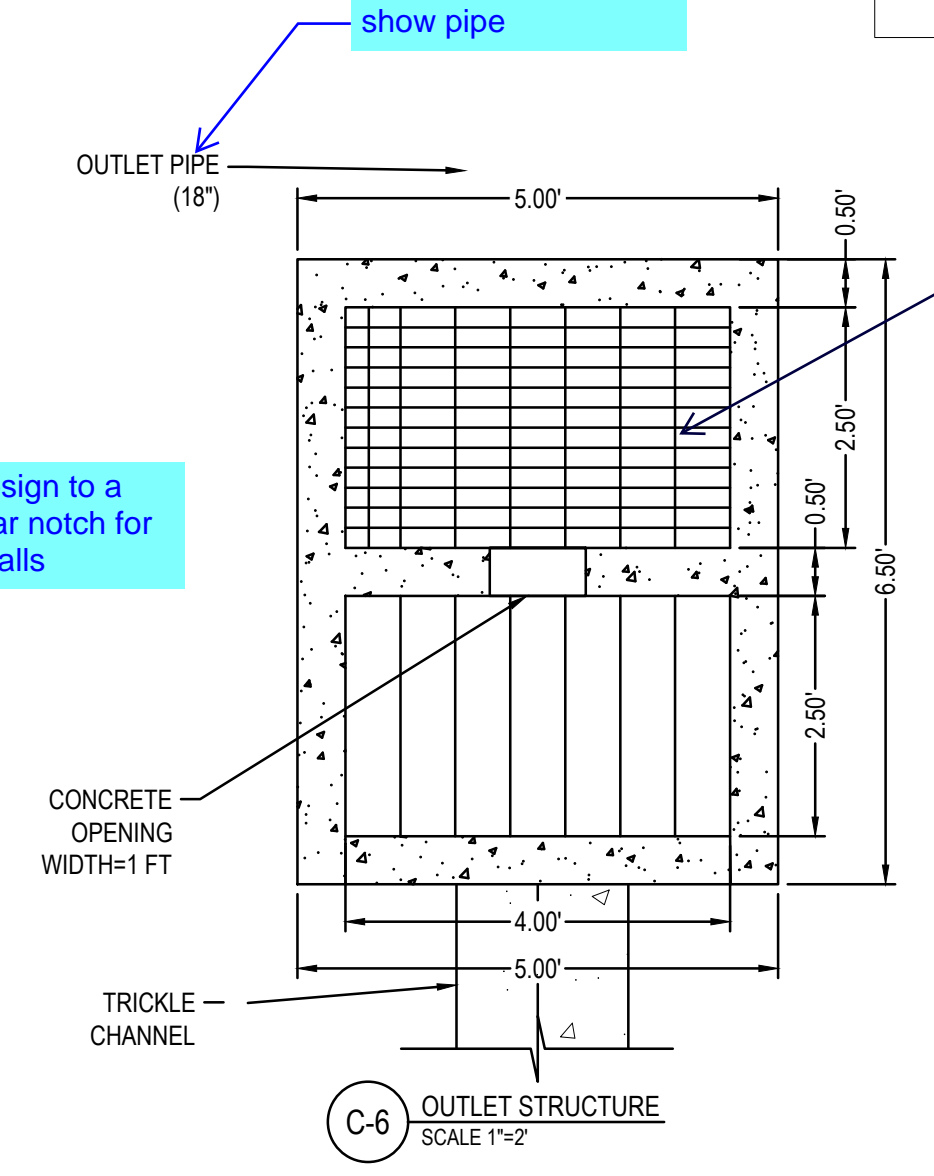


provide information for the grate to be installed on the second chamber

C-6 OUTLET STRUCTURE  
SCALE 1"=2'


show the finished grade relative to the structure

Revise design to a rectangular notch for forebay walls

show the finished grade relative to the structure

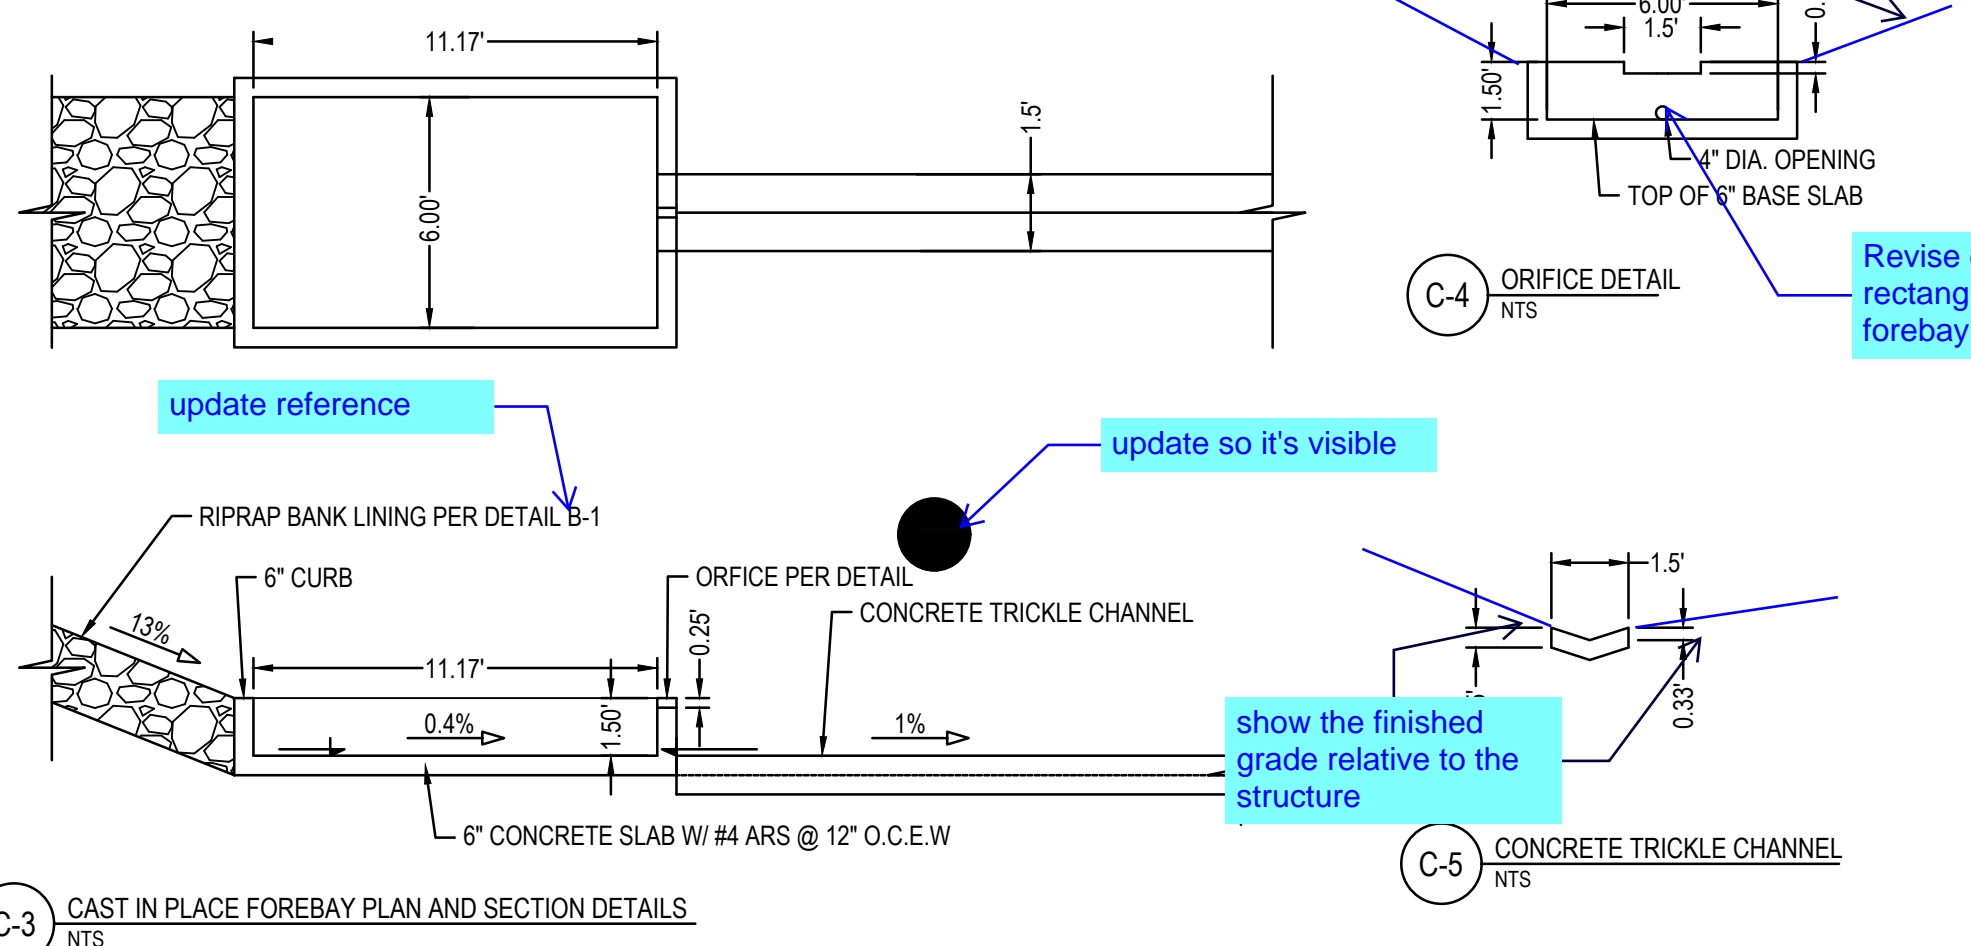


C-3 CAST IN PLACE FOREBAY PLAN AND SECTION DETAILS  
NTS

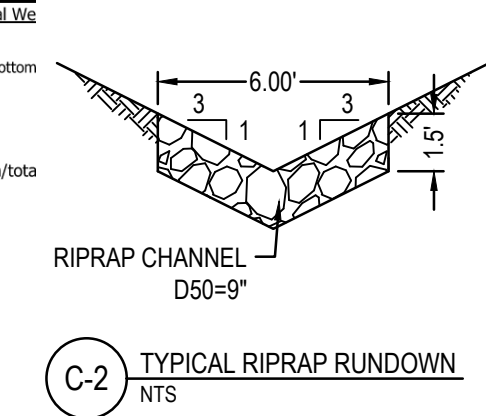

Zone 3 Weir	Not Selected
Overflow Weir Front Edge Height, Ho =	2.09 feet (relative to basin bottom)
Overflow Weir Front Edge Length =	4.00 feet
Overflow Weir Grade Slope =	N/A H:V
Horiz. Length of Weir Sides =	2.50 feet
Overflow Grate Open Area % =	70% N/A
Grate Chopping % =	50% N/A

update structure profile to match detail and drainage report. MHFD-Detention noted 4:1 slope, not horizontal for the second chamber

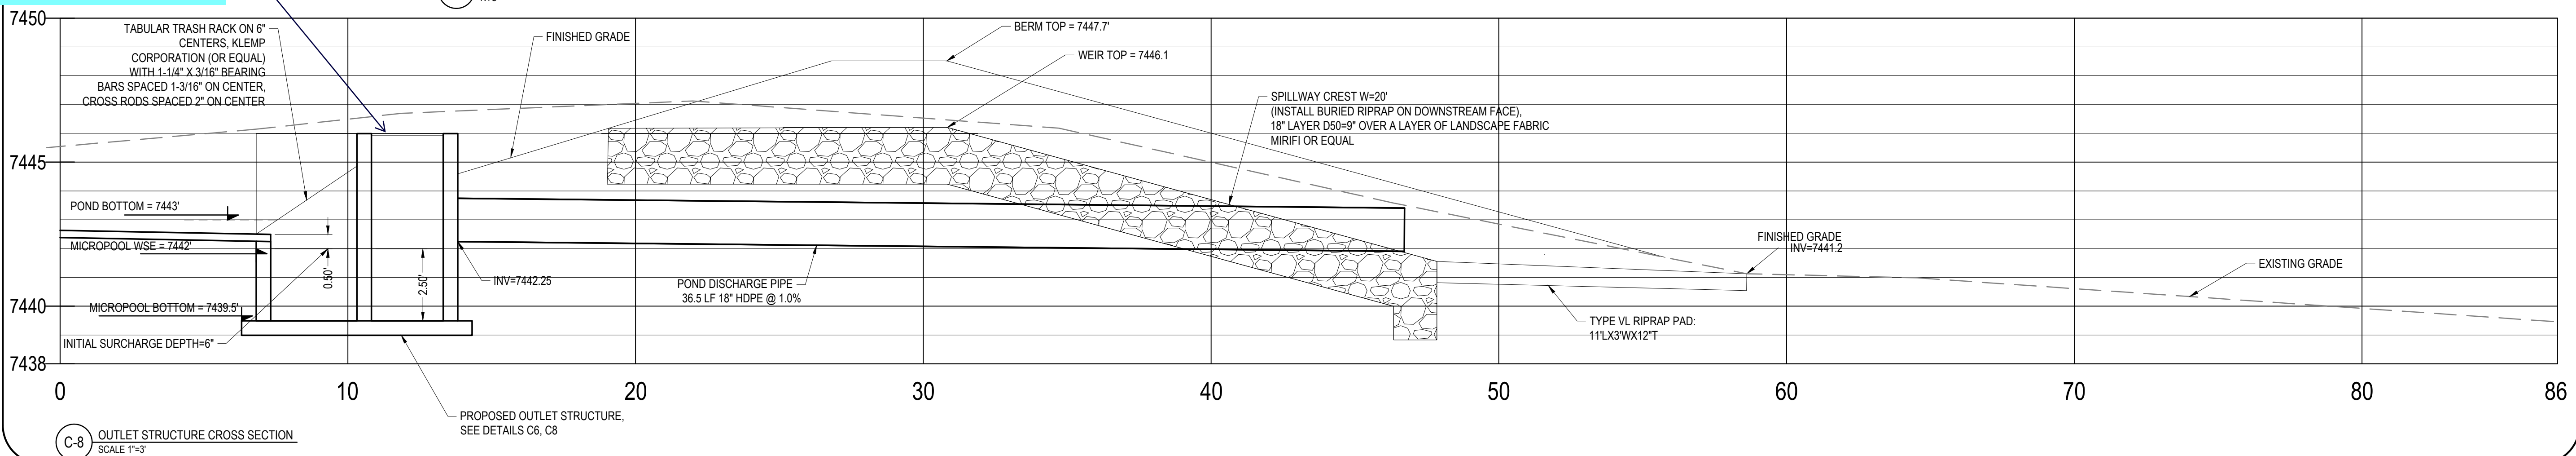

C-8 OUTLET STRUCTURE CROSS SECTION  
SCALE 1"=3'