

Final Drainage Report  
Terra Ridge North  
Colorado Springs, Colorado 80908

---

Prepared for:  
El Paso County, CO

On Behalf of:  
Phillip S. and Jennifer Miles  
PO Box 88461  
Colorado Springs, CO 80908  
719-352-8886

Prepared by:  
Lodestar Engineering, LLC  
PO Box 88461  
Colorado Springs, CO 80908  
Phillip Shay Miles, PE  
719-352-8886

February 16, 2023  
PCD File# SF2239

**ENGINEER’S STATEMENT:**

The attached drainage plan and report were prepared under my direction and supervision and are correct to the best of my knowledge and belief. Said drainage report has been prepared according to the criteria established by the County for drainage reports and said report is in conformity with the master plan of the drainage basin. I accept responsibility for any liability caused by any negligent acts, errors, or omissions on my part in preparing this report.

Signature: \_\_\_\_\_ Date: 2/17/23

Phillip Shay Miles, PE  
Registered Professional Engineer State of Colorado No.40462



**DEVELOPER’S STATEMENT:**

I, the owner/developer, have read and will comply with all of the requirements specified in this drainage report and plan.

Name of Owner/Developer: Phillip S. Miles

Authorized Signature: \_\_\_\_\_ Date: 2/17/23

Title: Owner

Address: 15630 Fox Creek Lane, Colorado Springs, CO 80908

**EL PASO COUNTY:**

Filed in accordance with the requirements of the Drainage Criteria Manual, Volumes 1 and 2, El Paso County Engineering Criteria Manual and Land Development Code as amended.

\_\_\_\_\_  
County Engineer / ECM Administrator

\_\_\_\_\_  
Date

Conditions:

## Table of Contents

1. Purpose .....	1
2. General Description.....	1
3. Soils Conditions.....	2
4. Drainage Criteria .....	2
5. Existing and Proposed Drainage Conditions.....	2
5.1 Drainage Patterns and Hydraulic Routing .....	2
5.2 Site Improvements.....	4
5.3 Hydraulic Calculations.....	4
5.4 On-site Detention Requirements.....	5
5.5 Compliance with Other Studies .....	5
5.6 Four Step Process.....	5
6. Water Quality .....	6
7. Floodplain Statement.....	7
8. Drainage and Bridge Fees.....	7
9. Construction Cost Opinion .....	7
10. Summary .....	7
11. References.....	8

## Appendix A - Maps

- NRCS Soils Map and Hydrologic Group Data
- FEMA Flood Insurance Rate Map

## Appendix B – Calculations

### Hydrologic

- Composite Runoff Coefficients
- Percentage of Imperviousness
- Basin Runoff Summary (Rational Methodology)
- Surface Routing Summary

### Hydraulic

- Ditches/Channel
- Culverts
- Outlet Erosion Protection

### Detention Pond

- Forebay
- Stage-Storage
- Outlet Structure Design
- Spillway Riprap

## Appendix C – Plan (located in plan pocket)

- Existing Drainage Plan
- Proposed Drainage Plan

## 1. Purpose


The purpose of this Final Drainage Report for Terra Ridge North is to quantify and evaluate the impacts of stormwater runoff generated by this Project and to provide adequate water quality/detention treatment.

## 2. General Description

The Terra Ridge North property (Project) is a 39.72-acre single-family development consisting of 11 lots and a public street (Fox Creek Lane) located within Black Forest, Colorado in El Paso County. The project will consist of a public street, detention pond, and new home construction and associated site elements typical of single-family residential development (e.g. – driveways, patios, landscaping, etc.). The property is bounded by Ridgeview Acres to the north, Whispering Hills Estates to the west Wildwood Village to the east, and Terra Ridge Estates to the south. All lots surrounding the subject property are all zoned RR-5. The entire 39.72-acre parcel lies within unincorporated El Paso County and is currently zoned RR-2.5.

This project is located in the Town of Black Forest, El Paso County, Colorado. Access to the site is from Fox Creek Lane. It is located in Section 29, Township 11 south, Range 65 west of the 6<sup>th</sup> principal meridian. A vicinity map is provided below in Figure 1.

**Figure 1 – Vicinity Map**

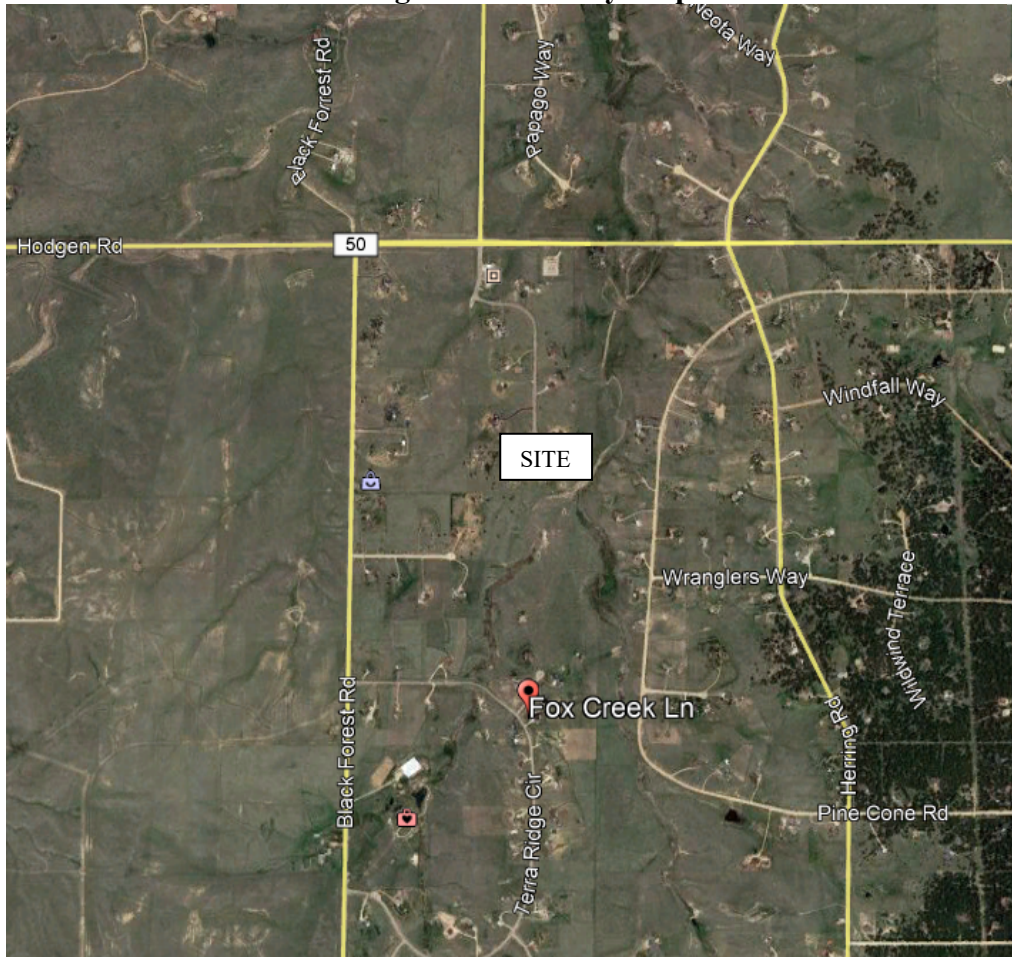



The existing site is covered with native grasses with a few randomly located ponderosa pines. The topography of the site is rolling hills with two drainage ways extending from south to north through the property. A 100-foot-wide electric easement extends north to south along the eastern portion of the site.

### 3. Soils Conditions

The proposed development is 39.72 acres. Ground cover primarily consists of existing vegetation primarily consisting of native grass and shrubs.

The general topography of the land slopes to the south at slopes in the range of 2% to 30%. According to the Natural Resources Conservation Service (NRCS), the soils in this area consist of Peyton-Pring Complex and Tomah-Crowfoot loamy sands, and can be classified as a Hydrologic Soil Group (HSG) Types B. A soil map and map unit (soils type) descriptions describing the HSG and other soils properties are provided in Appendix A. For the purposes of this report an HSG type B soil has been used to define rational method runoff coefficients.

Generally speaking, stormwater runoff from this project flows to the north and will initially enter an unnamed drainageway which ultimately discharges into East Cherry Creek.

### 4. Drainage Criteria

The hydrologic and hydraulic analysis performed in this report utilizes The City of Colorado Springs and El Paso County Drainage Criteria Manual (Vol 1, 1991) (Vol 2, 2002), The City of Colorado Springs (Chpt. 6, 2014, and the MHFD USDCM (Urban Storm Drainage Criteria Manual) Volumes 1 & 2. Stormwater runoff was determined using the Rational Method and was calculated for existing and proposed conditions for the 5-yr (minor) and 100-yr (major) recurrences. 1-hour rainfall depths were derived from NOAA Atlas 14, Volume 8, Version 2 specific to the Project location.

Revise to v4.06

The following MHFD hydrologic and hydraulic software were used in this report:

- UD-Culvert v3.05 –Culvert and Erosion Protection Calculations
- MHFD-Detention v4.05 – Water Quality and Detention Calculations

Additional software was needed for the triple 54” pipes to accurately model a parabolic overflow weir (driveway sag curve). USDOT Federal Highway Administration (FHWA) Culvert Analysis Program HY-8, version 7.6. The culverts have been designed so there will not be any overtopping during the 100yr storm event.

### 5. Existing and Proposed Drainage Conditions

#### 5.1 Drainage Patterns and Hydraulic Routing

##### *Existing*

Stormwater runoff from this Project generally flows to the north and will initially enter an unnamed tributary ultimately discharging to East Cherry Creek. The imperviousness value of undeveloped land is ~2% in accordance with DCM Table 6-6.

Review 2 clarification: see table on pdf page 12 below for a more simple and clear approach.

Design Point EX flows are generated from a naturally vegetated field in combination with the developed flows from the existing Terra Ridge subdivision filings to the south. The  $Q_{100}$  flow is 433.7cfs.

### *Proposed*

Proposed roadway construction and associated grading will create five (5) on-site basins and two (2) off-site basins. Refer to the drainage plan in Appendix C.

Design Point 1 flows are generated from basin B. Basin B consists of public roadway improvements to include pavement, and roadside ditches. Unconcentrated sheet flow across the pavement is collected in the adjacent ditch and is routed north to the proposed 18" storm culvert. At this location, runoff will be conveyed under the proposed roadway to the ditch on the east side. Runoff is then conveyed under the proposed maintenance access road via a 24" storm culvert with flow ultimately discharging into the proposed water quality/detention pond facility.

Design Point 2 flows are generated from basins A and B. Basin A consists of public roadway improvements to include pavement, and roadside ditches. Unconcentrated sheet flow across the pavement is collected in the adjacent ditch and combines with basin B runoff and is routed north to design point 2. At this location, runoff will be conveyed in a proposed ditch to the forebay of the proposed water quality/detention pond facility. Riprap will be provided on three sides of the structure with a d50 of 6" and a thickness of 12" to prevent erosion when overtopping during frequent storm events. The proposed forebay will be ~44cf in volume and will have a notch width of 3.7inches. Flows into a 1.5' wide concrete trickle channel will be conveyed to the outlet structure micropool. Refer to the forebay and detention pond calculations located in Appendix B. The emergency overflow route is over a 4' wide (i.e. - 4' long crest length) proposed spillway which has been designed to pass the peak flow from the 100yr flow event.

Design Point 3: The JR report shows flows entering the project site with a  $Q_{100yr}$  value of 369cfs (JR DP5). To route this flow to Fox Creek Design Point 3, this flow value (369cfs) and the time of concentration ( $T_c$ ) for Design Point 5 from the JR report (0.765hrs = 45.9minutes) was held and a corresponding CA equivalent (rational method input) was calculated for routing to Design Point 4. The  $T_c$  for the JR flow (45.9cfs) was added to the additional  $T_c$  (9.2 minutes) to route thru the site to Design Point 4, yielding a higher  $T_c$  (55.1) for Design Point 4 and was used to determine the  $Q_{100yr}$  peak flow value of 432cfs. As a rough check, using the JR Design Point 5 report data and the 371 tributary acres with a resultant flow of 369cfs yields ~1.01cfs/acre. Our addition of off-site basin OS1 and onsite basin D (total 45acres) yielded a peak flow at Design Point 4 of 431.8cfs. Therefore, our project site had flows of ~1.04cfs/acre which is close to the 1.01cfs/acre value determined by JR.

Design Point 4 flows are generated from off-site basins OS1 and OS2, Design Point 3 as well as on-site basin D. Basin OS1 and OS2 consist of large lot single family subdivision development improvements with homes, driveways, sheds, and various outbuildings. Runoff flows down the side slope and directly into the adjacent drainageway. Basin D consists of a

Review 2 clarification: You must reference an adequate WQ exclusion for any areas of proposed soil disturbance that are not tributary to the pond. Examples: 20% up to 1ac of development can be excluded per ECM App I.7.1.C.1 and exclusions listed in ECM App I.7.1.B.#).

naturally vegetated field which will have some minor impervious area additions from the proposed home sites. Runoff from basin D is routed directly into the drainageway and then to the north to design point 4. To enable the flows at this location to pass under the proposed driveway, three (3) 54" culverts are proposed. Riprap energy dissipation will be provided at the outfall to minimize the potential for erosion/local scour. Refer to appendix B calculations for additional information.

Basin E flows are generated from a naturally vegetated field and a short segment of driveway pavement. This basin runoff is not being treated in the proposed water quality/detention pond because of the topographical constraints on site. Basin E flows are routed in the existing drainageway to the northeast combining with the main channel of East Cherry Creek at the northeastern lot corner.

Basin F?

Basin F flows are generated from a naturally vegetated field which will have home site construction. Basin E flows are routed in an existing drainageway (East Cherry Creek) on the east side of the property which combines with the aforementioned onsite drainageway within basin E near the northeastern lot corner.

Basin C is not used.

Basins D, E & F are excluded from permanent water quality per ECM Appendix I Section I.7.1.B.5 since these contain large lot single family sites (greater than 2.5 ac) and will have soil and vegetation conditions which are suitable for infiltration/filtration.

Design Point 5 is the ultimate outflow outfall located at the northeast corner of the subdivision and is a combination of flows from DP4, basin E, F, JR basin 17, and the pond outfall. The Q<sub>100</sub> flow is 472.7cfs.

The developed 100-year flow at design point 5 is 39cfs higher than the historic 100-year flow at the same location (Design Point EX). This yields an 8.9% increase in flows from the proposed subdivision which is negligible and will not negatively impact downstream properties.

Unresolved Review comment:  
In the Proposed Drainage section above, also add a paragraph or two for the proposed roadway improvements for this project (Fox Creek Lane) that are South of this project (Terra Ridge North) within Terra Ridge F1 (as shown on the drainage map on pdf page 66 below).

### 5.2 Site Improvements

Utilities that exist within the project area are overhead electric lines running north to south across the east half of the project. There are no other known public utilities in the area. The existing electric lines are contained within an easement.

### 5.3 Hydraulic Calculations

#### Culverts

The calculations for the 18" culvert and 24" culvert which routes ditch flows from basin B to basin A under the proposed driveway and under the proposed maintenance access road were performed using 2022 Civil3D design software and are contained in Appendix B. The triple 54" storm culverts routing the drainageway under the proposed driveway were modeled using FHWA HY-8 software. Refer to Appendix B.

This is a follow-up to my Review 1 comment on the drainage map about untreated proposed soil disturbances in Basin D: Per direction from the State, subdivision developments that include impervious pavement roads do not qualify for Exclusion E (Large Lot Single-Family Site) on the PBMP form for those roadway areas. Therefore, a permanent WQ facility should be designed to treat runoff from the impervious roadway area and the subsequent grading like roadside ditches (but only if the total area of soil disturbance is >1ac). A driveway that feeds and crosses multiple lots counts toward roadway impervious area. But individual driveways for individual lots counts towards the impervious area for the large single-family lot. For this site, I recommend you look into utilizing Runoff Reduction (RR) for WQ treatment per MHFD Detail T-0. MHFD has a calculation spreadsheet for RR. See further guidance in my comment at the bottom of pdf page 11 below.

Revise to provide the spec that is referred to siting 6ft/sec velocities for grass. Include information in appendix.

### *Ditch Design*

The hydraulic analysis for the Fox Creek Lane roadway ditches was performed using 2022 Civil3D design software and are contained in Appendix B. A grassed lined channel Manning's roughness coefficient value of 0.040 was used for the ditches per table 10-2 of the drainage criteria manual which is the "normal" value as indicated at the top of the table. For all roadside ditches proposed for this project, a Shotgun seed mix will be used which results in long native grasses. Using a mix like this will provide adequate surface roughness and the stability needed to accommodate the 100yr storm event flow velocities. Long native grass is capable of withstanding velocities up to 6ft/sec. Our proposed design velocity values range from 3.2ft/sec to 5.5ft/sec. Furthermore, the existing on-site soils do not have a significant amount of sand content and are somewhat cohesive in nature. Therefore, we believe the onsite soils coupled with long native vegetative cover can be considered erosion resistant.

### *Channel Analysis*

The hydraulic analysis for the drainageway (unnamed tributary to East Cherry Creek) routed through the development was performed using 2022 Civil3D design software and is contained in Appendix B. A natural stream Manning's roughness coefficient value of 0.040 was used for the channel per table 10-2, of the drainage criteria manual which as stated above is the "normal" value used for computations. Five locations were chosen for normal depth flow analysis. Velocities ranged from 3.6ft/sec to 5.0ft/sec which as we have stated above would be considered non erosive being below the 6ft/sec threshold. Furthermore, the channel appears to be stable with no signs of thalweg incision, head cutting or unstable banks.

Unresolved Review 1 comment from CDs:  
In FDR, discuss need (or lack thereof) for geotech fabric beneath riprap (for riprap rundown(s)).

### **5.4 On-site Detention Requirements**

A full spectrum water quality/detention pond is proposed for this site to provide water quality for developed flows as a result of this development. In addition to water quality, detention is provided in the pond design. Refer to section 7 in this report for additional information regarding water quality capture volume (WQCV) and detention (peak flow attenuation) flow requirements for this project.

The Terra Ridge North HOA will own and maintain the water quality/detention pond.

### **5.5 Compliance with Other Studies**

The only studies related to this project are the Terra Ridge Filing No 1 and 2 reports (see references). The basins that are common to this project (Terra Ridge – basin 12 and 17) have only been modified slightly to account for the proposed roadway construction. Flows as determined in the Terra Ridge reports for the natural drainageway have been used and supplemented with the additional flows from the Terra Ridge North watershed to determine the on-site flow at the proposed driveway crossing.

### **5.6 Four Step Process**

#### Step 1 – Runoff Reduction Practices

This development address Low Impact Development strategies primarily through the utilization of roadway ditches. Runoff from the pavement sheet flows across the grass lined ditch side slopes which provides some level of water quality treatment.

Step 2 – Stabilize Drainageways

Portions of the existing conditions runoff currently enter the on-site natural drainageway via overland flow across the vacant lots and via the proposed full-spectrum detention pond. Due to the minor anticipated extent of land disturbance and improvements on these large lots coupled with on-site detention; the amount of runoff entering the drainageways remains basically the same. Predevelopment levels of release of the Excess Urban Runoff Volume (EURV) help the drainageway maintain its current morphology by mimicking the natural historic runoff rates over a longer period by peak flow attenuation.

Step 3 – Implement BMPs that Provide a Water Quality Capture Volume with Slow Release

On-site flow is directed to the on-site private proposed full-spectrum detention/water quality facility. The extended detention basin provides Water Quality Capture Volume (WQCV) required for this site and attenuates the peak flows releasing them at approximate historic runoff rates over a longer period by releasing Excess Urban Runoff Volume (EURV).

Step 4 – Consider Need for Industrial and Commercial BMPs

No industrial and commercial development exist onsite.

**6. Water Quality**

← read this whole section

Stormwater that is generated from this Project is either discharged offsite in the form of unconcentrated sheet flow or is collected in roadside ditches and routed thru the proposed water quality/detention facility outfalling via an 18” storm sewer pipe.

The proposed on-site imperviousness of the area contributing to the pond is 25.9%. Basin C is not used in this report.

The proposed full spectrum extended detention basin (EDB) has been analyzed in this study based on the proposed site conditions as shown on the Drainage Plan. The pond facility provides 0.060 acre-ft of water quality capture volume, 0.138acre-ft of excess urban runoff volume and 0.236 acre-ft of detention storage. The proposed EDB will release a peak flow 5.4cfs during the 100-year storm event. Outflows from the proposed EDB are released via a proposed 18" storm sewer pipe with a restrictor plate located within the outlet structure box. The outlet structure will have an orifice plate designed to drain the EURV over a period of 72 hours. The orifice plate will have 3 rows of holes. The lowest will be 15/16” in diameter, and the second and third rows will be 7/16” in diameter. The EDB will have a rip rap emergency overflow spillway that will drain the 100yr peak flows (8.0cfs) in the event the outlet structure becomes entirely clogged or the pond is already full. The spillway will be constructed of rip rap with a d50 = 9", 18” thick, a crest length of 4.0’ with 3:1 side slopes. Flow depth over the crest of the spillway during the 100yr event storm will be 0.61’ with 1.12’ of freeboard. The outfall pipe will have a 3’x5’ riprap pad (see appendix B calculations) to dissipate any energy. A 15ft maintenance road has been provided extending from the private driveway to the bottom of the pond. The pond will be maintained using a skid loader. Refer to the design calculations in Appendix B for additional information.

Revise back to 10ft wide per our email conversation from February.

This pad is not shown on CDs. Provide a detail.

### 7. Floodplain Statement

According to the Federal Emergency Management Agency (FEMA) Flood Insurance Rate Map (FIRM) number 08041C0315G dated December 7, 2018 this project is not located within a FEMA designated 100yr floodplain. Therefore, no map revisions will be necessary as a result of this project. A copy of the FIRM maps is provided in Appendix A.

### 8. Drainage and Bridge Fees

The drainage basin is located within the East Cherry Creek Drainage Basin.

The project is not located within a fee (drainage) basin and bridge fees are not required. Therefore, no drainage or bridge fees are required for this development.

### 9. Construction Cost Opinion

Item	Unit	Quantity	Unit Price	Extended Cost
18" Storm Pipe	LF	24	\$70	\$1,680
24" Storm Pipe	LF	20	\$75	\$1,992
54" Storm Pipe	LF	150	\$195	\$29,250
Outlet Structure	EA	1	\$12,450	\$12,450
Forebay	EA	1	\$3,250	\$3,250
Trickle Channel	LS	1	\$1,548	\$1,548
			Sub-total	\$50,170
			Contingency 10%	\$5,017
			TOTAL	\$55,187

All storm system elements for this project are private and therefore there will be no reimbursement from El Paso County.

### 10. Summary

The Final Drainage Report for Terra Ridge North was prepared using the El Paso County Engineering Criteria Manual, City of Colorado Springs Drainage Criteria Manuals, and Mile High Flood Control District Manuals. Stormwater quality and detention is provided by a proposed facility located on-site. No adverse downstream impacts are anticipated as a result of the proposed site improvements.



## 11. References

1. Engineering Criteria Manual, El Paso County, December 2016
2. Drainage Criteria Manual, Volumes I and II, El Paso County and City of Colorado Springs, Vol 1, 1991 and Vol 2, 2002
3. Drainage Criteria Manual, Chapter 6, Volume 1 Update, October 2018
4. Urban Storm Drainage Criteria Manual (USDCM), Volumes I-III, Mile High Flood Control District (MHFD).
5. Preliminary drainage report for Terra Ridge Filing No. 1, JR Engineering, April 1997.
6. Preliminary drainage report for Terra Ridge Filing No. 2, JR Engineering, June 1999.
7. FEMA Flood Insurance Rate Map Numbers 08041C0305G and 08041C0305G, El Paso County, Colorado, December 7, 2018
8. Natural Resources Conservation Service, Web Soil Survey, <http://websoilsurvey.nrcs.usda.gov/app/WebSoilSurvey.aspx>
9. United States Geological Survey (USGS) Topographic Quadrangle Map

In accordance with the MHFD, runoff reduction has vegetation requirements that have been overlooked in the past. Going forward the following will be required for runoff reduction:

- All RPA/SPA areas will need to be within a no build/drainage easement (or tract) and discussed in the maintenance agreement and O&M manual.
- RPA vegetation should be turf grass (from seed [provide appropriate seed mix] or sod).
- Turf grass vegetation should have a uniform density of at least 80%.
- Irrigation (temp or permanent) is necessary to establish sufficient vegetation and not just weeds.
- Show suitability of topsoil of RPA and steps for proper preparation of topsoil per recommendations in MHFD detail T-0 Table RR-3
- RPA/SPA limits must be shown on GEC Plans (not just FDR) so our SW inspectors and the QSM know that these areas are to remain pervious, vegetated (80%), and irrigated post-construction. Our SW inspectors do not look at drainage reports.

### Other requirements:

- Provide a figure showing all proposed UIA, RPA and SPA areas to be utilized for runoff reduction.
- Provide a detail for the UIA:RPA interface that shows the recommended vertical drop of 4".
- Show signage to be posted in RPAs so maintenance personnel and owners know that the area is a water quality treatment area (not just a regular grassy area and/or an SPA). The signage should say something like: "Water Quality Treatment Area, do not pollute. Area to remain vegetated and properly maintained per the O&M Manual."

The text on pdf pages 6 and 7 above about WQ treatment for each basin would be much clearer if summarized in a table like the example one provided below. This will be a lot more concise than expanded all of your paragraphs above. Instead you can just reference this table in those paragraphs.

Basin ID	Total Area (ac)	Total Proposed Disturbed Area (ac)	Area Trib to Pond A (ac)	Disturbed Area Treated via Runoff Reduction (ac)	Area Excluded from WQ per ECM App 1.7.1.C.1 (ac)	Area Excluded from WQ per ECM App 1.7.1.B.# (ac)	Applicable WQ Exclusions (App 1.7.1.B.#)
A	4.50	4.50	4.50	-	-	-	
B	1.25	1.25	-	1.00	0.25	-	
C	6.00	4.00	-	-	-	4.00	ECM App 1.7.1.B.5
D	2.50	2.50	1.00	-	0.50	1.00	ECM App 1.7.1.B.7
E	3.00	-	3.00	-	-	-	
F	8.25	-	-	-	-	-	
<b>Total</b>	<b>25.50</b>	<b>12.25</b>	<b>8.50</b>	<b>1.00</b>	<b>0.75</b>	<b>5.00</b>	
Comments		<i>[For each row, the sum of the values in Columns 4-7 must be greater than or equal to the value in Column 3 above.]</i>	<i>[Values in this column can be more than Column 3 if over-treating non-disturbed areas.]</i>	See RR calc spreadsheet.	<i>[Total must be &lt;20% of site and &lt;1ac.]</i>		

This table can be added to the report text above or inserted into the existing drainage map on pdf pg 66 below.

**Appendix A  
Maps**

# Custom Soil Resource Report for El Paso County Area, Colorado

fox creek subdivision



# Preface

---

Soil surveys contain information that affects land use planning in survey areas. They highlight soil limitations that affect various land uses and provide information about the properties of the soils in the survey areas. Soil surveys are designed for many different users, including farmers, ranchers, foresters, agronomists, urban planners, community officials, engineers, developers, builders, and home buyers. Also, conservationists, teachers, students, and specialists in recreation, waste disposal, and pollution control can use the surveys to help them understand, protect, or enhance the environment.

Various land use regulations of Federal, State, and local governments may impose special restrictions on land use or land treatment. Soil surveys identify soil properties that are used in making various land use or land treatment decisions. The information is intended to help the land users identify and reduce the effects of soil limitations on various land uses. The landowner or user is responsible for identifying and complying with existing laws and regulations.

Although soil survey information can be used for general farm, local, and wider area planning, onsite investigation is needed to supplement this information in some cases. Examples include soil quality assessments (<http://www.nrcs.usda.gov/wps/portal/nrcs/main/soils/health/>) and certain conservation and engineering applications. For more detailed information, contact your local USDA Service Center (<https://offices.sc.egov.usda.gov/locator/app?agency=nrcs>) or your NRCS State Soil Scientist ([http://www.nrcs.usda.gov/wps/portal/nrcs/detail/soils/contactus/?cid=nrcs142p2\\_053951](http://www.nrcs.usda.gov/wps/portal/nrcs/detail/soils/contactus/?cid=nrcs142p2_053951)).

Great differences in soil properties can occur within short distances. Some soils are seasonally wet or subject to flooding. Some are too unstable to be used as a foundation for buildings or roads. Clayey or wet soils are poorly suited to use as septic tank absorption fields. A high water table makes a soil poorly suited to basements or underground installations.

The National Cooperative Soil Survey is a joint effort of the United States Department of Agriculture and other Federal agencies, State agencies including the Agricultural Experiment Stations, and local agencies. The Natural Resources Conservation Service (NRCS) has leadership for the Federal part of the National Cooperative Soil Survey.

Information about soils is updated periodically. Updated information is available through the NRCS Web Soil Survey, the site for official soil survey information.

The U.S. Department of Agriculture (USDA) prohibits discrimination in all its programs and activities on the basis of race, color, national origin, age, disability, and where applicable, sex, marital status, familial status, parental status, religion, sexual orientation, genetic information, political beliefs, reprisal, or because all or a part of an individual's income is derived from any public assistance program. (Not all prohibited bases apply to all programs.) Persons with disabilities who require

alternative means for communication of program information (Braille, large print, audiotape, etc.) should contact USDA's TARGET Center at (202) 720-2600 (voice and TDD). To file a complaint of discrimination, write to USDA, Director, Office of Civil Rights, 1400 Independence Avenue, S.W., Washington, D.C. 20250-9410 or call (800) 795-3272 (voice) or (202) 720-6382 (TDD). USDA is an equal opportunity provider and employer.

# Contents

---

<b>Preface</b> .....	2
<b>Soil Map</b> .....	5
Soil Map.....	6
Legend.....	7
Map Unit Legend.....	8
Map Unit Descriptions.....	8
El Paso County Area, Colorado.....	10
14—Brussett loam, 1 to 3 percent slopes.....	10
68—Peyton-Pring complex, 3 to 8 percent slopes.....	11
92—Tomah-Crowfoot loamy sands, 3 to 8 percent slopes.....	12





# Soil Map

---


The soil map section includes the soil map for the defined area of interest, a list of soil map units on the map and extent of each map unit, and cartographic symbols displayed on the map. Also presented are various metadata about data used to produce the map, and a description of each soil map unit.

# Custom Soil Resource Report Soil Map

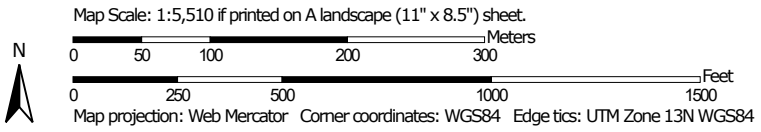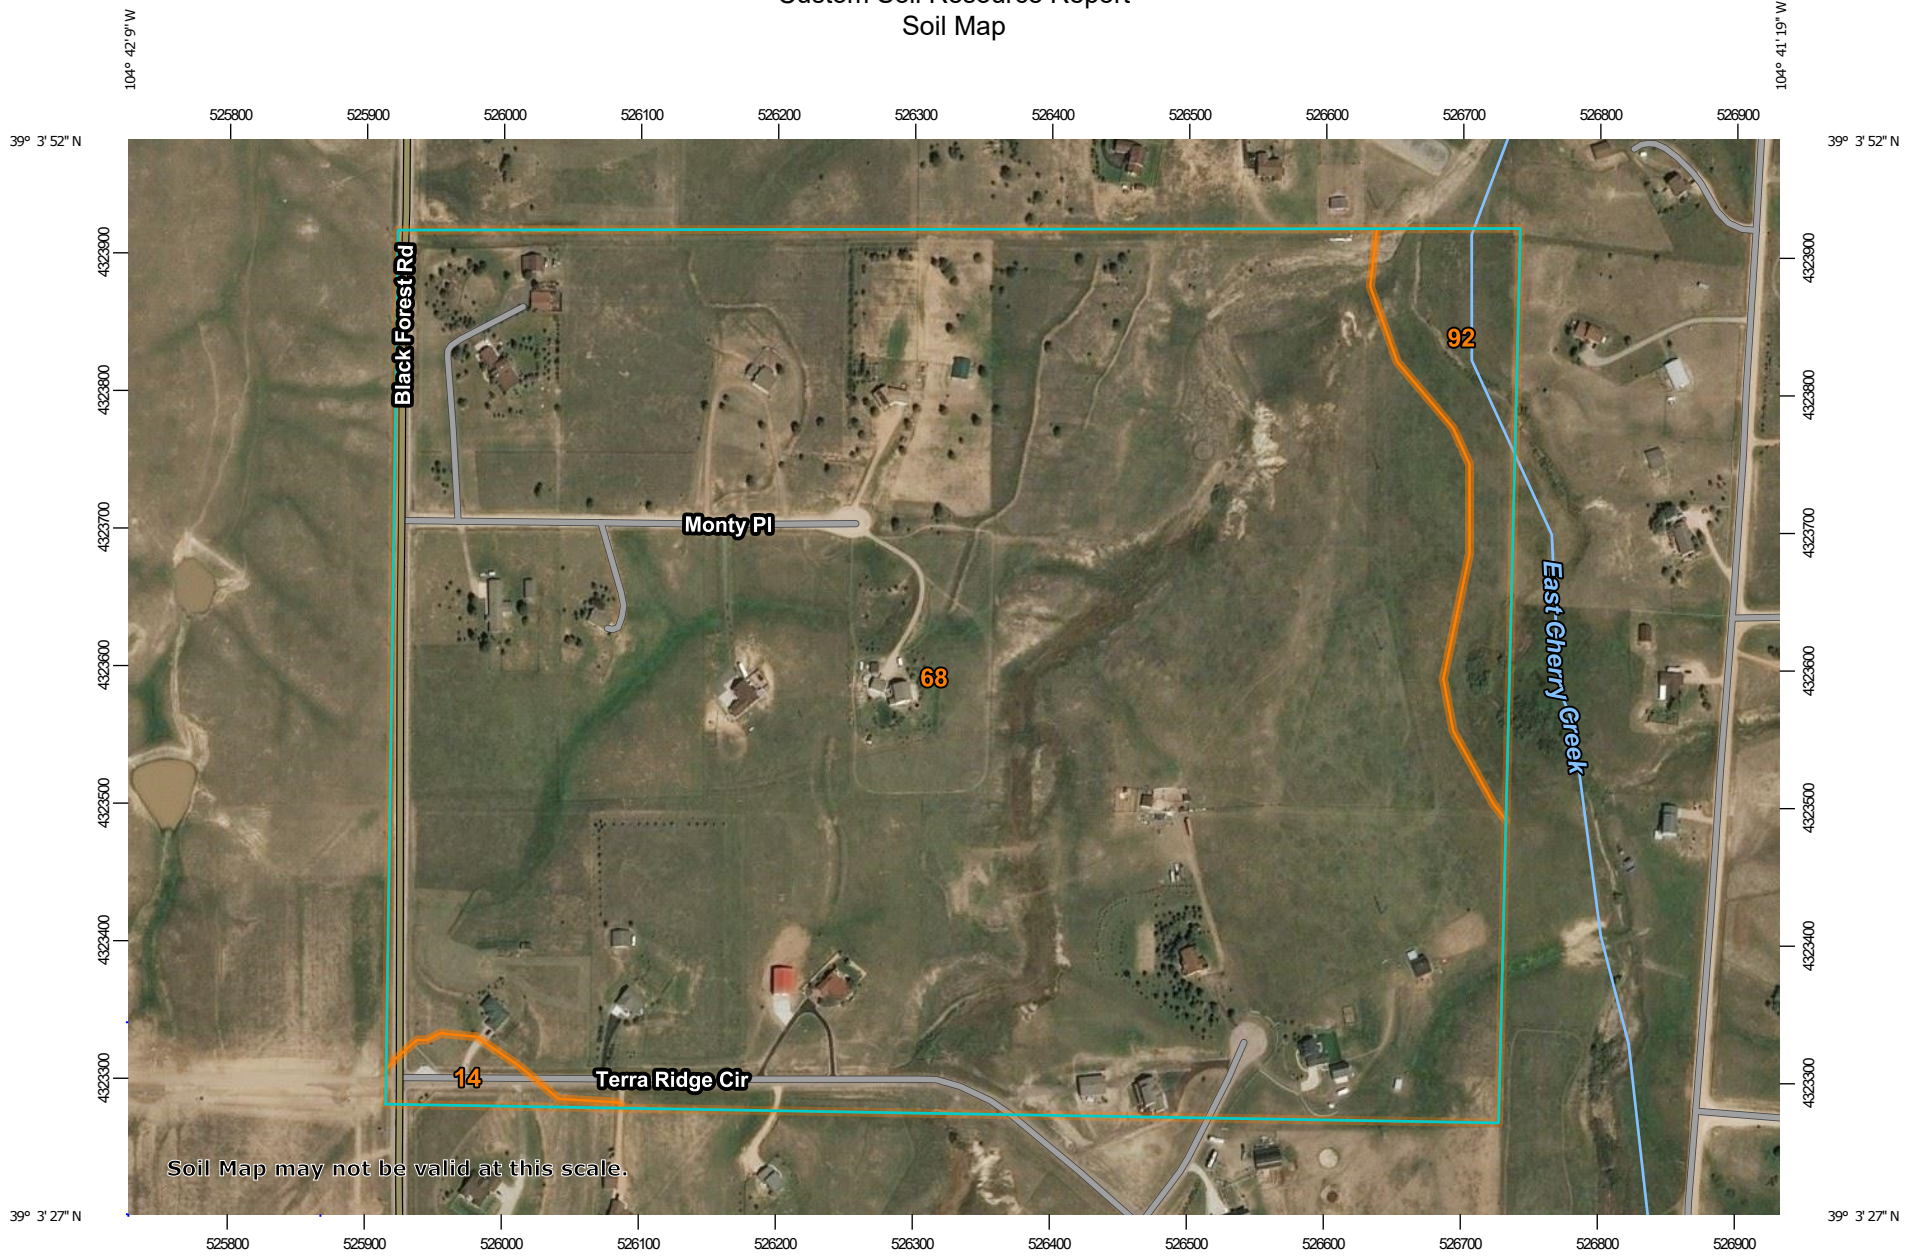

### MAP LEGEND

**Area of Interest (AOI)**

 Area of Interest (AOI)




















**Soils**

 Soil Map Unit Polygons

 Soil Map Unit Lines


 Soil Map Unit Points

**Special Point Features**






-  Blowout
-  Borrow Pit
-  Clay Spot
-  Closed Depression
-  Gravel Pit
-  Gravelly Spot
-  Landfill
-  Lava Flow
-  Marsh or swamp
-  Mine or Quarry
-  Miscellaneous Water
-  Perennial Water
-  Rock Outcrop
-  Saline Spot
-  Sandy Spot
-  Severely Eroded Spot
-  Sinkhole
-  Slide or Slip
-  Sodic Spot

-  Spoil Area
-  Stony Spot
-  Very Stony Spot
-  Wet Spot
-  Other
-  Special Line Features


**Water Features**

 Streams and Canals

**Transportation**

-  Rails
-  Interstate Highways
-  US Routes
-  Major Roads
-  Local Roads

**Background**

 Aerial Photography

### MAP INFORMATION

The soil surveys that comprise your AOI were mapped at 1:24,000.

Warning: Soil Map may not be valid at this scale.

Enlargement of maps beyond the scale of mapping can cause misunderstanding of the detail of mapping and accuracy of soil line placement. The maps do not show the small areas of contrasting soils that could have been shown at a more detailed scale.

Please rely on the bar scale on each map sheet for map measurements.

Source of Map: Natural Resources Conservation Service  
 Web Soil Survey URL:  
 Coordinate System: Web Mercator (EPSG:3857)

Maps from the Web Soil Survey are based on the Web Mercator projection, which preserves direction and shape but distorts distance and area. A projection that preserves area, such as the Albers equal-area conic projection, should be used if more accurate calculations of distance or area are required.

This product is generated from the USDA-NRCS certified data as of the version date(s) listed below.

Soil Survey Area: El Paso County Area, Colorado  
 Survey Area Data: Version 17, Sep 13, 2019

Soil map units are labeled (as space allows) for map scales 1:50,000 or larger.

Date(s) aerial images were photographed: Sep 8, 2018—May 26, 2019

The orthophoto or other base map on which the soil lines were compiled and digitized probably differs from the background imagery displayed on these maps. As a result, some minor shifting of map unit boundaries may be evident.

## Map Unit Legend

Map Unit Symbol	Map Unit Name	Acres in AOI	Percent of AOI
14	Brussett loam, 1 to 3 percent slopes	1.2	1.0%
68	Peyton-Pring complex, 3 to 8 percent slopes	123.2	94.7%
92	Tomah-Crowfoot loamy sands, 3 to 8 percent slopes	5.7	4.4%
<b>Totals for Area of Interest</b>		<b>130.1</b>	<b>100.0%</b>

## Map Unit Descriptions

The map units delineated on the detailed soil maps in a soil survey represent the soils or miscellaneous areas in the survey area. The map unit descriptions, along with the maps, can be used to determine the composition and properties of a unit.

A map unit delineation on a soil map represents an area dominated by one or more major kinds of soil or miscellaneous areas. A map unit is identified and named according to the taxonomic classification of the dominant soils. Within a taxonomic class there are precisely defined limits for the properties of the soils. On the landscape, however, the soils are natural phenomena, and they have the characteristic variability of all natural phenomena. Thus, the range of some observed properties may extend beyond the limits defined for a taxonomic class. Areas of soils of a single taxonomic class rarely, if ever, can be mapped without including areas of other taxonomic classes. Consequently, every map unit is made up of the soils or miscellaneous areas for which it is named and some minor components that belong to taxonomic classes other than those of the major soils.

Most minor soils have properties similar to those of the dominant soil or soils in the map unit, and thus they do not affect use and management. These are called noncontrasting, or similar, components. They may or may not be mentioned in a particular map unit description. Other minor components, however, have properties and behavioral characteristics divergent enough to affect use or to require different management. These are called contrasting, or dissimilar, components. They generally are in small areas and could not be mapped separately because of the scale used. Some small areas of strongly contrasting soils or miscellaneous areas are identified by a special symbol on the maps. If included in the database for a given area, the contrasting minor components are identified in the map unit descriptions along with some characteristics of each. A few areas of minor components may not have been observed, and consequently they are not mentioned in the descriptions, especially where the pattern was so complex that it was impractical to make enough observations to identify all the soils and miscellaneous areas on the landscape.

The presence of minor components in a map unit in no way diminishes the usefulness or accuracy of the data. The objective of mapping is not to delineate pure taxonomic classes but rather to separate the landscape into landforms or

## Custom Soil Resource Report

landform segments that have similar use and management requirements. The delineation of such segments on the map provides sufficient information for the development of resource plans. If intensive use of small areas is planned, however, onsite investigation is needed to define and locate the soils and miscellaneous areas.

An identifying symbol precedes the map unit name in the map unit descriptions. Each description includes general facts about the unit and gives important soil properties and qualities.

Soils that have profiles that are almost alike make up a *soil series*. Except for differences in texture of the surface layer, all the soils of a series have major horizons that are similar in composition, thickness, and arrangement.

Soils of one series can differ in texture of the surface layer, slope, stoniness, salinity, degree of erosion, and other characteristics that affect their use. On the basis of such differences, a soil series is divided into *soil phases*. Most of the areas shown on the detailed soil maps are phases of soil series. The name of a soil phase commonly indicates a feature that affects use or management. For example, Alpha silt loam, 0 to 2 percent slopes, is a phase of the Alpha series.

Some map units are made up of two or more major soils or miscellaneous areas. These map units are complexes, associations, or undifferentiated groups.

A *complex* consists of two or more soils or miscellaneous areas in such an intricate pattern or in such small areas that they cannot be shown separately on the maps. The pattern and proportion of the soils or miscellaneous areas are somewhat similar in all areas. Alpha-Beta complex, 0 to 6 percent slopes, is an example.

An *association* is made up of two or more geographically associated soils or miscellaneous areas that are shown as one unit on the maps. Because of present or anticipated uses of the map units in the survey area, it was not considered practical or necessary to map the soils or miscellaneous areas separately. The pattern and relative proportion of the soils or miscellaneous areas are somewhat similar. Alpha-Beta association, 0 to 2 percent slopes, is an example.

An *undifferentiated group* is made up of two or more soils or miscellaneous areas that could be mapped individually but are mapped as one unit because similar interpretations can be made for use and management. The pattern and proportion of the soils or miscellaneous areas in a mapped area are not uniform. An area can be made up of only one of the major soils or miscellaneous areas, or it can be made up of all of them. Alpha and Beta soils, 0 to 2 percent slopes, is an example.

Some surveys include *miscellaneous areas*. Such areas have little or no soil material and support little or no vegetation. Rock outcrop is an example.

## El Paso County Area, Colorado

### 14—Brussett loam, 1 to 3 percent slopes

#### Map Unit Setting

*National map unit symbol:* 367j  
*Elevation:* 7,200 to 7,500 feet  
*Frost-free period:* 115 to 125 days  
*Farmland classification:* Prime farmland if irrigated

#### Map Unit Composition

*Brussett and similar soils:* 85 percent  
*Estimates are based on observations, descriptions, and transects of the mapunit.*

#### Description of Brussett

##### Setting

*Landform:* Flats  
*Landform position (three-dimensional):* Talf  
*Down-slope shape:* Linear  
*Across-slope shape:* Linear  
*Parent material:* Eolian deposits

##### Typical profile

*A - 0 to 8 inches:* loam  
*BA - 8 to 12 inches:* loam  
*Bt - 12 to 26 inches:* clay loam  
*Bk - 26 to 60 inches:* silt loam

##### Properties and qualities

*Slope:* 1 to 3 percent  
*Depth to restrictive feature:* More than 80 inches  
*Natural drainage class:* Well drained  
*Runoff class:* Low  
*Capacity of the most limiting layer to transmit water (Ksat):* Moderately high (0.20 to 0.60 in/hr)  
*Depth to water table:* More than 80 inches  
*Frequency of flooding:* None  
*Frequency of ponding:* None  
*Calcium carbonate, maximum in profile:* 5 percent  
*Salinity, maximum in profile:* Nonsaline to very slightly saline (0.0 to 2.0 mmhos/cm)  
*Available water storage in profile:* High (about 9.1 inches)

##### Interpretive groups

*Land capability classification (irrigated):* None specified  
*Land capability classification (nonirrigated):* 3c  
*Hydrologic Soil Group:* B  
*Ecological site:* Loamy Park (R048AY222CO)  
*Hydric soil rating:* No

#### Minor Components

##### Other soils

*Percent of map unit:*  
*Hydric soil rating:* No



## 68—Peyton-Pring complex, 3 to 8 percent slopes

### Map Unit Setting

*National map unit symbol:* 369f

*Elevation:* 6,800 to 7,600 feet

*Farmland classification:* Not prime farmland

### Map Unit Composition

*Peyton and similar soils:* 40 percent

*Pring and similar soils:* 30 percent

*Estimates are based on observations, descriptions, and transects of the mapunit.*

### Description of Peyton

#### Setting

*Landform:* Hills

*Landform position (three-dimensional):* Side slope

*Down-slope shape:* Linear

*Across-slope shape:* Linear

*Parent material:* Arkosic alluvium derived from sedimentary rock and/or arkosic residuum weathered from sedimentary rock

#### Typical profile

*A - 0 to 12 inches:* sandy loam

*Bt - 12 to 25 inches:* sandy clay loam

*BC - 25 to 35 inches:* sandy loam

*C - 35 to 60 inches:* sandy loam

#### Properties and qualities

*Slope:* 3 to 5 percent

*Depth to restrictive feature:* More than 80 inches

*Natural drainage class:* Well drained

*Runoff class:* Low

*Capacity of the most limiting layer to transmit water (Ksat):* Moderately high (0.20 to 0.60 in/hr)

*Depth to water table:* More than 80 inches

*Frequency of flooding:* None

*Frequency of ponding:* None

*Available water storage in profile:* Moderate (about 7.3 inches)

#### Interpretive groups

*Land capability classification (irrigated):* None specified

*Land capability classification (nonirrigated):* 4c

*Hydrologic Soil Group:* B

*Ecological site:* Sandy Divide (R049BY216CO)

*Hydric soil rating:* No

## Description of Pring

### Setting

*Landform:* Hills

*Landform position (three-dimensional):* Side slope

*Down-slope shape:* Linear

*Across-slope shape:* Linear

*Parent material:* Arkosic alluvium derived from sedimentary rock

### Typical profile

*A - 0 to 14 inches:* coarse sandy loam

*C - 14 to 60 inches:* gravelly sandy loam

### Properties and qualities

*Slope:* 3 to 8 percent

*Depth to restrictive feature:* More than 80 inches

*Natural drainage class:* Well drained

*Runoff class:* Low

*Capacity of the most limiting layer to transmit water (Ksat):* High (2.00 to 6.00 in/hr)

*Depth to water table:* More than 80 inches

*Frequency of flooding:* None

*Frequency of ponding:* None

*Available water storage in profile:* Low (about 6.0 inches)

### Interpretive groups

*Land capability classification (irrigated):* None specified

*Land capability classification (nonirrigated):* 3e

*Hydrologic Soil Group:* B

*Ecological site:* Loamy Park (R048AY222CO)

*Hydric soil rating:* No

## Minor Components

### Other soils

*Percent of map unit:*

*Hydric soil rating:* No

### Pleasant

*Percent of map unit:*

*Landform:* Depressions

*Hydric soil rating:* Yes

## 92—Tomah-Crowfoot loamy sands, 3 to 8 percent slopes

### Map Unit Setting

*National map unit symbol:* 36b9

*Elevation:* 7,300 to 7,600 feet

*Farmland classification:* Not prime farmland

**Map Unit Composition**

*Tomah and similar soils:* 50 percent

*Crowfoot and similar soils:* 30 percent

*Estimates are based on observations, descriptions, and transects of the mapunit.*

**Description of Tomah**

**Setting**

*Landform:* Hills, alluvial fans

*Landform position (three-dimensional):* Side slope, crest

*Down-slope shape:* Linear

*Across-slope shape:* Linear

*Parent material:* Alluvium derived from arkose and/or residuum weathered from arkose

**Typical profile**

*A - 0 to 10 inches:* loamy sand

*E - 10 to 22 inches:* coarse sand

*C - 48 to 60 inches:* coarse sand

**Properties and qualities**

*Slope:* 3 to 8 percent

*Depth to restrictive feature:* More than 80 inches

*Natural drainage class:* Well drained

*Runoff class:* Medium

*Capacity of the most limiting layer to transmit water (Ksat):* Moderately high to high (0.60 to 2.00 in/hr)

*Depth to water table:* More than 80 inches

*Frequency of flooding:* None

*Frequency of ponding:* None

*Available water storage in profile:* Very low (about 2.0 inches)

**Interpretive groups**

*Land capability classification (irrigated):* None specified

*Land capability classification (nonirrigated):* 4e

*Hydrologic Soil Group:* B

*Ecological site:* Sandy Divide (R049BY216CO)

*Hydric soil rating:* No

**Description of Crowfoot**

**Setting**

*Landform:* Alluvial fans, hills

*Landform position (three-dimensional):* Side slope, crest

*Down-slope shape:* Linear

*Across-slope shape:* Linear

*Parent material:* Alluvium

**Typical profile**

*A - 0 to 12 inches:* loamy sand

*E - 12 to 23 inches:* sand

*Bt - 23 to 36 inches:* sandy clay loam

*C - 36 to 60 inches:* coarse sand

**Properties and qualities**

*Slope:* 3 to 8 percent

*Depth to restrictive feature:* More than 80 inches

## Custom Soil Resource Report

*Natural drainage class:* Well drained

*Runoff class:* Medium

*Capacity of the most limiting layer to transmit water (Ksat):* Moderately high to high (0.60 to 2.00 in/hr)

*Depth to water table:* More than 80 inches

*Frequency of flooding:* None

*Frequency of ponding:* None

*Available water storage in profile:* Low (about 4.7 inches)

### **Interpretive groups**

*Land capability classification (irrigated):* None specified

*Land capability classification (nonirrigated):* 4e

*Hydrologic Soil Group:* B

*Ecological site:* Sandy Divide (R049BY216CO)

*Hydric soil rating:* No

### **Minor Components**

#### **Other soils**

*Percent of map unit:*

*Hydric soil rating:* No

#### **Pleasant**

*Percent of map unit:*


*Landform:* Depressions

*Hydric soil rating:* Yes

# National Flood Hazard Layer FIRMette



39°3'52.64"N

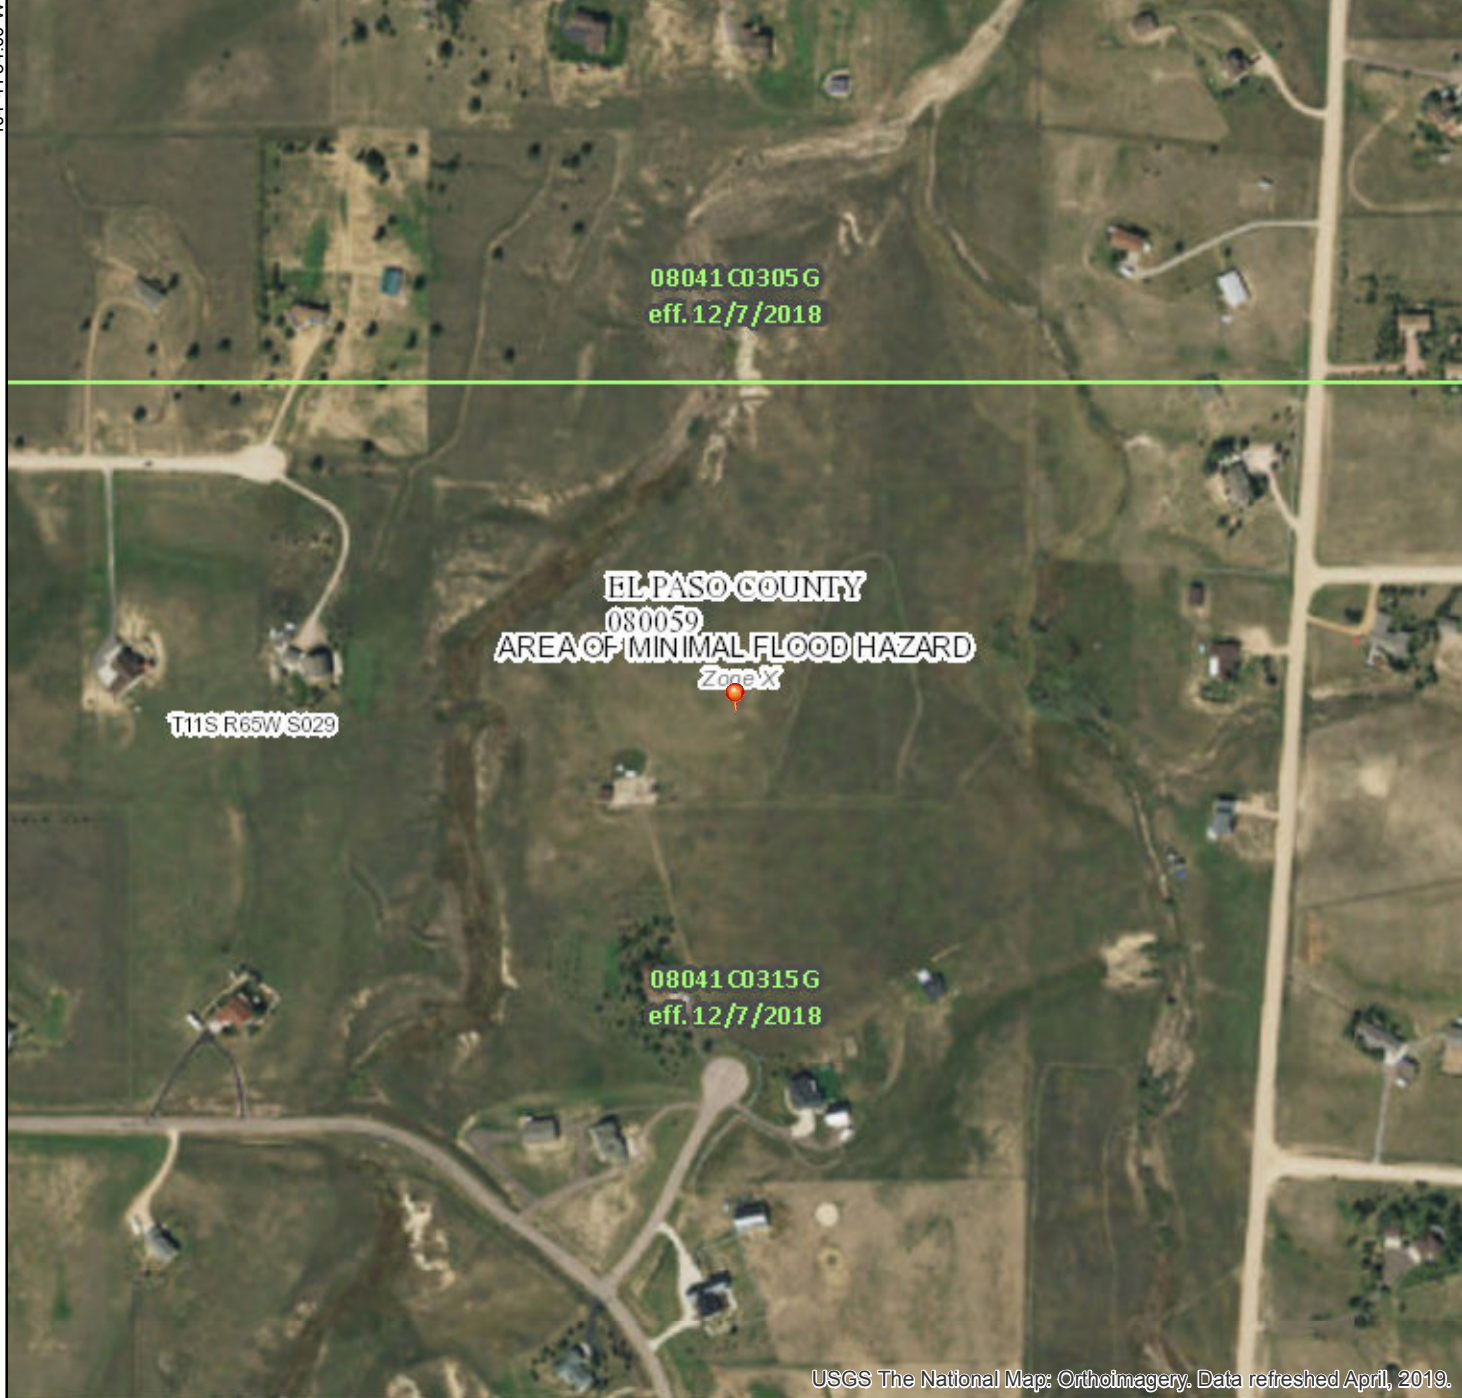

## Legend

SEE FIS REPORT FOR DETAILED LEGEND AND INDEX MAP FOR FIRM PANEL LAYOUT

- |                                    |  |  |
|------------------------------------|--|--|
| <b>SPECIAL FLOOD HAZARD AREAS</b>  |  | Without Base Flood Elevation (BFE)<br><i>Zone A, V, A99</i>  |
|                                    |  | With BFE or Depth <i>Zone AE, AO, AH, VE, AR</i>   |
|                                    |  | Regulatory Floodway  |
| <b>OTHER AREAS OF FLOOD HAZARD</b> |  | 0.2% Annual Chance Flood Hazard, Areas of 1% annual chance flood with average depth less than one foot or with drainage areas of less than one square mile <i>Zone X</i> |
|                                    |  | Future Conditions 1% Annual Chance Flood Hazard <i>Zone X</i>  |
|                                    |  | Area with Reduced Flood Risk due to Levee. See Notes. <i>Zone X</i>  |
|                                    |  | Area with Flood Risk due to Levee <i>Zone D</i>  |
| <b>OTHER AREAS</b>                 |  | NO SCREEN Area of Minimal Flood Hazard <i>Zone X</i>   |
|                                    |  | Effective LOMRs  |
| <b>GENERAL STRUCTURES</b>          |  | Area of Undetermined Flood Hazard <i>Zone D</i>  |
|                                    |  | Channel, Culvert, or Storm Sewer   |
|                                    |  | Levee, Dike, or Floodwall  |
| <b>OTHER FEATURES</b>              |  | 20.2 Cross Sections with 1% Annual Chance  |
|                                    |  | 17.5 Water Surface Elevation   |
|                                    |  | Coastal Transect   |
|                                    |  | Base Flood Elevation Line (BFE)  |
|                                    |  | Limit of Study   |
| <b>MAP PANELS</b>                  |  | Jurisdiction Boundary  |
|                                    |  | Coastal Transect Baseline  |
|                                    |  | Profile Baseline   |
|                                    |  | Hydrographic Feature   |
|                                    |  | Digital Data Available   |
|                                    |  | No Digital Data Available  |
|                                    |  | Unmapped   |

The pin displayed on the map is an approximate point selected by the user and does not represent an authoritative property location.

This map complies with FEMA's standards for the use of digital flood maps if it is not void as described below. The basemap shown complies with FEMA's basemap accuracy standards

The flood hazard information is derived directly from the authoritative NFHL web services provided by FEMA. This map was exported on **10/28/2019 at 7:40:48 PM** and does not reflect changes or amendments subsequent to this date and time. The NFHL and effective information may change or become superseded by new data over time.

This map image is void if the one or more of the following map elements do not appear: basemap imagery, flood zone labels, legend, scale bar, map creation date, community identifiers, FIRM panel number, and FIRM effective date. Map images for unmapped and unmodernized areas cannot be used for regulatory purposes.



104°41'54.00"W

104°41'16.54"W

**Appendix B**  
**Calculations**



**FINAL DRAINAGE REPORT**  
**Terra Ridge North**  
**(Composite Runoff Coefficient - 5 Year)**

<b>ON-SITE</b>							
<b>Basin</b>	<b>Area (acres)</b>						<b>C5</b>
	<b>Paved/Drive/Walk</b>	<b>Res 2.5ac</b>	<b>Gravel</b>	<b>Lawn/Meadow</b>	<b>Undev - Hist</b>	<b>TOTAL</b>	
A	0.43	2.69	0.12	0.96	0.00	4.20	0.18
B	0.40	0.00	0.06	0.49	0.00	0.94	0.46
C	Not Used						
D	0.19	14.38	0.02	0.00	0.00	14.59	0.09
E	0.17	6.18	0.02	0.00	0.00	6.36	0.10
F	0.00	14.15	0.00	0.00	0.00	14.15	0.08

<b>OFF-SITE</b>							
<b>Basin</b>	<b>Area (acres)</b>						<b>C5</b>
	<b>Paved/Drive/Walks</b>	<b>Res 5ac</b>	<b>Gravel</b>	<b>Lawn/Meadow</b>	<b>Undev - Hist</b>	<b>TOTAL</b>	
OS1	0.00	30.00	0.00	0.00	0.00	30.00	0.05
OS2	0.13	6.23	0.00	0.00	0.00	6.36	0.07

<b>EXISTING</b>							
<b>Basin</b>	<b>Area (acres)</b>						<b>C5</b>
	<b>Paved/Drive/Walks</b>	<b>Res 5ac</b>	<b>Gravel</b>	<b>Lawn/Meadow</b>	<b>Undev - Hist</b>	<b>TOTAL</b>	
EX1	0.00	0.00	0.00	0.00	24.84	24.84	0.09
EX2	0.00	0.00	0.00	0.00	14.10	14.10	0.09

Per DCM Table 6-6 Vol 1 Update

<b>Surface</b>	<b>Runoff Coefficient</b>
Paved/Drive/Walk	0.90
Res 2.5ac	0.08
Res 5ac	0.05
Gravel	0.59
Lawn/Meadow	0.08
Undev - Hist	0.09

Note: Res 2.5ac and Res 5ac C5 based on 11% Imp and 5% Imp (Table 3-1) and Interpolation of MHFD table 6-5

**FINAL DRAINAGE REPORT**  
**Terra Ridge North**  
**(Composite Runoff Coefficient - 100 Year)**

<b>ON-SITE</b>							
<b>Basin</b>	<b>Area (acres)</b>						<b>C100</b>
	<b>Paved/Drive/Walk</b>	<b>Res 2.5ac</b>	<b>Gravel</b>	<b>Lawn/Meadow</b>	<b>Undev - Hist</b>	<b>TOTAL</b>	
A	0.43	2.69	0.12	0.96	0.00	4.20	0.51
B	0.40	0.00	0.06	0.49	0.00	0.94	0.63
C	Not Used						
D	0.19	14.38	0.02	0.00	0.00	14.59	0.49
E	0.17	6.18	0.02	0.00	0.00	6.36	0.49
F	0.00	14.15	0.00	0.00	0.00	14.15	0.48

<b>OFF-SITE</b>							
<b>Basin</b>	<b>Area (acres)</b>						<b>C100</b>
	<b>Paved/Drive/Walks</b>	<b>Res 5ac</b>	<b>Gravel</b>	<b>Lawn/Meadow</b>	<b>Undev - Hist</b>	<b>TOTAL</b>	
OS1	0.00	30.00	0.00	0.00	0.00	30.00	0.46
OS2	0.13	6.23	0.00	0.00	0.00	6.36	0.47

<b>EXISTING</b>							
<b>Basin</b>	<b>Area (acres)</b>						<b>C100</b>
	<b>Paved/Drive/Walks</b>	<b>Res 5ac</b>	<b>Gravel</b>	<b>Lawn/Meadow</b>	<b>Undev - Hist</b>	<b>TOTAL</b>	
EX1	0.00	0.00	0.00	0.00	24.84	24.84	0.36
EX2	0.00	0.00	0.00	0.00	14.10	14.10	0.36

Per DCM Table 6-6 Vol 1 Update

<b>Surface</b>	<b>Runoff Coefficient</b>
Paved/Drive/Walk	0.96
Res 2.5ac	0.48
Res 5ac	0.46
Gravel	0.70
Lawn/Meadow	0.35
Undev - Hist	0.36

Note: Res 2.5ac and Res 5ac C5 based on 11% Imp and 5% Imp (Table 3-1) and Interpolation of MHFD table 6-5

**FINAL DRAINAGE REPORT**  
**Terra Ridge North**  
**(Percentage of Imperviousness)**

<b>ON-SITE: PROPOSED</b>							
<i>Basin</i>	<i>Area (acres)</i>						<i>% Imp</i>
	<i>Paved/Drive/Walk</i>	<i>Res 2.5ac</i>	<i>Gravel</i>	<i>Lawn/Meadow</i>	<i>Undev - Hist</i>	<i>TOTAL</i>	
<i>A</i>	0.43	2.69	0.12	0.96	0.00	4.20	19.68
<i>B</i>	0.48	0.00	0.06	0.49	0.00	1.02	51.42
<i>C</i>	NOT USED						
<i>D</i>	0.00	14.38	0.02	0.00	0.00	14.40	11.10
<i>E</i>	0.17	6.18	0.02	0.00	0.00	6.36	13.49
<i>F</i>	0.00	14.15	0.00	0.00	0.00	14.15	11.00
<b>Totals</b>	<b>1.08</b>	<b>37.39</b>	<b>0.22</b>	<b>1.44</b>	<b>0.00</b>	<b>40.12</b>	<b>13.37</b>

<b>OFF-SITE: PROPOSED</b>							
<i>Basin</i>	<i>Area (acres)</i>						<i>% Imp</i>
	<i>Paved/Drive/Walks</i>	<i>Res 5ac</i>	<i>Gravel</i>	<i>Lawn/Meadow</i>	<i>Undev - Hist</i>	<i>TOTAL</i>	
<i>OS1</i>	0.00	30.00	0.00	0.00	0.00	30.00	7.00
<i>OS2</i>	0.13	6.23	0.00	0.00	0.00	6.36	8.93
<b>Totals</b>	<b>0.13</b>	<b>36.23</b>	<b>0.00</b>	<b>0.00</b>	<b>0.00</b>	<b>36.36</b>	<b>7.34</b>

<b>TO POND: PROPOSED</b>							
<i>A,B</i>	<b>0.91</b>	<b>2.69</b>	<b>0.18</b>	<b>1.44</b>	<b>0.00</b>	<b>5.22</b>	<b>25.90</b>

<b>EXISTING</b>							
<i>Basin</i>	<i>Area (acres)</i>						<i>% Imp</i>
	<i>Paved/Drive/Walks</i>	<i>Res 5ac</i>	<i>Gravel</i>	<i>Lawn/Meadow</i>	<i>Undev - Hist</i>	<i>TOTAL</i>	
<i>EX1</i>	0.00	0.00	0.00	0.00	24.84	24.84	2.00
<i>EX2</i>	0.00	0.00	0.00	0.00	14.10	14.10	2.00
<b>Totals</b>	<b>0.00</b>	<b>0.00</b>	<b>0.00</b>	<b>0.00</b>	<b>38.94</b>	<b>38.94</b>	<b>2.00</b>

Per DCM Table 6-6

Surface	% Impervious
Paved/Drive/Walk	100
Res 2.5ac	11
Res 5ac	7
Gravel	80
Lawn/Meadow	0
Undeveloped - Historic	2

Note: Res 2.5+ac % Imp. Per ECM Appendix L, Table 3-1

*Final Drainage Report*  
***Terra Ridge North***  
***(Basin Summary)***

<i>From Area Runoff Coefficient Summary</i>				<b>OVERLAND FLOW TIME</b>				<b>TRAVEL TIME</b>					<b>TOTAL</b>	<b>INTENSITY *</b>		<b>TOTAL FLOWS</b>	
<b>BASIN</b>	<b>AREA TOTAL</b> <i>(Acres)</i>	<b>C<sub>5</sub></b>	<b>C<sub>100</sub></b>	<b>C<sub>5</sub></b>	<b>Length</b> <i>(ft)</i>	<b>Height</b> <i>(ft)</i>	<b>T<sub>C</sub></b> <i>(min)</i>	<b>Conveyance Coeff.</b>	<b>Slope</b> <i>(%)</i>	<b>Length</b> <i>(ft)</i>	<b>Velocity</b> <i>(fps)</i>	<b>T<sub>t</sub></b> <i>(min)</i>		<b>I<sub>5</sub></b> <i>(in/hr)</i>	<b>I<sub>100</sub></b> <i>(in/hr)</i>	<b>Q<sub>5</sub></b> <i>(c.f.s.)</i>	<b>Q<sub>100</sub></b> <i>(c.f.s.)</i>
<small><i>From DCM Table 6-6</i></small>																	
<b>A</b>	4.20	0.18	0.51	0.18	150	10	11.3	15	4.0%	320	3.0	1.8	13.0	3.7	6.3	<b>2.8</b>	<b>13.4</b>
<b>B</b>	1.02	0.46	0.63	0.46	10	3.3	1.2	15	5.6%	1285	3.5	6.0	7.2	4.6	7.8	<b>2.2</b>	<b>5.0</b>
<b>C</b>	Basin C no longer used. Combined into Basin E																
<b>D</b>	14.40	0.09	0.49	0.09	300	24	16.5	10	5.0%	240	2.2	1.8	18.3	3.2	5.4	<b>4.2</b>	<b>38.2</b>
<b>E</b>	6.36	0.10	0.49	0.10	300	20	17.3	15	4.9%	70	3.3	0.4	17.7	3.3	5.5	<b>2.1</b>	<b>17.1</b>
<b>F</b>	14.15	0.08	0.48	0.08	300	28	15.8	15	3.2%	1180	2.7	7.3	23.1	2.9	4.8	<b>3.2</b>	<b>32.7</b>
<b>OSI</b>	30.00	0.05	0.46	0.05	300	12	21.5	15	3.0%	815	2.6	5.2	26.8	2.7	4.5	<b>4.0</b>	<b>61.4</b>
<b>OS2</b>	6.36	0.07	0.47	0.07	300	10	22.4	15	3.0%	580	2.6	3.7	26.1	2.7	4.5	<b>1.2</b>	<b>13.5</b>
<b>EX1</b>	24.84	0.09	0.36	0.09	300	24	16.5	15	5.0%	990	3.4	4.9	21.4	3.0	5.0	<b>6.7</b>	<b>44.9</b>
<b>EX2</b>	14.10	0.09	0.36	0.09	300	28	15.7	15	3.2%	1180	2.7	7.3	23.0	2.9	4.8	<b>3.7</b>	<b>24.5</b>

\* Intensity equations assume a minimum travel time of 5 minutes.

Calculated by: PSM  
Date: 2/5/2023  
Checked by: PSM

**FINAL DRAINAGE REPORT**  
**Terra Ridge North**  
**(Surface Routing Summary)**

<i>Design Point(s)</i>	<i>Contributing Basins/Design Points</i>	<i>Equivalent CA<sub>5</sub></i>	<i>Equivalent CA<sub>100</sub></i>	<i>Maximum T<sub>C</sub></i>	<i>Intensity</i>		<i>Flow</i>		<i>Comments</i>
					<i>I<sub>5</sub></i>	<i>I<sub>100</sub></i>	<i>Q<sub>5</sub></i>	<i>Q<sub>100</sub></i>	
1	B	0.43	0.59	7.5	4.6	7.6	<b>2.0</b>	<b>4.5</b>	<i>To proposed 18" culvert</i>
2	DP1, A	1.19	2.73	11.6	3.9	6.6	<b>4.6</b>	<b>18.0</b>	<i>To proposed pond (inflow)</i>
3	JR ENG DP-005	47.97	118.08	45.9	1.8	3.1	<b>86.3</b>	<b>366.0</b>	<i>Creek flow at entrance to property</i>
4	DP3, OS1, OS2, D	3.26	23.94	55.1	1.6	2.6	<b>92.1</b>	<b>432.0</b>	<i>To proposed Triple 54" culverts</i>
5	DP4, E, F, JR17, POND OUT	DP4, Basin E and F Routed, Pond Out and JR 17 Direct Addition					<b>100.1</b>	<b>472.7</b>	<i>Proposed Site Outfall - Compare to DP EX</i>
EX	JR ENG DP-005, JR17, OS1, OS2, EX1	JR ENG DP-005 and OS1 and OS2 and EX1 routed, JR17 Direct Addition					<b>96.9</b>	<b>433.7</b>	<i>Existing Site Outfall - Compare to DP 5</i>

# Channel Report

## Basin A ditch 100yr Sta 6+50

### Triangular

Side Slopes (z:1) = 4.00, 3.00

Total Depth (ft) = 2.00

Invert Elev (ft) = 100.00

Slope (%) = 3.50

N-Value = 0.040

### Calculations

Compute by: Known Q

Known Q (cfs) = 4.70

### Highlighted

Depth (ft) = 0.65

Q (cfs) = 4.700

Area (sqft) = 1.48


Velocity (ft/s) = 3.18

Wetted Perim (ft) = 4.74

Crit Depth, Yc (ft) = 0.65

Top Width (ft) = 4.55

EGL (ft) = 0.81

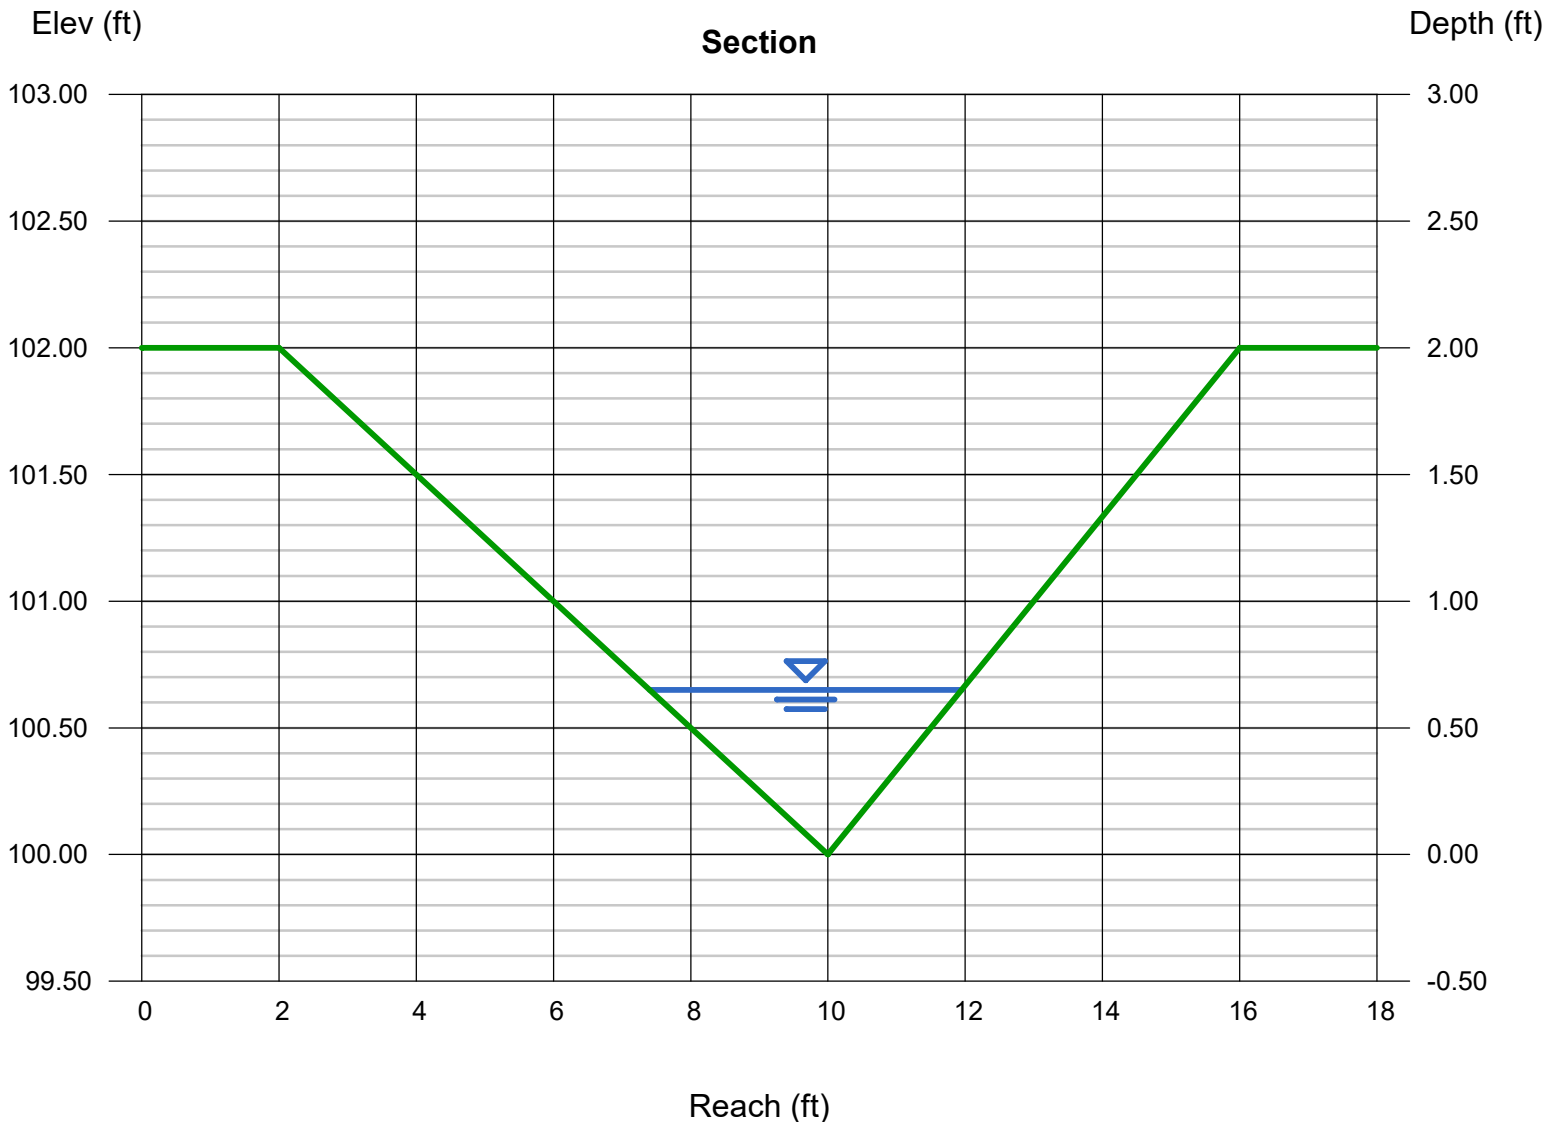

# Channel Report

## Basin A ditch 100yr Sta 10+00

### Triangular

Side Slopes (z:1) = 4.00, 3.00

Total Depth (ft) = 2.00

Invert Elev (ft) = 100.00

Slope (%) = 6.50

N-Value = 0.040

### Calculations

Compute by: Known Q

Known Q (cfs) = 5.50

### Highlighted

Depth (ft) = 0.62

Q (cfs) = 5.500

Area (sqft) = 1.35


Velocity (ft/s) = 4.09

Wetted Perim (ft) = 4.52

Crit Depth, Yc (ft) = 0.69

Top Width (ft) = 4.34

EGL (ft) = 0.88

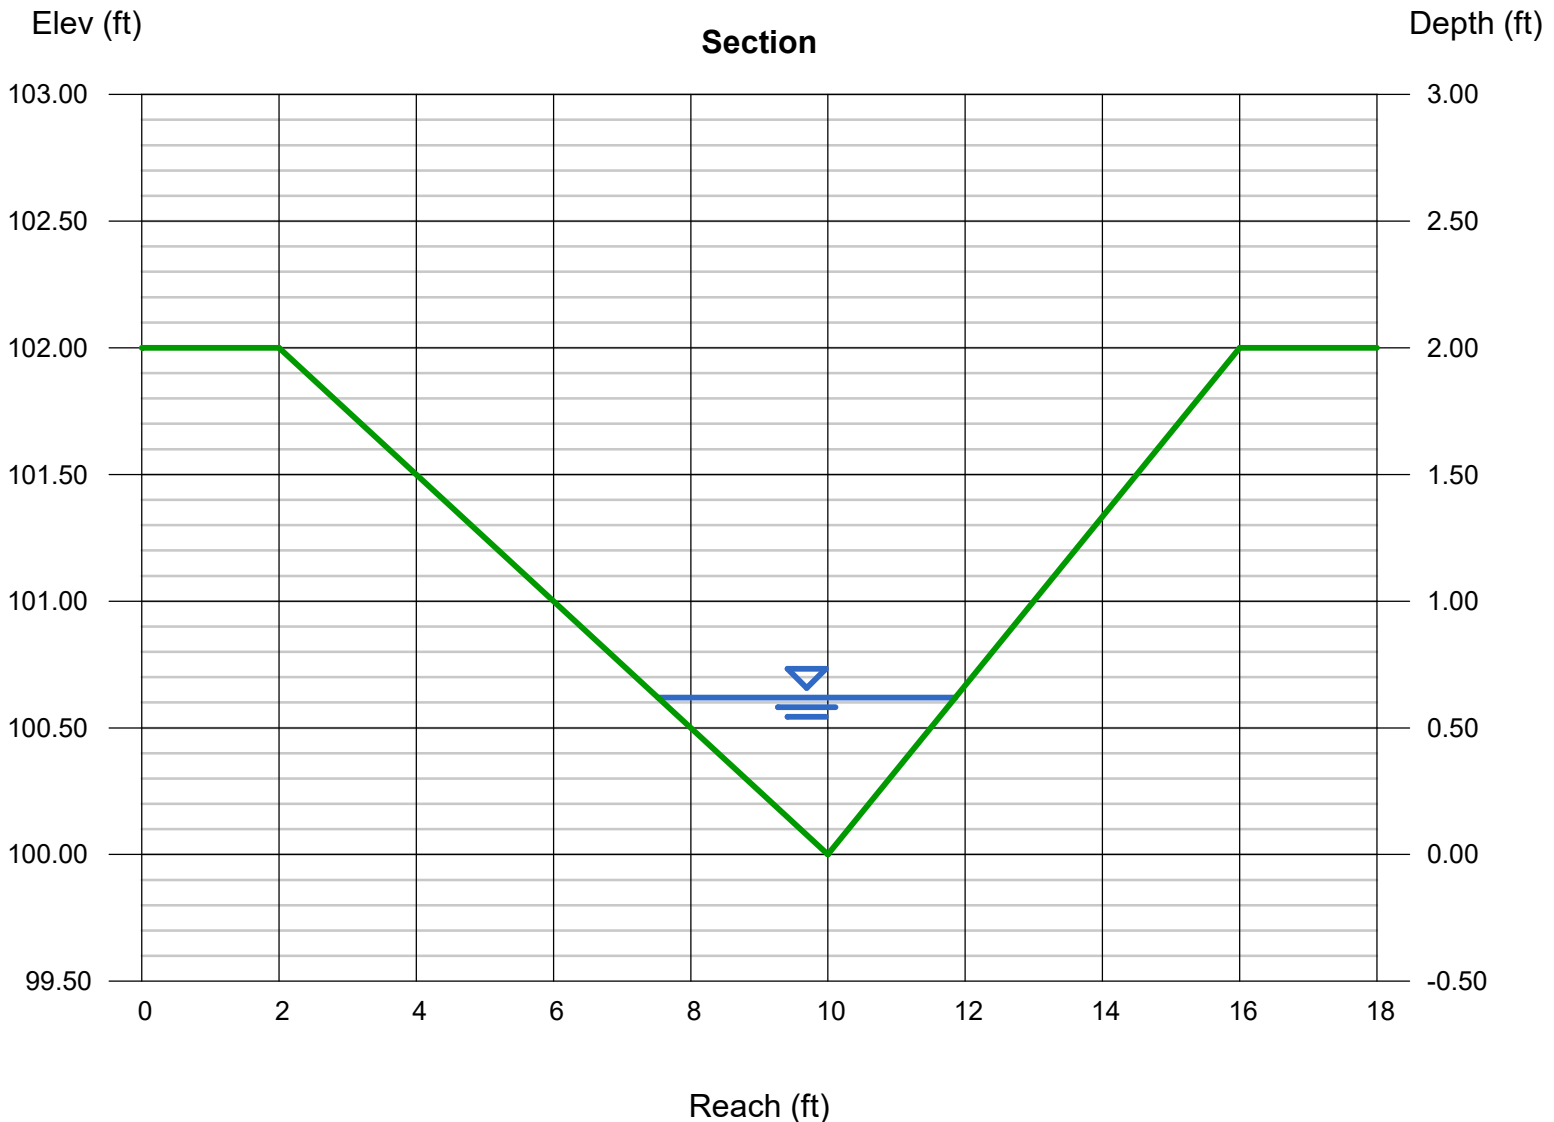



# Channel Report

## Basin A ditch 100yr Sta 12+00

### Triangular

Side Slopes (z:1) = 4.00, 3.00

Total Depth (ft) = 2.00

Invert Elev (ft) = 100.00

Slope (%) = 8.30

N-Value = 0.040

### Calculations

Compute by: Known Q

Known Q (cfs) = 9.80

### Highlighted

Depth (ft) = 0.73

Q (cfs) = 9.800

Area (sqft) = 1.87


Velocity (ft/s) = 5.25

Wetted Perim (ft) = 5.32

Crit Depth, Yc (ft) = 0.87

Top Width (ft) = 5.11

EGL (ft) = 1.16

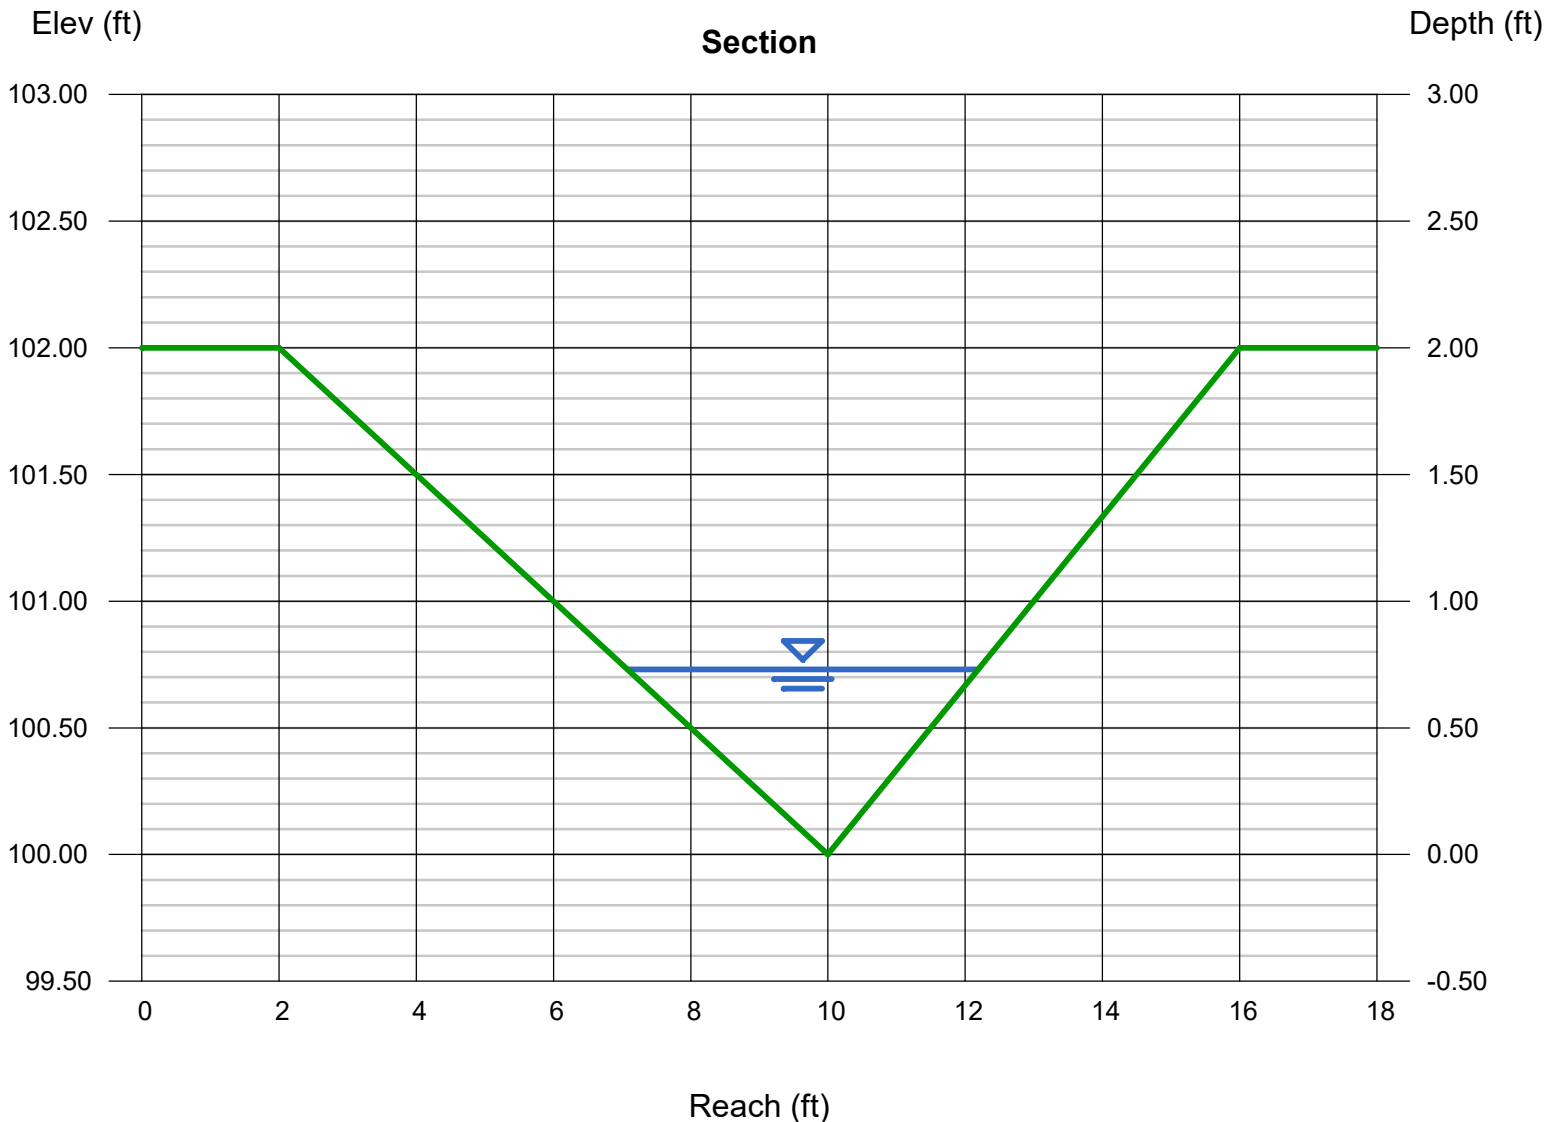

# Channel Report

## Basin A + B ditch 100ft South of Pond

### Triangular

Side Slopes (z:1) = 3.00, 3.00  
Total Depth (ft) = 2.00


Invert Elev (ft) = 100.00  
Slope (%) = 5.60  
N-Value = 0.040

### Calculations

Compute by: Known Q  
Known Q (cfs) = 17.80

### Highlighted

Depth (ft) = 1.04  
Q (cfs) = 17.80  
Area (sqft) = 3.24  
Velocity (ft/s) = 5.49  
Wetted Perim (ft) = 6.58  
Crit Depth, Yc (ft) = 1.17  
Top Width (ft) = 6.24  
EGL (ft) = 1.51

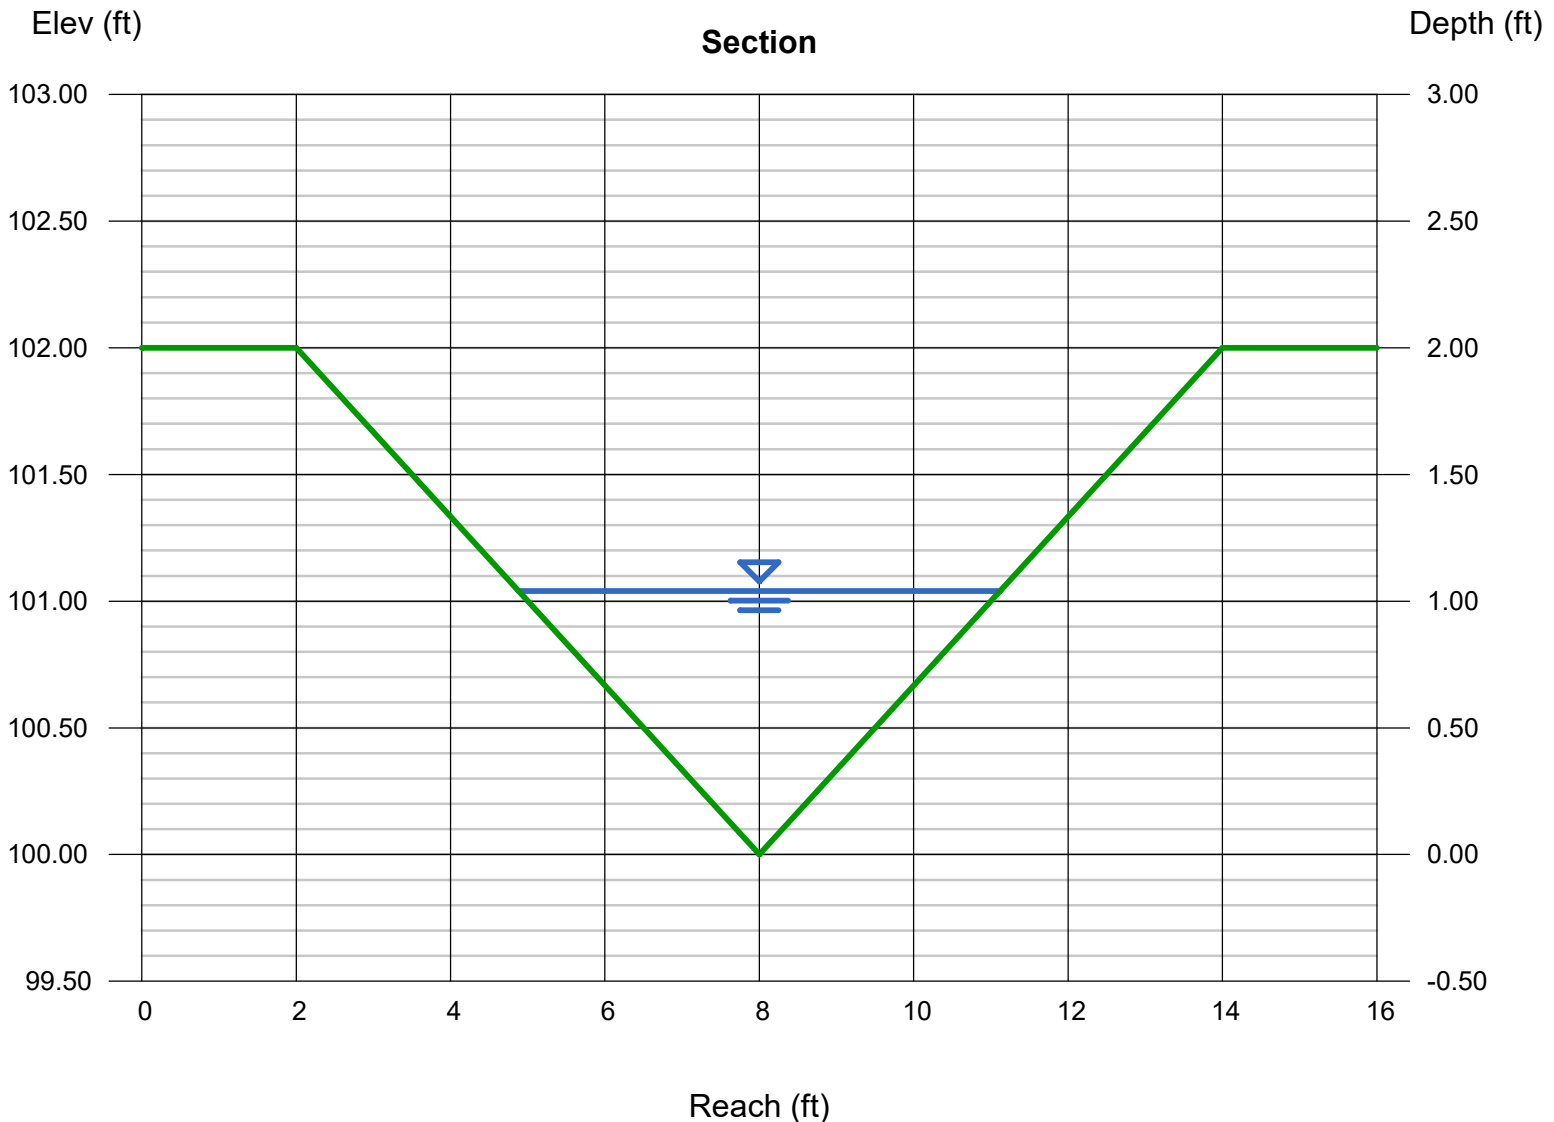

# Channel Report

## Main 75ft DS of Driveway

### User-defined

Invert Elev (ft) = 44.00  
Slope (%) = 1.12  
N-Value = 0.040

### Calculations


Compute by: Known Q  
Known Q (cfs) = 432.00

### Highlighted

Depth (ft) = 1.84  
Q (cfs) = 432.00  
Area (sqft) = 91.60  
Velocity (ft/s) = 4.72  
Wetted Perim (ft) = 69.74  
Crit Depth, Yc (ft) = 1.54  
Top Width (ft) = 69.56  
EGL (ft) = 2.19

### (Sta, El, n)-(Sta, El, n)...

(0.00, 52.00)-(7.00, 48.00, 0.040)-(28.00, 48.00, 0.040)-(82.00, 44.00, 0.040)-(112.00, 44.00, 0.040)-(120.00, 45.00, 0.040)-(128.00, 46.00, 0.040)  
-(140.00, 50.00, 0.040)

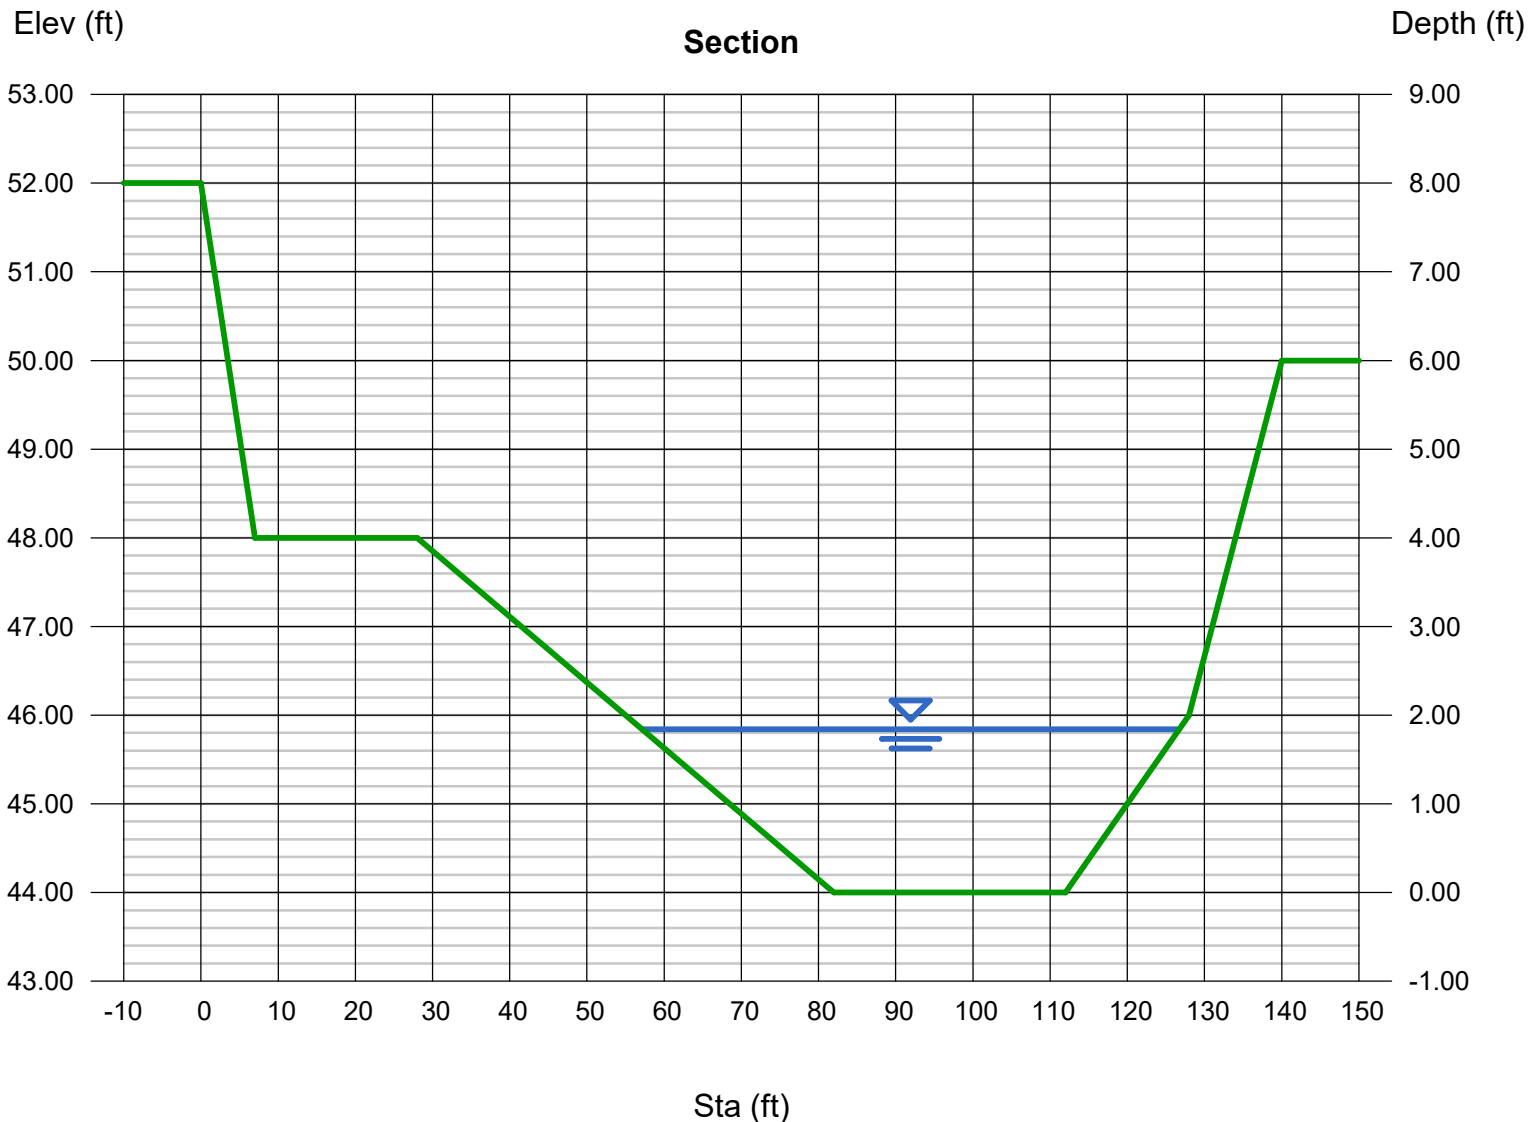

# Channel Report

## Main 190ft DS of Driveway

### User-defined

Invert Elev (ft) = 42.00  
Slope (%) = 1.70  
N-Value = 0.040

### Highlighted


Depth (ft) = 2.38  
Q (cfs) = 432.00  
Area (sqft) = 86.60  
Velocity (ft/s) = 4.99  
Wetted Perim (ft) = 82.63  
Crit Depth, Yc (ft) = 2.28  
Top Width (ft) = 82.35  
EGL (ft) = 2.77

### Calculations

Compute by: Known Q  
Known Q (cfs) = 432.00

### (Sta, El, n)-(Sta, El, n)...

(0.00, 48.00)-(11.00, 44.00, 0.040)-(26.00, 44.00, 0.040)-(60.00, 43.00, 0.040)-(73.00, 42.00, 0.040)-(88.00, 43.50, 0.040)-(110.00, 48.00, 0.040)

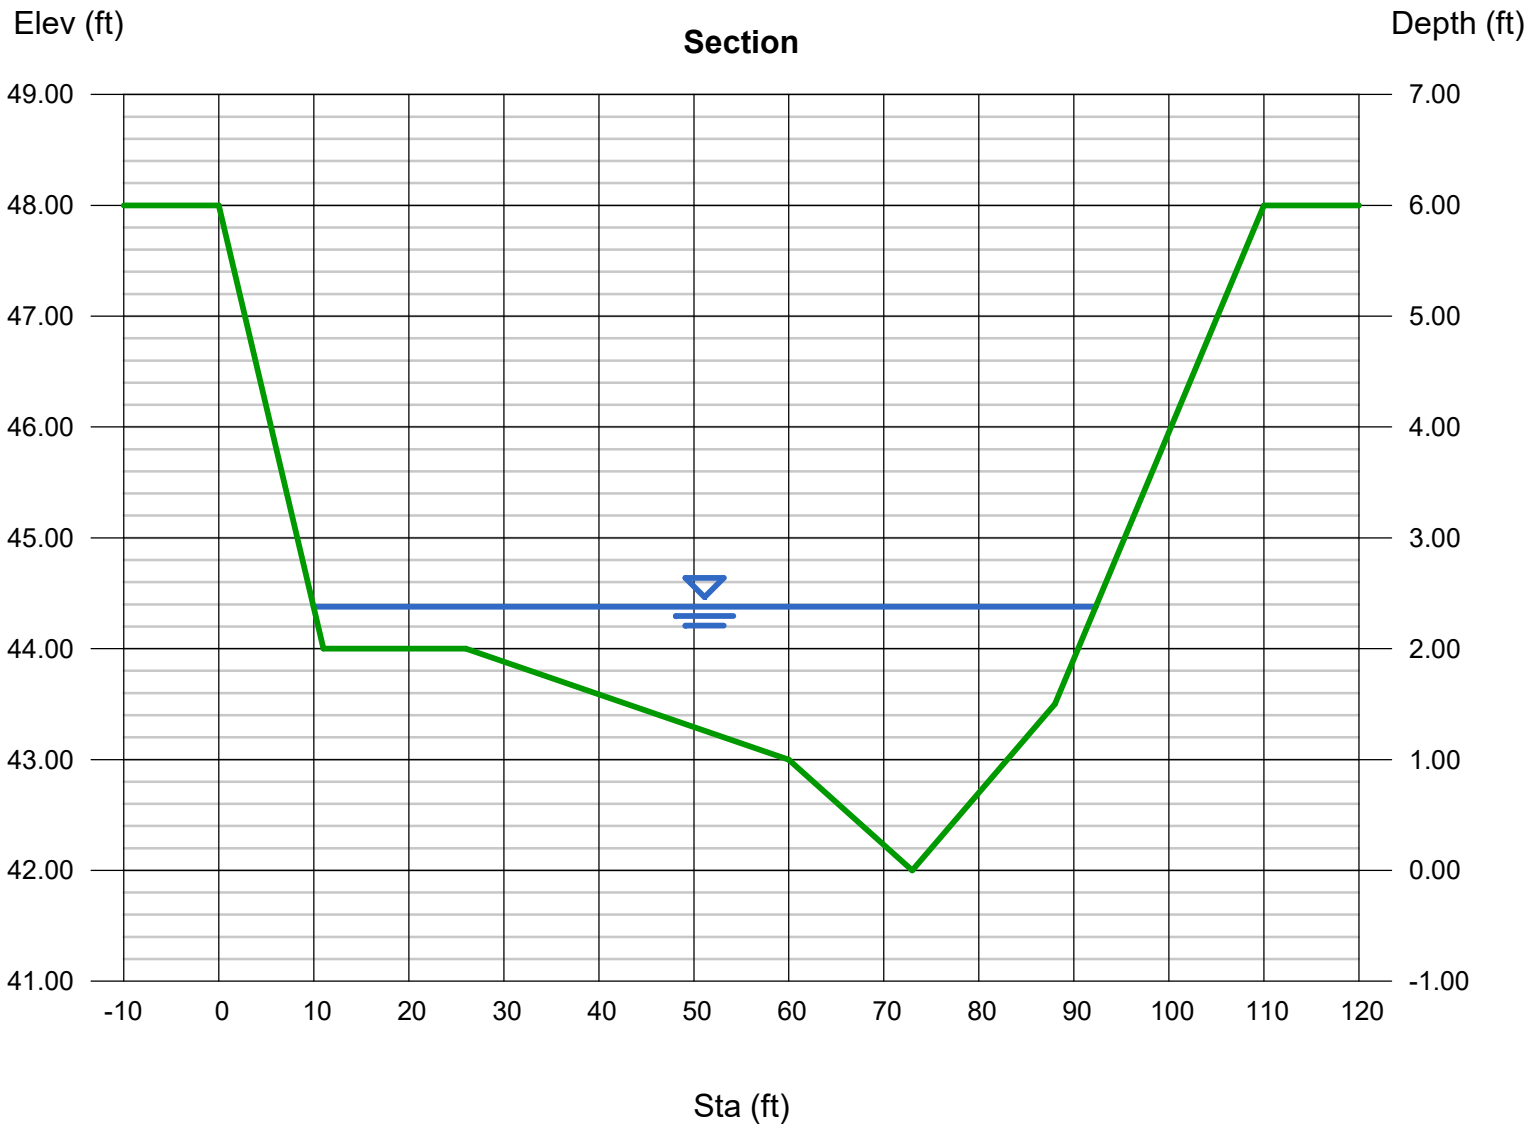

# Channel Report

## Main 370ft DS of Driveway

### User-defined

Invert Elev (ft) = 36.50  
Slope (%) = 1.25  
N-Value = 0.040

### Highlighted


Depth (ft) = 2.34  
Q (cfs) = 473.00  
Area (sqft) = 99.30  
Velocity (ft/s) = 4.76  
Wetted Perim (ft) = 80.27  
Crit Depth, Yc (ft) = 2.08  
Top Width (ft) = 79.96  
EGL (ft) = 2.69

### Calculations

Compute by: Known Q  
Known Q (cfs) = 473.00

### (Sta, El, n)-(Sta, El, n)...

( 0.00, 42.50)-(20.00, 41.00, 0.040)-(34.00, 37.00, 0.040)-(43.00, 36.50, 0.040)-(56.00, 37.00, 0.040)-(112.00, 39.00, 0.040)-(170.00, 39.00, 0.040)  
-(190.00, 40.00, 0.040)-(240.00, 47.00, 0.040)

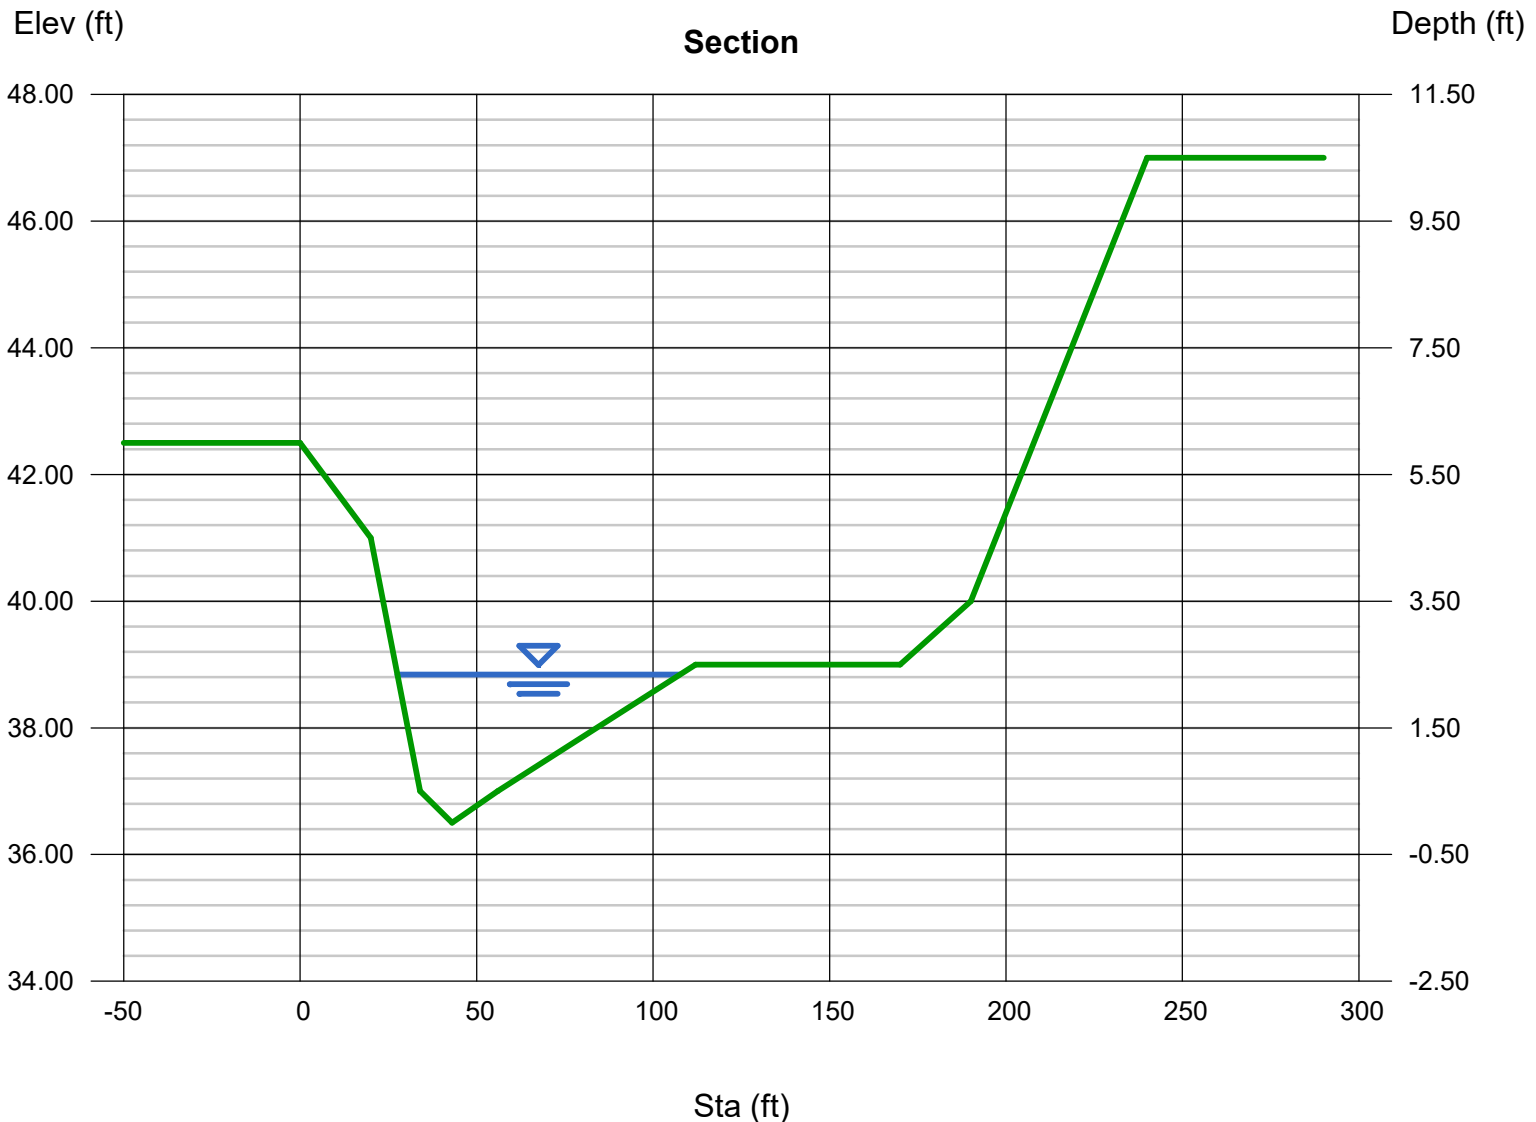

# Channel Report

## Main 560ft DS of Driveway

### User-defined

Invert Elev (ft) = 42.00  
Slope (%) = 1.12  
N-Value = 0.040

### Highlighted


Depth (ft) = 2.60  
Q (cfs) = 473.00  
Area (sqft) = 104.74  
Velocity (ft/s) = 4.52  
Wetted Perim (ft) = 83.87  
Crit Depth, Yc (ft) = 2.34  
Top Width (ft) = 83.48  
EGL (ft) = 2.92

### Calculations

Compute by: Known Q  
Known Q (cfs) = 473.00

### (Sta, El, n)-(Sta, El, n)...

(0.00, 50.00)-(11.00, 44.00, 0.040)-(26.00, 44.00, 0.040)-(60.00, 43.00, 0.040)-(73.00, 42.00, 0.040)-(88.00, 43.50, 0.040)-(110.00, 48.00, 0.040)

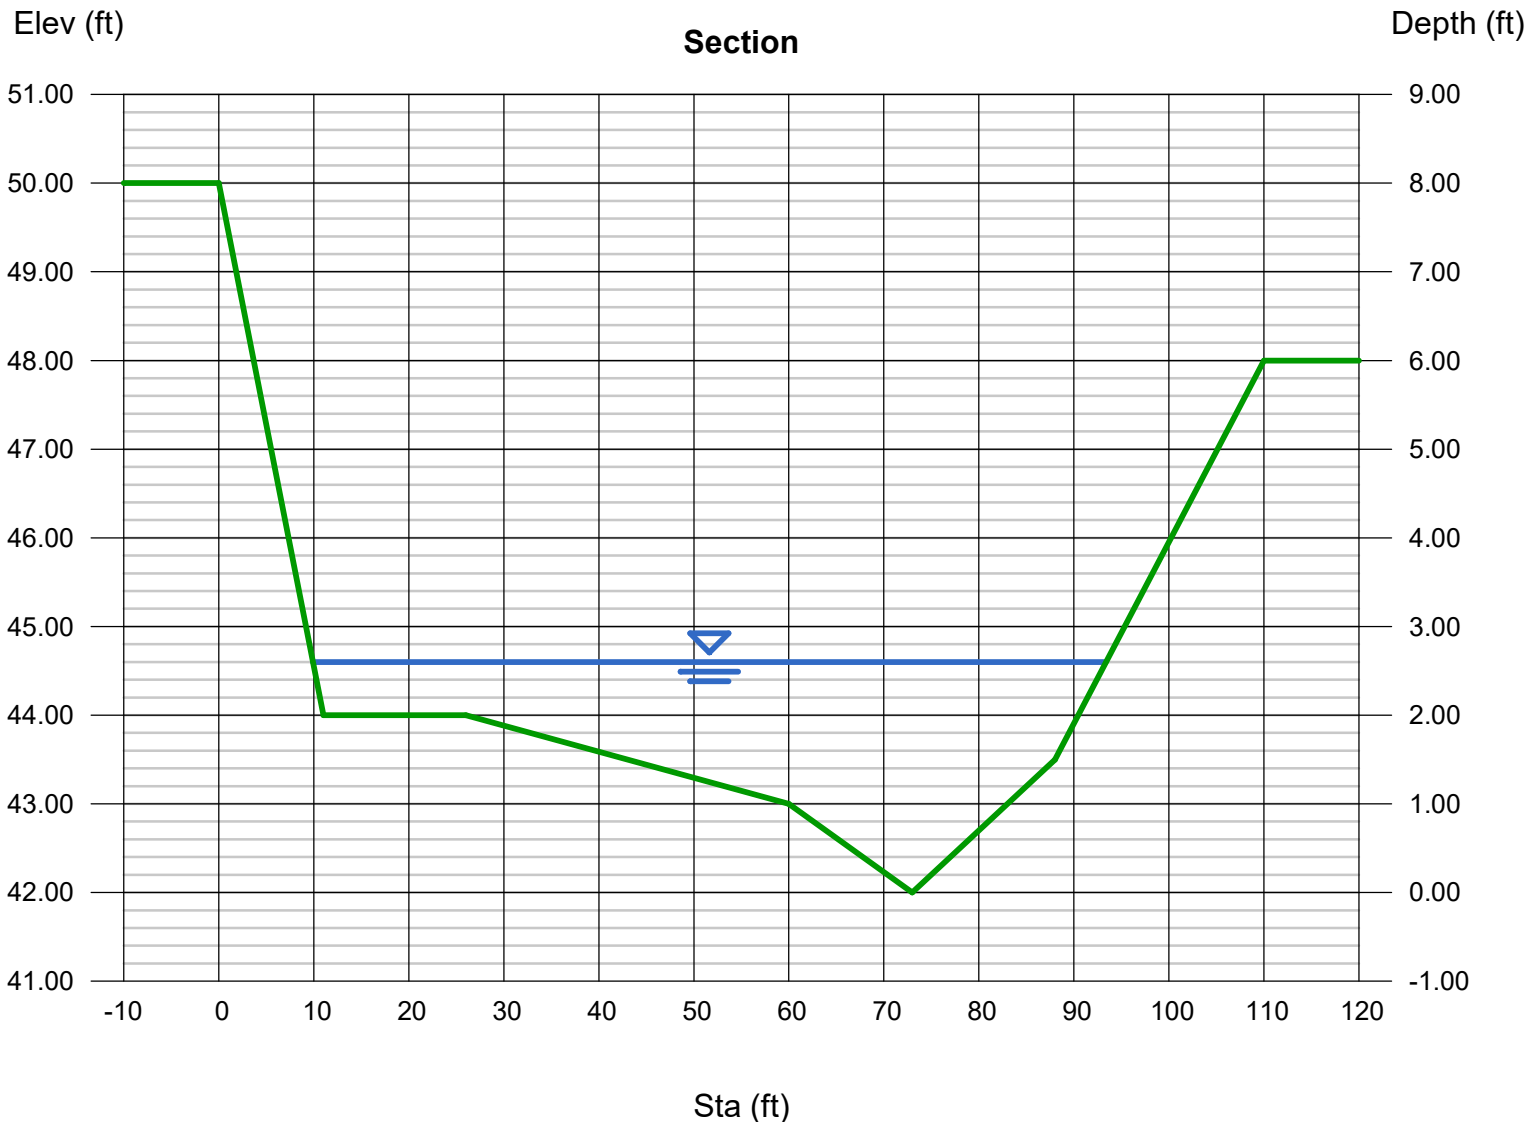

# Channel Report

## Main 700ft DS of Driveway

### User-defined

Invert Elev (ft) = 35.00  
Slope (%) = 0.62  
N-Value = 0.040

### Highlighted


Depth (ft) = 2.21  
Q (cfs) = 473.00  
Area (sqft) = 131.22  
Velocity (ft/s) = 3.60  
Wetted Perim (ft) = 96.11  
Crit Depth, Yc (ft) = 1.64  
Top Width (ft) = 95.95  
EGL (ft) = 2.41

### Calculations

Compute by: Known Q  
Known Q (cfs) = 473.00

### (Sta, El, n)-(Sta, El, n)...

( 0.00, 39.00)-(20.00, 36.00, 0.040)-(36.00, 35.00, 0.040)-(51.00, 35.00, 0.040)-(80.00, 36.00, 0.040)-(102.00, 37.00, 0.040)-(130.00, 38.00, 0.040)  
-(170.00, 44.00, 0.040)

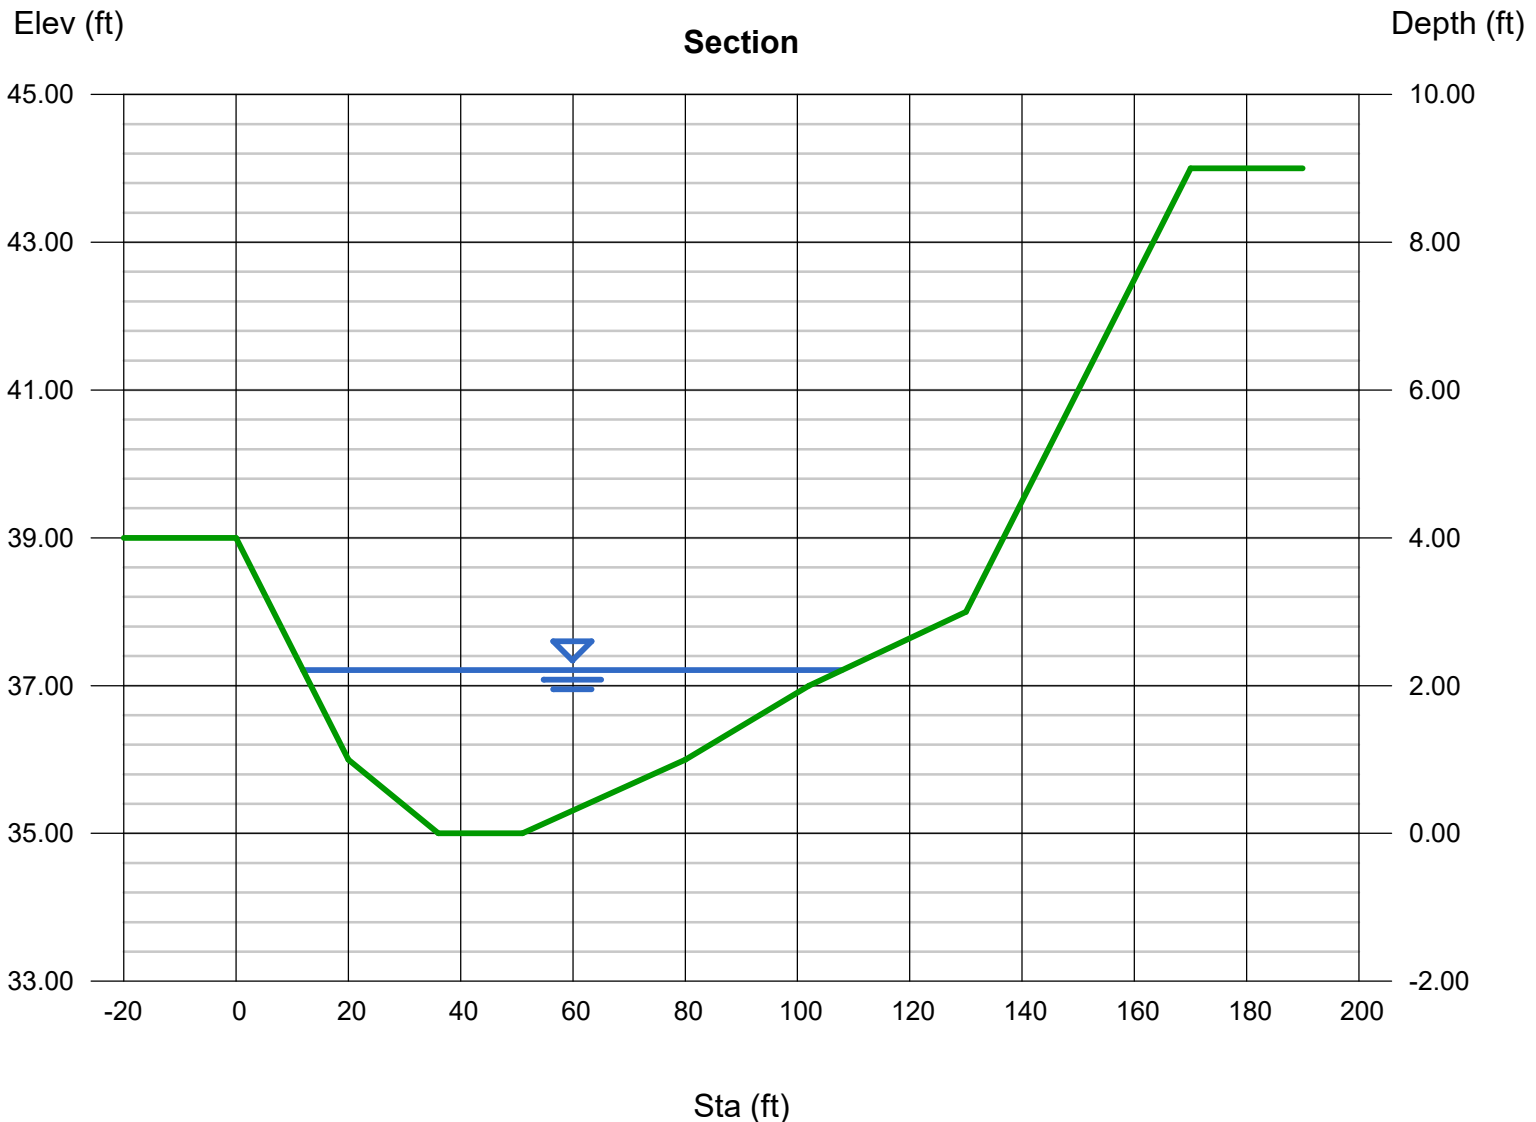



# Culvert Report


## 18inch Culvert

Invert Elev Dn (ft)	=	100.00
Pipe Length (ft)	=	50.00
Slope (%)	=	1.00
Invert Elev Up (ft)	=	100.50
Rise (in)	=	18.0
Shape	=	Circular
Span (in)	=	18.0
No. Barrels	=	1
n-Value	=	0.013
Culvert Type	=	Circular Concrete
Culvert Entrance	=	Square edge w/headwall (C)
Coeff. K,M,c,Y,k	=	0.0098, 2, 0.0398, 0.67, 0.5

<b>Embankment</b>	
Top Elevation (ft)	= 105.00
Top Width (ft)	= 24.00
Crest Width (ft)	= 150.00

<b>Calculations</b>	
Qmin (cfs)	= 5.00
Qmax (cfs)	= 5.00
Tailwater Elev (ft)	= (dc+D)/2

<b>Highlighted</b>	
Qtotal (cfs)	= 5.00
Qpipe (cfs)	= 5.00
Qovertop (cfs)	= 0.00
Veloc Dn (ft/s)	= 3.35
Veloc Up (ft/s)	= 4.77
HGL Dn (ft)	= 101.18
HGL Up (ft)	= 101.36
Hw Elev (ft)	= 101.78
Hw/D (ft)	= 0.86
Flow Regime	= Inlet Control

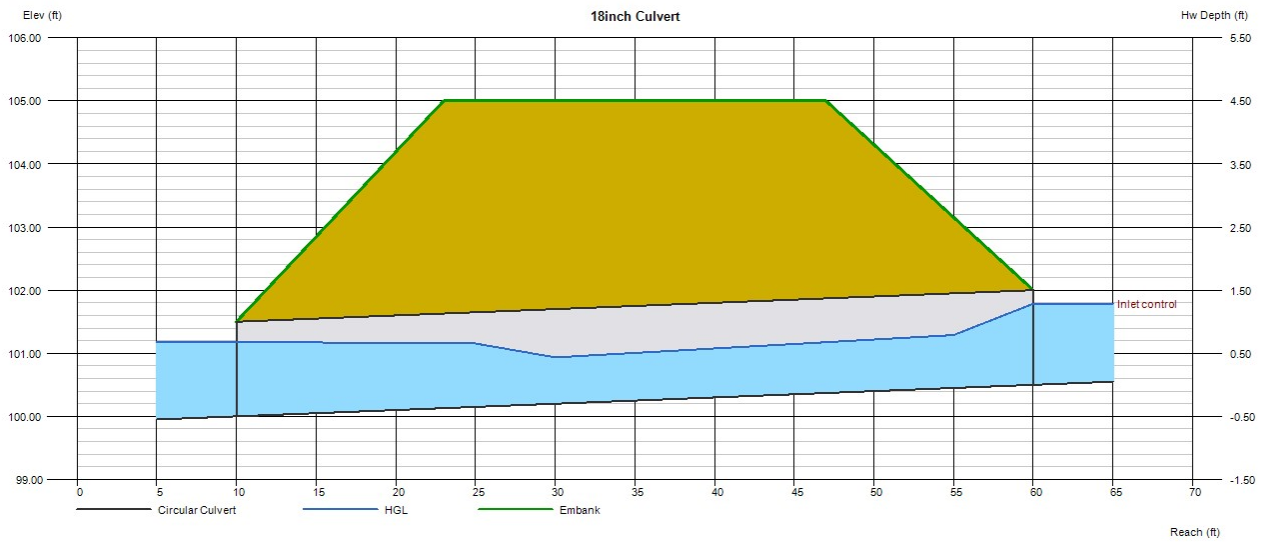

# Culvert Report


## 24inch Culvert

Invert Elev Dn (ft)	=	100.00
Pipe Length (ft)	=	25.00
Slope (%)	=	1.00
Invert Elev Up (ft)	=	100.25
Rise (in)	=	24.0
Shape	=	Circular
Span (in)	=	24.0
No. Barrels	=	1
n-Value	=	0.013
Culvert Type	=	Circular Concrete
Culvert Entrance	=	Square edge w/headwall (C)
Coeff. K,M,c,Y,k	=	0.0098, 2, 0.0398, 0.67, 0.5

<b>Embankment</b>	
Top Elevation (ft)	= 105.00
Top Width (ft)	= 20.00
Crest Width (ft)	= 150.00

<b>Calculations</b>	
Qmin (cfs)	= 17.80
Qmax (cfs)	= 17.80
Tailwater Elev (ft)	= (dc+D)/2

<b>Highlighted</b>	
Qtotal (cfs)	= 17.80
Qpipe (cfs)	= 17.80
Qovertop (cfs)	= 0.00
Veloc Dn (ft/s)	= 6.08
Veloc Up (ft/s)	= 6.93
HGL Dn (ft)	= 101.76
HGL Up (ft)	= 101.77
Hw Elev (ft)	= 102.86
Hw/D (ft)	= 1.30
Flow Regime	= Inlet Control

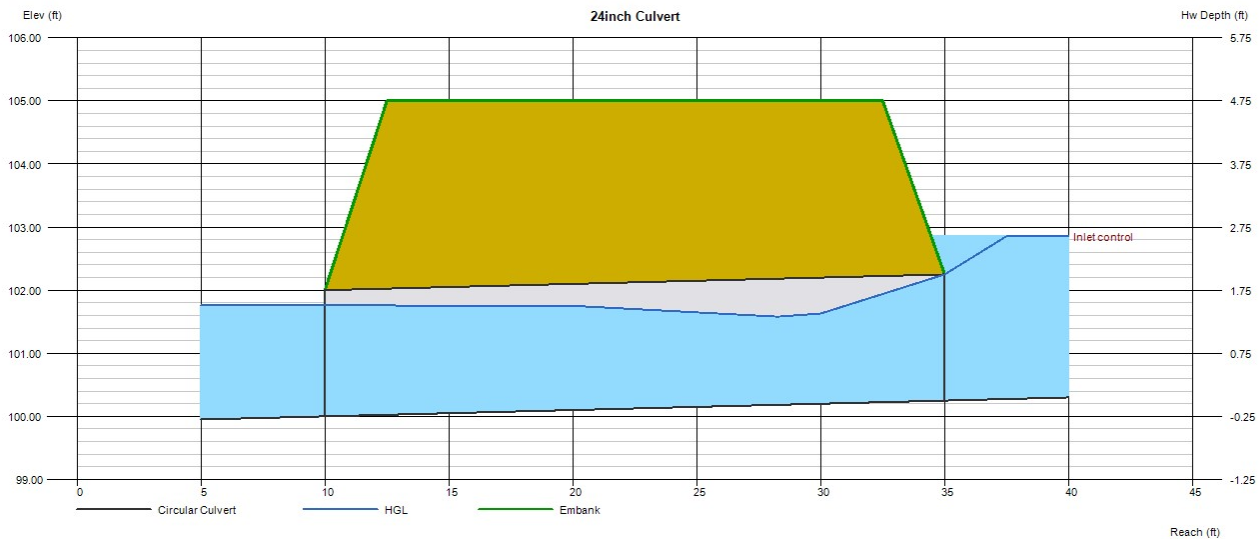

# HY-8 Culvert Analysis Report

---

## Crossing Discharge Data


Discharge Selection Method: User Defined

Table 1 - Summary of Culvert Flows at Crossing: Driveway Crossing

Headwater Elevation (ft)	Discharge Names	Total Discharge (cfs)	3 54s Discharge (cfs)	Roadway Discharge (cfs)	Iterations
48.39	25yr	198.00	198.00	0.00	1
49.37	50yr	304.00	304.00	0.00	1
50.69	100yr	431.80	431.80	0.00	1
50.75	Overtopping	436.84	436.84	0.00	Overtopping

**Rating Curve Plot for Crossing: Driveway Crossing**

**Total Rating Curve**  
Crossing: Driveway Crossing

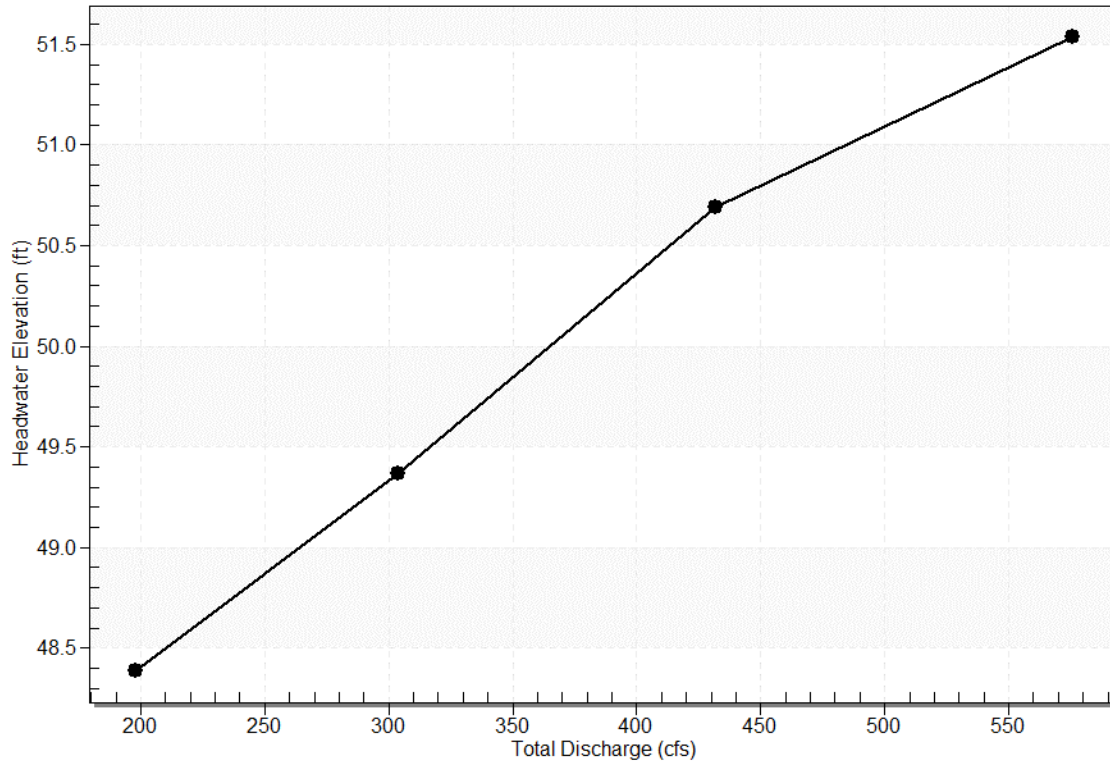

**Culvert Data: 3 54s**

**Table 1 - Culvert Summary Table: 3 54s**

Discharge Names	Total Discharge	Culvert Discharge	Headwater	Inlet Control	Outlet Control	Flow	Normal	Critical	Outlet	Tailwater Depth	Outlet Velocity	Tailwater
-----------------	-----------------	-------------------	-----------	---------------	----------------	------	--------	----------	--------	-----------------	-----------------	-----------

	e (cfs)	e (cfs)	Elevation (ft)	Inlet Depth (ft)	Outlet Depth (ft)	Type	Depth (ft)	Depth (ft)	Depth (ft)	(ft)	y (ft/s)	Velocity (ft/s)
<b>25yr</b>	198.00 cfs	198.00 cfs	48.39	3.39	2.492	1-S2n	2.18	2.37	2.21	1.12	8.50	3.80
<b>50yr</b>	304.00 cfs	304.00 cfs	49.37	4.37	3.596	1-S2n	2.85	2.96	2.86	1.43	9.51	4.39
<b>100yr</b>	431.80 cfs	431.80 cfs	50.69	5.69	5.674	7-M2c	3.84	3.52	3.52	1.74	10.77	4.92

### Culvert Barrel Data

Culvert Barrel Type Straight Culvert

Inlet Elevation (invert): 45.00 ft,

Outlet Elevation (invert): 44.75 ft


Culvert Length: 50.00 ft,

Culvert Slope: 0.0050

### Culvert Performance Curve Plot: 3 54s

#### Performance Curve


Culvert: 3 54s

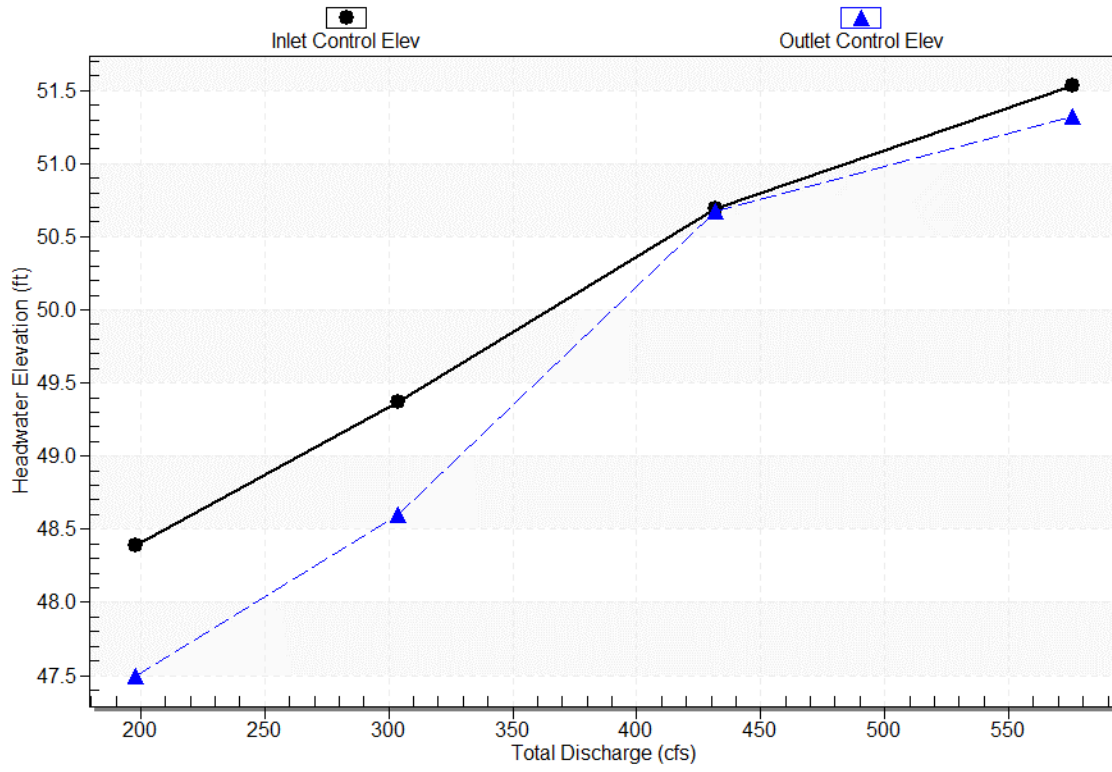

### Water Surface Profile Plot for Culvert: 3 54s

Crossing - Driveway Crossing, Design Discharge - 431.8 cfs

Culvert - 3 54s, Culvert Discharge - 431.8 cfs

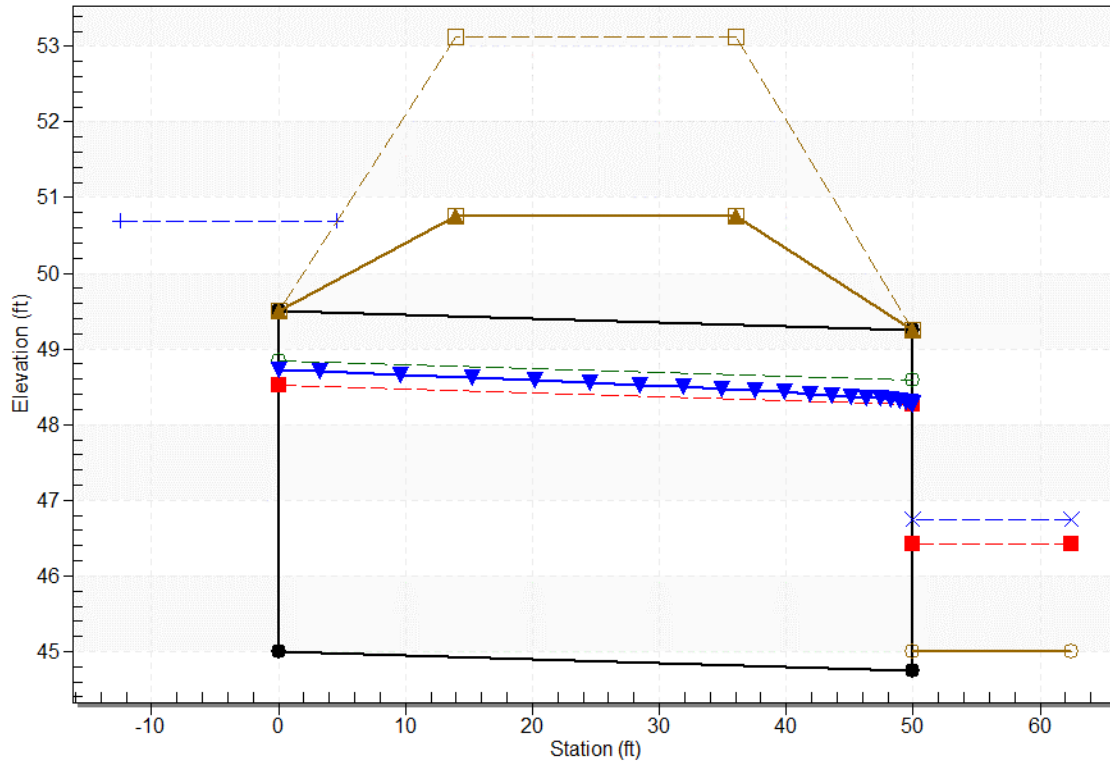

### Site Data - 3 54s

Site Data Option: Culvert Invert Data

Inlet Station: 0.00 ft

Inlet Elevation: 45.00 ft



Outlet Station: 50.00 ft

Outlet Elevation: 44.75 ft

Number of Barrels: 3

### Culvert Data Summary - 3 54s

Barrel Shape: Circular

Barrel Diameter: 4.50 ft

Barrel Material: Concrete

Embedment: 0.00 in

Barrel Manning's n: 0.0130

Culvert Type: Straight

Inlet Configuration: Grooved End Projecting (Ke=0.2)

Inlet Depression: None

### Tailwater Data for Crossing: Driveway Crossing

Table 2 - Downstream Channel Rating Curve (Crossing: Driveway Crossing)

Flow (cfs)	Water Surface Elev (ft)	Velocity (ft/s)	Depth (ft)	Shear (psf)	Froude Number
198.00	46.12	1.12	3.80	0.58	0.68
304.00	46.43	1.43	4.39	0.74	0.70
431.80	46.74	1.74	4.92	0.90	0.72

### Tailwater Channel Data - Driveway Crossing

Tailwater Channel Option: Trapezoidal Channel

Bottom Width: 40.00 ft

Side Slope (H:V): 6.00 (.:1)

Channel Slope: 0.0083

Channel Manning's n: 0.0350

Channel Invert Elevation: 45.00 ft

### Roadway Data for Crossing: Driveway Crossing

Roadway Profile Shape: Irregular Roadway Shape (coordinates)

#### Irregular Roadway Cross-Section


Coord No.	Station (ft)	Elevation (ft)
0	-110.00	53.12
1	-95.00	52.91
2	-20.00	51.02
3	0.00	50.75
4	20.00	51.01
5	40.00	51.81
6	60.00	53.03

Roadway Surface: Paved

Roadway Top Width: 22.00 ft

## Determination of Culvert Headwater and Outlet Protection

Project: **Terra Ridge North**  
 Basin ID: **18" Culvert Outfall Pad**

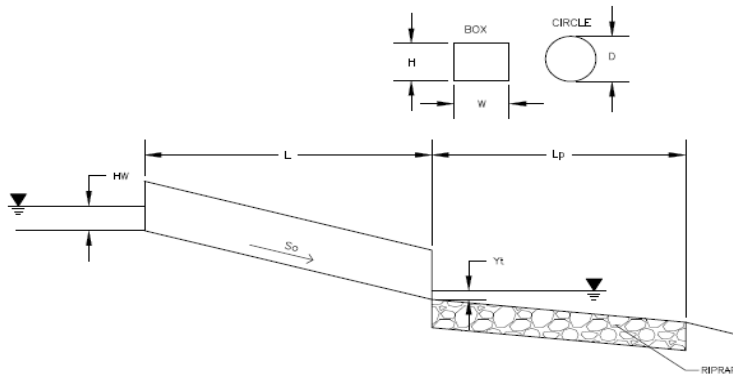

**Soil Type:**  
 Choose One:  
 Sandy  
 Non-Sandy


**Supercritical Flow! Using  $D_a$  to calculate protection type.**

Design Information (Input):	
Design Discharge	Q = <input style="width: 50px;" type="text" value="4.5"/> cfs
<b>Circular Culvert:</b>	
Barrel Diameter in Inches	D = <input style="width: 50px;" type="text" value="18"/> inches
Inlet Edge Type (Choose from pull-down list)	Grooved End Projection <input type="text" value="v"/>
<b>Box Culvert:</b>	<b>OR</b>
Barrel Height (Rise) in Feet	Height (Rise) = <input style="width: 50px;" type="text"/>
Barrel Width (Span) in Feet	Width (Span) = <input style="width: 50px;" type="text"/>
Inlet Edge Type (Choose from pull-down list)	<input type="text" value="v"/>
Number of Barrels	No = <input style="width: 50px;" type="text" value="1"/>
Inlet Elevation	Elev IN = <input style="width: 50px;" type="text" value="100.45"/> ft
Outlet Elevation <b>OR</b> Slope	Elev OUT = <input style="width: 50px;" type="text" value="100"/> ft
Culvert Length	L = <input style="width: 50px;" type="text" value="45"/> ft
Manning's Roughness	n = <input style="width: 50px;" type="text" value="0.012"/>
Bend Loss Coefficient	$k_b$ = <input style="width: 50px;" type="text" value="0"/>
Exit Loss Coefficient	$k_x$ = <input style="width: 50px;" type="text" value="1"/>
Tailwater Surface Elevation	Elev $Y_t$ = <input style="width: 50px;" type="text"/>
Max Allowable Channel Velocity	V = <input style="width: 50px;" type="text" value="7"/> ft/s

Required Protection (Output):	
Tailwater Surface Height	$Y_t$ = <input style="width: 50px;" type="text" value="0.60"/> ft
Flow Area at Max Channel Velocity	$A_t$ = <input style="width: 50px;" type="text" value="0.64"/> ft <sup>2</sup>
Culvert Cross Sectional Area Available	A = <input style="width: 50px;" type="text" value="1.77"/> ft <sup>2</sup>
Entrance Loss Coefficient	$k_e$ = <input style="width: 50px;" type="text" value="0.20"/>
Friction Loss Coefficient	$k_f$ = <input style="width: 50px;" type="text" value="0.69"/>
Sum of All Losses Coefficients	$k_s$ = <input style="width: 50px;" type="text" value="1.89"/> ft
Culvert Normal Depth	$Y_n$ = <input style="width: 50px;" type="text" value="0.65"/> ft
Culvert Critical Depth	$Y_c$ = <input style="width: 50px;" type="text" value="0.81"/> ft
Tailwater Depth for Design	d = <input style="width: 50px;" type="text" value="1.16"/> ft
Adjusted Diameter <b>OR</b> Adjusted Rise	$D_a$ = <input style="width: 50px;" type="text" value="1.08"/> ft
Expansion Factor	$1/(2*\tan(\theta))$ = <input style="width: 50px;" type="text" value="6.70"/>
Flow/Diameter <sup>2.5</sup> <b>OR</b> Flow/(Span * Rise <sup>1.5</sup> )	$Q/D^{2.5}$ = <input style="width: 50px;" type="text" value="1.63"/> ft <sup>0.5</sup> /s
Froude Number	Fr = <input style="width: 50px;" type="text" value="1.52"/> <span style="color: red; font-weight: bold;">Supercritical!</span>
Tailwater/Adjusted Diameter <b>OR</b> Tailwater/Adjusted Rise	$Y_t/D$ = <input style="width: 50px;" type="text" value="0.56"/>
Inlet Control Headwater	$HW_i$ = <input style="width: 50px;" type="text" value="1.17"/> ft
Outlet Control Headwater	$HW_o$ = <input style="width: 50px;" type="text" value="0.90"/> ft
<b>Design Headwater Elevation</b>	<b>HW</b> = <input style="width: 50px;" type="text" value="101.62"/> ft
<b>Headwater/Diameter <b>OR</b> Headwater/Rise Ratio</b>	<b>HW/D</b> = <input style="width: 50px;" type="text" value="0.78"/>
Minimum Theoretical Riprap Size	$d_{50}$ = <input style="width: 50px;" type="text" value="2"/> in
Nominal Riprap Size	$d_{50}$ = <input style="width: 50px;" type="text" value="6"/> in
<b>UDFCD Riprap Type</b>	<b>Type</b> = <input style="width: 50px;" type="text" value="VL"/>
<b>Length of Protection</b>	$L_p$ = <input style="width: 50px;" type="text" value="5"/> ft
<b>Width of Protection</b>	T = <input style="width: 50px;" type="text" value="3"/> ft

## Determination of Culvert Headwater and Outlet Protection

Project: **Terra Ridge North**  
 Basin ID: **24" Culvert Outfall Pad**

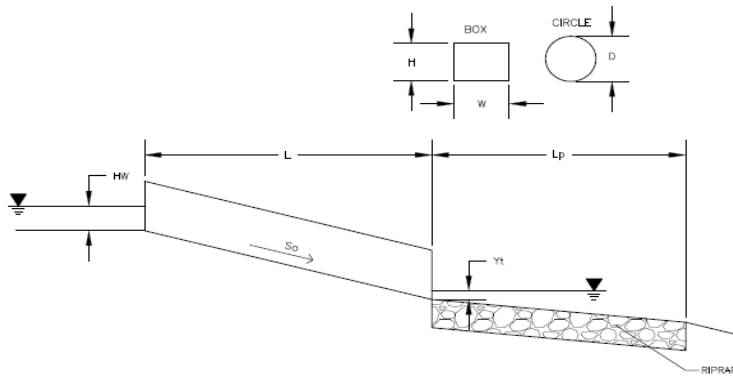

Soil Type:

Choose One:

- Sandy  
 Non-Sandy

Supercritical Flow! Using Da to calculate protection type.

### Design Information (Input):


Design Discharge	Q =	<input type="text" value="17.8"/>	cfs
<b>Circular Culvert:</b>			
Barrel Diameter in Inches	D =	<input type="text" value="24"/>	inches
Inlet Edge Type (Choose from pull-down list)	Grooved End Projection	<input type="text" value=""/>	
<b>Box Culvert:</b>			
Barrel Height (Rise) in Feet	Height (Rise) =	<input type="text" value=""/>	ft
Barrel Width (Span) in Feet	Width (Span) =	<input type="text" value=""/>	ft
Inlet Edge Type (Choose from pull-down list)			
Number of Barrels	No =	<input type="text" value="1"/>	
Inlet Elevation	Elev IN =	<input type="text" value="100.25"/>	ft
Outlet Elevation <b>OR</b> Slope	Elev OUT =	<input type="text" value="100"/>	ft
Culvert Length	L =	<input type="text" value="25"/>	ft
Manning's Roughness	n =	<input type="text" value="0.012"/>	
Bend Loss Coefficient	k <sub>b</sub> =	<input type="text" value="0"/>	
Exit Loss Coefficient	k <sub>x</sub> =	<input type="text" value="1"/>	
Tailwater Surface Elevation	Elev Y <sub>t</sub> =	<input type="text" value=""/>	ft
Max Allowable Channel Velocity	V =	<input type="text" value="7"/>	ft/s

### Required Protection (Output):

Tailwater Surface Height	Y <sub>t</sub> =	<input type="text" value="0.80"/>	ft
Flow Area at Max Channel Velocity	A <sub>t</sub> =	<input type="text" value="2.54"/>	ft <sup>2</sup>
Culvert Cross Sectional Area Available	A =	<input type="text" value="3.14"/>	ft <sup>2</sup>
Entrance Loss Coefficient	k <sub>e</sub> =	<input type="text" value="0.20"/>	
Friction Loss Coefficient	k <sub>f</sub> =	<input type="text" value="0.26"/>	
Sum of All Losses Coefficients	k <sub>s</sub> =	<input type="text" value="1.46"/>	ft
Culvert Normal Depth	Y <sub>n</sub> =	<input type="text" value="1.26"/>	ft
Culvert Critical Depth	Y <sub>c</sub> =	<input type="text" value="1.52"/>	ft
Tailwater Depth for Design	d =	<input type="text" value="1.76"/>	ft
Adjusted Diameter <b>OR</b> Adjusted Rise	D <sub>a</sub> =	<input type="text" value="1.63"/>	ft
Expansion Factor	1/(2*tan(θ)) =	<input type="text" value="5.59"/>	
Flow/Diameter <sup>2.5</sup> <b>OR</b> Flow/(Span * Rise <sup>1.5</sup> )	Q/D <sup>2.5</sup> =	<input type="text" value="3.15"/>	ft <sup>0.5</sup> /s
Froude Number	Fr =	<input type="text" value="1.44"/>	Supercritical!
Tailwater/Adjusted Diameter <b>OR</b> Tailwater/Adjusted Rise	Y <sub>t</sub> /D =	<input type="text" value="0.49"/>	
Inlet Control Headwater	HW <sub>i</sub> =	<input type="text" value="2.39"/>	ft
Outlet Control Headwater	HW <sub>o</sub> =	<input type="text" value="2.24"/>	ft
<b>Design Headwater Elevation</b>	<b>HW =</b>	<input type="text" value="102.64"/>	<b>ft</b>
<b>Headwater/Diameter <b>OR</b> Headwater/Rise Ratio</b>	<b>HW/D =</b>	<input type="text" value="1.20"/>	
Minimum Theoretical Riprap Size	d <sub>50</sub> =	<input type="text" value="6"/>	in
Nominal Riprap Size	d <sub>50</sub> =	<input type="text" value="6"/>	in
<b>UDFCD Riprap Type</b>	<b>Type =</b>	<input type="text" value="VL"/>	
<b>Length of Protection</b>	<b>L<sub>p</sub> =</b>	<input type="text" value="7"/>	<b>ft</b>
<b>Width of Protection</b>	<b>T =</b>	<input type="text" value="4"/>	<b>ft</b>

## Determination of Culvert Headwater and Outlet Protection

Project: **Terra Ridge North**  
 Basin ID: **Triple 54" Culvert Outfall Riprap**

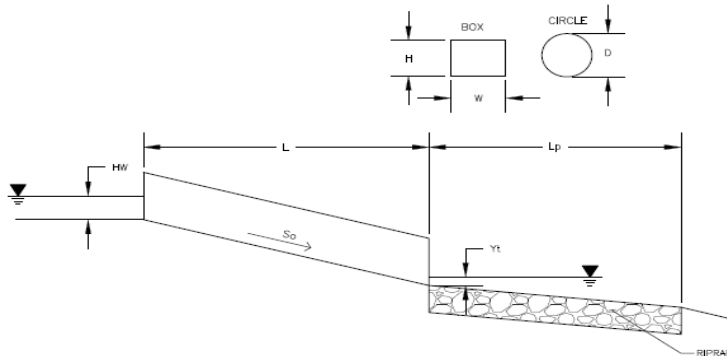

**Soil Type:**

Choose One:  
 Sandy  
 Non-Sandy

**Design Information (Input):**

Design Discharge	Q = <input type="text" value="432"/> cfs
<b>Circular Culvert:</b>	
Barrel Diameter in Inches	D = <input type="text" value="54"/> inches
Inlet Edge Type (Choose from pull-down list)	Grooved End Projection
<b>Box Culvert:</b>	
Barrel Height (Rise) in Feet	Height (Rise) = <input type="text" value="60"/> ft
Barrel Width (Span) in Feet	Width (Span) = <input type="text" value="7"/> ft
Inlet Edge Type (Choose from pull-down list)	
Number of Barrels	No = <input type="text" value="3"/>
Inlet Elevation	Elev IN = <input type="text" value="100"/> ft
Outlet Elevation <b>OR</b> Slope	Elev OUT = <input type="text" value="99.75"/> ft
Culvert Length	L = <input type="text" value="60"/> ft
Manning's Roughness	n = <input type="text" value="0.012"/>
Bend Loss Coefficient	k <sub>b</sub> = <input type="text" value="0"/>
Exit Loss Coefficient	k <sub>x</sub> = <input type="text" value="1"/>
Tailwater Surface Elevation	Elev Y <sub>t</sub> = <input type="text" value="103.75"/> ft
Max Allowable Channel Velocity	V = <input type="text" value="7"/> ft/s

**Required Protection (Output):**

Tailwater Surface Height	Y <sub>t</sub> = <input type="text" value="4.00"/> ft
Flow Area at Max Channel Velocity	A <sub>t</sub> = <input type="text" value="20.57"/> ft <sup>2</sup>
Culvert Cross Sectional Area Available	A = <input type="text" value="15.90"/> ft <sup>2</sup>
Entrance Loss Coefficient	k <sub>e</sub> = <input type="text" value="0.20"/>
Friction Loss Coefficient	k <sub>f</sub> = <input type="text" value="0.21"/>
Sum of All Losses Coefficients	k <sub>s</sub> = <input type="text" value="1.41"/> ft
Culvert Normal Depth	Y <sub>n</sub> = <input type="text" value="3.90"/> ft
Culvert Critical Depth	Y <sub>c</sub> = <input type="text" value="3.53"/> ft
Tailwater Depth for Design	d = <input type="text" value="4.01"/> ft
Adjusted Diameter <b>OR</b> Adjusted Rise	D <sub>a</sub> = <input type="text" value="-"/> ft
Expansion Factor	1/(2*tan(θ)) = <input type="text" value="6.70"/>
Flow/Diameter <sup>2.5</sup> <b>OR</b> Flow/(Span * Rise <sup>1.5</sup> )	Q/D <sup>2.5</sup> = <input type="text" value="3.35"/> ft <sup>0.5</sup> /s
Froude Number	Fr = <input type="text" value="0.79"/>
Tailwater/Adjusted Diameter <b>OR</b> Tailwater/Adjusted Rise	Y <sub>t</sub> /D = <input type="text" value="0.89"/>
Inlet Control Headwater	HW <sub>i</sub> = <input type="text" value="5.69"/> ft
Outlet Control Headwater	HW <sub>o</sub> = <input type="text" value="5.56"/> ft
<b>Design Headwater Elevation</b>	<b>HW = <input type="text" value="105.69"/> ft</b>
<b>Headwater/Diameter <b>OR</b> Headwater/Rise Ratio</b>	<b>HW/D = <input type="text" value="1.27"/></b>
Minimum Theoretical Riprap Size	d <sub>50</sub> = <input type="text" value="5"/> in
Nominal Riprap Size	d <sub>50</sub> = <input type="text" value="6"/> in
<b>UDFCD Riprap Type</b>	<b>Type = <input type="text" value="VL"/></b>
<b>Length of Protection</b>	<b>L<sub>p</sub> = <input type="text" value="14"/> ft</b>
<b>Width of Protection</b>	<b>T = <input type="text" value="7"/> ft</b>

**Design Procedure Form: Extended Detention Basin (EDB)**

UD-BMP (Version 3.07, March 2018)

Sheet 1 of 3

**Designer:** PSM  
**Company:** Lodestar  
**Date:** February 5, 2023  
**Project:** Terra Ridge North  
**Location:** Forebay Calculations

<p>1. Basin Storage Volume</p> <p>A) Effective Imperviousness of Tributary Area, <math>I_a</math></p> <p>B) Tributary Area's Imperviousness Ratio (<math>i = I_a / 100</math>)</p> <p>C) Contributing Watershed Area</p> <p>D) For Watersheds Outside of the Denver Region, Depth of Average Runoff Producing Storm</p> <p>E) Design Concept (Select EURV when also designing for flood control)</p> <p>F) Design Volume (WQCV) Based on 40-hour Drain Time (<math>V_{DESIGN} = (1.0 * (0.91 * i^3 - 1.19 * i^2 + 0.78 * i) / 12 * Area)</math>)</p> <p>G) For Watersheds Outside of the Denver Region, Water Quality Capture Volume (WQCV) Design Volume (<math>V_{WQCV\ OTHER} = (d_b * V_{DESIGN} / 0.43)</math>)</p> <p>H) User Input of Water Quality Capture Volume (WQCV) Design Volume (Only if a different WQCV Design Volume is desired)</p> <p>I) NRCS Hydrologic Soil Groups of Tributary Watershed              i) Percentage of Watershed consisting of Type A Soils              ii) Percentage of Watershed consisting of Type B Soils              iii) Percentage of Watershed consisting of Type C/D Soils</p> <p>J) Excess Urban Runoff Volume (EURV) Design Volume              For HSG A: <math>EURV_A = 1.68 * i^{1.28}</math>              For HSG B: <math>EURV_B = 1.36 * i^{1.08}</math>              For HSG C/D: <math>EURV_{C/D} = 1.20 * i^{1.08}</math></p> <p>K) User Input of Excess Urban Runoff Volume (EURV) Design Volume (Only if a different EURV Design Volume is desired)</p>	<p><math>I_a =</math> <input type="text" value="25.9"/> %</p> <p><math>i =</math> <input type="text" value="0.259"/></p> <p>Area = <input type="text" value="5.220"/> ac</p> <p><math>d_b =</math> <input type="text" value="0.43"/> in</p> <div style="border: 1px solid black; padding: 5px; margin: 5px 0;"> <p>Choose One</p> <p><input checked="" type="radio"/> Water Quality Capture Volume (WQCV)</p> <p><input type="radio"/> Excess Urban Runoff Volume (EURV)</p> </div> <p><math>V_{DESIGN} =</math> <input type="text"/> ac-ft</p> <p><math>V_{DESIGN\ OTHER} =</math> <input type="text" value="0.060"/> ac-ft</p> <p><math>V_{DESIGN\ USER} =</math> <input type="text"/> ac-ft</p> <p>HSG<sub>A</sub> = <input type="text"/> %</p> <p>HSG<sub>B</sub> = <input type="text"/> %</p> <p>HSG<sub>C/D</sub> = <input type="text"/> %</p> <p><math>EURV_{DESIGN} =</math> <input type="text"/> ac-ft</p> <p><math>EURV_{DESIGN\ USER} =</math> <input type="text"/> ac-ft</p>
<p>2. Basin Shape: Length to Width Ratio (A basin length to width ratio of at least 2:1 will improve TSS reduction.)</p>	<p>L : W = <input type="text" value="2.0"/> : 1</p>
<p>3. Basin Side Slopes</p> <p>A) Basin Maximum Side Slopes (Horizontal distance per unit vertical, 4:1 or flatter preferred)</p>	<p>Z = <input type="text" value="4.00"/> ft / ft</p>
<p>4. Inlet</p> <p>A) Describe means of providing energy dissipation at concentrated inflow locations:</p>	<p>_____</p> <p>_____</p> <p>_____</p>
<p>5. Forebay</p> <p>A) Minimum Forebay Volume (<math>V_{MIN} =</math> <input type="text" value="1"/> % of the WQCV)</p> <p>B) Actual Forebay Volume</p> <p>C) Forebay Depth (<math>D_F =</math> <input type="text" value="12"/> inch maximum)</p> <p>D) Forebay Discharge</p> <p>i) Undetained 100-year Peak Discharge</p> <p>ii) Forebay Discharge Design Flow (<math>Q_F = 0.02 * Q_{100}</math>)</p> <p>E) Forebay Discharge Design</p> <p>F) Discharge Pipe Size (minimum 8-inches)</p> <p>G) Rectangular Notch Width</p>	<p><math>V_{MIN} =</math> <input type="text" value="0.00100"/> ac-ft</p> <p><math>V_F =</math> <input type="text" value="0.00100"/> ac-ft</p> <p><math>D_F =</math> <input type="text" value="12.0"/> in</p> <p><math>Q_{100} =</math> <input type="text" value="18.00"/> cfs</p> <p><math>Q_F =</math> <input type="text" value="0.36"/> cfs</p> <div style="border: 1px solid black; padding: 5px; margin: 5px 0;"> <p>Choose One</p> <p><input type="radio"/> Berm With Pipe</p> <p><input checked="" type="radio"/> Wall with Rect. Notch</p> <p><input type="radio"/> Wall with V-Notch Weir</p> </div> <p align="right" style="color: blue; font-weight: bold;">Flow too small for berm w/ pipe</p> <p>Calculated <math>D_p =</math> <input type="text"/> in</p> <p>Calculated <math>W_N =</math> <input type="text" value="3.7"/> in</p>

**Design Procedure Form: Extended Detention Basin (EDB)**

**Designer:** PSM  
**Company:** Lodestar  
**Date:** February 5, 2023  
**Project:** Terra Ridge North  
**Location:** Forebay Calculations

<p>6. Trickle Channel</p> <p>A) Type of Trickle Channel</p> <p>F) Slope of Trickle Channel</p>	<div style="border: 1px solid black; padding: 5px; margin-bottom: 10px;">                 Choose One  <input type="radio"/> Concrete  <input type="radio"/> Soft Bottom             </div> <p>S = <input style="width: 50px;" type="text"/> ft / ft</p>
<p>7. Micropool and Outlet Structure</p> <p>A) Depth of Micropool (2.5-foot minimum)</p> <p>B) Surface Area of Micropool (10 ft<sup>2</sup> minimum)</p> <p>C) Outlet Type</p> <p>D) Smallest Dimension of Orifice Opening Based on Hydrograph Routing (Use UD-Detention)</p> <p>E) Total Outlet Area</p>	<p>D<sub>M</sub> = <input style="width: 50px;" type="text"/> ft</p> <p>A<sub>M</sub> = <input style="width: 50px;" type="text"/> sq ft</p> <div style="border: 1px solid black; padding: 5px; margin-bottom: 10px;">                 Choose One  <input type="radio"/> Orifice Plate  <input type="radio"/> Other (Describe):             </div> <hr/> <hr/> <p>D<sub>orifice</sub> = <input style="width: 50px;" type="text"/> inches</p> <p>A<sub>orifice</sub> = <input style="width: 50px;" type="text"/> square inches</p>
<p>8. Initial Surcharge Volume</p> <p>A) Depth of Initial Surcharge Volume (Minimum recommended depth is 4 inches)</p> <p>B) Minimum Initial Surcharge Volume (Minimum volume of 0.3% of the WQCV)</p> <p>C) Initial Surcharge Provided Above Micropool</p>	<p>D<sub>IS</sub> = <input style="width: 50px;" type="text"/> in</p> <p>V<sub>IS</sub> = <input style="width: 50px;" type="text"/> cu ft</p> <p>V<sub>IS</sub> = <input style="width: 50px;" type="text"/> cu ft</p>
<p>9. Trash Rack</p> <p>A) Water Quality Screen Open Area: <math>A_t = A_{or} * 38.5 * (e^{-0.095D})</math></p> <p>B) Type of Screen (If specifying an alternative to the materials recommended in the USDCM, indicate "other" and enter the ratio of the total open area to the total screen area for the material specified.)</p> <p style="margin-left: 40px;">Other (Y/N): <input style="width: 50px;" type="text"/> N</p> <p>C) Ratio of Total Open Area to Total Area (only for type 'Other')</p> <p>D) Total Water Quality Screen Area (based on screen type)</p> <p>E) Depth of Design Volume (EURV or WQCV) (Based on design concept chosen under 1E)</p> <p>F) Height of Water Quality Screen (H<sub>TR</sub>)</p> <p>G) Width of Water Quality Screen Opening (W<sub>opening</sub>) (Minimum of 12 inches is recommended)</p>	<p>A<sub>t</sub> = <input style="width: 50px;" type="text"/> square inches</p> <div style="border: 1px solid black; height: 15px; width: 100%; margin-bottom: 5px;"></div> <hr/> <hr/> <p>User Ratio = <input style="width: 50px;" type="text"/></p> <p>A<sub>total</sub> = <input style="width: 50px;" type="text"/> sq. in.</p> <p>H = <input style="width: 50px;" type="text"/> feet</p> <p>H<sub>TR</sub> = <input style="width: 50px;" type="text"/> inches</p> <p>W<sub>opening</sub> = <input style="width: 50px;" type="text"/> inches</p>



Design Procedure Form: Extended Detention Basin (EDB)

Sheet 3 of 3

Designer: PSM  
Company: Lodestar  
Date: February 5, 2023  
Project: Terra Ridge North  
Location: Forebay Calculations

10. Overflow Embankment

A) Describe embankment protection for 100-year and greater overtopping:

\_\_\_\_\_  
\_\_\_\_\_

B) Slope of Overflow Embankment  
(Horizontal distance per unit vertical, 4:1 or flatter preferred)

Ze =  ft / ft

11. Vegetation

Choose One  
 Irrigated  
 Not Irrigated

12. Access

A) Describe Sediment Removal Procedures

\_\_\_\_\_  
\_\_\_\_\_  

Notes:

\_\_\_\_\_  
\_\_\_\_\_  
\_\_\_\_\_



# DETENTION BASIN STAGE-STORAGE TABLE BUILDER

*MHFD-Detention, Version 4.06 (July 2022)*

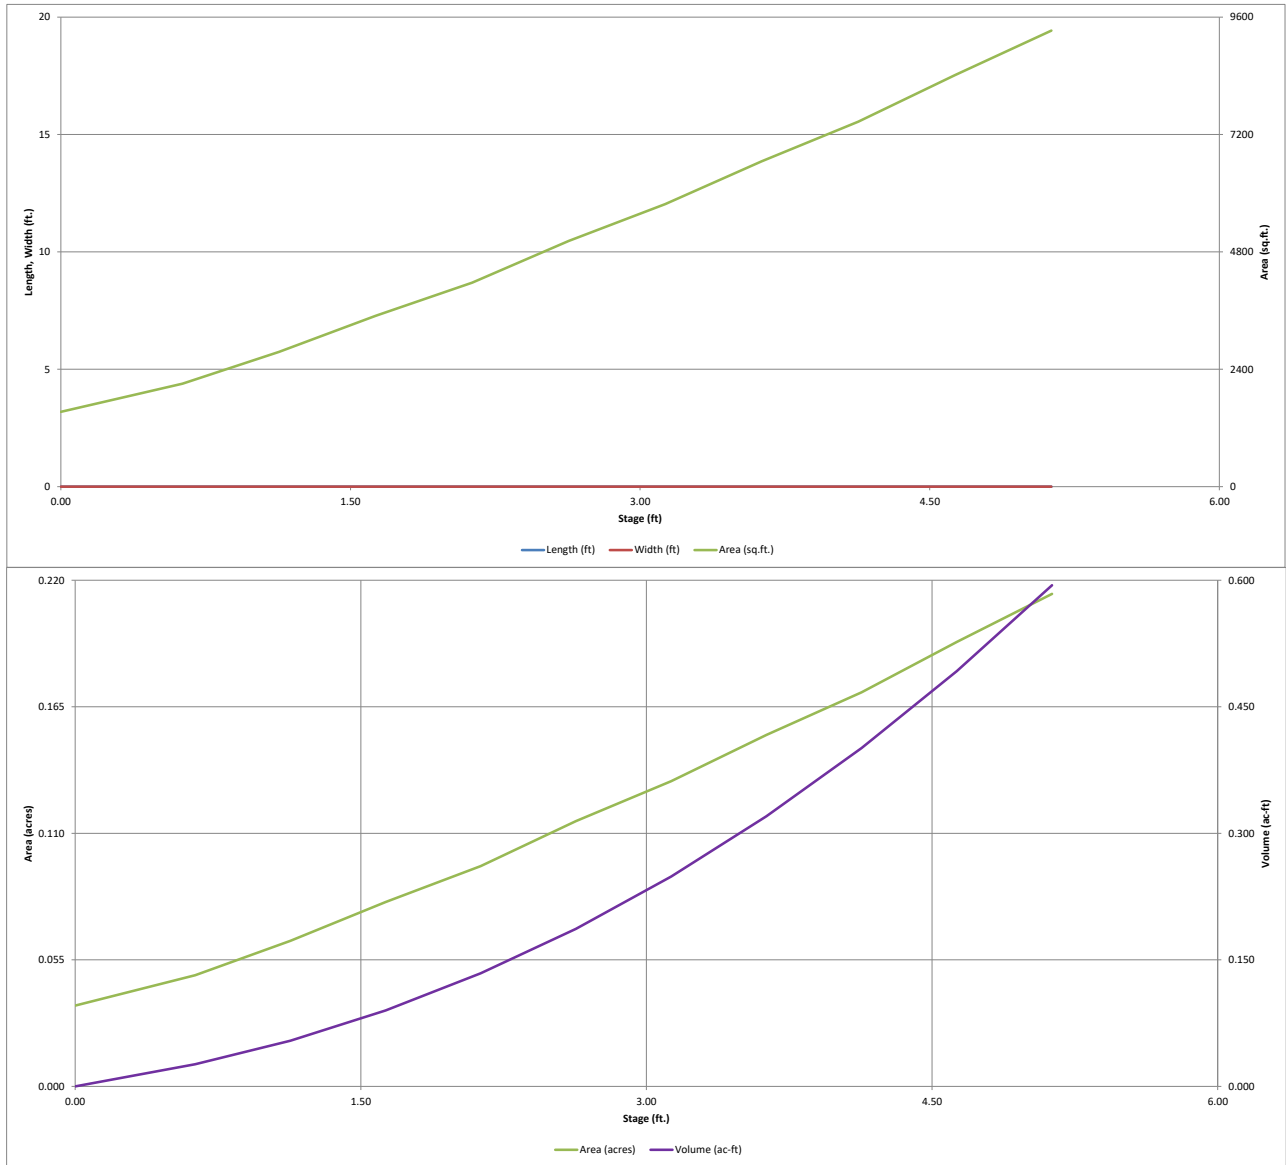


1" shown on Sht C9 of CDs, so revise this to 0.79 sq in. Or revise plans to show 15/16" diameter to be closer to 0.70 sq in (text on pdf pg 9 above shows 15/16" already)

## DETENTION BASIN OUTLET STRUCTURE DESIGN

MHFD-*Detention*, Version 4.06 (July 2022)

**Project:** Terra Ridge North  
**Basin ID:** Stage 0 = 7442.87

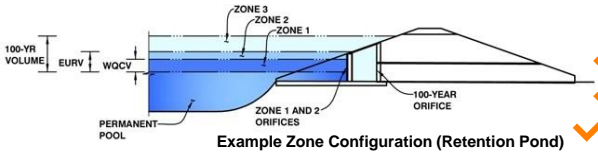

**Example Zone Configuration (Retention Pond)**

	Estimated Stage (ft)	Estimated Volume (ac-ft)	Outlet Type
Zone 1 (WQCV)	1.22	0.060	Orifice Plate
Zone 2 (EURV)	2.17	0.077	Orifice Plate
Zone 3 (100-year)	3.62	0.180	Weir&Pipe (Restrict)
<b>Total (all zones)</b>		<b>0.317</b>	

User Input: Orifice at Underdrain Outlet (typically used to drain WQCV in a Filtration BMP)

Underdrain Orifice Invert Depth =  ft (distance below the filtration media surface)  
 Underdrain Orifice Diameter =  inches

Calculated Parameters for Underdrain  
 Underdrain Orifice Area =  ft<sup>2</sup>  
 Underdrain Orifice Centroid =  feet

User Input: Orifice Plate with one or more orifices or Elliptical Slot Weir (typically used to drain WQCV and/or EURV in a sedimentation BMP)

Centroid of Lowest Orifice =  ft (relative to basin bottom at Stage = 0 ft)  
 Depth at top of Zone using Orifice Plate =  ft (relative to basin bottom at Stage = 0 ft)  
 Orifice Plate: Orifice Vertical Spacing =  inches  
 Orifice Plate: Orifice Area per Row =  sq. inches

Calculated Parameters for Plate  
 WQ Orifice Area per Row =  ft<sup>2</sup>  
 Elliptical Half-Width =  feet  
 Elliptical Slot Centroid =  feet  
 Elliptical Slot Area =  ft<sup>2</sup>

User Input: Stage and Total Area of Each Orifice Row (numbered from lowest to highest)

	Row 1 (required)	Row 2 (optional)	Row 3 (optional)	Row 4 (optional)	Row 5 (optional)	Row 6 (optional)	Row 7 (optional)	Row 8 (optional)
Stage of Orifice Centroid (ft)	0.00	0.75	1.50					
Orifice Area (sq. inches)	0.70	0.14	0.14					

	Row 9 (optional)	Row 10 (optional)	Row 11 (optional)	Row 12 (optional)	Row 13 (optional)	Row 14 (optional)	Row 15 (optional)	Row 16 (optional)
Stage of Orifice Centroid (ft)								
Orifice Area (sq. inches)								

User Input: Vertical Orifice (Circular or Rectangular)

Invert of Vertical Orifice =  ft (relative to basin bottom at Stage = 0 ft)  
 Depth at top of Zone using Vertical Orifice =  ft (relative to basin bottom at Stage = 0 ft)  
 Vertical Orifice Diameter =  inches

Calculated Parameters for Vertical Orifice  
 Vertical Orifice Area =  ft<sup>2</sup>  
 Vertical Orifice Centroid =  feet

User Input: Overflow Weir (Dropbox with Flat or Sloped Grate and Outlet Pipe OR Rectangular/Trapezoidal Weir and No Outlet Pipe)

Overflow Weir Front Edge Height, Ho =  ft (relative to basin bottom at Stage = 0 ft)  
 Overflow Weir Front Edge Length =  feet  
 Overflow Weir Grate Slope =  H:V  
 Horiz. Length of Weir Sides =  feet  
 Overflow Grate Type =   
 Debris Clogging % =  %

Calculated Parameters for Overflow Weir  
 Height of Grate Upper Edge, H<sub>u</sub> =  feet  
 Overflow Weir Slope Length =  feet  
 Grate Open Area / 100-yr Orifice Area =   
 Overflow Grate Open Area w/o Debris =  ft<sup>2</sup>  
 Overflow Grate Open Area w/ Debris =  ft<sup>2</sup>

User Input: Outlet Pipe w/ Flow Restriction Plate (Circular Orifice, Restrictor Plate, or Rectangular Orifice)

Depth to Invert of Outlet Pipe =  ft (distance below basin bottom at Stage = 0 ft)  
 Outlet Pipe Diameter =  inches  
 Restrictor Plate Height Above Pipe Invert =  inches

Calculated Parameters for Outlet Pipe w/ Flow Restriction Plate  
 Outlet Orifice Area =  ft<sup>2</sup>  
 Outlet Orifice Centroid =  feet  
 Half-Central Angle of Restrictor Plate on Pipe =  radians

User Input: Emergency Spillway (Rectangular or Trapezoidal)

Spillway Invert Stage =  ft (relative to basin bottom at Stage = 0 ft)  
 Spillway Crest Length =  feet  
 Spillway End Slopes =  H:V  
 Freeboard above Max Water Surface =  feet

Calculated Parameters for Spillway  
 Spillway Design Flow Depth =  feet  
 Stage at Top of Freeboard =  feet  
 Basin Area at Top of Freeboard =  acres  
 Basin Volume at Top of Freeboard =  acre-ft




### Routed Hydrograph Results

*The user can override the default CUHP hydrographs and runoff volumes by entering new values in the Inflow Hydrographs table (Columns W through AF).*

	WQCV	EURV	2 Year	5 Year	10 Year	25 Year	50 Year	100 Year	500 Year
Design Storm Return Period	N/A	N/A	1.19	1.50	1.75	2.00	2.25	2.52	3.14
One-Hour Rainfall Depth (in)	N/A	N/A	1.19	1.50	1.75	2.00	2.25	2.52	3.14
CUHP Runoff Volume (acre-ft)	0.060	0.137	0.140	0.238	0.328	0.469	0.573	0.714	0.984
Inflow Hydrograph Volume (acre-ft)	N/A	N/A	0.140	0.238	0.328	0.469	0.573	0.714	0.984
CUHP Predevelopment Peak Q (cfs)	N/A	N/A	0.5	1.5	2.3	4.0	5.0	6.4	9.0
OPTIONAL Override Predevelopment Peak Q (cfs)	N/A	N/A							
Predevelopment Unit Peak Flow, q (cfs/acre)	N/A	N/A	0.10	0.29	0.43	0.77	0.96	1.24	1.72
Peak Inflow Q (cfs)	N/A	N/A	1.6	2.7	3.6	5.5	6.6	8.0	10.8
Peak Outflow Q (cfs)	0.0	0.0	0.0	1.2	2.3	4.3	5.0	5.4	8.6
Ratio Peak Outflow to Predevelopment Q	N/A	N/A	N/A	0.8	1.0	1.1	1.0	0.8	1.0
Structure Controlling Flow	Plate	Overflow Weir 1	Plate	Overflow Weir 1	Overflow Weir 1	Overflow Weir 1	Outlet Plate 1	Outlet Plate 1	Spillway
Max Velocity through Grate 1 (fps)	N/A	N/A	N/A	0.1	0.3	0.5	0.6	0.7	0.7
Max Velocity through Grate 2 (fps)	N/A	N/A	N/A	N/A	N/A	N/A	N/A	N/A	N/A
Time to Drain 97% of Inflow Volume (hours)	41	63	64	62	59	55	53	50	45
Time to Drain 99% of Inflow Volume (hours)	45	68	69	69	68	65	64	62	60
Maximum Ponding Depth (ft)	1.22	2.17	2.11	2.31	2.39	2.51	2.62	3.03	3.44
Area at Maximum Ponding Depth (acres)	0.07	0.10	0.09	0.10	0.11	0.11	0.11	0.13	0.14
Maximum Volume Stored (acre-ft)	0.060	0.138	0.131	0.152	0.159	0.173	0.186	0.236	0.290

# DETENTION BASIN OUTLET STRUCTURE DESIGN

*MHFD-Detention, Version 4.06 (July 2022)*

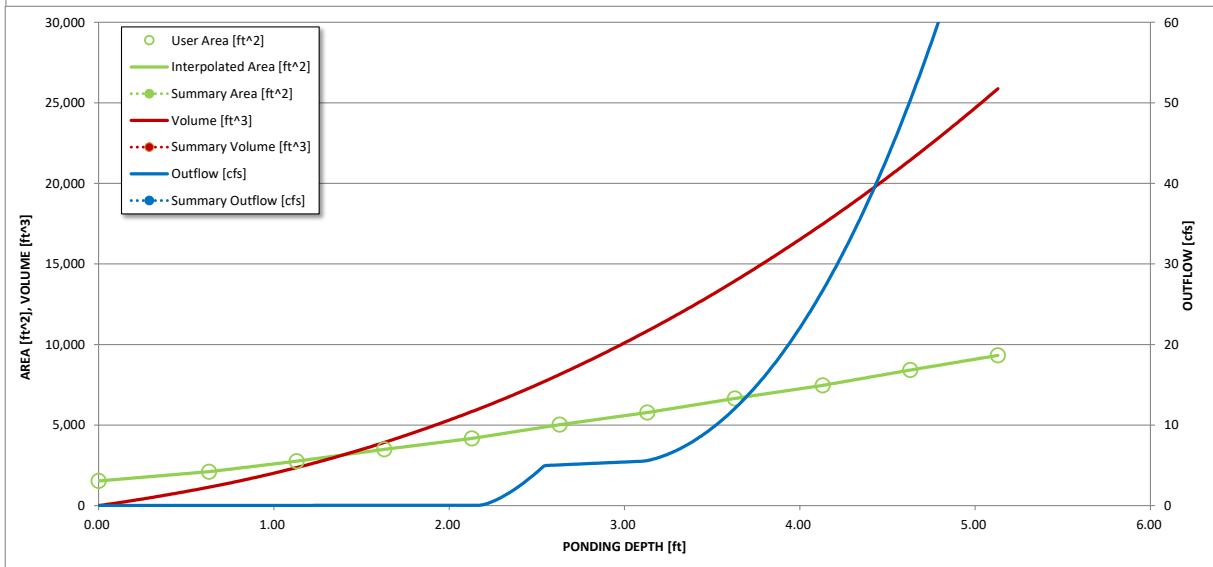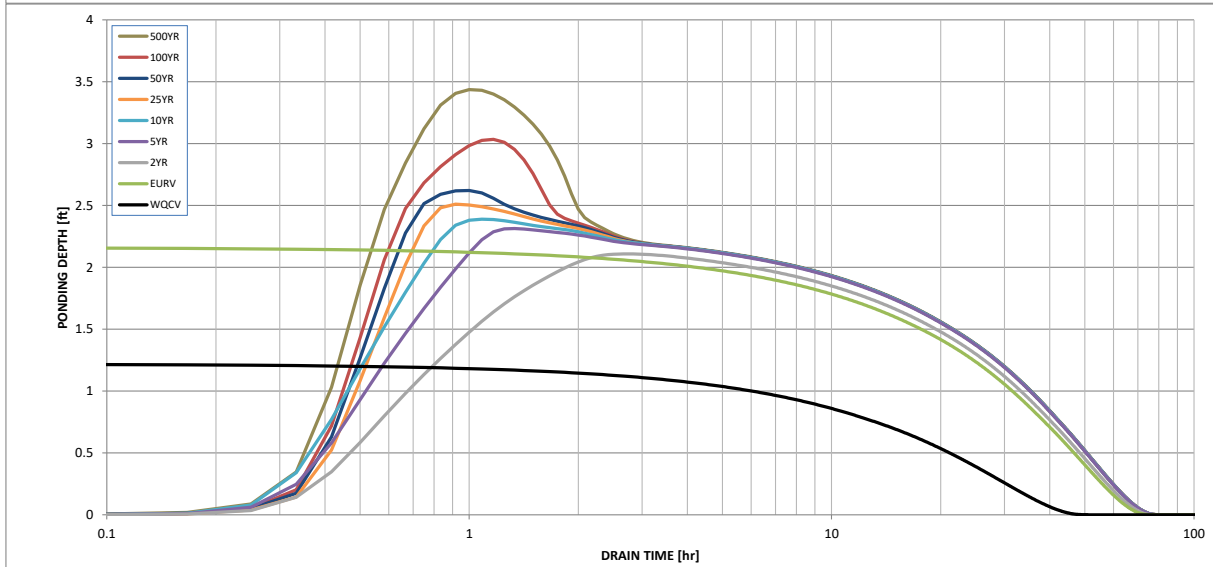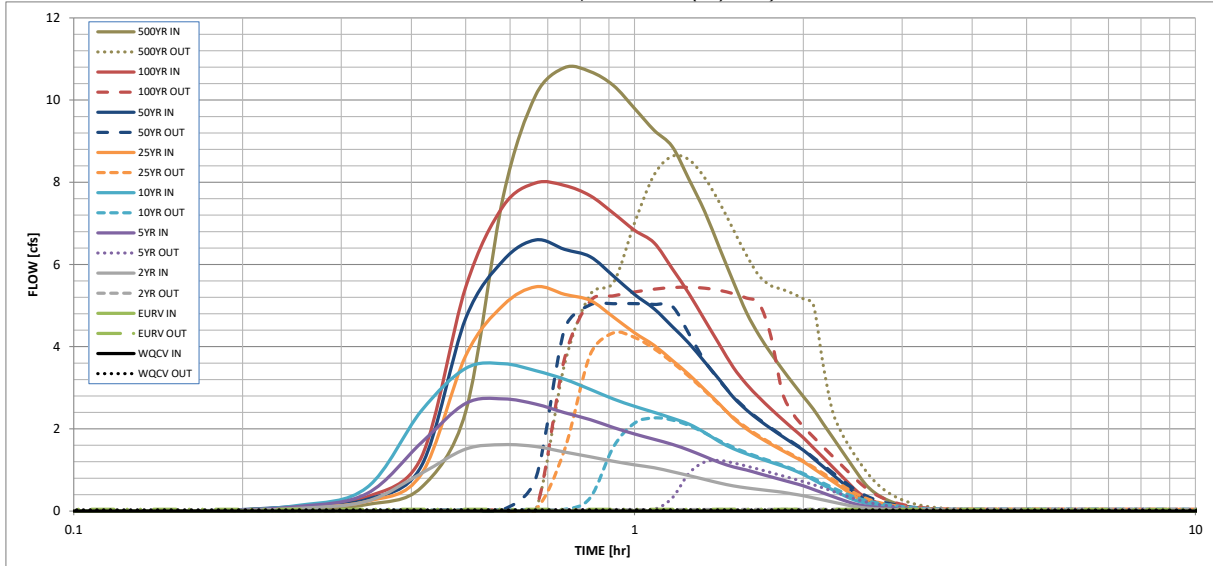

S-A-V-D Chart Axis Override	X-axis	Left Y-Axis	Right Y-Axis
minimum bound			
maximum bound			

# DETENTION BASIN OUTLET STRUCTURE DESIGN



Outflow Hydrograph Workbook Filename: \_\_\_\_\_

## Inflow Hydrographs

The user can override the calculated inflow hydrographs from this workbook with inflow hydrographs developed in a separate program.

Time Interval	SOURCE	CUHP	CUHP	CUHP	CUHP	CUHP	CUHP	CUHP	CUHP	CUHP
	TIME	WQCV [cfs]	EURV [cfs]	2 Year [cfs]	5 Year [cfs]	10 Year [cfs]	25 Year [cfs]	50 Year [cfs]	100 Year [cfs]	500 Year [cfs]
5.00 min	0:00:00	0.00	0.00	0.00	0.00	0.00	0.00	0.00	0.00	0.00
	0:05:00	0.00	0.00	0.00	0.00	0.00	0.00	0.00	0.00	0.00
	0:10:00	0.00	0.00	0.00	0.00	0.00	0.00	0.01	0.00	0.02
	0:15:00	0.00	0.00	0.07	0.11	0.13	0.09	0.11	0.11	0.16
	0:20:00	0.00	0.00	0.24	0.43	0.57	0.24	0.28	0.35	0.57
	0:25:00	0.00	0.00	0.92	1.66	2.44	0.90	1.10	1.31	2.42
	0:30:00	0.00	0.00	1.51	2.62	3.47	3.78	4.69	5.45	7.66
	0:35:00	0.00	0.00	1.62	2.73	3.59	5.01	6.10	7.42	10.13
	0:40:00	0.00	0.00	1.57	2.60	3.41	5.46	6.60	7.98	10.79
	0:45:00	0.00	0.00	1.44	2.39	3.21	5.27	6.37	7.92	10.69
	0:50:00	0.00	0.00	1.32	2.22	2.96	5.13	6.19	7.67	10.36
	0:55:00	0.00	0.00	1.21	2.03	2.73	4.72	5.72	7.25	9.80
	1:00:00	0.00	0.00	1.12	1.88	2.55	4.34	5.27	6.83	9.27
	1:05:00	0.00	0.00	1.05	1.75	2.40	4.03	4.92	6.53	8.87
	1:10:00	0.00	0.00	0.96	1.62	2.26	3.67	4.49	5.90	8.07
	1:15:00	0.00	0.00	0.86	1.48	2.12	3.32	4.08	5.29	7.29
	1:20:00	0.00	0.00	0.77	1.33	1.91	2.95	3.63	4.65	6.41
	1:25:00	0.00	0.00	0.68	1.18	1.69	2.60	3.20	4.05	5.58
	1:30:00	0.00	0.00	0.61	1.07	1.52	2.26	2.77	3.50	4.83
	1:35:00	0.00	0.00	0.56	1.00	1.39	2.00	2.46	3.09	4.28
	1:40:00	0.00	0.00	0.53	0.91	1.29	1.80	2.22	2.77	3.84
	1:45:00	0.00	0.00	0.49	0.83	1.19	1.63	2.01	2.49	3.45
	1:50:00	0.00	0.00	0.46	0.76	1.10	1.47	1.82	2.23	3.11
	1:55:00	0.00	0.00	0.42	0.69	1.00	1.33	1.65	2.00	2.78
	2:00:00	0.00	0.00	0.37	0.61	0.89	1.20	1.48	1.78	2.48
	2:05:00	0.00	0.00	0.32	0.53	0.76	1.04	1.28	1.54	2.14
	2:10:00	0.00	0.00	0.27	0.44	0.64	0.88	1.09	1.31	1.81
	2:15:00	0.00	0.00	0.22	0.36	0.52	0.73	0.90	1.09	1.50
	2:20:00	0.00	0.00	0.18	0.28	0.41	0.58	0.72	0.87	1.20
	2:25:00	0.00	0.00	0.14	0.21	0.32	0.44	0.55	0.66	0.90
	2:30:00	0.00	0.00	0.10	0.16	0.24	0.32	0.39	0.46	0.64
	2:35:00	0.00	0.00	0.08	0.12	0.19	0.22	0.28	0.33	0.47
	2:40:00	0.00	0.00	0.06	0.10	0.16	0.17	0.21	0.24	0.35
	2:45:00	0.00	0.00	0.05	0.08	0.13	0.12	0.16	0.18	0.26
	2:50:00	0.00	0.00	0.04	0.07	0.11	0.09	0.12	0.13	0.19
	2:55:00	0.00	0.00	0.03	0.05	0.09	0.07	0.09	0.09	0.14
	3:00:00	0.00	0.00	0.03	0.04	0.07	0.06	0.07	0.07	0.10
	3:05:00	0.00	0.00	0.02	0.03	0.05	0.04	0.06	0.05	0.07
	3:10:00	0.00	0.00	0.02	0.03	0.04	0.03	0.04	0.04	0.06
	3:15:00	0.00	0.00	0.02	0.02	0.03	0.03	0.03	0.03	0.04
	3:20:00	0.00	0.00	0.01	0.02	0.03	0.02	0.03	0.02	0.04
	3:25:00	0.00	0.00	0.01	0.01	0.02	0.02	0.02	0.02	0.03
	3:30:00	0.00	0.00	0.01	0.01	0.01	0.01	0.02	0.01	0.02
	3:35:00	0.00	0.00	0.00	0.01	0.01	0.01	0.01	0.01	0.02
	3:40:00	0.00	0.00	0.00	0.00	0.01	0.01	0.01	0.01	0.01
	3:45:00	0.00	0.00	0.00	0.00	0.00	0.00	0.00	0.00	0.01
	3:50:00	0.00	0.00	0.00	0.00	0.00	0.00	0.00	0.00	0.00
	3:55:00	0.00	0.00	0.00	0.00	0.00	0.00	0.00	0.00	0.00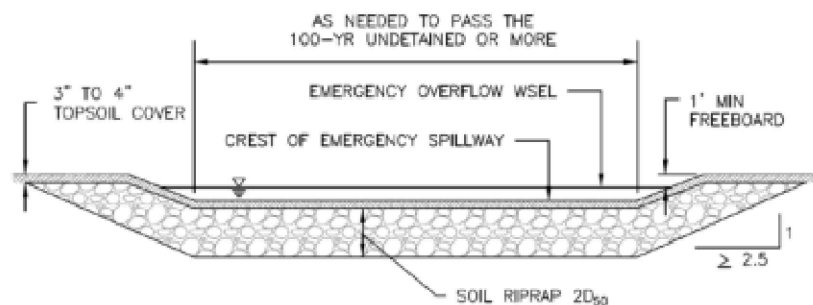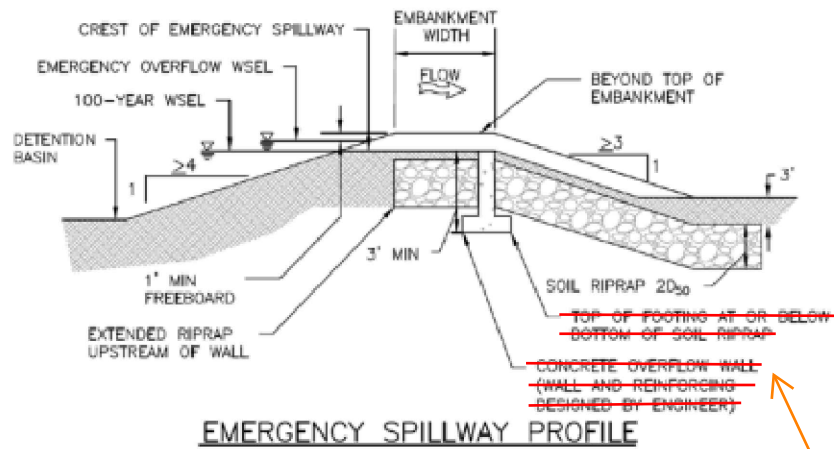
Unresolved Review 1 comment: Discuss in FDR text why a cutoff wall is not necessary.


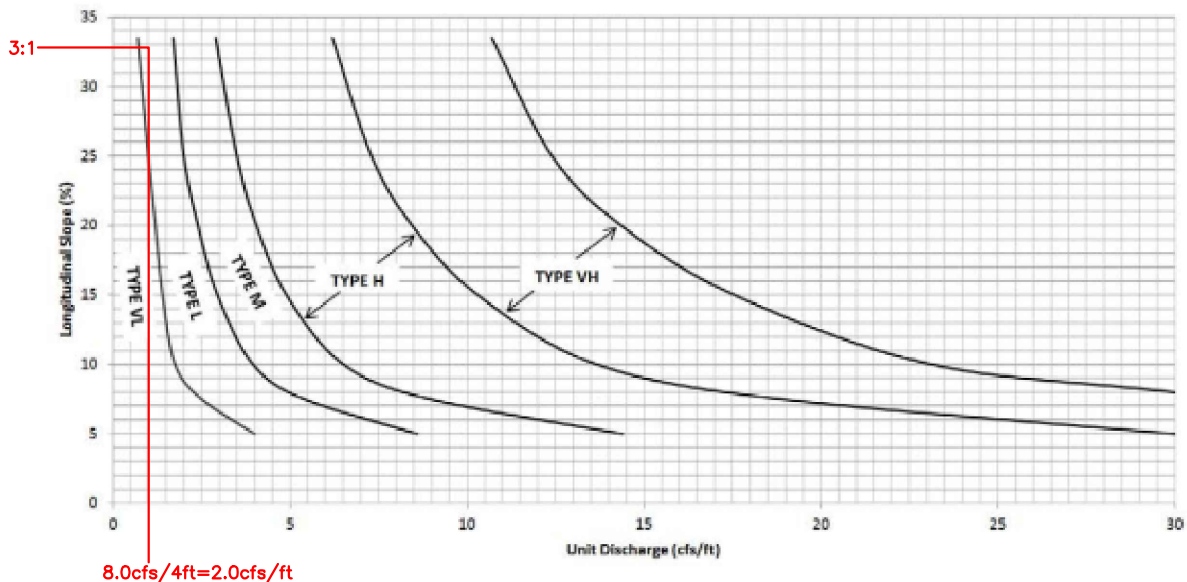



Figure 12-21. Embankment protection details and rock sizing chart (adapted from Arapahoe County)

USE TYPE L



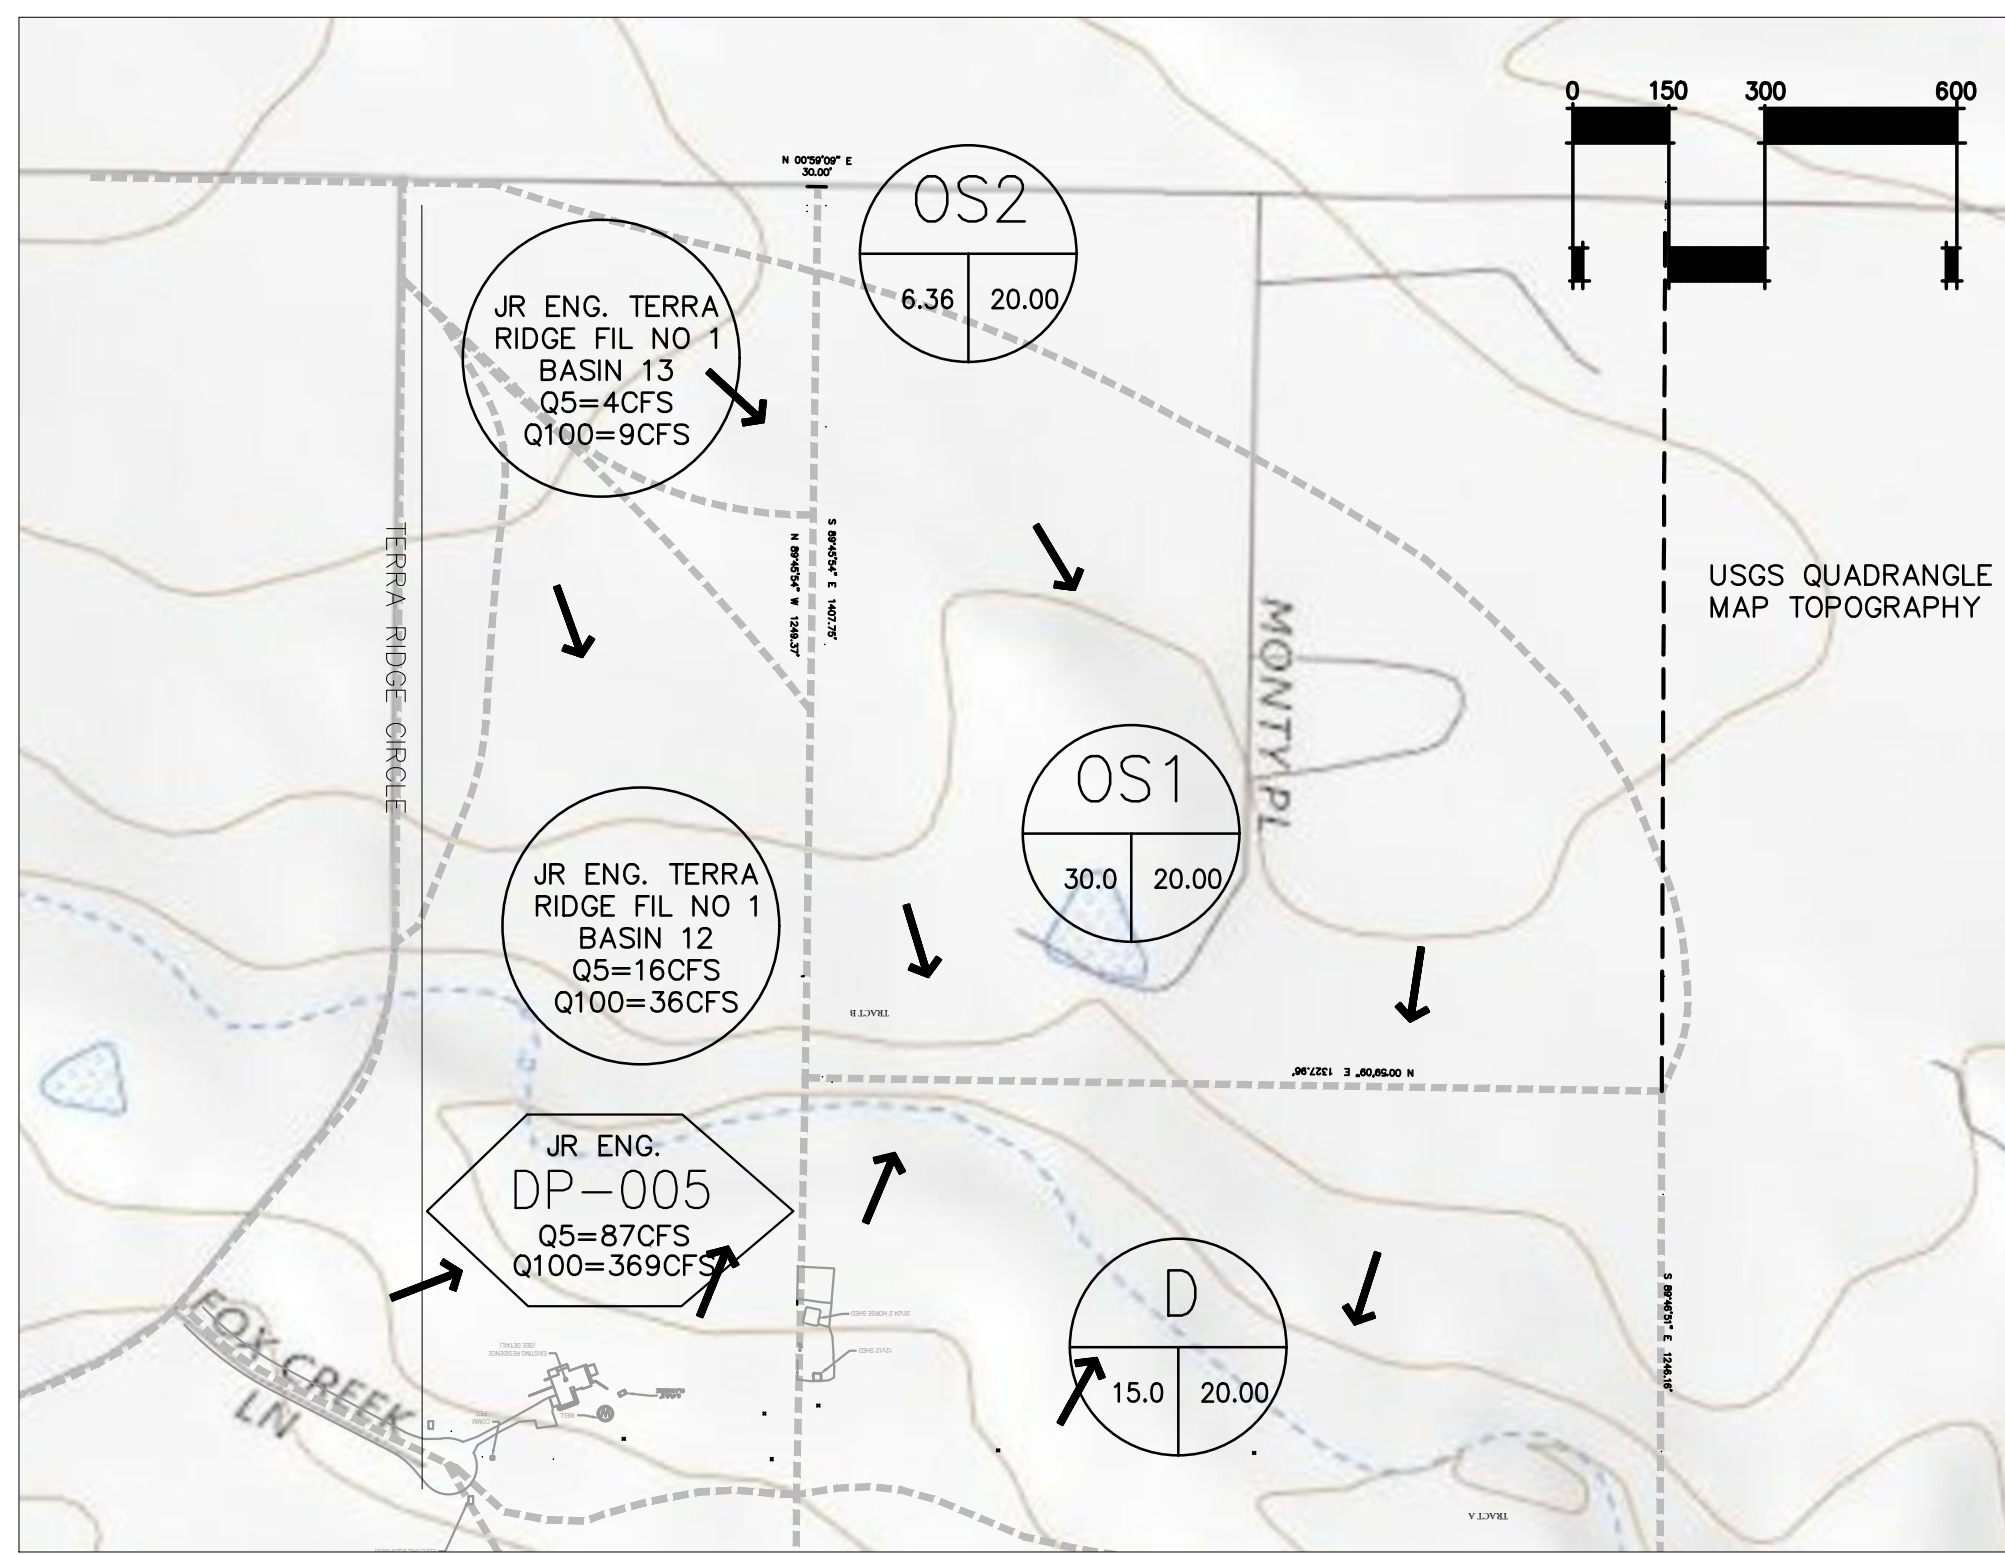

**OFF-SITE BASINS**

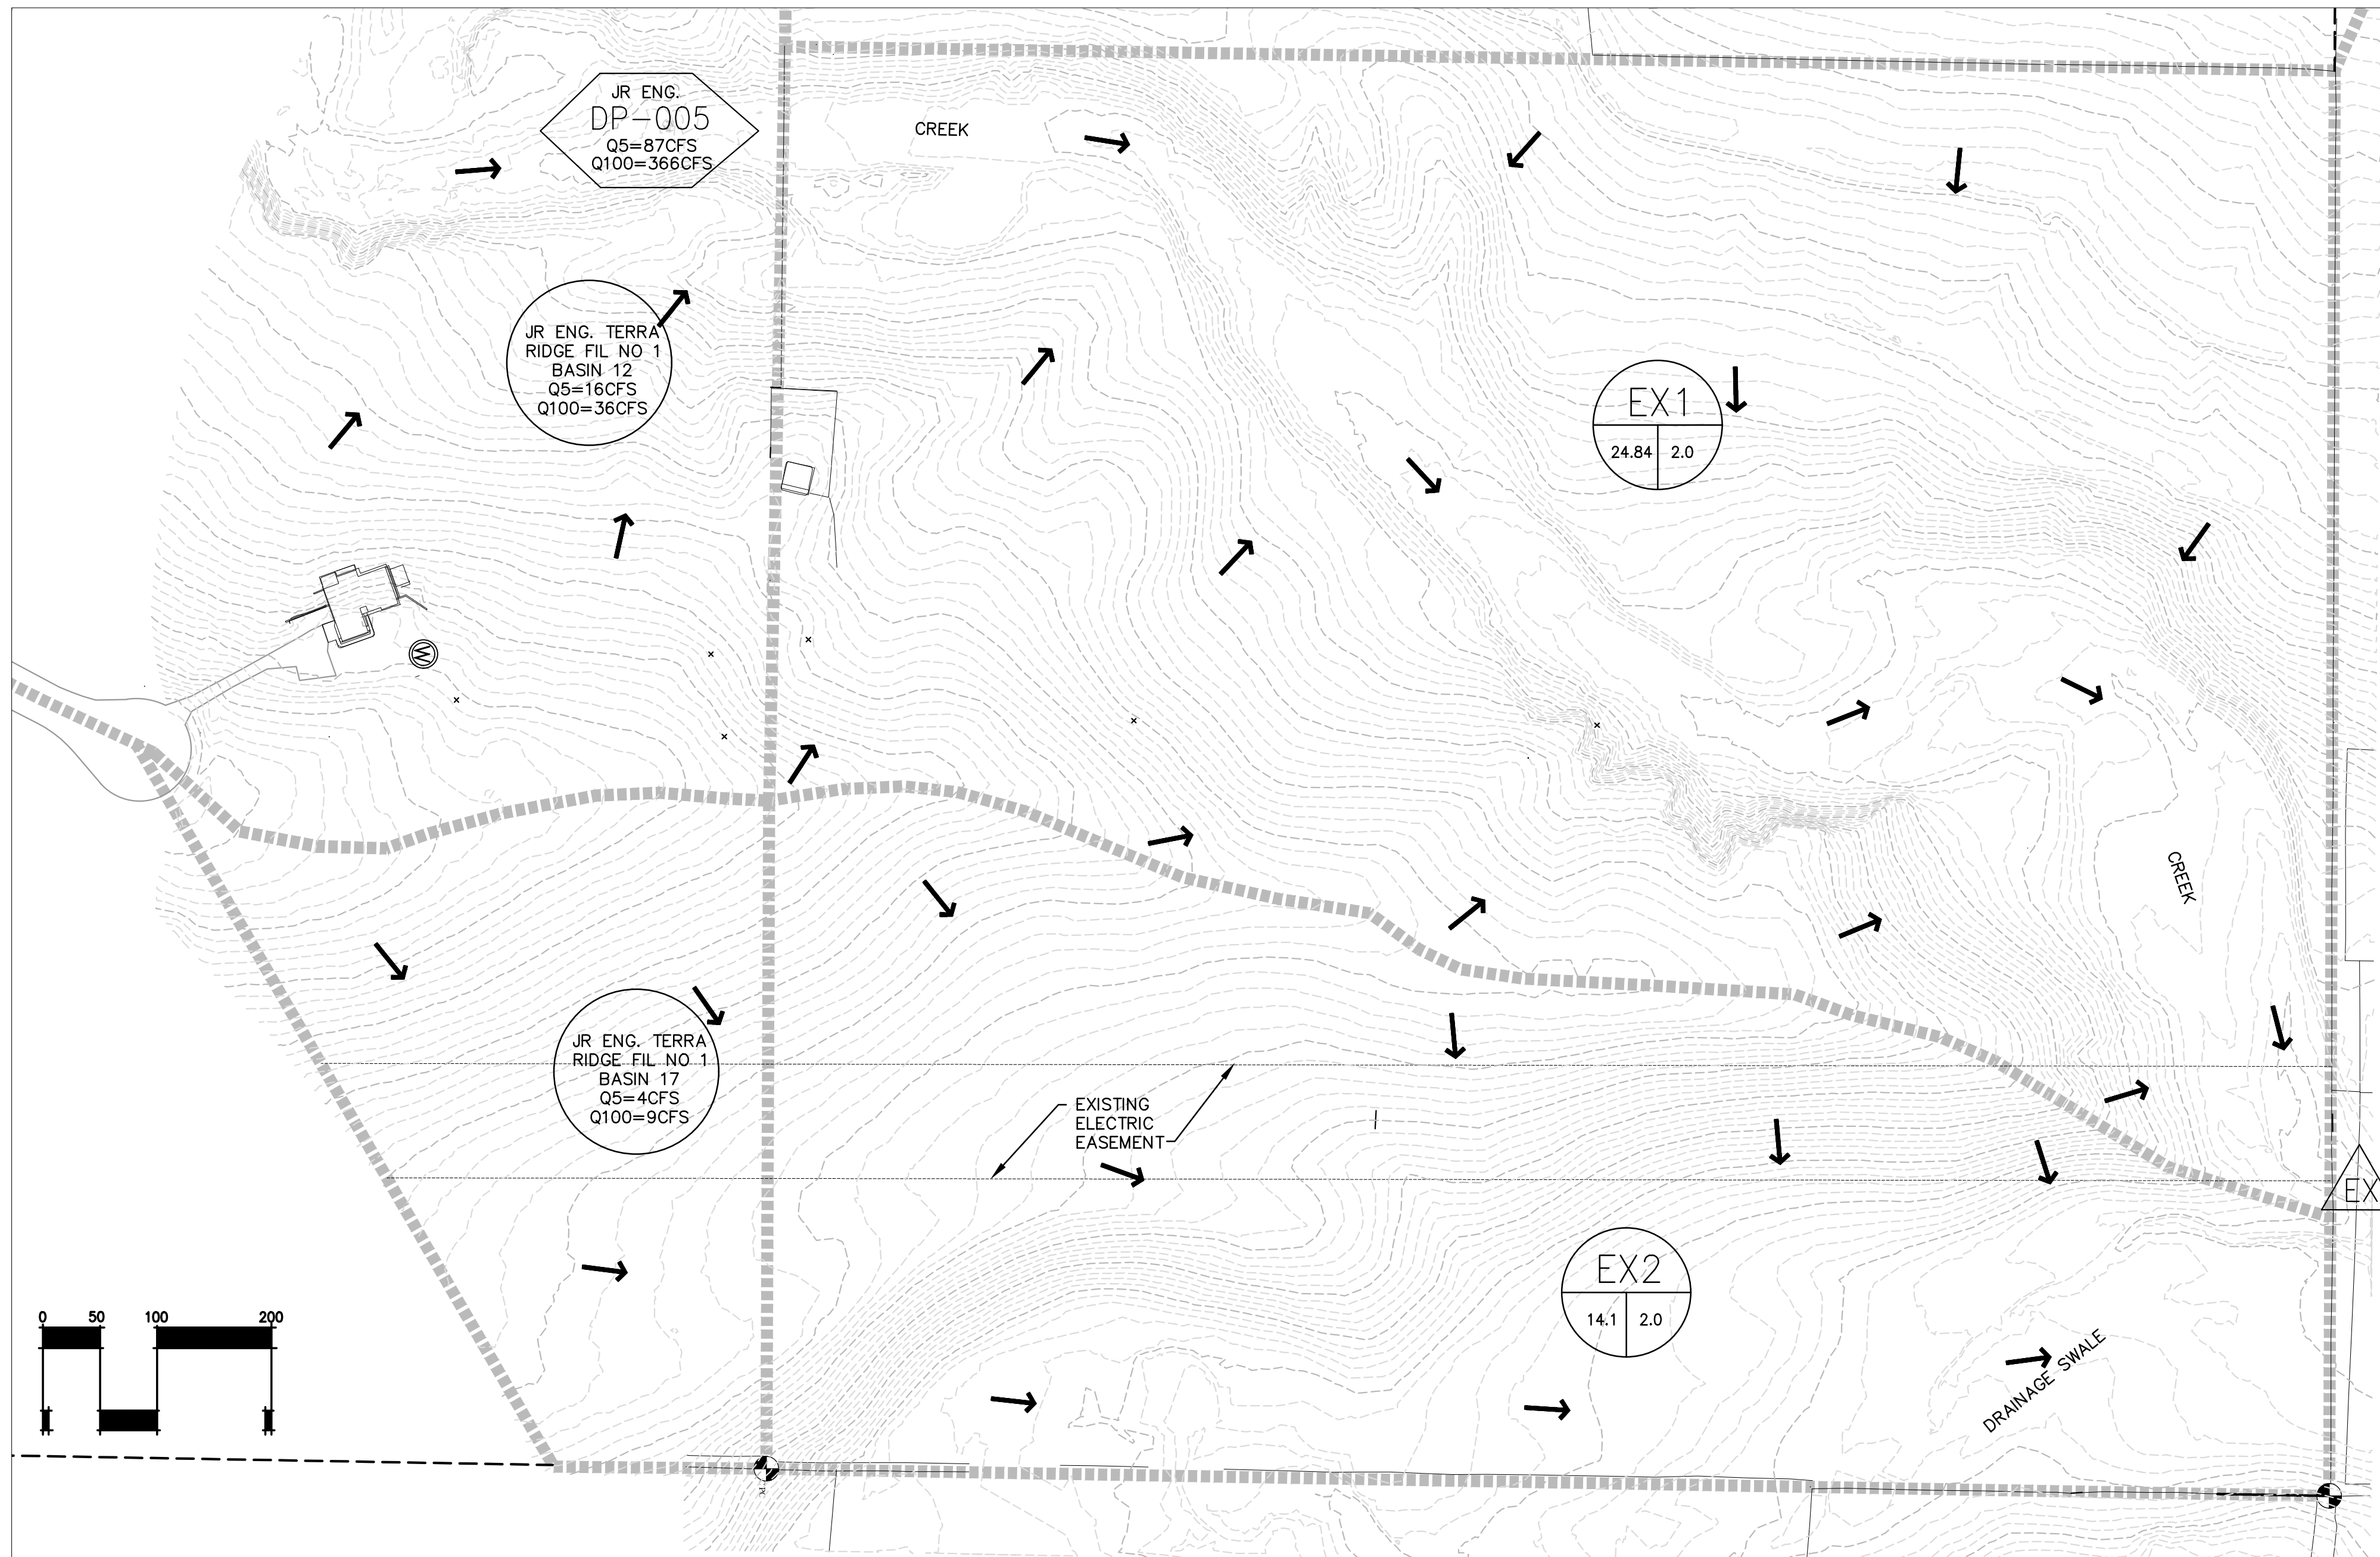

**ON-SITE BASINS**

**LEGEND**

- BASIN ID
- % IMPERVIOUS AREA (ACRES)
- DESIGN POINT
- DRAINAGE BASIN BOUNDARY
- EXISTING CONTOUR (2')
- PROPOSED CONTOUR (2')
- SURFACE FLOW DIRECTION

**RUNOFF COEFFICIENT SUMMARY**

BASIN	AREA (ACRES)	C5	C100
EX1	24.84	0.09	0.36
EX2	6.36	0.09	0.36

**RUNOFF SUMMARY**

DESIGN POINT	Q5	Q100
EX	93.1	433.2



**LODESTAR**  
ENGINEERING, LLC  
FEDERICS CIVIL DRAINAGE AND DEVELOPMENT  
10000 Highway 100, Suite 100  
Colorado Springs, CO 80901  
Tel: (719) 575-1000  
www.lodestar-engineering.com



ISSUED 2/23/23


REVISIONS

**TERRA RIDGE NORTH**  
TOWN OF BLACK FOREST  
EL PASO COUNTY, COLORADO


**EXISTING DRAINAGE PLAN**

**D1**  
SHEET NO.




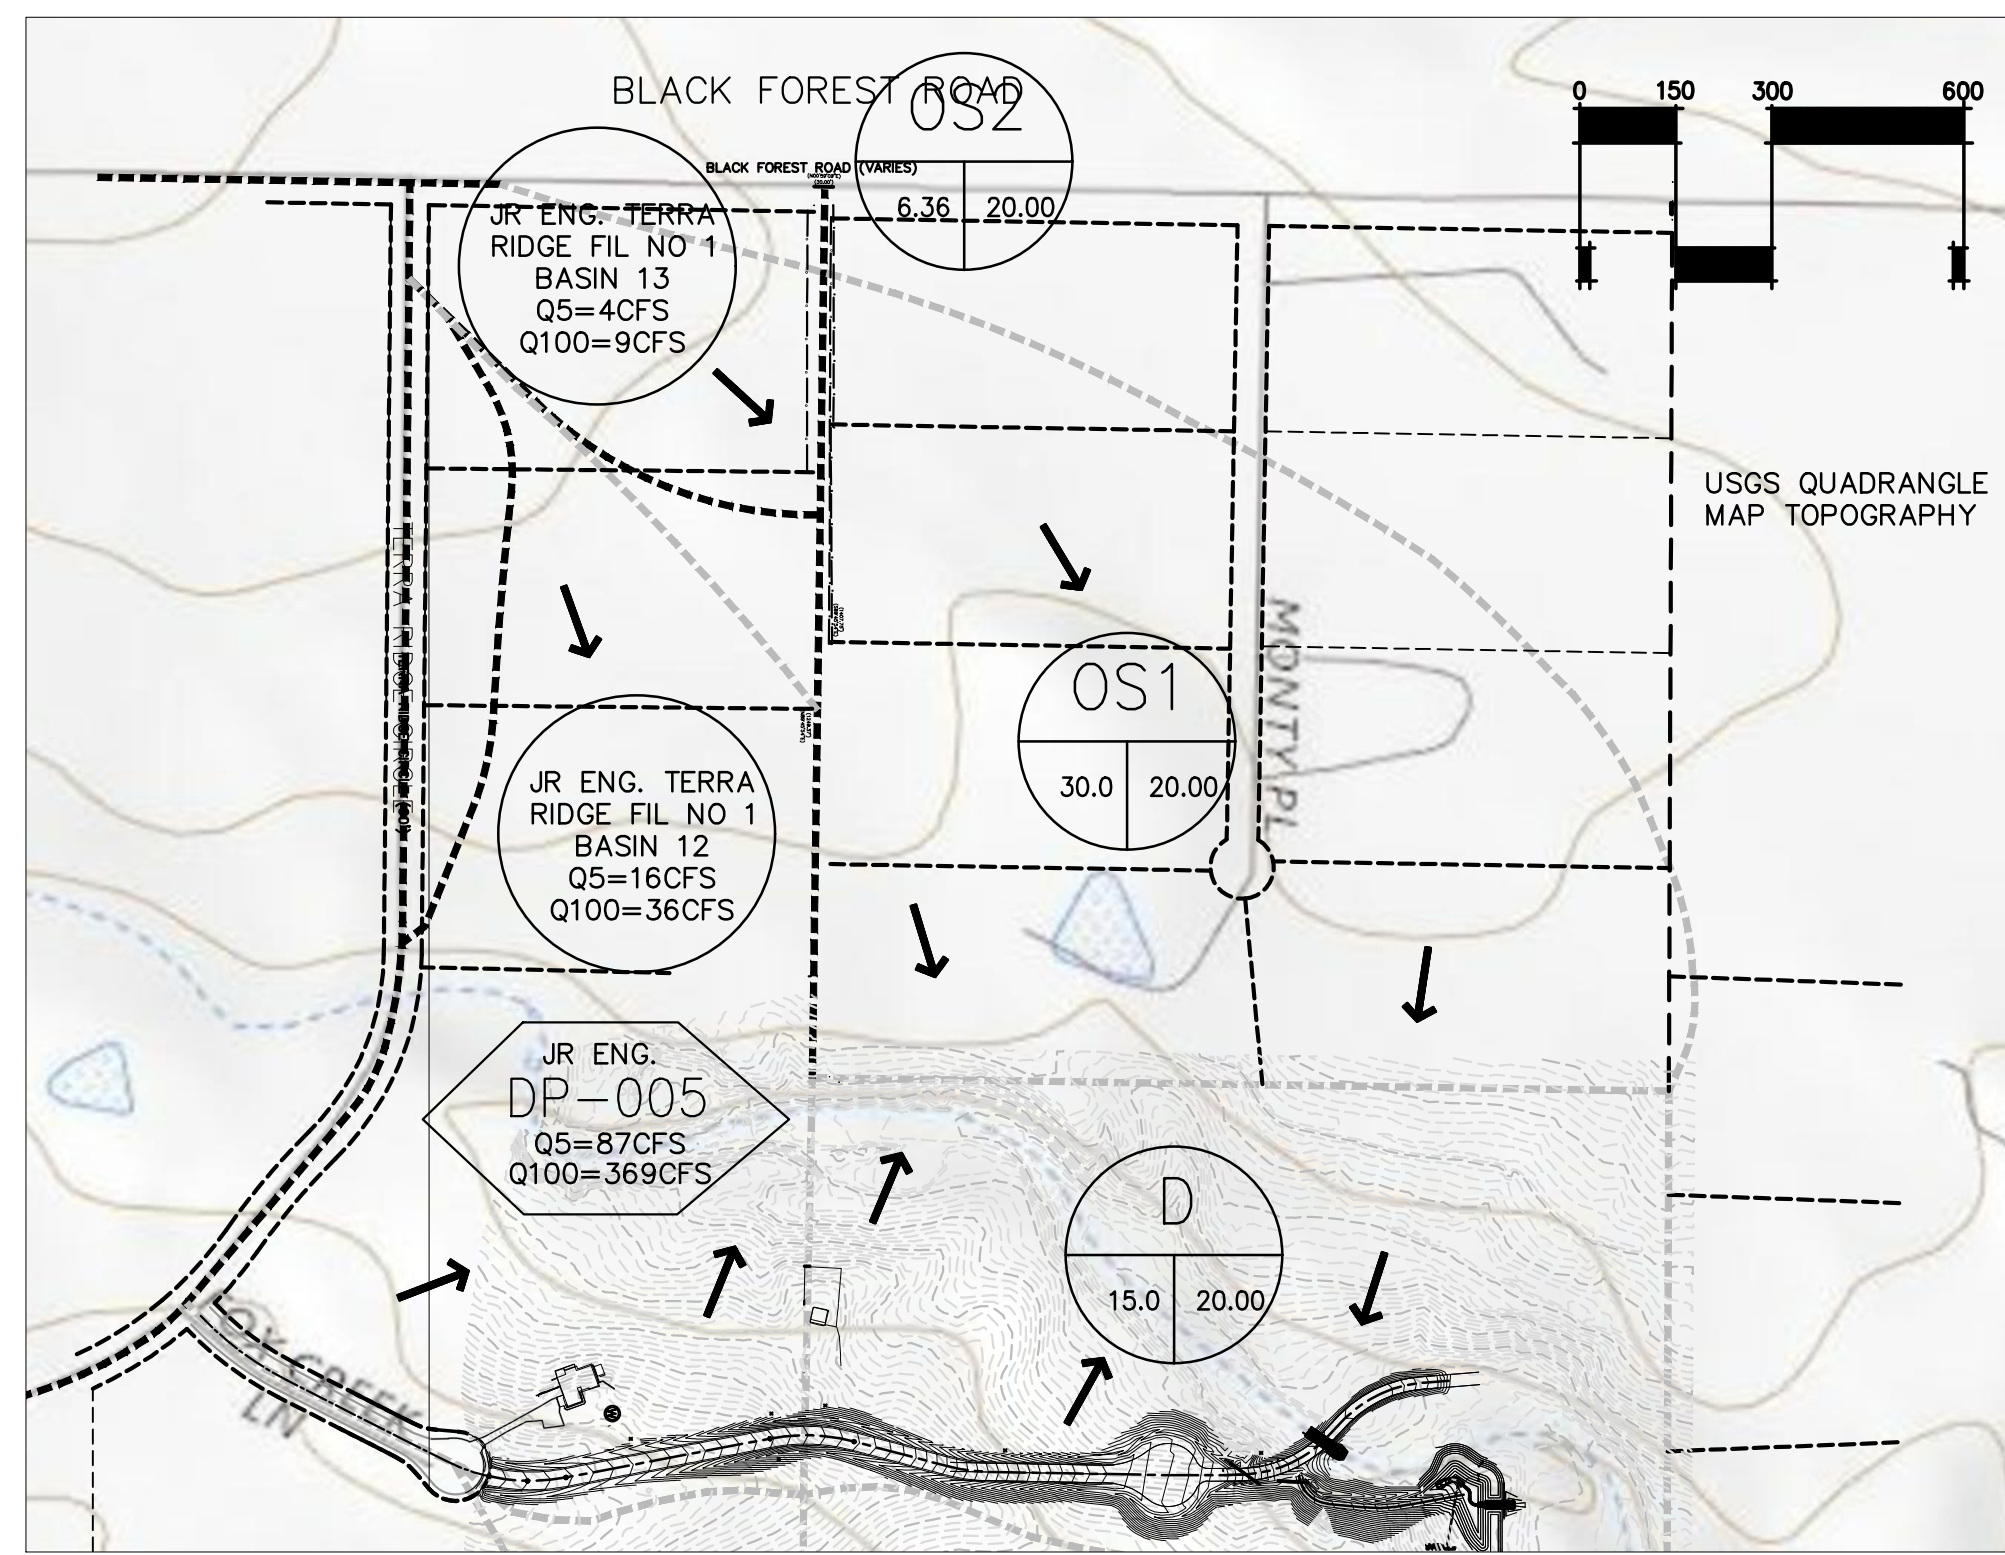

**OFF-SITE BASINS**  
1"=300'

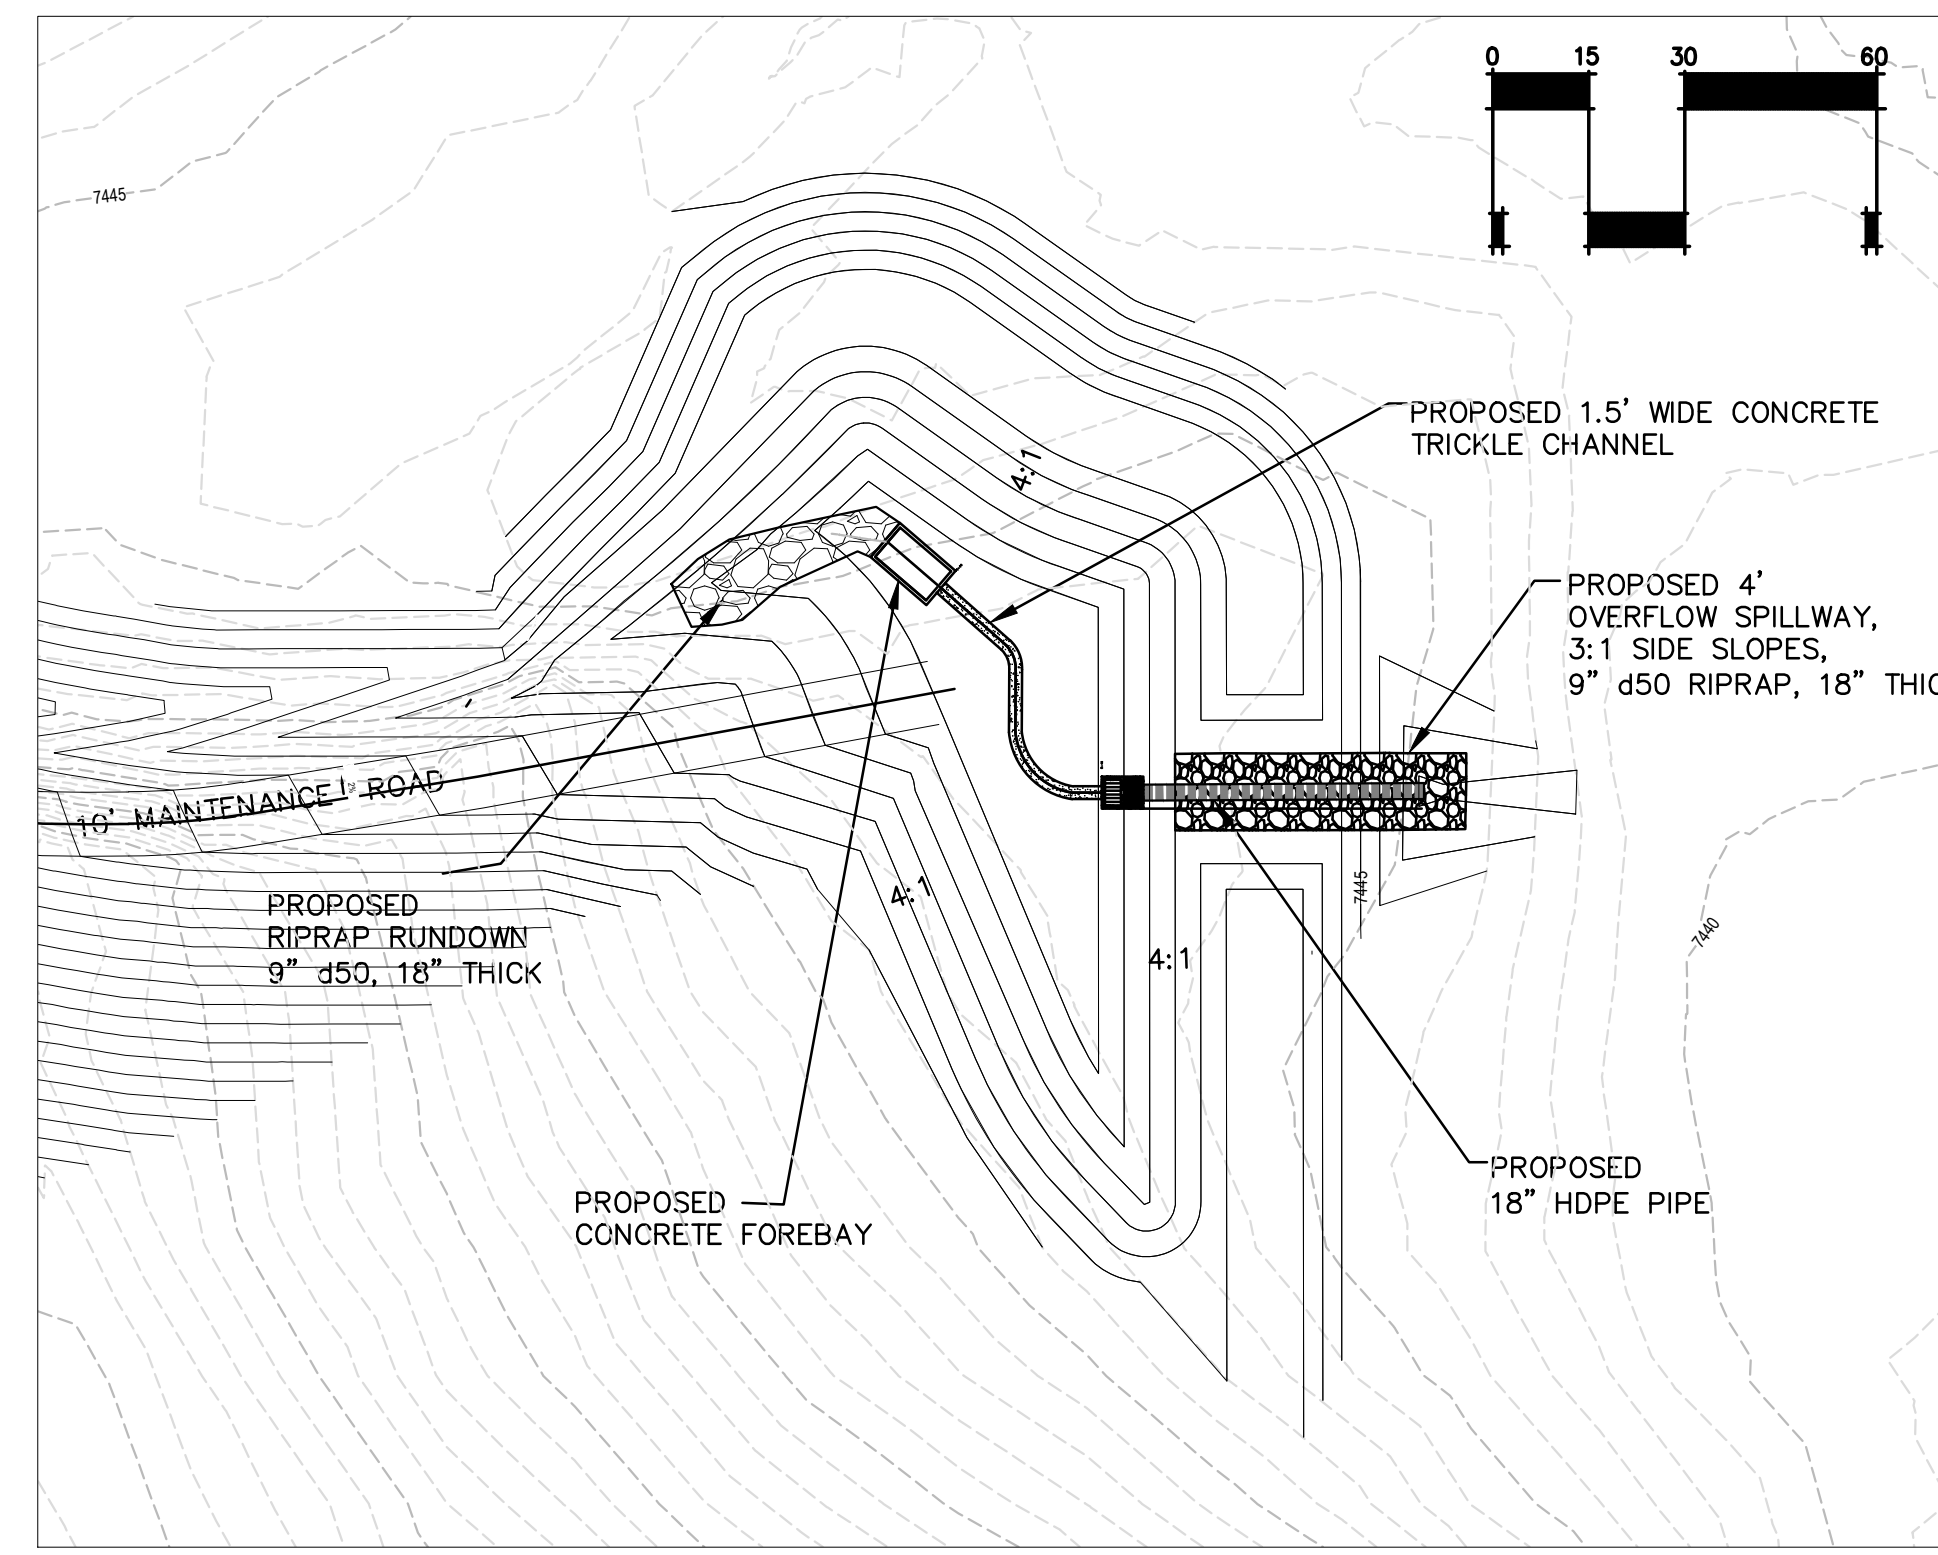

**DETENTION/WATER QUALITY FACILITY**  
1"=30'

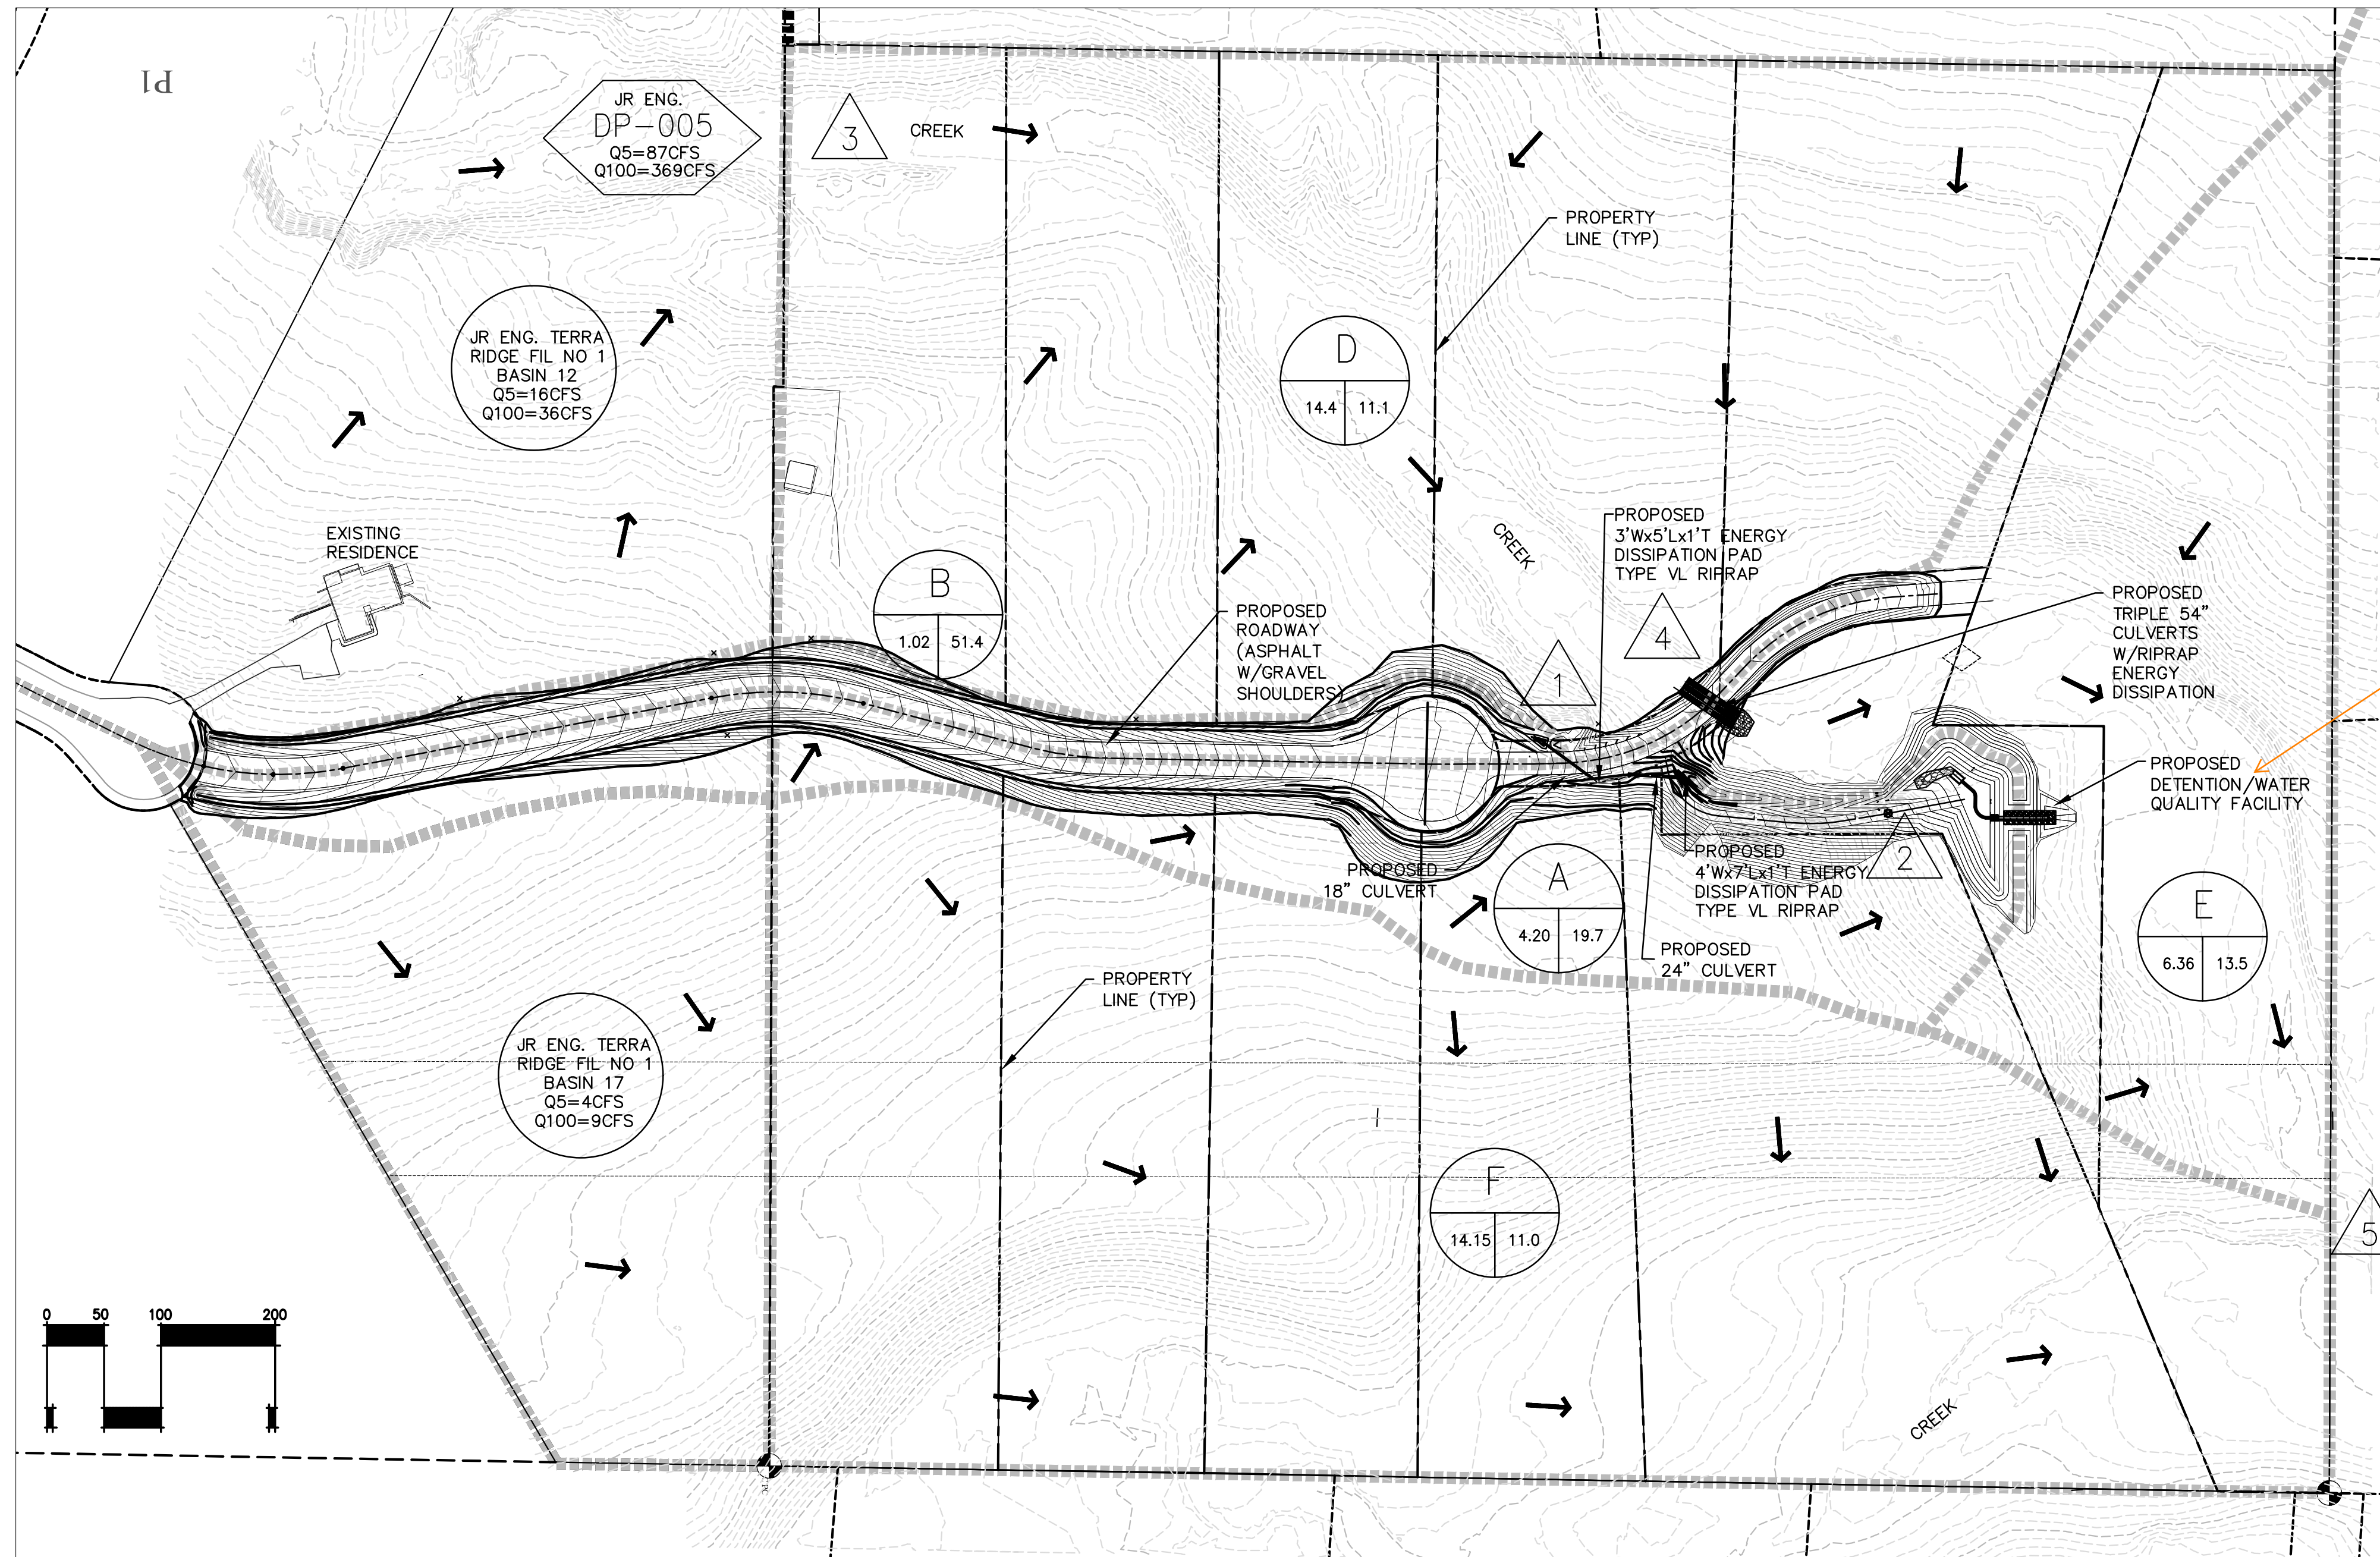

**ON-SITE BASINS**  
1"=100'

Assign a name/number to all PBMPs and then update all submitted text and drawings accordingly with consistent labeling throughout (example: "Pond A" or "Pond 1").

**LEGEND**

- BASIN ID
- % IMPERVIOUS AREA (ACRES)
- DESIGN POINT
- DRAINAGE BASIN BOUNDARY
- EXISTING CONTOUR (2')
- PROPOSED CONTOUR (2')
- SURFACE FLOW DIRECTION

**RUNOFF COEFFICIENT SUMMARY**


BASIN	AREA (ACRES)	C5	C100
A	4.20	0.18	0.51
B	0.94	0.46	0.63
C	N/A	N/A	N/A
D	14.59	0.09	0.49
E	6.36	0.10	0.49
F	14.15	0.08	0.48
OS1	30.00	0.05	0.46
OS2	6.36	0.07	0.47
EX1	24.84	0.09	0.36
EX2	14.10	0.09	0.36

**RUNOFF SUMMARY**

DESIGN POINT	Q5	Q100
1	2.0	4.5
2	5.4	18.0
3	86.3	366.0
4	92.1	432.0
5	100.1	472.7
EX	96.9	433.7

**WATER QUALITY/DETENTION SUMMARY**

FACILITY TYPE	EXTENDED DET. BASIN
WQCV	0.060 ACRE-FT
EURV	0.137 ACRE-FT
100-YR STORAGE PROVIDED	0.236 ACRE-FT
100-YR PEAK OUTFLOW Q	5.4 CFS

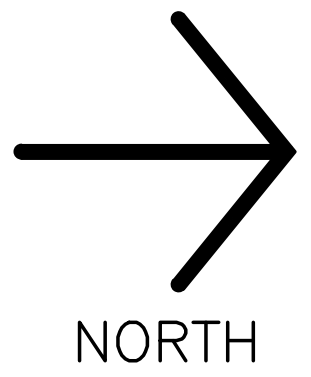

ISSUED 8/29/21

REVISIONS

TERRA RIDGE NORTH  
TOWN OF BLACK FOREST  
EL PASO COUNTY, COLORADO

DEVELOPED DRAINAGE PLAN

D2  
SHEET NO.



# V2\_Drainage Report Redlines.pdf Markup Summary 3-20-2023

## Glenn Reese - EPC Stormwater (33)

ing and proposed conditions for the 5-yr (in  
fall depths were derived from NOAA Atl:  
cation.  
**Revise to v4.06**  
ydrologic and hydraulic software were use  
5 -Culvert and Erosion Protection Calcul  
n v4.05 - Water Quality and Detention Ca  
needed for the triple 54" pipes to accurat  
( see course) - USFOT Erosion Highway A

**Author:** Glenn Reese - EPC Stormwater  
**Subject:** SW - Textbox with Arrow  
**Page Label:** 5  
**Date:** 3/15/2023 2:35:20 PM  
**Status:**  
**Color:** ■  
**Layer:**  
**Space:**

Revise to v4.06

**Unresolved Review 1 comment:**  
For Basins A and B, state the area of  
non-excluded soil disturbance to be treated by the  
pond and state the area of soil disturbance that is  
excluded from pond treatment.

**Author:** Glenn Reese - EPC Stormwater  
**Subject:** SW - Textbox  
**Page Label:** 6  
**Date:** 3/15/2023 2:47:44 PM  
**Status:**  
**Color:** ■  
**Layer:**  
**Space:**

**Unresolved Review 1 comment:**  
For Basins A and B, state the area of  
non-excluded soil disturbance to be treated by the  
pond and state the area of soil disturbance that is  
excluded from pond treatment.

Review 2 clarification: see table on pdf page 12  
below for a more simple and clear approach.

**This is a follow-up to my Review 1 comment on the  
drainage map about untreated proposed soil  
disturbances in Basin D:**  
Per direction from the State, subdivision  
developments that include impervious pavement  
roads do not qualify for Exclusion E (Large Lot  
Single-Family Site) on the PBMP form for those  
roadway areas. Therefore, a permanent WQ  
facility should be designed to treat runoff from the  
impervious roadway area and the subsequent  
grading like roadside ditches (but only if the total  
area of soil disturbance is >1ac). A driveway that  
feeds and crosses multiple lots counts toward  
roadway impervious area. But individual driveways  
for individual lots counts towards the impervious  
area for the large single-family lot.  
For this site, I recommend you look into utilizing  
Runoff Reduction (RR) for WQ treatment per  
MHFD Detail T-0. MHFD has a calculation  
spreadsheet for RR. See further guidance in my  
comment at the bottom of pdf page 11 below.

**Author:** Glenn Reese - EPC Stormwater  
**Subject:** SW - Textbox with Arrow  
**Page Label:** 7  
**Date:** 3/15/2023 2:21:40 PM  
**Status:**  
**Color:** ■  
**Layer:**  
**Space:**

This is a follow-up to my Review 1 comment on the  
drainage map about untreated proposed soil  
disturbances in Basin D:  
Per direction from the State, subdivision  
developments that include impervious pavement  
roads do not qualify for Exclusion E (Large Lot  
Single-Family Site) on the PBMP form for those  
roadway areas. Therefore, a permanent WQ  
facility should be designed to treat runoff from the  
impervious roadway area and the subsequent  
grading like roadside ditches (but only if the total  
area of soil disturbance is >1ac). A driveway that  
feeds and crosses multiple lots counts toward  
roadway impervious area. But individual driveways  
for individual lots counts towards the impervious  
area for the large single-family lot.  
For this site, I recommend you look into utilizing  
Runoff Reduction (RR) for WQ treatment per  
MHFD Detail T-0. MHFD has a calculation  
spreadsheet for RR. See further guidance in my  
comment at the bottom of pdf page 11 below.

**Unresolved Review comment:**  
In the Proposed Drainage section above, also add  
a paragraph or two for the proposed roadway  
improvements for this project (Fox Creek Lane)  
that are South of this project (Terra Ridge North)  
within Terra Ridge F1 (as shown on the drainage  
map on pdf page 66 below).

**Author:** Glenn Reese - EPC Stormwater  
**Subject:** SW - Textbox  
**Page Label:** 7  
**Date:** 3/15/2023 2:37:05 PM  
**Status:**  
**Color:** ■  
**Layer:**  
**Space:**

**Unresolved Review comment:**  
In the Proposed Drainage section above, also add  
a paragraph or two for the proposed roadway  
improvements for this project (Fox Creek Lane)  
that are South of this project (Terra Ridge North)  
within Terra Ridge F1 (as shown on the drainage  
map on pdf page 66 below).

**Basin F?**  
e generated from a naturally  
sin E flows are routed in an  
roperty which combines with  
northeastern lot corner

**Author:** Glenn Reese - EPC Stormwater  
**Subject:** SW - Textbox with Arrow  
**Page Label:** 7  
**Date:** 3/15/2023 2:38:03 PM  
**Status:**  
**Color:** ■  
**Layer:**  
**Space:**


Basin F?



**Author:** Glenn Reese - EPC Stormwater  
**Subject:** SW - Textbox with Arrow  
**Page Label:** 7  
**Date:** 3/15/2023 3:19:03 PM  
**Status:**  
**Color:** ■  
**Layer:**  
**Space:**


Unresolved Review 1 comment: Discuss WQ treatment exclusions for this basin: Excluded per ECM Appendix I.7.1.B.5 for Large Lot Single Family Sites.

Review 2 clarification: You must reference an adequate WQ exclusion for any areas of proposed soil disturbance that are not tributary to the pond. Examples: 20% up to 1ac of development can be excluded per ECM App I.7.1.C.1 and exclusions listed in ECM App I.7.1.B.#).

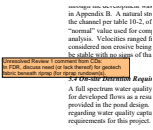


**Author:** Glenn Reese - EPC Stormwater  
**Subject:** SW - Textbox  
**Page Label:** 8  
**Date:** 3/15/2023 3:24:14 PM  
**Status:**  
**Color:** ■  
**Layer:**  
**Space:**

Unresolved Review 1 comment from CDs: In FDR, discuss need (or lack thereof) for geotech fabric beneath riprap (for riprap rundown(s)).

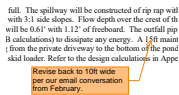


**Author:** Glenn Reese - EPC Stormwater  
**Subject:** SW - Textbox with Arrow  
**Page Label:** 9  
**Date:** 3/15/2023 4:26:11 PM  
**Status:**  
**Color:** ■  
**Layer:**  
**Space:**

Revise back to 10ft wide per our email conversation from February.

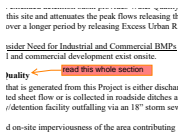


**Author:** Glenn Reese - EPC Stormwater  
**Subject:** SW - Textbox with Arrow  
**Page Label:** 9  
**Date:** 3/15/2023 2:30:03 PM  
**Status:**  
**Color:** ■  
**Layer:**  
**Space:**

read this whole section

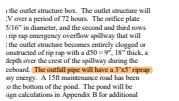


**Author:** Glenn Reese - EPC Stormwater  
**Subject:** SW - Highlight  
**Page Label:** 9  
**Date:** 3/15/2023 4:26:03 PM  
**Status:**  
**Color:** ■  
**Layer:**  
**Space:**

The outfall pipe will have a 3'x5' riprap

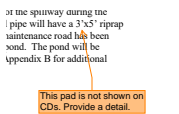

**Author:** Glenn Reese - EPC Stormwater  
**Subject:** SW - Textbox with Arrow  
**Page Label:** 9  
**Date:** 3/15/2023 4:26:41 PM  
**Status:**  
**Color:** ■  
**Layer:**  
**Space:**

This pad is not shown on CDs. Provide a detail.

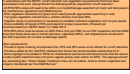

**Author:** Glenn Reese - EPC Stormwater  
**Subject:** SW - Textbox  
**Page Label:** 11  
**Date:** 3/15/2023 2:20:01 PM  
**Status:**  
**Color:** ■  
**Layer:**  
**Space:**

In accordance with the MHFD, runoff reduction has vegetation requirements that have been overlooked in the past. Going forward the following will be required for runoff reduction:

- All RPA/SPA areas will need to be within a no build/drainage easement (or tract) and discussed in the maintenance agreement and O&M manual.
- RPA vegetation should be turf grass (from seed [provide appropriate seed mix] or sod).
- Turf grass vegetation should have a uniform density of at least 80%.
- Irrigation (temp or permanent) is necessary to establish sufficient vegetation and not just weeds.
- Show suitability of topsoil of RPA and steps for proper preparation of topsoil per recommendations in MHFD detail T-0 Table RR-3
- RPA/SPA limits must be shown on GEC Plans (not just FDR) so our SW inspectors and the QSM know that these areas are to remain pervious, vegetated (80%), and irrigated post-construction. Our SW inspectors do not look at drainage reports.

**Other requirements:**

- Provide a figure showing all proposed UIA, RPA and SPA areas to be utilized for runoff reduction.
- Provide a detail for the UIA:RPA interface that shows the recommended vertical drop of 4".
- Show signage to be posted in RPAs so maintenance personnel and owners know that the area is a water quality treatment area (not just a regular grassy area and/or an SPA). The signage should say something like: "Water Quality Treatment Area, do not pollute. Area to remain vegetated and properly maintained per the O&M Manual."

 


**Author:** Glenn Reese - EPC Stormwater  
**Subject:** SW - Textbox  
**Page Label:** 12  
**Date:** 3/15/2023 2:45:51 PM  
**Status:**  
**Color:** ■  
**Layer:**  
**Space:**

The text on pdf pages 6 and 7 above about WQ treatment for each basin would be much clearer if summarized in a table like the example one provided below. This will be a lot more concise than expanded all of your paragraphs above. Instead you can just reference this table in those paragraphs.


Basin	Area (sq ft)	Volume (cu ft)	Retention Time (min)	Flow Rate (gpm)	Settling Velocity (ft/min)	Settling Time (min)	Settling Distance (ft)	Settling Efficiency (%)
Basin 1	1000	1000	10	100	0.1	100	100	100
Basin 2	2000	2000	20	200	0.2	200	200	100
Basin 3	3000	3000	30	300	0.3	300	300	100

**Author:** Glenn Reese - EPC Stormwater  
**Subject:** Image  
**Page Label:** 12  
**Date:** 3/15/2023 2:45:53 PM  
**Status:**  
**Color:** ■  
**Layer:**  
**Space:**



**Author:** Glenn Reese - EPC Stormwater  
**Subject:** SW - Textbox  
**Page Label:** 12  
**Date:** 3/15/2023 2:45:55 PM  
**Status:**  
**Color:** ■  
**Layer:**  
**Space:**

This table can be added to the report text above or inserted into the existing drainage map on pdf pg 66 below.

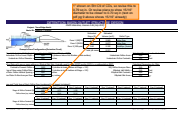

**Author:** Glenn Reese - EPC Stormwater  
**Subject:** SW - Textbox with Arrow  
**Page Label:** 60  
**Date:** 3/15/2023 4:21:36 PM  
**Status:**  
**Color:** ■  
**Layer:**  
**Space:**

1" shown on Sht C9 of CDs, so revise this to 0.79 sq in. Or revise plans to show 15/16" diameter to be closer to 0.70 sq in (text on pdf pg 9 above shows 15/16" already)

it: Stage and Total /



**Author:** Glenn Reese - EPC Stormwater  
**Subject:** Checkmark  
**Page Label:** 60  
**Date:** 3/14/2023 6:11:44 PM  
**Status:**  
**Color:** ■  
**Layer:**  
**Space:**


User Input: Ov




**Author:** Glenn Reese - EPC Stormwater  
**Subject:** Checkmark  
**Page Label:** 60  
**Date:** 3/14/2023 6:11:47 PM  
**Status:**  
**Color:** ■  
**Layer:**  
**Space:**



**Author:** Glenn Reese - EPC Stormwater  
**Subject:** Checkmark  
**Page Label:** 60  
**Date:** 3/14/2023 6:12:00 PM  
**Status:**  
**Color:** ■  
**Layer:**  
**Space:**

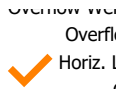

**Author:** Glenn Reese - EPC Stormwater  
**Subject:** Checkmark  
**Page Label:** 60  
**Date:** 3/14/2023 6:12:03 PM  
**Status:**  
**Color:** ■  
**Layer:**  
**Space:**

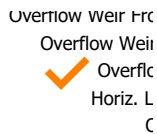

**Author:** Glenn Reese - EPC Stormwater  
**Subject:** Checkmark  
**Page Label:** 60  
**Date:** 3/14/2023 6:12:05 PM  
**Status:**  
**Color:** ■  
**Layer:**  
**Space:**



Restrictor

User Input:

**Author:** Glenn Reese - EPC Stormwater  
**Subject:** Checkmark  
**Page Label:** 60  
**Date:** 3/14/2023 6:12:43 PM  
**Status:**  
**Color:** ■  
**Layer:**  
**Space:**

Depth to Invert



Outlet

Restrictor Plate Height Above

**Author:** Glenn Reese - EPC Stormwater  
**Subject:** Checkmark  
**Page Label:** 60  
**Date:** 3/14/2023 6:12:47 PM  
**Status:**  
**Color:** ■  
**Layer:**  
**Space:**

User Input: Outlet Pipe



Depth

Restrictor Plate Height

**Author:** Glenn Reese - EPC Stormwater  
**Subject:** Checkmark  
**Page Label:** 60  
**Date:** 3/14/2023 6:13:07 PM  
**Status:**  
**Color:** ■  
**Layer:**  
**Space:**

Emergency Spillway



Spillway

Spillway

Spillway

**Author:** Glenn Reese - EPC Stormwater  
**Subject:** Checkmark  
**Page Label:** 60  
**Date:** 3/14/2023 6:13:33 PM  
**Status:**  
**Color:** ■  
**Layer:**  
**Space:**

Emergency Spillway



Spillway

Spillway

Spillway

Restrictor Plate Height Above Max Water

**Author:** Glenn Reese - EPC Stormwater  
**Subject:** Checkmark  
**Page Label:** 60  
**Date:** 3/14/2023 6:13:53 PM  
**Status:**  
**Color:** ■  
**Layer:**  
**Space:**

Spillway

Spillway




Spillway

Restrictor Plate Height Above Max Water


**Author:** Glenn Reese - EPC Stormwater  
**Subject:** Checkmark  
**Page Label:** 60  
**Date:** 3/14/2023 6:13:55 PM  
**Status:**  
**Color:** ■  
**Layer:**  
**Space:**




Author: Glenn Reese - EPC Stormwater  
 Subject: Checkmark  
 Page Label: 60  
 Date: 3/14/2023 6:13:59 PM  
 Status:  
 Color: ■  
 Layer:  
 Space:

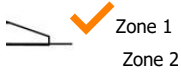


Author: Glenn Reese - EPC Stormwater  
 Subject: Checkmark  
 Page Label: 60  
 Date: 3/14/2023 6:14:53 PM  
 Status:  
 Color: ■  
 Layer:  
 Space:

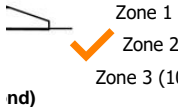

Author: Glenn Reese - EPC Stormwater  
 Subject: Checkmark  
 Page Label: 60  
 Date: 3/14/2023 6:14:54 PM  
 Status:  
 Color: ■  
 Layer:  
 Space:

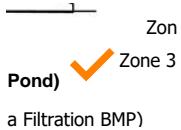


Author: Glenn Reese - EPC Stormwater  
 Subject: Checkmark  
 Page Label: 60  
 Date: 3/14/2023 6:14:55 PM  
 Status:  
 Color: ■  
 Layer:  
 Space:

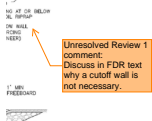

Author: Glenn Reese - EPC Stormwater  
 Subject: SW - Textbox with Arrow  
 Page Label: [1] developed  
 Date: 3/14/2023 6:03:04 PM  
 Status:  
 Color: ■  
 Layer:  
 Space:

Unresolved Review 1 comment:  
 Discuss in FDR text why a cutoff wall is not necessary.

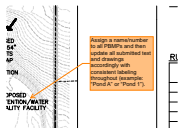

Author: Glenn Reese - EPC Stormwater  
 Subject: SW - Textbox with Arrow  
 Page Label: [1] developed  
 Date: 3/15/2023 4:18:52 PM  
 Status:  
 Color: ■  
 Layer:  
 Space:

Assign a name/number to all PBMPs and then update all submitted text and drawings accordingly with consistent labeling throughout (example: "Pond A" or "Pond 1").



**Revise to provide the spec that is referred to siting  
6ft/sec velocities for grass. Include information in  
appendix.**

**Author:** lpackman  
**Subject:** Callout  
**Page Label:** 8  
**Date:** 3/20/2023 2:26:24 PM  
**Status:**  
**Color:** ■  
**Layer:**  
**Space:**

Revise to provide the spec that is referred to siting  
6ft/sec velocities for grass. Include information in  
appendix.