


CONCRETE WALL NO. 1 DETAIL

NO SCALE


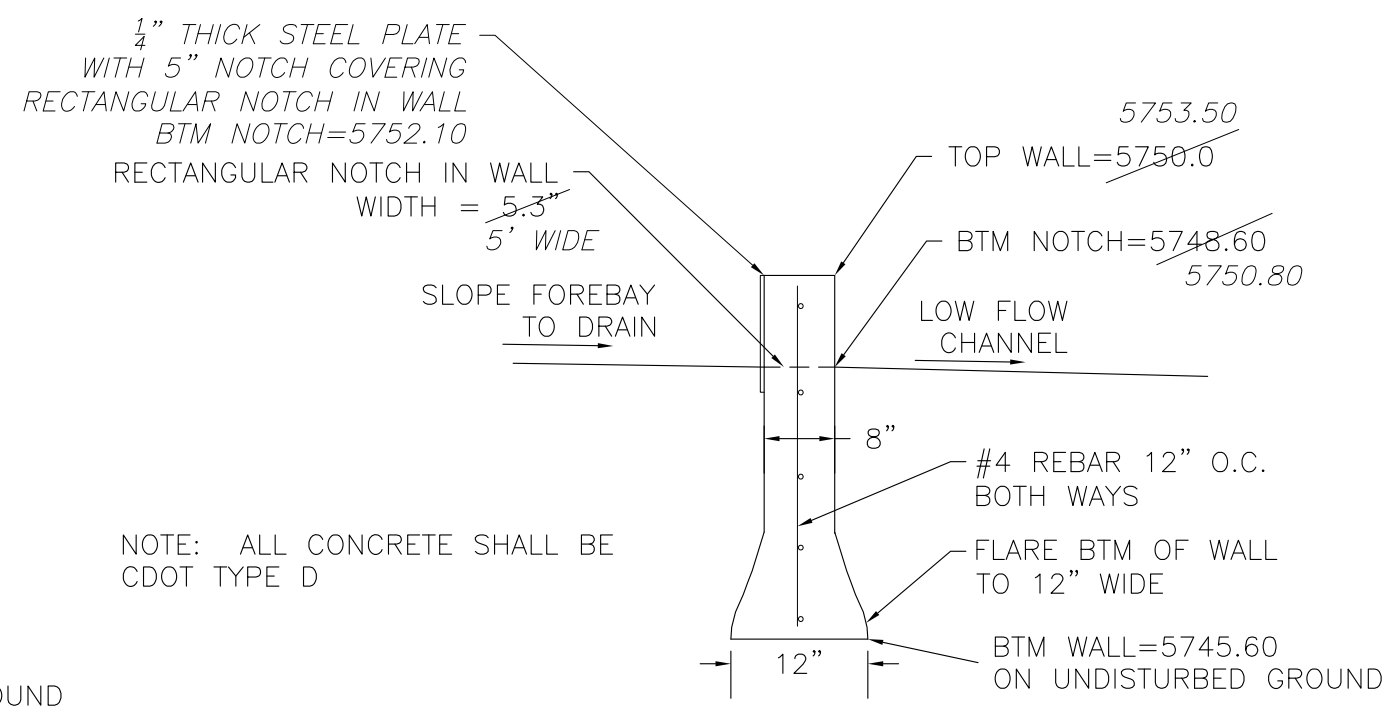


CONCRETE WALL NO. 2 DETAIL

NO SCALE

AS-BUILT NOTES:

- SEE AS-BUILT SURVEY BY LWA LAND SURVEYING FOR FOREBAY AS-BUILT CONTOURS AND LAYOUT
- FOREBAY #1: TOP=5752.90, BTM=5751.80
DESIGN VOLUME: 130cf
AS-BUILT VOLUME: 542cf
- FOREBAY #2: TOP=5753.50, BTM=5752.10
DESIGN VOLUME: 130cf
AS-BUILT VOLUME: 202cf

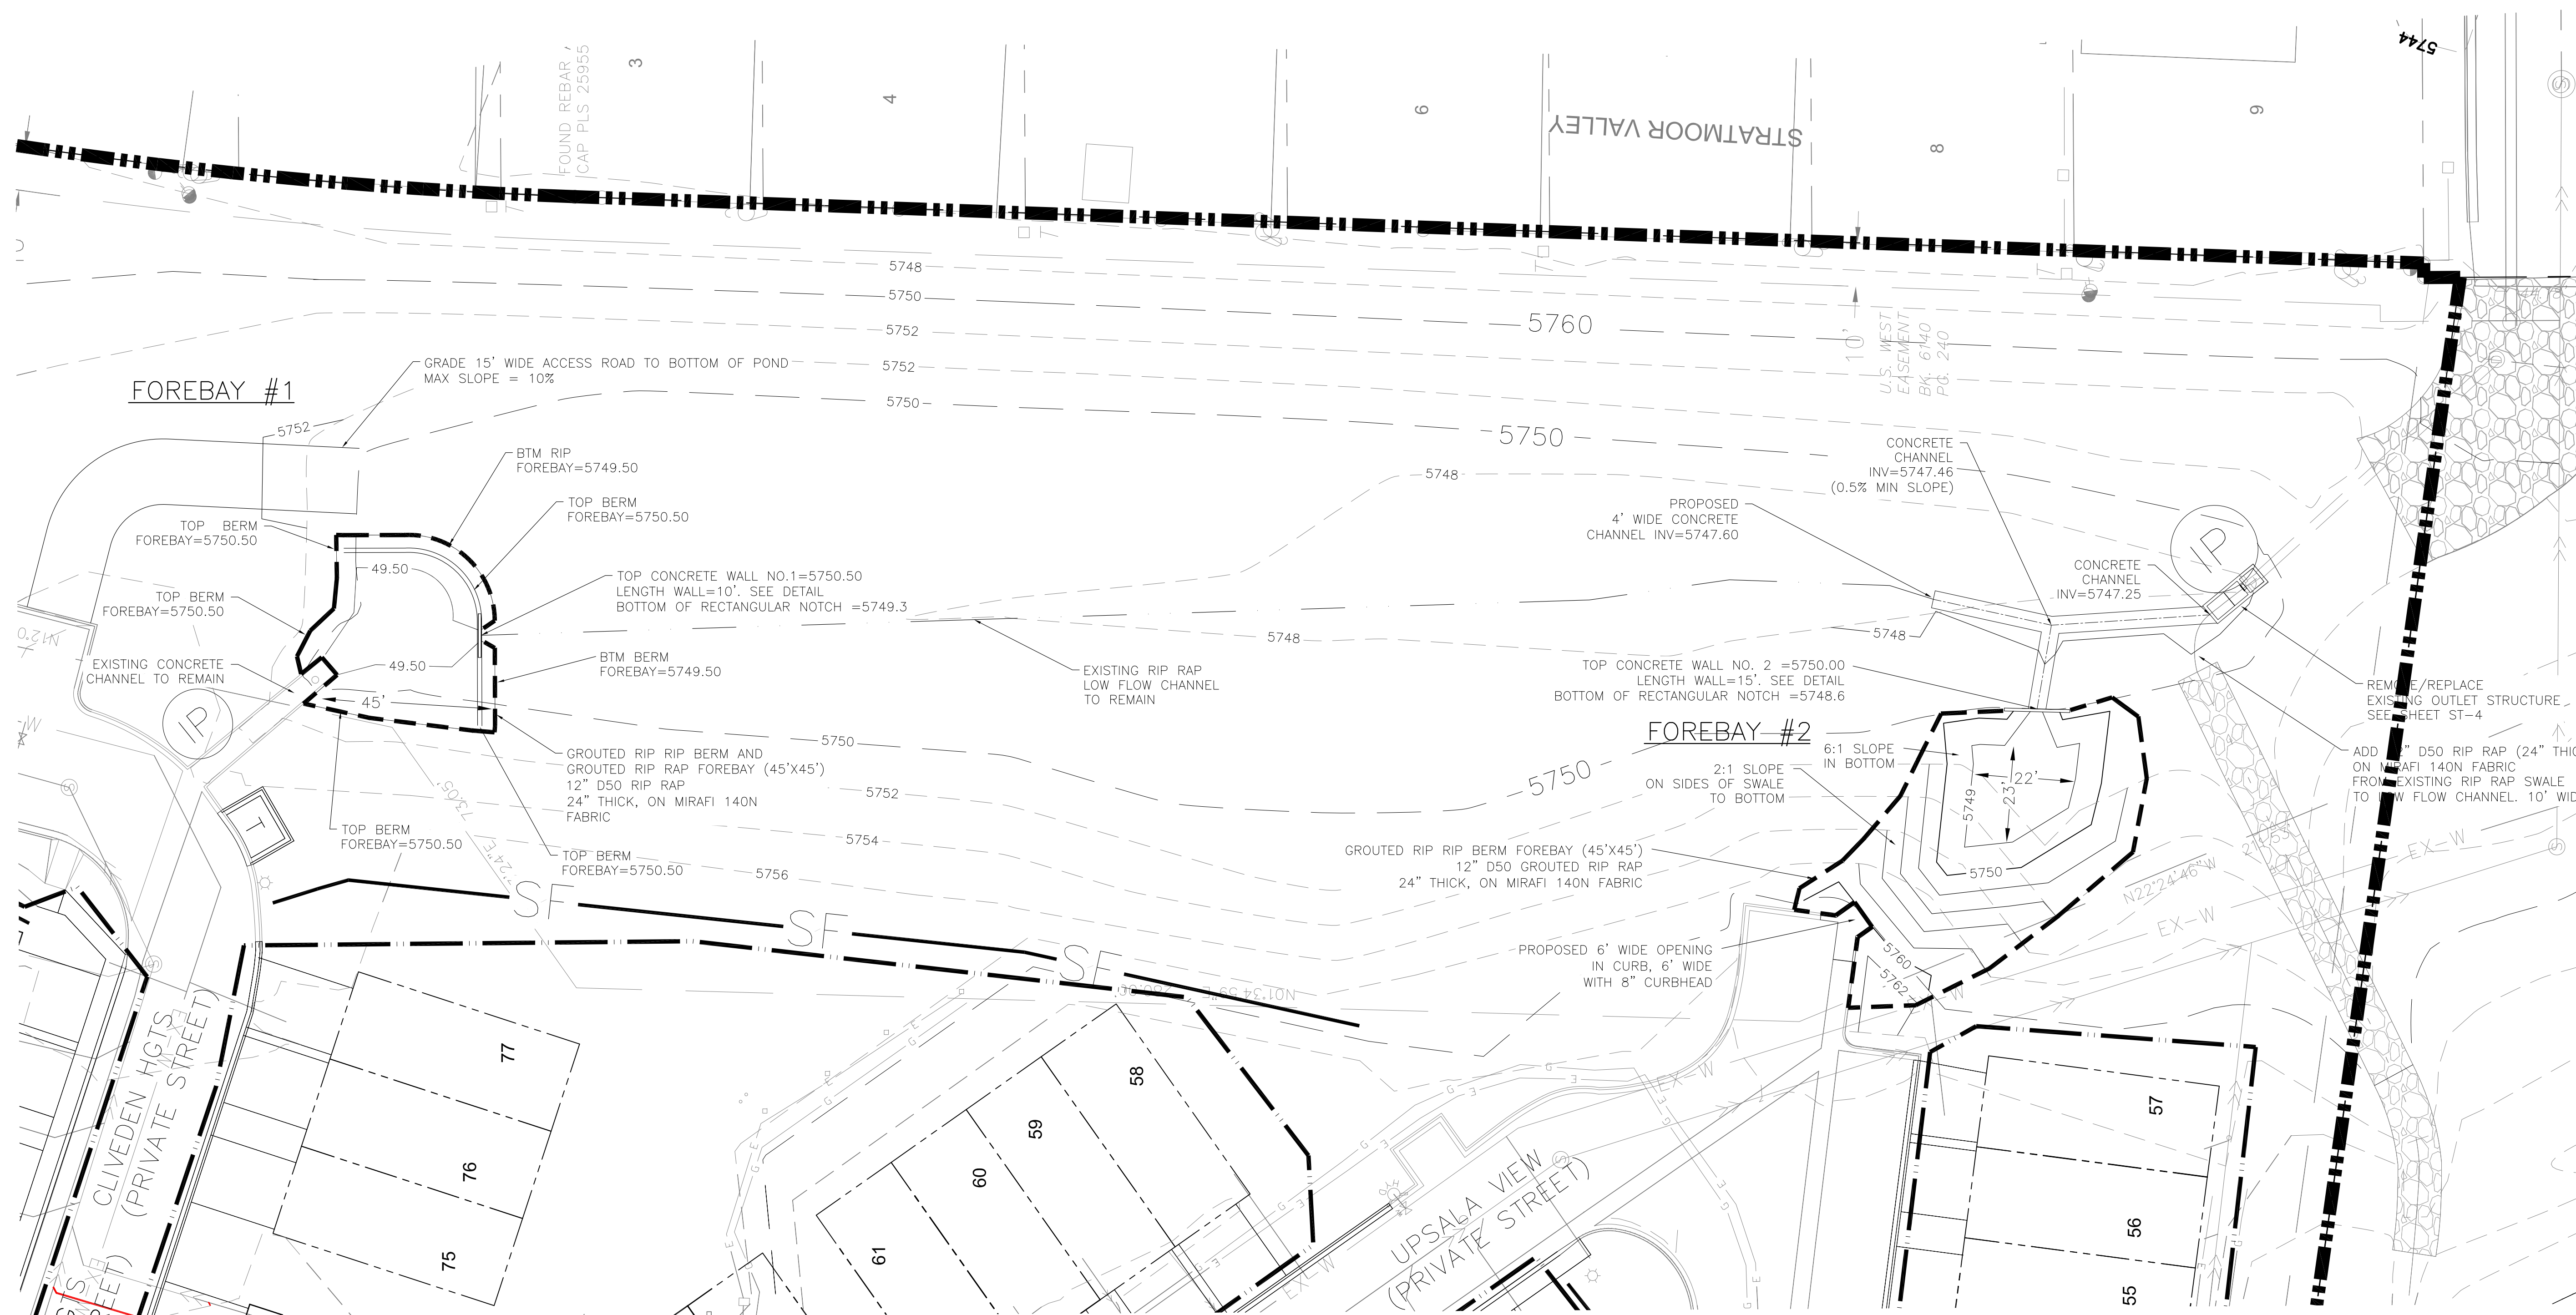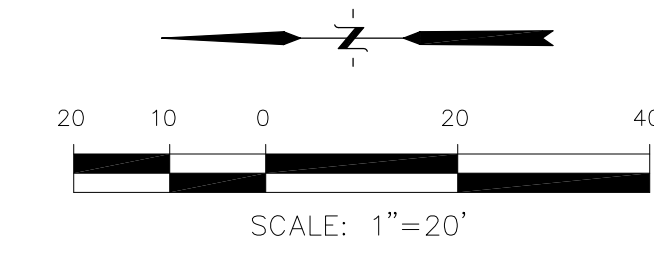

AS-BUILT
DATE: 12/14/2020

CORE ENGINEERING GROUP
15004 15TH AVE. SOUTH
BURNING WOODS, CO 80506
PHONE: 719.570.1100
CONTACT: RICHARD L. SCHINDLER, P.E.
EMAIL: Rich@ceg1.com

NO.	DESCRIPTION	DATE

PREPARED FOR:
IGD INVESTMENTS, LLC
337 E. PIKES PEAK AVENUE, SUITE 200
COLORADO SPRINGS, COLORADO 80903
(719) 635-3200
CONTACT: MATT CRADDOCK




PROJECT:
RESIDENCE AT STRATMOOR
FILING NO. 2
HARTFORD STREET/WILSHIRE DRIVE
COLORADO SPRINGS, COLORADO

DRAWN: DLM
DESIGNED: RLS
CHECKED: RLS

DETENTION POND MODIFICATIONS

DATE	APRIL 22, 2016
PROJECT NO.	311.006
SHEET NUMBER	ST-3
TOTAL SHEETS:	6

- ⊙ SANITARY SEWER MANHOLE
- SS C.O. SANITARY SEWER CLEANOUT
- ⊕ FIRE HYDRANT
- ⊕ WATER VALVE
- ⊙ STORM SEWER MANHOLE
- EL. SERV. * ELECTRIC SERVICE
- CATV □ CABLE TELEVISION RISER
- PH. RSR □ TELECOMMUNICATIONS RISER

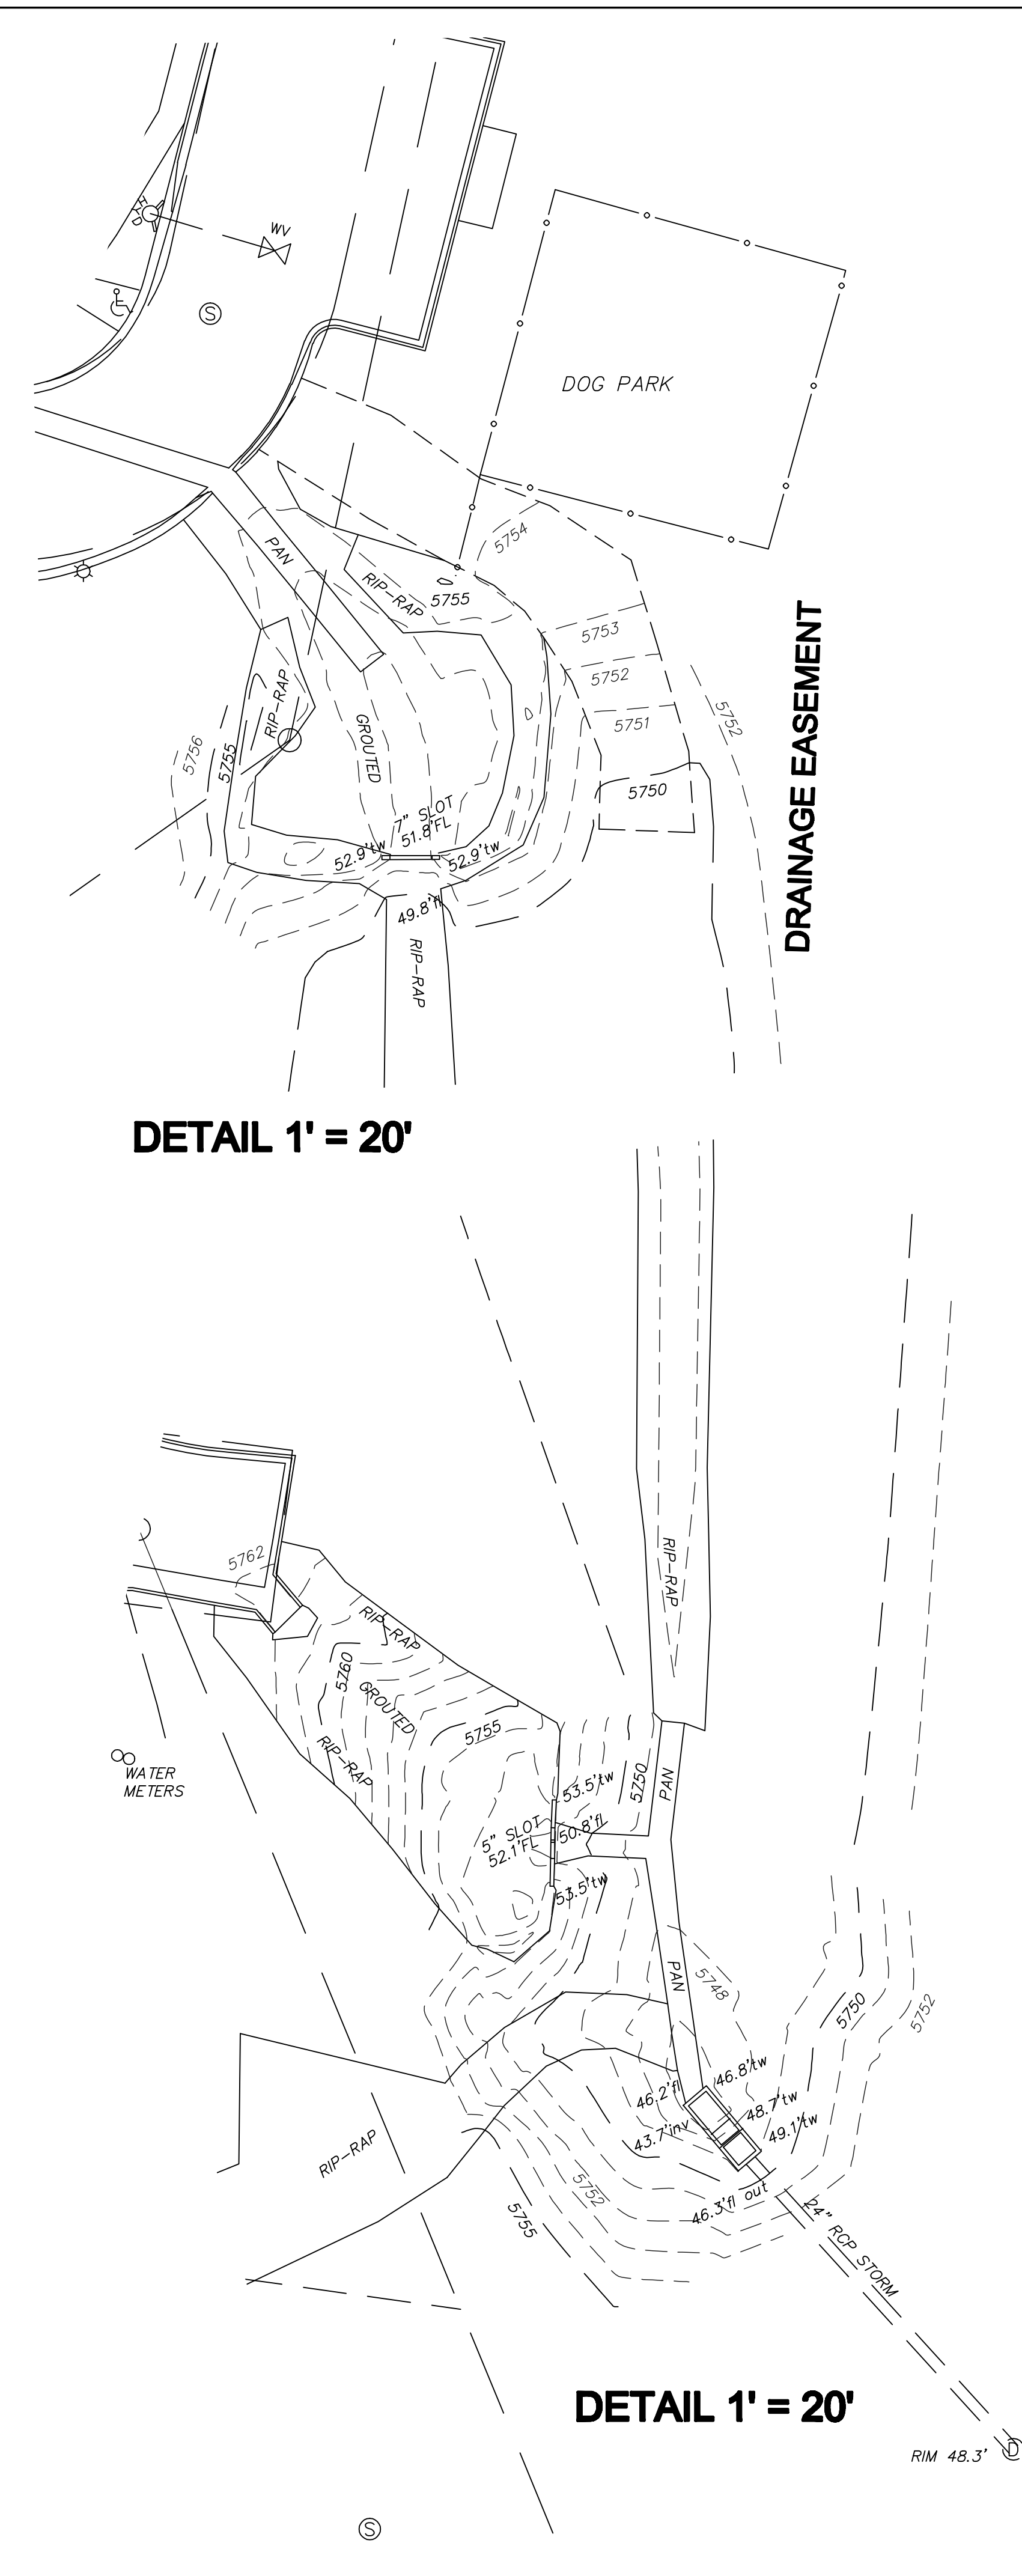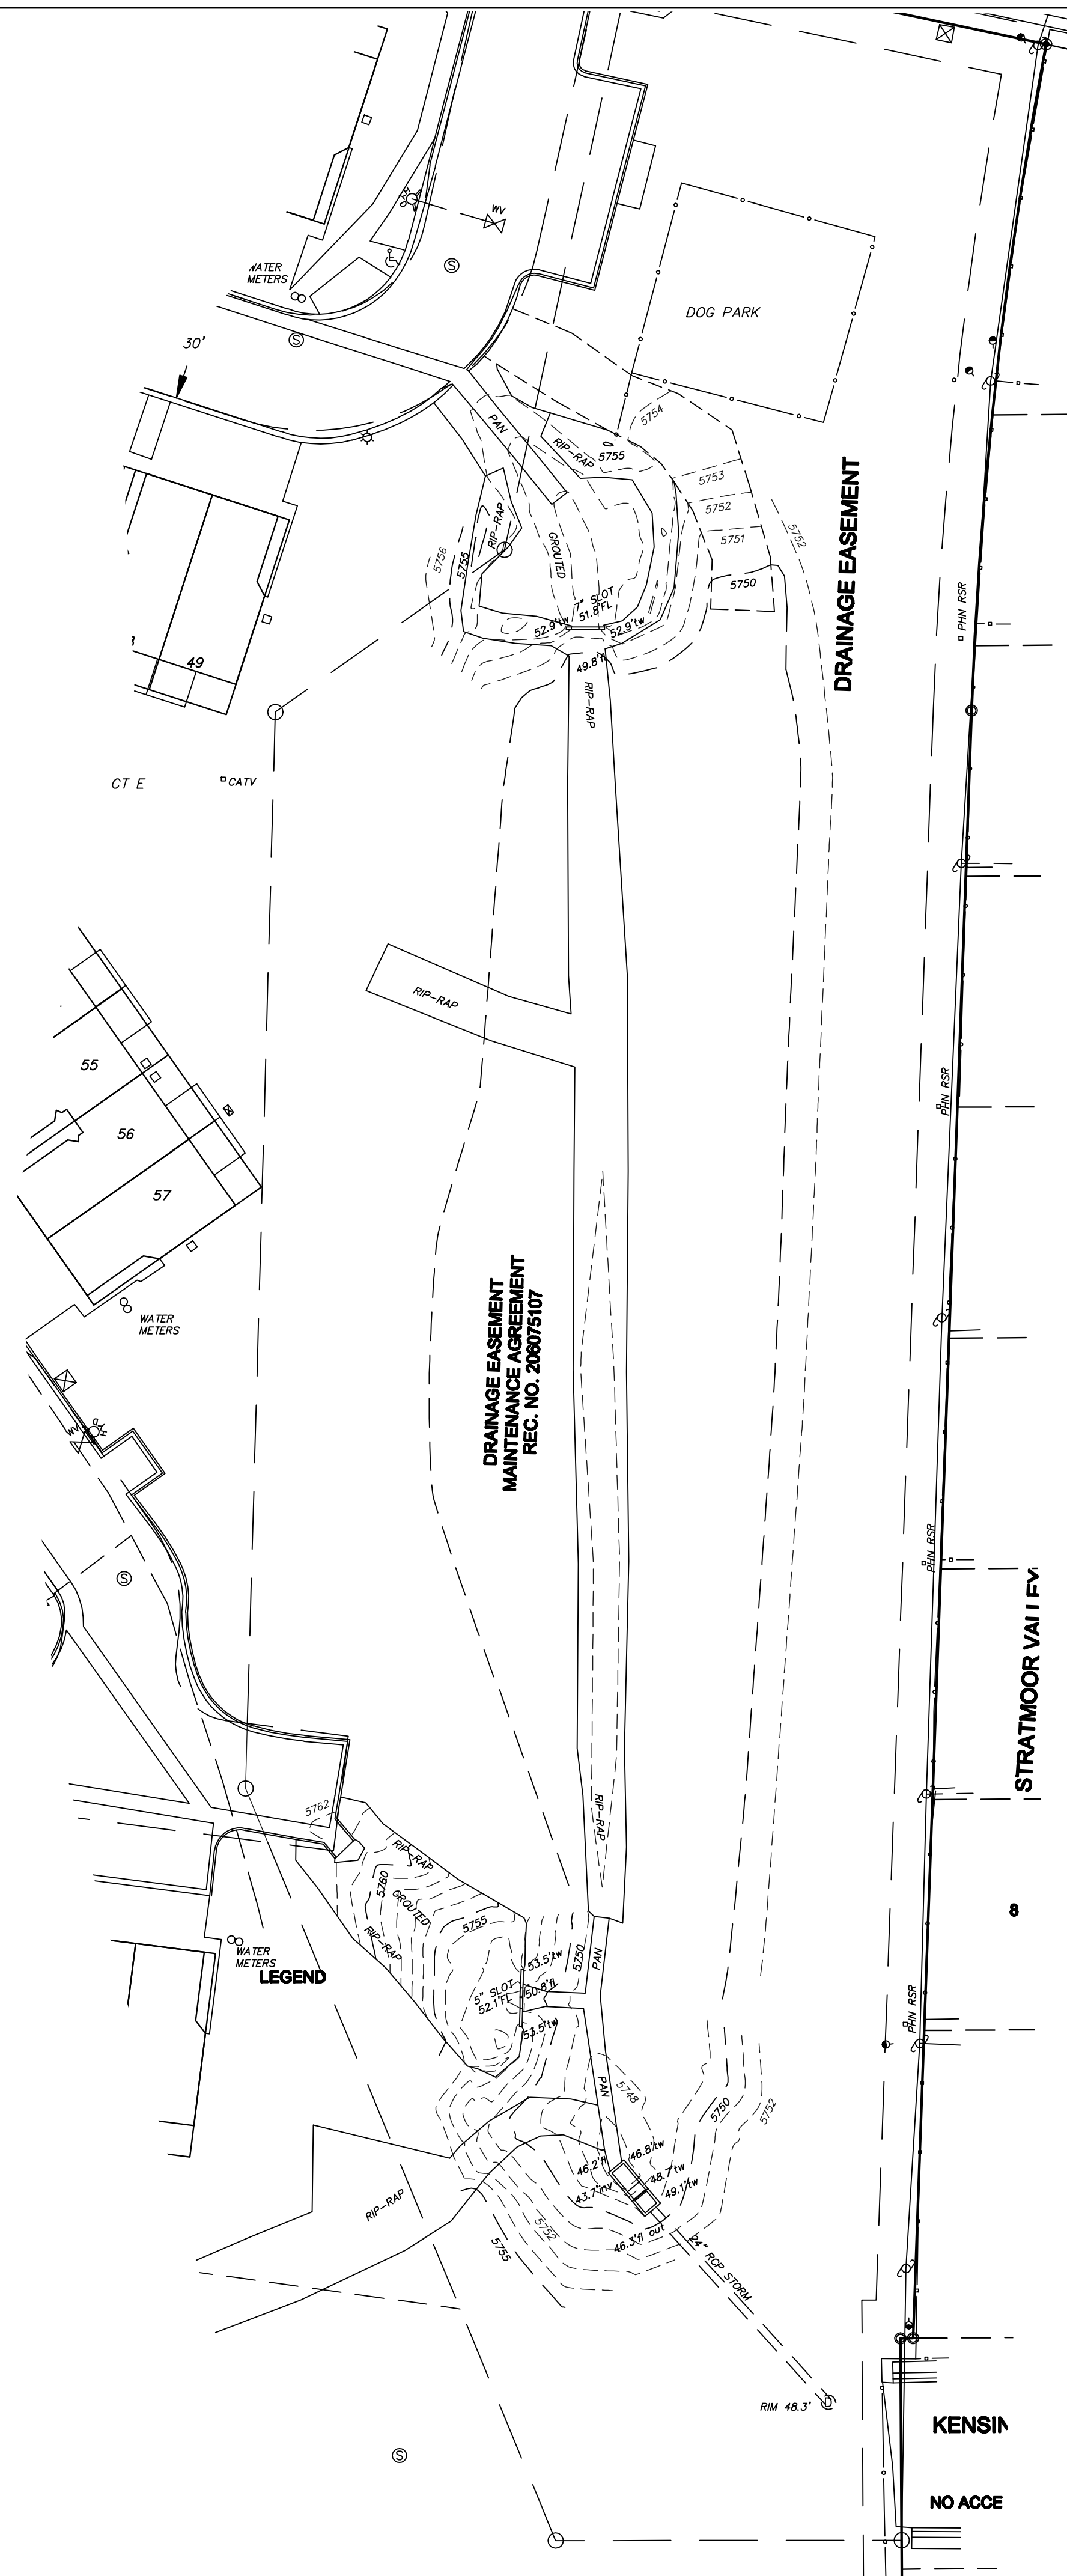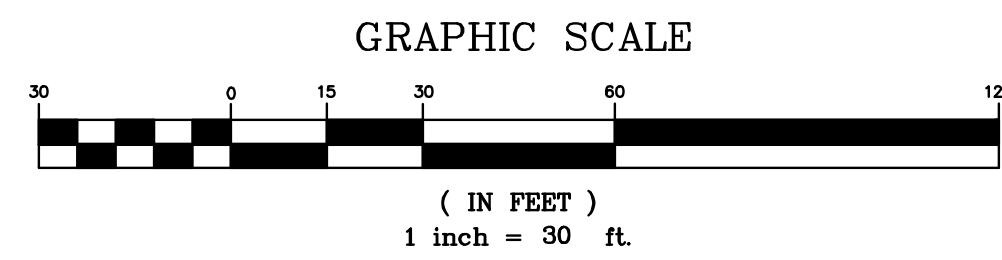

PROPERTY DESCRIPTION:

THE RESIDENCE AT STRATMOOR TOWNHOMES FILING NO. 2, EL. PASO COUNTY, COLORADO, ACCORDING TO THE SUBDIVISION PLAT THEREOF RECORDED AT RECEPTION NO. 216713814 OF THE EL. PASO COUNTY RECORDS.

PLATTED EASEMENTS ARE SHOWN. THIS SURVEY DOES NOT REPRESENT A TITLE SEARCH BY LWA LAND SURVEYING, INC.

THE BASIS OF BEARINGS FOR THIS SURVEY IS THE WESTERLY LINE OF TRACT A, N47°08'11"W - 1040.90'. THE DIRECTION IS BASED ON THE RECORDED PLAT AND THE LINE IS MONUMENTED AS SHOWN.

UNITS OF MEASURE ARE U.S. SURVEY FEET.

VERTICAL DATUM IS BASED ON THE SANITARY SEWER MANHOLE AT THE INTERSECTION OF WILSHIRE DRIVE AND HARTFORD ROAD. THE ELEVATION, 5773.41 IS BASED ON THE ORIGINAL DESIGN FOR THIS PROJECT. (IT APPEARS THE DATUM IS BASED ON THE CSDU FIMS NETWORK, HOWEVER, THIS WAS NOT VERIFIED.)

CONTOUR INTERVAL IS ONE FOOT

SPOT ELEVATIONS SHOWN ARE FLOWLINE OF EITHER THE CURB OR PAN, EXCEPT AS NOTED.

THE LOCATIONS OF EXISTING UNDERGROUND UTILITIES ARE SHOWN IN AN APPROXIMATE WAY ONLY AND HAVE NOT BEEN INDEPENDENTLY VERIFIED. THE OWNER OR ITS REPRESENTATIVE SHOULD DETERMINE THE EXACT LOCATION OF ALL EXISTING UTILITIES BEFORE COMMENCING WORK.





NOTICE: ACCORDING TO COLORADO LAW YOU MUST COMMENCE ANY LEGAL ACTION BASED UPON ANY DEFECT IN THIS SURVEY WITHIN THREE YEARS AFTER YOU FIRST DISCOVER SUCH DEFECT. IN NO EVENT MAY ANY ACTION BASED UPON ANY DEFECT IN THIS SURVEY BE COMMENCED MORE THAN TEN YEARS FROM THE DATE OF THE CERTIFICATION SHOWN HEREON.

REVISIONS:
12-11-20


LWA LAND SURVEYING, INC.
953 EAST FILLMORE STREET
COLORADO SPRINGS, CO 80907
TELEPHONE (719) 636-5179 FAX (719) 636-5199

DWG: STRATMOOR
SCALE: 1"=30'
DATE: 12/10/2020
DRAWN BY: KMO/THK
CHECKED BY: THK/KMO
PROJECT NO. 15111



AS-BUILT TOPOGRAPHIC SURVEY
NEW STORMWATER FACILITIES
THE RESIDENCE AT STRATMOOR
TOWNHOMES FILING NO. 2

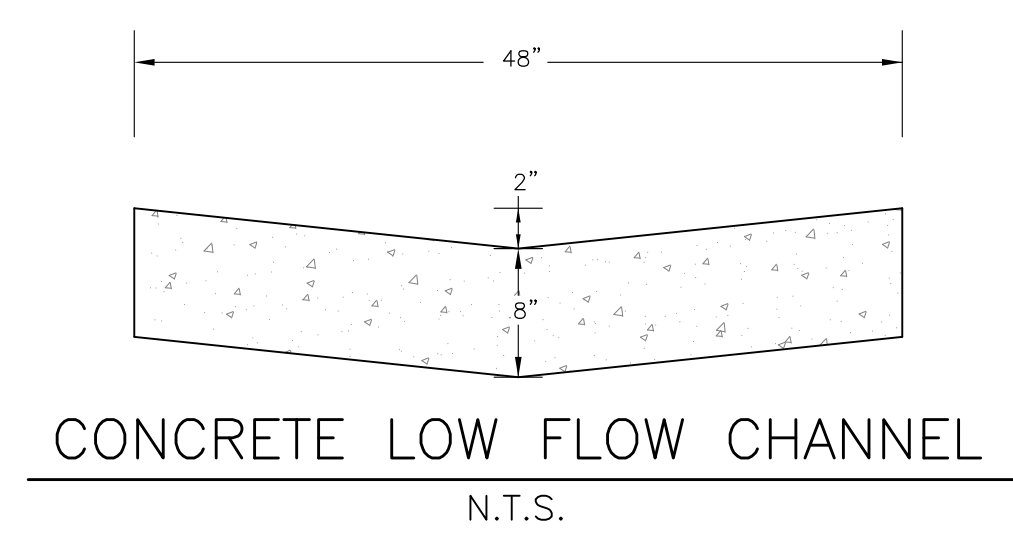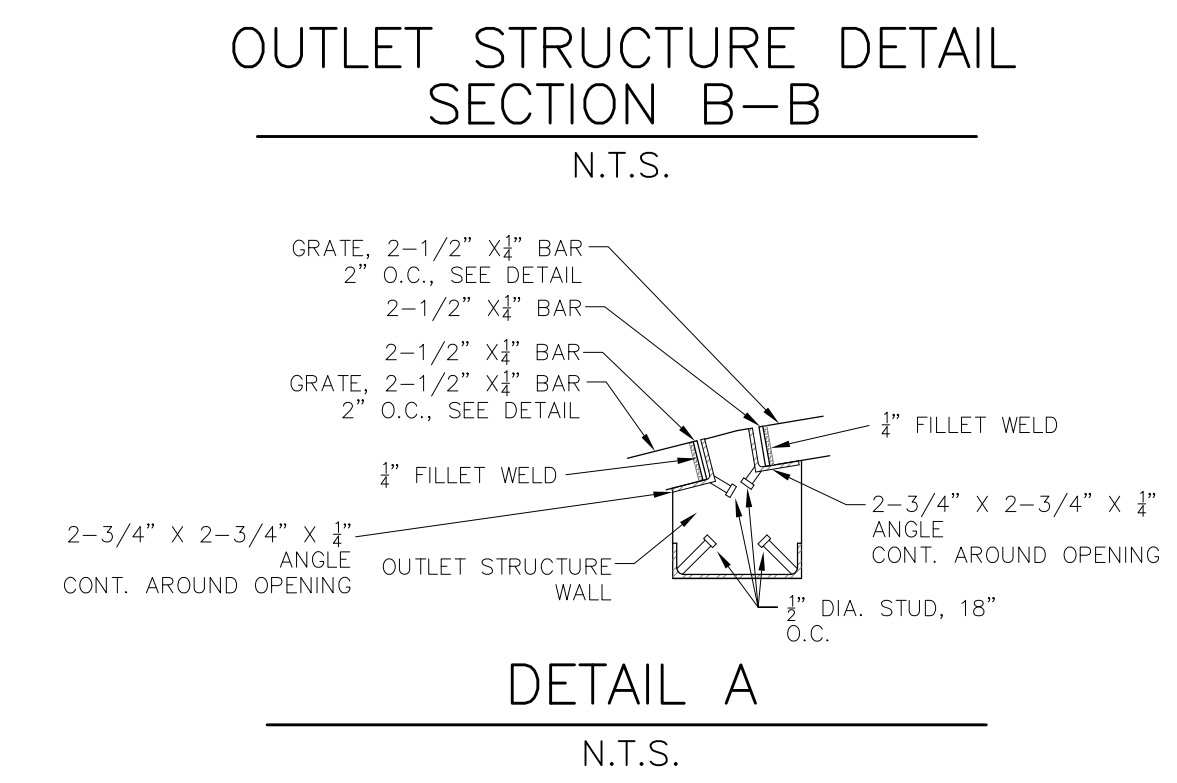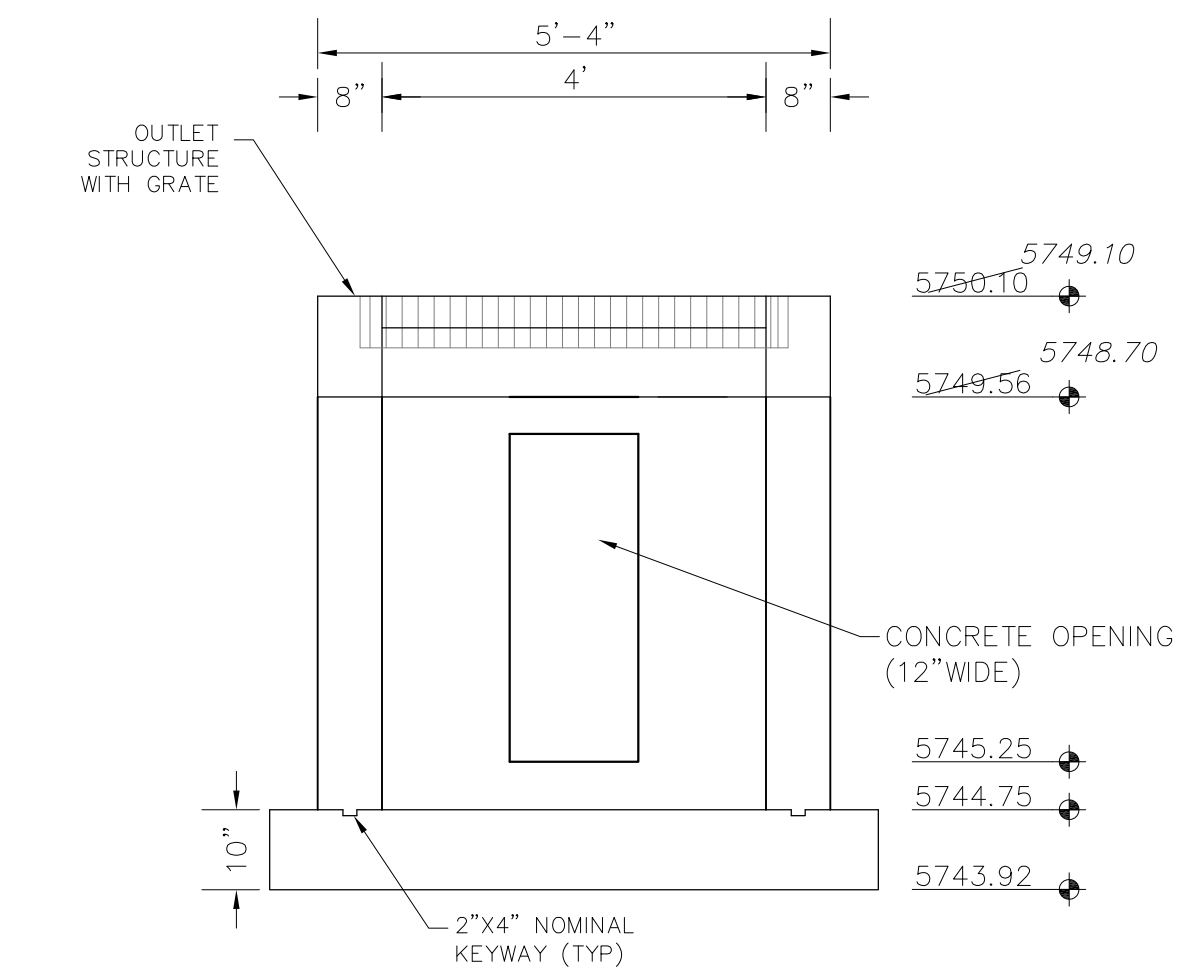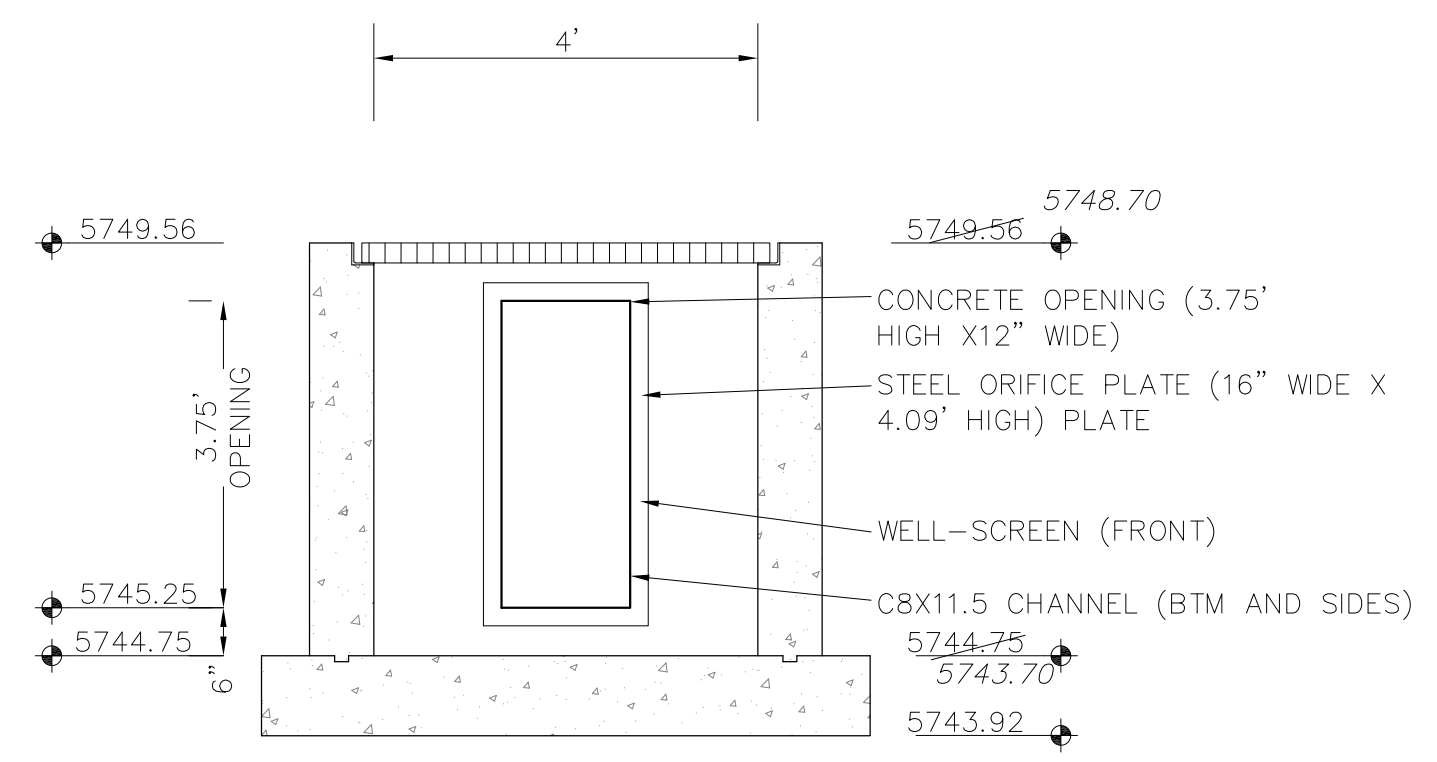



- OUTLET STRUCTURE, FOREBAY AND DRAIN CHANNEL NOTES:
- Prior to construction, Contractor shall provide Shop Drawings for all components of the outlet structure.
 - Grade 60 reinforcing steel required. See table for the minimum lap splice length for reinforcing bars. All reinforcing steel shall have a two-inch minimum clearance from edge of concrete, unless otherwise noted.
 - Concrete for the outlet structure and forebay shall be CDOT Class D concrete.
 - Concrete for drain channels shall be CDOT Class B concrete
 - Expansion joint material shall meet AASHTO Specification M-213. Expansion joint material shall be 1/2" thick, shall extend the full depth of contact surface and the joint shall be sealed, refer to details
 - All exposed concrete corners shall have 3/4" chamfer unless otherwise noted
 - Subgrade to be 12" thick clean fill compacted to 95% Standard Proctor Density per ASTM M698 under structure
 - Refer to Sheet 16 for Presedimentation Basin/ Forebay design
 - Engineer shall be notified prior to beginning construction of outlet structure to schedule observation visits for structures.
- | Bar Size | #4 | #5 | #6 |
|--------------------|-------|-------|-------|
| Min. Splice Length | 1'-3" | 1'-7" | 2'-0" |

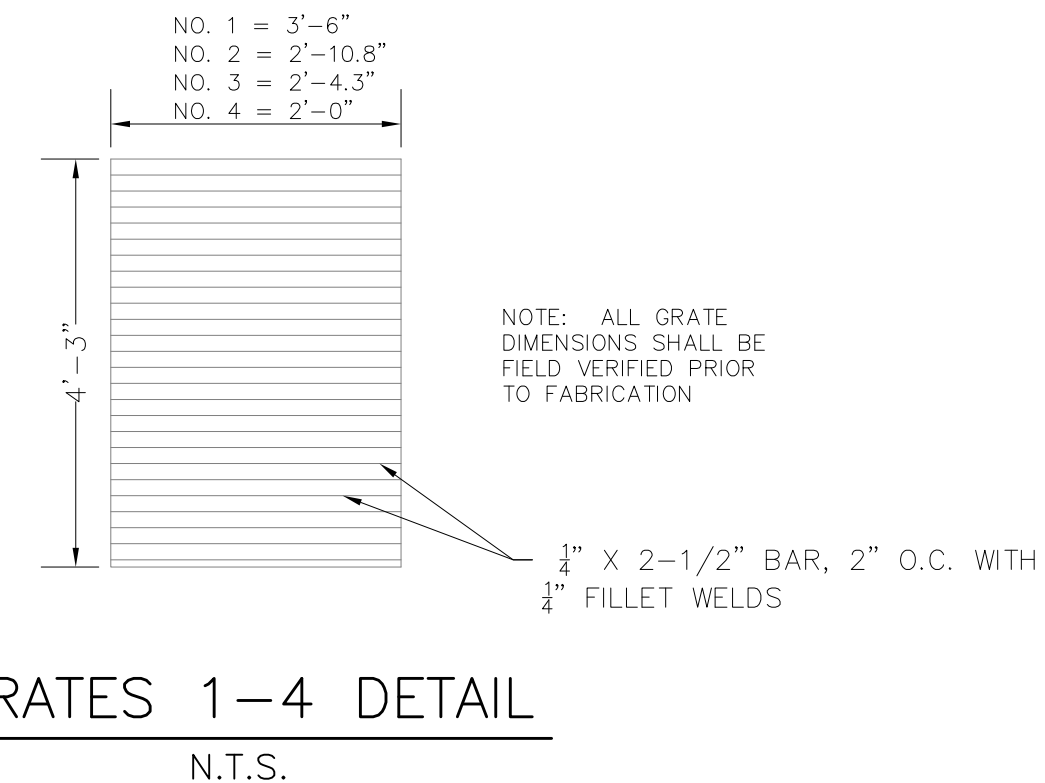

- WQCV WELL-SCREEN NOTES:
- Well-Screen shall be stainless steel and attached by intermittent welds or stainless steel bolts along edge of the mounting frame.
 - WQCV Well Screen
 - Type of Screen: Stainless steel #93 Vee Wire (Johnson Vee Wire (tm) Stainless Steel Screen or equivalent with 60% open area)
 - Screen slot opening dimension: 0.139" (Screen #93 Vee Wire Slot Opening)
 - Type and Size of Support Rod: TE 0.074"x0.50"
 - Spacing of Support Rod (O.C.): 1.0 Inch
 - Total Screen Thickness: 0.655"
 - Carbon Steel Holding Frame Type: 3/4" x 1.0" angle

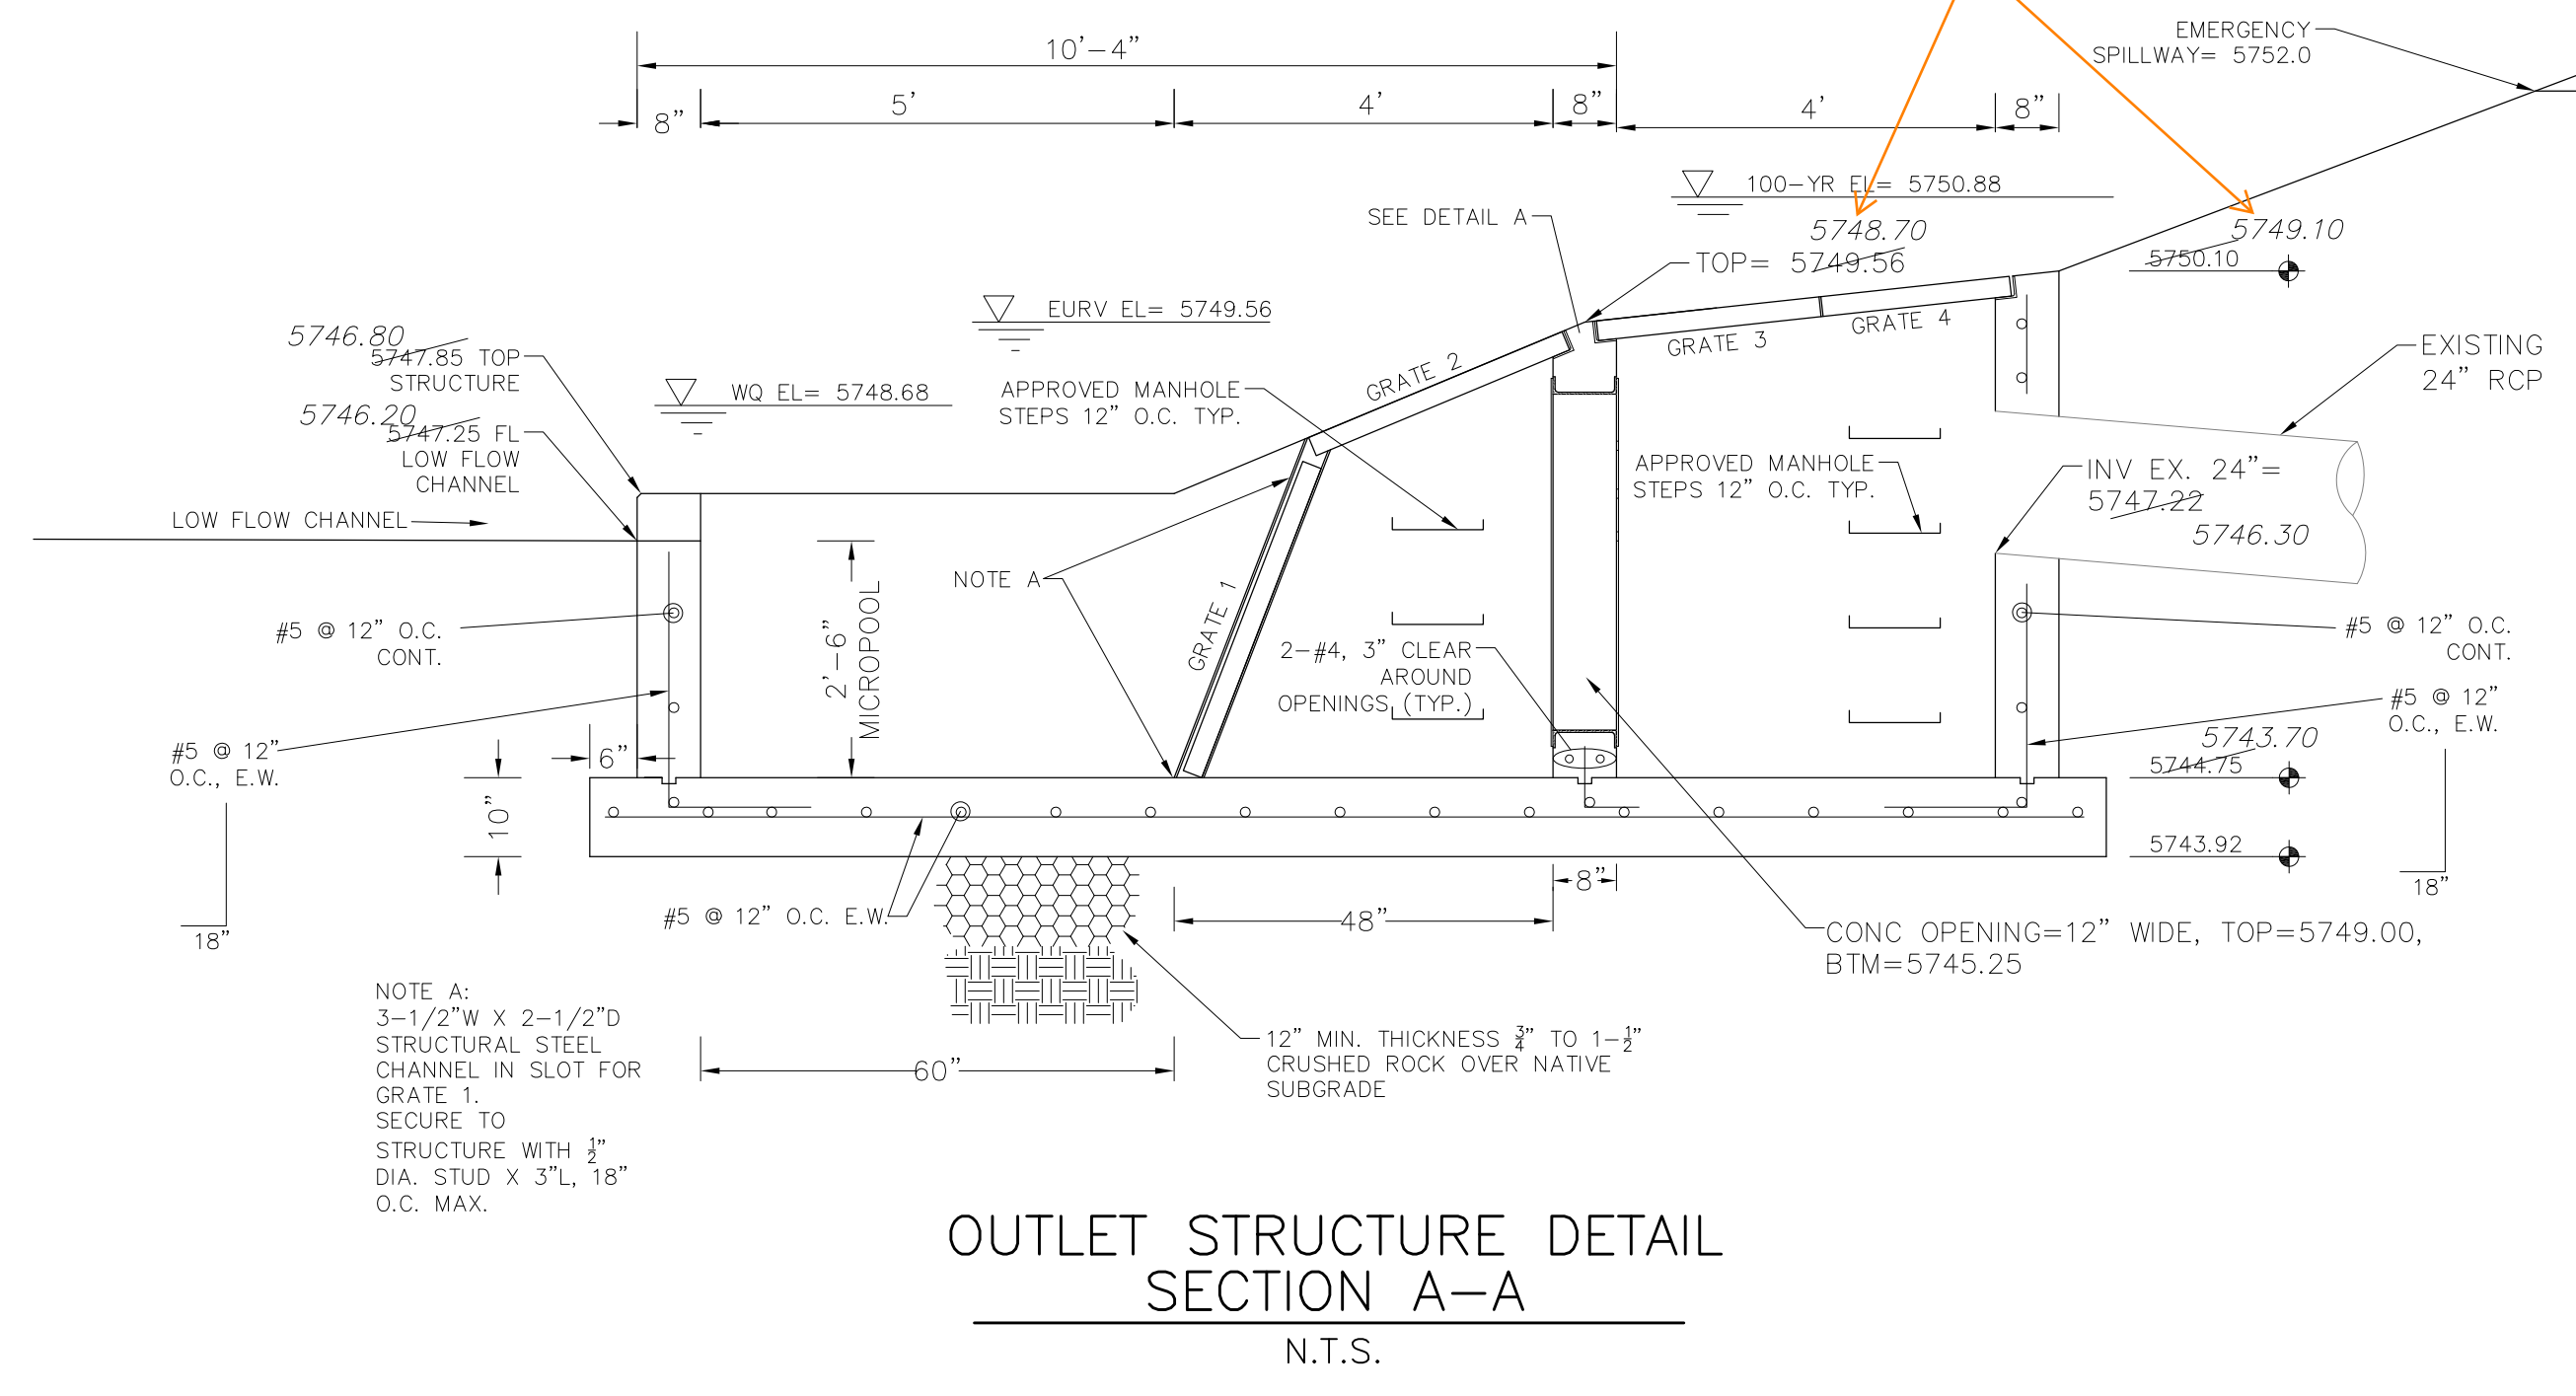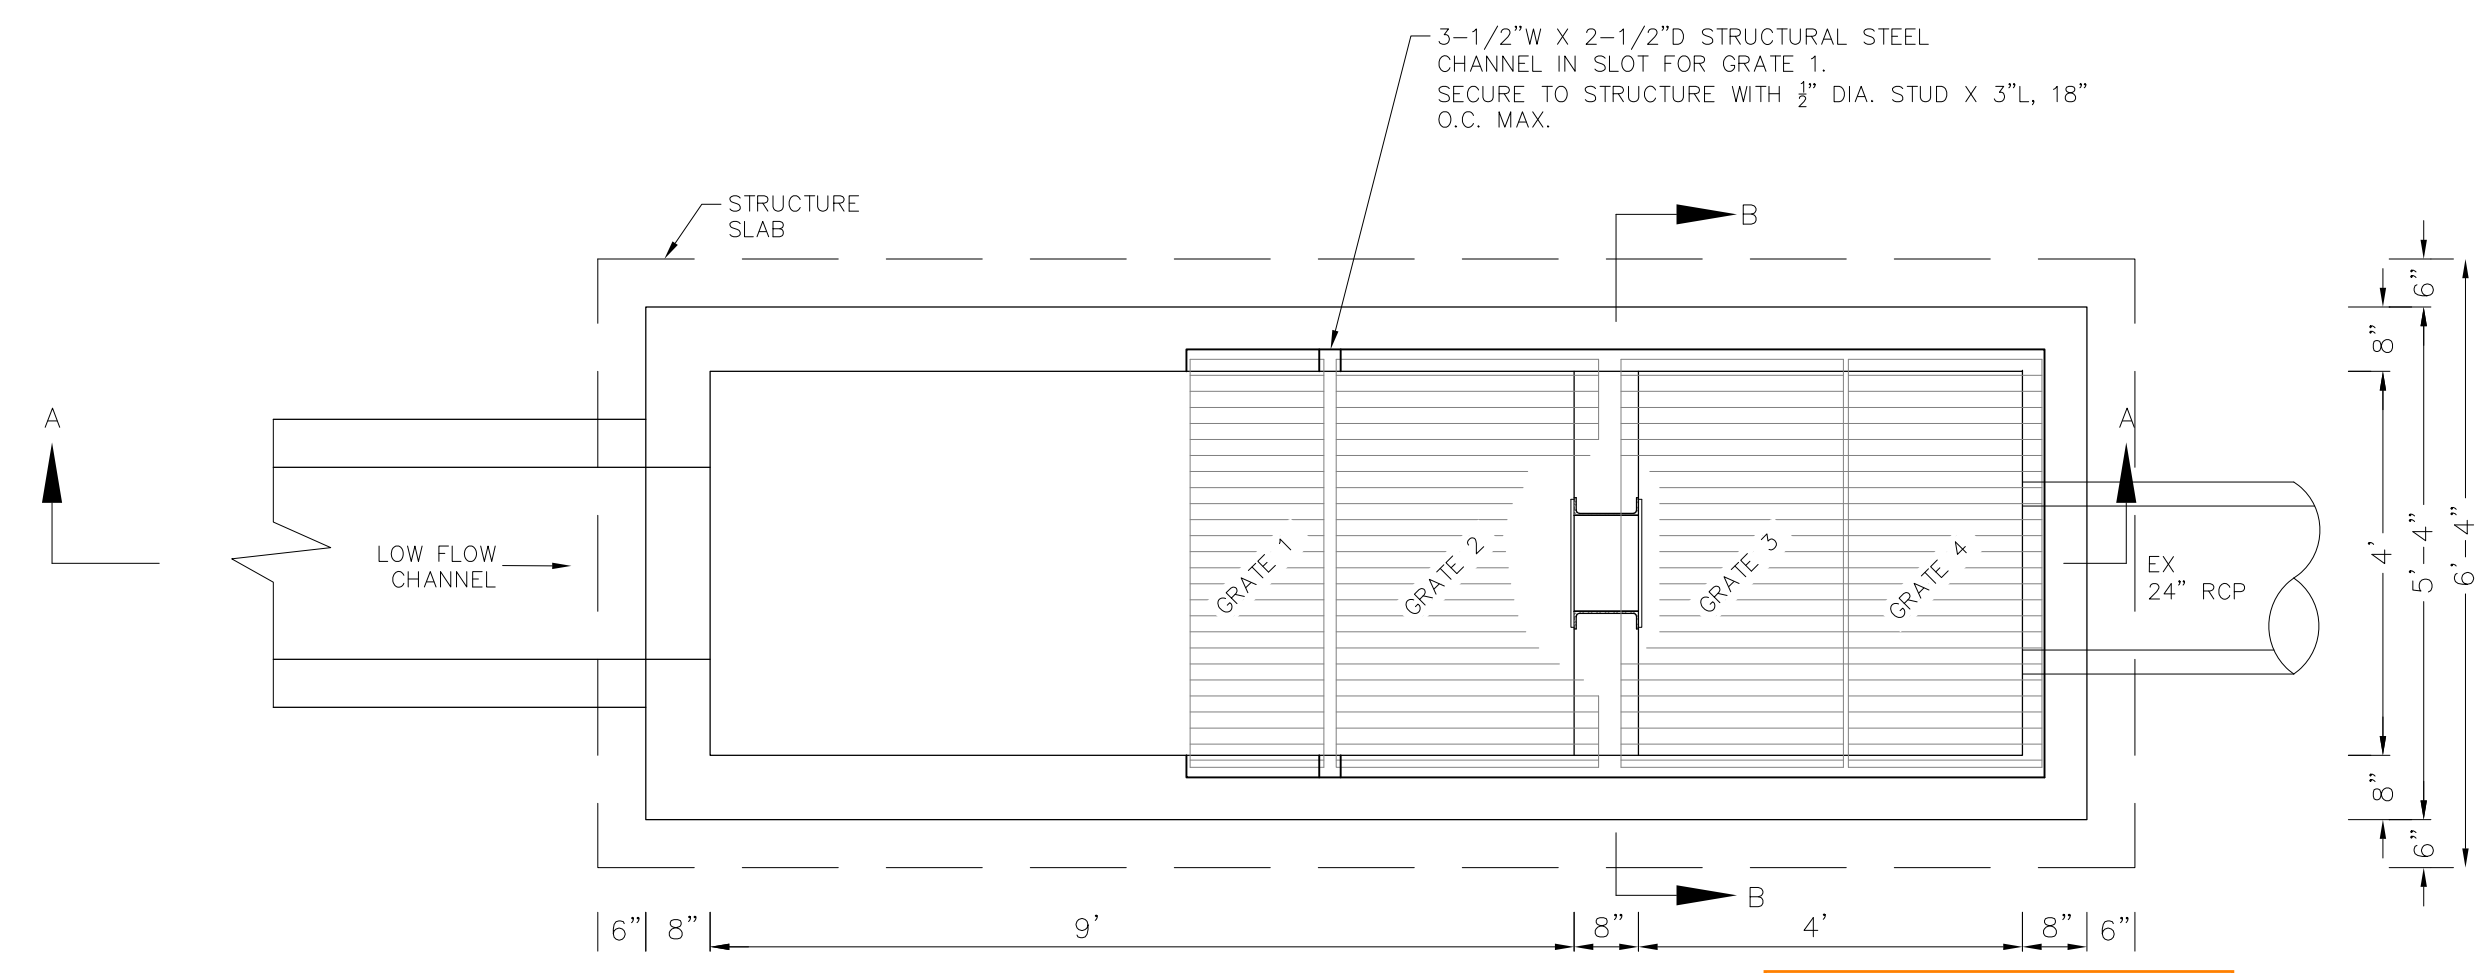

Since this grate is ~1ft lower than designed we'll need to see revised MHFD-Detention calcs that reflect these as-built conditions to see the change of the drain time and release flows compared to the original design inputs.

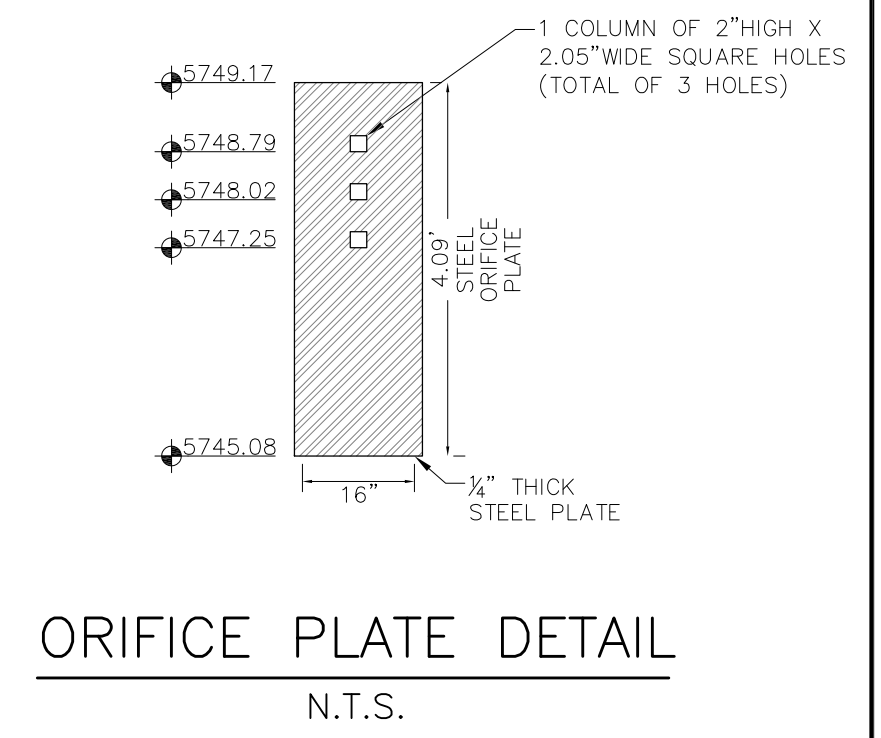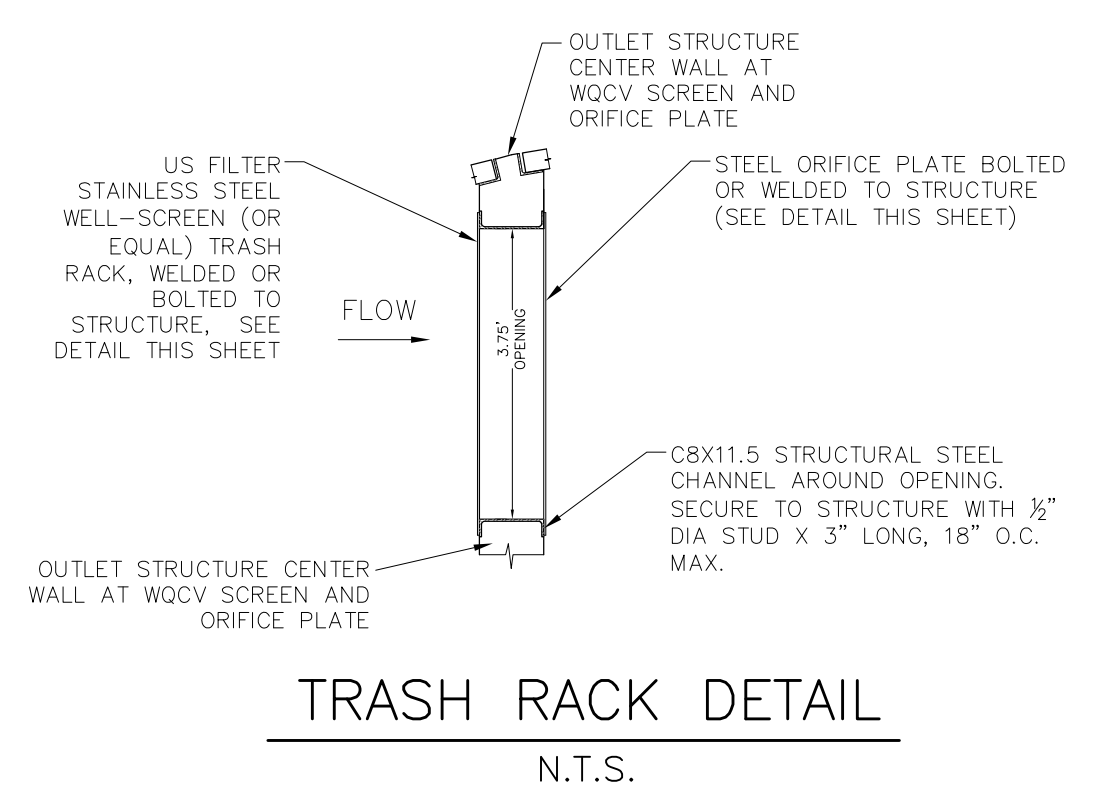

SEAL ALL EDGES OF PLATE TO CONCRETE OUTLET STRUCTURE W/ SILICONE CAULK BEAD

AS-BUILT
 DATE: 12/14/2020