

The logo for Super Star Car Wash features a large yellow five-pointed star with a blue outline, positioned above the words "SUPER STAR" in a bold, white, sans-serif font. Below "SUPER STAR" are the words "CAR WASH" in a larger, bold, white, sans-serif font. The entire text is set against a dark blue, stylized background that resembles a car wash sign with a drop shadow effect.

SUPER STAR CAR WASH

Meadowbrook Parkway, Colorado Springs, CO 80915

5 YEAR
WARRANTY
ALL PARTS, LABOR
& SIGNAGE

 **Signdealz**.com
GREAT SIGNS AT GREAT PRICES

30' Pylon Sign: Double Sided

SIGN A3



Top Cabinet: 60" x 120" = 50 SQ FT
LED Display: 60" x 120" = 50 SQ FT
100 SQ FT Total

Fabrication Specs

4" Fabricated aluminum top cap painted PMS 116 C Yellow

Main ID sign cabinet to be 36" deep fabricated .125" aluminum, faces & returns painted white

Super Star Car Wash logo: BL 48

3/16" white acrylic faces with vinyl applied

3M European Blue 3630-137 #

3M Yellow 3630-015 #

2" aluminum retainer, painted Pantone 2757 C Blue #

5" deep .063" aluminum returns, painted Pantone 2757 C Blue #

3mm ACM or .125" aluminum backs

Internally illuminated with white LEDs

LED Display: Double sided full color RGB - 16MM

Cabinet size: 65" x 123"

Visual area: 60" x 10"

.125" Aluminum filler between displays painted black

3.5" Fabricated aluminum accent reveal painted PMS 116 C Yellow

(x2) 4" Fabricated aluminum accents painted PMS 116 C Yellow

Base skirt to be fabricated .125" aluminum faces & filler painted PMS 2757 C blue



Electrical: Include Photocell, GC to make electrical connection

ID Cabinet Load: 2A at 120V, Power requirement: 120V / 20A dedicated circuit

LED Display, 10mm: 60A at 120V, Dedicated electrical service required

Support: 12" x 12" x .375 square tube steel (will stop at approx 28' above grade)

Foundation: 4'-0" dia x 12'-0" deep caisson concrete pier

Scale: 1/4" = 1'



Signdealz
 1644 Platte Street
 Denver, CO 80202

1-800-405-0686

CUSTOMER NAME:	Super Star Car Wash	
PROJECT NAME:	Exterior Signage	
LOCATION:	Meadowbrook Parkway Colorado Springs, CO 80915	
OPPORTUNITY / P.O. NO (#):	OP-SS-007036	SALES: Steve Scovill
DATE:	7/11/2023	

DESIGNER
 TH
PAGE 2

APPROVAL:


Customer Signature (legible)

(X)

Approval Date:

5 YEAR WARRANTY
ALL PARTS, LABOR & SIGNAGE


Site Plan: 30' Pylon Sign

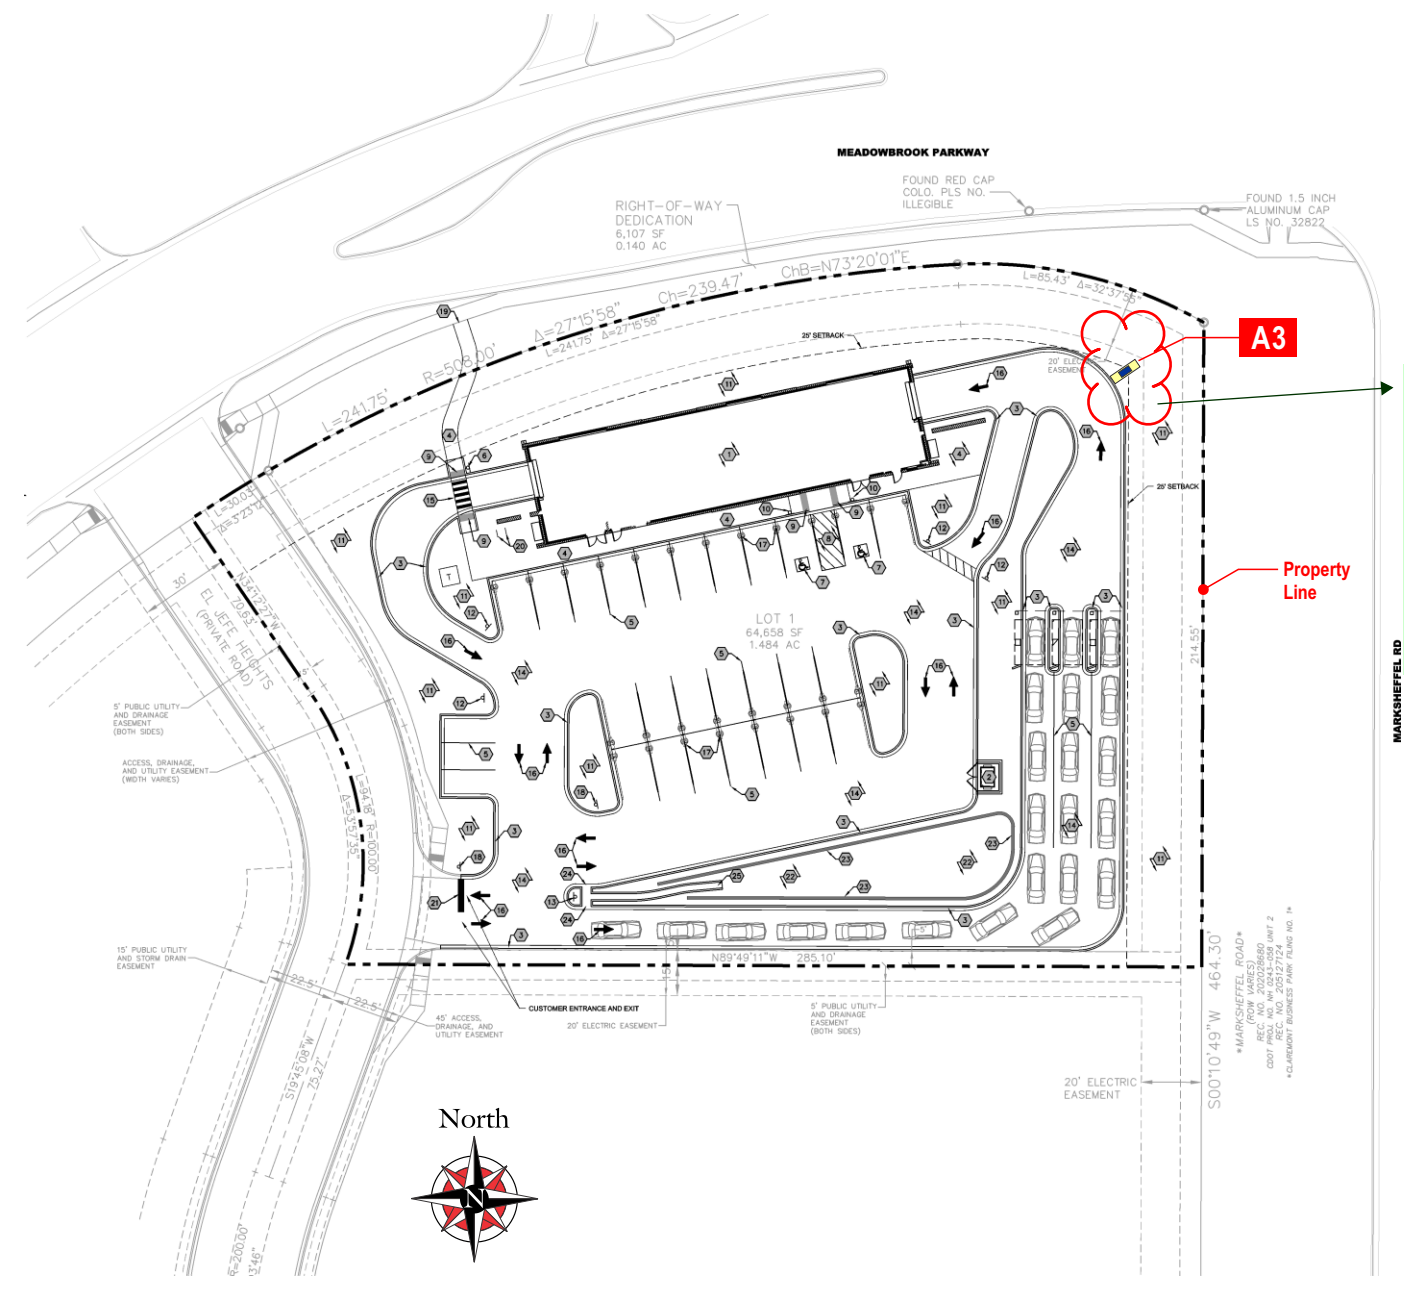

Scale: 1/64" = 1'

If this is encroaching within the 25 ft setback another process is required.

Please verify how much it is encroaching.

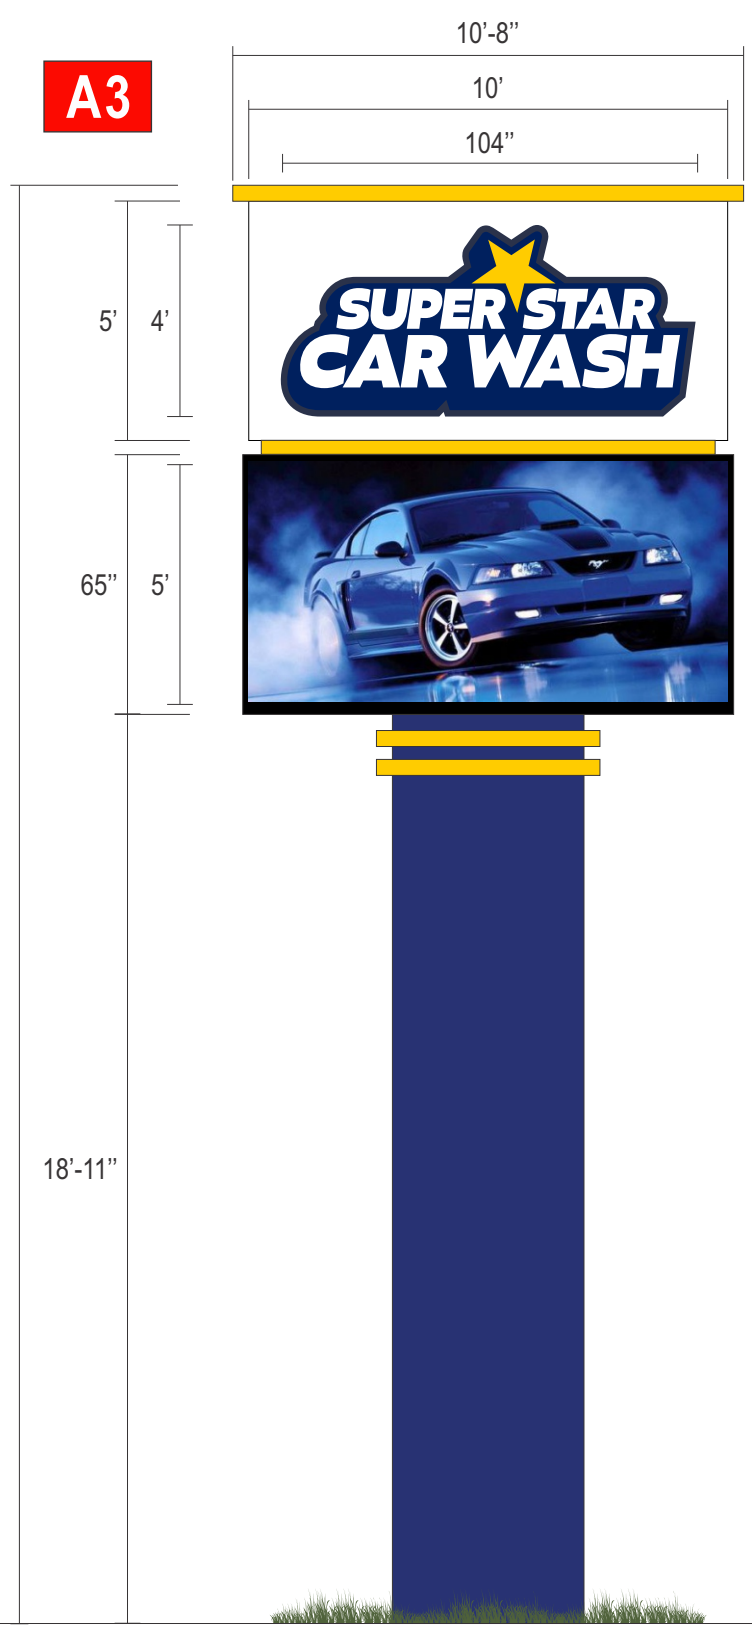

Signs installed over any easements require approval in writing by the entity or entities having jurisdiction over the easement

Site Plan: 30' Pylon Sign

Code summary: Freestanding signs:

Number of Freestanding Signs = Commercial Lot or Parcel Less than 10 Acres in Area
1 sign is allowed per road frontage.

Area of Freestanding Signs = Commercial Lot or Parcel Less than 8 Acres in Area
the maximum area of each sign shall be 40 square feet.

LED display: Submit proposal for review

Variation in Size of Sign.

Allowable Freestanding Sign Area Not Associated with a Building: The maximum freestanding sign area shall be 40 square feet where no building is present.

Reduction in Freestanding Sign Area: When an attached sign and/or flag and freestanding sign are located along the same building wall, the total allowable area of the freestanding sign shall, when combined with the area of attached signs and/or flag, not exceed the maximum size allowed under the General Freestanding Section above.

Increase in Freestanding Sign Area Along Arterial: When a freestanding sign is located along an arterial or expressway identified in the MTCP, the allowable freestanding sign area shall be 125% of the sign area otherwise allowed by this Code. The 25% increase shall be added after determining the maximum sign area allowed by this Code.

Increase in Freestanding Sign Address Provision: If freestanding sign copy includes an address, up to 20 square feet of the area of the sign devoted to the address will not count against the allowable sign area.

Increase in Freestanding Sign Area Associated with Drive-Thru. 2 additional signs up to 32 square feet in size each and no more than 7 feet in height are permitted in association with a commercial drive-thru.

Location of Freestanding Signs.

Low Profile Signs may be located in a setback area, but shall be located no closer than 3 feet from a lot, parcel, or tract line.

All other freestanding signs exceeding 6 feet in height shall be setback a minimum of 10 feet from a lot, parcel, or tract line.

Height of Freestanding Signs. The maximum height of a freestanding sign shall not exceed the height of the building with which the sign is associated.

If located adjacent to or within 300 feet of a grade-separated intersection or interstate highway, the maximum height of the sign shall not exceed the maximum height allowed in the zoning district.

Minimum Separation of Freestanding Signs. No freestanding sign shall be closer than 500 feet to any other freestanding sign along the same road frontage if the signs are located in the same commercial center or industrial center.



Signdealz
1644 Platte Street
Denver, CO 80202

1-800-405-0686

CUSTOMER NAME:	Super Star Car Wash
PROJECT NAME:	Exterior Signage
LOCATION:	Meadowbrook Parkway Colorado Springs, CO 80915
OPPORTUNITY / P.O. NO. (#):	OP-SS-007036
SALES:	Steve Scovill
DATE:	7/11/2023

DESIGNER
TH
PAGE 4

APPROVAL:




Customer Signature (legible)

(X)

Approval Date:

5 YEAR WARRANTY
ALL PARTS, LABOR & SIGNAGE

Building Elevations

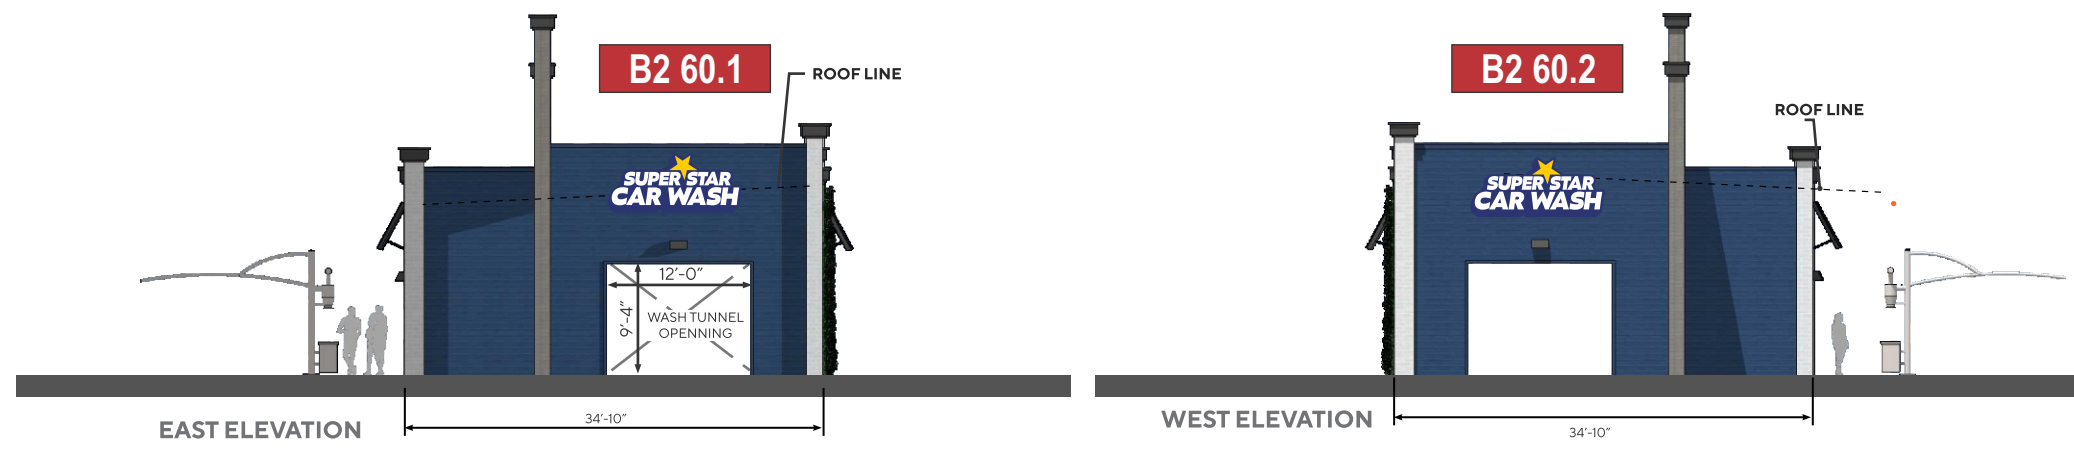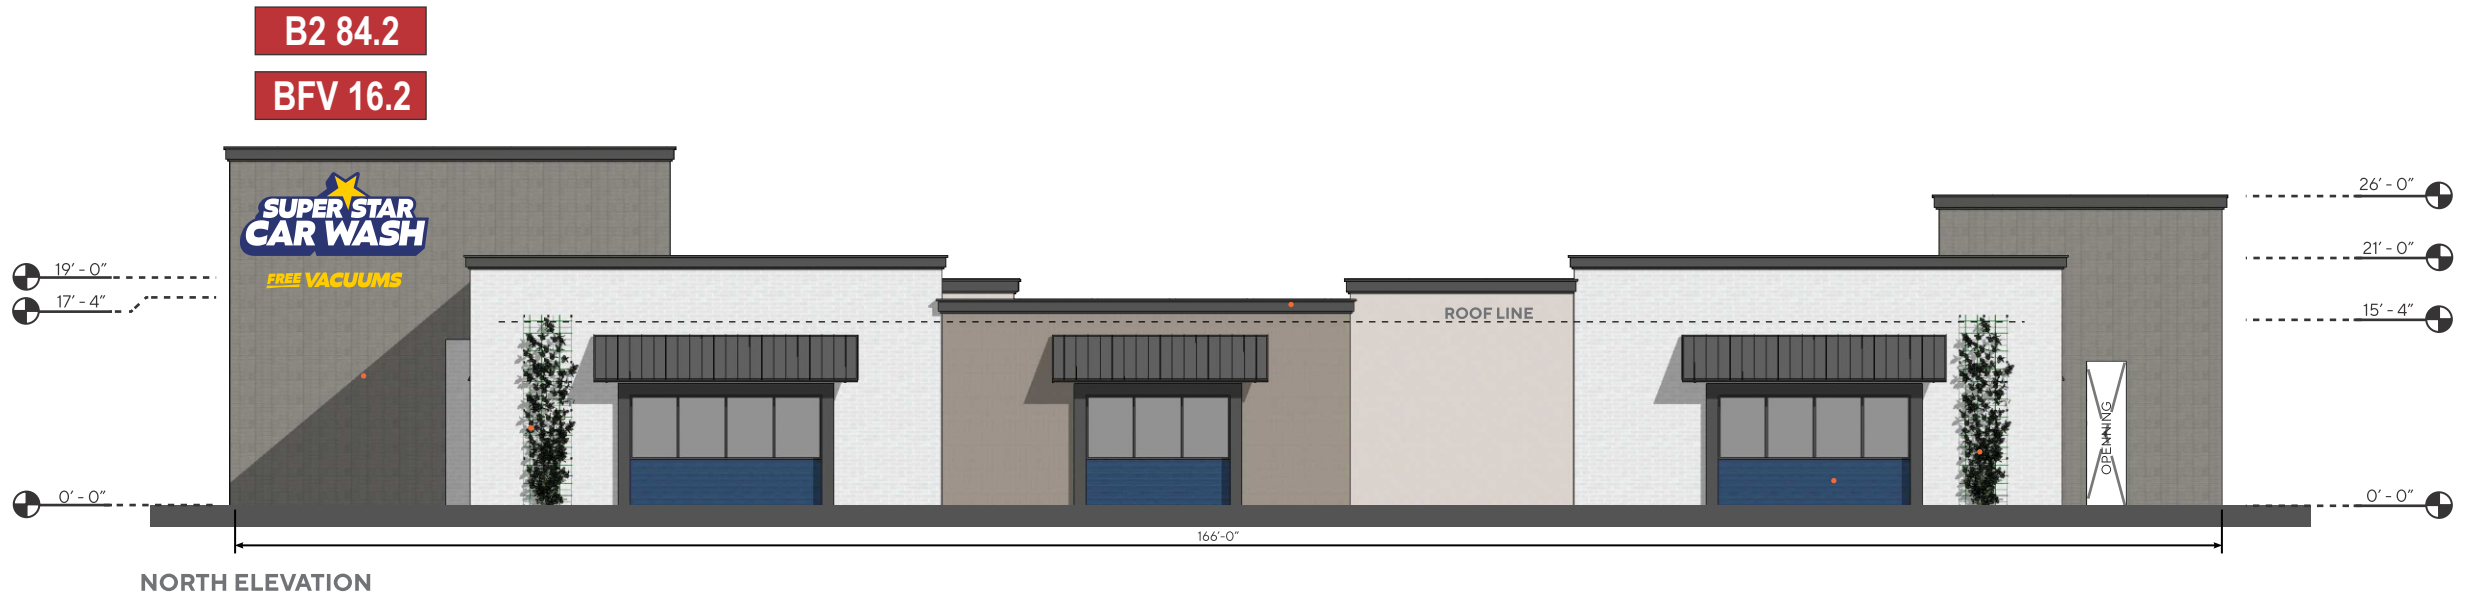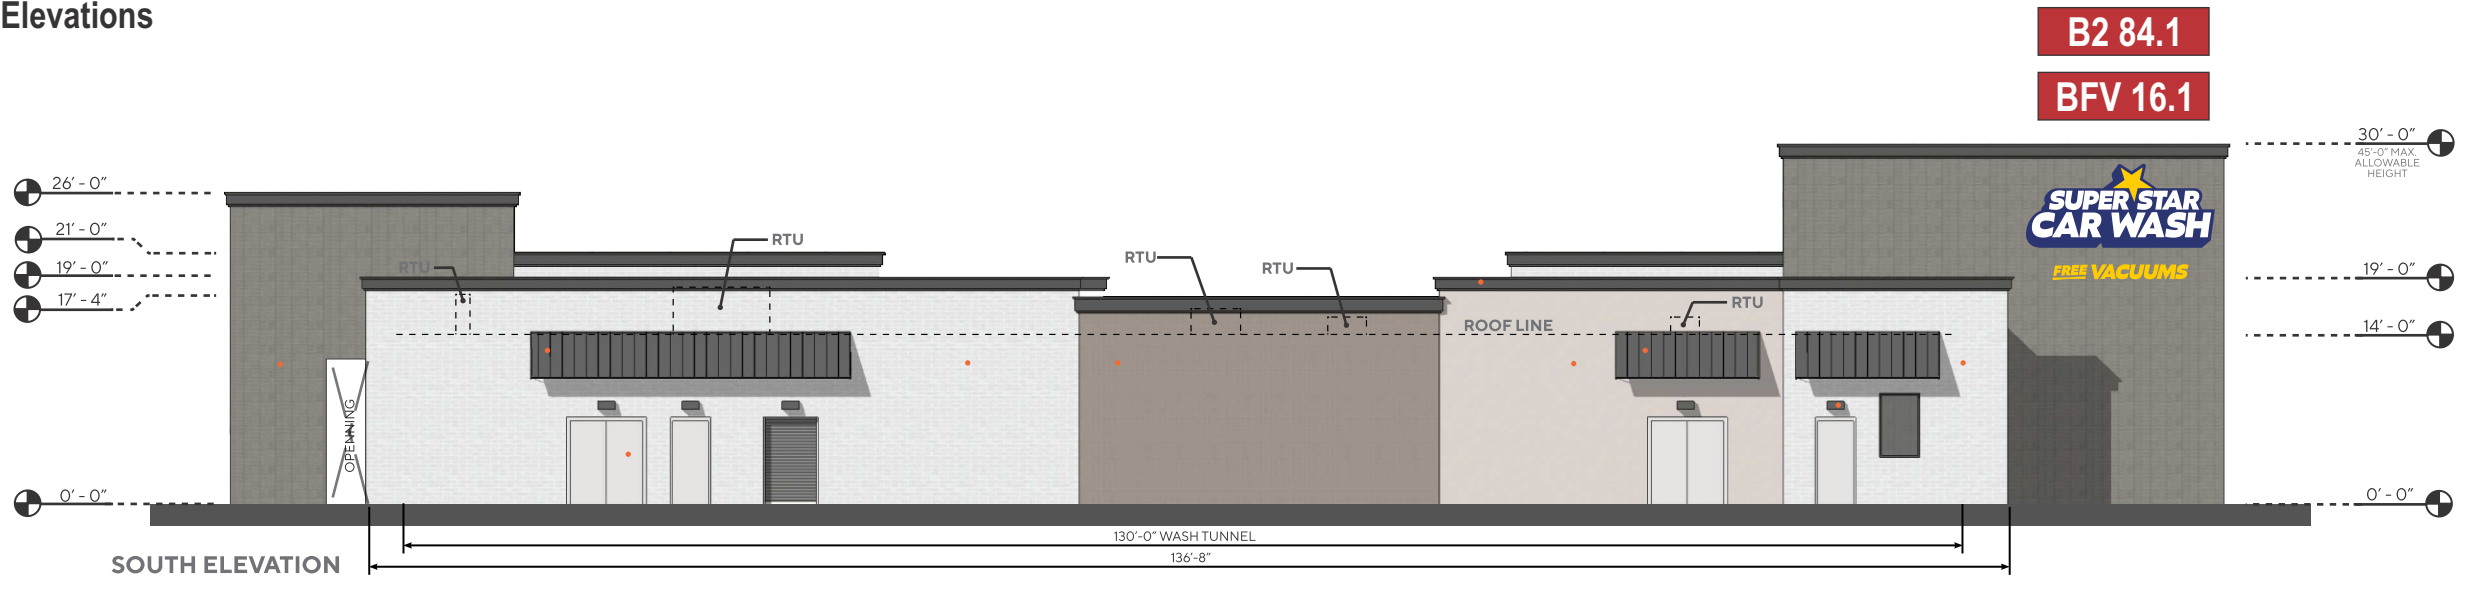

Scale: 1/16" = 1'

Code summary


Building signs:
No maximum # of signs

Maximum Sign Area Per Building Wall:
Building Walls within 300 Feet of Lot Line in Commercial Zoning Districts or Industrial Zoning Districts: 1½ square feet of attached signage is allowed per linear foot of building wall, or 300 square feet, whichever is less.

N&S elevations (166' long) = 249 SF per elevation
E&W elevations (34.10" wide) = 52 SF per elevation
34.10 x 1.5 = 51.15, rounding to 51.2 ft not 52 ft.

Main ID Signs: North & South Elevations

SIGN TYPE **B2 84**

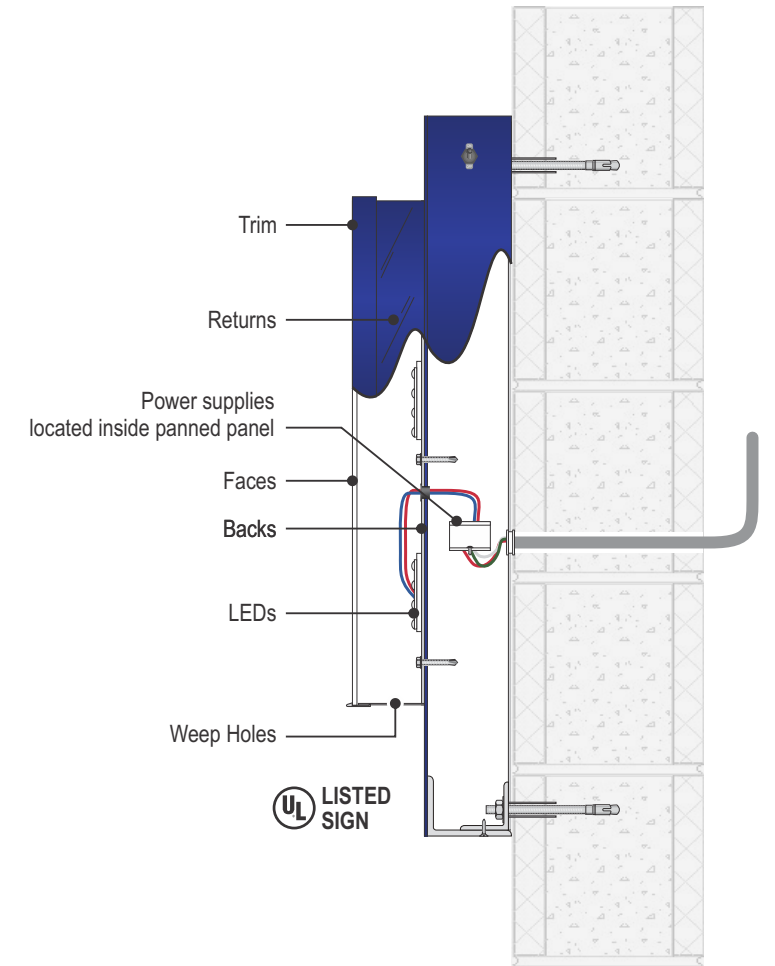

QTY: 2

Fabrication Specs


"SUPER STAR CAR WASH": Illuminated channel letters
 3/16" white acrylic faces
 1" trimcap aluminum, painted Pantone 2757 C Blue #
 5" deep .063" aluminum returns, painted Pantone 2757 C Blue #

"STAR": Illuminated channel letter
 3/16" white acrylic face with 3M Yellow 3630-015 Yellow #
 1" trimcap aluminum, painted Pantone 116 C Yellow #
 5" deep .063" aluminum returns, painted Pantone 116 C Yellow #

3mm ACM or .125" aluminum backs
 Internally illuminated with white LEDs
 Power supplies housed inside backer panel

Flush mounted to contour backer panel


Backer panel: .125" aluminum faces with 4" deep returns
 painted Pantone 2757 C Blue #
 Flush mounted with 3/8" expansion anchors, 6 typical
 Exact attachment as per field conditions / code requirements

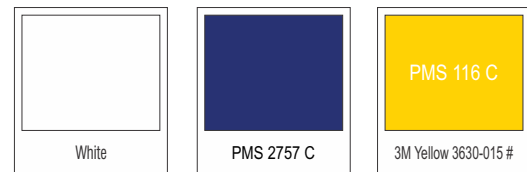

Electrical: Include Photocell, GC to make electrical connection
Load: 4A at 120V, Power requirement: 20A dedicated circuit

Attachment: 3/8" expansion anchors, 6 typical
 Exact attachment as per field conditions / code requirements

15 ft and 9 inches x 7 ft = 110.25 sq ft,
 please revise

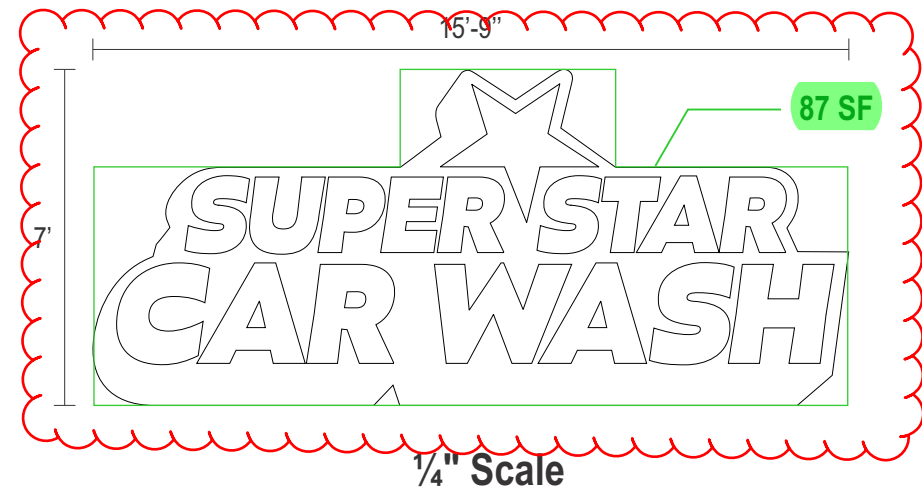

Signdealz
 1644 Platte Street
 Denver, CO 80202

1-800-405-0686

CUSTOMER NAME:	Super Star Car Wash
PROJECT NAME:	Exterior Signage
LOCATION:	Meadowbrook Parkway Colorado Springs, CO 80915
OPPORTUNITY / P.O. NO (#):	OP-SS-007036
DATE:	7/11/2023
SALES:	Steve Scovill

DESIGNER
 TH
PAGE 6

APPROVAL:

Customer Signature (legible)

(X)

Approval Date:

5 YEAR WARRANTY
ALL PARTS, LABOR & SIGNAGE


Free Vacuums Sign: North & South Elevations

SIGN TYPE

BFV 16

11'-4"

15 SQ FT

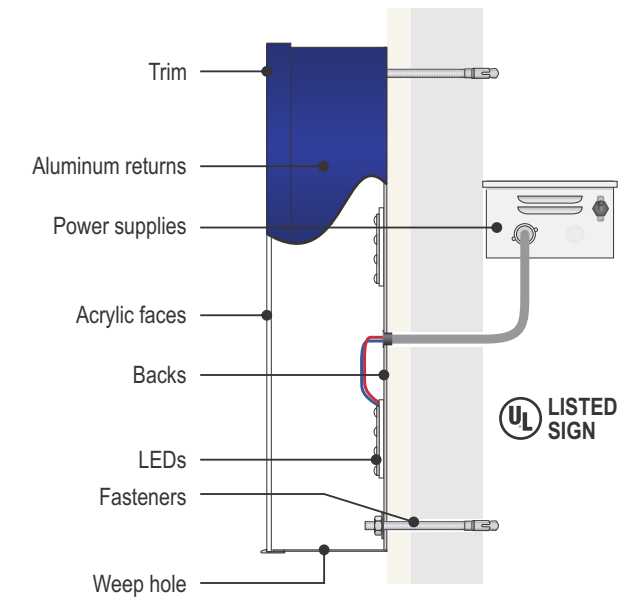

QTY: 2

Fabrication Specs:

Standard flush mounted, face lit channel letters

- 3/16" white acrylic faces with vinyl applied 3M 3630-015 Yellow #
- 1" trimcap, painted Pantone 2757 C Blue #
- 5" deep .040" aluminum returns, painted PMS 2757 C Blue #
- 3mm ACM or .063" aluminum backs
- Internally illuminated with white LEDs

Attachment: 3/8" expansion anchors, 3-4 per letter
Exact attachment as per field conditions / code requirements

Electrical: Include Photocell, GC to make electrical connection
Load: 2A at 120V, Power requirement: 20A dedicated circuit



CUSTOMER NAME:	Super Star Car Wash
PROJECT NAME:	Exterior Signage
LOCATION:	Meadowbrook Parkway Colorado Springs, CO 80915
OPPORTUNITY / P.O. NO(#):	OP-SS-007036
DATE:	7/11/2023
SALES:	Steve Scovill

DESIGNER
TH
PAGE 7

APPROVAL:

Customer Signature (legible)


(X)

Approval Date:

5 YEAR WARRANTY
ALL PARTS, LABOR & SIGNAGE

Main ID Signs: East & West Elevations

SIGN TYPE **B2 60**

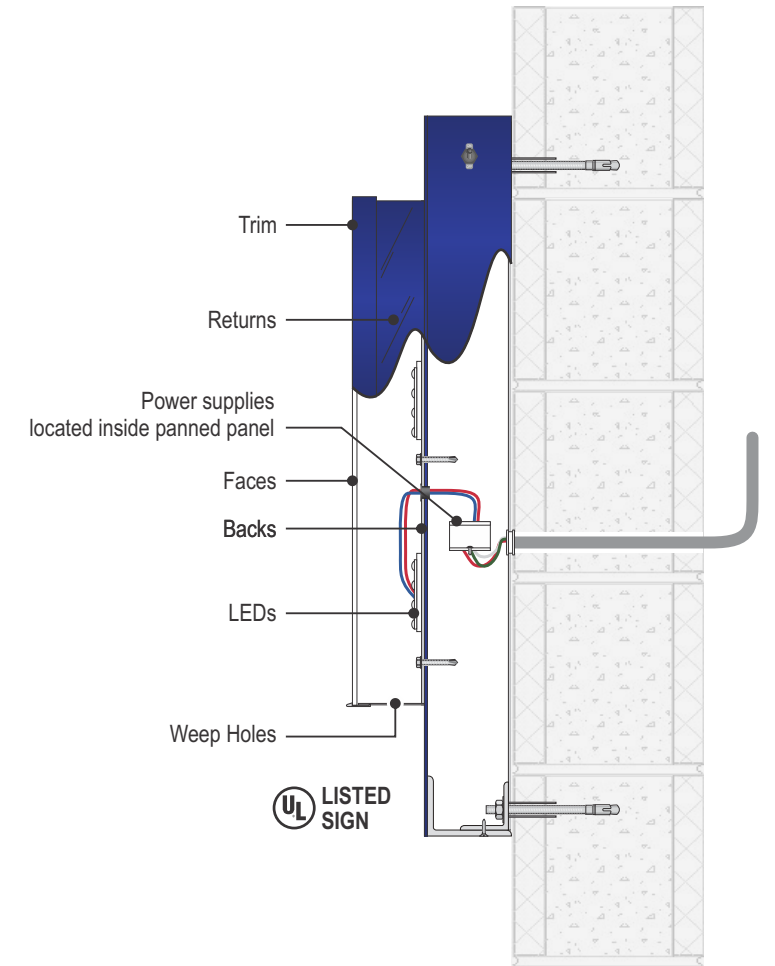

QTY: 2

Fabrication Specs


"SUPER STAR CAR WASH": Illuminated channel letters
 3/16" white acrylic faces
 1" trimcap aluminum, painted Pantone 2757 C Blue #
 5" deep .063" aluminum returns, painted Pantone 2757 C Blue #

"STAR": Illuminated channel letter
 3/16" white acrylic face with 3M Yellow 3630-015 Yellow #
 1" trimcap aluminum, painted Pantone 116 C Yellow #
 5" deep .063" aluminum returns, painted Pantone 116 C Yellow #

3mm ACM or .125" aluminum backs
 Internally illuminated with white LEDs
 Power supplies housed inside backer panel

Flush mounted to contour backer panel


Backer panel: .125" aluminum faces with 4" deep returns
 painted Pantone 2757 C Blue #
 Flush mounted with 3/8" expansion anchors, 6 typical
 Exact attachment as per field conditions / code requirements

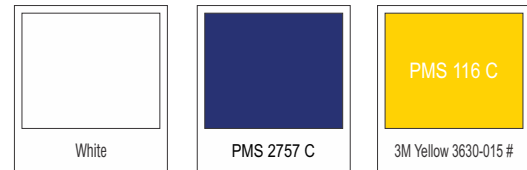

Electrical: Include Photocell, GC to make electrical connection
Load: 4A at 120V, Power requirement: 20A dedicated circuit

Attachment: 3/8" expansion anchors, 6 typical
 Exact attachment as per field conditions / code requirements

11 ft and 2.5 inches x 5 ft = 56.04 sq ft, please revise

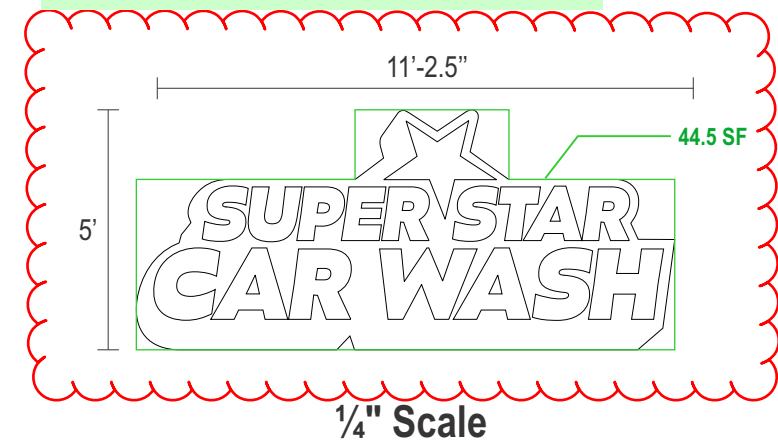

Signdealz
 1644 Platte Street
 Denver, CO 80202

1-800-405-0686

CUSTOMER NAME:	Super Star Car Wash
PROJECT NAME:	Exterior Signage
LOCATION:	Meadowbrook Parkway Colorado Springs, CO 80915
OPPORTUNITY / P.O. NO (#):	OP-SS-007036
DATE:	7/11/2023
SALES:	Steve Scovill

DESIGNER
 TH
PAGE 8


APPROVAL:

Customer Signature (legible)

(X)

Approval Date:

5 YEAR WARRANTY
ALL PARTS, LABOR & SIGNAGE

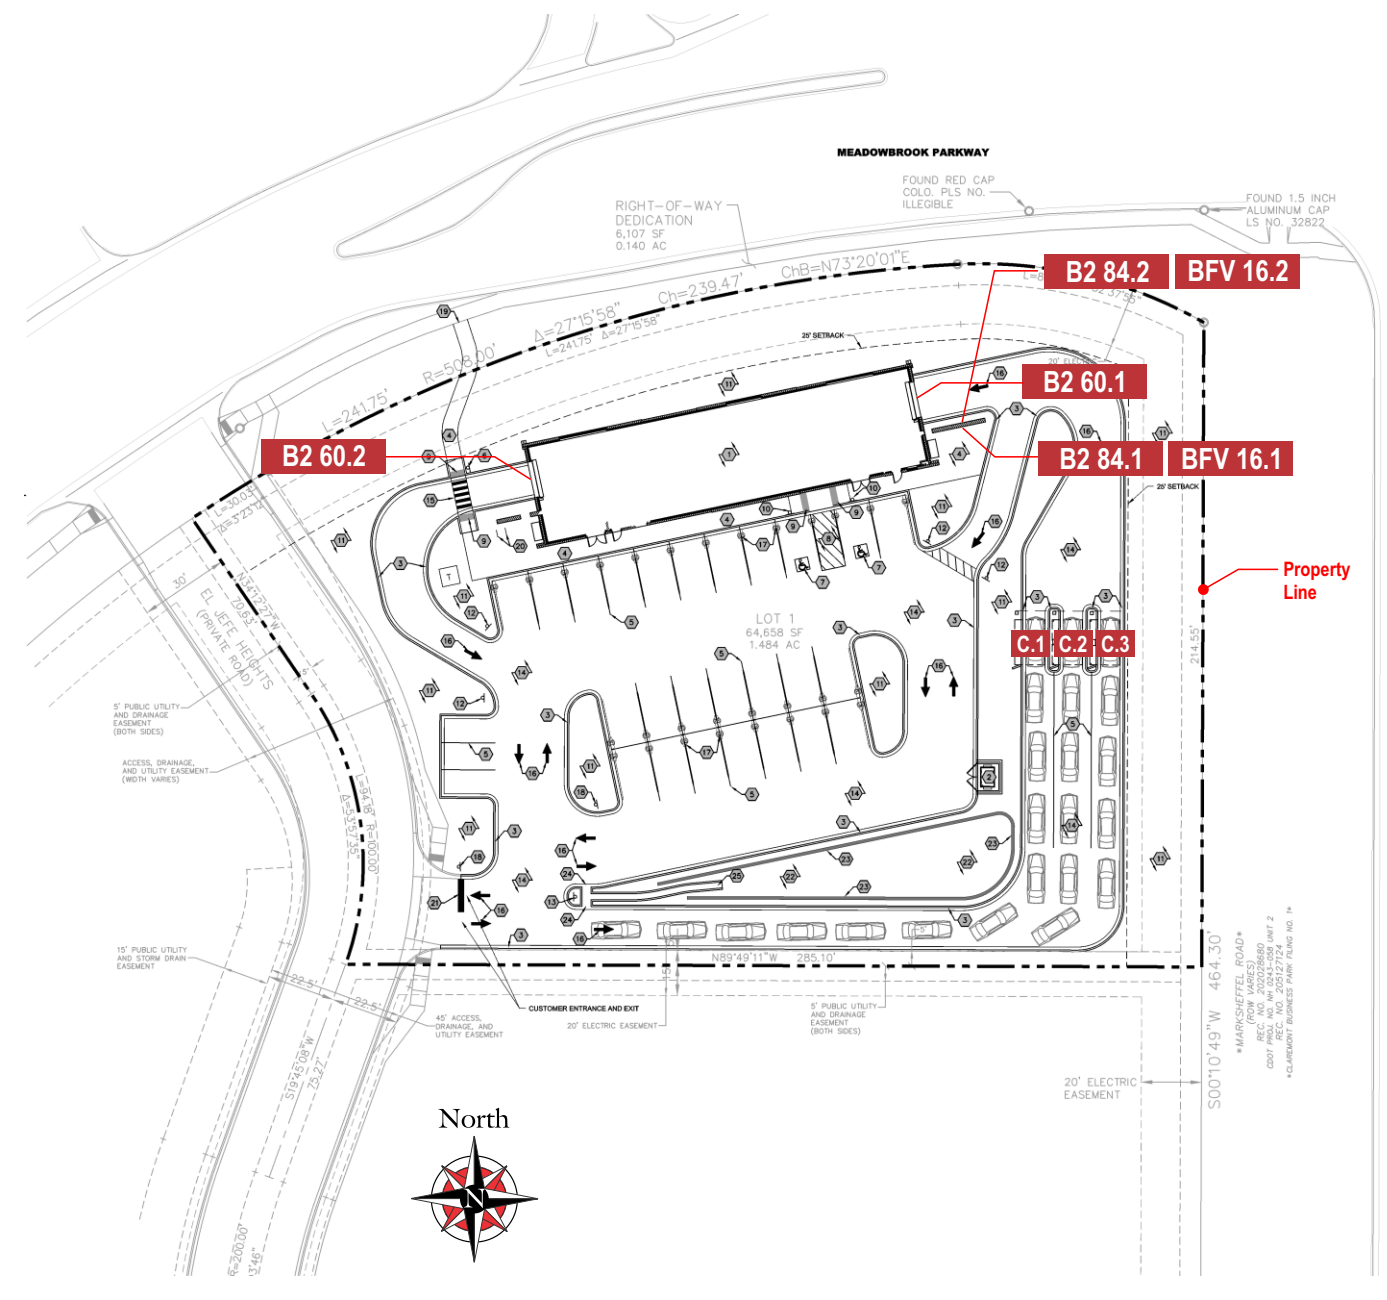

Scale: 1/64" = 1'

B2 84.1
B2 84.2



87 SF each

BFV 16.1
BFV 16.2

FREE VACUUMS

15 SQ FT each

B2 60.1
B2 60.2



44.5 SF each

C.1

C.2

C.3



LEFT LANE

Code summary: Building signs

No maximum # of signs

Maximum Sign Area Per Building Wall:



Building Walls within 300 Feet of Lot Line in Commercial Zoning Districts or Industrial Zoning Districts:
1½ square feet of attached signage is allowed per linear foot of building wall, or 300 square feet, whichever is less.

N&S elevations (166' long) = 249 SF per elevation
E&W elevations (34.10" wide) = 52 SF per elevation

Lane Signs: Single Sided

If location only has 2 lanes, Cash/Credit signs to be used on both lanes.

SIGN TYPE **C**

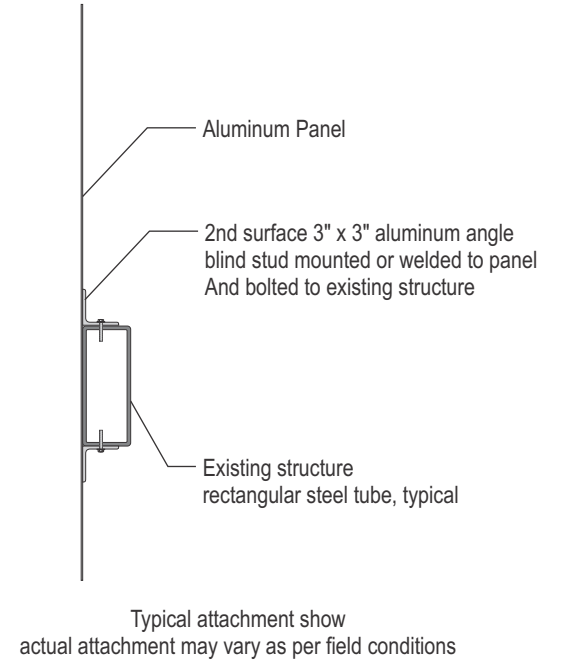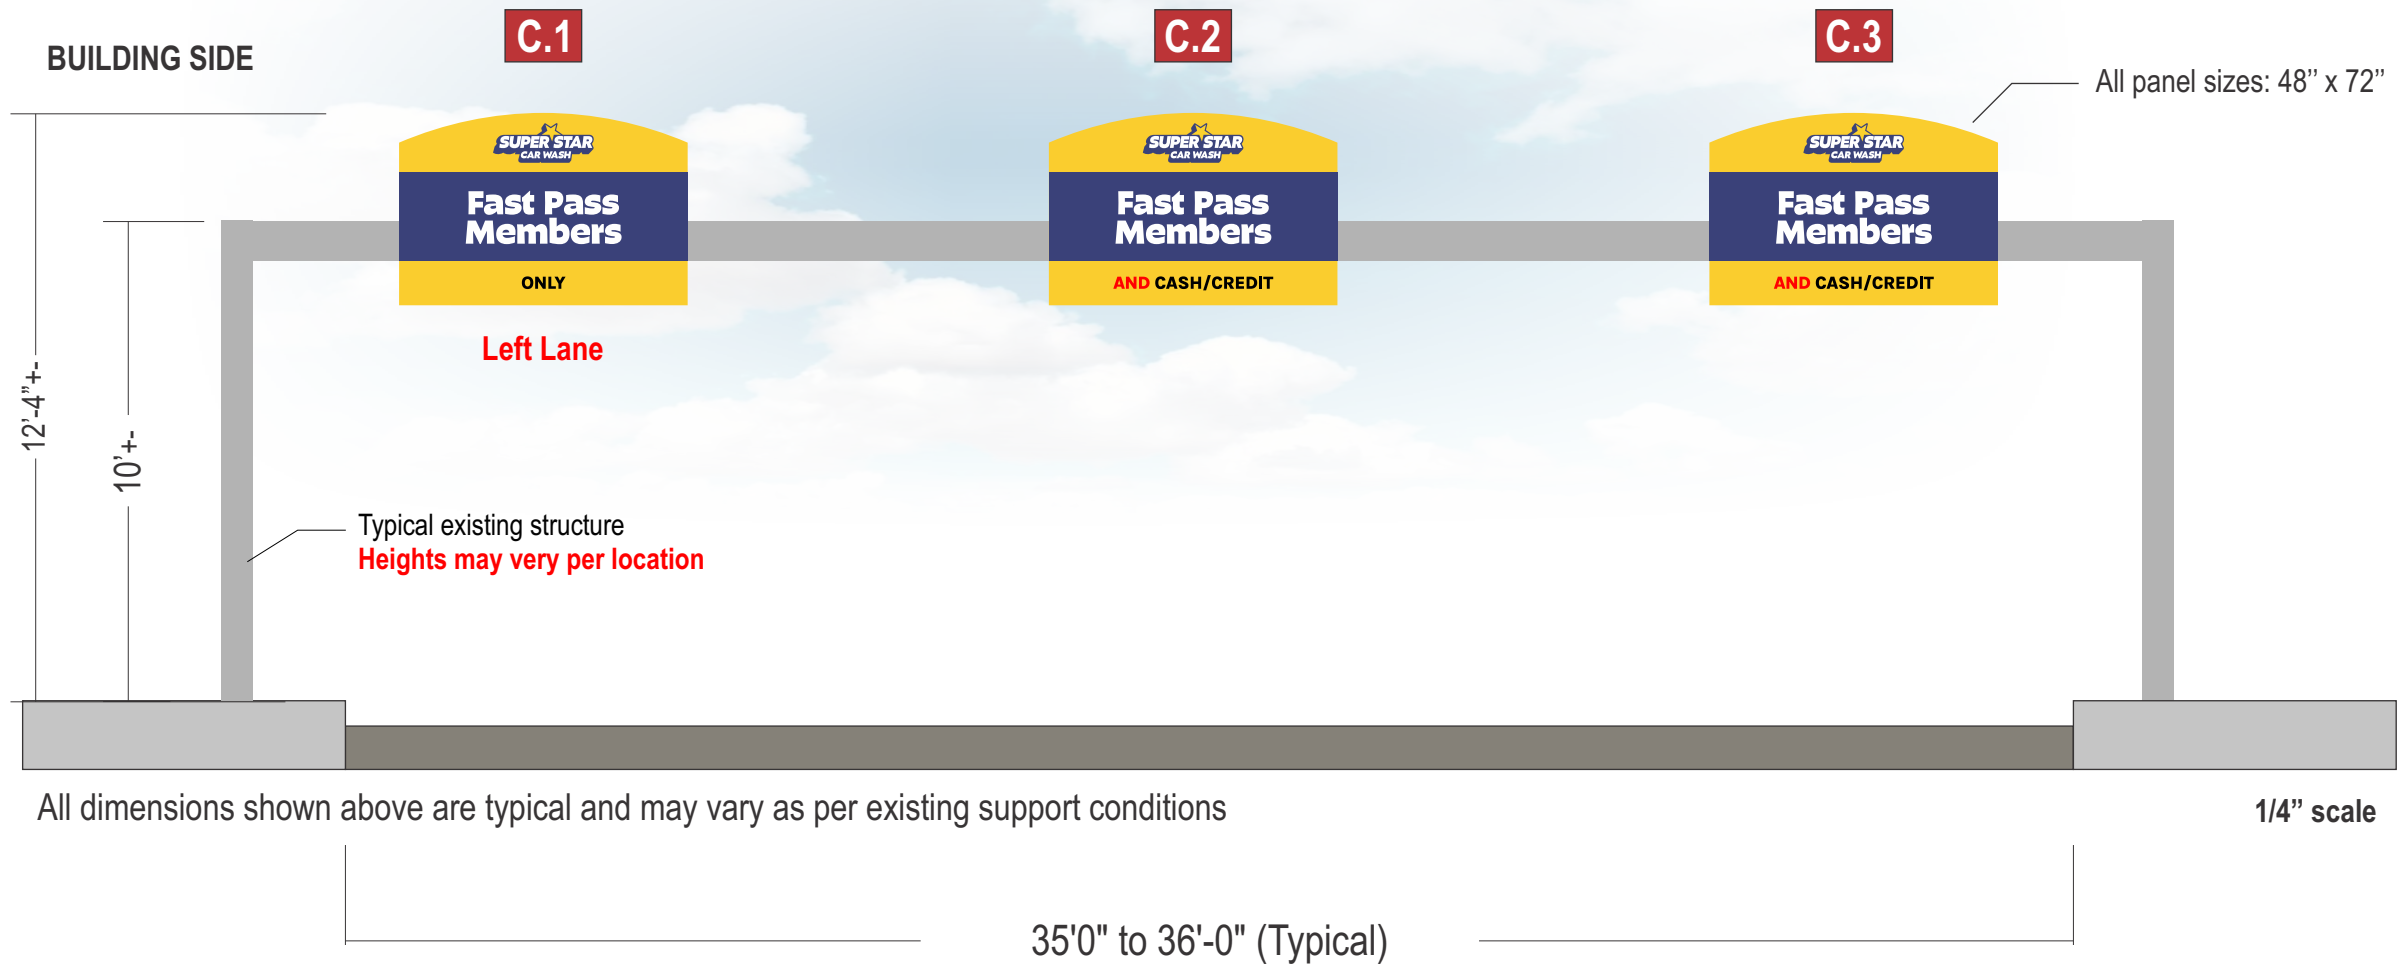

End / Section detail - 3/4" = 1'-0"

QTY: 3

Fabrication Specs

Panels: .125" painted aluminum with cast, printed vinyl applied as required
Printed vinyl to have UV laminate
Backs painted PMS 2757 C Blue #



Signdealz
1644 Platte Street
Denver, CO 80202

1-800-405-0686

CUSTOMER NAME:	Super Star Car Wash
PROJECT NAME:	Exterior Signage
LOCATION:	Meadowbrook Parkway Colorado Springs, CO 80915
OPPORTUNITY / P.O. NO (#):	OP-SS-007036
DATE:	7/11/2023
SALES:	Steve Scovill

DESIGNER
TH
PAGE 10

APPROVAL:

Customer Signature (legible)


(X)

Approval Date:

5 YEAR WARRANTY
ALL PARTS, LABOR & SIGNAGE

Directional Signs: Typical


SIGN TYPE **D**

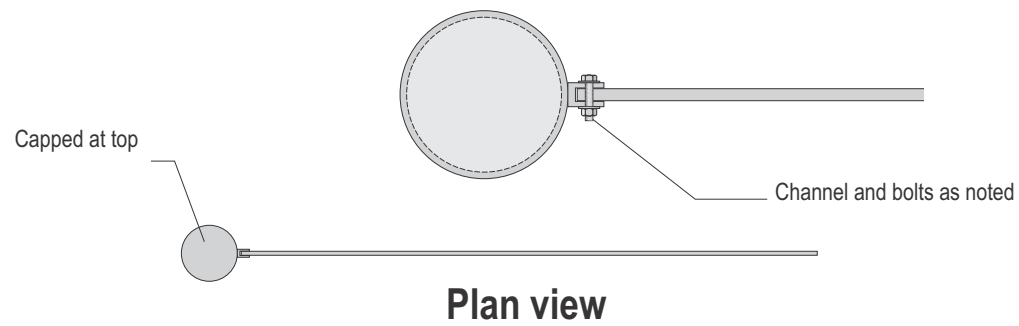

PAINT COLORS:



VINYL COLORS:

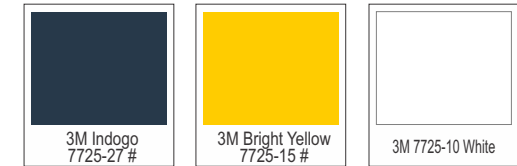

Poles to be placed at position least likely to get hit by a car

Typical layout shown, see next page for layouts, quantities

ALL directional signage needs to be installed with Owner's Rep present to confirm and approve all final locations before the holes are dug and signs are installed.

Notification of install date needs to be sent to SSCW PM no less than 48 hours in advance of proposed install date



1" Scale



Signdealz
1644 Platte Street
Denver, CO 80202

1-800-405-0686

CUSTOMER NAME:	Super Star Car Wash
PROJECT NAME:	Exterior Signage
LOCATION:	Meadowbrook Parkway Colorado Springs, CO 80915
OPPORTUNITY / P.O. NO (#):	OP-SS-007036
DATE:	7/11/2023
SALES:	Steve Scovill

DESIGNER
TH
PAGE 11

APPROVAL:


Customer Signature (legible)

(X)

Approval Date:

5 YEAR WARRANTY
ALL PARTS, LABOR & SIGNAGE

Building Address Numbers: Typical

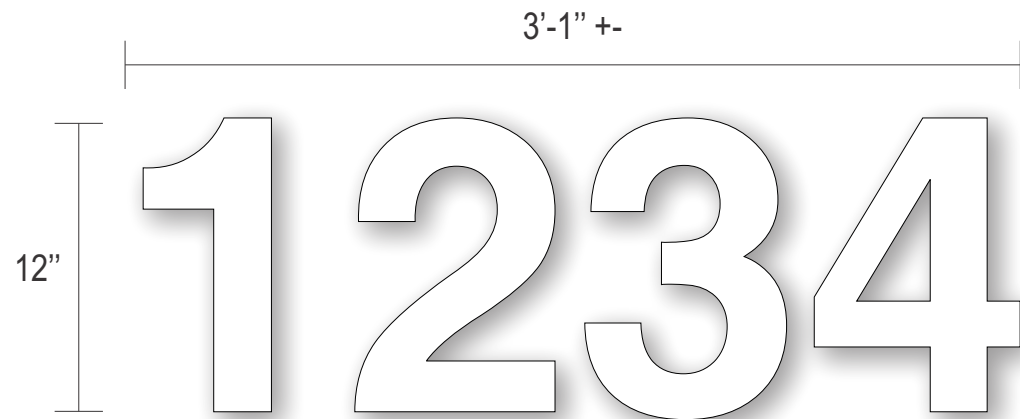

Scale: 1-1/2" = 1'

Fabrication Specs:

12" high, formed plastic, 1" deep

Font: Helvetica

Color will vary per site, typically black for light colored fascias, white for dark colored fascias

Stud mounted flush, include paper pattern



Signdealz
1644 Platte Street
Denver, CO 80202

1-800-405-0686

CUSTOMER NAME:	Super Star Car Wash
PROJECT NAME:	Exterior Signage
LOCATION:	Meadowbrook Parkway Colorado Springs, CO 80915
OPPORTUNITY / P.O. NO (#):	OP-SS-007036
SALES:	Steve Scovill
DATE:	7/11/2023

DESIGNER
TH
PAGE 13

APPROVAL:

Customer Signature (legible)

(X)

Approval Date:



CUSTOMER (ONLY)

Color Disclaimer Note

By Initialing this Box, Customer **"Agrees"** that He/She **"Approves"** of the following Colors and Materials specifications listed. Customer **"Agrees"** that Signdealz is "not" responsible for Color Accuracy if Physical Samples have "not" been provided. It is the Customers responsibility to Request Physical Samples.

COLORS & MATERIALS



LIGHTING

White LED's

APPROVAL OF COLOR(S) & MATERIAL(S):

Customer Initials: Approval Date:

CUSTOMER (ONLY)

Electrical Disclaimer Note:

Unless otherwise Noted in Contract, Electrical "Runs" or Final Electrical Connection Charges are not included. Illuminated Displays are Wired for 120V unless otherwise indicated on Drawing.

Electrical Disclaimer Acknowledgement:

Customer Initials: Approval Date:

Sign Removal / Structure Repair Disclaimer Note:

Unless otherwise Noted in Contract, No repair / refinishing of existing structure(s) is included with any sign removals.

Signdealz recommends any repair / refinishing be completed by customer between sign removal and new sign install

Sign Removal / Structure Repair Acknowledgement:

Customer Initials: Approval Date:

LANDLORD/MANAGEMENT (ONLY)

Landlord / Mgmt. Approval Required:

As the Manager / Landlord / Homeowners Association Representative / Owner of the above mentioned property, I (we) represent that I (we) have the authority to sign this Approval Authorization and hereby do "Authorize" installation of Outdoor Signage at the above-mentioned address by Signdealz, Inc. of their authorized subcontractor. I (we) have reviewed the Sign Specification package, and "Approve" the modifications to the property listed on the Sign Specifications package.

Landlord / Mgmt. Initials: Approval Date:

Landlord / Management:

Print Name:

Address:

Phone:

Email:



Signdealz
1644 Platte Street
Denver, CO 80202

1-800-405-0686

CUSTOMER NAME: Super Star Car Wash
 PROJECT NAME: Exterior Signage
 LOCATION: Meadowbrook Parkway Colorado Springs, CO 80915
 OPPORTUNITY / P.O. NO (#): OP-SS-007036 SALES: Steve Scovill
 DATE: 7/11/2023

DESIGNER
TH
PAGE 14

APPROVAL:

Customer Signature (legible):

(X)

Approval Date:

