SITE DEVELOPMENT PLANS SUPERSTAR CARWASH MEADOWBROOK PKWY COLORADO SPRINGS, CO 80915

PROJECT TEAM

OWNER SUPER STAR CAR WASH 1830 N 95TH AVE, SUITE 106 PHOENIX, AZ, 85037 CONTACT: TIM VARLEY TEL: 801-651-1748 EMAIL: TVARLEY@SSCWAZ.COM

ENGINEER AYRES ASSOCIATES 3665 JFK PARKWAY BLDG. 2 SUITE 100 FORT COLLINS, CO 80525 CONTACT: SCOTT MAIER TEL: (262)-522-4901 EMAIL:MAIERS@AYRESASSOCIATES.COM

LANDSCAPE ARCHITECT AYRES ASSOCIATES 3665 JFK PARKWAY BLDG. 2 SUITE 100 FORT COLLINS, CO 80525 CONTACT: DAVID LAND TEL: (303)-548-2870 EMAIL: LANDD@AYRESASSOCIATES.COM

ARCHITECT **AO ARCHITECTS** 144 N ORANGE STREET ORANGE CA 92866 CONTACT: DUC HUYNH TEL: (714)-639-9860 EMAIL: DUCH@AOARCHITECTS.COM

PROPERTY LEGAL DESCRIPTION


A TRACT OF LAND IN THE SOUTHEAST QUARTER OF THE SOUTHEAST QUARTER (SE 1/4, SE 1/4) OF SECTION 5 AND NORTHEAST QUARTER OF THE NORTHEAST QUARTER (NE 1/4, NE 1/4) OF SECTION 8, T14S, R65W, OF THE 6TH P.M., EL PASO COUNTY, COLORADO

Owner/Developer's Statement:

I, the owner/developer have read and will comply with all of the requirements specified in these detailed plans and specifications.

Tim Varley Super Star Car Wash 1830 N 95th Ave, Suite 106 Phoenix, AZ, 85037

Date

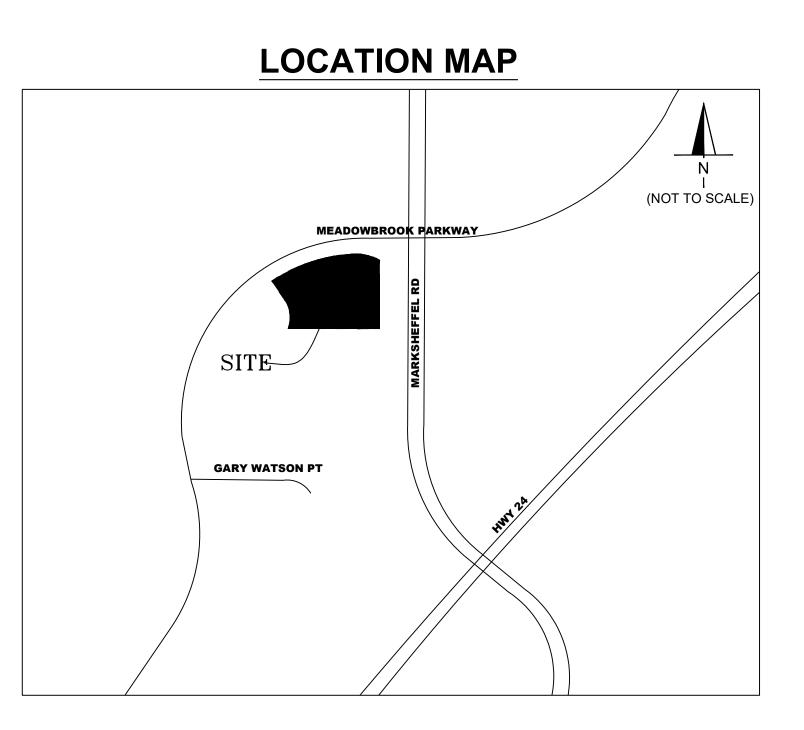


SITE DATA TABLE						
AREA SUMM	AREA SUMMARY				% PROP	
LANDSCAPE	AREA		23	3,149 S.F.	36%	
BUILDING AR	EA		4	,591 S.F.	7%	
PARKING LO			30	6,918 S.F.	57%	
TOTAL IMPER	RVIOUS AREA		4	1,509 S.F.	64%	
TOTAL AREA		64	4,658 S.F.	100%		
ZONING INFORMATION						
		EXISTING		PROF	POSED	
ZONING E	DISTRICT	CS	C		CS	
LAND	USE	VACANT		CAR	WASH	
	REQL			PRO	VIDED	
	FRONT (N) 25'			26.4'		
BUILDING SETBACKS	SIDE (W)	25'		8	0.2'	
JEIDAUNO	SIDE (E)	0'		7	8.3'	
REAR (S)		0'		13	86.6'	
DARKING	FRONT (N)	25'			6.0'	
PARKING SETBACKS	SIDE (W)	25'			6.1'	
	SIDE (E)	0'			6.0'	
	REAR (S)				5.0'	
PARKING	STANDARD	1 SPACE PER BAY OR			26	
			STVI	2		
BIKE PARKING	TOTAL PARKING 1U = 2 SPACES	1 SPACE PER BAY OR STALL 28 5% OF REQUIRED PARKING 4				

SHEET NUMBERSHEET TITLEC1.0COVER SHEETC1.1GENERAL NOTESC2.0EXISTING CONDITIONSC3.0SITE PLANC3.1HORIZONTAL CONTROL PLANC3.2PAVING PLANC3.3FIRE AND SERVICE PLANC4.0EROSION CONTROL PLANC5.1DRAINAGE PLANC5.1DRAINAGE PLANC6.0UTILITY PLANC7.0PHOTOMETRIC PLANC8.1CONSTRUCTION DETAILSC8.1CONSTRUCTION DETAILSL1.0LANDSCAPE PLANA1.0FLOOR PLAN	SHEET LIST TABLE					
C1.1GENERAL NOTESC2.0EXISTING CONDITIONSC3.0SITE PLANC3.1HORIZONTAL CONTROL PLANC3.2PAVING PLANC3.3FIRE AND SERVICE PLANC4.0EROSION CONTROL PLANC4.1EROSION CONTROL DETAILSC5.0GRADING PLANC5.1DRAINAGE PLANC6.0UTILITY PLANC7.0PHOTOMETRIC PLANC8.0CONSTRUCTION DETAILSC8.1CONSTRUCTION DETAILSL1.0LANDSCAPE PLANL1.1LANDSCAPE DETAILS	SHEET NUMBER					
C2.0EXISTING CONDITIONSC3.0SITE PLANC3.1HORIZONTAL CONTROL PLANC3.2PAVING PLANC3.3FIRE AND SERVICE PLANC4.0EROSION CONTROL PLANC4.1EROSION CONTROL PLANC5.0GRADING PLANC5.1DRAINAGE PLANC6.0UTILITY PLANC7.0PHOTOMETRIC PLANC8.0CONSTRUCTION DETAILSC8.1CONSTRUCTION DETAILSL1.0LANDSCAPE PLANL1.1LANDSCAPE DETAILS	C1.0					
C3.0SITE PLANC3.1HORIZONTAL CONTROL PLANC3.2PAVING PLANC3.3FIRE AND SERVICE PLANC4.0EROSION CONTROL PLANC4.1EROSION CONTROL DETAILSC5.0GRADING PLANC5.1DRAINAGE PLANC6.0UTILITY PLANC7.0PHOTOMETRIC PLANC8.0CONSTRUCTION DETAILSC8.1CONSTRUCTION DETAILSL1.0LANDSCAPE PLANL1.1LANDSCAPE DETAILS	C1.1					
C3.1HORIZONTAL CONTROL PLANC3.2PAVING PLANC3.3FIRE AND SERVICE PLANC4.0EROSION CONTROL PLANC4.1EROSION CONTROL DETAILSC5.0GRADING PLANC5.1DRAINAGE PLANC6.0UTILITY PLANC7.0PHOTOMETRIC PLANC8.0CONSTRUCTION DETAILSC8.1CONSTRUCTION DETAILSL1.0LANDSCAPE PLANL1.1LANDSCAPE DETAILS	C2.0					
C3.2PAVING PLANC3.3FIRE AND SERVICE PLANC4.0EROSION CONTROL PLANC4.1EROSION CONTROL DETAILSC5.0GRADING PLANC5.1DRAINAGE PLANC6.0UTILITY PLANC7.0PHOTOMETRIC PLANC8.0CONSTRUCTION DETAILSC8.1CONSTRUCTION DETAILSL1.0LANDSCAPE PLANL1.1LANDSCAPE DETAILS	C3.0					
C3.3FIRE AND SERVICE PLANC4.0EROSION CONTROL PLANC4.1EROSION CONTROL DETAILSC5.0GRADING PLANC5.1DRAINAGE PLANC6.0UTILITY PLANC7.0PHOTOMETRIC PLANC8.0CONSTRUCTION DETAILSC8.1CONSTRUCTION DETAILSL1.0LANDSCAPE PLANL1.1LANDSCAPE DETAILS	C3.1					
C4.0EROSION CONTROL C7.0PHOTOMETRIC PLANC8.0CONSTRUCTION DETAILSC8.1CONSTRUCTION DETAILSL1.0LANDSCAPE PLANL1.1LANDSCAPE DETAILS	C5.1					
C8.0CONSTRUCTION DETAILSC8.1CONSTRUCTION DETAILSL1.0LANDSCAPE PLANL1.1LANDSCAPE DETAILS	C6.0					
C8.1CONSTRUCTION DETAILSL1.0LANDSCAPE PLANL1.1LANDSCAPE DETAILS	C7.0					
L1.0 LANDSCAPE PLAN L1.1 LANDSCAPE DETAILS	C8.0					
L1.1 LANDSCAPE DETAILS	C8.1					
	L1.0					
A1.0 FLOOR PLAN	L1.1					
	A1.0					
A2.0 EXTERIOR ELVATIONS	A2.0					
A3.0 PERSPECTIVE 1	A3.0					
A4.0 PERSPECTIVE 2	A4.0					
A5.0 PERSPECTIVE 3	 A5.0					
A6.0 COLORS AND MATERIALS	 A6.0					

CONTRACTOR NOTE

CONTRACTOR SHALL KEEP A COPY OF EL PASO COUNTY STAMPED/APPROVED PLANS ON-SITE AT ALL TIMES FOR GENERAL CONTRACTOR AND MUNICIPAL INSPECTOR REFERENCE.

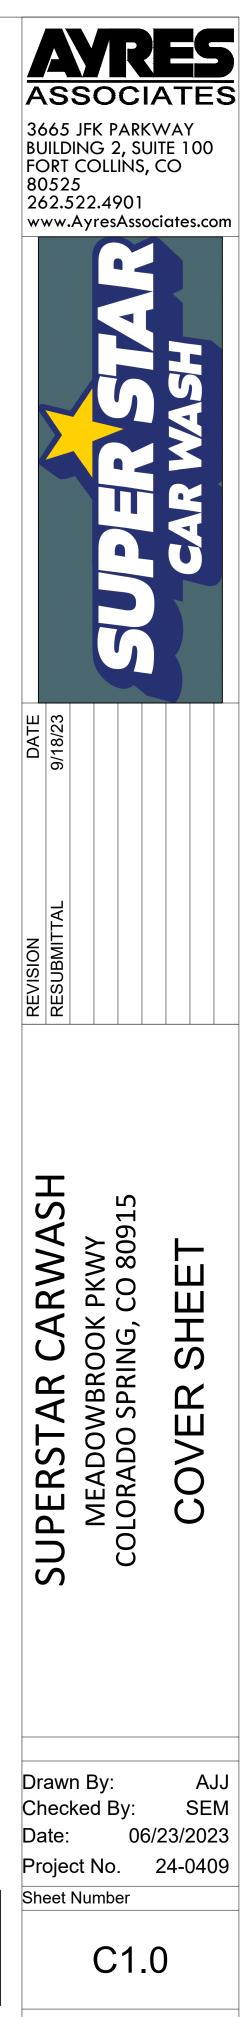

EPC - EDARP FILE NUMBER: PPR2315



GENERAL SITE WORK NOTES:

- ALL ROADWAY CONSTRUCTION SHALL CONFORM TO THE COLORADO DEPARTMENT OF TRANSPORTATION STANDARD SPECIFICATIONS BOOK, AND IN ACCORDANCE WITH THE LATEST EDITION OF THE SPECIFICATIONS FOR CONSTRUCTION IN EL PASO COUNTY, COLORADO; IN CASE OF CONFLICT, EL PASO COUNTY SHALL TAKE PRECEDENCE.
- ALL STORM SEWER, SANITARY SEWER, AND WATER MAIN CONSTRUCTION SHALL CONFORM TO THE SPECIFICATIONS FOR CONSTRUCTION IN EL PASO COUNTY, UNLESS OTHERWISE NOTED ON THE PLANS.
- STANDARD SPECIFICATIONS, SUPPLEMENTAL SPECIFICATIONS, AND RECURRING SPECIAL PROVISIONS, CONSTRUCTION PLANS, AND SUBSEQUENT DETAILS ARE ALL TO BE CONSIDERED AS PART OF THE CONTRACT. INCIDENTAL ITEMS OR ACCESSORIES NECESSARY TO COMPLETE THIS WORK MAY NOT BE SPECIFICALLY NOTED, BUT ARE CONSIDERED A PART OF THIS CONTRACT.
- THE CONTRACTOR IS RESPONSIBLE FOR OBTAINING ALL NECESSARY PERMITS AND APPROVALS BEFORE CONSTRUCTION BEGINS.
- THE CONTRACTOR IS RESPONSIBLE FOR VERIFYING THE NATURE AND STATUS OF ALL UTILITY RELOCATION WORK PRIOR TO THE START OF CONSTRUCTION. THE CONTRACTOR SHALL TAKE APPROPRIATE MEASURES TO ENSURE THAT CONSTRUCTION OPERATIONS DO NOT INTERFERE WITH UTILITY FACILITIES AND RELOCATION WORK. THE SCHEDULE SHOULD REFLECT CONSTRUCTION SEQUENCING THAT COORDINATES WITH ALL UTILITY RELOCATION WORK. THE CONTRACTOR SHALL BE REQUIRED TO ADJUST THE ORDER OF ITS REVISED SCHEDULE(S) IN COMPLIANCE THEREWITH AS DIRECTED BY THE OWNER. THE OWNER AND ENGINEER SHALL BE NOTIFIED IN WRITING BY THE CONTRACTOR AT LEAST 48 HOURS PRIOR TO THE START OF ANY OPERATION REQUIRING COOPERATION WITH OTHERS. THE UTILITY COMPANIES HAVE BEEN CONTACTED IN REGARD TO UTILITIES THEY OWN AND OPERATE WITHIN THE LIMITS FOR THIS PROJECT. ALL KNOWN DATA FROM THESE AGENCIES HAS BEEN INCORPORATED INTO THE PLANS. IT IS, HOWEVER, THE CONTRACTOR'S RESPONSIBILITY TO CONFIRM OR ESTABLISH THE EXISTENCE OF ALL UTILITY FACILITIES AND THEIR EXACT LOCATIONS. WHETHER CONTAINED IN THE DATA SUBMITTED BY THESE AGENCIES OR NOT, AND TO SAFELY SCHEDULE ALL UTILITY RELOCATIONS. FOR ADDITIONAL INFORMATION. THE AGENCIES LISTED ON THE TITLE SHEET MAY BE CONTACTED. IF EXISTING UTILITY LINES OF ANY NATURE ARE ENCOUNTERED WHICH CONFLICT WITH LOCATIONS OF THE NEW CONSTRUCTION, THE CONTRACTOR SHALL NOTIFY THE ENGINEER SO THAT THE CONFLICT MAY BE RESOLVED. THE OWNER OR ENGINEER WILL ASSUME NO LIABILITY FOR ANY DAMAGES SUSTAINED OR COST INCURRED BECAUSE OF THE OPERATIONS IN THE VICINITY OF EXISTING UTILITIES OR STRUCTURES, NOR FOR TEMPORARY BRACING AND SHORING OF SAME. IF IT IS NECESSARY TO SHORE, BRACE, SWING OR RELOCATE A UTILITY, THE UTILITY COMPANY OR DEPARTMENT AFFECTED SHALL BE CONTACTED BY THE CONTRACTOR AND THEIR PERMISSION OBTAINED REGARDING THE METHOD TO USE FOR SUCH WORK
- NO CONSTRUCTION PLANS SHALL BE USED FOR CONSTRUCTION UNLESS SPECIFICALLY MARKED "FOR CONSTRUCTION" PRIOR TO COMMENCEMENT OF CONSTRUCTION. THE CONTRACTOR SHALL VERIFY ALL DIMENSIONS AND CONDITIONS AFFECTING THE WORK WITH THE ACTUAL CONDITIONS AT THE JOB SITE. IN ADDITION, THE CONTRACTOR MUST VERIFY THE SURVEYOR'S LINE AND GRADE STAKES. IF THERE ARE ANY DISCREPANCIES WITH WHAT IS SHOWN ON THE CONSTRUCTION PLANS, HE MUST IMMEDIATELY REPORT SAME TO THE SURVEYOR OR ENGINEER BEFORE DOING ANY WORK. OTHERWISE, THE CONTRACTOR ASSUMES FULL RESPONSIBILITY. IN THE EVENT OF DISAGREEMENT BETWEEN THE CONSTRUCTION PLANS, SPECIFICATIONS, AND/OR SPECIAL DETAILS, THE CONTRACTOR SHALL SECURE WRITTEN INSTRUCTION FROM THE ENGINEER PRIOR TO PROCEEDING WITH ANY PART OF THE WORK AFFECTED BY OMISSIONS OR DISCREPANCIES, FAILING TO SECURE SUCH INSTRUCTION, THE CONTRACTOR WILL BE CONSIDERED TO HAVE PROCEEDED AT HIS OWN RISK AND EXPENSE. IN THE EVENT OF ANY DOUBT OR QUESTIONS ARISING WITH RESPECT TO THE TRUE MEANING OF THE CONSTRUCTION PLANS OR SPECIFICATIONS, THE DECISION OF THE ENGINEER SHALL BE FINAL AND CONCLUSIVE.
- NO FIELD CHANGES OR DEVIATIONS FROM DESIGN ARE TO BE MADE WITHOUT PRIOR APPROVAL OF THE OWNER AND NOTIFICATION TO THE ENGINEER. NO CONSIDERATION WILL BE GIVEN TO CHANGE ORDERS FOR WHICH THE OWNER AND ENGINEER WERE NOT CONTACTED PRIOR TO CONSTRUCTION OF THE AFFECTED ITEM.
- ALL FRAMES AND LIDS FOR STORM AND SANITARY SEWERS, VALVE VAULT COVERS, FIRE HYDRANTS, AND B-BOXES ARE TO BE ADJUSTED TO MEET FINISHED GRADE. THIS ADJUSTMENT IS TO BE MADE BY THE SEWER AND WATER CONTRACTOR, AND THE COST IS TO BE CONSIDERED INCIDENTAL. THESE ADJUSTMENTS TO FINISHED GRADE WILL NOT ALLEVIATE THE CONTRACTOR FROM ANY ADDITIONAL ADJUSTMENTS AS REQUIRED BY THE CITY UPON FINAL INSPECTION OF THE PROJECT.
- ALL WORK PERFORMED UNDER THIS CONTRACT SHALL BE GUARANTEED BY THE CONTRACTOR AND HIS SURETY FOR LENGTH SPECIFIED IN THE GENERAL CONDITIONS FROM THE DATE OF FINAL ACCEPTANCE OF THE PROJECT. THE CONTRACTOR SHALL BE HELD RESPONSIBLE FOR ALL DEFECTS IN MATERIALS AND WORKMANSHIP OF WHATEVER NATURE DURING THAT PERIOD.
- THE CONTRACTOR IS SOLELY RESPONSIBLE FOR SAFETY ON THE JOB PER OSHA REGULATIONS.
- IT SHALL BE THE CONTRACTOR'S SOLE RESPONSIBILITY TO PROVIDE PROPER BARRICADING, WARNING DEVICES, AND THE SAFE MANAGEMENT OF TRAFFIC WITHIN THE AREA OF CONSTRUCTION. ALL SUCH DEVICES AND THEIR INSTALLATION SHALL CONFORM TO THE MANUAL OF UNIFORM TRAFFIC CONTROL DEVICES FOR STREET AND HIGHWAYS, LATEST EDITION, AND IN ACCORDANCE WITH LOCAL MUNICIPAL CODES. A TRAFFIC CONTROL PERMIT IS REQUIRED FOR WORK ON CITY STREETS.
- THE CONTRACTOR SHALL COLLECT AND REMOVE ALL CONSTRUCTION DEBRIS, EXCESS MATERIALS, TRASH, OIL AND GREASE RESIDUE, MACHINERY, TOOLS, AND OTHER MISCELLANEOUS ITEMS WHICH WERE NOT PRESENT PRIOR TO PROJECT COMMENCEMENT AT NO ADDITIONAL EXPENSE TO THE OWNER. THE CONTRACTOR SHALL BE RESPONSIBLE FOR ACQUIRING ANY AND ALL PERMITS NECESSARY FOR THE HAULING AND DISPOSAL REQUIRED FOR CLEANUP, AS DIRECTED BY THE ENGINEER OR OWNER. BURNING ON THE SITE IS NOT PERMITTED.
- . NO UNDERGROUND WORK SHALL BE COVERED UNTIL IT HAS BEEN INSPECTED AND APPROVED AS REQUIRED BY THE OWNER AND ENTITY THAT HAS JURISDICTION OVER THE WORK
- 14. ALL EXISTING UTILITIES OR IMPROVEMENTS, INCLUDING WALKS, CURBS, PAVEMENT, AND PARKWAYS DAMAGED OR REMOVED DURING CONSTRUCTION SHALL BE PROMPTLY RESTORED TO THEIR RESPECTIVE ORIGINAL CONDITION. THIS WORK SHALL BE CONSIDERED INCIDENTAL TO THE CONTRACT UNLESS A PAY ITEM IS LISTED ON THE BID LIST.
- 15. AT THE CLOSE OF EACH WORKING DAY AND AT THE CONCLUSION OF CONSTRUCTION OPERATIONS, ALL DRAINAGE STRUCTURES AND FLOW LINES SHALL BE FREE FROM DIRT AND DEBRIS.
- 16. LIMB PRUNING SHALL BE PERFORMED UNDER THE SUPERVISION OF AN APPROVED LANDSCAPE ARCHITECT AND SHALL BE UNDERTAKEN IN A TIMELY FASHION SO AS NOT TO INTERFERE WITH CONSTRUCTION. ALL LIMBS, BRANCHES, AND OTHER DEBRIS RESULTING FROM THIS WORK SHALL BE DISPOSED OF OFF-SITE BY THE CONTRACTOR AT HIS OWN EXPENSE.
- . THE TRENCHES FOR PIPE INSTALLATION SHALL BE KEPT DRY AT ALL TIMES DURING PIPE PLACEMENT. APPROPRIATE FACILITIES TO MAINTAIN THE DRY TRENCH SHALL BE PROVIDED BY THE CONTRACTOR, AND THE COST OF SUCH SHALL BE INCIDENTAL TO THE UNIT PRICE BID FOR THE ITEM. PLANS FOR THE SITE DEWATERING, IF EMPLOYED, SHALL BE SUBMITTED TO AND APPROVED BY THE ENGINEER PRIOR TO IMPLEMENTATION. NO ADDITIONAL COMPENSATION SHALL BE MADE FOR DEWATERING DURING CONSTRUCTION UNLESS APPROVED IN WRITING BY THE OWNER.
- . EROSION CONTROL MEASURES SHALL BE INSTALLED IN ACCORDANCE WITH NPDES STANDARDS FOR SOIL EROSION AND SEDIMENTATION CONTROL AND SHALL BE MAINTAINED BY THE CONTRACTOR AND REMAIN IN PLACE UNTIL THE NOTICE OF TERMINATION HAS BEEN OBTAINED. THE CONTRACTOR SHALL MAKE NECESSARY ADJUSTMENTS TO THE EROSION CONTROL TO STAY IN COMPLIANCE WITH THE NPDES PERMIT. THESE ADJUSTMENTS MAY BE MADE TO ACCOMMODATE PHASED CONSTRUCTION AND/OR SPECIFIC SITE CONDITIONS.
- THE CONTRACTOR SHALL PREPARE RECORD DRAWINGS AND MAKE THE NECESSARY SUBMITTALS TO THE ENGINEER. SAID PLANS SHALL INDICATE THE FINAL LOCATION AND LAYOUT OF ALL IMPROVEMENTS, INCLUDING VERIFICATION OF ALL CONCRETE PADS, INVERT, RIM, AND SPOT GRADE ELEVATIONS, AND INCORPORATE ALL FIELD DESIGN CHANGES APPROVED BY THE OWNER.
- 20. THE CONTRACTOR SHALL VIDEOTAPE THE WORK AREA PRIOR TO CONSTRUCTION FOR THE PURPOSE OF DOCUMENTING EXISTING CONDITIONS.
- 21. ALL TESTING SHALL BE THE RESPONSIBILITY AND EXPENSE OF THE CONTRACTOR. COPIES OF ALL TEST RESULTS SHALL BE PROVIDED TO THE ENGINEER FOR REVIEW AND APPROVAL
- 22. THE PAVEMENT SHALL BE KEPT FREE OF MUD AND DEBRIS AT ALL TIMES.
- 23. THE CONTRACTOR SHALL BE RESPONSIBLE FOR REMOVAL AND DISPOSAL OFFSITE OF ANY EXISTING PAVING AND STRUCTURES REMOVED.
- 24. CONTRACTOR SHALL BE RESPONSIBLE FOR ALL CONSTRUCTION SURVEY.
- 25. ALL EXISTING TRAFFIC AND STREET SIGNS DISTURBED SHALL BE REINSTALLED WHERE APPLICABLE BY THE CONTRACTOR AND TO EL PASO COUNTY STANDARDS.
- 26. REFER TO IRRIGATION PLANS FOR SLEEVING REQUIREMENTS. CONTRACTOR SHALL COORDINATE WITH FRANCHISE UTILITY COMPANIES FOR SLEEVING REQUIREMENTS PRIOR TO ANY PAVING ACTIVITIES.
- BEFORE PLACING PAVEMENT, CONTRACTOR SHALL VERIFY THAT SUITABLE HANDICAPPED ROUTES (PER A.D.A. AND T.A.S.) EXIST TO AND FROM EVERY DOOR. IN NO CASE SHALL HANDICAP RAMP SLOPES EXCEED 1 VERTICAL TO 12 HORIZONTAL. IN NO CASE SHALL SIDEWALK CROSS SLOPES EXCEED 2.0 PERCENT. IN NO CASE SHALL LONGITUDINAL SIDEWALK SLOPES EXCEED 5.0 PERCENT. CONTRACTOR SHALL CONTACT ARCHITECT AND ENGINEER PRIOR TO PAVING IF ANY EXCESSIVE SLOPES ARE ENCOUNTERED. NO CONTRACTOR CHANGE ORDERS WILL BE ACCEPTED FOR A.D.A. COMPLIANCE ISSUES

SANITARY SEWER NOTES

- SANITARY SEWER PIPE 8 INCHES AND LARGER SHALL BE PVC (POLYVINYL CHLORIDE) PLASTIC PIPE CONFORMING TO ASTM D-3034 OR ASTM F-679 STANDARDS.
- BAND-SEAL OR SIMILAR FLEXIBLE-TYPE COUPLINGS SHALL BE USED WHEN CONNECTING SEWER PIPES OF DISSIMILAR MATERIALS.
- ALL SANITARY SEWERS ARE TO BE CONSTRUCTED USING A LASER INSTRUMENT TO MAINTAIN LINE AND GRADE.
- MANHOLES: SANITARY SEWER MANHOLES SHALL BE 4-FOOT, 0-INCH I.D. PRECAST CONCRETE SECTIONS CONFORMING TO ASTM D-478, WITH PREFORMED BITUMINOUS
- OR "O" RING JOINTS, IN ACCORDANCE WITH LOCAL REGULATIONS, AND HAVE AN ECCENTRIC CONE INSTALLED TO LINE UP WITH THE MANHOLE STEPS ALL PIPE CONNECTION OPENINGS SHALL BE PRECAST WITH RESILIENT RUBBER WATER-TIGHT SLEEVES. THE BOTTOM OF THE MANHOLE SHALL HAVE A CONCRETE BENCH POURED TO FACILITATE SMOOTH FLOWS.
- FRAMES AND LIDS: ALL SANITARY SEWER MANHOLE FRAMES AND LIDS SHALL BE PER EL PASO COUNTY SPECIFICATIONS.
- A MAXIMUM OF EIGHT (8) INCHES OF CONCRETE-ADJUSTING RINGS SHALL BE USED TO ADJUST FRAME ELEVATIONS. RINGS SHALL BE SEALED TOGETHER WITH BUTYL ROPE.
- 10. CLEANING: ALL MANHOLES AND PIPES SHALL BE THOROUGHLY CLEANED OF DIRT AND DEBRIS, AND ALL VISIBLE LEAKAGE ELIMINATED, BEFORE FINAL INSPECTION AND ACCEPTANCE.
- 11. TESTING: DEFLECTION AND LEAKAGE TESTING WILL BE REQUIRED.
- 3 12. TESTING THE ALIGNMENT/STRAIGHTNESS SHALL BE IN ACCORDANCE WITH UTILITY PROVIDER, OR AUTHORITY HAVING JURISDICTION REQUIREMENTS.
- 13. TELEVISING: ALL SANITARY SEWERS SHALL BE TELEVISED, AND A COPY OF THE TAPE AND A WRITTEN REPORT SHALL BE SUBMITTED AND REVIEWED BY THE UTILITY PROVIDER, OR AUTHORITY HAVING JURISDICTION BEFORE FINAL ACCEPTANCE. THE REPORT SHALL INCLUDE STUB LOCATION AS WELL AS A DESCRIPTION OF ALL DEFECTS. WATER LEVEL, LEAKS, AND LENGTHS, IDENTIFY MANHOLE TO MANHOLE BOTH VERBALLY AND ON-SCREEN USING MANHOLE NUMBERS FROM APPROVED PLANS. ORDER OF WRITTEN REPORT SHALL BE THE SAME AS THE VIDEOTAPES.

14. TEST RESULTS: IF THE SANITARY SEWER INSTALLATION FAILS TO MEET THE TEST REQUIREMENTS SPECIFIED, THE CONTRACTOR SHALL DETERMINE THE CAUSE OR CAUSES OF THE DEFECT AND REPAIR, OR REPLACE ALL MATERIALS AND WORKMANSHIP, AS MAY BE NECESSARY TO COMPLY WITH THE TEST REQUIREMENTS.

RECORD DRAWINGS: THE CONTRACTOR SHALL PROVIDE ALL INFORMATION TO PREPARE RECORD DRAWING(S), INCLUDING SERVICE STUB LOCATIONS, TO THE ENGINEER, WHO SHALL PREPARE RECORD DRAWINGS AND SUBMIT TO APPROPRIATE PUBLIC AGENCIES. IF FINAL MEASUREMENTS INDICATE DEFICIENCIES, THE CONTRACTOR, AT HIS OWN COST, WILL ADJUST MANHOLES AND/OR SEWERS TO PROPER ELEVATIONS AND OTHERWISE CORRECT THE DEFICIENCIES.

16. ALL SANITARY SEWER CONSTRUCTION AND MATERIAL SHALL MEET UTILITY PROVIDER, OR AUTHORITY HAVING JURISDICTION STANDARDS AND SPECIFICATION. IF ANY DISCREPANCY IN THESE PLANS OCCUR. THE CONTRACTOR SHALL NOTIFY THE ENGINEER PRIOR TO PURCHASING ANY MATERIA

WATER NOTES:

- 5.

COVER IS 10-FEET.

SANITARY SEWER, OR SEWER SERVICES CONNECTION.

- B. VERTICAL SEPARATION

15. AL MATERIALS SHALL BE SUBJECT TO FULL SHOP DRAWING REVIEW AND APPROVAL BY THE CITY OF COLORADO SPRINGS WATER AND SEWER UTILITY. SEE UTILITY PLANS FOR ADDITIONAL NOTES. ALL UTILITIES MUST MEET CITY OF COLORADO SPRINGS STANDARDS.

PAVING NOTES

A. PAVING WORK INCLUDES FINAL SUBGRADE SHAPING, PREPARATION, AND COMPACTION; PLACEMENT OF SUBBASE OR BASE COURSE MATERIALS; BITUMINOUS BINDER AND/OR SURFACE COURSES; FORMING, FINISHING, AND CURING CONCRETE PAVEMENT, CURBS, AND WALKS; AND FINAL CLEAN-UP AND ALL RELATED WORK. B. COMPACTION REQUIREMENTS PER GEOTECHNICAL REQUIREMENTS AND LOCAL MUNICIPALITIES HAVING JURISDICTION OVER THE WORK.

SUBGRADE PREPARATIO

B. PRIOR TO THE PLACEMENT OF THE BASE COURSE, THE SUBGRADE MUST BE PROOF-ROLLED AND INSPECTED BY THE GEOTECHNICAL ENGINEER FOR UNSUITABLE MATERIALS AND/OR EXCESSIVE MOVEMENT. IF UNSUITABLE SUBGRADE IS ENCOUNTERED, IT SHALL BE CORRECTED. THIS MAY INCLUDE ONE OR MORE OF THE FOLLOWING METHODS:

(1) SCARIFY, DISC, AND AERATE.

(2) REMOVE AND REPLACE WITH STRUCTURAL CLAY FILL.

(3) REMOVE AND REPLACE WITH GRANULAR MATERIAL

(4) USE OF GEOTEXTILE FABRIC

CONCRETE WOR

B. CONCRETE CURB AND/OR COMBINATION CURB AND GUTTER SHALL BE OF THE TYPE SHOWN ON THE PLANS. THE CONTRACTOR IS CAUTIONED TO REFER TO THE CONSTRUCTION STANDARDS AND THE PAVEMENT CROSS SECTION TO DETERMINE THE GUTTER FLAG THICKNESS AND THE AGGREGATE BASE COURSE THICKNESS BENEATH THE CURB AND GUTTER. SAWED OR FORMED CONTRACTION JOINTS SHALL BE PROVIDED AT NO GREATER THAN TEN (10) FOOT INTERVALS BETWEEN EXPANSION JOINTS. NO HONEY-COMBING OF THE CURB AND GUTTER WILL BE ACCEPTED.

PROVIDING ACCESSIBILITY.

D. THE CURBS SHALL BE BACKFILLED AFTER THEIR CONSTRUCTION AND PRIOR TO THE PLACEMENT OF THE BASE COURSE.

F. CONCRETE CURING AND PROTECTION SHALL BE PROVIDED BY THE CONTRACTOR. G. THE COST OF AGGREGATE BASE OR SUBBASE UNDER CONCRETE WORK SHALL BE INCLUDED IN THE COST OF THE RESPECTIVE CONCRETE ITEM.

ENGINEER.

PIPE MATERIALS: WATERMAINS SHALL BE CONSTRUCTED OF PER GOVERNING AUTHORITY INSTALLATION, MATERIAL, AND SPECIFICATION STANDARDS.

FITTINGS: ALL FITTINGS SHALL BE OF PUSH ON BLUE BRUTE PVC FITTINGS AND MEET MUNICIPAL STANDARDS.

VALVES: GATE VALVES SHALL BE USED ON ALL WATERMAINS AND MUST MEET MUNICIPAL STANDARDS.

THE JOINTS AND ALL FASTENERS ON THE VALVE BODY SHALL HAVE STAINLESS STEEL NUTS AND BOLTS.

FIRE HYDRANTS: FIRE HYDRANTS SHALL CONFORM TO AMERICAN WATER WORKS ASSOCIATION (AWWA) STANDARD C-502, LATEST REVISION, AND SHALL MEET THE STANDARDS SET BY THE UTILITY OR MUNICIPALITY HAVING JURISDICTION. FIRE HYDRANTS SHALL BE INSTALLED WITH AN AUXILIARY VALVE AND CAST IRON VALVE BOX. THE PUMPER CONNECTION SHALL FACE THE ROADWAY. 6.5' STANDARD BURY DEPTH.PROVIDE AND INSTALL FULL RESTRAINT FROM MAIN TO THE HYDRANT.THE SHAFT BREAK FLANGE AND ALL BELOW-GRADE FITTING SHALL HAVE STAINLESS STEEL NUTS AND BOLTS.

SERVICE BOX: PROVIDE CURB VALVE AND CURB BOX, AS INDICATED ON THE PLANS. BOX SHALL BE EXTENSION TYPE WITH MINNEAPOLIS PATTERN.

WATER MAIN DEFLECTIONS WILL GENERALLY NOT BE ALLOWED. HOWEVER, IF A MINOR DEFLECTION IS NECESSARY, THE MAXIMUM DEFLECTION AT PIPE JOINTS SHALL BE IN ACCORDANCE WITH PIPE MANUFACTURER'S CURRENT RECOMMENDATIONS AND AWWA SPECIFICATIONS

BEDDING: ALL WATERMAINS SHALL BE BEDDED ON FIRM GROUND, WITH BELLHOLES EXCAVATED SO THAT THE PIPE HAS AN EVEN BEDDING FOR ITS ENTIRE LENGTH. SAND SHALL BE CAREFULLY PLACED TO TWELVE (12) INCHES OVER THE TOP OF THE PIPE BEFORE FINAL BACKFILLING AND COMPACTION.

10. A MINIMUM DEPTH OF COVER OF 4.5-FEET UNDER PAVEMENT AND 6-FEET IN OPEN SPACES SHALL BE MAINTAINED OVER THE WATER LINES. MAXIMUM ALLOWABLE

CONCRETE THRUST BLOCKING SHALL BE POURED ON WATERMAINS AT ALL BENDS, TEES, ELBOWS, ETC. RESTRAINED JOINTS ARE REQUIRED ON ALL VALVES AND ALL FITTINGS AND ACCORDING TO RESTRAINT TABLE.

SUPPORT THE SEWER OR DRAIN LINES TO PREVENT SETTLING AND BREAKING THE WATERMAIN.

13. ALL WATER CONSTRUCTION AND MATERIAL SHALL MEET LOCAL MUNICIPAL STANDARDS AND SPECIFICATION. IF ANY DISCREPANCY IN THESE PLANS OCCUR, THE CONTRACTOR SHALL NOTIFY THE ENGINEER PRIOR TO PURCHASING ANY MATERIAL

HORIZONTAL SEPARATION-WATER MAINS SHALL BE LAID AT LEAST TEN (10) FEET HORIZONTALLY FROM ANY EXISTING OR PROPOSED DRAIN, STORM SEWER,

(1) IF A WATERMAIN CROSSES OVER A SANITARY OR STORM SEWER MAIN, THE WATERMAIN SHALL BE LAID SO THAT THE BOTTOM OF THE WATERMAIN IS AT LEAST EIGHTEEN (18) INCHES ABOVE THE TOP OF THE SEWER MAIN.

IF THE WATERMAIN CROSSES UNDER A SANITARY OR STORM SEWER MAIN, THE WATERMAIN SHALL BE LAID SO THAT THE TOP OF THE WATERMAIN IS AT LEAST EIGHTEEN (18) INCHES BELOW THE BOTTOM OF THE SEWER.

WHENEVER WATERMAINS CROSS STORM SEWERS, SANITARY SEWERS, OR SEWER SERVICE CONNECTIONS, THE VERTICAL SEPARATION SHALL BE MAINTAINED FOR THAT PORTION OF THE WATERMAIN LOCATED WITHIN EIGHT (8) FEET HORIZONTALLY OF ANY SEWER OR DRAIN CROSSED. A LENGTH OF WATERMAIN PIPE SHALL BE CENTERED OVER THE SEWER TO BE CROSSED WITH JOINTS EQUIDISTANT FROM THE SEWER OR DRAIN.

(4) BOTH THE WATERMAINS AND SEWER SHALL BE CONSTRUCTED WITH PIPE EQUIVALENT TO WATERMAIN STANDARDS OF CONSTRUCTION WHEN:

IT IS IMPOSSIBLE TO OBTAIN THE PROPER VERTICAL SEPARATION, AS DESCRIBED IN (B) ABOVE

C. IT SHALL BE THE CONTRACTOR'S SOLE RESPONSIBILITY TO PROVIDE PROPER BARRICADING WARNING DEVICES, AND THE SAFE MANAGEMENT OF TRAFFIC WITHIN THE AREA OF CONSTRUCTION. ALL SUCH DEVICES AND THEIR INSTALLATION SHALL CONFORM TO THE MANUAL OF UNIFORM TRAFFIC CONTROL DEVICES (MUCTD), LATEST EDITION, AND IN ACCORDANCE WITH EL PASO COUNTY CODE.

A. EARTHWORK FOR PROPOSED PAVEMENT SUBGRADE SHALL BE FINISHED TO WITHIN 0.1 FOOT, PLUS OR MINUS, OF PLAN ELEVATION. THE CONTRACTOR SHALL SATISFY THAT THE SUBGRADE HAS BEEN PROPERLY PREPARED AND THAT THE FINISH TOP SUBGRADE ELEVATION HAS BEEN GRADED WITHIN TOLERANCES ALLOWED IN THESE SPECIFICATIONS, UNLESS THE CONTRACTOR ADVISES THE ENGINEER IN WRITING PRIOR TO FINE GRADING FOR BASE COURSE CONSTRUCTION.

C. PRIOR TO THE CONSTRUCTION OF THE CURB AND GUTTER AND THE PLACEMENT OF THE BASE MATERIAL. THE PAVEMENT AREA SHALL BE FINE-GRADED TO WITHIN 0.04 FEET (1/2 INCH) OF FINAL SUBGRADE ELEVATION, TO A POINT TWO (2) FEET BEYOND THE BACK OF THE CURB, SO AS TO ENSURE THE PROPER THICKNESS OF PAVEMENT COURSES. NO CLAIMS FOR EXCESS QUANTITY OF BASE MATERIALS DUE TO IMPROPER SUBGRADE PREPARATION WILL BE HONORED.

D. PRIOR TO PLACEMENT OF THE BASE COURSE, THE SUBGRADE MUST BE APPROVED BY THE GEOTECHNICAL ENGINEER

A. ALL EXTERIOR CONCRETE SHALL MEET LOCAL MUNICIPAL STATE, OR OWNER REQUIREMENTS PER THE JURISDICTION HAVING AUTHORITY OVER THE WORK. IF NO SPECIFICATIONS ARE AVAILABLE, THE STATE DEPARTMENT OF TRANSPORTATION REQUIREMENTS SHALL PREVAIL. IF REQUIREMENTS CONFLICT WITH EACH OTHER, THE AUTHORITY HAVING JURISDICTION OVER THE WORK SHALL COMPLY, OTHERWISE FOLLOW THE MORE RESTRICTIVE.

C. CURBS SHALL BE DEPRESSED AT LOCATIONS WHERE PEDESTRIAN WALKS INTERSECT CURB LINES AND OTHER LOCATIONS, AS DIRECTED, FOR THE PURPOSE OF

E. CONCRETE SIDEWALK SHALL BE IN ACCORDANCE WITH THE ABOVE AND THE PLANS. PROVIDE SCORED JOINTS AT 5-FOOT INTERVALS AND 1/2-INCH PRE-MOLDED FIBER EXPANSION JOINTS AT 50-FOOT INTERVALS AND ADJACENT TO CONCRETE CURBS, DRIVEWAYS, FOUNDATIONS, ETC.

A. PRIOR TO PLACEMENT OF THE SURFACE COURSE, THE BINDER COURSE SHALL BE CLEANED AND TACK-COATED IF DUSTY OR DIRTY. ALL DAMAGED AREAS IN THE BINDER, BASE, OR CURB SHALL BE REPAIRED TO THE SATISFACTION OF THE OWNER PRIOR TO LAYING THE SURFACE COURSE. THE CONTRACTOR SHALL PROVIDE WHATEVER EQUIPMENT AND STAFF NECESSARY, INCLUDING THE USE OF POWER BROOMS IF REQUIRED BY THE OWNER, TO PREPARE THE PAVEMENT FOR APPLICATION OF THE SURFACE COURSE. THE TACK COAT SHALL BE UNIFORMLY APPLIED TO THE BINDER COURSE AT A RATE OF 0.05 TO 0.10 GALLONS PER SQUARE YARD. TACK COAT SHALL BE AS PER DOT AND/OR LOCAL MUNICIPAL SPECIFICATIONS.

5. TESTING AND FINAL ACCEPTANCE A. THE CONTRACTOR SHALL FOLLOW THE QUALITY CONTROL TESTING PROGRAM FOR CONCRETE AND PAVEMENT MATERIALS ESTABLISHED BY THE GEOTECHINCAL

B. FINAL ACCEPTANCE OF THE TOTAL PAVEMENT INSTALLATION SHALL BE SUBJECT TO THE TESTING AND CHECKING REQUIREMENTS CITED ABOVE.

GRADING AND EROSION CONTROL NOTES:

- WATERS. ALL WORK AND EARTH DISTURBANCE SHALL BE DONE IN A MANNER THAT MINIMIZES POLLUTION OF ANY ON-SITE OR OFF-SITE WATERS, INCLUDING WETLANDS
- SHALL BE KEPT UP TO DATE WITH WORK PROGRESS AND CHANGES IN THE FIELD.
- 4. ONCE THE ESQCP IS APPROVED AND A "NOTICE TO PROCEED" HAS BEEN ISSUED, THE CONTRACTOR MAY INSTALL THE INITIAL STAGE EROSION AND SEDIMENT
- FOR ALL SLOPES, CHANNELS, DITCHES, AND DISTURBED LAND AREAS SHALL BE INSTALLED IMMEDIATELY UPON COMPLETION OF THE DISTURBANCE.
- THE STORMWATER MANAGEMENT PLAN.
- PERMANENTLY CEASED OR TEMPORARILY CEASED FOR LONGER THAN 14 DAYS.
- MEASURES SHALL BE REMOVED UPON FINAL STABILIZATION AND BEFORE PERMIT CLOSURE.
- UNLESS SHOWN TO BE INFEASIBLE AND SPECIFICALLY REQUESTED AND APPROVED. VEGETATION CONTROL MEASURES MUST BE LOOSENED PRIOR TO INSTALLATION OF THE CONTROL MEASURE(S).
- DISTURBANCE AREA SHALL BE A STABILIZED CONVEYANCE DESIGNED TO MINIMIZE EROSION AND THE DISCHARGE OF SEDIMENT OFF-SITE.
- AREA WHERE SHALLOW GROUNDWATER MAY BE PRESENT, OR WITHIN 50 FEET OF A SURFACE WATER BODY, CREEK OR STREAM.
- RUNOFF UNLESS AN APPROVED STATE DEWATERING PERMIT IS IN PLACE. 15. EROSION CONTROL BLANKETING OR OTHER PROTECTIVE COVERING SHALL BE USED ON SLOPES STEEPER THAN 3:1.
- OR DISCHARGED AT THE SITE.
- CIRCUMSTANCES.
- IMMEDIATELY.
- MANUFACTURER'S LABELS.
- MONITORING MAY BE REQUIRED.
- SUBSURFACE STORM DRAINAGE SYSTEM OR OTHER FACILITIES.
- OR REGULATIONS SHALL APPLY.

5. ALL CONSTRUCTION TRAFFIC MUST ENTER/EXIT THE SITE ONLY AT APPROVED CONSTRUCTION ACCESS POINTS. 26. PRIOR TO CONSTRUCTION THE PERMITTEE SHALL VERIFY THE LOCATION OF EXISTING UTILITIES.

27. A WATER SOURCE SHALL BE AVAILABLE ON-SITE DURING EARTHWORK OPERATIONS AND SHALL BE UTILIZED AS REQUIRED TO MINIMIZE DUST FROM EARTHWORK EQUIPMENT AND WIND.

28. THE SOILS REPORT FOR THIS SITE HAS BEEN PREPARED BY [COMPANY NAME, DATE OF REPORT] AND SHALL BE CONSIDERED A PART OF THESE PLANS. 29. AT LEAST TEN (10) DAYS PRIOR TO THE ANTICIPATED START OF CONSTRUCTION, FOR PROJECTS THAT WILL DISTURB ONE (1) ACRE OR MORE, THE OWNER OR OPERATOR OF CONSTRUCTION ACTIVITY SHALL SUBMIT A PERMIT APPLICATION FOR STORMWATER DISCHARGE TO THE COLORADO DEPARTMENT OF PUBLIC HEALTH AND ENVIRONMENT, WATER QUALITY DIVISION. THE APPLICATION CONTAINS CERTIFICATION OF COMPLETION OF A STORMWATER MANAGEMENT PLAN (SWMP), OF WHICH THIS GRADING AND EROSION CONTROL PLAN MAY BE A PART. FOR INFORMATION OR APPLICATION MATERIALS CONTACT:

COLORADO DEPARTMENT OF PUBLIC HEALTH AND ENVIRONMENT WATER QUALITY CONTROL DIVISION WQCD - PERMITS

4300 CHERRY CREEK DRIVE SOUTH DENVER, CO 80246-1530

ATTN: PERMITS UNIT

1. STORMWATER DISCHARGES FROM CONSTRUCTION SITES SHALL NOT CAUSE OR THREATEN TO CAUSE POLLUTION, CONTAMINATION, OR DEGRADATION OF STATE

2. NOTWITHSTANDING ANYTHING DEPICTED IN THESE PLANS IN WORDS OR GRAPHIC REPRESENTATION, ALL DESIGN AND CONSTRUCTION RELATED TO ROADS, STORM DRAINAGE AND EROSION CONTROL SHALL CONFORM TO THE STANDARDS AND REQUIREMENTS OF THE MOST RECENT VERSION OF THE RELEVANT ADOPTED EL PASO COUNTY STANDARDS, INCLUDING THE LAND DEVELOPMENT CODE, THE ENGINEERING CRITERIA MANUAL, THE DRAINAGE CRITERIA MANUAL, AND THE DRAINAGE CRITERIA MANUAL VOLUME 2. ANY DEVIATIONS FROM REGULATIONS AND STANDARDS MUST BE REQUESTED, AND APPROVED, IN WRITING.

3. A SEPARATE STORMWATER MANAGEMENT PLAN (SMWP) FOR THIS PROJECT SHALL BE COMPLETED AND AN EROSION AND STORMWATER QUALITY CONTROL PERMIT (ESQCP) ISSUED PRIOR TO COMMENCING CONSTRUCTION. MANAGEMENT OF THE SWMP DURING CONSTRUCTION IS THE RESPONSIBILITY OF THE DESIGNATED QUALIFIED STORMWATER MANAGER OR CERTIFIED EROSION CONTROL INSPECTOR. THE SWMP SHALL BE LOCATED ON-SITE AT ALL TIMES DURING CONSTRUCTION AND

CONTROL MEASURES AS INDICATED ON THE APPROVED GEC. A PRECONSTRUCTION MEETING BETWEEN THE CONTRACTOR, ENGINEER, AND EL PASO COUNTY WILL BE HELD PRIOR TO ANY CONSTRUCTION. IT IS THE RESPONSIBILITY OF THE APPLICANT TO COORDINATE THE MEETING TIME AND PLACE WITH COUNTY STAFF. 5. CONTROL MEASURES MUST BE INSTALLED PRIOR TO COMMENCEMENT OF ACTIVITIES THAT COULD CONTRIBUTE POLLUTANTS TO STORMWATER. CONTROL MEASURES

6. ALL TEMPORARY SEDIMENT AND EROSION CONTROL MEASURES SHALL BE MAINTAINED AND REMAIN IN EFFECTIVE OPERATING CONDITION UNTIL PERMANENT SOIL EROSION CONTROL MEASURES ARE IMPLEMENTED AND FINAL STABILIZATION IS ESTABLISHED. ALL PERSONS ENGAGED IN LAND DISTURBANCE ACTIVITIES SHALL ASSESS THE ADEQUACY OF CONTROL MEASURES AT THE SITE AND IDENTIFY IF CHANGES TO THOSE CONTROL MEASURES ARE NEEDED TO ENSURE THE CONTINUED EFFECTIVE PERFORMANCE OF THE CONTROL MEASURES. ALL CHANGES TO TEMPORARY SEDIMENT AND EROSION CONTROL MEASURES MUST BE INCORPORATED INTO

7. TEMPORARY STABILIZATION SHALL BE IMPLEMENTED ON DISTURBED AREAS AND STOCKPILES WHERE GROUND DISTURBING CONSTRUCTION ACTIVITY HAS

8. FINAL STABILIZATION MUST BE IMPLEMENTED AT ALL APPLICABLE CONSTRUCTION SITES. FINAL STABILIZATION IS ACHIEVED WHEN ALL GROUND DISTURBING ACTIVITIES ARE COMPLETE AND ALL DISTURBED AREAS EITHER HAVE A UNIFORM VEGETATIVE COVER WITH INDIVIDUAL PLANT DENSITY OF 70 PERCENT OF PRE-DISTURBANCE LEVELS ESTABLISHED OR EQUIVALENT PERMANENT ALTERNATIVE STABILIZATION METHOD IS IMPLEMENTED. ALL TEMPORARY SEDIMENT AND EROSION CONTROL

9. ALL PERMANENT STORMWATER MANAGEMENT FACILITIES SHALL BE INSTALLED AS DESIGNED IN THE APPROVED PLANS. ANY PROPOSED CHANGES THAT EFFECT THE DESIGN OR FUNCTION OF PERMANENT STORMWATER MANAGEMENT STRUCTURES MUST BE APPROVED BY THE ECM ADMINISTRATOR PRIOR TO IMPLEMENTATION. 10. EARTH DISTURBANCES SHALL BE CONDUCTED IN SUCH A MANNER SO AS TO EFFECTIVELY MINIMIZE ACCELERATED SOIL EROSION AND RESULTING SEDIMENTATION. ALL DISTURBANCES SHALL BE DESIGNED, CONSTRUCTED, AND COMPLETED SO THAT THE EXPOSED AREA OF ANY DISTURBED LAND SHALL BE LIMITED TO THE SHORTEST PRACTICAL PERIOD OF TIME. PRE-EXISTING VEGETATION SHALL BE PROTECTED AND MAINTAINED WITHIN 50 HORIZONTAL FEET OF A WATERS OF THE STATE

11. COMPACTION OF SOIL MUST BE PREVENTED IN AREAS DESIGNATED FOR INFILTRATION CONTROL MEASURES OR WHERE FINAL STABILIZATION WILL BE ACHIEVED BY VEGETATIVE COVER. AREAS DESIGNATED FOR INFILTRATION CONTROL MEASURES SHALL ALSO BE PROTECTED FROM SEDIMENTATION DURING CONSTRUCTION UNTIL FINAL STABILIZATION IS ACHIEVED. IF COMPACTION PREVENTION IS NOT FEASIBLE DUE TO SITE CONSTRAINTS, ALL AREAS DESIGNATED FOR INFILTRATION AND

12. ANY TEMPORARY OR PERMANENT FACILITY DESIGNED AND CONSTRUCTED FOR THE CONVEYANCE OF STORMWATER AROUND, THROUGH, OR FROM THE EARTH

13. CONCRETE WASH WATER SHALL BE CONTAINED AND DISPOSED OF IN ACCORDANCE WITH THE SWMP. NO WASH WATER SHALL BE DISCHARGED TO OR ALLOWED TO ENTER STATE WATERS, INCLUDING ANY SURFACE OR SUBSURFACE STORM DRAINAGE SYSTEM OR FACILITIES. CONCRETE WASHOUTS SHALL NOT BE LOCATED IN AN

14. DURING DEWATERING OPERATIONS, UNCONTAMINATED GROUNDWATER MAY BE DISCHARGED ON-SITE, BUT SHALL NOT LEAVE THE SITE IN THE FORM OF SURFACE

16. CONTRACTOR SHALL BE RESPONSIBLE FOR THE REMOVAL OF ALL WASTES FROM THE CONSTRUCTION SITE FOR DISPOSAL IN ACCORDANCE WITH LOCAL AND STATE REGULATORY REQUIREMENTS. NO CONSTRUCTION DEBRIS, TREE SLASH, BUILDING MATERIAL WASTES OR UNUSED BUILDING MATERIALS SHALL BE BURIED, DUMPED,

17. WASTE MATERIALS SHALL NOT BE TEMPORARILY PLACED OR STORED IN THE STREET, ALLEY, OR OTHER PUBLIC WAY, UNLESS IN ACCORDANCE WITH AN APPROVED TRAFFIC CONTROL PLAN. CONTROL MEASURES MAY BE REQUIRED BY EL PASO COUNTY ENGINEERING IF DEEMED NECESSARY, BASED ON SPECIFIC CONDITIONS AND

18. TRACKING OF SOILS AND CONSTRUCTION DEBRIS OFF-SITE SHALL BE MINIMIZED. MATERIALS TRACKED OFF-SITE SHALL BE CLEANED UP AND PROPERLY DISPOSED OF


19. THE OWNER/DEVELOPER SHALL BE RESPONSIBLE FOR THE REMOVAL OF ALL CONSTRUCTION DEBRIS, DIRT, TRASH, ROCK, SEDIMENT, SOIL, AND SAND THAT MAY ACCUMULATE IN ROADS, STORM DRAINS AND OTHER DRAINAGE CONVEYANCE SYSTEMS AND STORMWATER APPURTENANCES AS A RESULT OF SITE DEVELOPMENT. 20. THE QUANTITY OF MATERIALS STORED ON THE PROJECT SITE SHALL BE LIMITED, AS MUCH AS PRACTICAL, TO THAT QUANTITY REQUIRED TO PERFORM THE WORK IN AN ORDERLY SEQUENCE. ALL MATERIALS STORED ON-SITE SHALL BE STORED IN A NEAT, ORDERLY MANNER, IN THEIR ORIGINAL CONTAINERS, WITH ORIGINAL

21. NO CHEMICAL(S) HAVING THE POTENTIAL TO BE RELEASED IN STORMWATER ARE TO BE STORED OR USED ON-SITE UNLESS PERMISSION FOR THE USE OF SUCH CHEMICAL(S) IS GRANTED IN WRITING BY THE ECM ADMINISTRATOR. IN GRANTING APPROVAL FOR THE USE OF SUCH CHEMICAL(S), SPECIAL CONDITIONS AND

22. BULK STORAGE OF ALLOWED PETROLEUM PRODUCTS OR OTHER ALLOWED LIQUID CHEMICALS IN EXCESS OF 55 GALLONS SHALL REQUIRE ADEQUATE SECONDARY CONTAINMENT PROTECTION TO CONTAIN ALL SPILLS ON-SITE AND TO PREVENT ANY SPILLED MATERIALS FROM ENTERING STATE WATERS, ANY SURFACE OR


23. NO PERSON SHALL CAUSE THE IMPEDIMENT OF STORMWATER FLOW IN THE CURB AND GUTTER OR DITCH EXCEPT WITH APPROVED SEDIMENT CONTROL MEASURES. 24. OWNER/DEVELOPER AND THEIR AGENTS SHALL COMPLY WITH THE "COLORADO WATER QUALITY CONTROL ACT" (TITLE 25, ARTICLE 8, CRS), AND THE "CLEAN WATER ACT" (33 USC 1344), IN ADDITION TO THE REQUIREMENTS OF THE LAND DEVELOPMENT CODE, DCM VOLUME II AND THE ECM APPENDIX I. ALL APPROPRIATE PERMITS MUST BE OBTAINED BY THE CONTRACTOR PRIOR TO CONSTRUCTION (1041, NPDES, FLOODPLAIN, 404, FUGITIVE DUST, ETC.). IN THE EVENT OF CONFLICTS BETWEEN THESE REQUIREMENTS AND OTHER LAWS, RULES, OR REGULATIONS OF OTHER FEDERAL, STATE, LOCAL, OR COUNTY AGENCIES, THE MOST RESTRICTIVE LAWS, RULES,

Revision Date SUPERSTAR CARWASH Revision MEADOWBROOK PKWY RESUBMITTAL MEADOWBROOK PKWY 9/18/23 COLORADO SPRING, CO 80915 9/18/23 GENERAL NOTES 9/18/23	FC 80 26	JILD DRT 052 52.5 ww.	INC CC 5 522	2 ک کلل 49.	2, S INS 201	UIT 6, C	0	00	
	DATE	9/18/23					5		
SUPERSTAR CARWASH MEADOWBROOK PKWY COLORADO SPRING, CO 80915 GENERAL NOTES	REVISION	RESUBMITTAL							
		SUPERSIAR CARWASH	MEADOW/BROOK DK/MV		COLORADO SPRING, CO 80915				

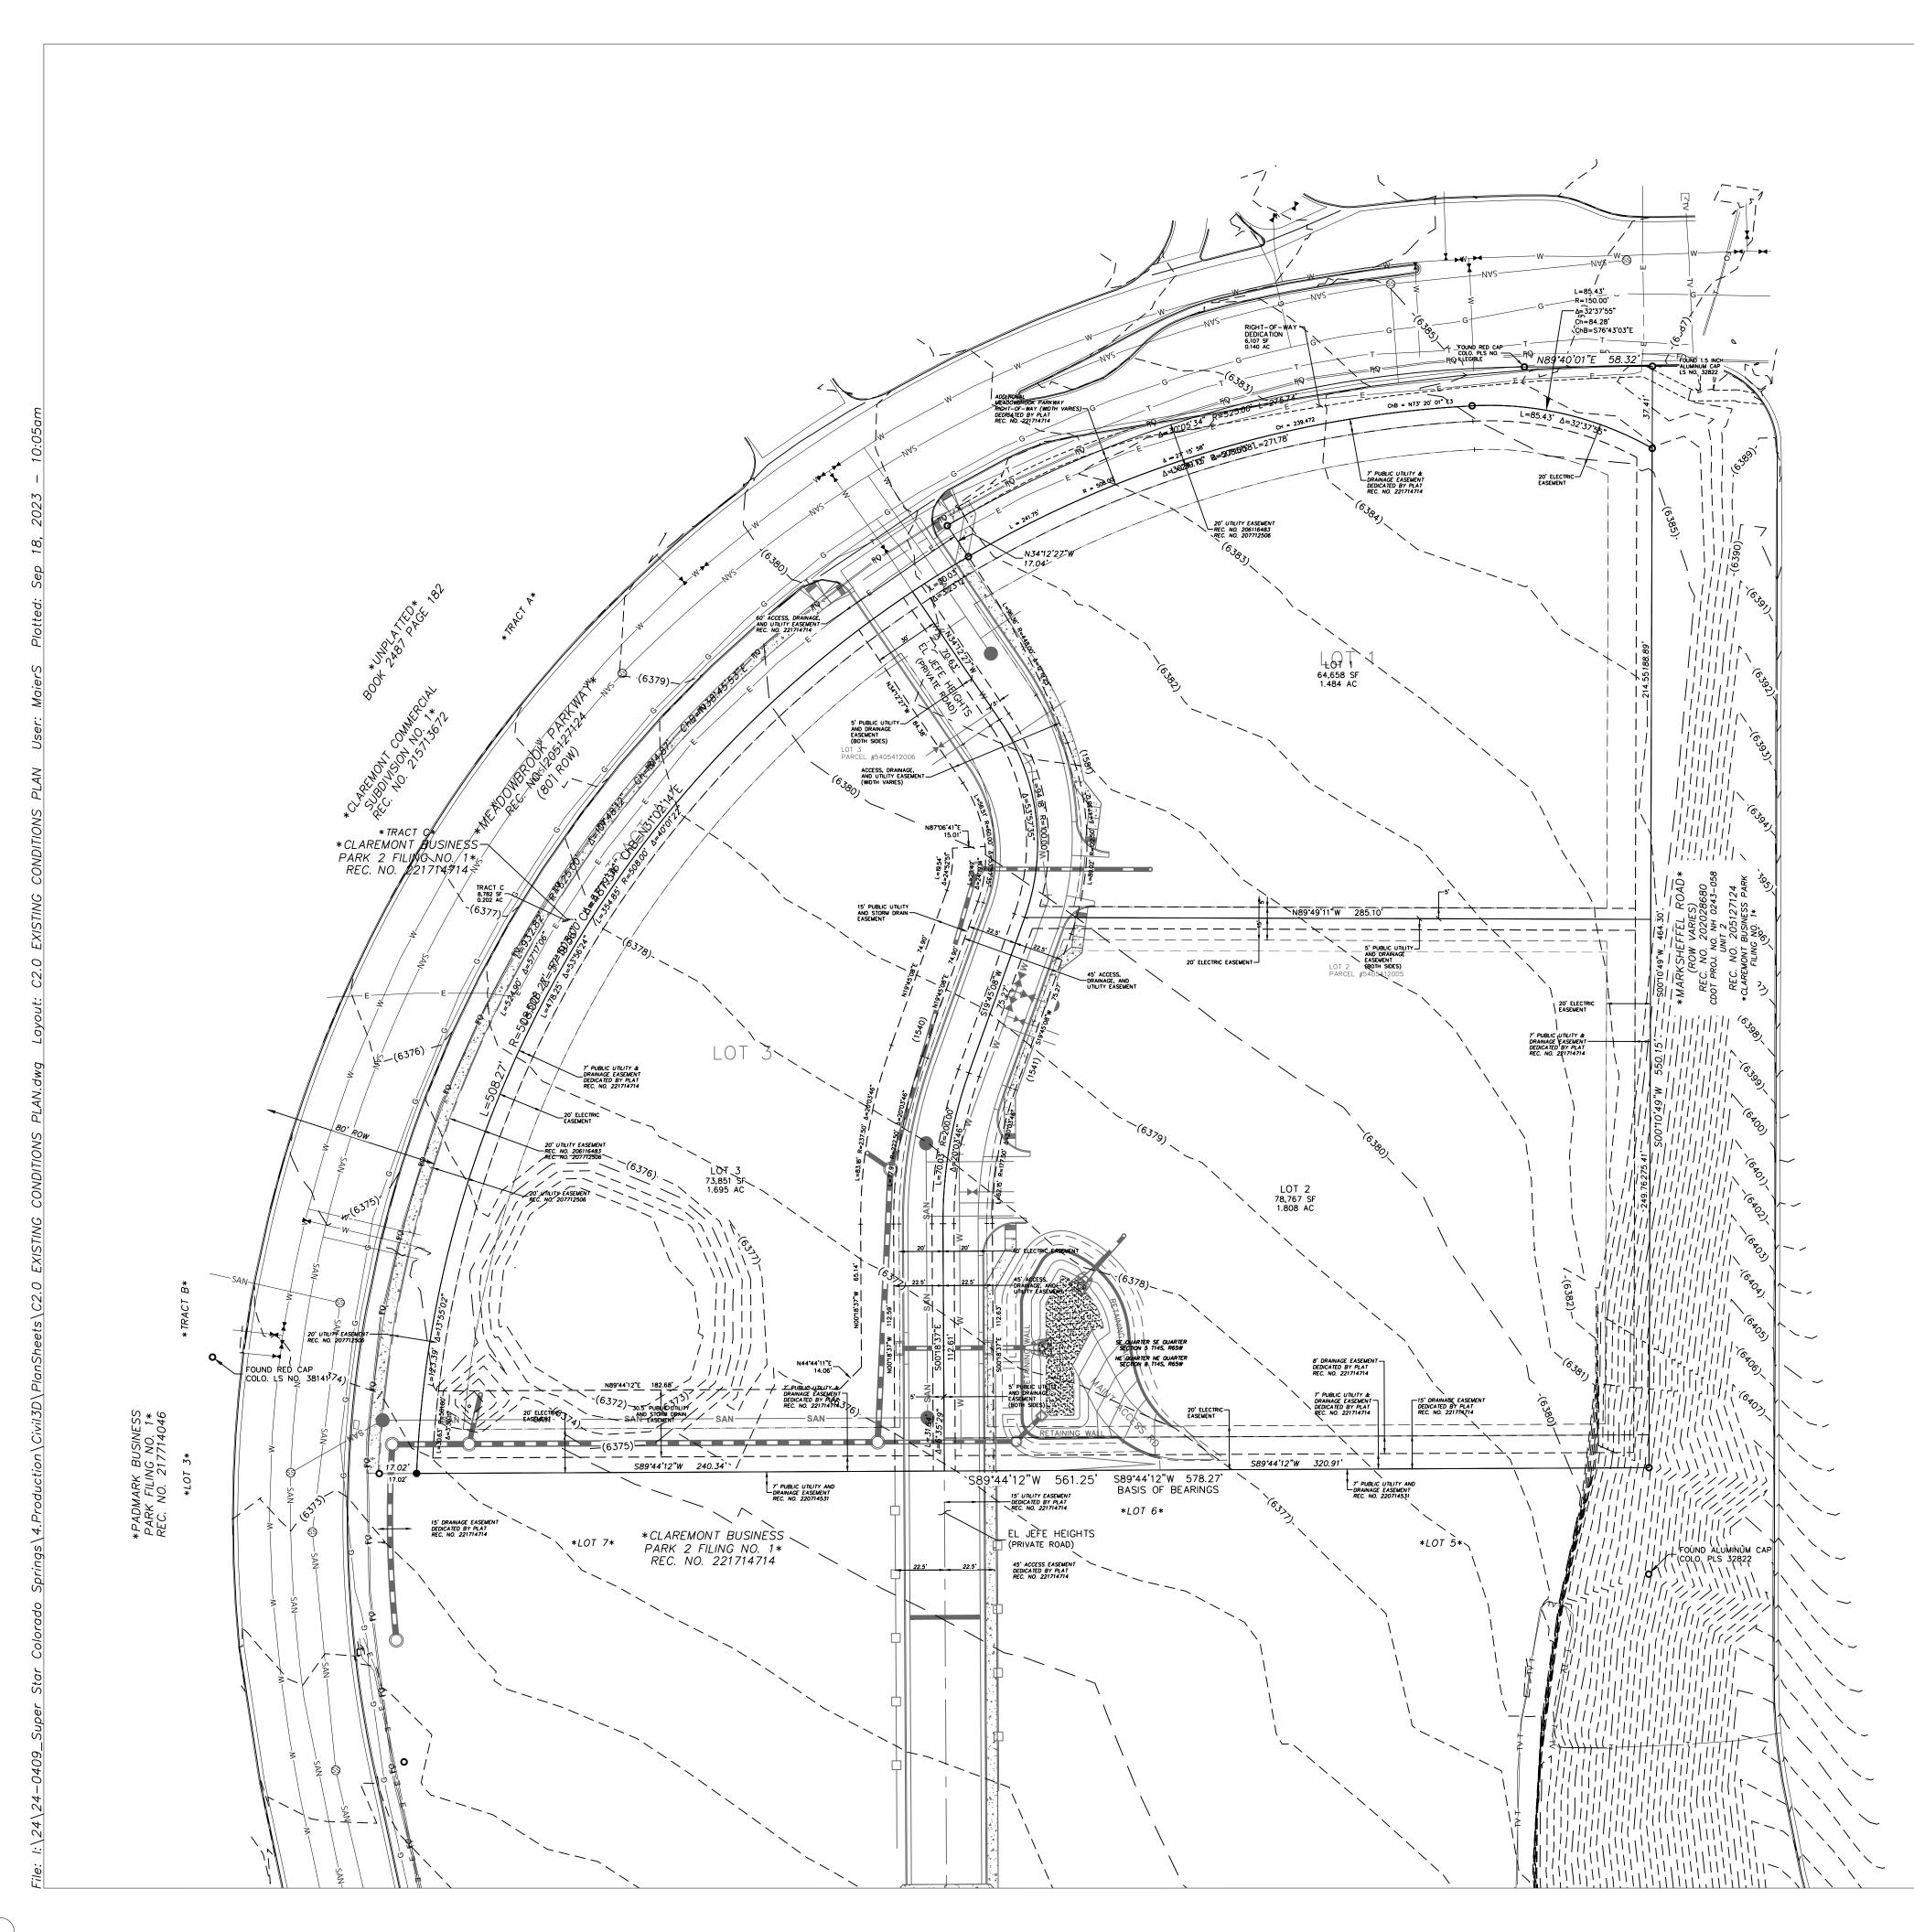

SURVEY PROVIDED BY: MS CIVIL CONSULTANTS, INC PROPERTY BOUNDARIES, EASEM ARE CURRENTLY UNDER DESIGN MAY BE SUBJECT TO CHANGES

		ASSOCIATES 3665 JFK PARKWAY BUILDING 2, SUITE 100 FORT COLLINS, CO 80525 262.522.4901 www.AyresAssociates.co
LEGEND		REVISION RESUBMITTAL
DMH SANITARY MAN DMH STORM SEWER ■ INLET CATCH BASIN 2WV WATER VALVE 2 GV GAS VALVE GV GAS VALVE FIRE HYDRANT WELL WELL DOGUY GUY ANCHOR 	MANHOLE Image: Constraint of the sector	SUPERSTAR CARWASH MEADOWBROOK PKWY COLORADO SPRING, CO 80915 EXISTING CONDITIONS
IENTS, AND UTILITIES I BY MS CIVIL CONSU	6	Drawn By: AJ Checked By: SEN Date: 06/23/202 Project No. 24-040 Sheet Number

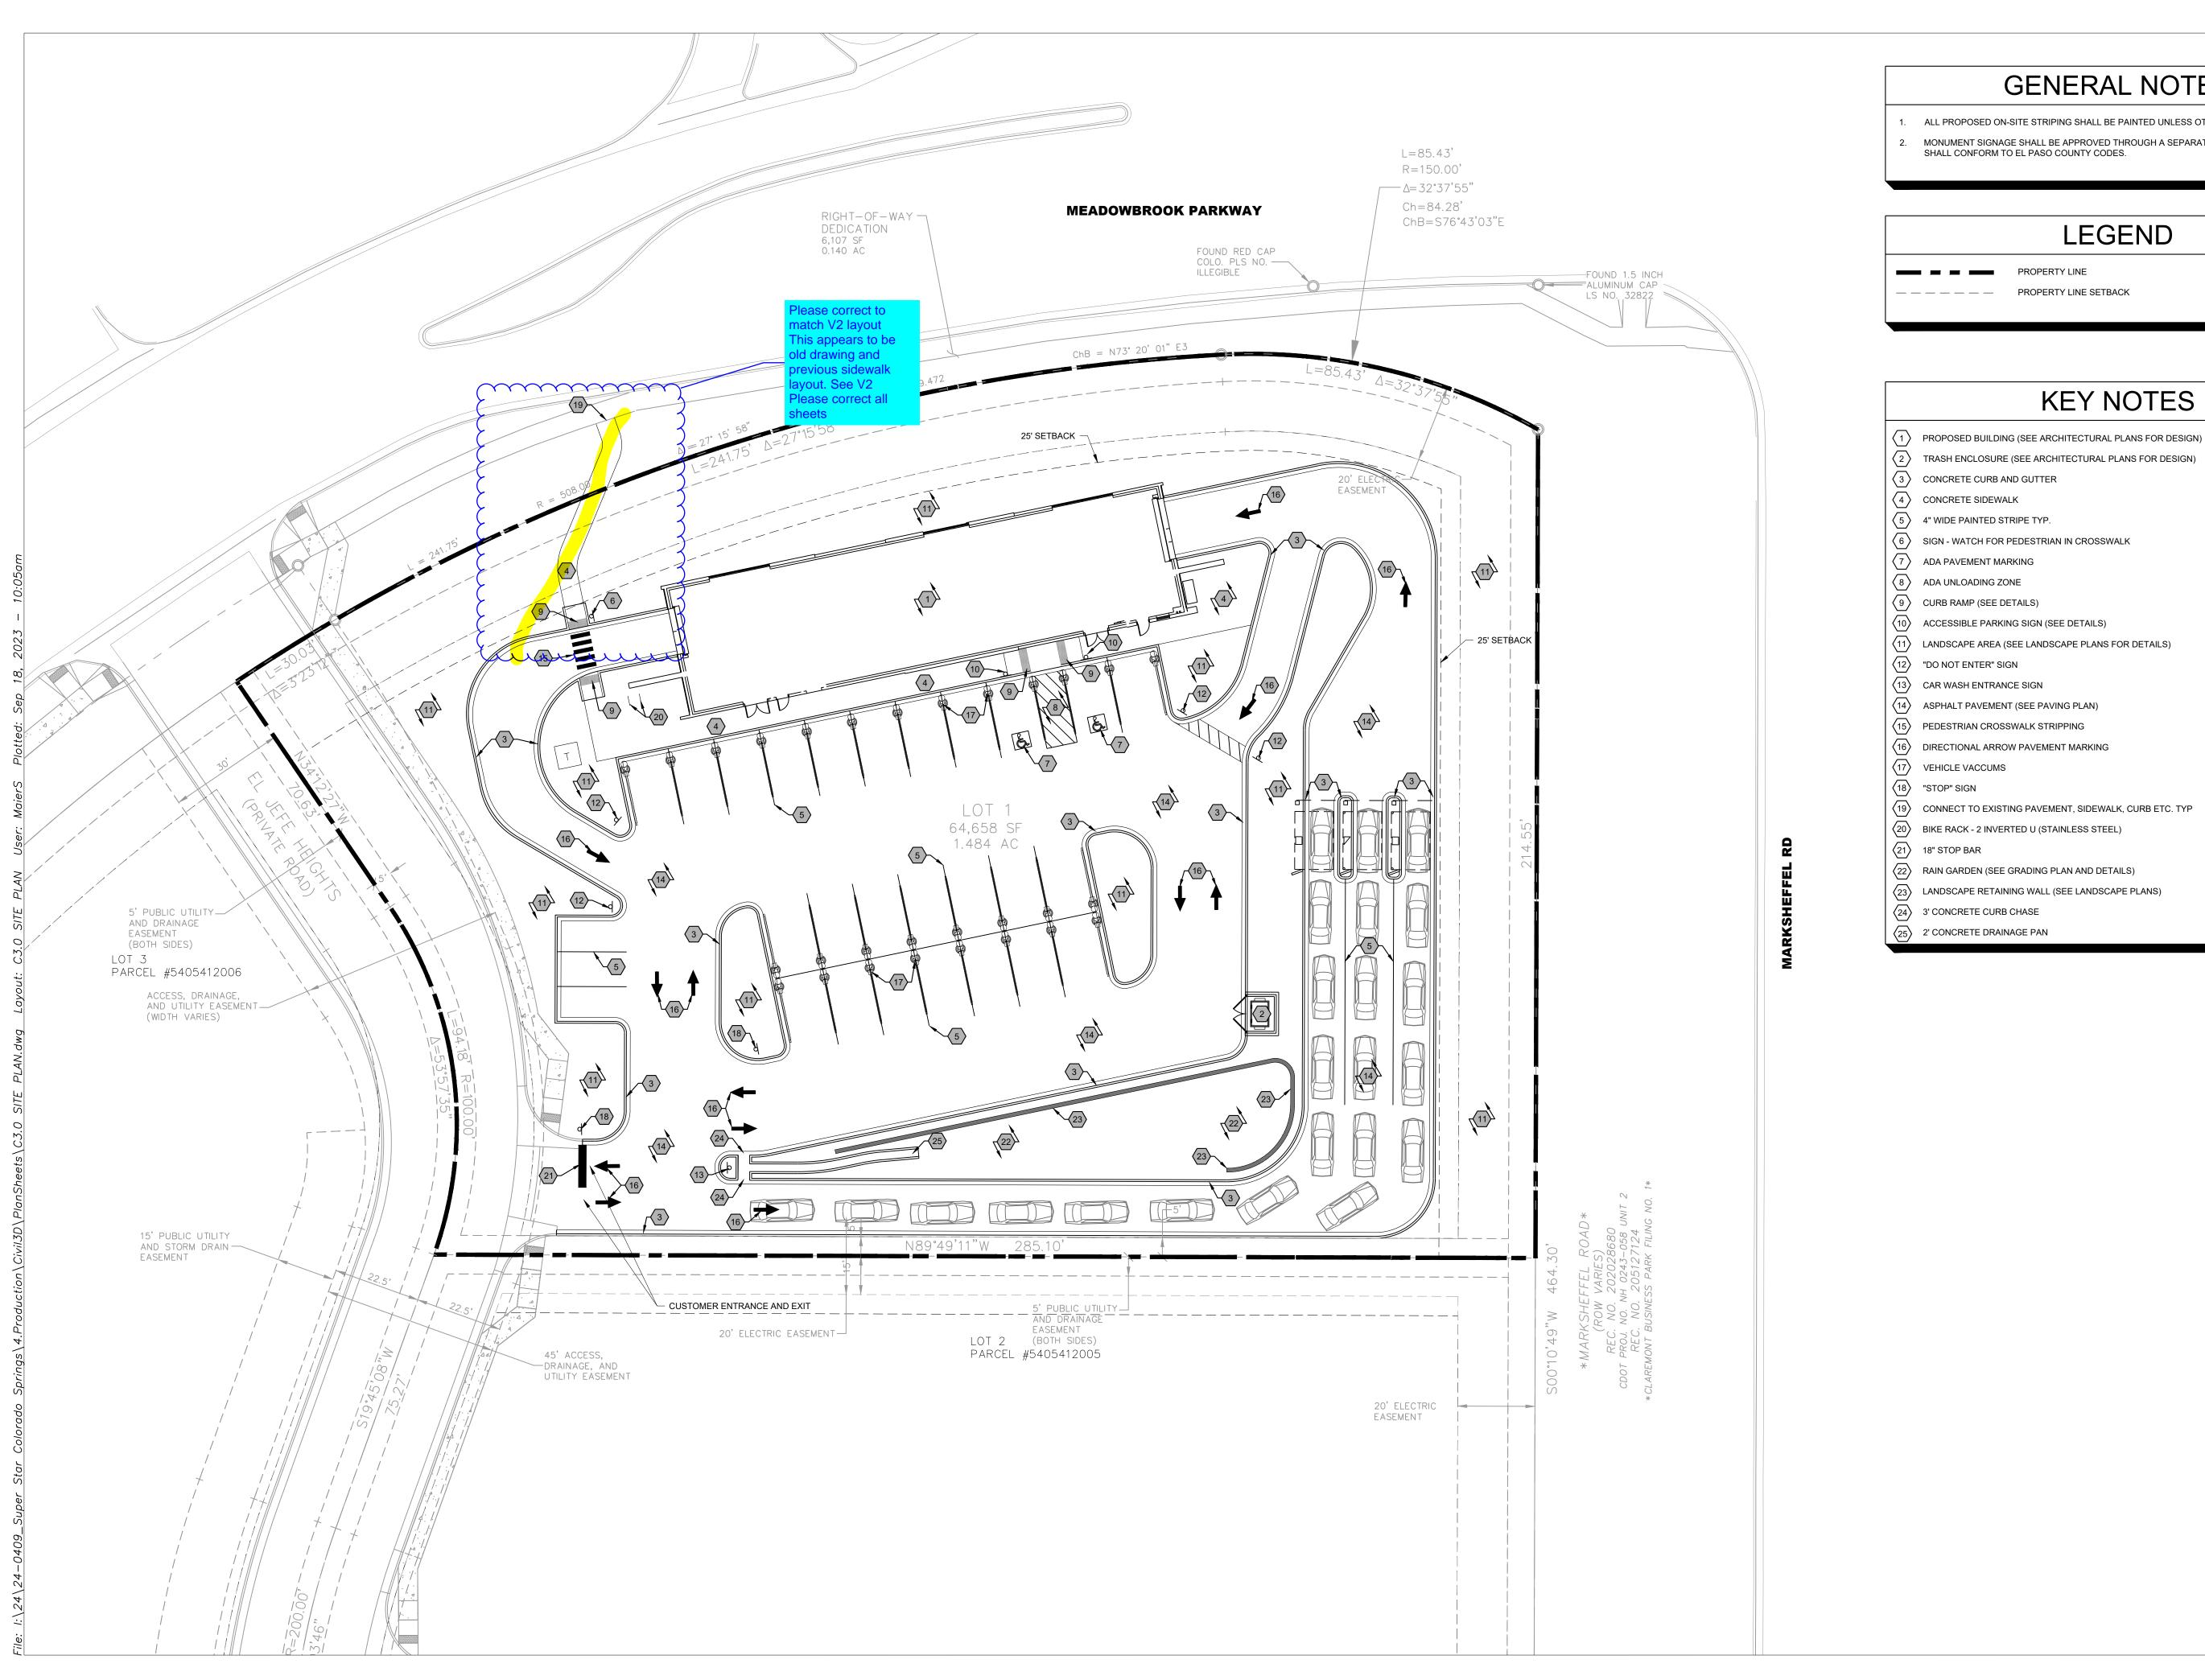

GENERAL NOTES


1. ALL PROPOSED ON-SITE STRIPING SHALL BE PAINTED UNLESS OTHERWISE NOTED. MONUMENT SIGNAGE SHALL BE APPROVED THROUGH A SEPARATE BUILDING PERMIT AND SHALL CONFORM TO EL PASO COUNTY CODES.


LEGEND

PROPERTY LINE – – – – – – PROPERTY LINE SETBACK


KEY NOTES


- 2 TRASH ENCLOSURE (SEE ARCHITECTURAL PLANS FOR DESIGN) 3 CONCRETE CURB AND GUTTER 4 CONCRETE SIDEWALK $\left< 5 \right>$ 4" WIDE PAINTED STRIPE TYP. $\left< 6 \right>$ SIGN - WATCH FOR PEDESTRIAN IN CROSSWALK (7) ADA PAVEMENT MARKING 8 ADA UNLOADING ZONE 9 CURB RAMP (SEE DETAILS) $\langle 10 \rangle$ ACCESSIBLE PARKING SIGN (SEE DETAILS) (11) LANDSCAPE AREA (SEE LANDSCAPE PLANS FOR DETAILS) 12 "DO NOT ENTER" SIGN (13) CAR WASH ENTRANCE SIGN (14) ASPHALT PAVEMENT (SEE PAVING PLAN) (15) PEDESTRIAN CROSSWALK STRIPPING (16) DIRECTIONAL ARROW PAVEMENT MARKING 17 VEHICLE VACCUMS (18) "STOP" SIGN (19) CONNECT TO EXISTING PAVEMENT, SIDEWALK, CURB ETC. TYP 20 BIKE RACK - 2 INVERTED U (STAINLESS STEEL) 21 18" STOP BAR 22 RAIN GARDEN (SEE GRADING PLAN AND DETAILS) (23) LANDSCAPE RETAINING WALL (SEE LANDSCAPE PLANS) 24 3' CONCRETE CURB CHASE
- $\langle 25 \rangle$ 2' CONCRETE DRAINAGE PAN

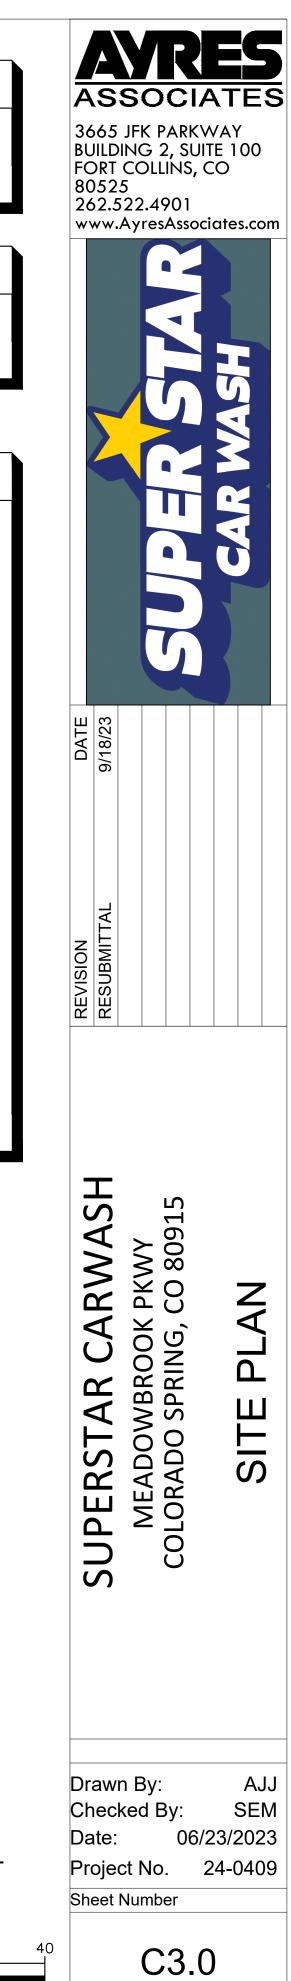

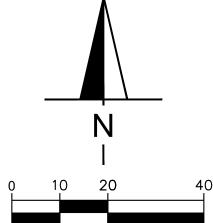


GRAPHIC SCALE IN FEET

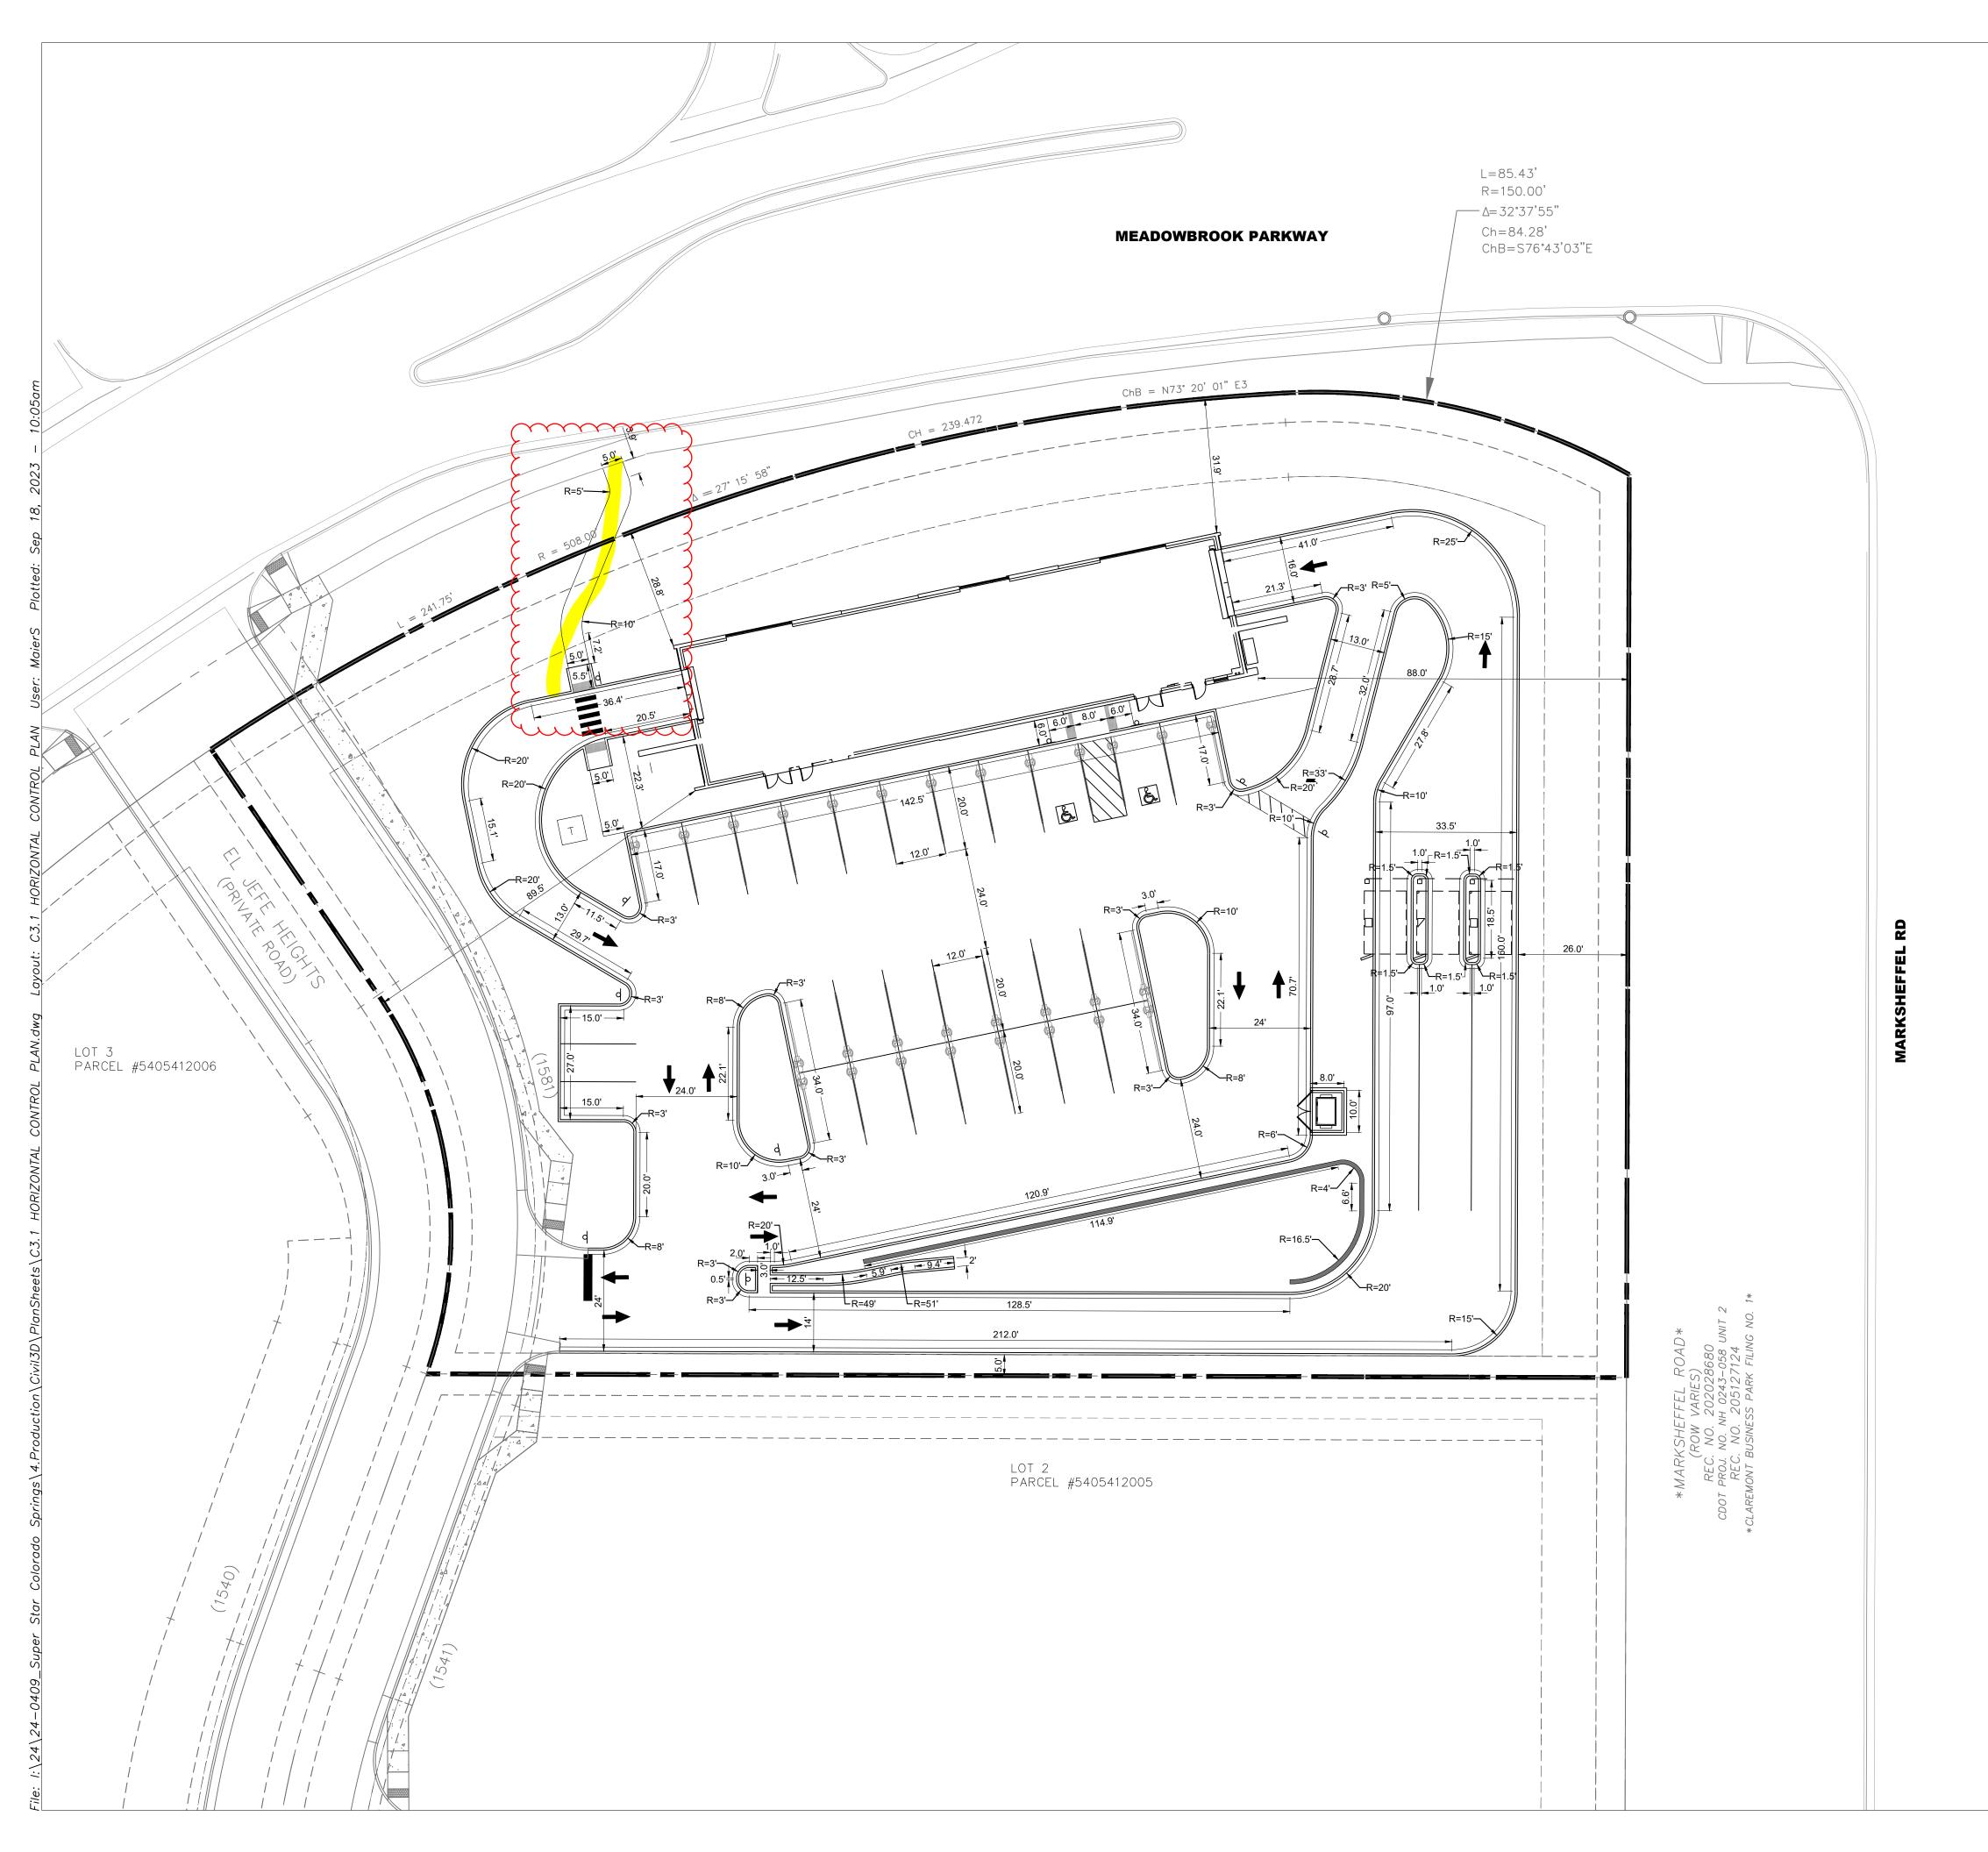


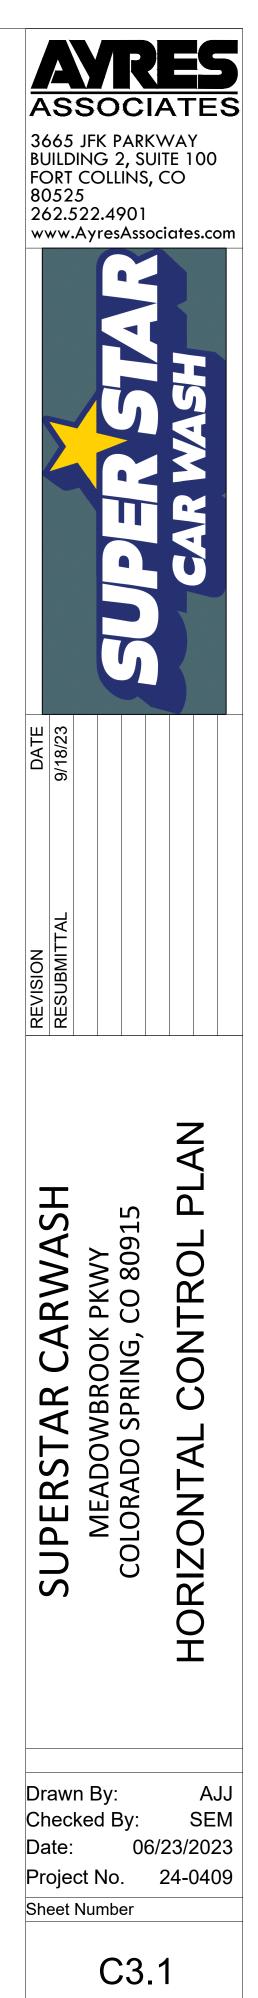

GENERAL NOTES

- 1. ALL DIMENSIONS REFER TO THE FACE OF CURB UNLESS OTHERWISE NOTED.
- 2. BUILDING DIMENSIONS ARE TO THE OUTSIDE FACE OF BUILDING UNLESS OTHERWISE NOTED.
- 3. REFER TO ARCHITECTURAL AND STRUCTURAL PLANS TO VERIFY ALL BUILDING DIMENSIONS.
- RADII ADJACENT TO PARKING STALL ALONG CURB FLOW LINE AND NOT DIMENSIONED ON THIS PLAN SHALL BE 1-FEET, TYPICAL .
 REFER TO ARCHITECTURAL PLANS FOR MONUMENT SIGN DETAILS. SEE MEP PLANS FOR
- 5. REFER TO ARCHITECTURAL PLANS FOR MONUMENT SIGN DETAILS. SEE MEP PLANS FOR SITE ELECTRICAL DRAWINGS.

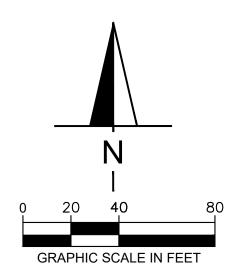

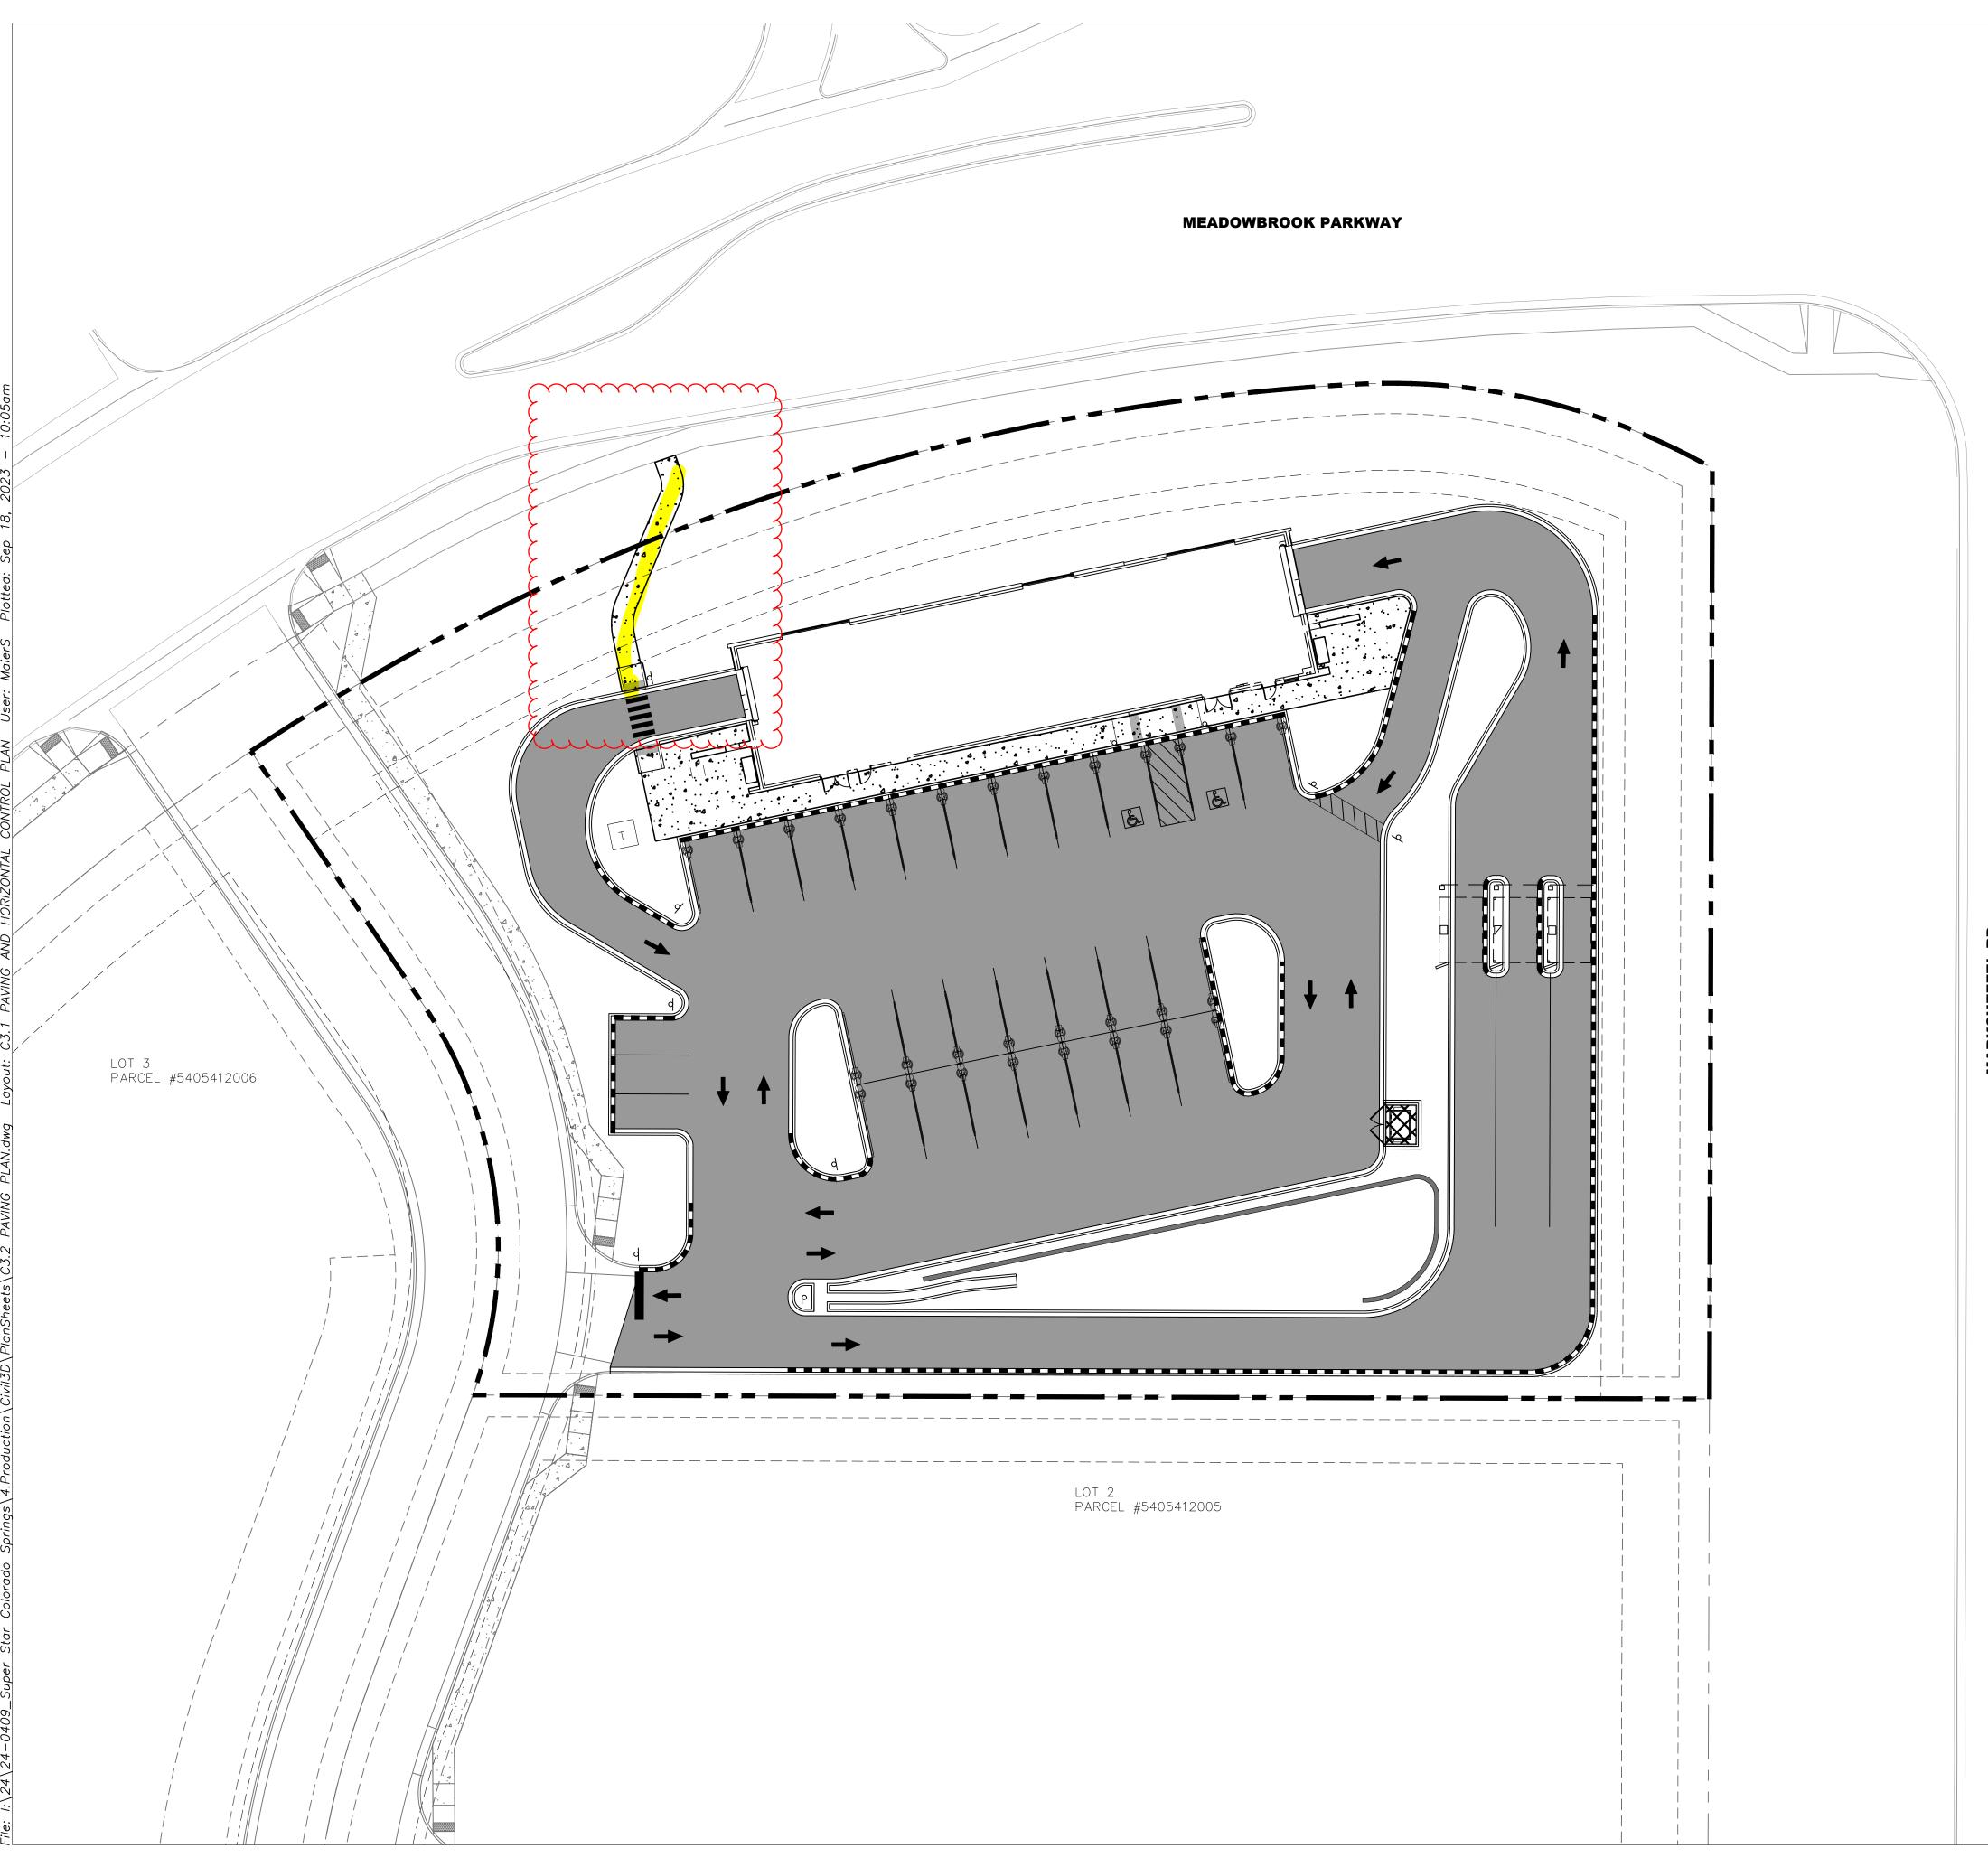



PAVING AND CURB LEGEND

<u>CONCRETE PAVEMENT - PARKING</u> SEE CONSTRUCTION DETAILS FOR PAVEMENT SECTION


CONCRETE SIDEWALK SEE CONSTRUCTION DETAILS FOR PAVEMENT SECTION


> CONCRETE PAVEMENT - TRASH ENCLOSURE SEE CONSTRUCTION DETAILS FOR PAVEMENT SECTION CATCH CONCRETE CURB AND GUTTER


SPILL CONCRETE CURB AND GUTTER

CONTRACTOR TO CREATE CLEAN SAWCUT LINE AT ALL JOINTS WITH NEW/EXISTING PAVEMENT CONNECTIONS


*NOTE: IF DRIVE THRU LANE CURBS ARE NOT POURED MONOLITHIC WITH THE DRIVE, CATCH/SPILL CURBS SHALL BE INSTALLED TO DRAIN PER THE INTENT OF THE GRADING PLAN

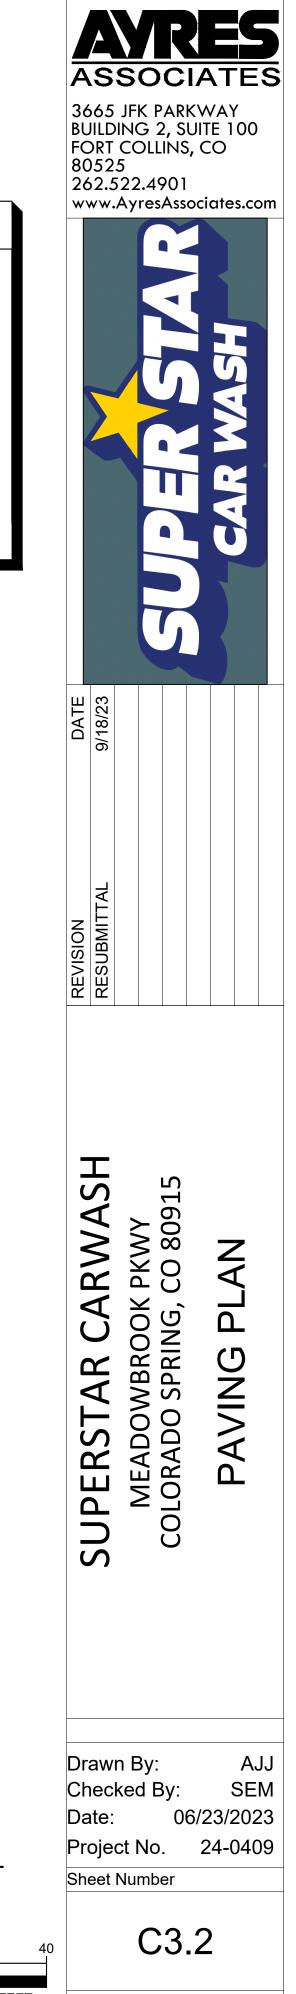

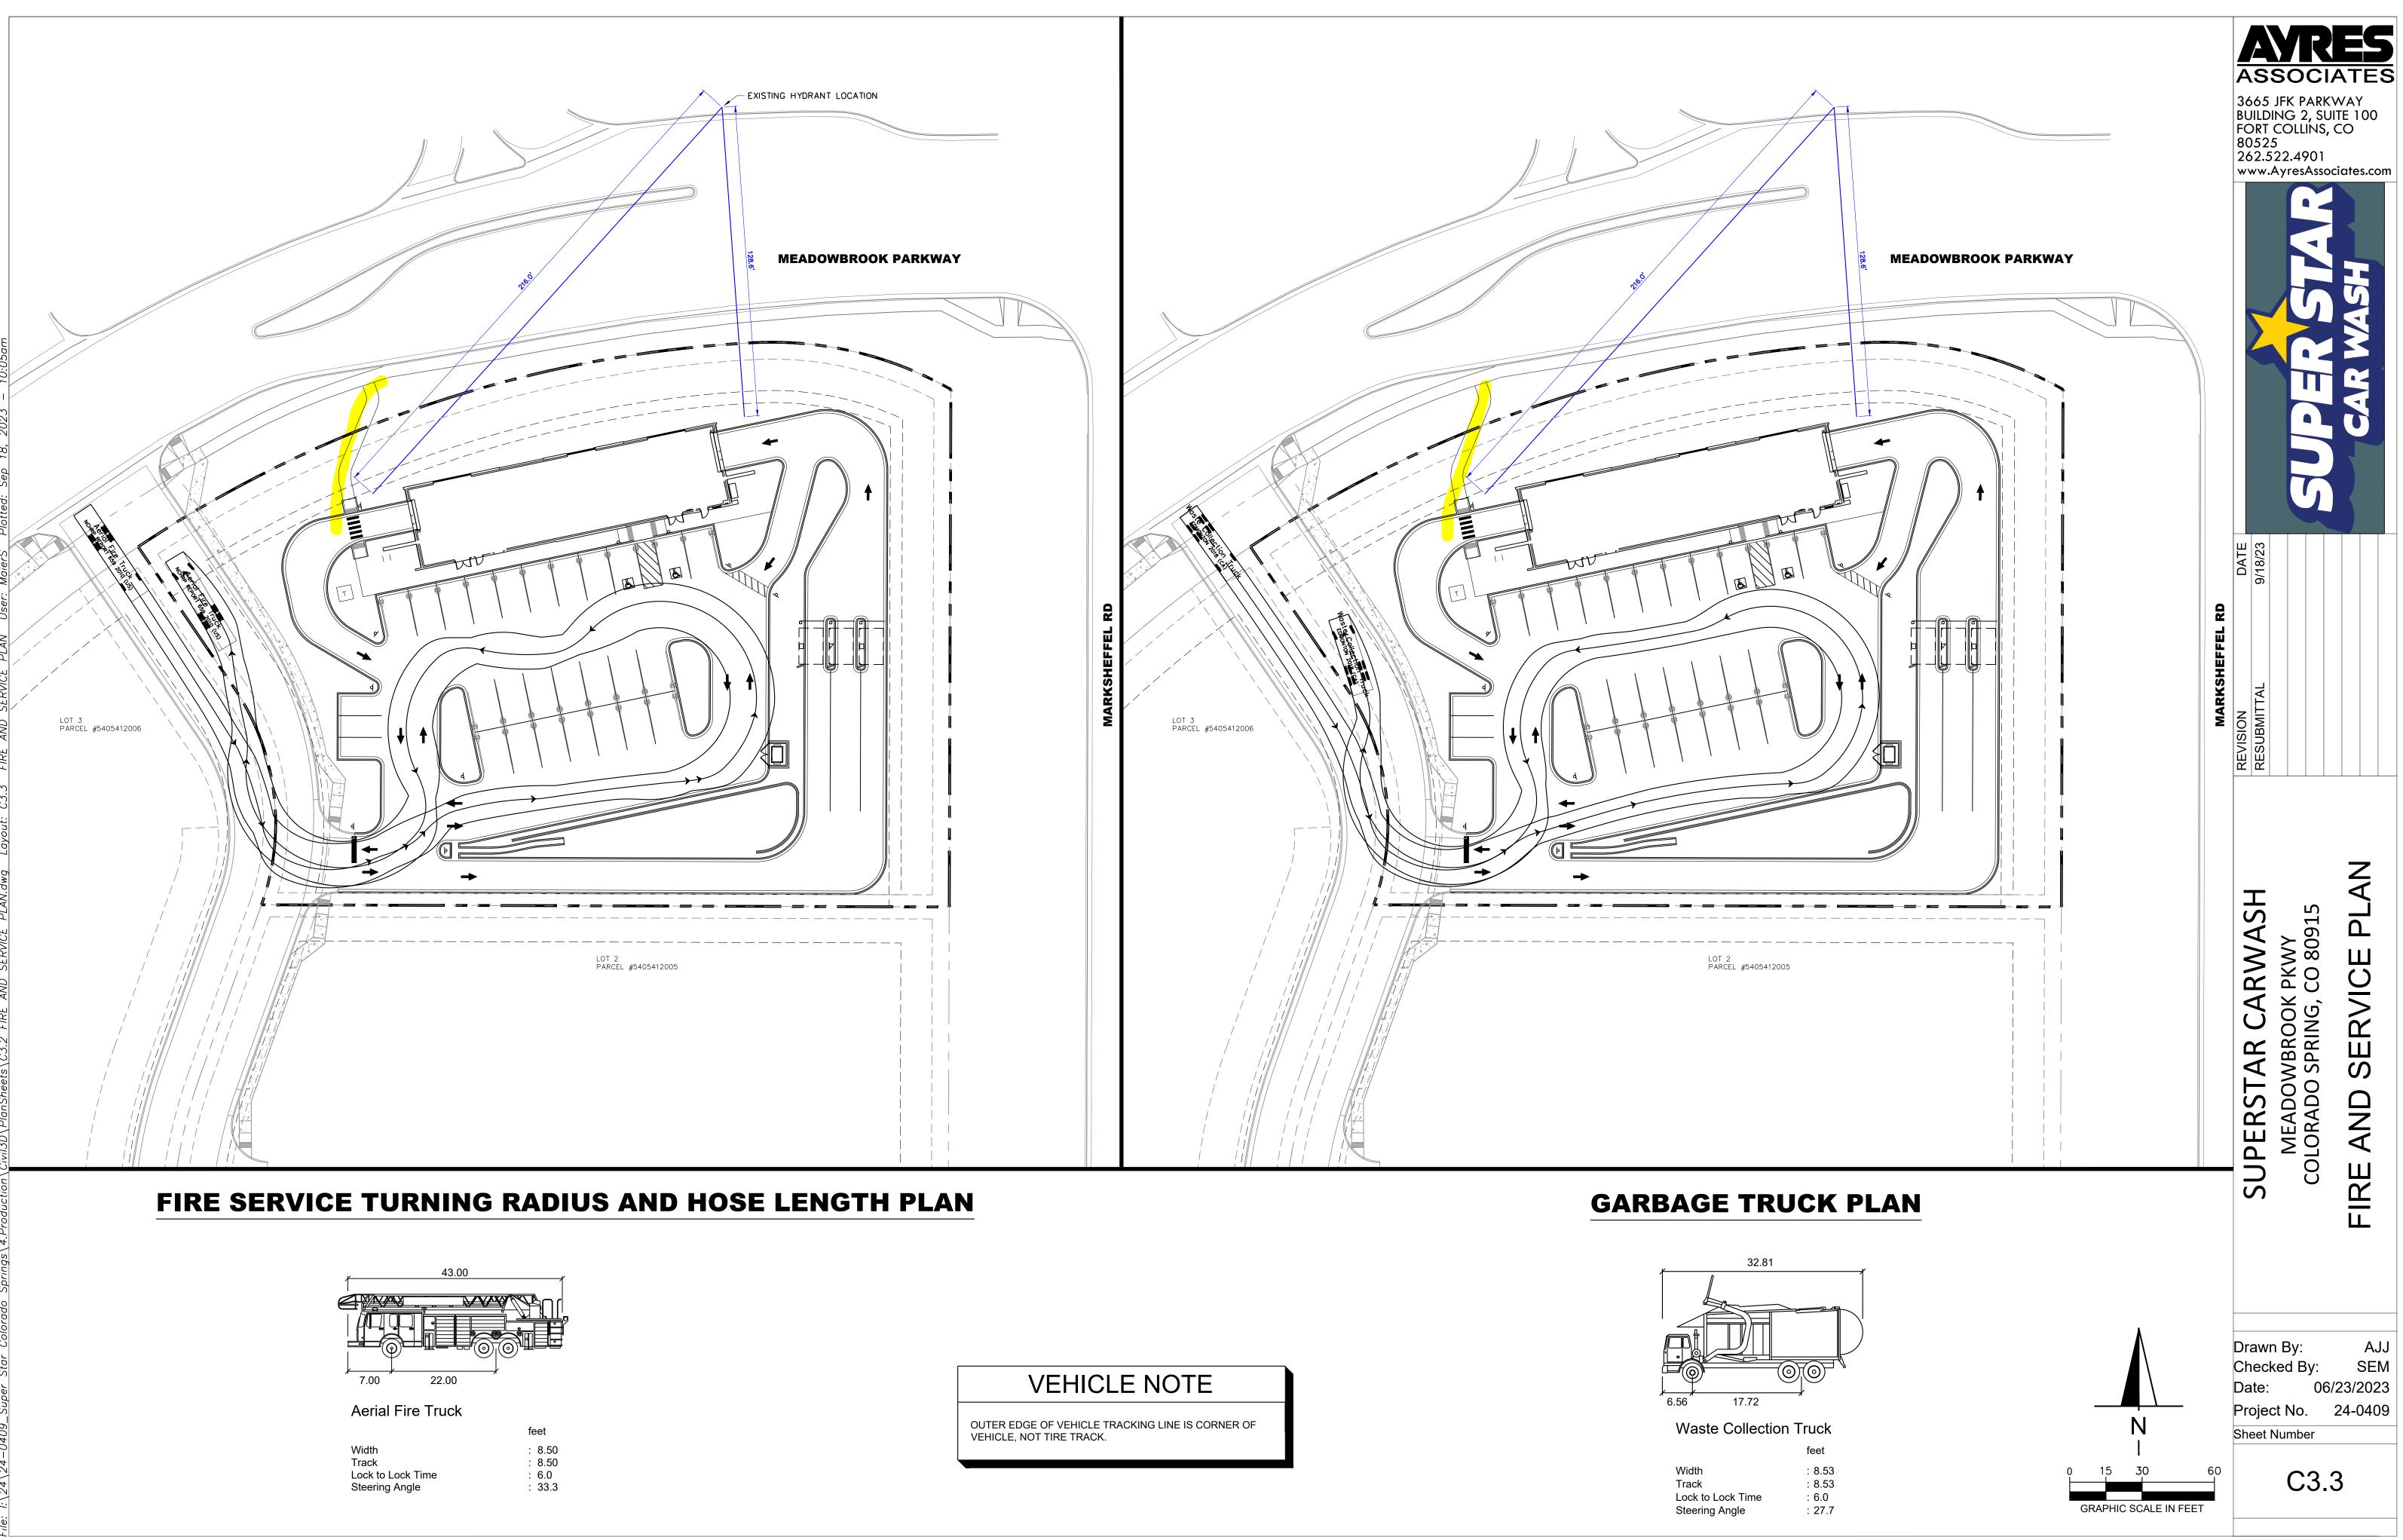

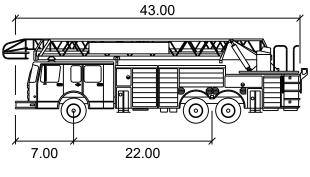

Width	: 8.5
Track	: 8.5
_ock to Lock Time	: 6.0
Steering Angle	: 33.

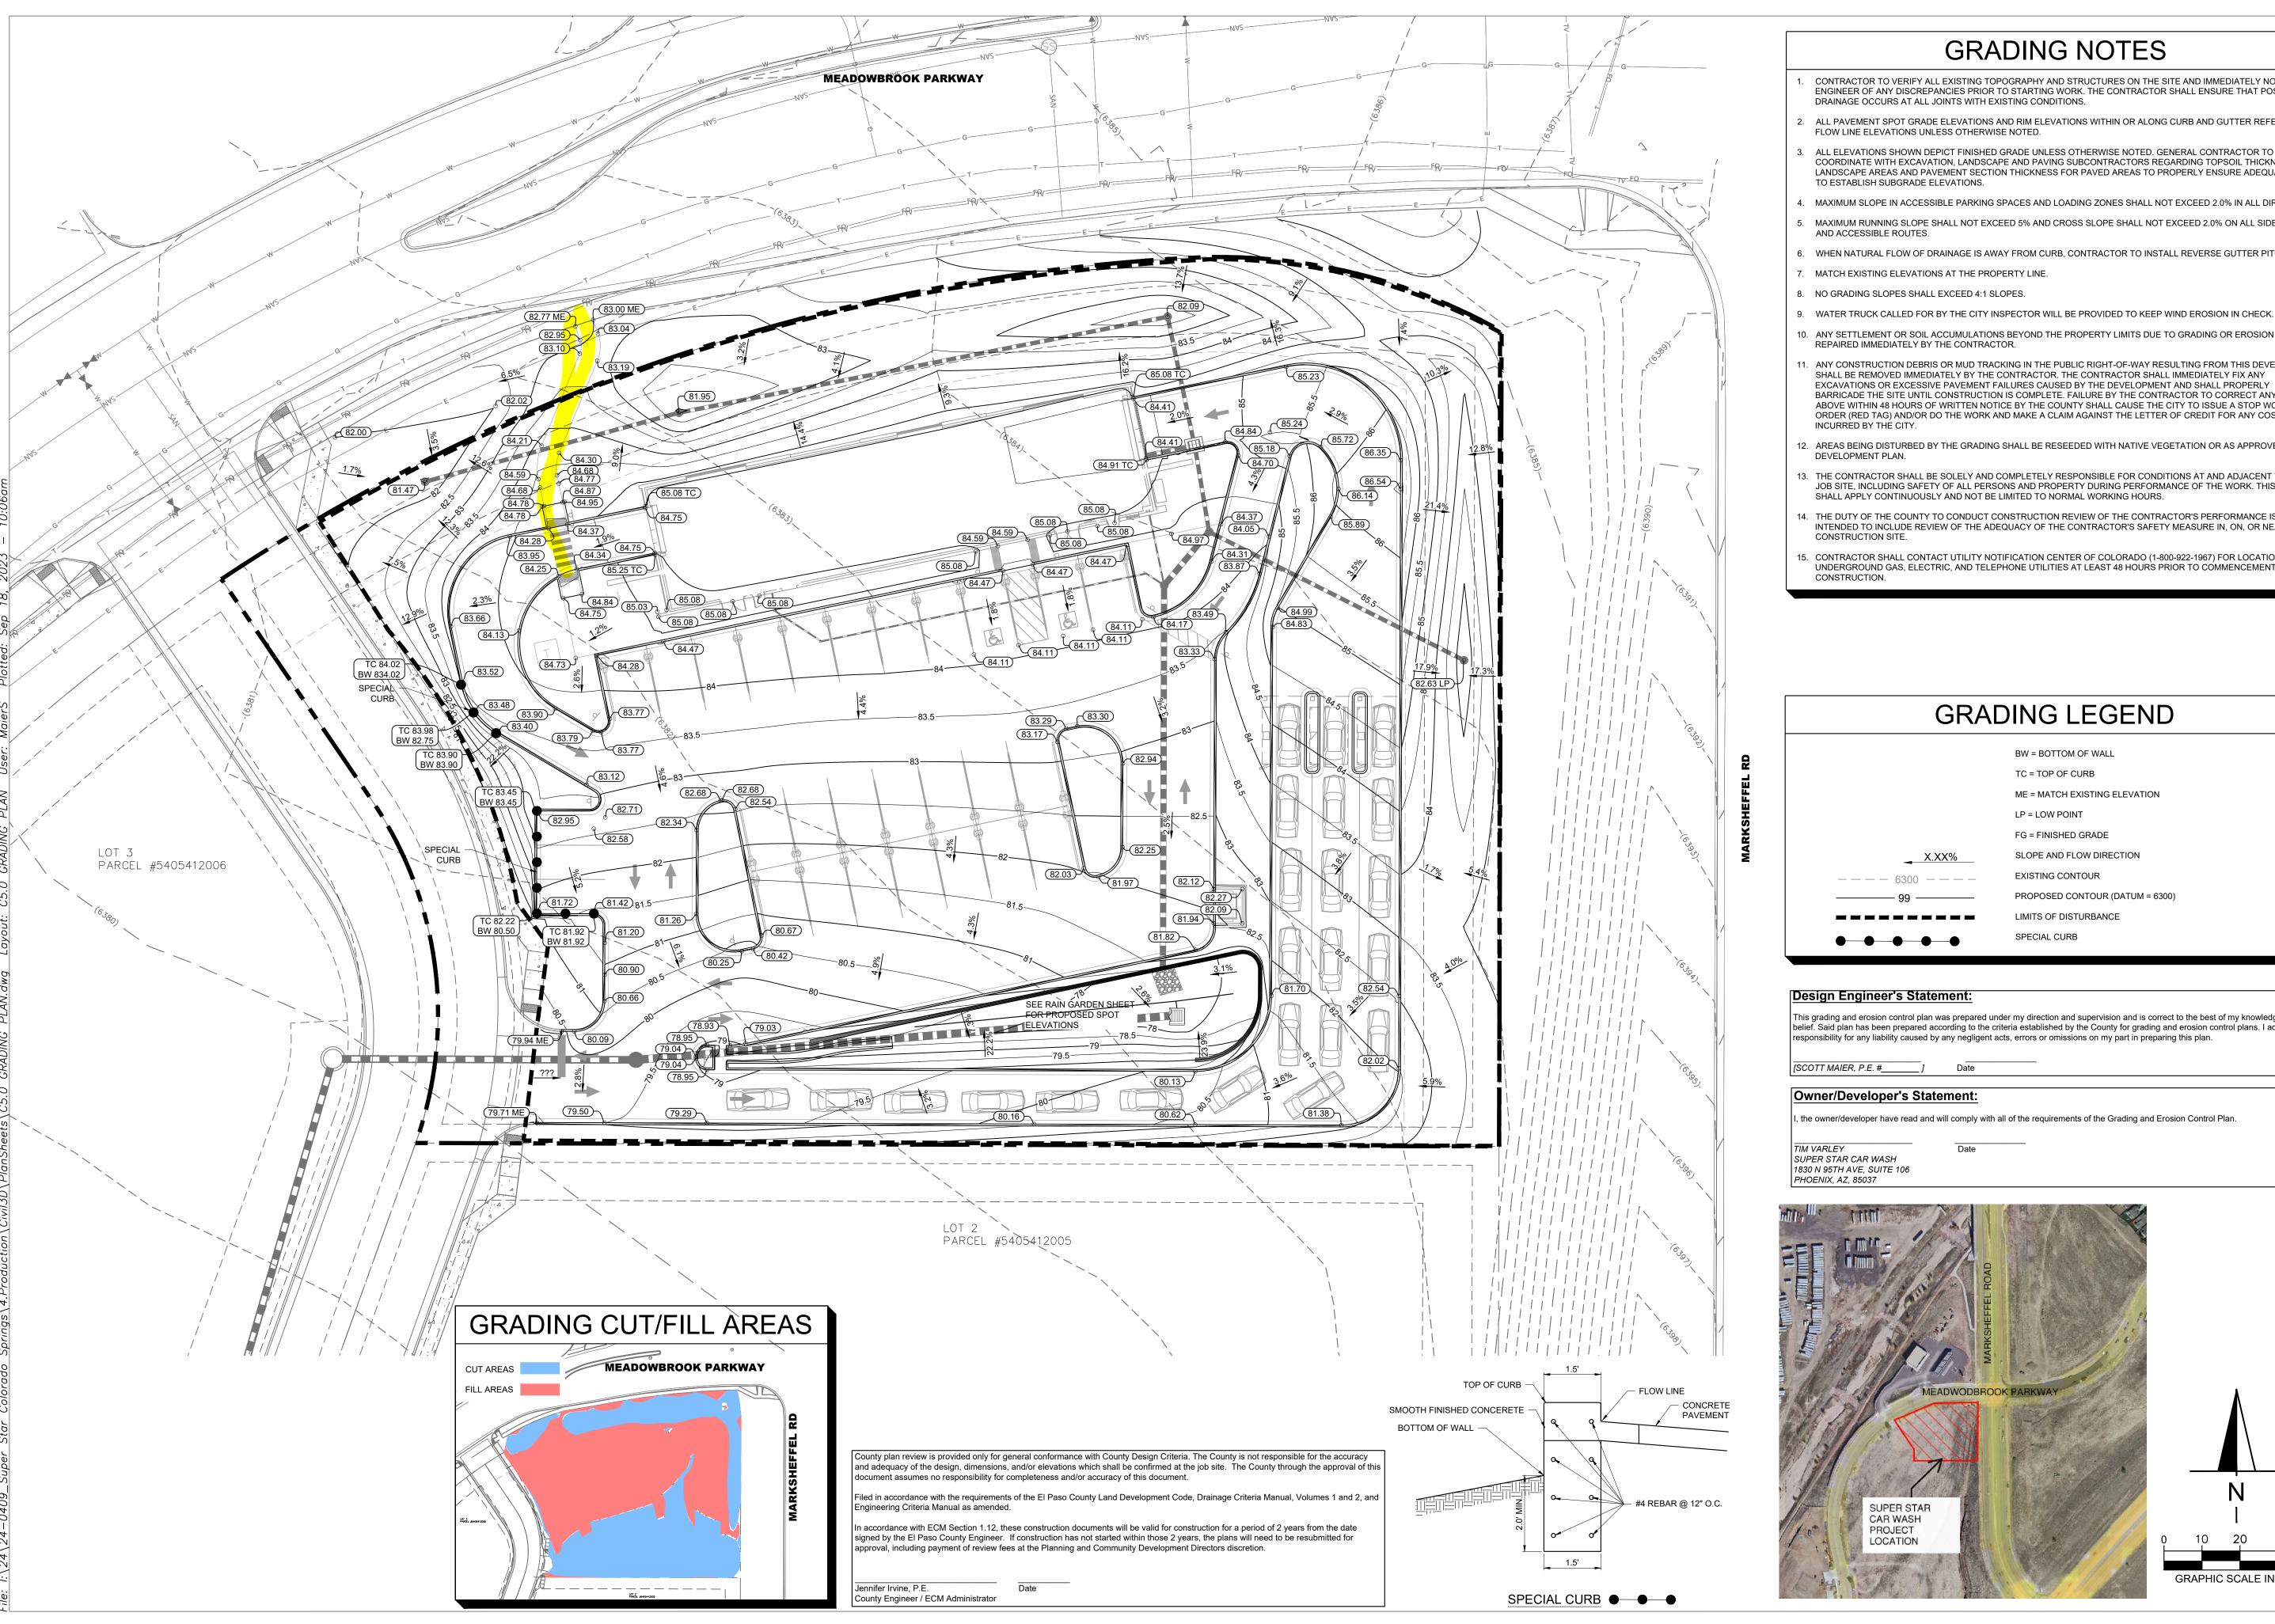

GRADING NOTES

CONTRACTOR TO VERIFY ALL EXISTING TOPOGRAPHY AND STRUCTURES ON THE SITE AND IMMEDIATELY NOTIFY THE ENGINEER OF ANY DISCREPANCIES PRIOR TO STARTING WORK. THE CONTRACTOR SHALL ENSURE THAT POSITIVE DRAINAGE OCCURS AT ALL JOINTS WITH EXISTING CONDITIONS.

ALL PAVEMENT SPOT GRADE ELEVATIONS AND RIM ELEVATIONS WITHIN OR ALONG CURB AND GUTTER REFER TO FLOW LINE ELEVATIONS UNLESS OTHERWISE NOTED.

ALL ELEVATIONS SHOWN DEPICT FINISHED GRADE UNLESS OTHERWISE NOTED. GENERAL CONTRACTOR TO COORDINATE WITH EXCAVATION, LANDSCAPE AND PAVING SUBCONTRACTORS REGARDING TOPSOIL THICKNESS FOR LANDSCAPE AREAS AND PAVEMENT SECTION THICKNESS FOR PAVED AREAS TO PROPERLY ENSURE ADEQUATE CUT TO ESTABLISH SUBGRADE ELEVATIONS

4. MAXIMUM SLOPE IN ACCESSIBLE PARKING SPACES AND LOADING ZONES SHALL NOT EXCEED 2.0% IN ALL DIRECTIONS. MAXIMUM RUNNING SLOPE SHALL NOT EXCEED 5% AND CROSS SLOPE SHALL NOT EXCEED 2.0% ON ALL SIDEWALKS

6. WHEN NATURAL FLOW OF DRAINAGE IS AWAY FROM CURB, CONTRACTOR TO INSTALL REVERSE GUTTER PITCH.

7. MATCH EXISTING ELEVATIONS AT THE PROPERTY LINE.

8. NO GRADING SLOPES SHALL EXCEED 4:1 SLOPES.

10. ANY SETTLEMENT OR SOIL ACCUMULATIONS BEYOND THE PROPERTY LIMITS DUE TO GRADING OR EROSION SHALL BE REPAIRED IMMEDIATELY BY THE CONTRACTOR

. ANY CONSTRUCTION DEBRIS OR MUD TRACKING IN THE PUBLIC RIGHT-OF-WAY RESULTING FROM THIS DEVELOPMENT SHALL BE REMOVED IMMEDIATELY BY THE CONTRACTOR. THE CONTRACTOR SHALL IMMEDIATELY FIX ANY EXCAVATIONS OR EXCESSIVE PAVEMENT FAILURES CAUSED BY THE DEVELOPMENT AND SHALL PROPERLY BARRICADE THE SITE UNTIL CONSTRUCTION IS COMPLETE. FAILURE BY THE CONTRACTOR TO CORRECT ANY OF THE ABOVE WITHIN 48 HOURS OF WRITTEN NOTICE BY THE COUNTY SHALL CAUSE THE CITY TO ISSUE A STOP WORK ORDER (RED TAG) AND/OR DO THE WORK AND MAKE A CLAIM AGAINST THE LETTER OF CREDIT FOR ANY COST INCURRED BY THE CITY.

12. AREAS BEING DISTURBED BY THE GRADING SHALL BE RESEEDED WITH NATIVE VEGETATION OR AS APPROVED ON THE DEVELOPMENT PLAN.

13. THE CONTRACTOR SHALL BE SOLELY AND COMPLETELY RESPONSIBLE FOR CONDITIONS AT AND ADJACENT TO THE JOB SITE, INCLUDING SAFETY OF ALL PERSONS AND PROPERTY DURING PERFORMANCE OF THE WORK. THIS REQUEST SHALL APPLY CONTINUOUSLY AND NOT BE LIMITED TO NORMAL WORKING HOURS.

14. THE DUTY OF THE COUNTY TO CONDUCT CONSTRUCTION REVIEW OF THE CONTRACTOR'S PERFORMANCE IS NOT INTENDED TO INCLUDE REVIEW OF THE ADEQUACY OF THE CONTRACTOR'S SAFETY MEASURE IN, ON, OR NEAR THE CONSTRUCTION SITE.

15. CONTRACTOR SHALL CONTACT UTILITY NOTIFICATION CENTER OF COLORADO (1-800-922-1967) FOR LOCATION OF UNDERGROUND GAS, ELECTRIC, AND TELEPHONE UTILITIES AT LEAST 48 HOURS PRIOR TO COMMENCEMENT OF

GRA	GRADING LEGEND					
X.XX% 6300 99	BW = BOTTOM OF WALL TC = TOP OF CURB ME = MATCH EXISTING ELEVATION LP = LOW POINT FG = FINISHED GRADE SLOPE AND FLOW DIRECTION EXISTING CONTOUR PROPOSED CONTOUR (DATUM = 6300) LIMITS OF DISTURBANCE SPECIAL CURB					
neer's Statement:						


This grading and erosion control plan was prepared under my direction and supervision and is correct to the best of my knowledge and belief. Said plan has been prepared according to the criteria established by the County for grading and erosion control plans. I accept responsibility for any liability caused by any negligent acts, errors or omissions on my part in preparing this plan.

Date


Owner/Developer's Statement:


I, the owner/developer have read and will comply with all of the requirements of the Grading and Erosion Control Plan.



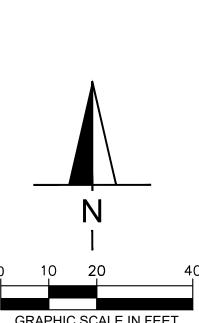




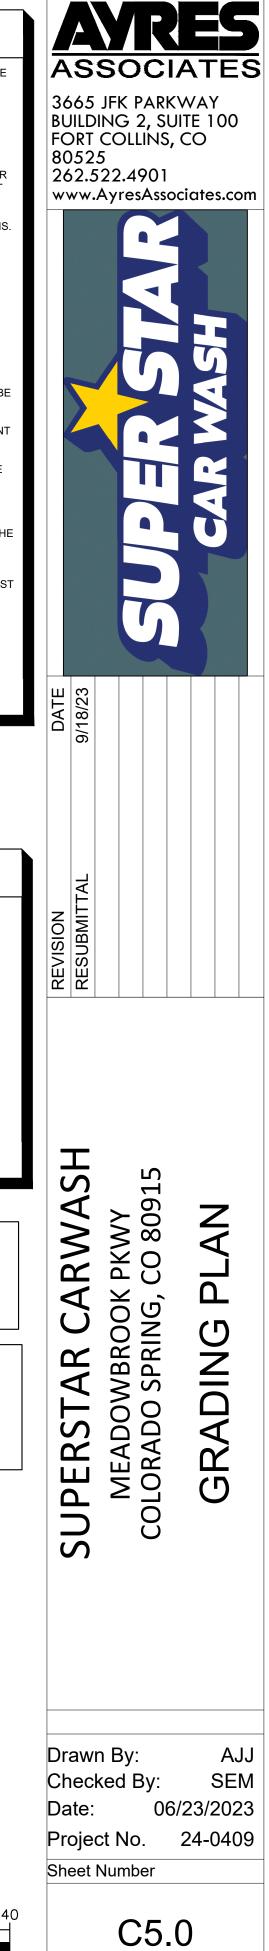

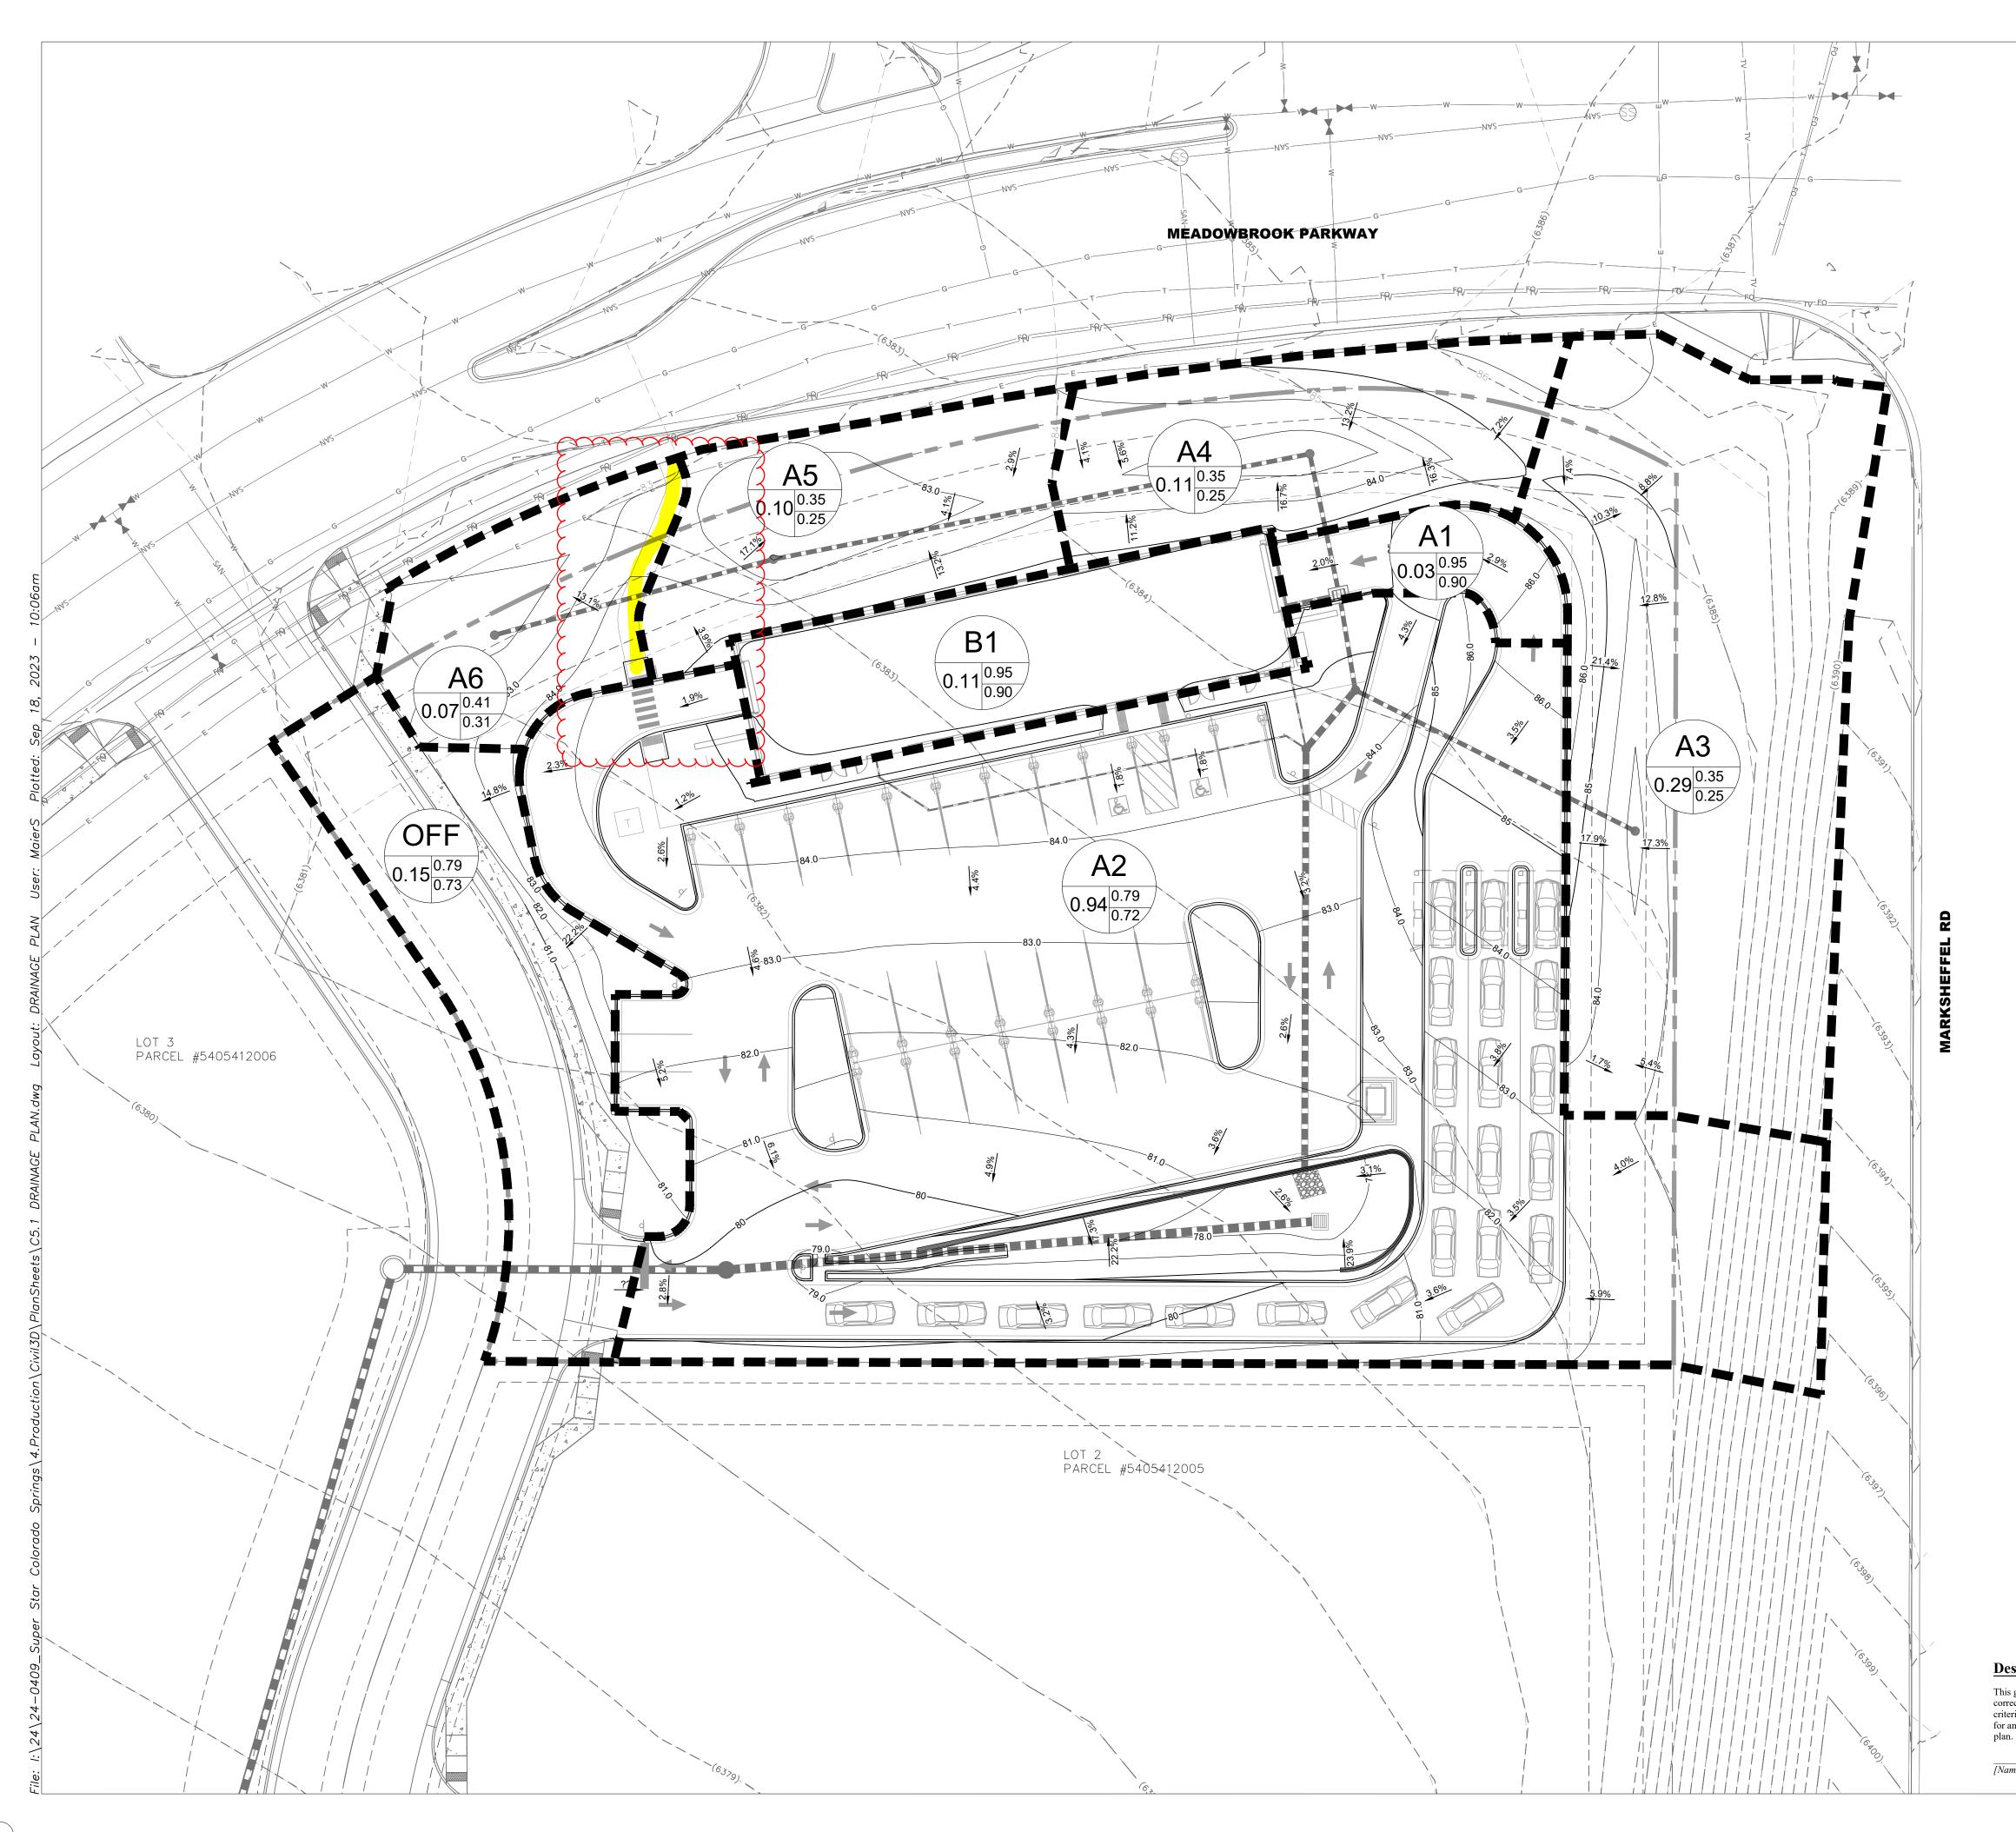

Design Engineer's Statement:

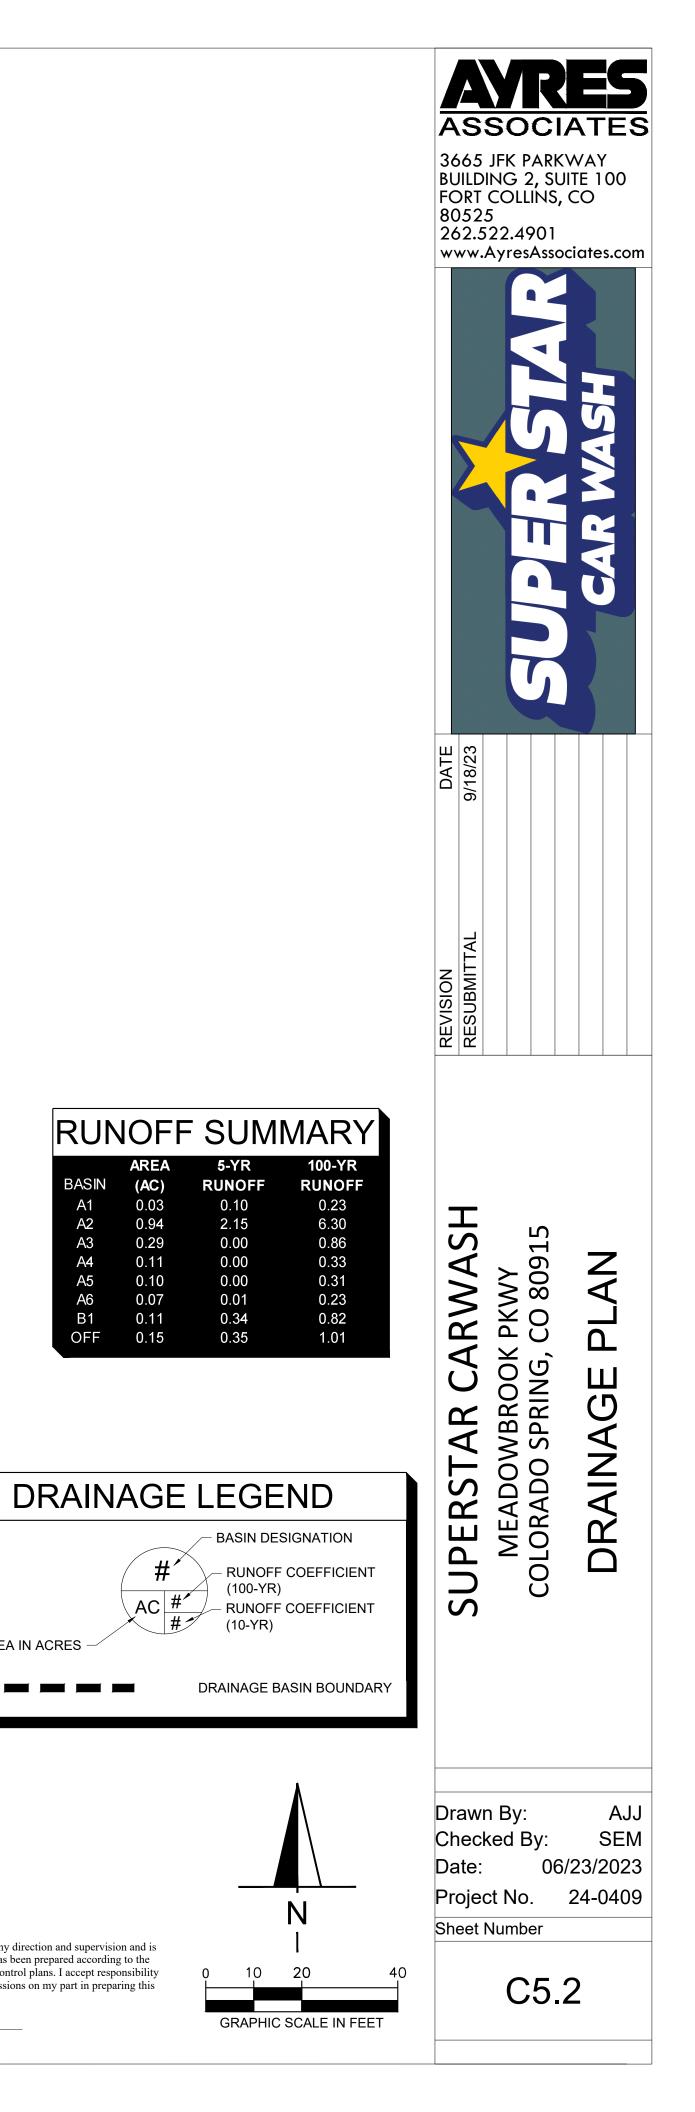

This grading and erosion control plan was prepared under my direction and supervision and is correct to the best of my knowledge and belief. Said plan has been prepared according to the criteria established by the County for grading and erosion control plans. I accept responsibility for any liability caused by any negligent acts, errors or omissions on my part in preparing this

AREA IN ACRES

0.94 0.29 0.11

0.10 0.07 0.11 0.15

#′

AC #


A2

A3

A4

A5 A6

B1 OFF

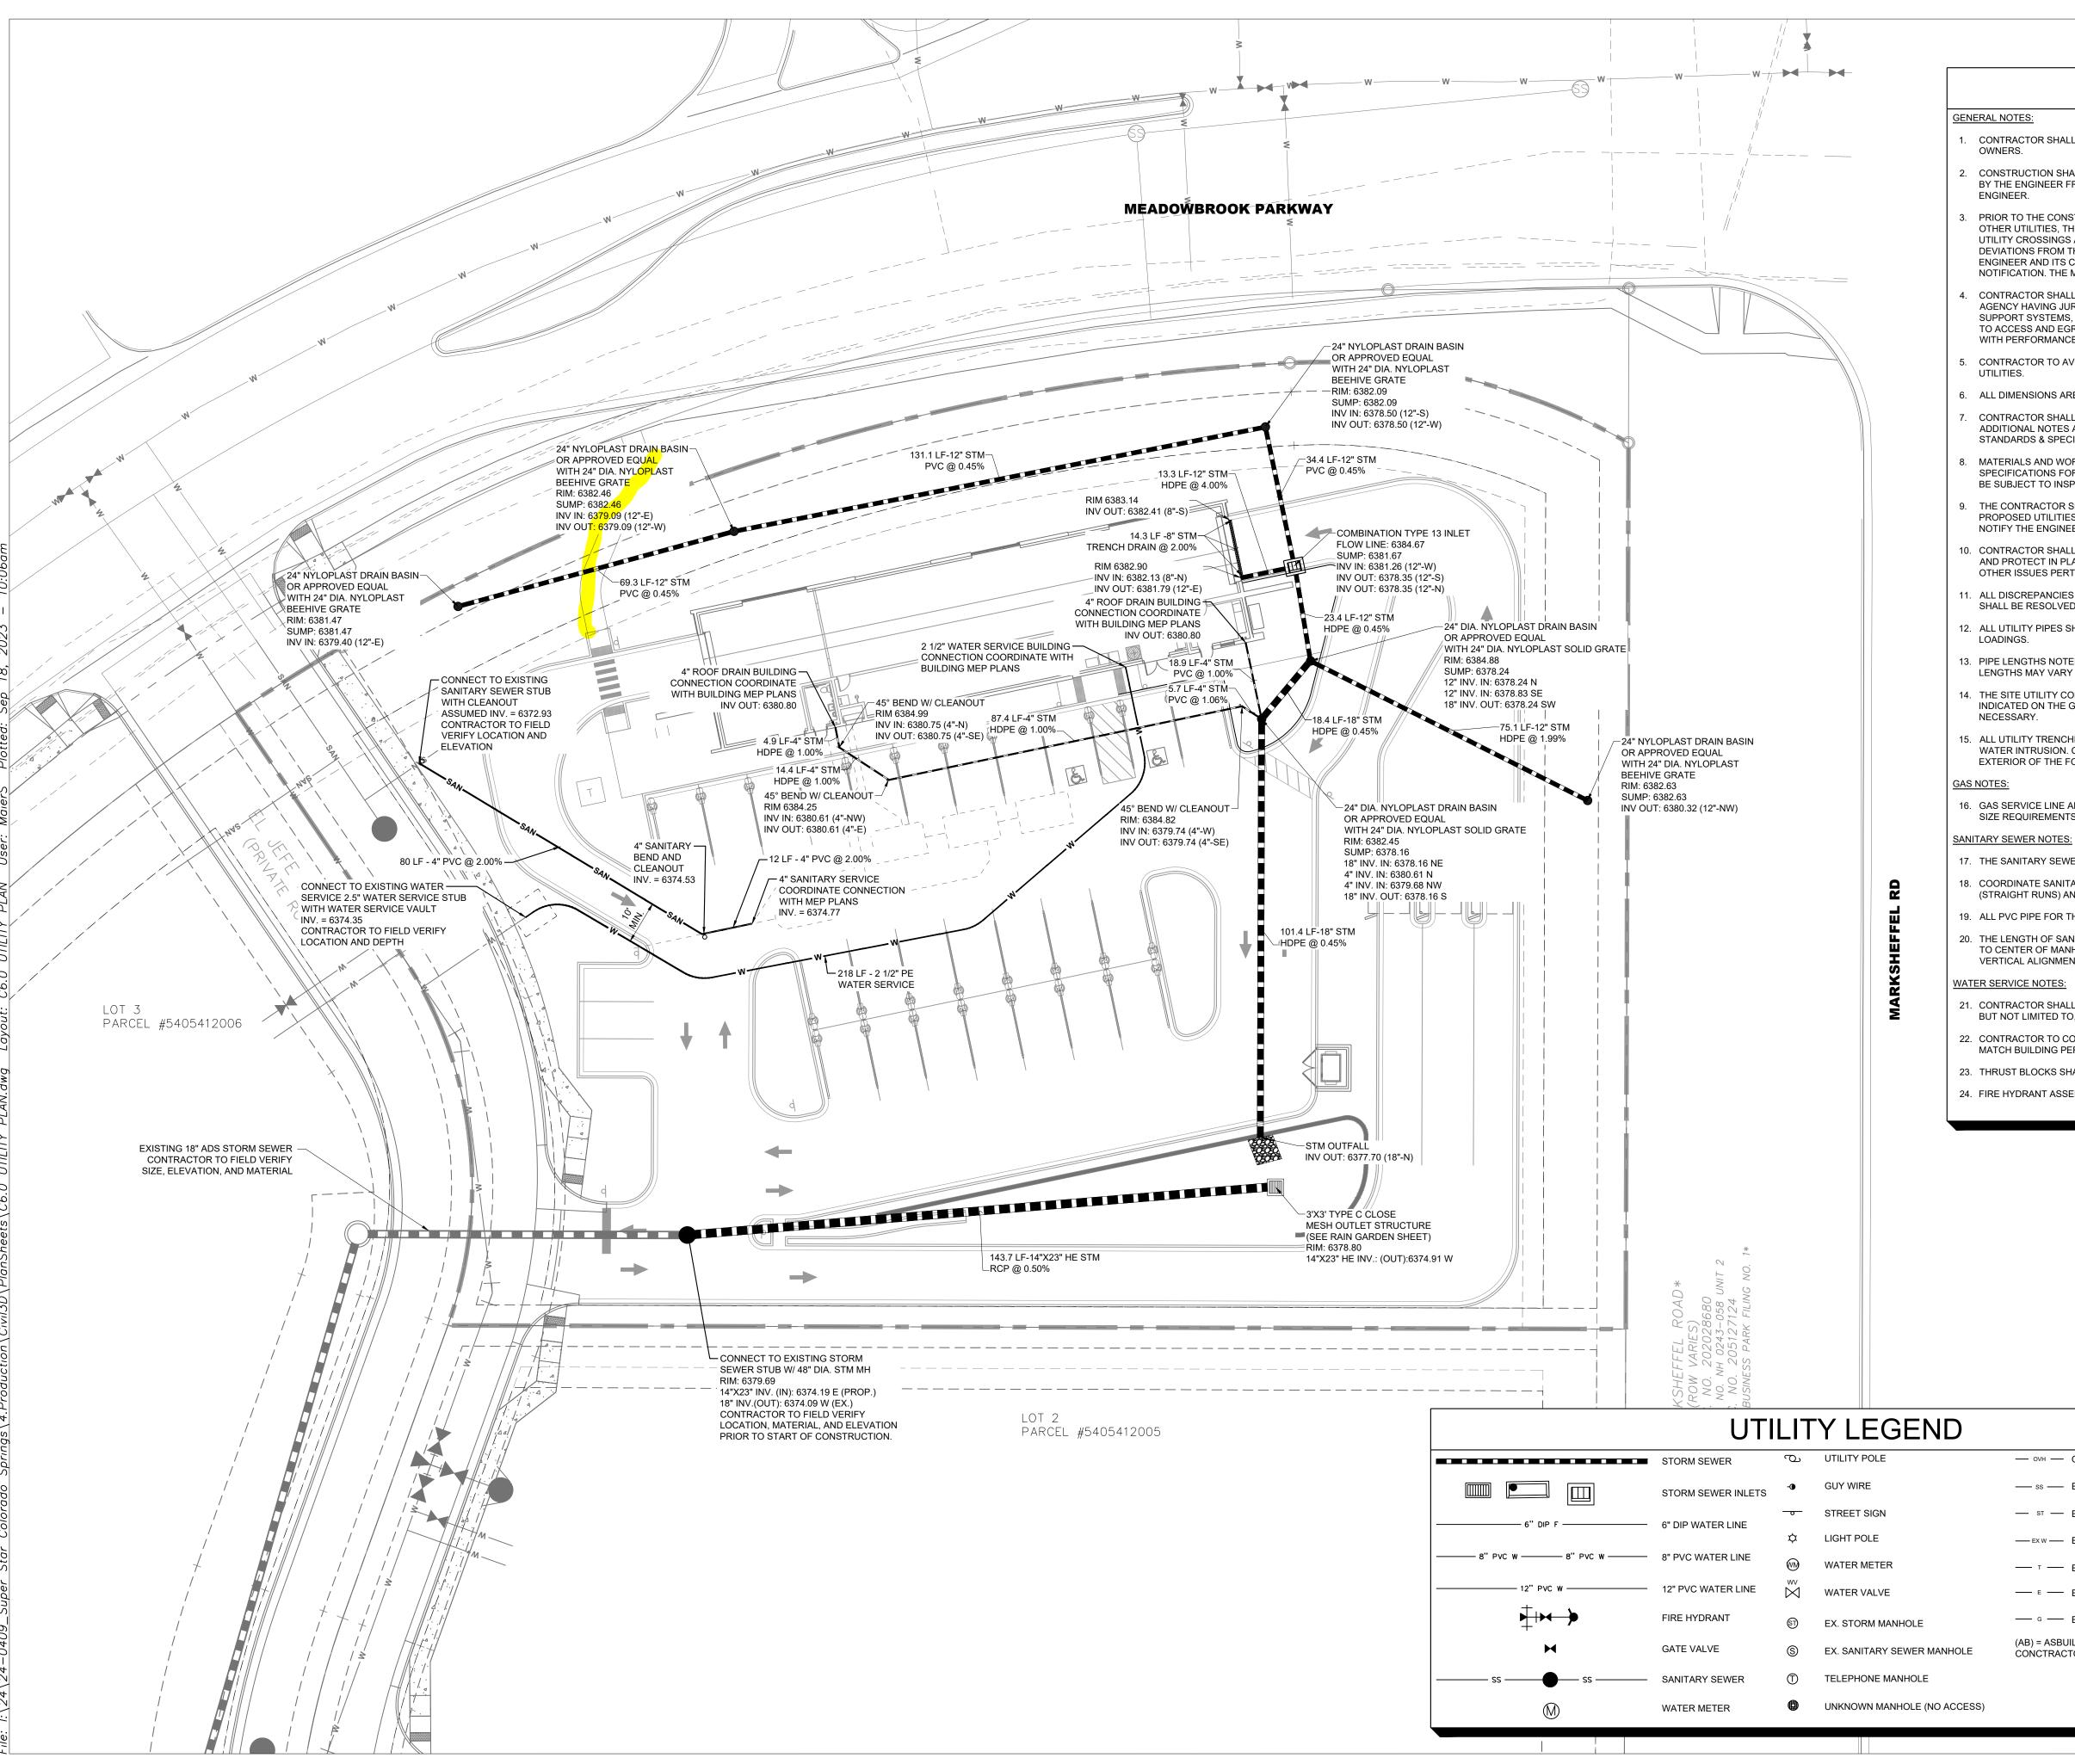

ER INLETS	-0	GUY WIRE	
R LINE		STREET SIGN	
	¢	LIGHT POLE	_
ER LINE	\bigotimes	WATER METER	
FER LINE	\bowtie	WATER VALVE	
NT	ST	EX. STORM MANHOLE	_
E	S	EX. SANITARY SEWER MANHOLE	(A C0
EWER	T	TELEPHONE MANHOLE	
ER	۲	UNKNOWN MANHOLE (NO ACCESS)	

UTILITY NOTES

CONTRACTOR SHALL COORDINATE ANY DISRUPTIONS TO EXISTING UTILITY SERVICES WITH ADJACENT PROPERTY

2. CONSTRUCTION SHALL NOT START ON ANY PUBLIC UTILITY SYSTEM UNTIL WRITTEN APPROVAL HAS BEEN RECEIVED BY THE ENGINEER FROM THE APPROPRIATE GOVERNING AUTHORITY AND CONTRACTOR HAS BEEN NOTIFIED BY THE

PRIOR TO THE CONSTRUCTION OF OR CONNECTION TO ANY STORM DRAIN, SANITARY SEWER, WATER MAIN OR ANY OTHER UTILITIES, THE CONTRACTOR SHALL EXCAVATE, VERIFY AND CALCULATE ALL POINTS OF CONNECTION AND ALL UTILITY CROSSINGS AND INFORM THE ENGINEER AND THE OWNER/DEVELOPER OF ANY CONFLICT OR REQUIRED DEVIATIONS FROM THE PLAN. NOTIFICATION SHALL BE MADE A MINIMUM OF 72 HOURS PRIOR TO CONSTRUCTION. THE ENGINEER AND ITS CLIENTS SHALL BE HELD HARMLESS IN THE EVENT THAT THE CONTRACTOR FAILS TO MAKE SUCH NOTIFICATION. THE MUNICIPALITY SHALL BE NOTIFIED OF ANY AND ALL CHANGES TO THE DESIGN PLANS.

CONTRACTOR SHALL COMPLY COMPLETELY WITH THE LATEST STANDARDS OF OSHA DIRECTIVES OR ANY OTHER AGENCY HAVING JURISDICTION FOR EXCAVATION AND TRENCHING PROCEDURES. THE CONTRACTOR SHALL USE SUPPORT SYSTEMS, SLOPING, BENCHING, AND OTHER MEANS OF PROTECTION. THIS IS TO INCLUDE BUT NOT LIMITED TO ACCESS AND EGRESS FROM ALL EXCAVATION AND TRENCHING. CONTRACTOR IS RESPONSIBLE FOR COMPLYING WITH PERFORMANCE CRITERIA AS REQUIRED BY OSHA.

5. CONTRACTOR TO AVOID DISRUPTION OF ANY ADJACENT TENANT'S TRAFFIC OPERATIONS DURING INSTALLATION OF

6. ALL DIMENSIONS ARE TO CENTERLINE OF PIPE OR CENTER OF MANHOLE UNLESS NOTED OTHERWISE.

CONTRACTOR SHALL REFERENCE EL PASO COUNTY STANDARD NOTES PROVIDED ON SHEET C1.1 OF THESE PLANS. ADDITIONAL NOTES ARE PROVIDED TO SUPPLEMENT THE CITY OF BRIGHTON STANDARD NOTES. EL PASO COUNTY STANDARDS & SPECIFICATIONS SHALL TAKE PRECEDENCE IN THE EVENT OF ANY DISCREPANCIES.

MATERIALS AND WORKMANSHIP SHALL CONFORM TO THE LATEST EDITION OF THE EL PASO COUNTY "STANDARDS AND SPECIFICATIONS FOR THE DESIGN AND CONSTRUCTION OF PUBLIC AND PRIVATE IMPROVEMENTS" AND WORK SHALL BE SUBJECT TO INSPECTION AND APPROVAL BY AUTHORIZED EL PASO COUNTY PERSONNEL.

). THE CONTRACTOR SHALL FIELD VERIFY THE HORIZONTAL AND VERTICAL LOCATION OF ALL EXISTING UTILITIES WHERE PROPOSED UTILITIES ARE BEING CONNECTED, PRIOR TO THE START OF CONSTRUCTION. THE CONTRACTOR SHALL NOTIFY THE ENGINEER IMMEDIATELY IF A CONFLICT IS DISCOVERED.

10. CONTRACTOR SHALL CONTACT NECESSARY FRANCHISE UTILITY COMPANIES PRIOR TO CONSTRUCTION TO LOCATE AND PROTECT IN PLACE OR RELOCATE EXISTING UTILITIES. FOR INSTALLATION OF SERVICE, ROUTE SELECTION, AND OTHER ISSUES PERTAINING TO INSTALLATION.

11. ALL DISCREPANCIES FOUND BY CONTRACTOR RELATED TO UNDERGROUND UTILITIES OR OTHER APPURTENANCES SHALL BE RESOLVED TO THE SATISFACTION OF OWNER AND ENGINEER PRIOR TO CONSTRUCTION. 12. ALL UTILITY PIPES SHALL BE OF ADEQUATE STRENGTH TO SUPPORT THE TRENCH AND AASHTO H-20 HIGHWAY

13. PIPE LENGTHS NOTED ON THE PLAN ARE HORIZONTAL DISTANCES FROM HORIZONTAL APPURTENANCES. ACTUAL PIPE LENGTHS MAY VARY DUE TO ELEVATION CHANGES OR APPURTENANCE DIMENSIONS.

14. THE SITE UTILITY CONTRACTOR SHALL COORDINATE THE INSTALLATION OF NEW UTILITIES WITH FINISHED GRADING AS INDICATED ON THE GRADING PLAN. MINOR ADJUSTMENTS TO THE TOP ELEVATION OF NEW UTILITIES MAY BE

15. ALL UTILITY TRENCHES THAT PENETRATE BENEATH THE BUILDING SHALL BE EFFECTIVELY SEALED TO RESTRICT WATER INTRUSION. CONTRACTOR SHALL INSTALL A CLAY TRENCH PLUG EXTENDING AT LEAST 5 FEET FROM THE EXTERIOR OF THE FOUNDATION WALL.

16. GAS SERVICE LINE AND METER INSTALLATION LOCATION SHALL BE COORDINATED WITH THE PLUMBING PLANS FOR SIZE REQUIREMENTS AND EXACT CONNECTION LOCATION.

17. THE SANITARY SEWER SERVICE ON-SITE SHALL BE PRIVATELY OWNED AND MAINTAINED.

18. COORDINATE SANITARY SEWER SERVICE WITH MEP PLANS. PROVIDE CLEAN OUTS AT 100' MAXIMUM SPACING (STRAIGHT RUNS) AND AT BEND LOCATIONS.

19. ALL PVC PIPE FOR THE SANITARY SEWER MAINS AND SERVICES SHALL BE SDR-35.

20. THE LENGTH OF SANITARY SEWER SERVICE IS THE HORIZONTAL DISTANCE BETWEEN CENTER OF MANHOLE OR BEND TO CENTER OF MANHOLE OR BEND, DISTANCES SHOWN ON PLANS ARE APPROXIMATE AND COULD VARY DUE TO VERTICAL ALIGNMENT AND MANHOLE DIMENSIONS.


21. CONTRACTOR SHALL BE RESPONSIBLE FOR INSTALLING ANY APPURTENANCES ON THE 3/4" DOMESTIC LINE SUCH AS, BUT NOT LIMITED TO, GATE VALVES, REDUCERS, BENDS, TEES, ETC..., WHICH MAY BE REQUIRED.

22. CONTRACTOR TO COORDINATE WATER METER WITH EL PASO COUNTY FOR DOMESTIC WATER SUPPLY, SIZE SHALL MATCH BUILDING PERMIT PLANS.

23. THRUST BLOCKS SHALL BE INCLUDED AT ALL BENDS, TEES, DEFLECTIONS, AND CAPS/PLUGS.


24. FIRE HYDRANT ASSEMBLY TO INCLUDE HYDRANT, LATERAL, VALVES, ETC. AS NOTED ON DETAILS.

оvн —	OVERHEAD UTILITY LINE
ss —	EX. SANITARY SEWER LINE
st <u> </u>	EX. STORM SEWER LINE
EX W ——	EX. WATER LINE
т —	EX. UNDERGROUND TELEPHONE LINE
е ——	EX. UNDERGROUND ELECTRICAL LINE
G —	EX. GAS LINE
= ASBU ICTRAC	ILT INFORMATION PROVIDED BY TOR

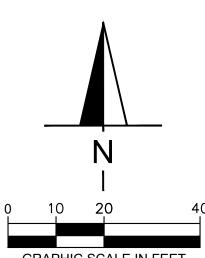






	36 30 30 26	65 IILD 0RT 052 02.5	JF IN CC 5 522	K F G 2 DLI 2.4	C PAR 2, S JIN 901 Ass	КУ 011 5, С	VAY TE 1 CO	Y OC	
		9/18/23							
	REVISION	RESUBMITTAL							
		SUPERSIAR CARWASH			COLORADO SPRING, CO 80915				
C F)a Pro	aw lec te: oje	ct Nu	No mb	0	2	23/2 24-(SE 202	23

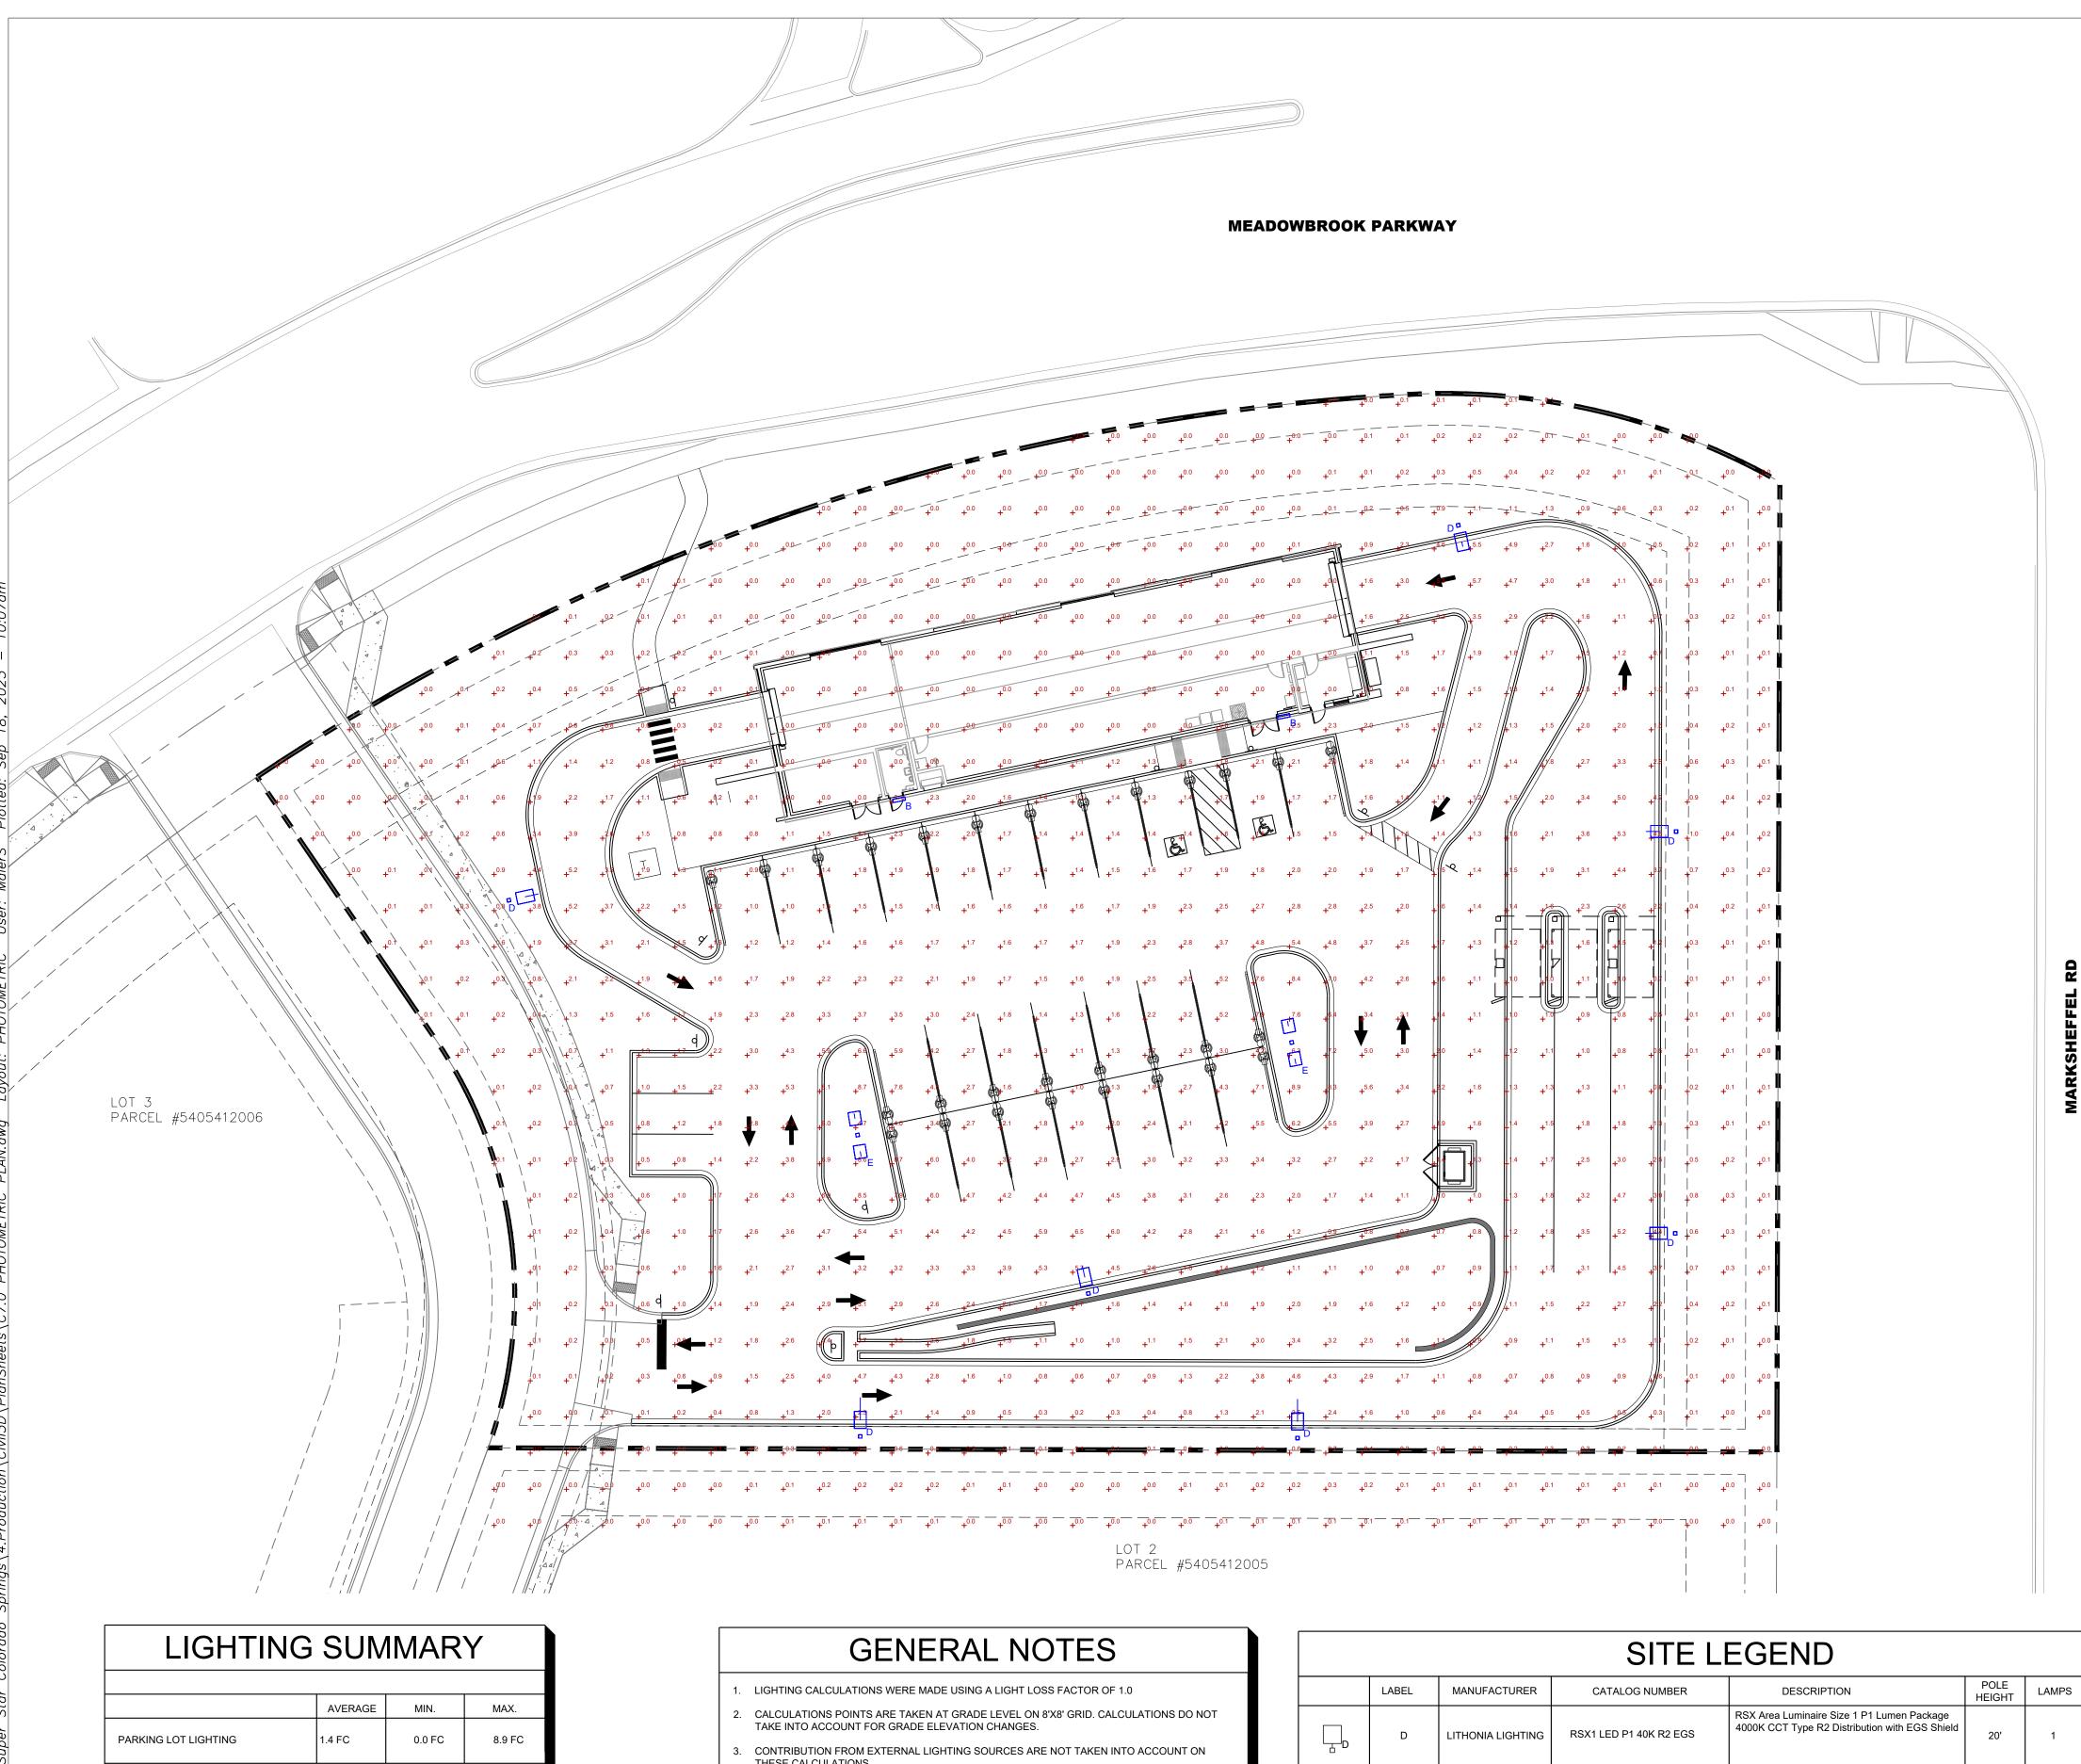

	THESE CALCULATIONS.
4.	CONTRACTOR SHALL SUBMIT SHOP DRAWINGS AND OBTAIN ENGINED TO ORDERING MATERIALS

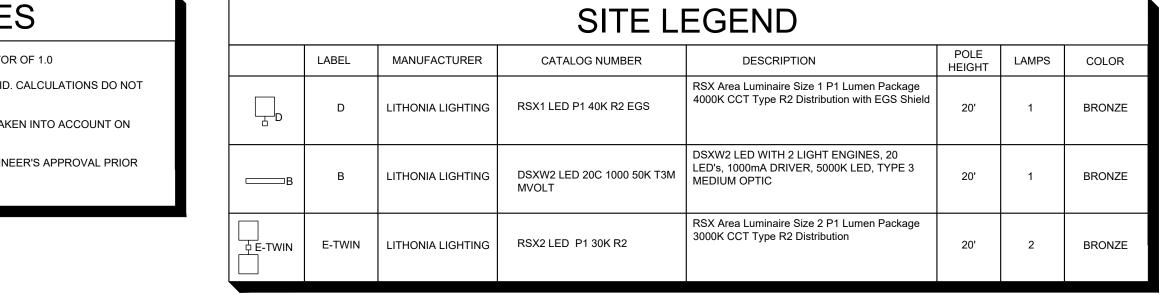

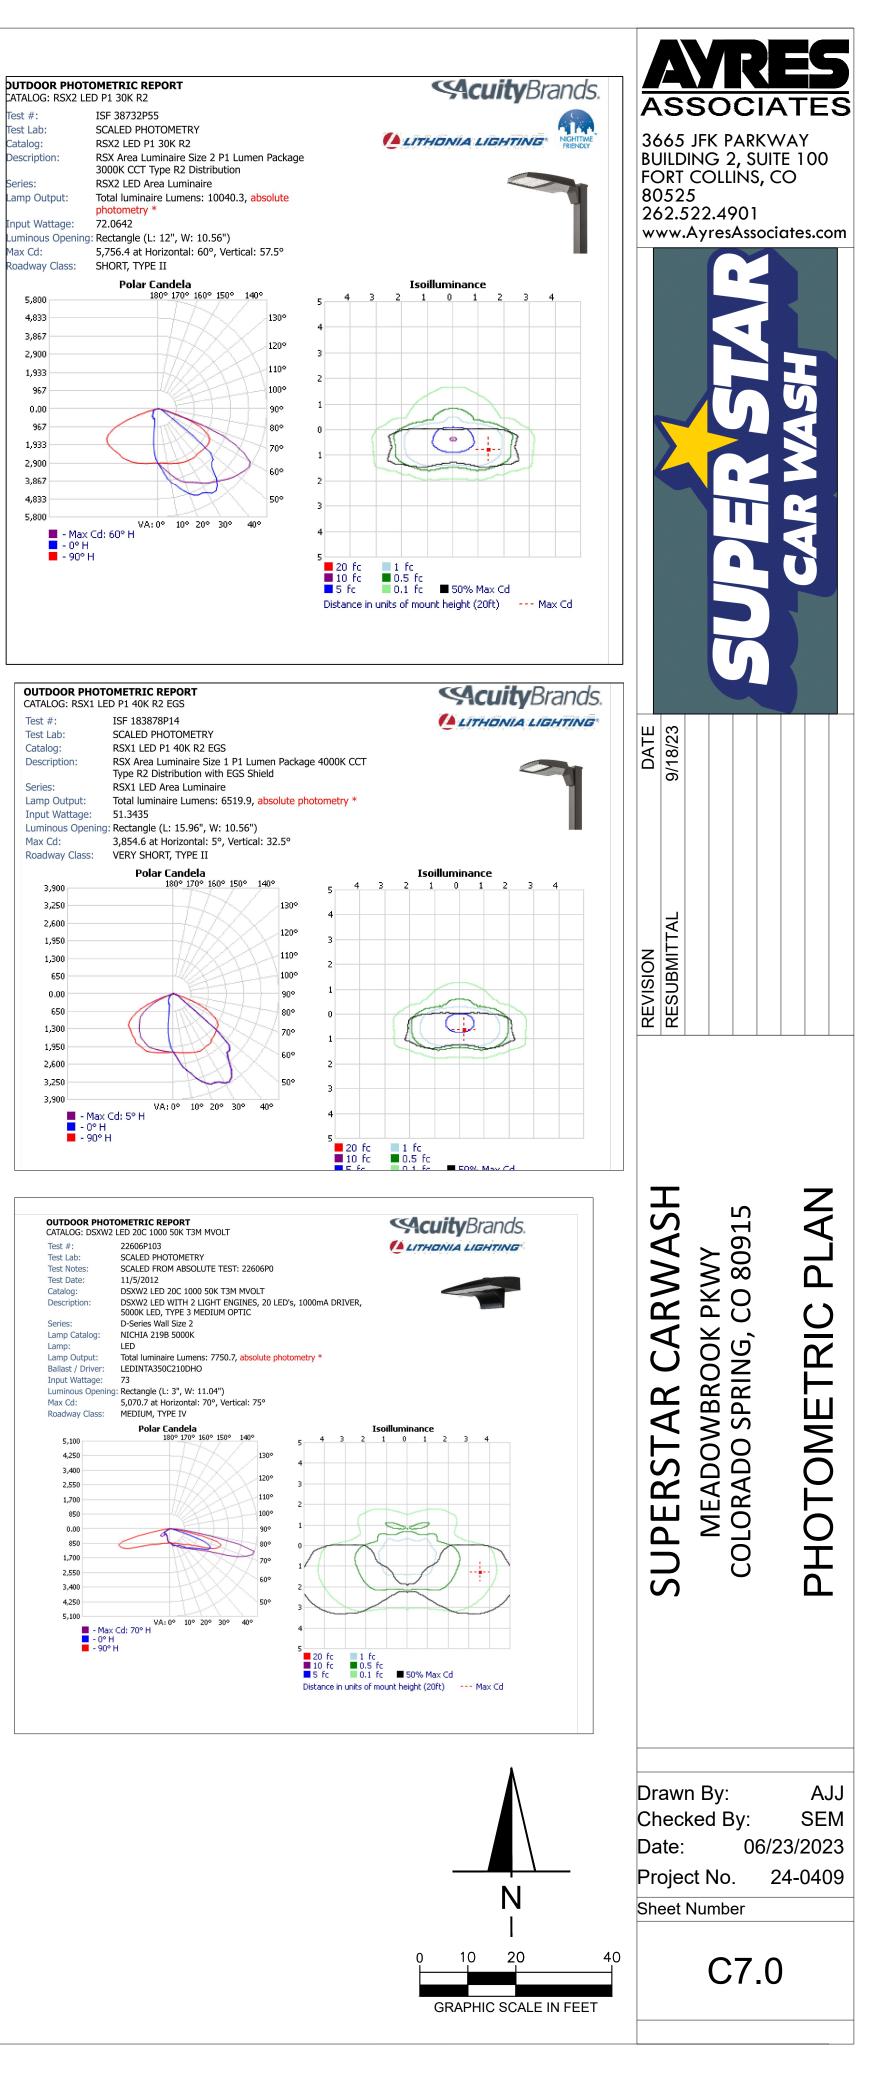

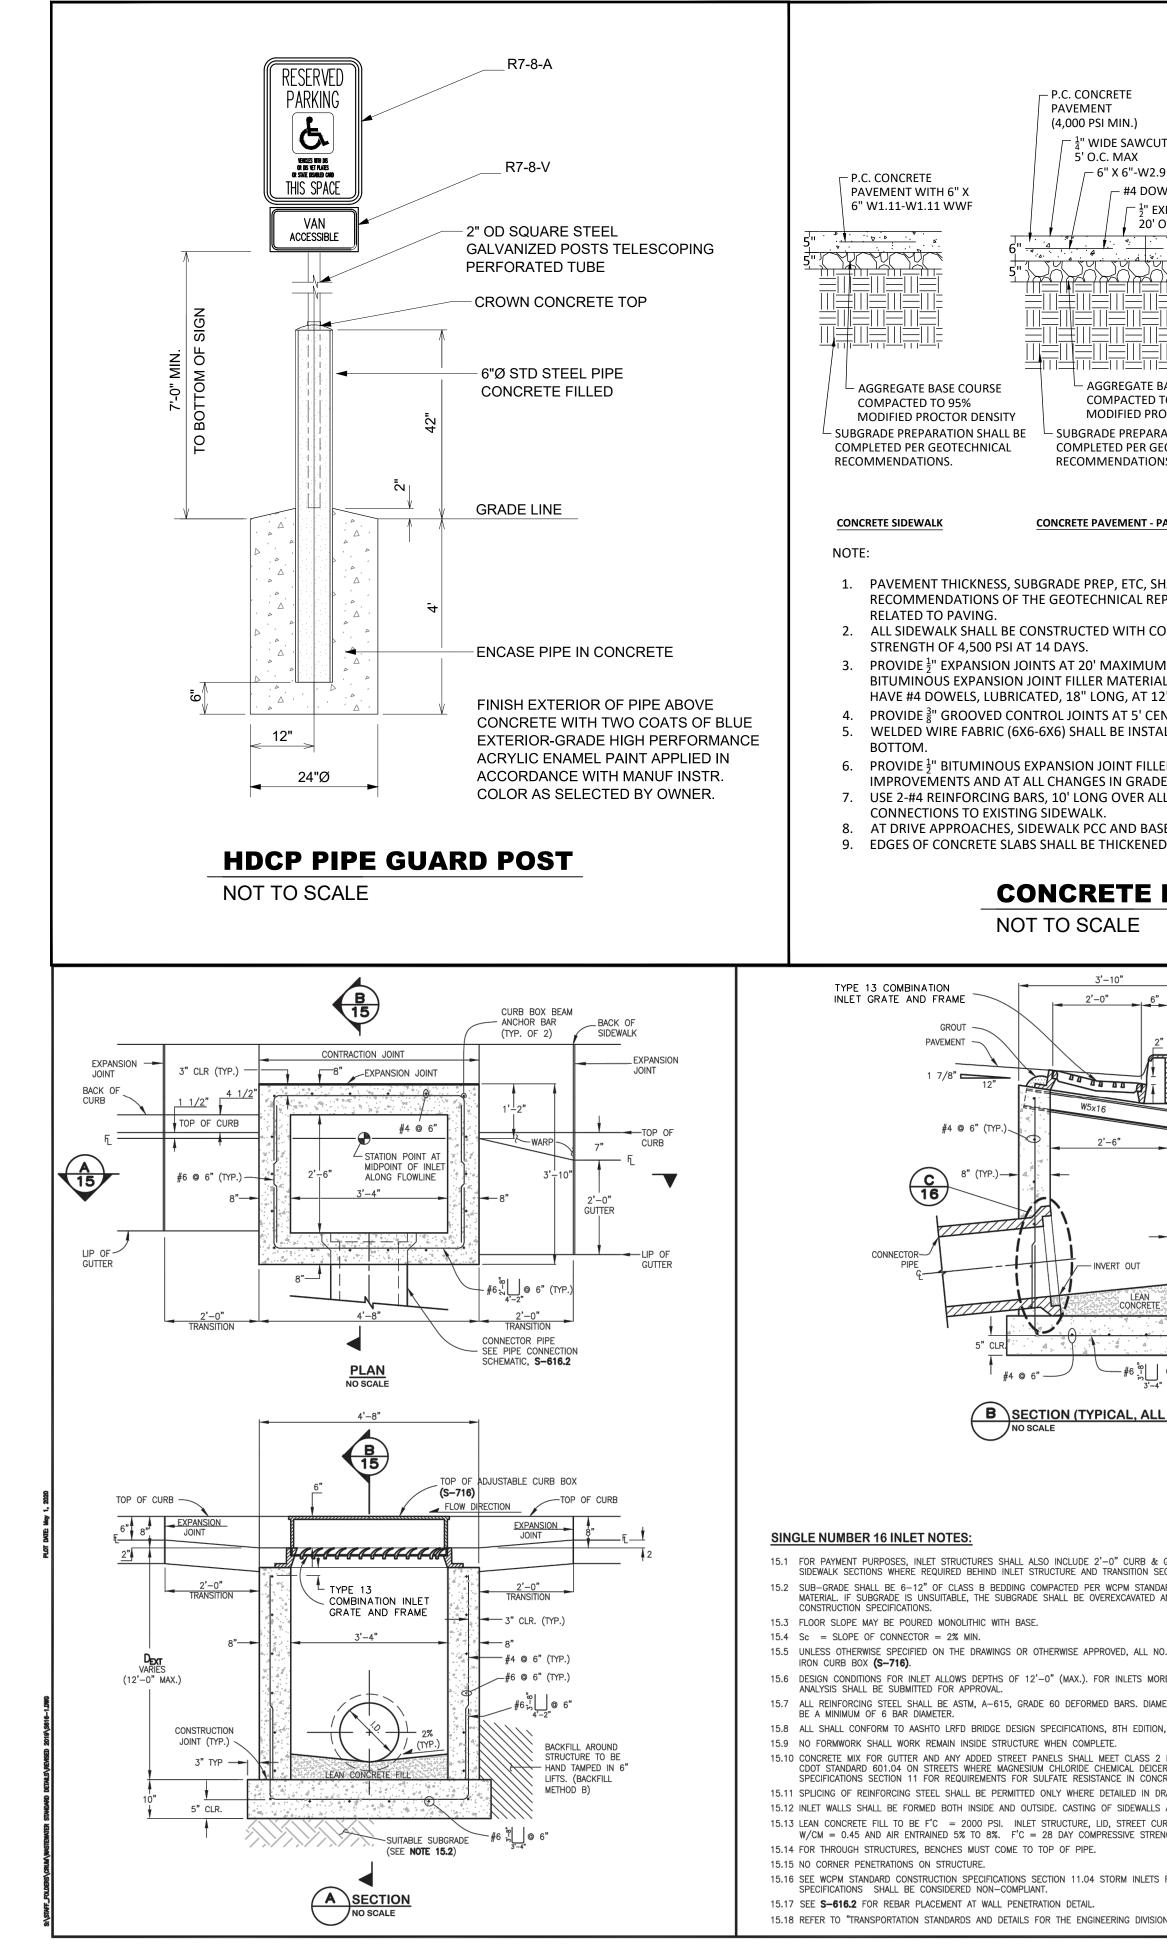

T, 1" DEEP, (4,000 PSI MIN.) 9 X W2.9 WWF 6" X 6"-W2.9 X W2.9 WW WELS @ 18" O.C. #4 DOWELS @ 18" O.C. KPANSION JOINT 20' O.C. MAX OC. MAX 20' O.C. MAX WIDE SAVE COURSE 10' O.C. MAX ASSE COURSE 0 TION SHALL BE AGGREGATE BASE COURSE COMPACTED TO 95% MODIFIED PROCTOR DENSITY ATION SHALL BE SUBGRADE PREPARATION SHALL B COMPLETED PER GEOTECHNICAL RECOMMENDATIONS.	F IT E 1	5' SIDEWALK SLOPE: 2% MAX- 1.5% PREF. 4" 6" 4" 5" 5" MAX SECTION A-A	(REVERSE S (REVERSE S 6"
CONCRETE PAVEMENT - TRASH ENCLOSUS HALL BE CONSTRUCTED PER THE PORT. REFER TO REPORT FOR ALL INFORMATION ONCRETE WITH A MINIMUM COMPRESSIVE A SPACING AND FILLED WITH PREMOLDED AL OR REDWOOD. EXPANSION JOINTS SHALL 2" CENTERS, 6" FROM EDGE. NTERS. ALLED THROUGH DRIVEWAYS AT 2" ABOVE SLAB ER MATERIAL WHERE WALK ABUTS EXISTING E. L UTILITY TRENCHES FOR NEW SIDEWALK AND	GI	$\frac{1}{2^{\prime}-0^{\prime\prime}} \xrightarrow{TO BE POURED MONOLITHICALLY}{TO BE POURED MONOLITHICALLY} \xrightarrow{UTRB} 8.3\% MAX. PREF. CURB AND GUTTER TYPE 2 TO BE POURED MONOLITHICALLY CURB AND GUTTER TYPE 2 TO BE POURED MONOLITHICALLY CURB AND GUTTER TYPE 2 FLOWLINE CURB AND GUTTER TYPE 2$	
BE THICKNESS SHALL MATCH THAT OF THE DRIVE. D TO 12" CONCRETE	DATE APPROVED:	/23/20 Parallel Pedestrian Curb Ramp Detail Standard Drawing Fer E. Irvine REMISION DATE:	6/23/2 date approved: Jennifer E. department of public works
 aDJ. CURB BOX & FRAME (S-716) 2" CLR. (TYP.) (2) #5 (3) CLR. (TYP.) (4) @ 6" (TYP.) (4) @ 6" (TYP.) (5) #4 (5) #6 SIZES)	CITY AND COUNTY OF DENVER 2000 W. 3RD AVE. DENVER, CO 80223 www.denvergov.org		ACCESS AISLE WIDTH PER PLAN (5' MIN STANDARD) B' MIN VAN ACCESS
GUTTER TRANSITION SECTION AT EACH END OF INLET PLUS ECTIONS. ARD CONSTRUCTION SPECIFICATIONS, ON SUITABLE, UNDISTURBED AND STABILIZED WITH CLASS B BEDDING PER WCPM STANDARD O. 16 INLETS SHALL BE CONSTRUCTED WITH AN ADJUSTABLE CAST RE THAN 12'-0" FEET IN DEPTH, SHOP DRAWINGS AND DESIGN HETER OF BEND MEASURED ON THE INSIDE OF THE BAR SHALL N, 2017. REQUIREMENTS FOR SULFATE RESISTANCE IN ACCORDANCE WITH ERS ARE APPLIED. REFER TO WCPM STANDARD CONSTRUCTION CRETE EXPOSED TO EARTH. RAWINGS. AGAINST EARTH IS NOT PERMITTED. JRB AND GUTTER, AND PAVEMENT TO BE F'C = 4,500 PSI, MAX NGTH REQUIREMENT FOR MIX DESIGN, FIELD ACCEPTANCE. FOR MORE INFORMATION. USE OF THIS DETAIL WITHOUT DN" FOR ADJACENT ROADWAY AND SIDEWALK DESIGN CRITERIA.	CT CT CONTRACT OF	NOTES: 1. EACH ACCESSIBLE PARKING SPACE IS TO BE A MINIMUM OF 8 FEET WIDE ANI CARS ADJACENT TO THE SPACE. 2. CONSTRUCTED SLOPES WITHIN THE ACCESSIBLE PARKING SPACES AND ACCESS 3. RAMPS MUST NOT EXTEND OUT FROM THE CURB INTO THE ACCESS AISLE OF 4. CURB AND GUTTER ADJACENT TO OR WITHIN ACCESSIBLE PARKING STALLS SF GUTTER PAN SHALL NOT EXCEED 1:50 OR (2%) SLOPE IN ALL DIRECTIONS. 5. SURFACE STRIPING PAINT SHALL BE FS-TT-P-1952D (WATERBORNE), TYPE II ACCESSIBLE	S AISLES SHALL NO ANY ACCESSIBLE F IALL BE MODIFIED IN ADVERSE CONDITIO


½" EXPANSION JOINT (TYP.)


P.C. CONCRETE

PAVEMENT

4-1/2"

6" WIDE X VARIABLE

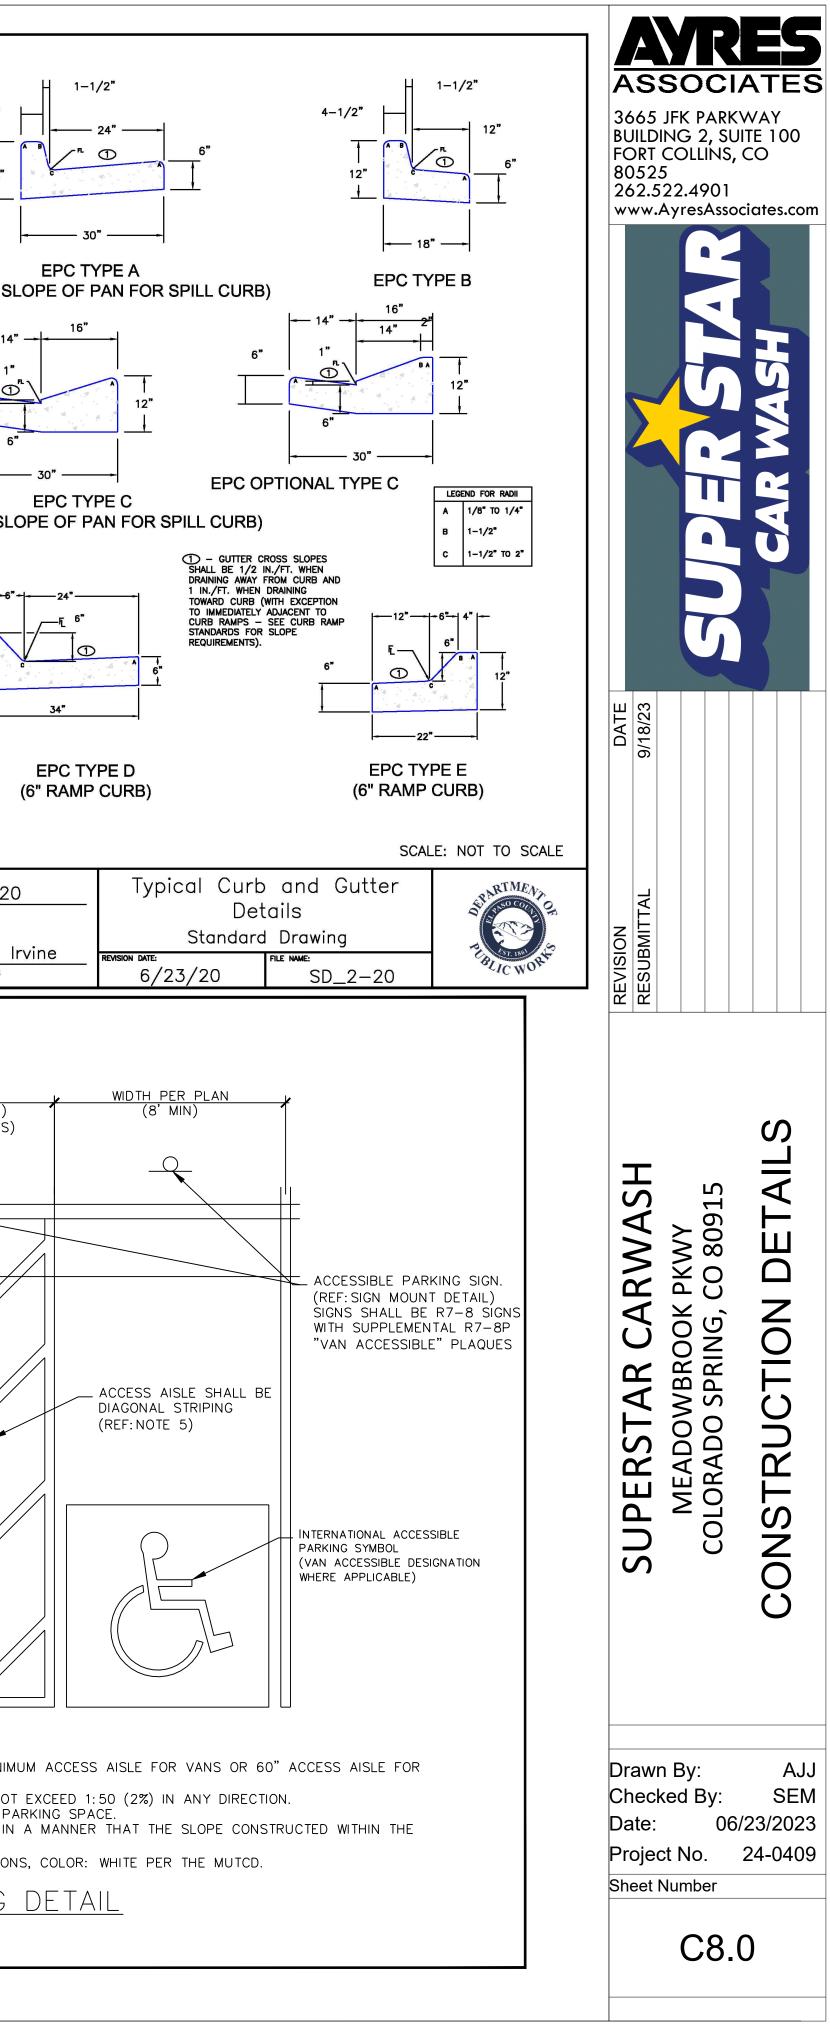

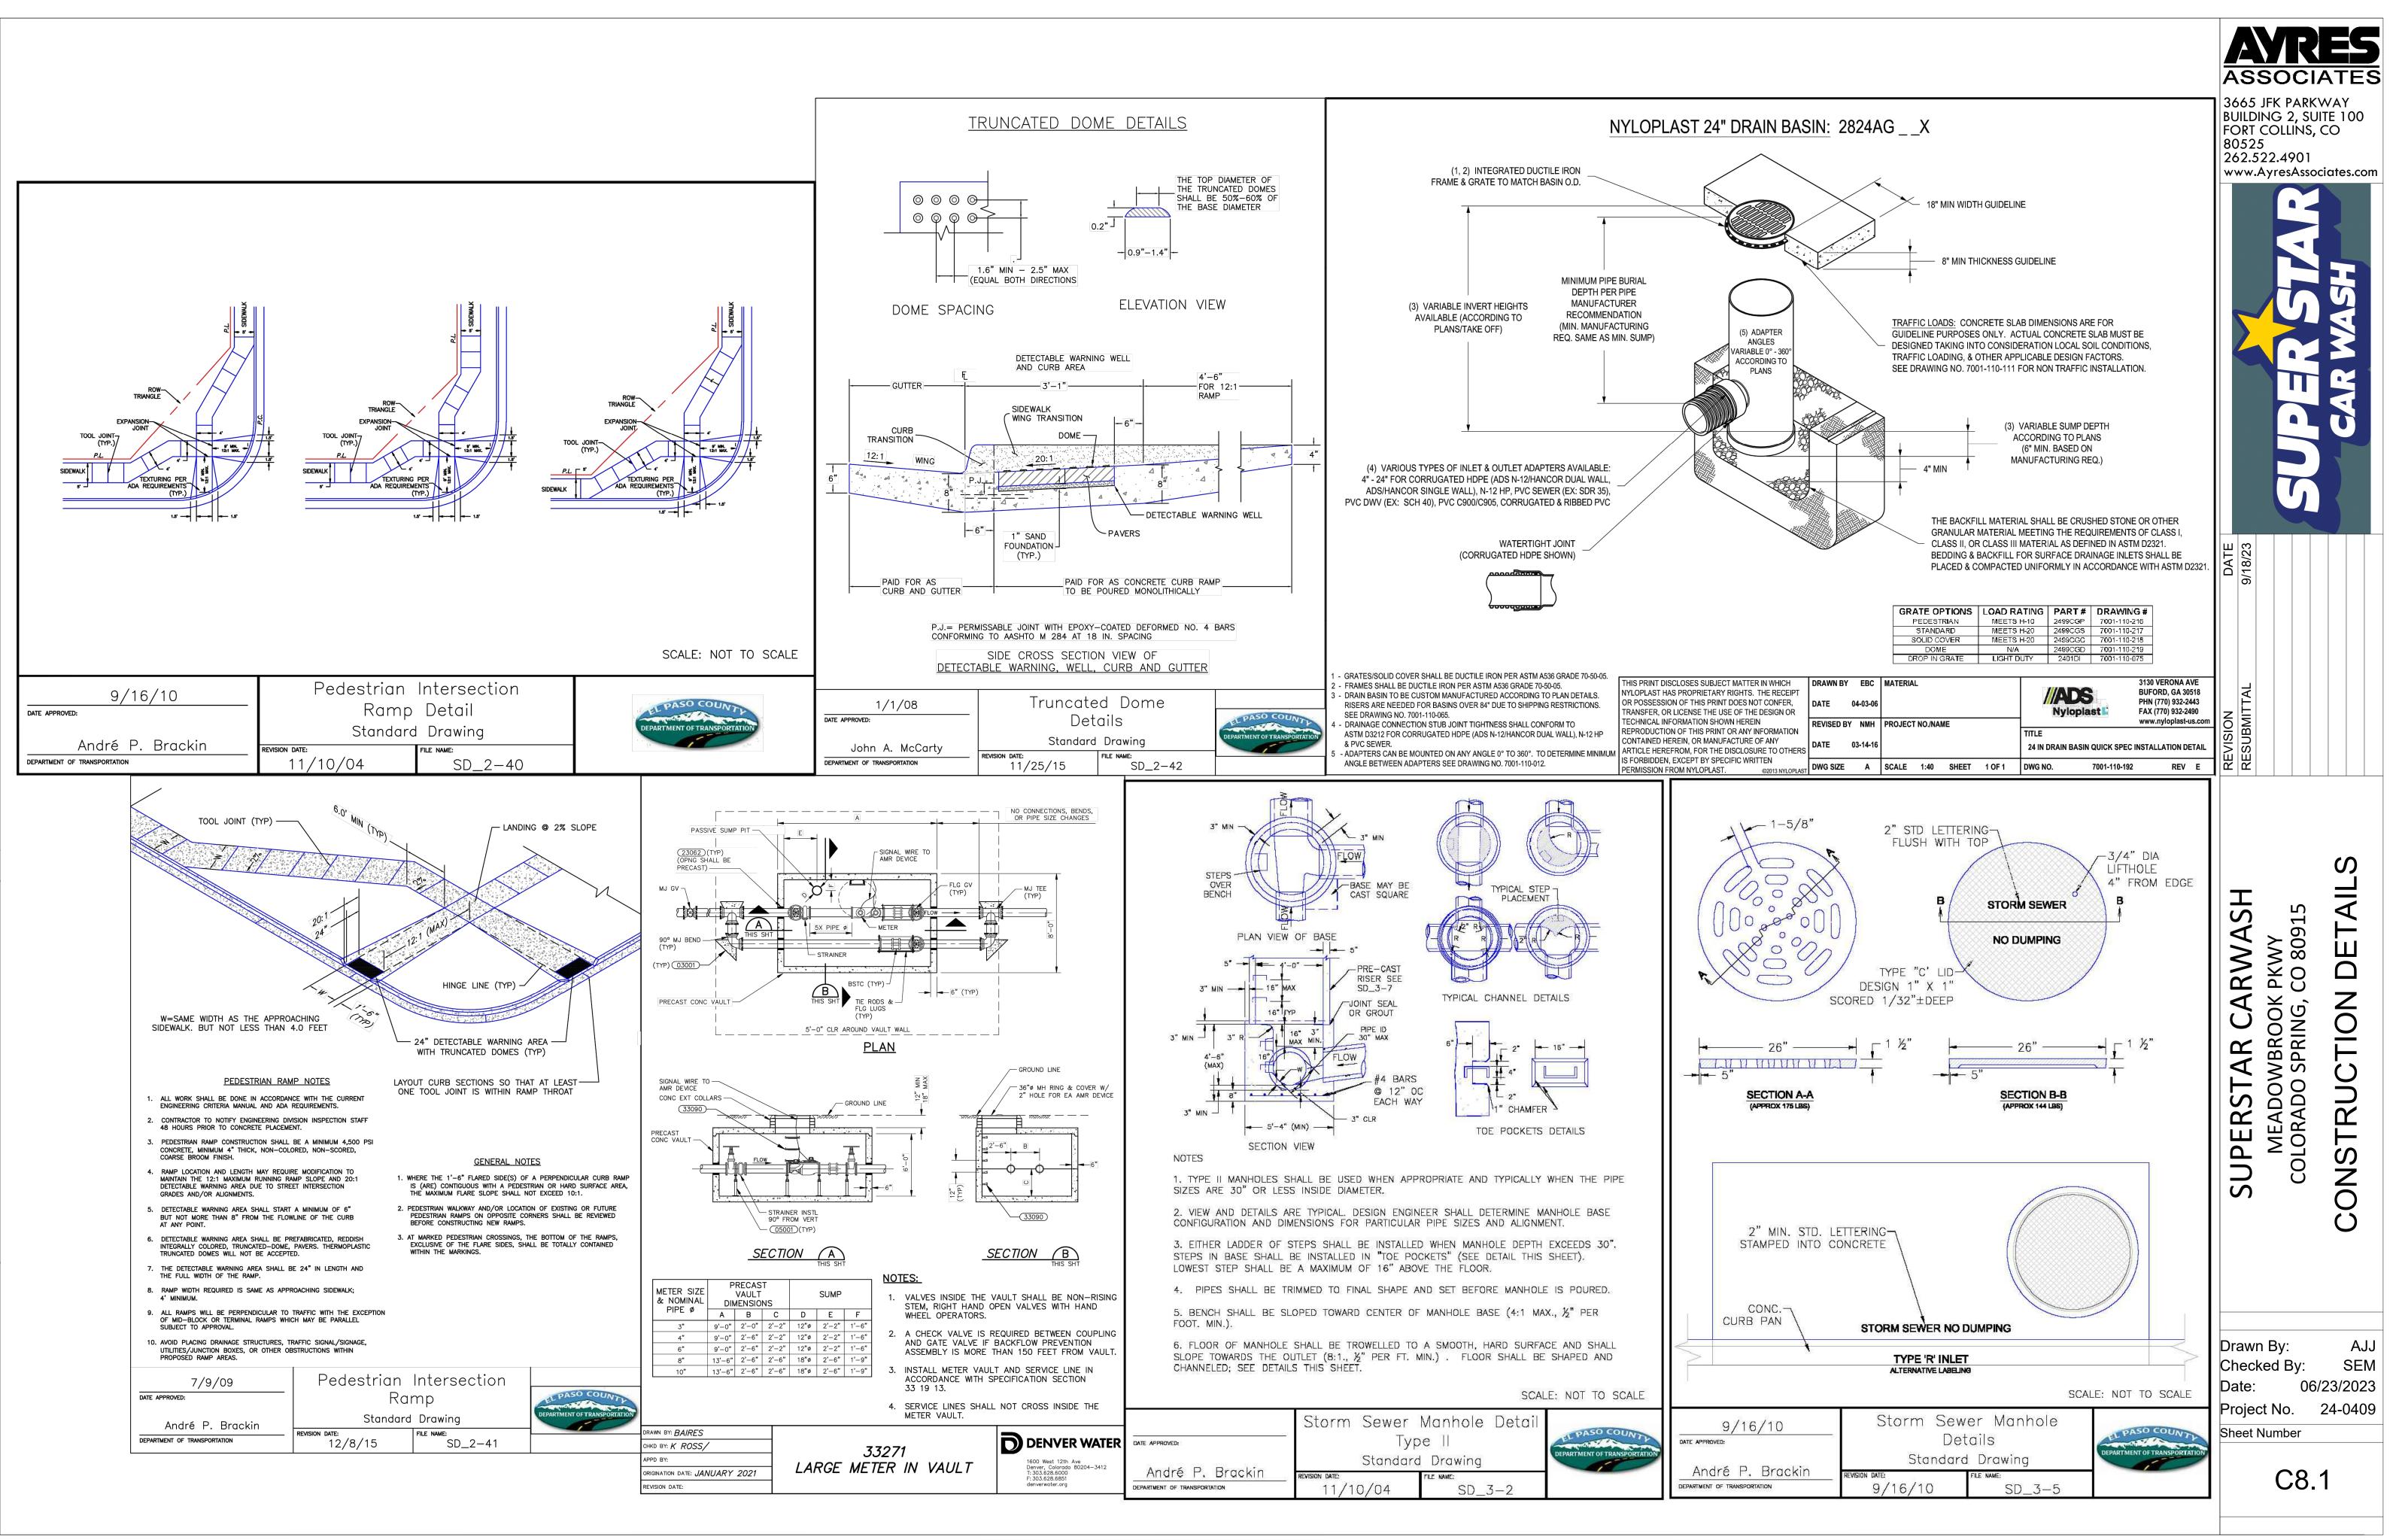

LANDSCAPE CALCULATIONS


LANDSCAPE SETBACKS

STREET NAME OR BOUNDARY	STREET CLASSIFICATION	WIDTH REQUIRED/PROVIDED	LINEAR FOOTAGE	TREE/FEET REQUIRED	NO. OF TREES REQUIRED/PROVIDED
MEADOWBROOK PARKWAY (NORTH BOUNDARY)	NONARTERIAL	10'/10'	336'-8"	1 TREE/30'	12 TREES/12 TREES
MARKSHEFFEL ROAD (EAST BOUNDARY)	MAJOR ARTERIAL	25'/25'	214'-6"	1 TREE/20'	11 TREES/11 TREES
SOUTH ZONE BOUNDARY	NONSTREET ZONE BOUNDARY	-	285'-1"	1 TREE/30'	10 TREES/**100 SHRUBS
WEST ZONE BOUNDARY	NONSTREET ZONE BOUNDARY	-	148'-5"	1 TREE/30'	5 TREES/5 TREES

* DUE TO EXISTING EASEMENT, TREES ARE UNABLE TO BE PLANTED ALONG SOUTH BOUNDARY. TEN (10 SHRUBS WITH A MINIMUM CONTAINER SIZE OF FIVE (5) GALLONS HAVE BEEN PROVIDED PER EACH REQUIRED TREE. DUE TO LIMITED SPACE, 56 SHRUBS HAVE BEEN PROVIDED ALONG SOUTH BOUNDARY. THE REMAINING 44 SHRUBS REQUIRED HAVE BEEN PROVIDED IN THE NORTHEAST AND NORTHWEST CORNERS.

TREES/3 TREES	MEADOWBROOK PARKWAY MARKSHEFFAL ROAD SOUTH SIDE WEST SIDE ER COBBLE SOD, TYP. ATA (2) [NV] SDM (4) [NV] PMS (4) CYS (3) ACM (8)	106'-2" 152'-6" 106'-6"	ISTING WALK TO REMAIN	O" VEHICULAR LOT FRONTAGE SO" VEHICULAR LOT FRONTAGE C	(3) QRC (3) A (3) QRC (3) A (3) A (3	
RIVE BLUEGRASS	SOUTH SIDE WEST SIDE	152'-6" 106'-6" EX EX EX EX EX EX EX EX EX EX EX EX EX	101'-7" 71'-0"	119'-7" 81'-10" MEADOWBROOK 336'-8	30/29 18/18 PARKWAY 8" (3) QRC (3) A (3) QRC (3) A (3) A (3) QRC (3) A (3) (A)(3) (A)(A)(A)(A)(A)(A)(A)(A)(A)(A)(A)(A)(A)(
BLUEGRASS	WEST SIDE	106'-6"	71'-0"	81'-10" MEADOWBROOK 336'-8	18/18 PARKWAY (3) QRC (3) A (3) QRC (3) A STEEL EDGING, TYP JPER STAR AR WASH	
BLUEGRASS	ATA (2) [NV] SDM (4) [NV] PMS (4) CYS (3) ACM (8)	(2) PDS (2) PDS (5) YGL	ISTING WALK TO REMAIN	SLOT VEHICULAR LOT FRONTAGE	(3) QRC (3) A (3) QRC (3) A (3) A (3	
BLUEGRASS	ATA (2) [NV] SDM (4) [NV] PMS (4) CYS (3) ACM (8)	(2) PDS (2) PDS (5) YGL	REMAIN	O" VEHICULAR LOT FRONTAGE SO" VEHICULAR LOT FRONTAGE C	(3) QRC STEEL EDGING, TYP. JPER STAR AR WASH	
BLUEGRASS	ATA (2) [NV] SDM (4) [NV] PMS (4) CYS (3) ACM (8)	(5) PMS (2) POS (5) YGL		SIC C	STEEL EDGING, TYP. JPER STAR AR WASH	
BLUEGRASS	ATA (2) [NV] SDM (4) [NV] PMS (4) CYS (3) ACM (8)	(5) PMS (2) POS (5) YGL	INV	S-O" VEHICULAR LOT FRONTAGE S-O" VEHICULAR LOT FRONTAGE SLOT SLOT SLOT SLOT SLOT SLOT SLOT SLOT	JPER STAR CAR WASH	
AS (5) QRC (2)	ATA (2) [NV] SDM (4) [NV] PMS (4) CYS (3) ACM (8)	(5) PMS (2) POS (5) YGL	INV	S-O" VEHICULAR LOT FRONTAGE S-O" VEHICULAR LOT FRONTAGE SLOT SLOT SLOT SLOT SLOT SLOT SLOT SLOT	JPER STAR CAR WASH	
QRC (2)	[NV] SDM (4) [NV] PMS (4) CYS (3) ACM (8)	(5) PMS (2) POS (2) POS (5) YGL	INV	S-O" VEHICULAR LOT FRONTAGE S-O" VEHICULAR LOT FRONTAGE SLOT SLOT SLOT SLOT SLOT SLOT SLOT SLOT	JPER STAR CAR WASH	
QRC (2)	[NV] SDM (4) [NV] PMS (4) CYS (3) ACM (8)	(5) PMS (2) POS (2) POS (5) YGL	INV	C	JPER STAR CAR WASH	
QRC (2)	[NV] SDM (4) [NV] PMS (4) CYS (3) ACM (8)	(5) PMS (2) POS (2) POS (5) YGL	INV	C	CAR WASH	
QRC (2)	[NV] PMS (4) CYS (3) ACM (8) CYS (3) CYS (3) C	(5) PMS (2) POS (2) POS (5) YGL	INV	C	CAR WASH	
QRC (2)		(5) PMS (2) POS (2) POS (5) YGL	INV	C	CAR WASH	
QRC (2)		(5) PMS (2) POS (2) POS (5) YGL	INV	C	CAR WASH	
QRC (2)		(5) PMS (2) POS (2) POS (5) YGL	INV	C	CAR WASH	
QRC (2)		(5) PMS (2) POS (2) POS (5) YGL				
QRC (2)		(2) ¹ POS (2) ² POS (5) YGL				
QRC (2)		(5) YGL				
QRC (2)		(5) YGL				
	and a start	(c) + C2 (c) GTI			TR I R	
✓ POC (3)						
						\uparrow
\CAF (8)			6) [°] CAF 7) [°] ARC			
					IT-	
		Contraction of the second seco	(196 ³), -		'	Y
				 F	W	
] CYS (5) V] PMS (8)	Saw.				
				W-W-W-		
M //			W () ()			P
		3				N
/////	\ \{\+{E}}	イ・ミート ノ				
\langle / \rangle						
- `\\\!!				⊖ ⊖ ⊖ ⊖ ⊖ ⊖ C RETAI		V] YGL (9)—
					RE: CIVIL [SV	V] HSE (7)—
	GTI (1)	Jung 20 1				
	[WV] YGL (8)			SV] HSE (9) SV] ARC (8)	TT STOL	CICILCI C
		A The Frank		SV] ARC (4)	(1 ,	R
					00000000000	OCHOR
				ATA ATA		
		ARC (6) RAG (8)	PBE (5)	PML (6)	PMS (5)	PBE (5)
H I I						
					AGE IVEWAY)	
7 / / / ,		$+/$ \sim \setminus		152'-6" VEHICOL 152'-6" TOTAL FRONTAGE - 20 DA	285'-1"	ZONING: CO SERVICE
		+	(177	L		
1 1 // /		1				
		[WV] PBS (3) [WV] HSE (7) [WV] ARC (5) GTI (1) [WV] YGL (8)	IWV] PBS (3) BGB PBS BGB IWV] HSE (7) Image: Comparison of the second secon	Image: PBS (3) Image: PBS (5) BGB (5) PBS (5) BGB (8) Image: PBS (5) BGB (8) Image: PBS (5) Image: PBS (7) Image: PBS (7) Image: PBS (7) Image: PBS (7)	Image: Second	Image: provide state st

NET SITE AREA (SF) 64,658 SF

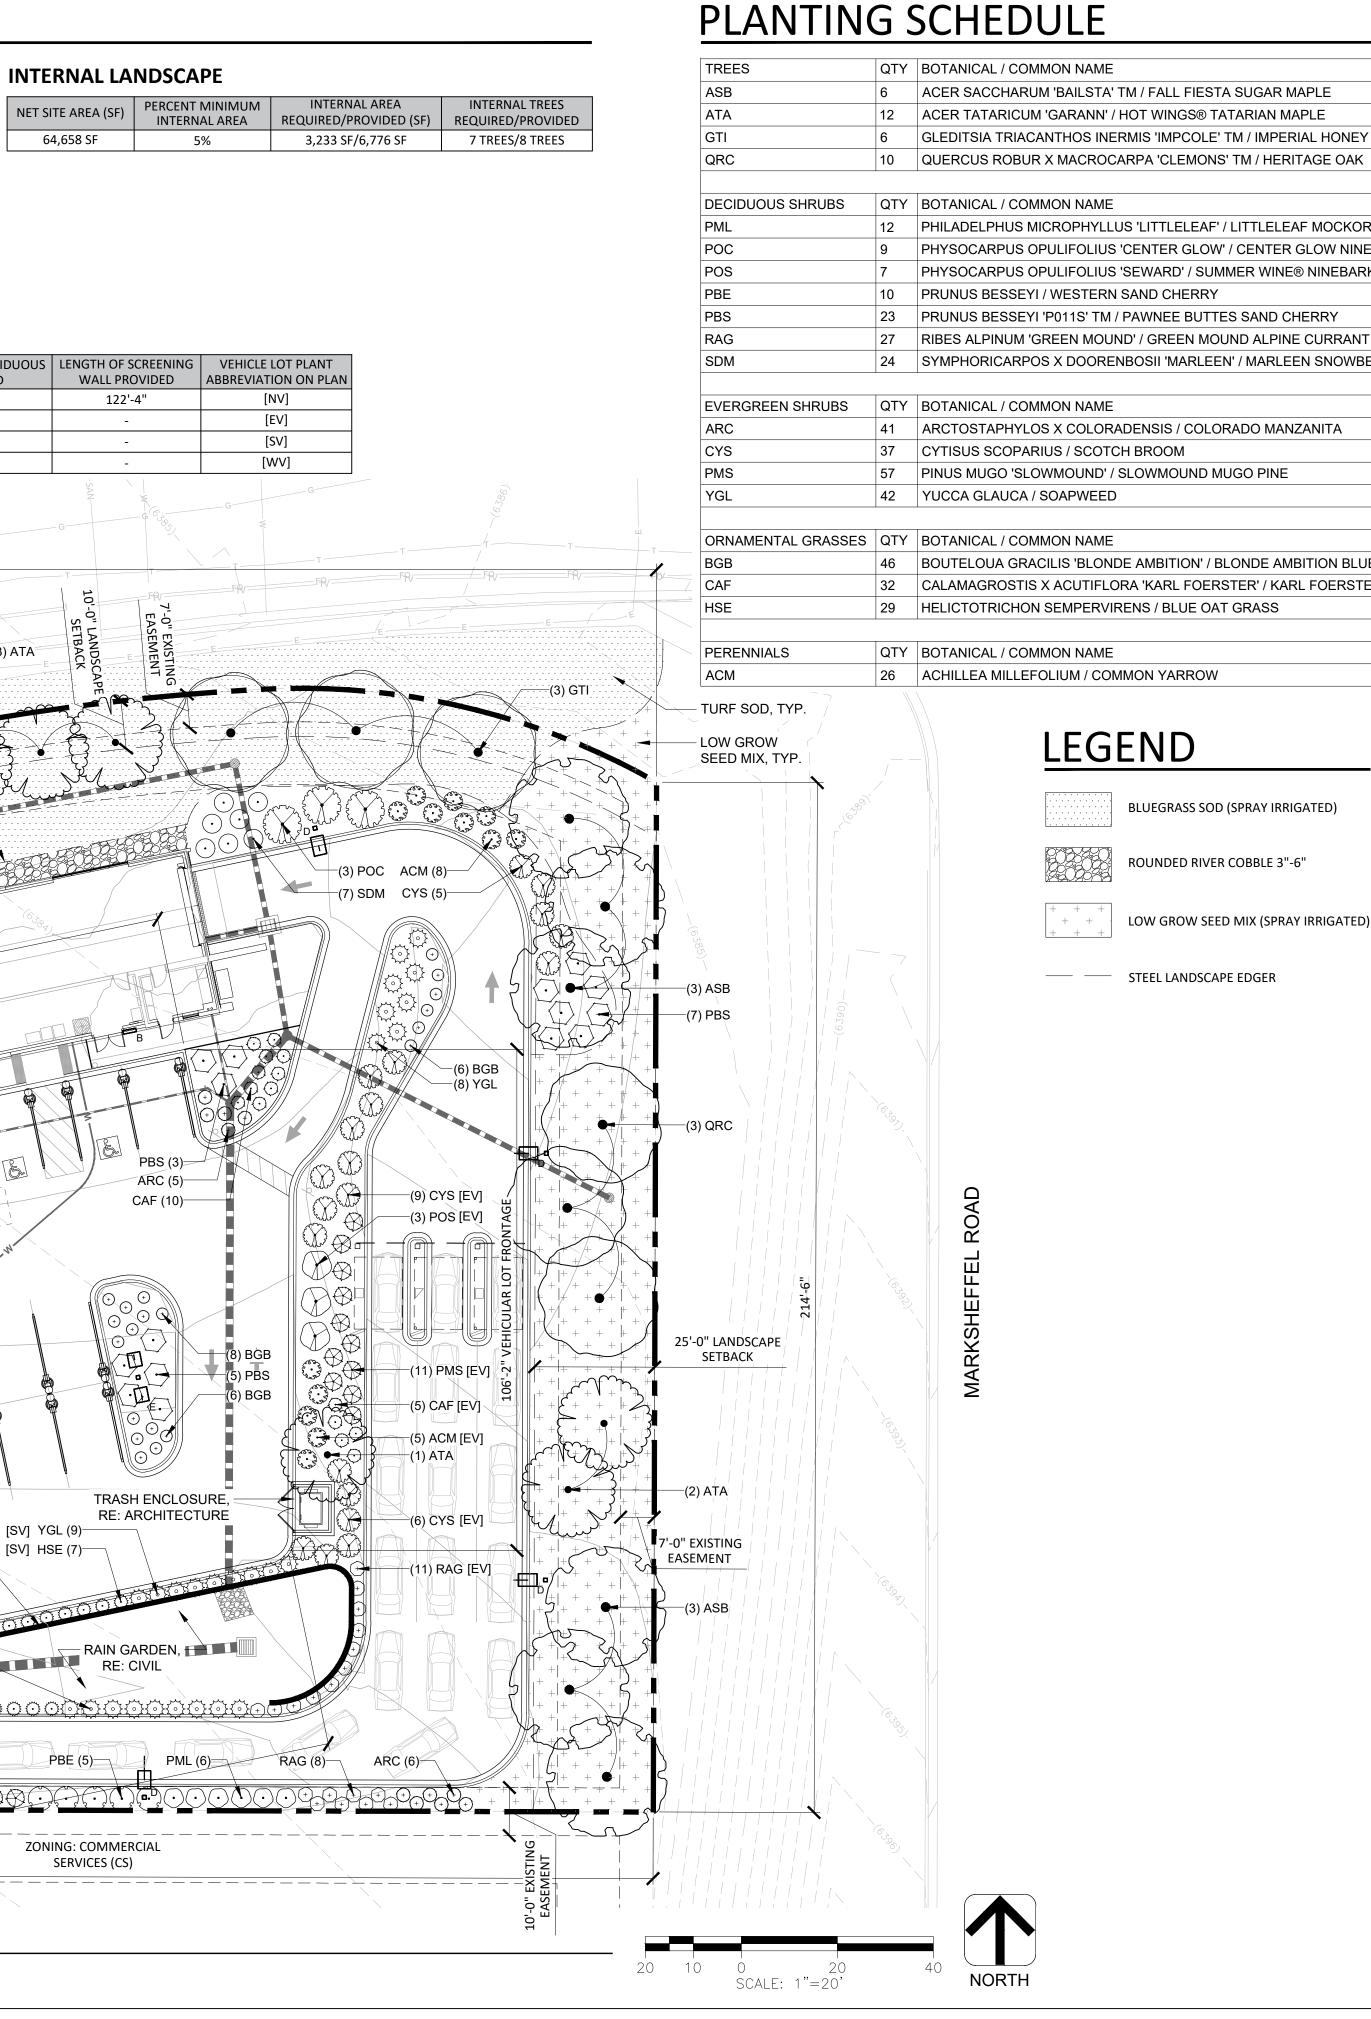

	CONT	CAL	MATURE HEIGHT	MATURE WIDTH
IAPLE	B&B	2"	40 - 65FT. HT.	25 - 40FT W.
APLE	B&B	2"	15 - 25FT. HT.	15 - 25FT. W.
RIAL HONEY LOCUST	B&B	2"	25 - 40FT. HT.	25 - 40FT. W.
ITAGE OAK	B&B	2"	40 - F' HT.	25 - 40FT' W.
	CONT		MATURE HEIGHT	MATURE WIDTH
AF MOCKORAGE	5 GAL.		4 - 5FT. HT.	5FT. W.
GLOW NINEBARK	5 GAL.		6 - 10FT. HT.	6 - 8FT. W.
® NINEBARK	5 GAL.		3 - 6FT. HT.	3 - 6FT. W.
	5 GAL.		12 - 18IN. HT.	4 - 6FT. W.
HERRY	5 GAL.		6 - 18IN. HT.	3 - 6FT. W.
E CURRANT	5 GAL.		2 - 3FT. HT.	2 - 3FT. W.
EN SNOWBERRY	5 GAL.		3 HT.	3FT. W.
	CONT		MATURE HEIGHT	MATURE WIDTH
ZANITA	5 GAL.		6 - 18IN. HT.	10 - 15FT. W.
	5 GAL.		4 - 6FT. HT.	4 - 6FT. W.
	5 GAL.		18 - 36IN. HT.	3 - 6FT. W.
	5 GAL.		2 - 4FT. HT.	2 - 4FT. W.
	CONT		MATURE HEIGHT	MATURE WIDTH
BITION BLUE GRAMA	5 GAL.		18 - 36IN. HT.	1 - 3FT. W.
RL FOERSTER FEATHER REED GRASS	5 GAL.		3 - 6FT. HT.	1 - 3FT. W.
	5 GAL.		18 - 36IN. HT.	1 - 3FT. W.
	CONT		MATURE HEIGHT	MATURE WIDTH
	1 GAL.		2 - 3FT. HT.	1 - 3FT. W.

LOW GROW SEED MIX

GATED)	
5"	

TYPE % OF MIX POUNDS PLS* 30% EPHRAIM CRESTED WHEATGRASS 25% SHEEP FESCUE 20% PERENNIAL RYE 15% CHEWINGS FESCUE 10% CANADA BLUEGRASS TOTAL PLS: 100% LOW GROW SEED MIX BY ARKANSAS VALLEY SEED SEEDING RATE:

TOTAL 50 PLS#/ACRE - DRILL SEEDED AT HALF RATE; TWO

DIFFERENT DIRECTIONS, PERPENDICULAR TO ONE ANOTHER.

*PLS = PURE LIVE SEED

Z く SH 15 Ω ARWA σ 4 80 \bigcirc PK/ CO S AND XO MEADOWBROOK COLORADO SPRING, SUPERSTAR Щ ∠ I RNA Ш く Drawn By: ME Checked By: DL 06/23/2023 Date: Project No. 24-0409 Sheet Number L1.0


AYRES

ASSOCIATES

3665 JFK PARKWAY BUILDING 2, SUITE 100 FORT COLLINS, CO


www.AyresAssociates.com

80525 262.522.4901

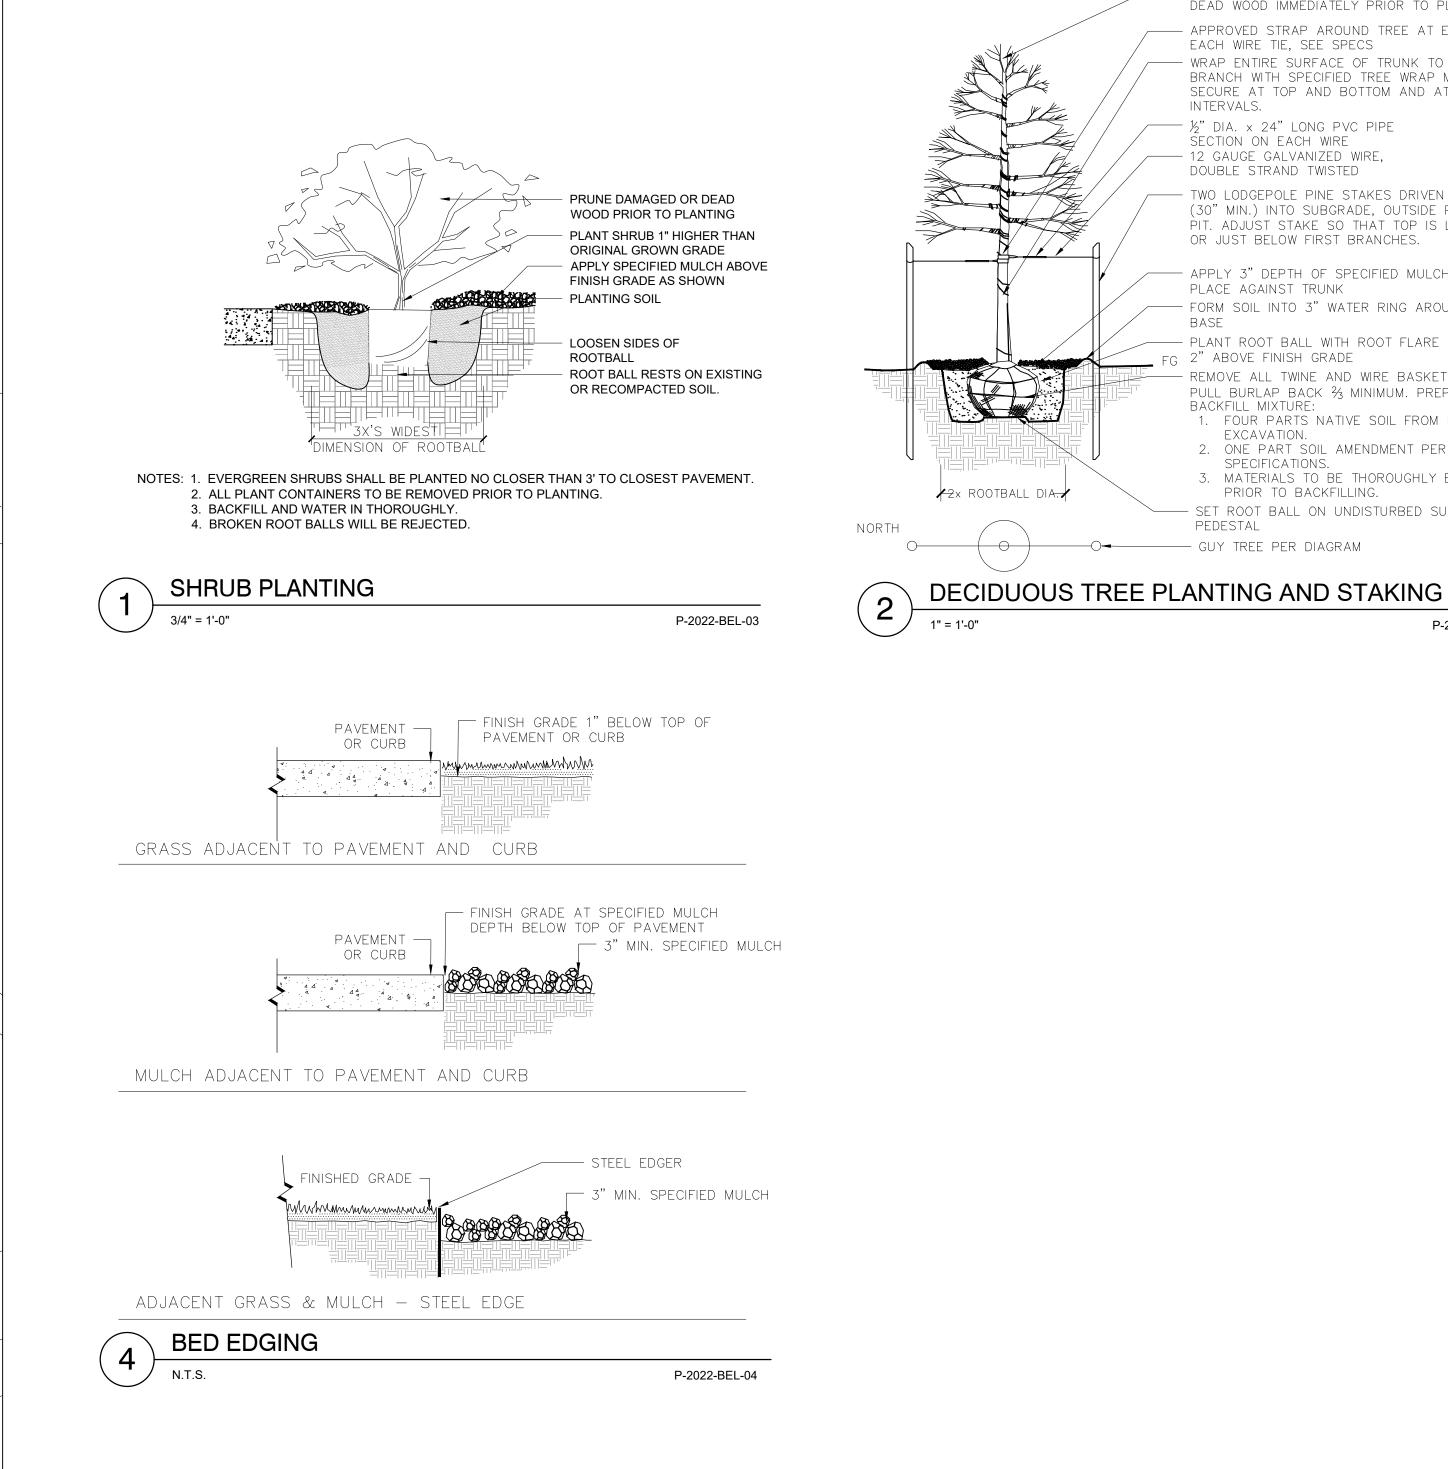

- DO NOT CUT LEADER PRUNE DAMAGED OR DEAD WOOD IMMEDIATELY PRIOR TO PLANTING - APPROVED STRAP AROUND TREE AT END OF EACH WIRE TIE, SEE SPECS - WRAP ENTIRE SURFACE OF TRUNK TO SECOND BRANCH WITH SPECIFIED TREE WRAP MATERIAL SECURE AT TOP AND BOTTOM AND AT 2 FT. INTERVALS. ½" DIA. x 24" LONG PVC PIPE SECTION ON EACH WIRE — 12 GAUGE GALVANIZED WIRE, DOUBLE STRAND TWISTED TWO LODGEPOLE PINE STAKES DRIVEN FIRMLY (30" MIN.) INTO SUBGRADE, OUTSIDE PLANTING PIT. ADJUST STAKE SO THAT TOP IS LEVEL WITH OR JUST BELOW FIRST BRANCHES. - APPLY 3" DEPTH OF SPECIFIED MULCH, DO NOT PLACE AGAINST TRUNK - FORM SOIL INTO 3" WATER RING AROUND TREE BASE - PLANT ROOT BALL WITH ROOT FLARE PLANTED FG 2" ABOVE FINISH GRADE REMOVE ALL TWINE AND WIRE BASKET ENTIRELY. PULL BURLAP BACK 3/3 MINIMUM. PREPARED
- BACKFILL MIXTURE: 1. FOUR PARTS NATIVE SOIL FROM PIT EXCAVATION.
- 2. ONE PART SOIL AMENDMENT PER SPECIFICATIONS.
- 3. MATERIALS TO BE THOROUGHLY BLENDED PRIOR TO BACKFILLING.
- SET ROOT BALL ON UNDISTURBED SUBSOIL PEDESTAL

- - P-2022-BEL-01

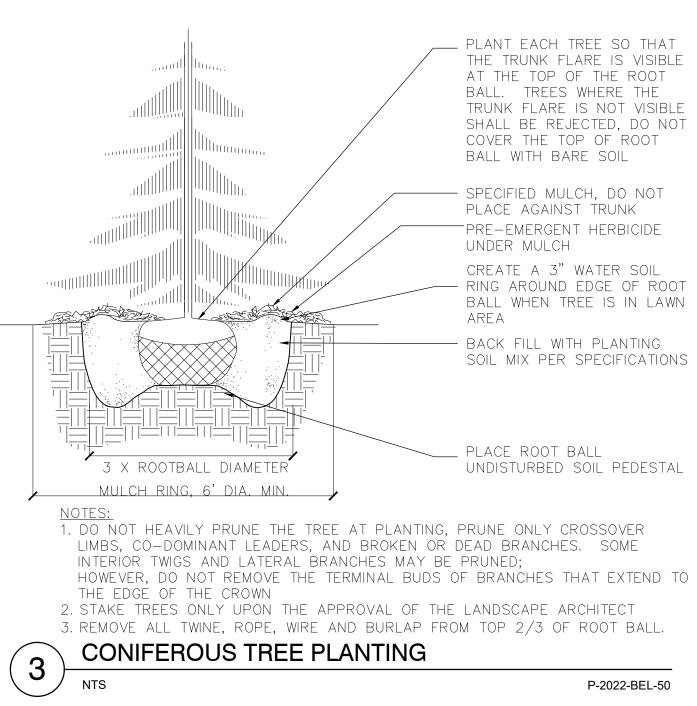


- 4. ALL PLANTING BEDS ADJACENT TO LAWN SHALL HAVE STEEL EDGING AS INDICATED ON PLANS.


- ALLOWED. LANDSCAPE ARCHITECT SHALL BE NOTIFIED OF ANY NOTABLE CONFLICTS AND PROPOSE

- 3. CONTRACTOR TO FIELD VERIFY ALL UTILITY LOCATIONS AND DIMENSIONS. MINOR ADJUSTMENTS TO

- TO HEAD SPRAY COVERAGE. OWNER TO BE RESPONSIBLE FOR IRRIGATION MAINTENANCE. 2. THIS PLAN DESCRIBES THE LANDSCAPE PORTION OF THE PROJECT ONLY. SEE OTHER SHEETS FOR

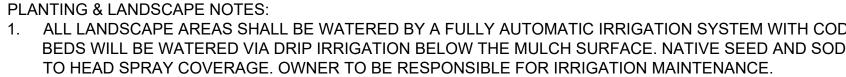

	PLANT EACH TREE SO THAT THE TRUNK FLARE IS VISIBLE AT THE TOP OF THE ROOT BALL. TREES WHERE THE TRUNK FLARE IS NOT VISIBLE SHALL BE REJECTED, DO NOT		3665 JFK PARKWAY BUILDING 2, SUITE 100 FORT COLLINS, CO 80525 262.522.4901 www.AyresAssociates.com
	COVER THE TOP OF ROOT BALL WITH BARE SOIL SPECIFIED MULCH, DO NOT PLACE AGAINST TRUNK PRE-EMERGENT HERBICIDE UNDER MULCH		
	CREATE A 3" WATER SOIL — RING AROUND EDGE OF ROOT BALL WHEN TREE IS IN LAWN AREA — BACK FILL WITH PLANTING		S S
	SOIL MIX PER SPECIFICATIONS		
Mulch Ring, 6' Dia. Min.	PLACE ROOT BALL UNDISTURBED SOIL PEDESTAL		
1. DO NOT HEAVILY PRUNE THE TREE AT PLANTIN LIMBS, CO-DOMINANT LEADERS, AND BROKEN INTERIOR TWIGS AND LATERAL BRANCHES MAY HOWEVER, DO NOT REMOVE THE TERMINAL BUD THE EDGE OF THE CROWN	OR DEAD BRANCHES. SOME BE PRUNED;		S
2. STAKE TREES ONLY UPON THE APPROVAL OF 3. REMOVE ALL TWINE, ROPE, WIRE AND BURLAP CONIFEROUS TREE PLANTING	FROM TOP 2/3 OF ROOT BALL.		DATE
NTS	P-2022-BEL-50		
			REVISION
 PLANTING & LANDSCAPE NOTES: 1. ALL LANDSCAPE AREAS SHALL BE WATERED BY A FULLY BEDS WILL BE WATERED VIA DRIP IRRIGATION BELOW TH TO HEAD SPRAY COVERAGE. OWNER TO BE RESPONSIBIL 	E MULCH SURFACE. NATIVE SEED AND SOD		
 THIS PLAN DESCRIBES THE LANDSCAPE PORTION OF TH CONTRACTOR TO FIELD VERIFY ALL UTILITY LOCATIONS ALLOWED. LANDSCAPE ARCHITECT SHALL BE NOTIFIED ALL PLANTING BEDS ADJACENT TO LAWN SHALL HAVE ST 	E PROJECT ONLY. SEE OTHER SHEETS FOR S AND DIMENSIONS. MINOR ADJUSTMENTS TO OF ANY NOTABLE CONFLICTS AND PROPOSEI	AVOID UTILITY AND SITE CONFLICTS ARE	T O
 TREE LOCATIONS ARE APPROXIMATE, CONTRACTOR TO CONTRACTOR IS RESPONSIBLE FOR FINAL PRODUCT TO CONTRACTOR TO MINIMIZE DISTURBANCE TO ESTABLISH TO OWNER OR ARCHITECT. THE CONTRACTOR SHALL BE RESPONSIBLE FOR COORD 	MEET ALL LOCAL AND STATE REQUIREMENT IED LAWN AND IRRIGATION SYSTEM AND REF	S. PLACE EXISTING LAWN THAT IS UNSATISFACTORY	WW WV TAIL
 THE CONTRACTOR SHALL BE RESPONSIBLE FOR COORD DRAINAGE, IRRIGATION, AND ELECTRICAL LINES. IRRIGA CONSTRUCTED PRIOR TO PAVING AND LANDSCAPE WOF EXISTING BUILDINGS, GRADING, EASEMENTS, AND UTILIT VERIFY ALL CONDITIONS AT JOB SITE AND NOTIFY LANDSCAPE 	TION AND ELECTRICAL SLEEVES AND SUBSU RK. TES ARE BASED ON SURVEY INFORMATION P	RFACE DRAINAGE SYSTEMS SHALL BE ROVIDED BY OTHERS.	E DE NG, CO E DE
 BEGINNING WORK. 11. THE LANDSCAPE ARCHITECT ASSUMES NO RESPONSIBIL USE EXTREME CAUTION WHEN WORKING OVER OR NEAF VERTICAL LOCATION OF ALL UTILITIES, ABOVE AND BELC 	LITY FOR THE UTILITIES OR STRUCTURES NO R EXISTING GAS MAINS AND ELECTRICAL LINE W GRADE, PRIOR TO EXCAVATION OR TREN	T SHOWN ON THE DRAWINGS. CONTRACTOR SHALL S. CONTRACTOR IS TO VERIFY HORIZONTAL AND CHING. NOTIFY ARCHITECT OF ANY DISCREPANCIES	STAR SOWBRO SO SPRII
OR CONFLICTS. DAMAGE SHALL BE REPAIRED BY THE CO 12. LAYOUT OF ALL SITE FURNISHINGS, INCLUDING BENCHES THE LANDSCAPE ARCHITECT PRIOR TO INSTALLATION. W VERIFIED IN THE FIELD PRIOR TO INSTALLING ADJACENT	S, TRASH RECEPTACLES, AND BIKE RACKS IS /HERE CONCRETE FOOTINGS ARE REQUIRES PAVEMENT OR FINISHES.	TO BE STAKED IN THE FIELD AND APPROVED BY FOR FURNITURE, THEY ARE TO BE STAKED AND	IPERS MEAD DLORAD
 ALL LAYOUT DIMENSIONS ARE TWO DIMENSIONAL, NO VI PLANS. WRITTEN DIMENSIONS TAKE PRECEDENCE OVER SCALE THE CONTRACTOR SHALL TAKE PRECAUTIONARY MEASU STRUCTURE DAMAGED BY THE CONTRACTORS OPERATIONARY MEASU 	D DIMENSIONS. JRES TO PROTECT EXISTING IMPROVEMENTS	S FROM DAMAGE. ALL SUCH IMPROVEMENTS AND	LAN SUI
 OWNERS EXPENSE. 16. CONTOUR LINES ARE SHOWN ON LANDSCAPE PLANS FO 17. TREES AND SHRUBS SHALL BE PLANTED PER DETAILS. S PRIOR TO PLANTING. 	R REFERENCE ONLY REFERENCE CIVIL DRAV	VING FOR ACTUAL INFORMATION.	
 CONTRACTOR TO REVIEW PLANT LIST DURING BIDDING A ALTERNATIVE. QUANTITIES PROVIDED IN SCHEDULE ARE FOR CONVENI THE PLAN AND MEETING THE DESIGN INTENT 			
 OWNER TO PERFORM ONGOING MAINTENANCE CONSIST PLANTING AREAS SHALL RECEIVE MIN. 3-INCH DEPTH DE TAN IN COLOR. TREES IN SODDED AREAS AND ROCK MULCHED PLANTIN 	CORATIVE ROCK MULCH OVER FILTER FABRI	-	Drawn By: ME Checked By: DL Date: 06/23/2023
DEPTH. 23. IF ANY TRANSFORMERS, GROUND-MOUNTED HVAC UNIT ADDITIONAL LANDSCAPING AND SCREENING MAY BE REC THE CERTIFICATE OF OCCUPANCY, OR FINAL INSPECTIO	QUIRED BASED UPON FIELD CONDITIONS DUP	•	Project No. 24-0409 Sheet Number
			L1.1

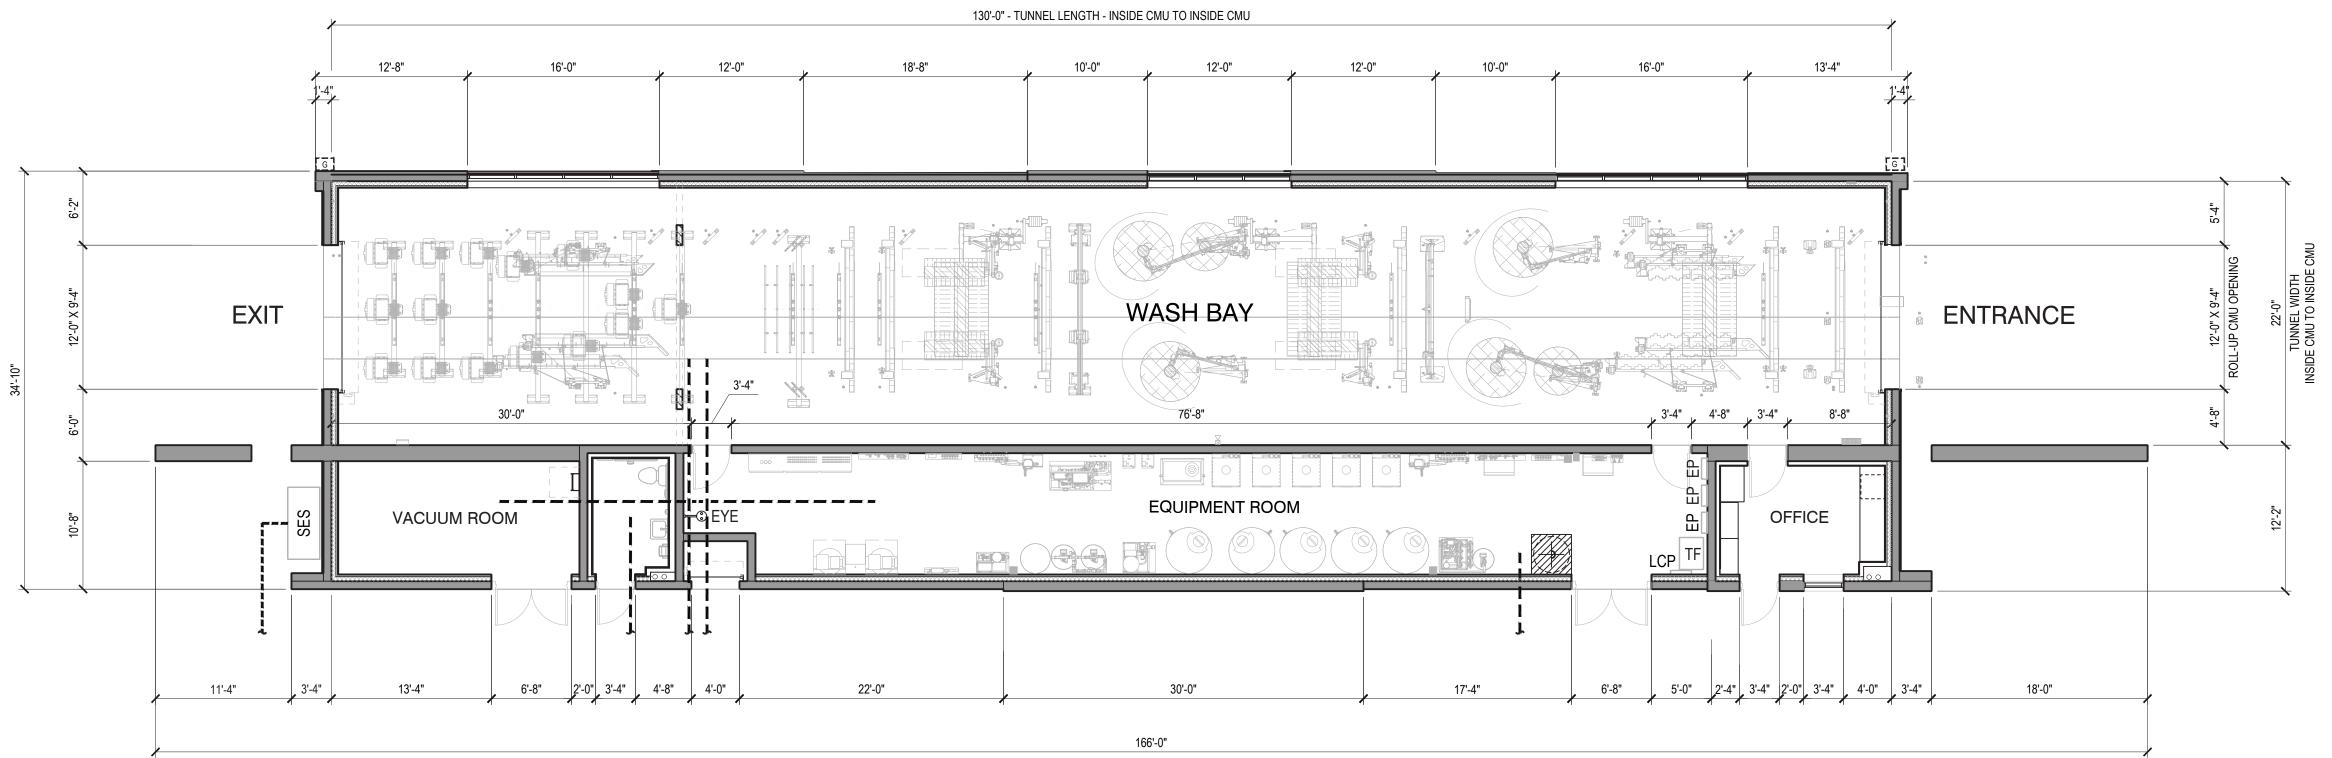





MEADOWBROOK & MARKSHEFFEL

COLORADO SPRINGS | CO 80915





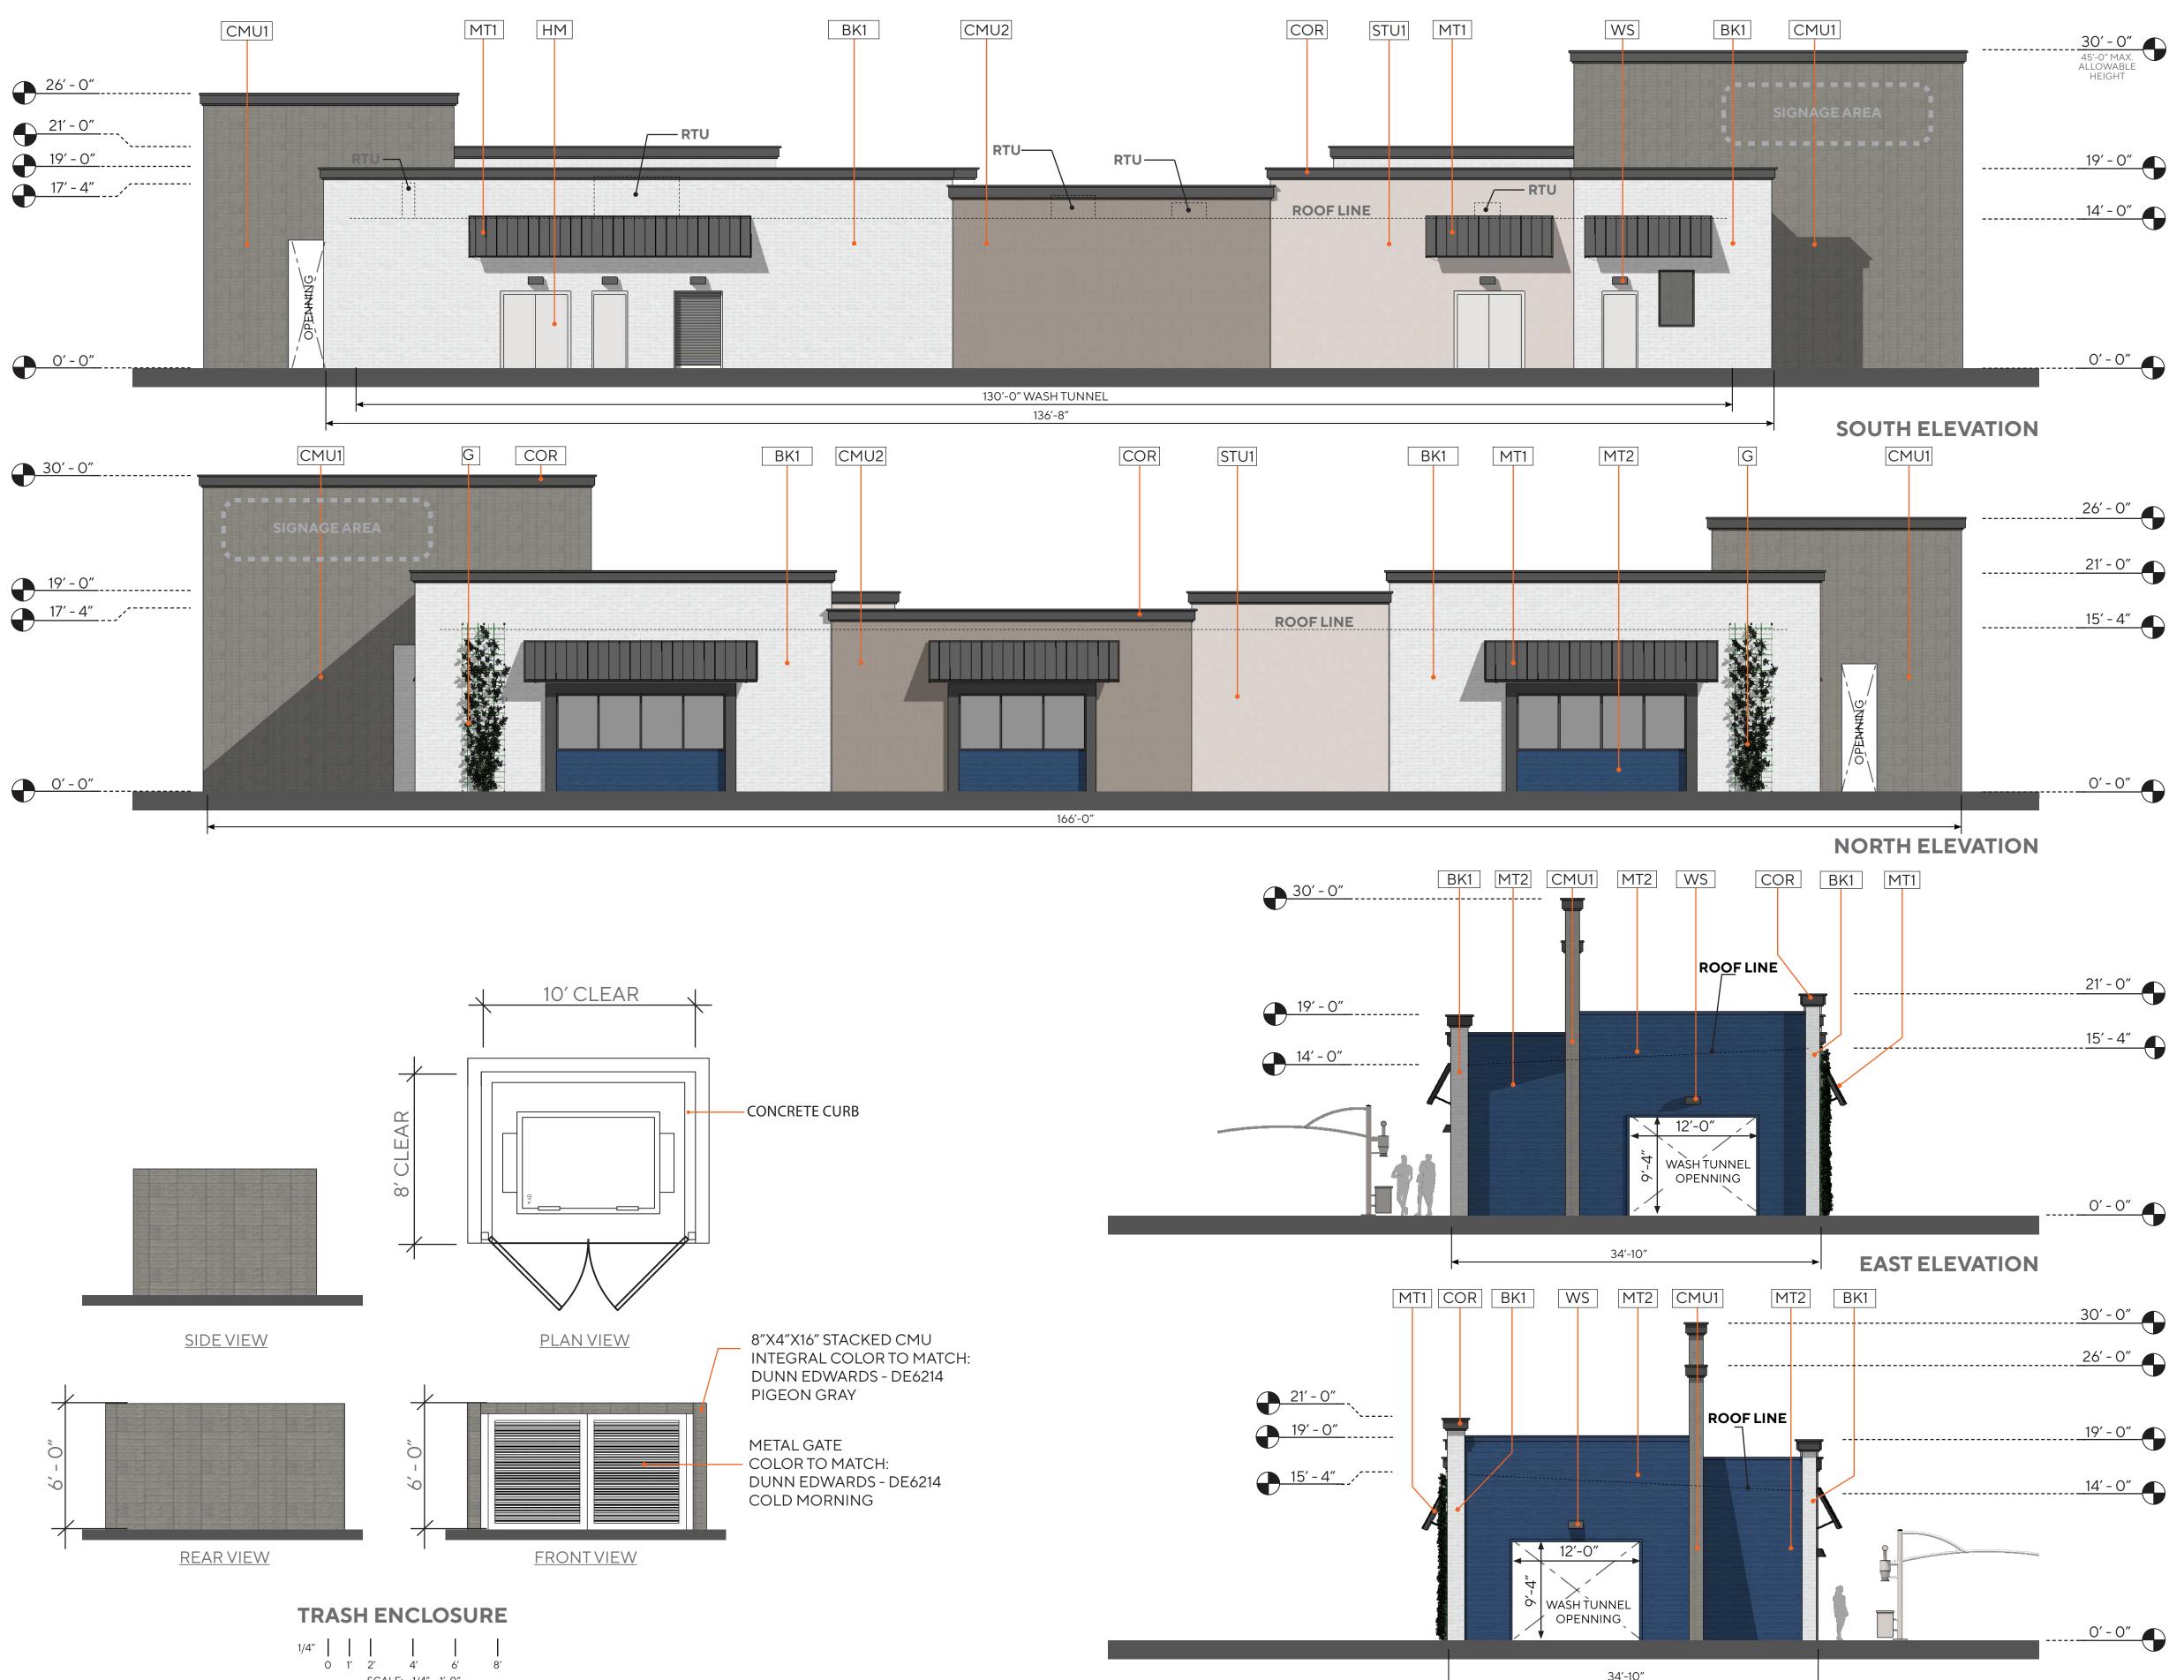

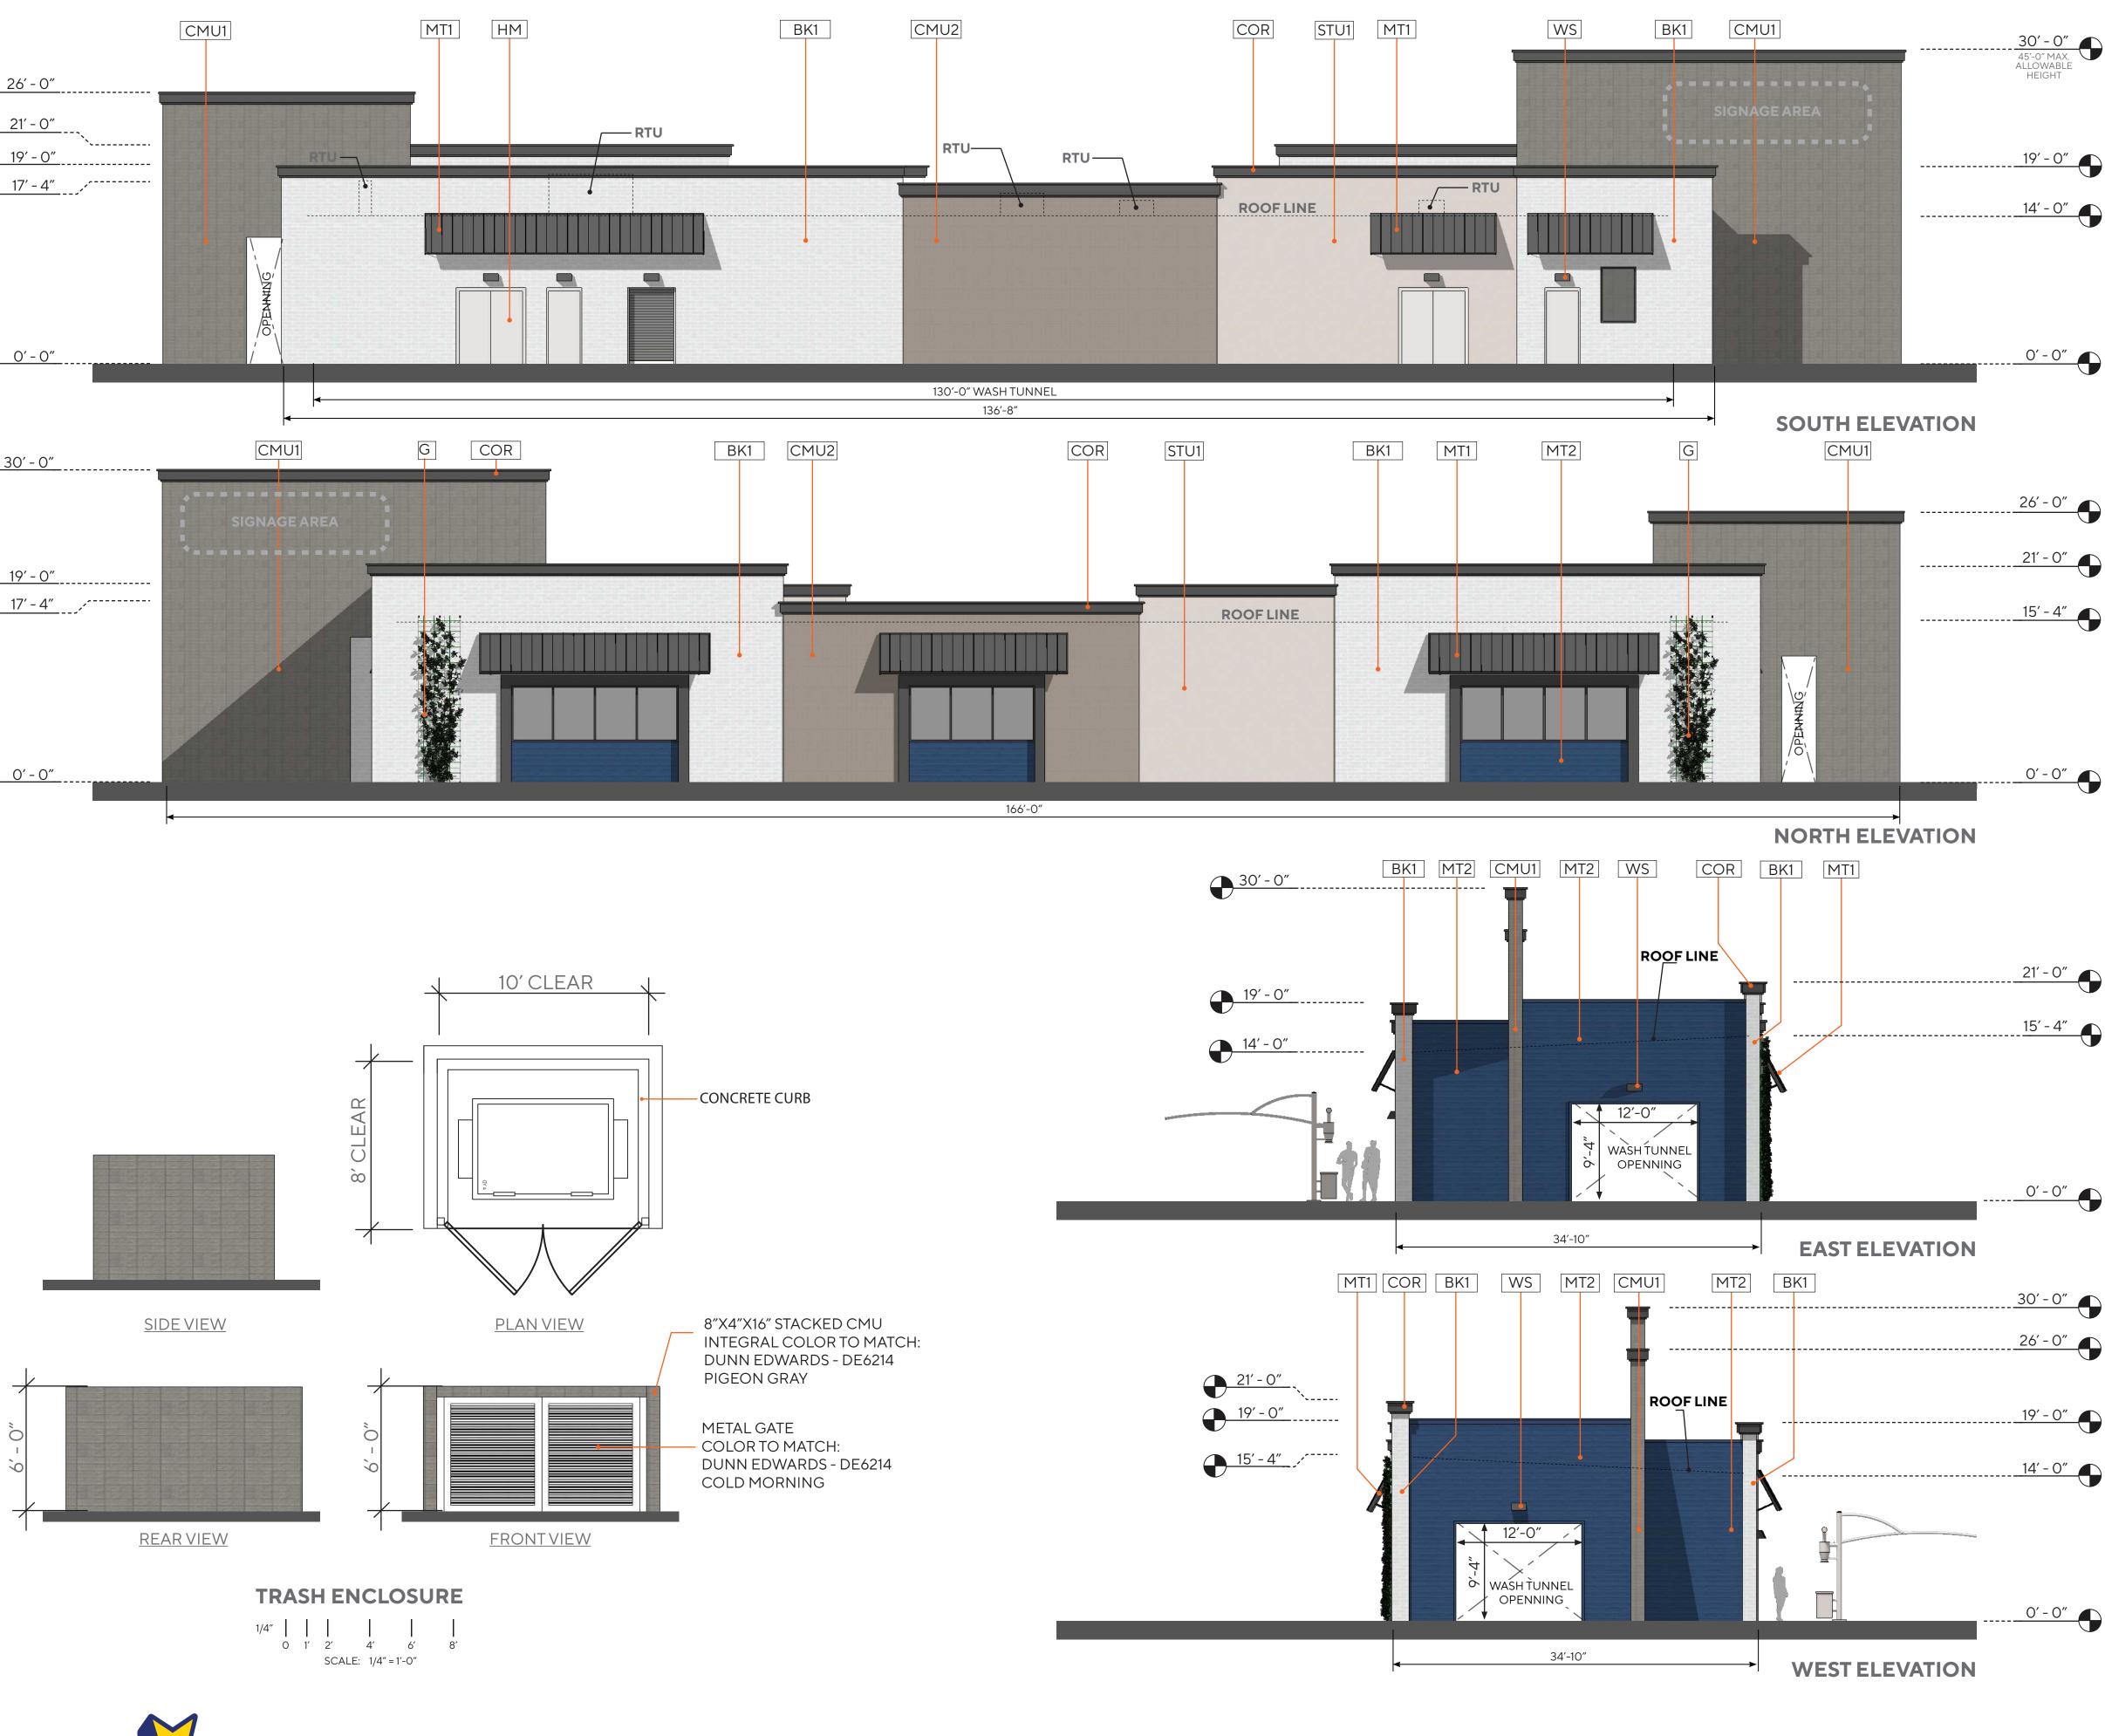



MEADOWBROOK & MARKSHEFFEL COLORADO SPRINGS | CO 80915



KEY	DESCRIPTION
MASONRY	
BK-1	8" X 4" X 16 - MANUFACTURE: SUPERLITE TYPE: STANDARD BLOCK - PATTERN: RUNNING BOND INTEGRAL COLOR TO MATCH PT-1
CMU-1	8″ X 4″ X 16 - MANUFACTURE: SUPERLITE TYPE: STANDARD BLOCK - PATTERN: STACK BOND INTEGRAL COLOR TO MATCH PT-2
CMU-2	10" X 8" X 16" - MANUFACTURE: SUPERLITE TYPE: VERTICAL SINGLE SCORE BLOCK - PATTERN: STACK BOND INTEGRAL COLOR TO MATCH PT-2
METAL	
MT-1	METAL AWNING - COLOR TO MATCH PT-4
MT-2	ALUMABOARD METAL PANEL, MANU: ROLLFAB, COLOR TO MATCH: REGAL BLUE
MISC	
COR	CORNICE TRIM - COLOR TO MATCH PT-4
СТ	CANOPY TUBE - ARCHES AND COLUMNS COLOR TO MATCH PT-3
НМ	HOLLOW METAL DOORS / FRAMES PAINTED COLOR TO MATCH PT-1
WS	ARCHITECTURAL WALL SCONCE LITHONIA LIGHTING - WST LED
STUCCO	
STU-1	STUCCO 30/30 FINE TEXTURE OVER STANDARD CMU BLOCK - COLOR TO MATCH PT-3
PAINT	
PT-1	DUNN EDWARDS - COLD MORNING - DE6365
PT-2	DUNN EDWARDS - PIGEON GRAY - DE6214
PT-3	DUNN EDWARDS - THICK FOG - DE6058
	DUNN EDWARDS - DARK ENGINE - DE6350

NOTE:

ALL EXTERIOR SIGNAGE UNDER A SEPARATE PERMIT

30' - 0" 26' - 0"

- 0' - 0"

EXTERIOR ELEVATIONS







Scale Job No.

Date




LANDSCAPING DEPICTED IS FOR ILLUSTRATIVE PURPOSES ONLY; REFER TO LANDSCAPE PLAN.



MEADOWBROOK & MARKSHEFFEL

COLORADO SPRINGS | CO 80915

*NOTE: ALL EXTERIOR SIGNAGE UNDER A SEPARATE PERMIT

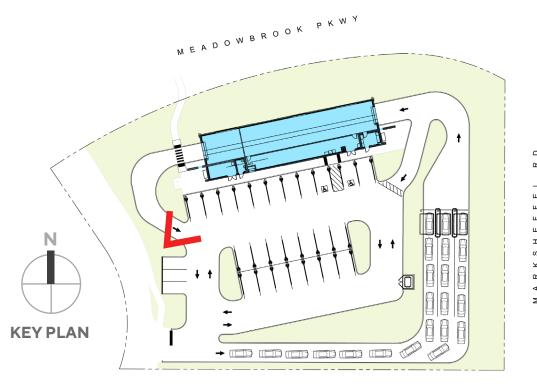










LANDSCAPING DEPICTED IS FOR ILLUSTRATIVE PURPOSES ONLY; REFER TO LANDSCAPE PLAN.



MEADOWBROOK & MARKSHEFFEL

COLORADO SPRINGS | CO 80915

*NOTE: ALL EXTERIOR SIGNAGE UNDER A SEPARATE PERMIT

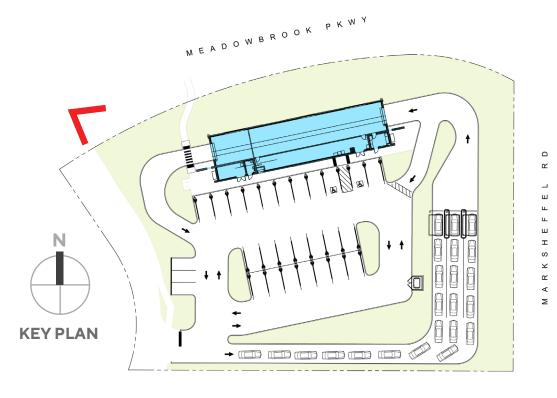

PERSPECTIVE 2





Scale Job No. Date




LANDSCAPING DEPICTED IS FOR ILLUSTRATIVE PURPOSES ONLY; REFER TO LANDSCAPE PLAN.



MEADOWBROOK & MARKSHEFFEL

COLORADO SPRINGS | CO 80915


*NOTE: ALL EXTERIOR SIGNAGE UNDER A SEPARATE PERMIT

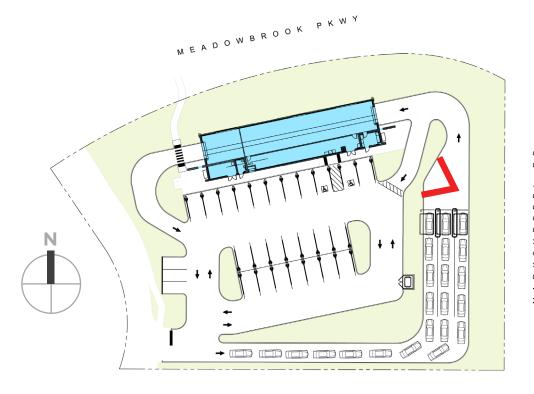

PERSPECTIVE 3






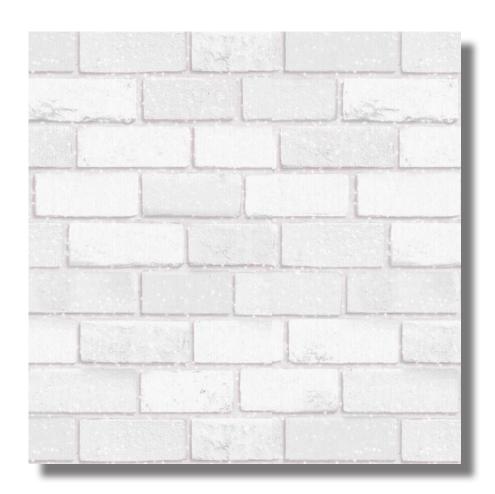

BK-1



CMU-1

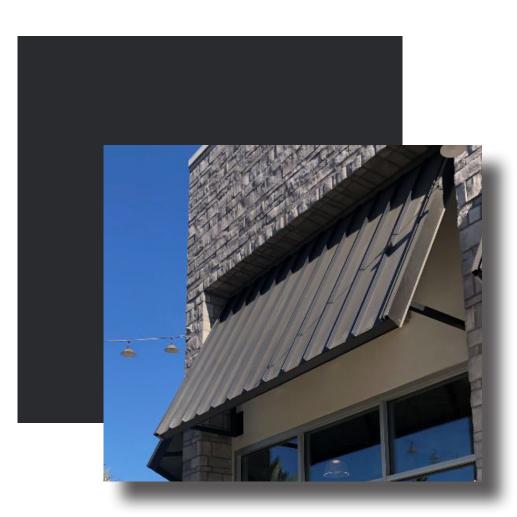

MT1



MT2



PT1



PT2




MEADOWBROOK & MARKSHEFFEL COLORADO SPRINGS | CO 80915





CMU-2

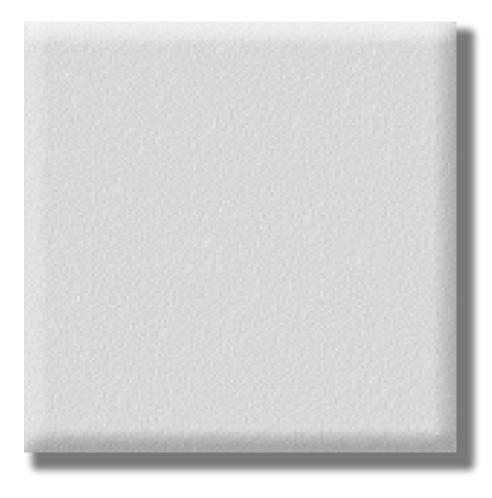

STU-1



СТ



G



PT3



KEY	DESCRIPTION
MASONRY	
BK-1	8" X 4" X 16 - MANUFACTURE: SUPERLITE TYPE: STANDARD BLOCK - PATTERN: RUNNING BOND INTEGRAL COLOR TO MATCH PT-1
CMU-1	8″ X 4″ X 16 - MANUFACTURE: SUPERLITE TYPE: STANDARD BLOCK - PATTERN: STACK BOND INTEGRAL COLOR TO MATCH PT-2
CMU-2	10" X 8" X 16" - MANUFACTURE: SUPERLITE TYPE: VERTICAL SINGLE SCORE BLOCK - PATTERN: STACK BOND INTEGRAL COLOR TO MATCH PT-2
METAL	
MT-1	METAL AWNING - COLOR TO MATCH PT-4
MT-2	ALUMABOARD METAL PANEL, MANU: ROLLFAB, COLOR TO MATCH: REGAL BLUE
MISC	
COR	CORNICE TRIM - COLOR TO MATCH PT-4
СТ	CANOPY TUBE - ARCHES AND COLUMNS COLOR TO MATCH PT-3
НМ	HOLLOW METAL DOORS / FRAMES PAINTED COLOR TO MATCH PT-1
WS	ARCHITECTURAL WALL SCONCE LITHONIA LIGHTING - WST LED
STUCCO	
STU-1	STUCCO 30/30 FINE TEXTURE OVER STANDARD CMU BLOCK - COLOR TO MATCH PT-3
PAINT	
PT-1	DUNN EDWARDS - COLD MORNING - DE6365
PT-2	DUNN EDWARDS - PIGEON GRAY - DE6214
PT-3	DUNN EDWARDS - THICK FOG - DE6058
PT-4	DUNN EDWARDS - DARK ENGINE - DE6350

NOTE: ALL EXTERIOR SIGNAGE UNDER A SEPARATE PERMIT

COLORS & MATERIALS



