


Nov. 30, 2018



The landscaping plan will be reviewed at the site development plan stage of the application. The requirements of Chapter 6 of the Land Development Code will apply.

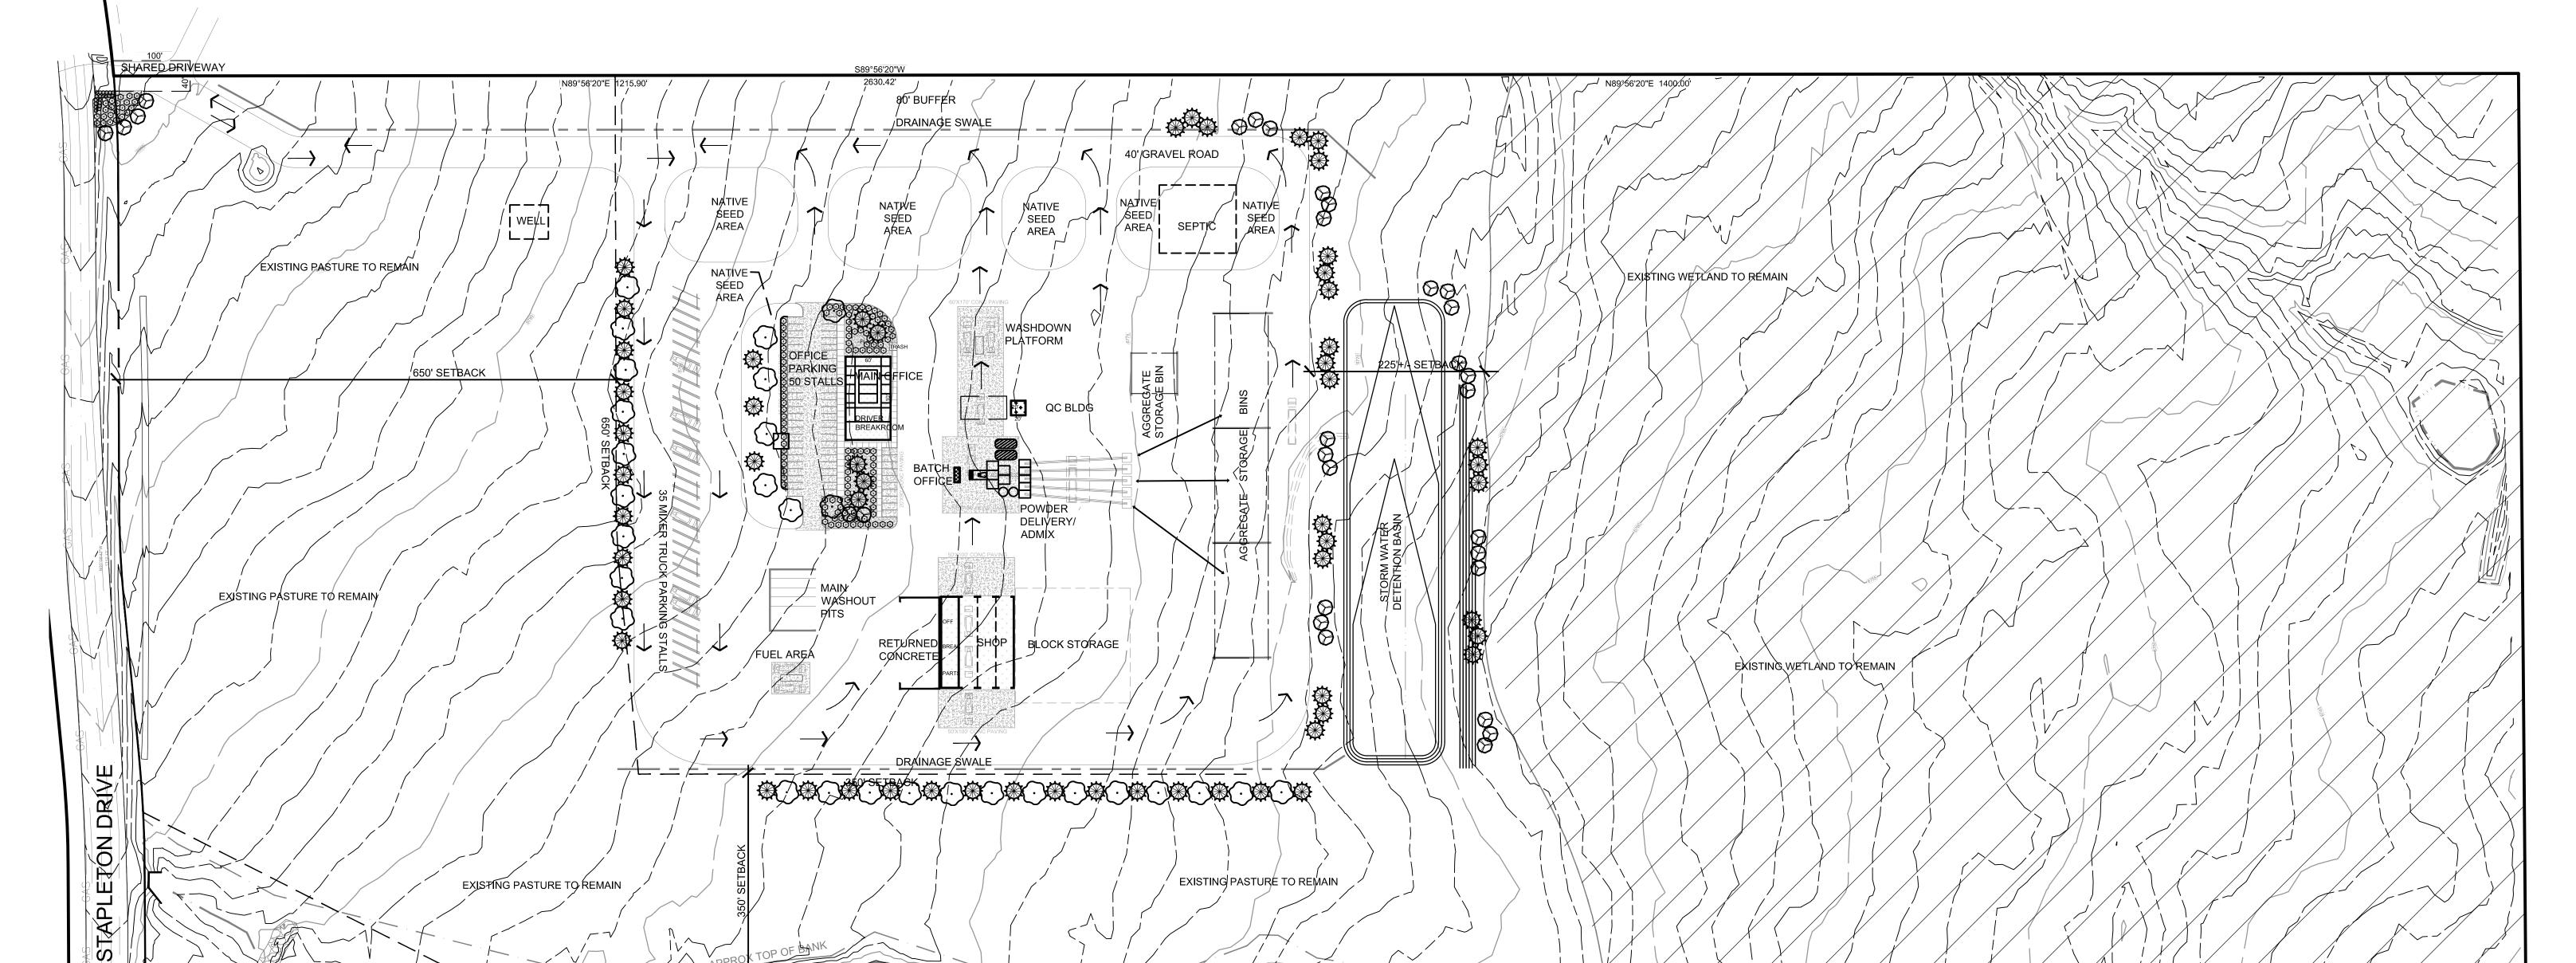

PLANT SCHEDULE						
TREE		CODE	QTY	COMMON NAME / BOTANICAL NAME	CONT	CAL
	<b>\}</b>	TEG	59	EVERGREEN TREE	6` B&B	
	~	ORN	27	ORNAMENTAL TREE	B & B	1"CAL
	$\cdot$	ST	29	SHADE TREE	В&В	1.5"CAL
SHR	UBS	CODE	QTY	COMMON NAME / BOTANICAL NAME	SIZE	FIELD2
	$\in$	SHR	130	PLACE ON DRIP / NEW 5 GALLON SHRUB	5 GAL	
	Ð	JSG	20	NEW LARGE GRASS	1 GAL	
MUL	CHES	CODE	QTY	COMMON NAME / BOTANICAL NAME	CONT	FIELD2
		RM	14,845 SF	RIVER ROCK / ROCK MULCH PER OWNER APPROVAL. PLACE TO A UNIFORM DEPTH OF 3" OVER PERMEABLE WEED BARRIER FABRIC.	MULCH	



Pete Lien & Sons
TRANS COLORADO CONCRETE

Conrado Springs, CO 80903 (719) 576-158

Conrado Springs, CO 80903 (719) 576-158

CONCEPT LSP PLAN

sheet

## Markup Summary

## dsdkendall (1)



Subject: Text Box Page Label: [1] L1.1 Lock: Locked Author: dsdkendall

Date: 3/26/2019 4:00:15 PM

Color:

The landscaping plan will be reviewed at the site development plan stage of the application. The requirements of Chapter 6 of the Land Development Code will

apply.