



FALCON COMMERCE CENTER

RUNOFF FROM FALCON COMMERCE CENTER
 TO BE CONVEYED TO THE EAST BY PROPOSED
 STORM INTERCEPTOR CONSTRUCTED WITH THAT PROJECT

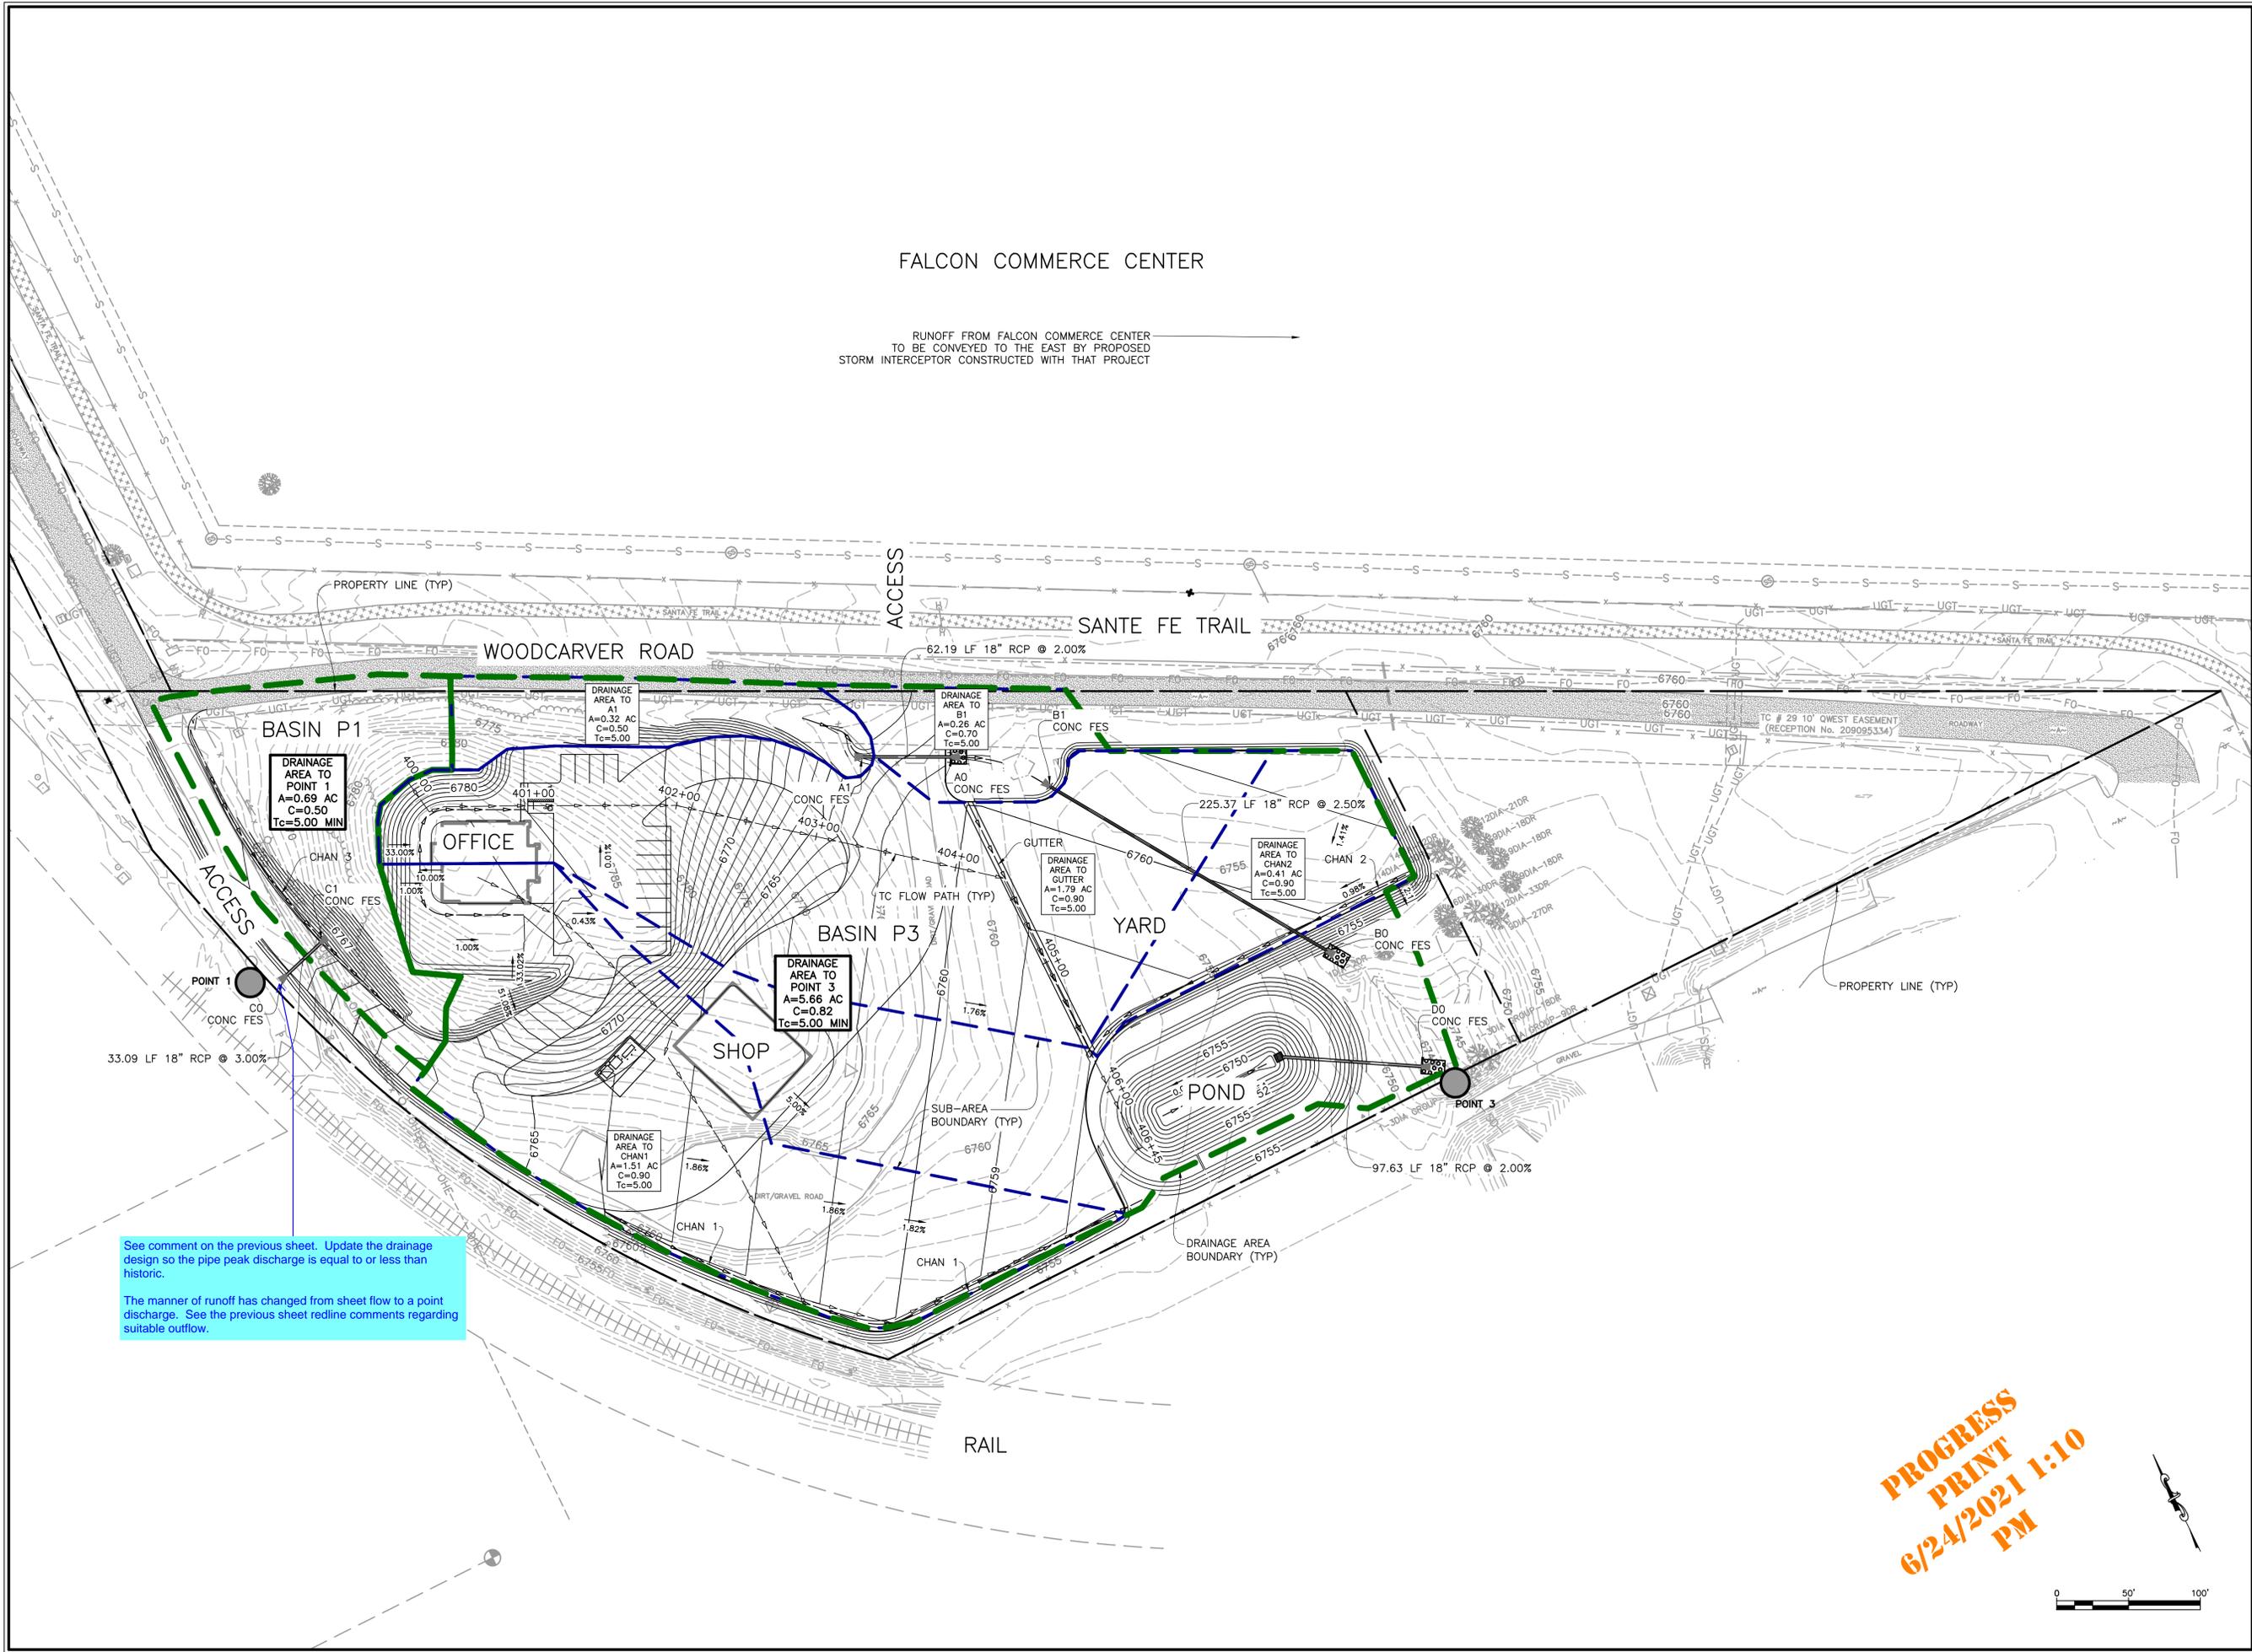

See comment on the previous sheet. Update the drainage design so the pipe peak discharge is equal to or less than historic.
 The manner of runoff has changed from sheet flow to a point discharge. See the previous sheet redline comments regarding suitable outflow.

PROGRESS PRINT
6/24/2021 1:10 PM

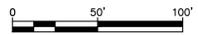

NATIVE SUN CONSTRUCTION
 SITE IMPROVEMENTS, WOODCARVER ROAD PROPERTY
 PROPOSED DRAINAGE MAP

REVISIONS:

SCALE:
 NOTED
 DATE:
 MARCH 2021
 PROJECT NO.:
 21001

SHEET NO.:
 PROPOSED DRAINAGE PLAN