

KNOW ALL MEN BY THESE PRESENTS:

That Atticus Land, LLC, being the owner of the described tract of land, to wit:

LEGAL DESCRIPTION:

That portion of southeast quarter of Section 13, Township 11 South, Range 66 West of the 6TH P.M., County of El Paso, State of Colorado, being more particularly described as follows:

Beginning at the southeast one--sixteenth (1/16) corner of said Section 13; thence North 82 degrees 37 minutes 02 seconds East, 1,338.80 feet to a point on the east line of the southeast quarter of said Section 13;

thence South 00 degrees 23 minutes 04 seconds East along the east line of th southeast quarter, 1,466.46 feet to the southeast corner of said Section 13;

thence South 88 degrees 44 minutes 30 seconds West along the south line of the southeast quarter of the southeast quarter of said Section 13, 1,326.86 feet to the east one--sixteen (1/16) corner of said Section 13;

thence North 00 degrees 28 minutes 34 seconds West along the west line of the southeast quarter of the southeast quarter of said Section 13, 1,323.58 feet to the Point of Beginning.

OWNER'S CERTIFICATE:

The undersigned, being all the owners, mortgagees, beneficiaries of deeds of trust and holders of other interests in the land described herein, have laid out, subdivided, and platted said lands into lots, streets, and easements as shown hereon under the name and subdivision of IRON RIDGE FILING NO. 2. All public improvements so platted are hereby dedicated to public use and said owner does hereby covenant and agree that the public improvements will be constructed to El Paso County standards and that proper drainage and erosion control for same will be provided at said owner's expense, all to the satisfaction of the Board of County Commissioners of El Paso County, Colorado. Upon acceptance by resolution, all public improvements so dedicated will become matters of maintenance by El Paso County, Colorado. The utility easements shown hereon are hereby dedicated for public utilities and communication systems and other purposes as shown hereon. The entities responsible for providing the services for which the easements are established are hereby granted the perpetual right of ingress and egress from and to adjacent properties for installation, maintenance, and replacement of utility lines and related facilities.

Jake Decoto as Manager of Atticus Land, LLC (Owner)

NOTARIAL:

STATE OF COLORADO }
COUNTY OF EL PASO } SS

The foregoing instrument was acknowledged before me this ___ day of _____, 20___ A.D., by Jake Decoto as Manager of Atticus Land, LLC.

Witness my Hand and Seal: _____ Notary Public
My Commission Expires: _____ Address: _____

DEDICATION:

The above party in interest has caused said tract to be platted into Lots, Blocks, Tracts, Streets and Easements as shown on the plat, which is drawn to a fixed scale as indicated thereon, and accurately sets forth the boundaries and dimensions of said Lots, Blocks, Streets and Easements which shall be known as "IRON RIDGE FILING NO. 2" EL Paso County, Colorado. All streets as platted are hereby dedicated to public use and said owner does hereby permanently covenant and agree that all platted streets will be graded, paved and that proper drainage for same will be provided at his own expense, all to the satisfaction of the Board of County Commissioners of El Paso County, Colorado, and upon acceptance by resolution, all streets so dedicated will become matters of maintenance by EL Paso County, Colorado.

GENERAL NOTES:

- Recovered monument, marked as noted.
 - Recovered Aliquot monument, marked as noted.
 - Set no. 5 rebar 18" long & pink plastic cap marked "PLS 38556".
 - Record bearing & distance
 - Measured bearing & distance
 - Above Grade
 - Below Grade
- The Basis of Bearings is the south line of of the southeast quarter of the southeast quarter, monumented as shown and assumed to bear South 88 degrees 44 minutes 30 seconds East.
- FEDERAL EMERGENCY MANAGEMENT AGENCY, Flood Insurance Rate Map, Map Number 08041C0305 G effective date December 7, 2018, indicates that this parcel of land is located in Zone X (areas determined to be outside 0.2% annual chance floodplain).
- This survey does not constitute a title search by Gould Land Surveying, LLC to determine ownership or easements of record. For all information regarding easements, rights of way and title of record, Gould Land Surveying, LLC relied upon a Commitment for Title Insurance prepared by Old Republic National Title Insurance Company, Order No. RND55123912 with an effective date of September 5, 2025 at 5:00 P.M.
- The purpose of this survey is to plat the parcel shown hereon and establish the proposed lot lines, Right-of-Way and easements as shown hereon. The field work was completed on April 29, 2025.
- This property contains a calculated area of 1,852,350 square feet or (42.5241 acres), more or less. Area shown hereon was not measured but instead is a result of a computer software calculation and is not warranted or guaranteed.
- Unless noted otherwise, all monuments were found or set flush with ground and accepted as representing the boundary corner.
- The lineal units used in this survey are International Feet. An international foot is defined exactly as 1200/3937.007874 meters.
- Easements and other public documents shown or noted on this survey were examined as to location and purpose and were not examined as to restrictions, exclusions, conditions, obligations, terms, or as to the right to grant the same.
- Notice: According to Colorado law you must commence any legal action based upon any defect in this survey within three years after you first discover such defect. In no event may any action be commenced more than ten years from the date of the certification shown hereon.
- Any person who knowingly removes, alters or defaces any public land survey monument or land boundary monument or accessory commits a class 2 misdemeanor pursuant to the Colorado Revised Statute 18-4-506.


EASEMENTS:

All side, front, and rear lot lines are hereby platted on either side with a 10 foot public utility and drainage easement unless otherwise indicated. All exterior subdivision boundaries are hereby platted with a 20 foot public utility and drainage easement. The sole responsibility for maintenance of these easements is hereby vested with the individual property owners.

SURVEYOR'S CERTIFICATION:


I, Kenneth Gould Jr., a duly registered Professional Land Surveyor in the State of Colorado, do hereby certify that this plat truly and correctly represents the results of a survey made on date of survey, by me or under my direct supervision and that all monuments exist as shown hereon; that mathematical closure errors are less than 1:10,000; and that said plat has been prepared in full compliance with all applicable laws of the State of Colorado dealing with monuments, subdivision, or surveying of land and all applicable provisions of the El Paso County Land Development Code. This statement is neither a guaranty or warranty, either expressed or implied.

I attest the above on this ___th day of _____, 2026.

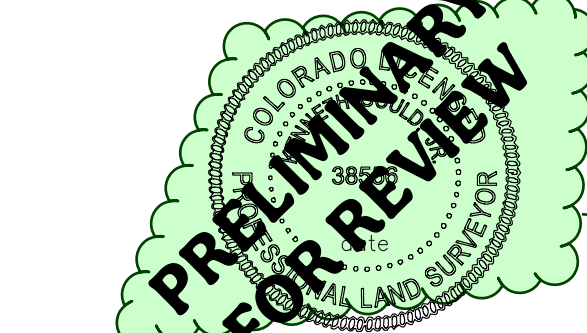

Kenneth Gould Jr.
State of Colorado Professional Land Surveyor No. 38556
For and on behalf of Gould Land Surveying, LLC.

FINAL PLAT
IRON RIDGE FILING NO. 2
A PORTION OF THE SOUTHEAST QUARTER
SEC. 13, T11S, R66W OF THE 6TH P.M., COUNTY OF EL PASO, STATE OF COLORADO

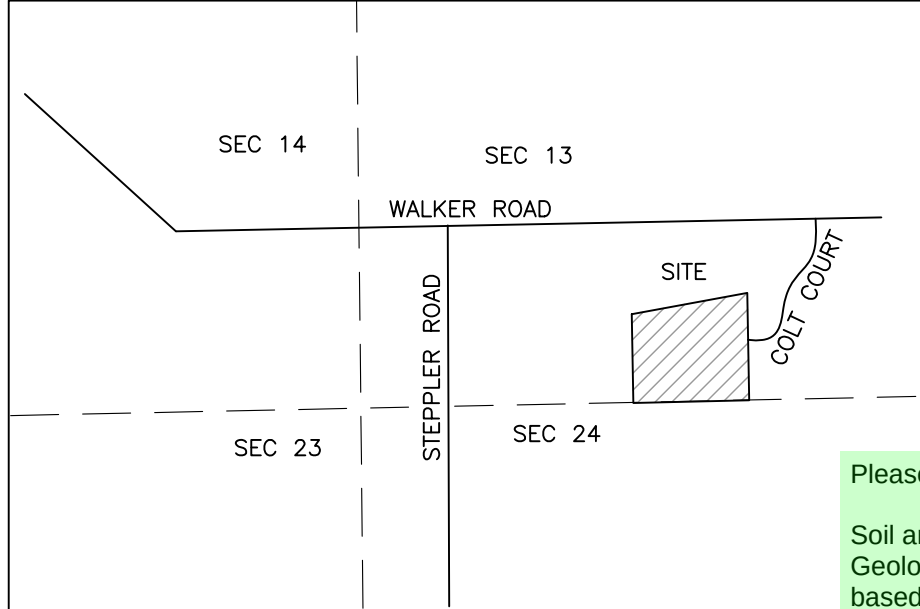

VICINITY MAP
(NOT TO SCALE)

IRON RIDGE ACREAGE TABLE	
RIGHT-OF-WAY (R.O.W.)	
TOTAL ACREAGE	2.1575 AC
LOTS (14 TOTAL)	
TOTAL ACREAGE	40.3666 AC
TOTAL IRON RIDGE	
TOTAL ACREAGE	42.5241 AC

NOTES:

This property is subject to the following per the Commitment for Title Insurance prepared by Old Republic National Title Insurance Company, Order No. RND55123912 with an effective date of September 5, 2025 at 5:00 P.M.

- Any interest which may have been acquired by the public in and to subject property by reason of Resolution of Board of County Commissioners dated and recorded October 3, 1887, in Road Book A at Page 78 which provided for public roads 60 feet in width being 30 feet on either side of section lines on the public domain. -- also 6-20-1917 in Book 571 at Page 55.
- terms, conditions, provisions, burdens and obligations as set forth in Right-of-Way Easement as granted to Colorado Interstate Gas Company in instrument recorded November 19, 1971, in Book 2450 at Page 586.
- Oil and Gas Lease in favor of Walter A. Ohmrt, Jr., recorded October 11, 1972 in Book 2530 at Page 716, and any and all assignments thereto or interests therein.
- Terms, conditions, provisions, burdens and obligations as set forth in Right-of-Way Easement recorded March 07, 1983 in Book 3684 at Page 510.
- Water rights as conveyed in Special Warranty Deed recorded April 21, 2004 under Reception No. 204063765, and any and all assignments thereto or interests therein.
- Easements, conditions, covenants, restrictions, reservations and notes on Improvement Survey Plat recorded may 16, 2025 under Reception No. 225900072.

Public and Common Subdivision Improvements:
No lot or interest therein, shall be sold, conveyed, or transferred whether by deed or by contract, nor shall building permits be issued, until and unless either the required public and common development improvements have been constructed and completed and preliminarily accepted in accordance with the Subdivision Improvements Agreement between the applicant/owner and El Paso County as recorded under Reception Number _____ in the Office of the Clerk and Recorder of El Paso County, Colorado or, in the alternative, other collateral is provided to make provision for the completion of said improvements in accordance with the El Paso County Land Development Code and Engineering Criteria Manual. Any such alternative collateral must be approved by the Board of County Commissioners or, if permitted by the Subdivision Improvements Agreement, by the Planning and Community Development Department Director and meet the policy and procedure requirements of El Paso County prior to the release by the County of any lots for sale, conveyance or transfer. This plat restriction may be removed or rescinded by the Board of County Commissioners or, if permitted by the Subdivision Improvements Agreement, by the Planning and Community Development Department Director upon either approval of an alternative form of collateral or completion and preliminary acceptance by the El Paso Board of County Commissioners of all improvements required to be constructed and completed in accordance with said Subdivision Improvements Agreement. The partial release of lots for sale, conveyance or transfer may only be granted in accordance with any planned partial release of lots authorized by the Subdivision Improvements Agreement.

Lot ____ (or Tract ____) (or entire property) of this property is subject to a Private Detention Basin/Stormwater Quality BMP Maintenance Agreement and Easement as recorded at Reception No. _____ of the records of El Paso County. The _____ HOA (or Owner or District) is responsible for maintenance of the subject drainage facilities.

PLAT NOTES:

- Sanitary Sewer: Sanitary Sewer will be provided by individual private septic systems at the expense of the individual property owners. Sewage treatment is the responsibility of each individual property owner. The El Paso County Department of Health and Environment must approve each system and, in some cases the Department may require an engineer designed system prior to permit approval. These systems may cost more to design, install, and maintain.
- Gas service is provided by Black Hills Energy. Electric Service is provided by Mountain View Electric Association, subject to the Providers rules, regulations and specifications. The subdivider/developer is responsible for extending utilities to each lo, tract or building site.
- All lot access shall be via Colt Court, an asphalt road maintained by the El Paso County Department of Transportation
- All property owners are responsible for maintaining proper storm water drainage in and through their property.
- No driveway shall be established unless an access permit has been granted by El Paso County.
- All structural foundations and septic systems shall be located and designed by a Professional Engineer, currently registered in the State of Colorado.
- The following reports have been submitted and are on file at the County Development Services Department: Soils and Geological Study, Water Resource Report, Drainage Report, Wildfire Hazard Report, Natural Features Report, Erosion Control Report. [Add Traffic Impact Study and Fire Protection Report](#)
- Developer shall comply with federal and state laws, regulations, ordinances, review and permit requirements, and other agency requirements, if any, of applicable agencies including, but not limited to, the Colorado Division of Wildlife, Colorado Department of Transportation, U.S. Army Corps of Engineers and the U.S. Fish and Wildlife Service regarding the Endangered Species Act, particularly as it relates to the listed species.
- The Subdivider(s) agrees on behalf of him/herself and any developer or builder successors and assignees that Subdivider and/or said successors and assignees shall be required to pay traffic impact fees in accordance with the El Paso County Road Impact Fee Program Resolution (Resolution No. 25-337) or any amendments thereto, at or prior to the time of building permit submittal. The fee obligation, if not paid at final plat recording, shall be documented on all sales documents and on plat notes to ensure that a title search would find the fee obligation before sale of the property.
- Individual wells are the responsibility of each property owner. Permits for individual wells must be obtained from the State Engineer who by law has the authority to set conditions for the issuance of these permits.
- Water in the Denver Basin Aquifers is allocated based on a 100-year aquifer life; however, for El Paso County planning purposes, water in the Denver Basin Aquifers is evaluated based on a 300-year aquifer life. Applicants and all future owners in the subdivision should be aware that the economic life of a water supply based on wells in a given Denver Basin Aquifer may be less than either the 100 years or 300 years indicated due to anticipated water level declines. Furthermore, the water supply plan should not rely solely upon non-renewable aquifers. Alternative renewable water resources should be acquired and incorporated in a permanent water supply plan that provides future generations with a water supply.
- Due to wildfire concerns, homeowners are encouraged to incorporate wildfire fuel break provisions as recommended by the Colorado State Forest Service and illustrated through publications available through the State Forest Service.
- This project is in a Low/Moderate/High Hazard Fire Intensity Area per the Colorado State Forest Service Wildfire Risk Assessment Program requiring hardened structure and defensible space.

Low Hazard hardened structure to consist of a minimum Class A roofing and a defensible space of 30 ft clearance and no portion of trees or other vegetation within 10 ft of chimney outlets. Trees within defensible space shall be pruned to minimize ladder fuels.

Moderate Hazard areas shall meet the requirements of Low Hazard areas if site plans are submitted prior to the adoption of the Colorado Wildfire Resiliency Code. After the adoption of the Colorado Wildfire Resiliency Code Moderate Hazard areas shall meet the requirements of High Hazard areas.

High Hazard hardened structure to consist of a minimum Class A roofing, noncombustible siding/decking, eaves and overhangs. A defensible space of 30 ft irrigated,100 ft fuel treatment, selected fire-resistant trees within 30 ft of structures, selected thinning of trees and shrubs, trees within defensible space shall be pruned to minimize ladder fuels, all trees and shrubs pruned of dead material, no portion of trees or other vegetation within 10 ft of chimney outlets.

Water supplies for fire protection shall be supplied per the requirements of the Land Development Code or if there is an adopted fire code for the fire district the project is in.

Maintenance of defensible space shall be continued in continuum for the existence of the structure

- Right to Farm and Ranch: Colorado is a "right-to-farm" state, meaning that certain protections are afforded agricultural operations by limiting the circumstances by which agriculture operations may be deemed to be a nuisance pursuant to C.R.S. §35-3.5-1-1 et seq.
- All property owners are responsible for maintaining proper storm water drainage in and through their property. Public drainage easements as specifically noted on the plat shall be maintained by the individual lot owners unless otherwise indicated. Homebuilders are responsible to ensure proper drainage around structures, including elevations of foundations and window wells in relation to side-lot drainage easements and swales. Homeowners shall not change the grade of the lot or drainage swales within said easements, as constructed by the builder, in a manner that would cause adverse drainage impacts to properties. Structures, fences, materials or landscaping that could impede the flow of runoff shall not be placed in drainage easements.
- Individual lot purchasers are responsible for constructing driveways, including necessary drainage culverts per Land Development Code 6.3.3.C.2 and 6.2.2.C.3.
- Per ECM section 1.7.1.B.5, residential lots impervious area may not exceed 10 percent unless a study is prepared in compliance with the requirements laid out in the above referenced ECM section. Impervious area may not exceed 20 percent. This impervious area for each lot must include the proposed driveway.
- The view corridor no-build areas depicted on lots 10, 11 13 & 14 are view corridor preservation. No structures requiring a building permit may be placed within the no-build area but driveways, septic systems, landscaping, chicken coops, and other improvements not requiring a building permit may be located within the no-build area. View easements are private easements and are not enforced by El Paso County.
- The addresses [000] exhibited on this plat are for informational purposes only. They are not the legal description and are subject to change.
- Mailboxes shall be installed in accordance with all El Paso County Department of Transportation and United States Postal Service regulations.
- There are 0.33 D.U. per acre.
- There are 14 lots in this subdivision.

BOARD OF COUNTY COMMISSIONERS CERTIFICATE:

This plat for IRON RIDGE FILING NO. 2 was approved for filing by the El Paso County, Colorado Board of County Commissioners on the _____ day of _____, 20____, subject to any notes specified hereon and any conditions included in the resolution of approval.

Chair, Board of County Commissioners

Date

PLANNING AND COMMUNITY DEVELOPMENT CERTIFICATE:

This plat for IRON RIDGE FILING NO. 2 was approved for filing by the El Paso County, Colorado Planning and Community Development Department Director on the _____ day of _____, 20____, subject to any notes or conditions specified hereon.

Planning and Community Development Director

CLERK & RECORDER'S CERTIFICATE:

STATE OF COLORADO }
COUNTY OF EL PASO } SS

I hereby certify that this instrument was filed in my office on this ____ day of _____, 20____, and was recorded at Reception Number _____ of the records of El Paso County, Colorado.

El Paso County Clerk and Recorder

OWNER:

Jake Decoto
Atticus Land, LLC
P.O. Box 88010
Colorado Springs, CO 80908
(206)-419-4533

School Fee - District# _____: _____

Park Fees: Regional: _____
Neighborhood: _____

Drainage Basin: _____
Drainage and Surety Fees: _____
Bridge Fee: _____

PCD File No. SF2612

Project No.: 25193
April 29, 2026
Sheet 1 of 2

A PORTION OF THE SOUTHEAST QUARTER OF SECTION 13,
TOWNSHIP 11 SOUTH, RANGE 66 WEST OF THE 6TH P.M.,
COUNTY OF EL PASO, STATE OF COLORADO

FINAL PLAT
IRON RIDGE FILING NO. 2

P.O. Box 7123
Woodland Park, CO 80863
(719) 687-8385
info@goulds.com
GouldLandSurveying.com



A green, cloud-shaped stamp with a black outline, tilted diagonally. It contains the text "PRELIMINARY FOR REVIEW" in bold, black, uppercase letters.

Please remove

(NOT PART OF THIS SUBDIVISION

SE 1/16, SEC. 13
2" ALUM. CAP
PLS 23890

POINT OF BEGINNING

PARCEL NO. 6124000002
REC. NO. 211108147
(NOT PART OF THIS SUBDIVISION)

PARCEL NO. 6124000010
REC. NO. 218135635
(NOT PART OF THIS SUBDIVISION)

FINAL PLAT
IRON RIDGE FILING NO. 2

**A PORTION OF THE SOUTHEAST QUARTER
SEC. 13, T11S, R66W OF THE 6TH P.M., COUNTY OF EL PASO, STATE OF COLORADO**

Lot numbering in closures sheet, final plan drawings, and construction drawings not consistent. Revise lot numbering as necessary for consistency throughout all documents.

Please include
"No-build" label

The natural features report shows this as a wetland; please label as so.

Drainage easement depicted in the construction drawings differs from what is shown on the final plat drawing. Please ensure that easements depicted on construction drawings and final plat are consistent.

Specify proposed ownership in label (Public and classication (local))

Show fire turnaround as contemplated in the fire protection report.

Add parcel number

Include name and ownership of all adjoining properties

SW1/4, SE1/4
PARCEL NO. 6100000440
REC. NO. 224085992
(NOT PART OF THIS SUBDIVISION)

Multiple discrepancies between closures sheet and final plat (see highlighted). Revise final plat drawings and/or closures sheet as necessary.


Please
length.

Add parcel number

Label as private view easement.

Add parcel number

Please remove

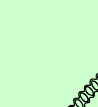

VIEW CORRIDOR/NO-BUILD AREAS

The view corridor including areas depicted on lots 10, 11, 13 & 14 are view corridor preservation. No structures requiring a building permit may be placed within the no-build area but driveways, septic systems, landscaping, chicken coops, and other improvements not requiring a building permit may be located within the no-build area. View easements are private easements and are not enforced by El Paso County.

Please add the location and proposed ownership of wetlands, watercourses, bodies of water, irrigation ditches and laterals.

Coordinate with civil engineer and include necessary drainage easements and note as no-build areas.

Project No.: 25133
April 29, 2026
Sheet 2 of 2

**A PORTION OF THE SOUTHEAST QUARTER OF SECTION 13,
TOWNSHIP 11 SOUTH, RANGE 66 WEST OF THE 6TH P.M.,
COUNTY OF EL PASO, STATE OF COLORADO**

FINAL PLAT
IRON RIDGE SUBDIVISION NO. 1-FILING NO. 2

**P.O. Box 7123
Woodland Park, CO 80863
(719) 687-8385
info@gouldls.com
GouldLandSurveying.com**



Gould
LAND SURVEYING

©2026 Gould Land Surveying, LLC.