


Please provide parking dimension detail.

Provide:  
1. Location of all garbage receptacles with a graphical depiction of the screening mechanism.  
2. Any additional information required pursuant to any associated conditions of approval from Special Use AL2322

Please provide location and detail of any signage proposed.

Identify the existing width of the driveway. Refer to ECM 2.4.1.E for min. and max width of two way driveways and revise as necessary.


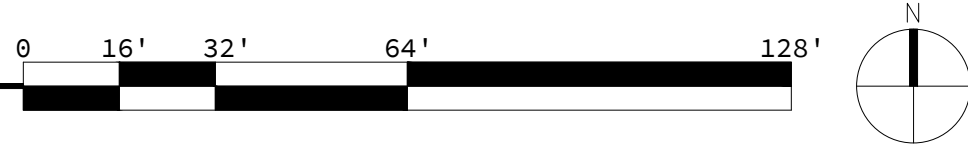


**TRAFFIC IMPACT NOTE**

1. THE OWNER AGREES ON BEHALF OF HIM/HERSELF AND ANY DEVELOPER OR BUILDER SUCCESSORS AND ASSIGNEES THAT SUBDIVIDER AND/OR SAID SUCCESSORS AND ASSIGNS SHALL BE REQUIRED TO PAY TRAFFIC IMPACT FEES IN ACCORDANCE WITH THE EL PASO COUNTY ROAD IMPACT FEE PROGRAM RESOLUTION (RESOLUTION NO. 19-471), OR ANY AMENDMENTS THERETO, AT OR PRIOR TO THE TIME OF BUILDING PERMIT SUBMITTALS. THE FEE OBLIGATION, IF NOT PAID AT FINAL PLAT RECORDING, SHALL BE DOCUMENTED ON ALL SALES DOCUMENTS AND ON PLAT NOTES TO ENSURE THAT A TITLE SEARCH WOULD FIND THE FEE OBLIGATION BEFORE SALE OF THE PROPERTY.

**PARKING CALCULATION**

	REQUIRED PER COUNTY CODE	# OF CLASSROOMS	# OF STUDENTS	SUBTOTAL
ELEMENTARY / JUNIOR HIGH	2 SPACES PER CLASSROOM	7	-	14
SENIOR HIGH	1 SPACE PER 4 STUDENTS	-	32	8
TOTAL REQUIRED				22
TOTAL PROVIDED				23

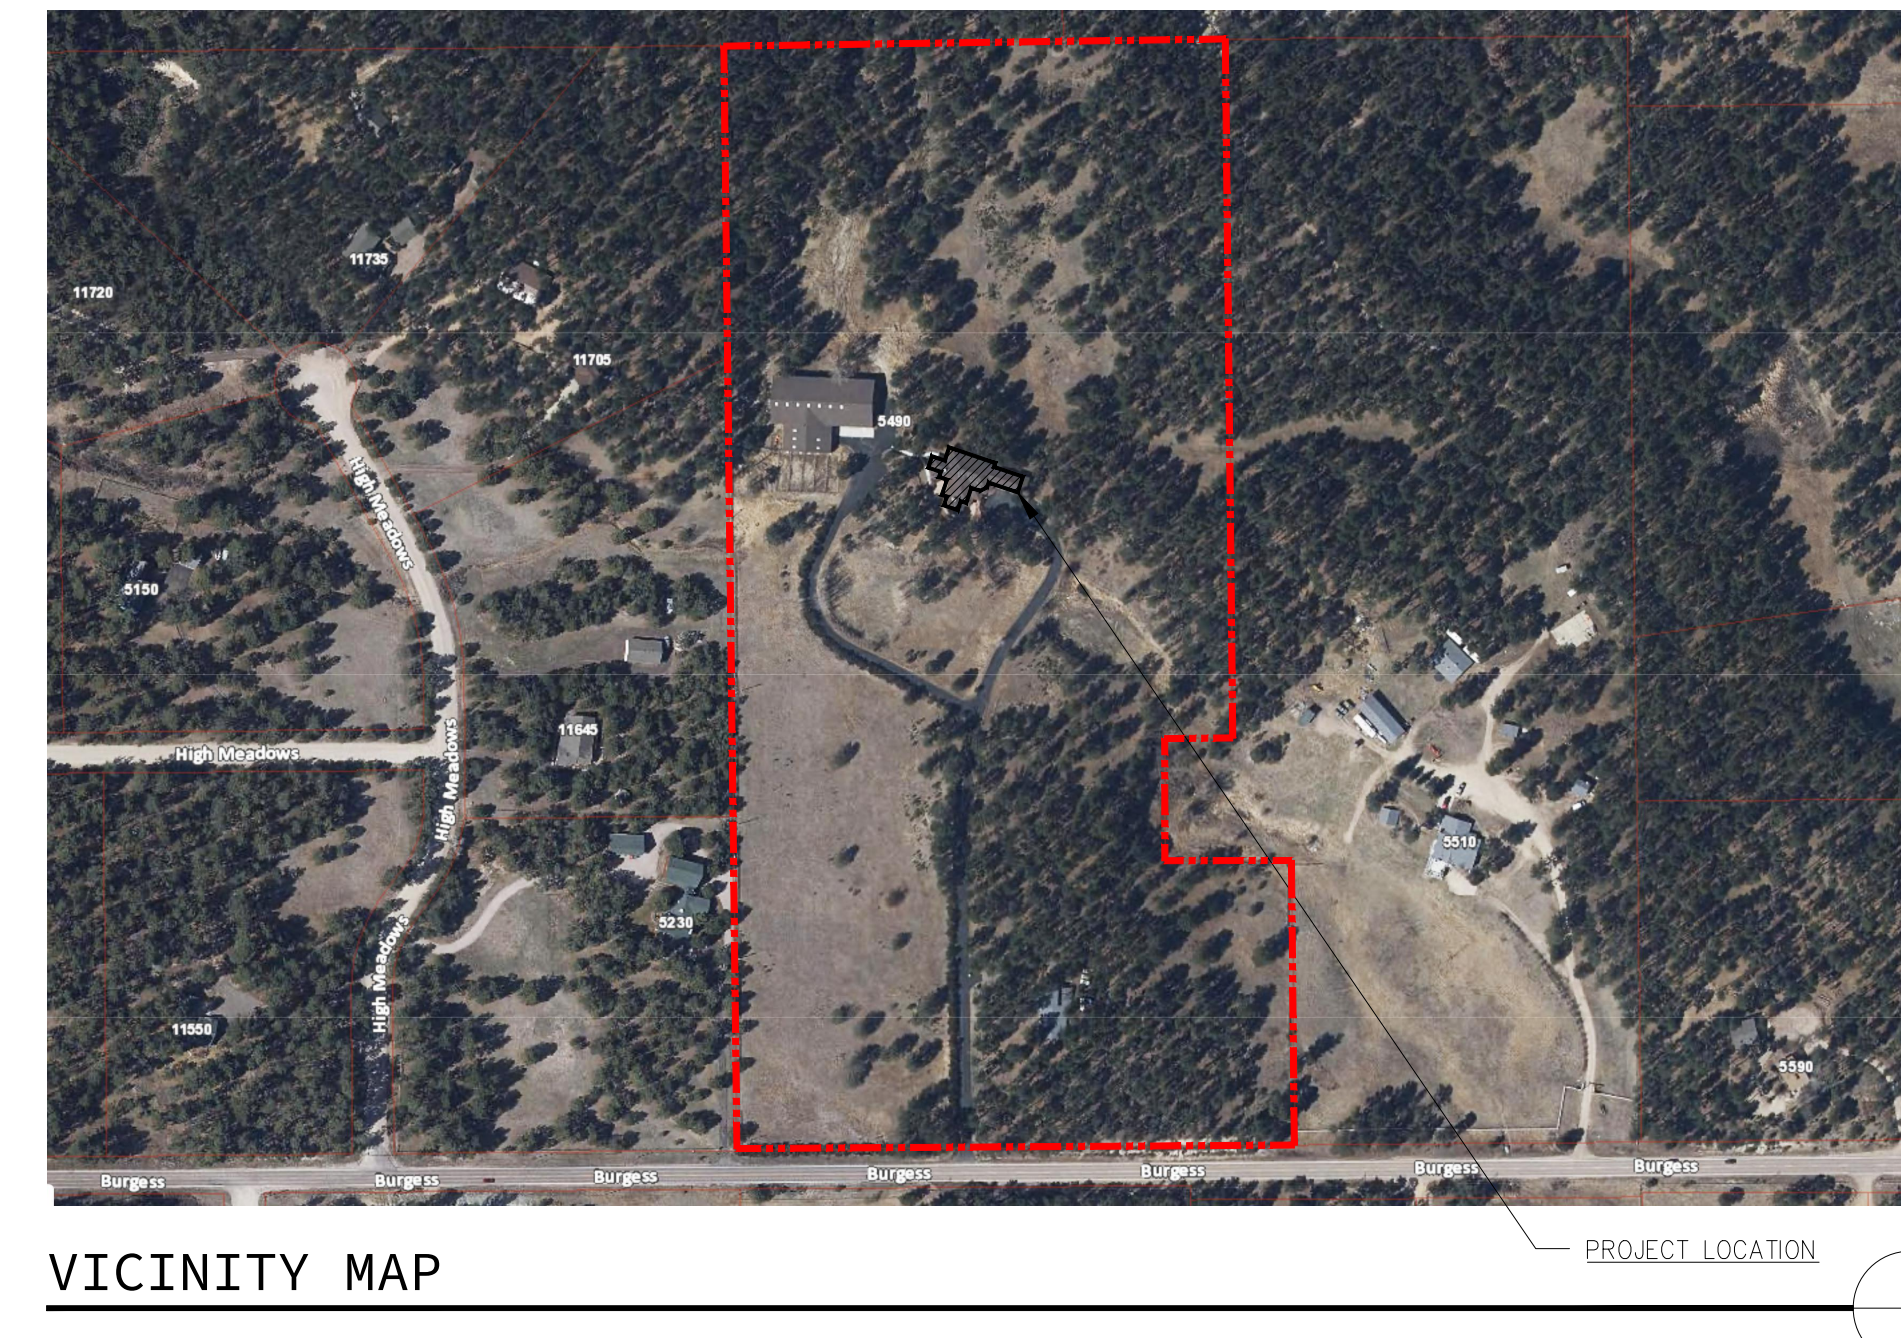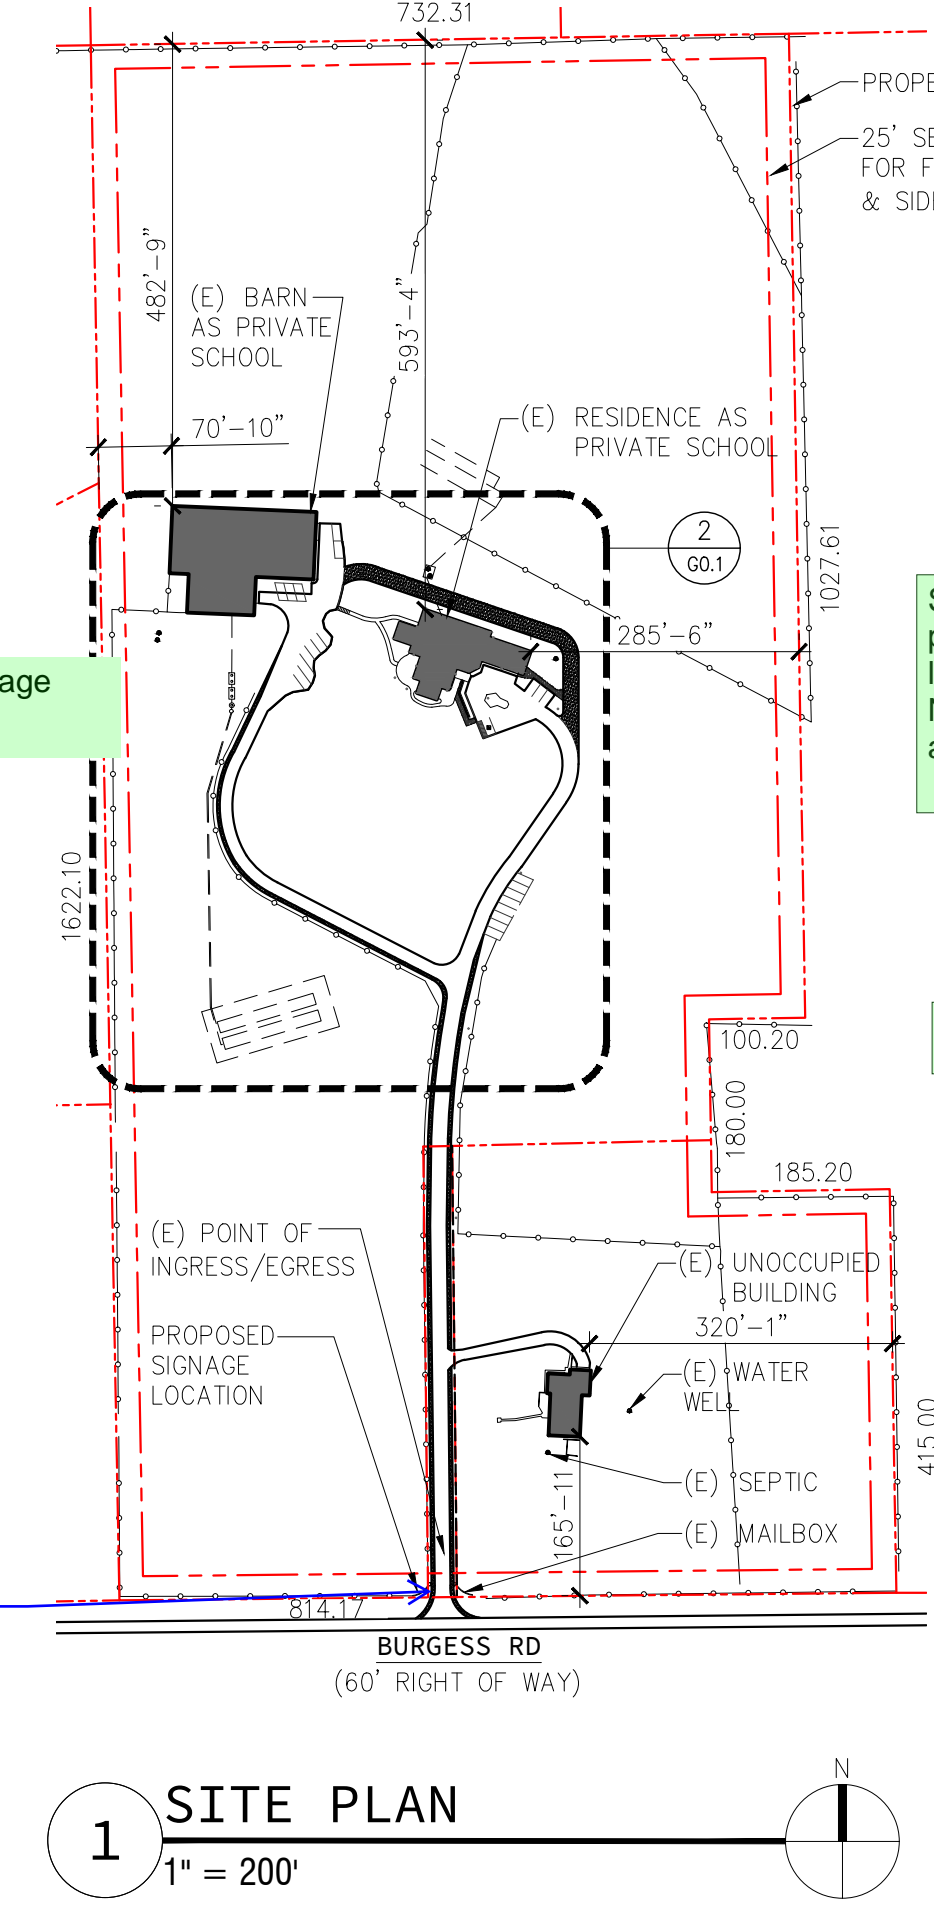

**PROJECT DATA**

**PROJECT SUMMARY:** THE PROJECT INCLUDES ASSOCIATED SITE AND BUILDING IMPROVEMENTS FOR THE CONVERSION OF AN (E) SINGLE FAMILY RESIDENCE AND AN (E) BARN INTO A PRIVATE SCHOOL FACILITY.

**PROJECT ADDRESS:** 5490 BURGESS ROAD COLORADO SPRINGS, CO 80908

**TSN:** 6213000037

**LEGAL DESCRIPTION:** BEG AT SW COR OF SW4SE4 SEC 13-12-66, TH N ON W LN SW4SE4 1650 FT, ANG R 90< E 727.2 FT, ANG R 90< S 1025 FT, ANG R 90< W 100.2 FT, ANG L 90< S 180.0 FT, ANG L 90< E 185.2 FT, ANG R 90< S 445.0 FT, TH ANG R 90< W TO POB EX S 30 FT FOR RD

**County not city. Please fix.**

**CITY ZONING:** RR-5

**PROJECT TYPE:** EDUCATION BUILDINGS, UNOCCUPIED BUILDING NOT IN SCOPE.

**PLD FILE #:** PPR2423

**BUILDING/SITE DATA**

**TOTAL SITE AREA:** 27.45 ACRES

**BUILDING FOOTPRINT:**  
(E) RESIDENCE: 6370 S.F.  
(E) BARN: 13353 S.F.  
UNOCCUPIED BUILDING: 2464 S.F.  
TOTAL: 21930 S.F. (NO CHANGE)

**# OF STORIES:** 1 (NO CHANGE)

**PROPOSED LOT COVERAGE:** 1.83% (NO CHANGE)

**EXISTING USE:** RESIDENTIAL

**PROPOSED USE:** EDUCATIONAL, PRIVATE

**OPEN SPACE:** 88.3%

**LANDSCAPING:** N/A  
(E) NATIVE VEGETATION TO REMAIN

**IMPERMEABLE SURFACE:** 4.9%

**ACTUAL BUILDING HEIGHT:** 19'-7 1/2" (NO CHANGE)

**CONTACTS**

**OWNER:** THE HAVEN SCHOOL  
CONTACT: EMILY HILL  
e. ehill@havenschool.com

**ARCHITECT/APPLICANT:** ECHO ARCHITECTURE  
2752 WEST COLORADO AVE  
COLORADO SPRINGS, CO 80904  
CONTACT: SCOTT SCHUSTER  
p. 719.387.7836  
e. scott@echo-arch.com

SDP and landscape plan denotes now landscape island. Note new landscape area and sq footage

Contact phone number?

# HAVEN SCHOOL

## 5490 BURGESS ROAD

### COLORADO SPRINGS, CO

PLD FILE #: PPR2423

**SITE PLAN**



2024-05-HAVEN SCHOOL  
5490 BURGESS RD COLORADO SPRINGS, CO 80908

date: 08.19.2024  
phase: SITE DEV. PLAN  
drawn by: ANG

Echo Architecture, PLLC  
2752 W Colorado Ave  
Colorado Springs, CO 80904  
www.echo-arch.com  
t 719.387.7836

**Go.1**