



Show in its entirety.

RACEWAY MOUNTED, FRONT LIT, CHANNEL LETTER SET WITH LOGO ITEM AND CAPSULE

SPECIFICATIONS:

Front lit, raceway mounted, aluminum fabricated, standard channel letter set having 5" black returns and 1" black trim caps, internal LED illumination, with blue acrylic faces illuminated by white LED modules (see illumination specifications). Letters to be flush mounted to aluminum raceway, and raceway to be flush mounted to fascia as shown using adequate fastening anchors. Logo and capsule to be LED illuminated with white acrylic faces and 3M vinyl graphic overlay.

Illumination Specifications:

White LED modules, low voltage power supply, low voltage insulated wiring, UL listed and approved, service/disconnect switch on raceway.

Electrical Specifications:

Property owner and/or client is responsible at their own expense to provide a dedicated 20A circuit for the sign, and is responsible at their own expense to have a qualified licensed electrician make the final connection of the sign to the provided circuit.

Attach a site plan showing the whole parcel, the structure, and where the sign is located.


Include that sign meets El Paso County Lighting Criteria in Ch. 6 of Land Development Code.

Attachment Specifications:

Aluminum construction, color matched to building

Electrical and Attachment Detail:

THIS SIGN IS INTENDED TO BE INSTALLED IN ACCORDANCE WITH THE REQUIREMENTS OF ARTICLE 600 OF THE NATIONAL ELECTRICAL CODE AND/OR OTHER APPLICABLE LOCAL CODES. THIS INCLUDES PROPER GROUNDING AND BONDING OF THE SIGN.

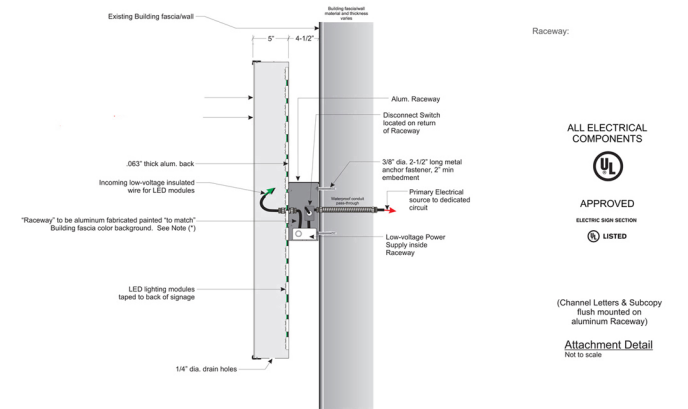

El Nissi Corporation
P.O. Box 63795
Colorado Springs, CO 80962
(719)492-5807

Customer: **FYZICAL THERAPY & BALANCE CENTERS**
Address: **7622 McLaughlin Road
Peyton, CO 80831**
Contact: **Brandy Bartlett, (719)495-0619
brandy@falconpt.com**

Sign Consultant: **Emil Rock**
Approved by:


Designed by:
KR

Article 600 of the National Electric Code (NEC)
This statement "MUST" go on every technical drawing that has a sign installed in any jurisdiction in the United States
(Note: the "UL" label or logo, is the Underwriters Laboratory icon and must be placed on every electrical sign attachment or installation detail drawing. UL is only one of several certifying agencies in the U.S.)



Markup Summary


dsdkendall (2)

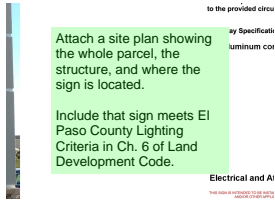

Subject: Text Box
Page Label: 1
Author: dsdkendall
Date: 7/27/2018 10:28:31 AM
Color: ■

Attach a site plan showing the whole parcel, the structure, and where the sign is located.

Include that sign meets El Paso County Lighting Criteria in Ch. 6 of Land Development Code.

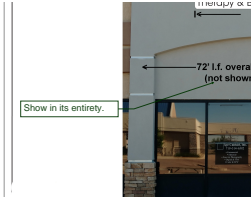

Subject: Callout
Page Label: 1
Author: dsdkendall
Date: 7/27/2018 10:28:47 AM
Color: ■

Show in its entirety.